

**ADDENDUM NO. 4**

**NOTICE INVITING BIDS**

**FOR**

**2022PW01**

**CHINO INSTRUCTIONAL BUILDING  
FROM PREQUALIFIED CONTRACTOR**

**CHAFFEY COMMUNITY COLLEGE DISTRICT**

February 16, 2022



CHAFFEY COMMUNITY COLLEGE DISTRICT  
5885 Haven Avenue  
Rancho Cucamonga, CA 91737

**NOTICE INVITING BIDS 2022PW01 CHINO INSTRUCTIONAL BUILDING  
FROM PREQUALIFIED CONTRACTORS**

The following changes, additions, deletions, clarifications, or corrections shall become part of the Proposal for Chaffey Community College District, **NOTICE INVITING BIDS 2022PW01, CHINO Instructional Building** at the **Chaffey Chino Campus**, first advertised January 11, 2022. All other terms, specifications, and conditions remain the same. Each proposer is responsible for transmitting this information to all affected subcontractors and suppliers prior to the receipt of proposals. Each proposer shall acknowledge receipt of this Addendum on their Proposal.


**ITEM 1: RFC 133 RESPONSE (SEE ADDENDUM 3) REFERENCE SHEET CHINO  
MAIN INSTRUCTIONAL BUILDING TELECOMMUNICATIONS SITE PLAN,  
SHEET EC1.02**

**ADD:** Chaffey College Chino Campus Main Instructional Building Telecommunications Site Plan, Sheet EC1.02 dated July 31, 2009, is hereby issued for reference to the answer for Request for Clarification #133, included in Addendum #3 dated February 15, 2022. Contractor is to utilize this sheet for bidding purposes only. (SEE ENCLOSURE #1) Please be advised that Addendum No. 2 to Bid No. 2022PW01 Chino Instruction Building was recalled in PlanetBids to remove duplicate pages due to clerical error. Addendum No. 3 was issued on February 15, 2022 to provide a REVISED document (previously Addendum No. 2) that excludes the duplicate pages.

**END OF ADDENDUM NO. 4**

Enclosures:

1. Chaffey College Chino Campus Main Instructional Building Telecommunications Site Plan dated July 31, 2009.

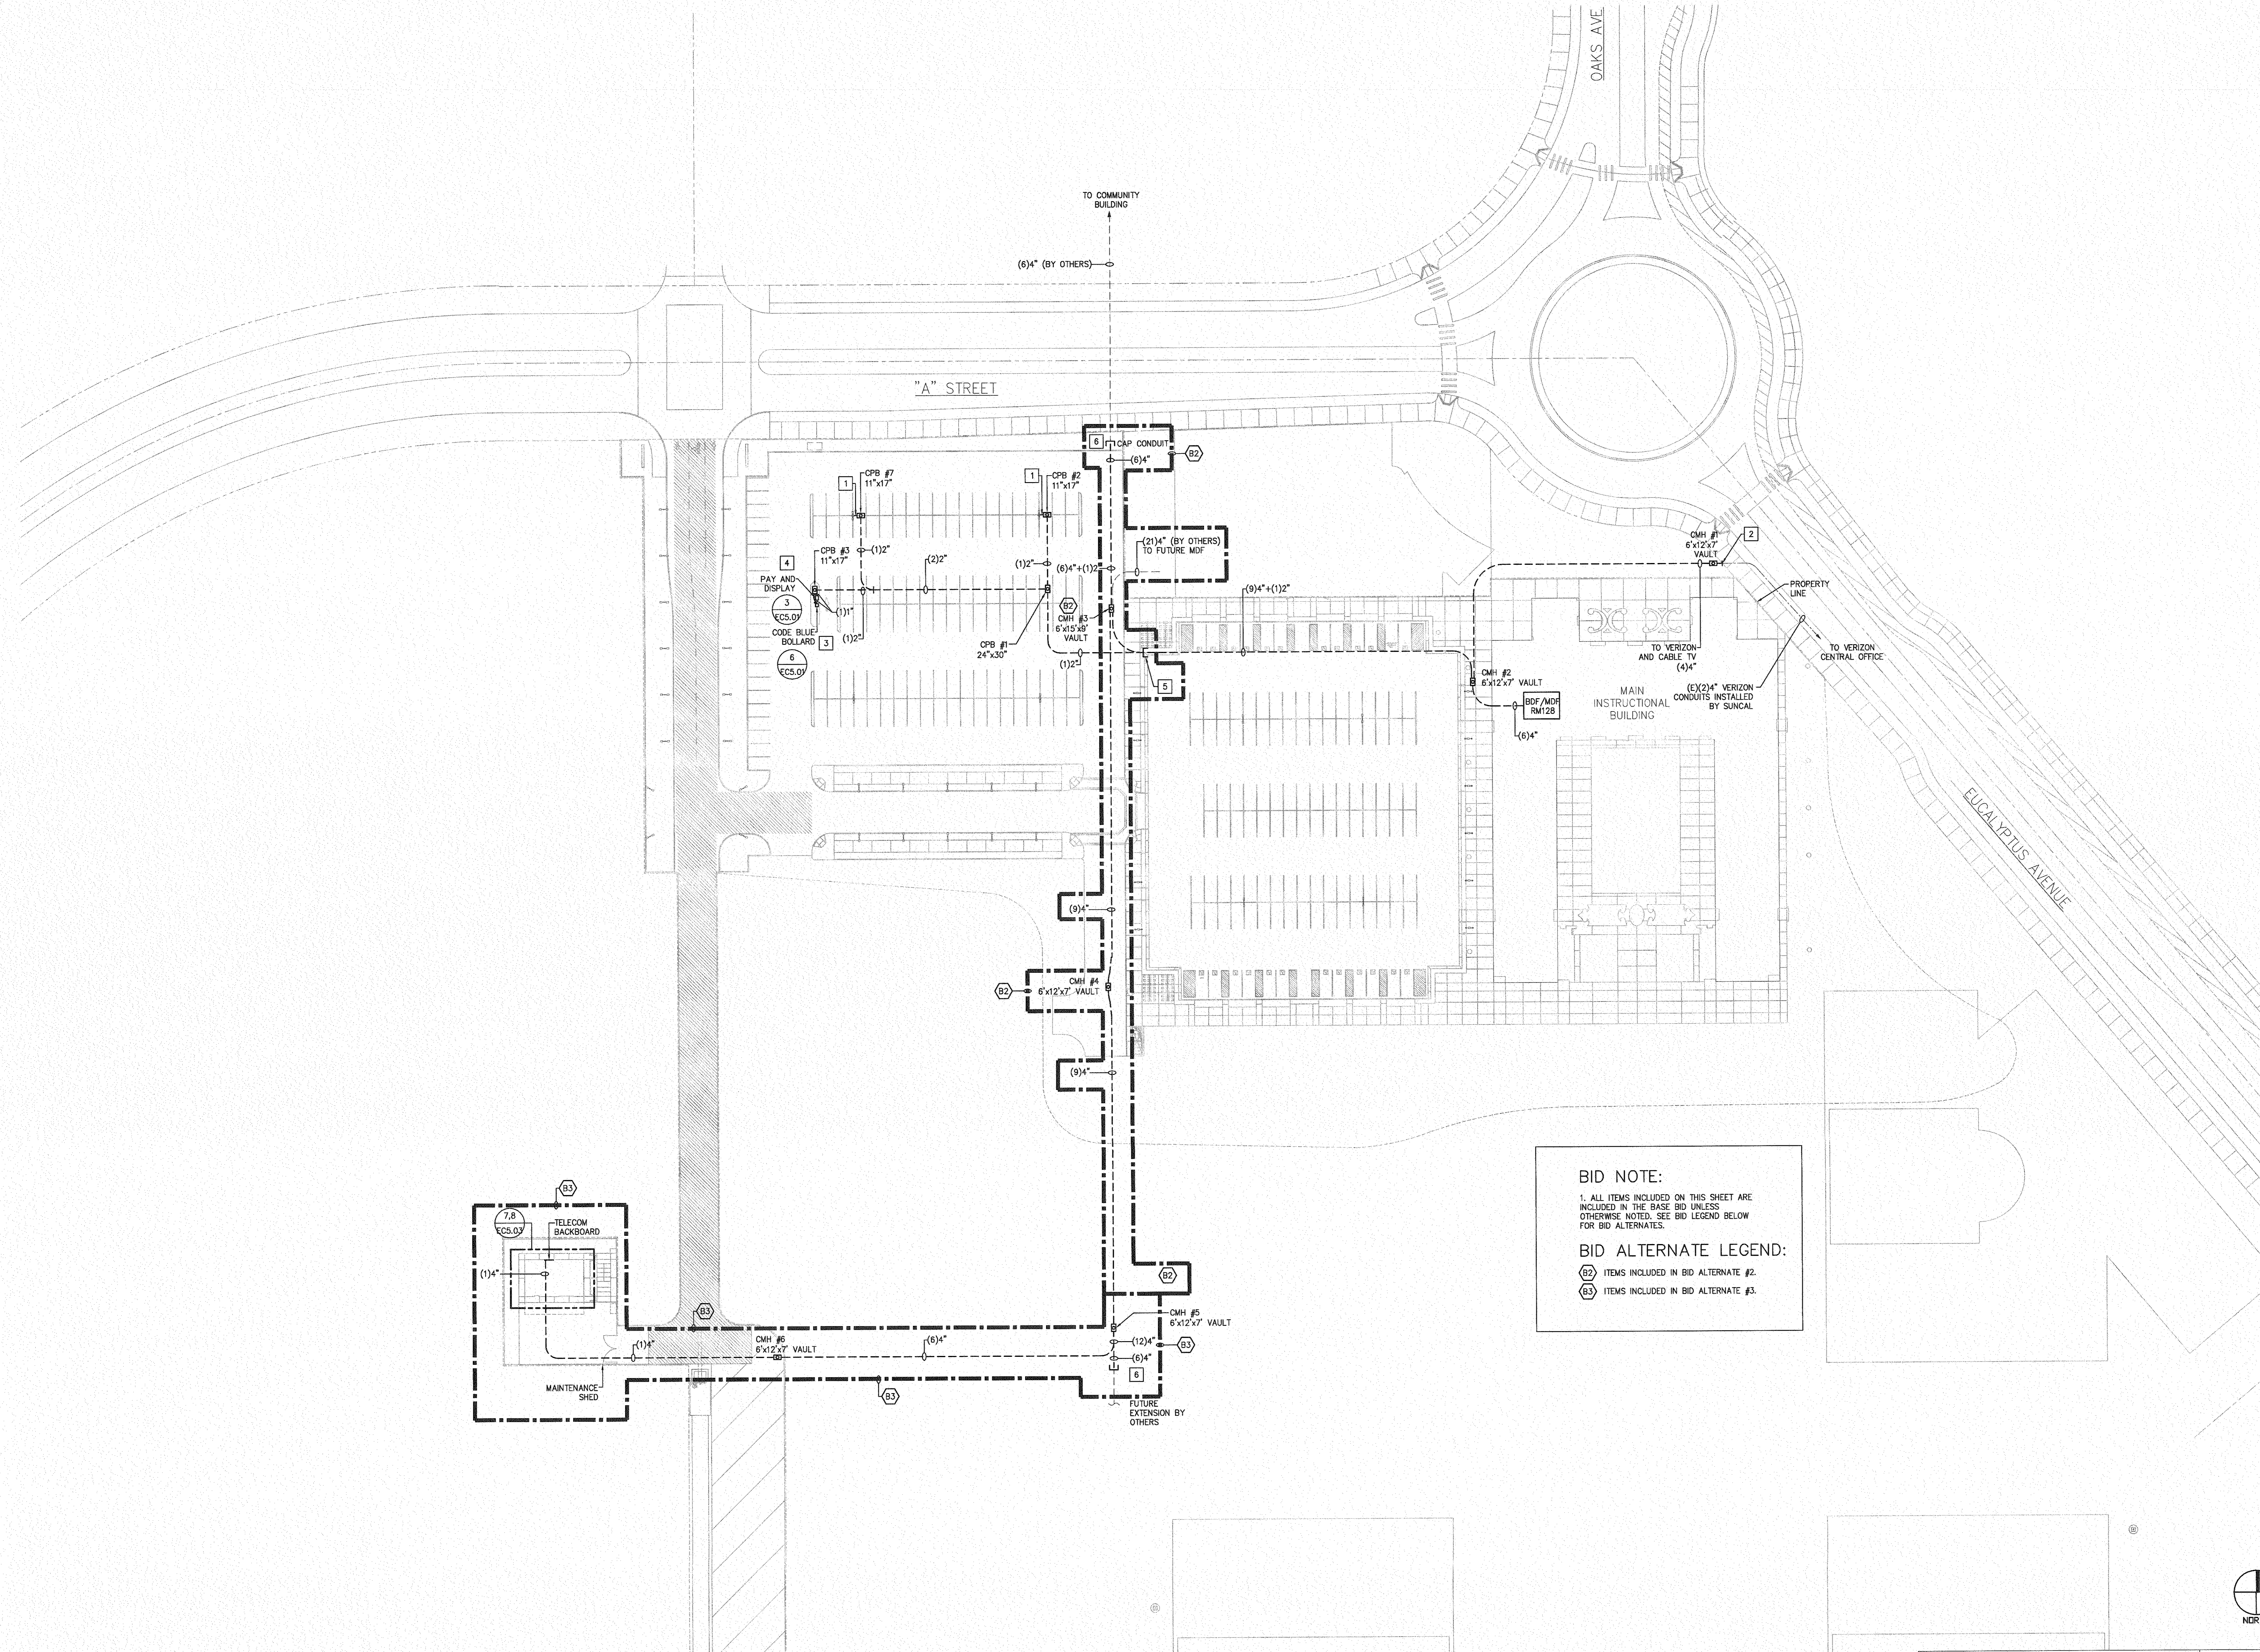

**BID NOTE:**  
 1. ALL ITEMS INCLUDED ON THIS SHEET ARE INCLUDED IN THE BASE BID UNLESS OTHERWISE NOTED. SEE BID LEGEND BELOW FOR BID ALTERNATES.

**BID ALTERNATE LEGEND:**  
 (B2) ITEMS INCLUDED IN BID ALTERNATE #2.  
 (B3) ITEMS INCLUDED IN BID ALTERNATE #3.

- KEYNOTES:**
- BASE BID:
1. INSTALL (1) 1" GALVANIZED RIGID CONDUIT (SRC) FROM UIC PULLBOX INTO BASE OF NEW POLE FOR FUTURE SECURITY CAMERA.
  2. INSTALL (2) 4" CONDUITS FROM MANHOLE CMH #1 TO PROPERTY LINE. AT PROPERTY LINE CONNECT CONDUITS TO TWO EXISTING VERIZON CONDUITS.
  3. INSTALL (1) 1" PVC CONDUIT FROM CPB INTO BASE OF CODE BLUE BOLLARD.
  4. INSTALL (1) 1" PVC CONDUIT FROM CPB INTO BASE OF PAY AND DISPLAY STATION.
  5. CAP (9) 4" UNDERGROUND CONDUITS FOR FUTURE EXTENSION. DO NOT ENCASE LAST FOUR FEET OF CONDUITS IN CONCRETE. (DELETE CAPPING CONDUITS IF BID ALTERNATE #2 IS IMPLEMENTED.)
  6. CAP NEW UNDERGROUND CONDUITS FOR FUTURE EXTENSION. DO NOT ENCASE LAST FOUR FEET OF CONDUITS IN CONCRETE.
- BID ALTERNATE #2 AND #3:

PROJECT  
**CHAFFEY COLLEGE**  
**MAIN INSTRUCTIONAL BUILDING**  
 5897 COLLEGE PARK AVENUE  
 CHINO, CALIFORNIA

ARCHITECT  
**MDA JOHNSON FAVARO**  
*Architecture and Urban Design*  
 5898 Blackwelder Street, Ground Floor  
 Culver City, CA 90232  
 (Tel) 310-559-8720 (Fax) 310-559-8220

CONSULTANTS  
**ENGLERKIRK & SABOL**  
 CONSULTING ENGINEERS, INC.  
 3116 Arroyo Avenue  
 Los Angeles, California 90038-1336  
 (Tel) 323-753-2040 (Fax) 323-753-8862

**KPFF CONSULTING ENGINEERS**  
 CONSULTING ENGINEERS  
 6900 Corner Drive, Suite 200  
 Los Angeles, California 90045  
 (Tel) 310-285-1338 (Fax) 310-285-9470

**P25 ENGINEERING**  
 CONSULTING AND TECHNOLOGY ENGINEERS  
 3000 East Spring Street  
 Long Beach, California 90805  
 (Tel) 562-457-2999 (Fax) 562-457-2995

**KATHERINE SPITZ ASSOCIATES INC.**  
 CONSULTING LANDSCAPE ARCHITECT  
 4425 151st Street, Suite 100  
 Redondo Beach, California 90473  
 (Tel) 310-574-4460 (Fax) 310-574-4460

**WALKER PARKING**  
 CONSULTING PARKING DESIGNER  
 2585 Midway Ave.  
 Suite 202  
 Buena Park, CA 92615  
 (Tel) 949-251-2663 (Fax) 949-960-0116

**FOLLIS DESIGN**  
 CONSULTING BRIDGE DESIGNER  
 807 Redwood Avenue  
 Redondo Beach, CA 90475  
 (Tel) 688-738-5550 (Fax) 688-738-4261

This design and specification, plan, section, and presentation are the sole property of the Designer. No part thereof shall be reproduced, stored in a retrieval system, or transmitted in any form or by any means, electronic, mechanical, photocopying, recording, or by any information storage and retrieval system, without the prior written consent of the Designer. The Designer shall not be held responsible for any errors or omissions in this plan and shall not be liable for any damages, including consequential damages, arising from the use of this plan. The Designer's Representative and Engineer for review before this approval.

ARCHITECTS / ENGINEERS STAMP

DIV. OF THE STATE ARCHITECT APPROVAL  
 APPLICATION # 04-107596  
 ... AC ... FLS ... SS ...  
 DATE

RECORD DRAWINGS  
 No. Issue Date  
 ISSUE / REVISIONS

TITLE  
**TELECOMMUNICATION SITE PLAN**

SCALE: AS NOTED DATE: 7-31-09

DRAWN BY: RM CHECKED BY: B.RICE

PROJECT # 0406 CHAFFEY PHASE I  
 MAIN INSTRUCTIONAL BUILDING

SHEET:

**EC1.02**

**LEGEND:**  
 --- EXISTING VERIZON CONDUIT  
 --- (LIGHT) FUTURE DUCTBANK  
 --- (BOLD) UNDERGROUND TELECOM DUCTBANK

SITE PLAN  
 SCALE 1"= 40'-0" 1