

BID ADDENDUM #6

April 21, 2022

To:
Prospective Bidders/Planholders

**Child Development Center
ST-01828
California State University Stanislaus
One University Circle, Turlock, CA 95382**

This Addendum forms a part of the contract documents and modifies the original bidding documents. Addendum shall be noted as received and acknowledged on the Bid Proposal Form when submitted as outlined in the Bid Package referenced above.

The following corrections, additions, deletions, and/or modifications to the above package, by this reference, shall be incorporated therein:

Addition:

SUBSTITUTIONS

Contractor is directed to interpret listed products in plans and specifications to include “or equal” to allow for substitutions in accordance with Section 01 25 00 – Substitutions, with the exception of the following four items:

- Access Control – Paxton Net 2
- Building Management System – Automated Logic Controls
- Fire Alarm – Notifier
- Keyways – Corbin Russwin to match campus standard

The aforementioned four items are campus proprietary systems and substitutions will not be considered. Refer to the Contract General Conditions Section 5.04 (c).

ALTERNATES

Sheet G0.01 lists seven (7) alternates. Please see revised Section 01 23 00 included in this addendum for alternates.

To clarify:

- #3 not used – disregard
- #4 Change Eomac Veneered Linear Plank Wood ceiling to Armstrong Wood Works Grille Tegular 663008 2x4 for 9/16” tegular, light cherry. Disregard this alternate. Specifications Section 09 54 29 2.01 already lists three approved manufacturers.
- #5 Increase PV scope from 100kW system to 300kW, see E6.1. The base bid is for 100kW. The add alternate is for 300kW.
- #6 Add water meter, see P0.02 Plumbing Fixture Schedule. The hot water meter in the plumbing fixture schedule should be deleted.
- Alternates #1, 2, 5, and 7 are included on the revised bid proposal form. Please see bid form included in this addendum.

SPECIFICATIONS

The specifications posted on the e-arc website may be difficult to read. Please click on this link to access a clearer copy. https://www.dropbox.com/s/p8z8ggr15zy5jve/02_CSUS_CDC_SPECS.pdf?dl=0 Additionally, see revised Specifications Sections included in this addendum.

Further, the University will **not** require wood products to be FSC certified.

QUESTIONS/RESPONSES

Question #1:

Would it be acceptable to submit the Company Address on the "List of Proposed Subcontractors" within 24 hours after bid opening?

Response: Per Exhibit C of the bid documents, list of proposed subcontractors is to be submitted with the bid.

Question #2:

Item 1.3.B lists a Geotechnical Report by Krazan & Associates. I couldn't find this report in the specifications, please provide.

Response: CSU Stan to post Krazan report to ARC Public Planroom

Question #3:

Can the architect/owner issue a better copy of the specifications, the scan pdf file is very light in some areas and hard to read.

Response: CSU to post higher quality scans to Dropbox link below:

<https://www.dropbox.com/s/p8z8ggr15zy5jve/02%20CSUS%20CDC%20SPECS.pdf?dl=0>

Question #4:

Please advise what are the allowances amounts to be entered on the newly issued addendum 4 Bid Proposal Form?

Response: There are no allowances on this project.

Question #5:

The Small Business & DVBE Incentives are no longer listed on the updated Bid Proposal Form, are they both still available to claim?

Response: Yes, an updated bid form will be issued as part of this addendum.

Question #6:

Regarding OCIP requirements, per general conditions page 24 subcontractor with an EMR rating over 1.25 will be excluded. Does this mean the subcontractor will not be able to bid on this project if the EMR is higher than the listed limit? If the subcontractor's EMR rating is over 1.25 can they provide their own insurance in order to comply with the insurance requirements?

Response: per section 4.06 b(2)(g), Excluded Parties and Their Insurance Obligations, "Subcontractors, of any tier, with an EMR rating of over 1.25 unless specifically approved by the Underwriter."

Question #7:

Spec section 10 14 00 SIGNAGE, Part 2 Products, 2.01.A. Acrylic Sheet, reads, "thickness specified," however we did not find thickness dimension(s) cited on Sheet G0.11 V3. Please provide the thickness(es).

Response: Standard 1/4" thickness.

Question #8:

Spec section 10 14 00 SIGNAGE, Part 2 Products, 2.01.B. Aluminum Sheet, please advise if sheet thickness should also be as "recommended by the aluminum producer or finisher..." or please provide the thickness(es).

Response: 3/16" minimum thickness

Question #9:

For all plaque signage types shown on Sheet G0.11, please also indicate if corners are sharp, eased, or radiused, and if the latter, provide the radius dimension. Similarly, indicate if exposed edges are sharp, beveled, or eased.

Response: All corners and edges are to be eased.

Question #10:

Detail 17/G0.11 (G0.11 PREMISE IDENTIFICATION) shows 4" minimum height letters depicting "BUILDING NAME" and "BUILDING ADDRESS." There is no notation as to the sign materials; are these possibly cast or flat cut out acrylic, aluminum or other metal, and if so, what type of finish? We inspected Sheet A2.21 V3 SIGNAGE PLAN & FINISH PLAN AND SCHEDULE but did not find any noted instances of these #17 premise identification signs, nor did any appear on the A3.01 V3 BUILDING ELEVATIONS. If these are part of the scope of work, please provide locations and additional specification detail.

Response: Building signage and details were provided in Addendum 3.

Question #11:

For type 2/G0.11 MEANS OF EGRESS SIGNAGE that appear to be applied to glazing at Reception 100 and South Entry 121 (and any other acrylic sign plaques applied to glazing such as type 15/G0.11 DELAYED EGRESS DOOR SIGN at South Entry 121), please specify whether a backer panel should be furnished and installed on the other side of the glazing from that sign.

Response: All signs applied to glazing must have a backer panel.


Question #12:

The Sign Type shown at detail 1/G0.11, "Back of House Room Number/Name Signage" is indicated as having braille and thus appears to be an acrylic sign type. However, the 7 locations shown are all at exterior locations. Nearly all manufacturers we are aware of for the "standard one-piece photopolymer sign face with tactile Braille and letters or acrylic sign face with applied tactile lettering and Braille" will not warranty this type for outdoor use. Please advise if a sign plaque product using a "sand blasted" hard phenolic ES/MP plastic laminate resulting in integral raised braille and letters and integral color (such as Mohawk Sign Systems Series 200A Sand Carved), may be used at these exterior locations. As that product is also cost effective, please advise if this may be specified for all interior locations as well.

Response: Exterior room signage to be painted 1/8" Zinc face panel laminated to 1/8" aluminum mounting plate. Etched to raise tactile and braille. Details were provided in Addendum 3.

Question #13:


Interior elevation 6/A5.02, viewed east from within Room 119 PRE-K CLASS A, appears to show the 8 1/2" wide (or more) sign type 3/G0.11 (ROOM NUMBER/NAME SIGNAGE) mounted on a narrower width of wall on the strike side of door no. 116A such that a portion of sign would freely protrude into air (and it appears to be drawn that way in elevation). This would not appear to be a feasible configuration; the same is true for its mirror image in Pre-Class B, Room 115. Please advise if this is the intended scope of work signage configuration to be furnished, or provide alternative(s).

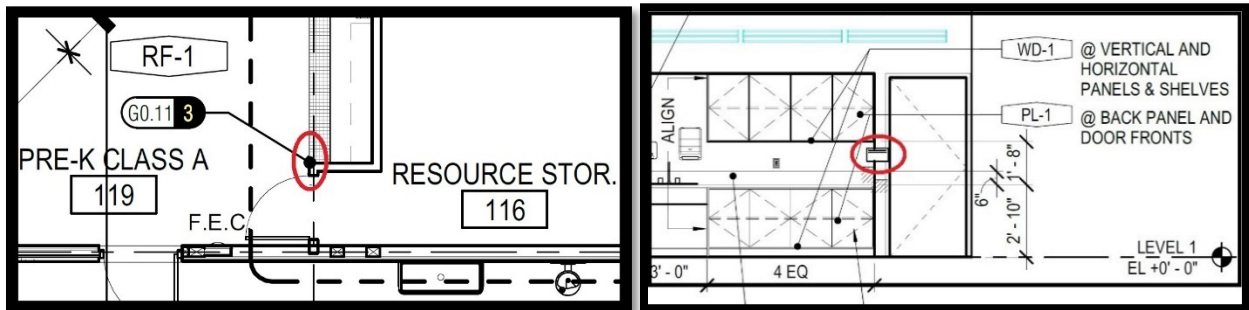

Response: Per CBC 11B-703.4.2 -

"Where there is no wall space at the latch side of a single door or at the right side of double doors, signs shall be located on the nearest adjacent wall. Signs containing tactile characters shall be located so that a clear floor space of 18 inches (457 mm) minimum by 18 inches (457 mm) minimum, centered on the tactile characters, is provided beyond the arc of any door swing between the closed position and 45-degree open position."

Signage at doors 108A, 108B, 116A, 116B will be relocated to the adjacent wall similar to the sketch below.

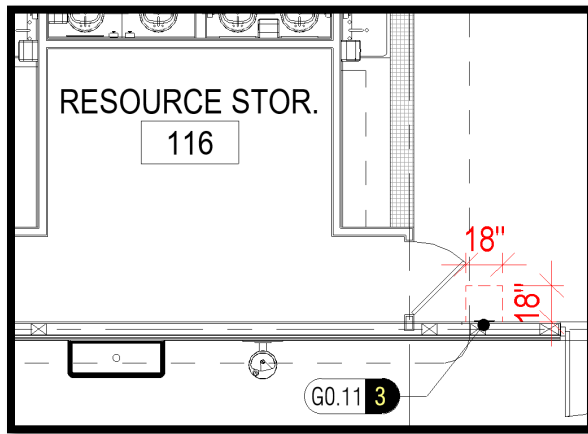

Question #14:

Regarding our previous question #6, we found that additionally at door 108A in Room 107/Toddler Class A and at door 108B in Room 111/Toddler Class B, the same condition of the 3/G0.11 wall sign being much wider than the available wall for its mounting, resulting in a significant length of sign jutting out freely into space, as clearly indicated in the elevation detail 3/A502.

Response: Refer to response of question #13

Question #15:

The Sign Type shown at detail 6/G0.11, Fire Bell Exterior Sign, did not appear to be marked on 1/A2.21 FINISH PLAN, will this sign be part of the Scope of Work? If so, please provide location(s).

Response: Sign type 6/G0.11 will be used in the project and will be located outside of the mechanical room on the south exterior wall near the fire bell. See plan note #12 on E2.1 for gong location.

Question #16:

The FACP & Fire Riser Signage shown at detail 9/G0.11 is noted as having red lettering and red border on white background. However, nothing is noted for the "FIRE RISER INSIDE" SIGN at 10/G0.11. May we assume that 10/G0.11 will have the same lettering, border and background colors as for 9/G0.11?

Response: Yes, same red lettering, white background and red border to be provided on both details 9&10/G0.11.

Question #17:

A4.01/02 toilet accessory schedule tag v calls out for a Koala Kare KB100-0. This model number has been discontinued for a number of years, and this unit is not called out on the plan pages. Can we please have an updated model number, and confirm where this is to be used

Response: Accessory 'V' has been deleted from the schedule and is reflected in Addendum 3.

Question #18:

S1.2 General Notes, Section D.1 states contractor to furnish design items by an engineer for review. Section D.2 states design for the pre-fabricated wood roof trusses and the seismic supports for the solar arrays shall be submitted for review by the University Seismic Review Board (SRB). There is no reference to DSA in these sections. Confirm these design items only require the review of the SRB and no review by DSA is required.

Response: There are no structural reviews by DSA.

Question #19:

S1.2 General Notes, Division 06 Wood, Section 061753 Metal Plated Wood Trusses, note 3, states "Shop fabrication of all wood trusses shall be certified by recognized independent testing agency per CBC 1704.2.5.1". The referenced CBC does not provide a list of certified independent testing agencies. Which agencies are recognized as certified?

Response: The question of researching sub-contractor qualifications is not the responsibility of the design team.

Question #20:

S1.2 General Notes, Division 06 Wood, Section 061753 Metal Plated Wood Trusses, note 6, states, all framing lumber shall be Forest Stewardship Council (FSC) certified. According to our manufacture and supplier community, most, if not all, manufactures are not FSC certified due to lack of traction within the program. Confirm FSC is not required for this project?

Response: The FSC requirement will be removed per Addendum #6.

Question #21:

Sheet L4.2 shows length of linear root barrier shall be 16 linear feet (8 panels), but refer to the symbol shown on sheet L4.1 and L4.2, the length is various. Please clarify.

Response: Length of root barrier shall be 16' linear feet on each side of any tree that is within 5' of hardscape.

Question #22:

Detail F on sheet L2.1 shows 4" layer of 3/4" chip aggregate, but refer to construction callouts 10 shown on sheet L1.1, it's 3" depth. Please clarify.

Response: 3"

Question #23:

Sleeves size shown on irrigation legend sheet L3.1 and L3.2 is 4" minimum size, but refer to callouts on plan, it's 2" or 2 1/2". Please clarify.

Response: Install quantity and size as shown in callouts on plan.

Question #24:

General irrigation notes #7 on sheet L3.1 requires two spare wires along mainline, but refer to specs section 32 80 00/3.06/D/6a, only one spare wire is needed. Please clarify.

Response: Specs call for 1 spare common wire, and additional spare control wires in quantity at a ratio of 1 spare per 6 valves. Install spare wires per specifications. Note #7 on sheet L3.1 has been updated.

Question #25:

Please provide model, size and detail of air vacuum relief valve shown on sub-surface dripline notes on sheet L3.1.

Response: Please disregard all subsurface dripline notes. Plans previously included subsurface drip irrigation, but there is no longer any subsurface drip included in the project.

Question #26:

Please provide detail of automatic flush valve shown on sub-surface dripline notes on sheet L3.1

Response: See response to question #25.

Question #27:

Maintenance period is 60 days per general planting notes #5, spec section 32 90 00/1.05/J calls for 1 year. and spec section 32 90 00/1.11/A, calls for 90 days. Please clarify.

Response: Maintenance period is defined in spec section 32 90 00/1.11/A. Section 1.05/J has been removed from the planting specs to avoid confusion. Planting Note #5 on sheet L4.1 has updated to conform to the specs, indicating the 90-day maintenance period.

Question #28:

Please provide size and material of aggregate base under decomposed granite per detail E/L2.1.

Response: Class II

Question #29:

Per Piping Material Specification on Contract Drawing M0.02 v3, Hydronic Pipe (HHWS/R & CHWS/R) above ground is to be Type "K" copper. Per mechanical building standards, Type L is not only acceptable but preferred. Please confirm Type L is an approved material for the hydronic piping above ground.

Response: Not acceptable; Type K is a University requirement.

Question #30:

Specifications Section 06 10 00 – Rough Carpentry Page 3, e. LEED Submittals:2a requires FSC Lumber and a Chain of Custody with documentation. There are no Lumber suppliers that can supply 100% FSC material for this project. Please provide a minimum percentage of FSC required to achieve the FSC LEED requirements? Typically, the maximum achievable is 51% of the entire wood framed portion of the project.

Response: The FSC requirement will be removed per Addendum #6

Question #31:

Section: 06 17 53-Metal Plated Wood Trusses Page 2 & 3, Part 2, Products. A. Lumber, 5, All Framing lumber shall be FSC certified. There is no truss supplier that will use FSC lumber to manufacture the roof trusses. Can this specification be eliminated?

Response: The FSC requirement will be removed per Addendum #6.

Question #32:

Section 06 18 50-Structural Glued Laminated Timber Page 2, 4. Submittals, e. LEED Submittals 2. FSC Lumber is required. A. Chain of custody with documentation is required. Please provide a percentage of FSC required to meet these requirements, needs to be 51% maximum. For your information. FSC Lumber is commanding a significant cost over standard lumber. The supply chain of FSC is difficult even for the items that should be available. Do to supply chain issues we suggest eliminating all FSC requirements as FSC adds an additional 50% material cost increase.

Response: The FSC requirement will be removed per Addendum #6.

Question #33:

Detail C/L2.1 calls for two integral colors of concrete at the enhanced entry areas:

1. Please provide a complete layout plan identifying exact locations of color #1 and color #2 for all "enhanced entry areas." This greatly affects pour sequencing.
2. Please specify colors for color #1 and color #2, as well as for the colored concrete bike bath (Note #26 on L1.1)

Response: See Addendum 6. Layout and selected colors are included in new Detail D, Sheet L2.5.

Question #34:

Please specify anchorage sizing and spacing for the wood decking connection to concrete on the site. No anchorage information is given on detail D/L2.1.

Response: Wedge anchors shall be provided at 32" O.C., centered between joists. Anchor to be 1/2" Hilti Kwik Bolt TZ2 CS Wedge anchor or approved equal

Question #35:

Please advise on whether an equal alternate to the Contech Stormfilter manhole can be submitted for consideration on the project.

Response: Normally we would allow equal alternatives; however, stormwater quality control measures are an exception due to most agencies' standards limiting the devices that can be used. Contech should be used if possible as their device has been approved for this installation.

Question #36:

Cover sheet G0.01 notes Alternates, Bid Proposal Form does not list all alternates as noted on G0.01 or on Drawings.

Response: CSUS to provide revised bid proposal form with all listed alternates in addendum #6.

Question #37:

Drawing A3.12, 3.21, 3.22 Roof Monitor North notes, Add Alternate, no details noted or listed on G0.01. Do we use North Roof Monitor detail A3.23?

Response: The roof monitor along gridline C has been removed, see updated elevations included with Addendum 6.

Question #38:

Provide color selection for light and dark colors for pricing. Reference C/L2.1

Response: Included with Addendum 6.

Question #39:

Please consider substitution Leviton to Signamax, see attached product data.

Response: The successful bidder should utilize the substitution process as specified in the Contract General Conditions and Specification Section 01 25 00 – Substitutions.

Question #40:

1. Voice/Data; how many wires per drop? 1v 1d?
2. WAPs owner furnished or contractor furnished? How many wires needed?
3. NVR; required resolution, frame rate and storage duration?
4. Paxton access; quantity of user cards?

Response:

1. Refer to Telecomm Schedule on E0.3 for cabling requirements.
2. WAPs are University furnished, refer to E0.3 for cabling requirements.
3. None required.
4. No additional cards required.

Question #41:

Please confirm framing lumber to be fire treated, reference Detail 11/A901.

Response: Fire-rated note has been deleted.

Question #42:

Please provide Fire Sprinkler Specification, Division 21 not found. Reference Fire Protection Drawings and Hydraulic and Seismic Calculations

Response: Included with Addendum 6.

Question #43:

Please confirm University standard for water meter. Reference Note G on Sheet C-7.1.

Response: A water meter is to be installed on the incoming domestic water within five (5) feet of the point of entry in the mechanical room and prior to any outlets. The water meter must be connected to the building management system. The basis of design is an Onicon F1000 Series Turbine Flow Meter or equal.

End of Addendum No. 6

BID PROPOSAL FORM

**CHILD DEVELOPMENT CENTER, PROJECT NUMBER ST-01828
CALIFORNIA STATE UNIVERSITY, STANISLAUS
One University Circle
Turlock, CA 95382**

To the Trustees of the California State University, on behalf of the State of California (hereinafter called the Trustees):

The undersigned bidder hereby offers, in the amount stated below, to furnish all labor, materials, tools, equipment, apparatus, facilities, transportation and permits for the construction of the Child Development Center at California State University, Stanislaus, if this offer is accepted by the Trustees.

TOTAL AMOUNT OF BASE BID: \$ _____ **LUMP SUM**
(use figures only)

Bidder shall include Allowances and Lump Sum Amount in Base Bid Lump Sum Price.

The Base Bid amount is to be stated in figures only and is the total amount bid for the entire contract work including all applicable taxes. Any alteration, erasure, or change must be clearly indicated and initialed by the bidder. The bidder agrees that if there are any discrepancies or questions in the figures, the Trustees will use the lower figure despite the bidder's intent. The Trustees' Construction Budget is \$15,243,000.

SPECIFY THE NUMBER OF EACH ADDENDUM YOU HAVE RECEIVED ON THE LINE BELOW.

ALTERNATIVES – BASIS OF AWARD

The lowest bid shall be the lowest total of the bid prices on the base contract (Base Bid) and those additive or deductive alternatives that, when taken in order and added to, or subtracted from the Base Bid, are less than or equal to the Trustees' Construction Budget stated above. If Trustees award a contract, it will go to the responsible bidder who submitted the lowest bid as determined by this basis of award. The Trustees are not precluded from adding to or deducting from the contract any of the additive or deductive alternatives after they have determined the lowest responsible bidder.

ADDITIVE ALTERNATIVES

The following additive alternatives are an integral part of this proposal, and to be responsive, the bidder shall quote for the Base Bid, and also for the following listed additive alternatives.

Additive Alternative No. 1:

Addition of fire lane extension as shown on sheet C3.1. \$ _____ Lump Sum
(use figures only)

Additive Alternative No. 2:

#5 Increase PV scope from 100kW system to 300kW, see E6.1. The base bid is for 100kW. The add alternate is for 300kW.
\$ _____ Lump Sum
(use figures only)

Additive Alternative No. 3:

Add 77 SF of dichroic glazing panels at truss of north roof monitor. See 2/A3.11, A6.01, 7/A9.41, & 08 80 00.
\$ _____ Lump Sum
(use figures only)

DEDUCTIVE ALTERNATIVES

The following deductive alternatives are an integral part of this proposal, and to be responsive, the bidder shall quote for the Base Bid, and also for the following listed deductive alternatives.

Deductive Alternative No. 1:

Alternate fence construction – Replace custom steel fences and gates at all yards with prefabricated steel fence shown on callout #17 on Sheets L1.1 and L1.2. Shape and layout of fences and gates to conform to original design.

\$ _____ Lump Sum
(use figures only)

Bidder shall state the above amounts in figures only, and these are the total amounts bid for all of the alternatives including all applicable taxes. Any alterations, erasures, or changes must be clearly indicated and initialed by the bidder. The bidder agrees that if there are any discrepancies or questions in the figures, the Trustees will use the lower figure despite the bidder’s intent.

The Bidder shall hold the lump sum prices for all alternatives for 60 calendar days after the start date of the Notice to Proceed. The Trustees reserve their right, within 60 calendar days after the start date of the Notice to Proceed, to add into or deduct from the awarded contract amount by change order, any or all alternatives that were not previously awarded at the listed lump sum amounts, without any delay or impact to the project and with no mark-up or mark-down.

The Trustees reserve the right to adjust by change order the actual quantity of each unit item utilizing the quoted add/deduct unit prices.

The bid is subject to the provisions contained in the Contract General Conditions (note especially Article 2.00 *et seq.*) regarding instructions to bidders, and the bidder agrees that failure to comply with the conditions thereof may be the basis for rejection of this bid.

Five Percent Small Business Preference

The undersigned bidder is hereby requesting the five percent Small Business Preference. To receive the five percent bid advantage, Bidder must submit with its bid a completed “Small Business Preference and Certification” form 701.09, and also indicate its intent by checking the appropriate response below:

- By checking the appropriate box below, Bidder is requesting the five percent Small Business Preference, as either a:
- 1) CA certified Small Business upon verification in accordance with the CA Code of Regulations, Title 2, Section 1896.2, having applied for certification no later than 5:00 p.m. on bid opening date, or Yes No
 - 2) Non-small business that commits to subcontracting at least 25% of its net bid price to CA certified small businesses and/or microbusinesses. Yes No

If Proposer checks one of the boxes above, and submits the completed Small Business Preference and Certification form 701.09, the Trustees will grant a bid preference of 5% of the lowest responsive bidder’s bid. Reference the Contract General Conditions and Supplementary General Conditions for Design-Bid-Build Project, Article 2.12, Small Business Five Percent Bid Advantage.

DVBE Participation / Request for DVBE Bid Incentive

The Trustees require the successful bidder to achieve three percent (3%) DVBE participation in contracting construction projects as established in the bidding documents, and this must occur prior to the bid opening. The basis of award for this contract includes alternatives, and bidder shall ensure that three percent DVBE participation is met whether or not the Trustees add or deduct alternatives from the Base Bid. The University is offering a 1% DVBE incentive. Bidders shall contact the Trustees’ DVBE Program Advocate at (209) 667-3323 or dsawyer1@csustan.edu.

The Trustees are granting a DVBE Bid Incentive, for bid evaluation purposes only, in accordance with the Contract General Conditions (for Design-Bid-Build Major Projects, Article 2.13, and for Design-Bid-Build Minor Projects,

Article 2.11). Bidder shall indicate whether or not Bidder is requesting the DVBE Bid Incentive by checking the appropriate response below. Bidder commits to subcontract at least the percentage of DVBE participation of its net bid price as stated hereon with one or more DVBE(s).

DVBE Participation	Incentive
3.00% to 3.99%	None
4.00% to 4.99%	1%
5.00% to 5.99%	2%
6.00% or more	3%

Bidder is requesting the DVBE Bid Incentive (check one): Yes No

Bidder shall indicate its Total DVBE Participation Percentage Commitment in the spaces below:

3% Mandatory + _____% DVBE Incentive = _____% Total DVBE Participation Percentage Commitment

Bidder must submit its bid on this Proposal Form, completely filled out and in a sealed envelope provided by the Trustees, and delivered to the Mary Stuart Rogers Building, Room 270 on the California State University, Stanislaus campus, before **2:00 p.m. on May 5, 2022**, or it will be disregarded. The Trustees will only accept bids from prequalified contractors with current California State License Board-issued A or B license and current California Department of Industrial Relations Public Works Registration number.

Bidders shall enclose with this Bid Proposal Form, bidder's security in the amount equal to at least ten (10) percent of the amount of the bid (see Article 2.06-c of the Contract General Conditions). If the bidder is awarded the contract and then fails to execute the contract, the bidder's security shall be forfeited to the Trustees.

The time period for completion of the base bid of the project shall be **488 calendar days** from the construction start date as stated on the Notice to Proceed. Liquidated damages shall be **\$5,000** for each calendar day completion is beyond the time prescribed for the project.

For projects with a construction value of \$10 million or more:

By initialing below, Proposer represents that he/she has read and understood the Contract General Conditions, including but not limited to its OCIP obligations: Proposer and all subcontractors shall exclude from their proposals, bids and change orders all costs for Proposer's insurance coverage described in Article 4.06-a, Insurance Requirements. Proposer shall exclude from its bid, and ensure every subcontractor of every tier excludes from his or her respective bids, the amount of the Proposer and its subcontractors' reduction in insurance costs due to eligibility for OCIP coverages. Reference Article 4.06-b-5, Trustees Insurance Obligations.

By placing his/her initials in the space below, Proposer acknowledges this notification of its Contract General Conditions and OCIP obligations:

(Initial here)

-End of Bid Proposal Form for Design-Bid-Build Project-

SECTION 01 23 00 – ALTERNATES

PART 1 GENERAL

1.01 RELATED DOCUMENTS

- A. Construction Drawings, Technical Specifications, Addenda, and general provisions of the Contract, including Contract General Conditions and Supplementary General Conditions and other Division 1 Specification Sections, apply to this Section.

1.02 SUMMARY

- A. This Section includes: Administrative and procedural requirements for Alternates.
 - 1. Acceptance or rejection of each Alternate is at discretion of the Trustees. None, any, or all Alternates may be accepted or rejected by the Trustees in order of precedence.
- B. Requirements and descriptions for products and scopes of Work identified as Alternates in the Drawings and Specifications and listed as “Bid Alternative “on the Bid Proposal Form.
- C. Included in this Section: non-technical descriptions of Alternates listed by number only on the Bid Proposal.
- D. Included in other Sections: technical specifications for work revising or adding/deducting from Base Bid work by Alternates.
- E. Unless otherwise specifically provided, the work described in Alternates shall be completed with no increase in Contract Time.
- F. The additional cost or credit for each Alternate shall represent the total adjustment to the contract sum associated with said Alternate.
- G. Refer to the Bid Proposal Form for information concerning order of acceptance of alternates.
- H. All labor, material, equipment, accessories, and incidental items required for a complete installation shall be included, whether or not specifically mentioned as part of the Alternate. Contractor shall perform necessary modifications or adjustments to affected adjacent work, whether new or existing, in order to fully and properly integrate the Alternate work into the Project. These necessary modifications and adjustments shall be included in the Alternate

1.01 QUALITY ASSURANCE

- A. The Base Bid specifications shall govern work of Alternates unless otherwise noted.

1.02 GENERAL REQUIREMENTS FOR ALTERNATES

- A. Coordination:
1. Determine the full effect on the Work of implementing each Alternate, including coordination, modification or adjustment of portions of the Work. Contract Amount included on the Bid Form for each Alternate includes the cost for all work required to incorporate the Alternate.
 2. To enable University to compare total costs where alternative materials and methods might be used or where scope of Work might be altered, Bid Alternate Work items have been established as described in this Section.
 3. Unless otherwise noted, Alternates will be accepted in the order listed until the Construction Budget is reached.
- A. Contract Amount included in Base Bid and as stated in executed Agreement shall include all costs for Work described in Contract Documents.
- C. Bid Proposal Form or other means prescribed for submission of proposed cost of Work shall include line items for each Alternate described in this Section. No Alternates other than as described in this Section shall be submitted, except in accordance with product options and substitutions provisions specified in Section 01 25 00, Substitutions.
- D. Each Alternative is identified herein by number. This identification shall be used whenever referring to Work described in Alternate and when submitting cost proposals and payment requests.
- E. Alternative construction described in Alternates and revised scopes of Work shall be performed only when such Alternate is made a part of the Work by specific provision in the University-Contractor Agreement, if selected by University prior to execution of the Agreement, or by Change Order or Change Directive if selected subsequent to execution of the Agreement.
- F. Costs for Alternates shall be valid for no less than 120 calendar days from date of Notice to Proceed and University may select any or all Alternates during that time. Once an Alternate is selected and the Contract modified for Work as described in the Alternate, changes to return to original scope of Work will be made only by Change Order or Change Directive in accordance with provisions of the Contract General Conditions for changes.

PART 2 - PRODUCTS AND EXECUTION

2.01

- A. If University elects to proceed on the basis of one or more of the described Alternates, Contractor shall make all modifications to Work as required to provide products complete, in place and fully functional, including all labor, equipment, services and incidental consumables necessary to apply, install and finish Work described in Alternate in accordance with requirements specified in related product

Sections of these Specifications.

- B. Cost for Alternates shall be complete and include all net increases and decreases in Contract Amount for Work described in Alternate and for all changes in related Work. No claims for additional costs to University will be honored other than as stated in cost proposal for each Alternate.

2.02 SCHEDULE OF ALTERNATES

- A. Additive Alternate Bid No. 1 – Fire Lane Extension.
 - 1. Base Bid condition: 190' of fire lane running east-west south of the building.
 - 2. Alternate Bid condition: extend fire lane an additional 112' to the east.
 - 3. Location in contract documents: Sheet C3.1.
- B. Additive Alternate Bid No. 2 – 77 SF of Dichroic Glazing Panels at Truss of North Roof Monitor.
 - 1. Base Bid condition: area without glazing infill.
 - 2. Alternate Bid condition: infill at each exposed truss with dichroic glazing of north roof monitor
 - 3. Location in contract documents: Spec Section 08 80 00 and Sheet 2/A3.11, A6.01, and 7/9.41.
- C. Deductive Alternate Bid No. 1 – Alternative Fence Construction
 - 1. Base Bid condition: Custom tube steel fence system and gates at all yards.
 - 2. Alternate Bid condition: prefabricated steel fence shown on callout #17 on Sheets L1.1 and L1.2.
 - 3. Location in contract documents: Sheets L1.1 and L1.2.
- D. Deductive Alternate Bid No. 2 – Wood Ceiling
 - 1. Base Bid condition: Eomac Veneered Plank Wood ceiling.
 - 2. Alternate Bid condition: Armstrong Wood Works Grille Tegular 663008 2x4 for 9/16" tegular, light cherry.
 - 3. Location in contract documents: Spec Section 09 54 29.

END OF SECTION 01 23 00

SECTION 23 21 13 - HYDRONIC PIPING

PART 1 - GENERAL

1.1 RELATED DOCUMENTS

- A. The requirements of the GENERAL CONDITIONS, SUPPLEMENTAL CONDITIONS, and DIVISION 1, GENERAL REQUIREMENTS, apply to the work of this SECTION.

1.2 SUMMARY

- A. Section Includes:
 - 1. Piping
 - 2. Special Duty Valves
 - 3. Hydronic Specialties for chilled water
 - 4. Hydronic Specialties for hot water
 - 5. Condensate drain piping
 - 6. Plastic pipe and fittings.
 - 7. Insulation

1.3 ACTION SUBMITTALS

- A. Product Data: For the following:
 - 1. For each type of special-duty valve indicated. Include flow and pressure drop curves based on manufacturer's testing for diverting fittings, calibrated balancing valves, and automatic flow-control valves
 - 2. Pipe insulation
 - 3. Pre-insulated piping
 - 4. Hydronic piping
 - 5. Substitutions acceptable.

1.4 INFORMATIONAL SUBMITTALS

- A. Profile Drawings: Show system piping in elevation. Show types, sizes, materials, and elevations of other utilities crossing hydronic piping.
- B. Qualification Data: For qualified Installer.
- C. Maintenance Data: For hydronic specialties and special-duty valves to include in maintenance manuals specified in Division 1.

1.5 QUALITY ASSURANCE

- A. Fusion piping: Certify that each installer has been trained by the manufacturer's representative for fusion piping installation.

- B. Welding: Qualify processes and operators according to the ASME Boiler and Pressure Vessel Code: Section IX, "Welding and Brazing Qualifications."
- C. ASME Compliance: Comply with ASME B31.9, "Building Services Piping," for materials, products, and installation. Safety valves and pressure vessels shall bear the appropriate ASME label. Fabricate and stamp air separators and expansion tanks to comply with the ASME Boiler and Pressure Vessel Code, Section VIII, Division 1.

1.6 COORDINATION

- A. Coordinate layout and installation of hydronic piping and suspension system components with other construction, including light fixtures, HVAC equipment, fire suppression system components, and partition assemblies.
- B. Coordinate pipe sleeve installations for foundation wall penetrations.
- C. Coordinate piping installation with roof curbs, equipment supports, and roof penetrations.
- D. Coordinate pipe fitting pressure classes with products specified in related Sections.
- E. Coordinate size and location of concrete bases.
- F. Coordinate installation of pipe sleeves for penetrations through exterior walls and floor assemblies.

PART 2 - PRODUCTS

2.1 MANUFACTURERS

- A. Available Manufacturers: Subject to compliance with requirements, manufacturers offering products that may be incorporated into the Work include, but are not limited to, the following:
 - 1. Calibrated Balancing Valves:
 - a. Armstrong Pumps, Inc.
 - b. Flow Design, Inc.
 - c. Nexus.
 - d. Griswold Controls.
 - e. ITT Bell & Gossett; ITT Fluid Technology Corp.
 - f. Taco, Inc.
 - g. Or equal.
 - 2. Pressure-Reducing Valves:
 - a. Amtrol, Inc.
 - b. Armstrong Pumps, Inc.
 - c. Conbraco Industries, Inc.
 - d. ITT Bell & Gossett; ITT Fluid Technology Corp.
 - e. Spence Engineering Company, Inc.
 - f. Watts Industries, Inc.; Watts Regulators.

- g. Or equal.
- 3. Safety Valves:
 - a. Amtrol, Inc.
 - b. Armstrong Pumps, Inc.
 - c. Conbraco Industries, Inc.
 - d. ITT McDonnell & Miller Div.; ITT Fluid Technology Corp.
 - e. Kunkle Valve Division.
 - f. Spence Engineering Company. Inc.
 - g. Or equal.
- 4. Expansion Tanks:
 - a. Amtrol, Inc.
 - b. Armstrong Pumps, Inc.
 - c. ITT Bell & Gossett; ITT Fluid Technology Corp.
 - d. Taco, Inc.
 - e. Wessels & Elbi
 - f. Or equal.
- 5. Air Separators and Air Purgers:
 - a. Amtrol, Inc.
 - b. Armstrong Pumps, Inc.
 - c. ITT Bell & Gossett; ITT Fluid Technology Corp.
 - d. Taco, Inc.
 - e. Or equal.
- 6. Strainers
 - a. Keckley
 - b. Muller Brass Company
 - c. Or equal.

2.2 PIPING MATERIALS

A. COPPER TUBE AND FITTINGS

- 1. Drawn-Temper Copper Tubing: ASTM B 88, Type L.
- 2. Annealed-Temper Copper Tubing: ASTM B 88, Type K.
- 3. Wrought-Copper Fittings: ASME B16.22.
- 4. Wrought-Copper Unions: ASME B16.22.
- 5. Solder Filler Metals: ASTM B 32, 95-5 tin antimony.
- 6. Viega ProPress.

B. STEEL PIPE AND FITTINGS

- 1. Steel Pipe, NPS 2 and Smaller: ASTM A 53, grade B, Schedule 40, black steel, plain ends.
- 2. Steel Pipe, NPS 2-1/2 through NPS 12: ASTM A 53, grade B, Schedule 40, black steel, plain ends.
- 3. Cast-Iron Threaded Fittings: ASME B16.4; Classes 125 and 250.
- 4. Malleable-Iron Threaded Fittings: ASME B16.3; Classes 150 and 300.
- 5. Malleable-Iron Unions: ASME B16.39; Classes 150, 250, and 300.
- 6. Cast-Iron Pipe Flanges and Flanged Fittings: ASME B16.1; Classes 25, 125, and 250, raised ground face, and bolt holes spot faced.
- 7. Wrought-Steel Fittings: ASTM A 234/A 234M, wall thickness to match adjoining pipe.

8. Wrought Cast- and Forged-Steel Flanges and Flanged Fittings: ASME B16.5, including bolts, nuts, and gaskets of the following material group, end connections, and facings:
 - a. Material Group: 1.1.
 - b. End Connections: Butt welding.
 - c. Facings: Raised face.
9. Welding Materials: Comply with Section II, Part C. of the ASME Boiler and Pressure Vessel Code for welding materials appropriate for wall thickness and for chemical analysis of pipe being welded.
10. Gasket Material: Thickness, material, and type suitable for fluid to be handled; and design temperatures and pressures.

C. POLYPROPYLENE (PP-R) PIPE AND FITTINGS FOR WATER DISTRIBUTION AND WATER SERVICE

1. Pipe shall be manufactured from a PP-R resin (Fusiolen) meeting the short-term properties and long-term strength requirements of ASTM F 2389. The pipe shall contain no rework or recycled materials except that generated in the manufacturer's own plant from resin of the same specification from the same raw material. All pipe shall be made in an extrusion process. Domestic hot water shall contain a fiber layer (faser) to restrict thermal expansion. All pipe shall comply with the rated pressure requirements of ASTM F 2389. All pipe shall be certified by NSF International as complying with NSF 14, NSF 61, and ASTM F 2389 or CSA B137.11.
2. Pipe shall be Aquatherm® Blue Pipe® MF® available from Aquatherm or equal manufacturer.
3. Fittings shall be manufactured from a PP-R resin (Fusiolen) meeting the short-term properties and long-term strength requirements of ASTM F 2389. The fittings shall contain no rework or recycled materials except that generated in the manufacturer's own plant from resin of the same specification from the same raw material. All fittings shall be certified by NSF International as complying with NSF 14, NSF 61, and ASTM F 2389 or CSA B137.11.
4. Polypropylene Fittings: socket fusion, butt fusion, electrofusion, or fusion outlet fittings shall be used for fusion weld joints between pipe and fittings.
5. Mechanical fittings and transition fittings shall be used where transitions are made to other piping materials or to valves and appurtenances.
6. Polypropylene pipe shall not be threaded. Threaded transition fittings per ASTM F 2389 shall be used where a threaded connection is required.
7. Polypropylene pipe used for hot water distribution shall include a fiberglass-reinforced layer to reduce thermal expansion/contraction.
8. Plastic, Pipe-Flange Gasket, Bolts, and Nuts: Type and material recommended by piping system manufacturer unless otherwise indicated.
9. Plastic-to-Metal Transition Fittings shall be the following:
 - a. PP-R one-piece fitting with threaded stainless steel, brass, or copper insert and one PP-R fusion weld joint end.

2.3 VALVES

- A. Gate, globe, check, ball, and butterfly valves are specified in Section 23 0523 "General- duty Valves for HVAC Piping."

- B. Refer to Part 3 "Valve Applications" Article for applications of each valve.
- C. Calibrated Balancing valves, N PS 2 and Smaller: Bronze body, ball type, 125-psig working pressure, 250 deg F maximum operating temperature, and having threaded ends. Valves shall have calibrated orifice or venturi, connections for portable differential pressure meter with integral seals, and be equipped with a memory stop to retain set position.
- D. Calibrated Balancing Valves, NPS 2-1/2 and Larger: Cast-iron or steel body, ball type, 125- psig working pressure, 250 deg F maximum operating temperature, and having flanged connections. Valves shall have calibrated orifice or venturi, connections for portable differential pressure meter with integral seals, and be equipped with a memory stop to retain set position.
- E. Pressure-Reducing Valves: Diaphragm-operated, bronze or brass body with low inlet pressure check valve, inlet strainer removable without system shutdown, and noncorrosive valve seat and stem. Select valve size, capacity, and operating pressure to suit system. Valve shall be factory set at operating pressure and have capability for field adjustment.
- F. Safety Valves: Diaphragm-operated, bronze or brass body with brass and rubber, wetted, internal working parts shall suit system pressure and heat capacity and shall comply with the ASME Boiler and Pressure Vessel Code, Section IV.

2.4 HYDRONIC SPECIALTIES

- A. Manual Air Vent: 1-piece 1/4 turn ball valve with 1/2" threaded connections.
- B. Automatic Air Vent: Designed to vent automatically with float principle, bronze body and nonferrous internal parts, 150-psig working pressure, 240 deg F operating temperature with NPS 1/4 discharge connection and NPS 1/2 inlet connection.
- C. Expansion Tanks: Welded carbon steel, rated for 125-psig working pressure and 240 deg F maximum operating temperature. Separate air charge from system water to maintain design expansion capacity by a flexible bladder securely sealed into tank. Include drain fitting and taps for pressure gage and air-charging fitting. Support vertical tanks with steel legs or base; support horizontal tanks with steel saddles. Factory fabricate and test tank
- D. with taps and supports installed and labeled according to the ASME Boiler and Pressure Vessel Code, Section VIII, Division 1.
- E. Air Purgers: Cast-Iron body with internal baffles that slow the water velocity to separate the air from solution and divert it to the vent for quick removal; Maximum working pressure of 150 psig and temperature of 250 deg F.
- F. Bypass Chemical Feeder: Welded steel construction, 125-psig working pressure, 2 gallon capacity, with inlet, outlet, and drain valves.

- G. Chemicals: Specially formulated, based on analysis of makeup water, to prevent accumulation of scale and corrosion in piping and connected equipment.
- H. Strainers shall be Keckley, Mueller Brass Company, Or equal, installed where shown on drawings or as required by the specifications.
- I. Strainers 2 inches and smaller shall be a wye-type, basket strainer. With 1/16- iinch mesh. Provide bronze body with soldered or threaded connections as required.
- J. Strainers 2-1/2-inch and larger shall be wye-type basket strainer with cast iron body, and type 304 stainless steel cylindrical removable baskets with 1/1-inch diameter perforations. Provide with grooved or flanged connections.

2.5 INSULATION

- A. Underground Piping
 - 1. Spray-on Pipe Insulation
 - a. Insulation shall be polyurethane foam or polyisocyanurate foam spray applied to the surface of the pipe with a minimum thickness of one inch. Insulation shall be rigid when dried, 90-95% closed cell polyurethane or polyisocyanurate with a 2.0 to 3.0 pounds per cubic foot density and coefficient of thermal conductivity (K- Factor) of 0.16 and shall conform to ASTM C-591.
 - 2. Pre- or post-insulated Pipe
 - a. Pre-insulated pipe shall be a complete system of factory pre-insulated polypropylene piping for the specified service.
 - b. Carrier pipe shall be polypropylene PP-R by Aquatherm, conforming to ASTM F-2389 as previously specified herein.
 - c. Insulation shall be polyurethane foam with a minimum thickness per material specifications on plans. Insulation shall be rigid, 90-95% closed cell polyurethane with a 2.0 to 3.0 pounds per cubic foot density and coefficient of thermal conductivity (K- Factor) of 0.16 and shall conform to ASTM C-591.
 - d. Manufacturers: Subject to compliance with requirements,
 - i. Aquatherm TI Pipe
 - ii. Thermacor Process, L.P..
 - iii. Or equal.
 - 3. Jacketing
 - a. Jacketing material shall be high density polyethylene (HDPE) or polyvinyl chloride (PVC), having a minimum wall thickness of 60 mils. Seams to be sealed with pressure sensitive wrap, 30 mils thick.
- B. Above Ground Piping
 - 1. General:

- a. All insulation material shall have a mold, humidity, and erosion resistant face that has met the requirements of the latest CMC.
- b. Insulation applied to the exterior surface of pipes located in buildings shall have a flame spread of no more than 25 and a smoke developed rating of not more than 50.
- 2. Rigid Molded Sectional Indoor/Concealed Jacket
 - a. Molded sectional, factory fabricated of heavy density resin bonded fibrous glass, with integral factory applied all service jacket of Kraft paper/aluminum foil & glass fiber reinforcement.
 - b. Insulation shall have a thermal conductivity k factor of 0.23 at 75 degrees Fahrenheit mean temperature and be suitable for direct application and service on piping having operating surface temperatures of minus 60 degrees to 450 degrees Fahrenheit.
 - c. Jacket shall:
 - 1) Extend 1 1/2 inches (minimum) along one edge of longitudinal joint to form a sealing lap which shall be faced inside with a paper protected pressure sensitive adhesive.
 - 2) Have a permanence rating of 0.02 perm per inch and a Beach puncture resistance of 50 units
 - d. Have an exterior suitable for painting with latex or water base paint.
 - e. All insulation shall have composite (insulation, jacket, tape seal and adhesive used to adhere jacket to the insulation) Fire and Smoke Hazard ratings as tested under procedure ASTM E-84, NFPA 255 and UL 723, not exceeding Flame Spread of 25 and a Smoke Developed of 50. PVC fitting covers and accessories, such as adhesives, mastics, cements and cloth for fittings shall have the same component ratings.
 - f. Paper laminate jackets shall be permanently flame and smoke resistant. Chemicals used for treating paper in jacket laminates shall not be water soluble and shall be unaffected by water and humidity.
 - g. Fiberglass Schuler Manville Micro Lok, or equal.
 - h. Irregular shape (fittings, flanges, valves, etc.):
 - 1) Fibrous glass of same density, thickness, and other properties or characteristics as the adjacent regular shape insulation either pre-molded or field forged to fit the item being insulated. The pre-molded insulation shall be provided with weather protection cover.
- 3. Rigid Molded Sectional Outdoor Jacket
 - a. Molded sectional, factory fabricated of heavy density resin bonded fibrous glass, with integral factory applied all service jacket of Kraft paper and aluminum foil and glass fiber reinforcement.
 - b. Insulation shall have a thermal conductivity k factor of 0.23 at 75 degrees Fahrenheit mean temperature and be suitable for direct application and service on piping having operating surface temperatures of minus 60 degrees to 450 degrees Fahrenheit.
 - c. Jacket:
 - 1) Straight runs: .016-inches thick smooth sheet aluminum finish.
 - d. Irregular shapes:
 - 1) Surefit Aluminum Pipe Fitting Covers for pipes up to 6-inches.
 - 2) Mitered aluminum sheet matching straight run jacketing for pipes over 6-inches.
 - 3) Alternative jacketing: Schuler Manville Type ML, metal jacketing system.

- e. All insulation shall have composite (insulation, jacket, tape seal and adhesive used to adhere jacket to the insulation) Fire and Smoke Hazard ratings as tested under procedure ASTM E-84, NFPA 255 and UL 723, not exceeding Flame Spread of 25 and a Smoke Developed of 50. PVC fitting covers and accessories, such as adhesives, mastics, cements and cloth for fittings shall have the same component ratings.
- f. Paper laminate jackets shall be permanently flame and smoke resistant. Chemicals used for treating paper in jacket laminates shall not be water soluble and shall be unaffected by water and humidity. Fiberglass Schuler Manville Micro Lok, or equal.

PART 3 - EXECUTION

3.1 EARTHWORK

- A. See Section 31 21 16 "Trenching" for excavating, trenching, and backfilling.

3.2 PIPING INSTALLATION

A. Underground Piping

1. Drawing plans, schematics, and diagrams indicate general location and arrangement of piping systems. Indicate piping locations and arrangements if such were used to size pipe and calculate friction loss, expansion, pump sizing, and other design considerations. Install piping as indicated unless deviations to layout are approved on Coordination Drawings.
2. Installers shall be trained and certified to install the pipe per the manufacturer's guidelines. Contact your local Aquatherm representative for training.
3. Remove standing water in the bottom of trench.
4. Do not backfill piping trench until field quality-control testing has been completed and results approved.
5. Install piping at minimum uniform grade of 0.2 percent. Install manual air vents at high points with concrete yard boxes.
6. Install components with pressure rating equal to or greater than system operating pressure.
7. Install piping free of sags and bends.
8. Install fittings for changes in direction and branch connections.
9. Thrust blocks shall not be required with PP-R piping.
10. Expansion loops shall not be required for direct buried underground PP-R piping.

B. Above Ground Piping

1. Install groups of pipes parallel to each other, spaced to permit applying insulation and servicing of valves.
2. Install drains, consisting of a tee fitting, NPS 3/4 ball valve, and short NPS 3/4 threaded nipple with cap, at low points in piping system mains and elsewhere as required for system drainage.
3. Reduce pipe sizes using reducer fitting.
4. Unless otherwise indicated, install branch connections to mains using tee fittings or mechanical formed tees in main pipe.

5. Install piping free of sags and bends.
6. Install fittings for changes in direction and branch connections.

3.3 HANGERS AND SUPPORTS

- A. Hanger, support, and anchor devices are specified in Section 23 05 29 "Hangers and Supports for HVAC Piping and Equipment." Comply with requirements below for maximum spacing of supports. Add additional hangers as required to comply with California Building Codes and as directed by the Authority having jurisdiction.
- B. Support vertical runs at roof, at each floor.

3.4 PIPE JOINT CONSTRUCTION

- A. Refer to Section 22 05 00 "Basic Mechanical Materials and Methods" for joint construction requirements for soldered and brazed joints in copper tubing; grooved, threaded, welded and flanged joints in steel piping.
- B. Fusion Piping
 1. Ream ends of pipes and tubes and remove burrs.
 2. Remove scale, slag, dirt, and debris from inside and outside of pipe and fittings before assembly.
 3. Fusion Joints: Fusion join polypropylene pipe in accordance with ASTM D2657, ASTM F 2389, and the manufacturer's instructions.
 4. Flanged Joints: Select appropriate gasket material, size, type, and thickness for service application. Install gasket concentrically positioned. Use suitable lubricants on bolt threads.
 5. Insulation joints made for pre-insulated pipe shall be done in accordance with the insulation manufacturer's instructions.

3.5 HYDRONIC SPECIALTIES INSTALLATION

- A. Install manual air vents at high points in piping, at heat-transfer coils, and elsewhere as required for system air venting.
- B. Install automatic air vents in mechanical equipment rooms only at high points of system piping, and elsewhere as required for system air venting.
- C. Install air separator or air scoop in closed hydronic systems where indicated on the drawings.
- D. Install bypass chemical feeders in each hydronic system where indicated, in upright position. Install feeder in bypass line, off main, using ball valves on each side of feeder and in the main between bypass connections. Pipe drain with ball valve.
- E. Install expansion tanks where indicated. Vent and purge air from hydronic system and ensure tank is properly charged with air to suit system design requirements.

3.6 TERMINAL EQUIPMENT CONNECTIONS

- A. Size for supply and return piping connections shall be same as for equipment connections.
- B. Install control valves in accessible locations close to connected equipment.
- C. Install ports for pressure and temperature gages at coil inlet connections.

3.7 FIELD APPLIED THERMAL INSULATION INSTALLATION

- A. Do not disturb the bottom of trench; otherwise, compact and stabilize it to ensure proper support.
- B. Remove standing water in the bottom of trench.
- C. Bed the pipe on a minimum 6-inch layer of granular fill material (sand) with a minimum 6-inch clearance between the pipes.
- D. Insulation and jacketing shall be applied to the piping in 10' segments (maximum)
- E. After completion, the segments are rotated 180o and the bottom of the jacketing and butt strips are inspected. Any defects or damage shall be replaced with new insulation.
- F. Jacketing and insulations joints shall be staggered.
- G. In larger diameter piping shorter segments can be insulated and jacketed if more practical.
- H. Where conditions permit, insulation and jacketing may be applied outside of the trench to sections of piping. Pipe lengths should be insulated in segments. Length of insulation segment should not exceed 10' (3 m).
- I. Backfill per manufacturer's instructions.

3.8 IDENTIFICATION

- A. Refer to Section 22 05 00 "Basic Mechanical Materials and Methods"
- B. Install continuous metallic/plastic underground warning tapes during back filling of trenches for underground hydronic piping. Locate tapes 6 to 8 inches below finished grade, directly over piping. Alternatively install 8 – 10 gage copper wire at 6" – 8" directly over the pipeline. Provide warning tapes above the wire at 6" to 8" below the finished grade directly over the pipeline.

3.9 FIELD QUALITY CONTROL

- A. Use ambient temperature water as a testing medium unless there is risk of damage due to freezing, another liquid that is safe for workers and compatible with piping may be used.
- B. While filling system, use vents installed at high points of system to release trapped air. Use drains installed at low points for complete draining of liquid.
- C. Check expansion tanks to determine that they are not air bound and that system is full of water.
- D. Subject piping system to hydrostatic test pressure that is not less than 1.5 times the design pressure. Test pressure shall not exceed maximum pressure for any vessel, pump, valve, or other component in system under test. Verify that stress due to pressure at bottom of vertical runs does not exceed either 90 percent of specified minimum yield strength or 1.7 times "SE" value in Appendix A of ASME B31.9, "Building Services Piping."
- E. After hydrostatic test pressure has been applied for at least 4 hours, examine piping, joints, and connections for leakage, eliminate leaks by tightening, repairing, or replacing components, and repeat hydrostatic test until there are no leaks.
- F. Prepare written report of testing.

3.10 ADJUSTING

- A. Mark calibrated nameplates of pump discharge valves after hydronic system balancing has been completed, to permanently indicate final balanced position.
- B. Perform these adjustments before operating the system:
 - 1. Open valves to fully open position. Close all bypass valves.
 - 2. Check pump for proper direction of rotation.
 - 3. Set automatic fill valves for required system pressure.
 - 4. Check air vents at high points of system and determine if all are installed and operating freely (automatic type), or bleed air completely (manual type).

END OF SECTION 23 21 13

SECTION 28 13 00 - ACCESS CONTROL – Net2 System

PART 1 GENERAL

1.1 SUMMARY

- A. Section includes
 - 1. Electronic Access Control
- B. Products
 - 1. An Access Control Unit (ACU), which shall interface with access point peripherals and identity gathering devices, providing logic and decision making to manage an access point.
 - 2. An Input/Output (I/O) Board, which shall contain input and output peripherals to monitor digital states and switch mains rated relays.
 - 3. A Power Supply Unit (PSU), which shall provide the power necessary to power the ACUs.
 - 4. A Desktop reader, which shall provide the method of enrolling proximity tokens to the system to be associated with users.
 - 5. Access Control Server software, which shall provide system engineers and administrators with a method of managing and configuring access control hardware and users, and providing real-time access control monitoring of the entire system, all within a single, easy to use, intuitive package. All hardware and user configuration and system events shall be stored on the computer running this software.
 - 6. Access Control Client software – This shall provide identical functionality and usability to the Access Control Server software. This software however shall not store any configuration or events, instead it shall be used as a portal to managing the access control system from multiple workstations.
- C. The products above shall form the fundamental part of an Access Control System (ACS), providing complete control and monitoring of access points at the installed site.
- D. Overall system capability
 - 1. The system shall monitor and control facility access via electronic access controllers utilising card readers and keypad devices. It shall be implemented through TCP/IP architecture using the electronic single door controller approach via PoE infrastructure.
 - 2. The system shall be capable of monitoring alarm points, controlling output devices, and managing lift control floors. The system shall maintain an audit trail of operator activity and all access control and alarm activity.
 - 3. The system shall be capable of starting with a single door, and expanding one door at a time, to up to a minimum of 1000 doors
 - 4. Each controller shall be able to manage the hardware necessary to secure one door. If entry and exit is required, only one controller shall be required. Each controller shall maintain a full database of information so that access decisions are made within a maximum of one quarter of a second in both online and offline states.
 - 5. The access controller units (ACU) shall be capable of DHCP or static IP addressing.
 - 6. The system shall allow unlimited workstations for programming and administration of the system including database management, report generation, and real-time monitoring of activity. No license keys or fees shall be required to install and operate the software on client workstations. A dedicated computer shall not be required (but shall be recommended) for large projects.
 - 7. The system shall support 500 input/output controllers for monitoring the condition of external devices such as alarm contacts, push buttons, photo sensors, and temperature points. The I/O controller shall be TCP/IP communications and shall be capable of DHCP or static IP addressing.
 - 8. The user shall be able to launch the time and attendance, online video tutorials, documentation and card badge designer from the access control GUI home page.
 - 9. The system shall support at minimum 50,000 unique credentials.
 - 10. The system shall be scalable, allowing for additional hardware from the same manufacturer.

- E. The ACS shall provide the following as a minimum:
1. Access Control
 2. CCTV Video Integration
 3. Time and Attendance
 4. Intruder Alarm Integration
 5. Open SDK for 3rd party application Integration
 6. Smart Phone application for system control and user administration
 7. Graphical Maps
 8. Lift Control
 9. Email/SMS Notifications
 10. Emergency Lockdown
 11. Mustering
 12. Energy Management
 13. Card Designer
 14. Credential enrolment reader
 15. Automatic User Image Display at PC on card use
 16. Secondary door unlock control from fire alarm input
 17. Various card reader technologies including clock & data, Wiegand and GSM
 18. License free software and lifetime updates at no charge
 19. Intercom / Video Entry Station
 20. Wireless door locks

1.2 DEFINITIONS

- A. Access Control System (ACS): The entire system as a whole, made up of hardware to control the relevant access points and appliances, readers to identify users, software/hardware to determine access control, and all firmware and additional hardware installed as part of the access control solution.
- B. Access Control Unit (ACU): An intelligent peripheral control unit that provides the interface between the Management and Monitoring Subsystem and the devices installed at the access portal for the purpose of restricting access and monitoring the portal status.
- C. AWG (American Wire Gauge): A unit of measurement for the diameter of wires.
- D. Client: A PC that can view and manage the system database.
- E. DHCP: Dynamic Host Configuration Protocol
- F. EMC: Electromagnetic Compatibility.
- G. Entry system (audio/video entry system): A system, either stand alone or integrated, comprised of Panels and Monitors to authorise access via video and audio communication.
- H. GSM (Global System for Mobile Communications): The standard to describe the protocols commonly used in mobile communications.
- I. I/O: Input / Output, relating to peripherals where an input is used to monitor the high/low state of a signal, and an output consists of a relay capable of switching a device on/off.
- J. IP: Internet Protocol incorporated into Microsoft Windows.
- K. LAN: Local area network.
- L. Mbps: Megabits per second
- M. Monitor: A piece of hardware that allows an occupant to validate entry to an unknown user via a location on the network.
- N. Multicast: Communication where information is addressed to multiple recipients simultaneously.
- O. Occupant/Resident: The user of a Monitor or the user of a reader.
- P. Open air: Without obstruction or interference.

- Q. Panel: A piece of hardware used to determine whether a known user is allowed access, and as a method of communication for unknown users to contact a buildings occupants.
- R. PC: Personal computer, used as the Central Station, workstations, and file servers.
- S. PoE: Power over Ethernet.
- T. Reader: A proximity reader or biometric reader that captures credential information.
- U. RS-485: A TIA/EIA standard for multipoint communications.
- V. Server: A PC that contains the database of users and access control settings, which runs the access control software.
- W. SIP: Session Initiation Protocol.
- X. TCP: Transport Control Protocol incorporated into Microsoft Windows.
- Y. Token: The credential issued to a person. This can be a PIN or a device containing an encoded number, used to determine if access will be granted or denied.
- Z. Triggers and Actions: A software component which provides the ability to create rules to perform custom/bespoke functionality.
- AA. UDP: User Datagram Protocol incorporated into Microsoft Windows.
- BB. Unicast: Communication where information is addressed to a single recipient.
- CC. UPS: Uninterruptible power supply.
- DD. USB: Universal Serial Bus.
- EE. Visitor: The user of a Panel.
- FF. WAN: Wide area network.
- GG. Wiegand: Patented magnetic principle that uses specially treated wires embedded in the credential card. Also known as reader data output format and Wiegand signal.
- HH. Windows: Operating system by Microsoft Corporation.
- II. Workstation: A PC with software that is configured for specific limited security system functions.

1.3 SYSTEM DESCRIPTION

A. General

1. The ACS shall control the movement of users through access points.
2. Users shall be identified and processed through any of these means:
 - a. Presenting a token to a reader.
 - b. Entering a unique PIN to a keypad
 - c. Recognition of a unique physical property at a biometric reader.
 - d. Phone number via GSM Access reader
 - e. Visual and/or audio confirmation from an occupant of the premises
 - f. Combination of the above
3. The system shall not require facility codes for card credentials. Each token/credential shall have a unique 40 bit encryption for high security.
4. The system shall provide for unique card serial numbers, so the user will not need to determine the next sequence of cards to purchase.
5. A PC shall be used to administer the access control system.
 - a. The access control software shall have a Client/Server structure to facilitate operation on multiple PCs.
 - b. A password shall be required to login and shall limit the activities an operator is permitted to perform.
6. A mobile application will be available for system control and user administration.
 - a. The mobile application will be available for Android and iOS devices.

1. Hardware shall consist of:
 - a. Access Control Units
 - b. I/O Boards
 - c. Proximity readers
 - d. Desktop readers
 - e. Power Supply Units
2. All hardware peripherals shall be clearly labelled and identified for ease of installation.

C. Software

1. The system database containing all hardware and user information shall be held at the PC running the Server software.
2. The software shall feature:
 - a. Multi-user and multi-tasking to allow for independent activities and monitoring occurring simultaneously at different workstations.
 - b. A graphical user interface to show pull-down menus and a menu tree format that complies with interface guidelines of Microsoft Windows operating system.
 - c. A mobile application for user administration, event reporting, door open and roll call.
3. System license shall be for the entire system and shall include capability for future additions that are within the indicated system size limits specified in this Section. There shall be no license fee or yearly renewal fees.
4. The system shall use open architecture that allows importing and exporting of data and interfacing with other systems that are compatible with Microsoft Windows operating system.
5. Access shall be restricted using password-protected operator login.

1.4 GENERAL REQUIREMENTS FOR SOFTWARE

- A. Two versions of the software shall be available from the manufacturer:
 1. A 'Lite' version of the software shall contain all of the standard access control features to manage access privileges and report on users. Other features include unlimited free client login, CCTV and basic intruder alarm integration and graphical maps – this version shall be available free of charge.
 2. A 'Pro' version of the software shall contain all of the features offered in the 'Lite' version, with the addition of more advanced functionality, including management features, fire alarm and multi-zone intruder alarm integration, security lockdown, and more – this version shall be available at an additional cost.
- B. Overall software capability
 1. The software shall allow the configuration and control of hardware controlling the operation of doors, turnstiles, and other controllable devices.
 2. The software shall monitor and report access control events of the entire ACS. It shall be possible to view these events at any number of workstations.
 3. The software shall be capable of supporting at minimum 50,000 unique credentials and be able to manage and report on at minimum 1,000 access points.
- C. The software shall provide the following as a minimum:
 1. Access Control
 2. CCTV Video Integration
 3. Biometric Integration
 4. Time and Attendance
 5. Intruder Alarm Integration
 6. Fire Alarm Integration
 7. Open SDK for HR Database Integration
 8. Graphical Maps
 9. Lift Control
 10. Email/SMS Notifications
 11. Emergency Lockdown

12. Roll Call and Mustering
 13. Energy Management
 14. Card Designer
 15. Automatic User Image Display at PC on card use
 16. Browser application for remote site management
 17. Triggers and actions to achieve custom/unique functionality
 18. Timesheet and timeline
 19. Anti-passback
 20. Customisable welcome page
 21. Landlord Tenant
 22. Support for various card reader technologies, including clock & data, Wiegand and GSM
 23. Support for Graphical Images on selected LCD Readers
 24. Support for a credential enrolment reader
 25. Android and iOS mobile application
- D. The Server and Client Graphical User Interface (GUI) shall be identical.
1. All configuration available at the Server shall be available at the Client.
- E. Operating system
1. The Server software at a minimum shall support the following operating systems:
 - a. Windows 10 Pro 64Bit
 - b. Windows 8 & Windows 8.1
 - c. Windows 7
 - d. Windows Vista
 - e. Windows Server 2008 & 2012
- F. Processor
1. A PC shall be able to run the Server software with the following, or greater, performance specifications:
 - a. Memory size: 4GB.
 - b. Hard disk free space: 20GB.
 - c. Display: 1024 x 768.
 - d. Interfaces: USB and Ethernet.
 - e. DVD-ROM drive.
 - f. Web browser: Internet Explorer 5 or later
 2. Number of PCs required:
 - a. One PC running the Server software shall be required per system.
 - b. There shall not be a limit to the number of PCs that can run the Client software. (Limits shall be placed based on the SQL licensing.)
 - c. There shall not be a limit to the number of mobile devices that can install and run the Android and iOS mobile application.

1.5 PERFORMANCE REQUIREMENTS

- A. The Server software shall create and maintain a single database for access-control and credential-creation functions.
- B. Any change made to the database shall automatically be communicated to all intelligent access control hardware:
1. When hardware is online, updates shall be communicated with appropriate changes taking immediate effect.
 2. When hardware is offline, updates shall be communicated when the hardware it is next online.
- C. Distributed Processing:
1. The system shall be a fully distributed processing system so that information (including time, date, valid codes, access levels, and similar data) is downloaded to Controllers in such manner access-control decisions for that location.

- 2. Intermediate Controllers shall be unacceptable for access control.
- 3. If communications to Central Station are lost, all Controllers shall automatically buffer event transactions until communications are restored, at which time buffered events shall be uploaded to the Central Station.
- D. System capacities:
 - 1. The system shall support at minimum:
 - a. 1,000 controlled access points.
 - b. 50,000 users, each with a unique credential.
 - c. 2,000 input devices.
 - d. 2,000 controllable appliances.
 - e. 10,000 individual access levels.
 - f. 64 time schedules and 512 segments per time zone.
- E. System Network Requirements
 - 1. Client PCs shall communicate with the Server PC via TCP/IP on a LAN/WAN:
 - a. System events recorded by the Server shall be communicated to Clients.
 - b. Changes made to the database at a Client shall be communicated to the Server.
 - 2. The Server PC shall communicate with access control hardware via TCP/IP on a LAN:
 - a. Access control events shall be communicated to the Server PC.
 - b. Changes to the database shall be communicated to the access control hardware.
 - 3. The system shall utilise standard networking protocols to allow installation on corporate infrastructure.
 - 4. No manual addressing shall be required.

1.6 QUALITY ASSURANCE

- ~~A. The software shall receive lifetime updates from the manufacturer free of charge.~~
- B. All equipment provided shall be covered by a manufacturer's warranty for a minimum of 5 years. The following aspects shall be covered:
 - 1. Electrical
 - 2. Electronic
 - 3. Component
 - 4. Mechanical
- C. All hardware provided shall receive firmware upgrades from the manufacturer free of charge.

1.7 COMPLIANCE

- A. The system shall comply with:
 - 1. The General Data Protection Regulation (GDPR) 2018
 - 2. EN60839-11-1 Grade 1
 - 3. EN60839-11-1 Grade 2
- B. Access Control Units shall comply with the following standards and directives:
 - 1. The Electro-Magnetic Compatibility (EMC) Directive
 - 2. The Restriction of Hazardous Substances (RoHS) Directive
 - 3. Part 15 of the FCC Rules
 - 4. UL 294 for Access Control
 - 5. CSA 22.2 No.205
 - 6. Innovation, Science and Economic Development (ISED) ICES-003
- C. I/O boards shall comply with the following standards and directives:
 - 1. The Low Voltage Directive (LVD)
 - 2. The Electro-Magnetic Compatibility (EMC) Directive
 - 3. The Restriction of Hazardous Substances (RoHS) Directive

4. Part 15 of the FCC Rules
 5. Innovation, Science and Economic Development (ISED) ICES-003
 6. IEC-60950-1 for Safety
- D. PSU's shall comply with the following standards and directives:
1. The Low Voltage Directive (LVD)
 2. The Electro-Magnetic Compatibility (EMC) Directive
 3. The Restriction of Hazardous Substances (RoHS) Directive
 4. Part 15 of the FCC Rules
 5. Innovation, Science and Economic Development (ISED) ICES-003
 6. IEC-60950-1 for Safety
- ~~E. Desktop readers shall comply with the following standards and directives:~~
- ~~1. The Low Voltage Directive (LVD)~~
 - ~~2. The Radio Equipment Directive (RED)~~
 - ~~3. The Restriction of Hazardous Substances (RoHS) Directive~~
 - ~~4. ISED licence-exempt RSS standard(s)~~
 - ~~5. Part 15 of the FCC Rules~~
 - ~~6. IEC-60950-1 for Safety~~

1.8 GENERAL REQUIREMENTS FOR COMMUNICATIONS

- A. ACU to Server
1. The ACU shall communicate with the Server using the TCP/IP LAN.
 - a. The ACU shall be addressable using:
 - (i) Static IP
 - (ii) DHCP
 - b. At minimum, 100 Mbps Ethernet network speed shall support
- B. ACU to ACU
1. It shall be possible to daisy chain ACUs using RS485 such that only one ACU shall require connection to the Server. The following cable shall be used:
 - a. Belden 8723
 - (i) 2 x twisted pairs
 - (ii) Maximum length 1000m (3000')
 - b. Technical equivalent CAT5, CAT5e or CAT6 cable
 2. Each RS485 data line shall support at minimum 200 ACUs.
- C. ACU to Reader
1. Readers shall communicate with an ACU over any of the following or technical equivalent cable:
 - a. Belden 9540
 - (i) 8 core screened cable.
 - (ii) 18 AWG
 - (iii) Maximum length 100m (328')
 - b. Belden 9538
 - (i) 8 core screened cable.
 - (ii) 22 AWG
 - (iii) Maximum length 25m (82')
 2. All surface mount readers shall be provided with 5m (16.4') Belden 9540 cable at no additional cost.
- D. No manual addressing shall be required.

PART 2 PRODUCTS

2.1 MANUFACTURERS

PERMIT SET - SFM
12.21.2021

- A. Acceptable manufacturer: Paxton per University's standard.
- B. The components of the ACS shall be available from a single source manufacturer to assure compatibility of products.
- C. Components shall consist of:
 - 1. Access Control Software. The manufacturer shall have in its employ the software engineering staff that write and manage the code for the ACS, and shall maintain all licensing required.
 - 2. Access Control Panels. The manufacturer of the ACS control panels shall be the same as software manufacturer. The access panel manufacturer shall have in its employ the engineering and manufacturing staff to produce the hardware and software for the control panels.
 - 3. Readers. The manufacturer of the access control readers shall be the same as the manufacturer of the access control software and control panels.
 - 4. Tokens/credentials. The manufacturer of the access control tokens shall be the same as the manufacturer of the access control readers.
 - 5. Power Supply Units (PSU), which shall provide a voltage appropriate for all access control hardware requiring external power.
- D. Substitution Limitations
 - 1. No substitutions.

2.2 SPECIFIC REQUIREMENTS FOR TOKENS

- A. The manufacturer of the ACS shall be able to supply Paxton HiTag2 125KHz tokens.
 - 1. The supplied tokens shall contain an authentication method to deter the copying and unauthorised use of tokens.

2.3 SPECIFIC REQUIREMENTS FOR ACCESS CONTROL UNITS

- A. Features
 - 1. The ACU shall store locally the system database for faster and offline lookup.
 - 2. The ACU shall be capable of making access control decisions.
 - 3. The ACU shall allow the control and monitoring of a single access point.
 - 4. The ACU shall be capable of supporting a combination of at least 4 of the following:
 - a. Proximity readers
 - b. Magstripe readers
 - c. Keypads
 - d. Combination reader/keypad.
 - 5. The ACU shall support up to 50,000 unique card ID's
 - 6. The ACU shall retain event data (at least 2,454 events per door) when there is no connection to the Server PC.
 - 7. The ACU shall be able to automatically unlock doors during specified time periods.
 - 8. All data shall be retained during a power loss.
 - 9. Where time and attendance is used, the ACU shall be configurable to support a Clock In reader and Clock Out reader on a single door controller.
 - 10. The ACU shall include support for tri-colour reader LED's control.
- B. User interaction
 - 1. Once installed, no further interaction with the hardware shall be required.
- C. Display
 - 1. The ACU shall have colour coding representation for reader, exit device, communications, and power connections to simplify installation, maintenance, and troubleshooting.
 - 2. The unit shall include installation LED's to indicate the output relay status, TCP/IP communications status, network server connected status, input status and end of line termination status.
- D. Communications
 - 1. The ACU shall include TCP/IP interface for network communications directly into the processing not approved.

2. In addition to TCP/IP, the ACU shall also include RS-485 communications for primary and/or secondary communications directly into the processing board.
 - a. The following data lines shall be supported:
 - (i) CAT5
 - (ii) CAT5e
 - (iii) CAT6
 - (iv) Belden 8723
 - b. The maximum cable length shall not exceed 1,000m (3,280').
3. It shall be possible to communicate with multiple ACU's over a single RS485 data line.
 - a. At minimum, 200 ACU's shall be supported per data line.
4. The ACU shall support the connection of readers:
 - a. The ACU shall support the following reader input technologies simultaneously:
 - (i) Clock & data
 - (ii) Wiegand.
 - b. The following cable types shall be supported:
 - (i) Belden 9540

E. Peripherals

1. The ACU shall provide at minimum the peripherals to support 2 readers or keypads.
 - a. The reader peripheral shall not be limited to a fixed data input, and instead shall accept data read from a variety of token types of different lengths, including but not limited to the following:
 - (i) PIN
 - (ii) Code
 - (iii) Token ID
 - b. The reader peripheral shall output current states relevant to the appliance to control for supplying feedback to the token holder in the form of an LED and speaker.
 - c. The reader peripheral shall provide the power that the reader requires to operate.
 - (i) The peripheral shall provide:
 1. A voltage of 12V DC
 - d. The ACU shall support an LCD graphics image reader capable of controlling four stages of image display including:
 - (i) Image 1 for idle reader state
 - (ii) Image 2 for access granted indication
 - (iii) Image 3 for access denied indication
 - (iv) Image 4 for personal identification code required indication
 - e. The ACU shall include an output for keypad readers that have a built in bell button that are used to activate an intercom, camera, or turn on siren/strobes.
 - f. It shall be possible to locate the reader at minimum 100m (328') from the door connector without communication becoming impaired.
 - g. The ACU shall automatically detect any readers/keypads.
2. The ACU shall house independent changeover relay channels.
 - a. The ACU shall provide at minimum 2 relays.
 - b. Each relay shall be provided with N.O. and N.C. contacts.
 - c. Relay contacts shall be voltage free.
 - d. Each relay shall be capable of switching a resistive load of at least 4A at 24V.
3. The ACU shall house a powered output for controlling locks.
 - a. The lock output shall provide at minimum 1A at 12V DC.
4. The ACU shall contain a tamper switch input.
 - a. The input shall be used to alert appropriate users in the case of unknown/impermissible access to the ACU.
5. The ACU shall contain a power supply unit (PSU) fail input.

- a. The input shall be used to alert appropriate users in the case of a door lock power supply failing.
- 6. The ACU shall contain a door contact input.
 - a. The input shall be used to monitor the state of the door.
- 7. The ACU shall contain an input for an exit button or break glass.
 - a. The input shall allow exit buttons, break glass, and any other push-to-make contacts to input to the ACS for the purpose of unlocking an access point.
 - b. It shall be possible to connect multiple exit buttons in series to a single ACU.
 - c. Exit buttons shall be available from the manufacturer of the door controller.
- 8. The ACU shall include connections for an external intrusion alarm panel.
 - a. As a minimum, the ACU shall have a designated relay output, alarm condition status, and arming contact.
- F. Power supply
 - 1. It shall be possible to power the ACU with either of the following:
 - a. A PoE / PoE+ Power Supply Unit (PSU)
 - b. A 12V, 2A Power Supply Unit (PSU)
 - 2. Maximum power usage shall not exceed 200mA at 24V DC.
- G. Temperature
 - 1. The ACU shall meet the required temperature standards for an internal product.
 - a. The ACU shall operate reliably within the temperature range of 0°C to 55°C (32°F to 131°F)
- H. Housing
 - 1. The ACU shall include removable connectors to provide ease of installation and board exchange if necessary. The connection points shall not require any special tools to terminate.

2.4 SPECIFIC REQUIREMENTS FOR I/O BOARD

- A. Features
 - 1. The ACS shall include support for input/output boards designed to monitor auxiliary inputs and provide relay outputs for control of external devices.
 - 2. The I/O board shall support a minimum of 4 inputs and 4 outputs.
 - 3. It shall be possible to use input states to trigger events in the ACS via Triggers and Actions.
 - 4. It shall be possible to control relay outputs via Triggers and Actions.
 - 5. Detachable terminals for quick and hassle free maintenance.
 - 6. Fault finding LEDs.
 - 7. Quick and intuitive installation.
- B. Power supply
 - 1. The I/O board shall be powered from a 12V, 2A Power Supply Unit (PSU)
 - 2. Power usage shall not exceed 400mA when all relays are energised.
- C. Display
 - 1. Peripherals shall be labelled clearly and intuitively.
 - 2. The item shall house LEDs for fault finding.
 - 3. An LED shall indicate when the item is powered.
- D. Communications
 - 1. The I/O board shall include TCP/IP interface for network communications directly into the processing board via an RJ45 connector. Add-on modules are not approved.
- E. Peripherals
 - 1. The I/O board shall house 4 independently controllable relays.
 - a. Each relay shall be provided with COM, N.O. and N.C. contacts.
 - b. Relay contacts shall be voltage free.
 - c. Each relay shall be capable of switching a resistive load of at least:

- (i) 13A @ 240V AC
- d. Each relay shall be capable of switching inductive loads.
- e. Each relay shall have a contact isolation of at least 4KV AC
- f. Each relay shall retain its state when the I/O connector losses power.
- g. The relay functionality shall be configurable in the access control software provided with the ACS.
- 2. The I/O board shall house 4 digital inputs.
 - a. Each input shall be formed of 2 terminals.
 - b. Each input shall be configurable to trigger a Trigger and Action rule to perform pre-defined tasks.
- F. Temperature
 - 1. The item shall operate reliably within the temperature range of -20°C to 55°C (-4°F to 131°F)
- G. Housing
 - 1. The I/O board shall include removable connectors to provide ease of installation and board exchange if necessary. The connection points shall not require any special tools to terminate.
 - 2. The I/O board shall be available in a selection of enclosures:
 - a. Plastic housing
 - (i) This shall be a plastic enclosure for the I/O board only.
 - (ii) The enclosure shall be wall mountable.
 - b. Plastic cabinet
 - (i) This shall be a plastic enclosure for the I/O board and a power supply.
 - (ii) The enclosure shall be wall mountable.
 - 3. The enclosures shall be available in white.
- H. Dimensions
 - 1. The dimensions of the I/O board shall not exceed:
 - a. A width of 114mm (4.5")
 - b. A height of 120mm (4.7")
 - c. A depth of 32mm (1.3")
 - 2. The dimensions of the plastic housing shall not exceed:
 - a. A width of 200mm (7.9")
 - b. A height of 200mm (7.9")
 - c. A depth of 78mm (3.1")
 - 3. The dimensions of the plastic cabinet shall not exceed:
 - a. A width of 236mm (9.3")
 - b. A height of 320mm (12.6")
 - c. A depth of 80mm (3.1")

2.5 SPECIFIC REQUIREMENTS FOR POWER SUPPLY UNIT (PSU)

- A. Features
 - 1. PSU voltage shall be correct for all ACS hardware requiring an external DC power source.
 - a. Output voltage shall be 12V DC (+/- 10%)
 - b. Output current ripple shall not exceed 100mV
 - 2. The PSU shall be capable of providing at minimum 2A.
 - 3. The PSU shall be capable of powering at least 3 individual devices at 12V each.
 - 4. Maximum cable length shall be at least 2m (6.6').
 - 5. The PSU shall allow connection to a 12V / 7Ah backup battery.
 - a. The PSU shall trickle charge the connected battery to keep it continuously charged at maximum capacity.
- B. Power supply
 - 1. The PSU shall operate from Mains supply, supporting the following:

- a. 100V to 240V
- b. 50 to 60 Hz AC
- C. Display
 - 1. Peripherals shall be labelled clearly and intuitively.
 - 2. An LED shall indicate when the item is powered by Mains supply.
 - a. This LED shall be green to indicate that the item is working correctly.
 - 3. An LED shall indicate when the item is powered by battery backup.
 - a. This LED shall be red to indicate that the supply has failed.
- D. Peripherals
 - 1. The PSU shall house 3 independent 12V connections.
 - 2. The PSU shall house a power supply fail output.
 - a. This shall be a pair of voltage free contacts that shall go open circuit is the mains power fails.
- E. Temperature
 - 1. The item shall operate reliably within the temperature range of -20°C to 44°C (-4°F to 111.2°F)
- F. Housing
 - 1. The PSU shall be available in a selection of enclosures:
 - a. Plastic cabinet
 - (i) This shall be a plastic enclosure for the PSU, an ACU and a backup battery.
 - (ii) The enclosure shall be wall mountable.
 - b. Metal cabinet
 - (i) This shall be a metal enclosure for the PSU, an ACU and a backup battery.
 - (ii) The enclosure shall be wall mountable.
 - 2. The enclosures shall be available in white.
- G. Dimensions
 - 1. The dimensions of the PSU shall not exceed:
 - a. A width of 58mm (2.3")
 - b. A height of 167mm (6.6")
 - c. A depth of 54mm (2.1")
 - 2. The dimensions of the plastic cabinet shall not exceed:
 - a. A width of 236mm (9.3")
 - b. A height of 320mm (12.6")
 - c. A depth of 80mm (3.1")
 - 3. The dimensions of the metal cabinet shall not exceed:
 - a. A width of 232mm (9.1")
 - b. A height of 320mm (12.6")
 - c. A depth of 80mm (3.1")

2.6 CABINET

- A. Manufacturer:
 - 1. LifeSafety Power #FPO250-4D8E8P per University's standard.
- B. The ACUs, I/O modules, and power supplies shall reside in a unified cabinet
- C. The cabinet is a dual voltage, offline switchmode power supply-battery charger system specifically designed for the access control segment of the lifesafety industry.
- D. The unit is configured in a painted, steel, locking enclosure with tamper switch and integral battery space, and provides two power supplies, each of which can be set to 12 or 24V.
- E. Eight auxiliary outputs are provided for readers, REX devices, or other similar units with each output selectable for either power supply.

- F. Eight access controlled trigger inputs control eight relay based lock outputs, with each output selectable for either power supply, and programmable for fire alarm disconnect, failsafe, failsecure, or dry contact operation.
- G. Complete fault detection and reporting, with programmable fault delays, is provided along with datalogging capability of fault occurrence, battery usage time and power supply status.

2.7 READERS

- 1. Mullion mounted readers shall be a HID iCLASS SE R10.
- 2. Wall box readers shall be a HID pivCLASS R40.

2.8 GENERAL REQUIREMENTS FOR APPLICATION SOFTWARE

- A. The software shall use a familiar style user interface, enabling intuitive use.
- B. The software shall be available in various languages to suit the installation and operator. Languages required at no additional cost include:
 - 1. English
 - 2. US English
 - 3. Dutch
 - 4. German
 - 5. Spanish
 - 6. Latin American Spanish
 - 7. French
 - 8. Japanese
 - 9. Danish
 - 10. Swedish
 - 11. Portuguese
 - 12. Greek
 - 13. Norwegian
 - 14. Czech
 - 15. Hungarian
- C. A SQL server database shall be used for the storage of user data and events.
- D. The software shall be capable of importing and exporting all user data in .vcf, .csv and .txt formats.
- E. The software shall be structured to support multiple workstations without extra license charges being levied.
- F. Access permissions:
 - 1. Access levels shall be used to administer the control of who is permitted through which access points and what times they are allowed through, on a minute by minute basis.
 - 2. A minimum of 256 unique access levels shall be supported, allowing for 10,000 individual permissions.
 - 3. The system shall be able to give alternative access permissions to some or all staff, to accommodate flexible scheduling and holidays.
- G. Reporting
 - 1. User and system events shall be shown in real-time.
 - 2. Reporting shall offer filtering options to allow for selection of all events, access events, alarm events and system events. Such event filtering and selection shall be customisable by time periods.
 - 3. Reports shall be customisable. They shall allow for selection of date, time, users or user groups and access points.
 - 4. Reports shall be configured within the access control user software and not a third-party application. A simple wizard shall be used to make configuring and saving reports as simple as possible for the user.
- H. Users

1. The system shall be capable of supporting 50,000 unique token holder records.
 2. The system shall be capable of supporting a minimum of 27 active tokens/credentials per user.
 3. Tokens/credentials shall be able to be designated as lost and, if used, shall create a special event message.
 4. The system shall be capable of setting a valid date range for each user. Outside of this date range any credentials for that user shall be recognised as invalid.
 5. The system shall have a minimum of 16 definable user fields that can be tailored by the system administrator to store specific information.
- I. The system shall allow users to be grouped into departments with validity dates and card templates. Departments shall be selectable when generating event reports and setting access permissions.
- J. Operators
1. Any user may be given operator rights that allow them to log onto the software and administer the system.
 2. A minimum of 50 operators shall be supported.
 3. The system shall allow the restriction of operator privileges from certain areas of the software.
 4. A user shall require operator rights to login to the Android and iOS mobile applications.
- K. Access control alarms
1. The software shall be able to handle alarms at controlled appliances. At a minimum, the following alarms shall be supported:
 - a. Door forced open
 - b. Door left open
 - c. Power supply failure
 - d. Hardware tamper
 2. Each alarm event shall be reported in the event log. The system shall allow for alarm events to be acknowledged by an authorised operator.
 3. The system shall support SMS texting and email notification of alarm information.
 4. When an alarm event occurs, an alarm shall sound local to the alarm source.
 - a. The action for alarms to sound shall be configurable in the software.
 - b. The time delay before sounding the alarm shall be configurable in the software.
- L. Data protection
1. The system shall comply with the General Data Protection Regulation (GDPR) 2018.
 2. It shall be possible to permanently delete:
 - a. A user, their events and activity.
 - b. A user, but retain anonymised user events.
 3. When required, the system shall automatically delete events after a user defined period of time.

2.9 SPECIFIC REQUIREMENTS FOR 'LITE' SOFTWARE

- A. The manufacturer shall provide a 'Lite' version of the software.
- B. The software shall be free of charge.
- C. The manufacturer of the software shall provide updates and upgrades free of charge.
- D. The software shall offer all features required to manage a basic access control system.
- E. At minimum, the 'Lite' software shall provide the following features:
 1. Access Control
 - a. The software shall manage at minimum 50,000 single token users.
 - b. The software shall manage at minimum 1,000 access points.
 2. Access levels
 - a. The software shall provide support for up to 256 access groups and 10,000 individual access levels.
 - b. Each access level shall include a combination of access points defined as a single group name for ease of administration.

- c. Each access point defined within an access level shall have a separate time schedule. For example, door one and door two can be within the same access level group, but each have a different time zone.
- d. It shall be possible to apply temporary access permissions to allow a user temporary access to a door or area for a specific period of time.
- 3. Time schedules
 - a. The software shall provide a minimum of 64 separate time schedules (zones) with each schedule supporting a minimum of 512 segments.
 - b. Each time schedule shall have the option to be configured through a graphical display or via text input. Graphical display shall allow a mouse to drag / drop for time selection as well as copying one day or segment to another.
- 4. Users (cardholders) shall include as a minimum
 - a. Automatic disabling of use when record is voided from use.
 - b. A lost card, if found, shall be capable of being enabled again.
 - c. Integrated photo display on primary card record page.
 - d. Card template selection from card badge designs.
 - e. 16 user definable fields.
 - f. Ability to create new departments from cardholder screen.
 - g. Start and expiration date for automatic card operation.
 - h. General access level (door assignment) settings combining multiple doors and times.
 - i. Customised individual access level settings
 - j. Assignment of a minimum of 27 individual tokens/credentials per person.
 - k. System generated personal identification numbers from 4-8 digits.
 - l. Manually entered personal identification numbers from 4-8 digits.
 - m. Permission to arm/disarm the intruder alarm system.
 - n. Capability to void the user from working with a single command.
 - o. Export the record in a .VCF format.
 - p. A graphic showing the type of token with each token/credential in the record.
 - q. Emergency information including:
 - (i) Address
 - (ii) Town
 - (iii) County
 - (iv) Postal Code
 - (v) Home telephone number
 - (vi) Home fax number
 - (vii) Cell phone number
 - (viii) Email address
 - r. Employment information including:
 - (i) Position
 - (ii) Employee start date
 - (iii) Car registration
 - (iv) Notes allowing custom entry of information
 - s. Last activity showing location, date, time, and event
 - t. Real-time display of where the cards are active at that specific time/date
 - u. Quick find button on main screen for cardholder search.
- 5. Door capabilities shall be at a minimum:
 - a. Door name of 50 characters
 - b. Controller serial number & MAC address
 - c. Controller type
 - d. Firmware version number

- f. Communications port
- g. Alarm Conditions
 - (i) Door held open
 - (ii) Door forced open
- h. Last activity showing location, date, time, and event
- i. Door unlock time up to 80 minutes
- j. Auto-unlock time schedule
- k. Manual open command
- l. Door based access codes which do not follow access level definitions
- m. Configure individual readers for entry and exit
- n. Capability to change the reader configuration based on time schedule between any of the reader formats
- o. Define a reader type as one of the following:
 - (i) Wiegand
 - (ii) Clock & data
- p. Define a reader format as one of the following:
 - (i) Token only
 - (ii) Token + PIN
 - (iii) Token + Code
 - (iv) PIN only
 - (v) Code only
 - (vi) Token or PIN
 - (vii) Token or Code
 - (viii) Token, PIN or Code
- q. Activate the main strike for door control
- r. Toggle at least 2 door relays on access granted events
- s. Sound local alarm under the following conditions:
 - (i) Door is forced open
 - (ii) Door is held open after valid exit or access
 - (iii) Controller is tampered with and the tamper switch is opened
 - (iv) Controller loses main power
- t. Sound local alarm under the following conditions:
 - (i) Delay alarm from sounding for up to 100 seconds
 - (ii) Sound alarm continuously until door is closed and input restored
 - (iii) Sound alarm for up to 100 seconds. Allowing the time to repeat indefinitely
 - (iv) Delay the interval between sounding up to 100 seconds
 - (v) Delay the alarm from sending to the PC/event logger for up to 100 seconds
- u. Arm/Disarm burglar alarm panel via dry contact relay using selectable constant and momentary closure.
- v. Automatically change the reader status based on whether the alarm is armed or disarmed.
- 6. Trigger & Actions
 - a. A trigger (a system event that can cause an action within the system) can be any of the following:
 - (i) User is granted access at a door
 - (ii) User is denied access at a door
 - (iii) Intruder alarm is armed or disarmed
 - (iv) Exit button is pressed
 - (v) Doorbell button is pressed
 - (vi) I/O board input changes state
 - (vii) A controller goes online or offline

- (viii) Fire alarm input gets activated
 - (ix) Local forced door and door held open alarms
 - (x) Specific time of day
 - (xi) When a token is presented to a door
 - (xii) When a token is presented twice in short succession.
 - (xiii) When a system setting is changed.
 - (xiv) When an I/O board goes online or offline
 - (xv) When a time zone becomes active or inactive
 - (xvi) When the on-screen lockdown is activated or deactivated
 - (xvii) When a low battery status is reported
 - (xviii) When a critical battery status is reported
 - (xix) When a keypad is reported as being hacked (too many attempts)
 - (xx) When an event occurs on a Net2 Entry system
- b. An action can be any of the following:
- (i) Send an email
 - (ii) Send a SMS text message
 - 1. Activate or deactivate a relay on an I/O controller indefinitely either until trigger is off or for one of the following time periods:
 - a. 1000 Milliseconds
 - b. 1000 Seconds
 - c. 1000 Minutes
 - d. 1000 Hours
 - (iii) Activate a WAV file on specific computers of the network
 - (iv) Affect an I/O board relay
 - (v) Control system lockdown
 - (vi) Execute a .exe file
 - (vii) Control a separate door
- c. A trigger can be further parsed by any of the following:
- (i) Department
 - (ii) Specific person
 - (iii) Group of persons
 - (iv) Everyone
 - (v) Specific door
 - (vi) Open a door
 - (vii) Hold the door open
 - (viii) Close the door
 - (ix) Specific time zone

7. Site graphics

- a. The software shall allow for multiple site graphics to be imported in either .jpg or .bmp format.
- b. The site graphics shall show the live status of doors including door open/closed, valid token, invalid token and alarm conditions.
- c. In the event of an alarm, the site graphic shall display the appropriate information.
- d. The ACS shall support IP based cameras. Cameras can be opened directly from the site graphic.
- e. The software shall allow for real-time video monitoring display on the workstation computer.

8. Video management

- a. The software shall be provided with integration to key CCTV manufacturers for this project. The following shall be required as a minimum:
 - (i) Milestone

- (ii) JVC
- (iii) Dedicated Micros
- (iv) Exacq Vision
- b. The software shall retrieve all pre-programmed cameras from the video system and automatically implement them in the doors sections for selection.
- c. Up to four cameras can be assigned to each door in the software.
- d. A link with date/time to the video system shall be created under the following conditions:
 - (i) Card events
 - (ii) Alarm events
 - (iii) Controller system events
- e. Each event-related item shall include a camera link within that event string that when pressed will retrieve the video from the video management system and display it on the access workstation.
- f. If the event is a card event then the stored photo shall be displayed as part of the video to allow a stored image to stored video comparison.
- g. The ACS shall support multiple video management systems simultaneously.
- 9. Basic Intruder alarm
 - a. The software shall have the ability to integrate with an intruder alarm system. Integration shall be achieved by using an intruder alarm momentary key switch input and status output.
 - b. The ACS shall distinguish users who can arm or disarm the intruder alarm system by a check box in the user record.
 - c. The ACS shall automatically arm the alarm system if an authorised user presents his/her token at the alarm setting reader.
 - d. The ACS shall deny access to unauthorised users if they attempt to set an alarm.
 - e. The ACS shall deny access to building entry even if the access privileges permit, when the alarm is active. Once the alarm is disarmed, access privileges shall be followed.
 - f. The system shall have the ability to have multiple alarm arming and disarming reader locations.
- 10. Lift control
 - a. An access control reader shall be able to call an elevator and, if necessary, take the user to their specific floor (denying access to unauthorised floors).
 - b. Integration shall be achieved by using a TCP/IP input/output module. The configuration of this feature shall be achieved using the software.
 - c. The software shall support the creation of departments or groups that are used in programming to simplify large quantities of people access rights to floors.
- 11. User Image Verification
 - a. Any controller can be configured as an image verify door that retrieves the users photo from the ACS and displays on selected workstations automatically.
 - b. A minimum of 5 windows can be opened and assigned different doors, per workstation.
 - c. An operator can manually open the door selected from the User Image window.
 - d. The event message shall be displayed within the User Image window.
- 12. Intercom / Access Entry Station
 - a. The software shall support an intercom station capable of allowing access entry from a remote monitor and/ or an integrated access control reader.
 - b. The reader will be built-in to the entry panel so that it is not visible except by a label or graphical representation so the user knows where to present their credential.
 - c. An LCD screen will be used to display and communicate verbally with the specified employee. Up to 1000 names can be displayed.
 - d. Once communications channel is open, the employee shall be able to view the visitor through the desktop station display monitor. An internal camera is included in the entry station.
 - e. All communications, audio, video and power shall be via a single cable using TCP/IP and Power-over-Ethernet, using IPV6 technology.

- f. The remote display station shall include a CCTV monitor to view who is at the entrance.
- g. The remote display station can initiate the communications to the entry station and make an announcement or to view video, as well as unlock the door.
- h. Up to 100 stations can be on a single system and up to 1000 monitors.
- i. The intercom station shall allow configuration of which controller it uses to unlock a door when access is permitted.
- j. A low-light colour camera will be included with the unit as default, and be housed internally to avoid damage due to vandalism.
- k. A series of LED's shall be included to illuminate the immediate area for night time viewing.
- l. If only one intercom station and one monitor are on the system – no configuration shall be required.
- m. The unit shall not require an IP address to be configured. All units within the same LAN shall auto-detect each other on power up.
- n. Where a keypad is present, the number five button shall have a unique design for touch reference.
- o. The intercom station shall not require any external power, other than what is provided via POE to the main processor board. All power for the cameras, intercom and access panels shall be included.
- p. A flush mount housing shall be available.
- q. Any smart phone, computer, tablet can be used with the Entry system using SIP Compliance and an industry standard SIP (session initiation protocol) Server.

2.10 SPECIFIC REQUIREMENTS FOR 'PRO' SOFTWARE

- A. The manufacturer shall provide a 'Pro' version of the software.
- B. The manufacturer of the software shall provide updates and upgrades free of charge.
- C. The software shall offer all features available in the 'Lite' software.
- D. At minimum, the 'Pro' software shall provide in addition the following features:
 - 1. Anti-passback
 - a. The software shall provide functionality of denying a user repeat access through the same access point within a specified time period. This shall prevent the same user's card being handed back to an unauthorised user for use.
 - b. It shall be possible to permit certain users to override the anti-passback rules.
 - c. Readers shall be required on both sides of any access point that is expected to employ anti-passback rules.
 - 2. Time and attendance
 - a. The software shall be able to monitor time and attendance of staff, through use of dedicated 'clocking in' and 'clocking out' readers. The software shall be capable of operating with multiple 'clocking in' and 'clocking out' readers.
 - b. The software shall be able to cope with different hourly rates for staff and overtime rates such as 'time and a half'.
 - c. The software shall produce reports showing hours worked for users and departments over different date ranges.
 - d. The software shall support the importing of vacation and holiday schedules.
 - e. The software shall produce a report that shows total hours worked, remaining vacation time and holidays planned.
 - f. A graphical image shall be used in the software to display a user as clocked in, clocked out, holiday, vacation, out sick, off-site but working. Each setting shall support a customer defined colour to represent the location of user.
 - g. The time and attendance graphic shall be displayed by time of day/month for easy recognition.
 - h. The software can be segmented to display by person, department, or all users.
 - 3. Roll call/muster

- a. The software shall be able to generate a roll call report. This roll call report shall be able to be generated either manually using the software or automatically via a direct input from the fire alarm system.
 - b. The roll call report shall document User name, Department, Last known location, time of last access transaction and status (such as Safe or Missing).
 - c. Any reader on the system shall be able to be designated as a muster reader. Users shall present their token to a muster reader to be marked as 'Safe' on a report subsequently generated.
 - d. To use the roll call function, the controllers shall be required to be split into sections called "areas".
4. Areas
- a. The software shall have the ability to group doors together into defined areas. Once the system is split into areas, users given access into an area shall automatically be validated through all the doors of that area.
 - b. It shall be possible to collect several areas into an area group (for example, the areas of Reception, Factory and Cafeteria could comprise the area group of Main Building).
 - c. If a user is in one area the access attempt with that credential at another area shall be denied.
 - d. Unlimited areas can be defined with up to 50 doors per area.
5. Card Design & Printing
- a. The card designer program shall allow unlimited configurations, with multiple templates saved for each user group. The ability to import company logos and background images, overlay watermarks, static text fields and layers shall all be required components.
 - b. The software shall include a card designer application for the design of custom badges.
 - c. The designer shall support static text, shapes, and colours.
 - d. The designer shall support automatically generated text based on information entered into the user record.
 - e. The designer shall support the creation of single or double sided designs. Each design shall be labelled a template that can be entered into a user record.
 - f. All user defined fields shall be available for inclusion on the card design.
 - g. The software shall have the ability to print cards using a standard Windows card printer.
6. Intruder alarm
- a. The 'Pro' version of software shall contain the same functionality as the 'Lite' version with at minimum the following additions:
 - (i) The software shall support multi-zone / partition based alarm systems integrated so that a user's card can automatically arm/disarm the appropriate locations.
7. Landlord Tenant
- a. The software shall allow the partitioning of a system, giving operators access to specific department groups and access levels only.
8. Energy Control
- a. The ACS shall use an energy controller to be able to switch lighting on and off as required by the movement of users.
 - b. Integration shall be achieved by using a controller with a proximity reader designed to hold an ISO access credential. When the credential is inserted the output of the controller shall remain energised. When the credential is removed the output of the controller shall be turned off.
 - c. User control of the energy management function shall follow standard access level assignments.
9. Remote access
- a. Remote access to the system configuration and reporting shall be available by means of:
 - (i) A mobile application

- (ii) A browser web user interface
- b. Remote access shall be restricted to core functionality, including the below:
 - (i) User administration
 - (ii) Reporting
 - (iii) Roll call
 - (iv) Open door functionality

2.11 SPECIFIC REQUIREMENTS FOR MOBILE APPLICATION

- A. The manufacturer shall provide a mobile application.
- B. The application will be available for Android and iOS devices.
- C. The application shall be free of charge.
- D. The manufacturer shall provide updates and upgrades free of charge.
- E. Only valid operators of the ACS shall be able to login via the mobile application.
- F. The application shall be responsive and scalable to various screen sizes and devices.
- G. At minimum, the application shall provide the following features:
 - 1. Remote access
 - a. The mobile application will allow an operator of the system to access the system from outside of the ACS network.
 - b. It shall be possible to disable remote access to the system, forbidding login from a remote location and via the application.
 - 2. Open door
 - a. It shall be possible to unlock a specified door remotely from the application.
 - b. The application shall remember the doors most used and display these to the user for convenience of future use.
 - (i) The list of most used doors shall be specific to each operator.
 - 3. User administration
 - a. It shall be possible to create a new user.
 - b. It shall be possible to browse existing users and view their details.
 - c. It shall be possible to manage existing users and change their details.
 - d. It shall be possible for an operator to bar a user
 - e. It shall be possible for an operator to manage a user's access permissions
 - f. It shall be possible to manage a user's credentials. The following controls shall be supported:
 - (i) Add a new PIN
 - (ii) Add new token
 - (iii) Delete token
 - (iv) Change token type
 - (v) Mark token as lost
 - (vi) Mark token as found
 - g. It shall be possible to add a new token using the following methods:
 - (i) Manual entry of a token number
 - (ii) Retrieving the token number automatically from an access denied event
 - h. It shall be possible to upload a user image to a user's record using the following methods:
 - (i) Selecting an existing image file from the device
 - (ii) Using the device camera to take a new photo
 - 4. Events and Reports
 - a. It shall be possible to view live system and access events within the mobile app.
 - b. It shall be possible to view pre-configured reports of events.
 - c. It shall be possible to filter events by a keyword or phrase.
 - 5. Roll call
 - a. It shall be possible to generate a new roll call report for a pre-configured area.

- b. It shall be possible to view an existing roll call report.
- c. Roll call reports shall be timestamped.
- d. It shall be possible to interact with a roll call report. The following actions shall be supported:
 - (i) Mark a user as safe
 - (ii) Mark a user as missing
 - (iii) View a user's contact details
 - (iv) View a user's image
- e. While connection to the ACS is maintained, roll call reports shall sync across all devices running the mobile application.
- f. Once opened, a roll call report shall remain available when internet or connection to the ACS is lost.
 - (i) Once connection is returned, any changes to the roll call report will sync across all devices.

2.12 SPECIFIC REQUIREMENTS FOR DESKTOP READER

A. Features

1. The desktop reader shall read multiple types and formats of proximity tokens.
2. The desktop reader shall facilitate assigning tokens to users,
3. The desktop reader shall identify tokens/credentials that have already been assigned to users.
4. The desktop reader shall eliminate the need to know each token's number.
5. In systems with several client PCs, the system shall be able to support multiple desktop readers.
6. The desktop reader shall output token data of a variety of formats and lengths.

B. User interaction

1. The desktop reader shall operate in an intuitive mode:
2. When an unassigned token/credential is presented, the ACS software shall automatically create the user record and user screen for entering user information as well as other security settings.
3. When the operator is already in a user record, and an unassigned token/credential is presented, the software shall display the option to add the token/credential to the current record.
4. When an existing token/credential is presented to the desktop reader, the software shall automatically retrieve and display the user record associated with that user. If there are multiple tokens/credentials assigned to that user, the software shall highlight the specific one presented.
5. The reader shall be plug & play.

C. Product variations

1. The ACS manufacturer shall provide 2 types of reader for enrolling credentials:
 - a. Proximity desktop reader
 - b. Proximity and Magstripe desktop reader

D. Proximity reader

1. The item shall contain a proximity reader.
 - a. At a minimum, the following token technology shall be supported:
 - (i) Paxton HiTag2 125KHz
 - (ii) HID 125KHz **{UK/EU only - may require activation}**
 - b. The Proximity desktop reader shall also support:
 - (i) EM4100
 - (ii) MIFARE® Classic
 - (iii) MIFARE® DESFire® EV1
 - (iv) MIFARE® Ultralight®
 - (v) MIFARE® Ultralight C®
 - (vi) SmartMX
 - (vii) R5
 - c. The Proximity and Magstripe desktop reader shall also support:

- d. All of the above token technology shall be supported concurrently.
- e. The following formats of credential shall be supported:
 - (i) ISO card
 - (ii) Clamshell
 - (iii) Minifob / keyfob
 - (iv) Proxidisc
 - (v) Watchprox
 - (vi) Hands free token
 - (vii) Magstripe card (Proximity and Magstripe product variant only)
- E. Power supply
 - 1. The item shall be powered via USB.
 - 2. Maximum current consumption while in use shall not exceed 100mA.
- F. Communication
 - 1. The desktop reader shall connect to a PC running the Client or Server software via a USB port.
- G. Display
 - 1. The item shall house a stylish LED display.
 - 2. The LEDs shall indicate the following states:
 - a. Item powered / ready to use
 - b. Credential being read
- H. Temperature
 - 1. The item shall meet the required temperature standards for an internal product
 - a. The item shall operate reliably within the temperature range of 0°C to 55°C (32°F to 131°F)
- I. Housing
 - 1. The item shall be stylish and modern.
 - 2. The product shall be available in black
- J. Dimensions
 - 1. The Proximity desktop reader dimensions shall not exceed:
 - a. A width of 115mm (4.5")
 - b. A height of 19mm (0.7")
 - c. A depth of 75mm (3")
 - 2. The Proximity and Magstripe desktop reader dimensions shall not exceed:
 - a. A width of 145mm (5.7")
 - b. A height of 37mm (1.5")
 - c. A depth of 90mm (3.5")

END OF SECTION

Addendum no. 6
to the
Contract Documents
April 25, 2022

General

1. Bidders are cautioned to examine the Addendum in detail, allowing for all changes, additions or deletions as set forth below. All other conditions remain the same.
2. Acknowledge receipt of this Addendum on the Bid Form.
3. The Bid Date remains.

Project Manual

The following pages of the Project Manual are revised by this Addendum and are enclosed herewith as revised for immediate insertion to replace pages originally issued. Revised text, which may consist of additions to, deletions of, or other modifications of the text originally issued, is marked with an asterisk and superscript [“A1” (*A1)] as is the corresponding Addendum designation (number and date) at the bottom of the reissued page. Previously issued addendum or revision designations remain as does the modified text.

Document Title

Page Number(s)

Bidding Requirements

The following pages of the Contract Conditions are revised by this Addendum and are enclosed herewith as revised for immediate insertion to replace pages originally issued. Revised text, which may consist of additions to, deletions of, or other modifications of the text originally issued, is marked with an asterisk and superscript [“A1” (*A1)] as is the corresponding Addendum designation (number and date) at the bottom of the reissued page. Previously issued addendum or revision designations remain as does the modified text.

Document Title

Page Number(s)

Bidding Requirements

The following pages of the Contract Conditions are issued by this Addendum and are enclosed herewith for immediate insertion into the Bidding Documents

Document Title	Page Number(s)
----------------	----------------

Specifications

The following Specification sections are revised by this Addendum and are enclosed herewith as revised for immediate insertion to replace pages originally issued. Revised text, which may consist of additions to, deletions of, or other modifications of the text originally issued, is marked with an asterisk and superscript [“A1” (*A1)] as is the corresponding Addendum designation (number and date) at the bottom of the reissued page. Previously issued addendum or revision designations remain as does the modified text.

Specification Section	Revision Description
00 10 10	Added 21 13 13 and 23 21 13.
22 40 00	Updated Section 2.4.
32 90 00	1.05 – J, section has been deleted to correct conflict with section 1.11-A.

The following Specifications sections were omitted from the originally issued set and are enclosed herewith as issued new by this Addendum.

Specification Section	Section Title
21 13 13	Wet-Pipe Sprinkler Systems
23 21 13	Hydronic Piping

Drawings

The following Contract Drawings are revised by this Addendum and are transmitted herewith as revised to replace immediately the respective original drawings.

Sheet	Revision Description
G0.01	Updated Alternate #5 to accommodate revised PV layout. Deleted Add Alternate #6 water meter.

L1.1	Updated Construction Callout 7.
L1.2	Updated Construction Callout 7.
L2.1	Updated details D, E, & F.
L2.5	Added detail D.
L3.1	Updated Callout 7. Deleted Subsurface Dripline Notes. Revised Piping note.
L3.2	Revised Piping note.
L4.1	Revised Planting note 5.
A2.02	Updated roof plan to accommodate revised PV layout per Electrical Drawings
A3.12	Deleted roof monitor alternate along gridline C.
A3.21	Deleted roof monitor alternate along gridline C.
A3.22	Deleted roof monitor alternate along gridline C.
A9.01	Detail 11: Deleted fire-rated requirement.
M2.01	Revised ducting at North Entry and Infant Classroom.
M2.02	Revised ducting at North Entry and Infant Classroom.
M3.01	Revised piping at North Entry and Infant Classroom.
M3.02	Revised piping at North Entry and Infant Classroom.
M4.01	Moved Condenser.
P0.01	Deleted Add Alternate water meter. Added info for building water meter.
P1.02	Deleted Add Alternate water meter.
E6.1	Various changes to photovoltaic panel sizes, quantities, and configuration. Minor adjustment to condensing unit at roof.
E7.1	Update to panel quantities per Sheet E6.1 and string and inverter ratings.

The following Contract Drawings are added by this Addendum and are transmitted herewith as new to be inserted immediately in the drawing set.

Sheet	Reference Title
XXX	XXX

+ + End of Addendum No. 6 + +

SECTION 00 01 10

TABLE OF CONTENTS

DIVISION 00 – PROCUREMENT AND CONTRACTING REQUIREMENTS

00 00 05	Certifications
00 01 10	Table of Contents
	Balanced to be furnished by the University

DIVISION 01 – GENERAL REQUIREMENTS

01 00 00	CALGreen Mandatory Checklist
01 10 00	Summary of Work
01 14 00	Work Restrictions
01 15 10	Construction and Demolition Materials
01 21 00	Allowances
01 23 00	Alternates
01 25 00	Substitutions
01 26 13	Request for Information
01 29 73	Measurements and Payments
01 31 13	Coordination
01 31 19	Project Meetings
01 31 26	Electronic Communications Protocol
01 32 00	Construction Progress Documentation
01 32 16	Contract Schedule
01 33 00	Submittals
01 35 00	Special Procedures
01 35 23	Owner Safety Requirements
01 35 53	Security
01 40 00	Quality Control
01 41 00	Regulatory Requirements
01 42 00	Reference Standards and Definitions
01 43 39	Mock-Ups
01 45 23	Owner’s Inspection Services
01 45 29	Testing Lab Services
01 50 00	Temporary Facilities
01 51 00	Temporary Utilities
01 55 00	Vehicle and Pedestrian Controls
01 56 39	Temporary Tree and Plant Protection
01 57 00	Temporary Controls
01 57 23	Storm Water Pollution Prevention
01 60 00	Product Requirements
01 65 00	Materials and Equipment
01 71 00	Examination and Preparation Requirements
01 73 00	Execution Requirements
01 73 29	Cutting and Patching
01 74 00	Cleaning Requirements
01 74 19	Construction Waste Management
01 75 00	Starting of Systems
01 77 00	Project Close-Out
01 78 36	Warranties
01 78 83	Operating and Maintenance Data
01 91 00	General commissioning Requirements

DIVISION 02 – EXISTING CONDITIONS – NOT USED

DIVISION 03 – CONCRETE

03 05 00	Concrete Floor Sealer
03 10 00	Concrete Formwork
03 20 00	Concrete Reinforcement
03 25 00	Concrete And masonry Anchors
03 30 00	Cast-in-Place Concrete

DIVISION 04 – MASONRY

04 22 23	Architectural Concrete Unit Masonry
----------	-------------------------------------

DIVISION 05 – METALS

05 04 00	Hot-Dip Galvanizing
05 12 00	Structural Steel
05 50 00	Metal Fabrications
05 51 33	Aluminum Cage Ladders
05 58 00	Formed Metal Fabrications

DIVISION 06 – WOOD, PLASTICS, AND COMPSITES

06 10 00	Rough Carpentry
06 17 53	Metal Plates Wood Trusses
06 18 50	Structural Glued Laminated Timber
06 40 23	Interior Architectural Woodwork
06 41 00	Architectural Wood Casework
06 64 00	Plastic Paneling (FRP)

DIVISION 07 – THERMAL AND MOISTURE PROTECTION

07 14 16	Elastomeric Liquid Waterproofing
07 21 00	Thermal Insulation
07 22 16	Roof Board Insulation
07 26 16	Below-Grade Vapor Barriers
07 27 14	Self-Adhered Sheet Membrane Air and Moisture Barrier
07 36 63	Metal Roofing Underlayment
07 41 13	Metal Roof and Wall Panels
07 46 48	Composite Wood Panels
07 46 49	Fiber Cement Soffit Panels
07 54 19	Polyvinyl-Chloride Roofing
07 62 00	Sheet Metal Flashing and Trim
07 72 33	Roof Hatches
07 84 00	Firestopping
07 92 00	Joint Sealants
07 92 19	Acoustical Joint Sealants

DIVISION 08 – OPENINGS

08 11 13	Hollow Metal Doors and Frames
08 14 16	Flush Wood Doors
08 31 13	Access Doors and Frames
08 44 13	Window Wall Storefronts and Entrances
08 71 00	Door Hardware

08 80 00 Glass and Glazing
 08 91 00 Louvers

DIVISION 09 – FINISHES

09 22 16 Non-Structural Metal Framing
 09 22 26.33 Ceiling Suspension Systems
 09 22 36.23 Metal Lath and Accessories
 02 24 00 Portland Cement Plaster
 09 28 13 Cementitious Backing Board
 09 29 00 Gypsum Board
 09 30 00 Tile
 09 51 13 Acoustical Panel Ceilings
 09 53 23 Metal Acoustical Ceiling Suspension Assemblies
 09 54 29 Wood Ceilings
 09 61 43 Water Vapor Emission and Humidity Testing and Control Systems
 09 65 13 Resilient Base and Accessories
 09 65 16 Resilient Sheet Flooring
 09 65 19 Resilient Tile Flooring
 09 68 13 Tile Carpeting
 09 77 23 Acoustical Wall Panels
 09 81 00 Acoustic Insulation
 09 91 00 Painting
 09 92 23 Graffiti-Resistant Coatings
 09 97 13 Steel Coatings

DIVISION 10 – SPECIALTIES

10 11 00 Visual Display Surfaces
 10 14 00 Signage
 10 21 13 Toilet Compartments
 10 21 23 Cubicles
 10 28 13 Toilet Accessories
 10 41 16 Emergency Key Cabinets
 10 43 13 Defibrillator Cabinets
 10 44 00 Fire Protection Specialties

DIVISION 11 – EQUIPMENT

11 24 29 Fall Protection Tieback Anchors
 11 31 00 Appliances
 11 40 00 Food Service Equipment
 11 40 01 Cutsheet for Service Equipment

DIVISION 12 – FURNISHINGS

12 21 23 Window Shades
 12 36 61 Solid Surfacing Countertops

DIVISION 13 – SPECIAL CONSTRUCTION – NOT USED

DIVISION 14 – CONVEYING EQUIPMENT – NOT USED

DIVISION 21 – FIRE PROTECTION

A6

A7 21 13 13 Wet-Pipe Sprinkler Systems A7

DIVISION 22 – PLUMBING

22 05 00	Basic Mechanical Materials and Methods
22 05 29	Pipe Hangers and Supports
22 40 00	Plumbing

DIVISION 23 – HEATING, VENTILATING AND AIR CONDITIONING

A6

23 08 00	HVAC
23 09 23	HVAC Controls
^{A7} 23 21 13	Hydronic Piping ^{A7}
23 73 13	Central Station Air Handler

DIVISION 25 – INTEGRATED AUTOMATION – NOT USED

DIVISION 26 – ELECTRICAL

26 05 00	Common Work Results for Electrical
26 05 16	Medium-Voltage Cables, Splices and Terminations
26 05 19	Low-Voltage Power Conductors and Cables
26 05 26	Grounding and Bonding for Electrical Systems
26 05 33	Raceways and Boxes
26 09 24	Networked Lighting Control Systems
26 12 00	Distribution Liquid Filled Transformers
26 13 13	Pad Mounted Underground Distribution Switchgear
26 22 00	Distribution Dr-Type Transformers (600vac and less)
26 23 50	Photovoltaic System
26 24 13	Switchboards
26 24 16	Panelboards
26 27 26	Wiring Devices
26 28 11	Overcurrent Protection Devices
26 28 16	Safety Switches and Individual Mounted Circuit Breakers
26 43 13	Transient Voltage Surge Suppressors

DIVISION 27 – COMMUNICATIONS

27 05 26	Grounding and Bonding for Communications
27 05 28	Pathways for Communication Systems
27 11 16	Data Racks and Enclosures
27 15 13	(Cat6) Telecommunications/Data Cabling and Devices
27 15 23	Fiber Optic Cabling and Devices

DIVISION 28 – ELECTRONIC SAFETY AND SECURITY

28 05 26	Grounding and Bonding for Electronic Safety and Security
28 05 33	Pathway for Electronic Safety and Security
28 13 00	Access Controls
28 23 00	Surveillance System
28 31 00	Fire Alarm System

DIVISION 31 – EARTHWORK

31 05 13	Soils for Earthwork
31 11 00	Site Clearing
31 20 00	Earthwork

31 20 05	Trending
31 22 19	Finish Grading

DIVISION 32 – EXTERIOR IMPROVEMENTS

32 01 90	Landscape Maintenance
32 12 16	Asphalt Paving
32 13 13	Concrete Paving and Walks
32 13 16	Integrally Colored Concrete
32 13 73	Paving Joint Sealants
32 15 40	Stabilized Decomposed Granite Paving
32 17 00	Paving Specialties
32 17 26	Detectable/Tactile Warning Surfaces
32 31 00	Fences and Gates
32 32 10	Site Walls
32 33 00	Site Furnishing
32 80 00	Irrigation
32 90 00	Planting

DIVISION 33 – UTILITIES

32 10 00	Water Distribution
33 30 00	Sanitary Sewerage
33 40 00	Storm Drainage Facilities

END OF TABLE OF CONTENTS

A6 SECTION 211313

WET-PIPE SPRINKLER SYSTEMS

PART 1 - GENERAL

1.1 SUMMARY

- A. Section Includes:**
- 1. Pipes, fittings, and joining methods**
 - 2. Fire-protection valves**
 - 3. Trim and drain valves**
 - 4. Specialty valves**
 - 5. Fire-department connections**
 - 6. Specialty fittings**
 - 7. Sprinklers**
 - 8. Alarm devices**

1.2 SYSTEM DESCRIPTIONS

- A. Wet-Pipe Sprinkler System: Automatic sprinklers are attached to piping containing water and that is connected to water supply. Water discharges immediately from sprinklers when they are opened.**

1.3 PERFORMANCE REQUIREMENTS

- A. Standard-Pressure Piping System Component: Listed for 175-psig minimum working pressure.**
- B. Sprinkler system(s) design shall be per current edition of the CFC and approved by authorities having jurisdiction.**
- 1. Margin of safety for available water flow and pressure shall be 10 percent, including losses through water-serving piping, fittings, valves, and backflow preventers.**
 - 2. Sprinkler Occupancy Hazard Classifications:**
 - a. Office and Public Areas: Light Hazard.**
 - b. Utility Areas: Ordinary Hazard, Group 1**
 - c. Storage Areas: Ordinary Hazard, Group 2**
 - 3. Minimum Density for Automatic-Sprinkler Piping Design:**
 - a. Light Hazard Occupancy: 0.10 GPM per sq. ft.**
 - b. Ordinary Hazard, Group 1 Occupancy: 0.15 GPM per sq. ft.**
 - c. Ordinary Hazard, Group 2 Occupancy: 0.20 GPM per sq. ft.**
 - 4. Maximum Protection Area per Sprinkler: Per UL listing.**

5. Total Combined Hose-Stream Demand Requirement: According to NFPA 13.

C. Seismic Performance: Sprinkler piping shall withstand the effects of earthquake motions determined according to NFPA 13.

1.4 SUBMITTALS

A. Product Data: For each type of product indicated.

B. Sprinkler Piping Shop Drawings: Working plans, prepared according to NFPA 13, shall be coordinated with the design drawings approved by the authorities having jurisdiction, including the hydraulic calculations.

C. Welding certificates.

D. "Contractor's Material and Test Certificate for Aboveground Piping."

E. "Contractor's Material and Test Certificate for Underground Piping."

F. Operation and maintenance data.

1.5 QUALITY ASSURANCE

A. Installer Qualifications:

1. Installer's responsibilities include fabricating, and installing sprinkler systems and providing engineering services needed to assume engineering responsibility. Base calculations on results of fire-hydrant flow test conducted within twelve months.

a. Engineering Responsibility: Preparation of working plans, calculations, and field test reports.

B. Welding Qualifications: Qualify procedures and operators according to ASME Boiler and Pressure Vessel Code.

C. Electrical Components, Devices, and Accessories: Listed and labeled as defined in NFPA 70, by a qualified testing agency, and marked for intended location and application.

D. NFPA Standards: Sprinkler system equipment, specialties, accessories, installation, and testing shall comply with the following:

1. NFPA 13, "Installation of Sprinkler Systems."

2. NFPA 24, "Installation of Private Fire Service Mains and Their Appurtenances."

PART 2 - PRODUCTS

2.1 PIPING MATERIALS

- A. Comply with requirements in "Piping Schedule" Article for applications of pipe, tube, and fitting materials, and for joining methods for specific services, service locations, and pipe sizes.**

2.2 STEEL PIPE AND FITTINGS

- A. Standard Weight (schedule 40) and Light Weight (schedule 10), Black-Steel Pipe: ANSI/ASTM A53, Type E, Grade A or B; or ASTM A135; or ASTM A795. Pipe ends may be factory or field-formed to match joining method.**
- B. Black-Steel Pipe Nipples: ASTM A733, made of ASTM A53/A53M, standard-weight, seamless steel pipe with threaded ends per ANSI 1.20.1 (B2.1).**
- C. Malleable-Iron Threaded Fittings: ANSI B16.3, made of ASTM A536 malleable iron, with threaded ends per ANSI 1.20.1 (B2.1).**
- D. Cast-Iron Threaded Fittings: ANSI B16.4, made of ASTM A126 cast iron, with threaded ends per ANSI 1.20.1 (B2.1).**
- E. Cast-Iron Flanges: ANSI B16.4, made of ASTM A126 cast iron, Class 125.**
- F. Steel Welding Fittings: ASTM A53, Type E, Grade A or B; or ASTM A135; or ASTM A795.**
- G. Grooved-Joint, Steel-Pipe Appurtenances:**
 - 1. Manufacturers: Subject to compliance with requirements, available manufacturers offering products that may be incorporated into the Work include, but are not limited to, the following:**
 - a. Victaulic Company**
 - b. Tyco Fire Suppression and Building Products**
 - c. Anvil International**
 - 2. Pressure Rating: 175 psig minimum.**
 - 3. Grooved-End Fittings for Steel Piping: ASTM A 536, ductile-iron casing; with dimensions matching steel pipe.**
 - 4. Grooved-End-Pipe Couplings for Steel Piping: Rigid pattern, unless otherwise indicated, for steel-pipe dimensions. ASTM A 536, ductile-iron housing, EPDM-rubber gasket, and bolts and nuts.**

2.3 PIPING JOINING MATERIALS

- A. Pipe-Flange Gasket Materials: ASME B16.21, nonmetallic and asbestos free.**
 - 1. Class 125, Cast-Iron Flat-Face Flanges: Full-face gaskets.**
- B. Metal, Pipe-Flange Bolts and Nuts: ASME B18.2.1, carbon steel unless otherwise indicated.**

- C. Welding Filler Metals: Comply with AWS D10.12M/D10.12 for welding materials appropriate for wall thickness and chemical analysis of steel pipe being welded.**

2.4 LISTED FIRE-PROTECTION VALVES

A. General Requirements:

- 1. Valves shall be UL listed.**
- 2. Minimum Pressure Rating: 175 psig.**

B. Backflow preventer: Double check type, Ames, Wilkins or equal.

C. Indicating Valves:

- 1. Body material: Cast or ductile iron.**
- 2. End connections: Flanged or grooved**

D. Check Valves: Victaulic, or equal.

- 1. Type: Swing check.**
- 2. Body material: Cast or ductile iron.**
- 3. End connections: Flanged or grooved.**

2.5 TRIM AND DRAIN VALVES

- A. Angle, check and globe trim valves for fire sprinkler service: NIBCO, United Brass, or equal.**

2.6 SPECIALTY VALVES

2.7 FIRE DEPARTMENT CONNECTIONS

2.8 SPECIALTY FITTINGS

2.9 SPRINKLERS

PRODUCT DATA SHEET 1 - S.

- A. Sprinkler heads shall glass bulb.**
- B. Sprinkler head bulbs shall be color coded.**
- C. Sprinkler heads in areas with exposed piping shall be standard upright or pendant type. Sprinklers in Acoustical T-bar ceilings and Gypsum Board ceilings to be Concealed with white cover plates. Wood Grille Ceilings and Exterior Overhangs to receive semi-recessed sprinklers with Standard Black finish and Black escutcheon.**
- D. Sprinklers in T-Bar ceilings to be quarter pointed or centerline of tile with a $\pm 3/4$ inch tolerance. Sprinklers in Wood Grille Ceilings to be positioned in center of slats with a $\pm 1/4$ inch tolerance.**

2.10 ALARM DEVICES

- A. Water flow indicator for local alarm: UL approved suitable for variable pressure, complete with instantaneous recycling retard and electrical contacts for alarm system (number as required). Potter Electric Signal, or equal.**

PART 3 - EXECUTION

3.1 WATER-SUPPLY CONNECTIONS

3.2 PIPING INSTALLATION

- A. Locations and Arrangements: Drawing plans, schematics, and diagrams indicate general location and arrangement of piping. Install piping as indicated, as far as practical.
 - 1. Deviations from approved working plans for piping require written approval from authorities having jurisdiction. File written approval with Architect before deviating from approved working plans.****
- B. Piping Standard: Comply with requirements for installation of sprinkler piping in NFPA 13.**
- C. Install seismic restraints on piping. Comply with requirements for seismic-restraint device materials and installation in NFPA 13.**
- D. Use listed fittings to make changes in direction, branch takeoffs from mains, and reductions in pipe sizes.**
- E. Install flanges, flange adapters, or couplings for grooved-end piping on valves, apparatus, and equipment having NPS 1-1/2 and larger end connections.**
- F. Install "Inspector's Test Connections" in sprinkler system piping, complete with shutoff valve, and sized and located according to NFPA 13.**
- G. Install air vent at high elevation point of system sized and located according to NFPA 13.**
- H. Install sprinkler piping with drains for complete system drainage.**
- I. Install sprinkler control valves, test assemblies, and drains.**
- J. Install alarm devices in piping systems.**
- K. Install hangers and supports for sprinkler system piping according to NFPA 13. Comply with requirements for hanger materials in NFPA 13.**
- L. Install pressure gages on riser.**
- M. Install sleeves for exposed piping penetrations of walls, ceilings, and floors.**
- N. Install sleeve seals for piping penetrations of concrete walls and slabs.**

- O. Install escutcheons for piping penetrations of walls, ceilings, and floors.**

3.3 JOINT CONSTRUCTION

3.4 VALVE AND SPECIALTIES INSTALLATION

- A. Install listed fire-protection valves, trim and drain valves, specialty valves and trim, controls, and specialties according to NFPA 13 and authorities having jurisdiction.**
- B. Install listed fire-protection shutoff valves supervised open, located to control sources of water supply except from fire-department connections. Install permanent identification signs indicating portion of system controlled by each valve.**
- C. Install check valve in each water-supply connection. Install backflow preventers instead of check valves in potable-water-supply sources.**

3.5 SPRINKLER INSTALLATION

- A. Install sprinklers in suspended ceilings in center of acoustical ceiling panels.**

3.6 FIELD QUALITY CONTROL

- A. Perform tests and inspections.**
- B. Tests and Inspections:**
 - 1. Leak Test: After installation, charge systems and test for leaks. Repair leaks and retest until no leaks exist.**
 - 2. Flush, test, and inspect sprinkler systems according to NFPA 13, "Systems Acceptance" Chapter.**
 - 3. Coordinate with fire-alarm tests. Operate as required.**
- C. Sprinkler piping system will be considered defective if it does not pass tests and inspections.**
- D. Prepare test and inspection reports.**

3.7 CLEANING

- A. Clean dirt and debris from sprinklers.**
- B. Remove and replace sprinklers with paint other than factory finish.**

END OF SECTION A6

SECTION 22 40 00 - PLUMBING

PART 1 GENERAL

1.1 RELATED DOCUMENTS

- A. The requirements of the GENERAL CONDITIONS, SUPPLEMENTAL CONDITIONS, and DIVISION 1, GENERAL REQUIREMENTS, apply to the work of this SECTION.

1.2 SUMMARY

- A. Provide plumbing where shown on the Drawings, as specified herein, and as needed for a complete and proper installation including, but not necessarily limited to:
 - 1. Domestic hot and cold water piping systems
 - 2. Drain, waste, and vent systems
 - 3. Plumbing fixtures and trim as shown on the Drawings
 - 4. Natural gas piping systems
 - 5. Steam / Condensate systems
 - 6. Roof drain piping systems

1.3 SUBMITTALS

- A. Comply with pertinent provisions of Section 220500.
- B. Record Drawings: At project closeout, submit Record Drawings of installed ductwork, duct accessories, and outlets and inlets in accordance with the requirements of Division 1.
- C. Sterilization certificate:
 - 1. Upon completion of water line sterilization, deliver to the Architect two copies of an acceptable "Certificate of Performance" for that activity.

1.4 QUALITY ASSURANCE

- A. Use adequate numbers of skilled workmen who are thoroughly trained and experienced in the necessary crafts and who are completely familiar with the specified requirements and the methods needed for proper performance of the work of this Section.
- B. Codes and regulations:
 - 1. In addition to complying with the specified requirements, comply with pertinent regulations of governmental agencies having jurisdiction.
 - 2. In the event of conflict between or among specified requirements and pertinent regulations, the more stringent requirement will govern when so directed by the Architect.

PART 2 PRODUCTS

2.1 EQUIPMENT

- 1. Provide plumbing equipment and appurtenances as shown on the "Plumbing Equipment Schedule" on the drawings.

2.2 FIXTURES

1. Provide fixtures and trim as shown on the "Plumbing Fixture Schedule" on the drawings.

2.3 PIPE SCHEDULE

1. Provide pipe materials and joints as shown on the "Plumbing Material Schedule" on the drawings.

A6

^{A6}2.4 MATERIALS

A. ABS Pipe

1. Acrylonitrile Butadiene Styrene (ABS)/Solvent-fused (Welded) Joints: Pipe shall be manufactured from virgin rigid acrylonitrile butadiene styrene compounds with a minimum cell class of 42222 as identified in ASTM D 2661. Fittings shall be manufactured from virgin ABS compounds with a cell class of 32222 as identified in ASTM D 2661. Pipe and fittings shall be manufactured as a system and be the product of one manufacturer. Pipe and fittings shall conform to National Sanitation Foundation Standard 14.

B. Copper Water Pipe

1. Pipe above grade shall be Type L hard drawn copper tubing per ASTM B 88, plain ends.
2. Fittings shall be solder type, wrought copper per ANSI Standard B16.22 or cast red bronze per ANSI Standard B16.18. Do not use T-drill.
3. Unions shall be solder type, cast red bronze.
4. Joining Materials/Methods
 - a. Canfield, Silvabrite or equal lead-free solder with a non-corrosive water-based flux.
 - b. Fifteen percent silver brazing alloy, water-based silver brazing flux. Silver content must be clearly identified on the brazing rod.
5. Connections
 - a. Copper to dissimilar metals shall have a dielectric connector.
 - b. Copper to threaded connections shall have cast brass adapters.

C. Galvanized or black steel pipe:

1. Provide standard weight complying with ASTM A12.

D. Fittings:

1. For copper lines, provide wrought copper fittings.
2. For cast iron lines, provide service weight cast iron type fittings.
3. For steel lines, provide malleable iron fittings

E. Unions:

1. For copper lines, provide copper fittings.
2. For connections in iron pipe lines 2-1/2" and smaller, provide ground joint brass-to-iron fittings.

F. Strainers: Provide Y-pattern, 200# WOG, 20 mesh monel screen:

1. 3" and smaller: Provide Crane #988-1/2 or equal, screwed.

G. Pressure regulators: Provide Mueller H-9000, or Wilkins series 500, all bronze.

H. Balancing cocks: Provide Bell & Gossett or equal.^{A6}

2.5 FLASHING

A. Where pipes of this Section pass through the roof, flash with 24 gauge galvanized sheet metal, counter-flashing to be 24 gauge sheet metal.

2.6 PIPE HANGERS – see Section 220529 PIPE HANGERS AND SUPPORTS

2.7 CLEANOUTS

A. Exterior:

1. Provide Smith #4253, Josam #8860 or equal with XH cast iron top in concrete areas.

B. Floors:

1. Provide Smith #4023, Josam #8330 or equal with round nickel-bronze top in finished room floors.

2. Provide Smith #4223, Josam #8090-CAL or equal with round cast iron top in unfinished room floors.

3. Provide "flush-with-floor" type cleanouts, with adjustable watertight covers and integral anchorage flange with clamping collar where waterproofing membrane is used.

C. Finished walls:

1. Provide Smith #4532, Josam #8790-4 or equal with round stainless steel access plate and screw.

D. Provide cleanout plugs of ABS indoors or bronze outdoors.

2.8 ACCESS BOXES

A. Walls:

1. Provide Smith #4730 or Josam #8650 with polished chrome plate face in tile walls.

2. Provide Smith #4760-AKL OR #4765-AKL, Josam #SLA or #SLB or equal paint-grade steel face and with Allen lock in walls of other finished rooms.

B. Ceilings:

1. Provide Acorn #8211-3-AKL, Josam #SLA or equal paint-grade steel face with Allen lock.

C. Floors:

1. Provide Smith #4910, Josam #8630-5 or equal with XH plain aluminum or nickel-bronze non-skid top.

2. Provide Smith #4920 or equal for floors covered with vinyl reinforced or pure vinyl tile.

D. Yard boxes:

1. Provide Brooks 36 HF, Frazer #2 or equal cast concrete boxes with cast iron rim and hinged self-closing cast iron lid marked GAS SHUTOFF or WATER, size 12" x 18" x 12".

2.9 PRESSURE GAGES AND THERMOMETERS

- A. Provide Marsh Quality Gages with 4-1/2" dial, gage cock, in type required. For pump suction, provide compound type.
- B. Provide Terrice 9" BX series thermometers, straight, angle, or oblique as required, equipped with separable sockets and well. Provide extension necks as required on insulated line.
- C. Arrange thermometers for easy reading from the floor.

2.10 TRAPS

- A. For lavatories and sinks, except service sinks, provide Los Angeles pattern cast brass traps with brass nuts.

2.11 INSULATION FOR ACCESSIBLE FIXTURES

- A. Where shown on the Drawings or required by governmental agencies having jurisdiction, at lavatories for handicapped persons insulation on hot water supply, tailpiece, and trap. TRUEBRO or equal.

2.12 PIPE WRAPPING

- A. Steel piping in concrete or underground:
 1. Wrap with 20 mil tape
 2. Fittings and other joints: Wrap in the field with 20 mil tape and primer.
 3. Provide 50% overlap on tape weld rubber coating.
- B. Testing:
 1. Secure inspection and testing by an independent agency approved in advance by the Architect.

2.13 PIPE INSULATION

- A. Provide domestic hot water supply and return piping with insulation to meet or exceed the latest Title 24 California Energy Code requirements.

2.14 VALVES

- A. Valves shall be the same size as upstream piping unless otherwise noted. All valves within insulated pipe shall be provided with an extended operating handle or rising stem to ensure operation without disturbing insulation.
- B. Shutoff Valves:

1. 2" and smaller: Gate valves or ball valves. Bronze or brass valves, Class 125.
2. 2-1/2" and larger: Gate valves. Iron valves, Class 125

C. Check valves:

1. 2" and smaller: Swing type. Bronze or brass valves, Class 125.
2. 2-1/2" and larger: Swing type. Iron valves, Class 125

2.15 SLEEVES

- A. Where pipes pass through concrete, masonry, or stud walls, or pass through ceilings, provide sleeve of the size required.

2.16 OTHER MATERIALS

- A. Provide other materials, not specifically described but required for a complete and proper installation, as selected by the Contractor subject to the approval of the Architect.

PART 3 EXECUTION

3.1 SURFACE CONDITIONS

- A. Examine the areas and conditions under which work of this Section will be performed. Correct conditions detrimental to timely and proper completion of the Work. Do not proceed until unsatisfactory conditions are corrected.

3.2 PLUMBING SYSTEM LAYOUT

- A. Lay out the plumbing system in careful coordination with the Drawings, determining proper elevations for all components of the system and using only the minimum number of bends to produce a satisfactorily functioning system.
- B. Follow the general layout shown on the Drawings in all cases except where other work may interfere.
- C. Lay out pipes to fall within partition, wall, or roof cavities, and to not require furring other than as shown on the Drawings.

3.3 TRENCHING AND BACKFILLING

- A. Perform trenching and backfilling associated with the work of this Section
- B. Cut bottom of trenches to grade. Make trenches 12" wider than the greatest dimension of the pipe.
- C. Bedding and backfilling:
1. Install piping promptly after trenching. Keep trenches open as short a time as practicable.
 2. Under the building, install pipes on a 6" bed of damp sand. Backfill to bottom of slab with damp sand.

3. Outside the building, install underground piping on a 6" bed of damp sand. Backfill to within 12" of finish grade with damp sand. Backfill remainder with native soil.
4. Do not backfill until installation has been approved and until Project Record Documents have been properly annotated.

3.4 INSTALLATION OF PIPING AND EQUIPMENT, GENERAL

A. General:

1. Proceed as rapidly as the building construction will permit.
2. Thoroughly clean items before installation. Cap pipe openings to exclude dirt until fixtures are installed and final connections have been made.
3. Cut pipe accurately, and work into place without springing or forcing, properly clearing windows, doors, and other openings. Excessive cutting or other weakening of the building will not be permitted.
4. Show no tool marks or threads on exposed plated, polished, or enameled connections from fixtures. Tape all finished surfaces to prevent damage during construction.
5. Make changes in directions with fittings; make changes in main sizes with eccentric reducing fittings. Unless otherwise noted, install water supply and return piping with straight side of eccentric fittings at top of the pipe.
6. Run horizontal sanitary and storm drainage piping at a uniform grade of 1/4" per foot, unless otherwise noted. Run horizontal water piping with an adequate pitch upwards in direction of flow to allow complete drainage.
7. Provide sufficient swing joining, ball joining, expansion loops, and devices necessary for a flexible piping system, whether or not shown on the Drawings.
8. Support piping independently at pumps, coils, tanks, and similar locations, so that the equipment will not support weight of pipe.
9. Pipe the drains from pump glands, drip pans, relief valves, air vents, and similar locations, to spill over an open sight drain, floor drain, or other acceptable discharge point, and terminate with a plain end un-threaded pipe 6" above the drain.
10. Securely bolt all equipment, isolators, hangers, and similar items in place.
11. Support each item independently from other pipes. Do not use wire for hanging or strapping pipes.
12. Provide complete dielectric isolation between ferrous and non-ferrous metals.
13. Provide union and shut off valves suitably located to facilitate maintenance and removal of equipment and apparatus.

B. Equipment access:

1. Install piping, equipment, and accessories to permit access for maintenance. Relocate items as necessary to provide such access, and without additional cost to the Owner.
2. Provide access doors where valves, motors or equipment requiring access for maintenance are located in walls or chases or above ceilings. Coordinate location of access doors with other trades as required.

3.5 PIPE JOINTS

A. Copper tubing:

1. Cut square, remove burrs, and clean inside of female fitting to a bright finish.

- a. Apply solder flux with brush to tubing.
- b. Remove internal parts of solder-end valves prior to soldering.
- 2. Provide dielectric unions at points of connection of copper tubing to ferrous piping and equipment.
- 3. For joining copper tubing, use:
 - a. Water piping 3" and smaller: "lead free solder";
 - b. Water piping larger than 3": "Sil-fos" brazing;
 - c. Underground: "sil-fos" brazing.
- B. Screwed piping:
 - 1. Deburr cuts.
 - a. Do not ream exceeding internal diameter of the pipe.
 - b. Thread to requirements of ANSI B2.1.
 - 2. Use teflon tape on male thread prior to joining other services.
- C. Leaky joints:
 - 1. Remake with new material.
 - 2. Remove leaking section and/or fitting as directed.
 - 3. Do not use thread cement or sealant to tighten joint.

3.6 PIPE SUPPORTS

- A. For Installation Guidelines, see Section 220529 PIPE HANGERS AND SUPPORTS
- B. Provide seismic bracing as required per B-Line's Seismic Restraint Design Booklet.
- C. Provide hard insulation inserts at hangers and rollers. Protect insulation inserts with galvanized steel shields.

3.7 SLEEVES AND OPENINGS

- A. Provide sleeves for each pipe passing through walls, partitions, floors, roofs, and ceilings.
 - 1. Set pipe sleeves in place before concrete is placed.
 - 2. For un-insulated pipe, provide sleeves two pipe sizes larger than the pipe passing through, or provide a minimum of 1/2" and maximum of 1" clearance between inside and outside of the pipe.
 - 3. For insulated pipe, provide sleeves of adequate size to accommodate the full thickness of pipe covering, with clearance for packing and caulking.
- B. Caulk the space between sleeve and pipe or pipe covering, using a noncombustible, permanently plastic, waterproof, non-staining compound which leaves a smooth finished appearance, or pack with noncombustible asbestos cotton, rope, or fiberglass to within 1/2" of both wall faces, and provide the waterproof compound described above.
- C. Finish and escutcheons:
 - 1. Smooth up rough edges around sleeves with plaster or spackling compound.
 - 2. Provide 1" wide chrome or nickel plated escutcheons on all pipes exposed to view where passing through walls, floors, partitions, ceilings, and similar locations.

- a. Size the escutcheons to fit pipe and covering.
- b. Hold escutcheons in place with setscrew.

3.8 INSULATION

- A. Install insulation products in accordance with manufacturer's directions.
- B. Provide equivalent thickness insulation for all fittings, flanges, strainers, and valves and finish with pre-molded PVC fitting covers, and for piping below 60F, ensure the vapor barrier remains properly sealed.
- C. Finish insulation neatly at hangers, supports and other protrusions.
- D. Terminate insulation neatly with mastic troweled on bevel.
- E. Do not insulate flexible connections, expansion joints, or seismic joints except on chilled water systems.

3.9 CLEANOUTS

- A. Secure the Architect's approval of locations for cleanouts in finished areas prior to installation.
- B. Provide cleanouts of same nominal size as the pipes they serve; except where cleanouts are required in pipes 4" and larger provide 4" cleanouts.
- C. Make cleanouts accessible. After pressure tests are made and approved, thoroughly graphite the cleanout threads.

3.10 VALVES

- A. Provide valves in water, air, and gas systems in at least the following locations:
 - 1. In branches and/or headers of water piping serving a group of fixtures.
 - 2. On both sides of apparatus and equipment.
 - 3. For shutoff of risers and branch mains.
 - 4. For flushing and sterilizing the system.
 - 5. Where shown on the Drawings.
- B. Locate valves for easy accessibility and maintenance.

3.11 WATER HAMMER ARRESTORS

- A. Provide water hammer arrestors on hot water lines and cold water lines.
 - 1. Install in upright position at all quick closing valves, solenoids, isolated plumbing fixtures, and supply headers at plumbing fixture groups.
 - 2. Locate and size as specified or as shown on the Drawings.
 - 3. Install water hammer arrestors behind access panels.

3.12 BLACKFLOW PREVENTION

- A. Protect plumbing fixtures, faucets with hose connections, and other equipment having plumbing connection, against possible back-siphonage.
- B. Arrange for testing of backflow devices as required by the governmental agencies having jurisdiction.

3.13 DISINFECTION OF WATER SYSTEMS

- A. Disinfect hot and cold water systems.
 - 1. Perform disinfection under the Architect's observation. Notify the Architect at least 48 hours prior to start of the disinfection process.
 - 2. Upon completion of disinfecting, secure and submit the Certificate of Performance required under Article 1.3 of this Section, stating system capacity, disinfectant used, time and rate of disinfectant applied, and resultant residuals in ppm at completion.
 - 3. Use disinfectant method approved by the Architect.
- B. When disinfection operation is completed, and after final flushing, secure an analysis by a laboratory approved by the Architect, based on water samples from the system, showing test negative for coli-aerogene organisms. Provide a total plate count of less than 100 bacteria per cc, or equal to the control sample.
- C. If analysis results are not satisfactory, repeat the disinfection procedures and retest until specified standards are achieved.

3.14 OTHER TESTING AND ADJUSTING

- A. Provide personnel and equipment, and arrange for all required tests and inspections required by governmental agencies having jurisdiction.
- B. Where tests show materials or workmanship to be deficient, replace or repair as necessary, and repeat the tests until the specified standards are achieved.
- C. Adjust the system to optimum standards of operation.

END OF SECTION 22 40 00

^{A6} **SECTION 23 21 13 - HYDRONIC PIPING**

PART 1 - GENERAL

1.1 RELATED DOCUMENTS

- A. The requirements of the GENERAL CONDITIONS, SUPPLEMENTAL CONDITIONS, and DIVISION 1, GENERAL REQUIREMENTS, apply to the work of this SECTION.

1.2 SUMMARY

- A. Section Includes:
 - 1. Piping
 - 2. Special Duty Valves
 - 3. Hydronic Specialties for chilled water
 - 4. Hydronic Specialties for hot water
 - 5. Condensate drain piping
 - 6. Plastic pipe and fittings.
 - 7. Insulation

1.3 ACTION SUBMITTALS

- A. Product Data: For the following:
 - 1. For each type of special-duty valve indicated. Include flow and pressure drop curves based on manufacturer's testing for diverting fittings, calibrated balancing valves, and automatic flow-control valves
 - 2. Pipe insulation
 - 3. Pre-insulated piping
 - 4. Hydronic piping
 - 5. Substitutions acceptable.

1.4 INFORMATIONAL SUBMITTALS

- A. Profile Drawings: Show system piping in elevation. Show types, sizes, materials, and elevations of other utilities crossing hydronic piping.
- B. Qualification Data: For qualified Installer.
- C. Maintenance Data: For hydronic specialties and special-duty valves to include in maintenance manuals specified in Division 1.

1.5 QUALITY ASSURANCE

- A. Fusion piping: Certify that each installer has been trained by the manufacturer's representative for fusion piping installation.

- B. Welding: Qualify processes and operators according to the ASME Boiler and Pressure Vessel Code: Section IX, "Welding and Brazing Qualifications."
- C. ASME Compliance: Comply with ASME B31.9, "Building Services Piping," for materials, products, and installation. Safety valves and pressure vessels shall bear the appropriate ASME label. Fabricate and stamp air separators and expansion tanks to comply with the ASME Boiler and Pressure Vessel Code, Section VIII, Division 1.

1.6 COORDINATION

- A. Coordinate layout and installation of hydronic piping and suspension system components with other construction, including light fixtures, HVAC equipment, fire suppression system components, and partition assemblies.
- B. Coordinate pipe sleeve installations for foundation wall penetrations.
- C. Coordinate piping installation with roof curbs, equipment supports, and roof penetrations.
- D. Coordinate pipe fitting pressure classes with products specified in related Sections.
- E. Coordinate size and location of concrete bases.
- F. Coordinate installation of pipe sleeves for penetrations through exterior walls and floor assemblies.

PART 2 - PRODUCTS

2.1 MANUFACTURERS

- A. Available Manufacturers: Subject to compliance with requirements, manufacturers offering products that may be incorporated into the Work include, but are not limited to, the following:
 - 1. Calibrated Balancing Valves:
 - a. Armstrong Pumps, Inc.
 - b. Flow Design, Inc.
 - c. Nexus.
 - d. Griswold Controls.
 - e. ITT Bell & Gossett; ITT Fluid Technology Corp.
 - f. Taco, Inc.
 - g. Or equal.
 - 2. Pressure-Reducing Valves:
 - a. Amtrol, Inc.
 - b. Armstrong Pumps, Inc.
 - c. Conbraco Industries, Inc.
 - d. ITT Bell & Gossett; ITT Fluid Technology Corp.
 - e. Spence Engineering Company, Inc.
 - f. Watts Industries, Inc.; Watts Regulators.

- g. Or equal.
- 3. Safety Valves:
 - a. Amtrol, Inc.
 - b. Armstrong Pumps, Inc.
 - c. Conbraco Industries, Inc.
 - d. ITT McDonnell & Miller Div.; ITT Fluid Technology Corp.
 - e. Kunkle Valve Division.
 - f. Spence Engineering Company. Inc.
 - g. Or equal.
- 4. Expansion Tanks:
 - a. Amtrol, Inc.
 - b. Armstrong Pumps, Inc.
 - c. ITT Bell & Gossett; ITT Fluid Technology Corp.
 - d. Taco, Inc.
 - e. Wessels & Elbi
 - f. Or equal.
- 5. Air Separators and Air Purgers:
 - a. Amtrol, Inc.
 - b. Armstrong Pumps, Inc.
 - c. ITT Bell & Gossett; ITT Fluid Technology Corp.
 - d. Taco, Inc.
 - e. Or equal.
- 6. Strainers
 - a. Keckley
 - b. Muller Brass Company
 - c. Or equal.

2.2 PIPING MATERIALS

A. COPPER TUBE AND FITTINGS

- 1. Drawn-Temper Copper Tubing: ASTM B 88, Type L.
- 2. Annealed-Temper Copper Tubing: ASTM B 88, Type K.
- 3. Wrought-Copper Fittings: ASME B16.22.
- 4. Wrought-Copper Unions: ASME B16.22.
- 5. Solder Filler Metals: ASTM B 32, 95-5 tin antimony.
- 6. Viega ProPress.

B. STEEL PIPE AND FITTINGS

- 1. Steel Pipe, NPS 2 and Smaller: ASTM A 53, grade B, Schedule 40, black steel, plain ends.
- 2. Steel Pipe, NPS 2-1/2 through NPS 12: ASTM A 53, grade B, Schedule 40, black steel, plain ends.
- 3. Cast-Iron Threaded Fittings: ASME B16.4; Classes 125 and 250.
- 4. Malleable-Iron Threaded Fittings: ASME B16.3; Classes 150 and 300.
- 5. Malleable-Iron Unions: ASME B16.39; Classes 150, 250, and 300.
- 6. Cast-Iron Pipe Flanges and Flanged Fittings: ASME B16.1; Classes 25, 125, and 250, raised ground face, and bolt holes spot faced.
- 7. Wrought-Steel Fittings: ASTM A 234/A 234M, wall thickness to match adjoining pipe.

8. Wrought Cast- and Forged-Steel Flanges and Flanged Fittings: ASME B16.5, including bolts, nuts, and gaskets of the following material group, end connections, and facings:
 - a. Material Group: 1.1.
 - b. End Connections: Butt welding.
 - c. Facings: Raised face.
9. Welding Materials: Comply with Section II, Part C. of the ASME Boiler and Pressure Vessel Code for welding materials appropriate for wall thickness and for chemical analysis of pipe being welded.
10. Gasket Material: Thickness, material, and type suitable for fluid to be handled; and design temperatures and pressures.

C. POLYPROPYLENE (PP-R) PIPE AND FITTINGS FOR WATER DISTRIBUTION AND WATER SERVICE

1. Pipe shall be manufactured from a PP-R resin (Fusiolen) meeting the short-term properties and long-term strength requirements of ASTM F 2389. The pipe shall contain no rework or recycled materials except that generated in the manufacturer's own plant from resin of the same specification from the same raw material. All pipe shall be made in an extrusion process. Domestic hot water shall contain a fiber layer (faser) to restrict thermal expansion. All pipe shall comply with the rated pressure requirements of ASTM F 2389. All pipe shall be certified by NSF International as complying with NSF 14, NSF 61, and ASTM F 2389 or CSA B137.11.
2. Pipe shall be Aquatherm® Blue Pipe® MF® available from Aquatherm or equal manufacturer.
3. Fittings shall be manufactured from a PP-R resin (Fusiolen) meeting the short-term properties and long-term strength requirements of ASTM F 2389. The fittings shall contain no rework or recycled materials except that generated in the manufacturer's own plant from resin of the same specification from the same raw material. All fittings shall be certified by NSF International as complying with NSF 14, NSF 61, and ASTM F 2389 or CSA B137.11.
4. Polypropylene Fittings: socket fusion, butt fusion, electrofusion, or fusion outlet fittings shall be used for fusion weld joints between pipe and fittings.
5. Mechanical fittings and transition fittings shall be used where transitions are made to other piping materials or to valves and appurtenances.
6. Polypropylene pipe shall not be threaded. Threaded transition fittings per ASTM F 2389 shall be used where a threaded connection is required.
7. Polypropylene pipe used for hot water distribution shall include a fiberglass-reinforced layer to reduce thermal expansion/contraction.
8. Plastic, Pipe-Flange Gasket, Bolts, and Nuts: Type and material recommended by piping system manufacturer unless otherwise indicated.
9. Plastic-to-Metal Transition Fittings shall be the following:
 - a. PP-R one-piece fitting with threaded stainless steel, brass, or copper insert and one PP-R fusion weld joint end.

2.3 VALVES

- A. Gate, globe, check, ball, and butterfly valves are specified in Section 23 0523 "General- duty Valves for HVAC Piping."

- B. Refer to Part 3 "Valve Applications" Article for applications of each valve.
- C. Calibrated Balancing valves, N PS 2 and Smaller: Bronze body, ball type, 125-psig working pressure, 250 deg F maximum operating temperature, and having threaded ends. Valves shall have calibrated orifice or venturi, connections for portable differential pressure meter with integral seals, and be equipped with a memory stop to retain set position.
- D. Calibrated Balancing Valves, NPS 2-1/2 and Larger: Cast-iron or steel body, ball type, 125- psig working pressure, 250 deg F maximum operating temperature, and having flanged connections. Valves shall have calibrated orifice or venturi, connections for portable differential pressure meter with integral seals, and be equipped with a memory stop to retain set position.
- E. Pressure-Reducing Valves: Diaphragm-operated, bronze or brass body with low inlet pressure check valve, inlet strainer removable without system shutdown, and noncorrosive valve seat and stem. Select valve size, capacity, and operating pressure to suit system. Valve shall be factory set at operating pressure and have capability for field adjustment.
- F. Safety Valves: Diaphragm-operated, bronze or brass body with brass and rubber, wetted, internal working parts shall suit system pressure and heat capacity and shall comply with the ASME Boiler and Pressure Vessel Code, Section IV.

2.4 HYDRONIC SPECIALTIES

- A. Manual Air Vent: 1-piece 1/4 turn ball valve with 1/2" threaded connections.
- B. Automatic Air Vent: Designed to vent automatically with float principle, bronze body and nonferrous internal parts, 150-psig working pressure, 240 deg F operating temperature with NPS 1/4 discharge connection and NPS 1/2 inlet connection.
- C. Expansion Tanks: Welded carbon steel, rated for 125-psig working pressure and 240 deg F maximum operating temperature. Separate air charge from system water to maintain design expansion capacity by a flexible bladder securely sealed into tank. Include drain fitting and taps for pressure gage and air-charging fitting. Support vertical tanks with steel legs or base; support horizontal tanks with steel saddles. Factory fabricate and test tank
- D. with taps and supports installed and labeled according to the ASME Boiler and Pressure Vessel Code, Section VIII, Division 1.
- E. Air Purgers: Cast-Iron body with internal baffles that slow the water velocity to separate the air from solution and divert it to the vent for quick removal; Maximum working pressure of 150 psig and temperature of 250 deg F.
- F. Bypass Chemical Feeder: Welded steel construction, 125-psig working pressure, 2 gallon capacity, with inlet, outlet, and drain valves.

- G. Chemicals: Specially formulated, based on analysis of makeup water, to prevent accumulation of scale and corrosion in piping and connected equipment.
- H. Strainers shall be Keckley, Mueller Brass Company, Or equal, installed where shown on drawings or as required by the specifications.
- I. Strainers 2 inches and smaller shall be a wye-type, basket strainer. With 1/16- iinch mesh. Provide bronze body with soldered or threaded connections as required.
- J. Strainers 2-1/2-inch and larger shall be wye-type basket strainer with cast iron body, and type 304 stainless steel cylindrical removable baskets with 1/1-inch diameter perforations. Provide with grooved or flanged connections.

2.5 INSULATION

- A. Underground Piping
 - 1. Spray-on Pipe Insulation
 - a. Insulation shall be polyurethane foam or polyisocyanurate foam spray applied to the surface of the pipe with a minimum thickness of one inch. Insulation shall be rigid when dried, 90-95% closed cell polyurethane or polyisocyanurate with a 2.0 to 3.0 pounds per cubic foot density and coefficient of thermal conductivity (K- Factor) of 0.16 and shall conform to ASTM C-591.
 - 2. Pre- or post-insulated Pipe
 - a. Pre-insulated pipe shall be a complete system of factory pre-insulated polypropylene piping for the specified service.
 - b. Carrier pipe shall be polypropylene PP-R by Aquatherm, conforming to ASTM F-2389 as previously specified herein.
 - c. Insulation shall be polyurethane foam with a minimum thickness per material specifications on plans. Insulation shall be rigid, 90-95% closed cell polyurethane with a 2.0 to 3.0 pounds per cubic foot density and coefficient of thermal conductivity (K- Factor) of 0.16 and shall conform to ASTM C-591.
 - d. Manufacturers: Subject to compliance with requirements,
 - i. Aquatherm TI Pipe
 - ii. Thermacor Process, L.P..
 - iii. Or equal.
 - 3. Jacketing
 - a. Jacketing material shall be high density polyethylene (HDPE) or polyvinyl chloride (PVC), having a minimum wall thickness of 60 mils. Seams to be sealed with pressure sensitive wrap, 30 mils thick.
- B. Above Ground Piping
 - 1. General:

- a. All insulation material shall have a mold, humidity, and erosion resistant face that has met the requirements of the latest CMC.
 - b. Insulation applied to the exterior surface of pipes located in buildings shall have a flame spread of no more than 25 and a smoke developed rating of not more than 50.
2. Rigid Molded Sectional Indoor/Concealed Jacket
- a. Molded sectional, factory fabricated of heavy density resin bonded fibrous glass, with integral factory applied all service jacket of Kraft paper/aluminum foil & glass fiber reinforcement.
 - b. Insulation shall have a thermal conductivity k factor of 0.23 at 75 degrees Fahrenheit mean temperature and be suitable for direct application and service on piping having operating surface temperatures of minus 60 degrees to 450 degrees Fahrenheit.
 - c. Jacket shall:
 - 1) Extend 1 1/2 inches (minimum) along one edge of longitudinal joint to form a sealing lap which shall be faced inside with a paper protected pressure sensitive adhesive.
 - 2) Have a permanence rating of 0.02 perm per inch and a Beach puncture resistance of 50 units
 - d. Have an exterior suitable for painting with latex or water base paint.
 - e. All insulation shall have composite (insulation, jacket, tape seal and adhesive used to adhere jacket to the insulation) Fire and Smoke Hazard ratings as tested under procedure ASTM E-84, NFPA 255 and UL 723, not exceeding Flame Spread of 25 and a Smoke Developed of 50. PVC fitting covers and accessories, such as adhesives, mastics, cements and cloth for fittings shall have the same component ratings.
 - f. Paper laminate jackets shall be permanently flame and smoke resistant. Chemicals used for treating paper in jacket laminates shall not be water soluble and shall be unaffected by water and humidity.
 - g. Fiberglass Schuler Manville Micro Lok, or equal.
 - h. Irregular shape (fittings, flanges, valves, etc.):
 - 1) Fibrous glass of same density, thickness, and other properties or characteristics as the adjacent regular shape insulation either pre-molded or field forged to fit the item being insulated. The pre-molded insulation shall be provided with weather protection cover.
3. Rigid Molded Sectional Outdoor Jacket
- a. Molded sectional, factory fabricated of heavy density resin bonded fibrous glass, with integral factory applied all service jacket of Kraft paper and aluminum foil and glass fiber reinforcement.
 - b. Insulation shall have a thermal conductivity k factor of 0.23 at 75 degrees Fahrenheit mean temperature and be suitable for direct application and service on piping having operating surface temperatures of minus 60 degrees to 450 degrees Fahrenheit.
 - c. Jacket:
 - 1) Straight runs: .016-inches thick smooth sheet aluminum finish.
 - d. Irregular shapes:
 - 1) Surefit Aluminum Pipe Fitting Covers for pipes up to 6-inches.
 - 2) Mitered aluminum sheet matching straight run jacketing for pipes over 6-inches.
 - 3) Alternative jacketing: Schuler Manville Type ML, metal jacketing system.

- e. All insulation shall have composite (insulation, jacket, tape seal and adhesive used to adhere jacket to the insulation) Fire and Smoke Hazard ratings as tested under procedure ASTM E-84, NFPA 255 and UL 723, not exceeding Flame Spread of 25 and a Smoke Developed of 50. PVC fitting covers and accessories, such as adhesives, mastics, cements and cloth for fittings shall have the same component ratings.
- f. Paper laminate jackets shall be permanently flame and smoke resistant. Chemicals used for treating paper in jacket laminates shall not be water soluble and shall be unaffected by water and humidity. Fiberglass Schuler Manville Micro Lok, or equal.

PART 3 - EXECUTION

3.1 EARTHWORK

- A. See Section 31 21 16 "Trenching" for excavating, trenching, and backfilling.

3.2 PIPING INSTALLATION

A. Underground Piping

1. Drawing plans, schematics, and diagrams indicate general location and arrangement of piping systems. Indicate piping locations and arrangements if such were used to size pipe and calculate friction loss, expansion, pump sizing, and other design considerations. Install piping as indicated unless deviations to layout are approved on Coordination Drawings.
2. Installers shall be trained and certified to install the pipe per the manufacturer's guidelines. Contact your local Aquatherm representative for training.
3. Remove standing water in the bottom of trench.
4. Do not backfill piping trench until field quality-control testing has been completed and results approved.
5. Install piping at minimum uniform grade of 0.2 percent. Install manual air vents at high points with concrete yard boxes.
6. Install components with pressure rating equal to or greater than system operating pressure.
7. Install piping free of sags and bends.
8. Install fittings for changes in direction and branch connections.
9. Thrust blocks shall not be required with PP-R piping.
10. Expansion loops shall not be required for direct buried underground PP-R piping.

B. Above Ground Piping

1. Install groups of pipes parallel to each other, spaced to permit applying insulation and servicing of valves.
2. Install drains, consisting of a tee fitting, NPS 3/4 ball valve, and short NPS 3/4 threaded nipple with cap, at low points in piping system mains and elsewhere as required for system drainage.
3. Reduce pipe sizes using reducer fitting.
4. Unless otherwise indicated, install branch connections to mains using tee fittings or mechanical formed tees in main pipe.

5. Install piping free of sags and bends.
6. Install fittings for changes in direction and branch connections.

3.3 HANGERS AND SUPPORTS

- A. Hanger, support, and anchor devices are specified in Section 23 05 29 "Hangers and Supports for HVAC Piping and Equipment." Comply with requirements below for maximum spacing of supports. Add additional hangers as required to comply with California Building Codes and as directed by the Authority having jurisdiction.
- B. Support vertical runs at roof, at each floor.

3.4 PIPE JOINT CONSTRUCTION

- A. Refer to Section 22 05 00 "Basic Mechanical Materials and Methods" for joint construction requirements for soldered and brazed joints in copper tubing; grooved, threaded, welded and flanged joints in steel piping.
- B. Fusion Piping
 1. Ream ends of pipes and tubes and remove burrs.
 2. Remove scale, slag, dirt, and debris from inside and outside of pipe and fittings before assembly.
 3. Fusion Joints: Fusion join polypropylene pipe in accordance with ASTM D2657, ASTM F 2389, and the manufacturer's instructions.
 4. Flanged Joints: Select appropriate gasket material, size, type, and thickness for service application. Install gasket concentrically positioned. Use suitable lubricants on bolt threads.
 5. Insulation joints made for pre-insulated pipe shall be done in accordance with the insulation manufacturer's instructions.

3.5 HYDRONIC SPECIALTIES INSTALLATION

- A. Install manual air vents at high points in piping, at heat-transfer coils, and elsewhere as required for system air venting.
- B. Install automatic air vents in mechanical equipment rooms only at high points of system piping, and elsewhere as required for system air venting.
- C. Install air separator or air scoop in closed hydronic systems where indicated on the drawings.
- D. Install bypass chemical feeders in each hydronic system where indicated, in upright position. Install feeder in bypass line, off main, using ball valves on each side of feeder and in the main between bypass connections. Pipe drain with ball valve.
- E. Install expansion tanks where indicated. Vent and purge air from hydronic system and ensure tank is properly charged with air to suit system design requirements.

3.6 TERMINAL EQUIPMENT CONNECTIONS

- A. Size for supply and return piping connections shall be same as for equipment connections.
- B. Install control valves in accessible locations close to connected equipment.
- C. Install ports for pressure and temperature gages at coil inlet connections.

3.7 FIELD APPLIED THERMAL INSULATION INSTALLATION

- A. Do not disturb the bottom of trench; otherwise, compact and stabilize it to ensure proper support.
- B. Remove standing water in the bottom of trench.
- C. Bed the pipe on a minimum 6-inch layer of granular fill material (sand) with a minimum 6-inch clearance between the pipes.
- D. Insulation and jacketing shall be applied to the piping in 10' segments (maximum)
- E. After completion, the segments are rotated 180o and the bottom of the jacketing and butt strips are inspected. Any defects or damage shall be replaced with new insulation.
- F. Jacketing and insulations joints shall be staggered.
- G. In larger diameter piping shorter segments can be insulated and jacketed if more practical.
- H. Where conditions permit, insulation and jacketing may be applied outside of the trench to sections of piping. Pipe lengths should be insulated in segments. Length of insulation segment should not exceed 10' (3 m).
- I. Backfill per manufacturer's instructions.

3.8 IDENTIFICATION

- A. Refer to Section 22 05 00 "Basic Mechanical Materials and Methods"
- B. Install continuous metallic/plastic underground warning tapes during back filling of trenches for underground hydronic piping. Locate tapes 6 to 8 inches below finished grade, directly over piping. Alternatively install 8 – 10 gage copper wire at 6" – 8" directly over the pipeline. Provide warning tapes above the wire at 6" to 8" below the finished grade directly over the pipeline.

3.9 FIELD QUALITY CONTROL

- A. Use ambient temperature water as a testing medium unless there is risk of damage due to freezing, another liquid that is safe for workers and compatible with piping may be used.
- B. While filling system, use vents installed at high points of system to release trapped air. Use drains installed at low points for complete draining of liquid.
- C. Check expansion tanks to determine that they are not air bound and that system is full of water.
- D. Subject piping system to hydrostatic test pressure that is not less than 1.5 times the design pressure. Test pressure shall not exceed maximum pressure for any vessel, pump, valve, or other component in system under test. Verify that stress due to pressure at bottom of vertical runs does not exceed either 90 percent of specified minimum yield strength or 1.7 times "SE" value in Appendix A of ASME B31.9, "Building Services Piping."
- E. After hydrostatic test pressure has been applied for at least 4 hours, examine piping, joints, and connections for leakage, eliminate leaks by tightening, repairing, or replacing components, and repeat hydrostatic test until there are no leaks.
- F. Prepare written report of testing.

3.10 ADJUSTING

- A. Mark calibrated nameplates of pump discharge valves after hydronic system balancing has been completed, to permanently indicate final balanced position.
- B. Perform these adjustments before operating the system:
 - 1. Open valves to fully open position. Close all bypass valves.
 - 2. Check pump for proper direction of rotation.
 - 3. Set automatic fill valves for required system pressure.
 - 4. Check air vents at high points of system and determine if all are installed and operating freely (automatic type), or bleed air completely (manual type).

END OF SECTION 23 21 13^{A6}

SECTION 32 90 00

PLANTING

PART 1 - GENERAL

1.01 RELATED DOCUMENTS

- A. Drawings and general provisions of the Contract, including General and Supplementary Conditions and Division 1 Specification Sections, apply to this Section.

1.02 SECTION INCLUDES

- A. Trees.
- B. Shrubs.
- C. Ground covers.
- D. Plants.
- E. Topsoil and soil amendments.
- F. Fertilizers and mulches.
- G. Stakes and guys.
- H. Landscape edgings.

1.03 MEASUREMENT AND PAYMENT

- A. Payment of the various Construction Items described in the Schedule of Values shall be considered full compensation for work of this Section.
- B. Unit prices for soil preparation and for items that include backfill mixes shall be adjusted to reflect changes due to the requirements of soil lab recommendation.

1.04 RELATED SECTIONS

- A. Section 32 80 00 – Irrigation: Coordination with head, pipe, and equipment locations.
- B. Section 31 22 19 – Finish Grading: Topsoil

1.05 SUBMITTALS


- A. General: Submit each item in this Article according to the Conditions of the Contract and Division 1 Specification Sections.
- B. Materials List:
 - 1. Within 15 days of Award, submit documentation that specified plants have been ordered. Include names and addresses of suppliers.
 - 2. Submit requests for substitutions with materials list.
- C. Delivery Tickets:
 - 1. Submit for all plants installed as part of the Project.

- 2. Include full botanical and common names of all plants.
- D. Product Data - Submit data on the following:
 - 1. Soil amendments.
 - 2. Herbicides.
 - 3. Fertilizers.
 - 4. Substitutions for specified accessories.
 - 5. Root Barrier.
- E. Product certificates signed by manufacturers certifying that their products comply with specified requirements.
 - 1. Manufacturer's certified analysis for standard products.
 - 2. Analysis for other materials by a recognized laboratory made according to methods established by the Association of Official Analytical Chemists, where applicable.
 - 3. Label data substantiating that plants, trees, shrubs, and planting materials comply with specified requirements.
- F. Material test reports from qualified independent testing agency indicating and interpreting test results relative to compliance of the following materials with requirements indicated.
 - 1. Analysis of existing surface soil.
 - 2. Analysis of imported topsoil.
- G. Samples of each of the following:
 - 1. 1 lb of mineral mulch for each color and texture of stone required for Project, in labeled plastic bags.
 - 2. Submit a 1 quart sample of the following. Indicate supplier.
 - A) Organic matter.
 - B) Mulch.
 - C) Edging materials and accessories to verify color selection.
- H. Planting schedule indicating anticipated dates and locations for each type of planting.

A6

1.06

I. Test Reports: Submit soil test results and recommendations.

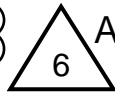

- A. Installer Qualifications: Engage an experienced Installer who has completed landscaping work similar in material, design, and extent to that indicated for this Project and with a record of successful landscape establishment.
 - 1. Installer's Field Supervision: Require Installer to maintain an experienced full-time supervisor on the Project site during times that landscaping is in progress.
- B. Provide quality, size, genus, species, and variety of trees and shrubs indicated, complying with applicable requirements of ANSI Z60.1 "American Standard for Nursery Stock."
- C. Plant nomenclature shall conform to that used in New Sunset Western Garden Book, 2000 edition or later, published by Sunset Publishing Corporation. Names and varieties not listed in this reference shall be those most commonly used in the nursery trade.
- D. Topsoil Analysis: Furnish a soil analysis made by a qualified independent soil-testing agency stating percentages of organic matter, inorganic matter (silt, clay, and sand), deleterious material, pH, and mineral and plant-nutrient content of topsoil.

1. Report suitability of topsoil for growth of applicable planting material. State recommended quantities of nitrogen, phosphorus, and potash nutrients and any limestone, aluminum sulfate, or other soil amendments to be added to produce satisfactory topsoil.

- E. Measurements: Measure trees and shrubs according to ANSI Z60.1 with branches and trunks or canes in their normal position. Do not prune to obtain required sizes. Take caliper measurements 6 inches above ground for trees up to 4-inch caliper size, and 12 inches above ground for larger sizes. Measure main body of tree or shrub for height and spread; do not measure branches or roots tip-to-tip.
- F. Herbicides shall be applied by licensed applicator. Submit name, address, and license number of application firm.

1.07 DELIVERY, STORAGE, AND HANDLING

- A. Packaged Materials: Deliver packaged materials in containers showing weight, analysis, and name of manufacturer. Protect materials from deterioration during delivery and while stored at site.
- B. Trees and Shrubs: Deliver trees and shrubs in sizes as indicated in the drawings. Do not prune before delivery, except as approved by Landscape Architect. Protect bark, branches, and root systems from sun scald, drying, sweating, whipping, and other handling and tying damage. Do not bend or bind-tie trees or shrubs in such a manner as to destroy natural shape. Provide protective covering during delivery. Do not drop trees and shrubs during delivery.
- C. Deliver trees, shrubs, ground covers, and plants after preparations for planting have been completed and install immediately. If planting is delayed more than 6 hours after delivery, set planting materials in shade, protect from weather and mechanical damage, and keep roots moist.
 - 1. Do not remove container-grown stock from containers before time of planting.
 - 2. Water root systems of trees and shrubs stored on site with a fine-mist spray. Water as often as necessary to maintain root systems in a moist condition.

1.08 PROJECT CONDITIONS

- A. Utilities: Determine location of above grade and underground utilities and perform work in a manner which will avoid damage. Hand excavate, as required. Maintain grade stakes until removal is mutually agreed upon by parties concerned.
- B. Excavation: When conditions detrimental to plant growth are encountered, such as rubble fill, adverse drainage conditions, or obstructions, notify Landscape Architect before planting.
- C. Planting operations shall not be conducted under the following conditions:
 - 1. Freezing weather.
 - 2. Excessive heat.
 - 3. High winds.
 - 4. Excessively wet conditions.

1.09 SEQUENCING AND SCHEDULING

- A. Coordinate planting operations with other construction to avoid damage to plants by other trades.

1.10 WARRANTY

- A. General Warranty: The special warranty specified in this Article shall not deprive the Owner of other rights the Owner may have under other provisions of the Contract Documents and shall be in addition to, and run concurrent with, other warranties made by the Contractor under requirements of the Contract Documents.

- B. Special Warranty: Warrant the following living planting materials for the following specified time period after date of Substantial Completion, against defects including death and unsatisfactory growth, except for defects resulting from lack of adequate maintenance, neglect, or abuse by Owner, abnormal weather conditions unusual for warranty period, or incidents that are beyond Contractor's control.
 - 1. Trees – 1 year.
 - 2. Shrubs – 1 year.
 - 3. Ground covers – Length of maintenance period.
- C. Remove and replace dead planting materials immediately unless required to plant in the succeeding planting season.
- D. Replace planting materials that are in a substantially unhealthy condition (more than 25 percent of the plant dead or removed due to death of branches, etc.) at end of warranty period.
- E. A limit of one replacement of each plant material will be required, except for losses or replacements due to failure to comply with requirements.

1.11 MAINTENANCE

- A. Maintain trees, shrubs, groundcovers, and lawns by pruning, cultivating, watering, weeding, fertilizing, restoring planting saucers, tightening and repairing stakes and guy supports, and resetting to proper grades or vertical position, as required to establish healthy, viable plantings. Spray as required to keep trees and shrubs free of insects and disease. Time period of the maintenance periods as specified on the drawings, or if not specified then a minimum of 3 months (90 days).

PART 2 - PRODUCTS

2.01 TREE AND SHRUB MATERIAL

- A. General: Furnish nursery-grown trees and shrubs conforming to ANSI Z60.1, with healthy root systems developed by transplanting or root pruning. Provide well-shaped, fully-branched, healthy, vigorous stock free of disease, insects, eggs, larvae, and defects such as knots, sun scald, injuries, abrasions, and disfigurement.
- B. Grade: Provide trees and shrubs of sizes and grades conforming to ANSI Z60.1 for type of trees and shrubs required. Trees and shrubs of a larger size may be used if acceptable to Landscape Architect.
- C. Label at least 1 tree and 1 shrub of each variety and caliper with a securely attached, waterproof tag bearing legible designation of botanical and common name.

2.02 GROUND COVERS AND PLANTS

- A. Provide ground covers and plants established and well rooted in removable containers or integral peat pots and with not less than the minimum number and length of runners required by ANSI Z60.1 for the pot size indicated.

2.03 TOPSOIL

- A. Topsoil: ASTM D 5268, pH range of 5.5 to 7, 4 percent organic material minimum, free of stones 1 inch or larger in any dimension, and other extraneous materials harmful to plant growth. Any topsoil added shall be thoroughly mixed with the existing site soil to a depth of 12" minimum (unless otherwise noted on drawings).
 - 1. Topsoil Source: Amend existing surface soil to produce topsoil. Supplement with imported topsoil when required.

2.04 SOIL AMENDMENTS

- A. Lime: ASTM C 602, Class T, agricultural limestone containing a minimum 80 percent calcium carbonate equivalent, with a minimum 99 percent passing a No. 8 sieve and a minimum 75 percent passing a No. 60 sieve.
 - 1. Provide lime in the form of dolomitic limestone.
- B. Aluminum Sulfate: Commercial grade, unadulterated.
- C. Sand: Clean, washed, natural or manufactured sand, free of toxic materials.
- D. Perlite: Horticultural perlite, soil amendment grade.
- E. Peat Humus: Finely divided or granular texture, with a pH range of 6 to 7.5, composed of partially decomposed moss peat (other than sphagnum), peat humus, or reed-sedge peat.
- F. Sawdust or Ground-Bark Humus: Decomposed, nitrogen-treated, of uniform texture, free of chips, stones, sticks, soil, or toxic materials.
- G. Manure: Well-rotted, un-leached stable or cattle manure containing not more than 25 percent by volume of straw, sawdust, or other bedding materials; free of toxic substances, stones, sticks, soil, weed seed, and material harmful to plant growth.

2.05 HERBICIDES

- A. EPA registered and approved, of type recommended by manufacturer.
- B. Post-emergent: Roundup or approved equal.
- C. Pre-emergent: Ronstar G, Dimension 270 TG or approved equal.

2.06 FERTILIZER

- A. Bonemeal: Commercial, raw, finely ground; minimum of 4 percent nitrogen and 20 percent phosphoric acid.
- B. Commercial Fertilizer: Commercial-grade complete fertilizer of neutral character, consisting of fast- and slow-release nitrogen, 50 percent derived from natural organic sources of urea-form, phosphorous, and potassium in the compositions as indicated on the drawings or as recommended by the soil test (soil test recommendation to take precedence over drawings).

2.07 MULCHES

- A. Organic Mulch: Organic mulch, free from deleterious materials and suitable as a top dressing of trees and shrubs, consisting of one of the following:
 - 1. Type: Wood and bark chips – refer to drawings.
- B. Mineral Mulch: Hard, durable stone, washed free from loam, sand, clay, and other foreign substances, of following type, size range, and color:
 - 1. Rounded riverbed gravel or smooth faced stone.
 - 2. Crushed stone or gravel. – per plans.

2.08 STAKES AND GUYS

- A. Upright: Rough-sawn, sound, new hardwood, redwood, or pressure-preservative-treated softwood, free of knots, holes, cross grain, and other defects, 2 by 2 inches by length indicated, pointed at one end.

- B. Hose Chafing Guard: Reinforced rubber or plastic hose at least 1/2 inch in diameter, black, cut to lengths required to protect tree trunks from damage.

2.09 LANDSCAPE EDGINGS

- A. Edging: Refer to drawings.

2.10 ROOT BARRIER

- A. Deep Root - Refer to drawings

PART 3 - EXECUTION

3.01 EXAMINATION

- A. Examine areas to receive landscaping for compliance with requirements and for conditions affecting performance of work of this Section. Do not proceed with installation until unsatisfactory conditions have been corrected.
- B. Start of work shall indicate Contractor's acceptance of existing conditions.

3.02 PREPARATION

- A. Conduct weed control measures as specified in the drawings.
- B. Lay out individual tree and shrub locations and areas for multiple plantings. Stake locations, outline areas, and secure Landscape Architect's acceptance before the start of planting work. Make minor adjustments as may be required.

3.03 PLANTING SOIL PREPARATION

- A. Soil Testing: confirm that required soil testing has been completed and that soil mixes and soil preparation specifications have been revised to reflect the recommendations of the soils laboratory as approved by Landscape Architect.
- B. Before mixing, clean topsoil of roots, plants, sods, stones, clay lumps, and other extraneous materials harmful to plant growth.
- C. Mix soil amendments and fertilizers with topsoil at rates indicated. Delay mixing fertilizer if planting does not follow placing of planting soil within a few days.
- D. For tree pit or trench backfill, mix planting soil before backfilling and stockpile at site.
- E. For planting beds and lawns, mix planting soil either prior to planting or apply on surface of topsoil and mix thoroughly before planting.

3.04 GROUND COVER AND PLANT BED PREPARATION

- A. Till soil in beds to a minimum depth of 12 inches and mix with specified soil amendments and fertilizers.

3.05 EXCAVATION FOR TREES AND SHRUBS

- A. Pits and Trenches: Excavate with vertical sides and with bottom of excavation slightly raised at center to assist drainage. Loosen hard subsoil in bottom of excavation.
 - 1. Container-Grown Trees and Shrubs: Excavate pits twice the width of the container.
- B. Mix subsoil removed from landscape excavations with soil amendment to use as backfill.

- C. Obstructions: Notify Landscape Architect if unexpected rock or obstructions detrimental to trees or shrubs are encountered in excavations.
- D. Drainage: Notify Landscape Architect if subsoil conditions evidence unexpected water seepage or retention in tree or shrub pits.
- E. Fill excavations with water and allow to percolate out before placing setting layer and positioning trees and shrubs.

3.06 PRE-EMERGENT HERBICIDE

- A. Apply herbicides in accordance with manufacturer's recommended rates and procedures.
- B. Apply to soil of all planting bed areas prior to placement of mulch.

3.07 PLANTING TREES AND SHRUBS

- A. Set container-grown stock plumb and in center of pit or trench with top of ball raised above adjacent finish grades as indicated.
 - 1. Carefully remove containers so as not to damage root balls.
 - 2. Place stock on setting layer of compacted planting soil.
 - 3. Place backfill around ball in layers, tamping to settle backfill and eliminate voids and air pockets. When pit is approximately 1/2 backfilled, water thoroughly before placing remainder of backfill. Repeat watering until no more is absorbed. Water again after placing and tamping final layer of backfill.
- B. Dish and tamp top of backfill to form a 3-inch-high mound around the rim of the pit (not in turf). Do not cover top of root ball with backfill.

3.08 TREE AND SHRUB PRUNING

- A. Prune, thin, and shape trees and shrubs as directed by Landscape Architect.

3.09 TREE AND SHRUB GUYING AND STAKING

- A. Upright Staking and Tying: Use a minimum of 2 stakes of length required to penetrate at least 18 inches below bottom of backfilled excavation and to extend at least 72 inches above grade. Set vertical stakes and space to avoid penetrating balls or root masses. Support trees with 2 strands of tie wire encased in hose sections at contact points with tree trunk. Allow enough slack to avoid rigid restraint of tree. Refer to staking detail in the drawings.

3.10 PLANTING GROUND COVER AND PLANTS

- A. Space ground cover and plants as indicated on the drawings.
- B. Dig holes large enough to allow spreading of roots, and backfill with planting soil. Work soil around roots to eliminate air pockets and leave a slight saucer indentation around plants to hold water. Water thoroughly after planting, taking care not to cover plant crowns with wet soil.

3.11 MULCHING

- A. Mulch backfilled surfaces of pits, trenches, planted areas, and other areas indicated.
- B. Mulch: Apply the following average thickness of mulch per plans and finish level with adjacent finish grades. Do not place mulch against trunks or stems.
 - 1. Thickness: As indicated on drawings.

3.12 INSTALLATION OF EDGINGS

- A. Steel Edging: Install steel headers or edgings where indicated and per the manufacturer's specifications.

3.13 CLEANUP AND PROTECTION

- A. During landscaping, keep pavements clean and work area in an orderly condition.
- B. Protect landscaping from damage due to landscape operations, operations by other contractors and trades, and trespassers. Maintain protection during installation and maintenance periods. Treat, repair, or replace damaged landscape work as directed.

3.14 DISPOSAL OF SURPLUS AND WASTE MATERIALS

- A. Disposal: Remove surplus soil and waste material, including excess subsoil, unsuitable soil, trash, and debris, and legally dispose of it off the Owner's property.

END OF SECTION



STYLISTIC RENDERING NOT INTENDED FOR USE IN CONSTRUCTION

CSU STANISLAUS CHILD DEVELOPMENT CENTER PERMIT SET - DSA V2 DECEMBER 15, 2021

CSUS CHILD DEVELOPMENT CENTER

CALIFORNIA STATE
UNIVERSITY, STANISLAUS
ONE UNIVERSITY CIRCLE
TURLOCK, CA 95382



PIER 1, BAY 2
THE EMBARCADERO
SAN FRANCISCO, CA 94111


INFO@EHDD.COM
+1 415-285-9193

ALTERNATES	VICINITY MAP	PROJECT TEAM	SHEET INDEX																																																																																																																																																																																																
<p>SITE ALTERNATES:</p> <ol style="list-style-type: none"> Addition of fire lane extension as shown on C3.1. Alternate fence construction – Replace custom steel fences and gates at all yards with pre-fabricated steel fence shown on callout #17 on Sheets L1.1 and L1.2. Shape and layout of fences and gates to conform to original design. Not used. <p>BUILDING ALTERNATES:</p> <ol style="list-style-type: none"> Change Eomac Veneered Linear Plank Wood ceiling to: Armstrong Wood Works Grille Tegular 663008 2x4 for 9'16" tegular, Light Cherry. Increase PV scope from 72kW system to 157kW, see E6.1. Not used. Add 77 SF of dichroic glazing panels at truss of north roof monitor, see 2/A3.11, A6.01, 7/A9.41, & 08 80 00. 		<p>ARCHITECT</p> <p>EHDD ARCHITECTURE PIER 1 BAY 2 THE EMBARCADERO SAN FRANCISCO, CA 94111 T: (415) 285-9193</p> <p>CIVIL ENGINEER</p> <p>NORTHSTAR ENGINEERING GROUP, INC. 620 12TH ST. MODESTO, CA 95354 T: (209) 524-3525</p> <p>LANDSCAPE ARCHITECT</p> <p>KLA, INC. 151 N. NORLIN ST. SONORA, CA 95370 T: (209) 532-2886</p> <p>FOOD SERVICE DESIGNER</p> <p>CIN-HITTLE INTERNATIONAL, INC. 156 2ND STREET SAN FRANCISCO, CA 94105 T: (415) 922-5900</p> <p>STRUCTURAL ENGINEER</p> <p>MAR STRUCTURAL DESIGN 2332 5TH ST., SUITE D BERKELEY, CA 94710 T: (510) 991-1102</p> <p>MECHANICAL / PLUMBING / FIRE PROTECTION ENGINEER</p> <p>NEXUS ENGINEERING 1400-A LONE PALM AVE, MODESTO, CA 95351 T: (209) 572-7399</p> <p>ELECTRICAL / AV / IT / FIRE ALARM ENGINEER</p> <p>PEZONNI ENGINEERING, INC. 1150 9TH ST., #1415 MODESTO, CA 95354 T: (209) 554-4602</p>	<p>(171 SHEETS TOTAL)</p> <table border="1"> <tr> <td>GENERAL</td> <td>A5.01 INTERIOR ELEVATIONS</td> <td>M3.01 MECHANICAL - OVERALL HVAC PIPING FLOOR PLAN</td> </tr> <tr> <td>G0.01 COVER SHEET AND INDEX</td> <td>A5.02 INTERIOR ELEVATIONS</td> <td>M3.02 MECHANICAL - ENLARGED HVAC PIPING FLOOR PLAN</td> </tr> <tr> <td>G0.02 ARCHITECTURAL ABBREVIATIONS AND SYMBOLS</td> <td>A5.03 INTERIOR ELEVATIONS</td> <td>M3.03 MECHANICAL - ENLARGED HVAC PIPING FLOOR PLAN</td> </tr> <tr> <td>G0.05 PROJECT INFORMATION</td> <td>A6.01 REFLECTED CEILING PLAN</td> <td>M4.01 MECHANICAL - ROOF PLAN</td> </tr> <tr> <td>G0.06 FIRE LIFE SAFETY PLAN</td> <td>A6.02 CEILING SLOPES DIAGRAM</td> <td>M5.01 MECHANICAL - DETAILS</td> </tr> <tr> <td>G0.07 PLUMBING CALCULATIONS</td> <td>A6.11 ENLARGED REFLECTED CEILING PLAN - EXTERIOR SOFFITS</td> <td>M5.02 MECHANICAL - DETAILS</td> </tr> <tr> <td>G0.08 LOCKDOWN PROCESS</td> <td>A6.12 ENLARGED REFLECTED CEILING PLAN - EXTERIOR SOFFITS</td> <td>M5.03 MECHANICAL - DETAILS</td> </tr> <tr> <td>G0.11 CODE SIGNAGE</td> <td>A8.01 BELOW GRADE WATERPROOFING DETAILS</td> <td>M5.04 MECHANICAL - DETAILS</td> </tr> <tr> <td>G0.12 ACCESSIBLE MOUNTING HEIGHTS</td> <td>A8.11 EXTERIOR WALL DETAILS - CEMENT PLASTER</td> <td></td> </tr> <tr> <td>CIVIL</td> <td>A8.21 EXTERIOR STOREFRONT DETAILS</td> <td>TITLE 24</td> </tr> <tr> <td>C1.1 COVER SHEET</td> <td>A8.22 EXTERIOR WINDOW WALL DETAILS</td> <td>T24.01 ENERGY COMPLIANCE</td> </tr> <tr> <td>C1.2 GENERAL NOTES AND SPECIFICATIONS</td> <td>A8.23 EXTERIOR DETAILS</td> <td>T24.02 ENERGY COMPLIANCE</td> </tr> <tr> <td>C1.3 DETAILS AND CROSS SECTIONS</td> <td>A8.24 EXTERIOR SOFFIT DETAILS</td> <td>T24.03 ENERGY COMPLIANCE</td> </tr> <tr> <td>C1.4 DETAILS AND CROSS SECTIONS</td> <td>A8.51 ROOF DETAILS</td> <td>T24.04 ENERGY COMPLIANCE</td> </tr> <tr> <td>C1.5 DETAILS AND CROSS SECTIONS</td> <td>A9.01 WOOD PARTITION TYPES AND FRAMING DETAILS</td> <td></td> </tr> <tr> <td>C1.6 DETAILS AND CROSS SECTIONS</td> <td>A9.02 TYPICAL PARTITION DETAILS</td> <td>PLUMBING</td> </tr> <tr> <td>C1.7 PAVEMENT DELINEATION PLAN</td> <td>A9.11 TYPICAL CEILING DETAILS</td> <td>P0.01 PLUMBING LEGENDS & NOTES</td> </tr> <tr> <td>C2.1 TOPOGRAPHIC AND DEMOLITION PLAN</td> <td>A9.12 CEILING DETAILS</td> <td>P0.02 PLUMBING SCHEDULES & GREEN BUILDING NOTES</td> </tr> <tr> <td>C2.2 TOPOGRAPHIC AND DEMOLITION PLAN</td> <td>A9.21 INTERIOR GLAZING AND DOOR DETAILS</td> <td>P1.01 PLUMBING - OVERALL FLOOR PLAN</td> </tr> <tr> <td>C2.3 TOPOGRAPHIC AND DEMOLITION PLAN</td> <td>A9.31 TYPICAL CASEWORK DETAILS</td> <td>P1.02 PLUMBING - ENLARGED FLOOR PLAN</td> </tr> <tr> <td>C3.1 DIMENSION AND PAVING PLAN</td> <td>A9.32 CASEWORK DETAILS</td> <td>P1.03 PLUMBING - ENLARGED FLOOR PLAN</td> </tr> <tr> <td>C3.2 DIMENSION AND PAVING PLAN</td> <td>A9.33 RECEPTION DESK PLAN AND DETAILS</td> <td>P2.01 PLUMBING - ROOF PLAN</td> </tr> <tr> <td>C3.3 DIMENSION AND PAVING PLAN</td> <td>A9.41 MISC. INTERIOR DETAILS</td> <td>P5.01 PLUMBING - DETAILS</td> </tr> <tr> <td>C4.1 GRADING AND DRAINAGE PLAN</td> <td></td> <td>P5.02 PLUMBING - DETAILS</td> </tr> <tr> <td>C5.1 STORM DRAINAGE PLAN</td> <td>FOOD SERVICE</td> <td></td> </tr> <tr> <td>C6.1 SANITARY SEWER PLAN</td> <td>QF101 FOOD SERVICE EQUIPMENT - PLAN, SCHEDULE AND SPECIAL CONDITIONS</td> <td>FIRE PROTECTION</td> </tr> <tr> <td>C7.1 COMPOSITE UTILITY PLAN</td> <td>QF102 FOOD SERVICE EQUIPMENT - MECHANICAL SPOT CONNECTION PLAN</td> <td>FP1.0 FIRE PROTECTION UNDERGROUND & SITE PLAN</td> </tr> <tr> <td>C7.2 COMPOSITE UTILITY PLAN</td> <td>QF103 FOOD SERVICE EQUIPMENT - ELECTRICAL SPOT CONNECTION PLAN</td> <td>FP2.0 FIRE PROTECTION OVERHEAD PIPING PLAN</td> </tr> <tr> <td>C7.3 COMPOSITE UTILITY PLAN</td> <td></td> <td>FP3.0 FIRE PROTECTION REFLECTED CEILING PLAN</td> </tr> <tr> <td>C8.1 EROSION CONTROL PLAN, NOTES AND DETAILS</td> <td></td> <td>FP4.0 FIRE PROTECTION BLDG SECTION</td> </tr> <tr> <td>LANDSCAPE</td> <td>STRUCTURAL</td> <td>ELECTRICAL</td> </tr> <tr> <td>L1.0 LANDSCAPE COVER SHEET</td> <td>S1.0 STRUCTURAL ABBREVIATIONS & SHEET INDEX</td> <td>E0.1 GENERAL ELECTRICAL NOTES AND ABBREVIATIONS</td> </tr> <tr> <td>L1.1 CONSTRUCTION PLAN</td> <td>S1.1 STRUCTURAL ISOMETRIC VIEWS</td> <td>E0.2 LIGHTING SCHEDULE</td> </tr> <tr> <td>L1.2 CONSTRUCTION PLAN</td> <td>S1.2 GENERAL NOTES</td> <td>E0.3 NETWORK CABLING SCHEDULE</td> </tr> <tr> <td>L2.1 CONSTRUCTION DETAILS</td> <td>S2.0 FOUNDATION & 1ST FLOOR PLAN</td> <td>E1.1 OVERALL ELECTRICAL CAMPUS PLAN</td> </tr> <tr> <td>L2.2 CONSTRUCTION DETAILS</td> <td>S2.1 ROOF FRAMING PLAN</td> <td>E1.2 ELECTRICAL PROJECT SITE PLAN</td> </tr> <tr> <td>L2.3 CONSTRUCTION DETAILS</td> <td>S3.0 BUILDING ELEVATIONS</td> <td>E2.1 FLOOR PLAN - POWER</td> </tr> <tr> <td>L2.4 CONSTRUCTION DETAILS</td> <td>S3.1 BUILDING SECTIONS</td> <td>E3.1 FLOOR PLAN - INFORMATION TECH. & AUDIO-VIDEO</td> </tr> <tr> <td>L2.5 CONSTRUCTION DETAILS</td> <td>S3.10 TRUSS KEY PLAN</td> <td>E3.2 FLOOR PLAN - ACCESS CONTROL & CCTV</td> </tr> <tr> <td>L3.1 IRRIGATION PLAN</td> <td>S3.11 TRUSS ELEVATIONS</td> <td>E4.1 FLOOR PLAN - FIRE ALARM</td> </tr> <tr> <td>L3.2 IRRIGATION PLAN</td> <td>S3.12 TRUSS ELEVATIONS</td> <td>E4.1A CEILING PLAN - FIRE ALARM</td> </tr> <tr> <td>L4.1 PLANTING PLAN</td> <td>S3.13 TRUSS ELEVATIONS</td> <td>E4.2 FIRE ALARM DETAILS</td> </tr> <tr> <td>L4.2 PLANTING PLAN</td> <td>S3.14 TRUSS ELEVATIONS</td> <td>E4.3 FIRE ALARM CALCULATIONS</td> </tr> <tr> <td>L6.1 LANDSCAPE DETAILS</td> <td>S4.0 TYPICAL CONCRETE DETAILS</td> <td>E5.1 CEILING PLAN - LIGHTING</td> </tr> <tr> <td>L7.1 WELO NOTES AND CALCULATIONS</td> <td>S4.1 CONCRETE FOUNDATION DETAILS</td> <td>E5.1E CEILING PLAN - LIGHTING EMERGENCY</td> </tr> <tr> <td>ARCHITECTURAL</td> <td>S6.0 TYPICAL WOOD FRAMING DETAILS</td> <td>E6.1 ROOF PLAN - POWER</td> </tr> <tr> <td>A0.11 SITE PLAN</td> <td>S6.1 TYPICAL WOOD SHEARWALL DETAILS</td> <td>E7.1 SINGLE LINE DIAGRAM</td> </tr> <tr> <td>A0.31 DOOR TYPES AND SCHEDULES</td> <td>S6.2 TYPICAL WOOD FRAMING DETAILS</td> <td>E7.2 PANELBOARD SCHEDULES</td> </tr> <tr> <td>A2.01 FLOOR PLAN</td> <td>S6.10 WOOD FRAMING DETAILS</td> <td>E8.1 DETAILS</td> </tr> <tr> <td>A2.02 ROOF PLAN</td> <td>S6.11 TRUSS CONNECTION DETAILS</td> <td>E9.1 DETAILS</td> </tr> <tr> <td>A2.11 SLAB PLAN</td> <td>S6.12 TRUSS CONNECTION & ROOF MONITOR DETAILS</td> <td>E9.2 DETAILS</td> </tr> <tr> <td>A2.21 SIGNAGE PLAN & FINISH PLAN AND SCHEDULE</td> <td>S6.13 ROOF MONITOR DETAILS</td> <td>E9.3 DETAILS</td> </tr> <tr> <td>A2.41 FURNITURE & EQUIPMENT PLAN (FOR REFERENCE ONLY)</td> <td>S6.14 WOOD FRAMING DETAILS</td> <td>E9.4 DETAILS</td> </tr> <tr> <td>A3.01 BUILDING ELEVATIONS</td> <td>S6.15 WOOD FRAMING DETAILS</td> <td>E9.5 DETAILS</td> </tr> <tr> <td>A3.11 BUILDING SECTIONS</td> <td>S6.16 WOOD FRAMING DETAILS</td> <td>E10.1 NRCC-ELEC</td> </tr> <tr> <td>A3.12 TRUSS PROFILE</td> <td></td> <td>E10.2 NRCC-LT1</td> </tr> <tr> <td>A3.21 ENLARGED ELEVATIONS & SECTIONS</td> <td>MECHANICAL</td> <td>E10.3 NRCC-LT0</td> </tr> <tr> <td>A3.22 ENLARGED ELEVATIONS & SECTIONS</td> <td>M0.01 MECHANICAL - SCHEDULES, LEGENDS & NOTES</td> <td>E10.4 NRCC-SOLAR</td> </tr> <tr> <td>A3.23 ENLARGED ELEVATIONS & SECTIONS</td> <td>M0.02 MECHANICAL - SCHEDULES, LEGENDS & NOTES</td> <td>E11.1 OVERALL SITE PHOTOMETRICS</td> </tr> <tr> <td>A4.01 ENLARGED RESTROOM PLANS AND ELEVATIONS</td> <td>M0.03 MECHANICAL - GREEN BUILDING NOTES</td> <td>E11.2 INTERIOR PHOTOMETRICS</td> </tr> <tr> <td>A4.02 ENLARGED RESTROOM PLANS AND ELEVATIONS</td> <td>M1.01 MECHANICAL - SITE PLAN</td> <td></td> </tr> <tr> <td>A4.03a ENLARGED RESTROOM PLANS AND ELEVATIONS</td> <td>M2.01 MECHANICAL - OVERALL HVAC FLOOR PLAN</td> <td></td> </tr> <tr> <td>A4.03b ENLARGED RESTROOM ELEVATIONS</td> <td>M2.02 MECHANICAL - ENLARGED HVAC FLOOR PLAN</td> <td></td> </tr> <tr> <td>A4.04 ENLARGED CHANGING PLANS AND ELEVATIONS</td> <td>M2.03 MECHANICAL - ENLARGED HVAC FLOOR PLAN</td> <td></td> </tr> </table>	GENERAL	A5.01 INTERIOR ELEVATIONS	M3.01 MECHANICAL - OVERALL HVAC PIPING FLOOR PLAN	G0.01 COVER SHEET AND INDEX	A5.02 INTERIOR ELEVATIONS	M3.02 MECHANICAL - ENLARGED HVAC PIPING FLOOR PLAN	G0.02 ARCHITECTURAL ABBREVIATIONS AND SYMBOLS	A5.03 INTERIOR ELEVATIONS	M3.03 MECHANICAL - ENLARGED HVAC PIPING FLOOR PLAN	G0.05 PROJECT INFORMATION	A6.01 REFLECTED CEILING PLAN	M4.01 MECHANICAL - ROOF PLAN	G0.06 FIRE LIFE SAFETY PLAN	A6.02 CEILING SLOPES DIAGRAM	M5.01 MECHANICAL - DETAILS	G0.07 PLUMBING CALCULATIONS	A6.11 ENLARGED REFLECTED CEILING PLAN - EXTERIOR SOFFITS	M5.02 MECHANICAL - DETAILS	G0.08 LOCKDOWN PROCESS	A6.12 ENLARGED REFLECTED CEILING PLAN - EXTERIOR SOFFITS	M5.03 MECHANICAL - DETAILS	G0.11 CODE SIGNAGE	A8.01 BELOW GRADE WATERPROOFING DETAILS	M5.04 MECHANICAL - DETAILS	G0.12 ACCESSIBLE MOUNTING HEIGHTS	A8.11 EXTERIOR WALL DETAILS - CEMENT PLASTER		CIVIL	A8.21 EXTERIOR STOREFRONT DETAILS	TITLE 24	C1.1 COVER SHEET	A8.22 EXTERIOR WINDOW WALL DETAILS	T24.01 ENERGY COMPLIANCE	C1.2 GENERAL NOTES AND SPECIFICATIONS	A8.23 EXTERIOR DETAILS	T24.02 ENERGY COMPLIANCE	C1.3 DETAILS AND CROSS SECTIONS	A8.24 EXTERIOR SOFFIT DETAILS	T24.03 ENERGY COMPLIANCE	C1.4 DETAILS AND CROSS SECTIONS	A8.51 ROOF DETAILS	T24.04 ENERGY COMPLIANCE	C1.5 DETAILS AND CROSS SECTIONS	A9.01 WOOD PARTITION TYPES AND FRAMING DETAILS		C1.6 DETAILS AND CROSS SECTIONS	A9.02 TYPICAL PARTITION DETAILS	PLUMBING	C1.7 PAVEMENT DELINEATION PLAN	A9.11 TYPICAL CEILING DETAILS	P0.01 PLUMBING LEGENDS & NOTES	C2.1 TOPOGRAPHIC AND DEMOLITION PLAN	A9.12 CEILING DETAILS	P0.02 PLUMBING SCHEDULES & GREEN BUILDING NOTES	C2.2 TOPOGRAPHIC AND DEMOLITION PLAN	A9.21 INTERIOR GLAZING AND DOOR DETAILS	P1.01 PLUMBING - OVERALL FLOOR PLAN	C2.3 TOPOGRAPHIC AND DEMOLITION PLAN	A9.31 TYPICAL CASEWORK DETAILS	P1.02 PLUMBING - ENLARGED FLOOR PLAN	C3.1 DIMENSION AND PAVING PLAN	A9.32 CASEWORK DETAILS	P1.03 PLUMBING - ENLARGED FLOOR PLAN	C3.2 DIMENSION AND PAVING PLAN	A9.33 RECEPTION DESK PLAN AND DETAILS	P2.01 PLUMBING - ROOF PLAN	C3.3 DIMENSION AND PAVING PLAN	A9.41 MISC. INTERIOR DETAILS	P5.01 PLUMBING - DETAILS	C4.1 GRADING AND DRAINAGE PLAN		P5.02 PLUMBING - DETAILS	C5.1 STORM DRAINAGE PLAN	FOOD SERVICE		C6.1 SANITARY SEWER PLAN	QF101 FOOD SERVICE EQUIPMENT - PLAN, SCHEDULE AND SPECIAL CONDITIONS	FIRE PROTECTION	C7.1 COMPOSITE UTILITY PLAN	QF102 FOOD SERVICE EQUIPMENT - MECHANICAL SPOT CONNECTION PLAN	FP1.0 FIRE PROTECTION UNDERGROUND & SITE PLAN	C7.2 COMPOSITE UTILITY PLAN	QF103 FOOD SERVICE EQUIPMENT - ELECTRICAL SPOT CONNECTION PLAN	FP2.0 FIRE PROTECTION OVERHEAD PIPING PLAN	C7.3 COMPOSITE UTILITY PLAN		FP3.0 FIRE PROTECTION REFLECTED CEILING PLAN	C8.1 EROSION CONTROL PLAN, NOTES AND DETAILS		FP4.0 FIRE PROTECTION BLDG SECTION	LANDSCAPE	STRUCTURAL	ELECTRICAL	L1.0 LANDSCAPE COVER SHEET	S1.0 STRUCTURAL ABBREVIATIONS & SHEET INDEX	E0.1 GENERAL ELECTRICAL NOTES AND ABBREVIATIONS	L1.1 CONSTRUCTION PLAN	S1.1 STRUCTURAL ISOMETRIC VIEWS	E0.2 LIGHTING SCHEDULE	L1.2 CONSTRUCTION PLAN	S1.2 GENERAL NOTES	E0.3 NETWORK CABLING SCHEDULE	L2.1 CONSTRUCTION DETAILS	S2.0 FOUNDATION & 1ST FLOOR PLAN	E1.1 OVERALL ELECTRICAL CAMPUS PLAN	L2.2 CONSTRUCTION DETAILS	S2.1 ROOF FRAMING PLAN	E1.2 ELECTRICAL PROJECT SITE PLAN	L2.3 CONSTRUCTION DETAILS	S3.0 BUILDING ELEVATIONS	E2.1 FLOOR PLAN - POWER	L2.4 CONSTRUCTION DETAILS	S3.1 BUILDING SECTIONS	E3.1 FLOOR PLAN - INFORMATION TECH. & AUDIO-VIDEO	L2.5 CONSTRUCTION DETAILS	S3.10 TRUSS KEY PLAN	E3.2 FLOOR PLAN - ACCESS CONTROL & CCTV	L3.1 IRRIGATION PLAN	S3.11 TRUSS ELEVATIONS	E4.1 FLOOR PLAN - FIRE ALARM	L3.2 IRRIGATION PLAN	S3.12 TRUSS ELEVATIONS	E4.1A CEILING PLAN - FIRE ALARM	L4.1 PLANTING PLAN	S3.13 TRUSS ELEVATIONS	E4.2 FIRE ALARM DETAILS	L4.2 PLANTING PLAN	S3.14 TRUSS ELEVATIONS	E4.3 FIRE ALARM CALCULATIONS	L6.1 LANDSCAPE DETAILS	S4.0 TYPICAL CONCRETE DETAILS	E5.1 CEILING PLAN - LIGHTING	L7.1 WELO NOTES AND CALCULATIONS	S4.1 CONCRETE FOUNDATION DETAILS	E5.1E CEILING PLAN - LIGHTING EMERGENCY	ARCHITECTURAL	S6.0 TYPICAL WOOD FRAMING DETAILS	E6.1 ROOF PLAN - POWER	A0.11 SITE PLAN	S6.1 TYPICAL WOOD SHEARWALL DETAILS	E7.1 SINGLE LINE DIAGRAM	A0.31 DOOR TYPES AND SCHEDULES	S6.2 TYPICAL WOOD FRAMING DETAILS	E7.2 PANELBOARD SCHEDULES	A2.01 FLOOR PLAN	S6.10 WOOD FRAMING DETAILS	E8.1 DETAILS	A2.02 ROOF PLAN	S6.11 TRUSS CONNECTION DETAILS	E9.1 DETAILS	A2.11 SLAB PLAN	S6.12 TRUSS CONNECTION & ROOF MONITOR DETAILS	E9.2 DETAILS	A2.21 SIGNAGE PLAN & FINISH PLAN AND SCHEDULE	S6.13 ROOF MONITOR DETAILS	E9.3 DETAILS	A2.41 FURNITURE & EQUIPMENT PLAN (FOR REFERENCE ONLY)	S6.14 WOOD FRAMING DETAILS	E9.4 DETAILS	A3.01 BUILDING ELEVATIONS	S6.15 WOOD FRAMING DETAILS	E9.5 DETAILS	A3.11 BUILDING SECTIONS	S6.16 WOOD FRAMING DETAILS	E10.1 NRCC-ELEC	A3.12 TRUSS PROFILE		E10.2 NRCC-LT1	A3.21 ENLARGED ELEVATIONS & SECTIONS	MECHANICAL	E10.3 NRCC-LT0	A3.22 ENLARGED ELEVATIONS & SECTIONS	M0.01 MECHANICAL - SCHEDULES, LEGENDS & NOTES	E10.4 NRCC-SOLAR	A3.23 ENLARGED ELEVATIONS & SECTIONS	M0.02 MECHANICAL - SCHEDULES, LEGENDS & NOTES	E11.1 OVERALL SITE PHOTOMETRICS	A4.01 ENLARGED RESTROOM PLANS AND ELEVATIONS	M0.03 MECHANICAL - GREEN BUILDING NOTES	E11.2 INTERIOR PHOTOMETRICS	A4.02 ENLARGED RESTROOM PLANS AND ELEVATIONS	M1.01 MECHANICAL - SITE PLAN		A4.03a ENLARGED RESTROOM PLANS AND ELEVATIONS	M2.01 MECHANICAL - OVERALL HVAC FLOOR PLAN		A4.03b ENLARGED RESTROOM ELEVATIONS	M2.02 MECHANICAL - ENLARGED HVAC FLOOR PLAN		A4.04 ENLARGED CHANGING PLANS AND ELEVATIONS	M2.03 MECHANICAL - ENLARGED HVAC FLOOR PLAN	
GENERAL	A5.01 INTERIOR ELEVATIONS	M3.01 MECHANICAL - OVERALL HVAC PIPING FLOOR PLAN																																																																																																																																																																																																	
G0.01 COVER SHEET AND INDEX	A5.02 INTERIOR ELEVATIONS	M3.02 MECHANICAL - ENLARGED HVAC PIPING FLOOR PLAN																																																																																																																																																																																																	
G0.02 ARCHITECTURAL ABBREVIATIONS AND SYMBOLS	A5.03 INTERIOR ELEVATIONS	M3.03 MECHANICAL - ENLARGED HVAC PIPING FLOOR PLAN																																																																																																																																																																																																	
G0.05 PROJECT INFORMATION	A6.01 REFLECTED CEILING PLAN	M4.01 MECHANICAL - ROOF PLAN																																																																																																																																																																																																	
G0.06 FIRE LIFE SAFETY PLAN	A6.02 CEILING SLOPES DIAGRAM	M5.01 MECHANICAL - DETAILS																																																																																																																																																																																																	
G0.07 PLUMBING CALCULATIONS	A6.11 ENLARGED REFLECTED CEILING PLAN - EXTERIOR SOFFITS	M5.02 MECHANICAL - DETAILS																																																																																																																																																																																																	
G0.08 LOCKDOWN PROCESS	A6.12 ENLARGED REFLECTED CEILING PLAN - EXTERIOR SOFFITS	M5.03 MECHANICAL - DETAILS																																																																																																																																																																																																	
G0.11 CODE SIGNAGE	A8.01 BELOW GRADE WATERPROOFING DETAILS	M5.04 MECHANICAL - DETAILS																																																																																																																																																																																																	
G0.12 ACCESSIBLE MOUNTING HEIGHTS	A8.11 EXTERIOR WALL DETAILS - CEMENT PLASTER																																																																																																																																																																																																		
CIVIL	A8.21 EXTERIOR STOREFRONT DETAILS	TITLE 24																																																																																																																																																																																																	
C1.1 COVER SHEET	A8.22 EXTERIOR WINDOW WALL DETAILS	T24.01 ENERGY COMPLIANCE																																																																																																																																																																																																	
C1.2 GENERAL NOTES AND SPECIFICATIONS	A8.23 EXTERIOR DETAILS	T24.02 ENERGY COMPLIANCE																																																																																																																																																																																																	
C1.3 DETAILS AND CROSS SECTIONS	A8.24 EXTERIOR SOFFIT DETAILS	T24.03 ENERGY COMPLIANCE																																																																																																																																																																																																	
C1.4 DETAILS AND CROSS SECTIONS	A8.51 ROOF DETAILS	T24.04 ENERGY COMPLIANCE																																																																																																																																																																																																	
C1.5 DETAILS AND CROSS SECTIONS	A9.01 WOOD PARTITION TYPES AND FRAMING DETAILS																																																																																																																																																																																																		
C1.6 DETAILS AND CROSS SECTIONS	A9.02 TYPICAL PARTITION DETAILS	PLUMBING																																																																																																																																																																																																	
C1.7 PAVEMENT DELINEATION PLAN	A9.11 TYPICAL CEILING DETAILS	P0.01 PLUMBING LEGENDS & NOTES																																																																																																																																																																																																	
C2.1 TOPOGRAPHIC AND DEMOLITION PLAN	A9.12 CEILING DETAILS	P0.02 PLUMBING SCHEDULES & GREEN BUILDING NOTES																																																																																																																																																																																																	
C2.2 TOPOGRAPHIC AND DEMOLITION PLAN	A9.21 INTERIOR GLAZING AND DOOR DETAILS	P1.01 PLUMBING - OVERALL FLOOR PLAN																																																																																																																																																																																																	
C2.3 TOPOGRAPHIC AND DEMOLITION PLAN	A9.31 TYPICAL CASEWORK DETAILS	P1.02 PLUMBING - ENLARGED FLOOR PLAN																																																																																																																																																																																																	
C3.1 DIMENSION AND PAVING PLAN	A9.32 CASEWORK DETAILS	P1.03 PLUMBING - ENLARGED FLOOR PLAN																																																																																																																																																																																																	
C3.2 DIMENSION AND PAVING PLAN	A9.33 RECEPTION DESK PLAN AND DETAILS	P2.01 PLUMBING - ROOF PLAN																																																																																																																																																																																																	
C3.3 DIMENSION AND PAVING PLAN	A9.41 MISC. INTERIOR DETAILS	P5.01 PLUMBING - DETAILS																																																																																																																																																																																																	
C4.1 GRADING AND DRAINAGE PLAN		P5.02 PLUMBING - DETAILS																																																																																																																																																																																																	
C5.1 STORM DRAINAGE PLAN	FOOD SERVICE																																																																																																																																																																																																		
C6.1 SANITARY SEWER PLAN	QF101 FOOD SERVICE EQUIPMENT - PLAN, SCHEDULE AND SPECIAL CONDITIONS	FIRE PROTECTION																																																																																																																																																																																																	
C7.1 COMPOSITE UTILITY PLAN	QF102 FOOD SERVICE EQUIPMENT - MECHANICAL SPOT CONNECTION PLAN	FP1.0 FIRE PROTECTION UNDERGROUND & SITE PLAN																																																																																																																																																																																																	
C7.2 COMPOSITE UTILITY PLAN	QF103 FOOD SERVICE EQUIPMENT - ELECTRICAL SPOT CONNECTION PLAN	FP2.0 FIRE PROTECTION OVERHEAD PIPING PLAN																																																																																																																																																																																																	
C7.3 COMPOSITE UTILITY PLAN		FP3.0 FIRE PROTECTION REFLECTED CEILING PLAN																																																																																																																																																																																																	
C8.1 EROSION CONTROL PLAN, NOTES AND DETAILS		FP4.0 FIRE PROTECTION BLDG SECTION																																																																																																																																																																																																	
LANDSCAPE	STRUCTURAL	ELECTRICAL																																																																																																																																																																																																	
L1.0 LANDSCAPE COVER SHEET	S1.0 STRUCTURAL ABBREVIATIONS & SHEET INDEX	E0.1 GENERAL ELECTRICAL NOTES AND ABBREVIATIONS																																																																																																																																																																																																	
L1.1 CONSTRUCTION PLAN	S1.1 STRUCTURAL ISOMETRIC VIEWS	E0.2 LIGHTING SCHEDULE																																																																																																																																																																																																	
L1.2 CONSTRUCTION PLAN	S1.2 GENERAL NOTES	E0.3 NETWORK CABLING SCHEDULE																																																																																																																																																																																																	
L2.1 CONSTRUCTION DETAILS	S2.0 FOUNDATION & 1ST FLOOR PLAN	E1.1 OVERALL ELECTRICAL CAMPUS PLAN																																																																																																																																																																																																	
L2.2 CONSTRUCTION DETAILS	S2.1 ROOF FRAMING PLAN	E1.2 ELECTRICAL PROJECT SITE PLAN																																																																																																																																																																																																	
L2.3 CONSTRUCTION DETAILS	S3.0 BUILDING ELEVATIONS	E2.1 FLOOR PLAN - POWER																																																																																																																																																																																																	
L2.4 CONSTRUCTION DETAILS	S3.1 BUILDING SECTIONS	E3.1 FLOOR PLAN - INFORMATION TECH. & AUDIO-VIDEO																																																																																																																																																																																																	
L2.5 CONSTRUCTION DETAILS	S3.10 TRUSS KEY PLAN	E3.2 FLOOR PLAN - ACCESS CONTROL & CCTV																																																																																																																																																																																																	
L3.1 IRRIGATION PLAN	S3.11 TRUSS ELEVATIONS	E4.1 FLOOR PLAN - FIRE ALARM																																																																																																																																																																																																	
L3.2 IRRIGATION PLAN	S3.12 TRUSS ELEVATIONS	E4.1A CEILING PLAN - FIRE ALARM																																																																																																																																																																																																	
L4.1 PLANTING PLAN	S3.13 TRUSS ELEVATIONS	E4.2 FIRE ALARM DETAILS																																																																																																																																																																																																	
L4.2 PLANTING PLAN	S3.14 TRUSS ELEVATIONS	E4.3 FIRE ALARM CALCULATIONS																																																																																																																																																																																																	
L6.1 LANDSCAPE DETAILS	S4.0 TYPICAL CONCRETE DETAILS	E5.1 CEILING PLAN - LIGHTING																																																																																																																																																																																																	
L7.1 WELO NOTES AND CALCULATIONS	S4.1 CONCRETE FOUNDATION DETAILS	E5.1E CEILING PLAN - LIGHTING EMERGENCY																																																																																																																																																																																																	
ARCHITECTURAL	S6.0 TYPICAL WOOD FRAMING DETAILS	E6.1 ROOF PLAN - POWER																																																																																																																																																																																																	
A0.11 SITE PLAN	S6.1 TYPICAL WOOD SHEARWALL DETAILS	E7.1 SINGLE LINE DIAGRAM																																																																																																																																																																																																	
A0.31 DOOR TYPES AND SCHEDULES	S6.2 TYPICAL WOOD FRAMING DETAILS	E7.2 PANELBOARD SCHEDULES																																																																																																																																																																																																	
A2.01 FLOOR PLAN	S6.10 WOOD FRAMING DETAILS	E8.1 DETAILS																																																																																																																																																																																																	
A2.02 ROOF PLAN	S6.11 TRUSS CONNECTION DETAILS	E9.1 DETAILS																																																																																																																																																																																																	
A2.11 SLAB PLAN	S6.12 TRUSS CONNECTION & ROOF MONITOR DETAILS	E9.2 DETAILS																																																																																																																																																																																																	
A2.21 SIGNAGE PLAN & FINISH PLAN AND SCHEDULE	S6.13 ROOF MONITOR DETAILS	E9.3 DETAILS																																																																																																																																																																																																	
A2.41 FURNITURE & EQUIPMENT PLAN (FOR REFERENCE ONLY)	S6.14 WOOD FRAMING DETAILS	E9.4 DETAILS																																																																																																																																																																																																	
A3.01 BUILDING ELEVATIONS	S6.15 WOOD FRAMING DETAILS	E9.5 DETAILS																																																																																																																																																																																																	
A3.11 BUILDING SECTIONS	S6.16 WOOD FRAMING DETAILS	E10.1 NRCC-ELEC																																																																																																																																																																																																	
A3.12 TRUSS PROFILE		E10.2 NRCC-LT1																																																																																																																																																																																																	
A3.21 ENLARGED ELEVATIONS & SECTIONS	MECHANICAL	E10.3 NRCC-LT0																																																																																																																																																																																																	
A3.22 ENLARGED ELEVATIONS & SECTIONS	M0.01 MECHANICAL - SCHEDULES, LEGENDS & NOTES	E10.4 NRCC-SOLAR																																																																																																																																																																																																	
A3.23 ENLARGED ELEVATIONS & SECTIONS	M0.02 MECHANICAL - SCHEDULES, LEGENDS & NOTES	E11.1 OVERALL SITE PHOTOMETRICS																																																																																																																																																																																																	
A4.01 ENLARGED RESTROOM PLANS AND ELEVATIONS	M0.03 MECHANICAL - GREEN BUILDING NOTES	E11.2 INTERIOR PHOTOMETRICS																																																																																																																																																																																																	
A4.02 ENLARGED RESTROOM PLANS AND ELEVATIONS	M1.01 MECHANICAL - SITE PLAN																																																																																																																																																																																																		
A4.03a ENLARGED RESTROOM PLANS AND ELEVATIONS	M2.01 MECHANICAL - OVERALL HVAC FLOOR PLAN																																																																																																																																																																																																		
A4.03b ENLARGED RESTROOM ELEVATIONS	M2.02 MECHANICAL - ENLARGED HVAC FLOOR PLAN																																																																																																																																																																																																		
A4.04 ENLARGED CHANGING PLANS AND ELEVATIONS	M2.03 MECHANICAL - ENLARGED HVAC FLOOR PLAN																																																																																																																																																																																																		

STATE FIRE MARSHAL & DSA STAMP								
<p>DSA APPLICATION NO. 02-119316</p> <p>STATE FIRE MARSHAL PERMIT 21-N-0498-CP-DR</p>								
<p>Revisions and Description Date</p> <table border="1"> <tr> <td>2</td> <td>A</td> <td>Addendum 2</td> <td>04.13.2022</td> </tr> <tr> <td>6</td> <td>A</td> <td>Addendum 6</td> <td>04.25.2022</td> </tr> </table>	2	A	Addendum 2	04.13.2022	6	A	Addendum 6	04.25.2022
2	A	Addendum 2	04.13.2022					
6	A	Addendum 6	04.25.2022					
<p>Scale 12" = 1'-0"</p> <p>Drawn by Author</p> <p>EHDD Job Number 20020</p> <p>Sheet Title COVER SHEET AND INDEX</p> <p>Sheet Number G0.01</p>								



Consultant

Stamp

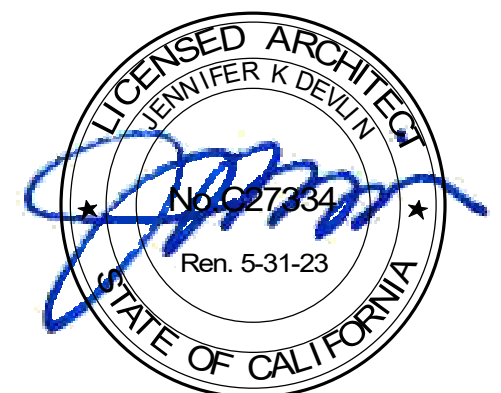

Printing Date

90% CONSTRUCTION DOCUMENTS	06.25.2021
PERMIT SET -	08.16.2021
PERMIT SET - DSA V2	12.15.2021
PERMIT SET - SFM	12.21.2021

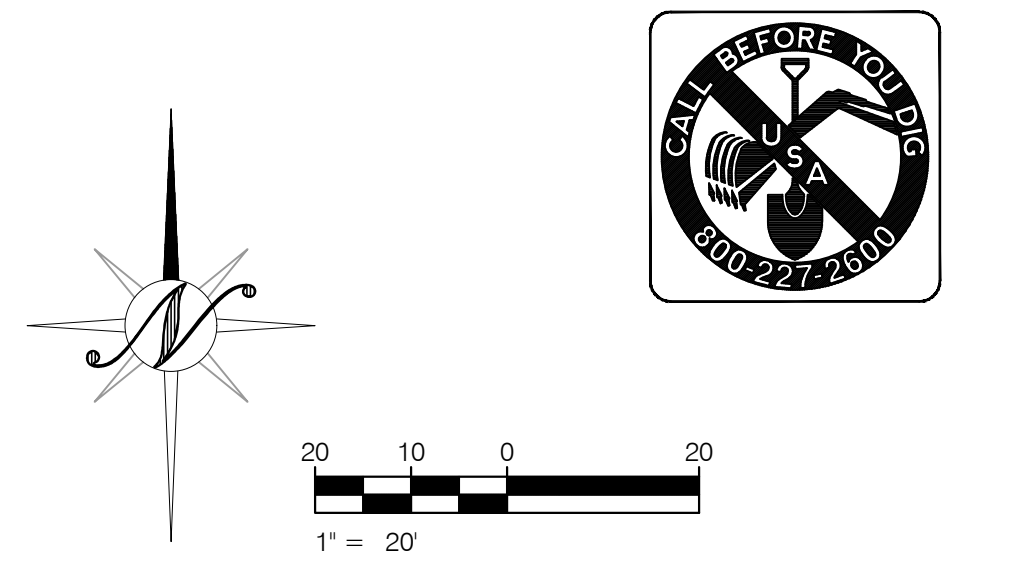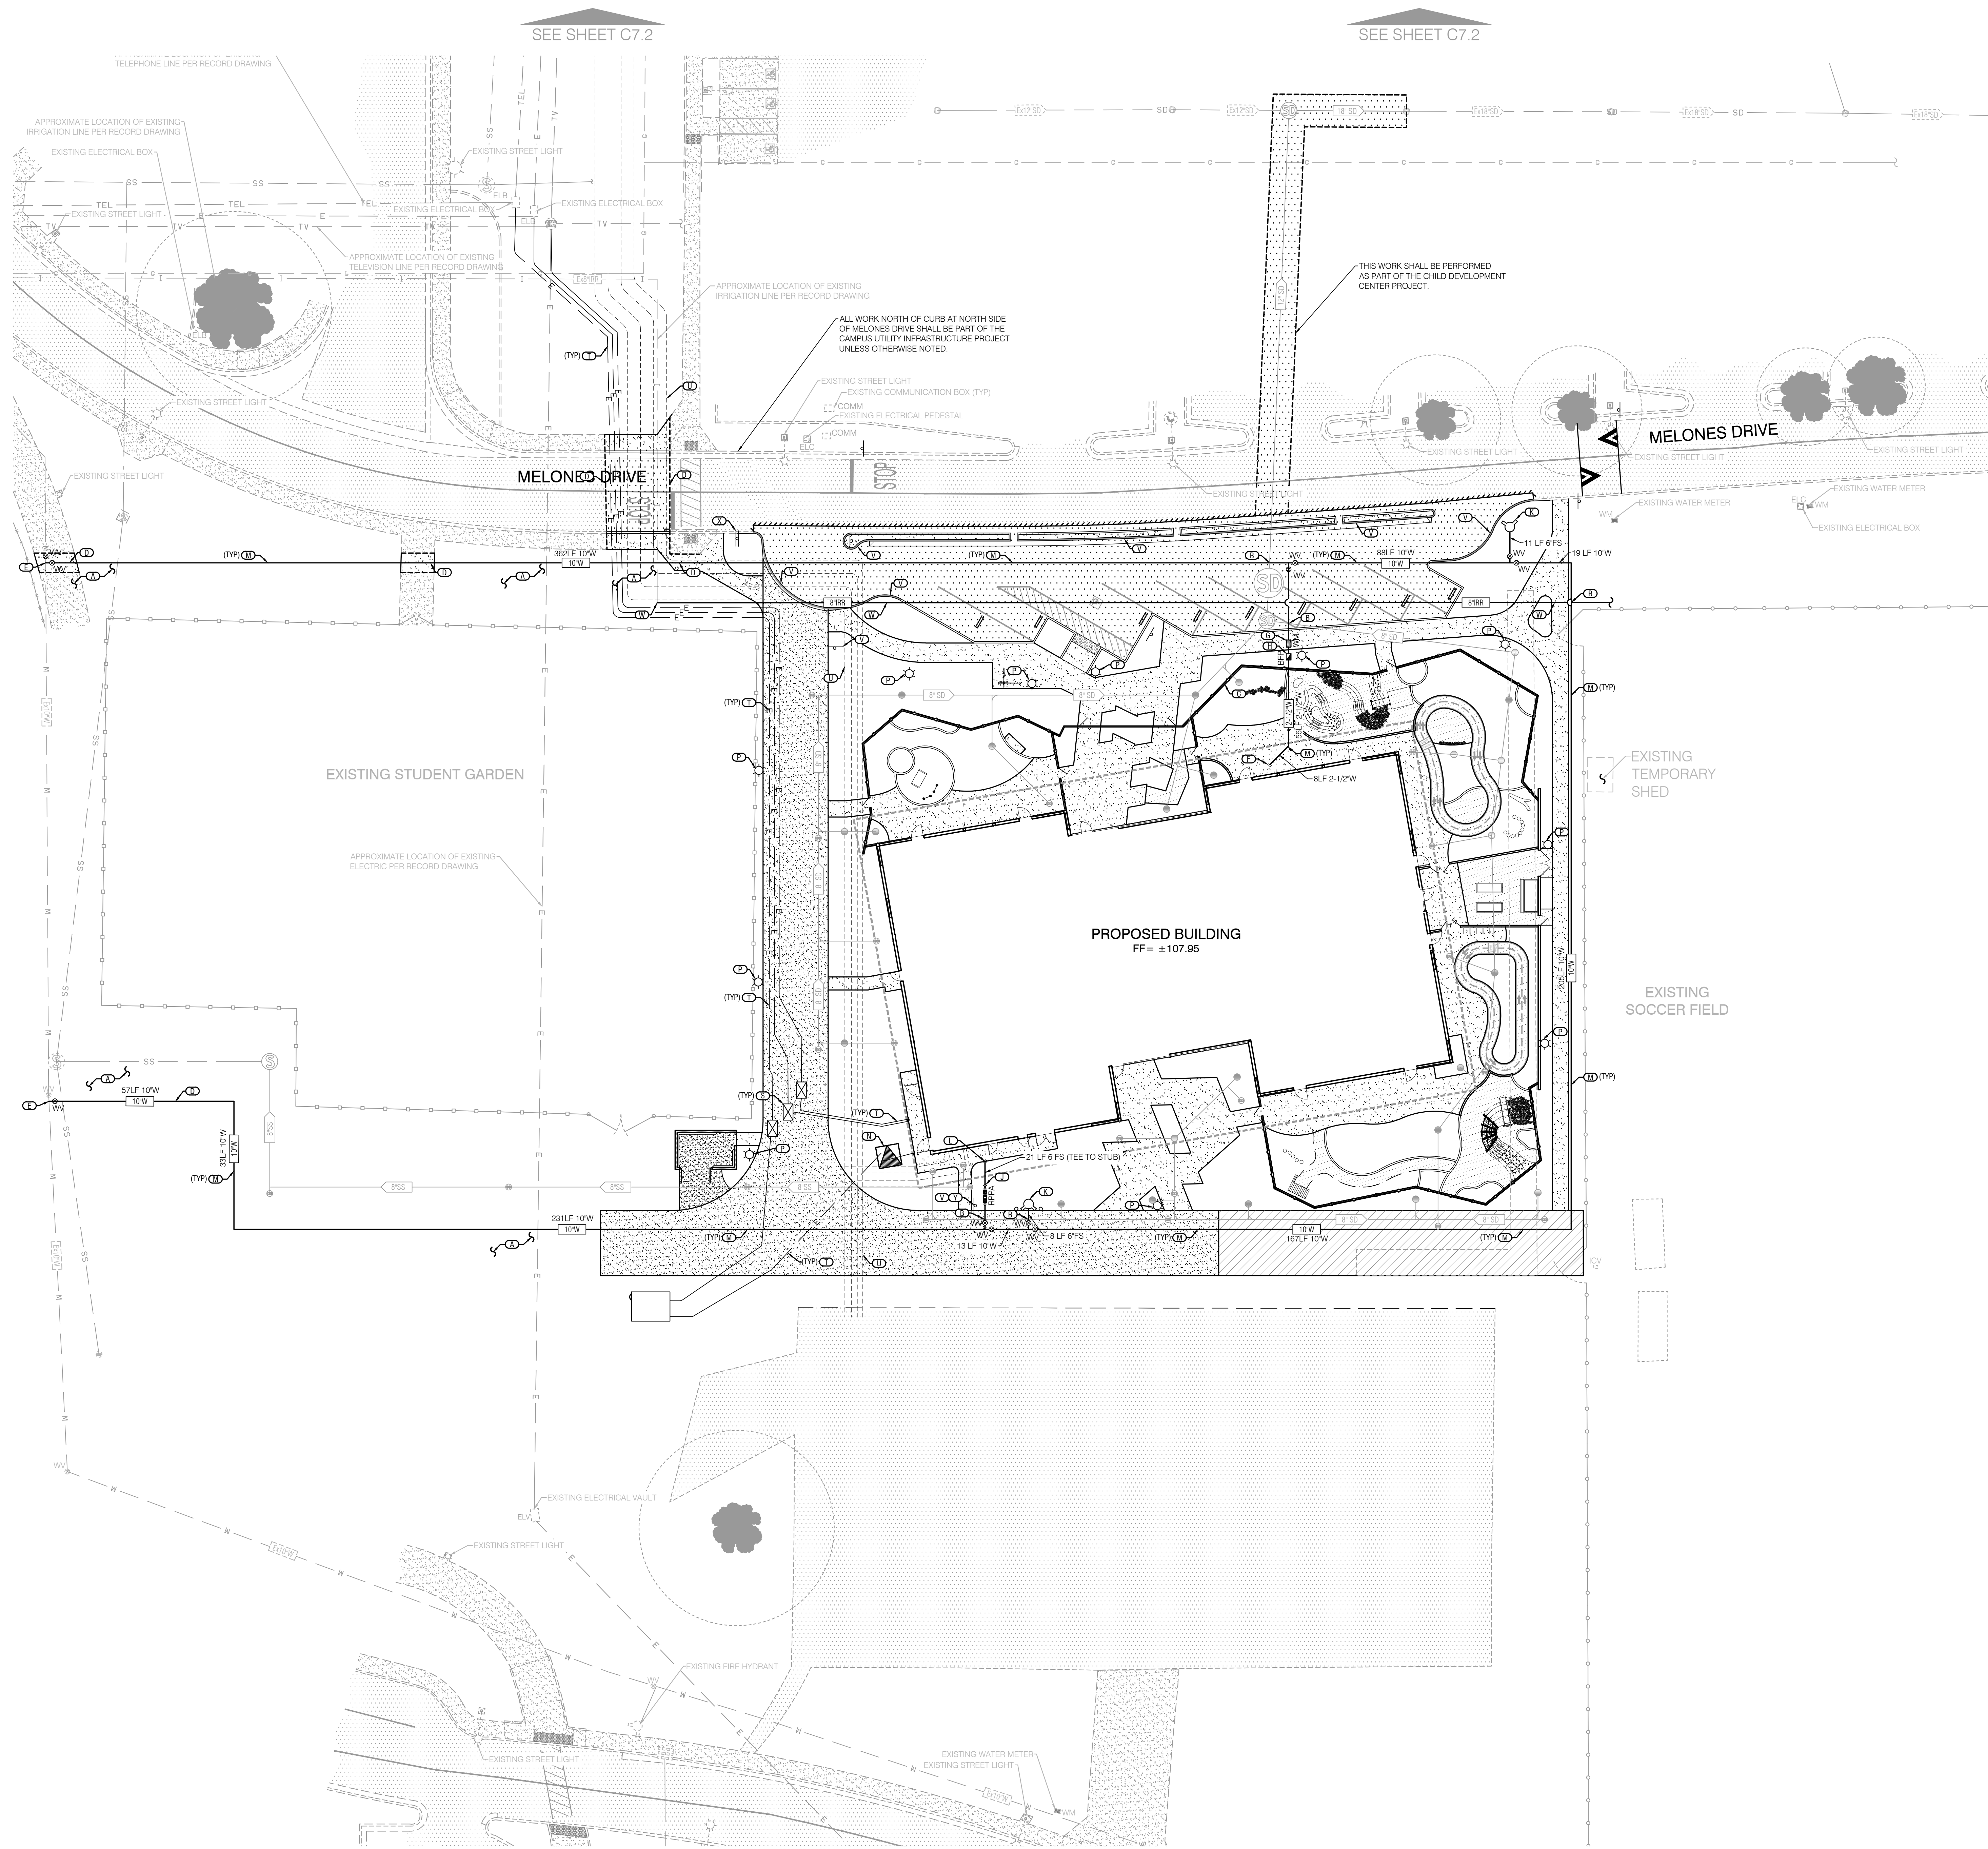

Division of the State Architect

Office of the State Fire Marshal

CSUS CHILD DEVELOPMENT CENTER

CALIFORNIA STATE UNIVERSITY, STANISLAUS ONE UNIVERSITY CIRCLE TURLOCK, CA 95382



PIER 1, BAY 2
THE EMBARCADERO
SAN FRANCISCO, CA 94111

INFO@EHDD.COM
+1 415-285-9193

KEY NOTES


- REFER TO APPLICABLE NOTES ON SHEET C1.2 AND APPLICABLE DETAILS ON SHEETS C1.3-C1.5
- SEE TOPOGRAPHIC AND DEMOLITION SHEET C2.1 FOR ADDITIONAL REMOVAL, REPLACEMENT AND PROTECTION NOTES.
- CONTRACTOR SHALL "USE EXTREME CAUTION" THROUGHOUT THE COURSE OF CONSTRUCTION AS TO AVOID EXISTING UNDERGROUND LINES AND STRUCTURES THAT MAY CONFLICT WITH PROPOSED IMPROVEMENTS.
- CONTRACTOR SHALL "USE EXTREME CAUTION" AT ALL UTILITY CROSSINGS AND SHALL COMPLY WITH ALL APPLICABLE STANDARDS. IF A CONFLICT IS FOUND, THE CONTRACTOR SHALL NOTIFY THE ENGINEER IMMEDIATELY.
- CONTRACTOR SHALL "USE EXTREME CAUTION" TO AVOID UNDERGROUND UTILITIES WHEN INSTALLING FOOTINGS FOR WALLS AND FENCES AT ALL UTILITY WALL/FENCE CROSSINGS.
- CONTRACTOR SHALL REPLACE CURB, TRENCH AND PATCH PAVEMENT AND/OR CONCRETE SECTION PER DETAILS 10-13 ON SHEET C1.5 TO ALLOW FOR CONNECTION. DAMAGED CURB, GUTTER AND/OR SIDEWALK SHALL BE REMOVED AND REPLACED TO THE NEAREST SCORE LINE OR CONSTRUCTION JOINT OR AS DETERMINED BY THE CITY ENGINEER.
- PROPOSED PRIVATE UNIVERSITY WATER MAIN POINT OF CONNECTION. PER UNIVERSITY STANDARDS CONTRACTOR SHALL EXCAVATE EXISTING WATER PIPE TO VERIFY THE HORIZONTAL AND VERTICAL ALIGNMENT PRIOR TO THE INSTALLATION OF THE WATER PIPE AND REMOVE/EXTEND AS REQUIRED. CONTRACTOR SHALL INFORM THE ENGINEER IF THE ALIGNMENTS ARE DIFFERENT THAN SHOWN. CONTRACTOR SHALL CONNECT TO EXISTING WATER PIPE PER UNIVERSITY STANDARDS AND SPECIFICATIONS. NOT TO BE PERFORMED UNDER SUPERVISION OF UNIVERSITY PERSONNEL. CONTRACTOR TO EXPOSE MAIN AND PROVIDE MATERIALS FEES.
- PROPOSED DOMESTIC WATER WITH SHUT OFF VALVE TO BE STUBBED 5 FEET FROM THE FACE OF THE BUILDING. CONTRACTOR SHALL VERIFY THE LOCATIONS OF THE UTILITY CONNECTIONS WITH THE PLUMBING PLANS PRIOR TO CONSTRUCTION OF PROPOSED STUBS.
- CONTRACTOR SHALL INSTALL 2-1/2" WATER METER FOR DOMESTIC SERVICE PER UNIVERSITY STANDARDS AND SPECIFICATIONS. WATER METER SHALL BE ONION F-1000 SERIES TURBINE FLOW METER OR EQUAL. "USE EXTREME CAUTION" WHEN INSTALLING DEVICES TO AVOID EXISTING UNDERGROUND UTILITIES THAT MAY EXIST. CONTRACTOR TO FIELD VERIFY PRIOR TO CONSTRUCTION. CITY PERSONNEL WILL DROP METER FOR FEE.
- CONTRACTOR SHALL INSTALL 2-1/2" REDUCED PRESSURE BACKFLOW PREVENTER FOR DOMESTIC SERVICE PER DETAIL 8 ON SHEET C1.5 AND UNIVERSITY STANDARDS AND SPECIFICATIONS. "USE EXTREME CAUTION" WHEN INSTALLING DEVICES TO AVOID EXISTING UNDERGROUND UTILITIES THAT MAY EXIST. CONTRACTOR TO FIELD VERIFY PRIOR TO CONSTRUCTION.
- CONTRACTOR SHALL INSTALL 6" REDUCED PRESSURE PRINCIPLE ASSEMBLY WITH OS&Y VALVES, TAMPER SWITCH, FDC, AND ASSOCIATED CONDUITS PER UNIVERSITY STANDARDS AND SPECIFICATIONS AND PER FIRE PROTECTION PLANS. SEE DETAIL 9 ON SHEET C1.5. "USE EXTREME CAUTION" WHEN INSTALLING DEVICES TO AVOID EXISTING UNDERGROUND UTILITIES THAT MAY EXIST. CONTRACTOR TO FIELD VERIFY PRIOR TO CONSTRUCTION.
- CONTRACTOR SHALL INSTALL FIRE HYDRANT ASSEMBLY PER DETAIL 5 ON SHEET C1.5. MAINTAINING A 3 FEET MINIMUM CLEARANCE SPACE. "USE EXTREME CAUTION" WHEN INSTALLING FOOTINGS TO AVOID UNDERGROUND UTILITIES.
- PROPOSED FIRE WATER WITH SHUT OFF VALVE TO BE STUBBED 5 FEET FROM THE FACE OF THE BUILDING. CONTRACTOR SHALL VERIFY THE LOCATIONS OF THE UTILITY CONNECTIONS WITH THE PLUMBING PLANS PRIOR TO CONSTRUCTION OF PROPOSED STUBS.
- CONTRACTOR SHALL INSTALL WATER PIPES WITH SUFFICIENT ENOUGH DEPTH TO MAINTAIN 1" MINIMUM VERTICAL CLEARANCE FROM OUTSIDE DIAMETER OF PIPES AND COMPLY WITH THE MOST CURRENT STATE HEALTH CODE AND THE CALIFORNIA BUILDING AND PLUMBING CODE STANDARDS. CONTRACTOR SHALL DEEPEN WATER PIPES AS NECESSARY AND USE EXTREME CAUTION WHEN PLACING THRUST BLOCKS AS TO AVOID CONFLICTS WITH OTHER UTILITY PIPES. CONTRACTOR SHALL INSTALL REDUCERS AS REQUIRED. WATER VALVES SHALL BE INSTALLED ON 4" WATER PIPES OR LARGER AND SHALL VALVES CORPS SHOULD BE INSTALLED ON 2" WATER PIPES OR SMALLER. THRUST BLOCKS SHALL BE INSTALLED AT FIRE HYDRANTS, BLOW-OFFS, TEES, CAPS, BENDS, ENDS, AND CHANGES IN SIZE AND/OR DIRECTION. WATER SEPARATION SHALL BE CONSTRUCTED IN ACCORDANCE WITH SECTION 720.8 AND TABLE 7.7 OF THE CALIFORNIA PLUMBING CODE. SEE DETAIL 6 ON SHEET C1.5 FOR THRUST BLOCK DETAILS AND SPECIFICATIONS.
- CONTRACTOR SHALL INSTALL TRANSFORMER PER ELECTRICAL PLANS AND SPECIFICATIONS.
- CONTRACTOR SHALL INSTALL LIGHT PER ELECTRICAL PLANS AND SPECIFICATIONS.
- CONTRACTOR SHALL INSTALL PAD MOUNTED NETWORK SWITCH PER ELECTRICAL PLANS AND SPECIFICATIONS.
- CONTRACTOR SHALL INSTALL VAULTS PER ELECTRICAL PLANS AND SPECIFICATIONS.
- CONTRACTOR SHALL INSTALL ELECTRICAL CONDUIT PER ELECTRICAL PLANS AND SPECIFICATIONS. CONTRACTOR SHALL "USE EXTREME CAUTION" AT ALL UTILITY CROSSINGS AND SHALL COMPLY WITH ALL APPLICABLE STANDARDS. IF A CONFLICT IS FOUND, THE CONTRACTOR SHALL NOTIFY THE ENGINEER IMMEDIATELY. MECHANICAL UTILITY NORTH OF MELONES DRIVE TO BE INSTALLED AS PART OF SITE INFRASTRUCTURE PROJECT.
- APPROXIMATE LOCATION OF MECHANICAL UTILITY TRENCH EDGE SHOWN. CONTRACTOR SHALL REFERENCE MECHANICAL UTILITY PLANS FOR EXACT LOCATION. CONTRACTOR SHALL "USE EXTREME CAUTION" AT ALL UTILITY CROSSINGS AND SHALL COMPLY WITH ALL APPLICABLE STANDARDS. IF A CONFLICT IS FOUND, THE CONTRACTOR SHALL NOTIFY THE ENGINEER IMMEDIATELY. MECHANICAL UTILITY NORTH OF MELONES DRIVE TO BE INSTALLED AS PART OF SITE INFRASTRUCTURE PROJECT.
- ALL AREAS INDICATED SHALL BE MARKED WITH RED CURB AND WHITE STENCILS "NO PARKING - FIRE LANE" INCLUDING THE PROPER SIGNAGE IN ACCORDANCE WITH THE REQUIREMENTS OF THE OFFICE OF THE STATE FIRE MARSHAL AND FIRE DEPARTMENT. SEE FIRE LANE DETAIL 11 ON SHEET C1.3. IN LIEU OF PAINTING "NO PARKING" RED CURB CONTRACTOR SHALL INSTALL "NO PARKING" SIGNAGE AS DIRECTED BY THE FIRE DEPARTMENT AND PER DETAIL 11 ON SHEET C1.3. "USE EXTREME CAUTION" WHEN INSTALLING POST AND FOOTINGS TO AVOID UNDERGROUND UTILITIES.
- CONTRACTOR SHALL RELOCATE EXISTING IRRIGATION LINE PER LANDSCAPE ARCHITECTURAL PLANS.
- CONTRACTOR SHALL INSTALL LEFT ARROW AND RIGHT ARROW FIRE DEPARTMENT CONNECTION SIGNAGE PER DETAIL 6 ON SHEET C1.4. CONTRACTOR SHALL INSTALL DOUBLE SIDED SIGNAGE TO POINT TOWARDS PROPOSED FIRE DEPARTMENT CONNECTION. "USE EXTREME CAUTION" WHEN INSTALLING POST AND FOOTINGS TO AVOID UNDERGROUND UTILITIES.
- CONTRACTOR SHALL INSTALL DOWN ARROW FIRE DEPARTMENT CONNECTION SIGNAGE PER DETAIL 6 ON SHEET C1.4. CONTRACTOR SHALL INSTALL DOUBLE SIDED SIGNAGE TO POINT TOWARDS PROPOSED FIRE DEPARTMENT CONNECTION. "USE EXTREME CAUTION" WHEN INSTALLING POST AND FOOTINGS TO AVOID UNDERGROUND UTILITIES.

Consultant

NorthStar Engineering Group, Inc.

CIVIL ENGINEERING • SURVEYING • PLANNING

620 12th Street Modesto, CA 95354
(209) 524-3525 Phone (209) 524-3526 Fax

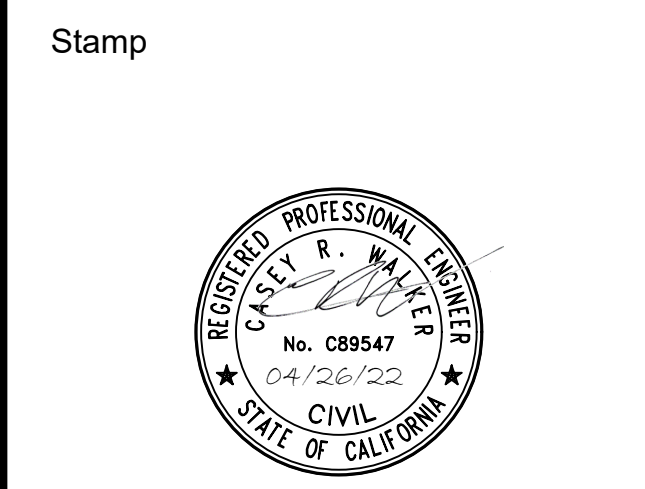

Stamp

Printing	Date
95% CONSTRUCTION DOCUMENTS	06.25.2021
PERMIT SET	08.16.2021
PERMIT SET - DSA V2	
PERMIT SET - SFM	

Revisions and Description	Date
▲ WATER METER SPEC	04/26/22

Scale
As Shown

Drawn by
BEC

EHDD Job Number
20020

Sheet Title
COMPOSITE UTILITY PLAN

Sheet Number
C7.1

CSUS CHILD DEVELOPMENT CENTER

CALIFORNIA STATE UNIVERSITY, STANISLAUS ONE UNIVERSITY CIRCLE TURLOCK, CA 95382



PIER 1, BAY 2 THE EMBARCADERO SAN FRANCISCO, CA 94111

INFO@EHDD.COM +1 415-285-9193

Consultant



Stamp




Printing and Date table with columns for 95% CONSTRUCTION DOCUMENTS, PERMIT SET, and PERMIT SET - DSA V2.

Revisions and Description table with columns for revision number, description, and date.

Scale 1" = 10'-0", Drawn by MBH, EHDD Job Number KLA 20-2266

Construction Plan

Sheet Number L1.1

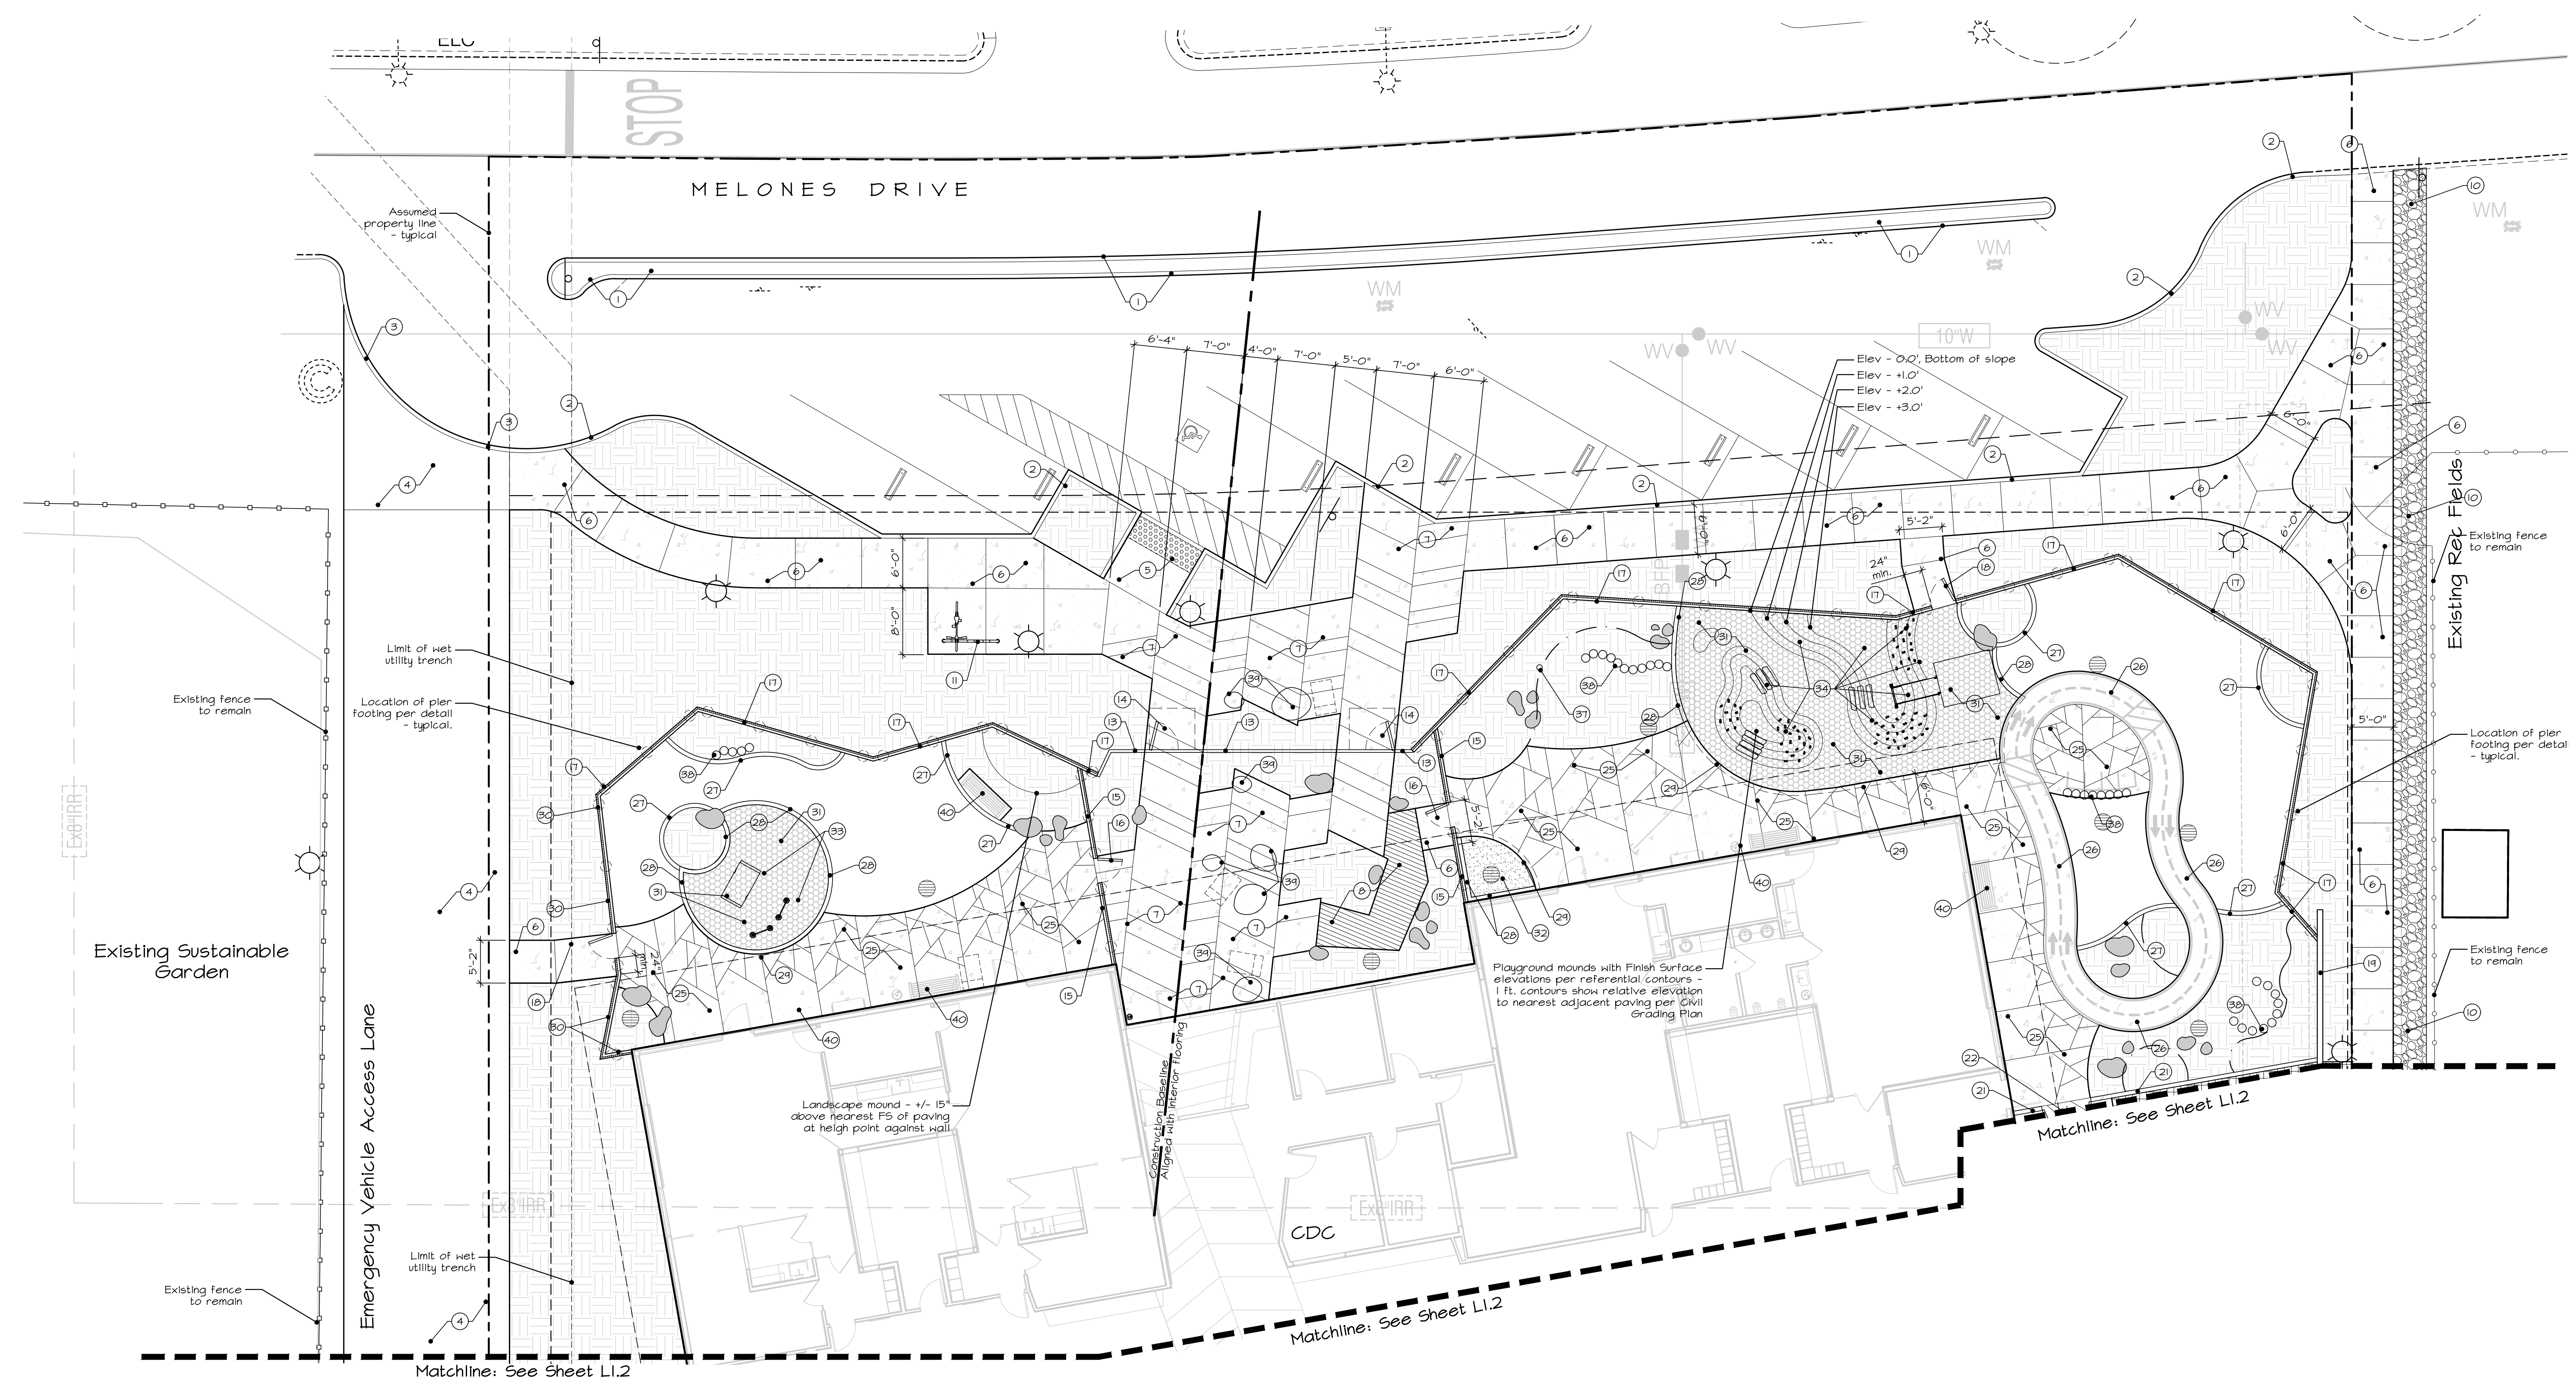

Wood Structure Notes

- 1. Wood structures such as fences, colonnades, trellis, etc. shall be installed to meet the design intent of the plans and details.

Tubular Steel Notes

- 1. Contractor shall install the fence, handrails, guard rails, gates, etc. per the design intent of the plans.

General Construction Notes

- 1. All dimensions are taken from curb face, building face, or edge of paving, unless otherwise noted on the plan.

Construction Callouts

Table with columns for No., Detail, Item Description, and Item Description. Includes callouts for concrete median, curb, paving, and various playground features.

Concrete Joints

- Score Joint - see detail A, L2.1
Expansion Joint - see detail A, L2.1
Cold Joint - see detail A, L2.1

NOTE: Contractor to provide min. 36" square mock-ups of each type of paving color and texture. Sample to be approved by Owner and Landscape Architect prior to pour.



CSUS CHILD DEVELOPMENT CENTER

CALIFORNIA STATE UNIVERSITY, STANISLAUS ONE UNIVERSITY CIRCLE TURLOCK, CA 95382



PIER 1, BAY 2 THE EMBARCADERO SAN FRANCISCO, CA 94111

INFO@EHDD.COM +1 415-285-9193

Consultant



Stamp



Printing	Date
95% CONSTRUCTION DOCUMENTS	08.25.2021
PERMIT SET	08.18.2021
PERMIT SET - DSA V2	12.15.2021
PERMIT SET - SFM	12.21.2021

Revisions and Description		Date
6	A Addendum 6	04.25.2022


Scale
1" = 10'-0"

Drawn by
MBH

EHDD Job Number
KLA 20-2266

Sheet Title
Construction Plan

Sheet Number
L1.2

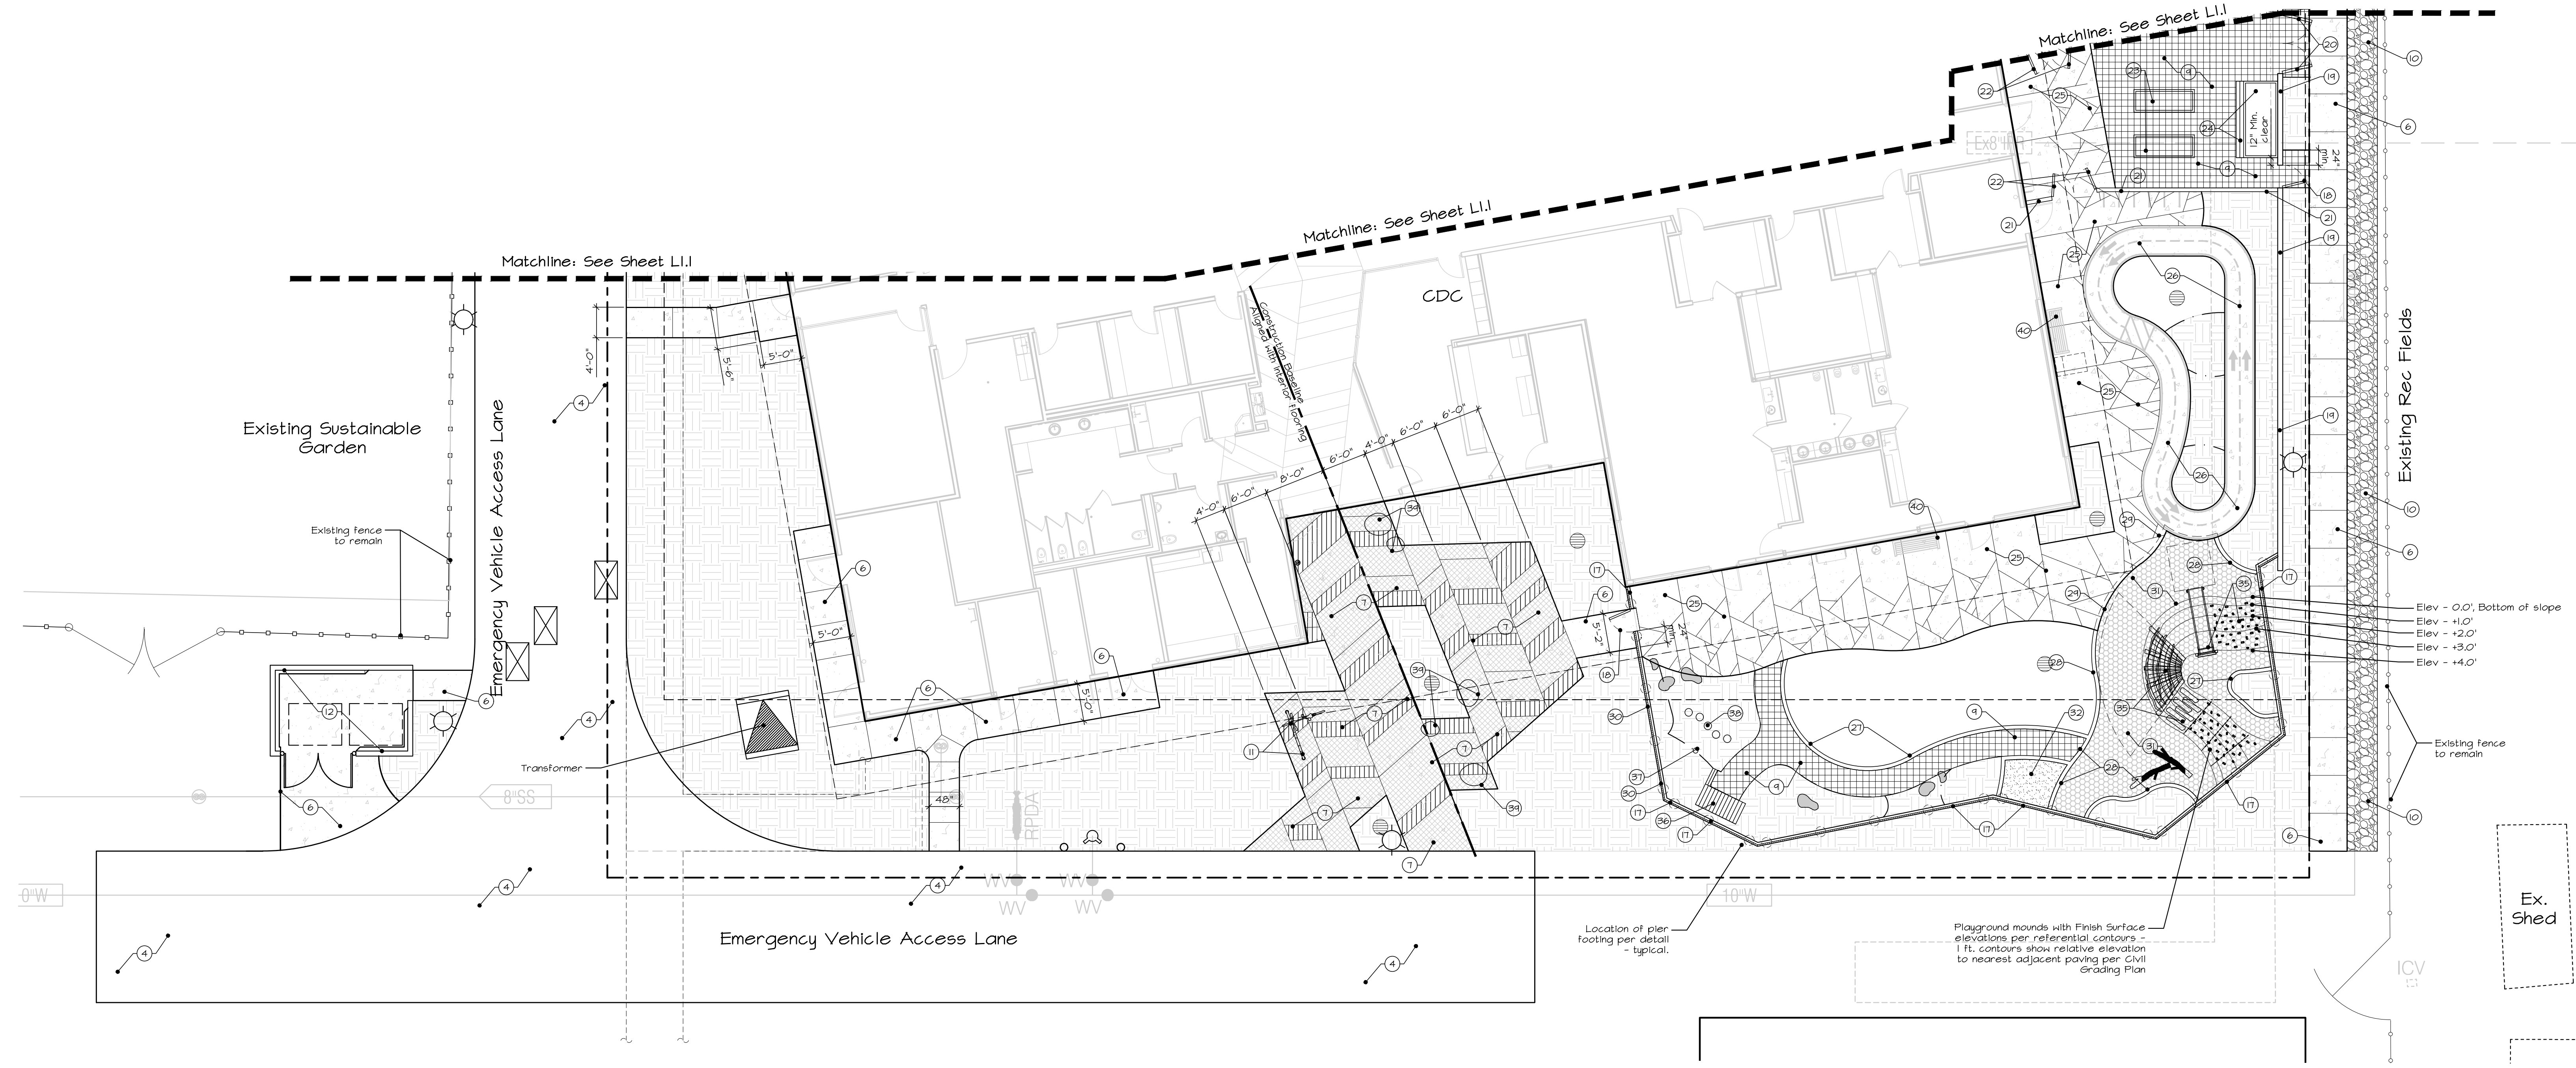

Play Area and Equipment Notes

- The plans, notes, and details shall in no way supersede play warranty or code requirements. Code and manufacturer requirements shall always take precedence over these plans.
- The play equipment shall comply with the manufacturer and model number as specifically called out on the plans. Play equipment has been specified per the specific size of the play area. No substitutions shall be made without the express approval of the owner and/or landscape architect.
- The contractor shall verify prior to installation that the play equipment and required fall zones fit within the play area surfacing and depth of surfacing (for cushioning) has been met. Utilities shall be clear of all footings and supports.
- The contractor shall use a licensed play ground installation company with experience in similar installations and familiar with the unique requirements of play areas. The contractor shall be responsible for ensuring that the play equipment, surfacing, and edging are installed per the project and local code requirements (contractor to verify).
- The play area surfacing shall be installed per the specifications of the manufacturer. Installation must be certified correct by the manufacturer to ensure that the warranty and insurance are valid. Verify depth of material as needed for specific fall-zones associated with the play equipment.
- Color combinations shall be selected or approved by the owner and/or landscape architect prior to ordering.
- Fencing shall drain away from play surfacing unless specifically noted on the plans. Fiberglass surfacing shall be installed with a drain at the bottom.
- ADA access to play surface shall be installed per the plans or local code requirements.
- Ground surfaces on accessible routes, clear floor or ground spaces, and turning spaces shall comply with CBC Section 11B-1008.2.6


- 11B-1008.2.6.1 Accessibility. Ground surfaces shall comply with ASTM F 1951. Ground surfaces shall be inspected and maintained regularly and frequently to ensure continued compliance with ASTM F 1951.
- 11B-1008.2.6.2 Use Zones. Ground surfaces located within use zones shall comply with ASTM F 1292 (1999 edition or 2004 edition).

Construction Callouts

- | No. | Detail | Item Description |
|-----|-----------------------------------|--|
| 1 | Per CIVIL | Concrete median per Civil Engineer's plans. |
| 2 | Per CIVIL | Concrete vertical curb per Civil Engineer's plans. |
| 3 | Per CIVIL | Concrete rolled curb per Civil Engineer's plans. |
| 4 | Per CIVIL | Emergency vehicle access lane paving per Civil Engineer's Plans. |
| 5 | Per CIVIL | Curb ramp and truncated domes per Civil Engineer's plans and applicable CBC accessibility code requirements. |
| 6 | A and B, Sheet L2.1 | Natural gray medium broom finish concrete paving. Install broveled score joints and expansion joints as shown on plans. Expansion joints shall be maximum 20' on center. |
| 7 | A-C, Sheet L2.1 and D, Sheet L2.5 | Colored concrete with light sandblast finish by means of top-surface finish retarder such as Topcoat or approved equal, color to be integrally mixed pigment by Davis Colors. Two colors to be provided in random pattern as shown in detail. Colors per detail. Provide product cut sheets and mix ratio for approval. Install saw cut score joints in enhanced pattern as shown on plans. Provide expansion joints as shown on plans. Expansion joints shall be maximum 20' on center. |
| 8 | D, Sheet L2.1 | As grade wood deck to be installed flush with adjacent paving. |
| 9 | E, Sheet L2.1 | Install stabilized decomposed granite paving, 'Stabilizer' soil binder by Stabilizer Solutions, (800)336-2468, www.stabilizersolutions.com. Mix ratio shall be per manufacturer's recommendations. Install per manufacturer's recommendations. Granite color: tan. Submit product information and stabilizer mix ratio for approval. |
| 10 | F, Sheet L2.1 | 3" layer of 3/4" chip aggregate at maintenance pathway. |
| 11 | G, Sheet L2.1 | Surface mount bike rack. |
| 12 | H+N, Sheet L2.1 | Split Face CMU trash enclosure with corrugated steel access doors. |
| 13 | O, Sheet L2.1 | Low ornamental fence at entry. Tube steel post and frame with laser cut architectural metal panels. |
| 14 | A, Sheet L2.2 | Entry gate at low entry fence. Gate to match fence. |
| 15 | B and C, Sheet L2.2 | Play yard enclosure fence and wall system at North entrance. Uniform base wall height to match building wall below window. |
| 16 | D, Sheet L2.2 | Single leaf egress gate at north entrance play yard enclosure fence. |
| 17 | F, Sheet L2.2 and A-C, Sheet L2.3 | Play yard enclosure fence and wall system. Tube steel fence system on top to be consistent 48" height, base wall varies from 12" to 60". Portions at play mounds have retaining condition.
ALTERNATE: Provide Alternate pricing for tube steel fence portion of fence system - Base wall has no alternate. Provide line item in bid to replace tube steel fence and pickets with pre-manufactured fence system by Fortress Building Products - Architectural fence - Flat, Top/Flat Bottom two rail panels with manufacturer's 2.5" posts and pressed dome caps. Install per manufacturer's specifications. |
| 18 | D and E, Sheet L2.2 | Single leaf egress and fire access gate at play yard enclosure fence. |
| 19 | H, L2.2 | 5'-6" tall CMU wall with precast concrete cap and stucco veneer to match the building. |
| 20 | F, L2.3 | Double leaf maintenance access and egress gate at full height wall. Gate design to match tube steel fence with vertical pickets - see Detail C L2.2 for reference. |

- | No. | Detail | Item Description |
|-----|---------------------|---|
| 21 | E, Sheet L2.3 | Low tube steel separation fence at shared garden. |
| 22 | F, Sheet L2.3 | Double leaf gate at low tube steel separation fence. Gate to match fence design. Single leaf to have heavy duty cone bolt to be used for maintenance access. |
| 23 | G, Sheet L2.3 | 8" tall raised garden bed |
| 24 | A, Sheet L2.4 | 12" tall raised garden bed with built in bench |
| 25 | A and B, Sheet L2.1 | Natural gray medium broom finish concrete paving. Install saw cut score joints in enhanced pattern as shown on plans. Provide expansion joints as shown on plans. Expansion joints shall be maximum 20' on center. |
| 26 | A and B, Sheet L2.4 | Colored concrete bike path with medium sandblast finish by means of top-surface finish retarder such as Topcoat or approved equal. Color to be integrally mixed pigment by Davis Colors. Color to be selected. Provide product cut sheets and mix ratio for approval. Provide broveled score joints at 5' on center and expansion joints at 20' on center. Striping as shown in plan and per typical striping detail. |
| 27 | C, Sheet L2.4 | Concrete mow curb. |
| 28 | D or E, Sheet L2.4 | Concrete curb edging at play area and sand pit |
| 29 | D, Sheet L2.4 | Downturn edge of sidewalk around play area. |
| 30 | I, Sheet L2.2 | Tube steel play yard enclosure fence. |
| 31 | D, Sheet L2.4 | Poured in place playground surfacing. Surfacing to be Corzan product supplied by SFECC Play - see also detail A-C, Sheet L2.3. |
| 32 | E, Sheet L2.4 | Play sand. Contractor to provide custom fabric cover with eye hooks in perimeter curb. |
| 33 | A, Sheet L2.5 | Infant Play Yard - Poured in place play surface and equipment by SFECC play equipment. Contact Caroline O'Neal - 650.764.0761. |
| 34 | B, Sheet L2.5 | Toddler Play Yard - Poured in place play surface playground mounds and equipment by SFECC play equipment. Contact Caroline O'Neal - 650.764.0761. |
| 35 | G, Sheet L2.5 | Preschool Play Yard - Poured in place play surface playground mounds and equipment by SFECC play equipment. Contact Caroline O'Neal - 650.764.0761. |
| 36 | F, Sheet L2.4 | Play hut. Product to be Kompan Robinia Play hut model NS-Custom 091046. |
| 37 | G, Sheet L2.4 | Farm pump by Ironic play. Provide switch for facility to turn on/off water supply - See Irrigation for water supply. |
| 38 | H, Sheet L2.4 | Natural wood log steps by Columbia Cascade or approved equal. |
| 39 | I, Sheet L2.4 | Precast concrete seating stones - Some Stones by Concreteworks or approved equal. |
| 40 | No Detail | Location for surface mount bench. Bench shown for reference only - FFE |

Boundaries - see Planting Plan

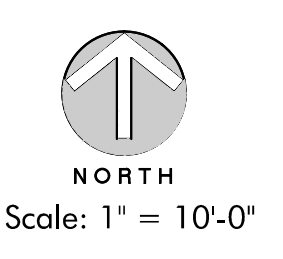



Printing	Date
95% CONSTRUCTION DOCUMENTS	08.25.2021
PERMIT SET	08.16.2021
PERMIT SET - DSA V2	12.15.2021
PERMIT SET - SFM	12.21.2021

















Revisions and Description	Date	
6	Addendum 6	04.25.2022

Scale
See Details
Drawn by
MBH
EHDD Job Number
KLA 20-2266

Sheet Title
Construction Details

Sheet Number

 L2.1

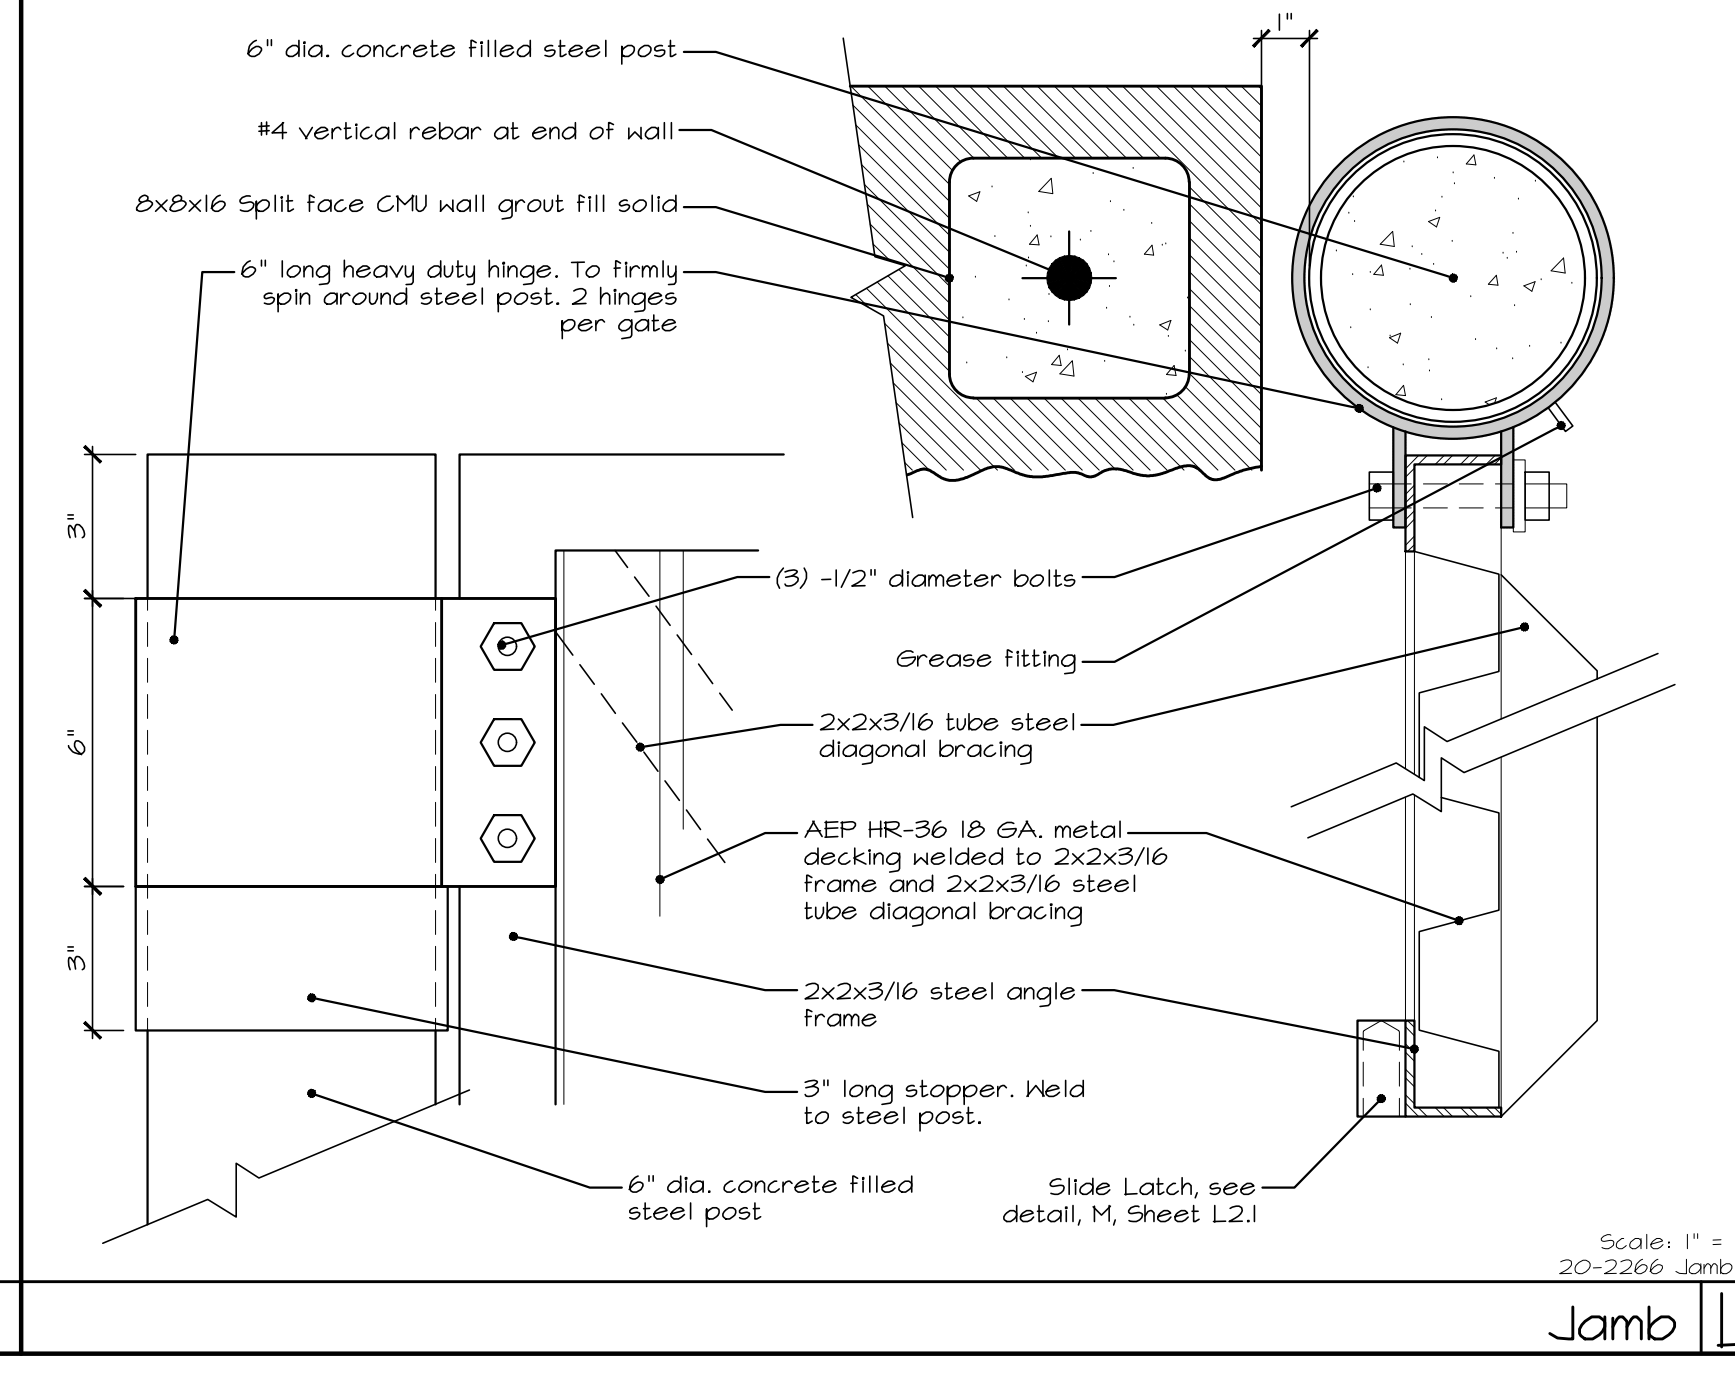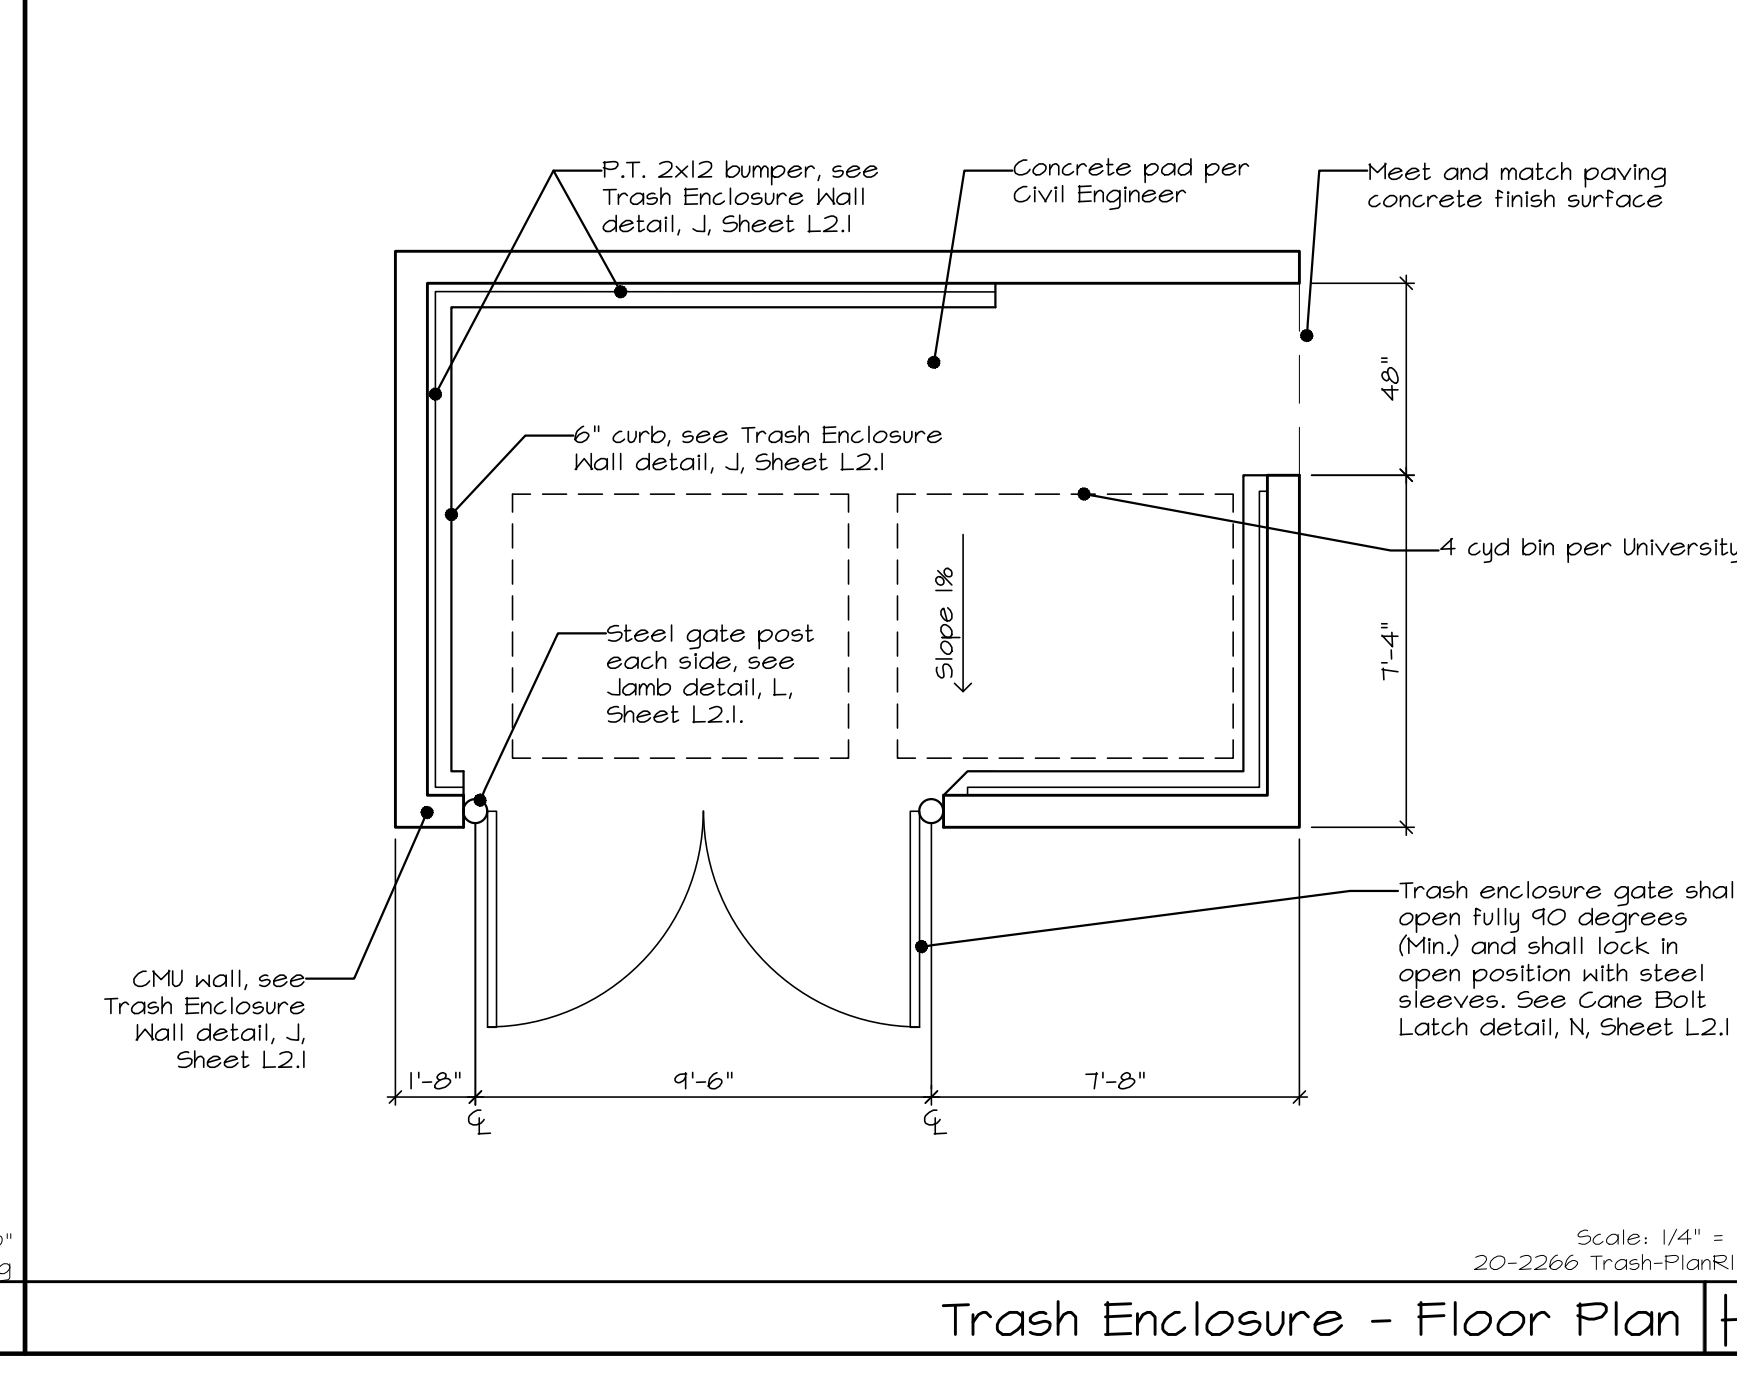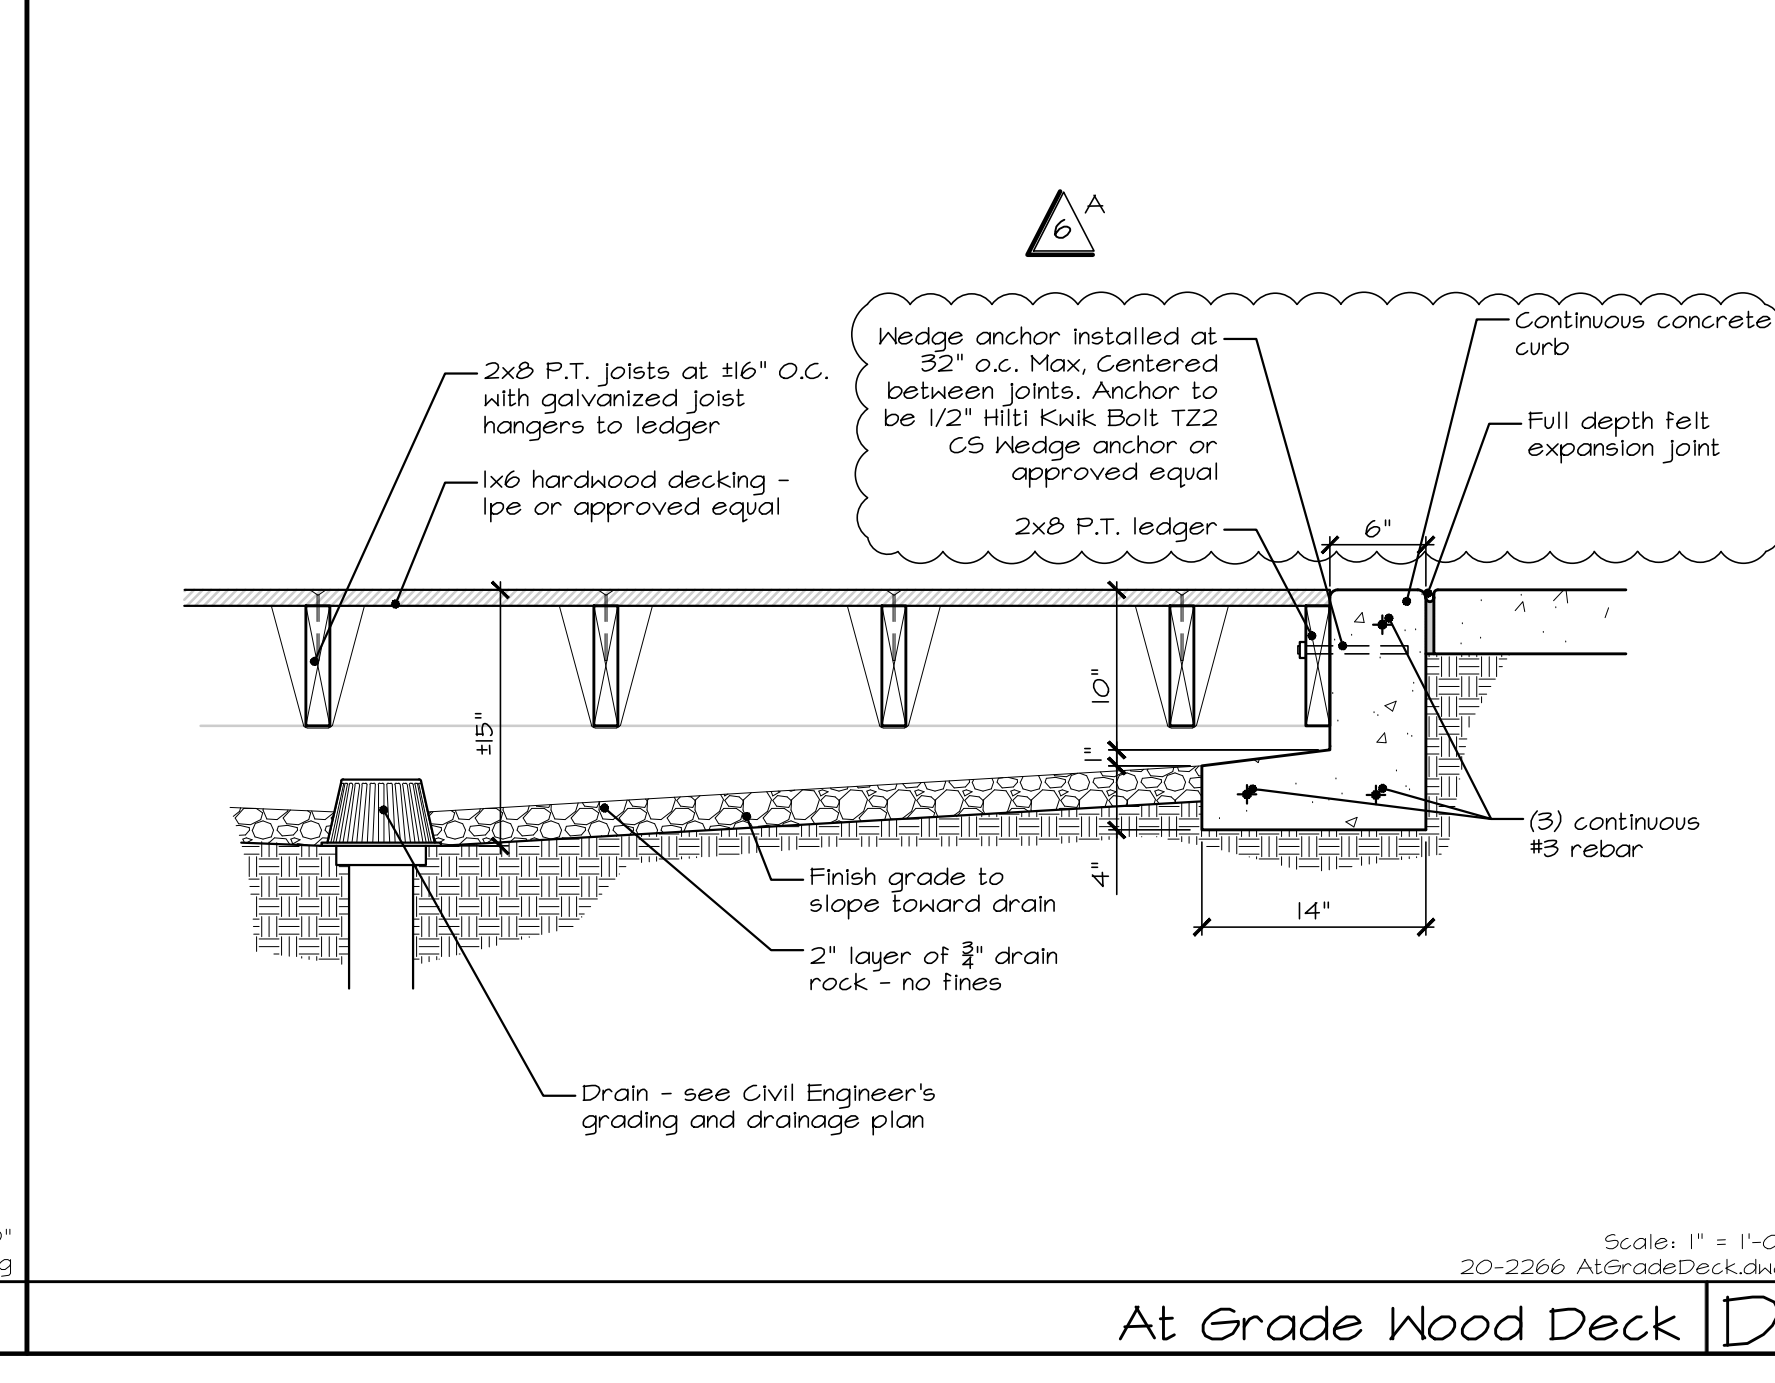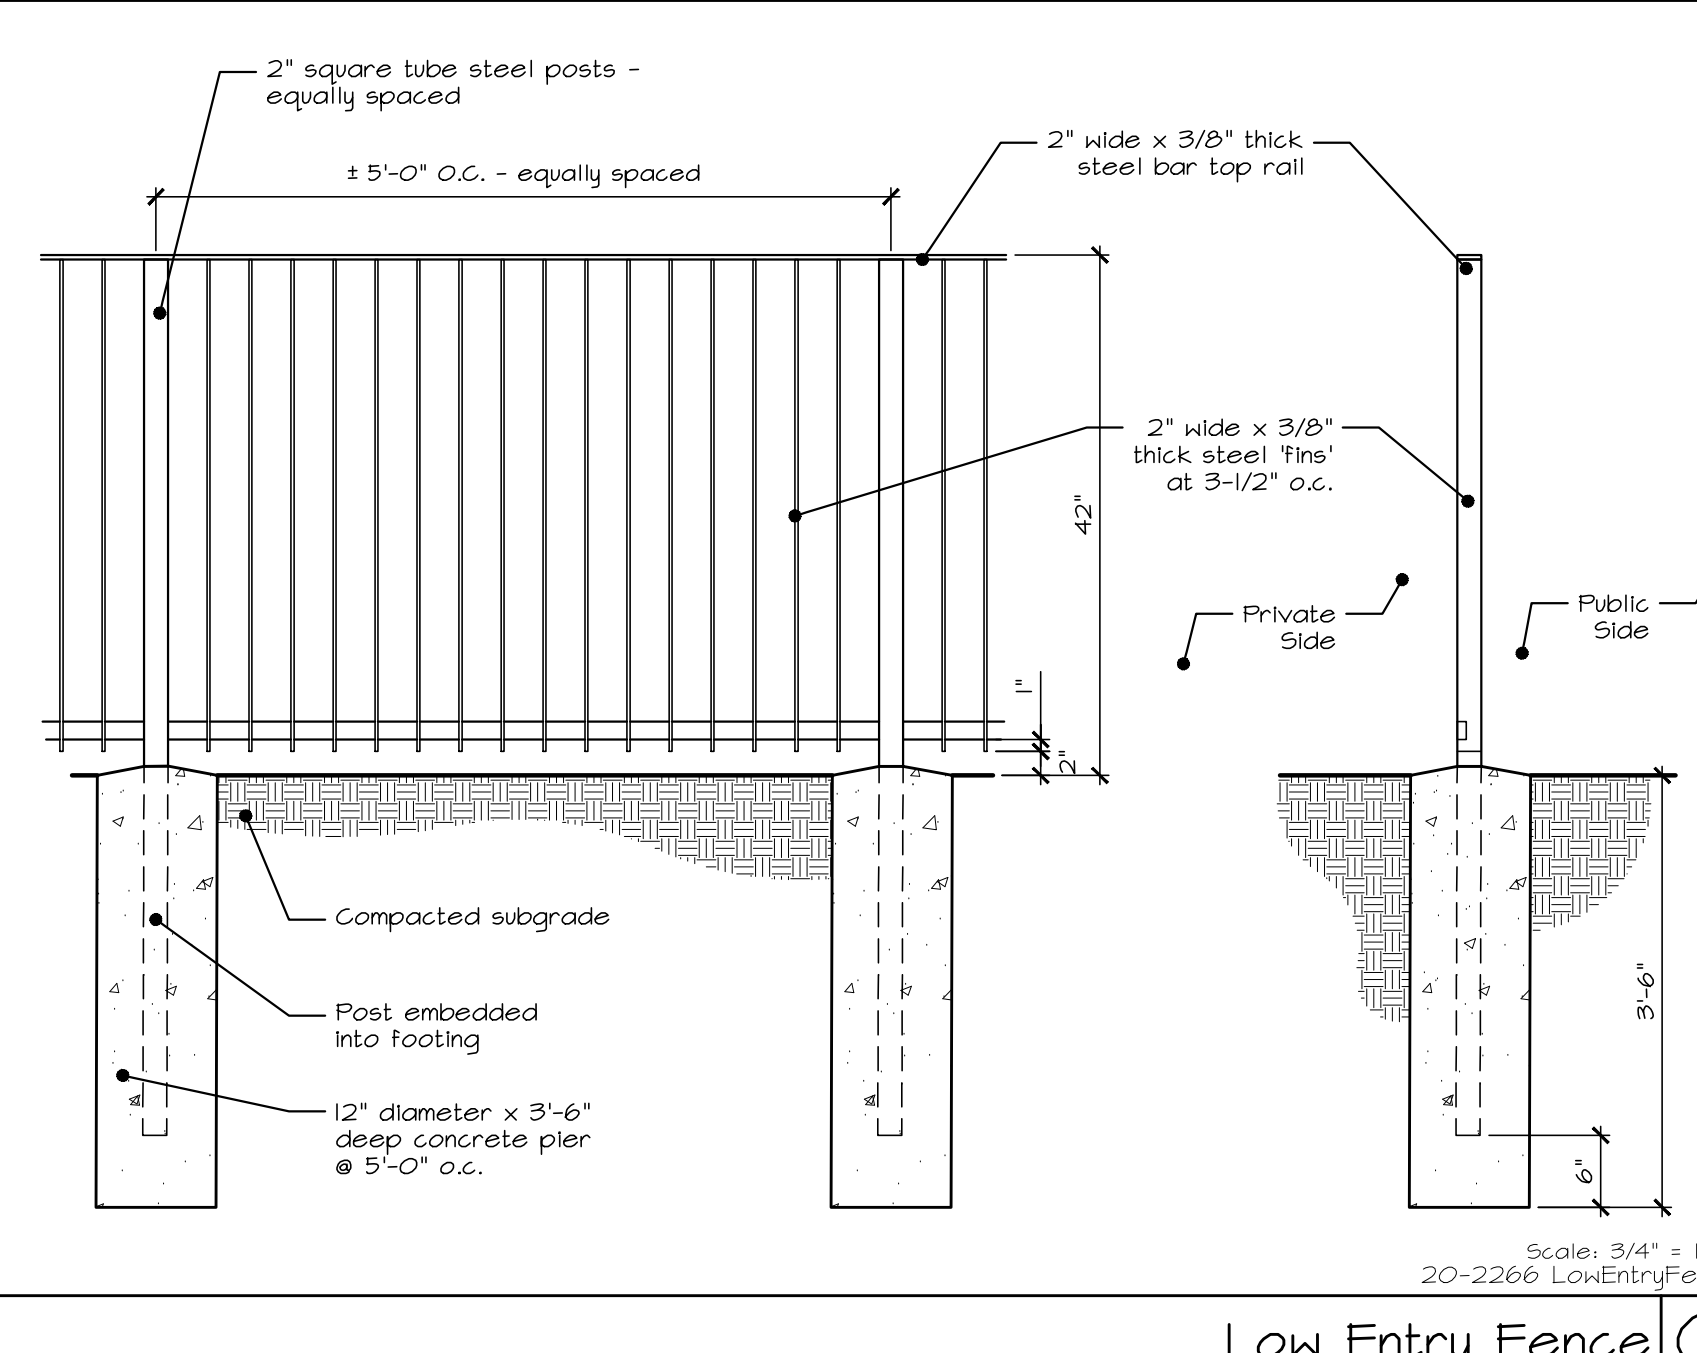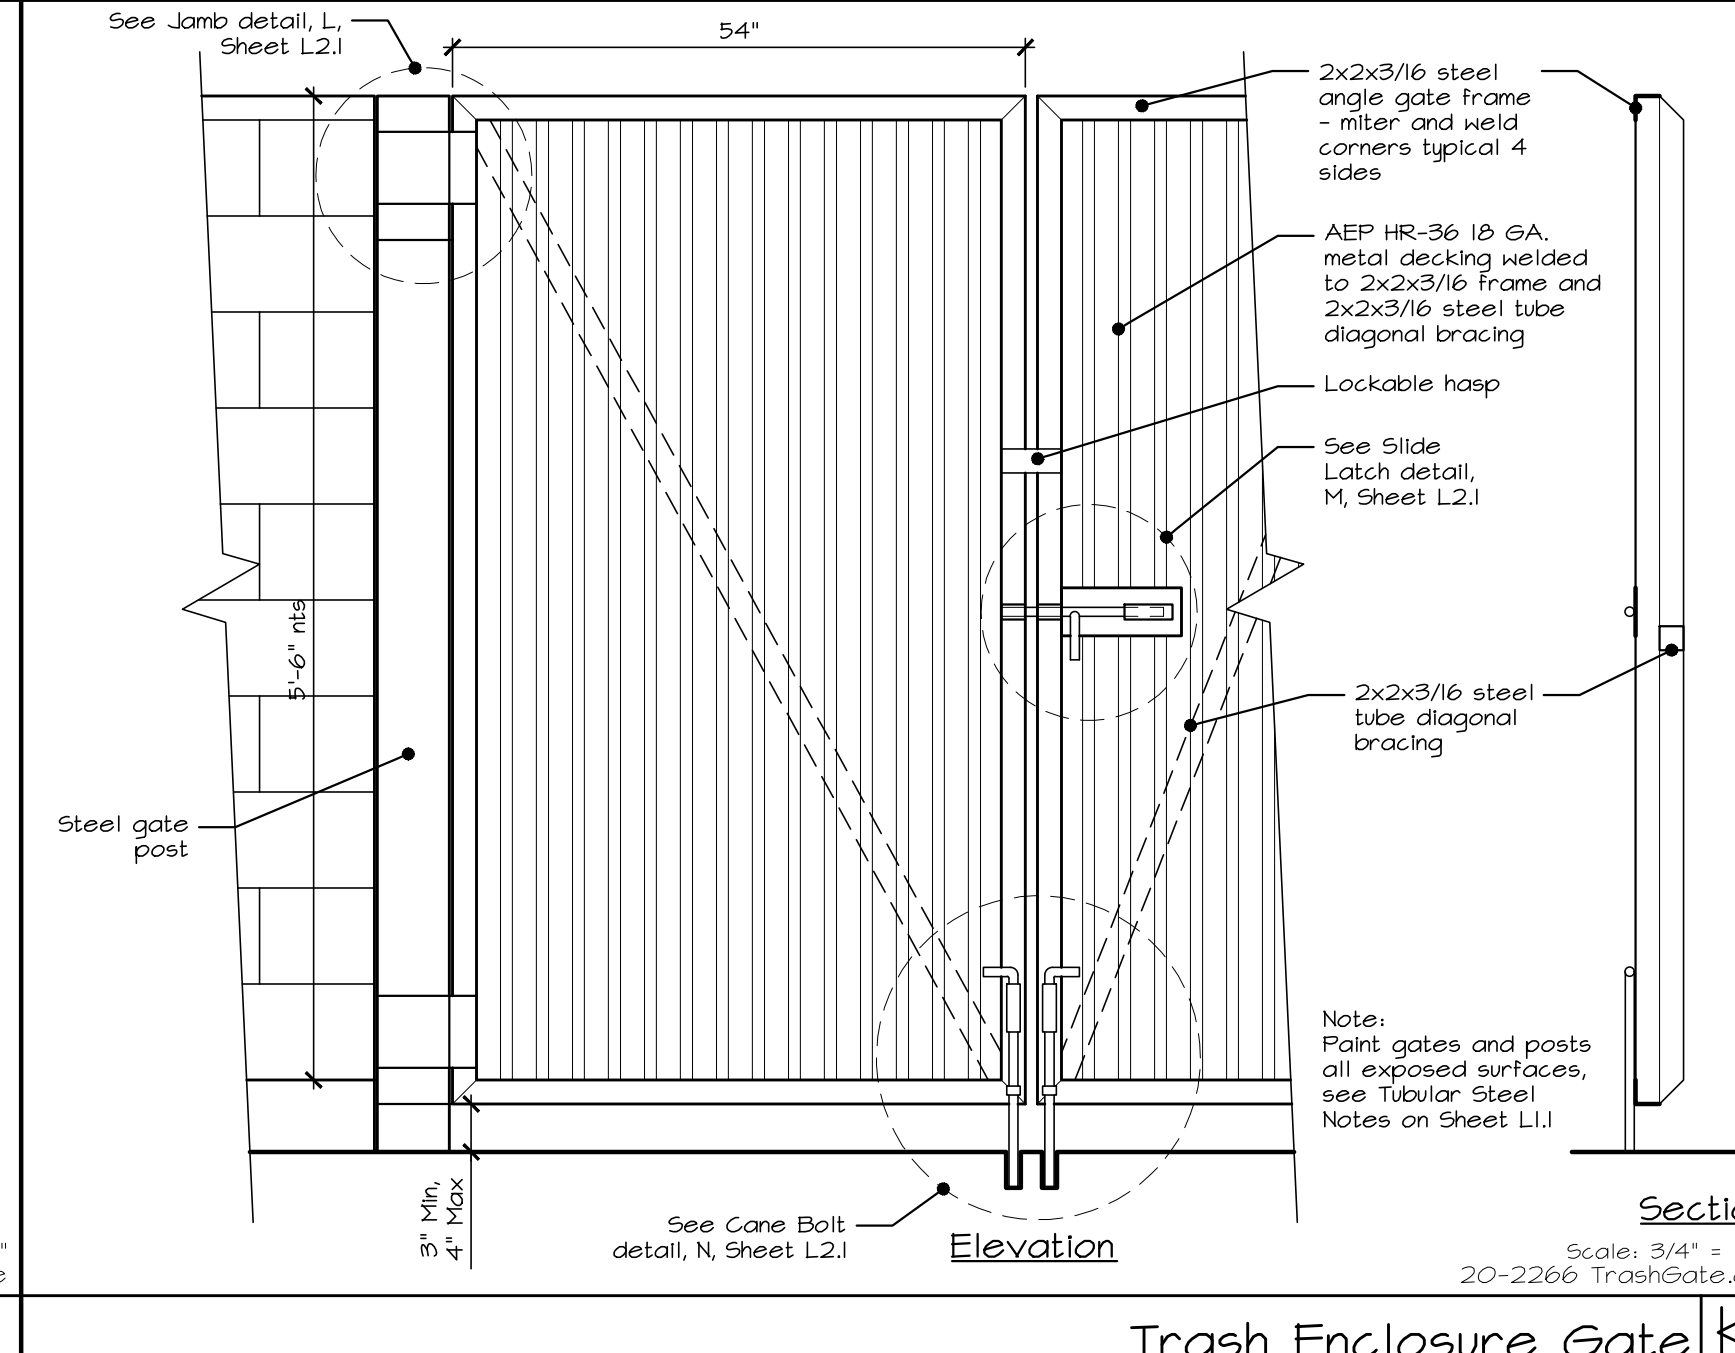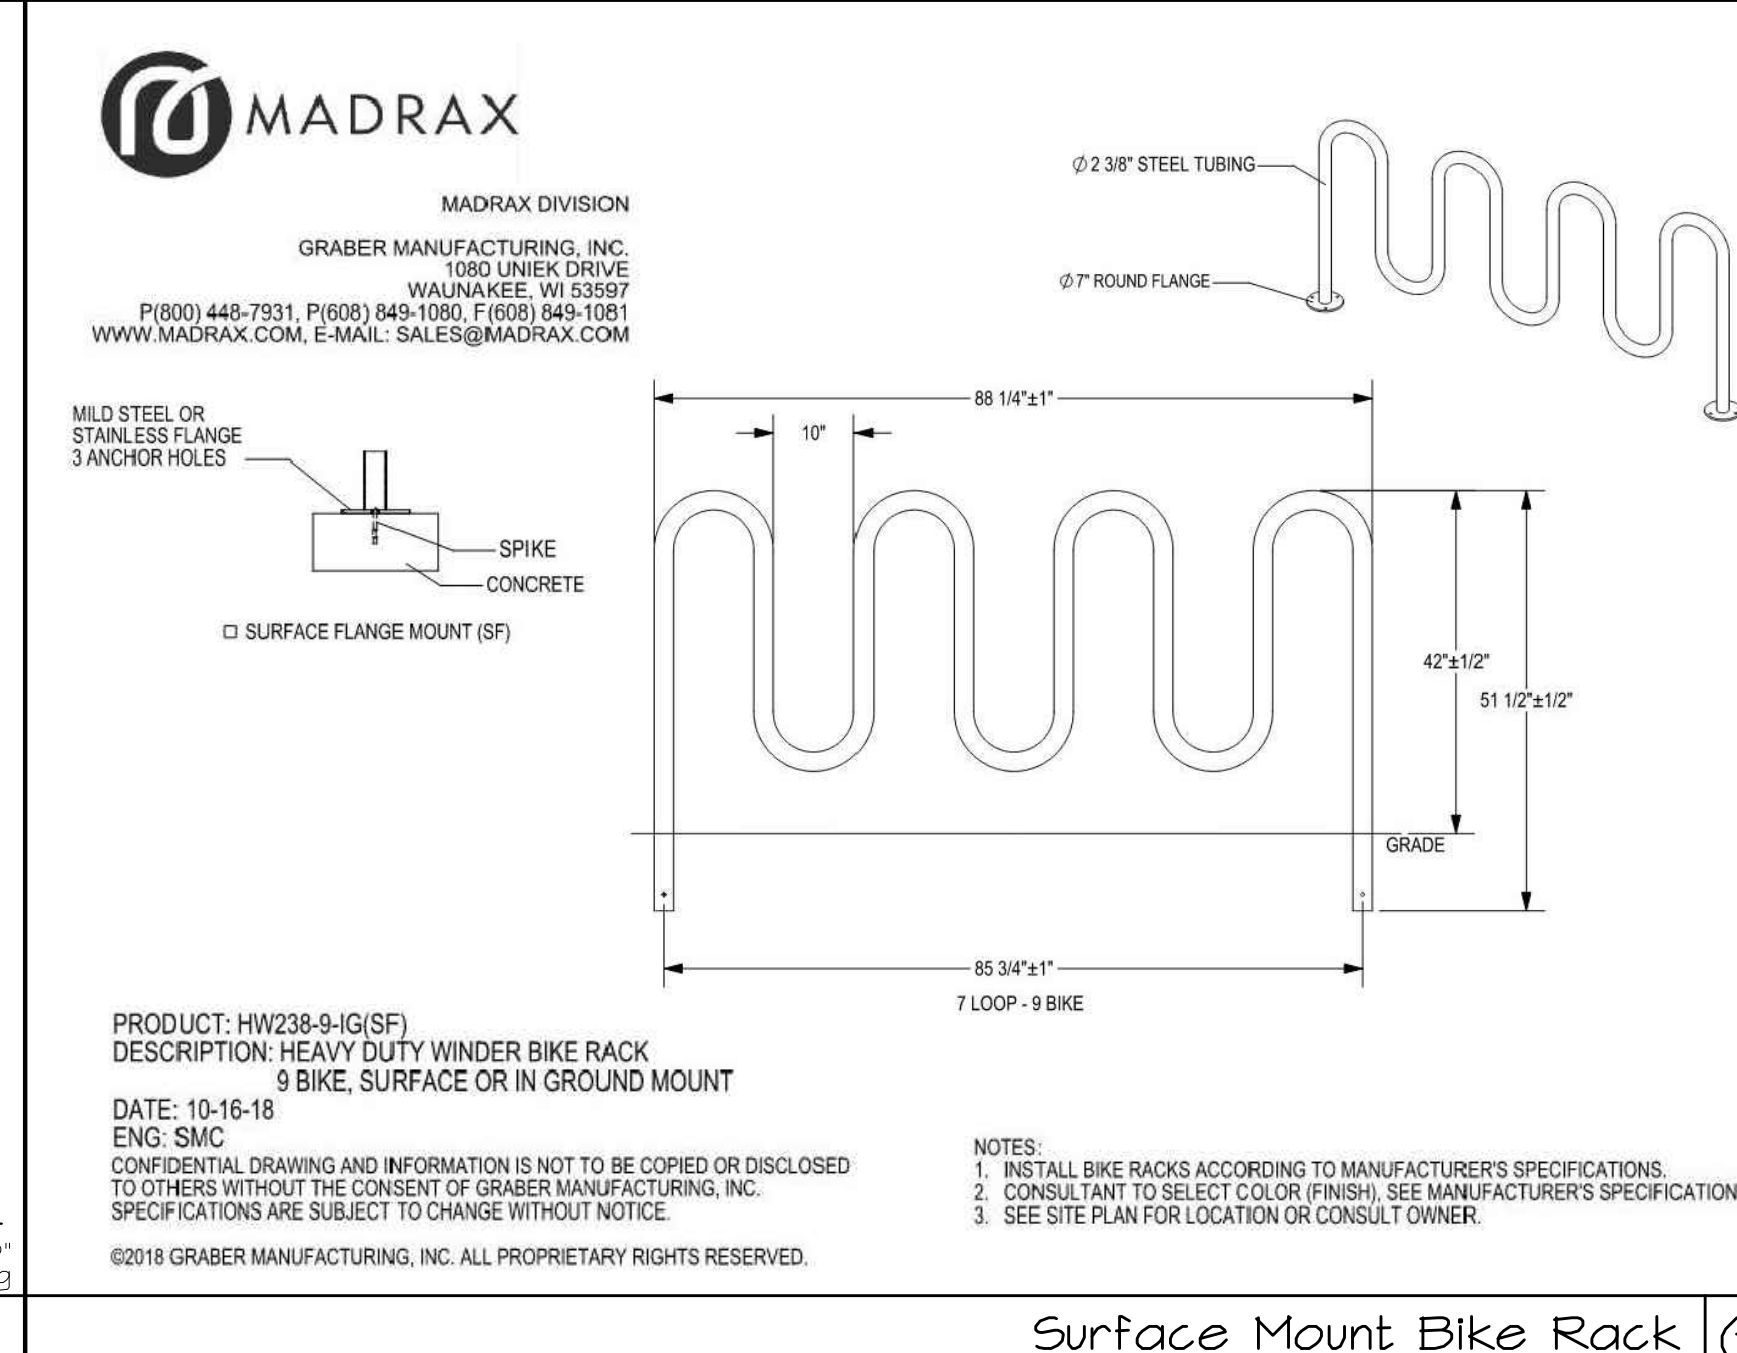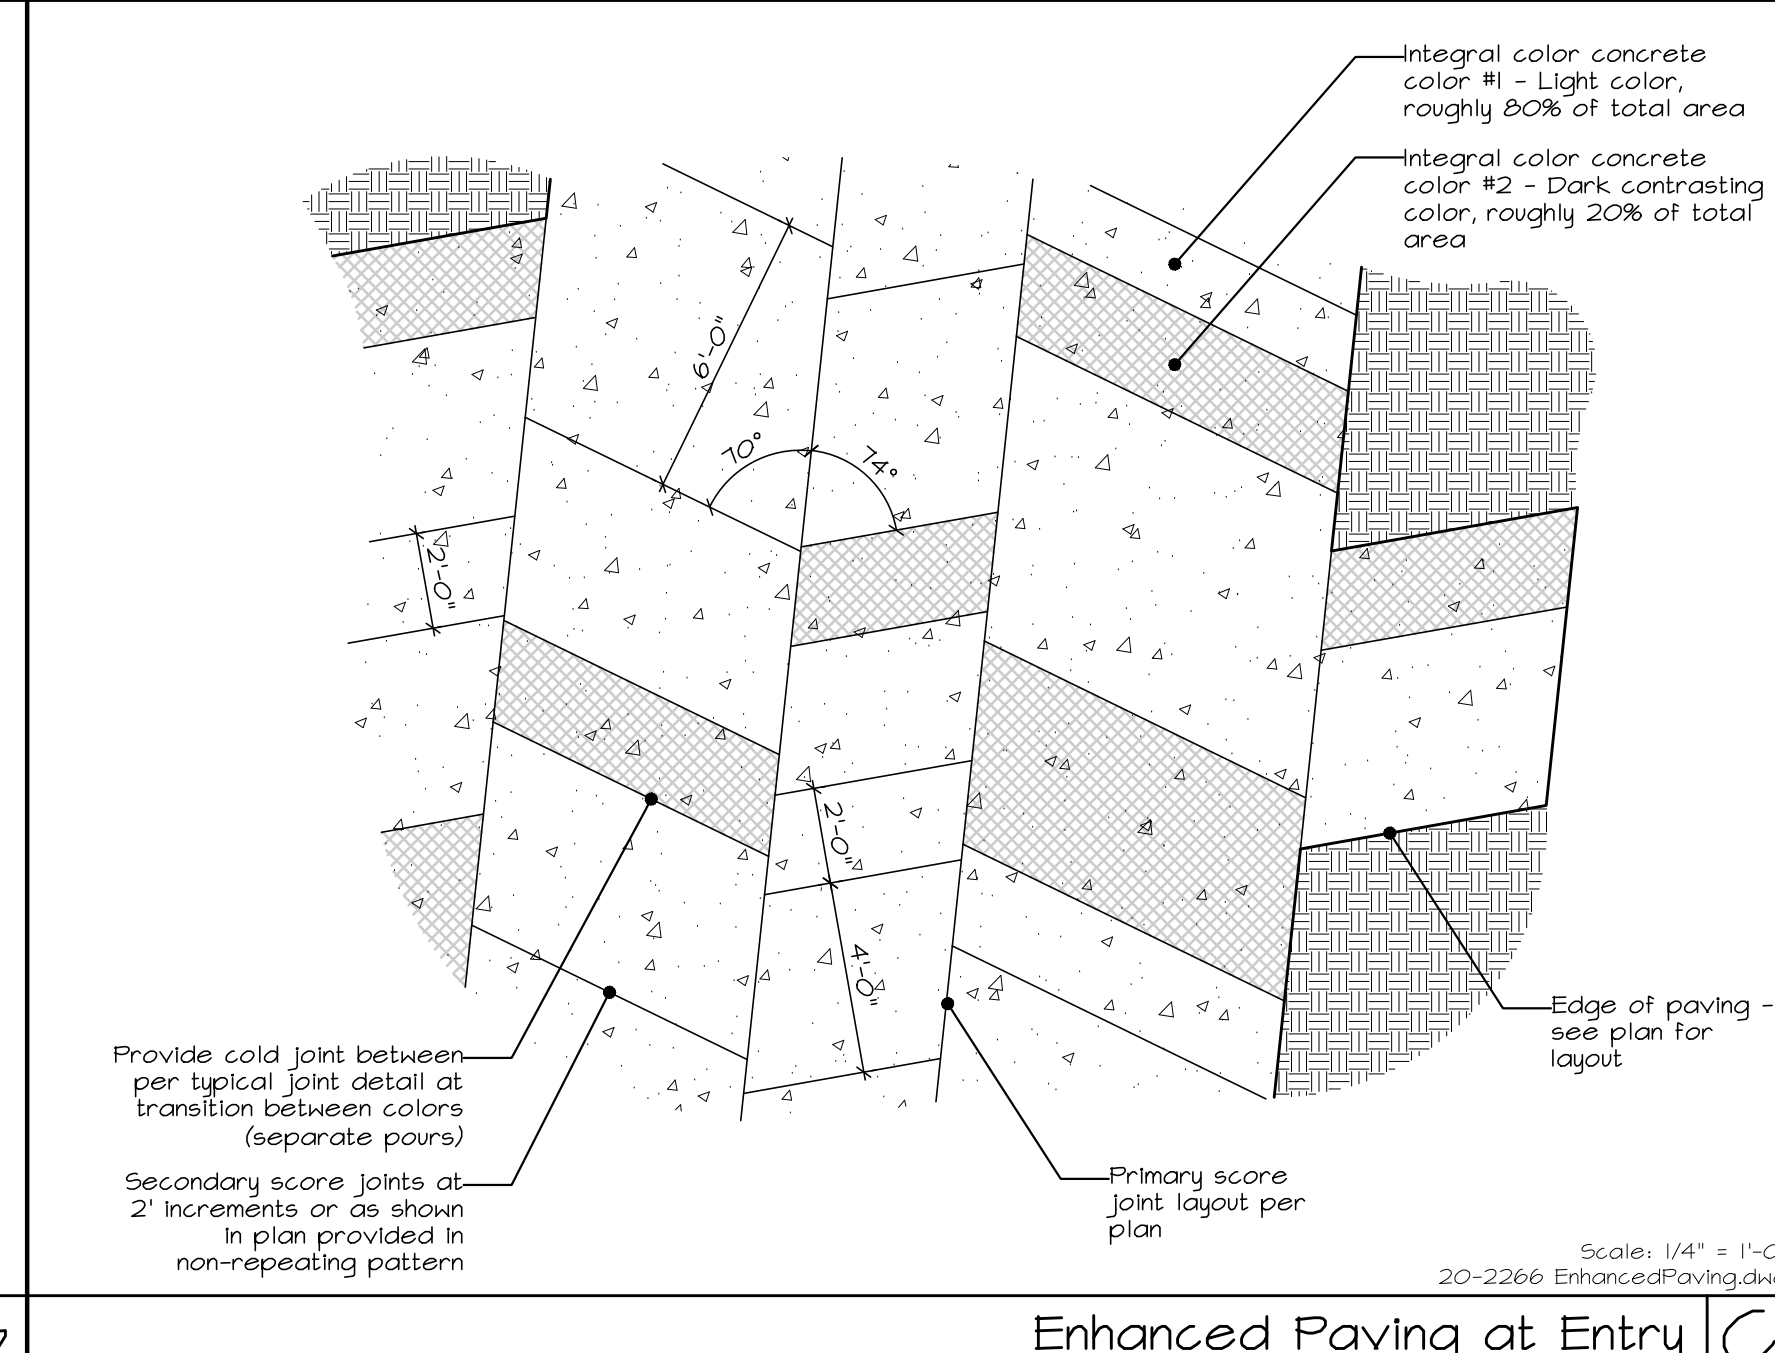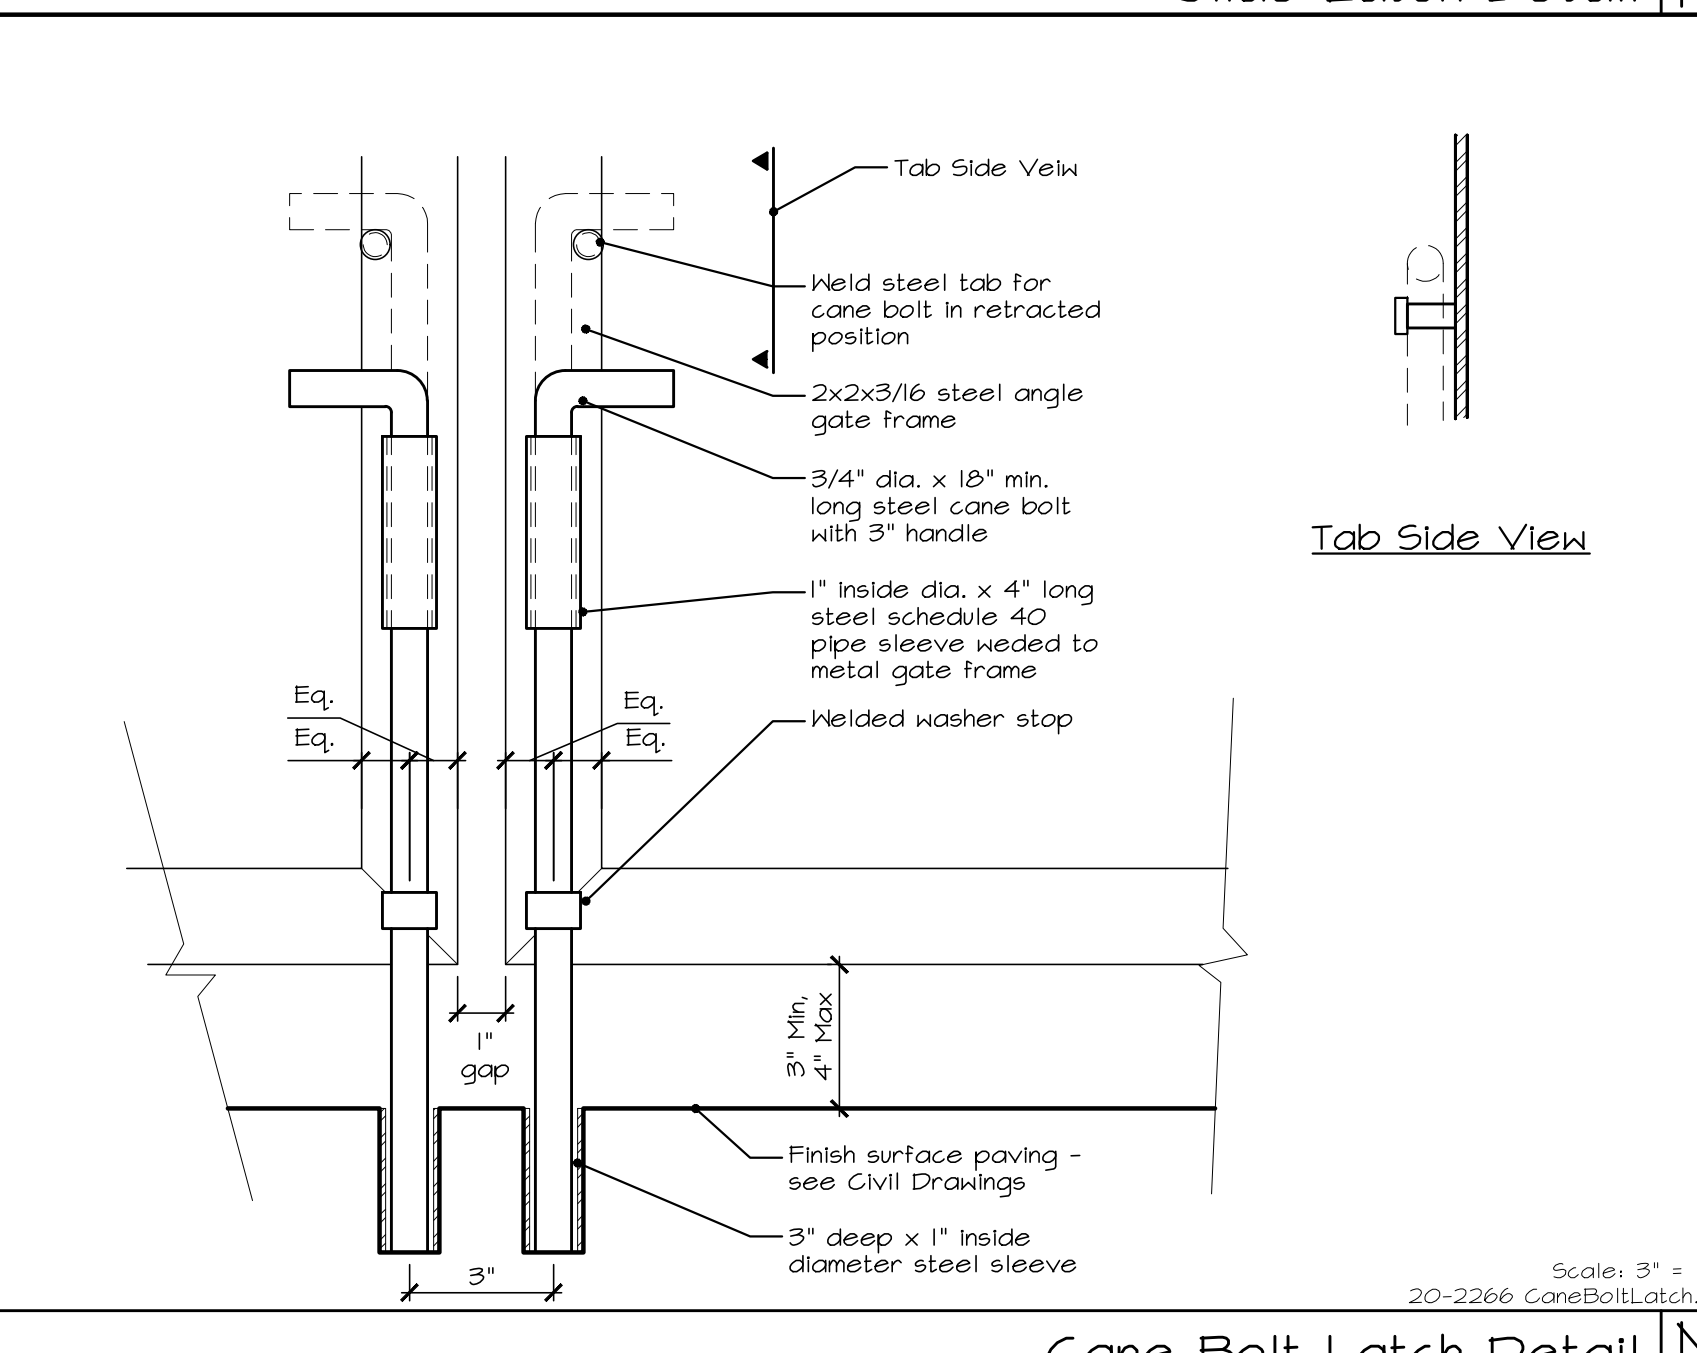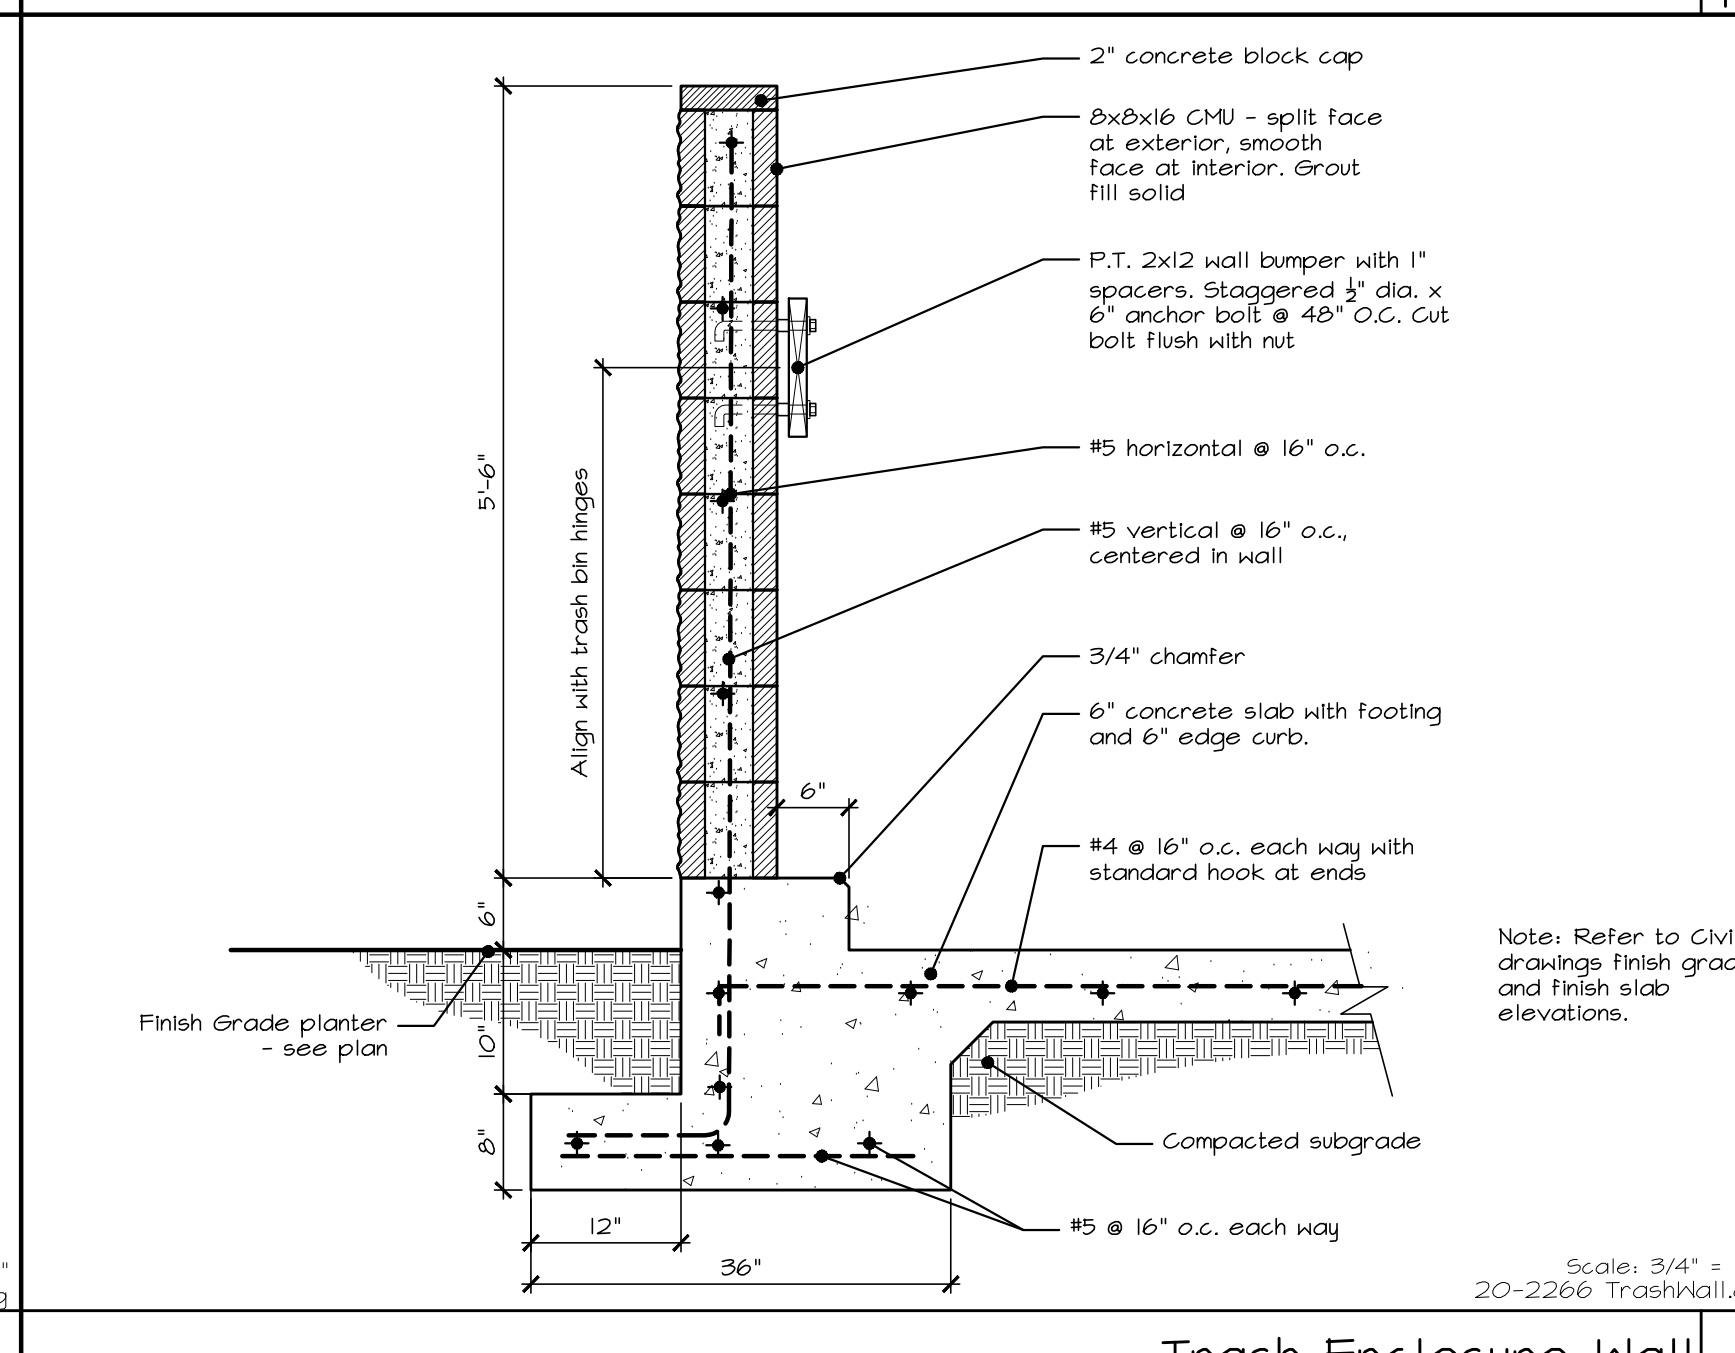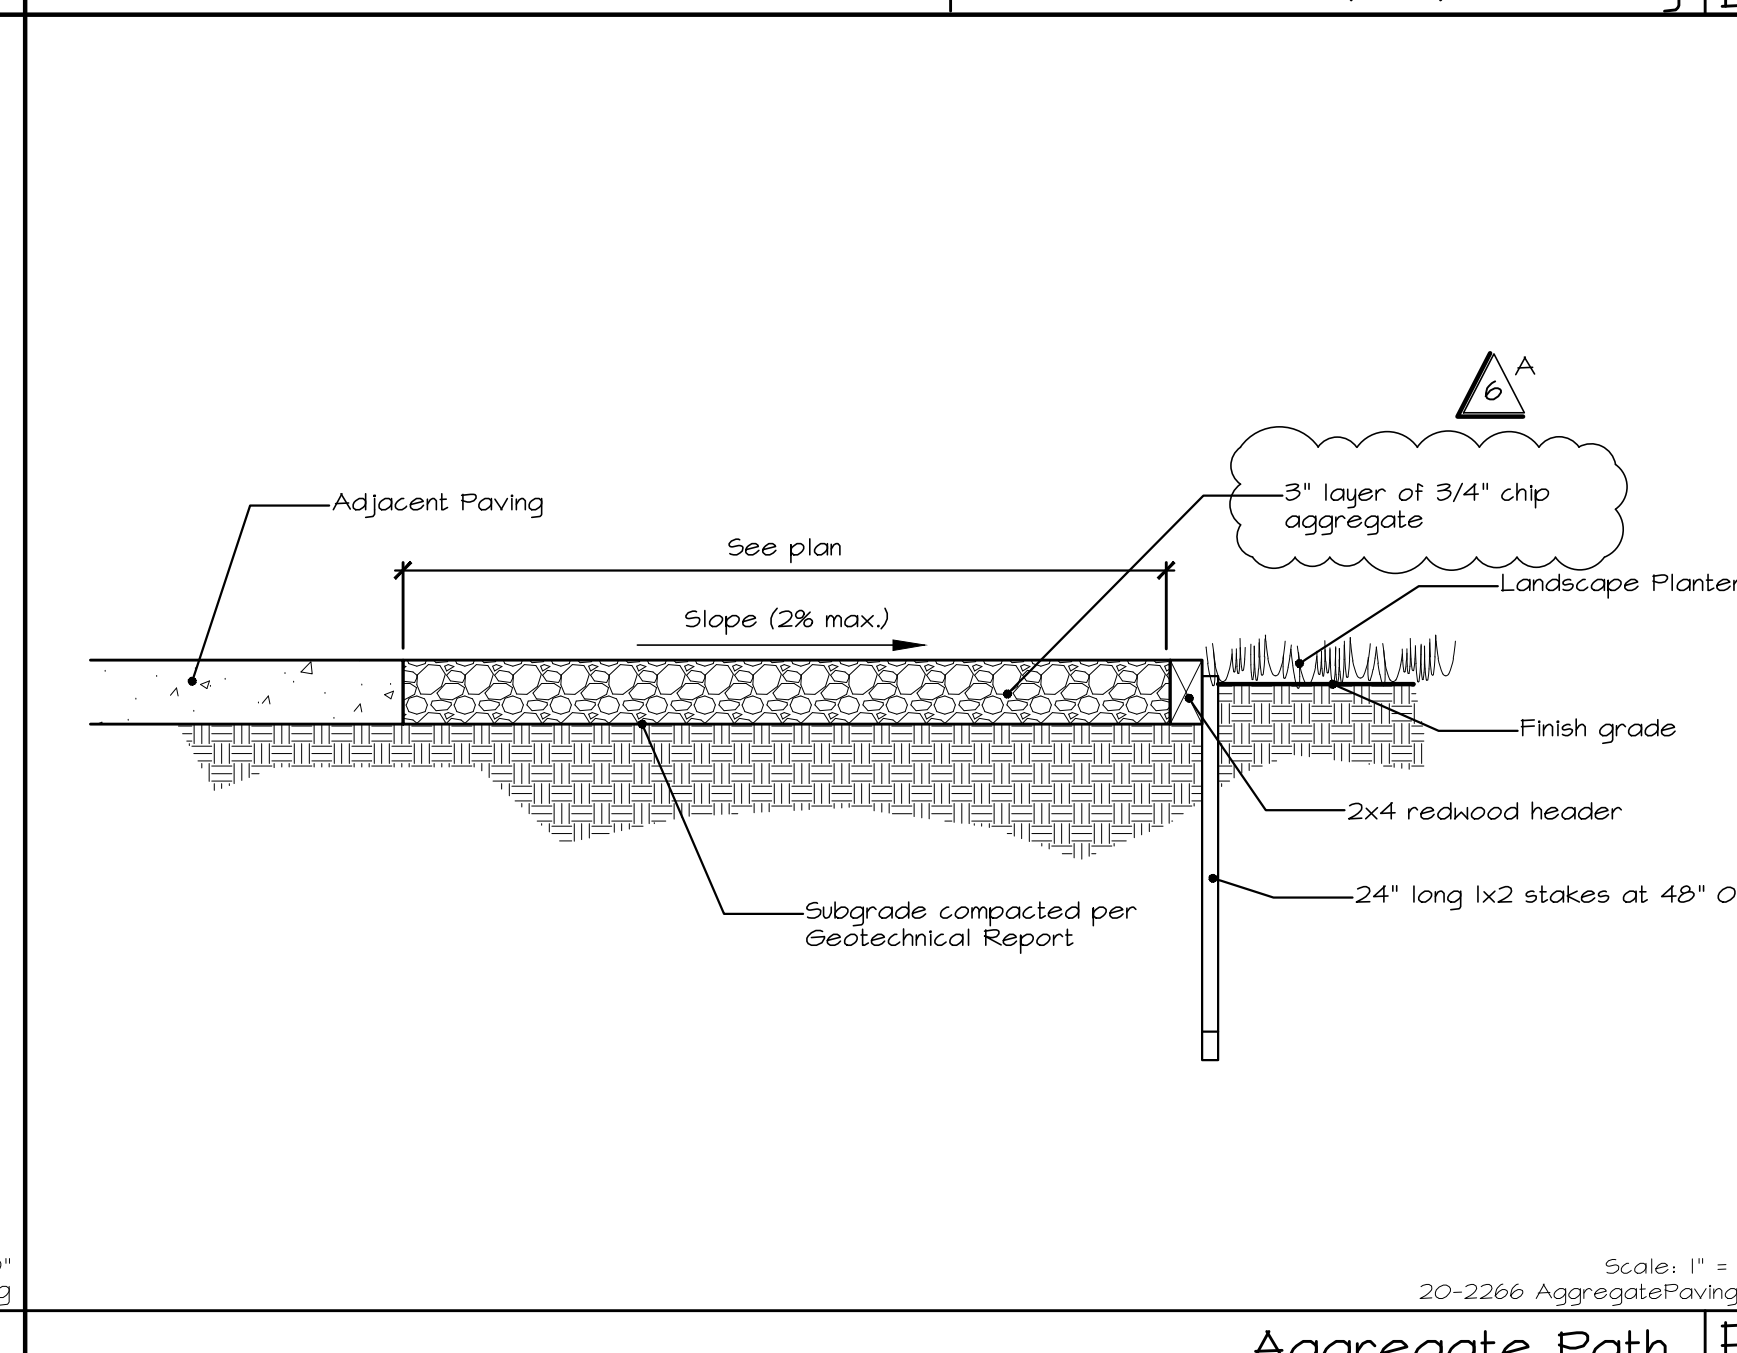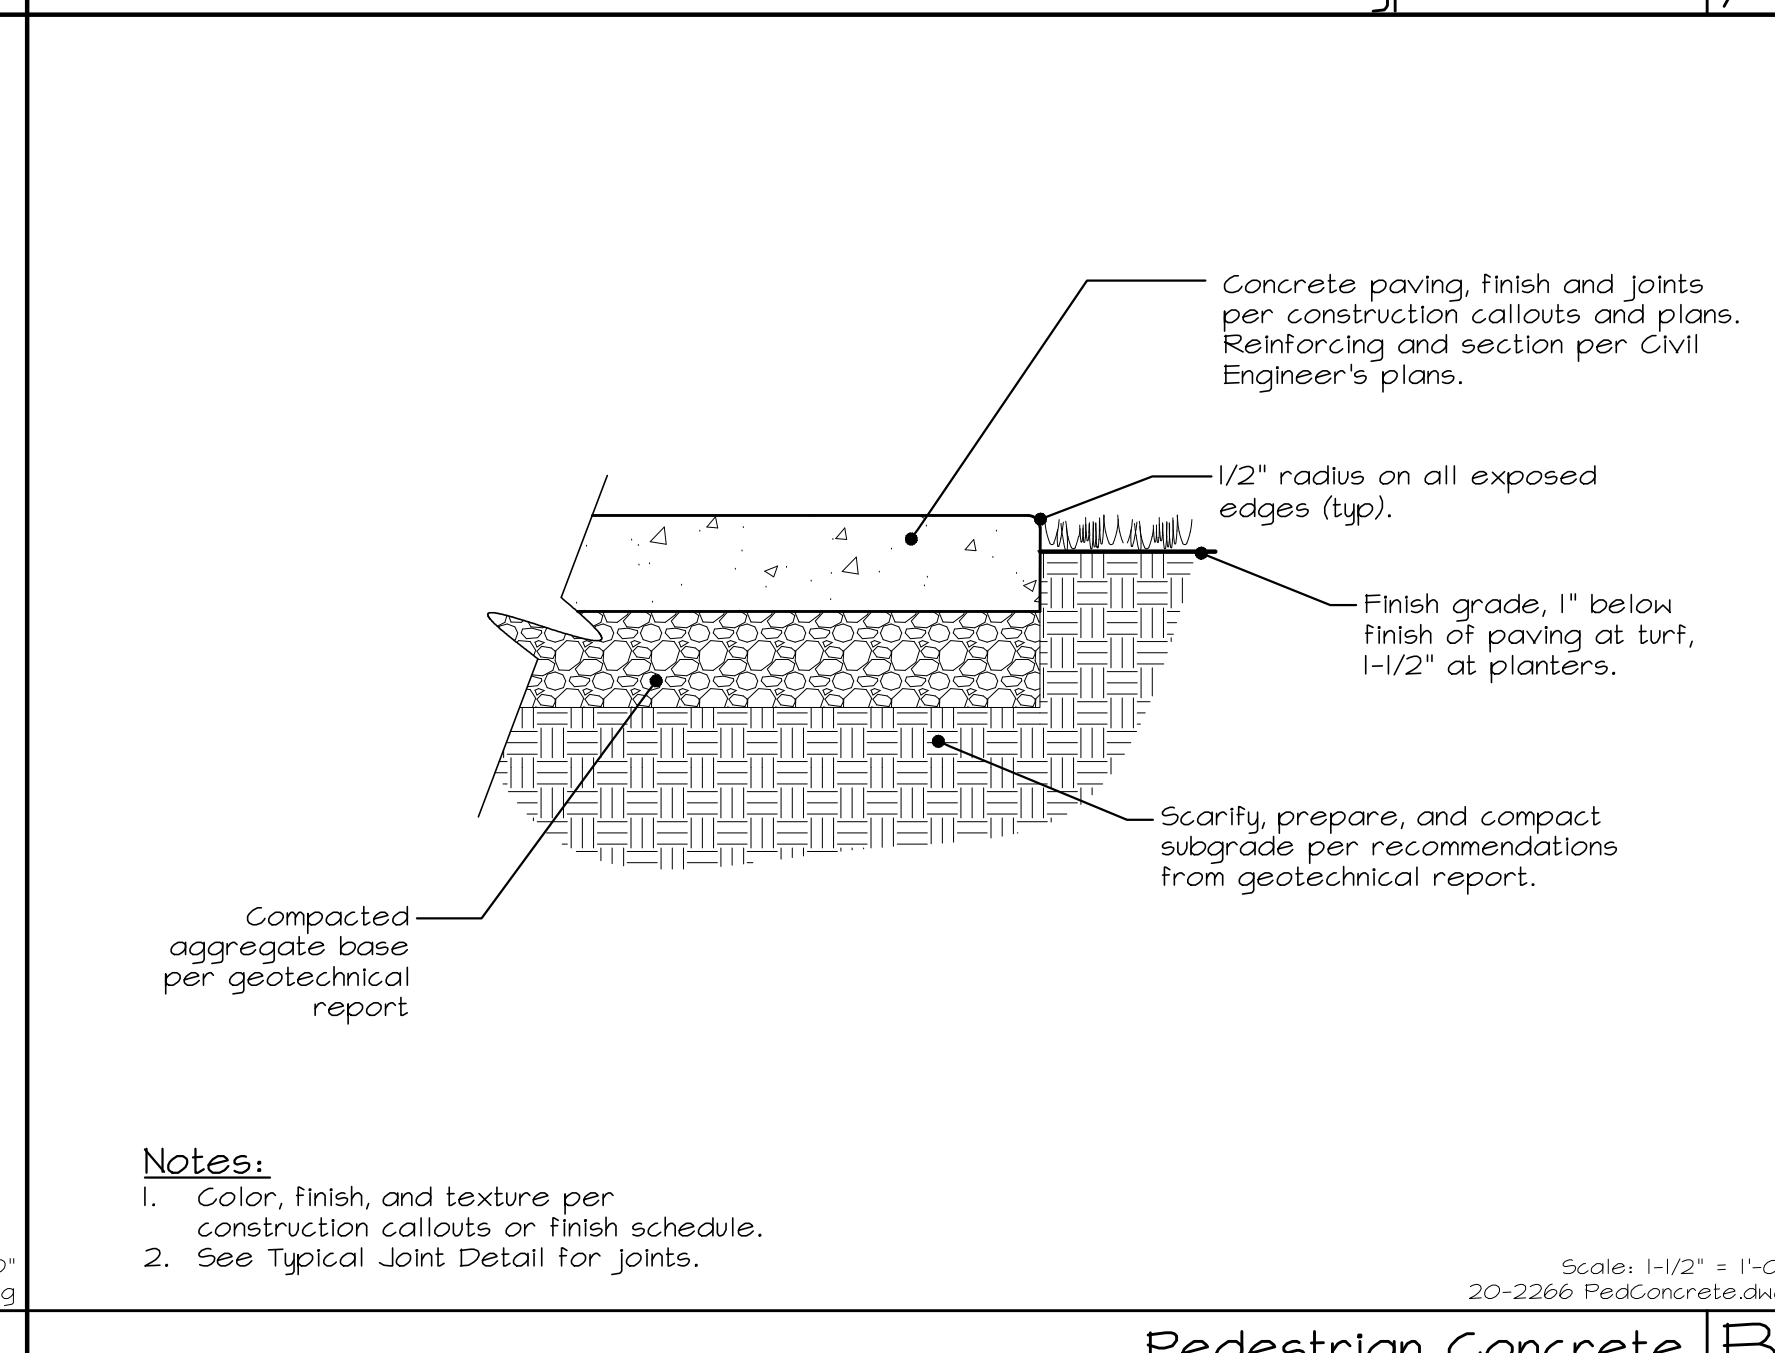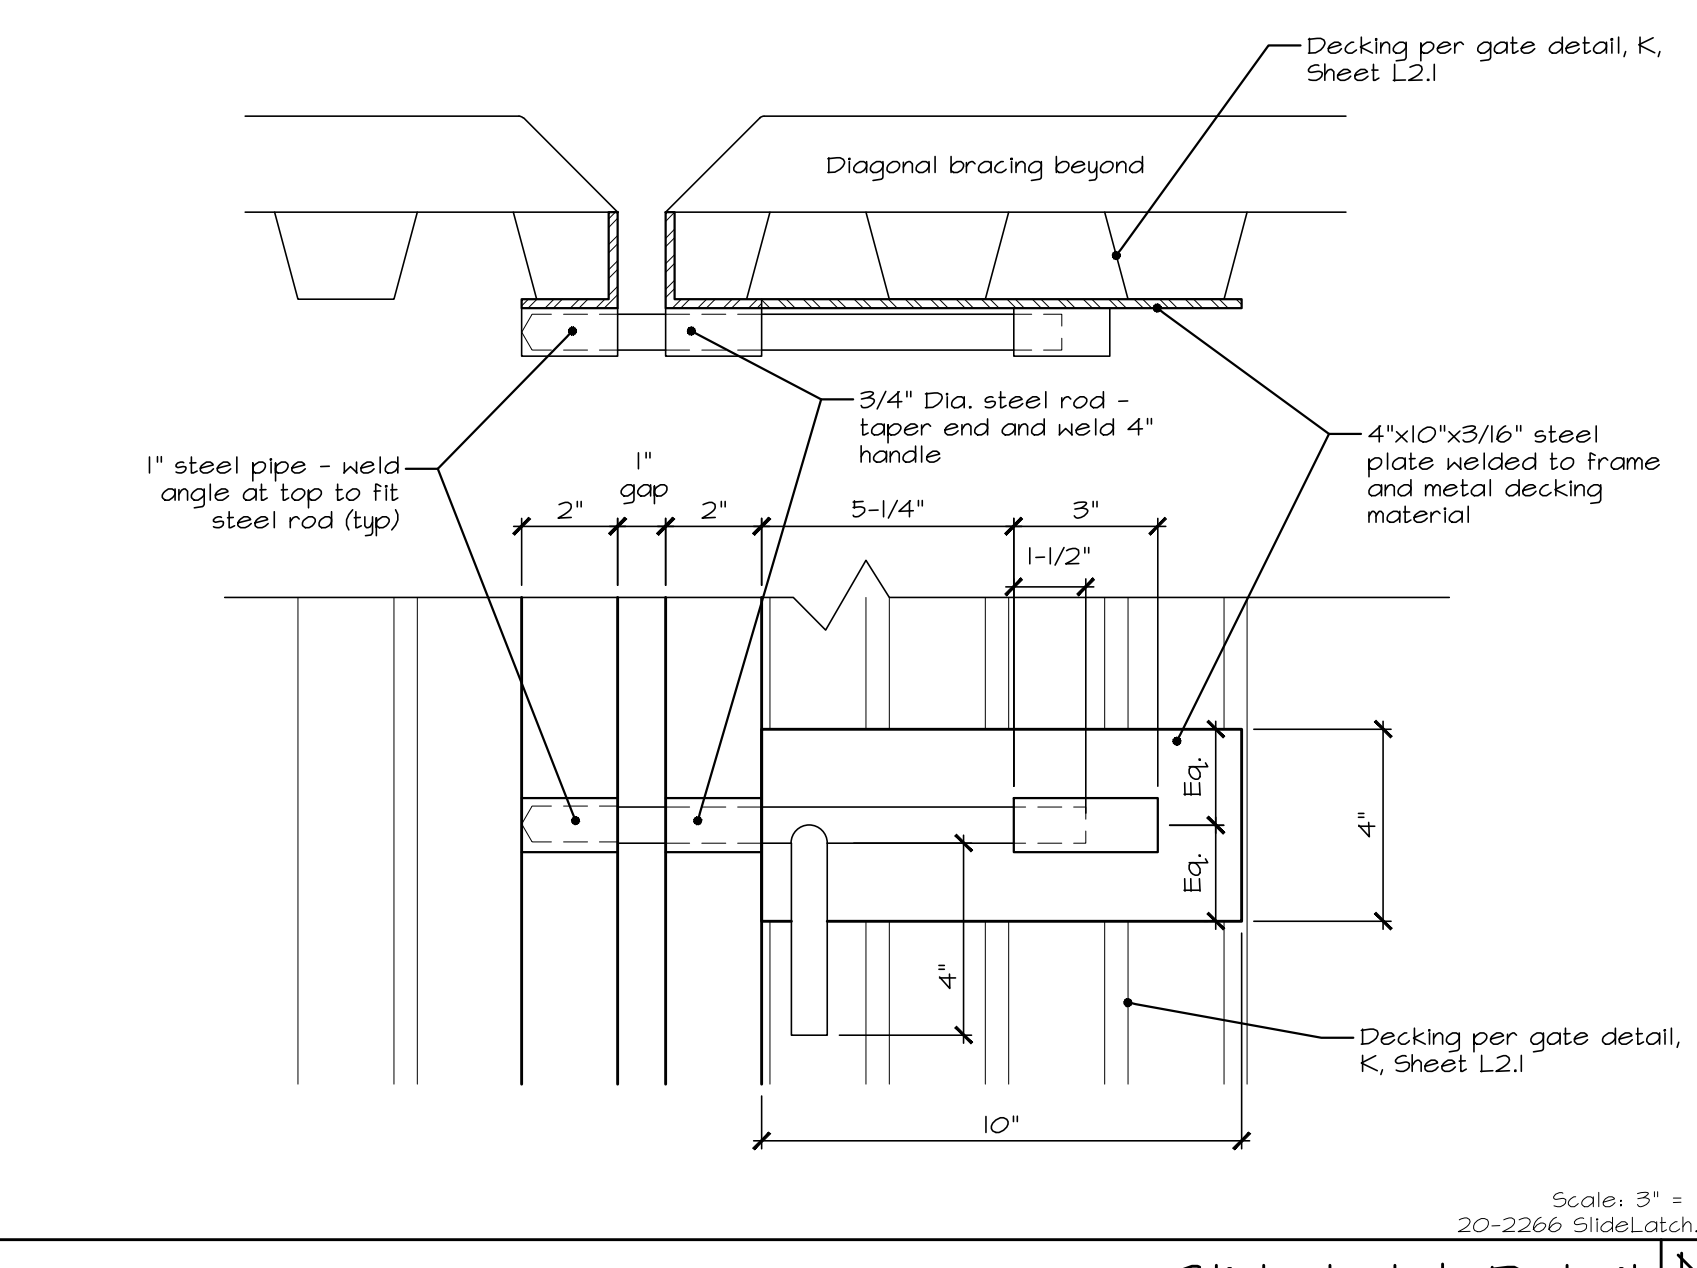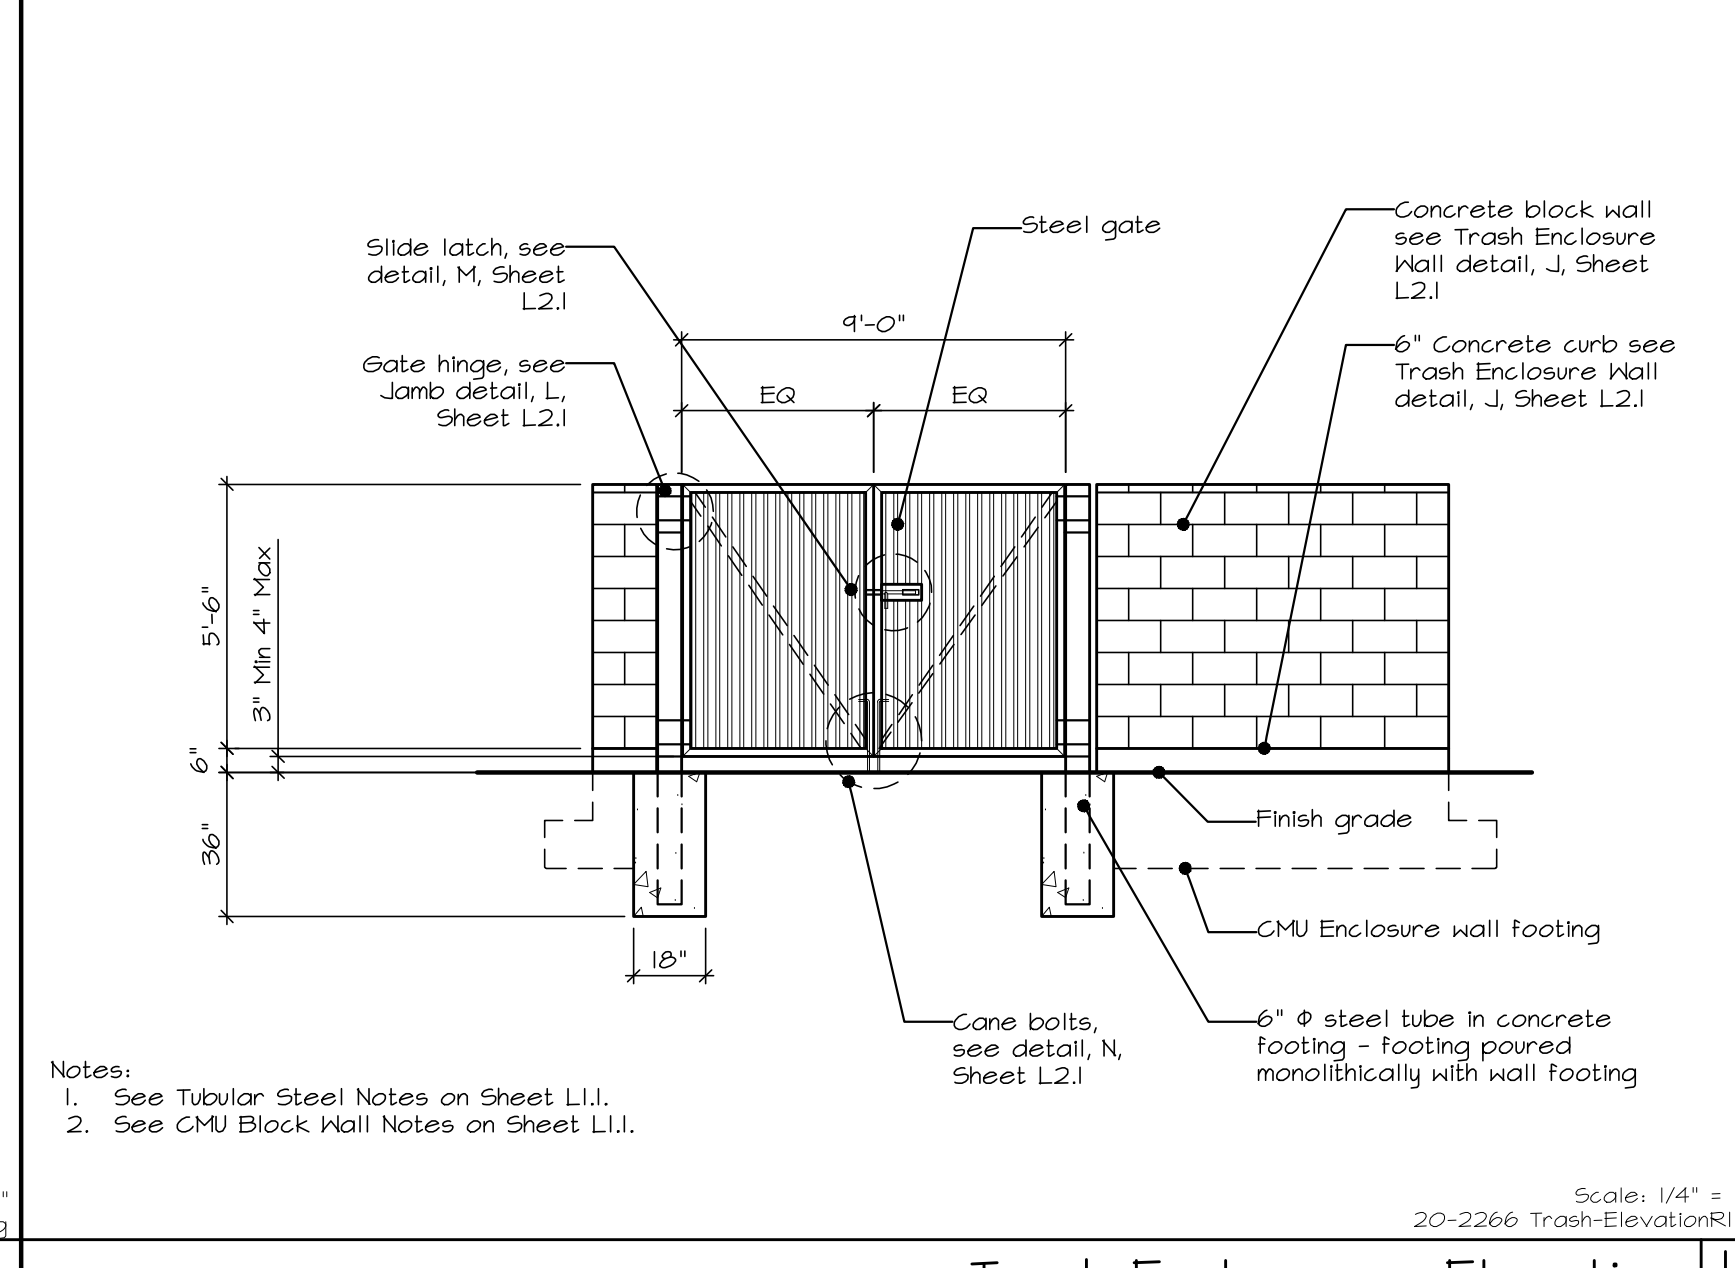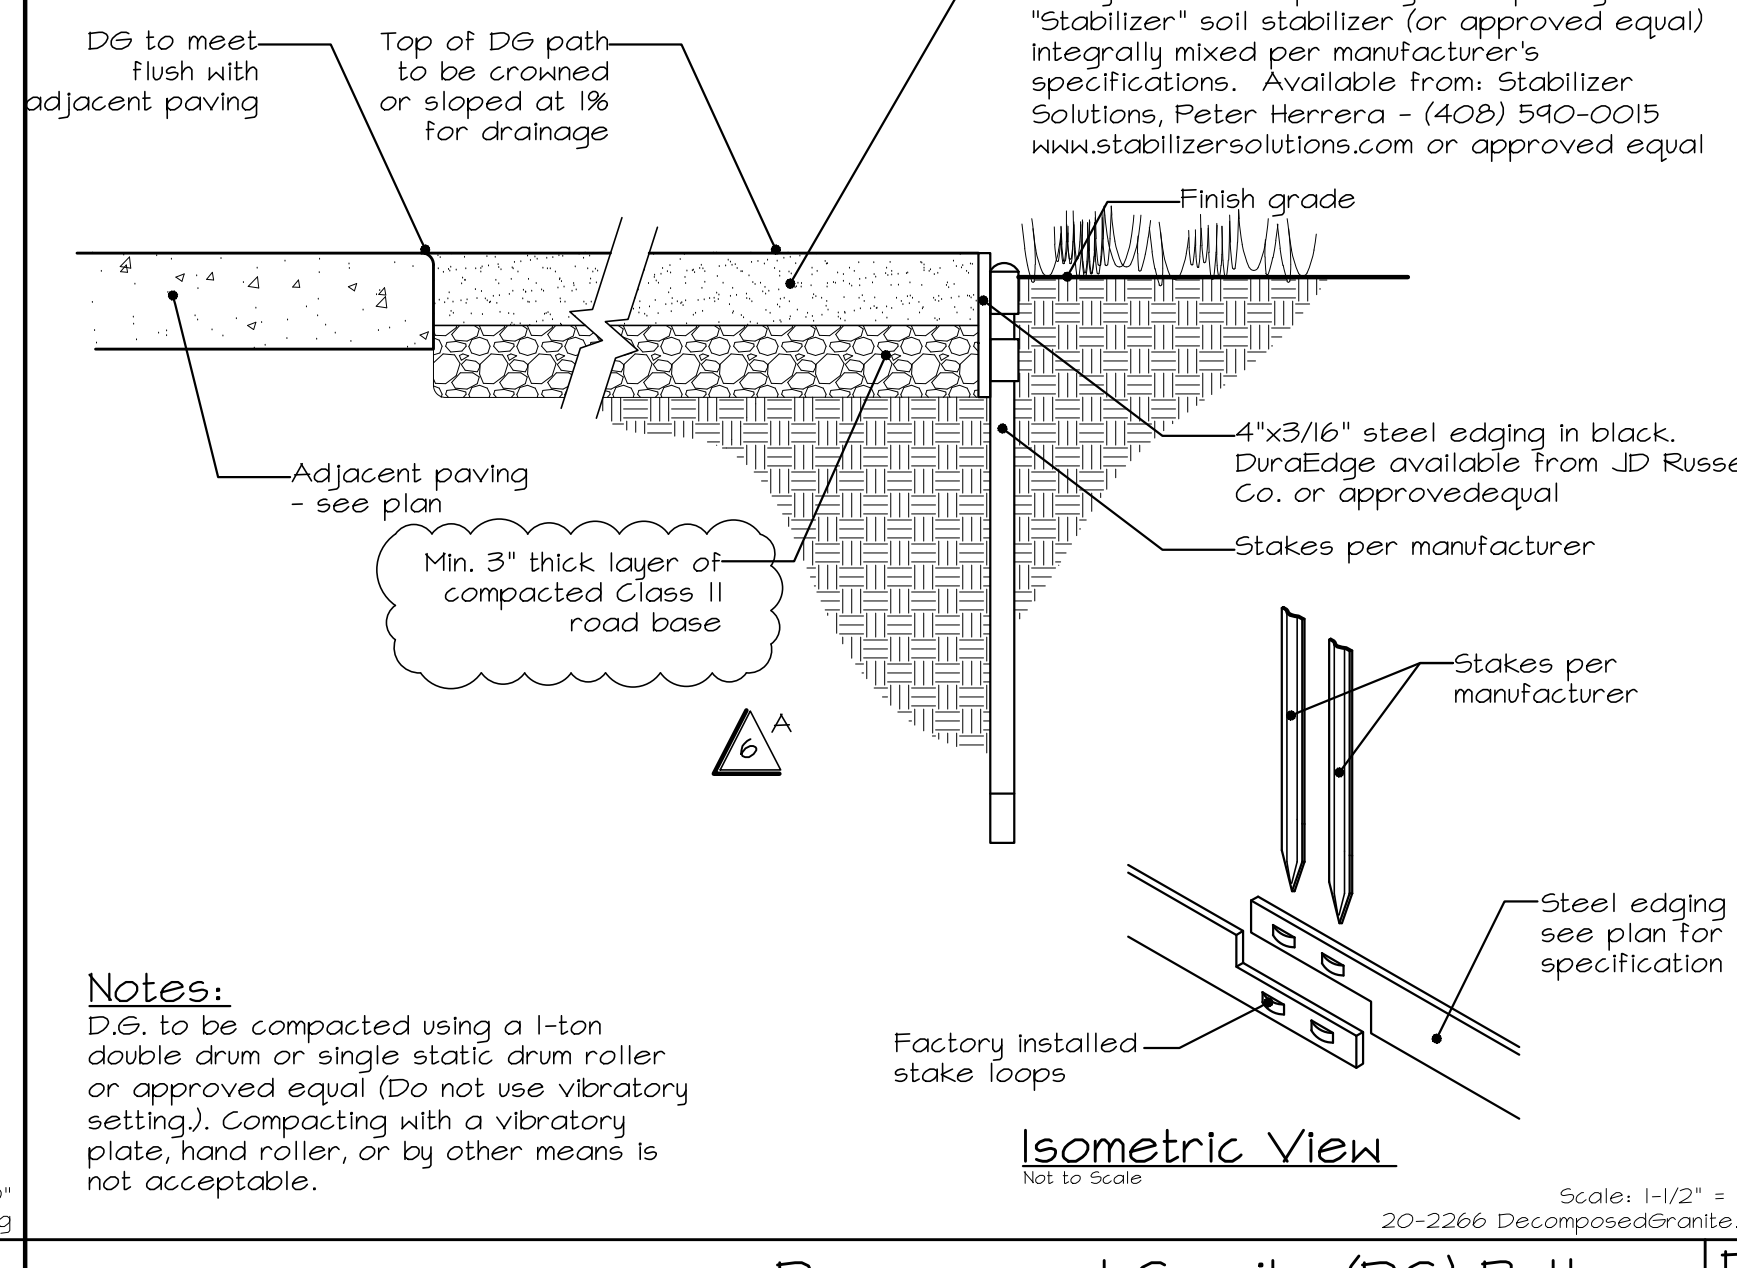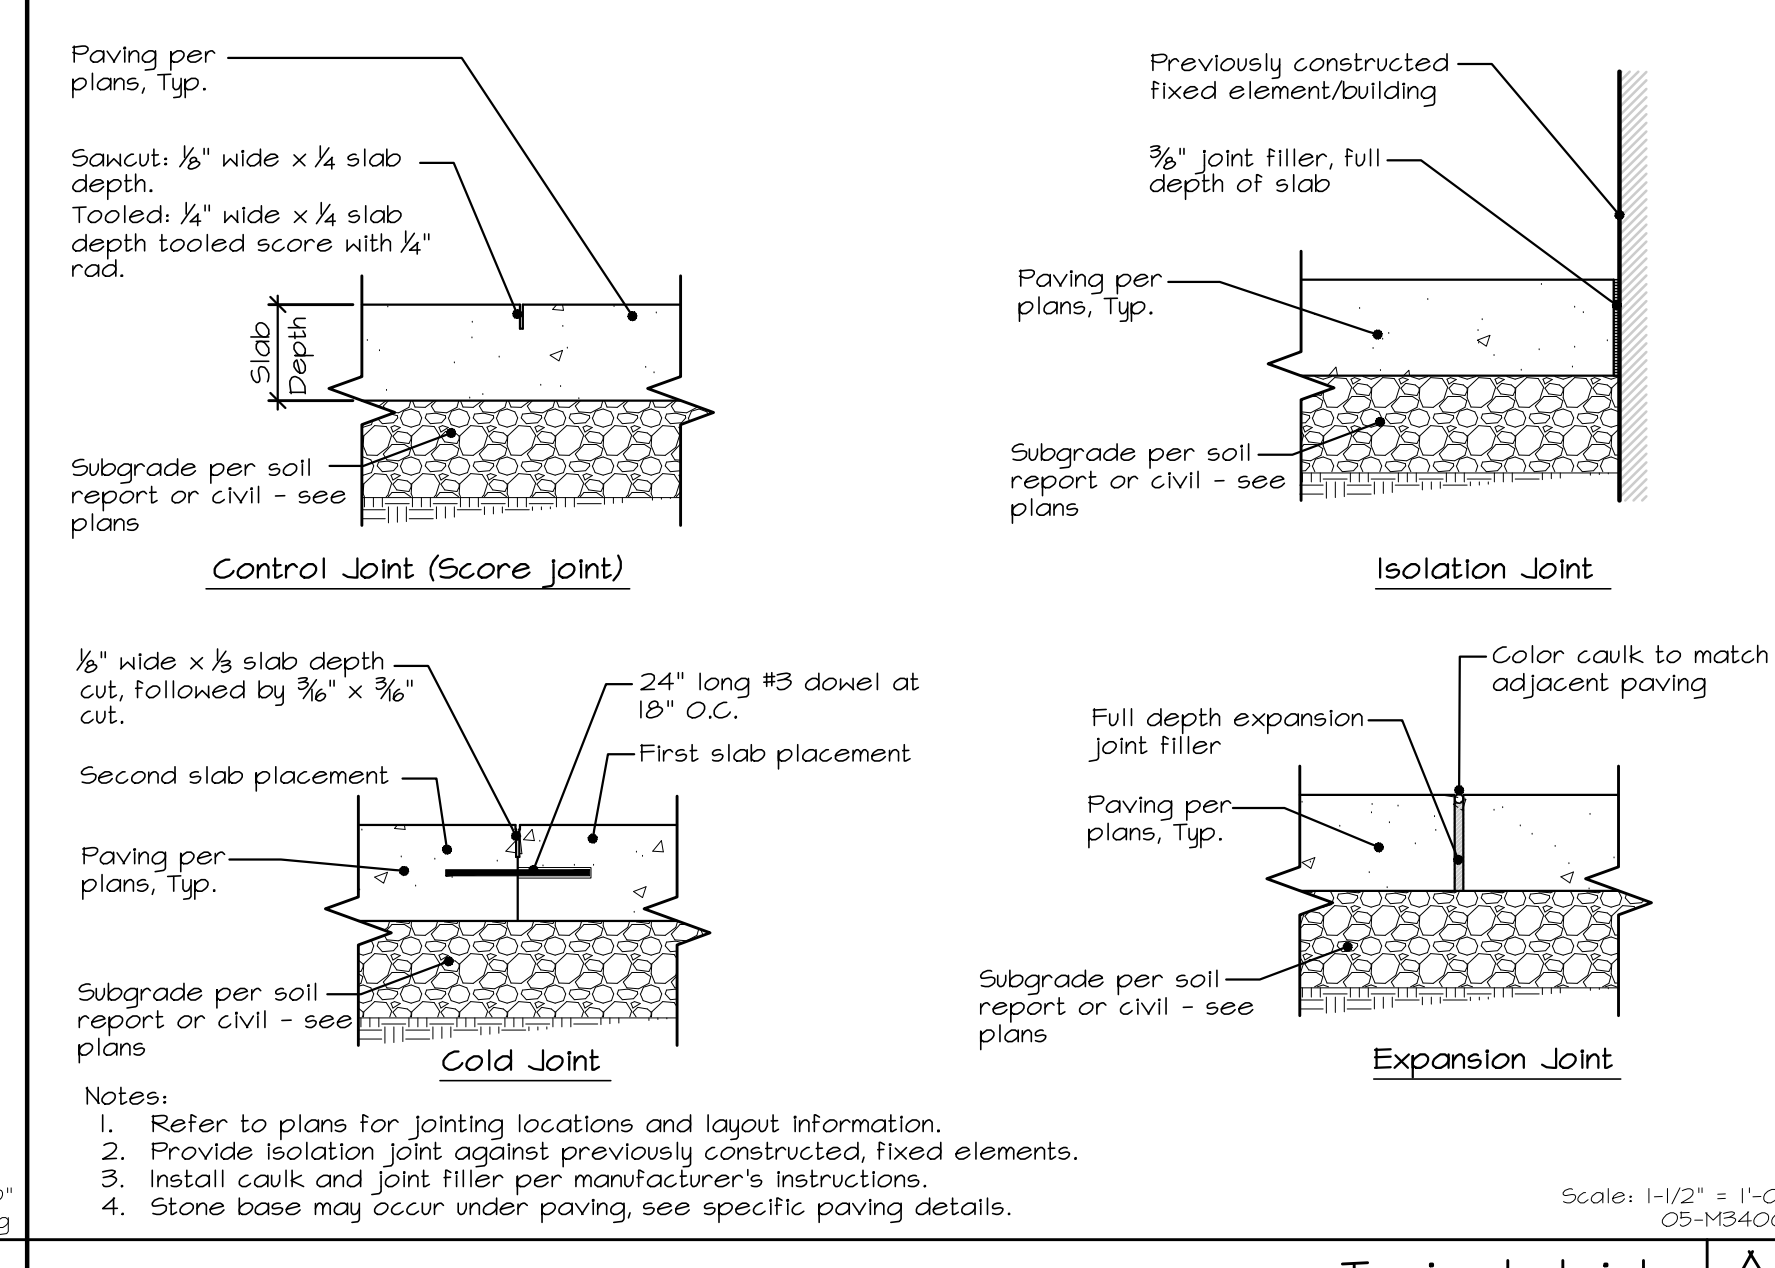

CSUS CHILD DEVELOPMENT CENTER

CALIFORNIA STATE UNIVERSITY, STANISLAUS ONE UNIVERSITY CIRCLE TURLOCK, CA 95362



PIER 1, BAY 2 THE EMBARCADERO SAN FRANCISCO, CA 94111

INFO@EHDD.COM +1 415-285-9193

Consultant



Stamp



Printing	Date
95% CONSTRUCTION DOCUMENTS	08.25.2021
PERMIT SET	08.18.2021
PERMIT SET - DSA V2	12.15.2021
PERMIT SET - SFM	12.21.2021

Revisions and Description	Date
6 A Addendum 6	04.25.2022


Scale
1" = 10'-0"

Drawn by
MBH

EHDD Job Number
KLA 20-2266

Sheet Title
Irrigation Plan

Sheet Number
L3.2

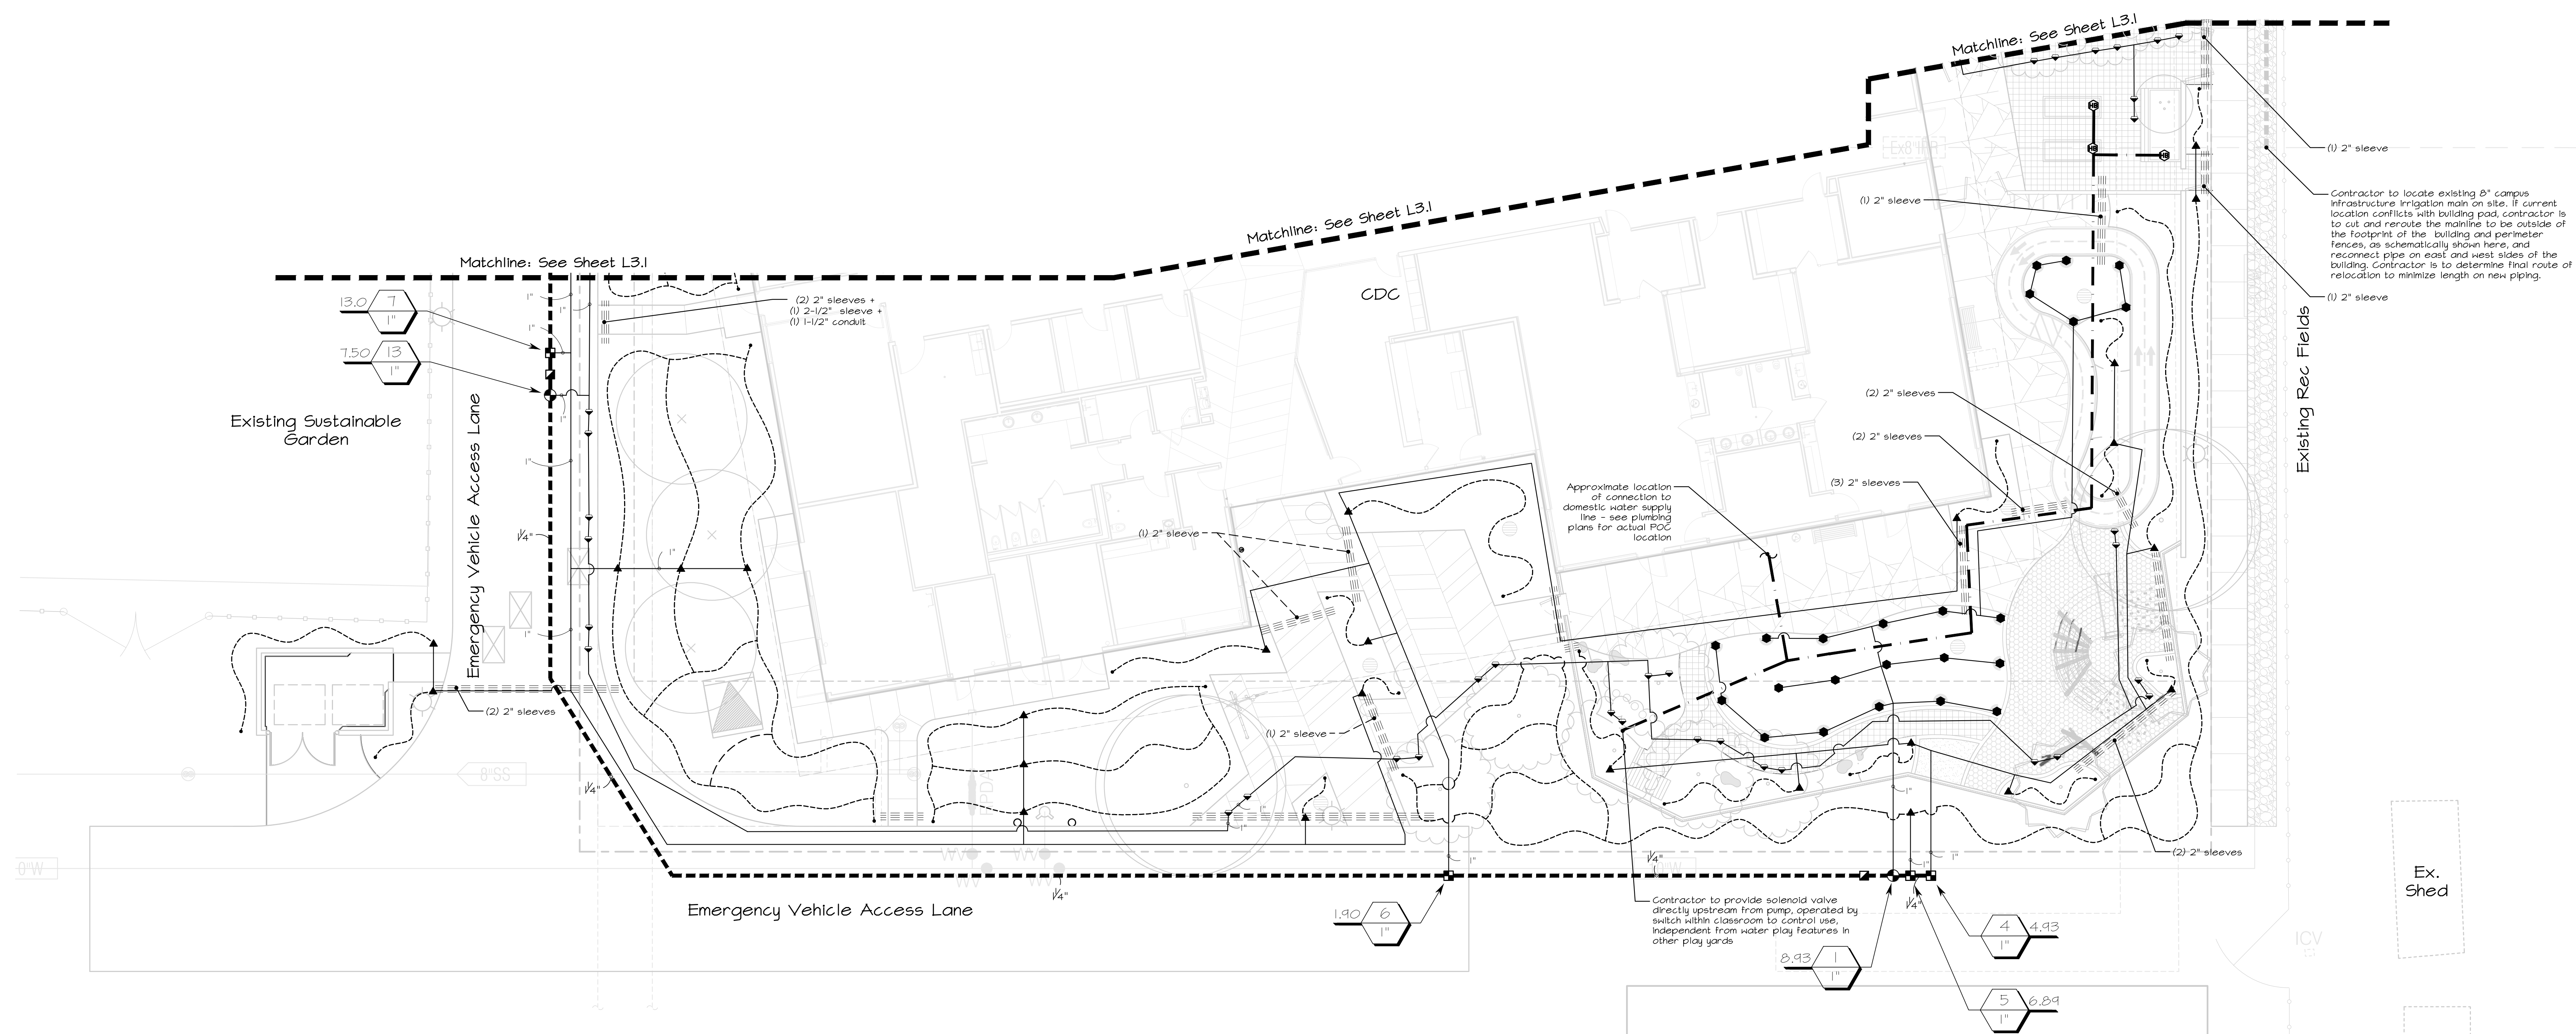

Irrigation Equipment Schedule

SPRINKLER HEADS:

SYMBOL	HFR	SPRINKLER BODY	DESCRIPTION	PRESSURE (PSI)	NOZZLE	ARC	FLOW (GPM)	RADIUS	DETAIL REF.
●	Rain	1806-SAM-P45	6" pop-up list sprinkler with 45 Psi regulator	40	MPB005R	90°	0.23	10'	Detail C, sheet L6.1
●					MPB005R	180°	0.42	10'	
●					MPB005R	210°	0.43	10'	
●					MPB005R	360°	0.78	10'	

SHRUB AREA DRIP SYSTEM COMPONENTS:

SYMBOL	MANUFACTURER	MODEL NO.	DESCRIPTION	DETAIL REFERENCE
~	RainBird		XT-100 5/8" (0.100" O.D.) polyethylene commercial-grade drip supply tubing with Xer-Bag barbed post-source emitters, per the following schedule: 1-gallon shrubs (1) XB-20 (2 GPH) emitter 2 and 3-gallon shrubs (2) XB-20 (2 GPH) emitters 5-gallon shrubs (3) XB-20 (2 GPH) emitters 5-gallon trees (4) XB-20 (2 GPH) emitters 24" box trees (6) XB-20 (2 GPH) emitters 36" box trees (8) XB-20 (2 GPH) emitters	Details A-C, sheet L6.1
▲	Approved		Drip supply tubing to PVC connection	Detail A, sheet L6.1
●	NDS	CEP-100	Compression flush cap in 6" round purple valve box with Hunter EC2-15 pop-up drip system operation indicator	Detail C, sheet L6.1

~~~~~ Indicates separation between drip zones

**TREE IRRIGATION:**

| SYMBOL | MANUFACTURER | MODEL NO.           | DESCRIPTION                                                                                                                                                    | DETAIL REFERENCE     |
|--------|--------------|---------------------|----------------------------------------------------------------------------------------------------------------------------------------------------------------|----------------------|
| ▼      | RainBird     | RHS-H-B-C-1401 1401 | 0.25 GPH root zone watering system with RHS-GRATE-P purple grate (one per tree) and 0.25 GPH supplemental surface bubbler on PVC IPS flex riser (one per tree) | Detail J, sheet L6.1 |

**VALVES:**

| SYMBOL | MANUFACTURER     | MODEL NO.   | DESCRIPTION                                                                                 | DETAIL REFERENCE     |
|--------|------------------|-------------|---------------------------------------------------------------------------------------------|----------------------|
| ☒      | RainBird         | XZ-100-FRBR | 1" drip control zone kit with scrubber valve and 200 mesh pressure-regulating basket filter | Detail K, sheet L6.1 |
| ☒      | RainBird         | 100-FESB-R  | 1" remote control scrubber valve                                                            | Detail L, sheet L6.1 |
| ☒      | RainBird         | 33-DNP      | 3/4" quick coupler valve with purple locking rubber cover                                   | Detail M, sheet L6.1 |
| ☒      | Nibco            | T-113       | Threaded bronze gate valve (line size)                                                      | Detail N, sheet L6.1 |
| ☒      | Buckner/Superior | B401        | 3/4" garden valve at vegetable garden planters                                              | Detail O, sheet L6.1 |

**P.O.C. EQUIPMENT:**

| SYMBOL | MANUFACTURER | MODEL NO. | DESCRIPTION                                            | DETAIL REFERENCE |
|--------|--------------|-----------|--------------------------------------------------------|------------------|
| ☐      | N/A          | N/A       | Point of connection at existing 8" irrigation mainline |                  |

**CONTROL EQUIPMENT:**

| SYMBOL | MANUFACTURER | MODEL NO.     | DESCRIPTION                                                                                                          | DETAIL REFERENCE |
|--------|--------------|---------------|----------------------------------------------------------------------------------------------------------------------|------------------|
| ☐      | RainMaster   | DX2 Evolution | Existing controller with 24 available stations. Contractor to connect all new control valves to existing controller. |                  |


**PIPES:**

| SYMBOL | MANUFACTURER | DESCRIPTION                                                                                                                                                                       | DETAIL REFERENCE     |
|--------|--------------|-----------------------------------------------------------------------------------------------------------------------------------------------------------------------------------|----------------------|
| ---    | Approved     | Schedule 40 Purple pressurized PVC mainline - schematic location (size per plan)                                                                                                  | Detail P, sheet L6.1 |
| ---    | Approved     | Schedule 40 Purple PVC lateral line (size per plan - 1" minimum size)                                                                                                             | Detail P, sheet L6.1 |
| ---    | Approved     | Schedule 40 PVC sleeve (size and quantity per plan)                                                                                                                               | Detail Q, sheet L6.1 |
| ---    | Approved     | 3/4" PVC SCH 40 Potable water supply line from domestic service provided on Civil Engineers plans to service water play features in play yards and hose bibs at vegetable gardens | Detail P, sheet L6.1 |

For General Irrigation Notes, see Sheet L3.1



**Water Efficient Landscape Ordinance (WELCO)**  
Planting and Irrigation have been designed to be compliant with the Water Efficient Landscape Ordinance. The contractor shall not make substitutions of irrigation product or placement of product or plant species and cultivars without written consent of the Landscape Architect. The contractor shall be responsible for making all modifications to ensure the requirements of the Water Efficient Landscape Ordinance are met if any changes are made. Water use calculations as described on these plans must be met. The signature on this plan concurs that I have complied with the criteria of the Water Efficient Landscape Ordinance and applied them accordingly for the efficient use of water in the irrigation and planting design plan.

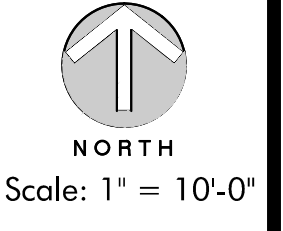



CSUS CHILD DEVELOPMENT CENTER

CALIFORNIA STATE UNIVERSITY, STANISLAUS ONE UNIVERSITY CIRCLE TURLOCK, CA 95362



PIER 1, BAY 2 THE EMBARCADERO SAN FRANCISCO, CA 94111

INFO@EHDD.COM +1 415-285-9193

Consultant



Stamp




Printing Date table with columns for permit set and date.

Revisions and Description table with columns for revision number, description, and date.

Scale 1" = 10'-0" Drawn by MBH EHDD Job Number KLA 20-2266

Planting Plan

Sheet Number L4.1

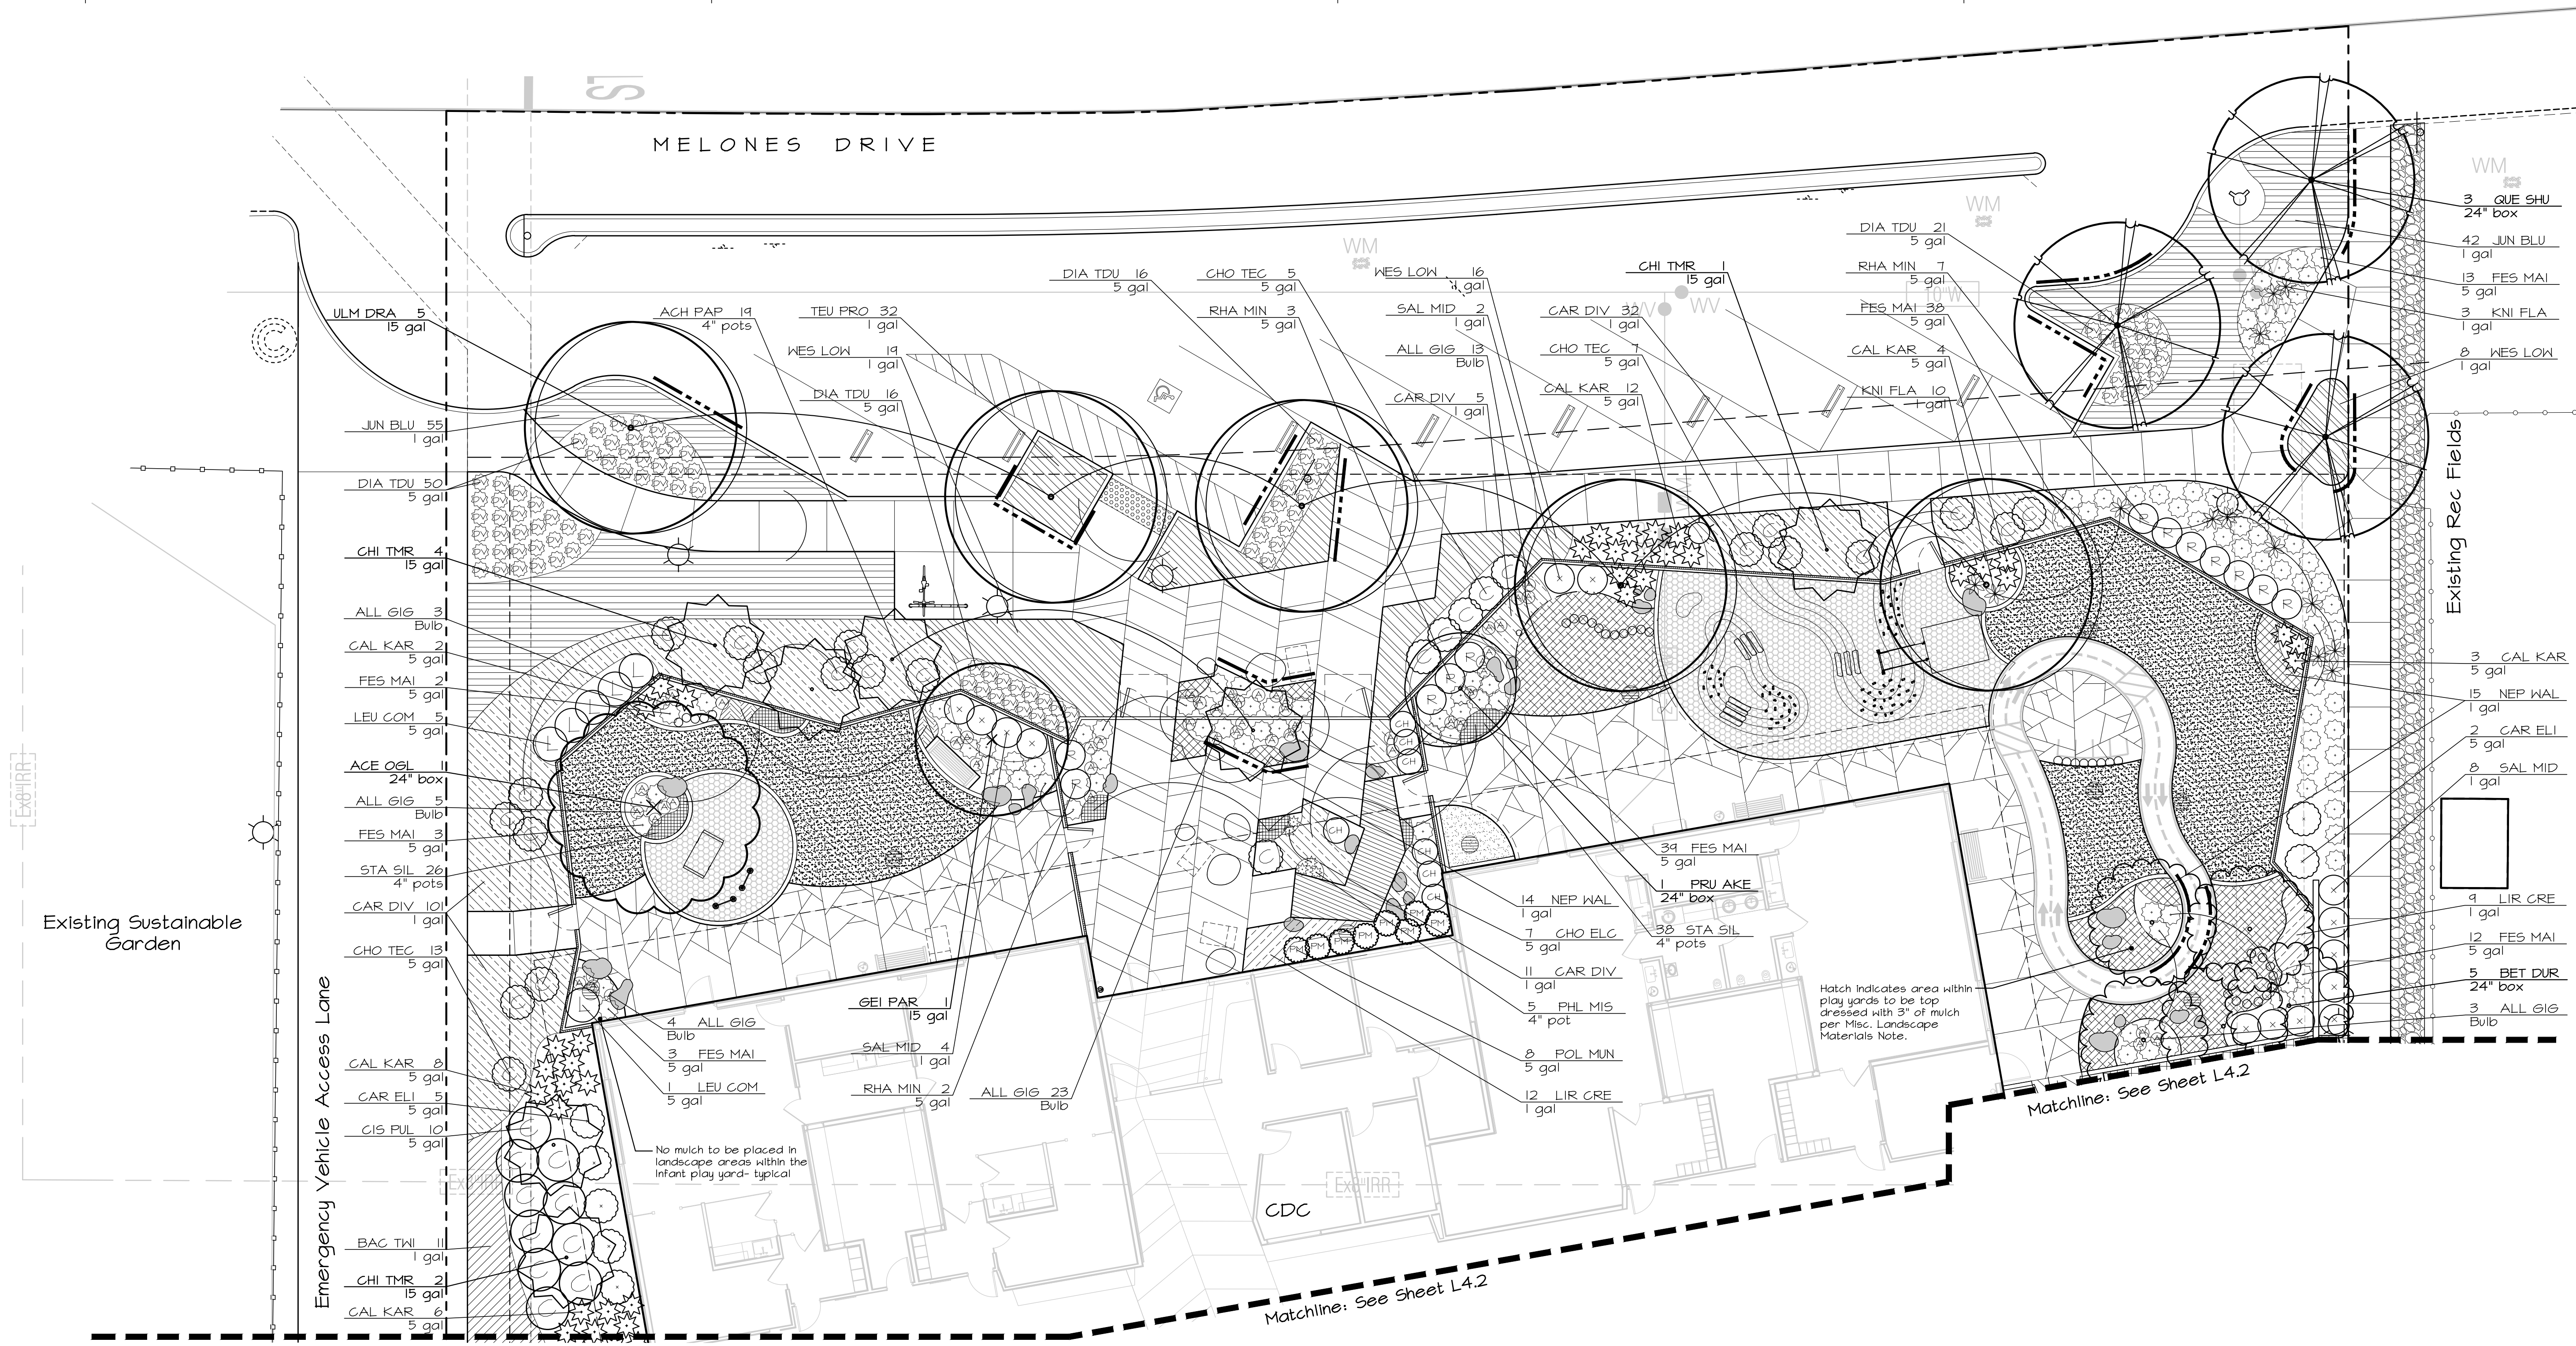

PLANT SCHEDULE table with columns for trees, shrubs, ground covers, vines, and turf sod, including botanical and common names, quantities, and spacing.

- General Planting Notes: 1. The contractor shall examine the conditions of the site prior to commencement of work. 2. The contractor shall verify all plant quantities prior to installation. 3. The contractor shall be responsible for the purchasing of all material to meet the specifications of the plans including plants, soil, fertilizer, stakes, and sod. 4. All plant material shall be subject to approval or rejection by the Landscape Architect or Owner's Representative prior to installation. 5. The contractor shall include in the bid for a continued maintenance period of ninety (90) days after completion and acceptance of the project by the Owner or Owner's Rep. 6. Trees to be planted a min. of 3'-0" from edge of paving or walls (unless otherwise stated on plan). 7. All trees provided in the Planting Schedule/Legend are to be installed as single "Standard Form" trees unless specifically otherwise noted in the Planting Schedule/Legend. 8. All vines shall be installed with the nursery stakes removed and runners espaltered to the adjacent wall. 9. The following soil amendments specified are for bidding purposes only. 10. All soil preparation shall be installed per the soil agronomy report to be provided and paid for by the Landscape Contractor. 11. A nitrogen stabilized commercial-grade mulch with maximum 3/4" dia. chip size shall be uniformly broadcast over all site areas (not turf) to a depth as specified on the Planting Legend. 12. The planting pits for trees shall be excavated per the detail on the Landscape Details sheet. 13. Fertilizer tablets shall be BEST, 21 gram fertilizer tablets (20-10-5) placed in all planting pits in quantities as follows: 14. All annual color is to be blooming and locally available and adapted to the area. 15. Thirty (30) days after installation all landscape shall be fertilized with 16-6-8 Fertilizer applied at the rate of 6 lbs./1000 sf. 16. For weed control prior to planting, the Landscape Contractor shall thoroughly irrigate the site to promote germination of weed seeds that may be in the soil. 17. All plant material to be nursery grown in similar climate. All plant material shall be vigorous and of normal habit of growth and shall be free of gnawing roots, sun scald, abrasions, disease, insects, insect eggs and larvae. Plants shall equal or exceed the standards as outlined by the American Standards for Nursery Stock and to applicable California Agriculture Code.

Existing Sustainable Garden

Emergency Vehicle Access Lane

No mulch to be placed in landscape areas within the infant play yard-typical

Hatch indicates area within play yards to be top dressed with 3" of mulch per Misc. Landscape Materials Note.

Matchline: See Sheet L4.2


Matchline: See Sheet L4.2

Existing Rec Fields

- WM 3 QUE SHU 24" box 42 JUN BLU 1 gal 13 FES MAI 5 gal 3 KNI FLA 1 gal 8 WES LOW 1 gal 3 CAL KAR 5 gal 15 NEP WAL 1 gal 2 CAR ELI 5 gal 8 SAL MID 1 gal 4 LIR CRE 1 gal 12 FES MAI 5 gal 5 BET DUR 24" box 3 ALL GIG Bulb





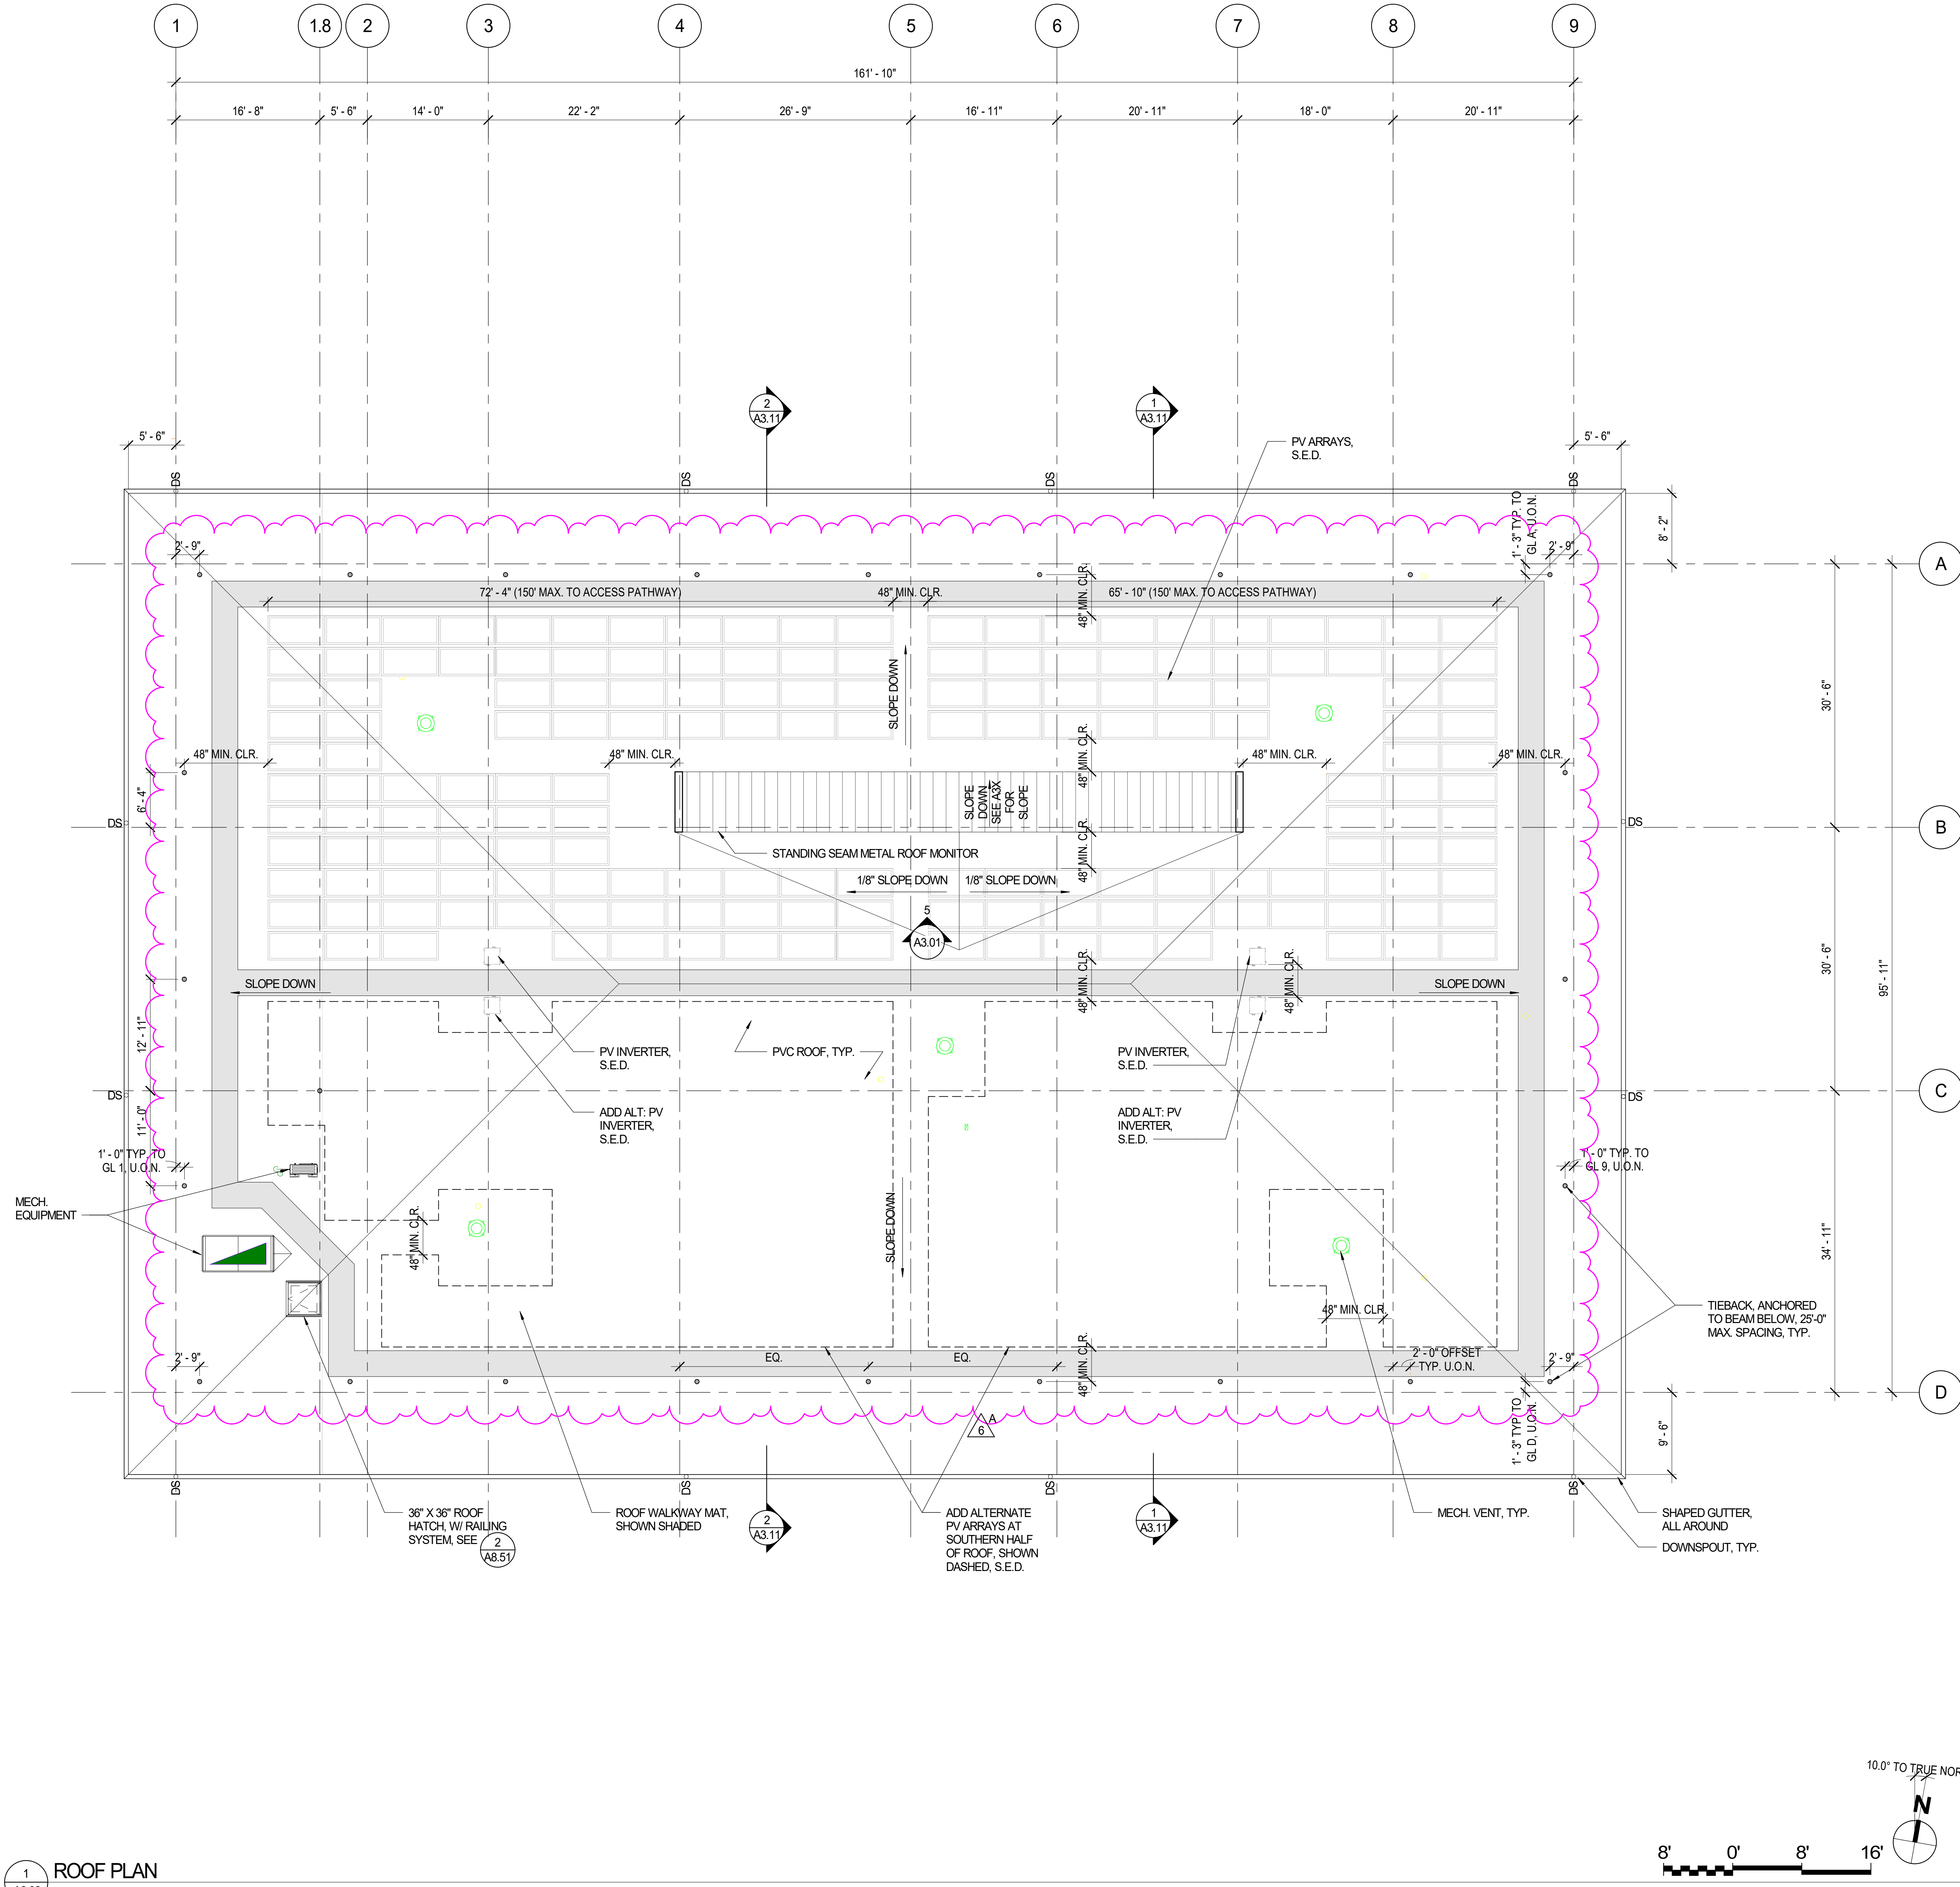

**ROOF PLAN SHEET NOTES**

1. ROOF SLOPE TO BE 1/4" / FT, U.O.N.
2. SEE A8.51 FOR TYPICAL ROOF DETAILS
3. SEE ELECTRICAL DRAWINGS FOR PV SIZING, SCOPE AND ADDITIONAL INFO

**ROOF PLAN LEGEND**

- DS DOWNSPOUT
- ROOF TIEBACK, SEE 10/A8.51 FOR WATERPROOFING, SEE S8.15 FOR ATTACHMENT DETAIL

Division of the State Architect  
Office of the State Fire Marshal


**CSUS CHILD DEVELOPMENT CENTER**  
CALIFORNIA STATE UNIVERSITY, STANISLAUS  
ONE UNIVERSITY CIRCLE  
TURLOCK, CA 95382



PIER 1, BAY 2  
THE EMBARCADERO  
SAN FRANCISCO, CA 94111  
INFO@EHDD.COM  
+1 415-285-9193


Consultant

Stamp

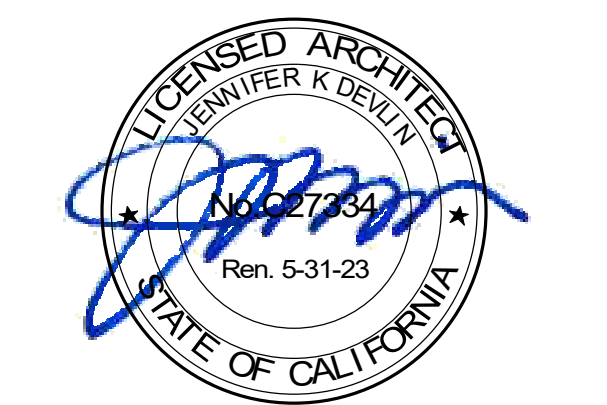

| Printing                   | Date       |
|----------------------------|------------|
| 95% CONSTRUCTION DOCUMENTS | 06.25.2021 |
| PERMIT SET - DSAV2         | 08.16.2021 |
| PERMIT SET - SFM           | 12.15.2021 |
| PERMIT SET - SFM           | 12.21.2021 |

| Revisions and Description | Date       |
|---------------------------|------------|
| 6 A Addendum 6            | 04.25.2022 |

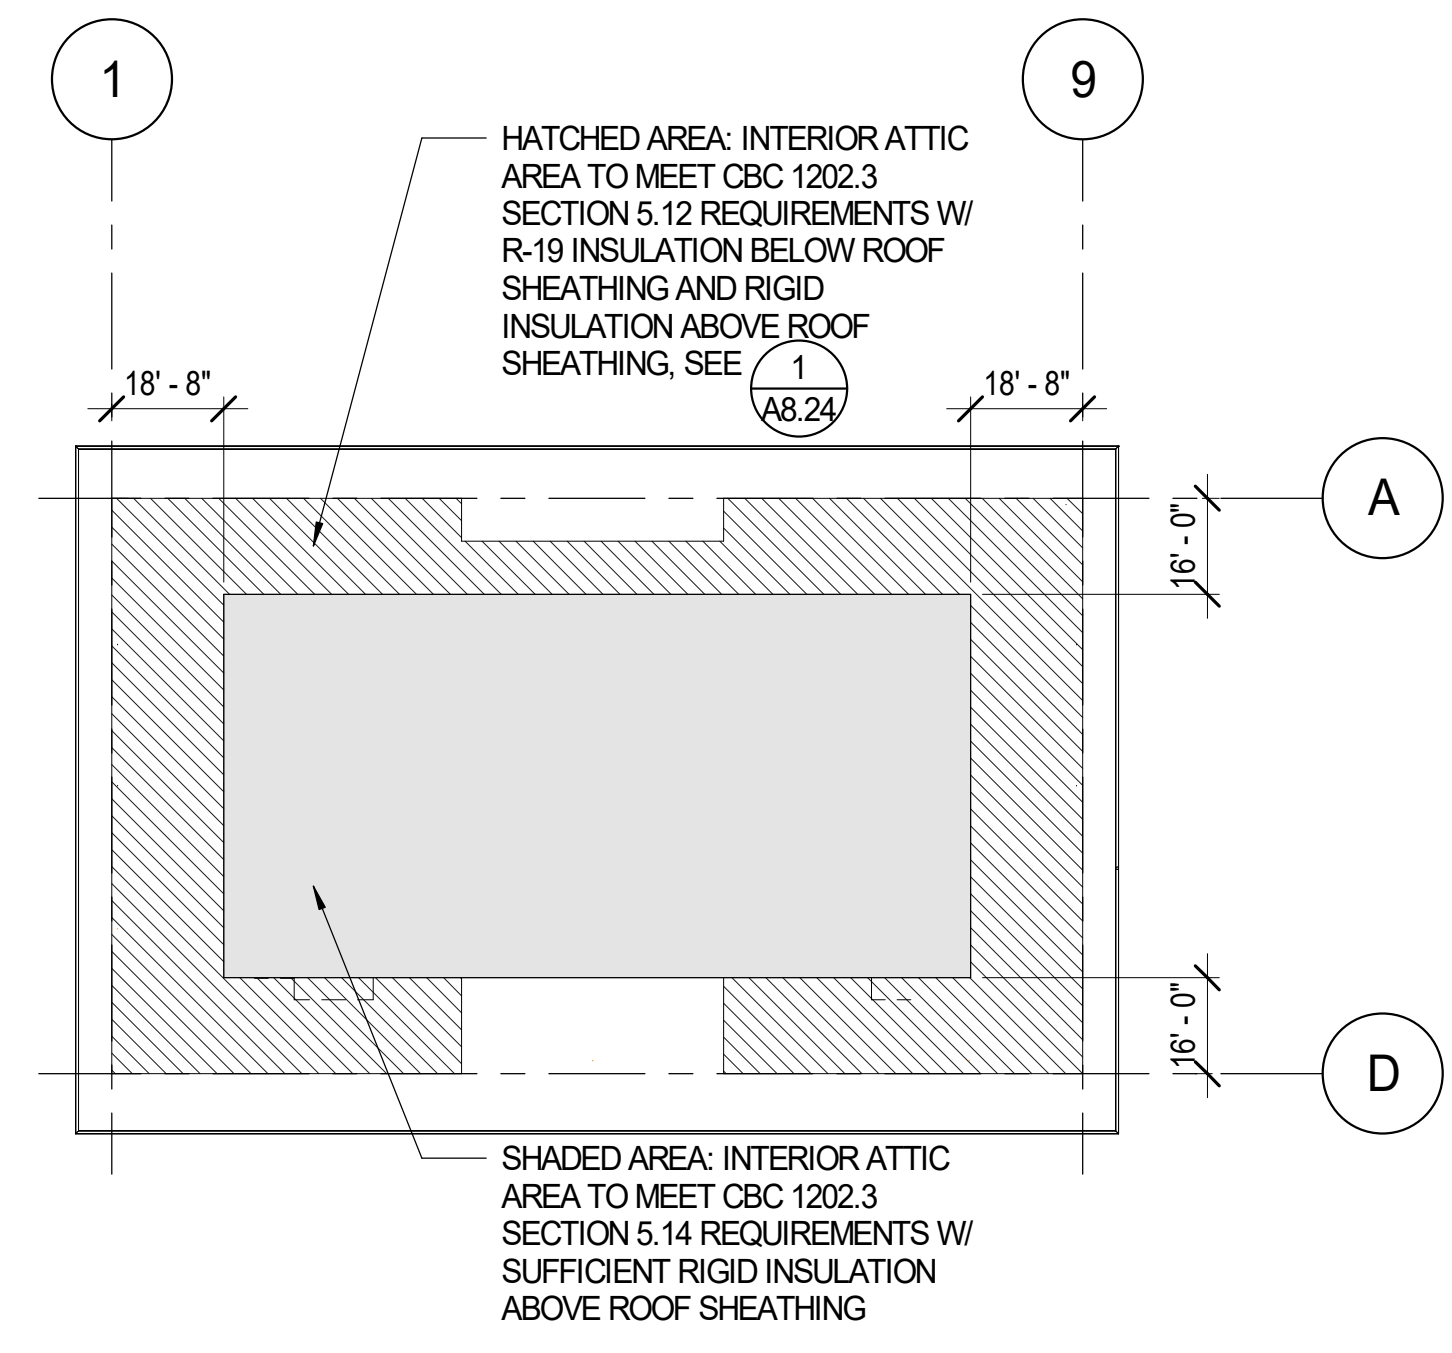

NOTES:  
1) ATTIC TO MEET CBC 1202.3 REQUIREMENTS.  
2) MONTHLY AVERAGE WINTER EXTERIOR TEMPERATURE IS ABOVE CODE MINIMUM OF 45F.

**2 ROOF PLAN - INSULATION DIAGRAM**  
A2.02 NOT TO SCALE


Scale  
As indicated  
Drawn by  
Author  
EHDD Job Number  
20020

Sheet Title  
**ROOF PLAN**

Sheet Number

**A2.02**

**1 ROOF PLAN**  
A2.02 SCALE: 1/8" = 1'-0"

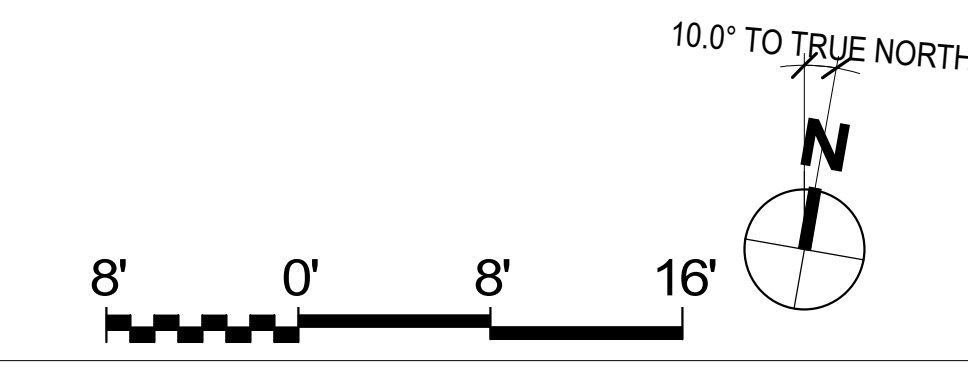

### CSUS CHILD DEVELOPMENT CENTER

CALIFORNIA STATE UNIVERSITY, STANISLAUS  
ONE UNIVERSITY CIRCLE  
TURLOCK, CA 95382



PIER 1, BAY 2  
THE EMBARCADERO  
SAN FRANCISCO, CA 94111

INFO@EHDD.COM  
+1 415-285-9193

Consultant

Stamp



| Printing                   | Date       |
|----------------------------|------------|
| 95% CONSTRUCTION DOCUMENTS | 06.25.2021 |
| PERMIT SET -               | 08.16.2021 |
| PERMIT SET - DSA V2        | 12.15.2021 |
| PERMIT SET - SFM           | 12.21.2021 |

| Revisions and Description | Date       |
|---------------------------|------------|
| 1 A Addendum 1            | 04.01.2022 |
| 6 A Addendum 6            | 04.25.2022 |


Scale  
1/4" = 1'-0"

Drawn by  
Author  
EHDD Job Number  
20020

Sheet Title  
**TRUSS PROFILE**

Sheet Number

# A3.12

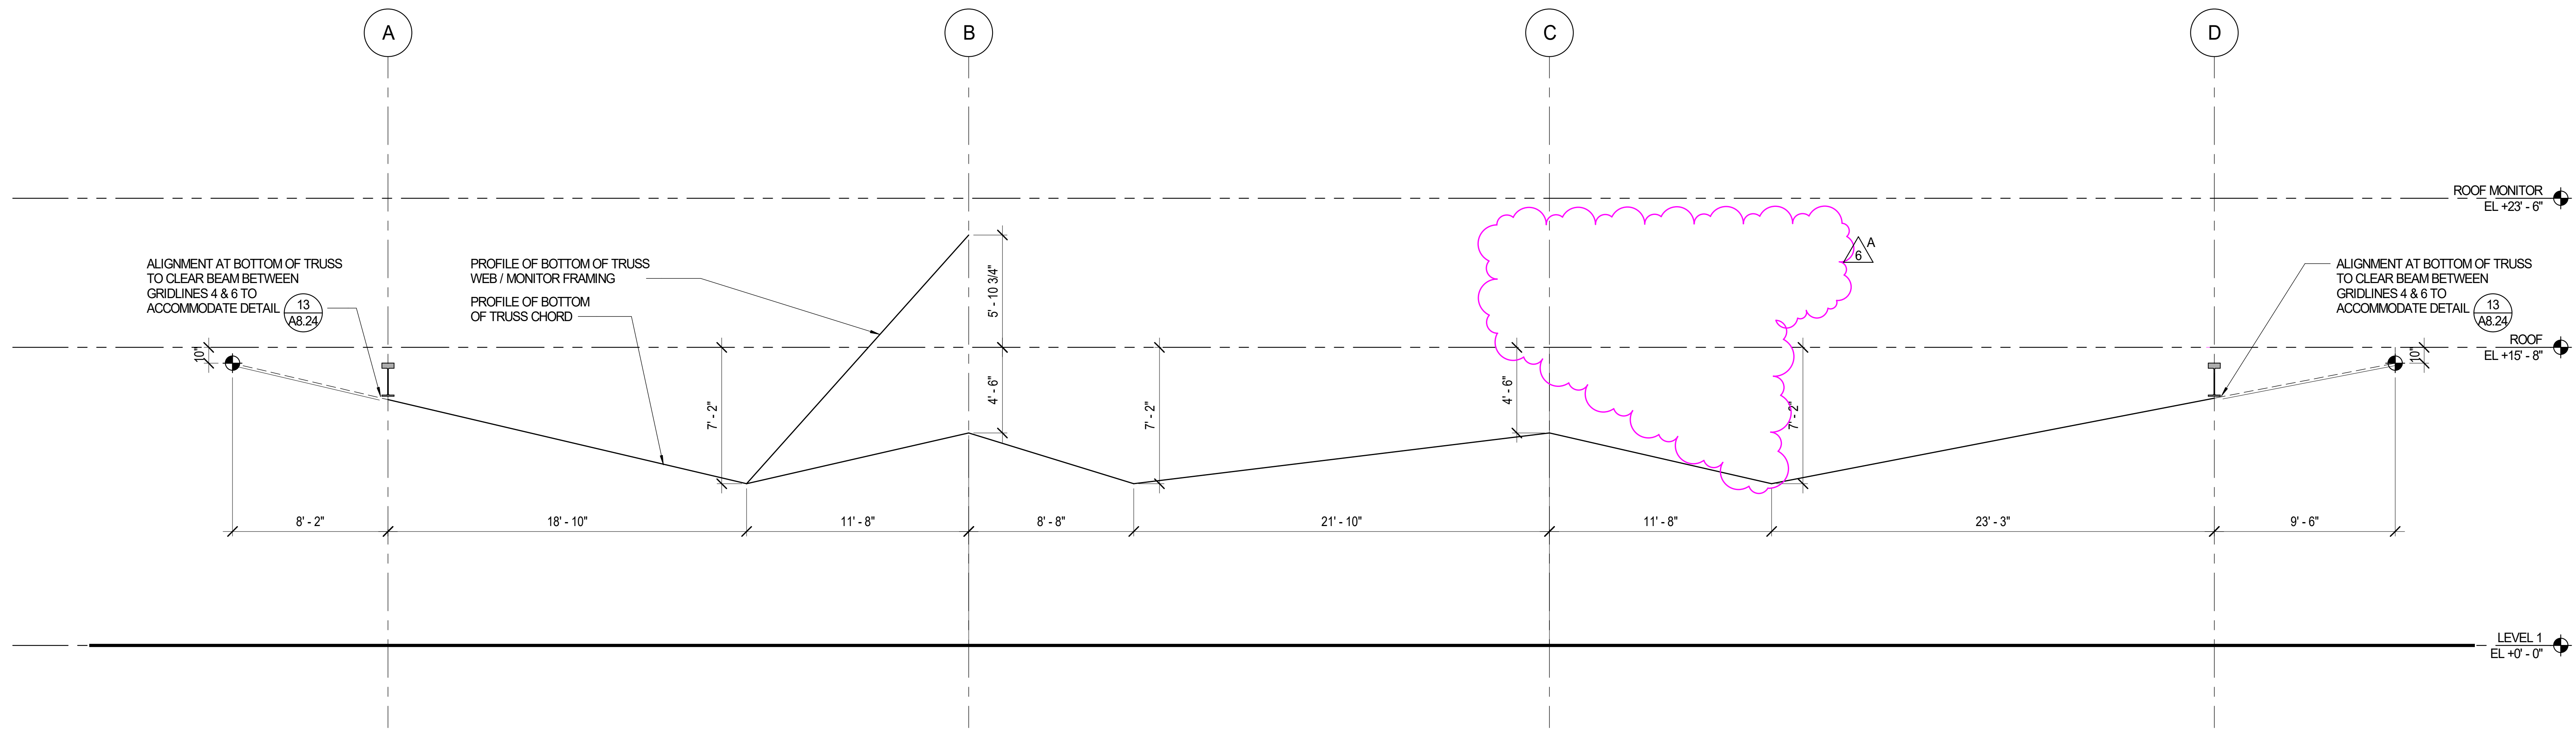

1 TRUSS PROFILE DIAGRAM  
A3.12 SCALE: 1/4" = 1'-0"














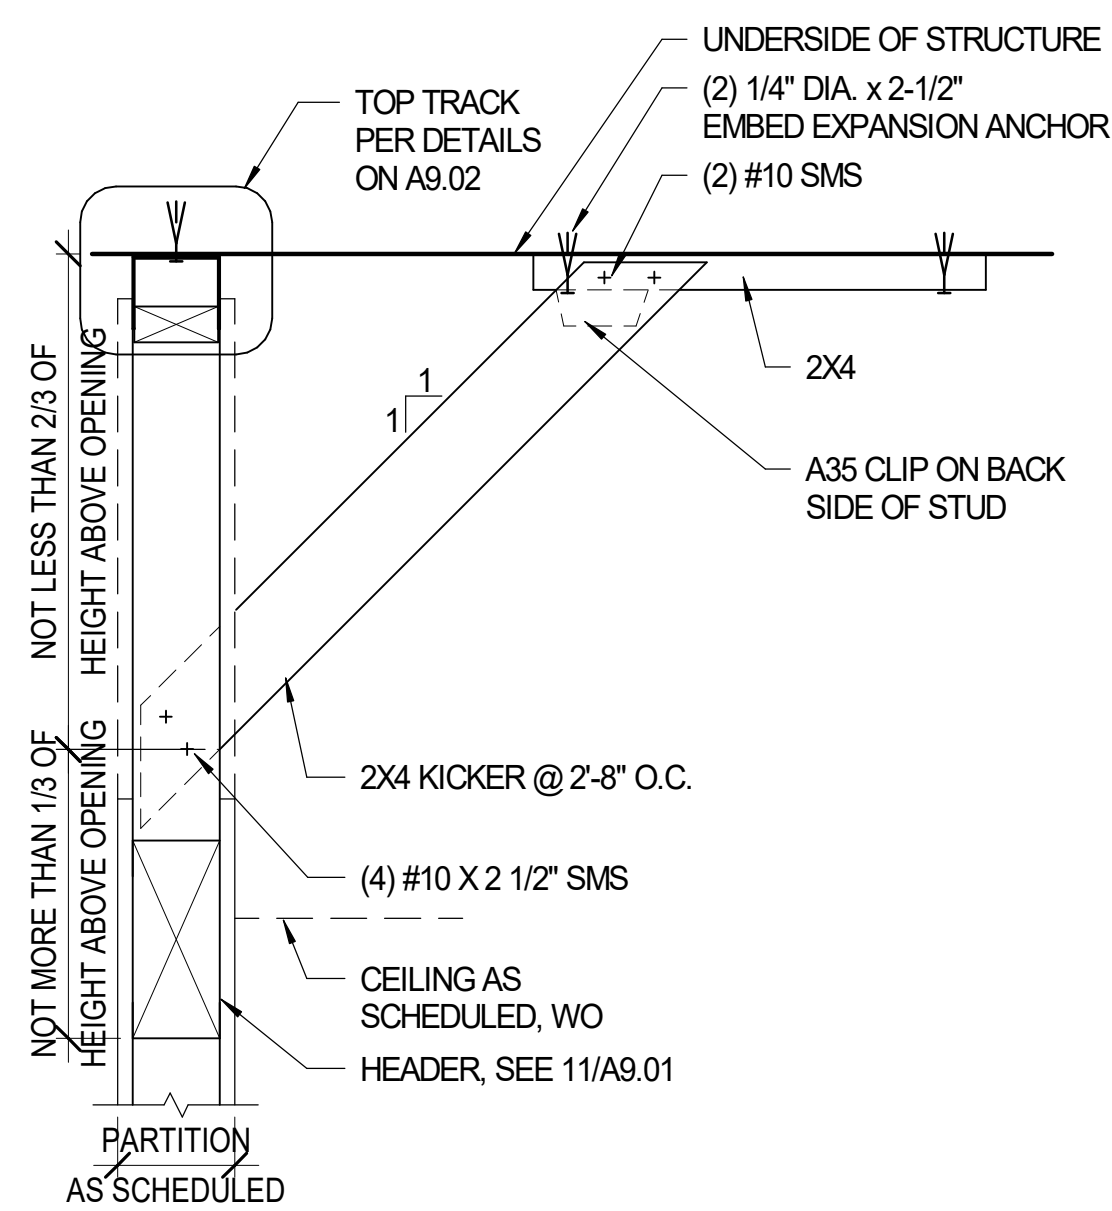


20 WALL BRACE AT OPNG'S MORE THAN 10' WIDE  
SCALE: 1 1/2" = 1'-0"

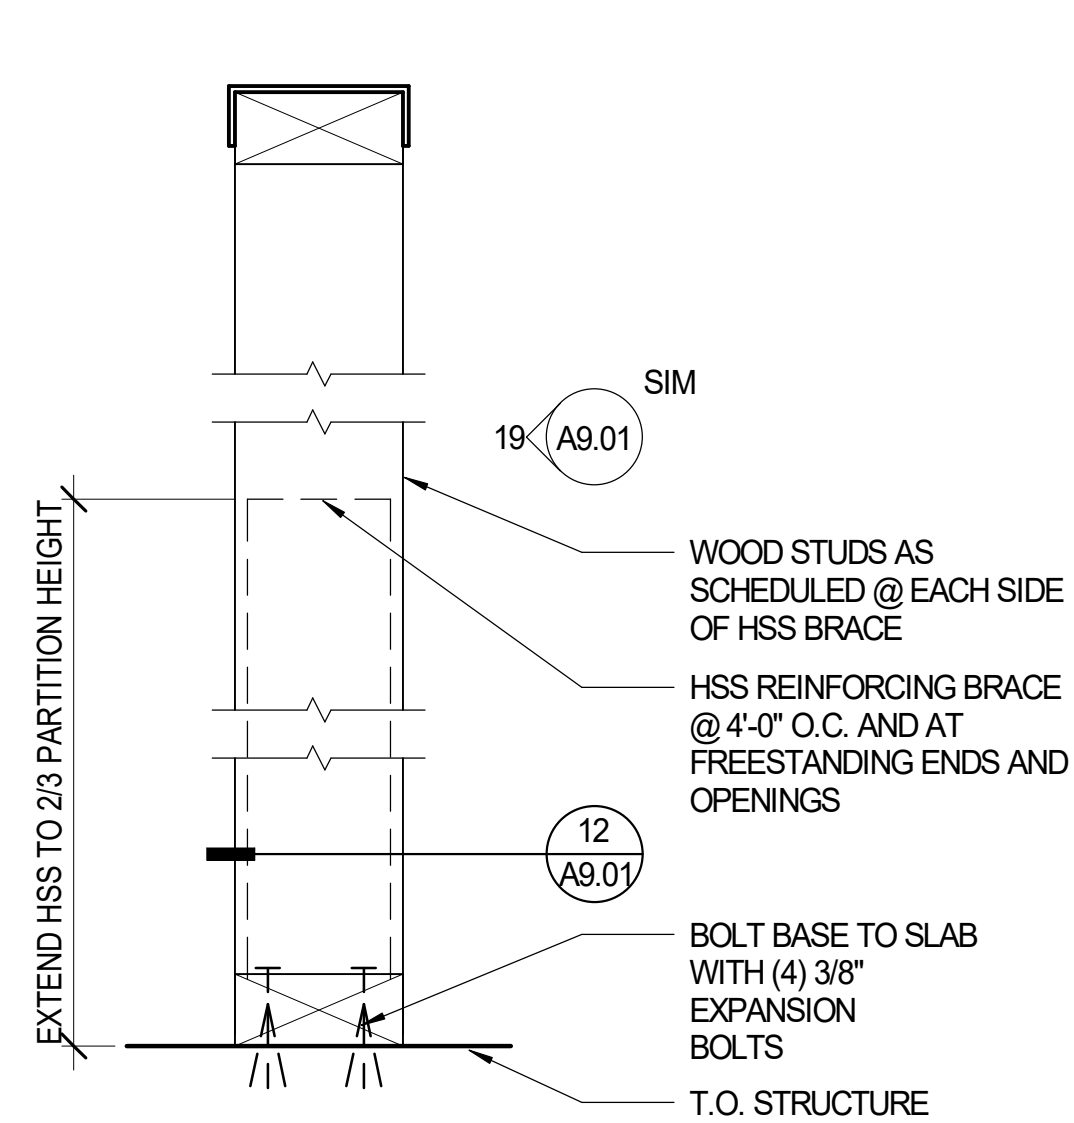


16 SECTION - BRACE @ PARTIAL HT. WALL  
SCALE: 3" = 1'-0"

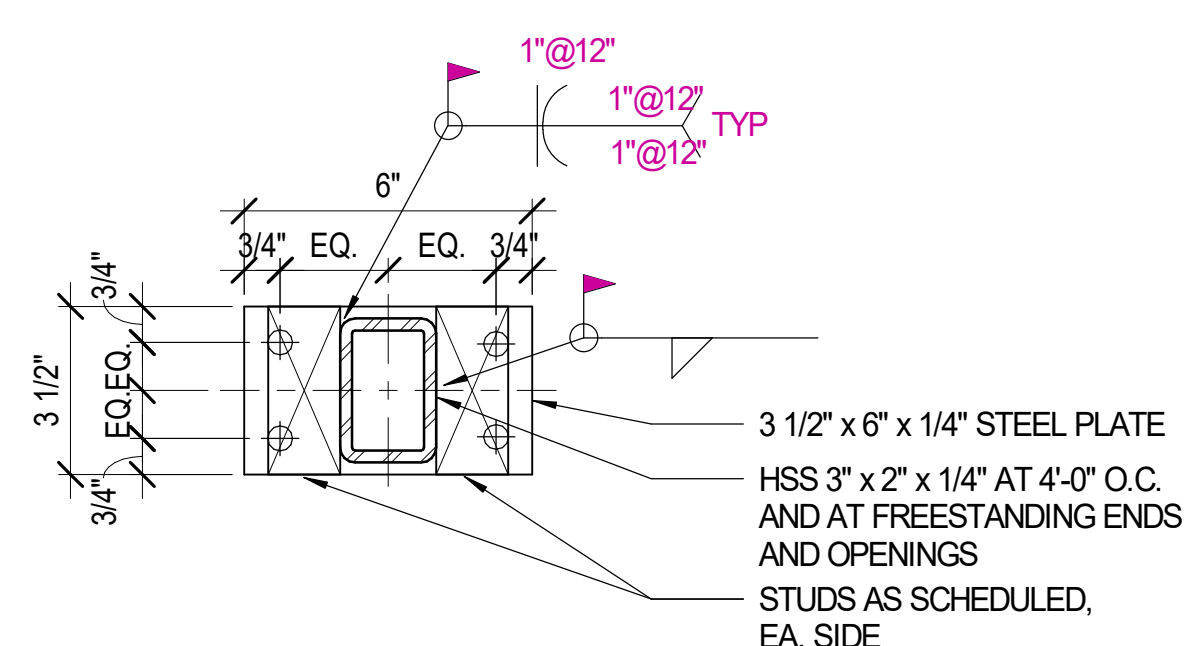


12 PLAN - BRACE @ PARTIAL HEIGHT WALL  
SCALE: 3" = 1'-0"

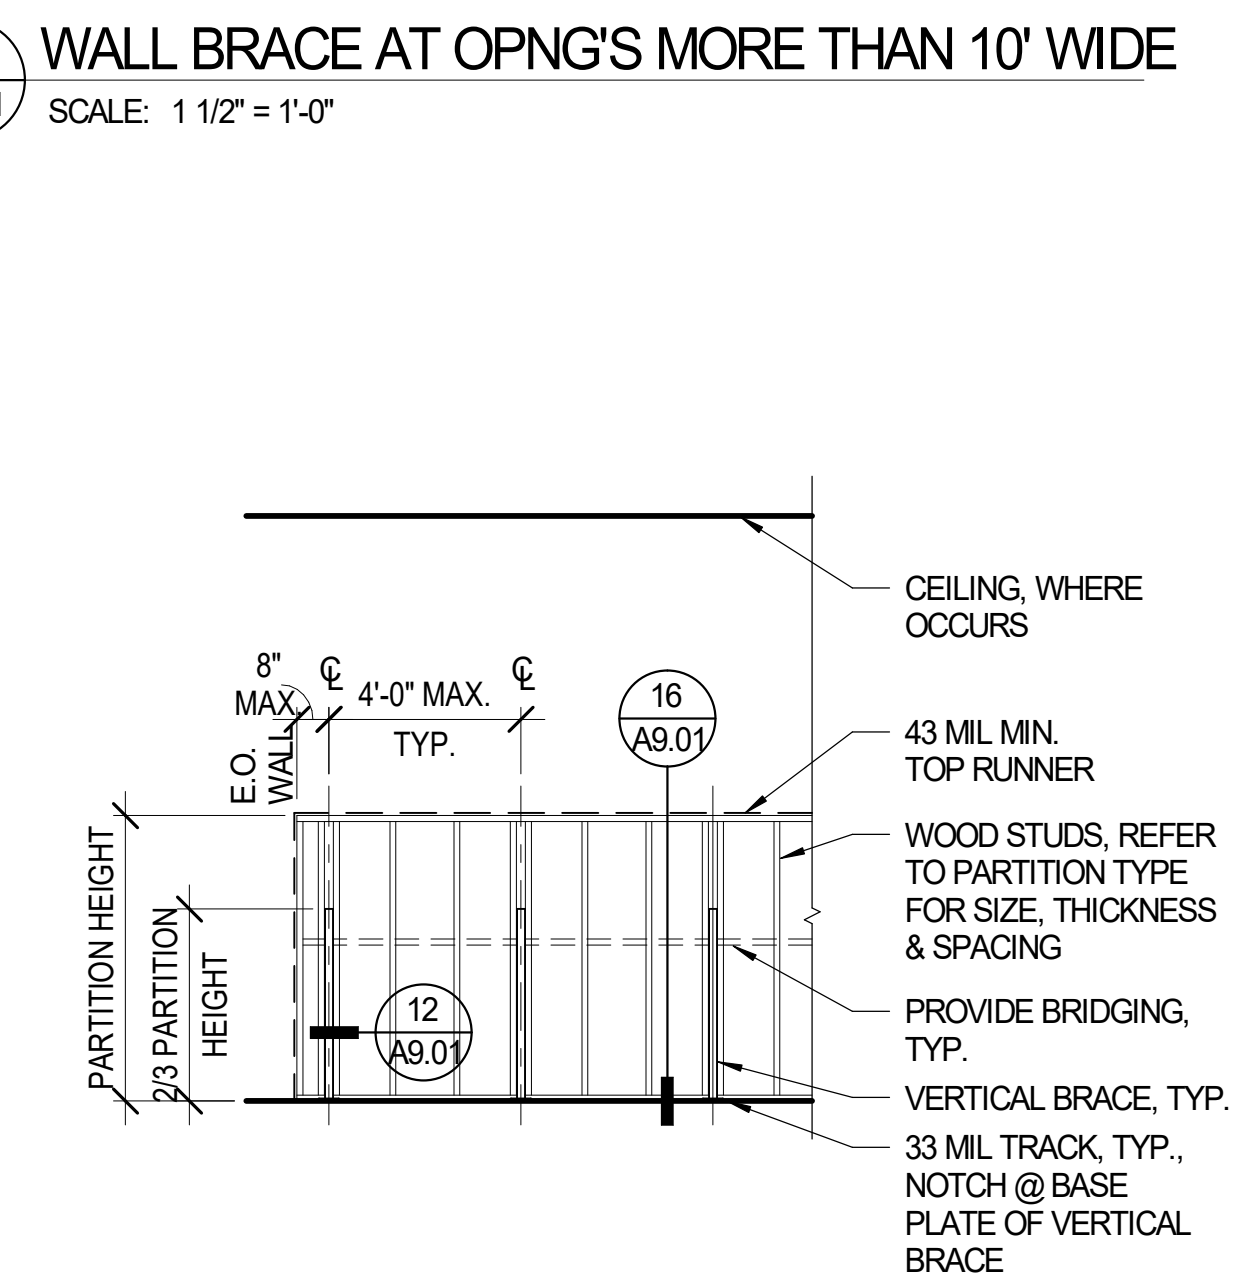

19 FRAMING FOR PARTIAL HT. WALL NOT EXTENDING TO CLG ABOVE  
SCALE: 1/4" = 1'-0"

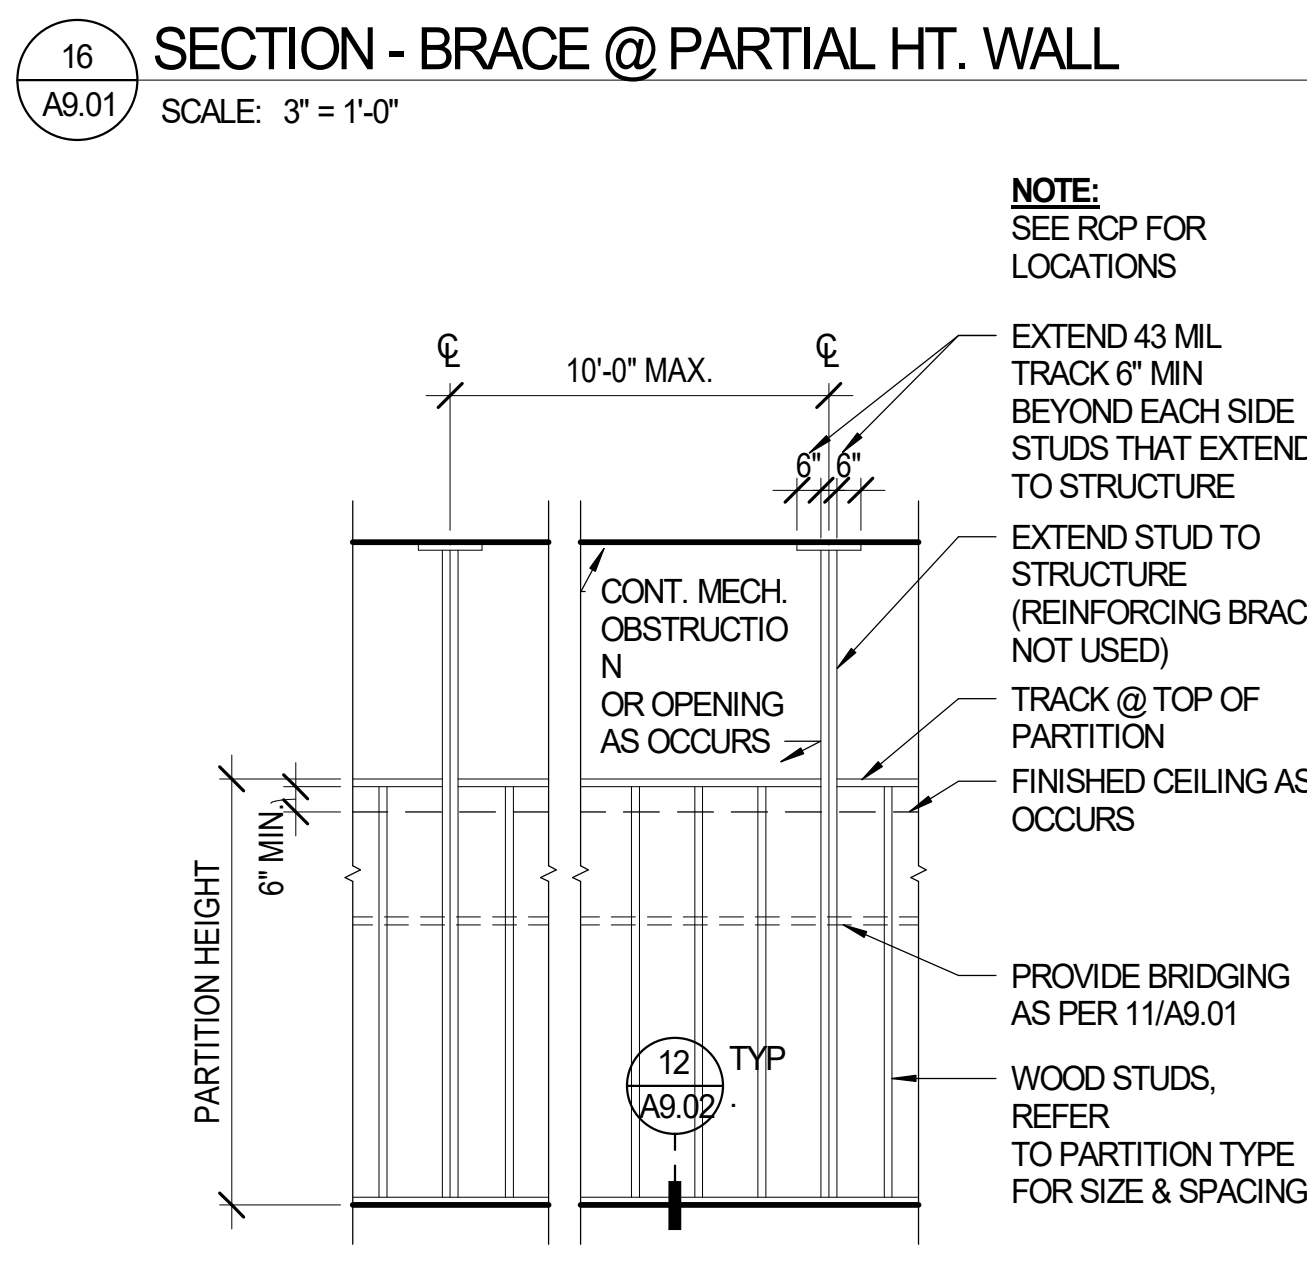

15 FRAMING FOR PARTIAL HEIGHT WALL NOT EXTENDING TO SLAB ABOVE  
SCALE: 1/4" = 1'-0"

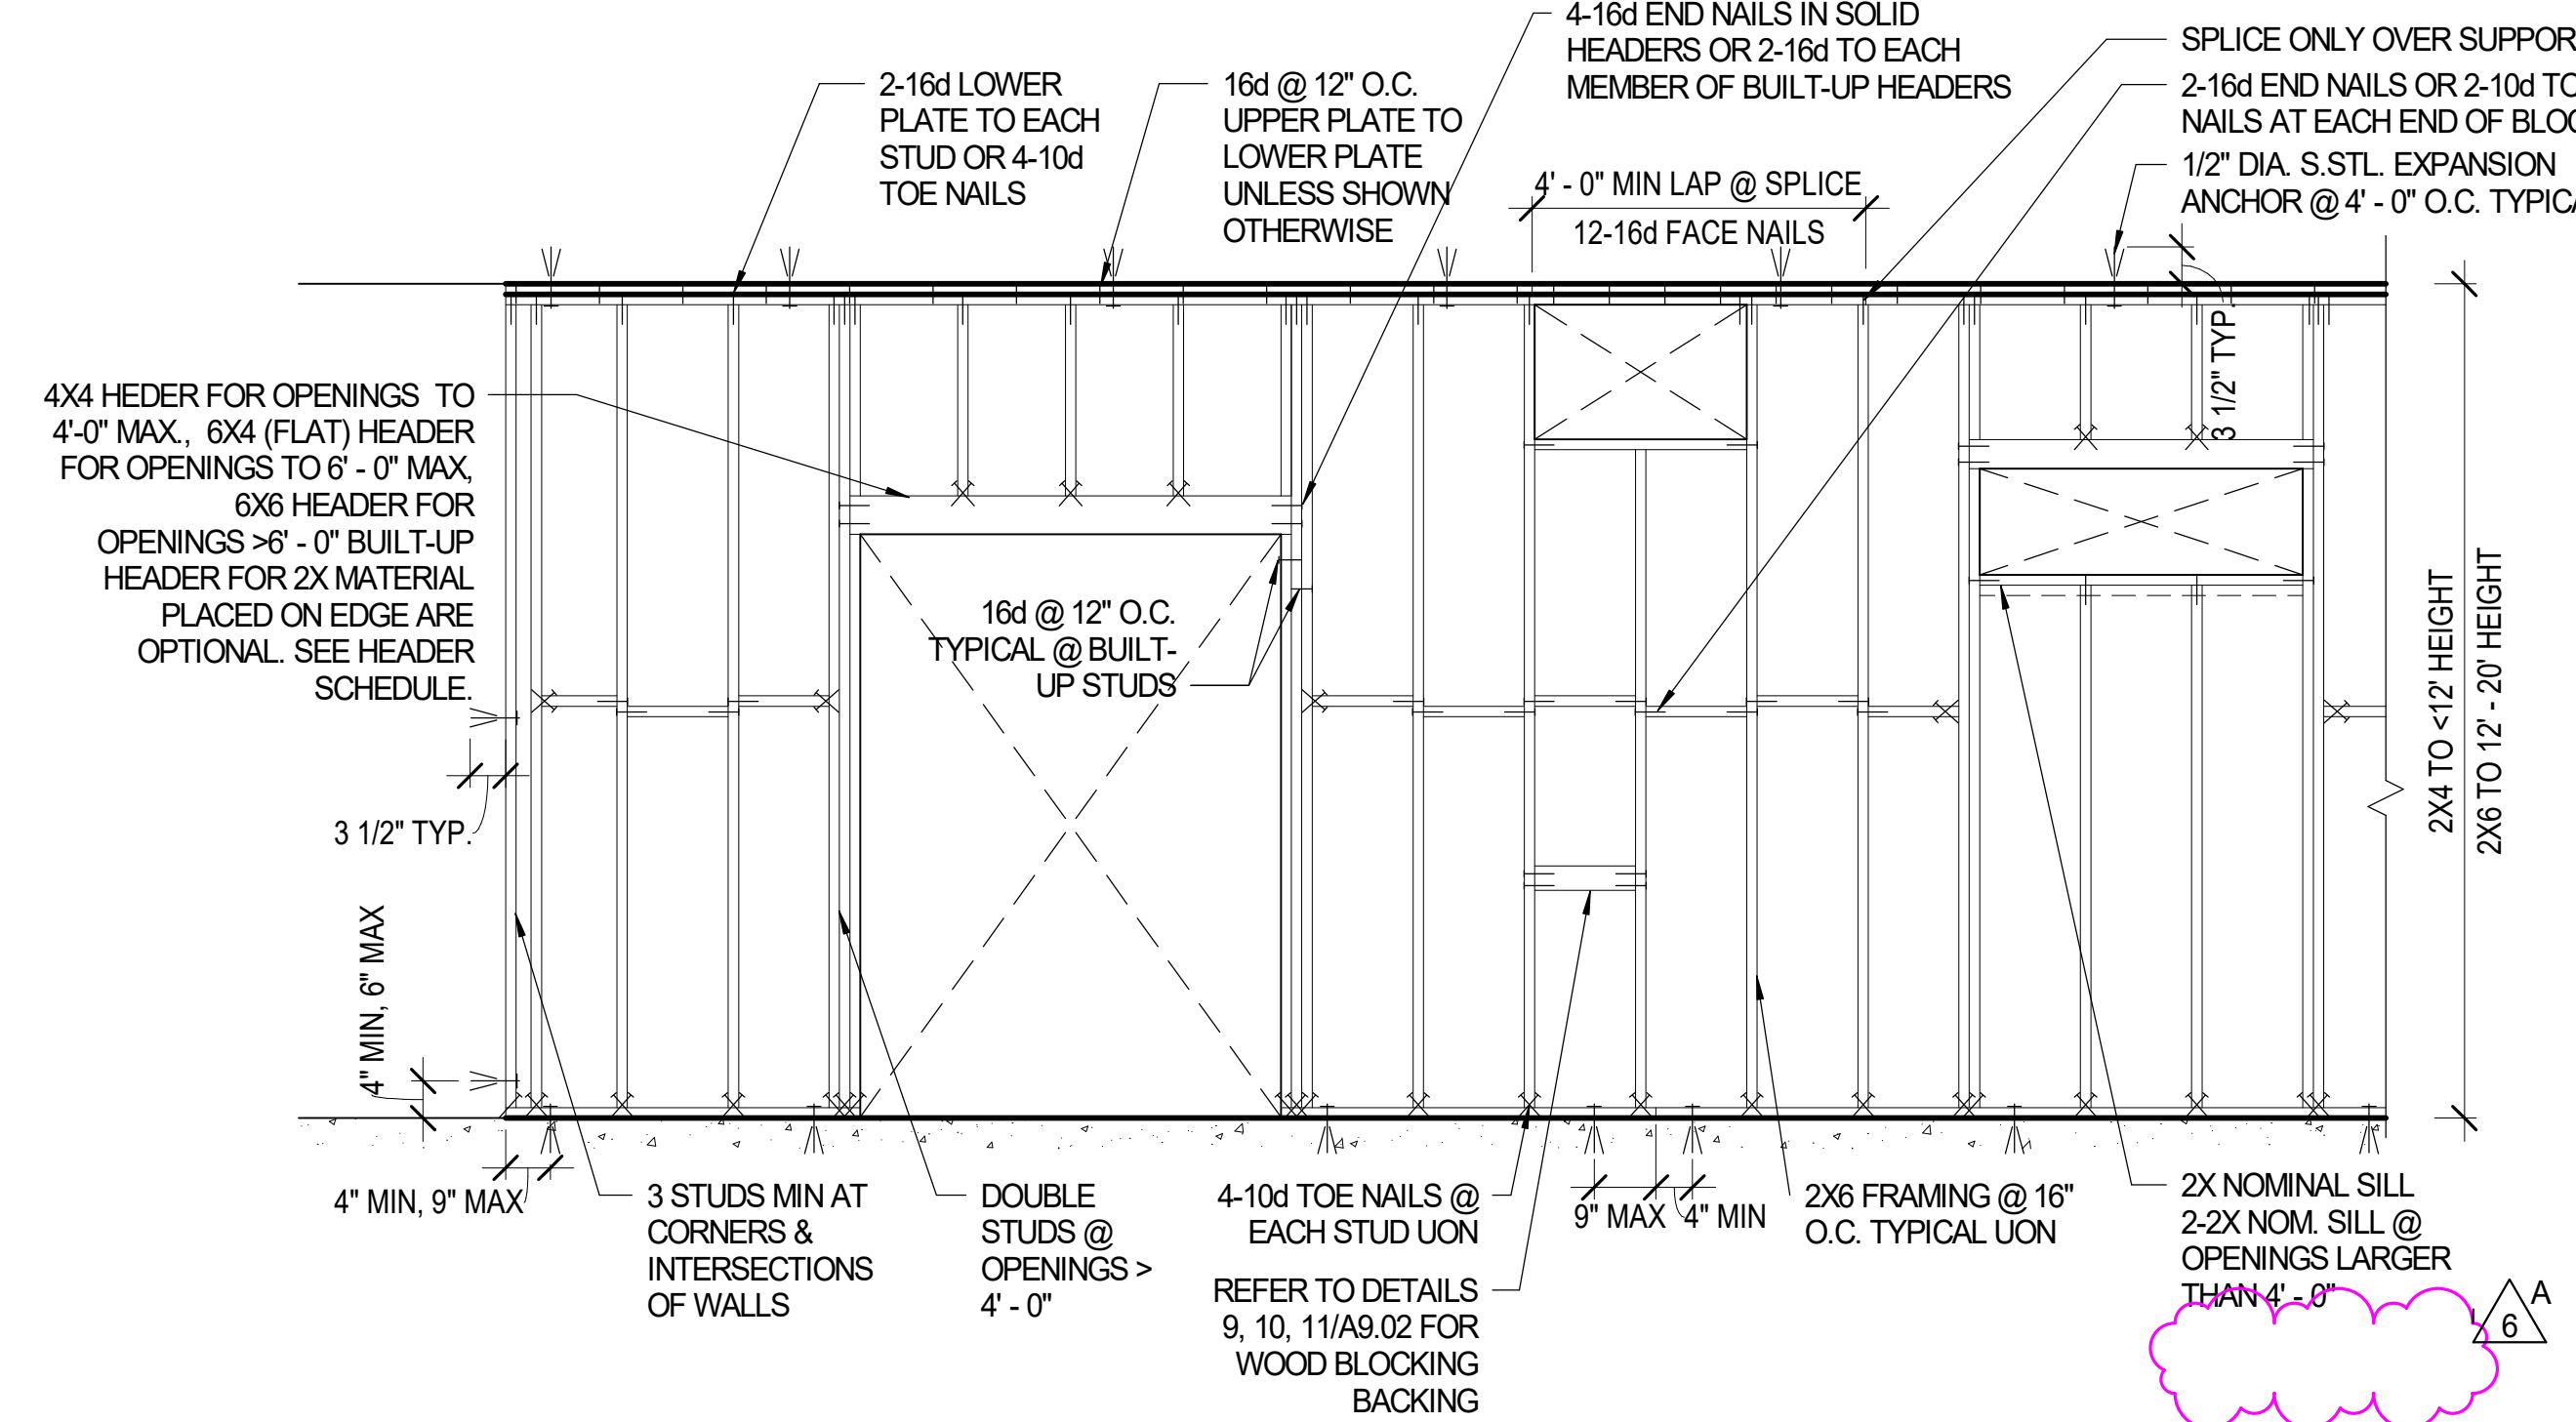

11 TYPICAL WOOD FRAMING FOR INTERIOR PARTITIONS  
SCALE: 1/4" = 1'-0"

**GENERAL SHEET NOTES**

- ALL PARTITIONS TO BE FULL-HEIGHT TO UNDERSIDE OF STRUCTURAL TRUSSES, UON
- GWB TO BE TYPE 'X' UON AND WATER RESISTANT AT WET CONDITIONS
- PROVIDE CEMENTIOUS BACKER BOARD WHERE TILE FINISH OCCURS, SEE SHEET A9.41 FOR TILE DETAILS.
- CONT. WOOD SILL PLATE TO MATCH STUD SIZE, UON
- REFERENCE STRUCTURAL DRAWING FOR STUD SPACING
- PROVIDE OPENING AND THROUGH-PENETRATION PROTECTION AT WALLS DESIGNATED AS FIRE SEPARATIONS ON G1.1 & A2 SERIES
- SEE SHEET A0.40 FOR SCHEDULED WALL FINISHES
- SEE A6 SERIES FOR SCHEDULED CEILING.
- ALLOW FOR ADDITIONAL ASSEMBLY COMPONENTS, AS REQUIRED TO MEET PROJECT ACOUSTICAL REQUIREMENTS. STRATEGY MAY INCLUDE RESILIENT CHANNELS

**PARTITION TYPE DESIGNATION**

- PARTITION TYPE
- STUD SIZE
- PARTITION SUBTYPE (ACOUSTIC RATING, FIRE RATING, SPECIAL CONDITIONS, ETC)
- GYP BD LAYERS (DENOTED ONLY FOR WALL TYPES C THROUGH J)

**PARTITION SUBTYPE DESIGNATION**

- A- WITH BATT INSULATION
- B- WITHOUT BATT INSULATION
- C- EXTEND GYP 6" ABOVE CEILING, W/ BATT INSULATION
- D- EXTEND GYP 6" ABOVE CEILING, W/O BATT INSULATION
- E- PARTIAL HEIGHT WALL NOT EXTENDING TO CEILING, W/O BATT INSULATION, SEE ELEVATIONS FOR HEIGHT
- F- FULL HEIGHT GYP TO UNDERSIDE OF ROOF SHEATHING, W/ BATT INSULATION
- G- PARTIAL HEIGHT WALL NOT EXTENDING TO CEILING, W/O BATT INSULATION, FINISHED PLYWOOD BOTH SIDES, SEE ELEVATIONS FOR HEIGHT
- P- FULL HEIGHT GYP TO UNDERSIDE OF ROOF SHEATHING WITH ONE LAYER PLYWOOD SHEATHING PER STRUCTURAL, W/ BATT INSULATION
- Q- FULL HEIGHT GYP TO UNDERSIDE OF ROOF SHEATHING WITH ONE LAYER PLYWOOD SHEATHING PER STRUCTURAL, W/O BATT INSULATION
- R- FULL HEIGHT GYP TO UNDERSIDE OF ROOF SHEATHING WITH 2 LAYERS PLYWOOD SHEATHING PER STRUCTURAL, W/ BATT INSULATION
- S- FULL HEIGHT GYP WITH 2 LAYERS PLYWOOD SHEATHING PER STRUCTURAL, W/O BATT INSULATION

**WOOD FRAMED PARTITION HEADER SCHEDULE**

| Opening Width (ft) | Header Size (in)     |
|--------------------|----------------------|
| <4'-0"             | 4x4                  |
| 4'-0" - 6'-0"      | 4x6                  |
| 6'-0" - 8'-0"      | 4x8                  |
| 8'-0" - 10'-0"     | 4x10                 |
| >10'-0"            | ENGINEERING REQUIRED |

**CSUS CHILD DEVELOPMENT CENTER**

CALIFORNIA STATE UNIVERSITY, STANISLAUS ONE UNIVERSITY CIRCLE TURLOCK, CA 95382




PIER 1, BAY 2 THE EMBARCADERO SAN FRANCISCO, CA 94111

INFO@EHDD.COM +1 415-285-9193

Consultant

Stamp

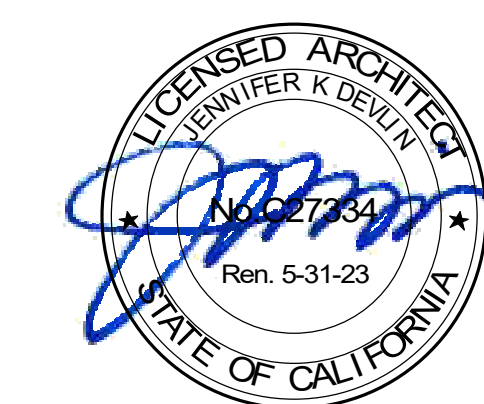

Printing Date  
95% CONSTRUCTION DOCUMENTS 06.25.2021  
PERMIT SET - OF 06.16.2021  
PERMIT SET - DSA V2 12.15.2021  
PERMIT SET - SFM 12.21.2021

Revisions and Description Date

| Revisions and Description | Date       |
|---------------------------|------------|
| 6 A Addendum 6            | 04.25.2022 |

Scale As Indicated

Drawn by Author

EHDD Job Number 20020

Sheet Title

**WOOD PARTITION TYPES AND FRAMING DETAILS**

Sheet Number

**A9.01**
















04/25/22 5:33:51 PM

C:\Users\gleusin\Documents\20251\_CSUS Child Development\_MP\_19\_gleusin\m3\m3.02\_mechanical-hvac-piping-floor-plan-a.rvt

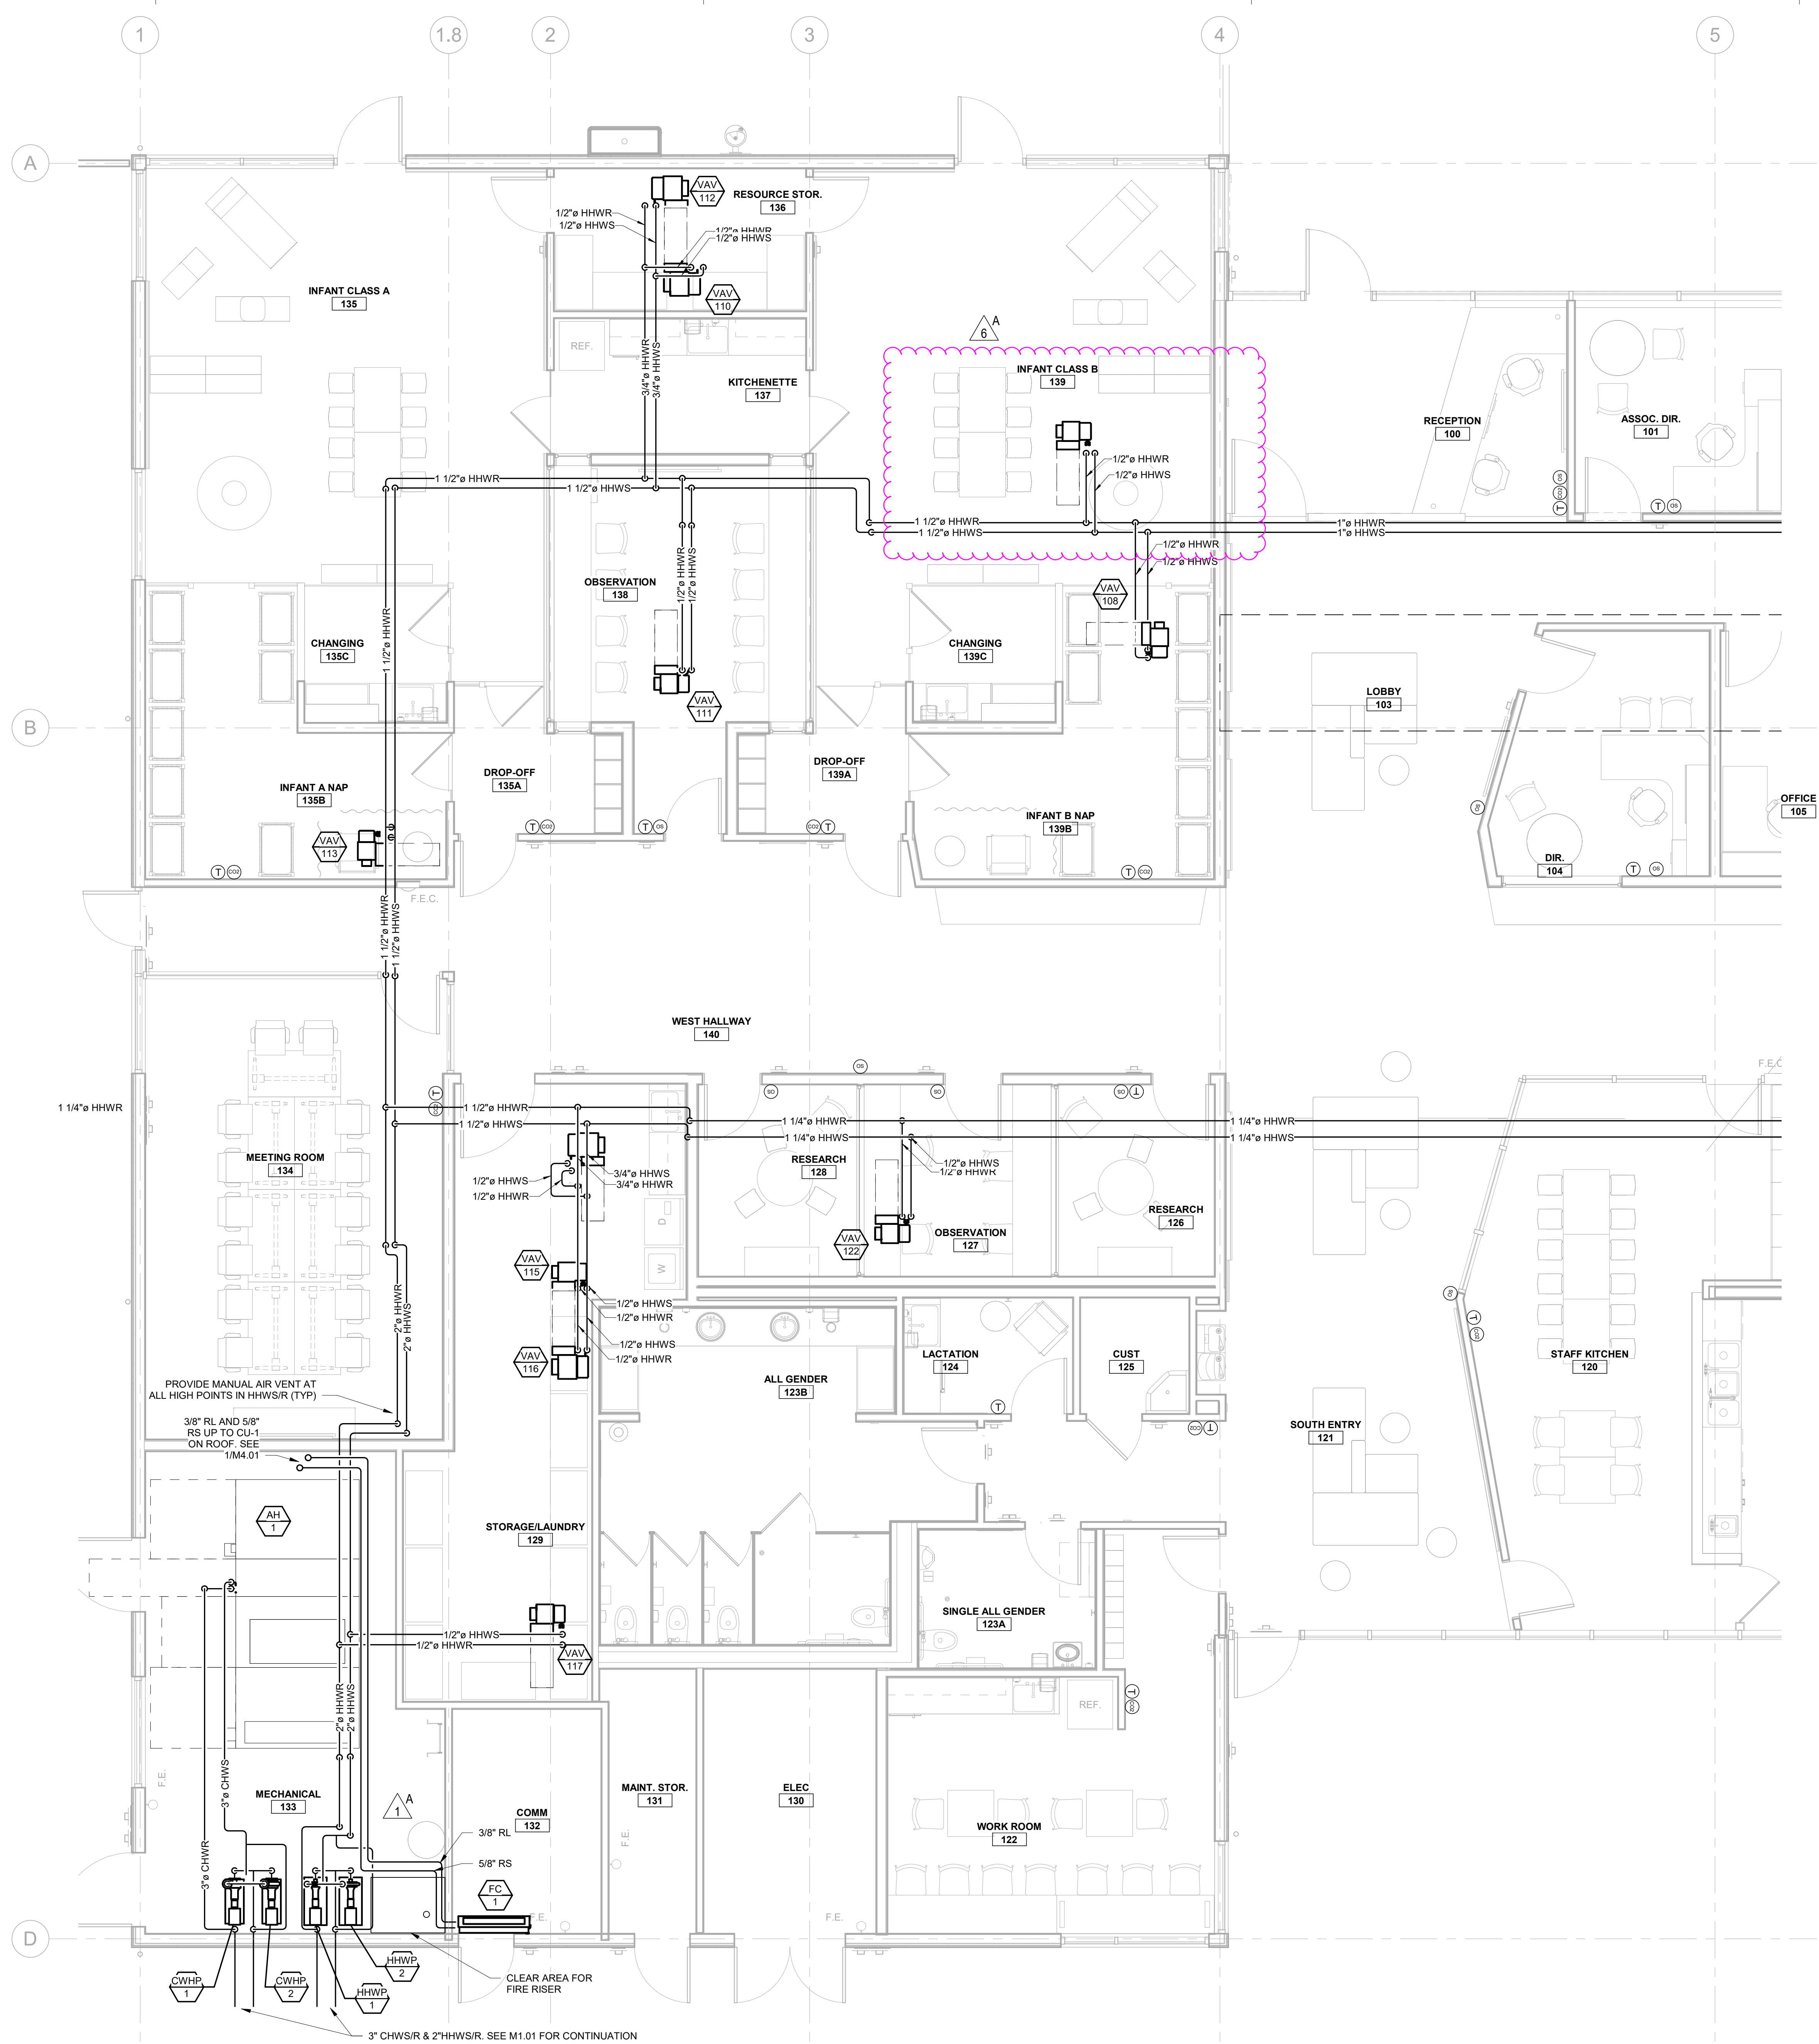

**MECHANICAL - HVAC PIPING FLOOR PLAN - A**  
 SCALE: 1/4" = 1'-0"  
 4' 0' 4' 8'

Division of the State Architect

Office of the State Fire Marshal

**CSUS CHILD DEVELOPMENT CENTER**


CALIFORNIA STATE UNIVERSITY, STANISLAUS  
 ONE UNIVERSITY CIRCLE  
 TURLOCK, CA 95382



PIER 1, BAY 2  
 THE EMBARCADERO  
 SAN FRANCISCO, CA 94111

INFO@EHDD.COM  
 +1 415-285-9193

Consultant

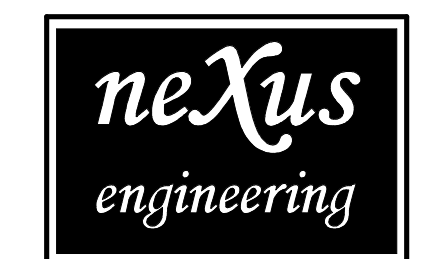

Consulting Mechanical Engineers  
 1400 Lone Palm Ave, Suite A  
 Modesto, CA 95351  
 Tel: 209.572.7399 Fax: 209.236.1579  
 www.nexus-engineering.com  
 HVAC, Plumbing, Fire, Sprinklers  
 Process/Pond Engineering, Refrigeration

Stamp



| Printing                   | Date       |
|----------------------------|------------|
| 95% CONSTRUCTION DOCUMENTS | 06.25.2021 |
| PERMIT SET                 | 08.16.2021 |
| PERMIT SET - DSA V2        | 12.15.2021 |
| PERMIT SET - SFM           | 12.21.2021 |

| Revisions and Description | Date       |
|---------------------------|------------|
| 1 A Addendum 1            | 04.01.2022 |
| 6 A Addendum 6            | 04.25.2022 |

Scale  
 1/4" = 1'-0"  
 Drawn by  
 GL  
 EHDD Job Number  
 20020

Sheet Title  
**MECHANICAL - ENLARGED HVAC PIPING FLOOR PLAN**  
 Sheet Number

**M3.02**

# CSUS CHILD DEVELOPMENT CENTER


CALIFORNIA STATE UNIVERSITY, STANISLAUS  
ONE UNIVERSITY CIRCLE  
TURLOCK, CA 95382



PIER 1, BAY 2  
THE EMBARCADERO  
SAN FRANCISCO, CA 94111

INFO@EHDD.COM  
+1 415-285-9193

Consultant

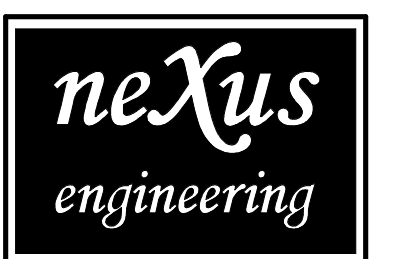

Consulting Mechanical Engineers  
1400 Lone Palm Ave, Suite A  
Menlo Park, CA 94025  
Tel: 209.572.7399 Fax: 209.236.1579  
www.nexusengineering.com  
HVAC, Plumbing, Fire, Sprinklers  
Process/Pilot Engineering, Refrigeration

Stamp



| Printing                   | Date       |
|----------------------------|------------|
| 95% CONSTRUCTION DOCUMENTS | 06.25.2021 |
| PERMIT SET                 | 08.16.2021 |
| PERMIT SET - DSA V2        | 12.15.2021 |
| PERMIT SET - SFM           | 12.21.2021 |

Revisions and Description Date

| 6 | A | Addendum 6 | 04.25.2022 |
|---|---|------------|------------|
|   |   |            |            |
|   |   |            |            |
Scale  
1/8" = 1'-0"


Drawn by  
GL

EHDD Job Number  
20020

Sheet Title  
**MECHANICAL - ROOF PLAN**

Sheet Number

# M4.01

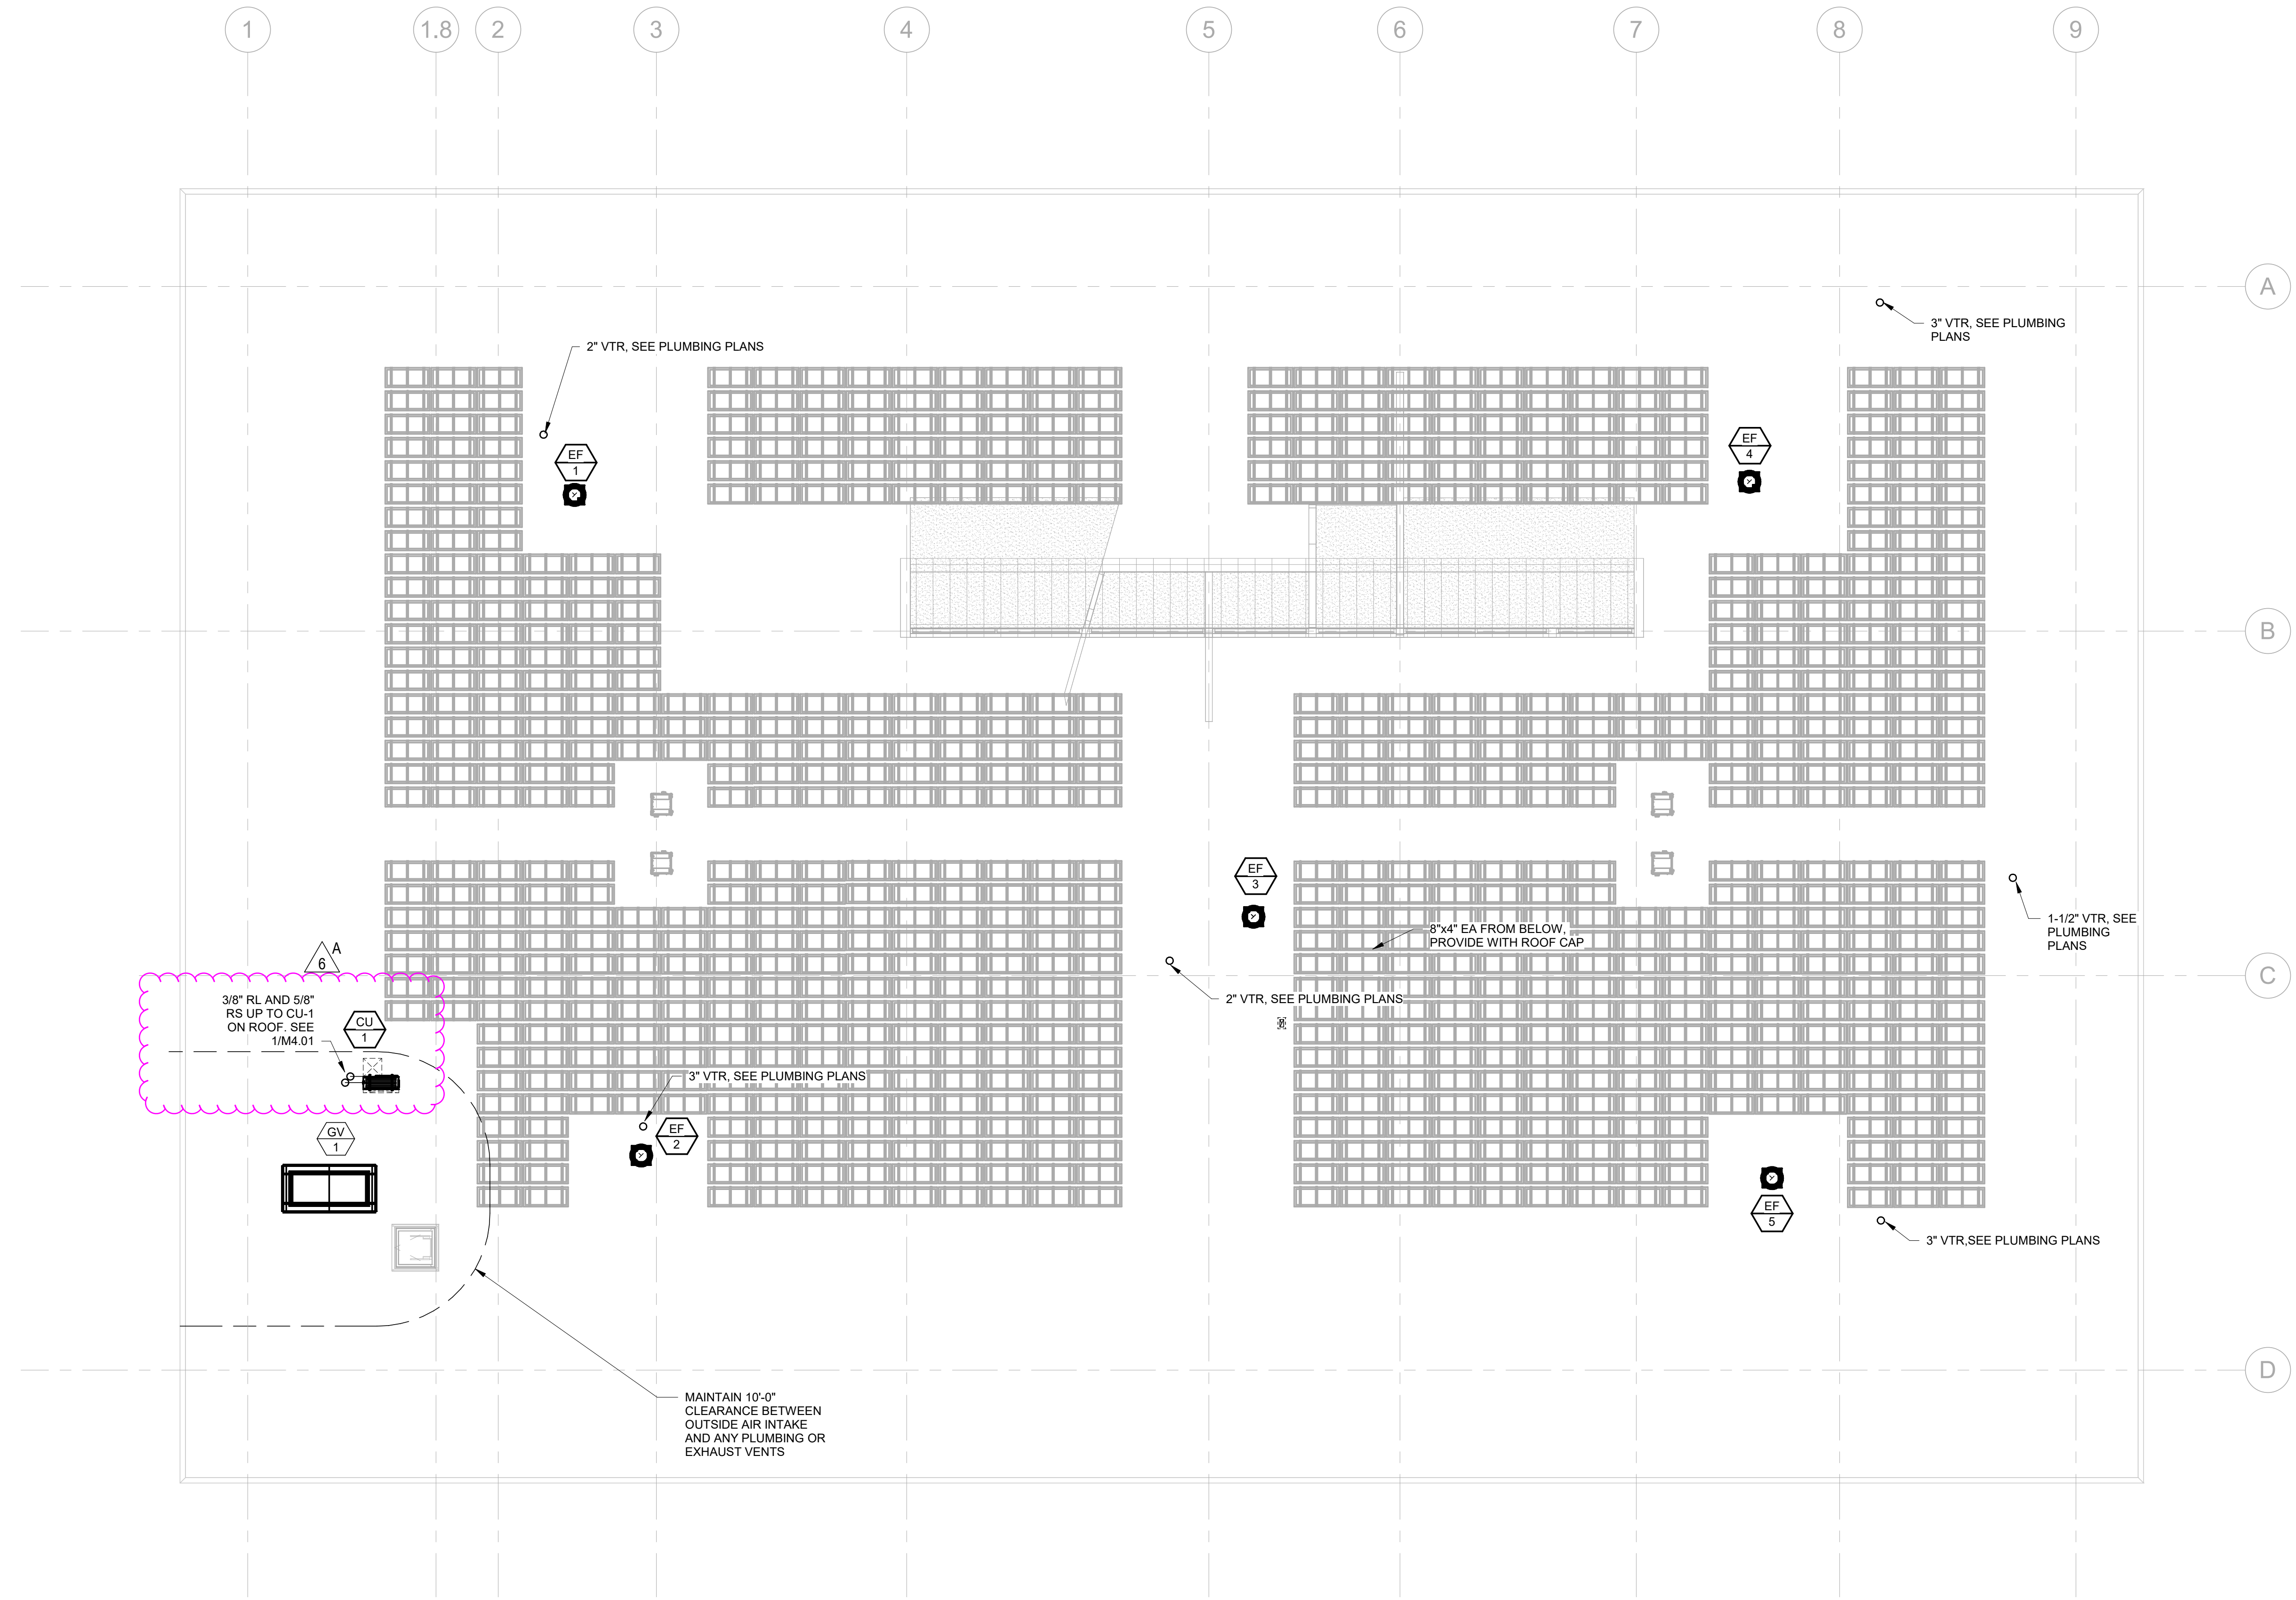

**MECHANICAL - ROOF PLAN**  
SCALE: 1/8" = 1'-0"  
8' 0' 8' 16'



PLUMBING GREEN BUILDING CODE NOTES

Table with 2 columns: REQUIRED and REQUIRED. Contains plumbing code notes for sections 5.301.1, 5.302, 5.303.1, 5.303.2, 5.303.3, 5.303.4, 5.303.5, and 5.303.6.

PLUMBING EQUIPMENT SCHEDULE

Table with 2 columns: MARK and DESCRIPTION. Lists plumbing equipment items like WH-1, ET-1, and GP-1.

PLUMBING FIXTURE SCHEDULE

Table with 2 columns: MARK and DESCRIPTION. Lists plumbing fixtures like WC-1, WC-2, WC-3, WC-4, UR-1, L-1, L-2, L-3, S-1, S-2, S-3, MS-1, WS-1, DF-1, DF-2, DF-3, TP-1, WB-1, WB-2, HB-1, HB-2, FS-1, FD-1, FCO, WCO, WHA-1, and WM.

6

CSUS CHILD DEVELOPMENT CENTER


CALIFORNIA STATE UNIVERSITY, STANISLAUS ONE UNIVERSITY CIRCLE TURLOCK, CA 95382



PIER 1, BAY 2 THE EMBARCADERO SAN FRANCISCO, CA 94111

INFO@EHDD.COM +1 415-285-9193

Consultant

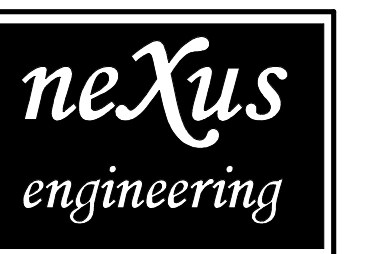

Consulting Mechanical Engineers 1400 Lone Palm Ave, Suite A Modesto, CA 95351 Tel: 209.572.7399 Fax: 209.236.1579 www.nexusengineering.com HVAC, Plumbing, Fire, Sprinkler Process/Paint Engineering, Refrigeration

Stamp



Printing

Table with 2 columns: Description and Date. Lists printing items like 95% CONSTRUCTION DOCUMENTS, PERMIT SET, PERMIT SET - DSA V2, PERMIT SET - SFM.

Revisions and Description Date

Table with 3 columns: Revision number, Description, and Date. Shows revision 6 as Addendum 6 on 04.25.2022.

Scale 1/2" = 1'-0"

Drawn by GL

EHDD Job Number 20020

Sheet Title


PLUMBING SCHEDULES & GREEN BUILDING NOTES

Sheet Number

P0.02



C:\Users\gleusin\Documents\20251\_CSUS Child Development\_MP\_19\_gleusin\mexuseengineering.net.rvt

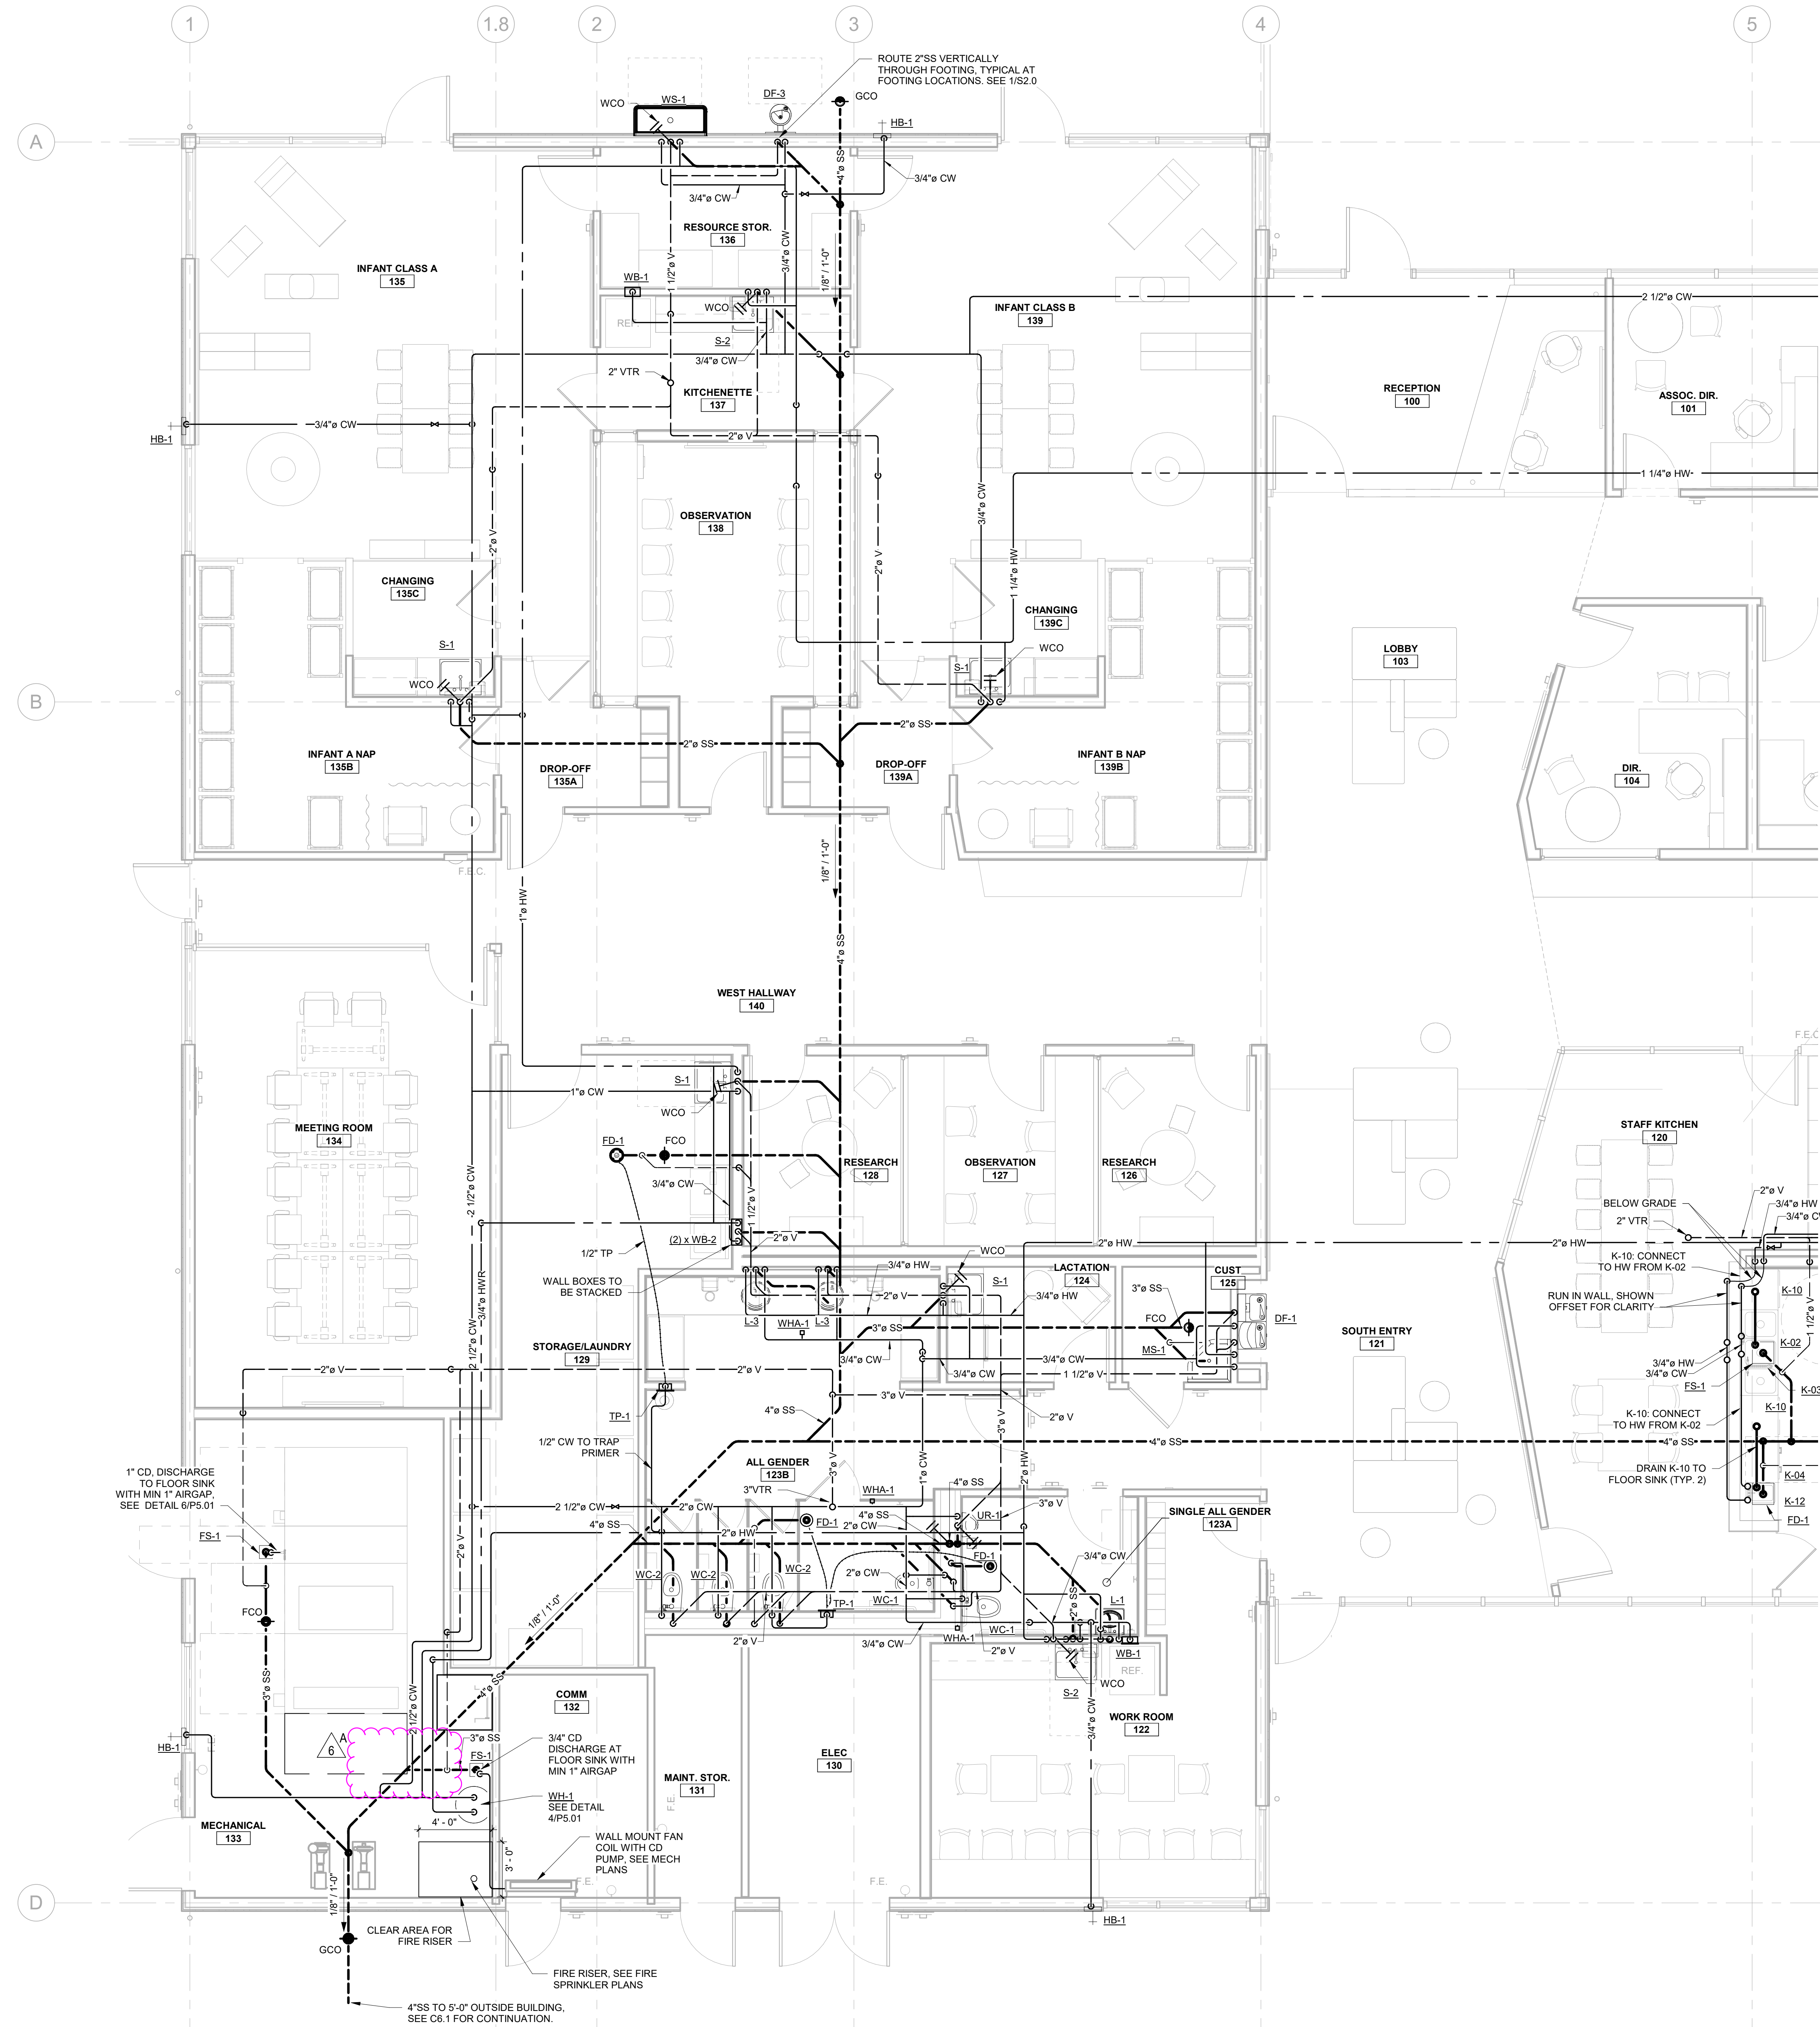

**SHEET NOTES**

1. ALL UNDERGROUND SS SHALL BE SLOPED AT 1/4" PER FOOT UNLESS OTHERWISE NOTED.

PIPE NOTED AS SLOPED AT 1/8" PER FOOT IS DUE TO STRUCTURE FEATURES MAKING 1/4" SLOPE IMPRACTICAL.

| EQUIPMENT SCHEDULE |     |                                              |                                                       |
|--------------------|-----|----------------------------------------------|-------------------------------------------------------|
| ITEM NO.           | QTY | DESCRIPTION                                  | REMARKS                                               |
| K-01               | 1   | HAND SINK                                    | INSTALLED BY VENDOR, PLUMBER CONNECT HW, CW, SS AND V |
| K-02               | 1   | THREE COMPARTMENT SINK DROP-IN               | INSTALLED BY VENDOR, PLUMBER CONNECT HW, CW, GS AND V |
| K-03               | 1   | PRE-RINSE FAUCET ASSEMBLY WITH ADD ON FAUCET | INSTALLED BY VENDOR, PLUMBER CONNECT HW, CW, GS AND V |
| K-04               | 1   | MOBILE DRAWER CABINET                        | INSTALLED BY VENDOR, NO PLUMBING                      |
| K-05               | 3   | TRASH CONTAINER                              | NICEC / BY OWNER-OPERATOR                             |
| K-06               | 1   | RANGE 30"                                    | INSTALLED BY VENDOR, NO PLUMBING                      |
| K-07               | 1   | EXHAUST VENTILATOR                           | INSTALLED BY VENDOR, NO PLUMBING                      |
| K-08               | 0   | OPEN NUMBER                                  |                                                       |
| K-09               | 1   | MICROWAVE                                    | INSTALLED BY VENDOR, NO PLUMBING                      |
| K-10               | 2   | DISHWASHER, UNDCOUNTER                       | INSTALLED BY VENDOR, PLUMBER CONNECT HW, AND GS       |
| K-11               | 1   | HEATED CABINET                               | INSTALLED BY VENDOR, NO PLUMBING                      |
| K-12               | 1   | PREP SINK, DROP IN                           | INSTALLED BY VENDOR, PLUMBER CONNECT HW, CW, GS AND V |
| P-01               | 1   | REACH-IN REFRIGERATOR                        | INSTALLED BY VENDOR, NO PLUMBING                      |
| P-02               | 3   | 80" SHELVING UNIT                            | INSTALLED BY VENDOR, NO PLUMBING                      |
| P-03               | 1   | REACH-IN FREEZER                             | INSTALLED BY VENDOR, NO PLUMBING                      |

Division of the State Architect

Office of the State Fire Marshal

**CSUS CHILD DEVELOPMENT CENTER**

CALIFORNIA STATE UNIVERSITY, STANISLAUS  
 ONE UNIVERSITY CIRCLE  
 TURLOCK, CA 95302



PIER 1, BAY 2  
 THE EMBARCADERO  
 SAN FRANCISCO, CA 94111

INFO@EHDD.COM  
 +1 415-285-9193

Consultant

Consulting Mechanical Engineers  
 1400 Lone Palm Ave., Suite A  
 Modesto, CA 95351  
 Tel: 209.572.7399 Fax: 209.236.1579  
 www.nexus-engineering.com

Stamp

| Printing                   | Date       |
|----------------------------|------------|
| 95% CONSTRUCTION DOCUMENTS | 06.25.2021 |
| PERMIT SET                 | 08.16.2021 |
| PERMIT SET - DSA V2        | 12.15.2021 |
| PERMIT SET - SFM           | 12.21.2021 |

| Revisions and Description | Date       |
|---------------------------|------------|
| 6 A Addendum 6            | 04.25.2022 |

Scale  
 As indicated

Drawn by  
 GL

EHDD Job Number  
 202020

Sheet Title  
**PLUMBING - ENLARGED FLOOR PLAN**

Sheet Number  
**P1.02**

**1 PLUMBING - FLOOR PLAN - A**  
 SCALE: 1/4" = 1'-0"



# CSUS CHILD DEVELOPMENT CENTER


CALIFORNIA STATE UNIVERSITY, STANISLAUS ONE UNIVERSITY CIRCLE TURLOCK, CA 95302



PIER 1, BAY 2 THE EMBARCADERO SAN FRANCISCO, CA 94111


INFO@EHDD.COM +1 415-285-9193

Consultant

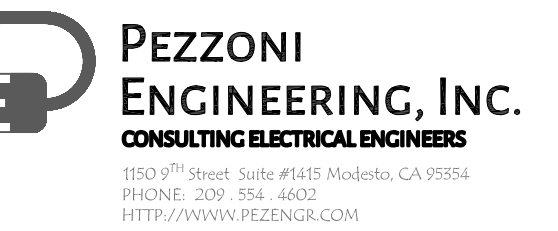

PEZZONI ENGINEERING, INC. © Copyrighted 2020

Stamp

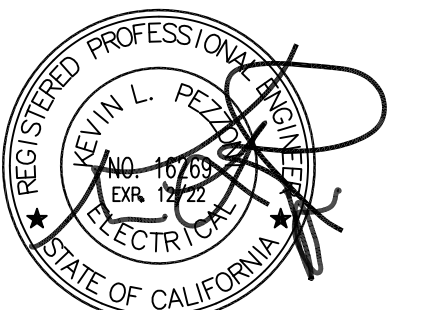

| Printing                   | Date       |
|----------------------------|------------|
| 95% CONSTRUCTION DOCUMENTS | 06.25.2021 |
| PERMIT SET                 | 08.18.2021 |
| PERMIT SET - DSA V2        | 12.15.2021 |
| PERMIT SET - SFM           | 12.21.2021 |

Revisions and Description Date

| 1 | A | Addendum 1 | 04.01.2022 |
|---|---|------------|------------|
| 2 | A | Addendum 2 | 04.13.2022 |
| 6 | A | Addendum 6 | 04.25.2022 |
|   |   |            |            |
|   |   |            |            |
Scale

AS NOTED

Drawn by

CCM / KP

EHDD Job Number

2020

Sheet Title

ROOF PLAN POWER

Sheet Number


# E6.1

## SHEET NOTES

- REFER TO THE GENERAL NOTES ON SHEET E0.1 FOR ADDITIONAL REQUIREMENTS.
- ALL RECEPTACLES, WHETHER INDICATED OR NOT, INSTALLED WITH-IN SIX FEET (6') OF A SINK SHALL BE EQUIPPED WITH A GROUND FAULT CIRCUIT INTERRUPTER AS REQUIRED BY THE CALIFORNIA ELECTRICAL CODE (C.E.C.) 210.8(B)(5).
- RECEPTACLE OUTLET BOX, (WITH UNRESTRICTED CLEAR APPROACH), MOUNTING HEIGHT SHALL BE LOCATED NO MORE THAN 48" MEASURED FROM THE TOP OF THE OUTLET BOX NOR LESS THAN 15" MEASURED FROM THE BOTTOM OF THE OUTLET BOX TO THE LEVEL OF THE FINISHED FLOOR OR WORKING PLATFORM AS REQUIRED BY C.E.C. SECTION 11B-308.1.2. RECEPTACLE OUTLET BOX LOCATED ABOVE COUNTER, WHERE ACCESS IS RESTRICTED, MOUNTING HEIGHT SHALL BE NO MORE THAN 3'-10" MEASURED FROM THE TOP OF THE OUTLET BOX FOR SIDE REACH OR 3'-8" MEASURED FROM THE TOP OF THE OUTLET BOX FOR FORWARD REACH TO THE LEVEL OF THE FINISHED FLOOR OR WORKING PLATFORM.
- SUBSCRIPT "ACT" AT DEVICE SYMBOL AT DEVICE INDICATES MOUNTING ABOVE COUNTER HEIGHT. COORDINATE DEVICE MOUNTING HEIGHT WITH THE ARCHITECTURAL INTERIOR ELEVATIONS PRIOR TO ROUGH-IN.
- CONTRACTOR IS RESPONSIBLE TO PROVIDE ALL JUNCTION BOXES, CONDUIT AND WIRING AS REQUIRED FOR A COMPLETE AND OPERABLE SYSTEM. MULTI-WIRE BRANCH CIRCUIT WIRING SHALL COMPLY WITH C.E.C. 210.4(B).
- ALL RECEPTACLES SHALL BE TAMPER RESISTANT.
- THE EQUIPMENT DESIGNATED "N.I.E.S." IS EITHER OWNER FURNISHED/CONTRACTOR INSTALLED OR FURNISHED AND INSTALLED UNDER OTHER SECTIONS OF THIS PROJECT. THE ELECTRICAL CONTRACTOR IS RESPONSIBLE TO MAKE ELECTRICAL CONNECTION TO EQUIPMENT AS REQUIRED BY THE EQUIPMENT. PROVIDE ALL NECESSARY JUNCTION BOXES, CONDUIT AND WIRING AS REQUIRED FOR COMPLETE INSTALLATION. COORDINATE CONNECTION REQUIREMENTS WITH EQUIPMENT PRIOR TO THE EXECUTION OF WORK.
- REFER TO THE MECHANICAL SCHEDULE ON SHEETS M0 FOR MECHANICAL EQUIPMENT REQUIREMENTS.
- MECHANICAL DRAWINGS AND SPECIFICATIONS ARE SUBJECT TO LAST MINUTE CHANGES, THEREFORE THE ELECTRICAL CONTRACTOR SHALL BE RESPONSIBLE FOR FINAL COORDINATION BETWEEN ELECTRICAL AND MECHANICAL DRAWINGS. CONDUIT AND WIRING FOR THE LOW VOLTAGE CONTROLS SHALL BE PROVIDED UNDER DIVISION 23 SCOPE OF WORK.
- ELECTRICAL REQUIREMENTS FOR MECHANICAL EQUIPMENT AS SPECIFIED ON THE MECHANICAL DRAWINGS MAY BE DIFFERENT BASED ON ACTUAL MECHANICAL EQUIPMENT SUBMITTALS. ELECTRICAL CONTRACTOR SHALL BE RESPONSIBLE FOR FINAL COORDINATION WITH THE ACTUAL MECHANICAL EQUIPMENT SUBMITTALS AND PROVIDE CONDUIT, WIRES, DISCONNECT AND CIRCUIT BREAKERS, SIZE AS REQUIRED, PER EQUIPMENT NAMEPLATE RATING.
- DISCONNECT SWITCHES LOCATED OUTSIDE SHALL BE WEATHERPROOF.

## PLAN NOTES



- (N) PV INVERTER -ROOF TOP MOUNTED -SMA #CORE1 SEE SINGLE LINE DIAGRAM -SEE STRUCTURAL FOR MOUNTING -INSTALL (N) 1 1/2" (POWER) & 1" (DATA) W/LFMC CONNECTIONS
- (N) 430V PV PANEL -TYPICAL
- (BASE BID) PV INVERTER LOCATION -ROOF TOP MOUNTED UNIT -SEE STRUCTURAL FOR MOUNTING -INSTALL (N) 1 1/2" (POWER) & 1" (DATA) W/CAPS +12" ABOVE FINISHED ROOFING  
(BID ALTERNATE #5) PROVIDE & INSTALL (N) PV INVERTER #CORE1-50-US (52kW -480V -3PH) UNIT -INSTALL (N) FEEDER & DATA CONNECTION TO INVERTER W/LFMC CONNECTIONS
- (BID ALTERNATE #5) (N) 430V PV PANEL -TYPICAL

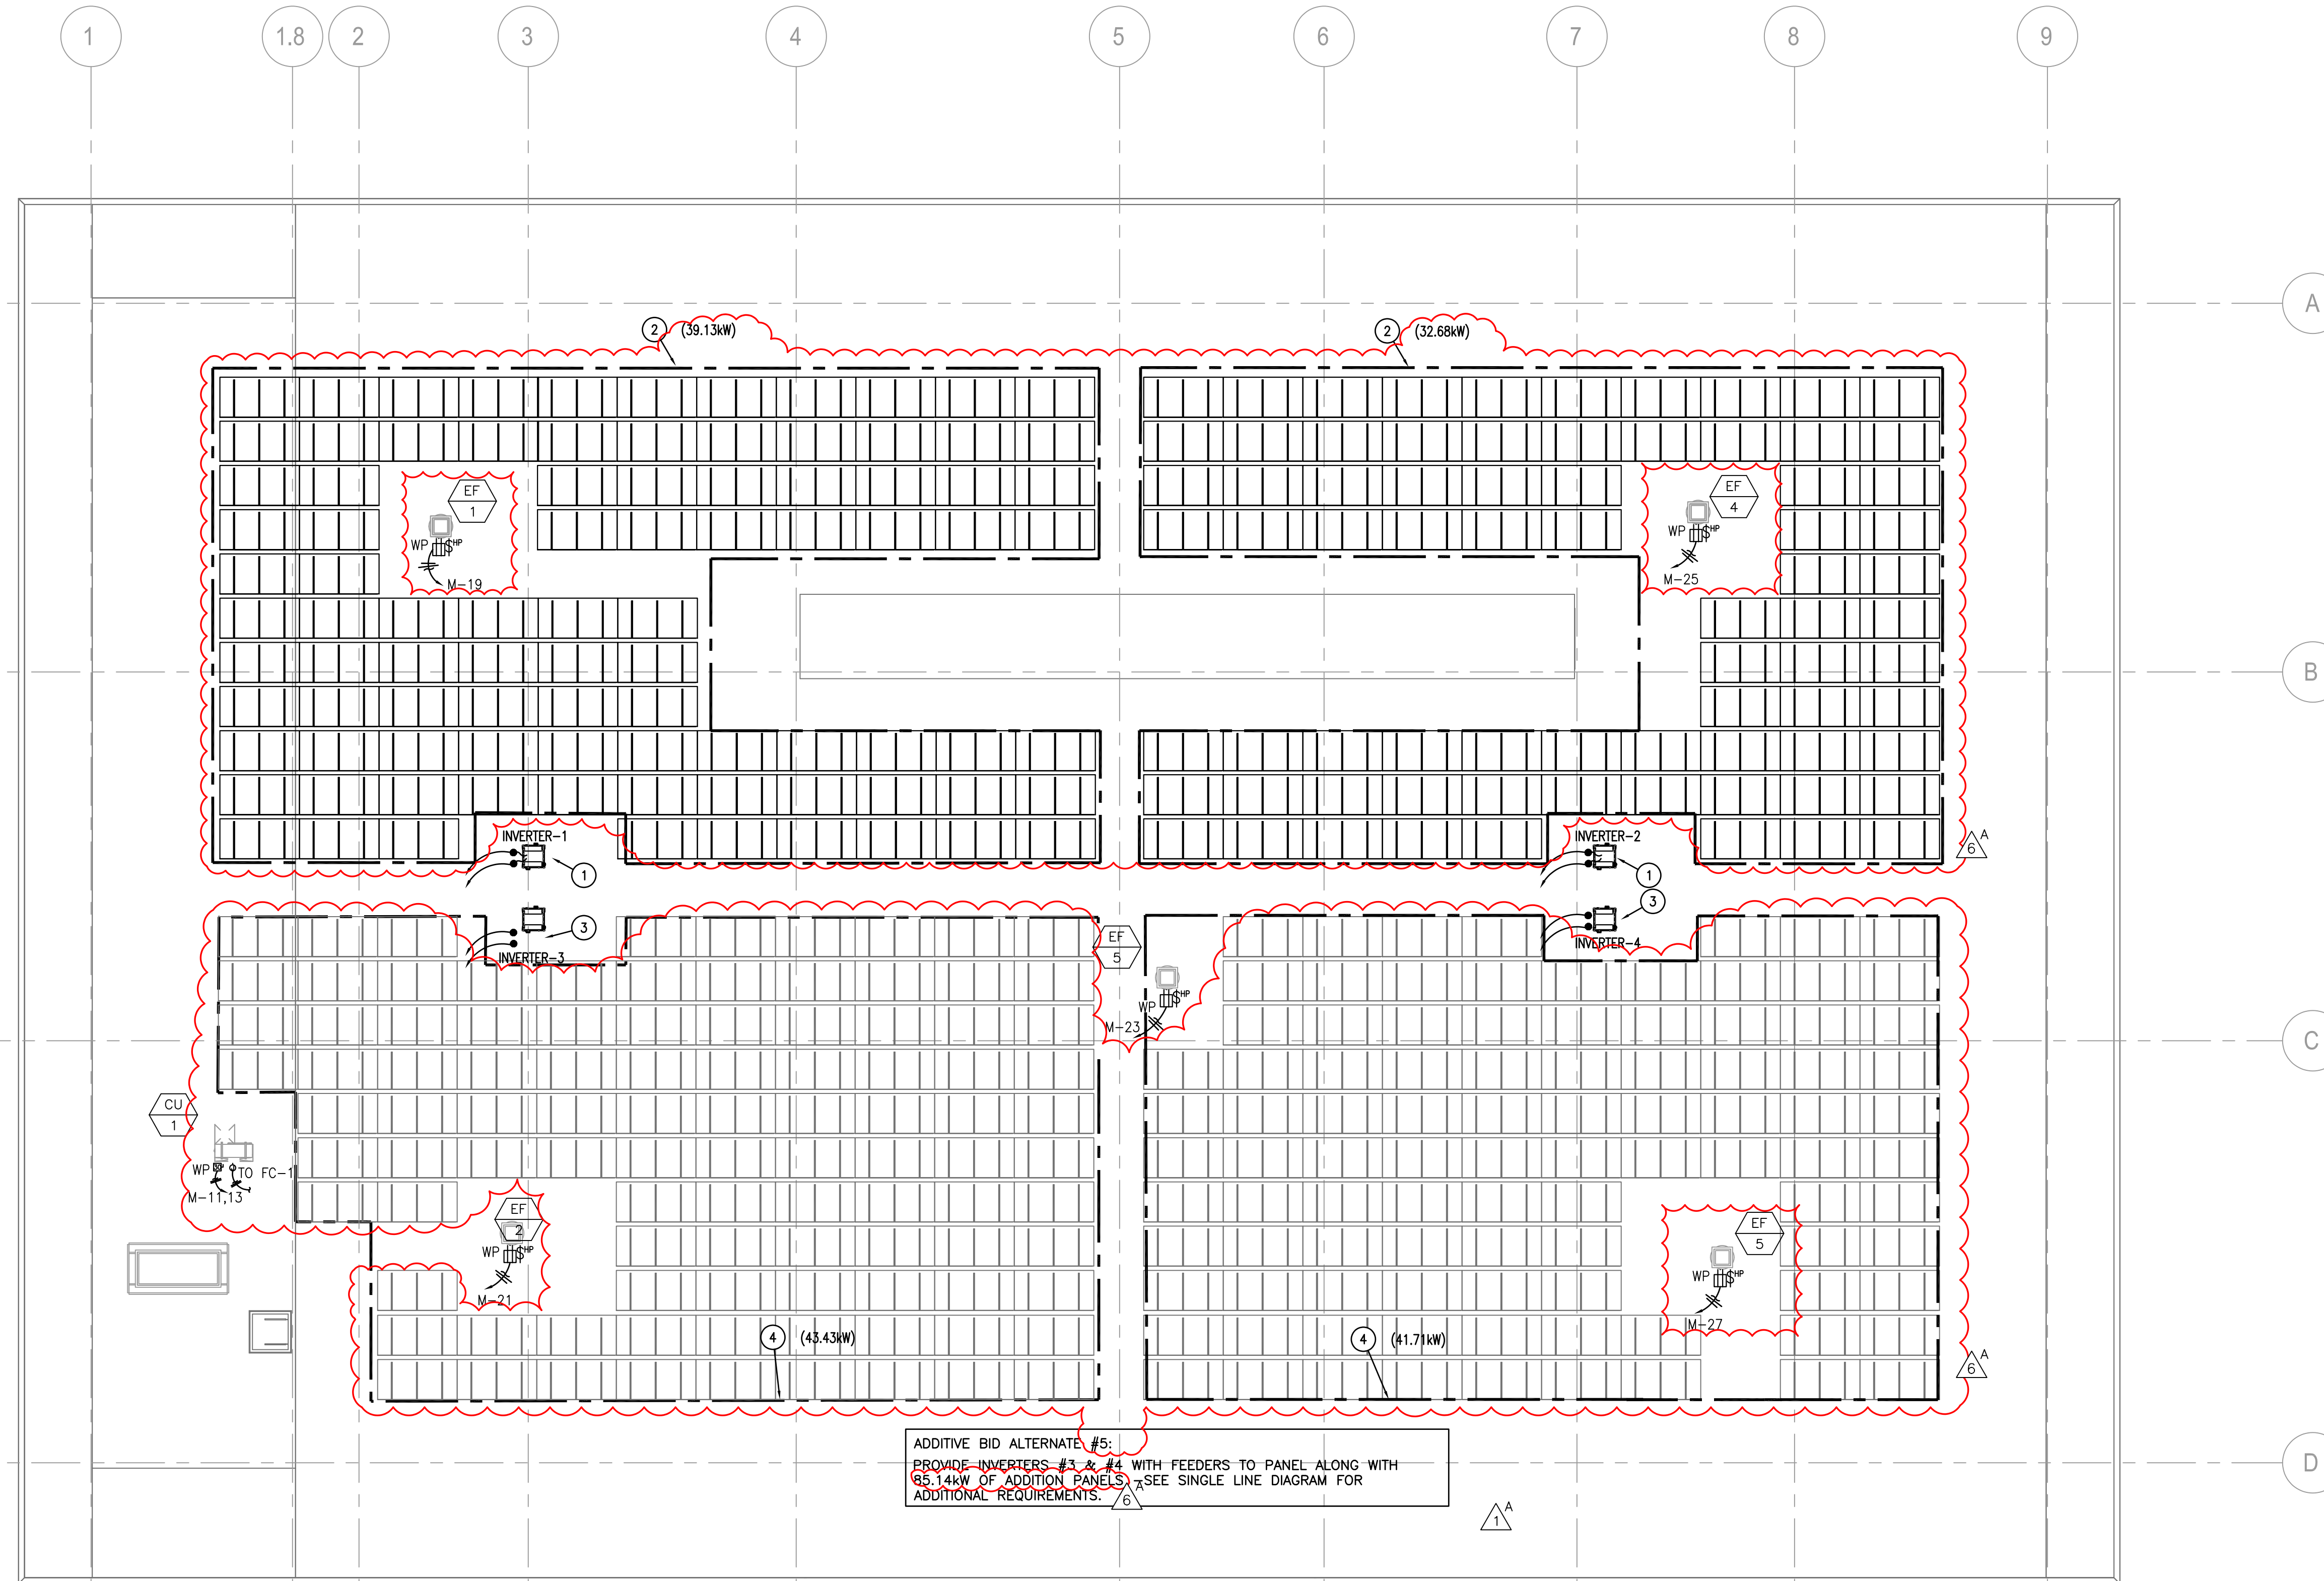

ADDITIVE BID ALTERNATE #5:  
 PROVIDE INVERTERS #1, #4, #14 WITH FEEDERS TO PANEL ALONG WITH  
 (65.14kW OF ADDITION PANELS) -SEE SINGLE LINE DIAGRAM FOR  
 ADDITIONAL REQUIREMENTS.

## 1 ROOF PLAN POWER

SCALE: 1/8"=1'-0"

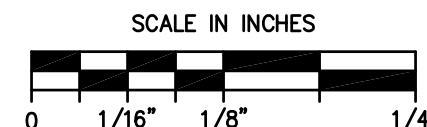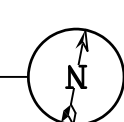



### CSUS CHILD DEVELOPMENT CENTER


CALIFORNIA STATE UNIVERSITY, STANISLAUS ONE UNIVERSITY CIRCLE TURLOCK, CA 95382



PIER 1, BAY 2 THE EMBARCADERO SAN FRANCISCO, CA 94111


INFO@EHDD.COM +1-415-285-9193

Consultant

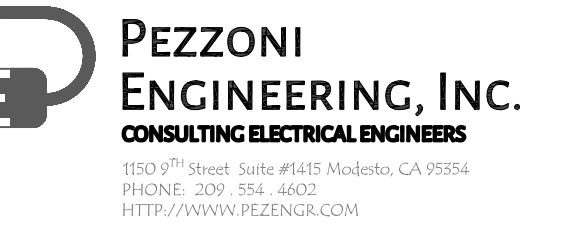

PEZZONI ENGINEERING, INC. © Copyrighted 2020

Stamp

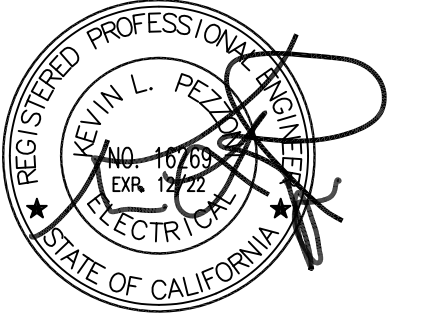

| Printing                   | Date       |
|----------------------------|------------|
| 95% CONSTRUCTION DOCUMENTS | 06.25.2021 |
| PERMIT SET                 | 08.18.2021 |
| PERMIT SET - DSA V2        | 12.15.2021 |
| PERMIT SET - SFM           | 12.21.2021 |

| Revisions and Description | Date       |
|---------------------------|------------|
| 1 A Addendum 1            | 04.01.2022 |
| 2 A Addendum 2            | 04.13.2022 |
| 6 A Addendum 6            | 04.25.2022 |
|                           |            |
|                           |            |
Scale  
**AS NOTED**  
 Drawn by  
**CCM / KP**  
 EHDD Job Number  
**20020**  
 Sheet Title  
**SINGLE LINE DIAGRAM**

Sheet Number


# E7.1

**BMS METERING AUTOMATION SCOPE**

INTERNAL/EXTERIOR EQUIPMENT CABINET (20"Wx36"Hx6"D MIN.) W/BACKBOARD FOR CAMPUS METERING EQUIPMENT. CONTRACTOR TO COORDINATE WITH VENDOR FOR A MODBUS NETWORK BETWEEN ALL (N) METERS. WITHIN THE CABINET PROVIDE THE FOLLOWING DIN RAIL MOUNTED EQUIPMENT:

- POWERLOGIC EGX300 MODBUS ETHERNET GATEWAY
- PHOENIX CONTACT #2891028- 4 PORT INDUSTRIAL ETHERNET SWITCH
- PHOENIX CONTACT #2866763- POWER SUPPLY UNIT 120VAC IN/24VDC OUT -10A OUTPUT
- PHOENIX CONTACT #5600462- DIN RAIL MOUNTED GFCI RECEPTACLE
- PROSOFT S201-MNET-BACNET- MODBUS TCP/IP TO BACNET/IP CLIENT GATEWAY
- DIN MOUNTED BREAKERS (QNTY & RATING AS REQ'D.)

REFER TO DRAWING 5/E3.0 FOR 120VAC AND 24VDC INTERCONNECTION WIRING AS WELL AS COORDINATE 24VDC TO ALL MODBUS DEVICES (POWER ION METERS AND POWERLOGIC DEVICES). CONTRACTOR TO PROVIDE CAT-6 SHIELD PATCH CABLES FOR GATEWAYS, ETHERNET SWITCH, AND WAP. PROVIDE A COMPLETE AND WORKING SYSTEM FOR ALL POWERLOGIC BREAKERS SHOWN AND THE POWER-ION METER. CONTRACTOR TO COORDINATE MODBUS TAGS INTO BACNET GATEWAY FOR UNIVERSITY'S BMS VENDOR. CONTRACTOR SHALL COORDINATE ETHERNET TCP/IP CONNECTIVITY WITH UNIVERSITY'S EXISTING WIRELESS NETWORK VIA IT DEPT.

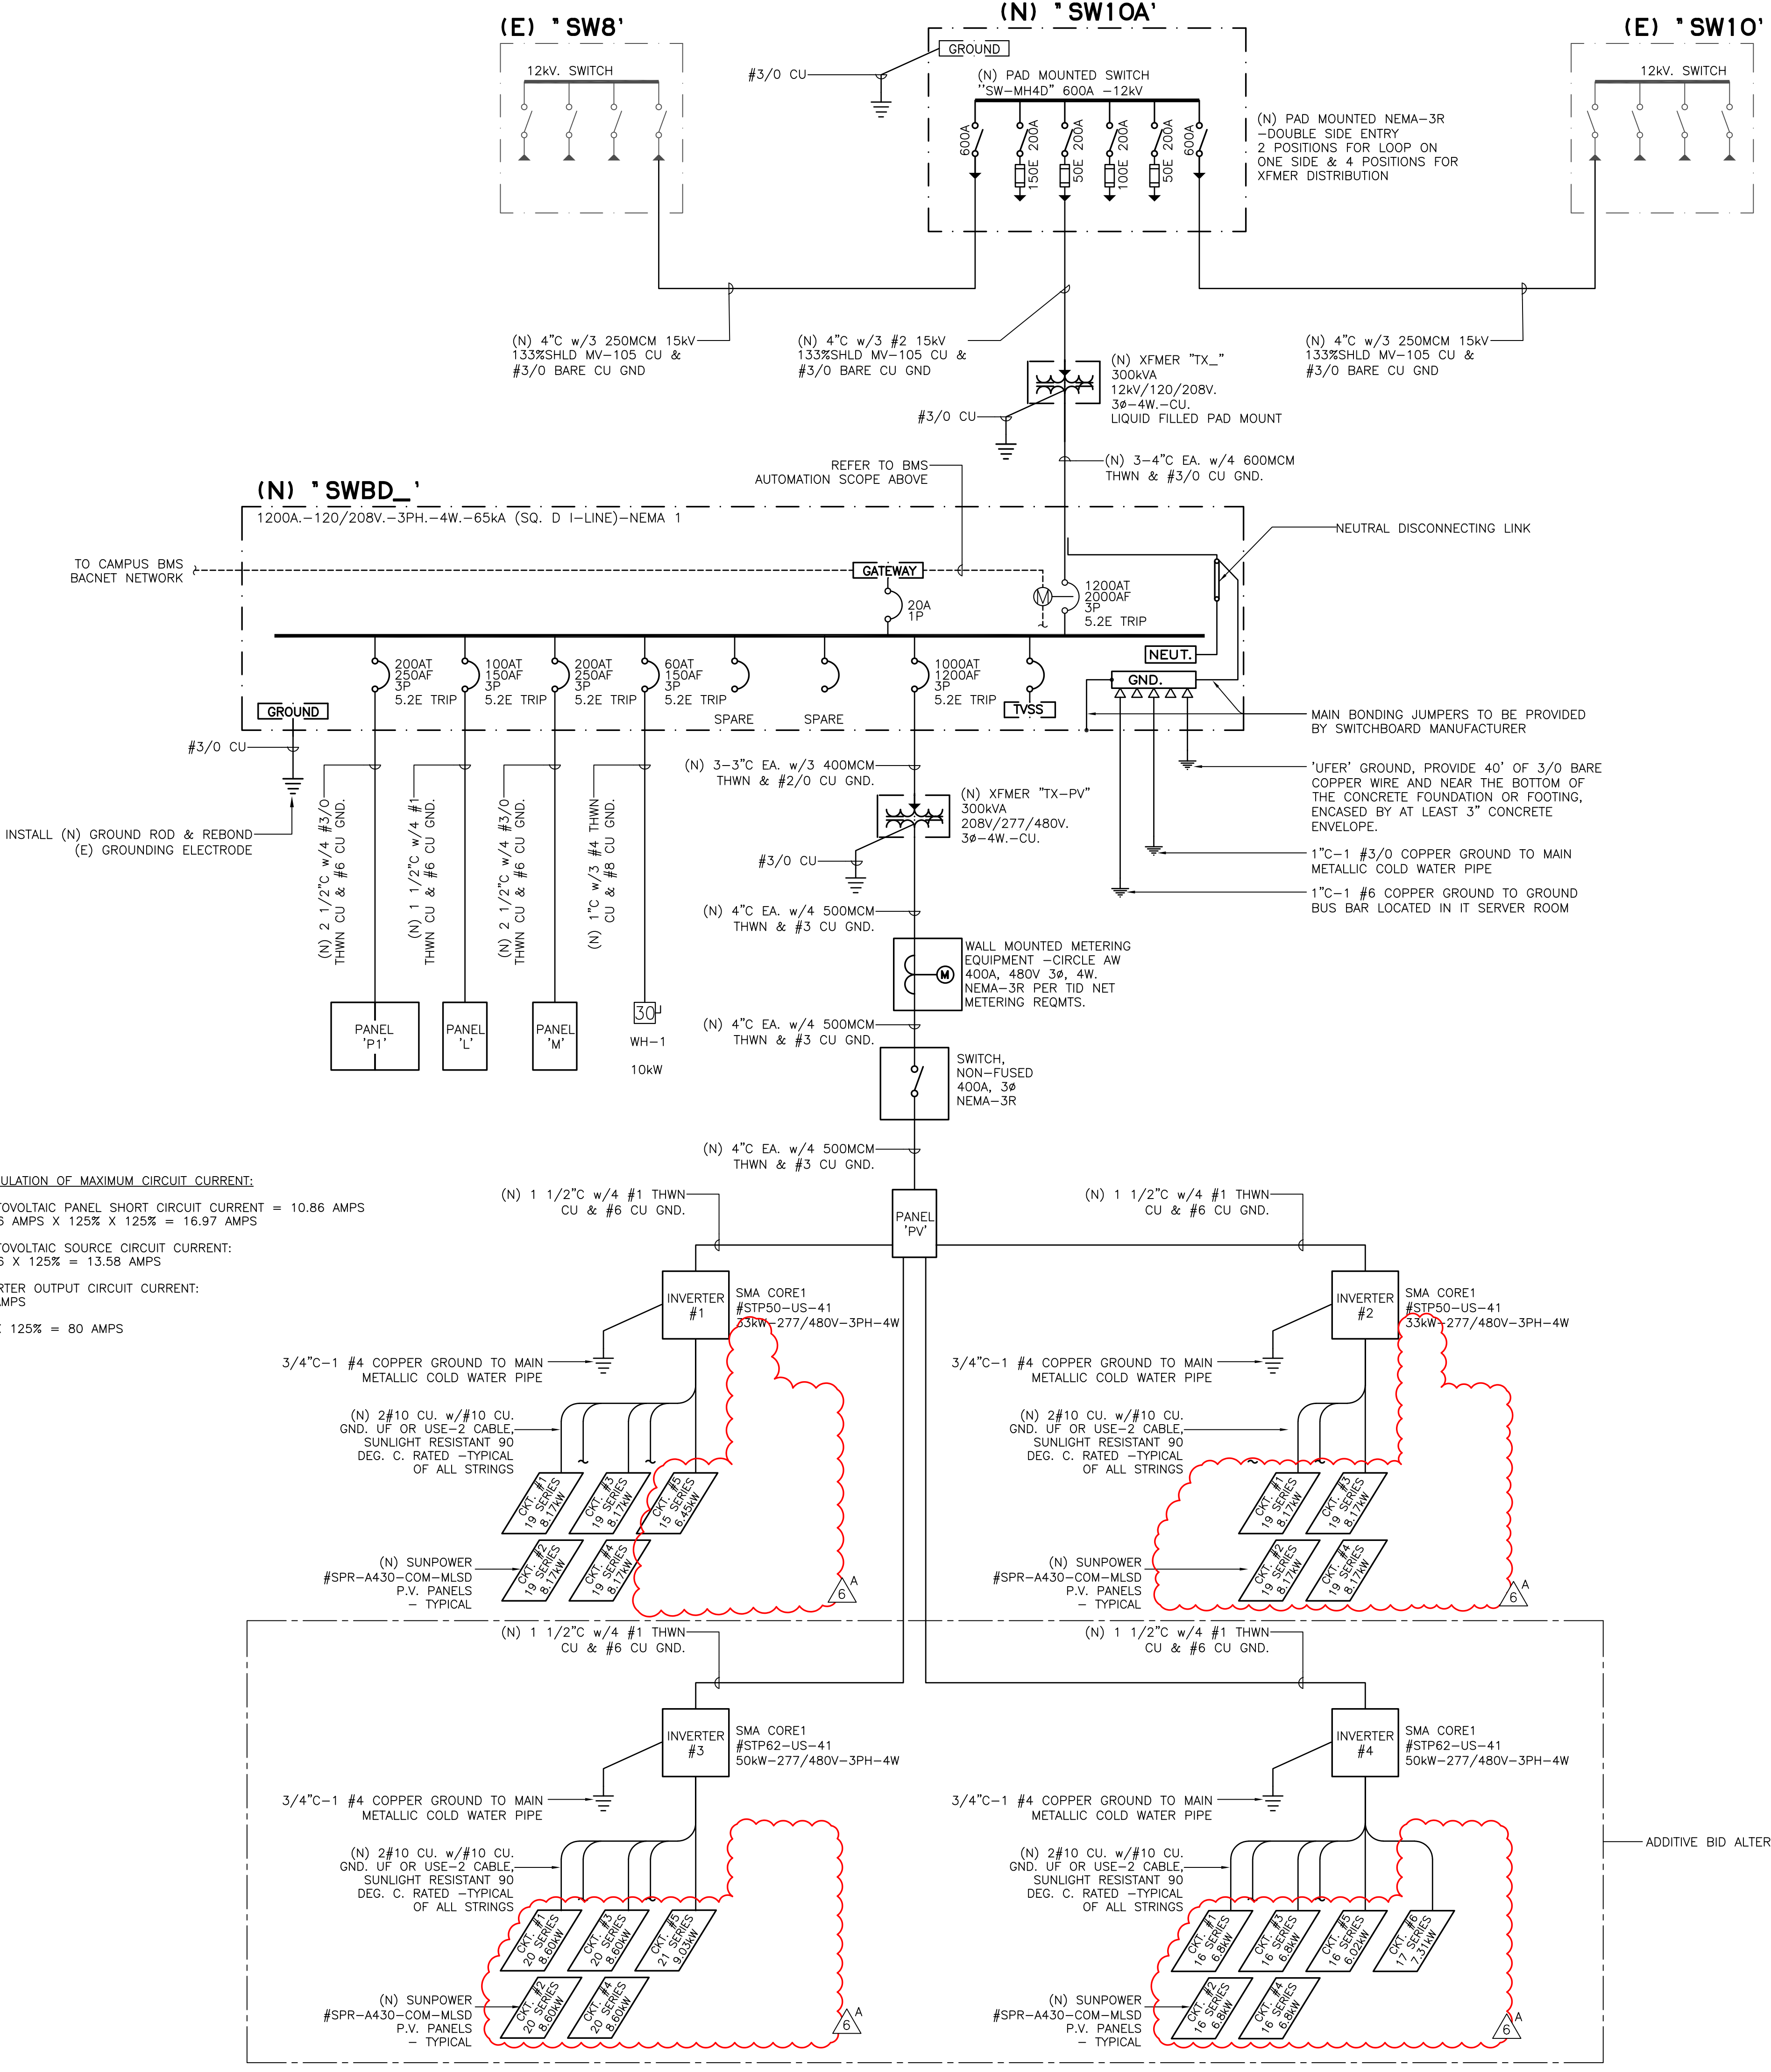

**CALCULATION OF MAXIMUM CIRCUIT CURRENT:**  
 PHOTOVOLTAIC PANEL SHORT CIRCUIT CURRENT = 10.86 AMPS  
 10.86 AMPS X 125% X 125% = 16.97 AMPS  
 PHOTOVOLTAIC SOURCE CIRCUIT CURRENT:  
 10.86 X 125% = 13.58 AMPS  
 INVERTER OUTPUT CIRCUIT CURRENT:  
 64 AMPS  
 64 X 125% = 80 AMPS

**1 SINGLE LINE DIAGRAM**  
 SCALE: NTS

**TRANSFORMER (NON-UTILITY) 3-PHASE, 4-WIRE SECONDARY POWER GROUNDING DETAIL**