

Addendum No. 02



March 10, 2023

Shields & Brawley Elementary School

Prepared By SIM-PBK Architects, Inc.; 7790 N. Palm Avenue; Fresno, California 93711

SIM-PBK Architects Project Number 17-67

Notice to Bidders

- A. Receipt of this Addendum shall be acknowledged on the Proposal Form. Failure to acknowledge receipt of each addendum may subject bidder to disqualification.
- B. This Addendum forms part of the Contract Documents for the above referenced project and shall be incorporated integrally therewith.
- C. Each proposer shall make necessary adjustments and submit their proposal with full knowledge of all modifications, clarifications, and supplemental data included therein. Where provisions of the following supplemental data differ from those of the original Contract Documents, this Addendum shall govern.

GENERAL

- Item No. 2-01 **CLOUDS and DELTA 2 TAGS**, indicate changes / revisions / modifications within the document, no changes to rest of DSA approved set.
- Item No. 2-02 **REFER TO “INSTRUCTION TO BIDDERS” PRE-BID CONFERENCES: *Bidders must attend at least one pre-bid conference in order to be eligible to submit a bid for this project.***
Mandatory Pre-bid conference will be held on May 11, 2023, at 10:00 A.M. and May 17, 2023, at 10:00 A.M. **and ADDED (third Mandatory job walk) May 23, 2023 at 10:00 A.M.** The project is located on the northwest corner of the intersection of Shields & Brawley Avenues in Fresno, CA. The address is: 4108 West Shields Avenue, Fresno, California 93722. We will meet on the 4000 block of Fountain Way (west of Brawley Avenue) in front of the site.

SPECIFICATIONS

- Item No. 2-03 **09 66 00 RESILIENT FLOOR COVERING**
ADDED specification, see attached AD 2-03a.
- Item No. 2-04 **09 72 00 PROTECTIVE WALL PANELS**
ADDED specification, see attached AD 2-04a.
- Item No. 2-05 **28 31 00 FIRE ALARM**
ADDED specification, see attached AD 2-05a.
- Item No. 2-06 **10 26 00 ACROVYN**
ADDED specification, see attached AD 2-06a

Addendum No. 02



March 10, 2023

Shields & Brawley Elementary School

Item No. 2-07 **09 72 00 TACKABLE WALL COVERING**
ADDED specification, see attached AD 2-07a. Replace all 2(2)"x 12' long Tack Strips in approved plans with (5) 24"x48" Tackboard Panels. See color schedule remark 13/A2.8. For Classrooms 4, 14,16, and 21, contractor to provide district with tackboard panels for each classroom instead of installing them in each specified room.

DRAWINGS

Item No. 2-08 **SHEET A1.4, ENLARGED RESTROOM PLAN, First Floor**
REPLACE sheet in its entirety, see attached AD 2-08a

Item No. 2-09 **SHEET A1.5, ENLARGED RESTROOM PLAN, First Floor**
REPLACE sheet in its entirety, see attached AD 2-09a

Item No. 2-10 **SHEET A1.9, ENLARGED RESTROOM PLAN, First Floor**
REPLACE sheet in its entirety, see attached AD 2-10a

Item No. 2-11 **SHEET A1.10, ENLARGED STAIR PLAN, First Floor**
REPLACE sheet in its entirety, see attached AD 2-11a

Item No. 2-12 **SHEET A1.14, ENLARGED RESTROOM PLAN, MPR**
REPLACE sheet in its entirety, see attached AD 2-12a

Item No. 2-13 **SHEET A2.1, FINISH SCHEDULE, MAIN**
REPLACE sheet in its entirety, see attached AD 2-13a

Item No. 2-14 **SHEET A2.2, FINISH SCHEDULE, MAIN**
REPLACE sheet in its entirety, see attached AD 2-14a

Item No. 2-15 **SHEET A2.3, FINISH SCHEDULE, MAIN**
REPLACE sheet in its entirety, see attached AD 2-15a

Item No. 2-16 **SHEET A2.4, FINISH SCHEDULE, MAIN**
REPLACE sheet in its entirety, see attached AD 2-16a

Item No. 2-17 **SHEET A2.5, DOOR SCHEDULE, MAIN, 2ND FLOOR**
REPLACE sheet in its entirety, see attached AD 2-17a

Item No. 2-18 **SHEET A2.6, WINDOW SCHEDULE, MAIN, 2ND FLOOR**
REVISED Door Schedule to Read Window Schedule,
see attached AD 2-18a

Item No. 2-19 **SHEET A2.8, COLOR SCHEDULE**
REPLACE sheet in its entirety, see attached AD 2-19a

Item No. 2-20 **SHEET A2.9, ENLARGED FINISH FLOOR PLAN**
REPLACE sheet in its entirety, see attached AD 2-20a

Addendum No. 02



March 10, 2023

Shields & Brawley Elementary School

- Item No. 2-21 **SHEET A5.1, INTERIOR ELEVATIONS, MAIN**
REPLACE sheet in its entirety, see attached AD 2-21a
- Item No. 2-22 **SHEET A5.5, INTERIOR ELEVATIONS, MAIN**
REPLACE sheet in its entirety, see attached AD 2-22a
- Item No. 2-23 **SHEET A5.6, INTERIOR ELEVATIONS, 1ST FLOOR, MAIN**
REPLACE sheet in its entirety, see attached AD 2-23a
- Item No. 2-24 **SHEET A5.7, INTERIOR ELEVATIONS, 1ST FLOOR, MAIN**
REPLACE sheet in its entirety, see attached AD 2-24a
- Item No. 2-25 **SHEET A5.8, INTERIOR ELEVATIONS, 1ST FLOOR, MAIN**
REPLACE sheet in its entirety, see attached AD 2-25a
- Item No. 2-26 **SHEET A5.9, INTERIOR ELEVATIONS, 1ST FLOOR, MAIN**
REPLACE sheet in its entirety, see attached AD 2-26a
- Item No. 2-27 **SHEET A5.10, INTERIOR ELEVATIONS, 1ST FLOOR, MAIN**
REPLACE sheet in its entirety, see attached AD 2-27a
- Item No. 2-28 **SHEET A5.11, INTERIOR ELEVATIONS, 1ST FLOOR, MAIN**
REPLACE sheet in its entirety, see attached AD 2-28a
- Item No. 2-29 **SHEET A5.12, INTERIOR ELEVATIONS, 2ND FLOOR, MAIN**
REPLACE sheet in its entirety, see attached AD 2-29a
- Item No. 2-30 **SHEET A5.13, INTERIOR ELEVATIONS, 2ND FLOOR, MAIN**
REPLACE sheet in its entirety, see attached AD 2-30a
- Item No. 2-31 **SHEET A5.14, INTERIOR ELEVATIONS, 2ND FLOOR, MAIN**
REPLACE sheet in its entirety, see attached AD 2-31a
- Item No. 2-32 **SHEET A5.15, INTERIOR ELEVATIONS, 2ND FLOOR, MAIN**
REPLACE sheet in its entirety, see attached AD 2-32a
- Item No. 2-33 **SHEET A5.16, INTERIOR ELEVATIONS, 2ND FLOOR, MAIN**
REPLACE sheet in its entirety, see attached AD 2-33a
- Item No. 2-34 **SHEET A5.20, INTERIOR ELEVATIONS, MPR**
REPLACE sheet in its entirety, see attached AD 2-34a
- Item No. 2-35 **SHEET A6.3, EXTERIOR ELEVATIONS, MAIN**
REPLACE sheet in its entirety, see attached AD 2-35a

Addendum No. 02




March 10, 2023

Shields & Brawley Elementary School

- Item No. 2-36 **SHEET A8.1, DETAILS**
REPLACE sheet in its entirety, see attached AD 2-36a
- Item No. 2-37 **SHEET A8.2, DETAILS**
REPLACE sheet in its entirety, see attached AD 2-37a
- Item No. 2-38 **SHEET A8.3, DETAILS**
REPLACE sheet in its entirety, see attached AD 2-38a
- Item No. 2-39 **SHEET A8.12, SERVICE YARD PLAN**
REPLACE sheet in its entirety, see attached AD 2-39a
- Item No. 2-40 **SHEET A8.16, DETAILS**
REPLACE sheet in its entirety, see attached AD 2-40a
- Item No. 2-41 **SHEET A8.18, DETAILS**
REPLACE sheet in its entirety, see attached AD 2-41a.
- Item No. 2-42 **SHEET C3.1, SITE AND DIMENSION PLAN**
OMIT entire sheet.
- Item No. 2-43 **SHEET C3.2, SITE AND DIMENSION PLAN**
OMIT entire sheet.
- Item No. 2-44 **SHEET C6.8, DETAILS**
REPLACE sheet in its entirety, see attached AD 2-44a.
- Item No. 2-45 **SHEET C6.9, DETAILS**
REPLACE sheet in its entirety, see attached AD 2-45a.
- Item No. 2-46 **SHEET FD1, FRESNO DEPARTMENT PLAN**
REPLACE sheet in its entirety, see attached AD 2-46a.
- Item No. 2-47 **SHEET FD2, FRESNO DEPARTMENT PLAN**
REPLACE sheet in its entirety, see attached AD 2-47a.

END OF ADDENDUM

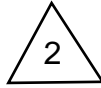

SECTION 09 66 00
RESILIENT FLOOR COVERING

AD 2-03a
S&B Elementary
02-116800

PART 1 – GENERAL

- 1.01 REFERENCE:
Requirements in Addenda, Alternates, Conditions, and Division 1 collectively apply to this work.
- 1.02 DESCRIPTION:
- A. Principal Work Items Are:
1. Resilient tile and sheet vinyl flooring, stair treads and risers.
 2. Resilient base.
 - a. At resilient flooring.
 - b. At carpet flooring.
 - c. At fixed casework.
 3. Adhesives and primers.
 4. Accessories.
- B. Related Work Specified Elsewhere:
1. Concrete: Section 03300.
 2. Carpeting: Section 09680.
- 1.03 QUALITY ASSURANCE:
- A. Qualifications of installers: Use workmen who are thoroughly trained and experienced in the installation of resilient flooring and who are completely familiar with the specified requirements and the methods needed for proper performance of installation.
- 1.04 SUBSTITUTIONS:
- A. Only written approval of Architect or District will permit substitutions for materials specified.
- 1.05 SUBMITTALS:
- A. Samples in duplicate of manufacturer's full range of colors and patterns.
- B. Maintenance Data: Two bound copies of manufacturer's printed recommendations for care and cleaning of resilient flooring.
- C. Product Data: For each type of product specified.
- 1.06 PRODUCT DELIVERY, STORAGE AND HANDLING:
- A. Deliver all materials to site in original sealed packages with manufacturer's brand and product clearly identified thereon.

- B. Store materials in building area where they will be installed for three days minimum prior to installation.

1.07 JOB CONDITIONS:

A. Environmental Requirements:

- 1. Maintain temperature range of materials and building space, which receives them at 70-90° F. for 48 hours minimum before, after and during all installation. Thereafter maintain 55-degree minimum.

- B. Sequencing, Scheduling: Coordinate with related work of other Sections.

- C. Do not install flooring over concrete slabs until slabs have cured and are sufficiently dry to bond with adhesive as determined by flooring manufacturer's recommended bond and moisture test.

1.08 EXTRA MATERIAL:

- A. Furnish extra materials described below that match products installed, are packaged with covering for storage, and are identified with labels describing contents.

- 1. Furnish not less than one box for each 50 boxes or fraction thereof of each type, color, pattern, class, wearing surface, and size of resilient tile flooring installed in unopened containers.
- 2. Furnish not less than 10 linear feet for each 500 linear feet or fraction thereof of each type, color, pattern, and size of resilient accessory installed.
- 3. Furnish not less than 2% of each type, color, pattern, class, wearing surface of vinyl sheet flooring installed. Each type a minimum of 10 lineal feet and must be a continuous piece.
- 4. Deliver extra materials to the District

PART 2 - PRODUCTS

2.01 VINYL SHEET FLOORING:

A. Acceptable Manufacturer and Product:

- 1. Armstrong Classic Corlon Series. Design elements shall extend throughout the thickness of the wear layer.

B. General

- 1. Reference: Federal Specifications L-F-475A (3), Type II, Grade A; Military Standard 1623D.
- 2. Fire Performance: ASTM E662, ASTM E84, ASTM E648.
- 3. 50 mil wear thickness.
- 4. Size: 6' wide.
- 5. Overall Thickness: .085".
- 6. Minimum Load Limit: 100 lbs/sq. in.
- 7. C.O.F. 7.06 per ASTM D1894

- C. Color Selection: Selected by Architect or District.
 - D. Underlayment: 1/4" (Weyerhaeuser Structureboard or approved equal).
Underlayment for resilient floors should be structurally sound and designed for resilient flooring underlayment purposes with a minimum thickness of 1/4".
Underlayment must comply with Sheet Vinyl and V.C.T. manufacturer's specifications.
- 2.03 RUBBER STAIR TREADS, RISERS, STRINGER, AND/OR SKIRTS:
- A. Acceptable Manufacturer and Product:
 - 1. Mannington Commercial
 - 2. Mohawk
 - B. Stair Tread: Slip-resistant rubber treads shall be "Rouleau" Round Profile. Top and Bottom treads shall have a 2" contrasting color adhesive strip which is embedded in the tread and shall be of first quality vulcanized rubber compound. Each tread shall be free of objectionable odors, blisters, cracks, or other imperfections which will detract from the serviceability and appearance of the tread. Stair treads shall conform to Federal Specifications 22-T. 001237 (GSA-FSS) Type II, Class 2, A and B and RR-T-650c, composition A, Types 1, 2 and 5.
 - C. Color Selection: Selected by Architect or District.
- 2.04 RUBBER FLOOR TILES AT LANDINGS - SMOOTH AND RIBBED - 12" x 12"
- A. Acceptable Manufacturer and Products:
 - 1. Mannington Commercial
 - 2. Mohawk
 - B. Products/Description: (Molded rubber floor tile) (Molded rubber floor tile with 1/4" wide groove surface design).
 - 1. Floor Tile Size: 12" x 12" (304.800 mm x 304.800 mm).
 - 2. Thickness: (gauge) .125" (3.175 mm).
 - 3. Color and Pattern Selection: As selected by the Architect or District from manufacturer's full range of colors and patterns produced for rubber stair treads and accessories complying with requirements indicated. Visually impaired.
 - a. Selection from manufacturer's standard array is to be,
 - 1. 'Natural Illusions'
 - 2. 'Marble'
 - 3. or as indicated in the drawings.
 - 4. Substrate adhesives pursuant to types and brands as recommended by manufacturer.
 - 5. Conformance:
 - a. ASTM F-1344, Class 1B; FS SS-T-312b, Ty
 - b. ASTM D-2047 Test: Static Coefficient of Friction. Exceeds ADA recommendation.
 - c. ASTM D-2240 Hardness Shore A; not less than 90.
 - d. ASTM E-84 Class B; (Class A upon special order).

- e. ASTM E-648/NFPA 253; Class 1 Fire Rating.
- f. ADA requirements.
- 6. Nosing Style: Square, adjustable to cover angles between 60 and 90 degrees.
- 7. Size: Lengths and depths to fit each stair tread in one piece.
- 8. Provide matching skirting and risers to match.

2.05 RESILIENT BASE / RUBBER BASE:

A. Acceptable Manufacturers and Products:

- 1. Mannington Commercial
- 2. Mohawk
- 3. Other manufacturers: See substitutions.

B. General:

- 1. Standards: Per Federal Specifications SS-W-40, Type I or Type II.
- 2. Rubber, uniform size, thickness.
- 3. Size: 4" or 6" height typical, other heights as indicated, 48" lengths typical, .080" minimum thickness, pre-formed inside and outside corners.
- 4. Style: Coved top-set at resilient flooring and sealed concrete.
- 5. Color Selection: Commercial and decorator colors as selected by Architect or District.

2.06 ADHESIVES, PRIMERS AND FILLERS:

- A. Types and brands as recommended by manufacturer of flooring and base materials.

2.07 TRANSITIONAL AND EDGE MOLDINGS:

- A. Vinyl transitions and edge as manufactured by Mercer Plastics Company.

- C. Other manufacturers: See substitutions.

- B. Color Selection: Color as selected by Architect or District.

PART 3 - EXECUTION

3.01 INSPECTION:

- A. General: Examine surfaces to determine suitability to receive flooring. Do not start work until unsatisfactory conditions are corrected.
- B. Moisture Test: Using the flooring material and recommended adhesives, install 3'x3' panels - tape edges to prevent edge drying of adhesive. If the panels are securely bonded after 72 hours, sub-floor is sufficiently dry.
- C. Calcium Chloride Test: A quantitative test such as the calcium chloride test may be conducted. If test fails, the concrete is not sufficiently dry for installation of resilient flooring.

3.02 PREPARATION:



- A. Clean sub-floor and wall surface. All floor fill, toppings, or underlayment must comply with resilient flooring manufacturer's specifications.
- B. Prime surfaces as recommended by flooring materials manufacturer.
- C. Sub-floor should be dry, smooth, structurally sound, free of depressions, scale or foreign deposits of any kind.
- D. Floor fill, toppings or underlayment must have minimum compressive Strength of 4,000 PSI.
- E. Level subfloor within 1/4 inch in 10 feet, noncumulative, in all directions. Sand or grind protrusions, bumps, and ridges. Patch and repair cracks, and rough areas. Fill depressions.
- F. Use stair-tread-nose filler, according to resilient tread manufacturer's written instructions, to fill nosing substrates that do not conform to tread contours.

3.03 APPLICATION:

- A. General: Follow manufacturer's printed instructions. Work to be aligned, square, with tight joints, well fitted to walls, cabinets and other work.
- B. Laying Floors:
 - 1. Spread adhesive evenly with notched trowel according to manufacturer's recommendation.
 - 2. Install tile only after all finishing operations, including painting, have been completed and permanent heating system is operating. Moisture content of concrete slabs, building air temperature and relative humidity must be within limits recommended by tile manufacturer.
 - 3. Butt units tightly to vertical surfaces, thresholds, nosing and edgings. Scribe as necessary around obstructions and to produce neat tight joints with even and straight lines.
 - 4. Extend units into toe spaces, door reveals, and in closets and similar openings.
 - 5. Maintain reference markers, holes, or openings that are in place or plainly marked for future cutting by repeating on the finish tile as marked in the subfloor. Use chalk or other non-permanent marking device.
 - 6. Lay tile from center marks established with principle walls, discounting minor off-sets, so that tile at opposite edges of the room are of equal width. Adjust as necessary to avoid use of cut widths less than 3' at room perimeters. Lay tile square to room axis.
 - 7. Match tiles for color and pattern by using tile from cartons in the same sequence as manufactured and packaged. Broken, cracked, chipped or deformed tile are not acceptable.
 - 8. Lay tile pattern selected by the Architect or District.
- C. Resilient Base:

1. Apply covered top-set base at all resilient floors, after laying tile. Use maximum practicable lengths.
 2. Apply adhesive, firmly adhere base, press down bottom cove of top-set base to permanently contact flooring at all points.
 3. Corners: Use pre-molded inside and outside corners, and fit accurately.
- D. Sheet Vinyl Flooring:
1. Install in strict accordance with manufacturer's written instructions with a minimum of seams by the Armstrong Securabond Installation System with Armstrong S-200 adhesive at the seams.
 2. Installer shall be competent in the Securabond installation technique.
 3. All flash coving must be by the one-piece flash coving method.
 4. All flash coving must be finished to "hard cap".
 5. All heat-welded seams must be in strict compliance with manufacturer's guidelines.
 6. When seam treatments are recommended and require protection until they cure or dry, provide adequate protection and post signs with necessary cautions.
- 3.04 ADJUSTMENT AND CLEANING:
- A. Adjustment: Remove and replace loose, damaged, mismatched, or misaligned work. Remove adhesive smears.
 - B. Cleaning: Just prior to final acceptance of project, clean work and remove all protective finishes and foreign substances.
 - C. Protection: Protect completed work from traffic or damage until acceptance by the C.U.S.D.
 - D. All rubbish, wrappings, debris, trimmings, etc. to be removed from the site and disposed of properly.

END OF SECTION

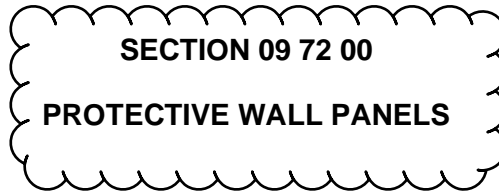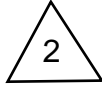

AD 2-04a
S&B Elementary
02-116800

PART 1 - GENERAL

1.01 SUMMARY

- A. This section includes the following types of wall protection systems:
 - 1. Wall Panels
- B. Related sections: The following sections contain requirements related to this section:
 - 1. Handrails, Bumper Guards, Crash Rails, Corner Guards, Accent Rails, Wall Covering, Door Protection; refer to section 10 26 00 "Wall and Door Protection"

1.02 REFERENCES

- A. National codes (CBC and Life Safety)
- B. American Society for Testing and Materials (ASTM)
- C. Underwriters Laboratories (UL)
- D. California 01350 specification

1.03 SUBMITTALS

- A. General: Submit the following in accordance with conditions of contract and Division 1 specification section 01 33 00 "Submittal Procedures".
- B. Product data and detailed specifications for each system component and installation accessory required, including installation methods for each type of substrate.
- C. Shop drawings showing locations, extent and installation details of wall panel products.
- D. Samples for verification purposes: Submit the following samples, as proposed for this work, for verification of color, texture, pattern and thickness:
 - 1. Sample of each product specified.
- E. Product test reports from a qualified independent testing laboratory showing compliance of each component with requirements indicated.

- F. Maintenance data for wall protection system components for inclusion in the operating and maintenance manuals specified in Division 1.

1.04 QUALITY ASSURANCE

- A. Installer qualifications: Engage an installer who has no less than 3 years experience in installation of wall panels similar in complexity to those required for this project.
- B. Manufacturer's qualifications: Not less than 5 years experience in the production of specified products and a record of successful performance.
- C. Code compliance: Assemblies should conform to all applicable codes including IBC, Life Safety and CA 01350.
- D. Fire performance characteristics: Provide engineered PETG wall panels identical to those tested in accordance with ASTM E84 for Class B characteristics listed below:
 - 1. Flame spread 75 or less
 - 2. Smoke developed: 450 or less
- E. Impact Strength: Provide assembled wall protection units that have been tested in accordance with the applicable provisions of ASTM F476.
- F. Chemical and stain resistance: Provide wall panels with chemical and stain resistance in accordance with ASTM D543.
- G. Color Match: Provide wall panels that are color matched in accordance with the following:
 - 1. Delta Ecmc of no greater than 1.0 using CIELab color space. Components of the wall protection system manufactured by the same company to ensure compatibility of color, texture and physical properties.
- H. Single source responsibility: Provide all components of the wall protection system manufactured by the same company to ensure compatibility of color, texture and physical properties.

1.05 DELIVERY, STORAGE AND HANDLING

- A. Deliver materials to the project site in unopened packaging clearly labeled to show manufacturer.
- B. Store materials in original, undamaged packaging in a clean, dry place out of direct sunlight and exposure to the elements. A room temperature of 40-100°F (4-38°C) should be maintained.
- C. Materials must be stored flat.

1.06 PROJECT CONDITIONS

- A. Materials must be acclimated in an environment of 65-75°F (18-24°C) for at least 24 hours prior to beginning the installation.
- B. Installation areas must be enclosed and weatherproofed before installation commences.

1.07 WARRANTY

- A. Acrovyn 5-year Limited Warranty
 - 1. Applies to Interior Wall Protection orders that do not include recommended components or accessories
Assemblies = Brackets, Hardware
Accessories = Primer, Adhesive, Caulk, Trims & Moldings
- A. Limited Lifetime Systems Warranty
 - 1. Applies to CS Interior Wall Protection projects that include all recommended components and accessories related to CS Interior Wall Protection Products.
Assemblies = Brackets, Hardware
Accessories = Primer, Adhesive, Caulk, Trims & Moldings

PART 2 - PRODUCTS

2.01 MANUFACTURERS

- A. Interior surface protection products specified herein and installed on the submittal drawings shall be manufactured by Construction Specialties, Inc.

2.02 MATERIALS

- A. Engineered PETG Wall Panels to be Acrovyn 4000 by Construction Specialties Inc: Wall panels to be manufactured of .040" (1.02mm) thick Acrovyn 4000 sheet factory bonded to the face side of a 3/8" (9.53mm) thick particle board core with no added urea formaldehyde. The backside of the panel to be laminated with a moisture resistant sheet.
 - 1. C/S Acrovyn 4000 Square Edge Pebblette Texture Wall Panel available in (64)* Acrovyn solid colors. All joint caulk and PVC-free trim members supplied in color to coordinate with panel color. Standard texture shall be 4' x 8' or 4' x 10'. Acrovyn sheet material is MBDC Cradle to Cradle® Certified Silver in all (64) colors.
 - 2. CRASH RAILS (Model 5CR-5CN) 5" x 1 1/16". Installation at 29" (verify with Architect) from floor to bottom of bumper.
 - 3. CORNER GUARDS (Model SM-20N) 90° surface mounted corner guard with 3" (76.1mm) legs, 1/4" (6.4mm) radius cover and regrind PVC FREE retainer. Specify SM-20AN for continuous aluminum retainer or SM-20MN for odd degree corners. Select from one of Acrovyn™ solid colors, Acrovyn™ Woodgrains or Acrovyn™ Brushed Metals simulated patterns. Optional horizontal accent reveal available in Black only (90° only).

PROTECTIVE WALL PANELS

[Specifier note: refer to the Acrovyn Cradle to Cradle Product Summary at www.acrovyn.com/c2c to determine which colors and patterns are *Cradle to Cradle Certified™* Gold or Silver (exception: optional horizontal accent reveal). *Cradle to Cradle Certified™* is a certification mark licensed by the Cradle to Cradle Products Innovation Institute.]

Engineered PVC FREE Corner Guards to be CS Acrovyn: Surface mounted guards consisting of continuous retainer with snap-on Acrovyn 4000 cover. Color matched end caps to be provided for both partial and full height applications. Attachment hardware shall be appropriate for wall construction.

2.03 WALL PANEL MOUNTING OPTIONS

- A. Mount Option to be construction grade adhesive supplied by manufacturer. Panel edges to be butt joint or trim options as per manufacturers.

2.04 FABRICATION

- A. General: Fabricate wall panels to comply with requirements indicated for design, dimensions, detail, finish and sizes. All based upon required field verified dimensions.

2.05 ACCESSORIES

- A. Acrovyn Wall Panels shall be furnished as a complete packaged system.

PART 3 - EXECUTION

3.01 EXAMINATION

- A. Verification of conditions: Examine areas and conditions under which work is to be performed and identify conditions detrimental to proper or timely completion.
 - 1. Do not proceed until unsatisfactory conditions have been corrected.

3.02 PREPARATION

- A. Surface preparation: Prior to installation, clean substrate to remove dirt, debris and loose particles. Perform additional preparation procedures as required by manufacturer's instructions.
- B. Protection: Take all necessary steps to prevent damage to material during installation as required in manufacturer's installation instructions.

3.03 INSTALLATION

- A. Install the work of this section in strict accordance with the manufacturer's recommendations and the required field verified dimensions.
- B. Temperature at the time of installation must be between 65-75°F (18-24°C) and be maintained for at least 48 hours after the installation to allow for proper adhesive set up.
- C. Relative humidity shall not exceed 80%.
- D. Do not expose wall panels to direct sunlight during or after installation. This will cause the surface temperature to rise, which in turn will cause bubbles and delamination.


3.04 CLEANING

- A. General: Immediately upon completion of installation, clean wall panels and accessories in accordance with manufacturer's recommended cleaning method.
- B. Remove surplus materials, rubbish and debris resulting from installation as work progresses and upon completion of work.

3.05 PROTECTION

- A. Protect installed materials to prevent damage by other trades. Use materials that may be easily removed without leaving residue or permanent stains.

END OF SECTION

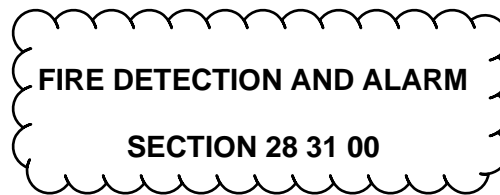

AD 2-05a
S&B Elementary
02-116800

PART 1 – GENERAL

1.1 RELATED SECTIONS

- A. Section 21 00 00 – Fire Suppression.
- B. Section 26 00 00 – Electrical
- C. Section 27 10 00 – Structured Cabling System

1.2 REFERENCES

- A. Electrical Industries Association (EIA):
 - 1. EIA-232-D – Interface Between Data Terminal Equipment and Data Circuit-Terminating Equipment Employing Serial Binary Data Interchange
 - 2. TIA-485-A – Electrical Characteristics of Generators and Receivers for Use in Balanced Multipoint Systems
- B. California Code of Regulations
 - 1. Title 24, Part 3 – California Electrical Code (CEC)
- C. National Fire Protection Association (NFPA):
 - 1. NFPA 12 – Standard on Carbon Dioxide Extinguishing Systems.
 - 2. NFPA 13 – Installation of Sprinkler Systems.
 - 3. NFPA 15 – Standard for Water Spray Fixed Systems for Fire Protection.
 - 4. NFPA 16 – Standard for the Installation of Foam-Water Sprinkler and Foam-Water Spray Systems.
 - 5. NFPA 16A – Standard for the Installation of Closed Head Foam-Water Sprinkler Systems.
 - 6. NFPA 70 – National Electrical Code (NEC)
 - 7. NFPA 72 – National Fire Alarm Code.
 - 8. NFPA 90A – Standard for the Installation of Air Conditioning and Ventilating Systems.
 - 9. NFPA 101 – Life Safety Code.
 - 10. NFPA 750 – Standard on Water Mist Fire Protection Systems.
 - 11. NFPA 5000 – Building Construction and Safety Code.
- D. Underwriters Laboratories (UL):
 - 1. UL 268 – Standard for Smoke Detectors for Fire Alarm Signaling Systems.
 - 2. UL 864 – Standard for Control Units and Accessories for Fire Alarm Systems.
 - 3. UL 1971 – Standard for Signaling Devices for the Hearing Impaired.

1.3 SCOPE OF WORK

- A. Furnish all labor, equipment, and materials for, and comply with the performance requirements of the Fire Alarm System indicated in the drawings and specified herein.
- B. It is the intent of the Contract Documents to provide an installation complete in every respect. In the event that additional details or special construction is required to accomplish work indicated or specified in this or other sections, it shall be the responsibility of the Contractor to provide all materials and equipment which is usually furnished with such systems in order to complete the installation, whether or not specifically mentioned herein.

1.4 SYSTEM DESCRIPTION

- A. A new, intelligent reporting, Style 7 networked, fully peer-to-peer, microprocessor-controlled fire detection and notification system shall be installed in accordance with the specifications and as indicated on the Drawings.
- B. Basic Performance:
 - 1. Network Communications Circuit Serving Network Nodes: Connected using approved fiber optic cable between nodes in Class A configuration (NFPA Style 7).
 - 2. Signaling Line Circuits (SLC) Serving Addressable Devices: Wired Class B.
 - 3. Initiation Device Circuits (IDC) Serving Non-addressable Devices Connected to Addressable Monitor Modules: Wired Class B.
 - 4. Notification Appliance Circuits (NAC) Serving Strobes and Horns: Wired Class B.
 - 5. Alarm Signals Arriving at Control Panel: Not lost following primary power failure until alarm signal is processed and recorded.
 - 6. Network Node Communications:
 - a. Communicated between panels on Style 7 connected fiber optic cables.
 - b. To enhance system survivability, ability to operate on loss of Command Center, short or open of entire riser at Command Center shall be demonstrated at time of system acceptance testing.
 - c. Systems that are not capable of providing true Style 7 riser performance shall not be acceptable.
 - 7. Signaling Line Circuits (SLC):
 - a. SLC modules shall operate in peer-to-peer fashion with all other panels in system.
 - b. On loss of Command Center, each remaining panel shall continue to communicate with remainder of system, including all SLC and control functions. Systems that provide a "Degraded" mode of operation upon loss of Command Center or short in riser shall not be acceptable.
 - c. Limit the number of devices to 80% of the maximum allowed of each type on SLC circuits.

8. Notification Appliance Circuits (NAC):
 - a. Arranged such that loss of any 1 NAC circuit will not cause loss of any other NAC circuit in system.
 - b. Electrically supervised for open and short circuit conditions.
 - c. If short circuit exists on NAC circuit, it shall not be possible to activate that circuit.
 - d. Voltage drop is not to exceed 10% at the furthest point on any NAC circuit.
 9. Emergency Voice/Alarm Communications (EVAC):
 - a. Arranged such that loss of any 1 EVAC amplifier or branch will not cause loss of any other EVAC circuit in the system.
 - b. Electrically supervised for open and short circuit conditions.
 - c. If short circuit exists on NAC circuit, it shall not be possible to activate that circuit.
 - d. Voltage drop is not to exceed 10% at the furthest point on any NAC circuit.
 10. Standby Power:
 - a. Provide a minimum of 20% spare battery capacity above calculated requirements.
- C. Sequence of Operations:
1. General Alarm: Upon alarm activation of any area smoke detector, duct smoke detector, heat detector, manual pull station, or sprinkler water flow switch, the following functions shall automatically occur:
 - a. The internal audible device shall sound at the control panel or command center.
 - b. The LCD Display shall indicate all applicable information associated with the alarm condition including zone, device type, device location and time/date.
 - c. All system activity/events shall be documented on the system printer.
 - d. Any remote or local annunciator LCD/LED's associated with the alarm zone shall be illuminated.
 - e. The following notification signals and actions shall occur simultaneously:
 - i. A signal shall be sounded on fire floors (zones). The signal shall be a Temporal 3 tone.
 - ii. Activate visual strobes on the fire floors (zones). The visual strobe shall stop operating when the "Alarm Silence" is pressed.
 - iii. Transmit signal to the building automation system (if applicable) and/or shutdown all HVAC units serving the floor of alarm.
 - iv. Transmit signal to the central station with point identification.
 - v. Activate automatic smoke control sequences (if applicable).
 - vi. All stairwell/exit doors shall unlock throughout the building.
 - vii. All self-closing fire/smoke doors held open shall be released.
 - viii. All automatic events programmed to the alarm point shall be executed and the associated outputs activated.
 2. Elevator Lobby / Equipment Room Detectors: Upon alarm activation of any elevator lobby smoke detector or equipment room detector the following functions shall automatically occur:
 - a. Perform general alarm sequence above.
 - b. Elevator Lobby smoke detectors shall recall the elevators to primary floor

- c. Elevator Lobby smoke detectors located on the primary recall floor shall recall the elevator the alternate floor.
 - d. Equipment room smoke detectors shall recall the elevator to the primary floor.
 - e. Activation of the Equipment room heat detector shall initiate the shunt trip in the associated elevator equipment room.
3. Supervisory Operation: Upon supervisory activation of any sprinkler valve supervisory switch, fire pump off-normal, clean agent fire suppression system trouble, the following functions shall automatically occur:
 - a. The internal audible device shall sound at the control panel or command center.
 - b. The LCD display shall indicate all applicable information associated with the supervisory condition including; zone, device type, device location and time/date.
 - c. All system activity/events shall be documented on the system printer.
 - d. Any remote or local annunciator LCD/LED's associated with the supervisory zone shall be illuminated.
 - e. Transmit signal to the central station with point identification.
 4. Trouble Operation: Upon activation of a trouble condition or signal from any device on the system, the following functions shall automatically occur:
 - a. The internal audible device shall sound at the control panel or command center.
 - b. The LCD keypad display shall indicate all applicable information associated with the trouble condition including; zone, device type, device location and time/date.
 - c. All system activity/events shall be documented on the system printer.
 - d. Any remote or local annunciator LCD/LED's associated with the trouble zone shall be illuminated.
 - e. Transmit signal to the central station with point identification.
 5. Monitor Operation: Upon activation of any device connected to a monitor circuit (fire pump/emergency generator status), the following functions shall automatically occur:
 - a. The LCD display shall indicate all applicable information associated with the status condition including; zone, device type, device location and time/date.
 - b. All system activity/events shall be documented on the system printer.
 - c. Any remote or local annunciator LCD/LED's associated with the status zone shall be illuminated.
- D. Fire Alarm System Functionality:
1. Provide complete, electrically supervised distributed, networked analog/addressable fire alarm and control system, with analog initiating devices.
 2. Fire Alarm System:

- a. Incorporate E3 Series multiprocessor-based control panels, with Intelligent Loop Interface (ILI-MB-E3), and RPT-E3 repeater modules communicating over peer-to-peer token ring network with capacity of up to 64 nodes.
3. Each ILI-MB-E3 Node: Incorporate 2 Signaling Line Circuits (SLC), with capacity to support up to 159 analog addressable detectors and 159 addressable modules per SLC.
4. All data transmits over single pair of wires or fiber optic cable.
5. Each Network Node: Incorporate Boolean control-by-event programming, including as a minimum AND, OR, NOT, and Timer functions.
6. Control Panels: Capability to accept firmware upgrades via connection with laptop computer, without requirement of replacing microchips.
7. Network:
 - a. Based on peer-to-peer token ring technology operating at 625 K baud, using Style 7 configuration.
 - b. Capability of using twisted-pair wiring, pair of fiber optic cable strands up to 200 microns, or both, to maximize flexibility in system configuration.
8. Each Network Node:
 - a. Capability of being programmed off-line using Windows-based software utilized by fire alarm system manufacturer. Capability of being downloaded by connecting laptop computer into any other node in system. Systems that require system software to be downloaded to each transponder at each transponder location shall not be acceptable.
 - b. Capability of being grouped with any number of additional nodes to produce a "Region", allowing that group of nodes to act as 1, while retaining peer-to-peer functionality. Systems utilizing "Master/Slave" configurations shall not be acceptable.
 - c. Capability of annunciating all events within its "Region" or annunciating all events from entire network, on front panel LCD without additional equipment.
9. Each SLC Network Node: Capability of having integral DACT (digital alarm communicator transmitter) that can report events in either its region, or entire network to single central station monitoring account.
10. Each Control Panel: Capability of storing its entire program, and allow installer to activate only devices that are installed during construction, without further downloading of system.
11. Password Protection: Each system shall be provided with 4 levels of password protection with up to 16 passwords.

1.5 SUBMITTALS

- A. Comply with Section 01 33 00 – Submittal Procedures.

- B. Include sufficient information, clearly presented, to determine compliance with the specifications and the Drawings. Insufficiently detailed submittals shall be rejected.
- C. Equipment Submittals:
1. Cover Page: Indicate the following:
 - a. Project name and address.
 - b. Engineered systems distributor's name and other contact information.
 - c. Installing contractor's name and other contact information.
 - d. Date of equipment submittals. Indicate on revised submittals the original submittal date and revised submittal date.
 2. Table of Contents: Lists each section of equipment submittal.
 3. Scope of Work Narrative: Detail indented scope of work.
 4. Sequence of Operations: Use matrix or written text format, detailing activation of each type of device and associated resulting activation of the following:
 - a. Control panel.
 - b. Annunciator panels.
 - c. Notification appliances.
 - d. Building fire safety functions, including elevator recall, elevator power shutdown, door lock release, door holder release, HVAC unit shutdown, smoke evacuation system activation, and stair pressurization fan activation.
 5. Bill of Material: Indicate for each component of system the following:
 - a. Quantity.
 - b. Model number.
 - c. Description.
 6. SLC Circuit Schedule: Detail address and associated description of each addressable device. Clearly provide information that indicates number of both active and spare addresses.
 7. Battery Calculations: Show load of each of, and total of, components of system along with standby and alarm times that calculations are based on. Show calculated spare capacity and size of intended battery.
- D. Shop Drawings:
1. Cover Page: Indicate the following:
 - a. Project name and address.
 - b. Engineered systems distributor's name and other contact information.
 - c. Installing contractor's name and other contact information.
 - d. Date of equipment submittals. Indicate on revised submittals the original submittal date and revised submittal date.
 2. Floor Plans:
 - a. Provide separate floor plan for each floor.

- b. If a floor plan must be split using match lines to fit on the page, provide match lines and match line references that refer to sheet number that shows area on opposite side of match line.
 - c. Prepare using CAD program capable of producing AutoCAD compliant DXF (Drawings Exchange Format) files.
 - d. Prepare to scale no smaller than 1/8 inch = 1'-0", unless otherwise required by the Architect or Engineer.
 - e. Show equipment and device locations.
 - f. Show wiring information in point-to-point format.
 - g. Show conduit routing, if required by the AHJ.
 3. Title Block: Provide on each sheet and include, at a minimum, the following:
 - a. Project name.
 - b. Project address.
 - c. Sheet name.
 - d. Sheet number.
 - e. Scale of drawing.
 - f. Date of drawing.
 - g. Revision dates, if applicable.
 4. Control Panel: Provide sheet that details exterior and interior views of control panel and clearly shows associated wiring information.
 5. Annunciator Panels: Provide sheet that details exterior and interior views of annunciator panels and clearly shows associated wiring information.
 - E. Certification: Submit with equipment submittals and shop drawings, letter of certification from major equipment manufacturer, indicating proposed engineered system distributor is an authorized representative of major equipment manufacturer.
 - F. Project Record Drawings:
 1. Submit complete project record drawings within 14 calendar days after acceptance test.
 2. Project record drawings shall be similar to shop drawings, but revised to reflect changes made during construction.
 - G. Operation and Maintenance Manuals:
 1. Submit complete operation and maintenance manuals within 14 calendar days after acceptance test.
 2. Operation and maintenance manuals shall be similar to equipment submittals, but revised to reflect changes made during construction.
 3. Include factory's standard installation and operating instructions.
- 1.6 APPROVAL
- A. All Fire Alarm System components are required to be listed with the California State Fire Marshal (CSFM).
 - B. Installation of the Fire Alarm System shall not commence until all approvals are granted by the California State Fire Marshal (CSFM), Division of the State Architect (DSA), and any other Authorities Having Jurisdiction (AHJ).

- C. Installation of the system shall not commence until all shop drawings and submittals are approved by the School District, Architect of Record, and Engineer of Record.

1.7 QUALITY ASSURANCE

A. Codes and Standards:

1. NFPA: System shall comply with all applicable NFPA codes and standards:
2. ADA: System shall conform to American with Disabilities Act (ADA).

- B. To ensure reliability and complete compatibility, all items of fire alarm system, including control panels, power supplies, initiating devices, and notification appliances, shall be listed by Underwriters Laboratories Inc. (UL) and shall bear the "UL" label.

- C. Fire Alarm Control Panel Equipment: UL-listed under UL 864 Ninth Edition.

D. Equipment, Programming, and Installation Supervision:

1. The contractor is required to hold a C-10 license and any other certifications required by the Authority Having Jurisdiction.
2. The contractor is required to be an approved engineered systems distributor of Gamewell-FCI for equipment, programming, and installation supervision.
3. Proof of factory training shall be delivered within 14 calendar days of award of the Contract.

E. Software Modifications:

1. Provide services of Gamewell-FCI factory-trained and authorized technician to perform system software modifications, upgrades, or changes.
2. Provide use of all hardware, software, programming tools, and documentation necessary to modify fire alarm system software on-site.
3. Modification includes addition and deletion of devices, circuits, zones, and changes to system operation and custom label changes for devices or zones.
4. System structure and software shall place no limit on type or extent of software modifications on-site.
5. Modification of software shall not require power-down of system or loss of system fire protection while modifications are being made.

1.8 DELIVERY, STORAGE, AND HANDLING

- A. Delivery: Deliver materials to site in manufacturer's original, unopened containers and packaging, with labels clearly identifying product name and manufacturer.

- B. Storage: Store materials in clean, dry area indoors in accordance with manufacturer's instructions.

- C. Handling: Protect materials from damage during handling and installation.

1.9 COORDINATION

- A. Coordinate the Work of this section with the Work of other sections, including sprinkler systems, elevators, HVAC systems, and security/door locking systems, as applicable.

1.10 WARRANTY

- A. Warranty Period for System Equipment: 1 year from date of final acceptance.
- B. Trouble Calls: The contractor shall guarantee on-site service for the Fire Alarm System within 24 hours of the receipt of a trouble call.

PART 2 – PRODUCTS

2.1 MANUFACTURERS

- A. Gamewell-FCI, Honeywell Fire Systems
12 Clintonville Road, Northford, Connecticut 06472. Phone (203) 484-7161. Fax (203) 484-7118. Website: www.gamewell-fci.com
 - 1. NO SUBSTITUTION.
- B. System Sensor
3825 Ohio Avenue, St. Charles, Illinois 60174.
Phone (630) 377-6580. Fax (630) 377-6495. Website: www.systemsensor.com

2.2 DISTRIBUTED NETWORKED FIRE ALARM SYSTEM

- A. Distributed Networked Fire Alarm System: Gamewell-FCI E3 Series Expandable Emergency Evacuation Fire Alarm System.

2.3 CONTROL PANEL HARDWARE

- A. Intelligent Control Panel: Supply user interface, including LCD or touch-screen 1/4 VGA display Intelligent Loop Interface Modules (ILI-MB-E3), manual switching, Control Panel shall consist of the following units and components:
 - 1. System Cabinet (B-, C-, or D-Size Cabinet) with associated inner door.
 - 2. Power Supply Module (PM-9) with batteries.
 - 3. 80-Character LCD Display (LCD-E3).
 - 4. Intelligent Loop Main Board Interface (ILI-MB-E3).
 - 5. Intelligent Loop Supplemental Interface (ILI-S-E3).
 - 6. FocalPoint Gateway (FPT-GATE-E3).
 - 7. Optional DACT (DACT-E3).
 - 8. Optional Network Repeater (RPT-E3).
 - 9. Optional 1/4 VGA touch-screen display (NGA).
 - 10. Optional Auxiliary Switch Module (ASM-16).
- B. System Cabinet:
 - 1. Surface or semi-flush mounted with texture finish.
 - 2. Consist of back box, inner door, and door.
 - 3. Available in at least 3 sizes to best fit project configuration.
 - 4. Houses 1 or more PM-9 Power Supply Modules, 1 or more ILI-MB-E3 or ILI-S-E3 assemblies, and other optional modules as specified.
 - 5. Construction: Dead-front steel construction with inner door to conceal internal circuitry and wiring.

6. Wiring: Terminated on removable terminal blocks to allow field servicing of modules without disrupting system wiring.
- C. Power Supply Module (PM-9): Use latest technologies to provide power to the Control Panel and incorporate the following features:
1. Power-saving switching technology using no step-down transformers.
 2. 9-amp continuous-rated output to supply up to all power necessary under normal and emergency conditions.
 3. Integral battery charger with capacity to charge up to 55 amp-hour batteries while under full load.
- D. Batteries:
1. Sufficient capacity to provide power for entire system upon loss of normal AC power for a period of 24 hours with 15 minutes of alarm signaling at end of this 24-hour period, as required by NFPA 72, Local Systems.
- E. LCD Display Module (LCD-E3):
1. LCD Display: 80-character RS-485 based textual annunciator with capability of being mounted locally or remotely. Provides audible and visual annunciation of all alarms and trouble signals. Provide dedicated LEDs for:
 - a. AC Power On: Green.
 - b. Alarm: Red.
 - c. Supervisory: Yellow.
 - d. System Trouble: Yellow.
 - e. Power Fault: Yellow.
 - f. Ground Fault: Yellow.
 - g. System Silenced: Yellow.
 2. 80-Character Alphanumeric Display: Provide status of all analog/addressable sensors, monitor and control modules. Display shall be liquid crystal type (LCD), clearly visible in dark and under all light conditions.
 3. Panel shall contain 4 functional keys:
 - a. Alarm Acknowledge.
 - b. Trouble Acknowledge.
 - c. Signal Silence.
 - d. System Reset/Lamp Test.
 4. Panel shall contain 3 configuration buttons:
 - a. Menu/Back.
 - b. Back Space/Edit.
 - c. OK/Enter.
 5. Panel shall have 12-key telephone-style keypad to permit selection of functions.
- F. Intelligent Loop Interface (ILI-MB-E3): System shall be of multiprocessor design to allow maximum flexibility of capabilities and operation. Intelligent Loop Interface shall be capable of mounting in stand-alone enclosure as specified.
1. Field Programmable: System shall be capable of being programmed by Field Configuration Program (FCP), allowing programming to be downloaded via portable computer from any node on network.
 2. RS-232C Serial Output: Supervised RS-232C serial port shall be provided to operate remote printers and/or video terminals, accept downloaded program from portable computer, or provide 80-column readout of all alarms, troubles, location

- descriptions, time, and date. Communication shall be standard ASCII code operating from 1,200 to 115,200 baud rate.
3. RS-485 Serial Output: Each ILI-MB-E3 shall incorporate RS-485 bus via ribbon harness for connection of modules inside same cabinet, and via 4-wire quick connector for connection of modules up to 3,000 feet from cabinet. Each ILI-MB-E3's RS-485 bus shall support up to 16 ASM-16 auxiliary switch modules, 6 LCD-E3 main annunciators, and 5 LCD-7100 annunciators.
 4. Peer-to-Peer Panel Configuration: All Loop Interface Modules shall incorporate own programming, log functions, Central Processor Unit, and control-by-event (CBE) programming. If any loop driver becomes disabled, each remaining loop driver shall continue to communicate with remainder of network and maintain normal operation.
 5. Control-by-Event (CBE) Program: ILI-MB-E3 shall be capable of programming using Boolean logic including AND, OR, NOT, and TIMING functions to provide complete programming flexibility.
 6. Alarm Verification: Smoke detector alarm verification shall be standard option while allowing other devices such as manual stations and sprinkler flow to create immediate alarm. This feature shall be selectable for smoke sensors that are installed in environments prone to nuisance or unwanted alarms.
 7. Alarm Signals: All alarm signals shall be automatically latched or "locked in" at control panel until operated device is returned to normal and control panel is manually reset. When used for sprinkler flow, "SIGNAL SILENCE" switch may be bypassed, if required by AHJ.
 8. Electrically Supervised:
 - a. Each SLC and NAC circuit shall be electrically supervised for opens, shorts, and ground faults. Occurrence of fault shall activate system trouble circuitry, but shall not interfere with proper operation of other circuits.
 - b. Yellow "SYSTEM TROUBLE" LEDs shall light and system audible sounder shall steadily sound when trouble is detected in system. Failure of power, open or short circuits on SLC or NAC circuits, disarrangement in system wiring, failure of microprocessor or any identification module, or system ground faults shall activate this trouble circuit. Trouble signal shall be acknowledged by operating "TROUBLE ACKNOWLEDGE" switch. This shall silence sounder. If subsequent trouble conditions occur, trouble circuitry shall resound. During alarm, all trouble signals shall be suppressed with exception of lighting yellow "SYSTEM TROUBLE" LEDs.
 9. Drift Compensation – Analog Smoke Sensors: System software shall automatically adjust each analog smoke sensor approximately once each week for changes in sensitivity due to effects of component aging or environment, including dust. Each sensor shall maintain its actual sensitivity under adverse conditions to respond to alarm conditions while ignoring factors which generally contribute to nuisance alarms. System trouble circuitry shall activate, display units that requires maintenance.
 10. Analog Smoke Sensor Test: System software shall automatically test each analog smoke sensor a minimum of 3 times daily. Test shall be recognized functional test of each photocell (analog photoelectric sensors) and ionization chamber (analog ionization sensors) as required annually by NFPA 72. Failure of sensor shall activate system trouble circuitry, display "Test Failed" indication, and identify individual device that failed.
 11. Off-Premises Connection:

- a. Fire Alarm System: Connect via Digital Alarm Communicator Transmitter (DACT) and telephone lines to central station or remote station. Panel shall contain disconnect switch to allow testing of system without notifying fire department.
12. Central Station Option: Fire alarm control panel shall provide Digital Alarm Communicator Transmitter (DACT) for signaling to central station. DACT shall contain "Dialer-Runaway" feature preventing unnecessary transmissions as result of intermittent faults in system and shall be Carrier Access Code (CAC) compliant, accepting up to 20-digit central station telephone numbers. Fire department shall be consulted as to authorized central station companies serving municipality. Fire alarm system shall transmit both alarm and trouble signals, with alarm having priority over trouble signal. Contractor shall be responsible for all installation charges and Owner will be responsible for line lease charges.
13. Network Annunciator Option: Each ILI-MB-E3 and associated display shall provide option of being configured as network annunciator. Options for annunciation shall default as regional annunciator with capability of selecting global annunciation to provide system-wide protection and Acknowledge, Silence, and Reset capabilities.
14. Redundant History Log: Each ILI-MB-E3 shall contain full 4100 event history log supporting local and network functions. If a main processor or network node is lost the entire log shall be accessible at any other Loop Interface board. This shall be demonstrated by removing power from Command Center followed by extraction of history log from any loop driver location, including Command Center or Transponder.
15. LEDs Indicator and Outputs: Each ILI-MB-E3 Loop Interface shall incorporate as a minimum the following diagnostic LED indicators:
 - a. Power: Green.
 - b. Alarm: Red.
 - c. Supervisory: Yellow.
 - d. General Trouble: Yellow.
 - e. Ground Fault: Yellow.
 - f. Transmit: Green.
 - g. Receive: Green.
16. Auxiliary Power Outputs: Each ILI-MB-E3 Loop Interface shall provide the following supply outputs:
 - a. 24 VDC non-resettable, 1 amp. maximum, power limited.
 - b. 24 VDC resettable, 1 amp. maximum, power limited.
17. Microprocessor: Loop interface shall incorporate 32-bit RISC processor. Isolated "watchdog" circuit shall monitor microprocessor and upon failure shall activate system trouble circuits on display. Microprocessor shall access system program for all control-by-event (CBE) functions. System program shall not be lost upon failure of both primary and secondary power. Programming shall support Boolean logic including AND, OR, NOT, TIME DELAY functions for maximum flexibility.
18. Auto Programming: System shall provide for all SLC devices on any SLC loop to be pre-programmed into system. Upon activation of auto programming, only devices that are present shall activate. This allows for system to be commissioned in phases without need of additional downloads.
19. Environmental Drift Compensation: System shall provide for setting Environmental Drift Compensation by device. When detector accumulates dust in chamber and reaches unacceptable level but yet still below allowed limit, control panel shall indicate maintenance alert warning. When detector accumulates dust in chamber above allowed limit, control panel shall indicate maintenance urgent warning.

20. NON-FIRE Alarm Module Reporting: Non-reporting type ID shall be available for use for energy management or other non-fire situations. NON-FIRE point operation shall not affect control panel operation nor shall it display message at panel LDC. Activation of NON-FIRE point shall activate control by event logic, but shall not cause indication on control panel.
 21. 1-Man Walk Test:
 - a. System shall provide both basic and advanced walk test for testing entire fire alarm system. Basic walk test shall allow single operator to run audible tests on panel. All logic equation automation shall be suspended during test and while annunciators can be enabled for test, all shall default to disabled state. During advanced walk test, field-supplied output point programming shall react to input stimuli, such as CBE and logic equations. When points are activated in advanced test mode, each initiating event shall latch input. Advanced test shall be audible and shall be used for pull station verification, magnet activated tests on input devices, input and output device, and wiring operation/verification.
 - b. Test feature is intended to provide for certain random spot testing of system and is not intended to comply with requirements of testing fire alarm systems in accordance with NFPA 72, as it is impossible to test all functions and verify items such as annunciation with only 1 person.
 22. Signaling Line Circuits: Each ILI-MB-E3 module shall provide communication with analog/addressable (initiation/control) devices via 2 signaling line circuits. Each signaling line circuit shall be capable of being wired Class B, Style 4 or Class A, Style 6. Circuits shall be capable of operating in NFPA Style 7 configuration when equipped with isolator modules between each module type device and isolator sensor bases. Each circuit shall communicate with a maximum of 159 analog sensors and 159 addressable monitor/control devices. Unique 40-character identifier shall be available for each device. Devices shall be of the Velocity series with capability to poll 10 devices at a time with a maximum polling time of 2 seconds when both SLCs are fully loaded.
 23. Notification Appliance Circuits: 2 independent NAC circuits shall be provided on ILI-MB, polarized and rated at 2 amperes DC per circuit, individually over current protected and supervised for opens, grounds, and short circuits. They shall be capable of being wired Class B, Style Y or Class A, Style Z.
 24. Alarm Dry Contacts: Provide alarm dry contacts (Form C) rated 2 amps at 30 VDC (resistive) and transfer whenever system alarm occurs.
 25. Supervisory Dry Contacts: Provide supervisory dry contacts (Form C) rated 2 amps at 30 VDC (resistive) and transfer whenever system supervisory condition occurs.
 26. Trouble Dry Contacts: Provide trouble dry contacts (Form C) rated 2 amps at 30 VDC (resistive) and transfer whenever system trouble occurs.
- H. Auxiliary Switch Module (ASM-16):
1. Each ASM-16 has 16 programmable push-button switches.
 2. Each push-button switch has 3 associated status LEDs (red, yellow, and green), configurable to indicate any combination of functions.
 3. Flexible switch configurations to allow auxiliary functions.
 4. An insertable label to identify function of each switch and LEDs combination.
 5. Provide capability to communicate with up to 16 ASM-16 modules locally, or up to 3,000 feet from the Control Panel

- I. Network Repeater Module RPT-E3:
 - 1. Intelligent Network Interface shall provide interconnection and protection of remote Control Panels. Repeater shall regenerate and condition token passing, 625 K baud signal between units. Repeater shall be available in wire, fiber, or wire/fiber configurations as determined by field conditions.
 - 2. Fiber configurations shall use "ST"-type connectors and be able to operate with up to 200-micron multi-mode fiber, but optimize for 62.5/125. Interface shall have jumper to allow selection of ground detection of wiring when used in wire mode. Interface shall have integral LEDs to display current status of board.

- J. Network Graphic Annunciator (NGA): Networked, 1/4 VGA, touch-screen annunciator with the following characteristics:
 - 1. Custom Graphics: Panel shall permit uploading of custom bit-mapped graphic to display screen. Graphic shall display when all systems are normal.
 - 2. Intuitive Functions: In alarm or trouble condition, annunciator shall display only information pertaining to event, including control switches.
 - a. Trouble Condition: Display shall indicate cause of trouble. Only controls available to operator shall be Acknowledge and Reset functions.
 - b. Alarm Condition: Display shall indicate cause of alarm. Only controls available to operator shall be Acknowledge, Silence, and Reset functions.

2.4 SUPPLEMENTAL NOTIFICATION APPLIANCE CIRCUIT (HPF24)

- A. Supplemental Notification Appliance Circuit (HPF24) shall be either Model HPF24S6 or HPF24S8, as indicated on drawings, offering up to 6.0 amps (4.0 amps continuous) or 8.0 amps (6.0 amps continuous), respectively, of regulated 24-volt power. HPF24 shall include the following features:
 - 1. Integral Charger: Charge up to 18.0 amp-hour batteries and support 60-hour standby.
 - 2. 2 Input Triggers. Input trigger shall be Notification Appliance Circuit (from fire alarm control panel) or relay.
 - 3. Surface-mount back box.
 - 4. Ability to delay AC fail delay in accordance with applicable NFPA requirements.
 - 5. Power limited circuitry in accordance with applicable UL standards.
 - 6. Operates as sync follower or a sync generator

2.5 SYSTEM PERIPHERALS

- A. Addressable Devices – General:
 - 1. Provide address-setting means using rotary-decimal switches.
 - 2. Use simple to install and maintain decade-type (numbered 0 to 15) address switches by using standard screwdriver to rotate 2 dials on device to set address. Devices which use binary address set via dipswitch packages, handheld device programmer, or other special tools for setting device address shall not be acceptable.
 - 3. Detectors: Analog and addressable. Connect to fire alarm control panel's Signaling Line Circuits.
 - 4. Addressable Thermal and Smoke Detectors: Provide 2 status LEDs. Both LEDs shall flash under normal conditions, indicating detector is operational and in regular communication with control panel, and both LEDs shall be placed into steady illumination by control panel, indicating alarm condition has been detected. If

required, flashing mode operation of detector LEDs can be programmed off via fire control panel program.

5. Fire Alarm Control Panel: Permit detector sensitivity adjustment through field programming of system. Sensitivity can be automatically adjusted by panel on time-of-day basis.
 6. Using software, detectors shall automatically compensate for dust accumulation and other slow environmental changes that may affect their performance. Detectors shall be listed by UL as meeting calibrated sensitivity test requirements of NFPA 72, Chapter 7.
 7. Detectors shall be ceiling-mounted and shall include separate twist-lock base with tamper-proof feature.
 8. Following bases and auxiliary functions shall be available:
 - a. Standard base with remote LED output.
 - b. Sounder base rated at 85 dBA minimum.
 - c. Form-C relay base rated 30 VDC, 2.0 A.
 - d. Isolator base.
 9. Detectors shall provide test means whereby they will simulate alarm condition and report that condition to control panel. Such test shall be initiated at detector itself by activating magnetic switch or initiated remotely on command from control panel.
 10. Detectors shall store internal identifying type code that control panel shall use to identify type of device (PHOTO, THERMAL).
- B. Addressable Manual Stations (MS-7AF):
1. Manual Fire Alarm Stations: Non-code, non-break glass type, equipped with key lock so they may be tested without operating handle.
 2. Operated Station: Visually apparent, as operated, at a minimum distance of 100 feet (30.5 m) from front or side.
 3. Stations shall be designed so after actual activation, they cannot be restored to normal except by key reset.
 4. Manual stations shall be constructed of Lexan with clearly visible operating instructions provided on cover. The word FIRE shall appear on front of stations in raised letters, 1.75 inches (44 mm) or larger.
 5. Addressable manual stations shall, on command from control panel, send data to panel representing state of manual switch and addressable communication module status.
- C. Intelligent Thermal Detectors (ATD-L2F, ATD-HL2F): Intelligent addressable devices rated at 135 degrees F (58 degrees C) and 190 degrees F (73 degrees C), respectively. Connect via 2 wires to fire alarm control panel signaling line circuit.
- D. Intelligent Photoelectric Smoke Detectors (ASD-PL2F): Use photoelectric (light-scattering) principal to measure smoke density and shall, on command from control panel, send data to panel representing analog level of smoke density.
- E. Intelligent Duct Smoke Detectors (ADPF):
1. In-Duct Smoke Detector Housing: Use on-board intelligent photoelectric detector, which provides continuous analog monitoring and alarm verification from panel.
 2. When sufficient smoke is sensed, alarm signal is initiated, and appropriate action taken to shut down or change over air handling systems to help prevent rapid distribution of toxic smoke and fire gases throughout areas served by duct system.

3. Duct Smoke Detectors Mounted Above Ceiling or Otherwise Obstructed from Normal View: Provide with remote alarm indicator.
 4. Each Detector: Install in either supply side or return side duct in accordance with local mechanical code.
- F. Addressable Dry Contact Monitor Modules (AMM-2F):
1. Provide to connect 1 supervised IDC zone of conventional alarm initiating devices (any N.O. dry contact device) to 1 of the fire alarm control panel SLCs.
 2. Mount in standard deep electrical box.
 3. IDC Zone: Suitable for Style B operation.
- G. Addressable Dry Contact Monitor Modules (AMM-4F):
1. Provide to connect 1 supervised IDC zone of conventional alarm initiating devices (any N.O. dry contact device) to 1 of the fire alarm control panel SLCs.
 2. Mount in 4-inch (102-mm) square, 2-1/8-inch (54-mm) deep electrical box.
 3. IDC Zone: Suitable for Style D or Style B operation.
 4. LEDs: Flash under normal conditions, indicating monitor module is operational and in regular communication with control panel.
- H. Addressable Dry Contact Monitor Modules (AMM-2IF):
1. Provide to connect 2 supervised IDC zones of conventional alarm initiating devices (any N.O. dry contact device) to 1 of the fire alarm control panel SLCs.
 2. Mount in 4-inch (101.6-mm) square, 2-1/8-inch (54-mm) deep electrical box.
 3. IDC Zones: Suitable for Style B operation.
 4. LEDs: Flash under normal conditions, indicating monitor module is operational and in regular communication with control panel.
- I. Addressable Dry Contact Monitor Modules (MMI-10F):
1. Provide to connect 10 supervised Style B IDC zones or 5 supervised Style D IDC zones of conventional alarm initiating devices (any N.O. dry contact device) to 1 of the fire alarm control panel SLCs.
 2. Mount in factory-supplied MBB-2 or MBB-6 enclosure.
 3. LEDs: Flash under normal conditions, indicating monitor module is operational and in regular communication with control panel.
- J. 2-Wire Detector Monitor Modules (AMM-4SF):
1. Provided to connect 1 supervised IDC zone of conventional 2-wire smoke detectors or alarm initiating devices (any N.O. dry contact device).
 2. Mount in 4-inch (101.6-mm) square, 2-1/8-inch (54-mm) deep electrical box or to optional surface-mounted back box.
 3. IDC Zone: Wired for Class A or B (Style D or Style B) operation.
 4. LEDs: Flash under normal conditions, indicating monitor module is operational and in regular communication with control panel.
- K. 2-Wire Detector Monitor Modules (MMI-6SF):
1. Provided to connect 6 supervised Class B IDC zones of conventional 2-wire smoke detectors or alarm initiating devices (any N.O. dry contact device).
 2. Mount in factory-supplied MBB-2 or MBB-6 enclosure.
 3. LEDs: Flash under normal conditions, indicating monitor module is operational and in regular communication with control panel.

- L. Addressable Control Modules (AOM-2SF):
1. Provide to supervise and control operation of 1 conventional NAC of compatible, 24-VDC powered, polarized audio/visual notification appliances or UL-listed polarized relays for fan shutdown and other auxiliary control functions.
 2. Mount in standard 4-inch (101.6-mm) square, 2-1/8-inch (54-mm) deep electrical box or to surface-mounted back box.
 3. Control Module NAC: Wire for Style Z or Style Y (Class A/B) with up to 1 amp of inductive signal or 2 amps of resistive signal operation. Relay coil shall be magnetically latched to reduce wiring connection requirements and to ensure 100 percent of all auxiliary relay or NACs shall be energized at same time on same pair of wires.
 4. Audio/Visual Power: Provide by separate supervised power circuit from main fire alarm control panel or from supervised, UL-listed remote power supply.
- M. Addressable Control Modules (MMO-6SF):
1. Provide to supervise and control operation of 1 conventional NAC of compatible, 24-VDC powered, polarized audio/visual notification appliances or UL-listed polarized relays for fan shutdown and other auxiliary control functions.
 2. Mount in factory-supplied MBB-2 or MBB-6 enclosure.
 3. LEDs: Flash under normal conditions, indicating monitor module is operational and in regular communication with control panel.
 4. Control module NAC: Wire for Style Z or Style Y (Class A/B) with up to 1 amp of inductive signal or 2 amps of resistive signal operation. Relay coil shall be magnetically latched to reduce wiring connection requirements and to ensure 100 percent of all auxiliary relay or NACs shall be energized at same time on same pair of wires.
 5. Audio/Visual Power: Provide by separate supervised power circuit from main fire alarm control panel or from supervised, UL-listed remote power supply.
- N. Addressable Relay Modules (AOM-2RF):
1. Available for HVAC control and other building functions. Relay shall have 2 Form C sets of contacts that operate in tandem and are rated for a minimum of 2.0 amps resistive or 1.0 amps inductive. Relay coil shall be magnetically latched to reduce wiring connection requirements and to ensure 100 percent of all auxiliary relay or NACs shall be energized at same time on same pair of wires.
 2. Mount in standard 4-inch (101.6-mm) square, 2-1/8-inch (54-mm) deep electrical box or to surface-mounted back box.
- O. Addressable Relay Modules (MMO-6RF):
1. Available for HVAC control and other building functions. Relay shall be Form C and rated for a minimum of 2.0 amps resistive or 1.0 amps inductive. Relay coil shall be magnetically latched to reduce wiring connection requirements and to ensure 100 percent of all auxiliary relay or NACs shall be energized at same time on same pair of wires.
 2. Mount in factory-supplied MBB-2 or MBB-6 enclosure.
 3. LEDs: Flash under normal conditions, indicating monitor module is operational and in regular communication with control panel.
- P. Isolator Modules (M500X):
1. Provide to automatically isolate wire-to-wire short circuits on SLC Class A or Class B branch. Isolator module shall limit number of modules or detectors that may be

- rendered inoperative by short-circuit fault on SLC loop segment or branch. At least 1 isolator module shall be provided for each floor or protected zone of building. No more than 25 devices shall be connected to 1 isolator module.
2. If wire-to-wire short occurs, isolator module shall automatically open-circuit (disconnect) SLC. When short-circuit condition is corrected, isolator module shall automatically reconnect isolated section.
 3. Does not require address-setting, and its operations shall be totally automatic. Not necessary to replace or reset isolator module after normal operation.
 4. Mount in standard 4-inch (101.6-mm) deep electrical box or in surface-mounted back box.
 5. Single LED: Flash to indicate isolator is operational and illuminate steadily to indicate short-circuit condition has been detected and isolated.
- Q. Addressable Projected Beam Detectors (ABD-2F):
1. Single-ended, reflective design.
 2. Six user-selectable sensitivity levels.
 3. Operates in range from 16 feet to 328 feet.
 4. Temperature Range of Device: Minus 22 degrees F to 131 degrees F.
 5. Beam Detector: Automatic gain control to compensate for gradual signal deterioration from dirt accumulation on lenses.
 6. UL Listed.
 7. Ability to be tested using calibrated test filters or magnet-activated remote test station.
- R. Sprinkler Waterflow Switches (provided and installed by the sprinkler contractor):
1. Integral, mechanical, non-coded, non-accumulative retard type.
 2. Alarm transmission delay time conveniently adjustable from 0 to 60 seconds. Initial settings shall be 30 to 45 seconds.
 3. Single manufacturer and series.
 4. Where possible, locate waterflow switches a minimum of 1 foot from fitting which changes direction of flow and a minimum of 3 feet from valve.
 5. Waterflow switches shall be provided and connected under this section but installed by the mechanical contractor.
- S. Sprinkler and Standpipe Valve Supervisory Switches (provided and installed by the sprinkler contractor):
1. Each sprinkler system water supply control valve riser, zone control valve, and standpipe system riser control valve shall be equipped with supervisory switch. Standpipe hose valves, test valves, and drain valves shall not be equipped with supervisory switches.
 2. PIV (Post Indicator Valve) or Main Gate Valves: Equip with supervisory switch.
 3. Mount not to interfere with normal operation of valve and adjust to operate within 2 revolutions toward closed position of valve control, or when stem has moved no more than one-fifth of distance from normal position.
 4. Contain in weatherproof aluminum housing, which shall provide 3/4-inch (19-mm) conduit entrance and incorporate necessary facilities for attachment to valves.
 5. Switch Housing Finish: Red baked enamel.
 6. Entire Installed Assembly: Tamper proof and arranged to cause switch operation if housing cover is removed or if unit is removed from mounting.
 7. Valve supervisory switches shall be provided and connected under this section and installed by mechanical contractor.

- T. Graphic Annunciator (Uses ANU-48 Serial Driver Board):
1. Communicate to fire alarm control panel via EIA-485 (multi-drop) 2-wire communications loop. Up to 16 annunciator drivers, each configured up to 48 points, shall be connected per ILI-MB-E3.
 3. ANU-48: Provide interface to approved UL-listed graphic-style annunciator and provide each of the features specified.
- U. Remote LCD Display Annunciator:
1. Furnish and install as indicated on the Drawings a remote serial annunciator, Model LCD-7100. Annunciator shall provide 80-character display, which shall duplicate all information on basic system display, including any network nodes its host panel is annunciating, with exception of menus. Contain the following function keys:
 - a. Alarm Acknowledge.
 - b. Trouble Acknowledge.
 - c. Signal Silence.
 - d. System Reset/Lamp Test.
 - e. System Drill Test.
 2. Key Lock: Enable switches only when placed in "ON" position, with exception of Trouble Acknowledge, which is used to silence local trouble audible sounder. Annunciator shall contain the following LEDs:
 - a. Alarm.
 - b. Supervisory.
 - c. System Trouble.
 - d. Power Fault.
 - e. System Silenced.
 3. Mount on standard 3-gang surface or flush electrical box.
 4. Each ILI-MB-E3: Accommodate up to 5 remote LCD-7100 annunciators which shall be located up to 3,000 feet from control panel.
- V. Notification Appliances: Wheelock Exceeder Series, ET1010 Series
1. Operate on 24 VDC
 2. Interior speakers shall have selectable output options of 1/8, 1/4, 1/2, 1, and 2 watts continuous power.
 3. Exterior speakers shall have additional selectable outputs of 4 and 8 watts.
 4. Strobe Maximum Pulse Duration: 0.2 second.
 5. Strobe Intensity: UL 1971.
 6. Flash Rate: UL 1971.
 7. Strobe Candela Rating: Determine by positioning selector switch on back of device.

2.6 WIRING

- A. Raceways:
1. EMT: Allied Tube & Conduit "Fire Alarm Red" steel EMT conduit, or equivalent.
 2. Other raceways, junction boxes, etc.: Where fire alarm raceway is not buried underground, it shall be painted red.
- B. Cables & Conductors:
1. Optical Fiber Network Cable: 6-Strand Cable, as per data specification.

2. Signaling Line Circuit Cable:
 - a. OSP: West Penn #AQ225 (Black Jacket)
 - b. ISP: West Penn #D980 (Red Jacket)
3. Notification Appliance Circuit Cable:
 - a. OSP: West Penn #AQ227 (Black Jacket)
 - b. ISP: West Penn #974 (Red Jacket)
4. Voice Evacuation Speaker Cable:

As per notification appliance manufacturer.

PART 3 – EXECUTION

3.1 EXAMINATION

- A. Examine areas and surfaces to receive fire alarm system.
 1. Notify Architect of conditions that would adversely affect installation or subsequent use.
 2. Do not begin installation until unacceptable conditions are corrected.

3.2 INSTALLATION

- A. Install fire alarm system in accordance with NFPA 72, NFPA 70, state and local codes, manufacturer's instructions, and as indicated on the Drawings.
- B. Smoke detectors shall neither be installed within 36 inches of any HVAC supply or return air grille, to include air handling light fixtures, nor within 12 inches of any wall.
- C. Smoke detectors shall not be installed before system programming and test period. If construction is ongoing during this period, take measures to protect smoke detectors from contamination and physical damage.
- D. Wall mounted notification appliances shall be installed not lower than 80 inches and not higher than 96 inches, above finished floor. Devices shall be not be mounted within 6 inches of the ceiling.
- E. All fire alarm devices shall be accessible for periodic maintenance. Should a device location indicated in the Contract Documents not meet this requirement, it shall be the responsibility of the Contractor to bring it, in writing, to the attention of the Engineer.
- F. Flush-mount fire detection and alarm system devices, control panels, and remote annunciators in finished areas. Flush-mount or surface-mount fire detection and alarm system devices, control panels, and remote annunciators in unfinished areas.
- G. Ensure manual stations are suitable for surface mounting or semi-flush mounting as indicated on the Drawings. Install stations at 48 inches above finished floor, measured to operating handle.
- H. End of Line Resistors shall be furnished as required by the manufacturer. Devices containing end-of-line resistors shall be appropriately labeled so as not to require removal to identify the EOL device.

- I. Addressable modules shall be mounted within 36 inches of the monitored or controlled point of termination. This shall include, but is not necessarily limited to, fan shutdown, elevator recall, shunt trip, sprinkler status points, or door release. Label all addressable modules as "FIRE ALARM SYSTEM" and to their function, e.g., "FAN F-1 SHUTDOWN".
 - J. Conduit/Raceways, Junction Boxes:
 - 1. All systems and system components listed to UL864 Control Units for Fire Protective Signaling Systems maybe installed within a common conduit raceway system, in accordance with the manufacture's recommendations. System(s) or system components not listed to the UL864 standard shall utilize a separate conduit raceway system for each of the sub-systems.
 - 2. The fire alarm system cabling / wiring shall be installed in RED color conduit, minimum size 3/4". In upgrade projects, existing fire alarm system conduit may be reused, if serviceable. Paint existing conduits red to match new.
 - 2. All junction box covers shall be painted red.
 - 2. Minimum conduit size shall be 3/4" trade size.
 - 3. Conceal conduit, junction boxes, and conduit supports and hangers in finished areas. Conceal or expose conduit, junction boxes, and conduit supports and hangers in unfinished areas. Concealed installation is preferred wherever possible.
 - K. Cables & Conductors:
 - 1. Cables & conductors shall be labeled at both ends as to their origin and destination; e.g. "FACP - i1-1" indicates the origin as the FACP and the destination as initiation device "i1-1". Utilize Panduit labels (or equivalent), size MP-150c through MP-350, as required by the amount of information on the label.
 - 2. Splices in wiring are permitted only at terminal cabinets, or locations specifically approved by the Engineer. Do not splice in conduit, pull boxes, inaccessible locations, etc.
 - L. Terminal Cabinets:
 - 1. Wiring shall be neatly bundled, fanned, tagged, and laced. Leave minimum three inches fan space between terminal block connection and vertical wiring. Incoming wiring shall terminate on the left, outgoing on the right.
 - 2. Wire terminations at devices and terminal strips shall be "spade" type terminal connections, Sta-Kon, or equivalent.
 - 3. Terminal barrier strips shall be Cinch 142 series (or equivalent) with minimum six points. Leave minimum two space separation between types of system cables. Provide minimum four spare termination points.
 - M. Coordinate the required space in the Data equipment frames with this and other network based systems. Provide racks with sufficient space to accommodate all systems.
- ### 3.3 SYSTEM UPGRADES
- A. When upgrading an existing system, the existing fire alarm shall be tested in the presence of an assigned representative of Central Unified School District prior to any work being started by a contractor. Upon completion of testing, it shall be the contractor's responsibility to note any discrepancy with the existing system. It will be contractor's responsibility to provide and complete a working system, minus any discrepancies noted.

- B. When upgrading an existing system, all end of line resistors shall be changed out to meet the manufacturer's specifications for each fire panel. Install the latest software updates on existing equipment to be reused.
- C. When specifications call for the removal of existing equipment, that equipment shall be returned to the District.

3.4 FIELD QUALITY CONTROL

- A. Manufacturer's Field Services: Provide service of competent, factory-trained technician authorized by manufacturer to technically supervise and participate during pre-testing and acceptance testing of system.
- B. Testing:
 - 1. Conduct complete visual inspection of control panel connections and test wiring for short circuits, ground faults, continuity, and insulation before energizing cables and wires.
 - 2. Close each sprinkler system control valve and verify proper supervisory alarm at Control Panel.
 - 3. Verify activation of flow switches.
 - 4. Open initiating device circuits and verify that trouble signal actuates.
 - 5. Open signaling line circuits and verify that trouble signal actuates.
 - 6. Open and short notification appliance circuits and verify that trouble signal actuates.
 - 7. Ground initiating device circuits and verify response of trouble signals.
 - 8. Ground signaling line circuits and verify response of trouble signals.
 - 9. Ground notification appliance circuits and verify response of trouble signals.
 - 10. Check installation, supervision, and operation of intelligent smoke detectors.
 - 11. Introduce on system each of the alarm conditions that system is required to detect. Verify proper receipt and proper processing of signal at Control Panel and correct activation of control points.
 - 12. Consult manufacturer's manual to determine proper testing procedures when system is equipped with optional features. This is intended to address such items as verifying controls performed by individually addressed or grouped devices, sensitivity monitoring, verification functionality, and similar.
- C. Acceptance Testing:
 - 1. The contractor's job foreman and an assistant, in the presence of a representative of the manufacturer, an assigned representative of Central Unified School District, and the assigned inspector of the AHJ, shall perform a test of the system. All attending personnel shall be given reasonable notice so as to make themselves available for the test.
 - 2. Operate every installed device to verify proper operation and correct annunciation at the control panel.
 - 2. Open signaling line circuits and notification appliance circuits in at least 2 locations to verify presence of supervision.
 - 3. Completely disconnect main Control Panel from rest of network. Activate initiating device. All control outputs supported by transponder SLC circuits shall operate under project programming mode. Default or degrade mode programming shall not be acceptable.
 - 4. Complete any additional testing required by the AHJ.

5. When testing has been completed to satisfaction of both Contractor's job foreman, representatives of the manufacturer and Owner, and the inspector of the AHJ, a notarized letter co-signed by each attesting to satisfactory completion of said testing shall be forwarded to the Owner and fire department.
6. Leave fire alarm system in proper working order and, without additional expense to Owner, replace defective materials and equipment provided within 1 year (365 days) from date of final acceptance by the owner.

3.5 DEMONSTRATION

- A. Provide instruction as required for operating fire alarm system.
- B. Provide hands-on demonstrations of operation of fire alarm system components and functions.

END OF SECTION

| CS Acrovyn 4000 Models

Suggested Specifications | Section 10 26 00
Models: SM-20N, SM-20AN and SM-20MN



AD 2-06a
S&B Elementary
02-116800

Part 1 - General

1.01 Summary

- A. This section includes the following types of wall protection systems:
 - 1. Corner Guards
- B. Related sections: The following sections contain requirements related to this section:
 - 1. Handrails, Bumper Guards, Crash Rails, Accent Rails, Wall Covering, Wall Panels, Door Protection; refer to section 10 26 00 "Wall and Door Protection"
 - 2. Blocking in walls for fasteners; refer to section 09 22 00 "Supports for Plaster and Gypsum Board"

1.02 References

- A. National codes (IBC, UBC, SBCCI, BOCA and Life Safety)
- B. American Society for Testing and Materials (ASTM)
- C. Underwriters Laboratories (UL)
- D. California 01350 specification

1.03 Submittals

General: Submit the following in accordance with conditions of contract and Division 1 specification section 01 33 00 "Submittal Procedures":

- A. Product data and detailed specifications for each system component and installation accessory required, including installation methods for each type of substrate.
- B. Shop drawings showing locations, extent and installation details of corner guards. Show methods of attachment to adjoining construction.
- C. Samples for verification purposes: Submit the following samples, as proposed for this work, for verification of color, texture, pattern and end cap attachment and alignment:
 - 1. 12" (304.8mm) long sample of each model specified including end cap.
- D. Product test reports from a qualified independent testing laboratory showing compliance of each component with requirements indicated.
- E. Maintenance data for wall protection system components for inclusion in the operating and maintenance manuals specified in Division 1.

1.04 Quality Assurance

- A. Installer qualifications: Engage an installer who has no less than 3 years' experience in installation of systems similar in complexity to those required for this project.
- B. Manufacturer's qualifications: Not less than 5 years' experience in the production of specified products and a record of successful in-service performance.
- C. Code compliance: Assemblies should conform to all applicable codes including IBC, UBC, SBCCI, BOCA, Life Safety and CA 01350.

- D. Fire performance characteristics: Provide engineered PVC FREE wall protection system components with UL label indicating that they are identical to those tested in accordance with ASTM E84 for Class A/1 characteristics listed below:
 - 1. Flame spread: 25 or less
 - 2. Smoke developed: 450 or less
- B. Impact strength: Provide wall protection components that have been tested for impact using a ram-type impact test in accordance with the applicable provisions of ASTM F476 -84.
- E. Chemical and stain resistance: Provide wall protection system components with chemical and stain resistance in accordance with ASTM D543.
- F. Color match: Provide wall protection components that are color matched in accordance with the following:
 - 1. Delta Ecmc of no greater than 1.0 using CIE Lab color space. (Specifier note: Construction Specialties' colors are matched under cool white fluorescent lighting and computer controlled within manufacturing tolerances. Color may vary if alternate lighting sources are present.)
- G. Single source responsibility: Provide all components of the wall protection system manufactured by the same company to ensure compatibility of color, texture, and physical properties.

1.05 Delivery, Storage and Handling

- A. Deliver materials to the project site in unopened original factory packaging clearly labeled to show manufacturer.
- B. Store materials in original, undamaged packaging in a cool, dry place out of direct sunlight and exposure to the elements. A minimum room temperature of 40°F (4°C) and a maximum of 100°F (38°C) should be maintained.
- C. Material must be stored flat.

1.06 Project Conditions

- A. Materials must be acclimated in an environment of 65°-75°F (18°-24°C) for at least 24 hours prior to beginning the installation.
- B. Installation areas must be enclosed and weatherproofed before installation commences.

1.07 Warranty

A. Acrovyn 5-year Limited Warranty

- Applies to Interior Wall Protection orders that do not include recommended components or accessories
 - Assemblies = Brackets, Hardware
 - Accessories = Primer, Adhesive, Caulk, Trims & Moldings

B. Limited Lifetime Systems Warranty

- Applies to CS Interior Wall Protection projects that include all recommended components and accessories related to CS Interior Wall Protection Products.
 - Assemblies = Brackets, Hardware
 - Accessories = Primer, Adhesive, Caulk, Trims & Moldings

Part 2 - Products

2.01Manufacturers

- A. Construction Specialties, 3 Werner Way, Lebanon, NJ 08833 USA 800-233-8493; email: cet@c-sgroup.com
- B. Drawings and specifications are based on manufacturer's literature from Construction Specialties, Inc. drawings and specifications unless otherwise indicated. Other manufacturers must be approved equal by Architect/Owner.

2.02 Materials

- A. Engineered PVC FREE: Extruded material should be high-impact Acrovyn 4000 with Shadowgrain texture, nominal .078" (1.98mm) thickness. Chemical and stain resistance should be per ASTM D543 standards as established by the manufacturer. Colors to be indicated in the finish schedule from one of manufacturer's available colors and patterns.
- B. Regrind PVC FREE: PVC-free regrind retainer for model SM-20N.
- C. Aluminum: Extruded aluminum retainers should be 6063-T6 alloy, nominal .062" (1.57mm) thickness for models SM-20AN and SM-20MN. Minimum strength and durability properties as specified in ASTM B221.
- D. Fasteners: All fasteners to be non-corrosive and compatible with aluminum retainers. All necessary fasteners to be supplied by the manufacturer.

2.03 Corner Guards

- A. Engineered PVC FREE Corner Guards to be CS Acrovyn: Surface mounted guards consisting of continuous retainer with snap-on Acrovyn 4000 cover. Color matched end caps to be provided for both partial and full height applications. Attachment hardware shall be appropriate for wall construction.
 - 1. Model SM-20N 90° surface mounted corner guard with 3" (76.1mm) legs, 1/4" (6.4mm) radius cover and regrind PVC FREE retainer. Specify SM-20AN for continuous aluminum retainer or SM-20MN for odd degree corners. Select from one of Acrovyn™ solid colors, Acrovyn™ Woodgrains or Acrovyn™ Brushed Metals simulated patterns. Optional horizontal accent reveal available in Black only (90° only). [Specifier note: refer to the Acrovyn Cradle to Cradle Product Summary at www.acrovyn.com/c2c to determine which colors and patterns are Cradle to Cradle Certified™ Gold or Silver (exception: optional horizontal accent reveal). Cradle to Cradle Certified™ is a certification mark licensed by the Cradle to Cradle Products Innovation Institute.]

2.04 Fabrication

- A. General: Fabricate wall protection systems to comply with requirements indicated for design, dimensions, detail, finish and member sizes.

Part 3 - Execution

3.01Examination

- A. Verification of conditions: Examine areas and conditions under which work is to be performed and identify conditions detrimental to proper or timely completion.
 - 1. Do not proceed until unsatisfactory conditions have been corrected.

3.02 Preparation

- A. Surface preparation: Prior to installation, clean substrate to remove dirt, debris and loose particles. Perform additional preparation procedures as required by manufacturer's instructions.
- B. Protection: Take all necessary steps to prevent damage to material during installation as required in manufacturer's installation instructions.

3.03 Installation

- A. Install the work of this section in strict accordance with the manufacturer's recommendations, using only approved mounting hardware and locating all components firmly into position, level and plumb.
- B. Temperature at the time of installation must be between 65°-75°F (18°-24°C) and be maintained for at least 48 hours after the installation.
- C. Adjust installed end caps as necessary to ensure tight seams.

3.04 Cleaning

- A. General: Immediately upon completion of installation, clean material in accordance with manufacturer's recommended cleaning method.
- B. Remove surplus materials, rubbish and debris resulting from installation as work progresses and upon completion of work.

3.05 Protection

- A. Protect installed materials to prevent damage by other trades. Use materials that may be easily removed without leaving residue or permanent stains.



**SECTION 09 72 60
TACKABLE WALLCOVERING**

**AD 2-07a
S&B Elementary
02-116800**

PART 1 - GENERAL

1.1 SUMMARY

EDIT ITEMS NOT INCLUDED IN THIS PROJECT

- A. Section Includes:
 - 1. Resilient cork/linoleum tackable wallcovering.
 - 2. Accessories.

- B. Related Divisions:
 - 1. Division 09 91 23 Interior Painting: Priming for wallcoverings.
 - 2. Division 09 72 16.13 Flexible Vinyl Wallcoverings.
 - 3. Division 10 11 00 Visual Display Surfaces: Tackboards.

1.2 SUBMITTALS

- A. Comply with Division 01 33 00.
- B. Product data indicating compliance with specified requirements.
- C. Installation Instructions.
- D. Samples: 7 inch (18 centimeter) by 9 inch (23 centimeter) samples of each type of tackable wallcovering material required.

1.3 QUALITY ASSURANCE

- A. Surface Burning Characteristics Classification: Provide materials that meet classification ratings below:
 - ASTM E84 (Flame Spread and Smoke Developed) II/B
- B. Single Source Responsibility: Obtain tackable wallcovering system components from a single source.

DELETE PARAGRAPHS C AND D BELOW IF DIVISION 01 REQUIREMENTS SATISFY PROJECT REQUIREMENTS.

- C. Deliver materials in original factory packaging, labeled with manufacturer, brand name, size, color, and lot number.
- D. Store materials in original, undamaged packaging inside a well-ventilated area protected from weather, moisture, soiling, and extreme temperatures.
 - Maintain room temperature within the storage area at not less than 68 degrees Fahrenheit (20 degrees Celsius) during the period materials are stored.
- E. Mock-ups: Prepare mock-ups for architect's review and to establish requirements for seaming and finish trim.
 - 1. Correct areas, modify method of application/installation, or adjust finish texture as directed by architect to comply with specified requirements.
 - 2. Maintain mock-ups accessible to serve as a standard of quality.
 - 3. Install sample panel of each type of wallcovering specified.
 - 4. Install panels in areas designated by architect.

1.4 PROJECT CONDITIONS

Maintain ambient temperature within the building at not less than 68 degrees Fahrenheit (20 degrees Celsius) for a minimum of seventy-two hours prior to beginning of installation.

1. Do not install tackable wallcovering until the space is enclosed and weatherproof.
2. Do not install tackable wallcovering until temperature is stabilized and permanent lighting is in place.

1.5 MAINTENANCE

Maintenance Instructions: Include precautions against cleaning materials and methods that may be detrimental to finishes and performance.

1.6 WARRANTY

Submit manufacturer's limited five-year written warranty against manufacturing defects.

PART 2 - PRODUCTS

2.1 PRODUCTS

Tac-Wall[®] resilient, tackable, linoleum surface material. Width: 48 inch (122 centimeter) or 72 inch (183 centimeter) suntan, quarry and acorn are the only colors available in 72 inch. Gauge: 1/4 inch (6 millimeter). Approximately 95 lineal feet (29.1 meter) rolls. Flexible enough to bend around a 2-3/4 inch (7 centimeter) radius. Dimensionally stable due to burlap backing.

Walltalkers[®] **Tac-Wall**[®]: Uni-color resilient homogeneous tackable linoleum surface consisting of linseed oil, granulated cork, rosin binders, and dry pigments calendered onto natural burlap backing. Color shall extend through thickness of material.

2.2 ACCESSORIES

- A. Adhesive: Solvent-free, SBR type linoleum adhesive (L-910W) or polyvinyl acetate dispersion type (contact adhesive) when used in a press.
- B. Color matched caulk:
 1. C100-04: Acrylic caulk stone.
 2. C100-06: Acrylic caulk harbor.
 3. C100-07: Acrylic caulk aztec.
 4. C100-08: Acrylic caulk earthen.
 5. C100-09: Acrylic caulk onyx.
 6. C100-10: Acrylic caulk gypsy.
 7. C100-11: Acrylic caulk cayenne.
 8. C100-12: Acrylic caulk citrine.
 9. C100-13: Acrylic caulk botanical.
 10. C100-14: Acrylic caulk deep sea.
 11. C100-62: Acrylic caulk pewter.
 12. C100-66: Acrylic caulk suntan.
 13. C100-82: Acrylic caulk quarry
 14. C100-86: Acrylic caulk acorn
 15. C100-87: Acrylic caulk sandalwood

- C. Colonial **Tac-Wall** Wood Trim: Provide wood trim in random lengths of 8 foot (244 centimeter) to 12 foot (366 centimeter).
 - 1. WTWC-M0: Colonial **Tac-Wall** maple wood trim, unfinished.
 - 2. WTWC-M1: Colonial **Tac-Wall** maple wood trim, clear coat.
 - 3. WTWC-M2: Colonial **Tac-Wall** maple wood trim, red oak stain.
 - 4. WTWC-M3: Colonial **Tac-Wall** maple wood trim, cherry stain
 - 5. WTWC-MZ: Colonial **Tac-Wall** maple wood trim, specify custom stain.
 - 6. WTWC-R0: Colonial **Tac-Wall** oak wood trim, unfinished.
 - 7. WTWC-R1: Colonial **Tac-Wall** oak wood trim, clear coat.
 - 8. WTWC-R2: Colonial **Tac-Wall** oak wood trim, red oak stain.
 - 9. WTWC-R3: Colonial **Tac-Wall** oak wood trim, cherry stain.
 - 10. WTWC-RZ: Colonial **Tac-Wall** oak wood trim, specify custom stain.
- D. J-Trim for **Tac-Wall**
 - JT12-00: Clear satin, anodized aluminum, 1/4 inch (6 millimeter) trim (old: JTRM-00).

PART 3 - EXECUTION

3.1 EXAMINATION

Examine areas and conditions in which tackable wallcoverings will be installed.

- 1. Complete finishing operations, including painting, before beginning installation of tackable wallcovering materials.
- 2. Wall surfaces to receive wallcovering materials shall be dry and free from dirt, grease, loose paint, and scale.
- 3. Notify the contractor and architect in writing of any conditions detrimental to the proper and timely completion of the installation.
- 4. Beginning of installation means acceptance of surface conditions.

3.2 PREPARATION

Surface Preparation: Remove hardware, accessories, plates, and similar items to allow tackable wallcovering to be installed.

- 1. Plaster surface: Remove surface chalk. In new work, use moisture meter to determine moisture content. Do not begin installation when moisture content is greater than five percent.
- 2. Gypsum board surface: Recess nails and screws. Repair irregular tape joints, sand and remove dust.
- 3. Painted surface: Remove loose paint or scale. Sand surface of enamel or gloss paint and wipe clean with damp cloth.
- 4. Ensure wall surfaces scheduled to receive tackable wallcovering are properly sealed with a quality primer specified for use under flexible vinyl wallcoverings.

3.3 APPLICATION

- A. Comply with manufacturer's printed installation instructions.
- B. Cut sheets to size including a few inches of overage. Allow sheets to lay flat for at least twenty-four hours prior to the application. Mark roll direction and sequence on the backside of each sheet. Hang sheets in sequence as cut from the roll, do not reverse sheets.
- C. Permanent HVAC system should be set to 68 degrees Fahrenheit (20 degrees Celsius) for at least seventy-two hours prior to, during, and after the installation.
- D. Back roll each sheet prior to the installation to release curl memory.

- E. For seamed applications, using a seam and strip cutter remove the factory edge of one sheet. Using the same tool, overlap and trace cut the mating edge of the second sheet. Repeat this step for as many sheets as required for the job.
- F. Scribe, cut, and fit material to butt tightly to adjacent surfaces, built-in casework, and permanent fixtures and pipes.
- G. Apply adhesive with a 1/16 inch square notch trowel to the area to receiving the sheet (apply enough for one sheet at a time).
- H. Work from top to bottom then side to side. Roll sheet firmly into adhesive for positive contact and to remove air bubbles.
- I. Remove adhesive residue immediately after each panel is hung with a mild soap/water solution and a soft cloth/sponge.

JOINTS MAY BE BUTTED, V-GROOVED, SPACED WITH REVEAL, OR JOINED WITH DECORATIVE T-MOLDING.

3.4 CLEANING

- A. Clean wallcovering using a sponge with a neutral pH cleaning solution. Do not use abrasive cleaners. Rinse thoroughly with water and let dry before using.
- B. It is important to remove adhesive while wet.






3.5 PROTECTION


Protect installed product and finish surfaces from damage during construction.

END OF SECTION

proposed colors
& pattern

SEE REMARK 13/A2.8
COLOR SCHEDULE FOR
SIZING AND SPECIFIC
LAYOUT.

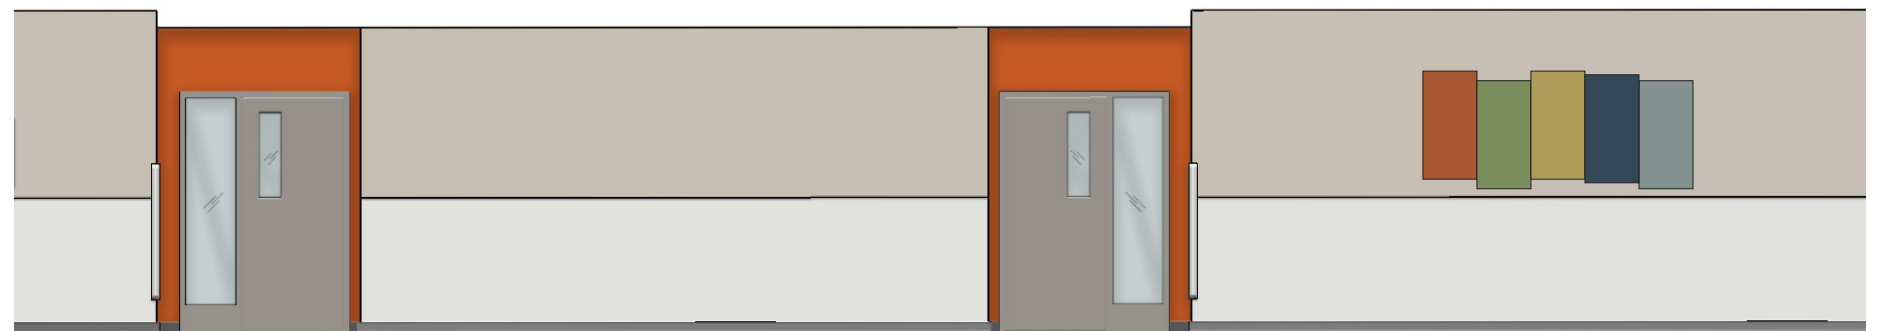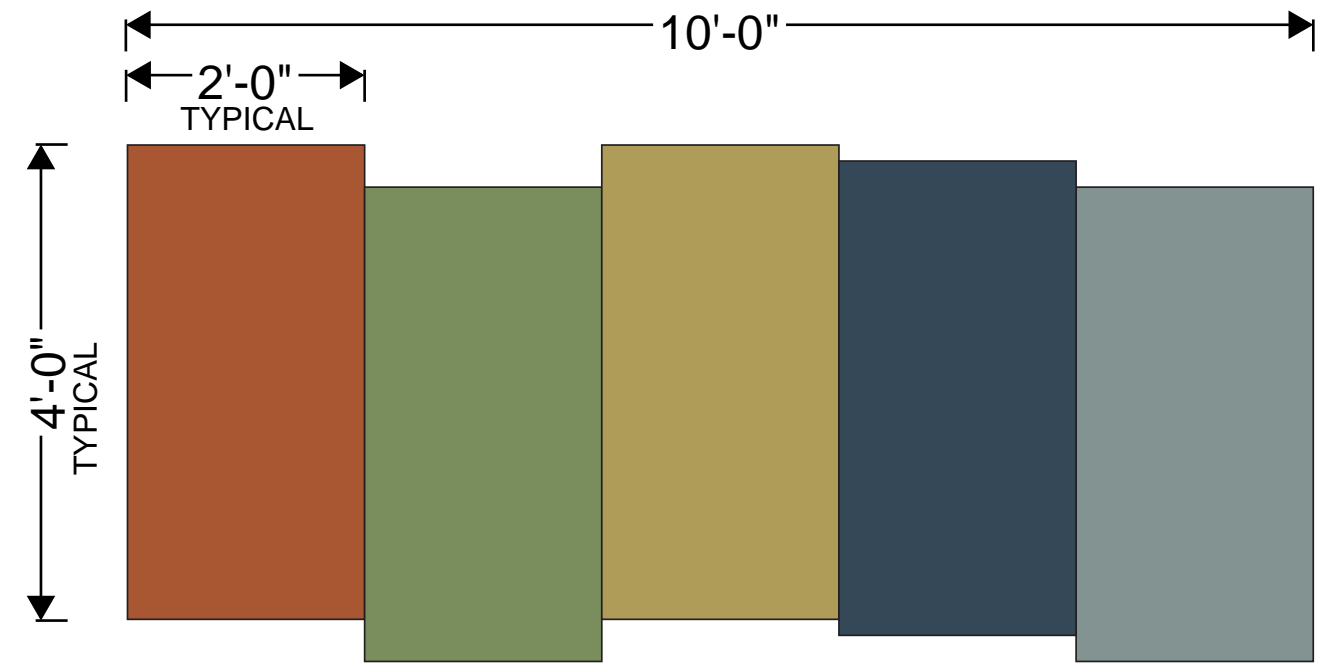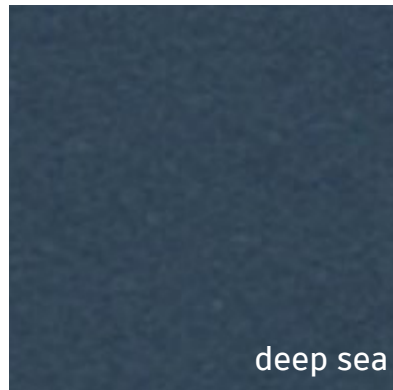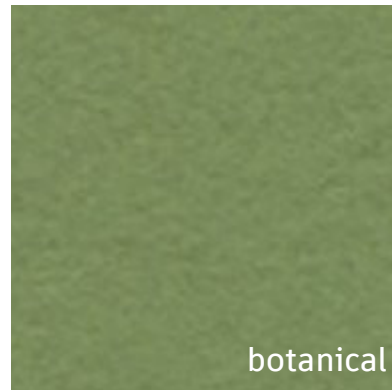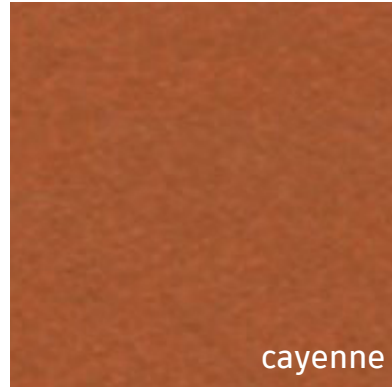


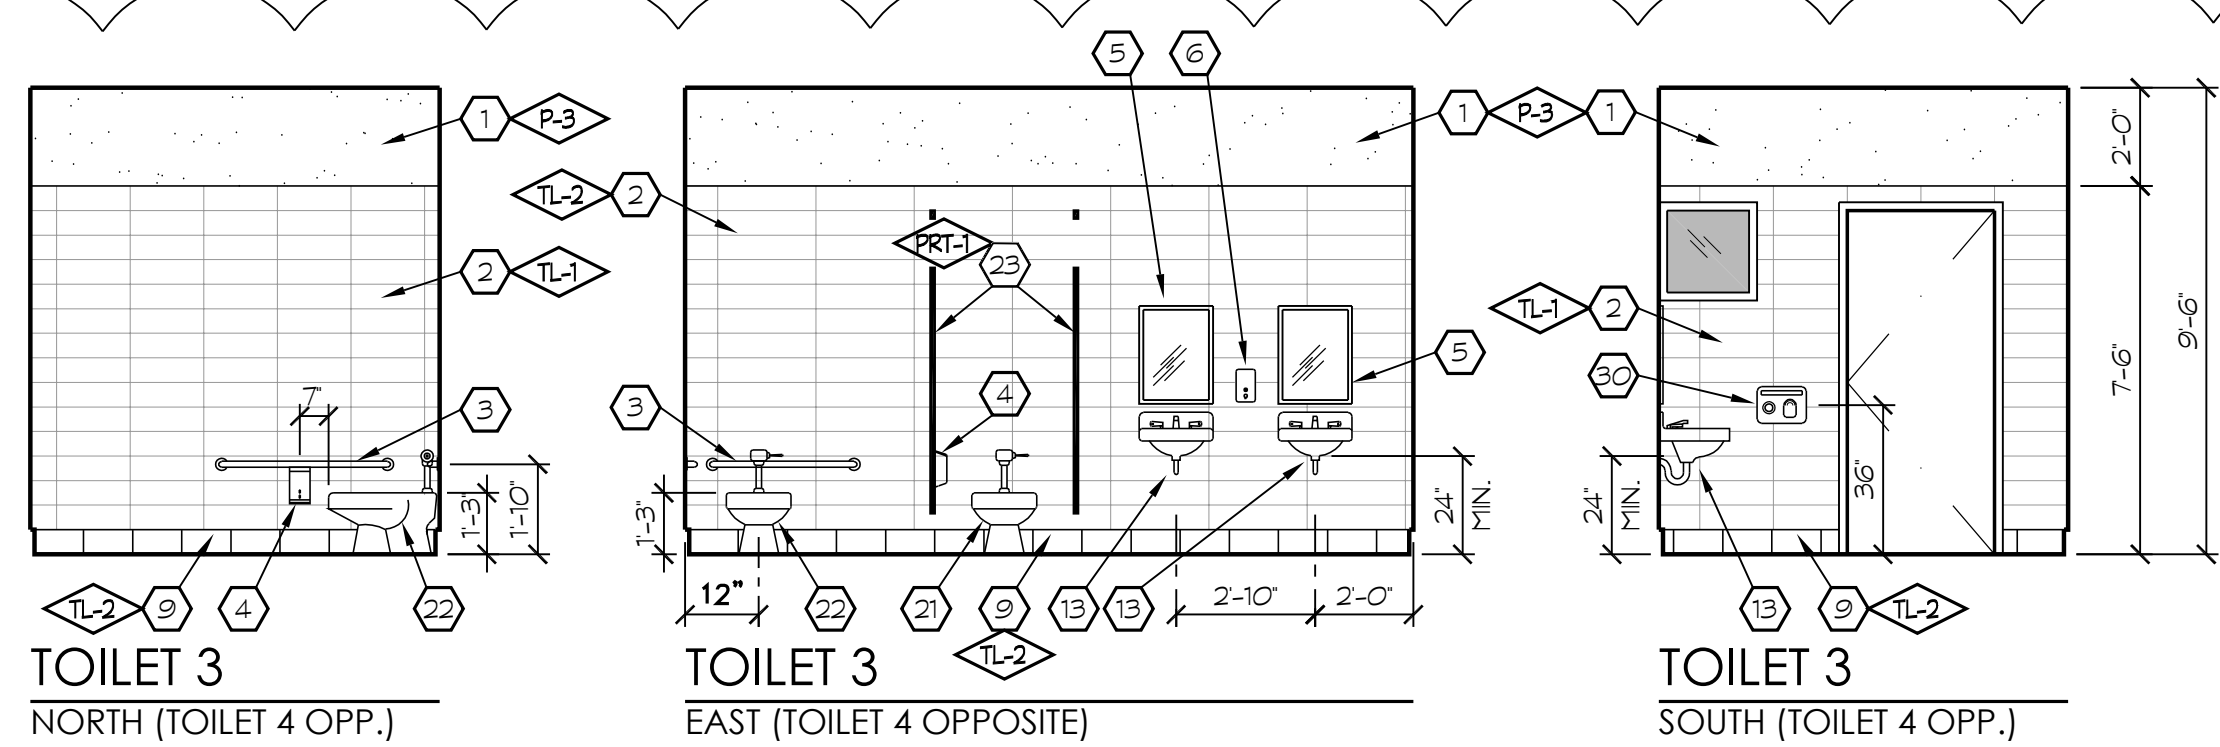


TOILET 3
NORTH (TOILET 4 OPP.)

TOILET 3
EAST (TOILET 4 OPPOSITE)


TOILET 3
SOUTH (TOILET 4 OPP.)

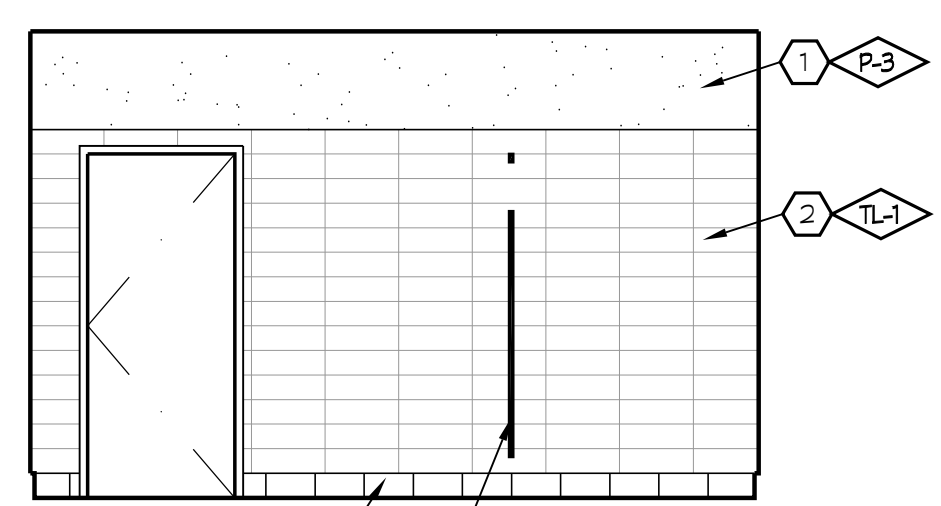

TOILET 3
WEST (TOILET 4 OPPOSITE)

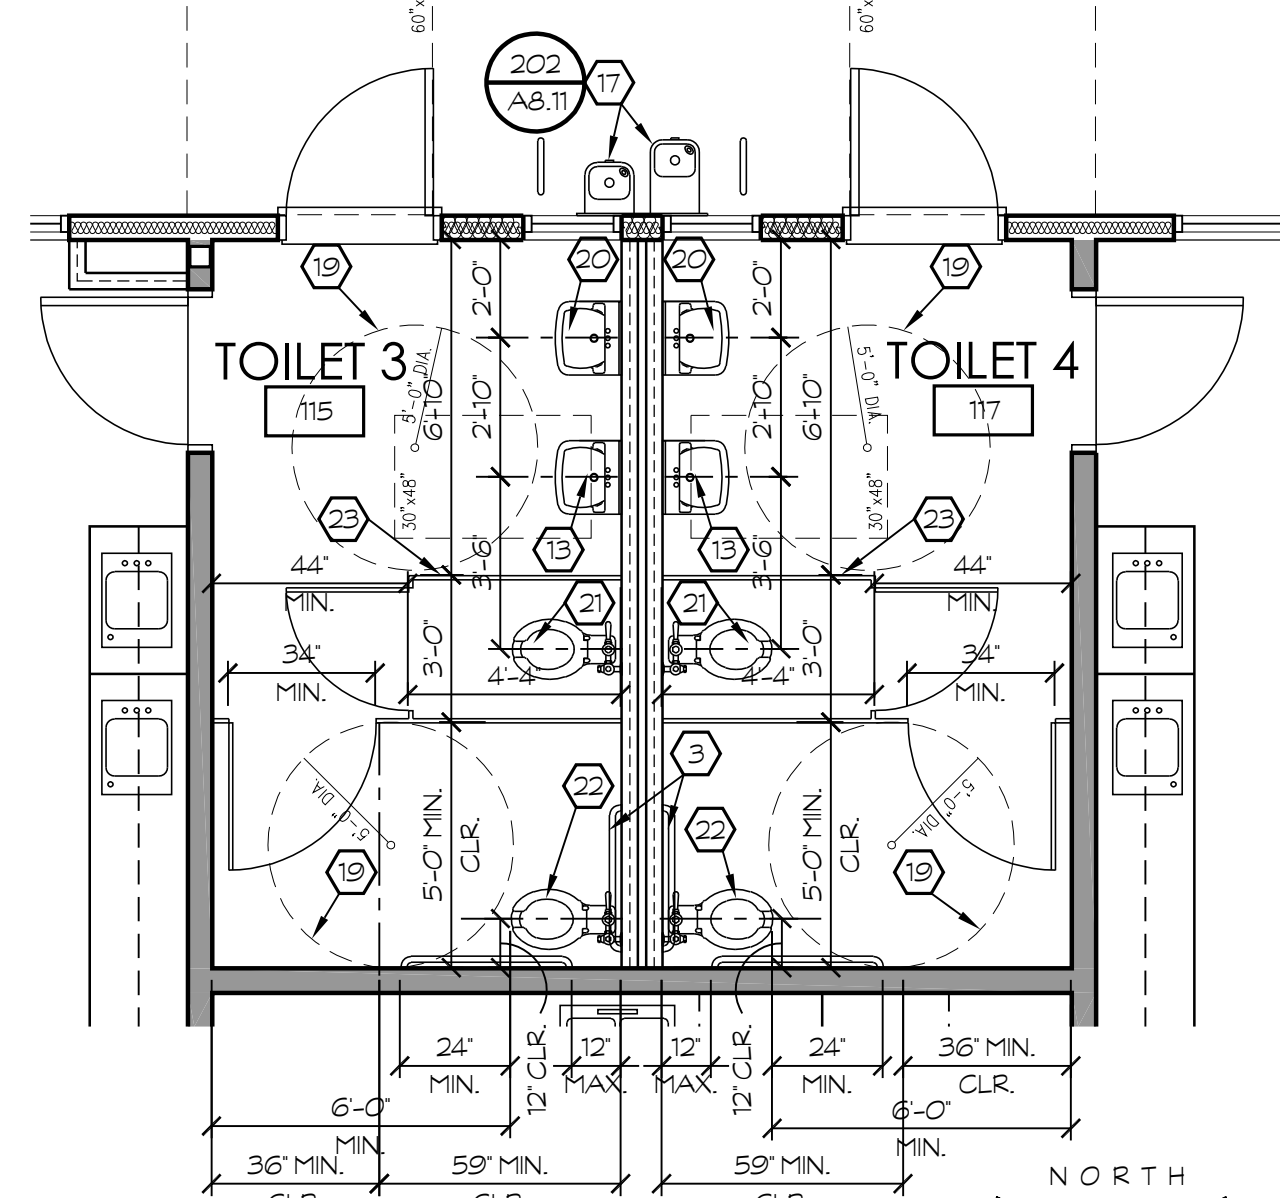


A RESTROOM FLOOR PLAN (KINDERGARTEN)
ENLARGED FLOOR AND ELEVATIONS (ROOMS 106 & 108 SIM.)
SCALE: 1/4" = 1'-0"

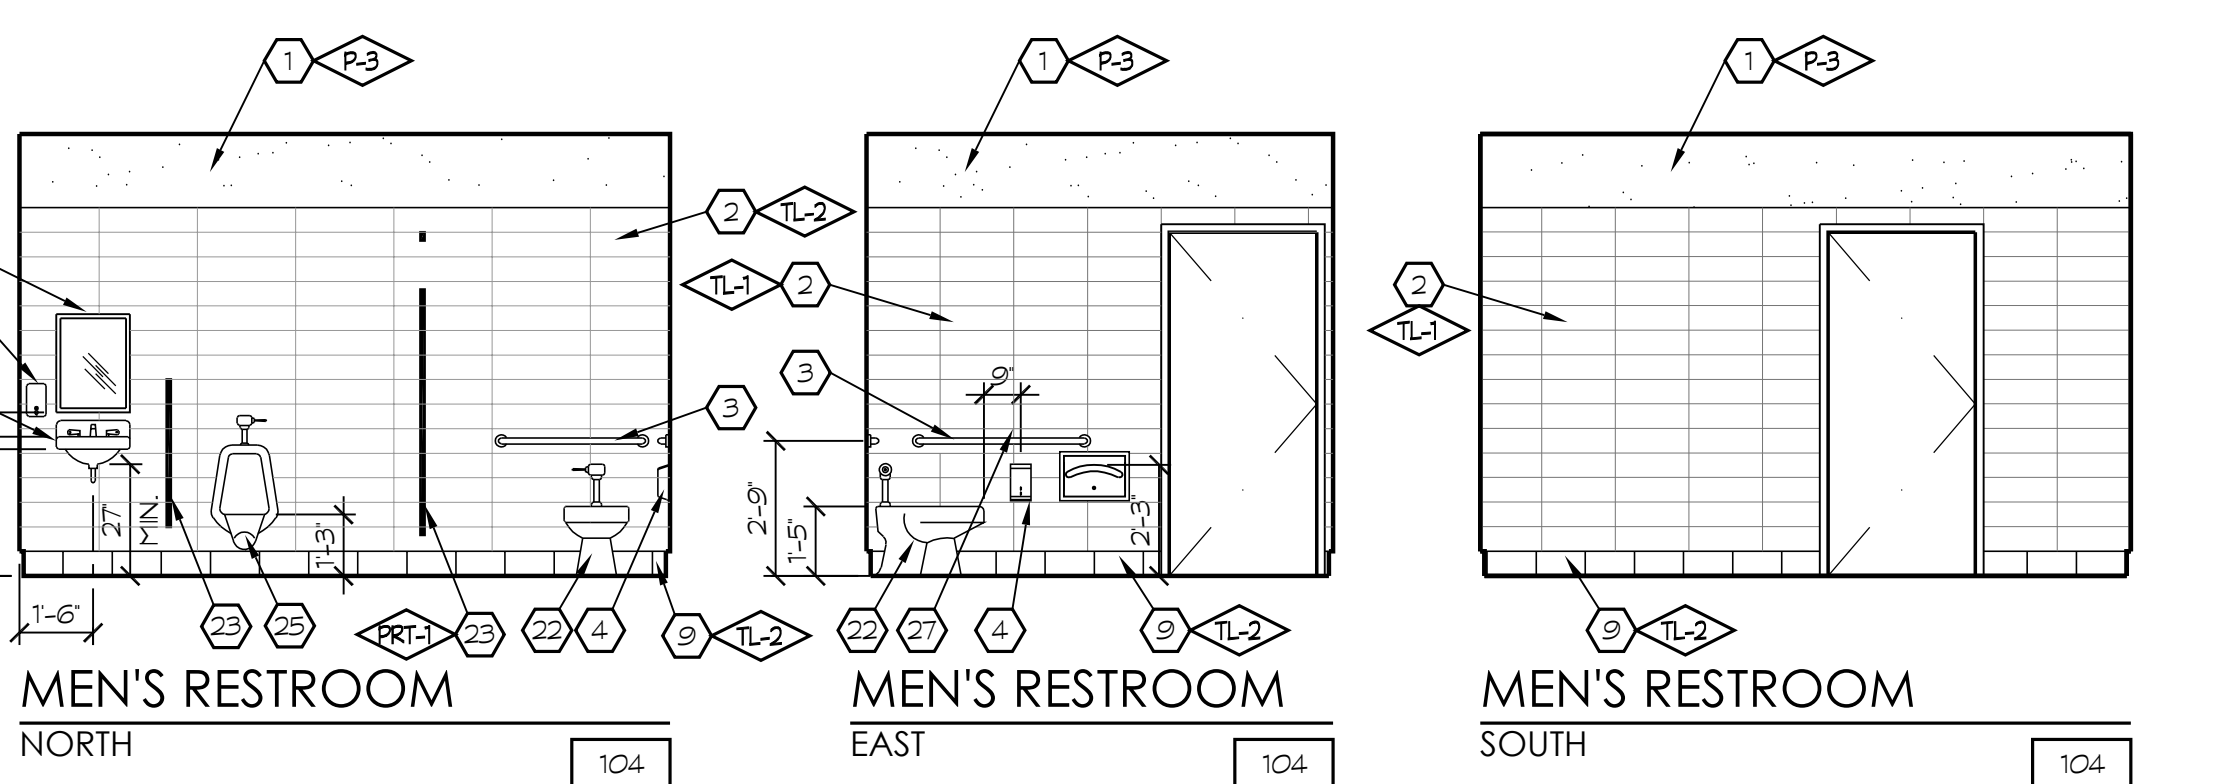


MEN'S RESTROOM
NORTH

MEN'S RESTROOM
EAST

MEN'S RESTROOM
SOUTH

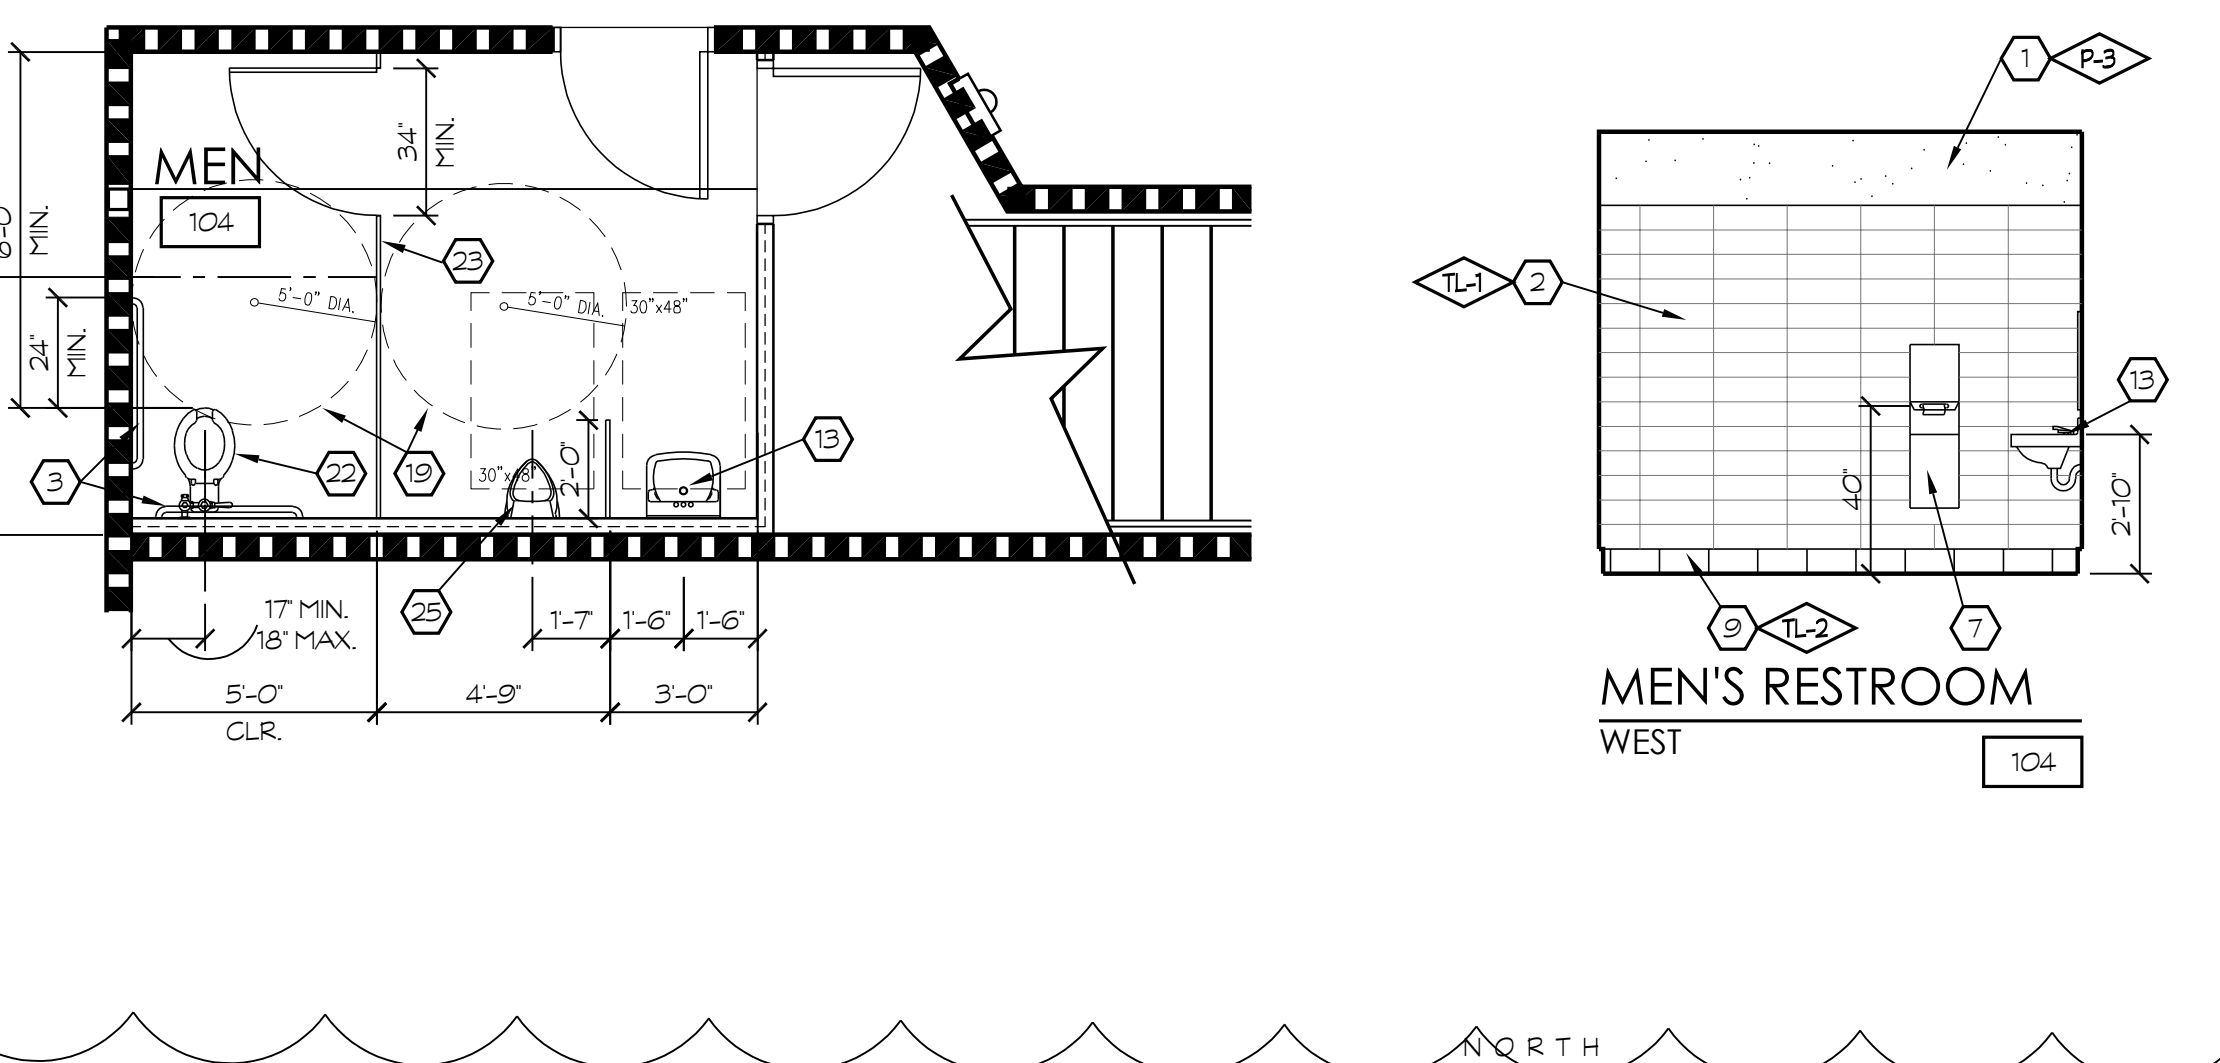


C RESTROOM FLOOR PLAN
ENLARGED FLOOR AND ELEVATIONS
SCALE: 1/4" = 1'-0"

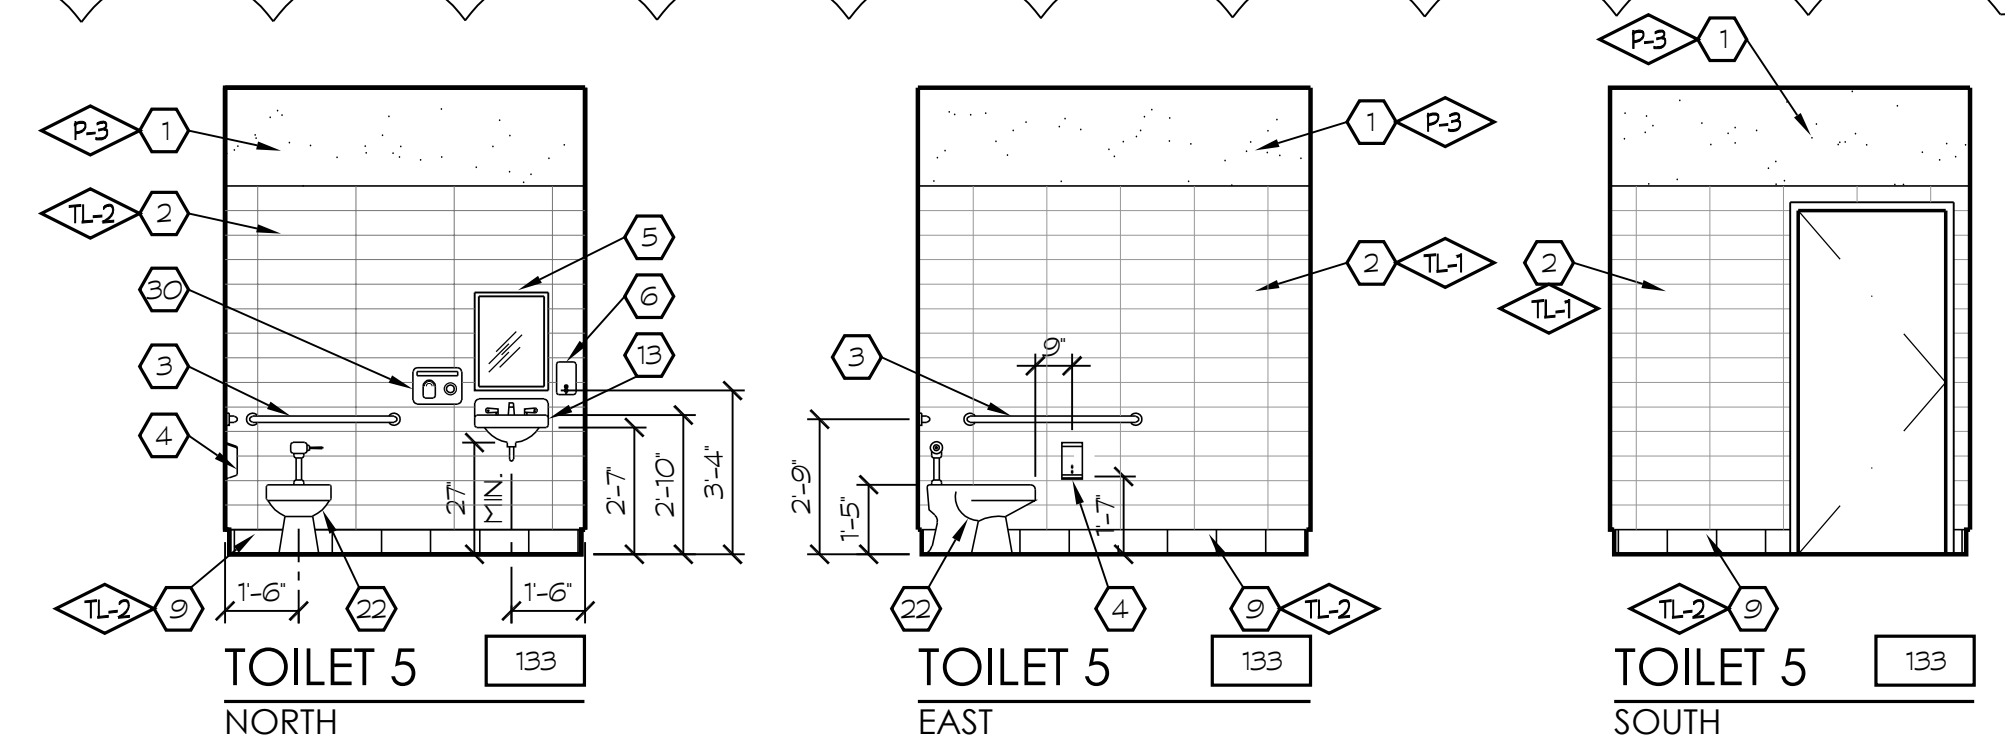


TOILET 5
NORTH

TOILET 5
EAST


TOILET 5
SOUTH

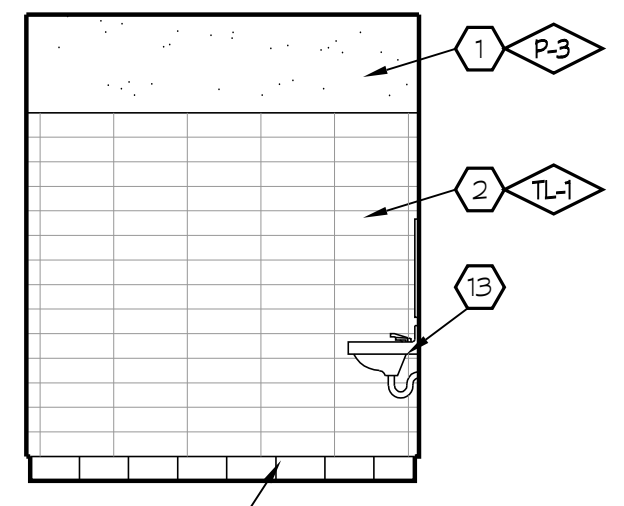

TOILET 5
WEST

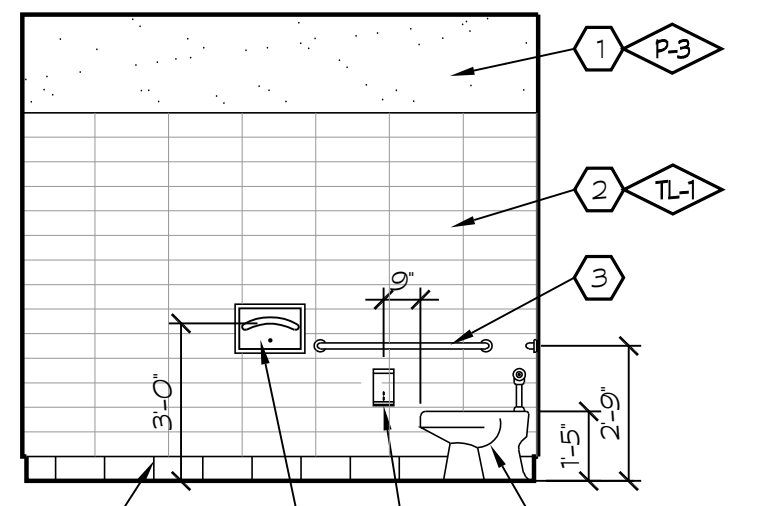


WOMEN'S RESTRM. 1
NORTH

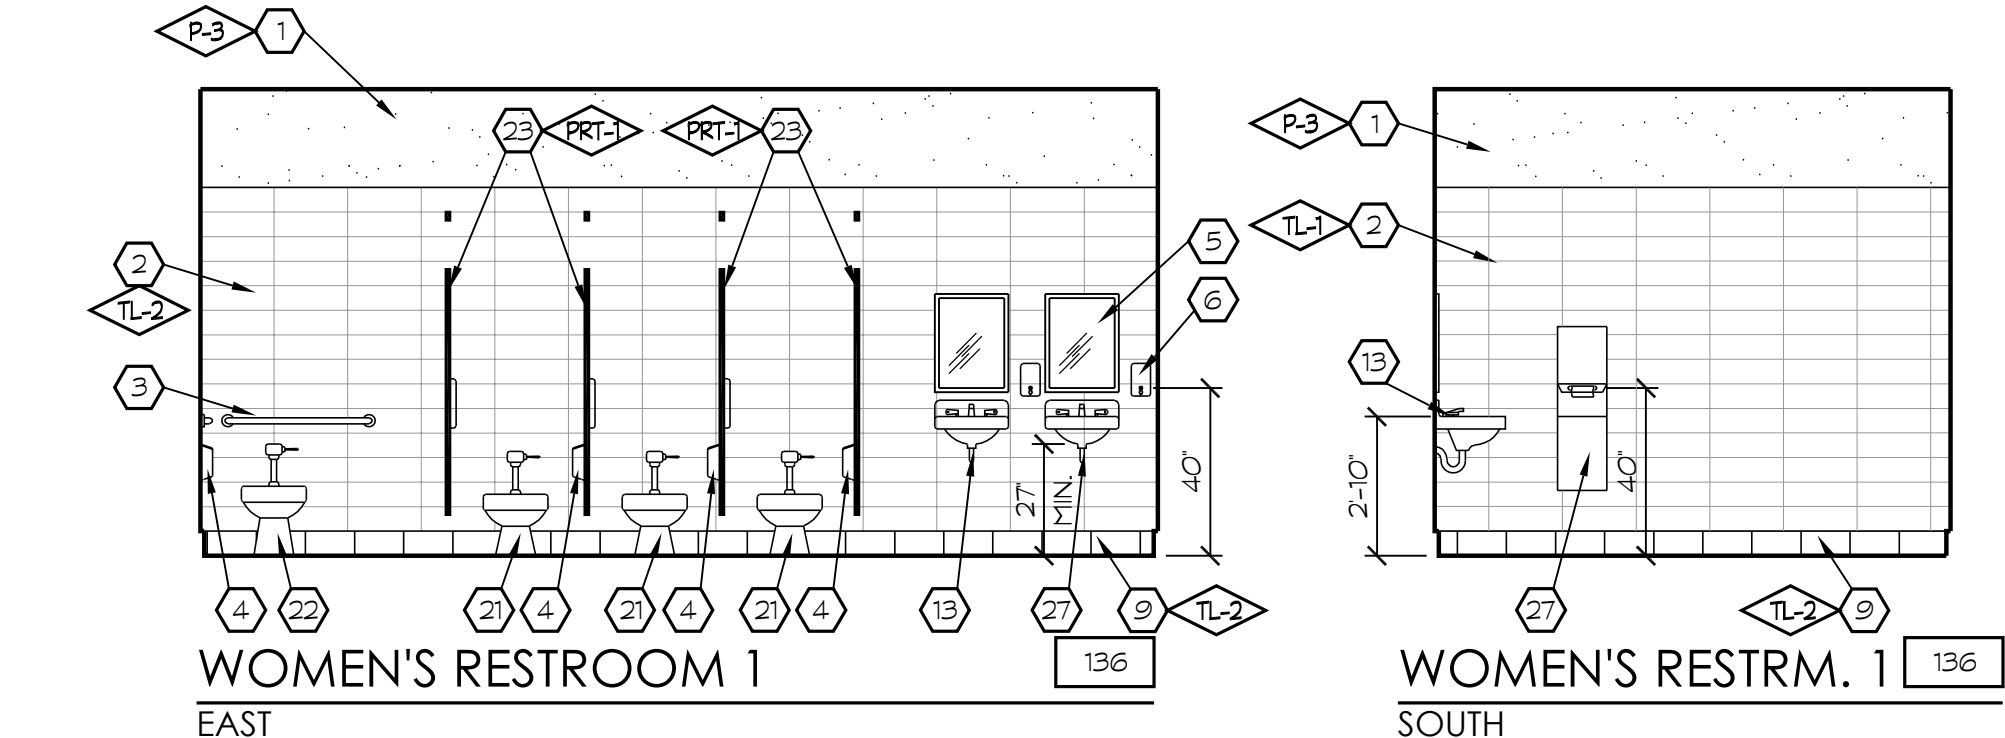

WOMEN'S RESTROOM 1
EAST

WOMEN'S RESTRM. 1
SOUTH

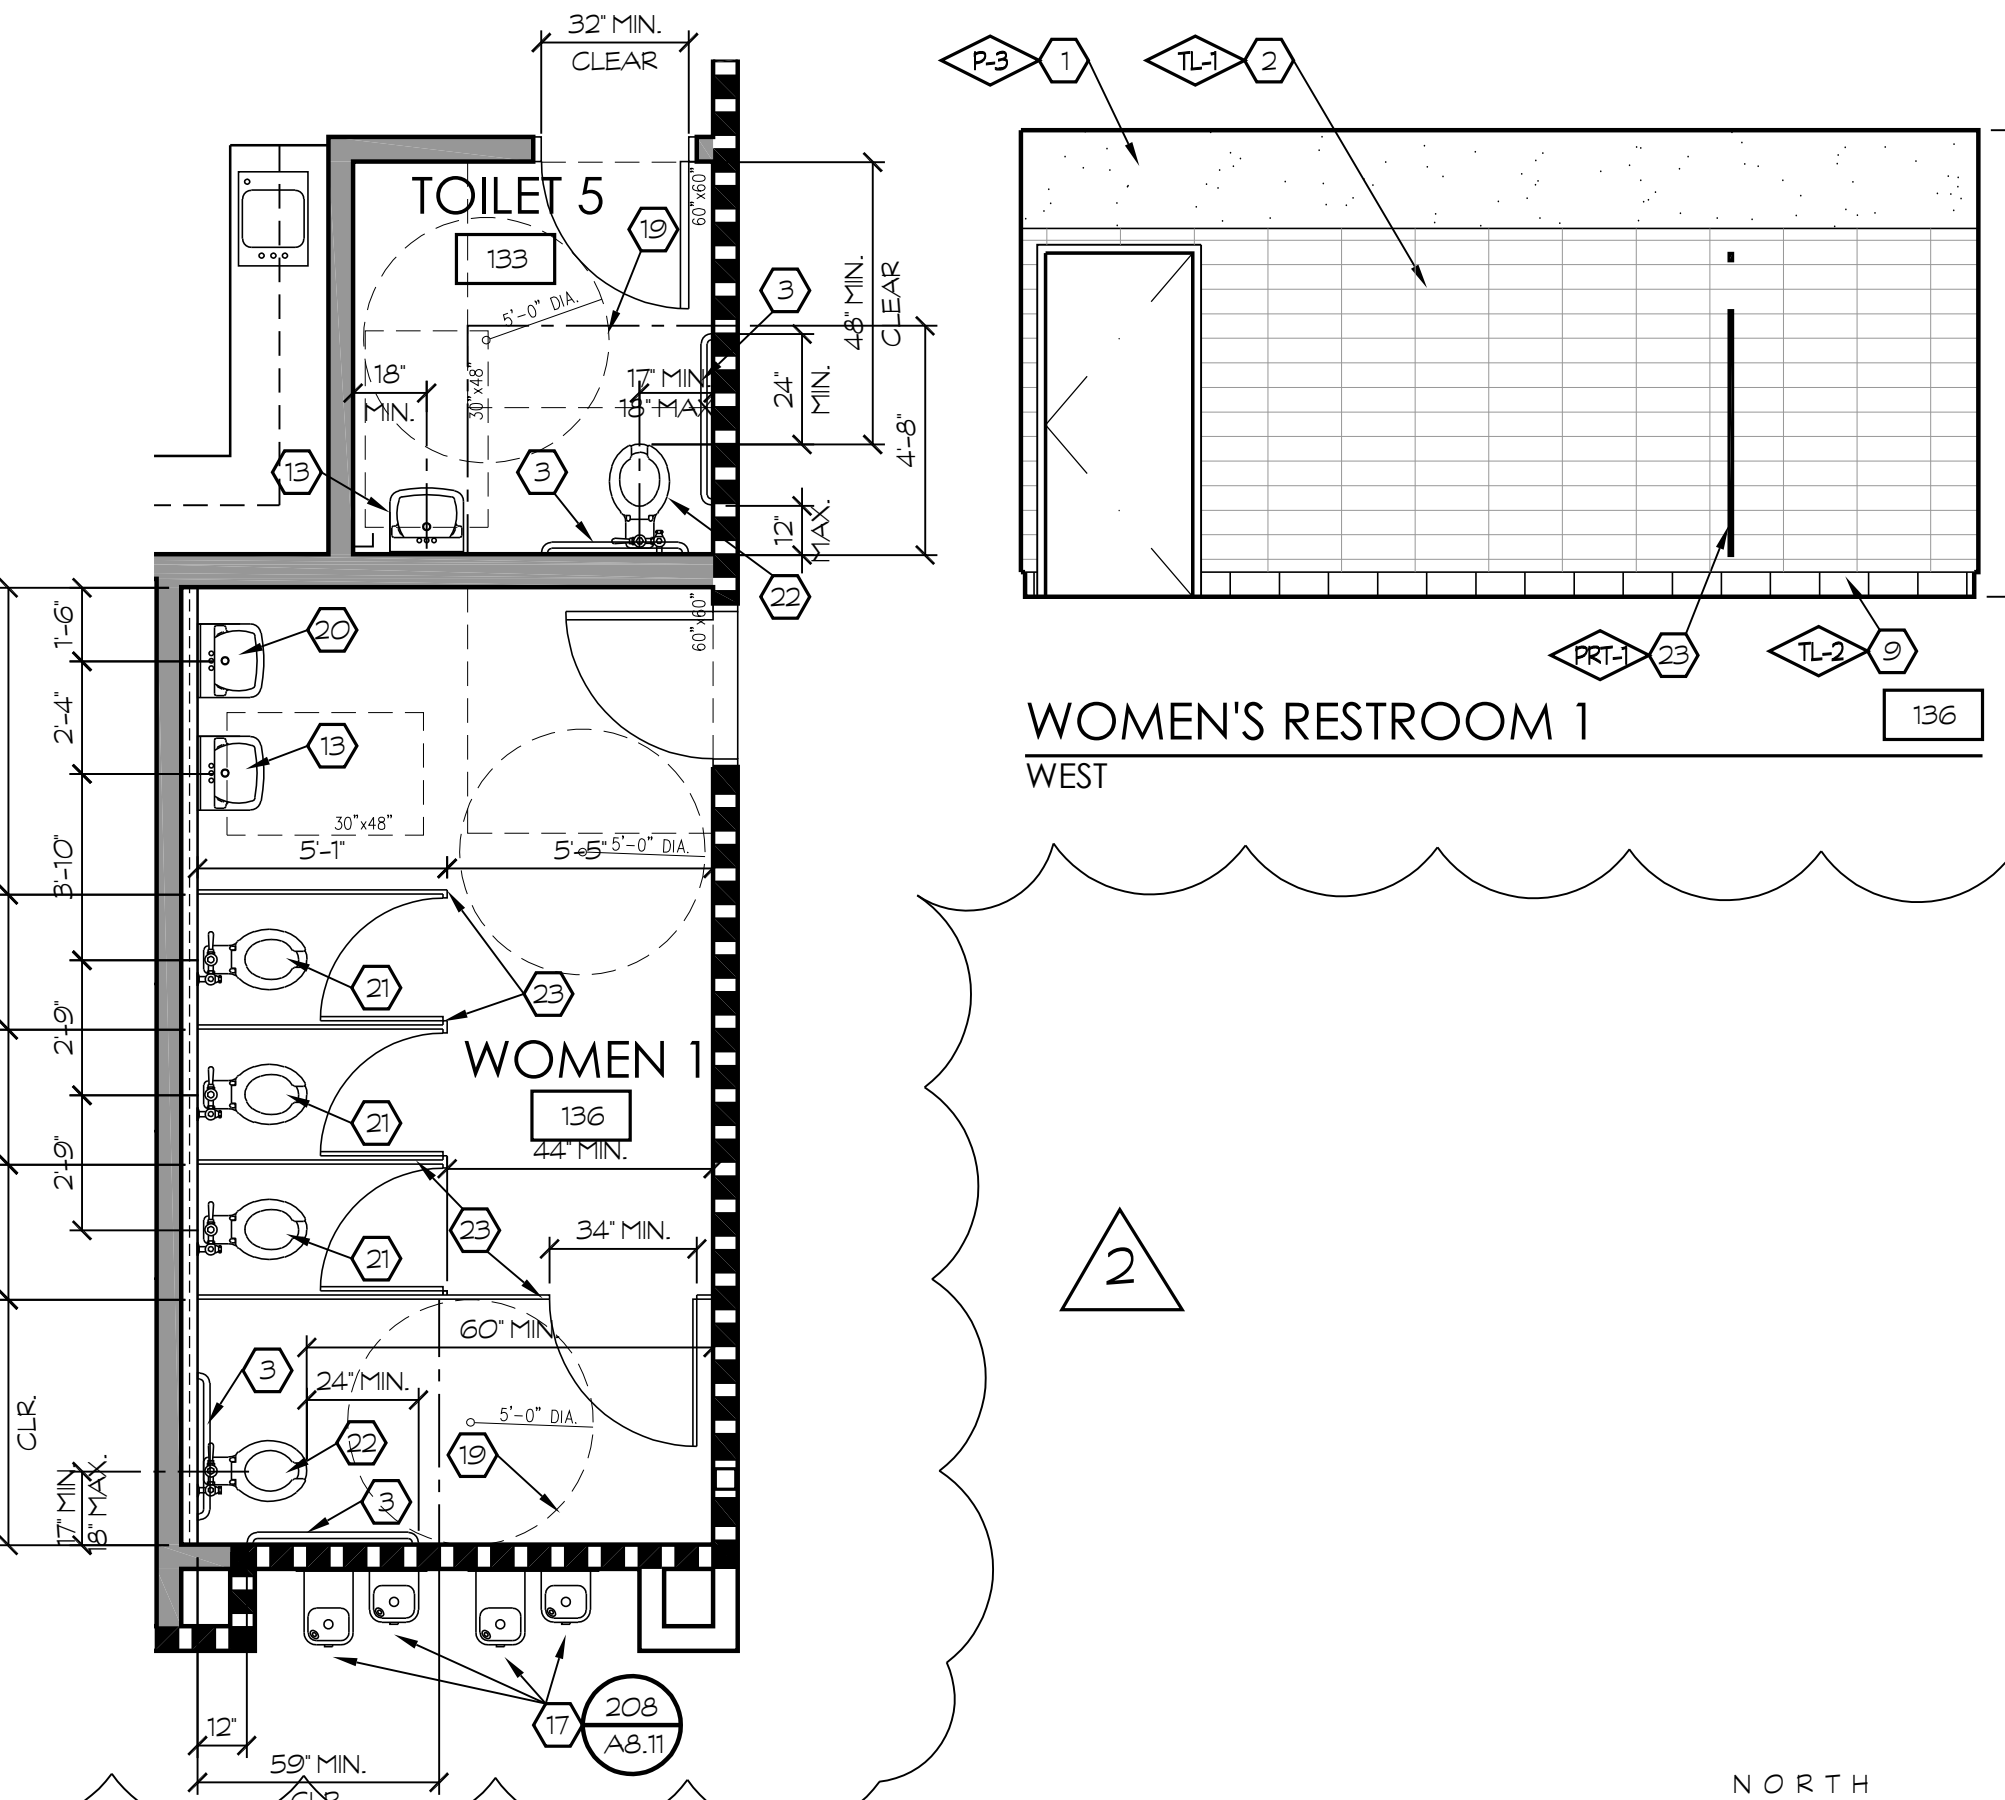


B RESTROOM FLOOR PLAN
ENLARGED FLOOR AND ELEVATIONS
SCALE: 1/4" = 1'-0"

KEYNOTES

- GYP. BD.
 - WALL TILE
 - GRAB BAR, SEE DTL. 210/A8.11
 - TOILET PAPER DISPENSER
 - MIRROR
 - SOAP DISPENSER
 - PAPER TOWEL DISPENSER
 - FRP
 - COVERED BASE - SEE FINISH SCHEDULE
 - BRILLE SIGNAGE - SEE DTL. 311/A8.17
 - ACCESSIBLE SIGNAGE - SEE DTL. 217/A8.11
 - HAND WASH LAV
 - ACCESSIBLE LAVATORY
 - VINYL TACKBOARD, SEE DTL. 112/A8.6
 - RUBBER TOPSET BASE
 - CASEWORK - SEE INTERIOR ELEVATIONS
 - DRINKING FOUNTAIN
 - GUARDRAIL/HANDRAIL
 - 5'-0" DIA. ACCESSIBLE TURNING RADIUS
 - STANDARD LAVATORY
 - STANDARD TOILET
 - ACCESSIBLE TOILET
 - PARTITIONS
 - STANDARD URINAL
 - ACCESSIBLE URINAL
 - FOLD DOWN CHANGING TABLE, SEE DETAIL 184/A8.10 & SPEC. SECTION 10811
 - TOILET SEAT COVER DISPENSER
 - PRIMARY LAVATORY
 - ROOF ACCESS LADDER
 - ELECTRIC HAND DRYER
- NOTE: 1. SEE DTL. 219/A8.11 FOR ACCESSIBILITY STANDARDS
2. ALL SHELVING WITH SPANS GREATER THAN 30" TO BE 1" THICK
3. REFER TO COLOR SCHEDULE (SHEET A2.8) FOR ALL COLOR REFERENCES, TYP.


SYMBOL LEGEND

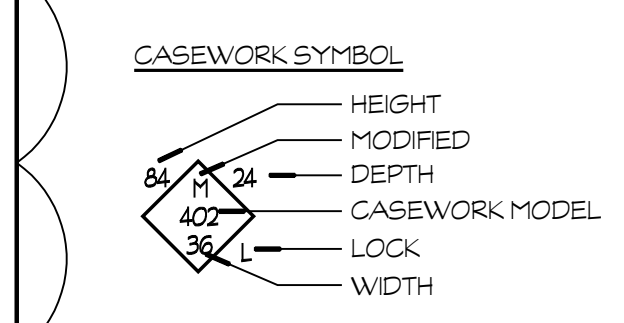

WALL LEGEND

- 2x6 METAL STUDS AT 16" O.C. w/R-19 INSULATION
EXT. SIDE: CEMENT PLASTER w/PAPER BACKED
WIRE LATH w/1/2" DENS. GLASS GOLD
INTERIOR SIDE: SEE FINISH SCHEDULE
 - 2x6 METAL STUDS AT 16" O.C. w/SOUND BATT
INSULATION - SEE FINISH SCHEDULE
 - 2x6 METAL STUDS AT 16" O.C. 42" HIGH w/PAINTED
WOOD CAP - SEE FINISH SCHEDULE
 - 2x4 METAL STUDS AT 16" O.C. - SEE FINISH SCHEDULE
 - 1-HR WALL: 2x6 METAL STUDS AT 16" O.C. w/SOUND
BATT INSULATION - PROVIDE 5/8" TYPE X GYP. BD.
EACH SIDE (UL-H419) SEE DETAIL 102/A8.6
 - DOUBLE 2x4 18 GA METAL STUDS AT 16" O.C.
SEE FINISH SCHEDULE
 - 20" DIA. CONCRETE COLUMN, SEE DETAIL 60/A8.3
 - 8" x 8" x 16" CMU WALL - SEE DETAIL 51/A8.3
- NOTE: SEE STRUCT. FOR METAL STUD SIZES AND CONNECTIONS

KEY PLAN

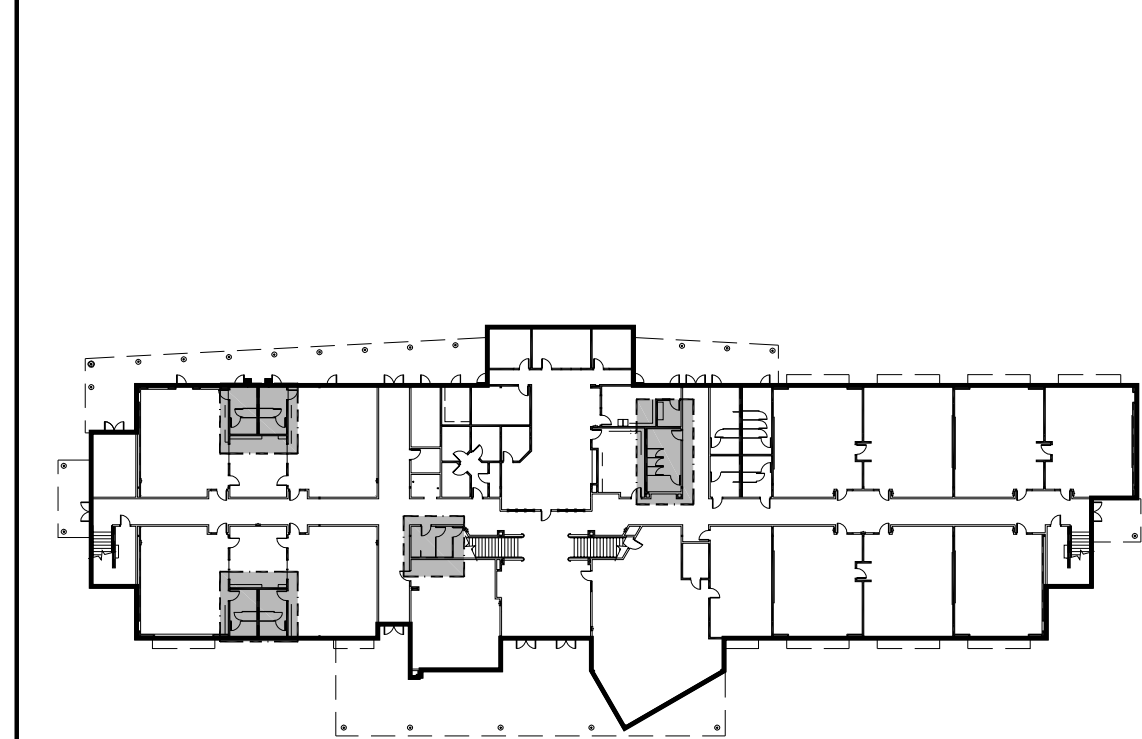


7790 NORTH PALM AVENUE
FRESNO, CALIFORNIA 93711
T 559.448.8400 F 559.448.8467
www.simprk.com

PROJECT:
**SHIELDS
& BRAWLEY
ELEMENTARY
SCHOOL**



**AD 2-08a
S&B Elementary
02-116800**

JOHN H. SMITH, A.I.A. C15885

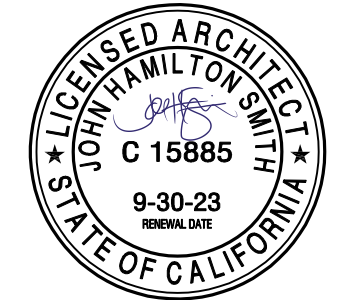

THE FIRM OF SMITH, MANAGA, MULLINS, ARCHITECTS, INC. EXPRESSLY RESERVES ITS
COPYRIGHT, TRADEMARK AND OTHER APPLICABLE PROPERTY RIGHTS IN THESE PLANS.
THESE PLANS ARE NOT TO BE REPRODUCED, CHANGED, OR COPIED IN ANY FORM OR
MANNER WITHOUT THE WRITTEN PERMISSION AND CONSENT OF THE ARCHITECT. IN THE
EVENT OF UNAUTHORIZED RELEASE OF THESE PLANS BY A THIRD PARTY, THE THIRD PARTY
SHALL HOLD THE ARCHITECT HARMLESS, AND SHALL BEAR THE COST OF THE ARCHITECT'S
LEGAL FEES, ASSOCIATED WITH DEFENDING AND ENFORCING THESE RIGHTS.

PROJECT DEVELOPMENT

| DATE | ISSUED FOR |
|------|------------|
| | |
| | |
| | |

REVISIONS

| No. | DATE | DESCRIPTION |
|-----|---------|------------------------|
| 1 | 2.14.23 | DISTRICT MODIFICATIONS |
| 2 | 2.27.23 | DISTRICT MODIFICATIONS |


SHEET DESCRIPTION

**ENLARGED
RESTROOM PLANS**

MAIN - 1ST FLOOR

| | |
|-----------------------------------|--------------------------|
| PROJECT COORDINATOR JOHN SMITH | SHEET NO. A1.4 |
| PROJECT NO. 17-67 | DATE 1.27.23 |
| SCALE 1/4"=1'-0" | |


S:\17-67_Shields & Brawley Elementary\17-67_A1.4_Enlarged RSP.dwg 05/20/18 21:12

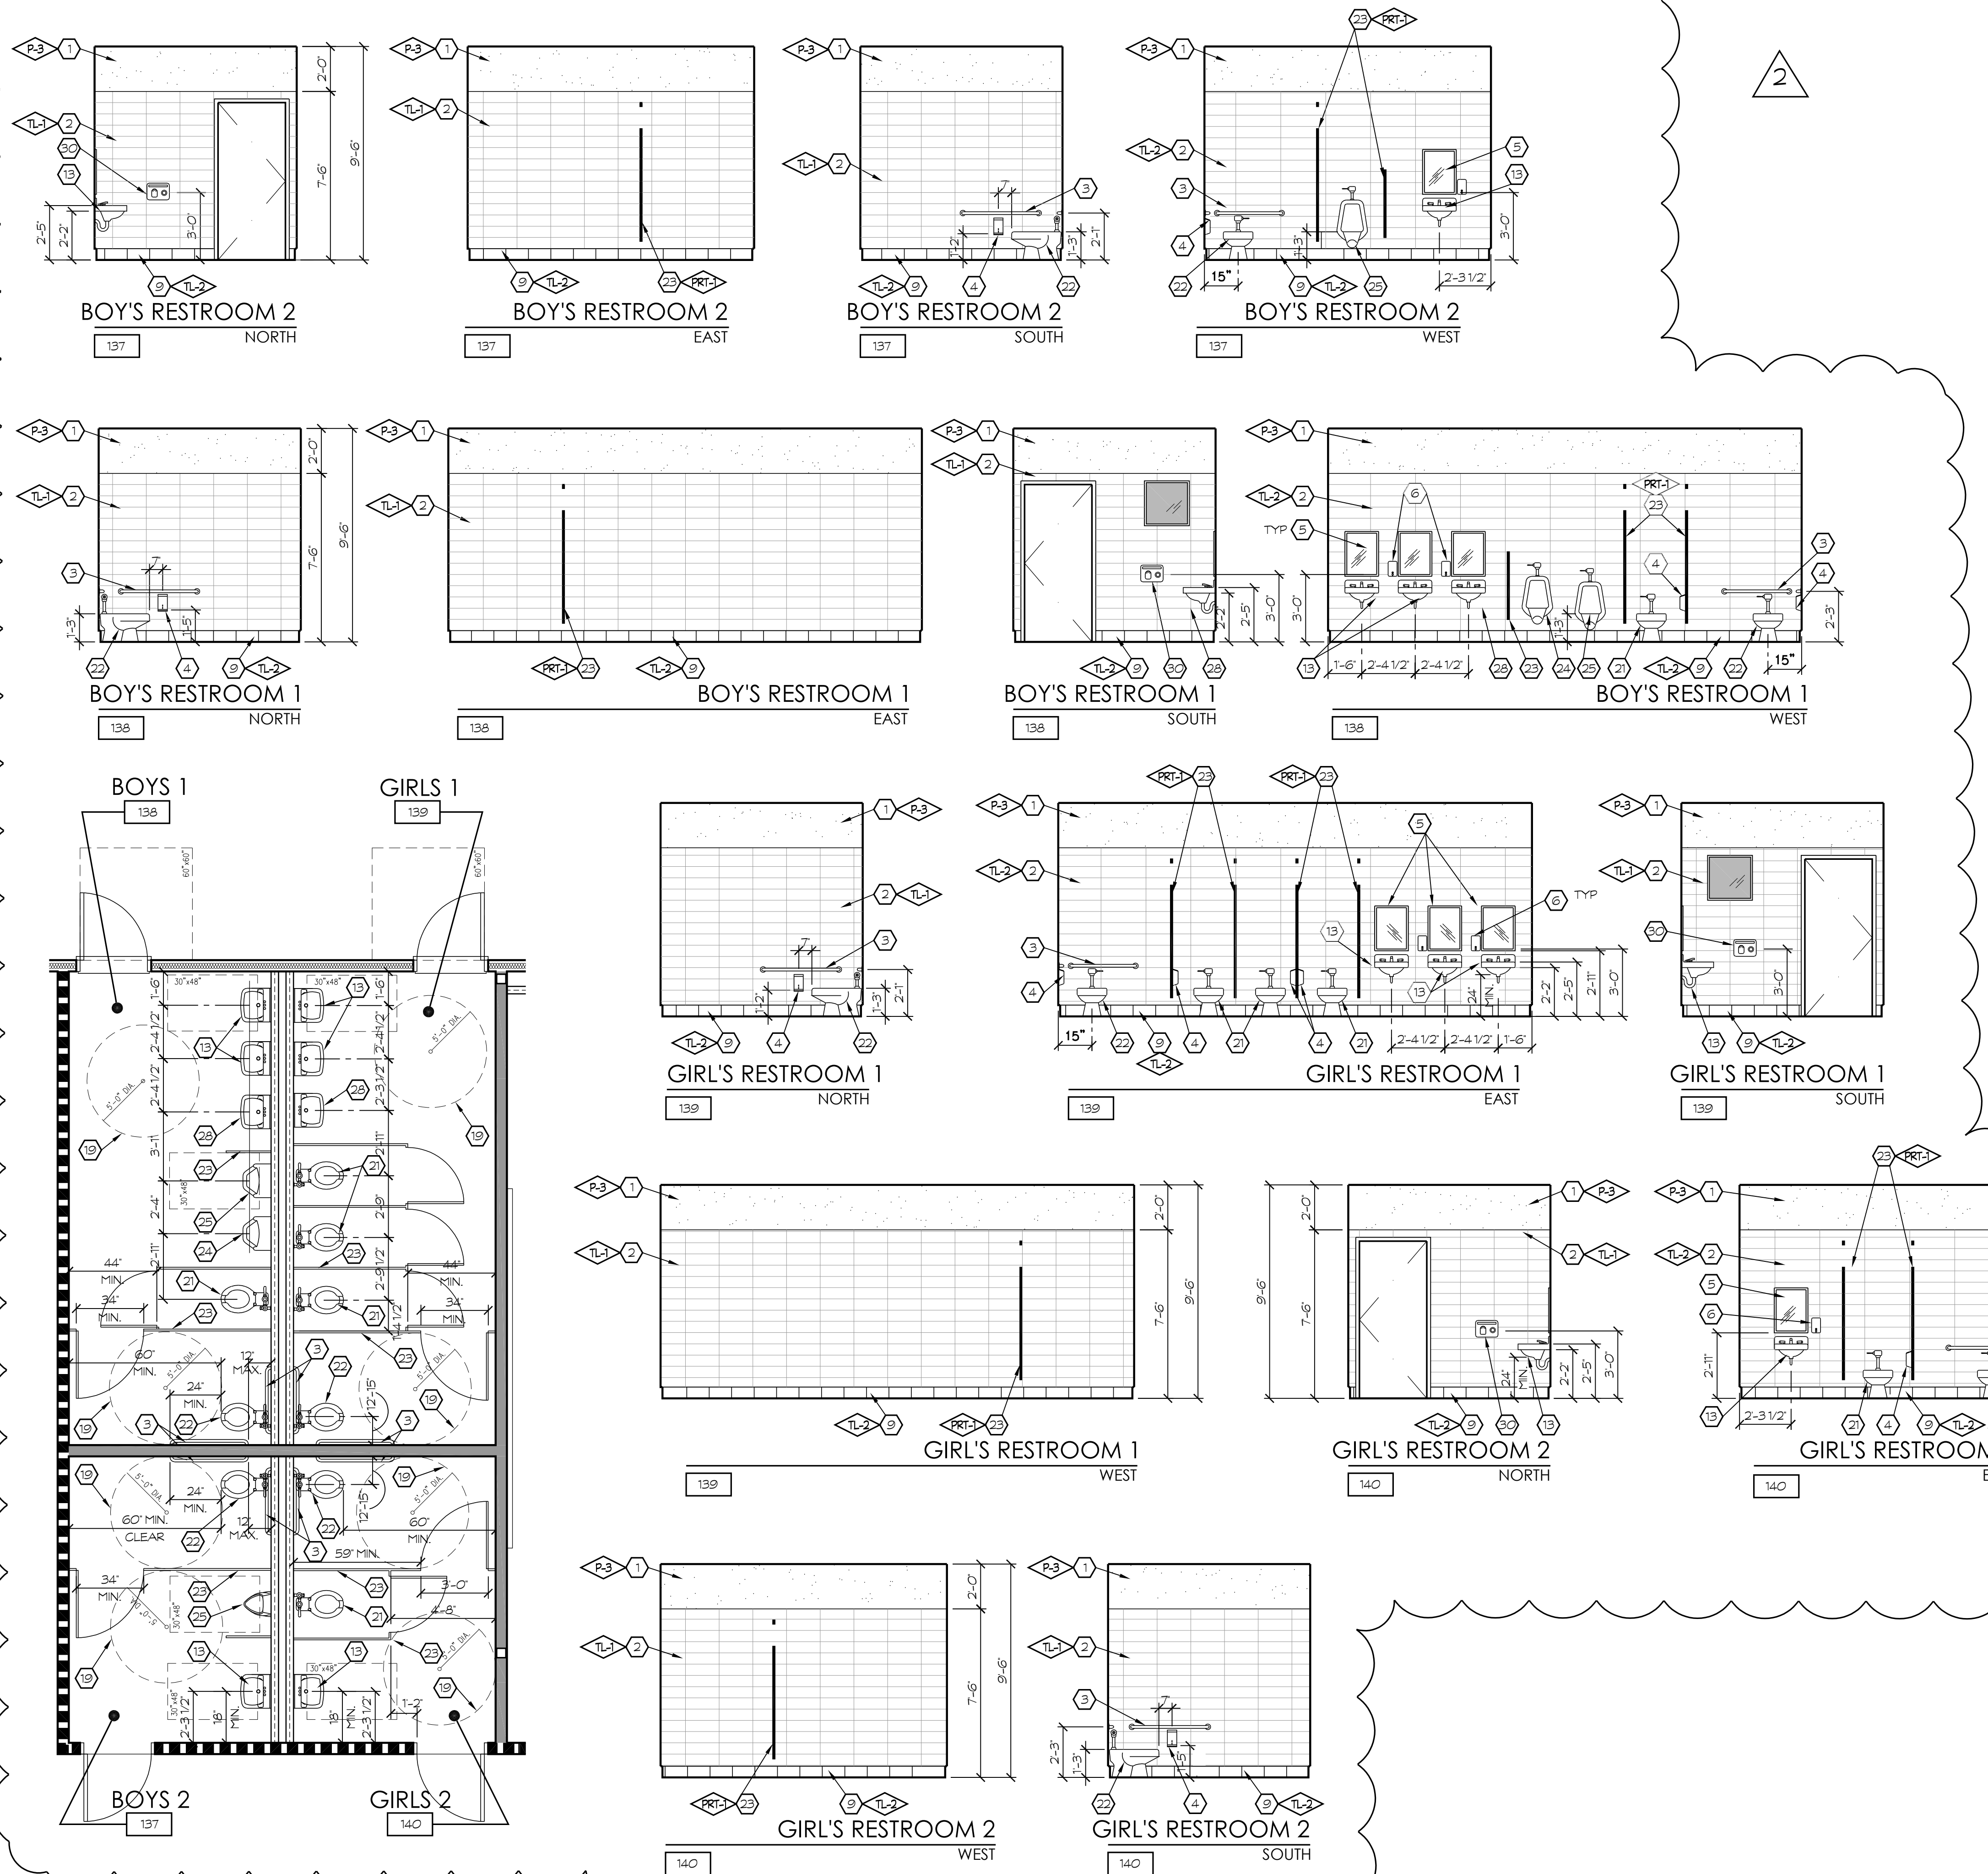

KEYNOTES

1. GYP. BD.
 2. WALL TILE
 3. GRAB BAR - SEE DTL. 210/A8.11
 4. TOILET PAPER DISPENSER
 5. MIRROR
 6. SOAP DISPENSER
 7. PAPER TOWEL DISPENSER
 8. FRP
 9. COVERED BASE - SEE FINISH SCHEDULE
 10. BRAILLE SIGNAGE - SEE DTL. 311/A8.17
 11. ACCESSIBLE SIGNAGE - SEE DTL. 217/A8.11
 12. HAND WASH LAV
 13. ACCESSIBLE LAVATORY
 14. VINYL TACKBOARD - SEE DTL. 112/A8.6
 15. RUBBER TOPSET BASE
 16. CASEWORK - SEE INTERIOR ELEVATIONS
 17. DRINKING FOUNTAIN
 18. GUARDRAIL/HANDRAIL
 19. 5'-0" DIA. ACCESSIBLE TURNING RADIUS
 20. STANDARD LAVATORY
 21. STANDARD TOILET
 22. ACCESSIBLE TOILET
 23. PARTITIONS
 24. STANDARD URINAL
 25. ACCESSIBLE URINAL
 26. FOLD DOWN CHANGING TABLE - SEE DETAIL 184/A8.10 & SPEC. SECTION 10811
 27. TOILET SEAT COVER DISPENSER
 28. PRIMARY LAVATORY
 29. ROOF ACCESS LADDER
 30. ELECTRIC HAND DRYER
- NOTE: 1. SEE DTL. 219/A8.11 FOR ACCESSIBILITY STANDARDS
 2. ALL SHELVING WITH SPANS GREATER THAN 30" TO BE 1" THICK
 3. REFER TO COLOR SCHEDULE (SHEET A2.8) FOR ALL COLOR REFERENCES, TYP.


SYMBOL LEGEND

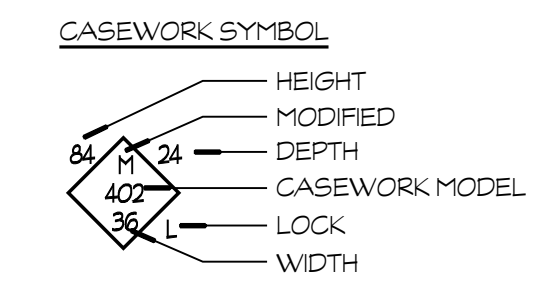

WALL LEGEND

- 2x6 METAL STUDS AT 16" O.C. w/ R-19 INSULATION EXT. SIDE, CEMENT PLASTER w/ PAPER BACKED WIRE LATH @ 1/2" DENS. GLAS GOLD INTERIOR SIDE - SEE FINISH SCHEDULE
 - 2x6 METAL STUDS AT 16" O.C. w/ SOUND BATT INSULATION - SEE FINISH SCHEDULE
 - 2x6 METAL STUDS AT 16" O.C. 42" HIGH w/ PAINTED WOOD CAP - SEE FINISH SCHEDULE
 - 2x4 METAL STUDS AT 16" O.C. - SEE FINISH SCHEDULE
 - 1-HR WALL: 2x6 METAL STUDS AT 16" O.C. w/ SOUND BATT INSULATION - PROVIDE 5/8" TYPE 'X' GYP. BD. EACH SIDE (UL #1419) SEE DETAIL 102/A8.6
 - DOUBLE 2x4 18 GA METAL STUDS AT 16" O.C. SEE FINISH SCHEDULE
 - 20" DIA. CONCRETE COLUMN, SEE DETAIL 60/A8.3
 - 8" x 8" x 16" CMU WALL - SEE DETAIL 51/A8.3
- NOTE: SEE STRUCT. FOR METAL STUD SIZES AND CONNECTIONS

KEY PLAN

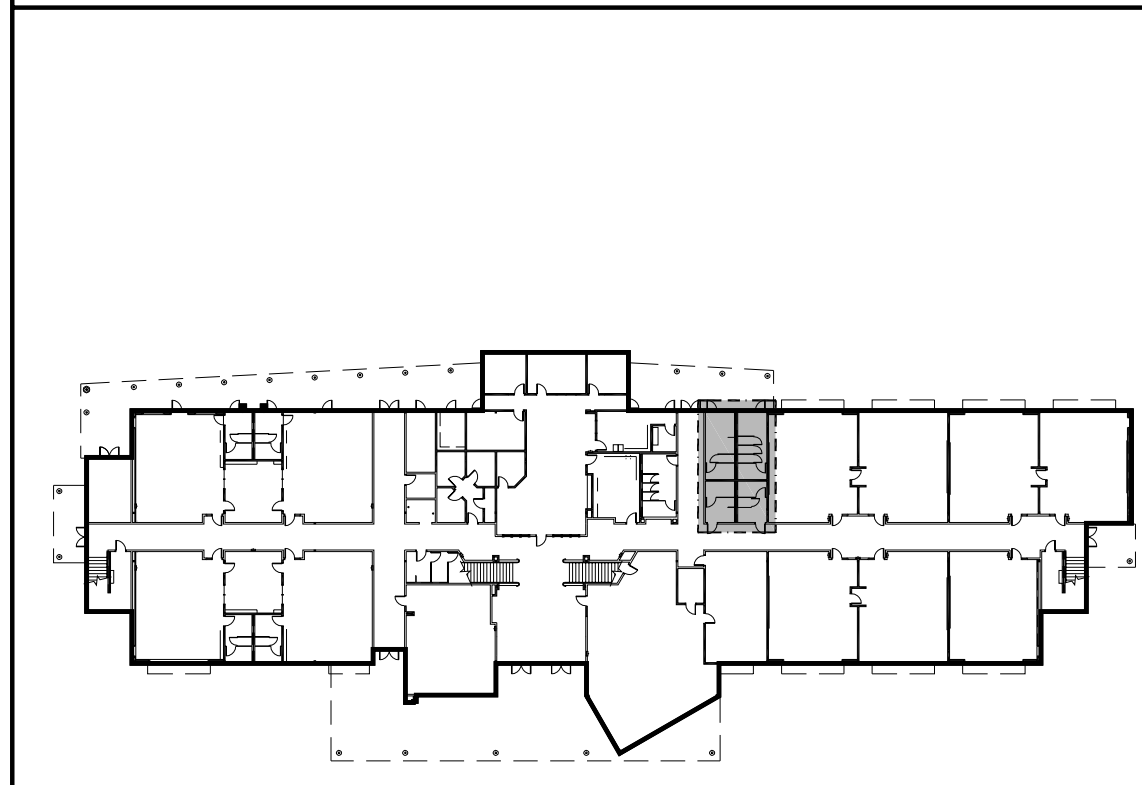

PROJECT:
SHIELDS & BRAWLEY ELEMENTARY SCHOOL



AD 2-09a
S&B Elementary
02-116800



THE FIRM OF SMITH, WANAGAN, MILHOUS, ARCHITECTS, INC. EXPRESSLY RESERVES ITS COMMON LAW COPYRIGHT AND OTHER APPLICABLE PROPERTY RIGHTS IN THESE PLANS. THESE PLANS ARE NOT TO BE REPRODUCED, CHANGED, OR COPIED IN ANY FORM OR MANNER WHATSOEVER, NOR ARE THEY TO BE ASSIGNED TO A THIRD PARTY WITHOUT FIRST OBTAINING THE WRITTEN PERMISSION AND CONSENT OF THE ARCHITECT. IN THE EVENT OF UNAUTHORIZED REUSE OF THESE PLANS BY A THIRD PARTY, THE THIRD PARTY SHALL HOLD THE ARCHITECT HARMLESS, AND SHALL BEAR THE COST OF THE ARCHITECT'S LEGAL FEES, ASSOCIATED WITH DEFENDING AND ENFORCING THESE RIGHTS.

PROJECT DEVELOPMENT

| DATE | ISSUED FOR |
|------|------------|
| | |
| | |
| | |

REVISIONS


| No. | DATE | DESCRIPTION |
|-----|---------|------------------------|
| △ | 2.14.23 | DISTRICT MODIFICATIONS |
| △ | 2.27.23 | DISTRICT MODIFICATIONS |

SHEET DESCRIPTION

ENLARGED RESTROOM PLANS

MAIN - 1ST FLOOR


| | |
|-----------------------------------|-------------|
| PROJECT COORDINATOR JOHN SMITH | SHEET No. |
| PROJECT NO. 17-67 | A1.5 |
| DATE 1.27.23 | |
| SCALE | |

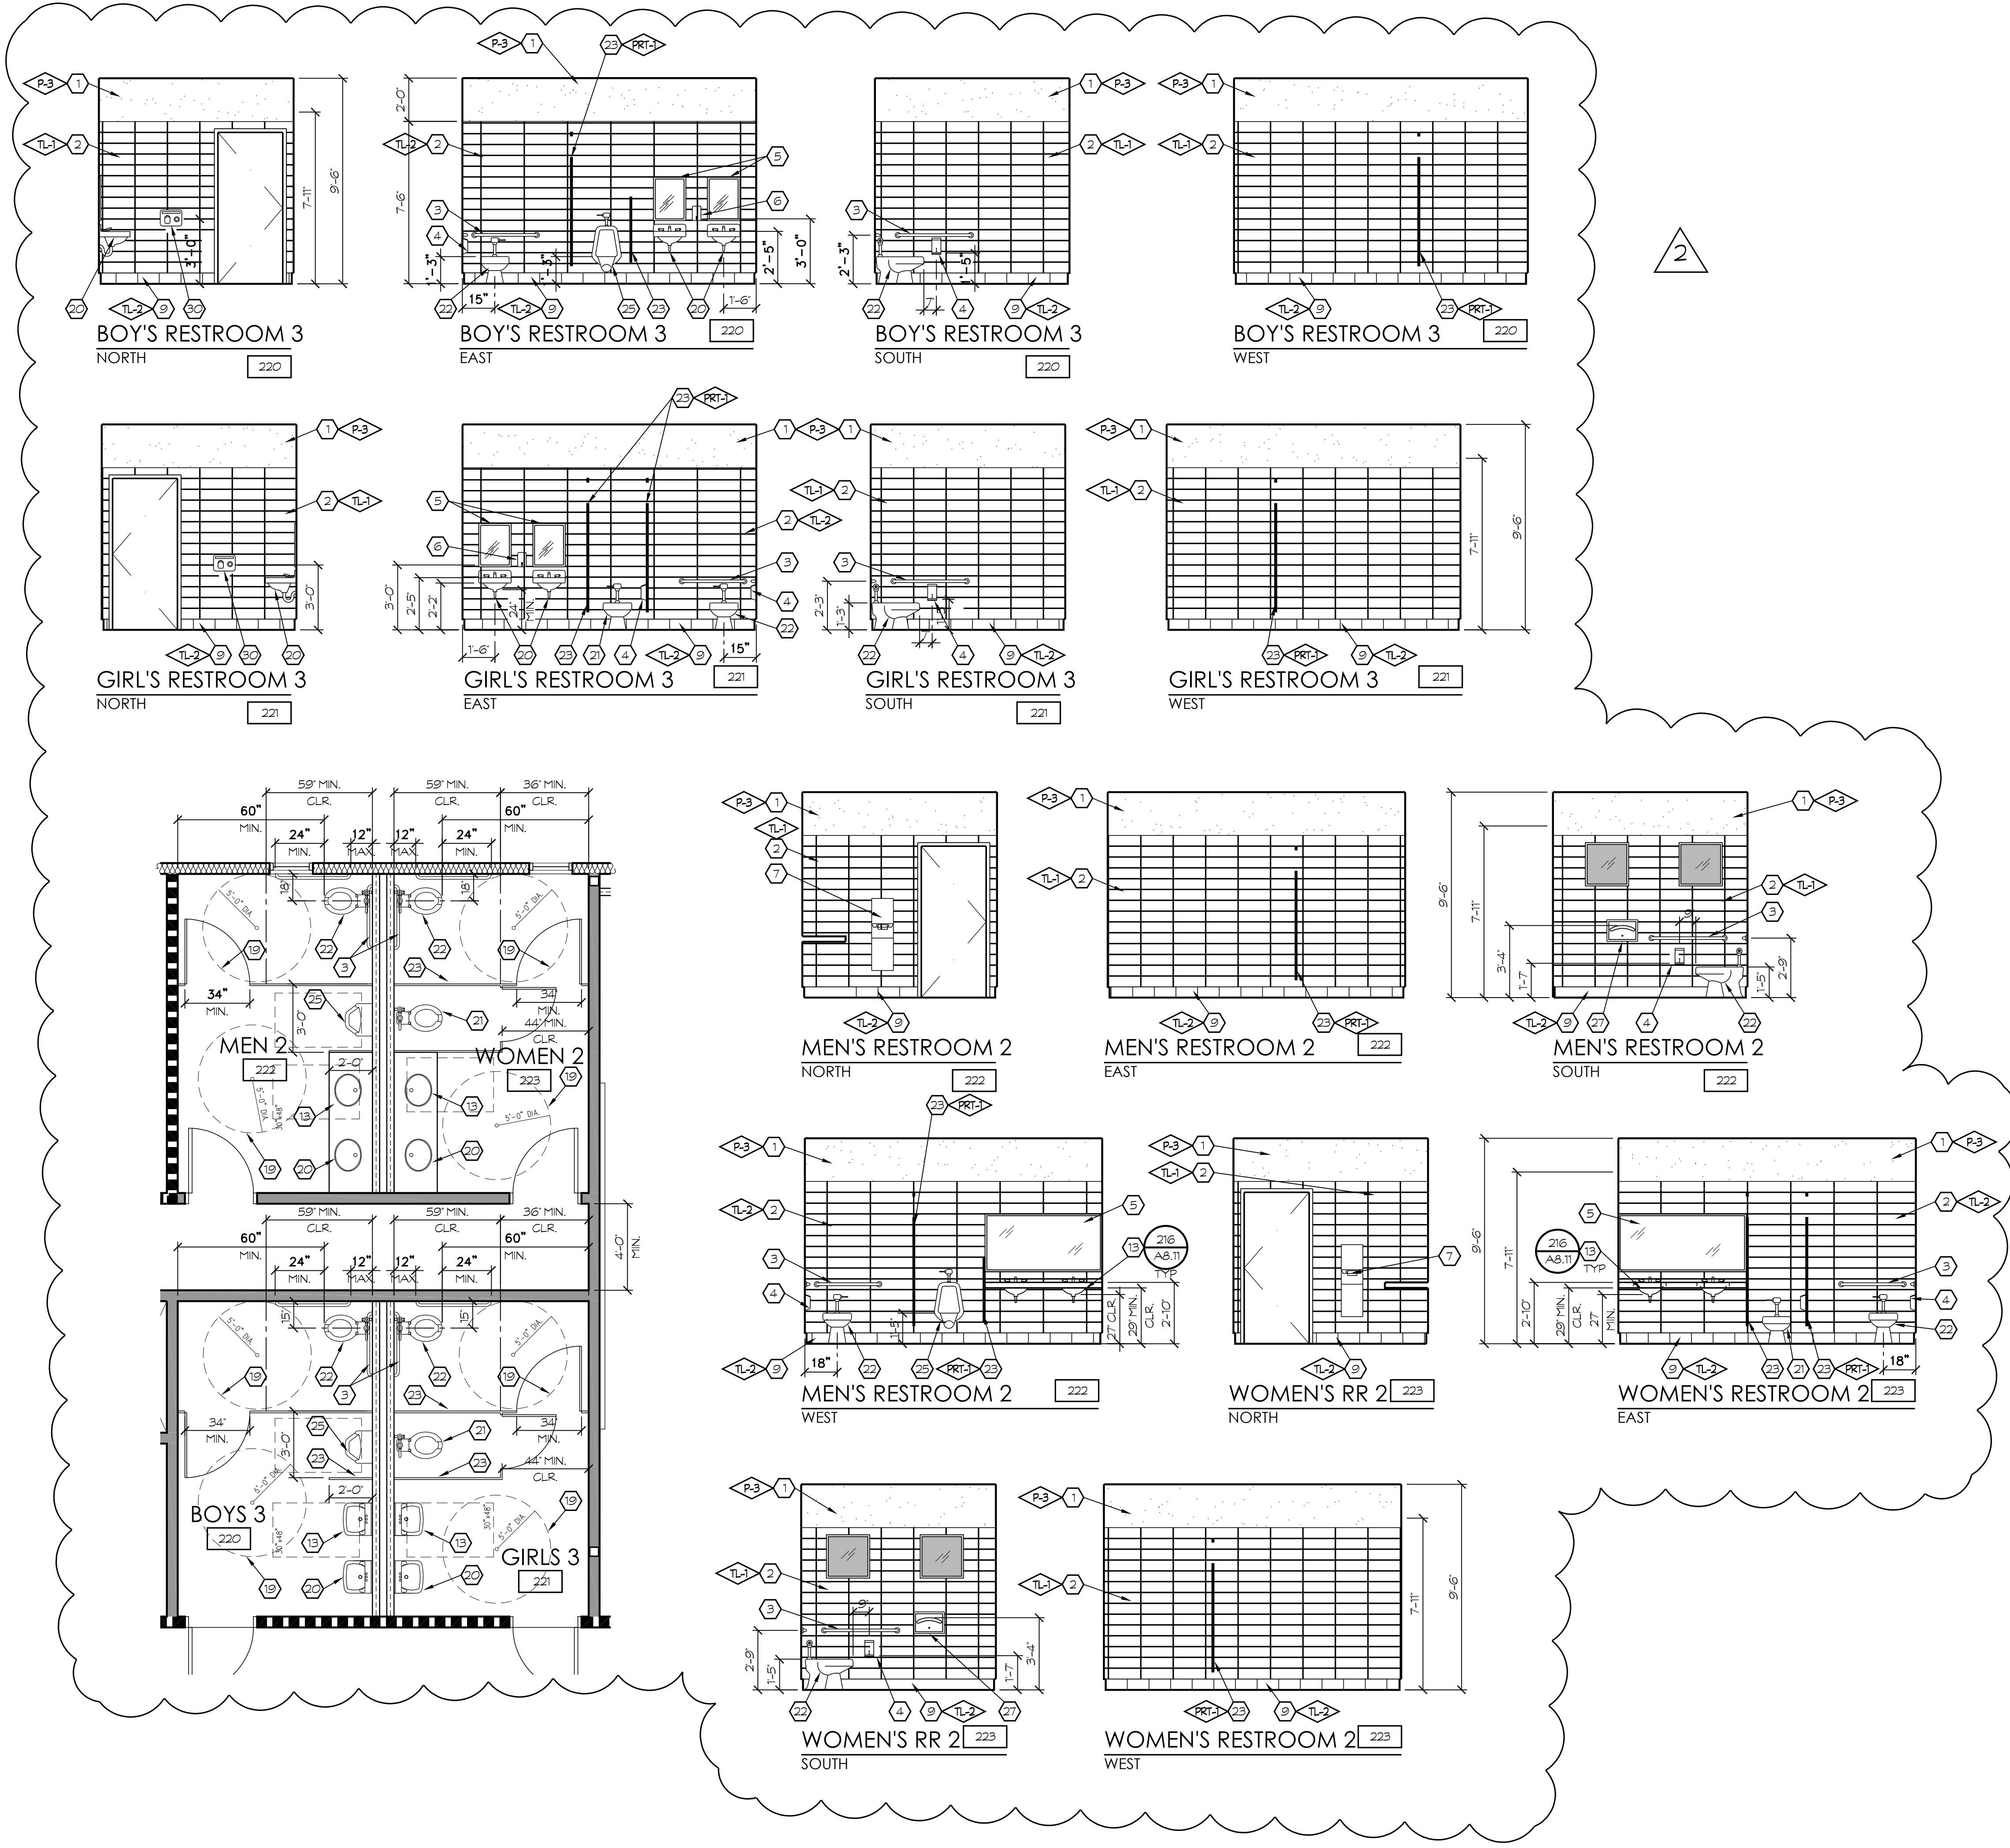

KEYNOTES

1. GYP. BD.
 2. WALL TILE
 3. GRAB BAR, SEE DTL. 210/A8.11
 4. TOILET PAPER DISPENSER
 5. MIRROR
 6. SOAP DISPENSER
 7. PAPER TOWEL DISPENSER
 8. FRP
 9. COVED BASE - SEE FINISH SCHEDULE
 10. BRAILLE SIGNAGE - SEE DTL. 311/A8.17
 11. ACCESSIBLE SIGNAGE - SEE DTL. 217/A8.11
 12. HAND WASH LAV
 13. ACCESSIBLE LAVATORY
 14. VINYL TACKBOARD, SEE DTL. 112/A8.6
 15. RUBBER TOPSET BASE
 16. CASEWORK - SEE INTERIOR ELEVATIONS
 17. DRINKING FOUNTAIN
 18. GUARDRAIL/HANDRAIL
 19. 5'-0" DIA. ACCESSIBLE TURNING RADIUS
 20. STANDARD LAVATORY
 21. STANDARD TOILET
 22. ACCESSIBLE TOILET
 23. PARTITIONS
 24. STANDARD URINAL
 25. ACCESSIBLE URINAL
 26. FOLD DOWN CHANGING TABLE, SEE DETAIL 184/A8.10 & SPEC. SECTION 10811
 27. TOILET SEAT COVER DISPENSER
 28. PRIMARY LAVATORY
 29. ROOF ACCESS LADDER
 30. ELECTRIC HAND DRYER
- NOTE: 1. SEE DTL. 219/A8.11 FOR ACCESSIBILITY STANDARDS
 2. ALL SHELVING WITH SPANS GREATER THAN 30" TO BE 1" THICK
 3. REFER TO COLOR SCHEDULE (SHEET A2.8) FOR ALL COLOR REFERENCES, TYP.


SYMBOL LEGEND

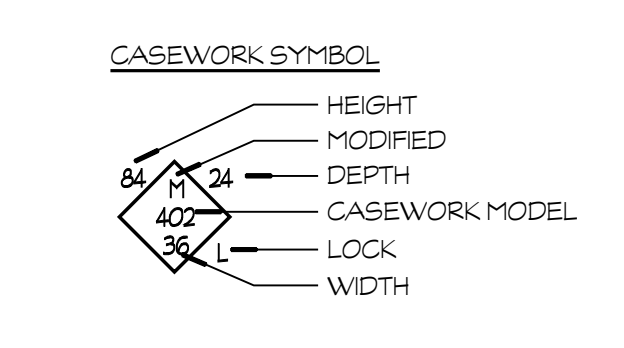

WALL LEGEND

- 2x6 METAL STUDS AT 16" O.C. w/ R-19 INSULATION
EXT. SIDE: CEMENT PLASTER or PAPER BACKED WIRE LATH or 1/2" DENS. GLAS GOLD
INTERIOR SIDE: SEE FINISH SCHEDULE
 - 2x6 METAL STUDS AT 16" O.C. w/ SOUND BATT INSULATION - SEE FINISH SCHEDULE
 - 2x6 METAL STUDS AT 16" O.C. 42" HIGH w/ PAINTED WOOD CAP - SEE FINISH SCHEDULE
 - 2x4 METAL STUDS AT 16" O.C. - SEE FINISH SCHEDULE
 - 1-HR WALL: 2x6 METAL STUDS AT 16" O.C. w/ SOUND BATT INSULATION - PROVIDE 5/8" TYPE 'X' GYP. BD. EACH SIDE (JL #U419) SEE DETAIL 102/A8.6
 - DOUBLE 2x4 18 GA METAL STUDS AT 16" O.C. SEE FINISH SCHEDULE
 - 20" DIA. CONCRETE COLUMN, SEE DETAIL 60/A8.3
 - 8" x 8" x 16" CMU WALL - SEE DETAIL 51/A8.3
- NOTE: SEE STRUCT. FOR METAL STUD SIZES AND CONNECTIONS

KEY PLAN

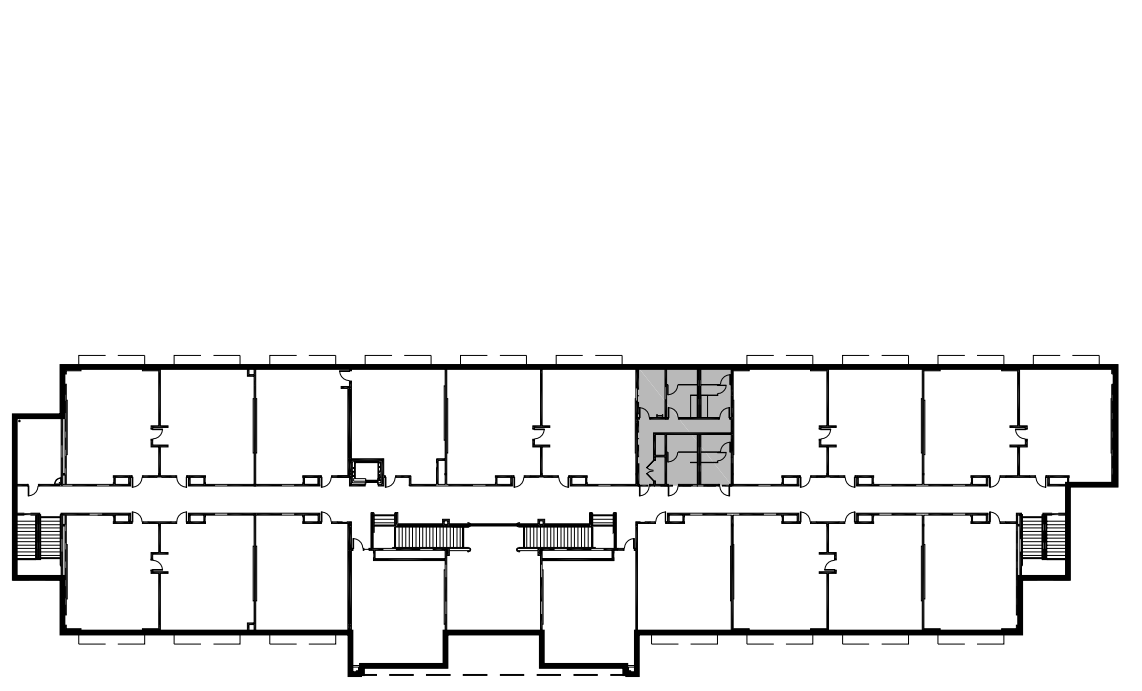


7790 NORTH PALM AVENUE
 FRESNO, CALIFORNIA 93711
 T559.448.8400 · F559.448.8467
 www.sim-prbk.com

PROJECT:
SHIELDS & BRAWLEY ELEMENTARY SCHOOL



AD 2-10a
S&B Elementary
02-116800

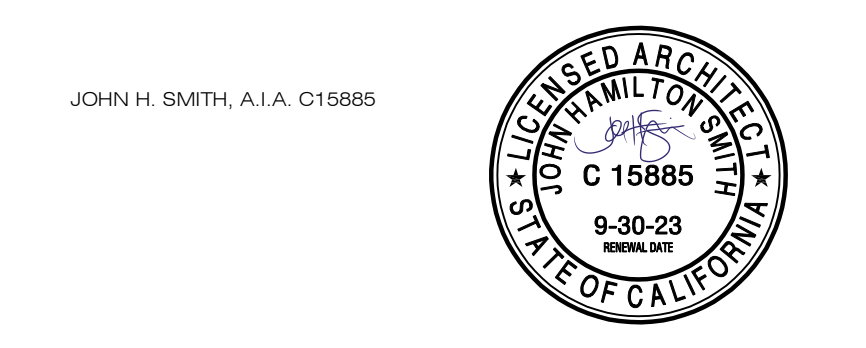

THE FIRM OF SMITH, IWANAGA, MILHOUS, ARCHITECTS, INC. EXPRESSLY RESERVES ITS COMMON LAW COPYRIGHT AND OTHER APPLICABLE PROPERTY RIGHTS IN THESE PLANS. THESE PLANS ARE NOT TO BE REPRODUCED, CHANGED, OR COPIED IN ANY FORM OR MANNER WHATSOEVER NOR ARE THEY TO BE ASSIGNED TO A THIRD PARTY WITHOUT FIRST OBTAINING THE WRITTEN PERMISSION AND CONSENT OF THE ARCHITECT. IN THE EVENT OF UNAUTHORIZED REUSE OF THESE PLANS BY A THIRD PARTY, THE THIRD PARTY SHALL HOLD THE ARCHITECT HARMLESS, AND SHALL BEAR THE COST OF THE ARCHITECT'S LEGAL FEES, ASSOCIATED WITH DEFENDING AND ENFORCING THESE RIGHTS.

PROJECT DEVELOPMENT

| DATE | ISSUED FOR |
|------|------------|
| | |
| | |
| | |

REVISIONS

| No. | DATE | DESCRIPTION |
|-----|---------|------------------------|
| △ 1 | 2.14.23 | DISTRICT MODIFICATIONS |
| △ 2 | 2.27.23 | DISTRICT MODIFICATIONS |
| | | |
| | | |

SHEET DESCRIPTION


ENLARGED RESTROOM PLANS


MAIN - 2ND FLOOR

| | |
|-----------------------------------|--------------------------|
| PROJECT COORDINATOR JOHN SMITH | SHEET NO. A1.9 |
| PROJECT NO. 17-67 | |
| DATE 1.27.23 | |
| SCALE 1/4"=1'-0" | |


S:\17-67_Shields & Brawley_Elementary\Work\17-67_A1.9_Enlarged_RR.dwg 05/20/23 21:36

RESTROOM FLOOR PLAN
ENLARGED FLOOR AND ELEVATIONS

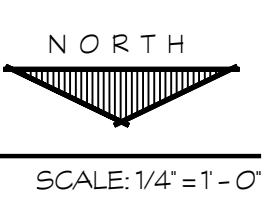


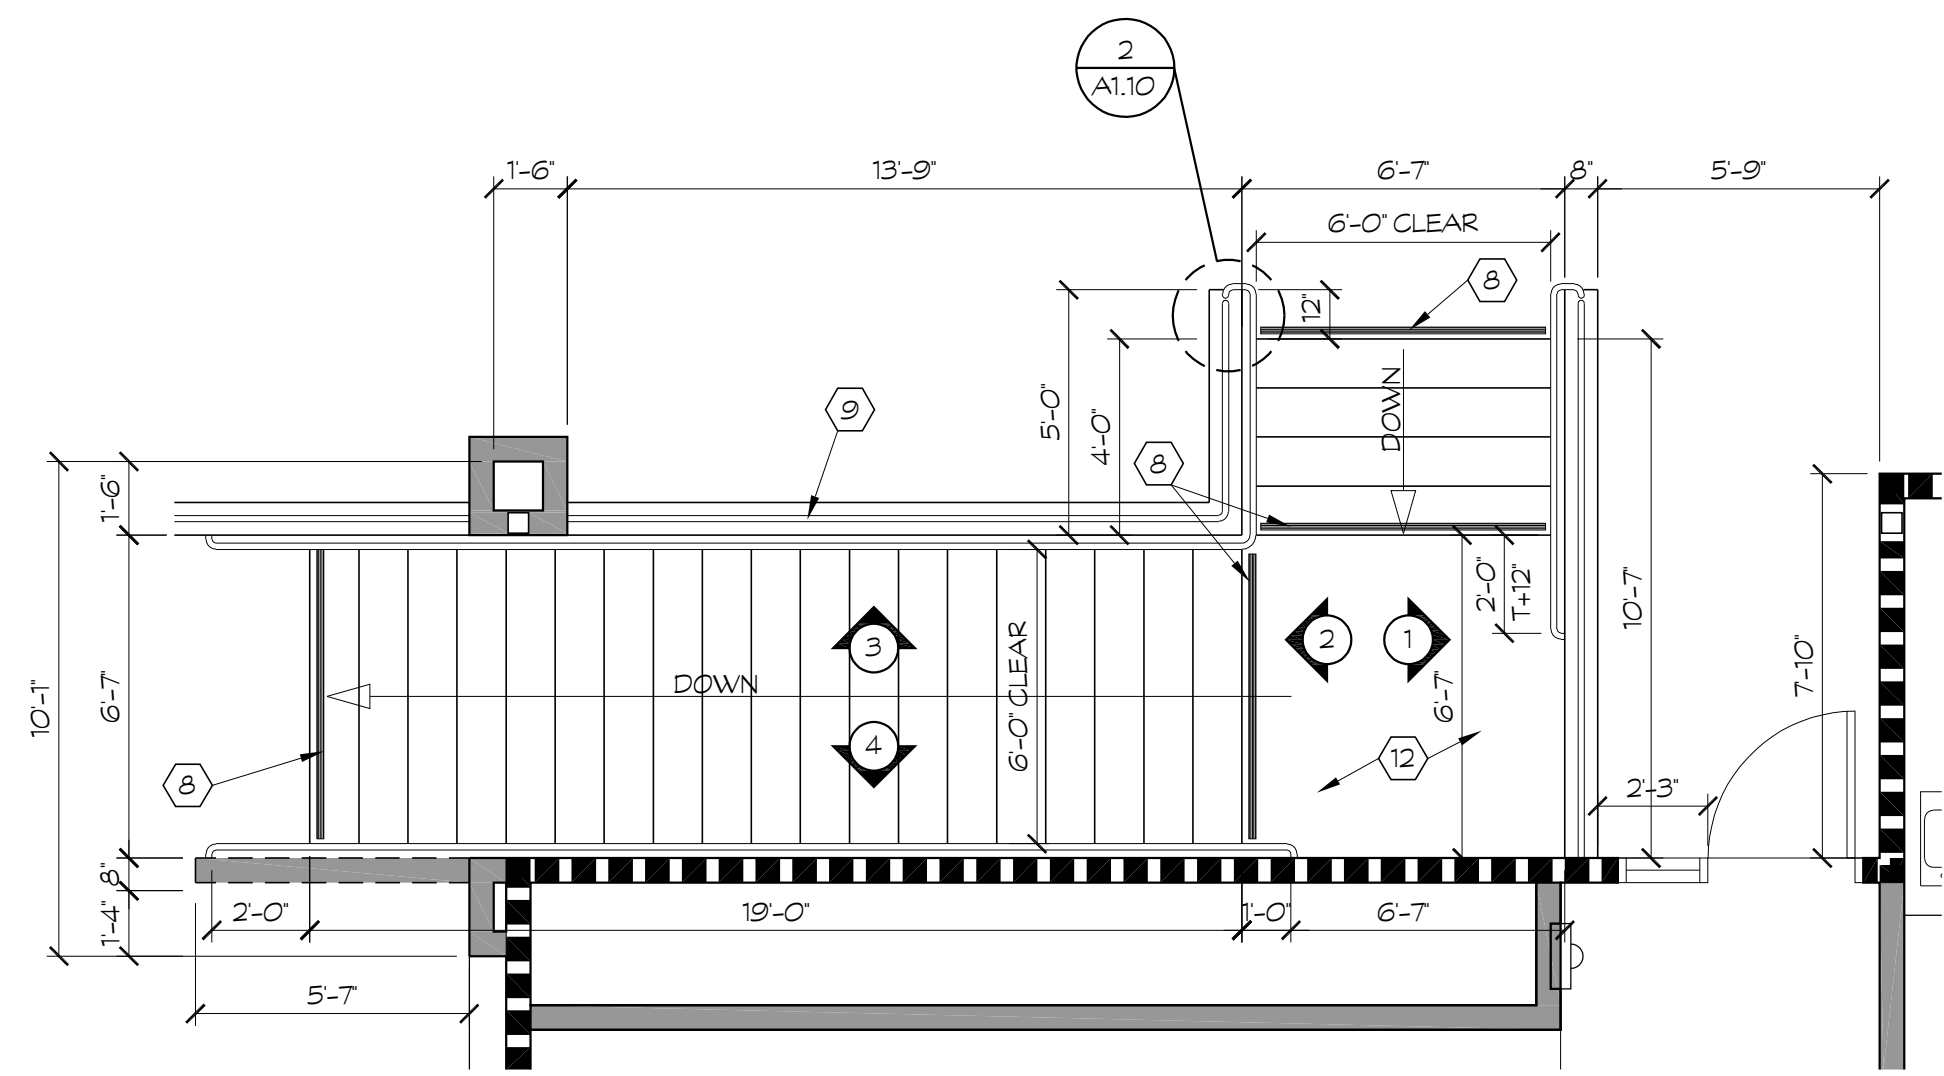


A ENLARGED STAIRS 1 @ 2nd FLOOR (VIEW)
 STAIRS 3 154 & 234 SIMILAR OPPOSITE
 SCALE: 1/4" = 1'-0"
 E:\17-67 Shields & Brawley Elementary\Work\17-67_A1.10_Enlarged Stairs.dwg 05/30/18 2:35

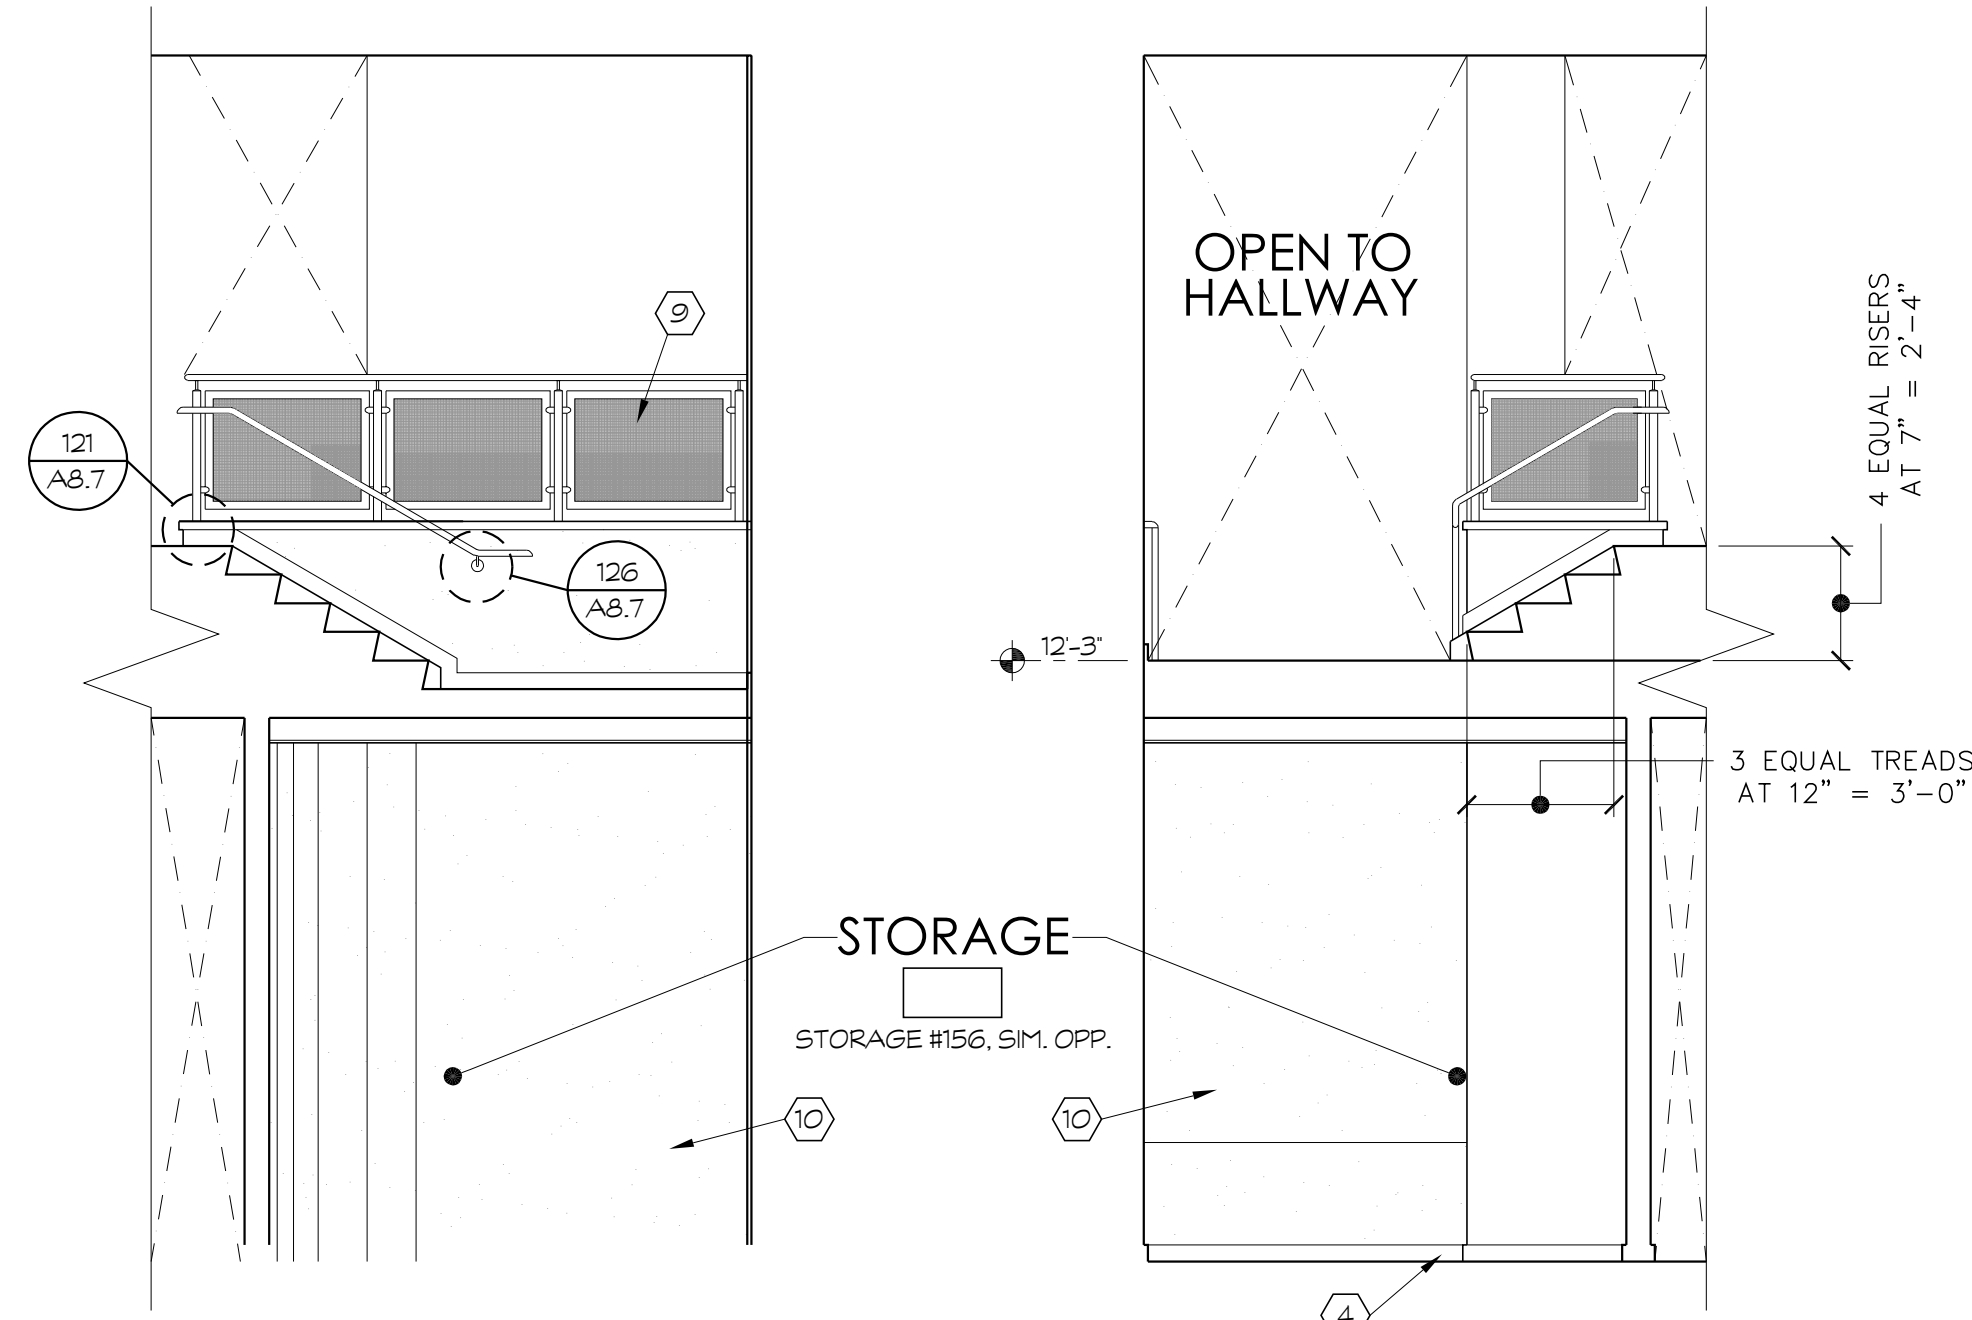




1 STAIRS 1 103 & 202
 STAIRS 3 154 & 234 SIM. OPP.
2 STAIRS 1 103 & 202
 STAIRS 3 154 & 234 SIM. OPP.

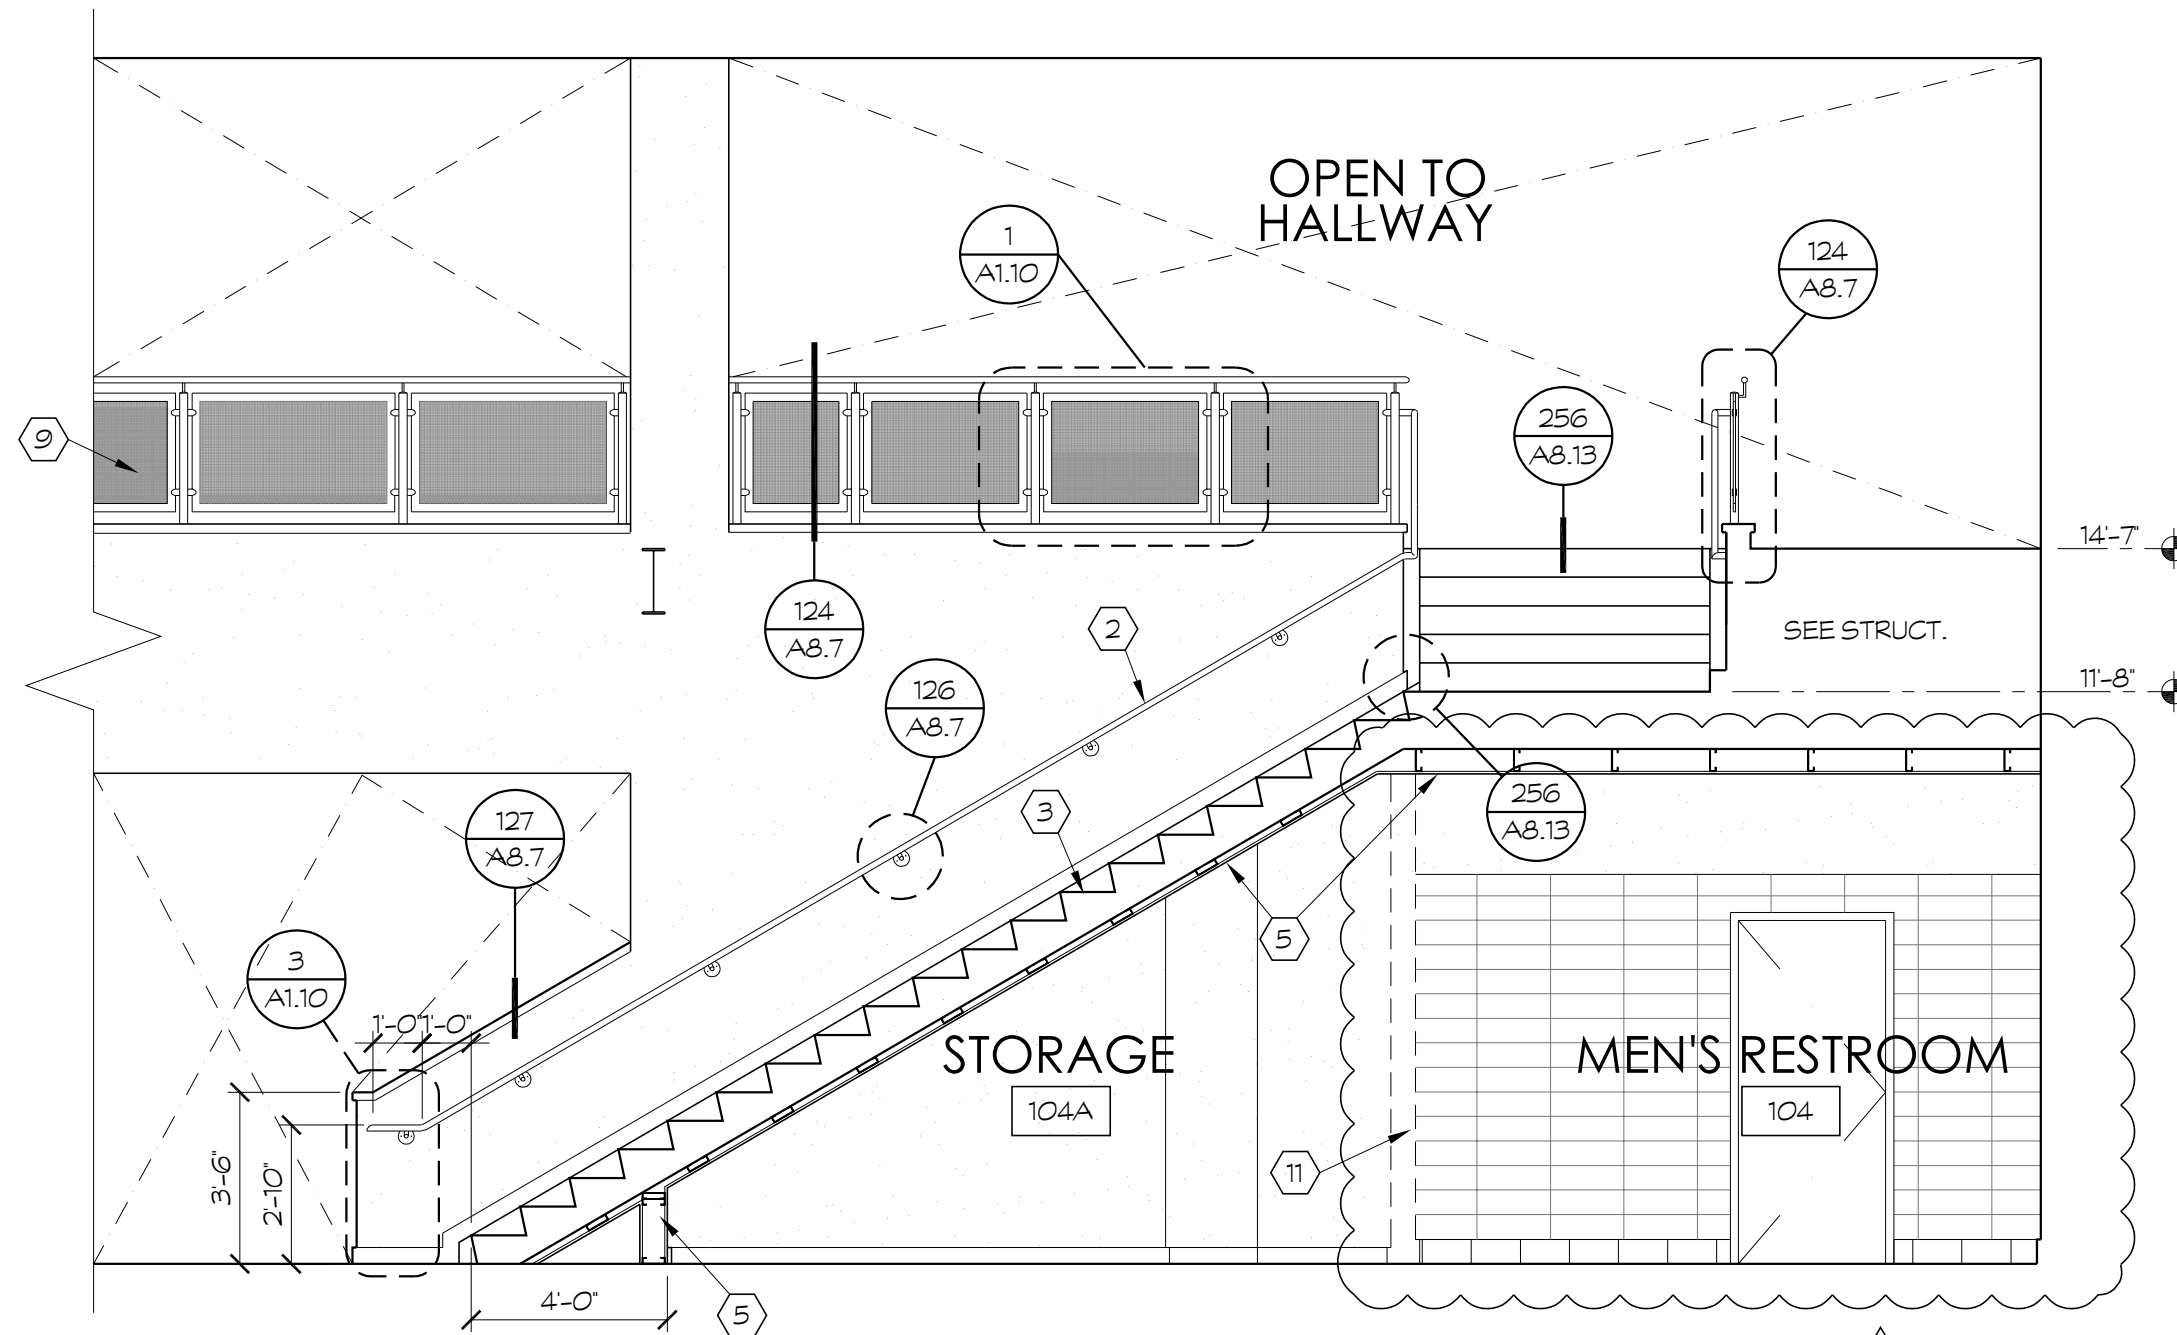

3 STAIRS 1 103 & 202
 STAIRS 3 154 & 234 SIMILAR OPPOSITE

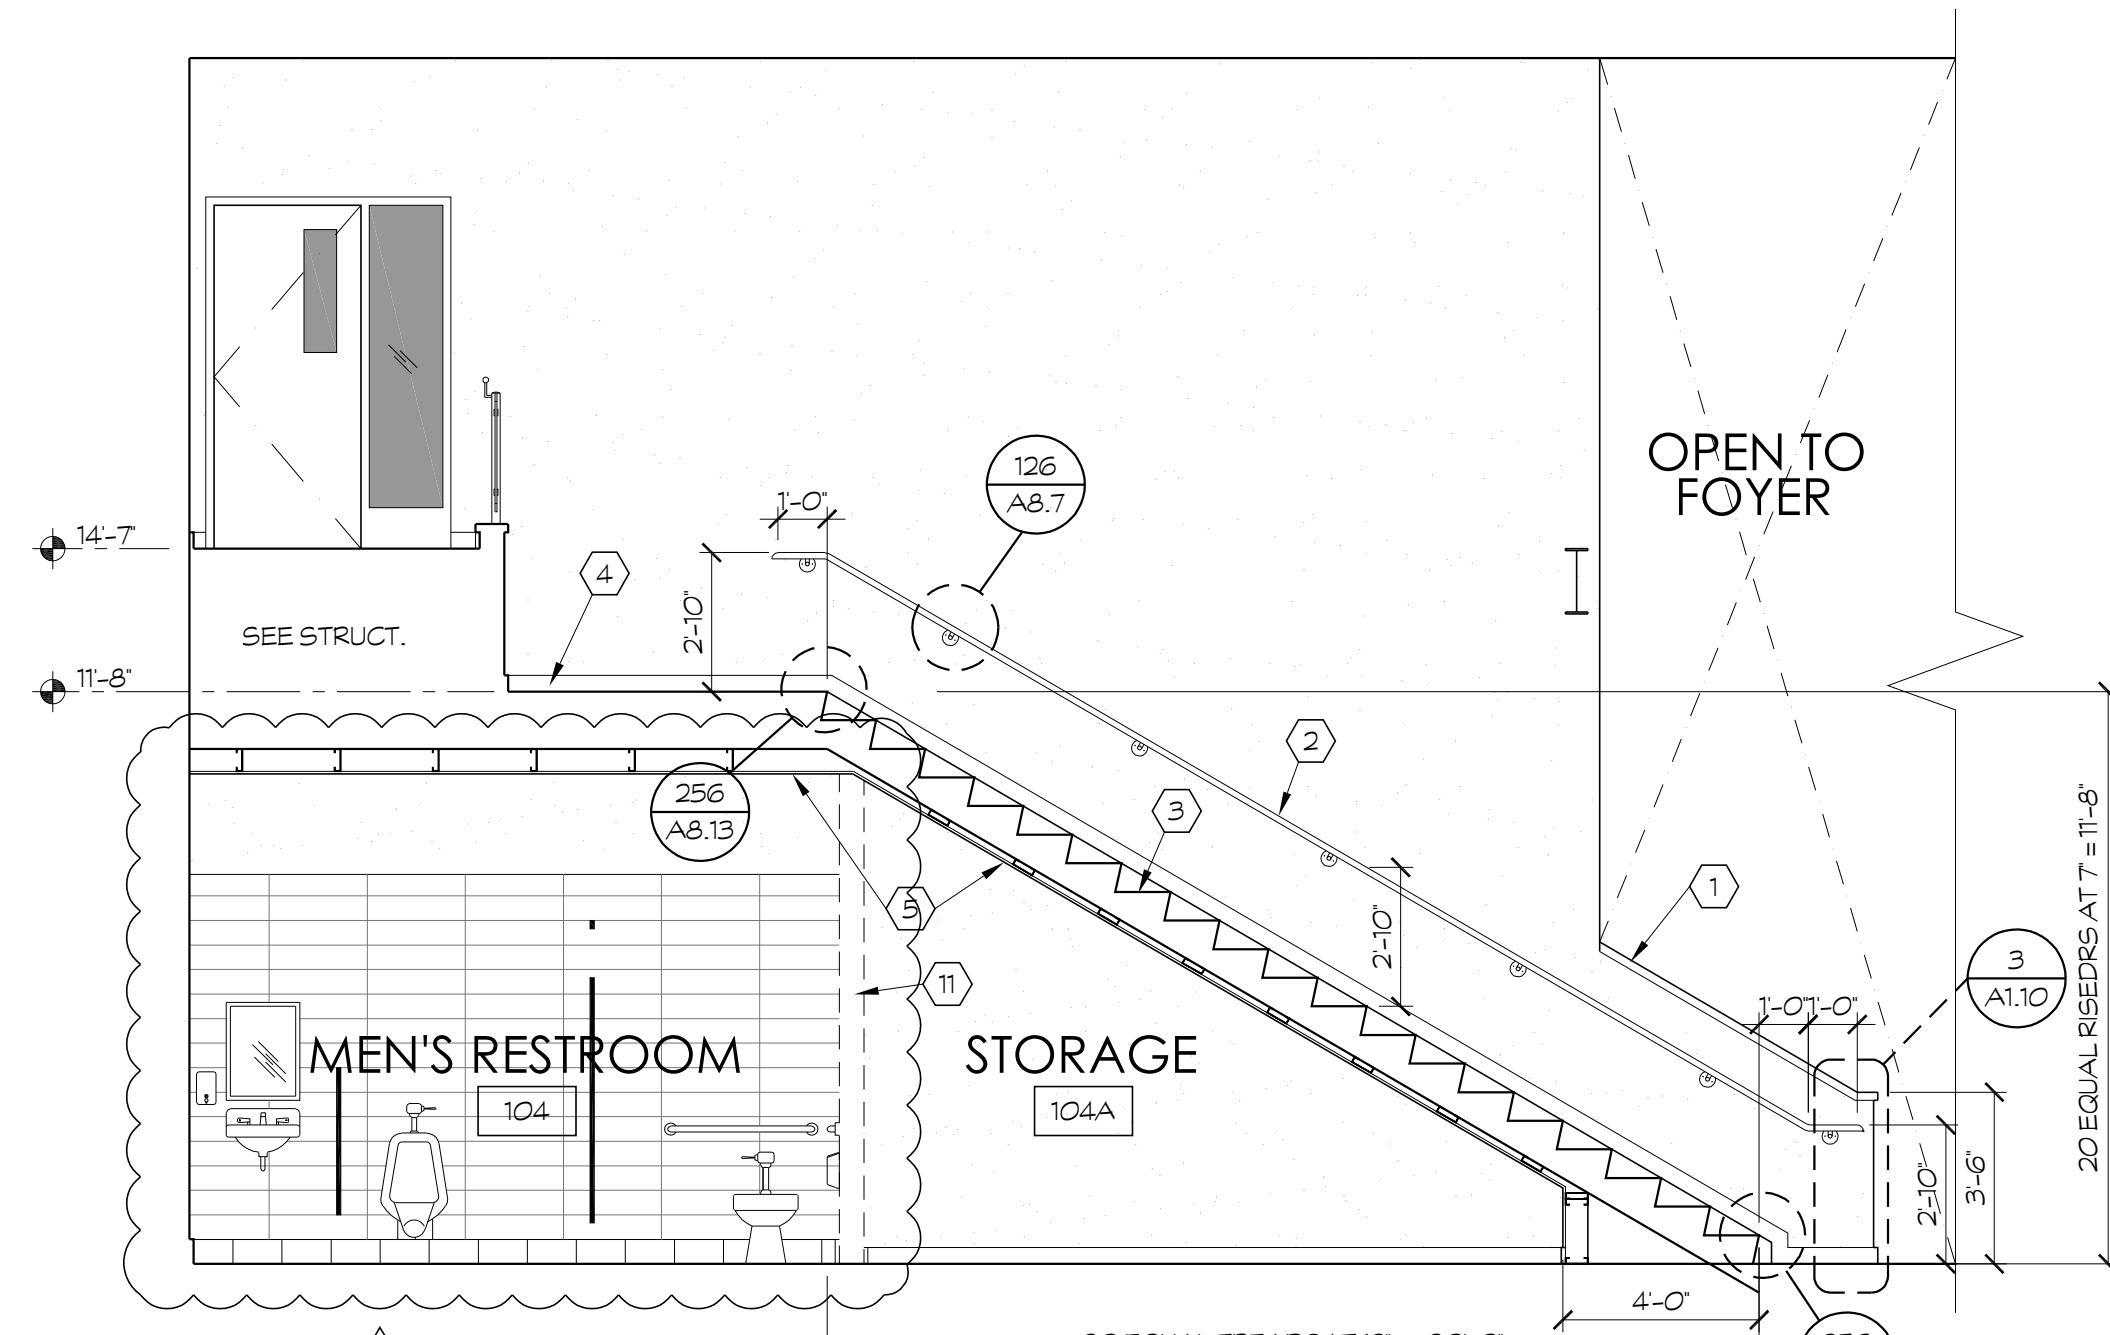

4 STAIRS 1 103 & 202
 STAIRS 3 154 & 234 SIMILAR OPPOSITE

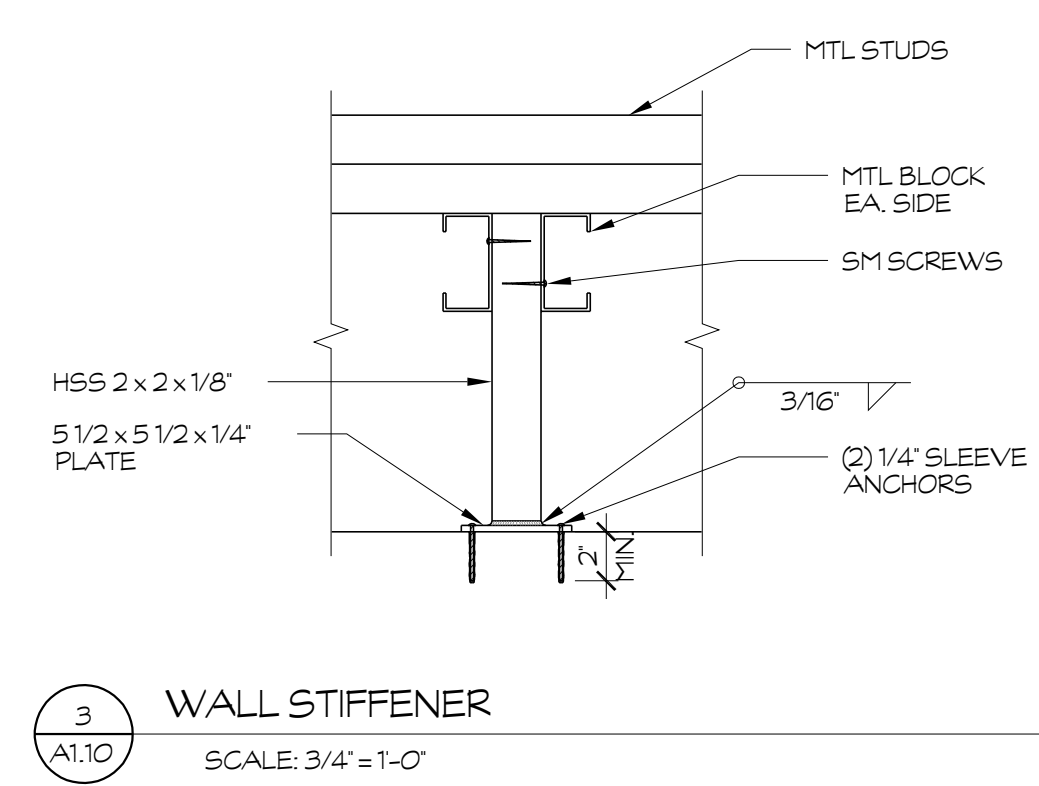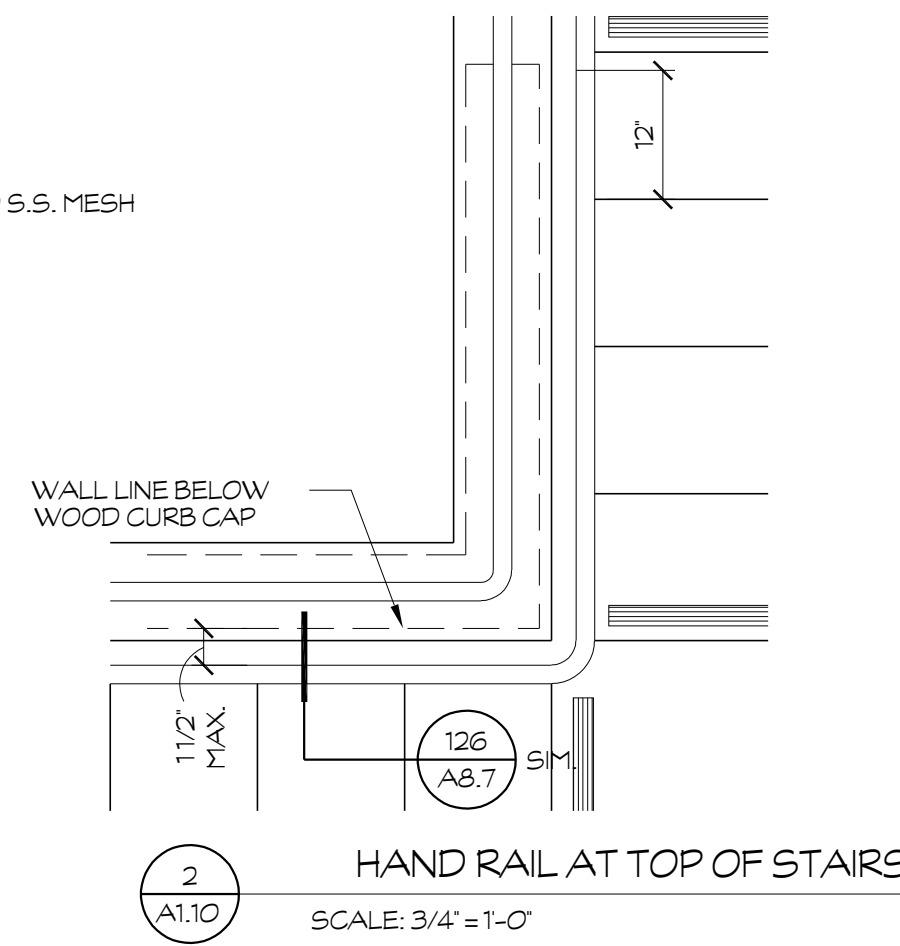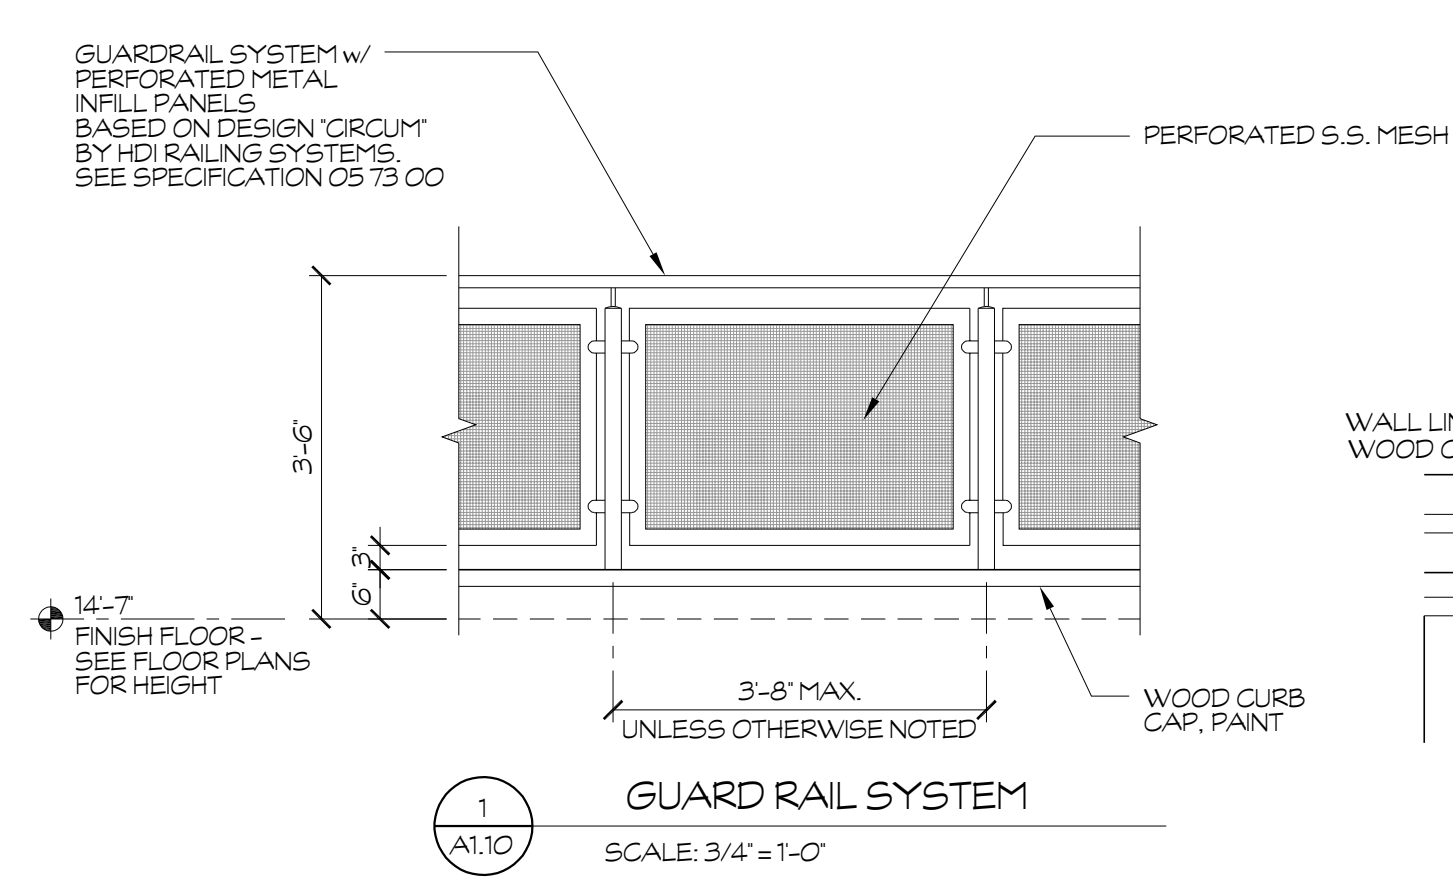


KEYNOTES

1. WALL CAP, SEE DETAIL 127/A8.7
2. ALUMINUM HANDRAIL
3. 7 RISERS AND 12 TREADS, SEE DETAIL 122/A8.7
4. RUBBER TOPSET BASE
5. 5/8" TYPE X GYP. BD. @ 6" MTL. STUDS AT 24" O.C. CONSTRUCT PER CBC TABLE 721.1 (1)
6. FRP BOARD
7. MOP SINK
8. 2 WARNING SAFETY STRIP OF CONTRASTING COLOR
9. METAL GUARDRAIL SYSTEM, SEE DTL. 124/A8.7 FOR ATTACHMENT
10. GYPSUM BOARD
11. DASHED LINE INDICATES 1-HR WALL/DOOR ASSEMBLY AT STORAGE ROOM 156, SEE FLOOR PLAN FOR CLARIFICATION
12. RUBBER FLOOR COVERING TO MATCH TREADS

WALL LEGEND


- 2x6 METAL STUDS AT 16" O.C. w/ R-19 INSULATION EXT. SIDE: CEMENT PLASTER @ PAPER BACKED WIRE LATH @ 1/2" DENS. GLAS GOLD INTERIOR SIDE: SEE FINISH SCHEDULE
 - 2x6 METAL STUDS AT 16" O.C. w/ SOUND BATT INSULATION - SEE FINISH SCHEDULE
 - 2x6 METAL STUDS AT 16" O.C. 42" HIGH w/ PAINTED WOOD CAP - SEE FINISH SCHEDULE
 - 2x4 METAL STUDS AT 16" O.C. - SEE FINISH SCHEDULE
 - 1-HR WALL: 2x6 METAL STUDS AT 16" O.C. w/ SOUND BATT INSULATION - PROVIDE 5/8" TYPE X GYP. BD. EACH SIDE (UL HL419) SEE DETAIL 102/A8.6
 - DOUBLE 2x4 18 GA METAL STUDS AT 16" O.C. SEE FINISH SCHEDULE
 - 20" DIA. CONCRETE COLUMN, SEE DETAIL 60/A8.3
 - 8" x 8" x 16" CMU WALL - SEE DETAIL 51/A8.3
- NOTE: SEE STRUCT. FOR METAL STUD SIZES AND CONNECTIONS

KEY PLAN

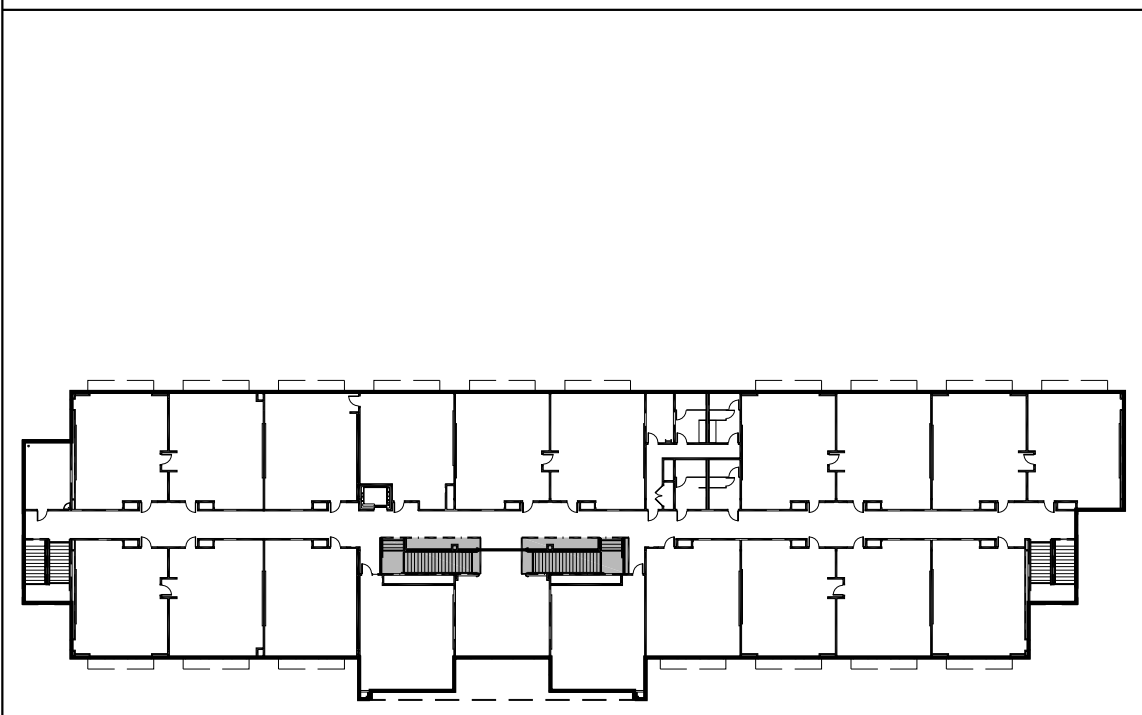

7790 NORTH PALM AVENUE
 FRESNO, CALIFORNIA 93711
 T 559.448.8400 • F 559.448.8467
 www.sim-pbk.com

PROJECT:
SHIELDS & BRAWLEY ELEMENTARY SCHOOL

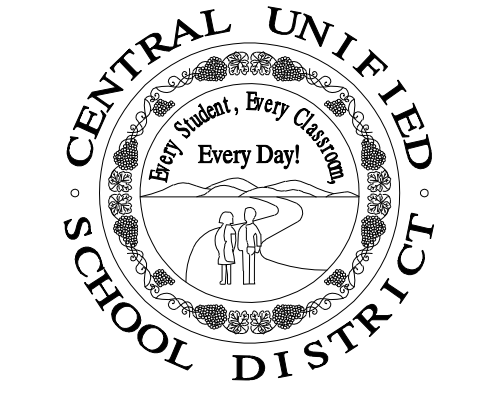

AD 2-11a
S&B Elementary
02-116800

JOHN H. SMITH, A.I.A. C15885

THE FIRM OF SMITH, WANGHA, MILHOUS, ARCHITECTS, INC. EXPRESSLY RESERVES ITS COMMON LAW COPYRIGHT AND OTHER APPLICABLE PROPERTY RIGHTS IN THESE PLANS. THESE PLANS ARE NOT TO BE REPRODUCED, CHANGED, OR COPIED IN ANY FORM OR MANNER WHATSOEVER, NOR ARE THEY TO BE ASSIGNED TO A THIRD PARTY WITHOUT FIRST OBTAINING THE WRITTEN PERMISSION AND CONSENT OF THE ARCHITECT. IN THE EVENT OF UNAUTHORIZED REUSE OF THESE PLANS BY A THIRD PARTY, THE THIRD PARTY SHALL HOLD THE ARCHITECT HARMLESS, AND SHALL BEAR THE COST OF THE ARCHITECT'S LEGAL FEES, ASSOCIATED WITH DEFENDING AND ENFORCING THESE RIGHTS.

PROJECT DEVELOPMENT




| DATE | ISSUED FOR |
|------|------------|
| | |
| | |
| | |
| | |

REVISIONS

| No. | DATE | DESCRIPTION |
|-----|---------|------------------------|
| △ 1 | 2.14.23 | DISTRICT MODIFICATIONS |
| △ 2 | 2.27.23 | DISTRICT MODIFICATIONS |

SHEET DESCRIPTION


| | | |
|-----------------------------------|---------------------------|------|
| ENLARGED STAIR PLAN | | MAIN |
| PROJECT COORDINATOR JOHN SMITH | SHEET NO. A1.10 | |
| PROJECT NO. 17-67 | DATE 1.27.23 | |
| SCALE 1/4" = 1'-0" | | |

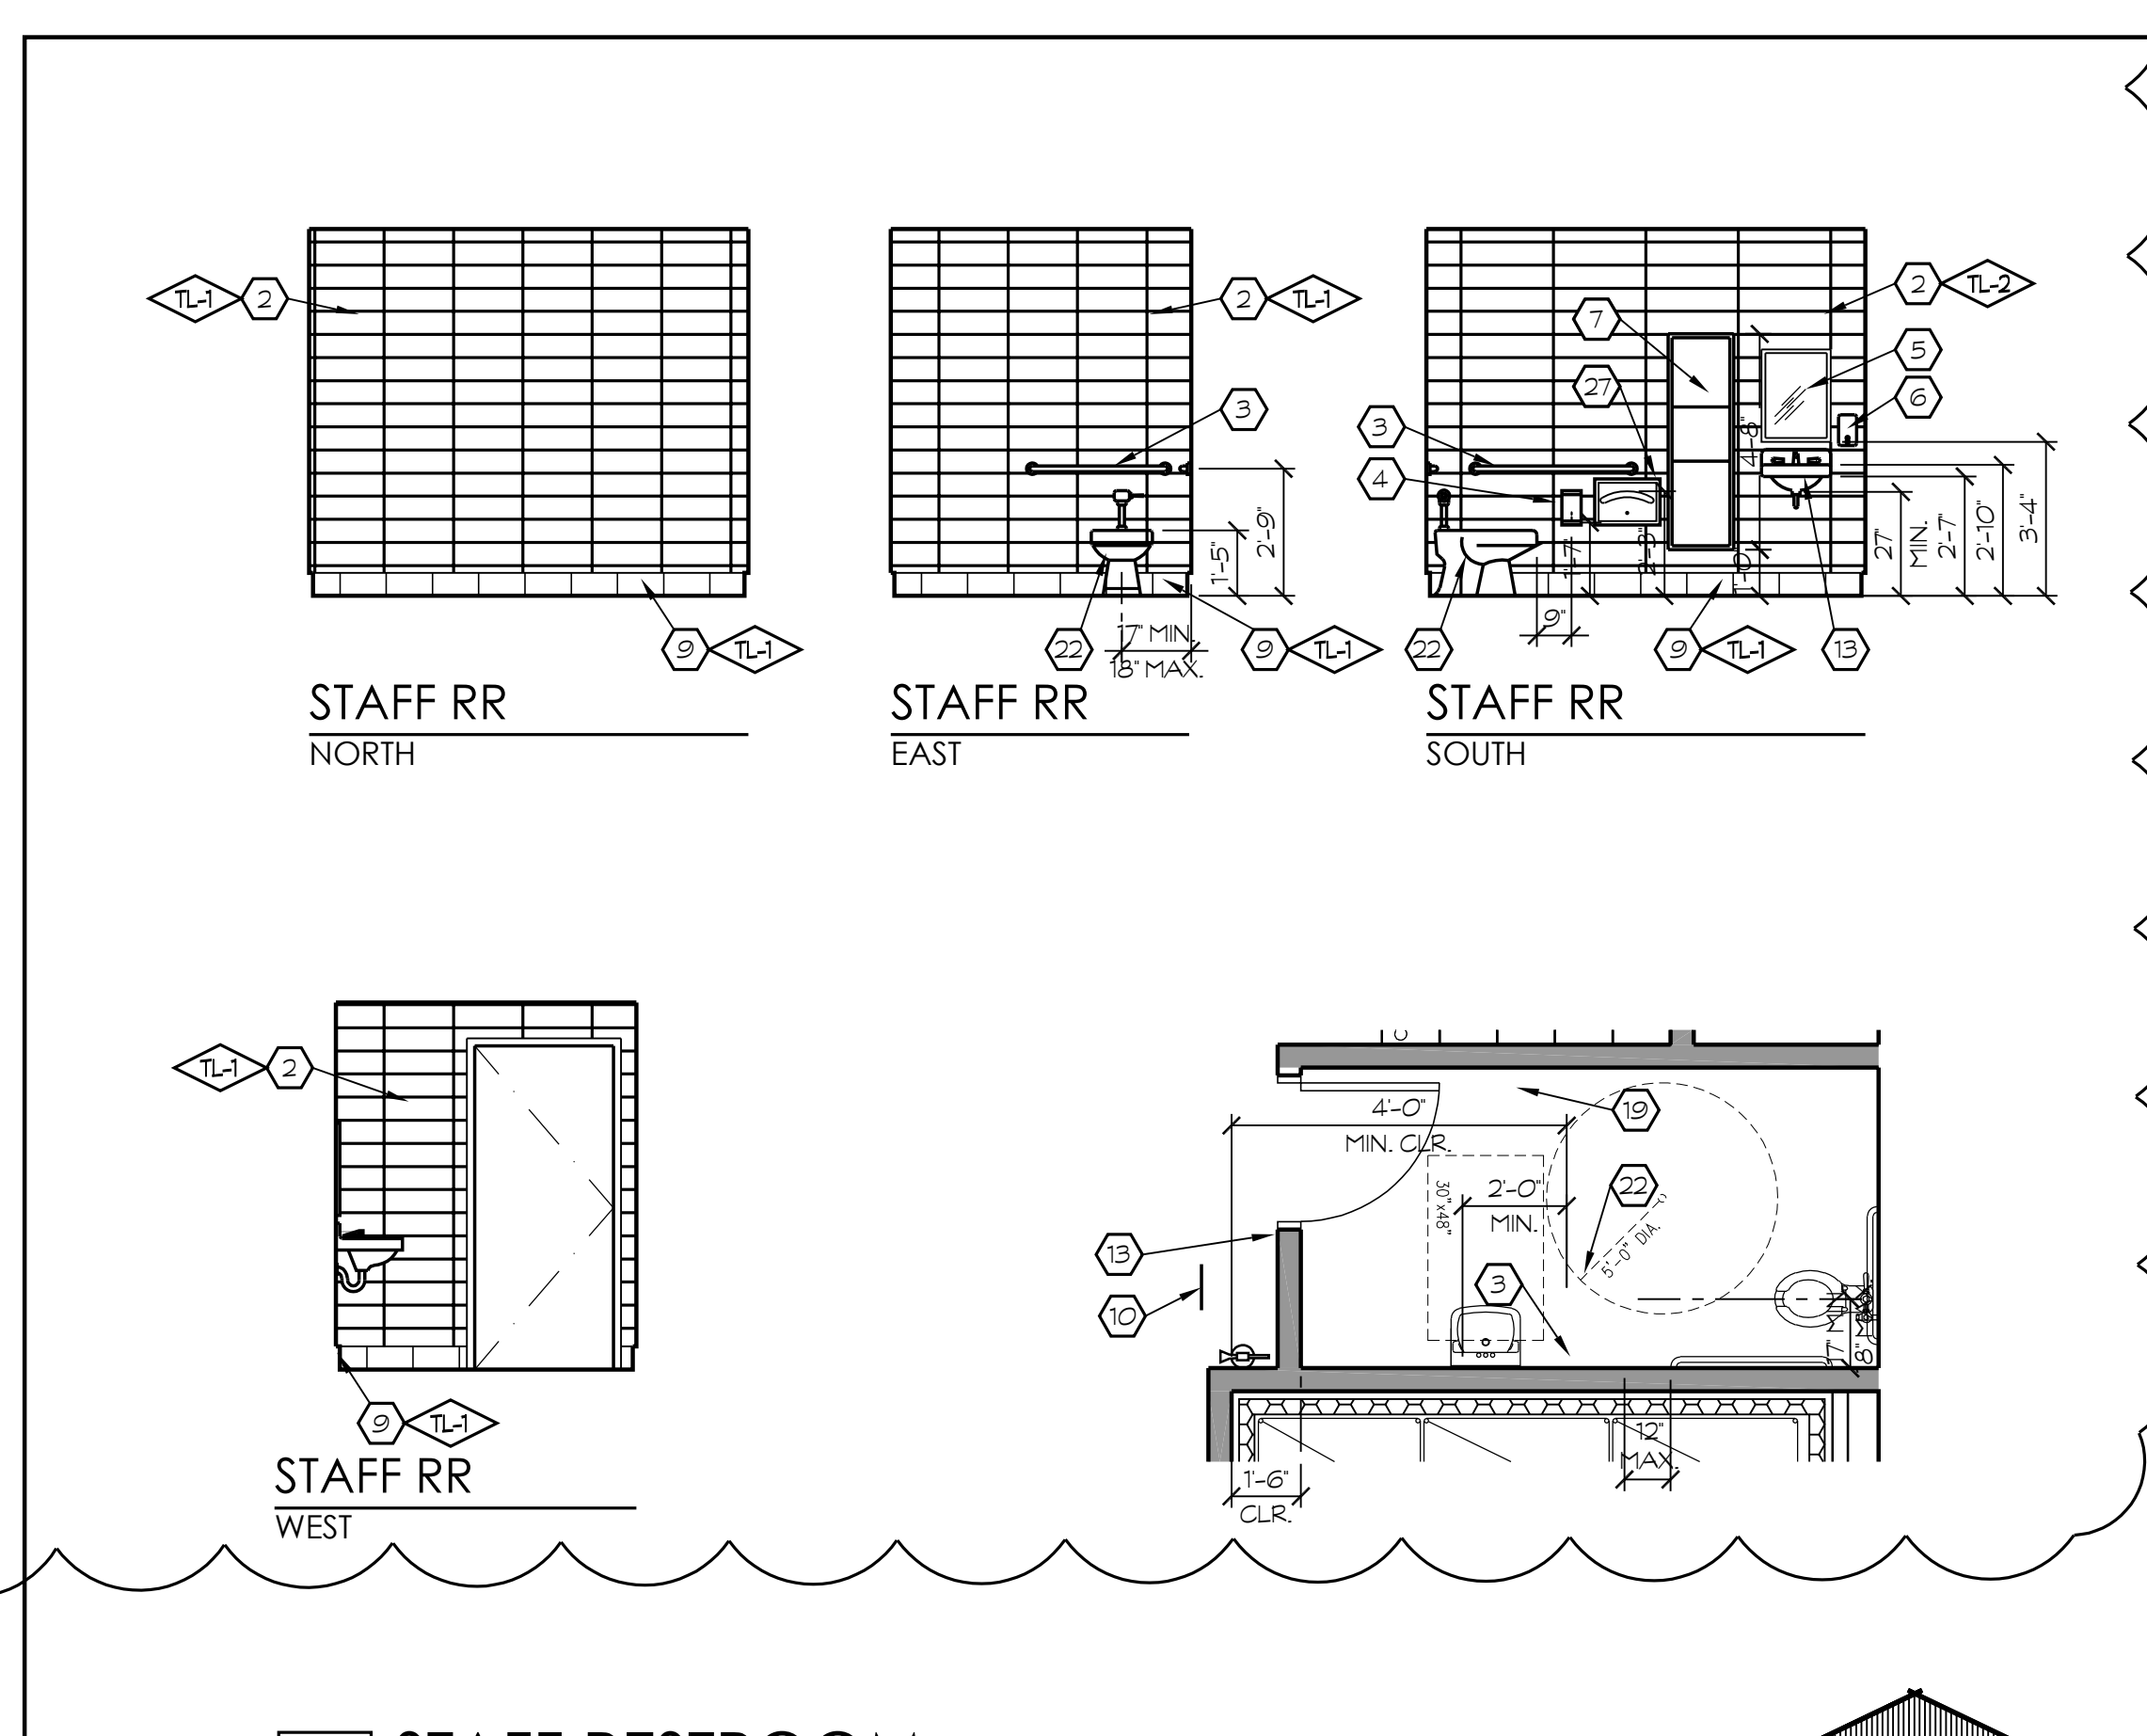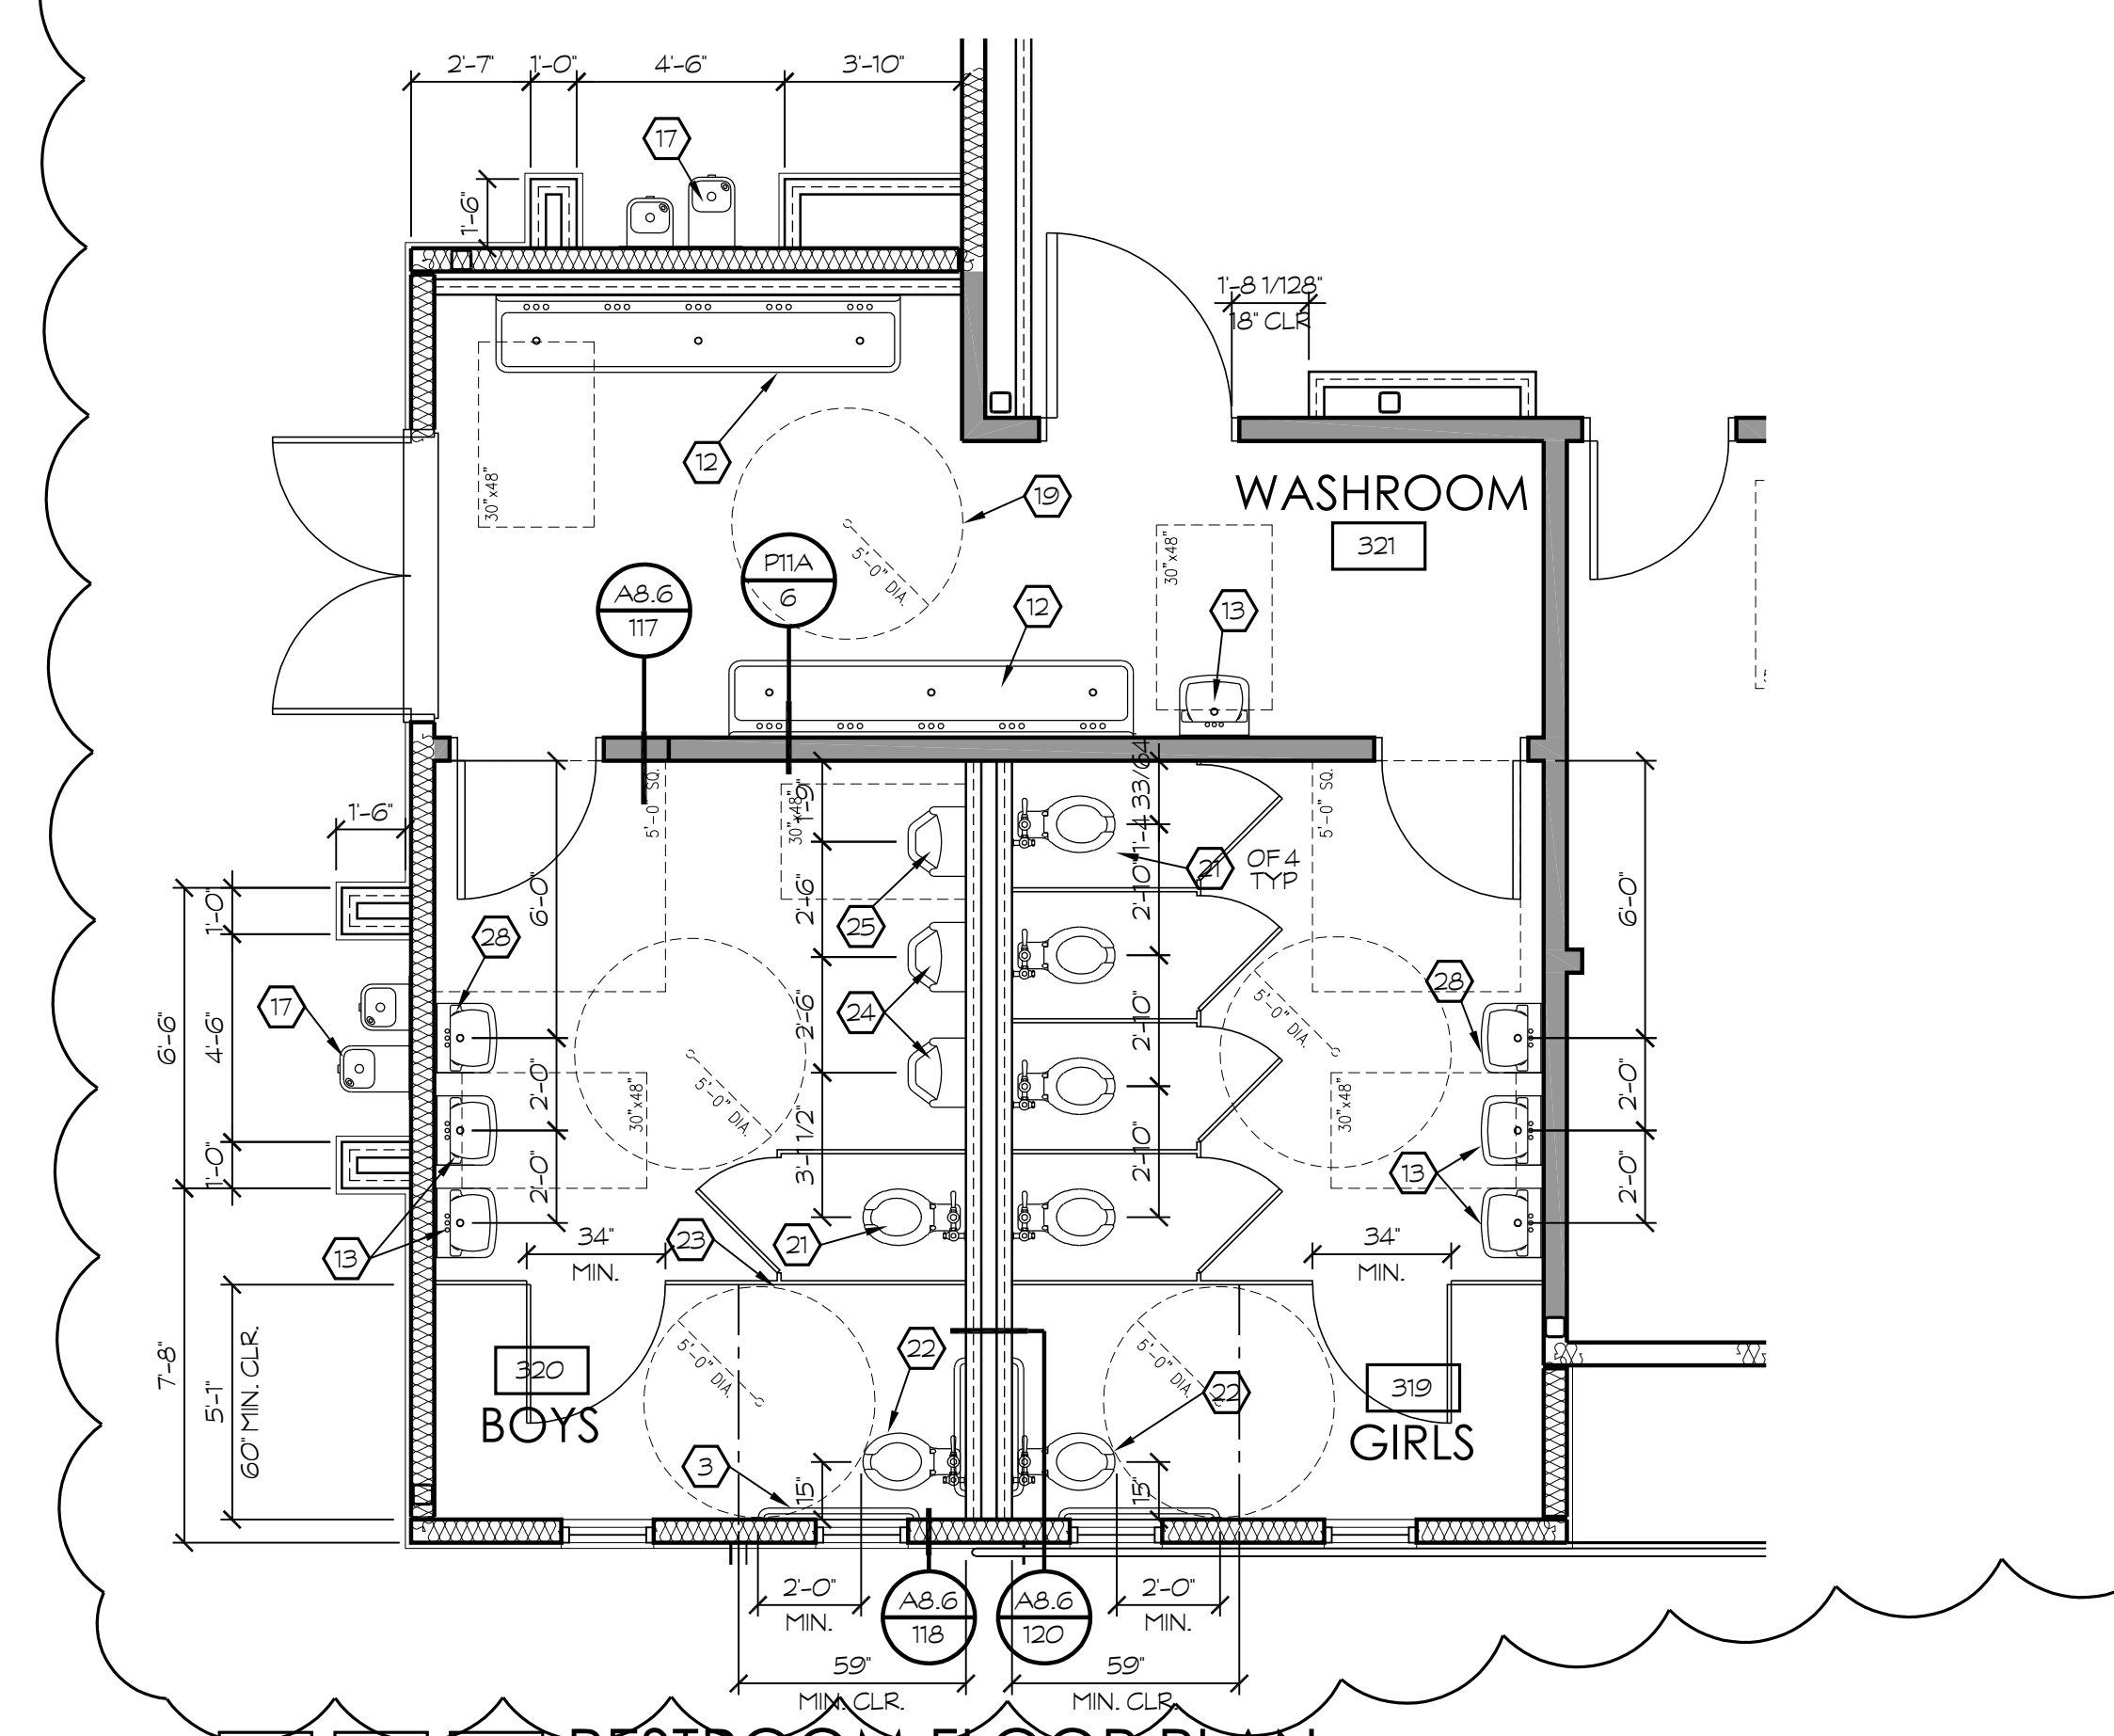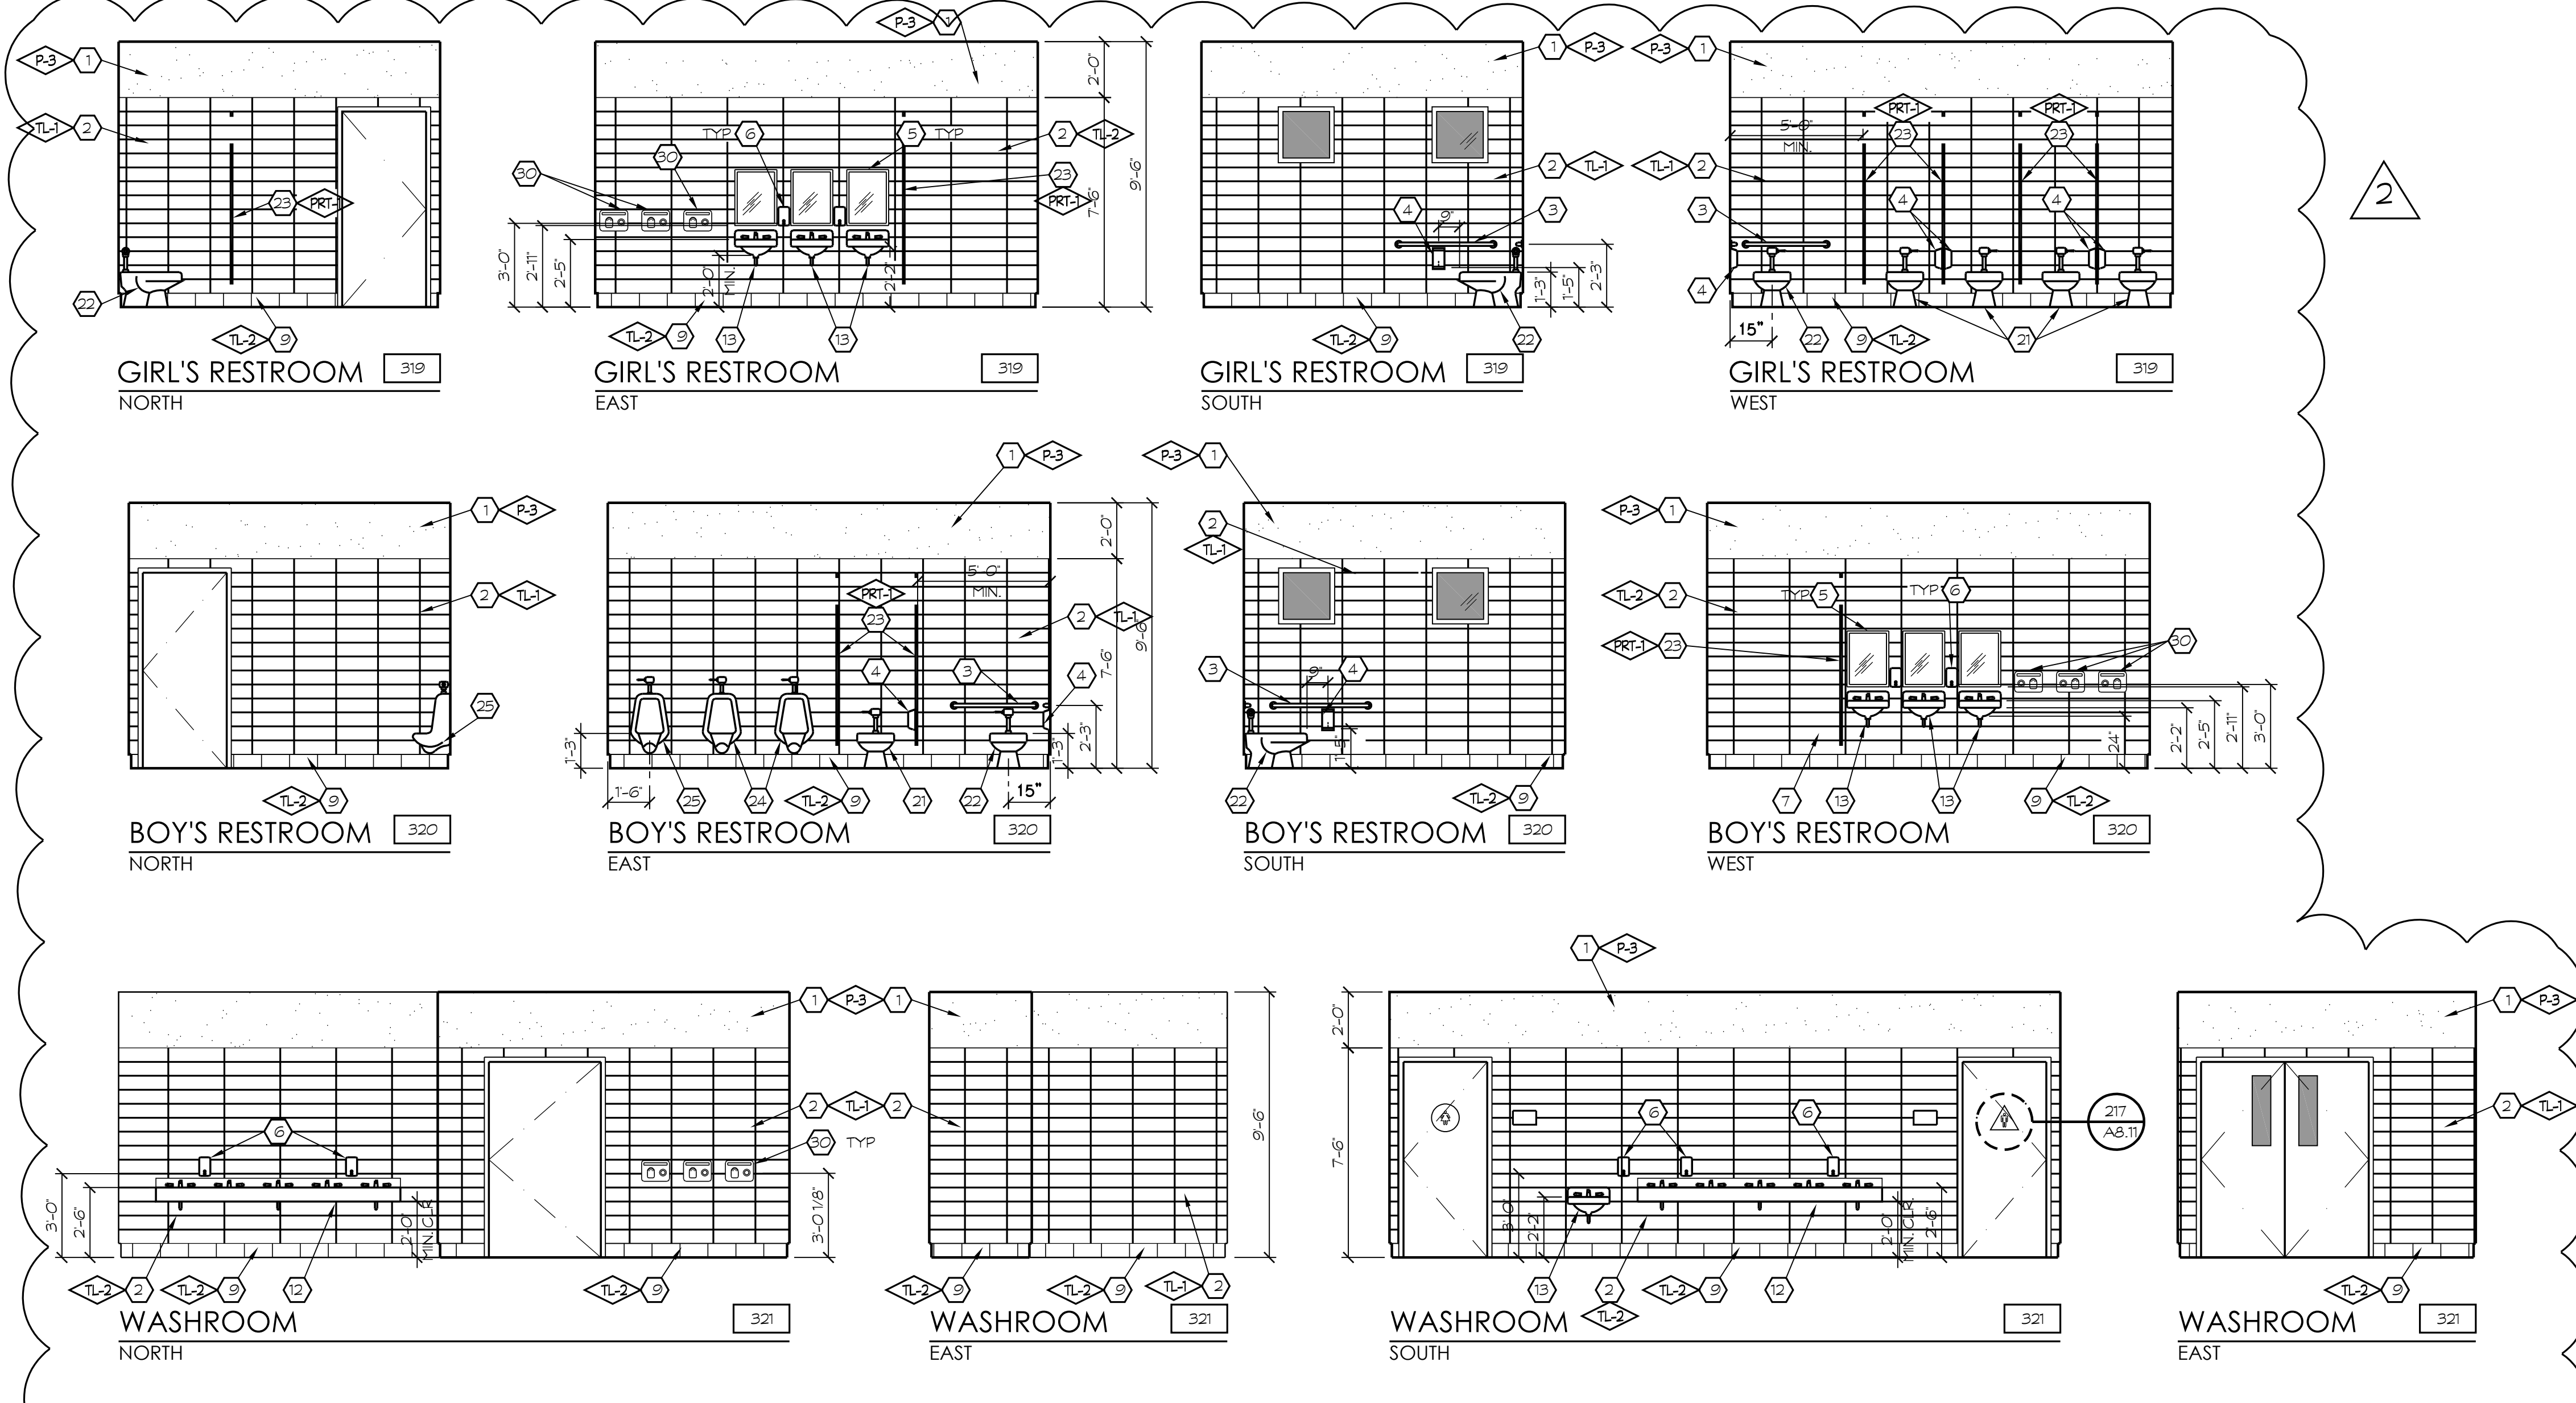

KEYNOTES

1. GYP. BD.
 2. WALL TILE
 3. GRAB BAR, SEE DTL. 210/A8.11
 4. TOILET PAPER DISPENSER
 5. MIRROR
 6. SOAP DISPENSER
 7. PAPER TOWEL DISPENSER
 8. FRP
 9. COVERED BASE - SEE FINISH SCHEDULE
 10. BRAILLE SIGNAGE - SEE DTL. 311/A8.17
 11. ACCESSIBLE SIGNAGE - SEE DTL. 217/A8.11
 12. HAND WASH LAV
 13. ACCESSIBLE LAVATORY
 14. VINYL TACKBOARD, SEE DTL. 112/A8.6
 15. RUBBER TOPSET BASE
 16. CASEWORK - SEE INTERIOR ELEVATIONS
 17. DRINKING FOUNTAIN
 18. GUARDRAIL/HANDRAIL
 19. 5'-0" DIA. ACCESSIBLE TURNING RADIUS
 20. STANDARD LAVATORY
 21. STANDARD TOILET
 22. ACCESSIBLE TOILET
 23. PARTITIONS
 24. STANDARD URINAL
 25. ACCESSIBLE URINAL
 26. FOLD DOWN CHANGING TABLE, SEE DETAIL 184/A8.10 & SPEC. SECTION 10811
 27. TOILET SEAT COVER DISPENSER
 28. PRIMARY LAVATORY
 29. ROOF ACCESS LADDER
 30. ELECTRIC HAND DRYER
- NOTE: 1. SEE DTL. 219/A8.11 FOR ACCESSIBILITY STANDARDS
 2. ALL SHELVING WITH SPANS GREATER THAN 30" TO BE 1" THICK
 3. REFER TO COLOR SCHEDULE (SHEET A2.8) FOR ALL COLOR REFERENCES, TYP.

SYMBOL LEGEND

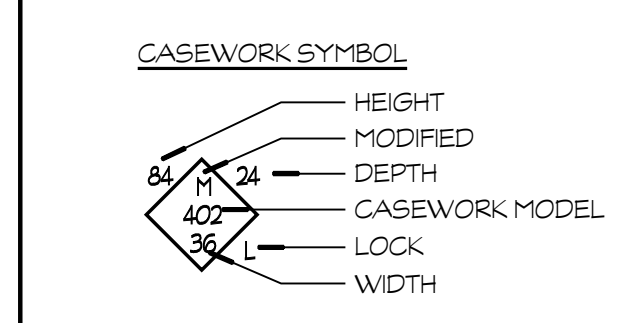


WALL LEGEND

- 2x6 METAL STUDS AT 16" O.C. w/ R-19 INSULATION
EXT. SIDE: CEMENT PLASTER or PAPER BACKED
WIRE LATH or 1/2" DENS. GLASS GOLD
INTERIOR SIDE: SEE FINISH SCHEDULE
 - 2x6 METAL STUDS AT 16" O.C. w/ SOUND BATT
INSULATION - SEE FINISH SCHEDULE
 - 2x6 METAL STUDS AT 16" O.C. 42" HIGH w/ PAINTED
WOOD CAP - SEE FINISH SCHEDULE
 - 2x4 METAL STUDS AT 16" O.C. - SEE FINISH SCHEDULE
 - 1-HR WALL: 2x6 METAL STUDS AT 16" O.C. w/ SOUND
BATT INSULATION - PROVIDE 5/8" TYPE X GYP. BD.
EACH SIDE (UL #1419) SEE DETAIL 102/A8.6
 - 20" DIA. CONCRETE COLUMN, SEE DETAIL 60/A8.3
 - 8" x 8" x 16" CMU WALL - SEE DETAIL 51/A8.3
- NOTE: SEE STRUCT. FOR METAL STUD SIZES AND CONNECTIONS




7790 NORTH PALM AVENUE
 FRESNO, CALIFORNIA 93711
 T 559.448.8400 F 559.448.8467
 www.simprk.com

PROJECT:
SHIELDS & BRAWLEY ELEMENTARY SCHOOL

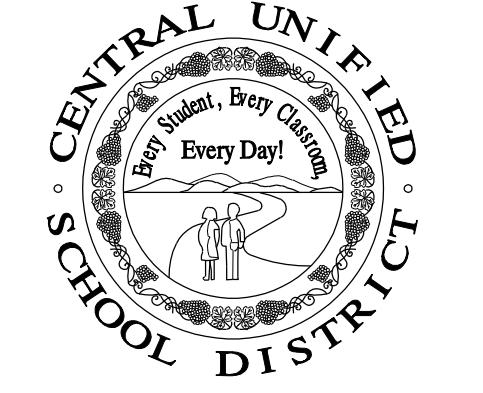

AD 2-12a
S&B Elementary
02-116800

JOHN H. SMITH, A.I.A. C15885

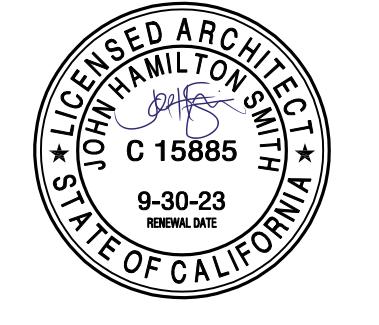

THE FIRM OF SMITH, WATANABE, MALHOTRA, ARCHITECTS, INC. EXPRESSLY RESERVES ITS OWNERSHIP, LAWYER COPYRIGHT AND OTHER AVAILABLE PROPERTY RIGHTS IN THESE PLANS. THESE PLANS ARE NOT TO BE REPRODUCED, CHANGED, OR COPIED IN ANY FORM OR MANNER WITHOUT THE WRITTEN PERMISSION AND CONSENT OF THE ARCHITECT. IN THE EVENT OF UNAUTHORIZED REUSE OF THESE PLANS BY A THIRD PARTY, THE THIRD PARTY SHALL HOLD THE ARCHITECT HARMLESS, AND SHALL BEAR THE COST OF THE ARCHITECT'S LEGAL FEES, ASSOCIATED WITH DEFENDING AND ENFORCING THESE RIGHTS.

| PROJECT DEVELOPMENT | |
|---------------------|------------|
| DATE | ISSUED FOR |
| | |
| | |
| | |

| REVISIONS | | |
|-----------|---------|------------------------|
| No. | DATE | DESCRIPTION |
| △ | 2.14.23 | DISTRICT MODIFICATIONS |
| △ | 2.27.23 | DISTRICT MODIFICATIONS |


| SHEET DESCRIPTION | |
|-----------------------------------|-----------------------|
| ENLARGED RESTROOM PLANS | |
| MULTI-PURPOSE | |
| PROJECT COORDINATOR JOHN SMITH | SHEET NO. A1.14 |
| PROJECT NO. 17-67 | DATE 1.27.23 |
| DATE 1.27.23 | SCALE 1/4" = 1'-0" |

S:\17-67_Shields & Brawley_Elementary\17-67_A1.14_Enlarged_Restrooms_05/20/18_217.rvt

| ROOMING | ROOM DESCRIPTION | FLOOR | | BASE | | | WAINSCOT | | | WALLS | | | | | | | | CEILING | FLOOR COLOR NOTE | REMARKS |
|---------|------------------|----------|--------|----------|--------|--------|----------|--------|--------|----------|--------|----------|--------|----------|--------|----------|--------|---------|------------------|---------|
| | | MATERIAL | FINISH | MATERIAL | FINISH | HEIGHT | MATERIAL | FINISH | HEIGHT | EAST | | SOUTH | | WEST | | NORTH | | | | |
| | | | | | | | | | | MATERIAL | FINISH | MATERIAL | FINISH | MATERIAL | FINISH | MATERIAL | FINISH | | | |
| 101 | FOYER | CONC | CD | RTB | FT | 4' | --- | --- | --- | GB | ESP | GB | ESP | GB | ESP | GB | ESP | | | |
| 102 | CLASSROOM | CPT/LVT | FT | RTB | FT | 4' | --- | --- | --- | GB | ESP | VTB | FT | VTB | FT | VTB | FT | | | |
| 103 | STAIRS | RT | FT | RTB | FT | 4' | --- | --- | --- | GB | ESP | GB | ESP | --- | --- | GB | ESP | | | |
| 104 | MENS RESTROOM | TL | FT | CV | FT | 6' | TL | FT | 7-6' | GB | SGP | GB | SGP | GB | SGP | GB | SGP | | | |
| 104A | STORAGE | CONC | --- | RTB | FT | 4' | --- | --- | --- | GB | ESP | GB | ESP | GB | ESP | GB | ESP | | | |
| 105 | KINDERGARTEN 3 | CPT/LVT | FT | RTB | FT | 4' | --- | --- | --- | VTB | FT | GB | ESP | VTB | FT | VTB | FT | | | |
| 106 | TOILET 1 | TL | FT | CV | FT | 6' | TL | FT | 7-6' | GB | SGP | GB | SGP | GB | SGP | GB | SGP | | | |
| 107 | WORK ROOM | CPT | FT | RTB | FT | 4' | --- | --- | --- | VTB | FT | VTB | FT | VTB | FT | VTB | FT | | | |
| 108 | TOILET 2 | TL | FT | CV | FT | 6' | TL | FT | 7-6' | GB | SGP | GB | SGP | GB | SGP | GB | SGP | | | |
| 109 | KINDERGARTEN 1 | CPT/LVT | FT | RTB | FT | 4' | --- | --- | --- | VTB | FT | GB | ESP | VTB | FT | VTB | FT | | | |
| 110 | STORAGE | CONC | SL | RTB | FT | 4' | --- | --- | --- | GB | SGP | GB | SGP | GB | SGP | GB | SGP | | | |
| 111 | STAIRS | RT | FT | RTB | FT | 4' | --- | --- | --- | GB | ESP | --- | --- | GB | ESP | GB | ESP | | | |
| 112 | NOT USED | --- | --- | --- | --- | --- | --- | --- | --- | --- | --- | --- | --- | --- | --- | --- | --- | | | |
| 113 | STORAGE | CONC | --- | RTB | FT | 4' | --- | --- | --- | GB | ESP | GB | ESP | GB | ESP | GB | ESP | | | |
| 114 | KINDERGARTEN 4 | CPT/LVT | FT | RTB | FT | 4' | --- | --- | --- | VTB | FT | VTB | FT | VTB | FT | VTB | FT | | | |
| 115 | TOILET 3 | TL | FT | CV | FT | 6' | TL | FT | 7-6' | GB | SGP | GB | SGP | GB | SGP | GB | SGP | | | |
| 116 | WORK ROOM | CPT | FT | RTB | FT | 4' | --- | --- | --- | VTB | FT | VTB | FT | VTB | FT | VTB | FT | | | |
| 117 | TOILET 4 | TL | FT | CV | FT | 6' | TL | FT | 7-6' | GB | SGP | GB | SGP | GB | SGP | GB | SGP | | | |
| 118 | KINDERGARTEN 2 | CPT/LVT | FT | RTB | FT | 4' | --- | --- | --- | VTB | FT | VTB | FT | VTB | FT | VTB | FT | | | |
| 119 | ELECTRICAL | CONC | --- | RTB | FT | 4' | --- | --- | --- | GB | ESP | GB | ESP | GB | ESP | GB | ESP | | | |
| 120 | PUMP ROOM | CONC | --- | RTB | FT | 4' | --- | --- | --- | GB | ESP | GB | ESP | GB | ESP | GB | ESP | | | |
| 121 | ELEVATOR | TL | FT | --- | --- | --- | --- | --- | --- | --- | --- | --- | --- | --- | --- | --- | --- | | | |
| 122A | C.S.L. 1 | CPT | FT | RTB | FT | 4' | --- | --- | --- | GB | ESP | GB | ESP | GB | ESP | VTB | FT | | | |
| 122B | C.S.L. 2 | CPT | FT | RTB | FT | 4' | --- | --- | --- | GB | ESP | VTB | FT | GB | ESP | GB | ESP | | | |
| 122C | C.S.L. 3 | CPT | FT | RTB | FT | 4' | --- | --- | --- | GB | ESP | VTB | FT | GB | ESP | GB | ESP | | | |
| 122D | STORAGE | CONC | --- | RTB | FT | 4' | --- | --- | --- | GB | ESP | GB | ESP | GB | ESP | GB | ESP | | | |
| 122E | HALLWAY | CPT | FT | RTB | FT | 4' | --- | --- | --- | GB | ESP | GB | ESP | GB | ESP | GB | ESP | | | |
| 123 | BALL ROOM | CONC | --- | RTB | FT | 4' | --- | --- | --- | GB | ESP | GB | ESP | GB | ESP | GB | ESP | | | |
| 124 | I.T. | CPT | FT | RTB | FT | 4' | --- | --- | --- | GB | ESP | VTB | FT | GB | ESP | GB | ESP | | | |
| 125 | WAITING AREA | CONC | CD | RTB | FT | 4' | --- | --- | --- | VTB | FT | GB | ESP | VTB | FT | VTB | FT | | | |
| 126 | RECEPTION | CPT | FT | RTB | FT | 4' | --- | --- | --- | VTB | FT | GB | ESP | --- | --- | GB | ESP | | | |
| 127 | SECRETARY | CPT | FT | RTB | FT | 4' | --- | --- | --- | VTB | FT | GB | ESP | --- | --- | GB | ESP | | | |
| 128 | OFFICE | CPT | FT | RTB | FT | 4' | --- | --- | --- | GB | ESP | GB | ESP | VTB | FT | VTB | FT | | | |
| 129 | VICE PRINCIPAL | CPT | FT | RTB | FT | 4' | --- | --- | --- | GB | ESP | GB | ESP | VTB | FT | VTB | FT | | | |
| 130 | PRINCIPAL | CPT | FT | RTB | FT | 4' | --- | --- | --- | VTB | FT | GB | ESP | GB | ESP | GB | ESP | | | |
| 131 | H.S.L. | CPT | FT | RTB | FT | 4' | --- | --- | --- | VTB | FT | GB | ESP | GB | ESP | GB | ESP | | | |
| 132 | NURSE | LVT | FT | RTB | FT | 4' | --- | --- | --- | GB | ESP | GB | ESP | FRP/GB | FT/ESP | FRP/GB | FT/ESP | | | |
| 133 | TOILET 5 | TL | FT | CV | FT | 6' | TL | FT | 7-6' | GB | SGP | GB | SGP | GB | SGP | GB | SGP | | | |
| 134 | WORK ROOM | CPT | FT | RTB | FT | 4' | --- | --- | --- | VTB | FT | VTB | FT | VTB | FT | VTB | FT | | | |
| 135 | MENS ROOM 1 | TL | FT | CV | FT | 6' | TL | FT | 7-6' | GB | SGP | GB | SGP | GB | SGP | GB | SGP | | | |
| 136 | WOMENS ROOM 1 | TL | FT | CV | FT | 6' | TL | FT | 7-6' | GB | SGP | GB | SGP | GB | SGP | GB | SGP | | | |

| ROOMING | ROOM DESCRIPTION | FLOOR | | BASE | | | WAINSCOT | | | WALLS | | | | | | | | CEILING | FLOOR COLOR NOTE | REMARKS |
|---------|------------------|----------|--------|----------|--------|--------|----------|--------|--------|----------|--------|----------|--------|----------|--------|----------|--------|---------|------------------|---------|
| | | MATERIAL | FINISH | MATERIAL | FINISH | HEIGHT | MATERIAL | FINISH | HEIGHT | EAST | | SOUTH | | WEST | | NORTH | | | | |
| | | | | | | | | | | MATERIAL | FINISH | MATERIAL | FINISH | MATERIAL | FINISH | MATERIAL | FINISH | | | |
| 137 | BOYS ROOM 2 | TL | FT | CV | FT | 6' | TL | FT | 7-6' | GB | SGP | GB | SGP | GB | SGP | GB | SGP | | | |
| 138 | BOYS ROOM 1 | TL | FT | CV | FT | 6' | TL | FT | 7-6' | GB | SGP | GB | SGP | GB | SGP | GB | SGP | | | |
| 139 | GIRLS ROOM 1 | TL | FT | CV | FT | 6' | TL | FT | 7-6' | GB | SGP | GB | SGP | GB | SGP | GB | SGP | | | |
| 140 | GIRLS ROOM 2 | TL | FT | CV | FT | 6' | TL | FT | 7-6' | GB | SGP | GB | SGP | GB | SGP | GB | SGP | | | |
| 141 | CLASSROOM 1 | CPT/LVT | FT | RTB | FT | 4' | --- | --- | --- | VTB | FT | VTB | FT | VTB | FT | VTB | FT | | | |
| 142 | CLASSROOM 2 | CPT/LVT | FT | RTB | FT | 4' | --- | --- | --- | GB | ESP | VTB | FT | VTB | FT | VTB | FT | | | |
| 143 | CLASSROOM 3 | CPT/LVT | FT | RTB | FT | 4' | --- | --- | --- | VTB | FT | VTB | FT | VTB | FT | VTB | FT | | | |
| 144 | CLASSROOM 4 | CPT/LVT | FT | RTB | FT | 4' | --- | --- | --- | GB | ESP | VTB | FT | VTB | FT | VTB | FT | | | |
| 145 | STAIRS | RT | FT | RTB | FT | 4' | --- | --- | --- | GB | ESP | GB | ESP | --- | --- | GB | ESP | | | |
| 146 | STORAGE | CONC | FT | RTB | FT | 4' | --- | --- | --- | GB | SGP | FRP | FT | GB | SGP | GB | SGP | | | |
| 147 | CLASSROOM 7 | CPT/LVT | FT | RTB | FT | 4' | --- | --- | --- | VTB | FT | VTB | FT | VTB | FT | VTB | FT | | | |
| 148 | CLASSROOM 6 | CPT/LVT | FT | RTB | FT | 4' | --- | --- | --- | GB | ESP | VTB | FT | VTB | FT | VTB | FT | | | |
| 149 | CLASSROOM 5 | CPT/LVT | FT | RTB | FT | 4' | --- | --- | --- | VTB | FT | VTB | FT | VTB | FT | VTB | FT | | | |
| 150 | RESOURCE | CPT | FT | RTB | FT | 4' | --- | --- | --- | GB | ESP | GB | ESP | GB | ESP | GB | ESP | | | |
| 151 | AUDIO VISUAL | CPT | FT | RTB | FT | 4' | --- | --- | --- | GB | ESP | GB | ESP | GB | ESP | GB | ESP | | | |
| 152 | MEDIA LAB | CPT | FT | RTB | FT | 4' | --- | --- | --- | VTB | FT | VTB | FT | VTB | FT | VTB | FT | | | |
| 153 | WORK ROOM | CPT | FT | RTB | FT | 4' | --- | --- | --- | VTB | FT | VTB | FT | VTB | FT | VTB | FT | | | |
| 154 | STAIRS | RT | FT | RTB | FT | 4' | --- | --- | --- | GB | ESP | GB | ESP | --- | --- | GB | ESP | | | |
| 155 | CORRIDOR | CONC | CD | RTB | FT | 4' | AC | FT | 48" | GB | ESP | GB | ESP | GB | ESP | GB | ESP | | | |
| 156 | STORAGE | CONC | --- | RTB | FT | 4' | --- | --- | --- | GB | ESP | GB | ESP | GB | ESP | GB | ESP | | | |
| 157 | CORRIDOR | CONC | CD | RTB | FT | 4' | AC | FT | 48" | GB | ESP | GB | ESP | GB | ESP | GB | ESP | | | |
| 158 | CORRIDOR | CONC | CD | RTB | FT | 4' | AC | FT | 48" | GB | ESP | GB | ESP | GB | ESP | GB | ESP | | | |


| ROOMING | ROOM DESCRIPTION | FLOOR | | BASE | | | WAINSCOT | | | WALLS | | | | | | | | CEILING | FLOOR COLOR NOTE | REMARKS |
|---------|------------------|----------|--------|----------|--------|--------|----------|--------|--------|----------|--------|----------|--------|----------|--------|----------|--------|---------|------------------|---------|
| | | MATERIAL | FINISH | MATERIAL | FINISH | HEIGHT | MATERIAL | FINISH | HEIGHT | EAST | | SOUTH | | WEST | | NORTH | | | | |
| | | | | | | | | | | MATERIAL | FINISH | MATERIAL | FINISH | MATERIAL | FINISH | MATERIAL | FINISH | | | |
| | | | | | | | | | | | | | | | | | | | | |




7700 NORTH PALM AVENUE
FRESNO, CALIFORNIA 93711
T 559.448.8400 • F 559.448.8467
www.simpbk.com

PROJECT:

SHIELDS & BRAWLEY ELEMENTARY SCHOOL



AD 2-13a
S&B Elementary
02-116800



THE FIRM OF SMITH, MANAGA, ML-HOUSE, ARCHITECTS, INC. EXPRESSLY RESERVES ITS COMMON LAW COPYRIGHT AND OTHER APPLICABLE PRIORITY RIGHTS IN THESE PLANS. THESE PLANS ARE NOT TO BE REPRODUCED, CHANGED, OR COPIED IN ANY FORM OR MANNER WITHOUT THE WRITTEN PERMISSION OF THE ARCHITECT. IN THE EVENT OF UNAUTHORIZED REUSE OF THESE PLANS BY A THIRD PARTY, THE THIRD PARTY SHALL HOLD THE ARCHITECT HARMLESS, AND SHALL BEAR THE COST OF THE ARCHITECT'S LEGAL FEES, ASSOCIATED WITH DEFENDING AND ENFORCING THESE RIGHTS.

| PROJECT DEVELOPMENT | |
|---------------------|------------|
| DATE | ISSUED FOR |
| | |
| | |
| | |

| REVISIONS | | |
|-----------|---------|------------------------|
| No. | DATE | DESCRIPTION |
| △ | 2.14.23 | DISTRICT MODIFICATIONS |
| △ | 2.27.23 | DISTRICT MODIFICATIONS |

SHEET DESCRIPTION

FINISH SCHEDULE

MAIN - 1ST FLOOR


| | |
|-----------------------------------|-----------|
| PROJECT COORDINATOR JOHN SMITH | SHEET NO. |
| PROJECT NO. 17-67 | A2.1 |
| DATE 1.27.23 | |
| SCALE 1/4" = 1'-0" | |

S:\17-67 Shields & Brawley Elementary\Work\17-67_A2.1_1st-Fin_Sched.dwg 05/20/18 22:00

| DOOR SCHEDULE | | | | | | | | | | | | | | | DOOR SCHEDULE | | | | | | | | | | | | | | | | | | | | | | |
|---------------|-----------|----------------------|-----------|--------|--------|--------|--------|------|--------|------|------|--------|-------------|---------|---------------|-----------|--------|---------|----------|---------------|----------------------|--------|--------|--------|-------|--------|------|-------|-----------|-----------|--------|-------------|---------|---------|--------|--------|---------|
| DOOR No. | DOOR TYPE | DOOR SIZE W. x H. | DOOR | | | FRAME | | | GLASS | | | LOUVER | FIRE RATING | SIGNAGE | DETAILS | | | REMARKS | DOOR No. | DOOR TYPE | DOOR SIZE W. x H. | DOOR | | | FRAME | | | GLASS | | | LOUVER | FIRE RATING | SIGNAGE | DETAILS | | | REMARKS |
| | | | THICKNESS | CONST. | FINISH | CONST. | FINISH | TYPE | FINISH | HEAD | JAMB | | | | THRESHOLD | THICKNESS | CONST. | | | | | FINISH | CONST. | FINISH | TYPE | FINISH | HEAD | JAMB | THRESHOLD | THICKNESS | | | | CONST. | FINISH | CONST. | |
| 101 | A | PAIR 3'-0" x 7'-0" | 13/4 | ALUM | FF | ALUM | ANOD | T | TNT | -- | -- | 1,2,3 | 86 | 87 | 88 | 01 | 1 | 143 | G | 3'-0" x 7'-0" | 13/4 | SC | LP | HM | SGP | T | CLR | -- | -- | 3 | 105 | 105 | -- | 23 | 3 | | |
| 102 | A | PAIR 3'-0" x 7'-0" | 13/4 | ALUM | FF | ALUM | ANOD | T | TNT | -- | -- | 1,2,3 | 86 | 87 | 88 | 04 | 1 | 144 | J | 3'-0" x 7'-0" | 13/4 | SC | LP | HM | SGP | T | CLR | -- | -- | 3 | 105 | 105 | -- | 23 | 3 | | |
| 103 | B | PAIR 3'-0" x 7'-0" | 13/4 | ALUM | FF | ALUM | ANOD | T | TNT | -- | -- | 1,2,3 | 86 | 87 | 88 | 04 | 1 | 145 | G | 3'-0" x 7'-0" | 13/4 | SC | LP | HM | SGP | T | CLR | -- | -- | 3 | 105 | 105 | -- | 23 | 3 | | |
| 104 | B | PAIR 3'-0" x 7'-0" | 13/4 | ALUM | FF | ALUM | ANOD | T | TNT | -- | -- | 1,2,3 | 86 | 87 | 88 | 01 | 1 | 146 | H | 3'-0" x 7'-0" | 13/4 | SC | LP | HM | SGP | T | CLR | -- | -- | 3 | 105 | 105 | -- | 23 | 3 | | |
| 105 | C | PAIR 3'-0" x 7'-0" | 13/4 | HM | SGP | HM | SGP | -- | -- | -- | -- | 3 | 82 | 83 | 84 | 15 | 3 | 147 | H | 3'-0" x 7'-0" | 13/4 | SC | LP | HM | SGP | T | CLR | -- | -- | 3 | 105 | 105 | -- | 23 | 3 | | |
| 106 | I | 3'-0" x 7'-0" | 13/4 | HM | SGP | ALUM | ANOD | T | TNT | -- | -- | 2,3 | 86 | 87 | 88 | 06 | 3 | 148 | E | 3'-0" x 7'-0" | 13/4 | SC | LP | HM | SGP | -- | -- | 45 | 2,3 | 105 | 105 | -- | 17 | 3 | | | |
| 107 | E | 3'-0" x 7'-0" | 13/4 | HM | SGP | HM | SGP | -- | -- | -- | -- | 4 | 82 | 83 | 84 | 10 | 2 | 149 | H | 3'-0" x 7'-0" | 13/4 | SC | LP | HM | SGP | T | CLR | -- | -- | 3 | 105 | 105 | -- | 23 | 3 | | |
| 108 | E | 3'-0" x 7'-0" | 13/4 | HM | SGP | HM | SGP | -- | -- | -- | -- | 4 | 82 | 83 | 84 | 10 | 2 | 150 | E | 3'-0" x 7'-0" | 13/4 | SC | LP | HM | SGP | -- | -- | 45 | 4 | 105 | 105 | -- | 19 | 2 | | | |
| 109 | I | 3'-0" x 7'-0" | 13/4 | HM | SGP | ALUM | ANOD | T | TNT | -- | -- | 2,3 | 86 | 87 | 88 | 06 | 3 | 151 | E | 3'-0" x 7'-0" | 13/4 | SC | LP | HM | SGP | -- | -- | 4 | 105 | 105 | -- | 22 | 2 | | | | |
| 110 | B | PAIR 3'-0" x 7'-0" | 13/4 | ALUM | ANOD | ALUM | ANOD | T | TNT | -- | -- | 1,2,3 | 86 | 87 | 88 | 01 | 1 | 152 | E | 3'-0" x 7'-0" | 13/4 | SC | LP | HM | SGP | -- | -- | 20 | 4 | 105 | 105 | -- | 19 | 2 | | | |
| 111 | E | 4'-6" x 4'-2" | 13/4 | HM | SGP | HM | SGP | -- | -- | -- | -- | 3 | 82 | 83 | 84 | 13 | 3 | 153 | E | 3'-0" x 7'-0" | 13/4 | SC | LP | HM | SGP | -- | -- | 20 | 4 | 105 | 105 | -- | 19 | 2 | | | |
| 112 | H | 3'-0" x 7'-0" | 13/4 | HM | SGP | HM | SGP | T | TNT | -- | -- | 1,2 | 82 | 83 | 84 | 08 | 1 | 154 | D | 3'-0" x 7'-0" | 13/4 | SC | LP | HM | SGP | T | CLR | -- | 20 | 2,3 | 105 | 105 | -- | 17 | 3 | | |
| 113 | H | 3'-0" x 7'-0" | 13/4 | HM | SGP | HM | SGP | T | TNT | -- | -- | 1,2 | 82 | 83 | 84 | 08 | 1 | 155 | H | 3'-0" x 7'-0" | 13/4 | SC | LP | HM | SGP | T | CLR | -- | -- | 3 | 105 | 105 | -- | 25 | 3 | | |
| 114 | E | 3'-0" x 7'-0" | 13/4 | HM | SGP | HM | SGP | -- | -- | -- | -- | 1,2,3 | 82 | 83 | 84 | 09 | 3 | 156 | D | 3'-0" x 7'-0" | 13/4 | SC | LP | HM | SGP | T | CLR | -- | 20 | 2,3 | 105 | 105 | -- | 17 | 3 | | |
| 115 | B | PAIR 3'-0" x 7'-0" | 13/4 | ALUM | ANOD | ALUM | ANOD | T | TNT | -- | -- | 1,2,3 | 86 | 87 | 88 | 02 | 1 | 157 | D | 3'-0" x 7'-0" | 13/4 | SC | LP | HM | SGP | T | CLR | -- | 20 | 2,3 | 105 | 105 | -- | 17 | 3 | | |
| 116 | E | 3'-0" x 7'-0" | 13/4 | HM | SGP | HM | SGP | -- | -- | -- | -- | 4 | 82 | 83 | 84 | 11 | 2 | 158 | H | 3'-0" x 7'-0" | 13/4 | SC | LP | HM | SGP | T | CLR | -- | -- | 3 | 105 | 105 | -- | 25 | 3 | | |
| 117 | E | 3'-0" x 7'-0" | 13/4 | HM | SGP | HM | SGP | -- | -- | -- | -- | 4 | 82 | 83 | 84 | 10 | 2 | 159 | D | 3'-0" x 7'-0" | 13/4 | SC | LP | HM | SGP | T | CLR | -- | 20 | 2,3 | 105 | 105 | -- | 17 | 3 | | |
| 118 | B | PAIR 3'-0" x 7'-0" | 13/4 | ALUM | ANOD | ALUM | ANOD | T | TNT | -- | -- | 1,2,3 | 86 | 87 | 88 | 01 | 1 | 160 | E | 3'-0" x 7'-0" | 13/4 | SC | LP | HM | SGP | -- | -- | 45 | 3 | 105 | 105 | -- | 26 | 3 | | | |
| 119 | G | 3'-0" x 7'-0" | 13/4 | SC | LP | HM | SGP | T | CLR | -- | 20 | 2,3 | 105 | 105 | -- | 17 | 3 | 161 | D | 3'-0" x 7'-0" | 13/4 | SC | LP | HM | SGP | T | CLR | -- | 20 | 2,3 | 105 | 105 | -- | 17 | 3 | | |
| 120 | E | 3'-0" x 7'-0" | 13/4 | SC | LP | HM | SGP | T | CLR | -- | 45 | 4 | 105 | 105 | -- | 20 | 2 | 162 | D | 3'-0" x 7'-0" | 13/4 | SC | LP | HM | SGP | T | CLR | -- | 45 | 2,3 | 105 | 105 | -- | 17 | 3 | | |
| 121 | E | 3'-0" x 7'-0" | 13/4 | SC | LP | HM | SGP | T | CLR | -- | 20 | 3 | 105 | 105 | -- | 26 | 3 | 163 | H | 3'-0" x 7'-0" | 13/4 | SC | LP | HM | SGP | T | CLR | -- | -- | 3 | 105 | 105 | -- | 25 | 3 | | |
| 122 | D | 3'-0" x 7'-0" | 13/4 | SC | LP | HM | SGP | T | CLR | -- | 20 | 2,3 | 105 | 105 | -- | 17 | 3 | 164 | D | 3'-0" x 7'-0" | 13/4 | SC | LP | HM | SGP | T | CLR | -- | 20 | 2,3 | 105 | 105 | -- | 17 | 3 | | |
| 123 | H | 3'-0" x 7'-0" | 13/4 | SC | LP | HM | SGP | T | CLR | -- | -- | 3 | 105 | 105 | -- | 24 | 3 | 165 | H | 3'-0" x 7'-0" | 13/4 | SC | LP | HM | SGP | T | CLR | -- | 20 | 2,3 | 105 | 105 | -- | 17 | 3 | | |
| 124 | E | 3'-0" x 7'-0" | 13/4 | SC | LP | HM | SGP | -- | -- | -- | -- | 4 | 105 | 105 | -- | 19 | 2 | 166 | H | 3'-0" x 7'-0" | 13/4 | SC | LP | HM | SGP | T | CLR | -- | -- | 3 | 105 | 105 | -- | 08 | 3 | | |
| 125 | E | 3'-0" x 7'-0" | 13/4 | SC | LP | HM | SGP | -- | -- | -- | -- | 4 | 105 | 105 | -- | 19 | 2 | 167 | E | 3'-0" x 7'-0" | 13/4 | SC | LP | HM | SGP | -- | -- | 45 | 3 | 105 | 105 | -- | 17 | 3 | | | |
| 126 | H | 3'-0" x 7'-0" | 13/4 | SC | LP | HM | SGP | T | CLR | -- | -- | 3 | 105 | 105 | -- | 24 | 3 | 168 | E | 3'-0" x 7'-0" | 13/4 | SC | LP | HM | SGP | -- | -- | 20 | 3 | 105 | 105 | -- | 17 | 3 | | | |
| 127 | D | 3'-0" x 7'-0" | 13/4 | SC | LP | HM | SGP | T | CLR | -- | 20 | 2,3 | 105 | 105 | -- | 17 | 3 | 170 | H | 3'-0" x 7'-0" | 13/4 | SC | LP | HM | SGP | T | CLR | -- | 45 | 2,3 | 105 | 105 | -- | 17 | 3 | | |
| 128 | E | 3'-0" x 7'-0" | 13/4 | SC | LP | HM | SGP | -- | -- | -- | 45 | 3 | 105 | 105 | -- | 26 | 3 | 171 | K | 3'-0" x 3'-8" | 13/4 | SC | LP | | | | | | | | | | 29 | 3 | | | |
| 129 | D | 3'-0" x 7'-0" | 13/4 | SC | LP | HM | SGP | T | CLR | -- | 20 | 2,3 | 105 | 105 | -- | 17 | 3 | | | | | | | | | | | | | | | | | | | | |
| 130 | H | 3'-0" x 7'-0" | 13/4 | SC | LP | HM | SGP | T | CLR | -- | -- | 3 | 105 | 105 | -- | 24 | 3 | | | | | | | | | | | | | | | | | | | | |
| 131 | E | 3'-0" x 7'-0" | 13/4 | SC | LP | HM | SGP | -- | -- | -- | -- | 4 | 105 | 105 | -- | 19 | 2 | 173 | | | | | | | | | | | | | | | | | | | |
| 132 | E | 3'-0" x 7'-0" | 13/4 | SC | LP | HM | SGP | -- | -- | -- | -- | 4 | 105 | 105 | -- | 19 | 2 | 174 | | | | | | | | | | | | | | | | | | | |
| 133 | H | 3'-0" x 7'-0" | 13/4 | SC | LP | HM | SGP | T | CLR | -- | -- | 3 | 105 | 105 | -- | 24 | 3 | 175 | | | | | | | | | | | | | | | | | | | |
| 134 | D | 3'-0" x 7'-0" | 13/4 | SC | LP | HM | SGP | T | CLR | -- | 20 | 2,3 | 105 | 105 | -- | 17 | 3 | 176 | | | | | | | | | | | | | | | | | | | |
| 135 | E | 3'-0" x 6'-0" | 13/4 | SC | LP | HM | SGP | -- | -- | -- | 45 | 3 | 105 | 105 | -- | 26 | 3 | | | | | | | | | | | | | | | | | | | | |
| 136 | H | 3'-0" x 7'-0" | 13/4 | SC | LP | HM | SGP | T | CLR | -- | -- | 3 | 105 | 105 | -- | 23 | 3 | | | | | | | | | | | | | | | | | | | | |
| 137 | F | 3'-0" x 7'-0" | 13/4 | HM | LP | HM | SGP | -- | -- | -- | -- | 3 | 105 | 105 | -- | 12 | 3 | | | | | | | | | | | | | | | | | | | | |
| 138 | E | 3'-0" x 7'-0" | 13/4 | SC | LP | HM | SGP | T | CLR | -- | -- | 3 | 105 | 105 | -- | 23 | 3 | | | | | | | | | | | | | | | | | | | | |
| 139 | E | 3'-0" x 7'-0" | 13/4 | SC | LP | HM | SGP | -- | -- | -- | 45 | 2,3 | 105 | 105 | -- | 16 | 3 | | | | | | | | | | | | | | | | | | | | |
| 140 | E | 3'-0" x 7'-0" | 13/4 | SC | LP | HM | SGP | -- | -- | -- | -- | 3 | 105 | 105 | -- | 28 | 3 | | | | | | | | | | | | | | | | | | | | |
| 141 | H | 3'-0" x 7'-0" | 13/4 | SC | LP | HM | SGP | T | CLR | -- | -- | 3 | 105 | 105 | -- | 23 | 3 | | | | | | | | | | | | | | | | | | | | |
| 142 | E | 3'-0" x 7'-0" | 13/4 | SC | LP | HM | SGP | -- | -- | -- | -- | 3 | 105 | 105 | -- | 23 | 4 | | | | | | | | | | | | | | | | | | | | |

ABBREVIATIONS

| | | | |
|------|-------------------|------|------------------|
| ALUM | ALUMINUM | MT | MARLITE PANEL |
| ANOD | ANODIZED | P | PAINT |
| CLN | CLEAN | PL | PLATE |
| CLR | CLEAR | PW | PICTURE WINDOW |
| CPT | CARPET (N.I.C.) | S | SINGLE GLAZED |
| CV | INTEGRAL COVE | SC | SOLID CORE |
| DL | DUAL GLAZED | SGP | SEMI-GLOSS PAINT |
| EP | EPOXY PAINT | SH | SINGLE-HUNG |
| ESP | EGG SHELL PAINT | SIGN | PROVIDE SIGNAGE |
| EXP | EXPOSED STRUCTURE | SL | SEAL |
| FG | FIBERGLASS | STN | STAIN |
| FF | FACTORY FINISH | STL | STEEL |
| FP | FACTORY PAINT | T | TEMPERED |
| FR | FIRE RATED | TF | "TIMELY" FRAME |
| FT | FACTORY | TNT | TINTED |
| GBLK | GLASS BLOCK | TT | TAPE & TEXTURED |
| HM | HOLLOW METAL | VAR | VARIES |
| LP | LAMINATE PLASTIC | W | WIRE GLASS |
| | | WD | WOOD |

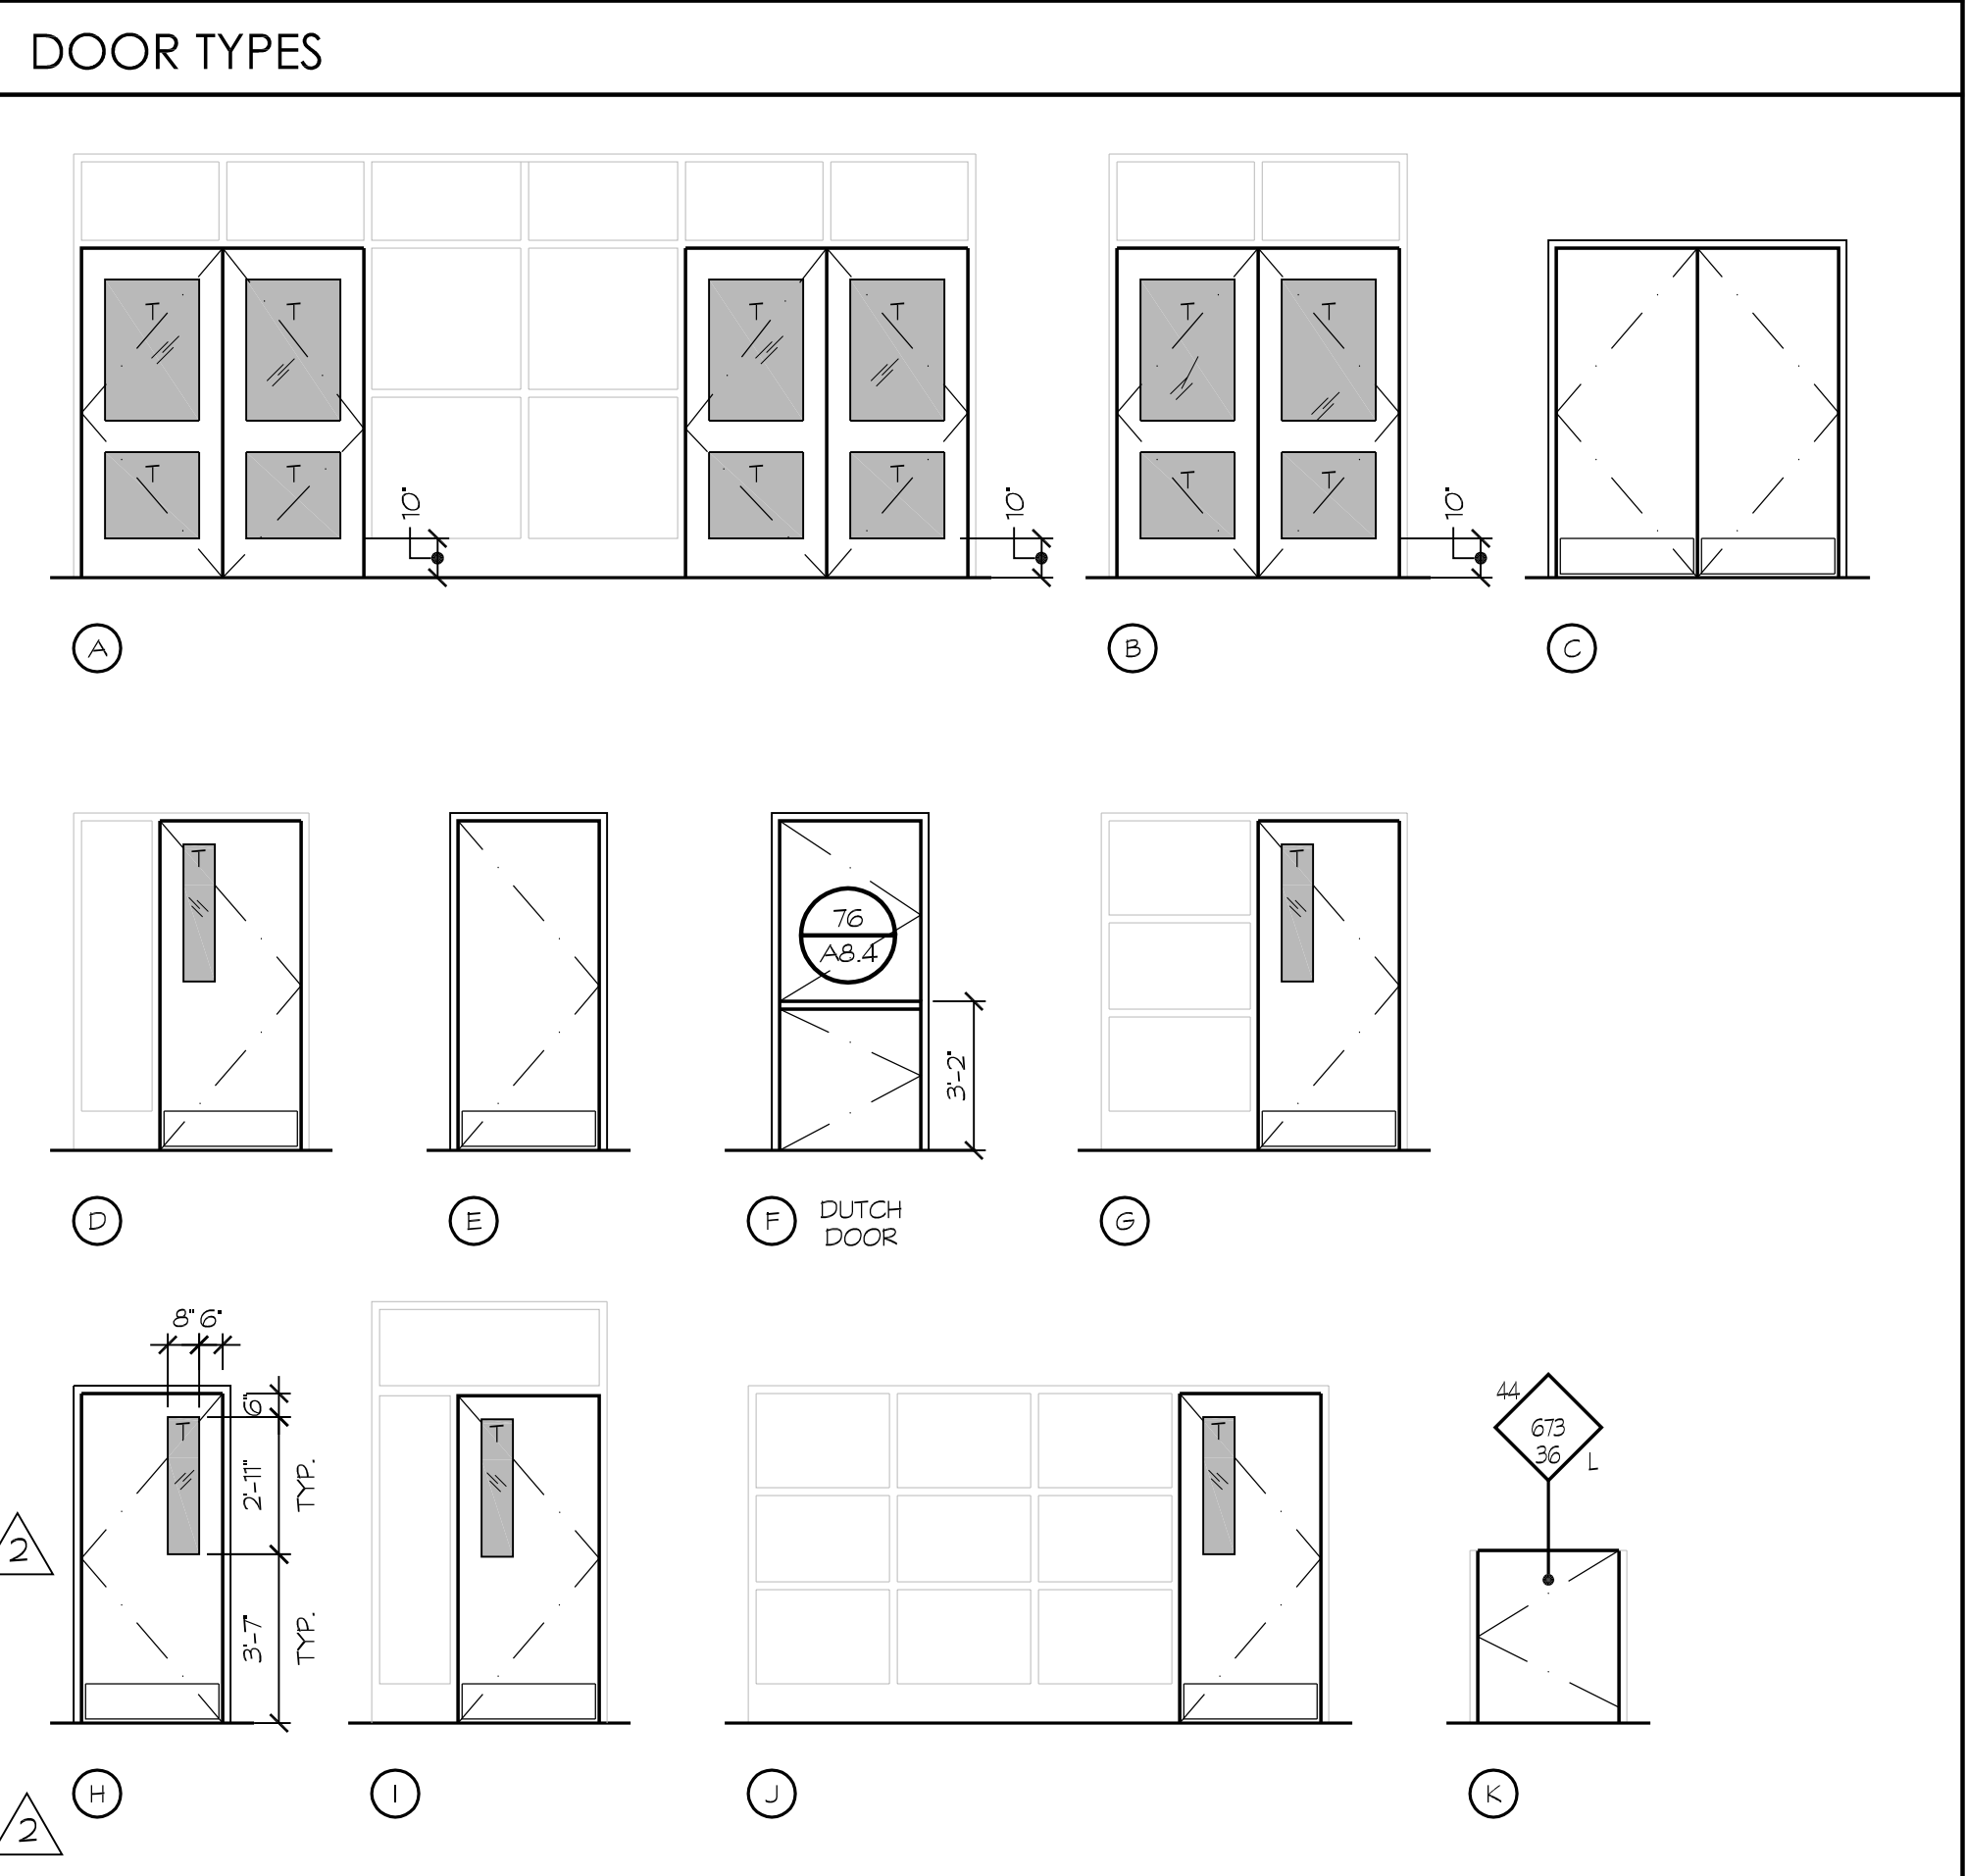

REMARKS

1. PROVIDE ACCESSIBLE EXIT SIGNAGE. SEE DETAIL 201/A8.11
2. PROVIDE ACCESSIBLE RESTROOM SIGNAGE. SEE DETAIL 217/A8.11
3. PROVIDE ROOM IDENTIFICATION SIGNAGE. SEE DETAIL 212/A8.11

GENERAL NOTES

1. SEE SPECIFICATIONS FOR SUSPENDED ACOUSTICAL CEILING TILE TYPE.
2. ARCHITECT TO SELECT PAINT COLORS AND LOCATIONS.
3. WINDOW JAMBS AT LOCATIONS WITH VINYL TACKBOARD FINISH TO RECEIVE V.T.B. WRAP.
4. ALL GLAZING WITHIN 24" OF A DOOR OR OPERABLE WINDOW SHALL BE TEMPERED GLASS
5. SEE SPECIFICATION SECTION 10400 FOR DOOR & ROOM SIGNAGE
6. ALL FINISH MATERIALS SHALL COMPLY WITH CBC TABLE 803.5
7. FOR CONDITIONS AT METAL PANELS NOT SPECIFICALLY REFERENCED, SEE SHEETS A8.14 & A8.15. DOORS TO BE SIMILAR TO WINDOWS. COORDINATE W/ METAL PANEL MANUFACTURER.
8. SEE DETAIL #179/A8.9 FOR HM FRAME ANCHORAGE, TYP.
9. SEE GENERAL NOTES ON COLOR SCHEDULE, SHEET A2.8, FOR TYPICAL DOOR & WINDOW FINISHES.
10. HANDLES, PULLS, LATCHES, LOCKS, AND OTHER OPERABLE PARTS ON DOORS AND GATES SHALL BE 34 INCHES MINIMUM AND 44 INCHES MAXIMUM ABOVE THE FINISH FLOOR OR GROUND.
11. FOR ADDITIONAL SIGNAGE NOT SHOWN IN SCHEDULE, SEE T4

DOOR SIGNAGE

1. BUILDING ENTRANCE/ISA SIGNAGE. SEE DETAIL 212 / A8.11
2. TACTILE EXIT SIGNAGE. SEE DETAIL 201/A8.11, AND/OR SEE ELECTRICAL PLANS FOR ILLUMINATED EXIT REQUIREMENTS.
3. ROOM IDENTIFICATION SIGNAGE. SEE DETAIL 212/A8.11 (VERIFY ROOM NAME & NUMBER w/ OWNER). WHERE TWO ROOMS ADJOIN ONE ANOTHER, PROVIDE SIGNAGE ON EACH SIDE OF THE WALL, TYP. ALL ROOMS.
4. RESTROOM SIGNAGE. SEE DETAIL 217/A8.11.




SHIELDS & BRAWLEY ELEMENTARY SCHOOL



**AD 2-14a
S&B Elementary
02-116800**

JOHN H. SMITH, AIA, C15885

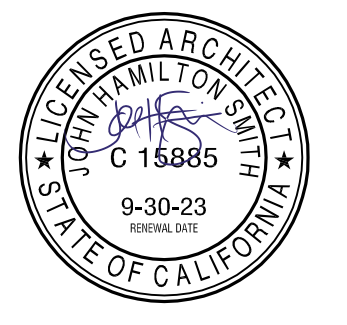

THE FIRM OF SMITH, AWAN


| WINDOW SCHEDULE | | | | | | | | | | | WINDOW SCHEDULE | | | | | | | | | | | | |
|-----------------|-------------|-------------------|--------|--------|----------|--------|-------------|---------|------|------|-----------------|------------|-------------|-------------------|--------|--------|----------|--------|-------------|---------|------|------|---------|
| WINDOW No. | WINDOW TYPE | WINDOW DIMENSIONS | WINDOW | | FRAME | | | DETAILS | | | REMARKS | WINDOW No. | WINDOW TYPE | WINDOW DIMENSIONS | WINDOW | | FRAME | | | DETAILS | | | REMARKS |
| | | | TYPE | FINISH | MATERIAL | FINISH | FIRE RATING | HEAD | JAMB | SILL | | | | | TYPE | FINISH | MATERIAL | FINISH | FIRE RATING | HEAD | JAMB | SILL | |
| 101 | A | 26'-0" x 12'-6" | DL | TNT | ALUM | ANOD | 90 | 91 | 106 | | | 139 | P | 17'-8" x 9'-4" | DL | TNT | ALUM | ANOD | 261 | 265 | 267 | 1 | |
| 102 | D | 24'-0" x 9'-4" | DL | TNT | ALUM | ANOD | 261 | 265 | 267 | | 1 | 140 | G | 6'-0" x 7'-2" | S | CLR | HM | P | 45 | A8.6 | A8.6 | A8.6 | |
| 103 | | | | | | | | | | | | 141 | G | 5'-0" x 7'-2" | S | CLR | HM | P | 45 | 107 | 107 | 107 | |
| 104 | L | 6'-4" x 9'-0" | DL | TNT | ALUM | ANOD | 90 | 91 | 86 | | | 142 | M | 6'-0" x 3'-0" | S | CLR | HM | P | | 107 | 107 | 107 | |
| 105 | B | 7'-0" x 5'-10" | DL | TNT | FG | FT | 94 | 95 | 267 | | | 143 | M | 6'-0" x 3'-0" | S | CLR | HM | P | | 107 | 107 | 107 | |
| 106 | E | 2'-0" x 2'-0" | DL | OBSC | FG | FT | 94 | 95 | 96 | | 2 | 144 | G | 5'-0" x 7'-2" | S | CLR | HM | P | 45 | 107 | 107 | 107 | |
| 107 | E | 2'-0" x 2'-0" | DL | OBSC | FG | FT | 94 | 95 | 96 | | 2 | 145 | G | 5'-0" x 7'-2" | S | CLR | HM | P | 45 | 107 | 107 | 107 | |
| 108 | C | 7'-0" x 5'-10" | DL | TNT | FG | FT | 98 | 99 | 100 | | 2 | 146 | M | 6'-0" x 3'-0" | S | CLR | HM | P | | 107 | 107 | 107 | |
| 109 | | NOT USED | | | | | | | | | | 147 | M | 6'-0" x 3'-0" | S | CLR | HM | P | | 107 | 107 | 107 | |
| 110 | B | 7'-0" x 5'-10" | DL | TNT | FG | FT | 98 | 99 | 100 | | 1 | 148 | G | 5'-0" x 7'-2" | S | CLR | HM | P | 45 | 107 | 107 | 107 | |
| 111 | H | 3'-0" x 5'-10" | DL | TNT | FG | FT | 98 | 99 | 100 | | 1,2 | 149 | | NOT USED | | | | | | | | | |
| 112 | H | 3'-0" x 5'-10" | DL | TNT | FG | FT | 98 | 99 | 100 | | 1,2 | 150 | N | 9'-0" x 9'-6" | S | CLR | HM | P | | 107 | 107 | 107 | |
| 113 | I | 6'-0" x 5'-10" | DL | TNT | FG | FT | 98 | 99 | 100 | | 1,2 | 151 | N | 9'-0" x 9'-6" | S | CLR | HM | P | | 107 | 107 | 107 | |
| 114 | T | 5'-0" x 9'-0" | DL | TNT | ALUM | ANOD | 90 | 91 | 106 | | 1 | 152 | K | 5'-0" x 7'-2" | S | CLR | HM | P | | 107 | 107 | 107 | |
| 115 | J | 6'-0" x 5'-10" | DL | TNT | FG | FT | 98 | 99 | 100 | | 1 | 153 | O | 12'-4" x 7'-2" | S | CLR | HM | P | | 107 | 107 | 107 | 1 |
| 116 | E | 2'-0" x 2'-0" | DL | OBSC | FG | FT | 94 | 95 | 96 | | 2 | 154 | K | 5'-0" x 7'-2" | S | CLR | HM | P | | 107 | 107 | 107 | |
| 117 | E | 2'-0" x 2'-0" | DL | OBSC | FG | FT | 94 | 95 | 96 | | 2 | 155 | G | 5'-0" x 7'-2" | S | CLR | HM | P | 45 | A8.6 | A8.6 | A8.6 | |
| 118 | I | 6'-0" x 5'-10" | DL | TNT | FG | FT | 94 | 95 | 267 | | 1 | 156 | G | 5'-0" x 7'-2" | S | CLR | HM | P | 45 | 107 | 107 | 107 | |
| 119 | J | 6'-0" x 5'-10" | DL | TNT | FG | FT | 94 | 95 | 267 | | 1 | 157 | G | 5'-0" x 7'-2" | S | CLR | HM | P | 45 | 107 | 107 | 107 | |
| 120 | S | 3'-0" x 4'-0" | DL | TNT | FG | FT | 94 | 95 | 96 | | 1 | 158 | G | 5'-0" x 7'-2" | S | CLR | HM | P | 45 | A8.6 | A8.6 | A8.6 | |
| 121 | J | 6'-0" x 5'-10" | DL | TNT | FG | FT | 261 | 265 | 267 | | 1 | 159 | G | 5'-0" x 7'-2" | S | CLR | HM | P | 45 | 107 | 107 | 107 | |
| 122 | R | 8'-0" x 5'-10" | DL | TNT | FG | FT | 261 | 265 | 267 | | 1 | 160 | G | 5'-0" x 7'-2" | S | CLR | HM | P | 45 | 107 | 107 | 107 | |
| 123 | I | 6'-0" x 5'-10" | DL | TNT | FG | FT | 261 | 265 | 267 | | 1 | 161 | G | 5'-0" x 7'-2" | S | CLR | HM | P | 45 | 107 | 107 | 107 | |
| 124 | S | 4'-6" x 4'-0" | DL | TNT | FG | FT | 94 | 95 | 96 | | 1 | | | | | | | | | | | | 2 |
| 125 | C | 7'-0" x 5'-10" | DL | TNT | FG | FT | 98 | 99 | 100 | | 1 | 163 | | NOT USED | | | | | | | | | |
| 126 | B | 7'-0" x 5'-10" | DL | TNT | FG | FT | 98 | 99 | 100 | | 1 | 164 | T | 5'-0" x 9'-0" | DL | TNT | ALUM | ANOD | 90 | 91 | 106 | | |
| 127A | C | 7'-0" x 5'-10" | DL | TNT | FG | FT | 94 | 95 | 267 | | 1 | 165 | | NOT USED | | | | | | | | | |
| 127B | B | 7'-0" x 5'-10" | DL | TNT | FG | FT | 94 | 95 | 267 | | 1 | 166 | | NOT USED | | | | | | | | | |
| 128 | C | 7'-0" x 5'-10" | DL | TNT | FG | FT | 98 | 99 | 100 | | 1 | 167 | | NOT USED | | | | | | | | | |
| 129 | B | 7'-0" x 5'-10" | DL | TNT | FG | FT | 98 | 99 | 100 | | 1 | 168 | | NOT USED | | | | | | | | | |
| 130 | C | 7'-0" x 5'-10" | DL | TNT | FG | FT | 94 | 95 | 267 | | 1 | 169 | E | 4'-0" x 4'-0" | S | CLR | HM | P | | 107 | 107 | 107 | 1 |
| 131A | B | 7'-0" x 5'-10" | DL | TNT | FG | FT | 94 | 95 | 267 | | 1 | 170 | | NOT USED | | | | | | | | | |
| 131B | H | 3'-0" x 5'-10" | DL | TNT | FG | FT | 98 | 99 | 100 | | 1,2 | 171 | | NOT USED | | | | | | | | | |
| 132 | H | 3'-0" x 5'-10" | DL | TNT | FG | FT | 98 | 99 | 100 | | 1,2 | | | | | | | | | | | | |
| 133A | C | 7'-0" x 5'-10" | DL | TNT | FG | FT | 98 | 99 | 100 | | 1 | | | | | | | | | | | | |
| 133B | B | 7'-0" x 5'-10" | DL | TNT | FG | FT | 98 | 99 | 100 | | 1 | | | | | | | | | | | | |
| 134A | C | 7'-0" x 5'-10" | DL | TNT | FG | FT | 94 | 95 | 267 | | 1 | | | | | | | | | | | | |
| 134B | B | 7'-0" x 5'-10" | DL | TNT | FG | FT | 94 | 95 | 267 | | 1 | | | | | | | | | | | | |
| 135 | C | 7'-0" x 5'-10" | DL | TNT | FG | FT | 98 | 99 | 100 | | 1 | | | | | | | | | | | | |
| 136 | B | 7'-0" x 5'-10" | DL | TNT | FG | FT | 98 | 99 | 100 | | 1 | | | | | | | | | | | | |
| 137 | C | 7'-0" x 5'-10" | DL | TNT | FG | FT | 94 | 95 | 267 | | 1 | | | | | | | | | | | | |
| 138 | Q | 34'-10" x 9'-4" | DL | TNT | ALUM | ANOD | 261 | 265 | 267 | | 1 | | | | | | | | | | | | |

GENERAL NOTES

- ALL WINDOWS WITHIN 24" OF DOOR OR 18" FROM GROUND SHALL BE TEMPERED GLASS.
- WINDOW JAMBS AT LOCATIONS WITH VINYL BACKBOARD FINISH TO RECEIVE V.T.B. WRAP.
- ALL GLAZING WITHIN 24" OF DOOR OR OPERABLE WINDOW ARE TO BE TEMPERED.
- SEE 97/A8.5 FOR FLASHING SEQUENCE
- FOR CONDITIONS AT METAL PANELS NOT SPECIFICALLY REFERENCED, SEE SHEETS A8.14 & A8.15

REMARKS

- PROVIDE VERTICAL LOUVERS (SPEC. SECTION 12510)
- WINDOWS ARE FIXED, DETAIL SHOWS OPENABLE

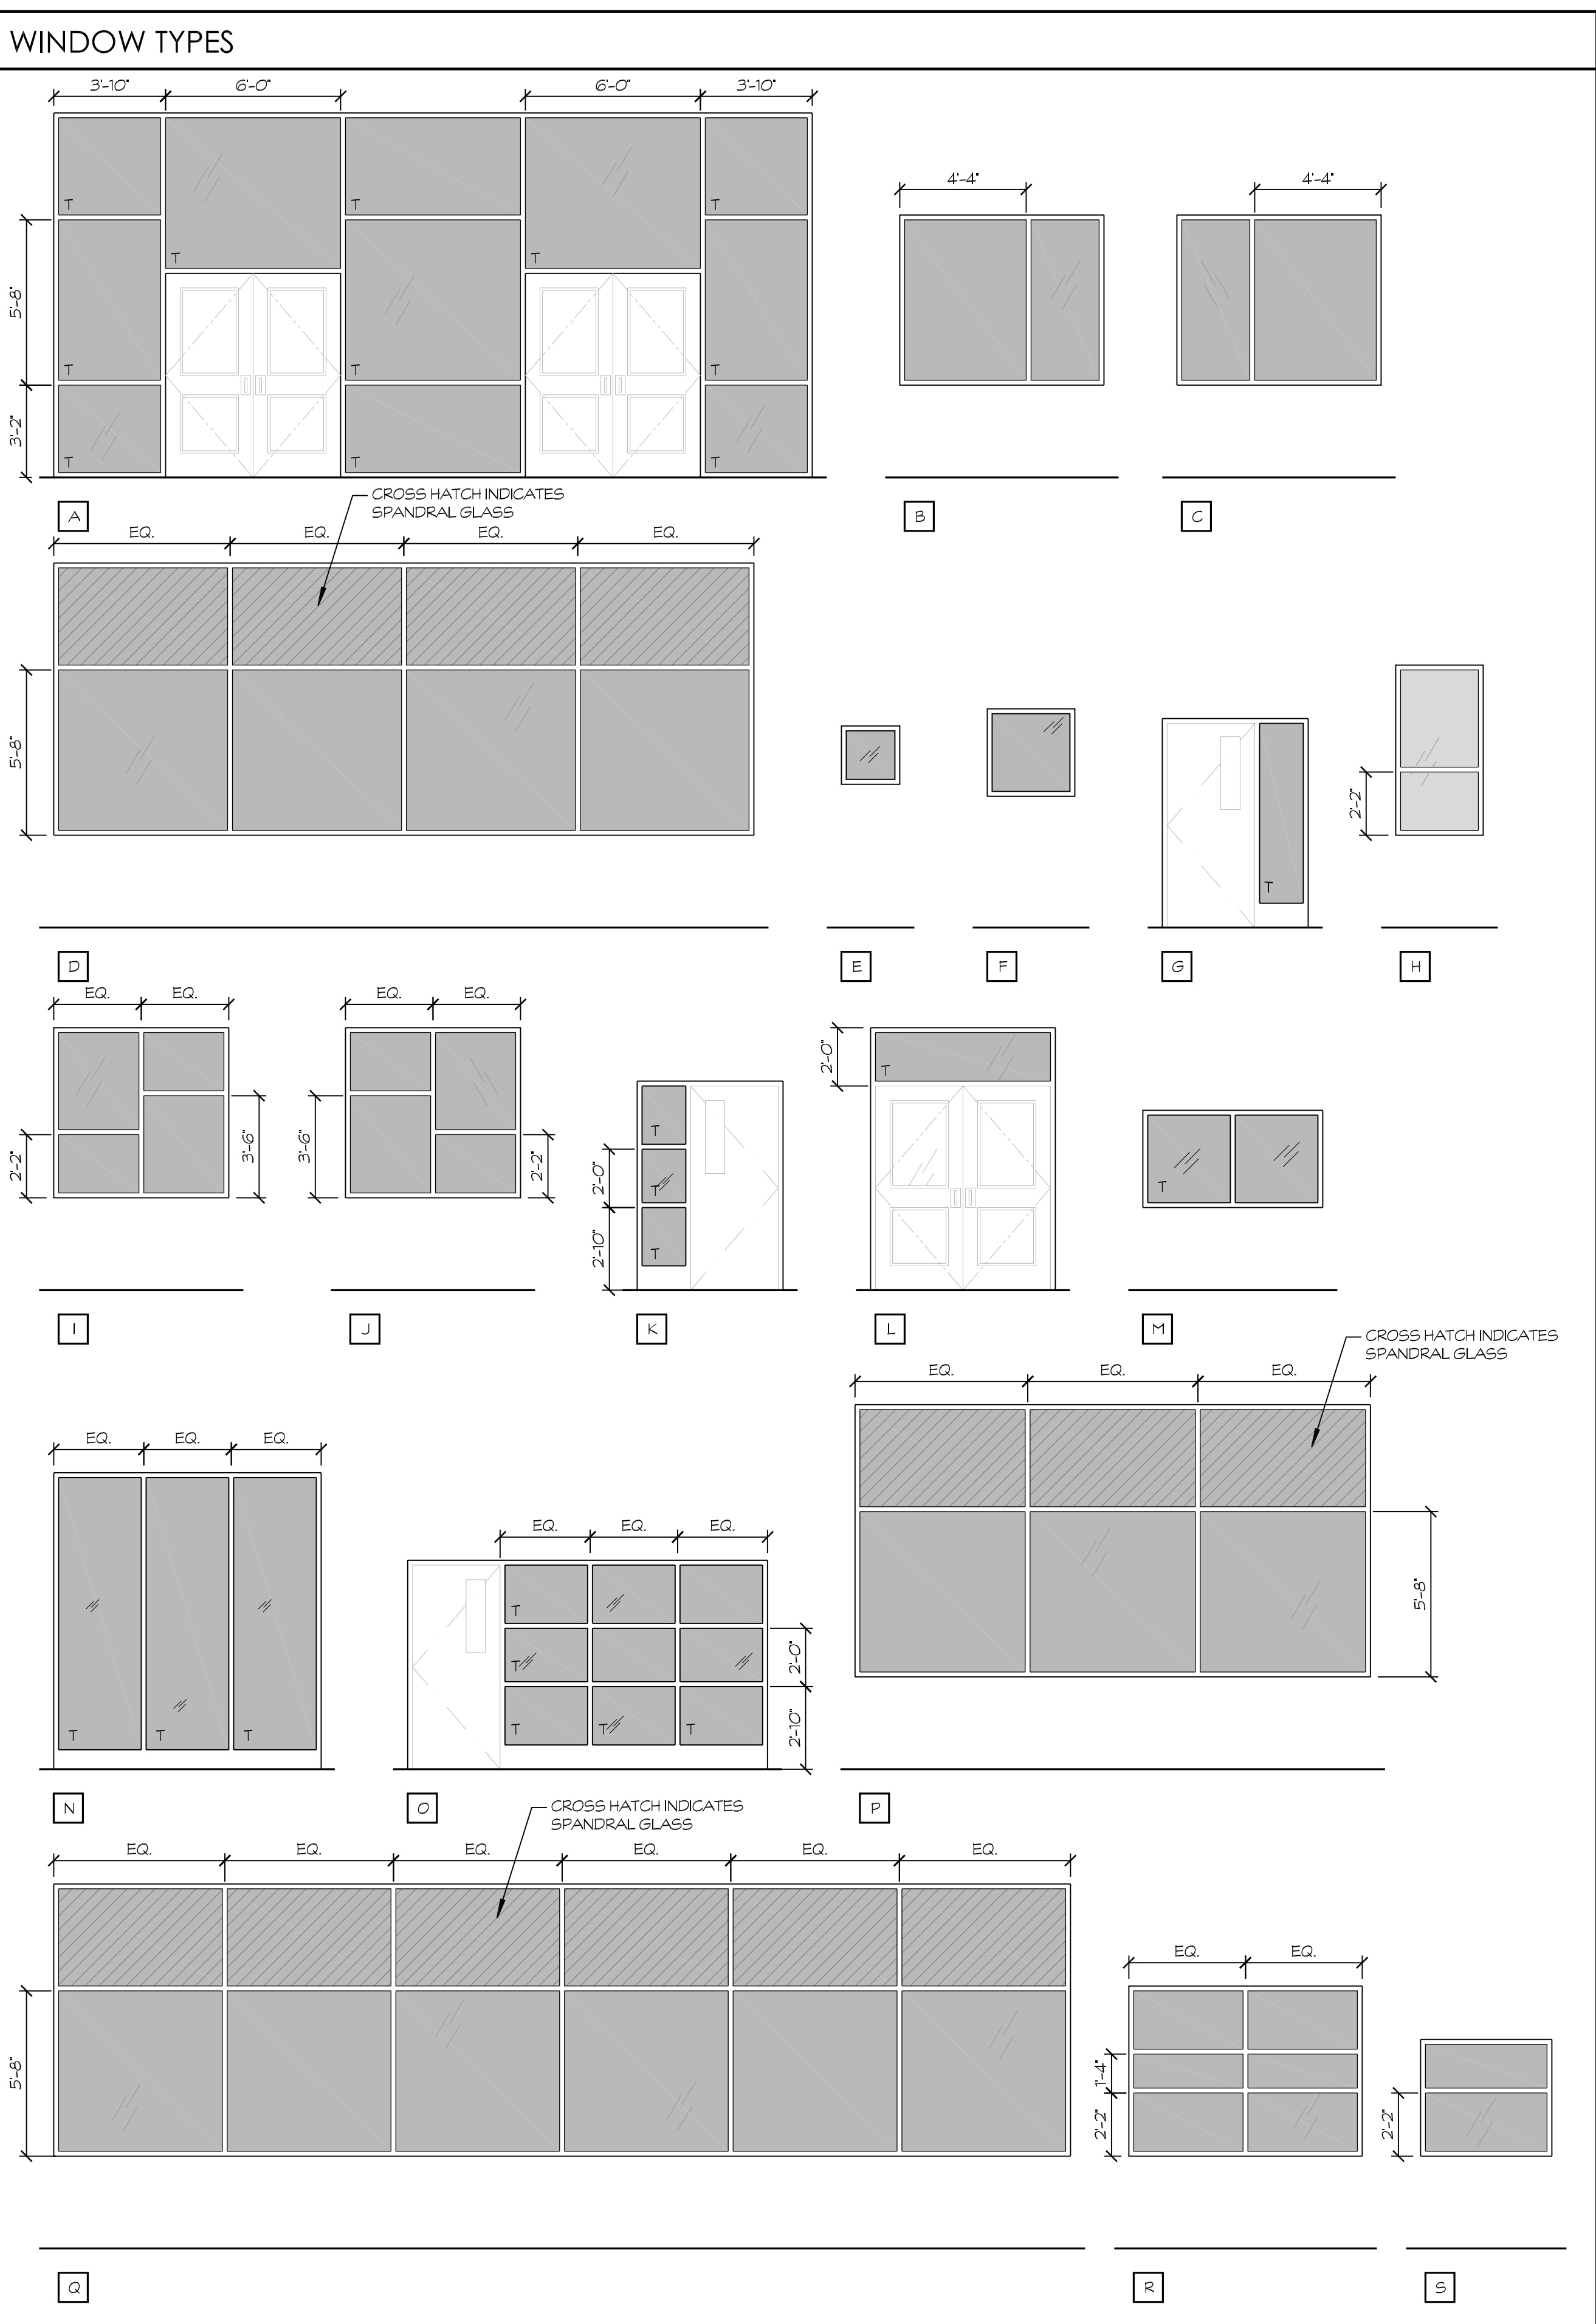

ABBREVIATIONS

| | | | | | |
|------|---------------------|------|------------------|-----|-------------------------|
| ALUM | ALUMINUM | FR | FIRE RATED | SGP | SEMI GLOSS PAINT |
| ANOD | ANODIZED | FT | FACTORY | SH | SINGLE-HUNG |
| CLV | CLEAN | GBLK | GLASS BLOCK | SL | SEAL |
| CLR | CLEAR INTEGRAL | HM | HOLLOW METAL | STN | STAIN |
| CV | COVE | LP | LAMINATE PLASTIC | STL | STEEL |
| DL | DUAL GLAZED | MT | MARLITE PANEL | TTT | TEMPERED "TIMELY" FRAME |
| EP | EPOXY PAINT | OBSC | OBSOLETE | TNT | TINTED |
| ESP | EGG SHELL PAINT | P | PAINT | TT | TAPE & TEXTURED |
| FG | FIBERGLASS (FRAMES) | FL | FLUTE | VAR | VARIABLE |
| FF | FABRIC FINISH | PW | PICTURE WINDOW | W | WIRE GLASS |
| FP | FACTORY FINISH | SC | SOLID CORE | | |


SIMPRK

7790 NORTH PALM AVENUE
 FRESNO, CALIFORNIA 93711
 T559.448.8400 · F559.448.8467
 www.slm-pbk.com

PROJECT:
**SHIELDS
 & BRAWLEY
 ELEMENTARY
 SCHOOL**



AD 2-15a
S&B Elementary
02-116800

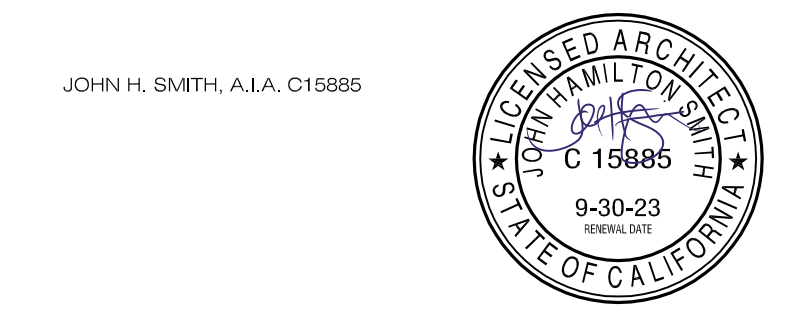

THE FIRM OF SMITH, IWANAGA, MULLIGAN, ARCHITECTS, INC. EXPRESSLY RESERVES ITS OWNERSHIP, COPYRIGHT AND OTHER APPLICABLE PROPERTY RIGHTS IN THESE PLANS. THESE PLANS ARE NOT TO BE REPRODUCED, CHANGED, OR COPIED IN ANY FORM OR MANNER WITHOUT THE WRITTEN PERMISSION AND CONSENT OF THE ARCHITECT. IN THE EVENT OF UNAUTHORIZED REUSE OF THESE PLANS BY A THIRD PARTY, THE THIRD PARTY SHALL HOLD THE ARCHITECT HARMLESS, AND SHALL BEAR THE COST OF THE ARCHITECT'S LEGAL FEES ASSOCIATED WITH DEFENDING AND ENFORCING THESE RIGHTS.

PROJECT DEVELOPMENT

| DATE | ISSUED FOR |
|------|------------|
| | |
| | |
| | |
| | |

REVISIONS

| No. | DATE | DESCRIPTION |
|-----|---------|------------------------|
| 1 | 2.14.23 | DISTRICT MODIFICATIONS |
| 2 | 2.27.23 | DISTRICT MODIFICATIONS |

SHEET DESCRIPTION

WINDOW SCHEDULE

MAIN - 1ST FLOOR

| | |
|-----------------------------------|--------------------------|
| PROJECT COORDINATOR JOHN SMITH | SHEET No. A2.3 |
| PROJECT NO. 17-67 | |
| DATE 1.27.23 | |
| SCALE 1/4" = 1'-0" | |

A:\17-67 Shields & Brawley Elementary\Work\17-67_A2.3_Window Schedule_09/29/23_21:08

FINISH SCHEDULE

2

| ROOM NO. | ROOM DESCRIPTION | FLOOR | | | | | | | | | BASE | | | WAINSCOT | | | WALLS | | | | | | | | CEILING | FLOOR COLOR NOTE | REMARKS |
|----------|------------------|------------|--------|----------|--------|--------|----------|--------|--------|----------|--------|--------|----------|----------|----------|--------|----------|--------|----------|--------|----------------------------------|--------|--|--|---------|------------------|---------|
| | | MATERIAL | FINISH | MATERIAL | FINISH | HEIGHT | MATERIAL | FINISH | HEIGHT | MATERIAL | FINISH | HEIGHT | EAST | | SOUTH | | WEST | | NORTH | | | | | | | | |
| | | | | | | | | | | | | | MATERIAL | FINISH | MATERIAL | FINISH | MATERIAL | FINISH | MATERIAL | FINISH | MATERIAL | FINISH | | | | | |
| 201 | CORRIDOR | CONC | CD | RTB | FT | 4' | AC | FT | 4.8' | GB | ESP | GB | ESP | GB | ESP | GB | ESP | GB | ESP | | | | | | | | |
| 202 | STAIRS | RT | FT | RTB | FT | 4' | --- | --- | --- | GB | ESP | GB | ESP | GB | ESP | GB | ESP | GB | ESP | | | | | | | | |
| 203 | CLASSROOM 14 | CPT LVT | FT | RTB | FT | 4' | --- | --- | --- | VTB | FT | VTB | FT | VTB | FT | VTB | FT | VTB | FT | | CPT-1 CPT-3 LVT-1 CPT-2 CPT-5 | | | | | | |
| 204 | CLASSROOM 13 | CPT LVT | FT | RTB | FT | 4' | --- | --- | --- | VTB | FT | VTB | FT | GB | ESP | VTB | FT | VTB | FT | | | | | | | | |
| 205 | CLASSROOM 12 | CPT LVT | FT | RTB | FT | 4' | --- | --- | --- | GB | ESP | VTB | FT | VTB | FT | VTB | FT | VTB | FT | | | | | | | | |
| 206 | CLASSROOM 11 | CPT LVT | FT | RTB | FT | 4' | --- | --- | --- | VTB | FT | VTB | FT | GB | ESP | VTB | FT | VTB | FT | | | | | | | | |
| 207 | STAIRS | RT | FT | RTB | FT | 4' | --- | --- | --- | GB | ESP | GB | ESP | GB | ESP | GB | ESP | GB | ESP | | | | | | | | |
| 208 | STORAGE | CONC | SL | RTB | FT | 4' | --- | --- | --- | GB | SGP | GB | SGP | GB | SGP | GB | SGP | GB | SGP | | | | | | | | |
| 209 | CLASSROOM 8 | CPT LVT | FT | RTB | FT | 4' | --- | --- | --- | VTB | FT | VTB | FT | GB | ESP | VTB | FT | VTB | FT | | CPT-1 CPT-3 LVT-1 CPT-2 CPT-5 | | | | | | |
| 210 | CLASSROOM 9 | CPT LVT | FT | RTB | FT | 4' | --- | --- | --- | GB | ESP | VTB | FT | VTB | FT | VTB | FT | VTB | FT | | | | | | | | |
| 211 | CLASSROOM 10 | CPT LVT | FT | RTB | FT | 4' | --- | --- | --- | VTB | FT | VTB | FT | GB | ESP | VTB | FT | VTB | FT | | | | | | | | |
| 212 | ELEVATOR | --- | --- | --- | --- | --- | --- | --- | --- | --- | --- | --- | --- | --- | --- | --- | --- | --- | --- | | | | | | | | |
| 213 | CLASSROOM | CPT LVT | FT | RTB | FT | 4' | --- | --- | --- | VTB | FT | VTB | FT | VTB | FT | VTB | FT | VTB | FT | | CPT-1 CPT-3 LVT-1 CPT-2 CPT-5 | | | | | | |
| 214 | n/a | . | . | . | . | . | . | . | . | . | . | . | . | . | . | . | . | . | . | | | | | | | | |
| 215 | CLASSROOM 15 | CPT LVT | FT | RTB | FT | 4' | --- | --- | --- | VTB | FT | VTB | FT | GB | ESP | VTB | FT | VTB | FT | | CPT-1 CPT-3 LVT-1 CPT-2 CPT-5 | | | | | | |
| 216 | CLASSROOM 17 | CPT LVT | FT | RTB | FT | 4' | --- | --- | --- | GB | ESP | VTB | FT | VTB | FT | VTB | FT | VTB | FT | | | | | | | | |
| 217 | ELEC. | CONC | --- | RTB | FT | 4' | --- | --- | --- | GB | ESP | GB | ESP | GB | ESP | GB | ESP | GB | ESP | | | | | | | | |
| 218 | HALLWAY | CONC | CD | RTB | FT | 4' | --- | --- | --- | GB | ESP | GB | ESP | GB | ESP | GB | ESP | GB | ESP | | | | | | | | |
| 219 | STORAGE | CONC | --- | RTB | FT | 4' | --- | --- | --- | GB | ESP | GB | ESP | GB | ESP | GB | ESP | GB | ESP | | | | | | | | |
| 220 | BOYS ROOM 3 | TL | FT | CV | FT | 6' | TL | FT | 7-6' | GB | SGP | GB | SGP | GB | SGP | GB | SGP | GB | SGP | | TL-1 | | | | | | |
| 221 | GIRLS ROOM 3 | TL | FT | CV | FT | 6' | TL | FT | 7-6' | GB | SGP | GB | SGP | GB | SGP | GB | SGP | GB | SGP | | TL-1 | | | | | | |
| 222 | MENS ROOM 2 | TL | FT | CV | FT | 6' | TL | FT | 7-6' | GB | SGP | GB | SGP | GB | SGP | GB | SGP | GB | SGP | | TL-1 | | | | | | |
| 223 | WOMENS ROOM 2 | TL | FT | CV | FT | 6' | TL | FT | 7-6' | GB | SGP | GB | SGP | GB | SGP | GB | SGP | GB | SGP | | TL-1 | | | | | | |
| 224 | CLASSROOM 18 | CPT LVT | FT | RTB | FT | 4' | --- | --- | --- | VTB | FT | VTB | FT | GB | ESP | VTB | FT | VTB | FT | | CPT-1 CPT-3 LVT-1 CPT-2 CPT-5 | | | | | | |
| 225 | CLASSROOM 19 | CPT LVT | FT | RTB | FT | 4' | --- | --- | --- | GB | ESP | VTB | FT | VTB | FT | VTB | FT | VTB | FT | | CPT-1 CPT-3 LVT-1 CPT-2 CPT-5 | | | | | | |
| 226 | CLASSROOM 20 | CPT LVT | FT | RTB | FT | 4' | --- | --- | --- | VTB | FT | VTB | FT | GB | ESP | VTB | FT | VTB | FT | | CPT-1 CPT-3 LVT-1 CPT-2 CPT-5 | | | | | | |
| 227 | CLASSROOM 21 | CPT LVT | FT | RTB | FT | 4' | --- | --- | --- | GB | ESP | VTB | FT | VTB | FT | VTB | FT | VTB | FT | | CPT-1 CPT-3 LVT-1 CPT-2 CPT-5 | | | | | | |
| 228 | STAIRS | RT | FT | RTB | FT | 4' | --- | --- | --- | GB | ESP | GB | ESP | GB | ESP | GB | ESP | GB | ESP | | | | | | | | |
| 229 | CLASSROOM 25 | CPT LVT | FT | RTB | FT | 4' | --- | --- | --- | VTB | FT | VTB | FT | GB | ESP | VTB | FT | VTB | FT | | CPT-1 CPT-3 LVT-1 CPT-2 CPT-5 | | | | | | |
| 230 | CLASSROOM 24 | CPT LVT | FT | RTB | FT | 4' | --- | --- | --- | GB | ESP | VTB | FT | VTB | FT | VTB | FT | VTB | FT | | | | | | | | |
| 231 | CLASSROOM 23 | CPT LVT | FT | RTB | FT | 4' | --- | --- | --- | VTB | FT | VTB | FT | GB | ESP | VTB | FT | VTB | FT | | | | | | | | |
| 232 | CLASSROOM 22 | CPT LVT | FT | RTB | FT | 4' | --- | --- | --- | GB | ESP | VTB | FT | VTB | FT | VTB | FT | VTB | FT | | CPT-1 CPT-3 LVT-1 CPT-2 CPT-5 | | | | | | |
| 233 | CLASSROOM 16 | CPT LVT | FT | RTB | FT | 4' | --- | --- | --- | VTB | FT | VTB | FT | VTB | FT | VTB | FT | VTB | FT | | CPT-1 CPT-3 LVT-1 CPT-2 CPT-5 | | | | | | |
| 234 | STAIRS | RT | FT | RTB | FT | 4' | --- | --- | --- | GB | ESP | GB | ESP | GB | ESP | GB | ESP | GB | ESP | | | | | | | | |

SEE REFLECTED CEILING PLANS FOR ALL CEILING INFORMATION

ABBREVIATIONS


| | |
|------|-------------------------------------|
| ACT | ACOUSTICAL CEILING TILE |
| CLN | CLEAN |
| CONC | CONCRETE |
| CPT | CARPET (N.I.C.) |
| CT | CERAMIC TILE |
| CV | COVED BASE |
| FRP | FIBER REINFORCED PANEL |
| FT | FACTORY |
| GB | GYPSUM BOARD w/ LIGHT SPRAY TEXTURE |
| P | PAINT |
| PT | PORCELAIN TILE |
| RTB | RUBBER TOPSET BASE |
| RT | RUBBERIZED NON SLIP TREAD |
| SGP | SEMI-GLOSS PAINT |
| SL | SEAL |
| SV | SHEET VINYL |
| VTB | VINYL TACKBD |
| VAR | VARIABLE |
| CB | CEMENTITIOUS BOARD |
| WR | WATER RESISTANT GYP BOARD |
| CD | POLISHED CONCRETE SYSTEM |
| RF | RESILIENT RUBBER FLOORING |

AC ACROVYN 2



7790 NORTH PALM AVENUE
FRESNO, CALIFORNIA 93711
T 559.448.8400 F 559.448.8467
www.slm-pbk.com

SHIELDS & BRAWLEY ELEMENTARY SCHOOL

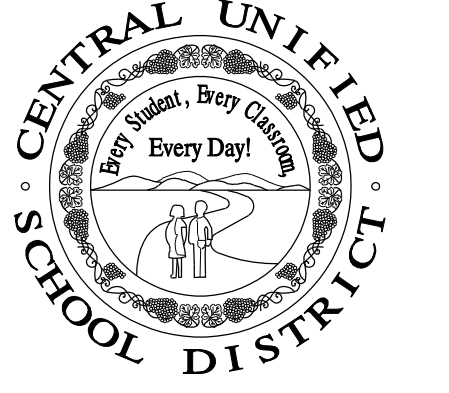

**AD 2-16a
S&B Elementary
02-116800**

JOHN H. SMITH, A.I.A. C15885
 C 15885
9-30-23

THE FIRM OF SMITH, WANAGA, MILHOUS, ARCHITECTS, INC. EXPRESSLY RESERVES ITS COMMON LAW COPYRIGHT AND OTHER AVAILABLE PROPRITY RIGHTS IN THESE PLANS. THESE PLANS ARE NOT TO BE REPRODUCED, CHANGED, OR COPIED IN ANY FORM OR MANNER WHATSOEVER, NOR ARE THEY TO BE ASSIGNED TO A THIRD PARTY WITHOUT FIRST OBTAINING THE WRITTEN PERMISSION AND CONSENT OF THE ARCHITECT. IN THE EVENT OF UNAUTHORIZED REUSE OF THESE PLANS BY A THIRD PARTY, THE THIRD PARTY SHALL HOLD THE ARCHITECT HARMLESS, AND SHALL BEAR THE COST OF THE ARCHITECTS LEGAL FEES ASSOCIATED WITH DEFENDING AND ENFORCING THESE RIGHTS.

| DATE | ISSUED FOR |
|------|------------|
| | |
| | |
| | |
| | |

| No. | DATE | DESCRIPTION |
|-----|---------|------------------------|
| △ 2 | 2.14.23 | DISTRICT MODIFICATIONS |
| △ 3 | 2.27.23 | DISTRICT MODIFICATIONS |
| | | |
| | | |

GENERAL NOTES

- SEE SPECIFICATIONS FOR SUSPENDED ACOUSTICAL CEILING TILE TYPE.
- ARCHITECT TO SELECT PAINT COLORS AND LOCATIONS.
- WINDOW JAMBS AT LOCATIONS WITH VINYL BACKBOARD FINISH TO RECEIVE V.T.B. WRAP.
- SEE DETAIL 140/A8.7 FOR SUSPENDED ACOUSTICAL CEILING TILE SYSTEM.
- ALL VINYL TACKBOARD TO BE APPLIED OVER GYPSUM BOARD SUBSTRATE.
- ALL FINISH MATERIALS SHALL COMPLY WITH CBC TABLE 8.03.5.

REMARKS

- SEE ENLARGED FINISH FLOOR PLAN FOR FLOORING COLORS & PATTERN.

SHEET DESCRIPTION

| | | | |
|-----------------------------------|-----------------------|------------------|-------------|
| FINISH SCHEDULE | | MAIN - 2ND FLOOR | |
| PROJECT COORDINATOR JOHN SMITH | PROJECT NO. 17-67 | SHEET NO. | A2.4 |
| DATE 1.27.23 | SCALE 1/4" = 1'-0" | | |

S:\11-23\shields & brawley elementary\work\11-23\ad-16a_s-bp-02-116800.dwg 10/20/23 2:10p

DOOR SCHEDULE

| DOOR No. | DOOR TYPE | DOOR SIZE W, X H. | DOOR | | | FRAME | | GLASS | | LOUVER | FIRE RATING | SIGNAGE | DETAILS | | | | REMARKS |
|----------|-----------|----------------------|-----------|--------|--------|--------|--------|-------|--------|--------|-------------|---------|---------|------|-----------|----------|---------|
| | | | THICKNESS | CONST. | FINISH | CONST. | FINISH | TYPE | FINISH | | | | HEAD | JAMB | THRESHOLD | HARDWARE | |
| 201 | B | 3'-0" x 7'-0" | 13/4 | SC | LP | HM | SGP | T | CLR | -- | 20 | 2.3 | 105 | 105 | -- | 17 | 3 |
| 202 | B | 3'-0" x 7'-0" | 13/4 | SC | LP | HM | SGP | T | CLR | -- | 20 | 2.3 | 105 | 105 | -- | 17 | 3 |
| 203 | B | 3'-0" x 7'-0" | 13/4 | SC | LP | HM | SGP | T | CLR | -- | 20 | 2.3 | 105 | 105 | -- | 17 | 3 |
| 204 | D | 3'-0" x 7'-0" | 13/4 | SC | LP | HM | SGP | T | CLR | -- | 3 | | 105 | 105 | -- | 25 | 3 |
| 205 | B | 3'-0" x 7'-0" | 13/4 | SC | LP | HM | SGP | T | CLR | -- | 20 | 2.3 | 105 | 105 | -- | 17 | 3 |
| 206 | C | 3'-0" x 7'-0" | 13/4 | SC | LP | HM | SGP | -- | -- | -- | 45 | 3 | 105 | 105 | -- | 26 | 3 |
| 207 | B | 3'-0" x 7'-0" | 13/4 | SC | LP | HM | SGP | T | CLR | -- | 20 | 2.3 | 105 | 105 | -- | 17 | 3 |
| 208 | D | 3'-0" x 7'-0" | 13/4 | SC | LP | HM | SGP | T | CLR | -- | 3 | | 105 | 105 | -- | 25 | 3 |
| 209 | B | 3'-0" x 7'-0" | 13/4 | SC | LP | HM | SGP | T | CLR | -- | 20 | 2.3 | 105 | 105 | -- | 17 | 3 |
| 210 | B | 3'-0" x 7'-0" | 13/4 | SC | LP | HM | SGP | T | CLR | -- | 20 | 2.3 | 105 | 105 | -- | 17 | 3 |
| 211 | B | 3'-0" x 7'-0" | 13/4 | SC | LP | HM | SGP | -- | -- | -- | 20 | 2.3 | 105 | 105 | -- | 17 | 3 |
| 212 | C | 3'-0" x 7'-0" | 13/4 | SC | LP | HM | SGP | -- | -- | -- | 3 | | 105 | 105 | -- | 25 | 3 |
| 213 | B | 3'-0" x 7'-0" | 13/4 | SC | LP | HM | SGP | T | CLR | -- | 20 | 2.3 | 105 | 105 | -- | 17 | 3 |
| 214 | D | 3'-0" x 7'-0" | 13/4 | SC | LP | HM | SGP | T | CLR | -- | 3 | | 105 | 105 | -- | 25 | 3 |
| 215 | B | 3'-0" x 7'-0" | 13/4 | SC | LP | HM | SGP | T | CLR | -- | 20 | 2.3 | 105 | 105 | -- | 17 | 3 |
| 216 | D | 3'-0" x 7'-0" | 13/4 | SC | LP | HM | SGP | -- | -- | -- | 20 | 1.2,3 | 105 | 105 | -- | 17 | 3 |
| 217 | A | 6'-0" x 7'-0" | 13/4 | SC | LP | HM | SGP | -- | -- | -- | 3 | | 105 | 105 | -- | 31 | 3 |
| 218 | C | 3'-0" x 7'-0" | 13/4 | SC | LP | HM | SGP | -- | -- | -- | 45 | 3 | 105 | 105 | -- | 26 | 3 |
| 219 | C | 3'-0" x 7'-0" | 13/4 | SC | LP | HM | SGP | -- | -- | -- | 4 | | 105 | 105 | -- | 21 | 2 |
| 220 | C | 3'-0" x 7'-0" | 13/4 | SC | LP | HM | SGP | -- | -- | -- | 4 | | 105 | 105 | -- | 21 | 2 |
| 221 | C | 3'-0" x 7'-0" | 13/4 | SC | LP | HM | SGP | -- | -- | -- | 20 | 4 | 105 | 105 | -- | 19 | 2 |
| 222 | C | 3'-0" x 7'-0" | 13/4 | SC | LP | HM | SGP | -- | -- | -- | 20 | 4 | 105 | 105 | -- | 19 | 2 |
| 223 | B | 3'-0" x 7'-0" | 13/4 | SC | LP | HM | SGP | T | CLR | -- | 20 | 2.3 | 105 | 105 | -- | 17 | 3 |
| 224 | D | 3'-0" x 7'-0" | 13/4 | SC | LP | HM | SGP | T | CLR | -- | 3 | | 105 | 105 | -- | 25 | 3 |
| 225 | B | 3'-0" x 7'-0" | 13/4 | SC | LP | HM | SGP | T | CLR | -- | 20 | 2.3 | 105 | 105 | -- | 17 | 3 |
| 226 | B | 3'-0" x 7'-0" | 13/4 | SC | LP | HM | SGP | T | CLR | -- | 20 | 2.3 | 105 | 105 | -- | 17 | 3 |
| 227 | D | 3'-0" x 7'-0" | 13/4 | SC | LP | HM | SGP | T | CLR | -- | 3 | | 105 | 105 | -- | 25 | 3 |
| 228 | B | 3'-0" x 7'-0" | 13/4 | SC | LP | HM | SGP | T | CLR | -- | 20 | 2.3 | 105 | 105 | -- | 17 | 3 |
| 229 | B | 3'-0" x 7'-0" | 13/4 | SC | LP | HM | SGP | T | CLR | -- | 20 | 2.3 | 105 | 105 | -- | 17 | 3 |
| 230 | B | 3'-0" x 7'-0" | 13/4 | SC | LP | HM | SGP | T | CLR | -- | 20 | 2.3 | 105 | 105 | -- | 17 | 3 |
| 231 | D | 3'-0" x 7'-0" | 13/4 | SC | LP | HM | SGP | T | CLR | -- | 3 | | 105 | 105 | -- | 25 | 3 |
| 232 | B | 3'-0" x 7'-0" | 13/4 | SC | LP | HM | SGP | T | CLR | -- | 20 | 2.3 | 105 | 105 | -- | 17 | 3 |
| 233 | B | 3'-0" x 7'-0" | 13/4 | SC | LP | HM | SGP | T | CLR | -- | 20 | 2.3 | 105 | 105 | -- | 17 | 3 |
| 234 | B | 3'-0" x 7'-0" | 13/4 | SC | LP | HM | SGP | T | CLR | -- | 20 | 2.3 | 105 | 105 | -- | 17 | 3 |
| 235 | . | . | . | . | . | . | . | . | . | . | . | . | . | . | . | . | . |
| 236 | . | . | . | . | . | . | . | . | . | . | . | . | . | . | . | . | . |
| 237 | . | . | . | . | . | . | . | . | . | . | . | . | . | . | . | . | . |
| 238 | . | . | . | . | . | . | . | . | . | . | . | . | . | . | . | . | . |
| 239 | . | . | . | . | . | . | . | . | . | . | . | . | . | . | . | . | . |
| 240 | . | . | . | . | . | . | . | . | . | . | . | . | . | . | . | . | . |
| 241 | . | . | . | . | . | . | . | . | . | . | . | . | . | . | . | . | . |
| 242 | . | . | . | . | . | . | . | . | . | . | . | . | . | . | . | . | . |

E:\V-C-01 Shields & Brawley Elementary\Work\17-67-AD-2.5-Door Schedules\17-67-21-07

DOOR SCHEDULE

| DOOR No. | DOOR TYPE | DOOR SIZE W, X H. | DOOR | | | FRAME | | GLASS | | LOUVER | FIRE RATING | SIGNAGE | DETAILS | | | | REMARKS |
|----------|-----------|----------------------|-----------|--------|--------|--------|--------|-------|--------|--------|-------------|---------|---------|------|-----------|----------|---------|
| | | | THICKNESS | CONST. | FINISH | CONST. | FINISH | TYPE | FINISH | | | | HEAD | JAMB | THRESHOLD | HARDWARE | |
| 243 | . | . | . | . | . | . | . | . | . | . | . | . | . | . | . | . | . |
| 244 | . | . | . | . | . | . | . | . | . | . | . | . | . | . | . | . | . |
| 265 | . | . | . | . | . | . | . | . | . | . | . | . | . | . | . | . | . |

ABBREVIATIONS

| | | | | | |
|-------|-------------------|------|------------------|-----|------------|
| ALUM | ALUMINUM | MT | MARLITE PANEL | VAR | VARIES |
| ANOD | ANODIZED | P | PAINT | W | WIRE GLASS |
| CLN | CLEAN | PL | PLATE | WD | WOOD |
| CLR | CLEAR | PLY | PLYWOOD | | |
| CONC. | CONCRETE | PW | PICTURE WINDOW | | |
| CV | INTEGRAL COVE | S | SINGLE GLAZED | | |
| DL | DUAL GLAZED | SC | SOLID CORE | | |
| EP | EPOXY PAINT | SGP | SEMI GLOSS PAINT | | |
| ESP | EGG SHELL PAINT | SH | SINGLE-HUNG | | |
| EXP | EXPOSED STRUCTURE | SIGN | PROVIDE SIGNAGE | | |
| FG | FIBERGLASS | SL | SEAL | | |
| FF | FACTORY FINISH | STN | STAIN | | |
| FP | FACTORY PAINT | STL | STEEL | | |
| FR | FIRE RATED | SV | SHEET VINYL | | |
| FT | FACTORY | T | TEMPERED | | |
| GBLK | GLASS BLOCK | TF | "TIMELY" FRAME | | |
| HM | HOLLOW METAL | TNT | TINTED | | |
| LP | LAMINATE PLASTIC | TT | TAPE & TEXTURE | | |

GENERAL NOTES


1. SEE SPECIFICATIONS FOR SUSPENDED ACOUSTICAL CEILING TILE TYPE.
2. ARCHITECT TO SELECT PAINT COLORS AND LOCATIONS.
3. WINDOW JAMBS AT LOCATIONS WITH VINYL TACKBOARD FINISH TO RECEIVE V.T.B. WRAP.
4. ALL GLAZING WITHIN 24" OF A DOOR OR OPERABLE WINDOW SHALL BE TEMPERED GLASS
5. SEE SPECIFICATION SECTION 10400 FOR DOOR & ROOM SIGNAGE
6. FOR CONDITIONS AT METAL PANELS NOT SPECIFICALLY REFERENCED, SEE SHEETS A8.14 & A8.15. DOORS TO BE SIMILAR TO WINDOWS. COORDINATE W/ METAL PANEL MANUFACTURER.
7. SEE DETAIL #179/A8.9 FOR HM FRAME ANCHORAGE, TYP.
8. SEE GENERAL NOTES ON COLOR SCHEDULE, SHEET A2.8, FOR TYPICAL DOOR & WINDOW FINISHES.
9. HANDLES, PULLS, LATCHES, LOCKS, AND OTHER OPERABLE PARTS ON DOORS AND GATES SHALL BE 34 INCHES MINIMUM AND 44 INCHES MAXIMUM ABOVE THE FINISH FLOOR OR GROUND.
10. FOR ADDITIONAL SIGNAGE NOT SHOWN IN SCHEDULE, SEE T4

REMARKS

1. PROVIDE ACCESSIBLE EXIT SIGNAGE. SEE DETAIL 201/A8.11
2. PROVIDE ACCESSIBLE RESTROOM SIGNAGE. SEE DETAIL 217/A8.11
3. PROVIDE ROOM IDENTIFICATION SIGNAGE. SEE DETAIL 212/A8.11

DOOR SIGNAGE

1. BUILDING ENTRANCE/ ISA SIGNAGE. SEE DETAIL 212 / A8.11
2. TACTILE EXIT SIGNAGE. SEE DETAIL 201/A8.11. AND/OR SEE ELECTRICAL PLANS FOR ILLUMINATED EXIT REQUIREMENTS.
3. ROOM IDENTIFICATION SIGNAGE. SEE DETAIL 212/A8.11 (VERIFY ROOM NAME & NUMBER W/ OWNER). WHERE TWO ROOMS ADJOIN ONE ANOTHER, PROVIDE SIGNAGE ON EACH SIDE OF THE WALL. TYP. ALL ROOMS.
4. RESTROOM SIGNAGE. SEE DETAIL 217/A8.11.

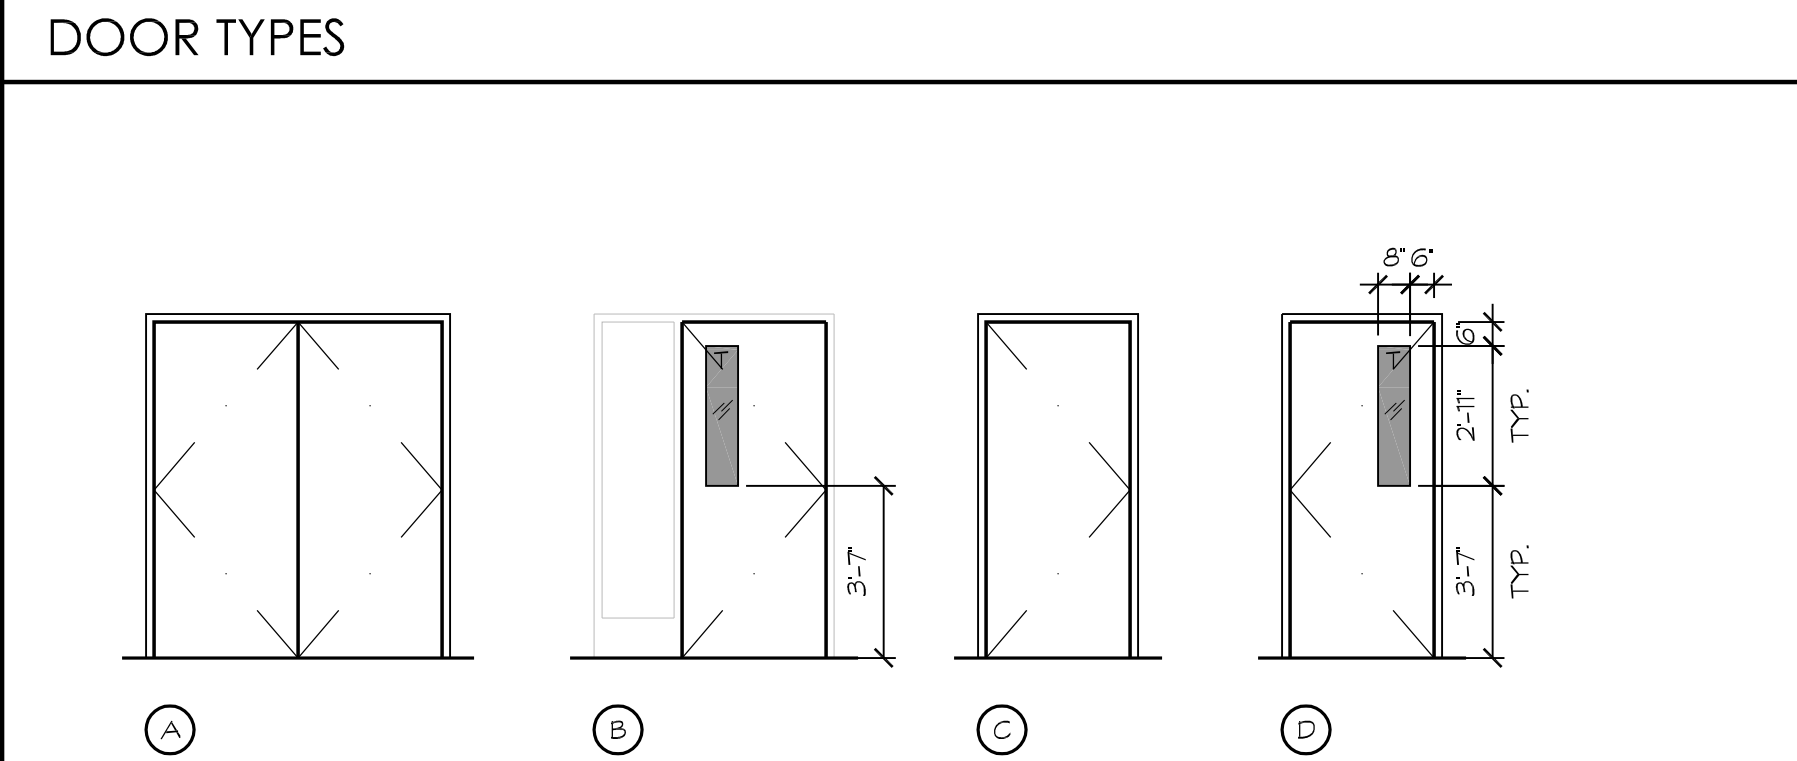

7790 NORTH PALM AVENUE
FRESNO, CALIFORNIA 93711
T 559.448.8400 F 559.448.8467
www.sim-pbk.com

PROJECT:
SHIELDS & BRAWLEY ELEMENTARY SCHOOL

AD 2-17a
S&B Elementary
02-116800

JOHN H. SMITH, AIA, C15865

THE FIRM OF SMITH, IWANAGA, MILHOUS, ARCHITECTS, INC. EXPRESSLY RESERVES ITS COMMON LAW COPYRIGHT AND OTHER APPLICABLE PROPERTY RIGHTS IN THESE PLANS. THESE PLANS ARE NOT TO BE REPRODUCED, CHANGED, OR COPIED IN ANY FORM OR MANNER WHATSOEVER, NOR ARE THEY TO BE ASSIGNED TO A THIRD PARTY WITHOUT FIRST OBTAINING THE WRITTEN PERMISSION AND CONSENT OF THE ARCHITECT. IN THE EVENT OF UNAUTHORIZED REUSE OF THESE PLANS BY A THIRD PARTY, THE THIRD PARTY SHALL HOLD THE ARCHITECT HARMLESS, AND SHALL BEAR THE COST OF THE ARCHITECT'S LEGAL FEES ASSOCIATED WITH DEFENDING AND ENFORCEING THESE RIGHTS.

PROJECT DEVELOPMENT

| DATE | ISSUED FOR |
|------|------------|
| | |
| | |
| | |

REVISIONS

| No. | DATE | DESCRIPTION |
|-----|---------|------------------------|
| 1 | 2.14.23 | DISTRICT MODIFICATIONS |
| 2 | 2.27.23 | DISTRICT MODIFICATIONS |
| | | |
| | | |

SHEET DESCRIPTION

DOOR SCHEDULE

MAIN - 2ND FLOOR

| | |
|-----------------------------------|-------------|
| PROJECT COORDINATOR JOHN SMITH | SHEET No. |
| PROJECT NO. 17-67 | A2.5 |
| DATE 1.27.23 | |
| SCALE 1/4" = 1'-0" | |

| WINDOW No. | WINDOW TYPE | WINDOW SIZE | WINDOW | | FRAME | | | DETAILS | | | REMARKS |
|------------|-------------|-----------------|--------|--------|----------|--------|--------|---------|------|------|---------|
| | | | TYPE | FINISH | MATERIAL | FINISH | FINISH | HEAD | JAMB | SILL | |
| 201 | A | 27'-6" x 18'-5" | DL | TNT | ALUM | ANOD | | 90 | 91 | 92 | |
| 202 | D | 9'-6" x 18'-5" | DL | TNT | ALUM | ANOD | | 90 | 92 | 92 | 1 |
| 203 | E | 24'-0" x 18'-5" | DL | TNT | ALUM | ANOD | | 90 | 92 | 92 | 1 |
| 204A | C | 7'-0" x 5'-10" | DL | TNT | FG | FT | | 94 | 95 | 96 | 1 |
| 204B | B | 7'-0" x 5'-10" | DL | TNT | FG | FT | | 94 | 95 | 96 | 1 |
| 205 | J | 2'-6" x 8'-0" | DL | TNT | FG | FT | | 261 | 265 | 267 | 1 |
| 206 | C | 7'-0" x 5'-10" | DL | TNT | FG | FT | | 94 | 95 | 96 | 1 |
| 207 | B | 7'-0" x 5'-10" | DL | TNT | FG | FT | | 94 | 95 | 96 | 1 |
| 208A | C | 7'-0" x 5'-10" | DL | TNT | FG | FT | | 98 | 99 | 100 | 1 |
| 208B | B | 7'-0" x 5'-10" | DL | TNT | FG | FT | | 98 | 99 | 100 | 1 |
| 209 | I | 3'-0" x 5'-10" | DL | TNT | FG | FT | | 98 | 99 | 100 | 1 |
| 210 | G | 5'-0" x 8'-0" | DL | TNT | FG | FT | | 261 | 265 | 267 | 1 |
| 211 | H | 6'-0" x 5'-10" | DL | TNT | FG | FT | | 261 | 265 | 267 | 1 |
| 212 | I | 3'-0" x 5'-10" | DL | TNT | FG | FT | | 98 | 99 | 100 | 1 |
| 213A | C | 7'-0" x 5'-10" | DL | TNT | FG | FT | | 98 | 99 | 100 | 1 |
| 213B | B | 7'-0" x 5'-10" | DL | TNT | FG | FT | | 98 | 99 | 100 | 1 |
| 214A | C | 7'-0" x 5'-10" | DL | TNT | FG | FT | | 94 | 95 | 96 | 1 |
| 214B | B | 7'-0" x 5'-10" | DL | TNT | FG | FT | | 94 | 95 | 96 | 1 |
| 215 | J | 2'-6" x 8'-0" | DL | TNT | FG | FT | | 261 | 265 | 267 | 1 |
| 216 | C | 7'-0" x 5'-10" | DL | TNT | FG | FT | | 94 | 95 | 96 | 1 |
| 217 | B | 7'-0" x 5'-10" | DL | TNT | FG | FT | | 94 | 95 | 96 | 1 |
| 218 | C | 7'-0" x 5'-10" | DL | TNT | FG | FT | | 94 | 95 | 96 | 1 |
| 219 | B | 7'-0" x 5'-10" | DL | TNT | FG | FT | | 94 | 95 | 96 | 1 |
| 220 | C | 7'-0" x 5'-10" | DL | TNT | FG | FT | | 94 | 95 | 96 | 1 |
| 221 | B | 7'-0" x 5'-10" | DL | TNT | FG | FT | | 94 | 95 | 96 | 1 |
| 222 | C | 7'-0" x 5'-10" | DL | TNT | FG | FT | | 94 | 95 | 96 | 1 |
| 223 | B | 7'-0" x 5'-10" | DL | TNT | FG | FT | | 94 | 95 | 96 | 1 |
| 224 | K | 2'-0" x 2'-0" | DL | TNT | FG | FT | | 94 | 95 | 96 | 1 |
| 225 | K | 2'-0" x 2'-0" | DL | TNT | FG | FT | | 94 | 95 | 96 | 1 |
| 226 | C | 7'-0" x 5'-10" | DL | TNT | FG | FT | | 98 | 99 | 100 | 1 |
| 227 | B | 7'-0" x 5'-10" | DL | TNT | FG | FT | | 98 | 99 | 100 | 1 |
| 228 | C | 7'-0" x 5'-10" | DL | TNT | FG | FT | | 94 | 95 | 96 | 1 |
| 229 | B | 7'-0" x 5'-10" | DL | TNT | FG | FT | | 94 | 95 | 96 | 1 |
| 230 | C | 7'-0" x 5'-10" | DL | TNT | FG | FT | | 98 | 99 | 100 | 1 |
| 231 | B | 7'-0" x 5'-10" | DL | TNT | FG | FT | | 98 | 99 | 100 | 1 |
| 232 | C | 7'-0" x 5'-10" | DL | TNT | FG | FT | | 94 | 95 | 96 | 1 |
| 233 | B | 7'-0" x 5'-10" | DL | TNT | FG | FT | | 94 | 95 | 96 | 1 |
| 234 | H | 6'-0" x 5'-10" | DL | TNT | FG | FT | | 261 | 265 | 267 | 1 |
| 235 | G | 5'-0" x 8'-0" | DL | TNT | FG | FT | | 261 | 265 | 267 | 1 |
| 236 | I | 3'-0" x 5'-10" | DL | TNT | FG | FT | | 98 | 99 | 100 | 1 |
| 237A | C | 7'-0" x 5'-10" | DL | TNT | FG | FT | | 98 | 99 | 100 | 1 |
| 237B | B | 7'-0" x 5'-10" | DL | TNT | FG | FT | | 98 | 99 | 100 | 1 |


| WINDOW No. | WINDOW TYPE | WINDOW SIZE | WINDOW | | FRAME | | | DETAILS | | | REMARKS |
|------------|-------------|-----------------|--------|--------|----------|--------|--------|---------|------|------|---------|
| | | | TYPE | FINISH | MATERIAL | FINISH | FINISH | HEAD | JAMB | SILL | |
| 238A | C | 7'-0" x 5'-10" | DL | TNT | FG | FT | | 94 | 95 | 96 | 1 |
| 238A | B | 7'-0" x 5'-10" | DL | TNT | FG | FT | | 94 | 95 | 96 | 1 |
| 239 | I | 3'-0" x 5'-10" | DL | TNT | FG | FT | | 98 | 99 | 100 | 1 |
| 240A | C | 7'-0" x 5'-10" | DL | TNT | FG | FT | | 98 | 99 | 100 | 1 |
| 240B | B | 7'-0" x 5'-10" | DL | TNT | FG | FT | | 98 | 99 | 100 | 1 |
| 242A | C | 7'-0" x 5'-10" | DL | TNT | FG | FT | | 94 | 95 | 96 | 1 |
| 242B | B | 7'-0" x 5'-10" | DL | TNT | FG | FT | | 94 | 95 | 96 | 1 |
| 243 | E | 24'-0" x 18'-5" | DL | TNT | ALUM | ANOD | | 90 | 92 | 92 | 1 |
| 244 | D | 9'-6" x 18'-5" | DL | TNT | ALUM | ANOD | | 90 | 92 | 92 | 1 |
| 245 | F | 5'-0" x 7'-2" | S | CLR | HM | P | 45 | 107 | 107 | 107 | 1 |
| 246 | F | 5'-0" x 7'-2" | S | CLR | HM | P | 45 | 107 | 107 | 107 | 1 |
GENERAL NOTES

- ALL WINDOWS WITHIN 24" OF DOOR OR 18" FROM GROUND SHALL BE TEMPERED GLASS.
- WINDOW JAMBS AT LOCATIONS WITH VINYL BACKBOARD FINISH TO RECEIVE V.T.B. WRAP.
- ALL GLAZING WITHIN 24" OF DOOR OR OPERABLE WINDOW ARE TO BE TEMPERED.
- SEE 97/A8.5 FOR FLASHING SEQUENCE
- FOR CONDITIONS AT METAL PANELS NOT SPECIFICALLY REFERENCED, SEE SHEETS A8.14 & A8.15

REMARKS

- PROVIDE VERTICAL LOUVERS (SPEC. SECTION 12510)

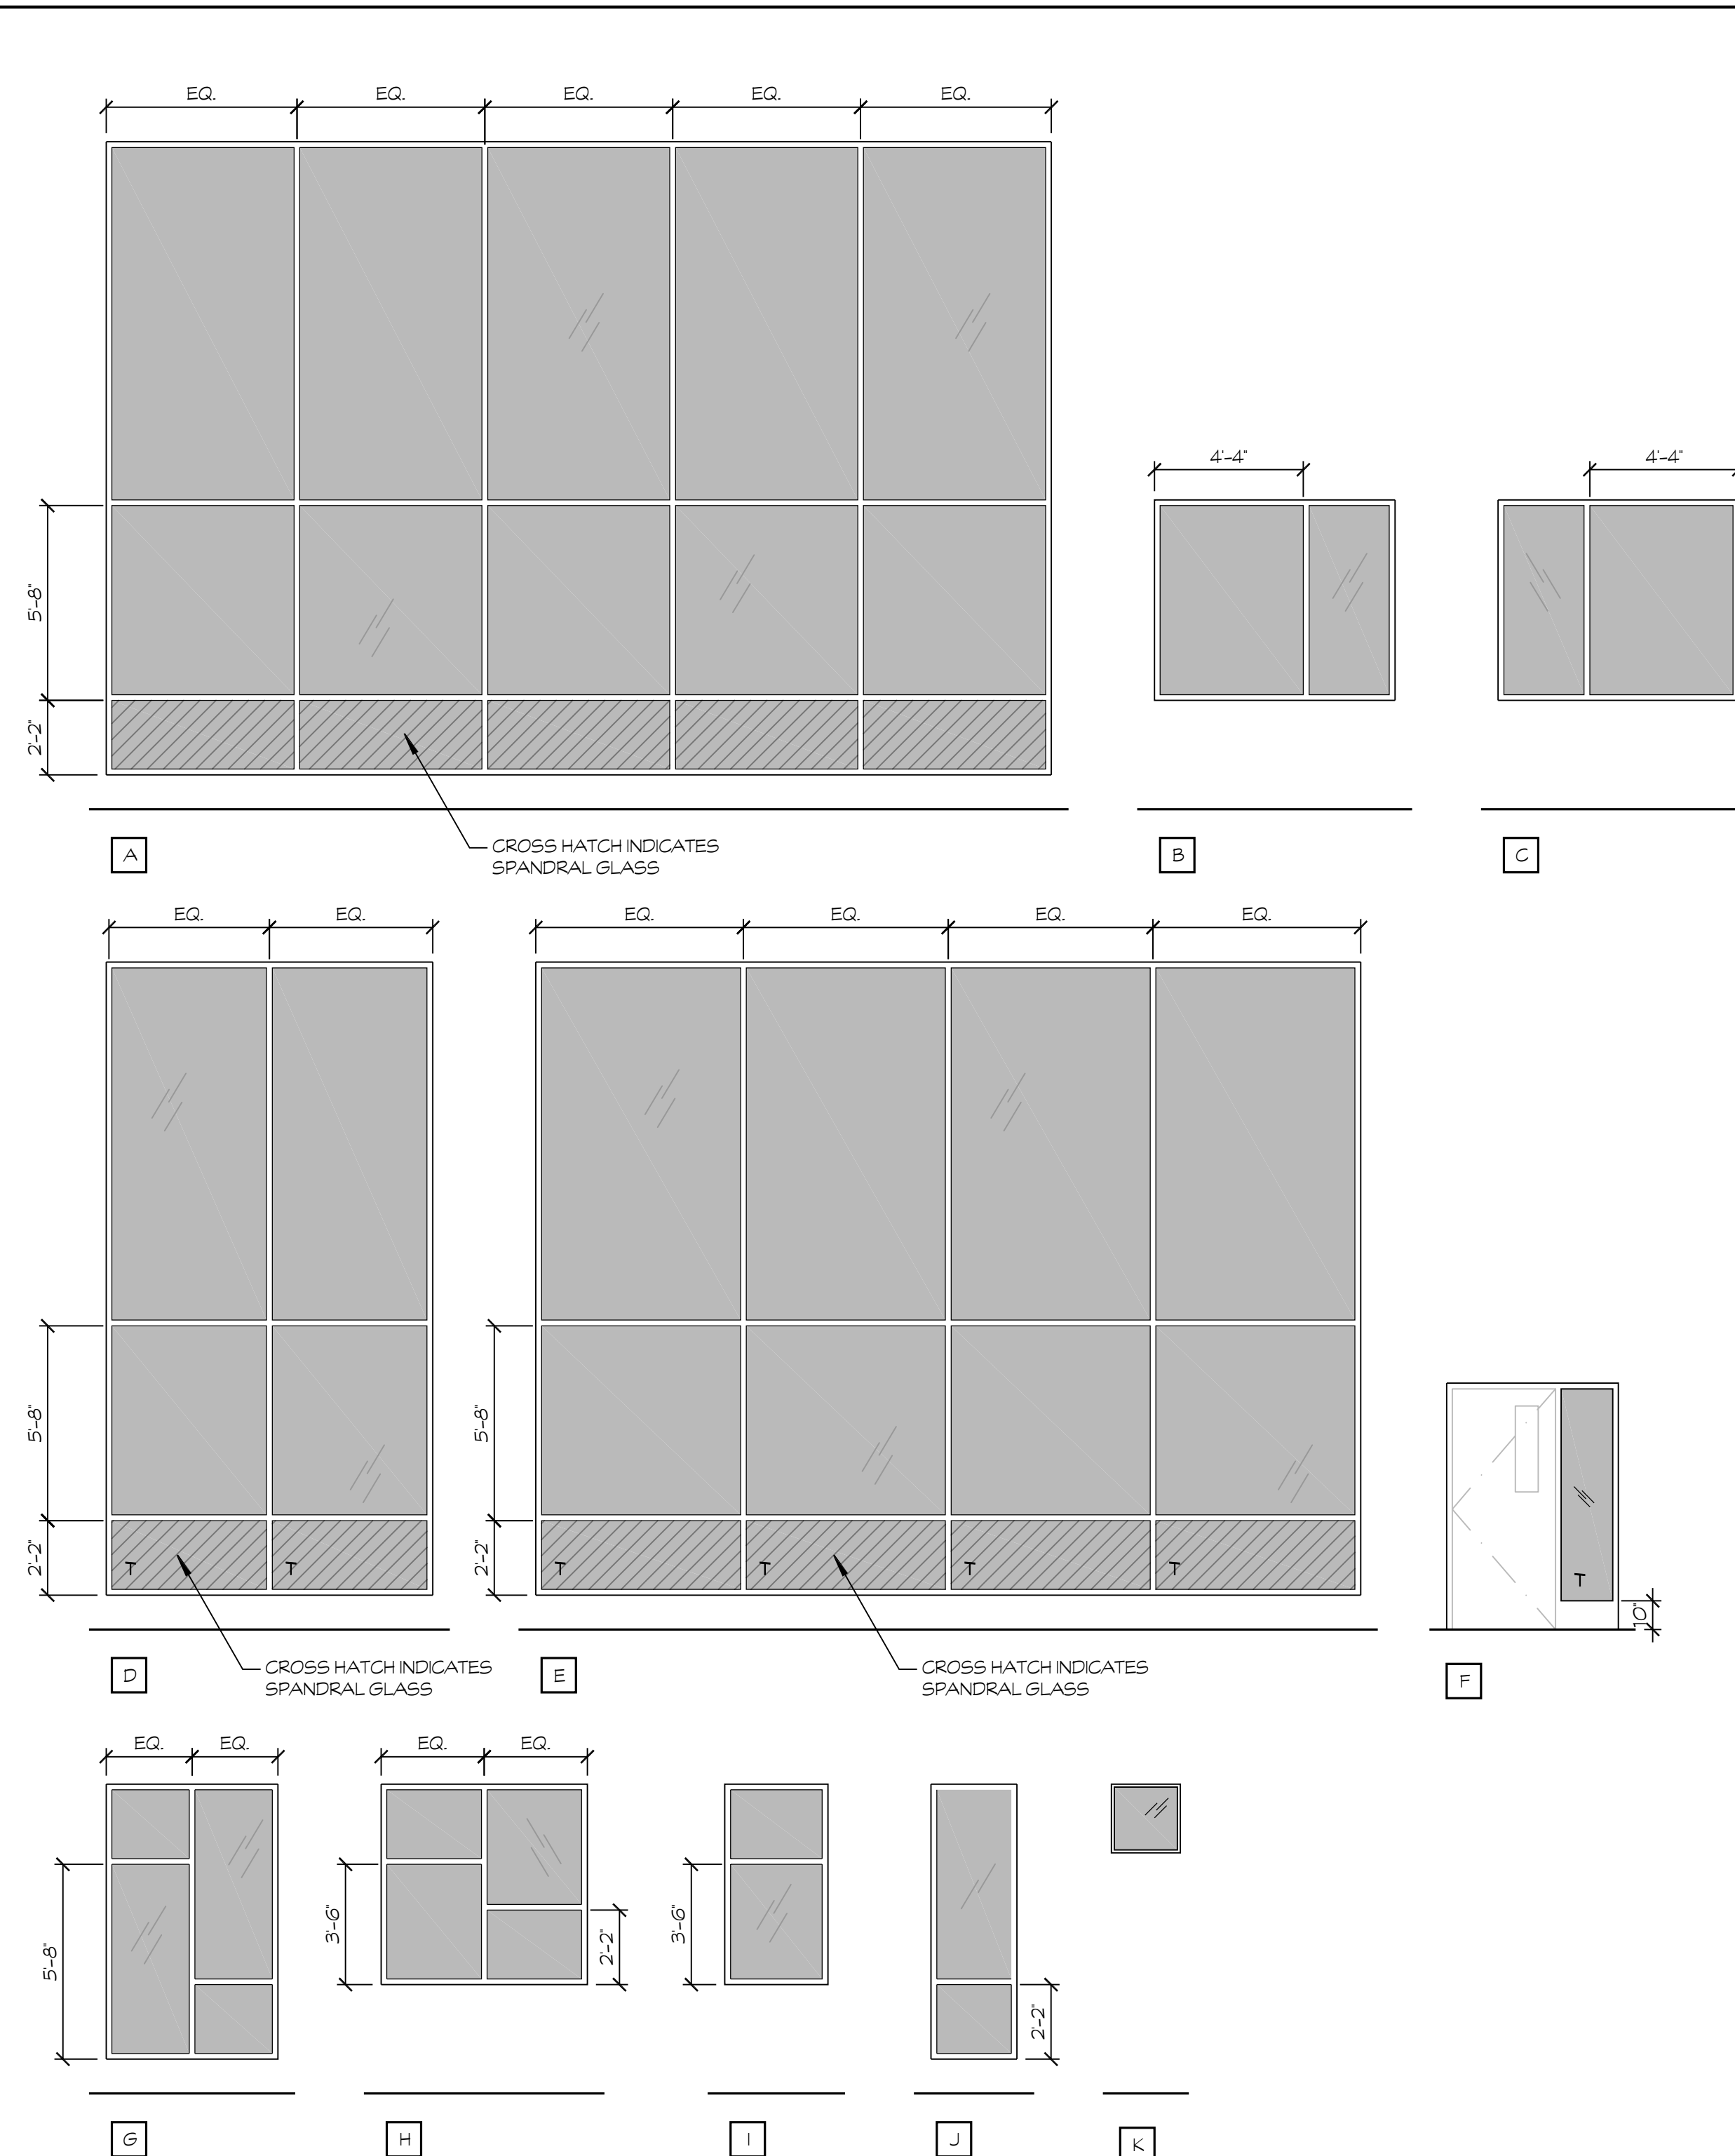

ABBREVIATIONS


| | | | |
|------|----------------------|------|-----------------------|
| ALUM | ALUMINUM | MT | MARLITE PANEL |
| ANOD | ANODIZED | OBSC | OBSCURE |
| CLN | CLEAN | P | PAINT |
| CLR | CLEAR INTEGRAL | PL | PLATE |
| CV | COVE | PW | PICTURE WINDOW |
| DL | DUAL GLAZED | S | SINGLE GLAZED |
| EP | EPOXY PAINT | SC | SOLID CORE |
| ESP | EGG SHELL PAINT | SGP | SEMI-GLOSS PAINT |
| FG | FIBERGLASS (FRAMES) | SH | SINGLE-HUNG |
| FG | FIRE GLASS (WINDOWS) | SL | SEAL |
| FF | FACTORY FINISH | STN | STAIN |
| FP | FACTORY PAINT | STL | STEEL |
| FR | FIRE RATED | TTF | TEMPERED TIMELY FRAME |
| FT | FACTORY | TNT | TINTED |
| GBLK | GLASS BLOCK | TT | TAPE & TEXTURED |
| HM | HOLLOW METAL | VAR | VARIABLE |
| LP | LAMINATE PLASTIC | W | WIRE GLASS |



7790 NORTH PALM AVENUE
 FRESNO, CALIFORNIA 93711
 T 559.448.8400 · F 559.448.8467
 www.sim-prk.com

PROJECT:

**SHIELDS
 & BRAWLEY
 ELEMENTARY
 SCHOOL**

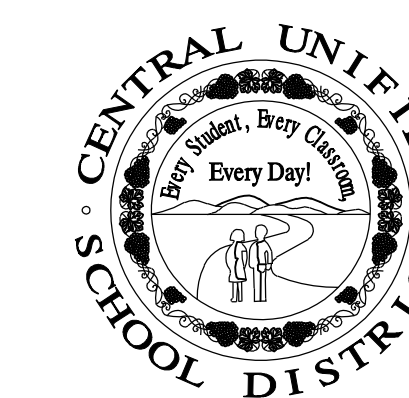

AD 2-18a
S&B Elementary
02-116800

JOHN H. SMITH, A.I.A. C15885



THE FIRM OF SMITH, WANAJA, MELHOU, ARCHITECTS, INC. EXPRESSLY RESERVES ITS COMMON LAW COPYRIGHT AND OTHER APPLICABLE PROPERTY RIGHTS IN THESE PLANS. THESE PLANS ARE NOT TO BE REPRODUCED, CHANGED, OR COPIED IN ANY FORM OR MANNER WHATSOEVER, NOR ARE THEY TO BE ASSIGNED TO A THIRD PARTY WITHOUT FIRST OBTAINING THE WRITTEN PERMISSION AND CONSENT OF THE ARCHITECT. IN THE EVENT OF UNAUTHORIZED REUSE OF THESE PLANS BY A THIRD PARTY, THE THIRD PARTY SHALL HOLD THE ARCHITECT HARMLESS, AND SHALL BEAR THE COST OF THE ARCHITECT'S LEGAL FEES ASSOCIATED WITH DEFENDING AND ENFORCING THESE RIGHTS.

PROJECT DEVELOPMENT

| DATE | ISSUED FOR |
|------|------------|
| | |
| | |
| | |
| | |

REVISIONS

| No. | DATE | DESCRIPTION |
|-----|---------|------------------------|
| Δ | 2.14.23 | DISTRICT MODIFICATIONS |
| Δ | 2.27.23 | DISTRICT MODIFICATIONS |
| | | |
| | | |

SHEET DESCRIPTION

**WINDOW
 SCHEDULE**

MAIN - 2ND FLOOR

| | |
|-----------------------------------|--------------------------|
| PROJECT COORDINATOR JOHN SMITH | SHEET No. A2.6 |
| PROJECT NO. 17-67 | DATE 1.27.23 |
| SCALE 1/4" = 1'-0" | |

COLOR SCHEDULE

| MATERIAL | DESIGNATION | MANUFACTURER | STYLE | COLOR | REMARKS |
|--------------------------|-------------|--------------|---------------------------------|-------------------------------|---------|
| RUBBER TOPSET BASE | RTB-1 | BURKE | 4' x 6' | #660, ROCKY | . |
| SOLID SURFACE | SO-1 | DALTILE | ONE QUARTZ SURFACES | #N052, MERCER GREY, VELVET | . |
| SHEET VINYL | SV-1 | ALTRO | SAFETY FLOORING | . | . |
| TILE | TL-1 | DALTILE | LINEAR (8' x 24') | MATTE ARCTIC WHITE | 1, 4 |
| TILE | TL-2 | DALTILE | CHORD (12' x 24') | #CH25 FORTE GREY | 2 |
| TILE | TL-3 | DALTILE | SURFACE PAVER (6' x 6') | 0036 CHARCOAL W/6' BASE | 9 |
| VINYL TACKBOARD | VTB-1 | KOROSEAL | ORLEANS | #R921-01 BEIGNET | . |
| VINYL TACKBOARD | VTB-2 | KOROSEAL | CHAPFIELD-CLARKE | MISTY GRAY | . |
| ACOUSTIC CEILING | ACI-1 | ARMSTRONG | CLEAN ROOM VL | WHITE | . |
| CORNER GUARDS | PWC-1 | KOROGARD | WALL PROTECTION SYSTEMS | #620F, MANITOBA MAPLE | . |
| BUMPER RAIL | PWC-2 | KOROGARD | WALL PROTECTION SYSTEMS | #C500, 5 1/4", MANITOBA MAPLE | . |
| PROTECTIVE WALL COVERING | PWC-3 | ACROVYN | ACROVYN 4000 | #262 DRIFTWOOD | . |
| CORNER GUARDS | PWC-4 | ACROVYN | ACROVYN 4000 | #262 DRIFTWOOD | . |
| TACKBOARD | TB-1 | KOROSEAL | WALLTALKERS TAC-WALL (8' x 48') | CAYENNE | . |
| TACKBOARD | TB-2 | KOROSEAL | WALLTALKERS TAC-WALL (8' x 48') | BOTANICAL | . |
| TACKBOARD | TB-3 | KOROSEAL | WALLTALKERS TAC-WALL (8' x 48') | CITRINE | . |
| TACKBOARD | TB-4 | KOROSEAL | WALLTALKERS TAC-WALL (8' x 48') | DEEP SEA | . |
| TACKBOARD | TB-5 | KOROSEAL | WALLTALKERS TAC-WALL (8' x 48') | PEWTER | . |

2

COLOR SCHEDULE

| MATERIAL | DESIGNATION | MANUFACTURER | STYLE | COLOR | REMARKS |
|--------------------------------|-------------|-------------------|--|--------------------------------------|---------|
| CUBICLE CURTAIN | CC-1 | ARC COM | #AC-33103, NAM1 | SEA MIST #4 | 10 |
| CORNER GUARD | CG-1 | KOROGARD | GS20 | STAINLESS STEEL | . |
| CARPET TILE | CPT-1 | MOHAWK GROUP | COLOR BALANCE #GT405 (12' x 36') | #959, BEDROCK | 5, 8 |
| CARPET TILE | CPT-2 | MOHAWK GROUP | COLOR BALANCE #GT405 (12' x 36') | #9269, TITANIUM | 5, 8 |
| CARPET TILE | CPT-3 | MOHAWK GROUP | COLOR BALANCE #GT405 (12' x 36') | #556, FILTERED | 5, 8 |
| CARPET TILE | CPT-4 | MOHAWK GROUP | COLOR BALANCE #GT405 (12' x 36') | #566, ELECTRIC | 5, 8 |
| CARPET TILE | CPT-5 | MOHAWK GROUP | COLOR BALANCE #GT405 (12' x 36') | #641, PUNCHY | 5, 8 |
| CARPET TILE | CPT-6 | MOHAWK GROUP | COLOR BALANCE #GT405 (12' x 36') | #252, SOLAR | 5, 8 |
| CARPET TILE | CPT-7 | MOHAWK GROUP | FIRST STEP II, #GT315 / #QL315 (24' x 24') | #955, COBALT | . |
| FIBER REINFORCED PANEL | FRP-1 | NUDO | EMBOSSSED | WHITE (50) | . |
| FIBER REINFORCED PANEL | FRP-2 | NUDO | SMOOTH | WHITE (50) | . |
| LUXURY VINYL TILE | LVT-1 | MOHAWK | LINEATE | 948 FIGURED | 5 |
| LUXURY VINYL TILE | LVT-2 | MOHAWK | LINEATE | 232 BARRED | 5 |
| LUXURY VINYL TILE | LVT-3 | MOHAWK | LINEATE | 656 LINES | 5 |
| METAL ROOFING | MT-1 | IMETCO | . | CADET GRAY | . |
| METAL WALL SYSTEM (CORRUGATED) | MT-2 | IMETCO | . | CADET GRAY | . |
| METAL COMPOSITE PANEL (SMOOTH) | MT-3 | ALUCOBOND | . | CHAMPAGNE METALLIC | . |
| METAL COMPOSITE PANEL (SMOOTH) | MT-4 | ALUCOBOND | . | CHESTNUT (PVDF) | 11 |
| PAINT | P-1 | BENJAMIN MOORE | . | #OC-57, WHITE HERON | . |
| PAINT | P-2 | SHERWIN WILLIAMS | . | #SW 1015, SKYLINE STEEL | . |
| PAINT | P-3 | SHERWIN WILLIAMS | . | #SW7642, PAVESTONE | . |
| PAINT | P-4 | SHERWIN WILLIAMS | . | #SW 0042, RUSKIN ROOM GREEN | . |
| PAINT | P-5 | SHERWIN WILLIAMS | . | #SW 7617, MEDITERRANEAN | . |
| PAINT | P-6 | SHERWIN WILLIAMS | . | #SW 6229, TEMPE STAR | . |
| PAINT | P-7 | BENJAMIN MOORE | . | #2175-30, RUST | . |
| PAINT | P-8 | BENJAMIN MOORE | . | #2132-10, BLACK | . |
| PAINT (EXTERIOR) | P-9 | SHERWIN WILLIAMS | . | #SW7541, GRECIAN IVORY | . |
| PAINT (EXTERIOR) | P-10 | BENJAMIN MOORE | . | #HC-105, ROCKPORT GRAY | . |
| PAINT (EXTERIOR) | P-11 | SHERWIN WILLIAMS | . | #SW7019, GAUNTLET GRAY | . |
| PAINT (EXTERIOR) | P-12 | BENJAMIN MOORE | . | #HC-10, STUART GOLD | . |
| PLASTIC LAMINATE | PL-1 | FORMICA | NATURAL GRAIN | #8910-NG, RAW BIRCHPLY | 7 |
| PLASTIC LAMINATE | PL-2 | FORMICA | NATURAL GRAIN | 8910-NG RAW BIRCH PLY | . |
| PLASTIC LAMINATE | PL-3 | FORMICA | MATTE FINISH | #928-58, MOUSE | . |
| PLASTIC LAMINATE | PL-4 | WILSONART | VERANDA TEAK | 8209K-28 | 7 |
| PLASTIC LAMINATE | PL-5 | ARBORITE | . | #P-400 CA, CHAMBRAY FUSAIN | . |
| PLASTIC LAMINATE | PL-6 | ARBORITE | . | #P-382 CA, CLOUDY TWILL | . |
| PLASTIC LAMINATE (STAGE) | PL-8 | WILSONART | LINEARITY FINISH | #7939K-18, BLONDE ECHO | 7 |
| TOILET PARTITION | PRT-1 | SCRANTON PRODUCTS | HINY HIDERS | CONCRETE (ORANGE PEEL) | . |
| PROTECTIVE WALL COVERING | PWC | KOROGARD | WALL PROTECTION SYSTEMS | SHEET .040 THICKNESS, MANITOBA MAPLE | 12 |

ABBREVIATIONS

- CC CUBICLE CURTAIN
- CPT CARPET
- CS COMPOSITE PANELING
- FRP FIBER REINFORCED PANEL
- LVT LUXURY VINYL TILE
- MT METAL
- P PAINT
- PWC WALL PROTECTION
- RTB RUBBER TOPSET BASE
- RT RUBBERIZED NON-SLIP TREAD
- SO SOLID QUARTZ SURFACE
- TB WALLTALKERS TAC-WALL
- TL TILE
- VTB VINYL TACKBOARD
- VAR VARIES

2

GENERAL NOTES

1. SEE SPECIFICATIONS FOR SUSPENDED ACOUSTICAL CEILING TILE TYPE.
2. ALL PAINT COLOR TRANSITIONS SHALL OCCUR AT INTERIOR CORNERS.
3. WINDOW JAMBS AT LOCATIONS WITH VINYL BACKBOARD FINISH TO RECEIVE V.T.B. WRAP.
4. SEE DETAIL 140/A8.7 FOR SUSPENDED ACOUSTICAL CEILING TILE SYSTEM.
5. ALL VINYL TACKBOARD TO BE APPLIED OVER GYPSUM BOARD SUBSTRATE.
6. CORNER GUARDS SHALL BE USED ON EXTERIOR CORNERS AT RIGID SHEET WALL PANELS. COLOR TO MATCH ADJACENT RIGID SHEET WALL PANELS.
7. EXTERIOR SIDE OF HOLLOW METAL DOORS & FRAMES SHALL BE: P-1
8. INTERIOR SIDE OF HOLLOW METAL DOORS & FRAMES SHALL BE: P-3
9. PLASTIC LAMINATE DOOR FINISH SHALL BE: P-2 w/ VERTICAL WOOD GRAIN.


REMARKS

1. GROUT COLOR SHALL BE: CUSTOM BUILDING PRODUCTS PRISM SURE COLOR GROUT, #335 WINTER GRAY
2. GROUT COLOR SHALL BE: CUSTOM BUILDING PRODUCTS PRISM SURE COLOR GROUT, #543 DRIFTWOOD
3. TILE INSTALLATION SHALL BE 90 DEGREE HERRINGBONE PATTERN AS SHOWN ON INTERIOR ELEVATIONS.
4. TILE INSTALLATION SHALL BE STACKED PATTERN AT RESTROOM WALLS AND FLOORS.
5. SEE FINISH FLOOR PLAN, SHEET A2.9 thru A2.10 FOR FLOOR PATTERNS & DIRECTION OF INSTALLATION
6. SEE EXTERIOR ELEVATIONS FOR LOCATION OF SMOOTH & CORRUGATED METAL PANELS
7. RUN GRAIN ON PLASTIC LAMINATE HORIZONTAL, UNLESS OTHERWISE NOTED ON PLAN.
8. CARPET TILE INSTALLATION SHALL BE 90 DEGREE HERRINGBONE
9. GROUT COLOR SHALL BE: CUSTOM BUILDING PRODUCTS PRISM SURE COLOR GROUT, #185 NEW TALPE
10. CUBICLE CURTAIN IS LOCATED IN NURSE 132.
11. WOODGRAIN SERIES BY ALUCOBOND (OR APPROVED EQUAL)
12. ADD LAYER OF SHEETROCK UNDER KOROGARD TO MATCH THE THICKNESS OF THE TACKBOARD.




7790 NORTH PALM AVENUE
FRESNO, CALIFORNIA 93711
T 559.448.8400 · F 559.448.8467
www.simprk.com

PROJECT:
SHIELDS & BRAWLEY ELEMENTARY SCHOOL

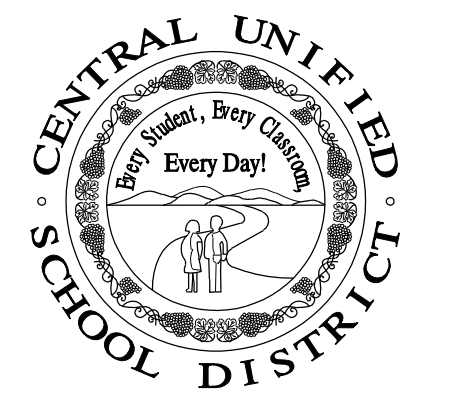

AD 2-19a
S&B Elementary
02-116800

JOHN H. SMITH, A.I.A. C15885

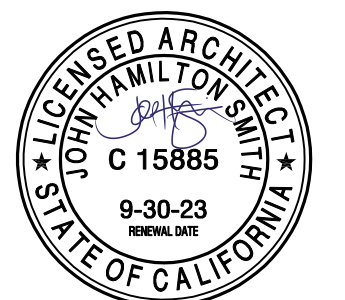

THE FIRM OF SMITH, WANAGA, MILHOUS, ARCHITECTS, INC. EXPRESSLY RESERVES ITS COMMON LAW COPYRIGHT AND OTHER APPLICABLE PROPERTY RIGHTS IN THESE PLANS. THESE PLANS ARE NOT TO BE REPRODUCED, CHANGED, OR COPIED IN ANY FORM OR MANNER WHATSOEVER, NOR ARE THEY TO BE ASSIGNED TO A THIRD PARTY WITHOUT FIRST OBTAINING THE WRITTEN PERMISSION AND CONSENT OF THE ARCHITECT. IN THE EVENT OF UNAUTHORIZED REUSE OF THESE PLANS BY A THIRD PARTY, THE THIRD PARTY SHALL HOLD THE ARCHITECT HARMLESS, AND SHALL BEAR THE COST OF THE ARCHITECT'S LEGAL FEES, ASSOCIATED WITH DEFENDING AND ENFORCING THESE RIGHTS.

PROJECT DEVELOPMENT

| DATE | ISSUED FOR |
|------|------------|
| | |
| | |
| | |
| | |

REVISIONS


| No. | DATE | DESCRIPTION |
|-----|---------|------------------------|
| Δ | 2.14.23 | DISTRICT MODIFICATIONS |
| Δ | 2.27.23 | DISTRICT MODIFICATIONS |
| | | |
| | | |

SHEET DESCRIPTION

COLOR SCHEDULE


| | |
|-----------------------------------|-------------|
| PROJECT COORDINATOR JOHN SMITH | SHEET No. |
| PROJECT NO. 17-67 | A2.8 |
| DATE 1.27.23 | |
| SCALE AS NOTED | |

2

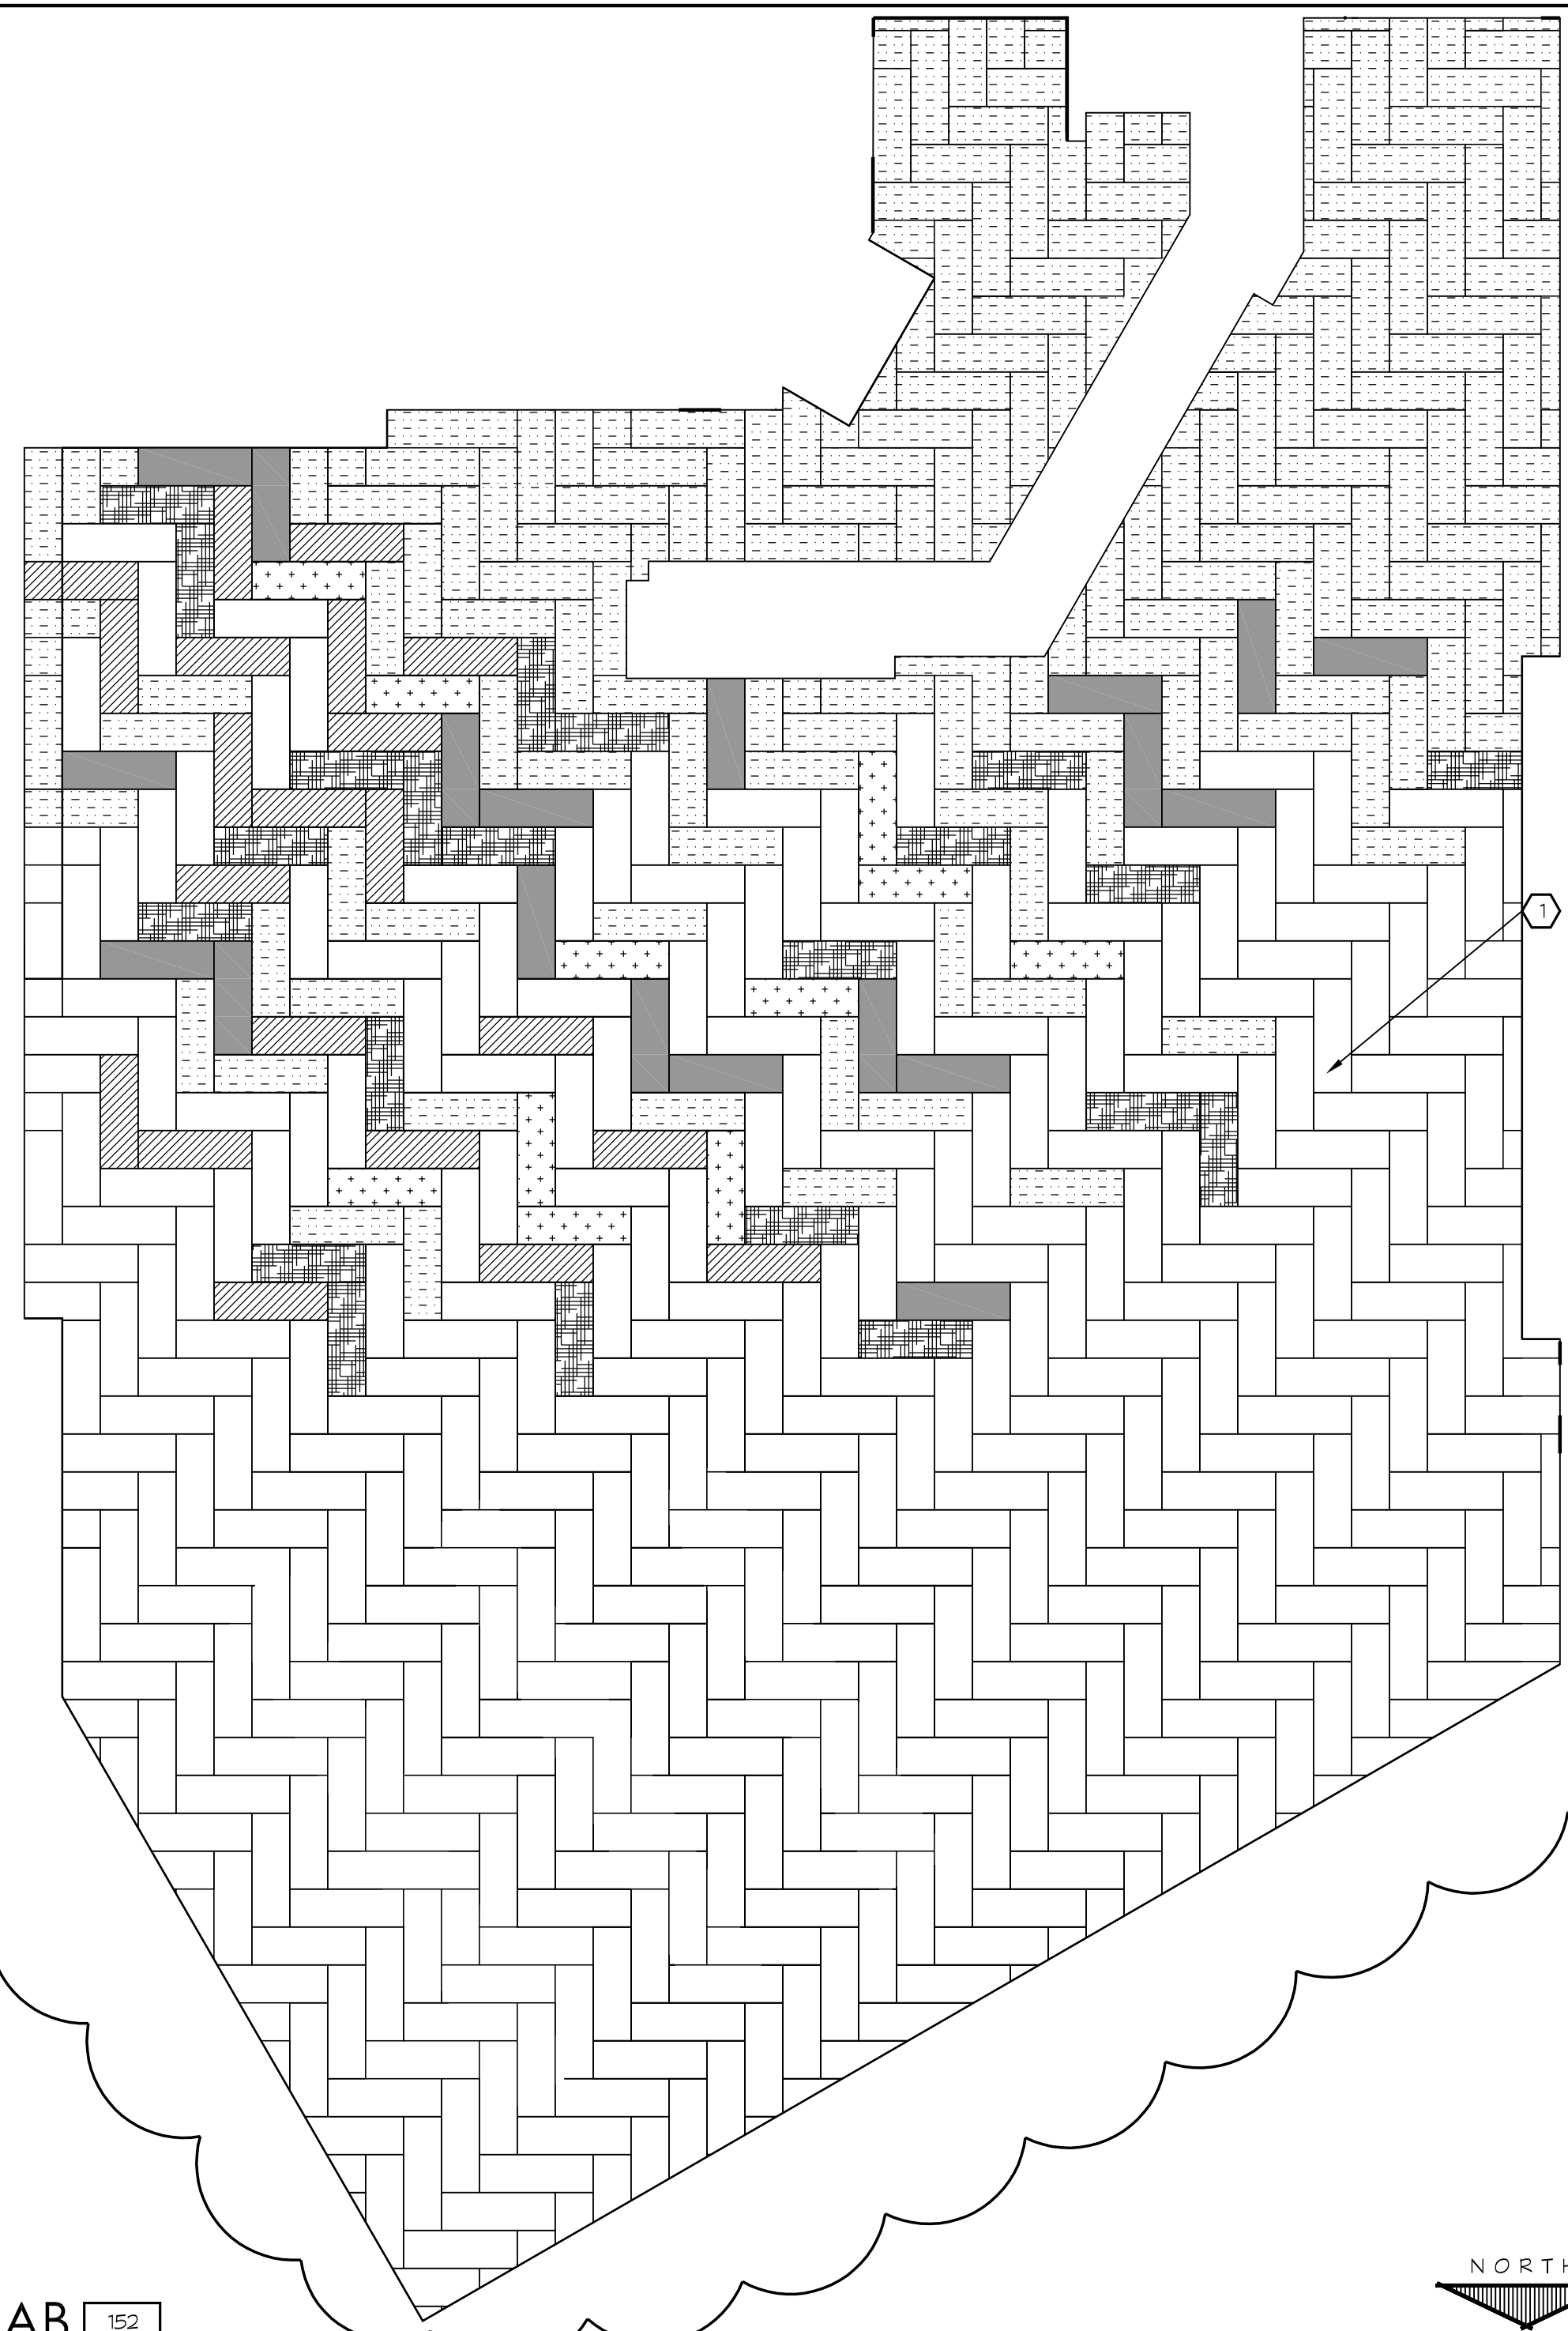


C MEDIA LAB 152 ENLARGED FINISH FLOOR PLAN

NORTH
SCALE: 1/4" = 1'-0"

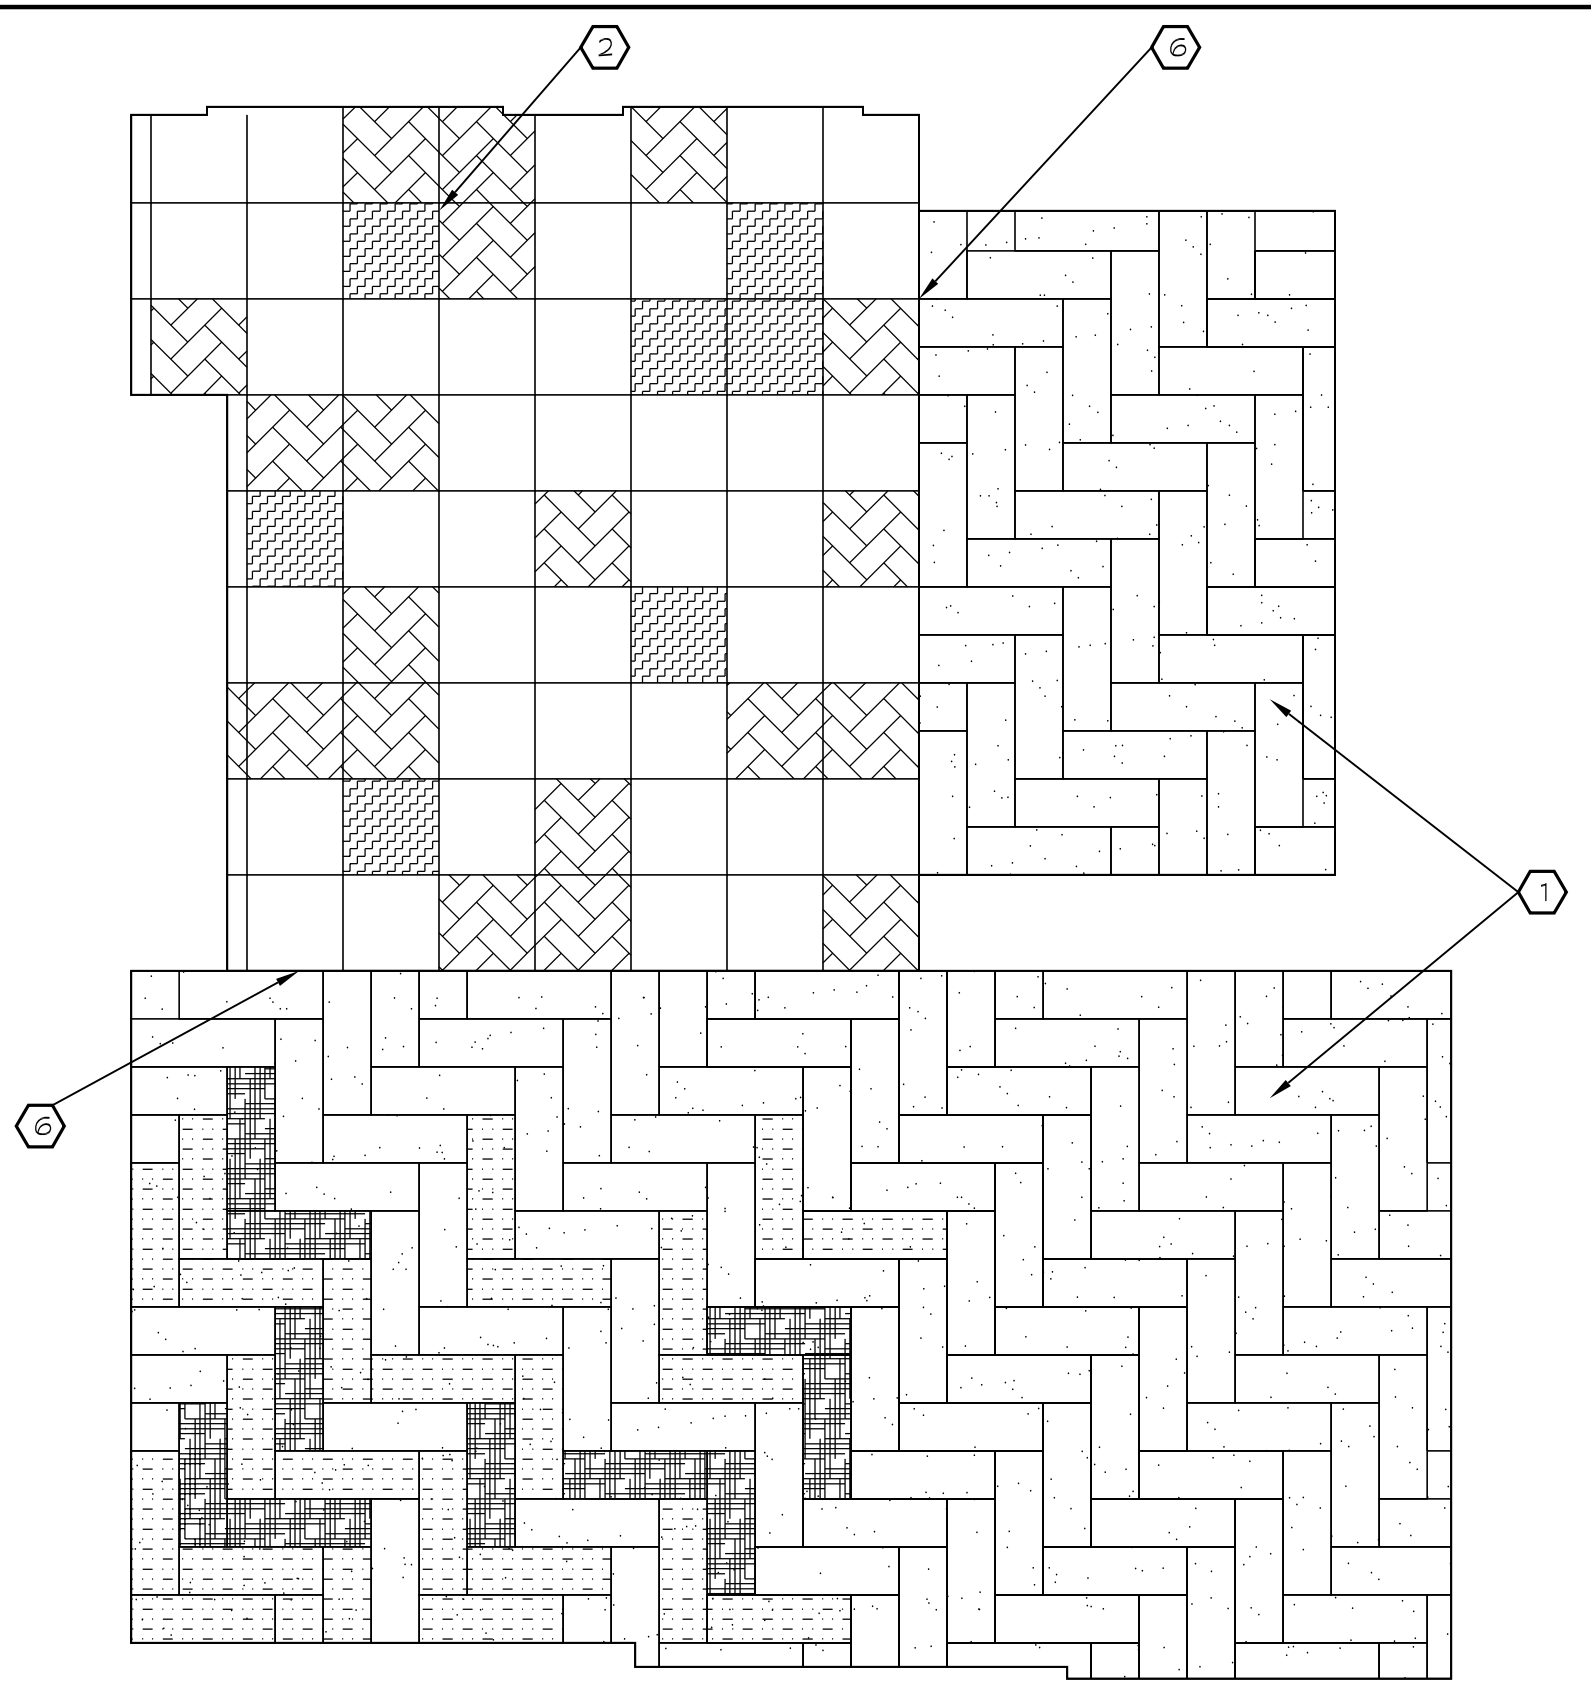


A KINDERGARTEN 116 ENLARGED FINISH FLOOR PLAN

NORTH
SCALE: 1/4" = 1'-0"

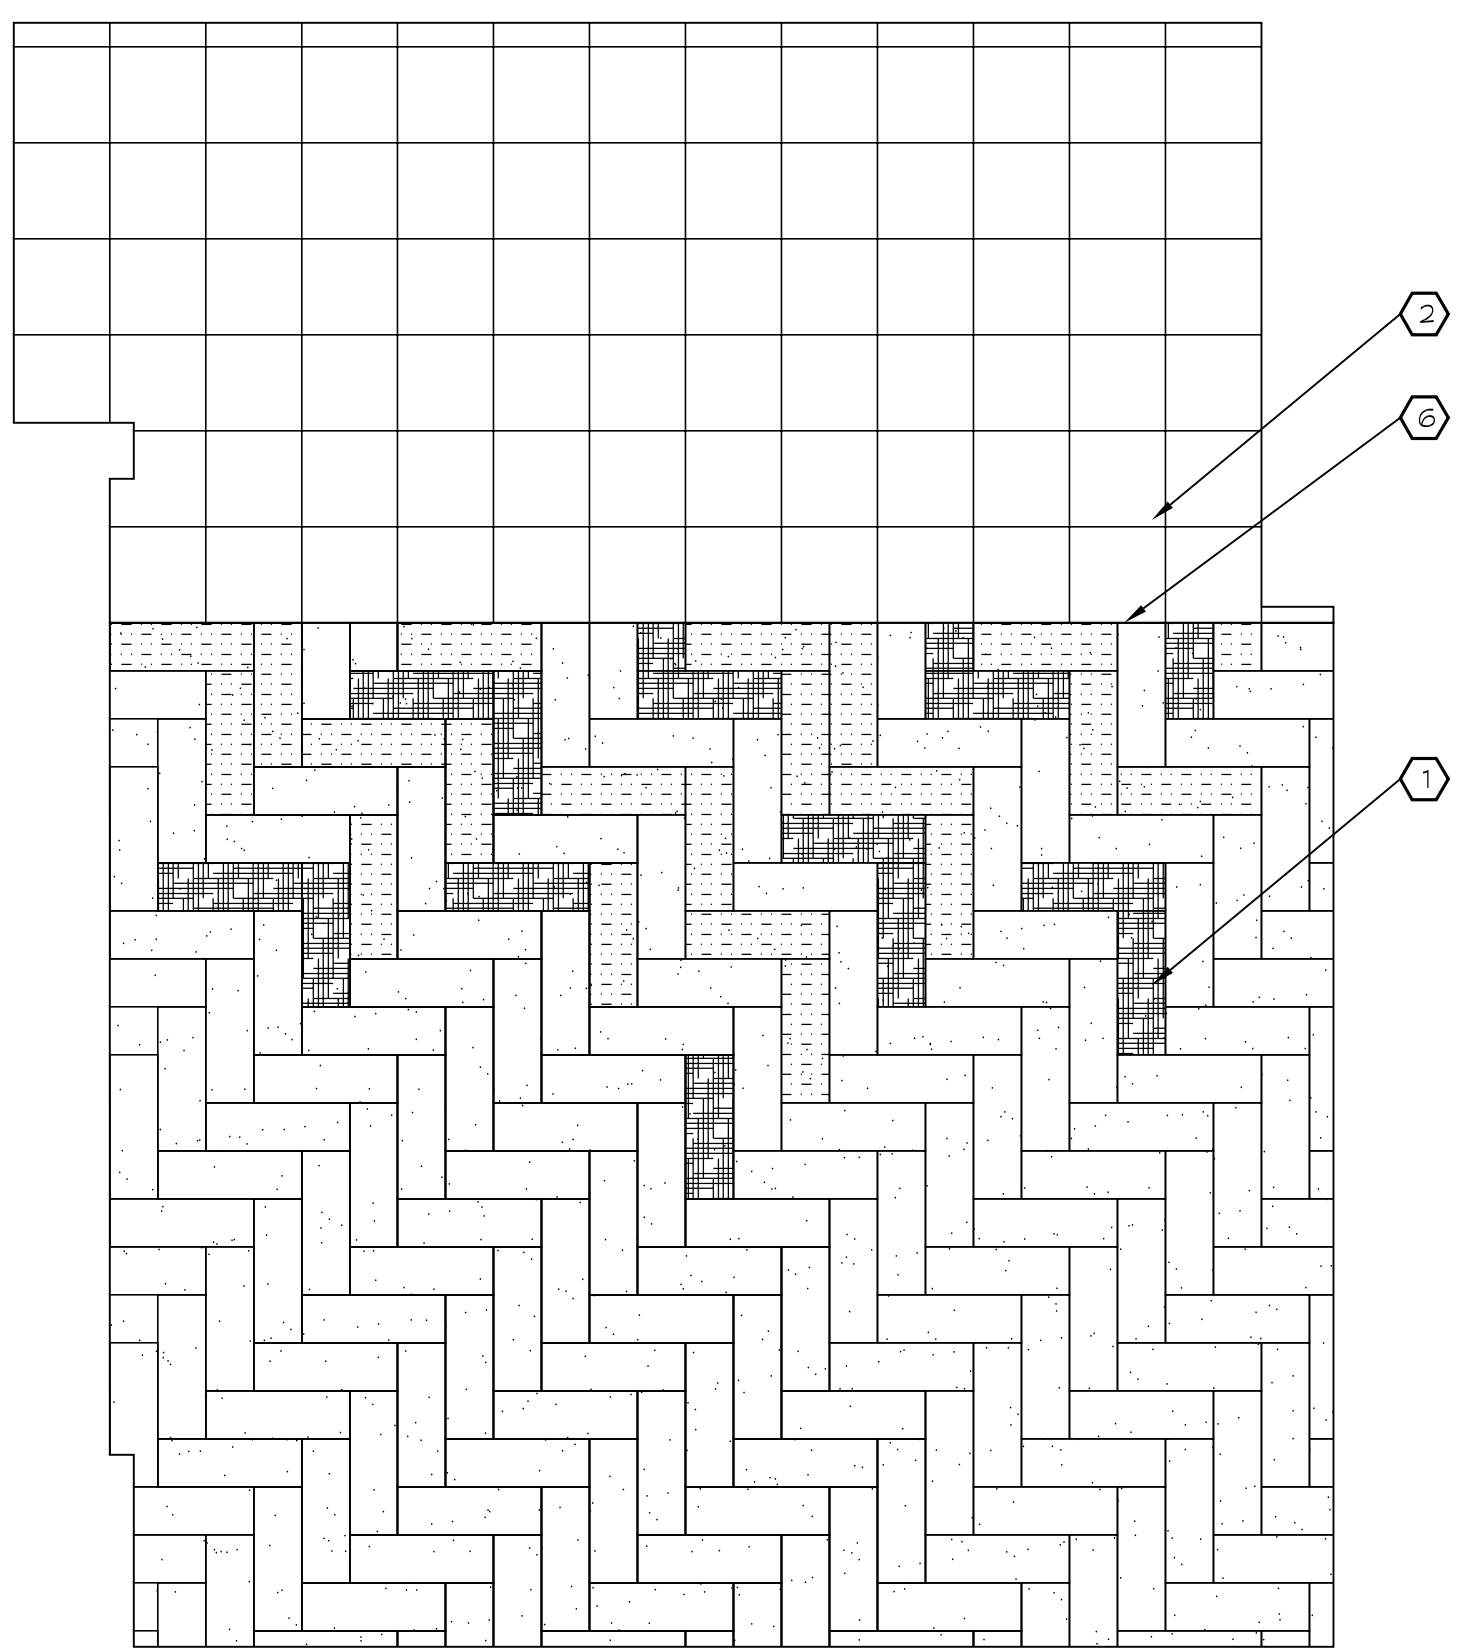

B CLASSROOM 102 ENLARGED FINISH FLOOR PLAN

NORTH
SCALE: 1/4" = 1'-0"

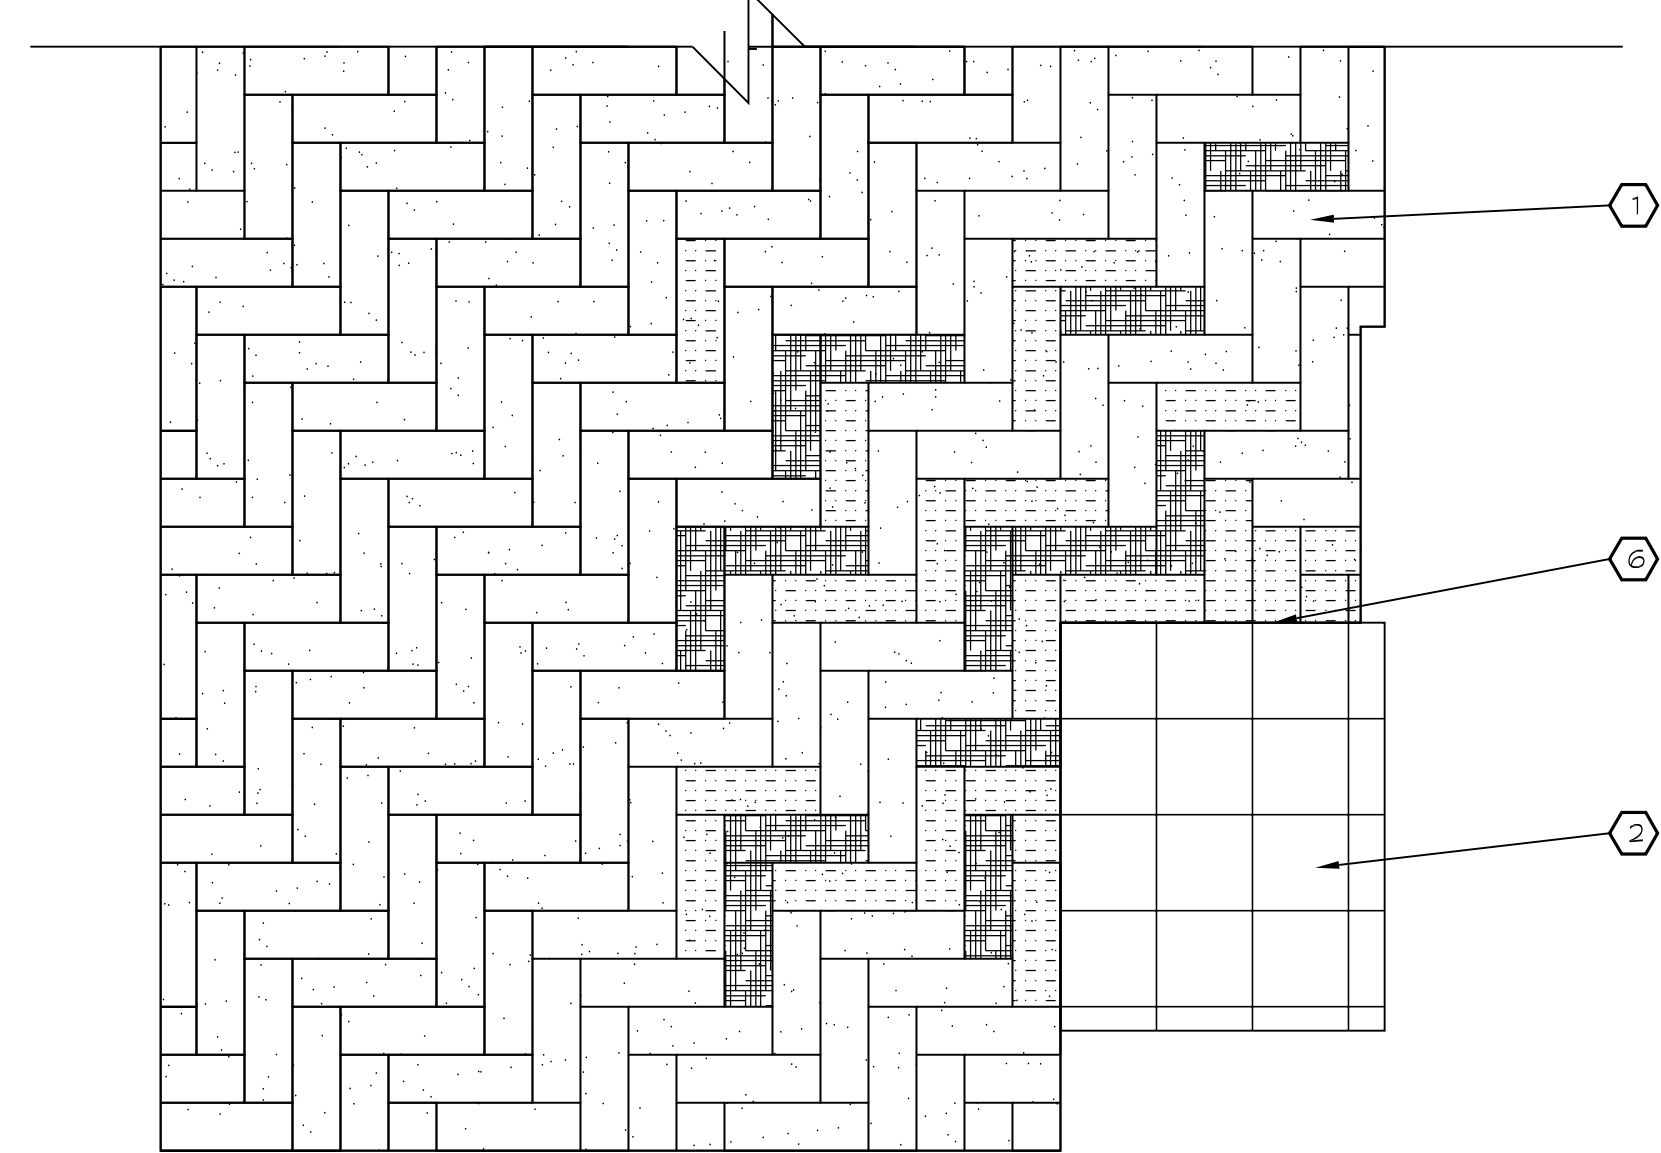


D CLASSROOM 141 ENLARGED FINISH FLOOR PLAN

NORTH
SCALE: 1/4" = 1'-0"


KEYNOTES

- 1. CARPET
- 2. LUXURY VINYL TILE
- 3. open
- 4. POLISHED CONCRETE (NATURAL COLOR)
- 5. TILE
- 6. TRANSITION & EDGE TREATMENT. SEE DTL. 78/A8.4

LEGEND

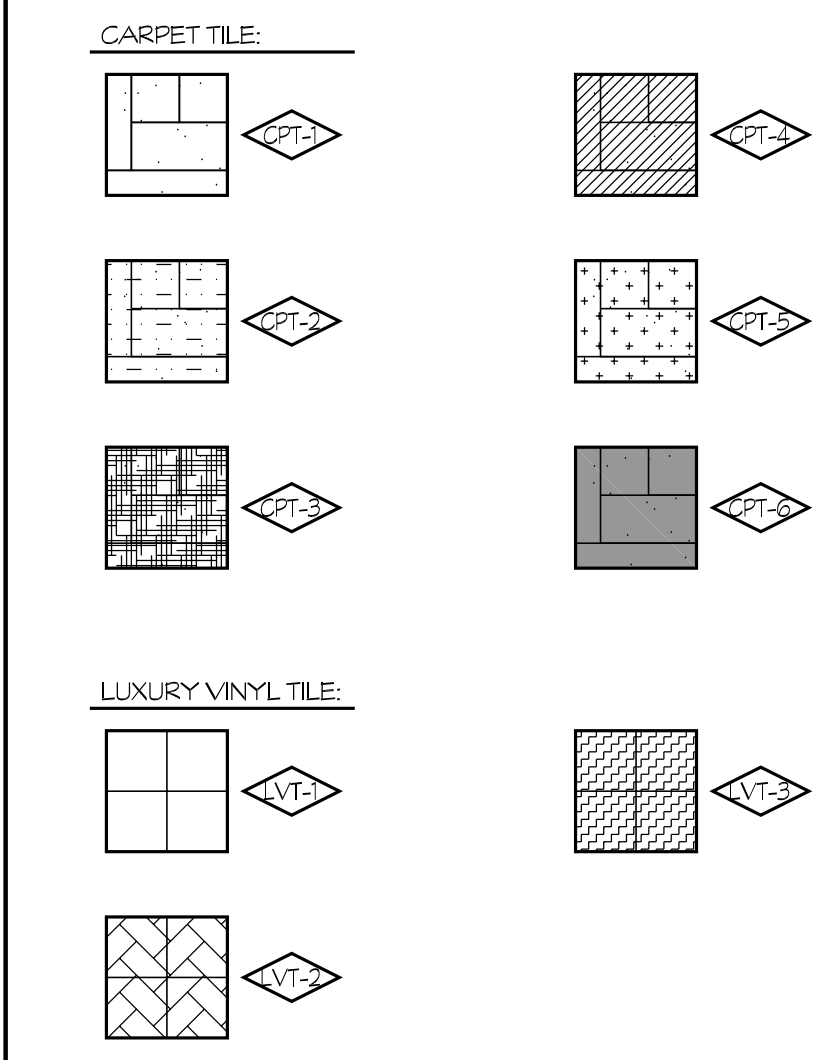

KEY PLAN

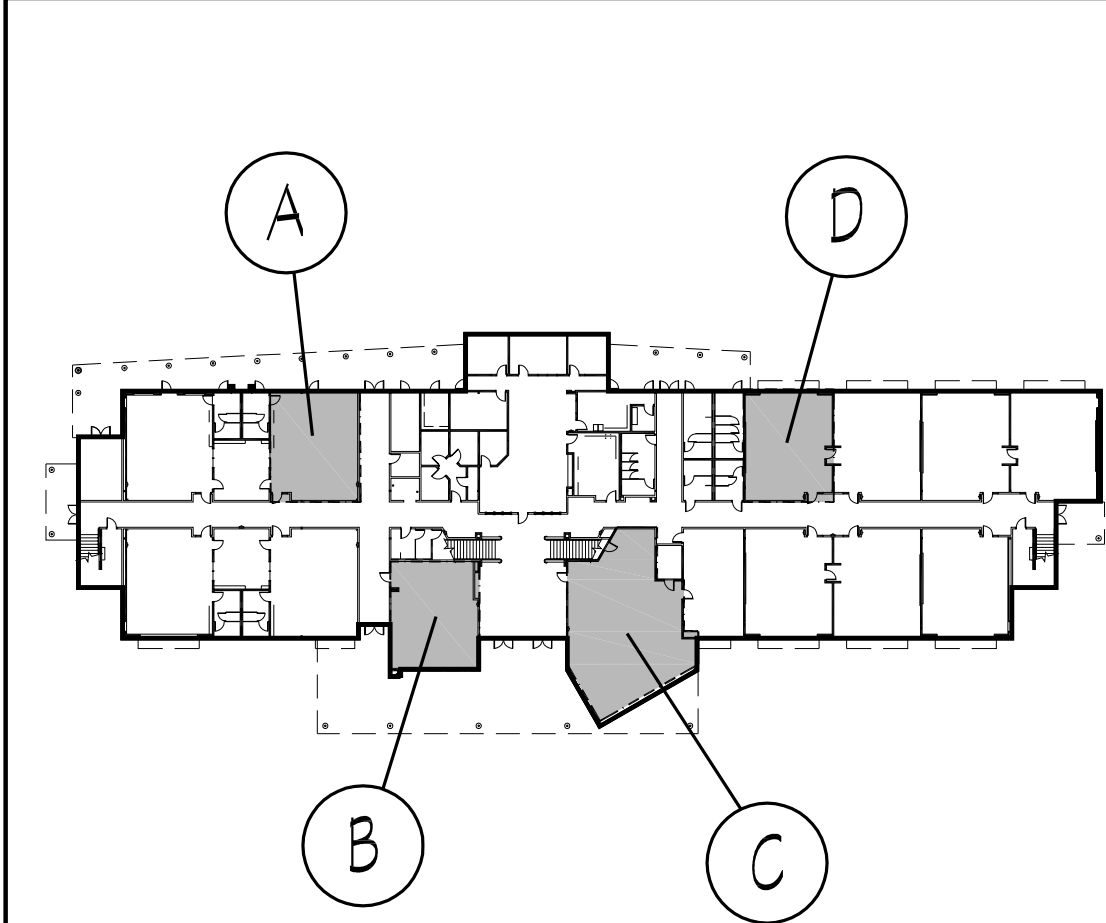


7790 NORTH PALM AVENUE
FRESNO, CALIFORNIA 93711
T 559.448.8400 F 559.448.8467
www.sim-pbk.com

PROJECT:
SHIELDS & BRAWLEY ELEMENTARY SCHOOL



AD 2-20a
S&B Elementary
02-116800

JOHN H. SMITH, A.L.A. C15885

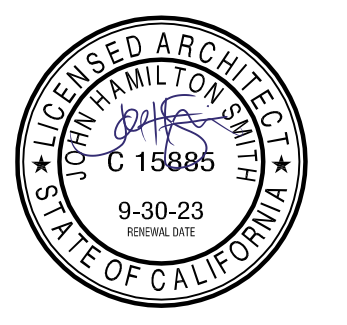

THE FIRM OF SMITH, SWANAGA, MILHOLS, ARCHITECTS, INC. EXPRESSLY RESERVES ITS COMMON LAW COPYRIGHT AND OTHER APPLICABLE PROPERTY RIGHTS IN THESE PLANS. THESE PLANS ARE NOT TO BE REPRODUCED, CHANGED, OR COPIED IN ANY FORM OR MANNER WHATSOEVER, NOR ARE THEY TO BE ASSIGNED TO A THIRD PARTY WITHOUT FIRST OBTAINING THE WRITTEN PERMISSION AND CONSENT OF THE ARCHITECT. IN THE EVENT OF UNAUTHORIZED REUSE OF THESE PLANS BY A THIRD PARTY, THE THIRD PARTY SHALL HOLD THE ARCHITECT HARMLESS, AND SHALL BEAR THE COST OF THE ARCHITECT'S LEGAL FEES ASSOCIATED WITH DEFENDING AND ENFORCING THESE RIGHTS.



| PROJECT DEVELOPMENT | |
|---------------------|------------|
| DATE | ISSUED FOR |
| | |
| | |

| REVISIONS | | |
|-----------|---------|------------------------|
| No. | DATE | DESCRIPTION |
| △ | 2.14.23 | DISTRICT MODIFICATIONS |
| △ | 2.27.23 | DISTRICT MODIFICATIONS |

| SHEET DESCRIPTION | |
|-----------------------------------|-------------|
| ENLARGED FINISH FLOOR PLAN | |
| MAIN - 1ST FLOOR | |
| PROJECT COORDINATOR JOHN SMITH | SHEET No. |
| PROJECT NO. 17-67 | A2.9 |
| DATE 1.27.23 | |
| SCALE 1/4" = 1'-0" | |

S:\17-67 Shields & Brawley Elementary\Work\17-67-029-Floor-Finishes-Plan-Misc-Info-05/22/23-21-53

WINDOW WALL, SEE DEFERRED ITEM NO. 2

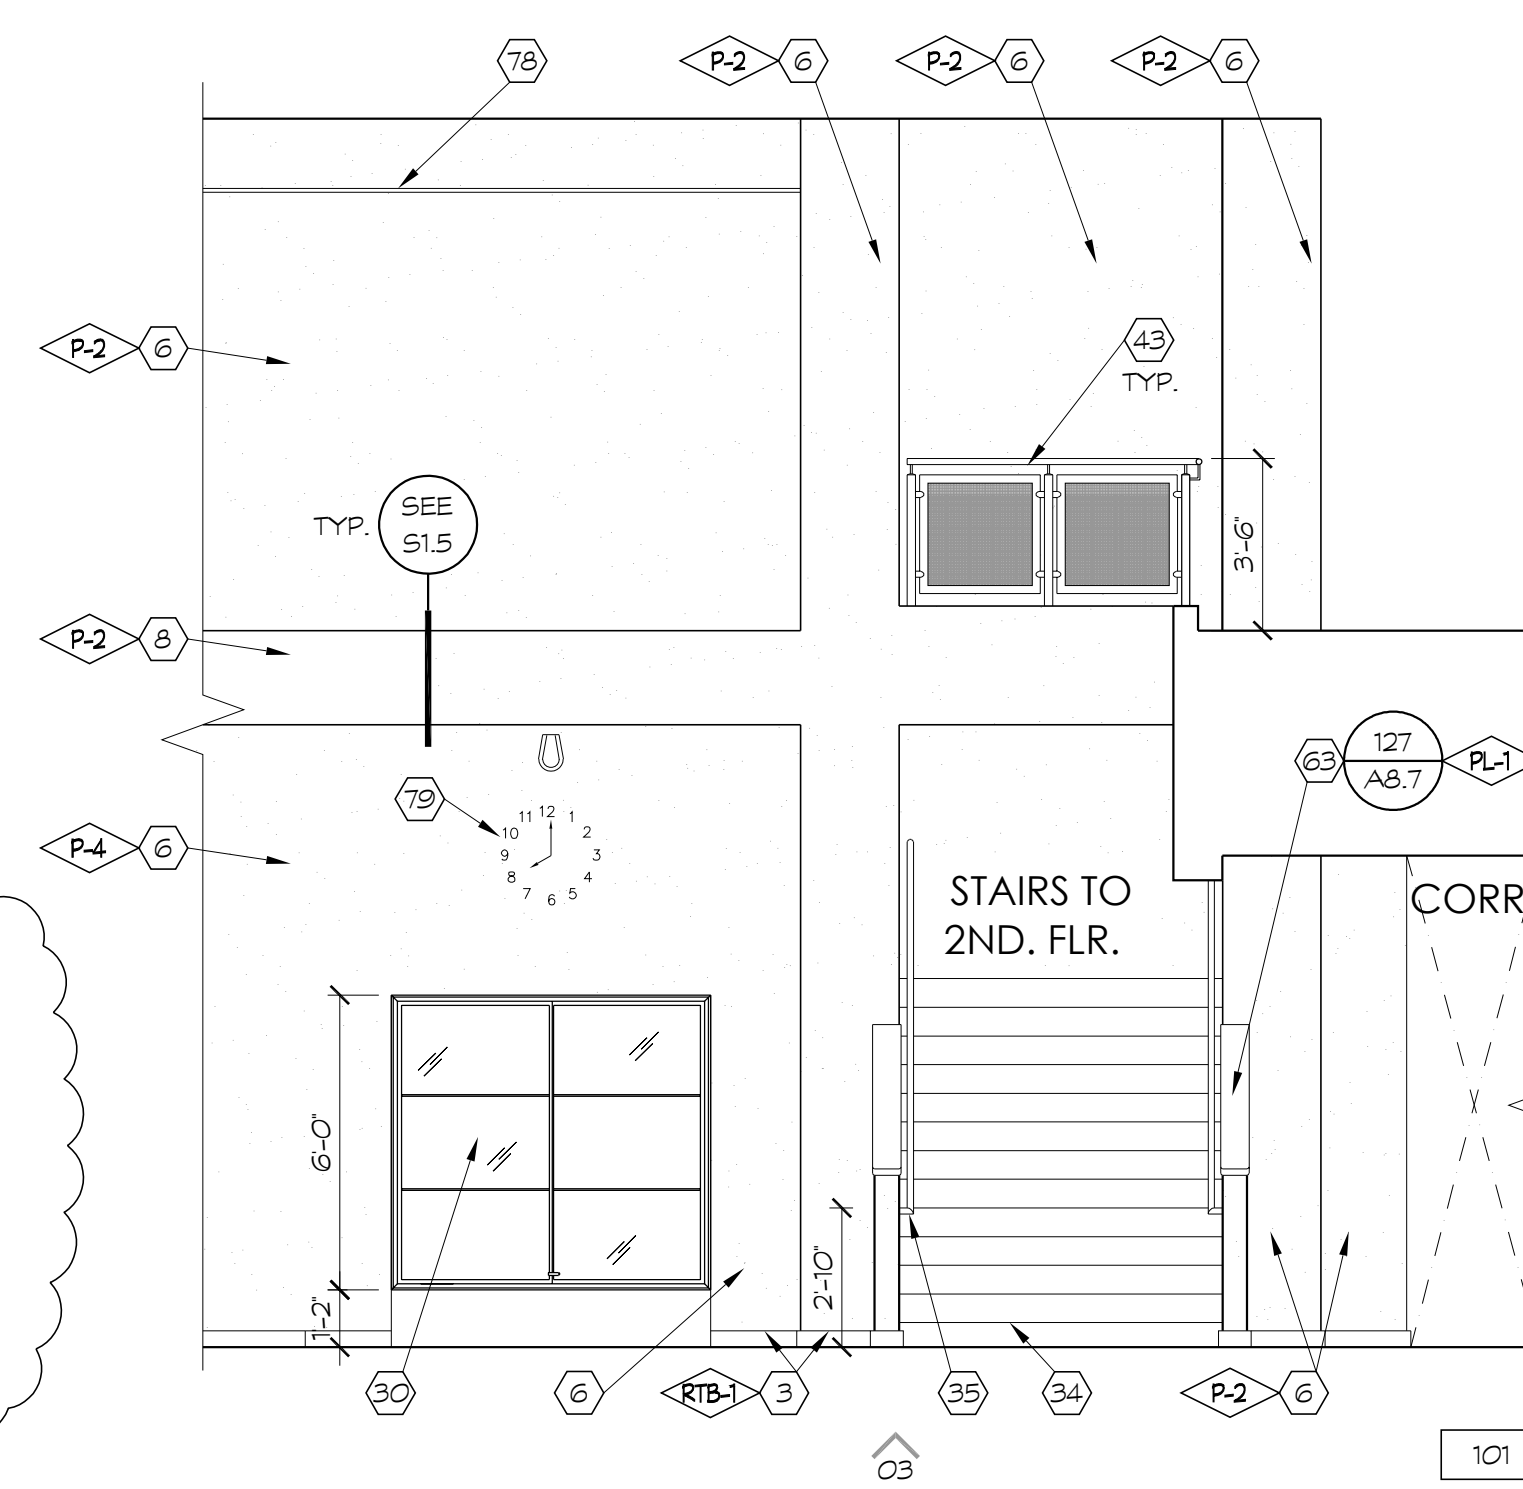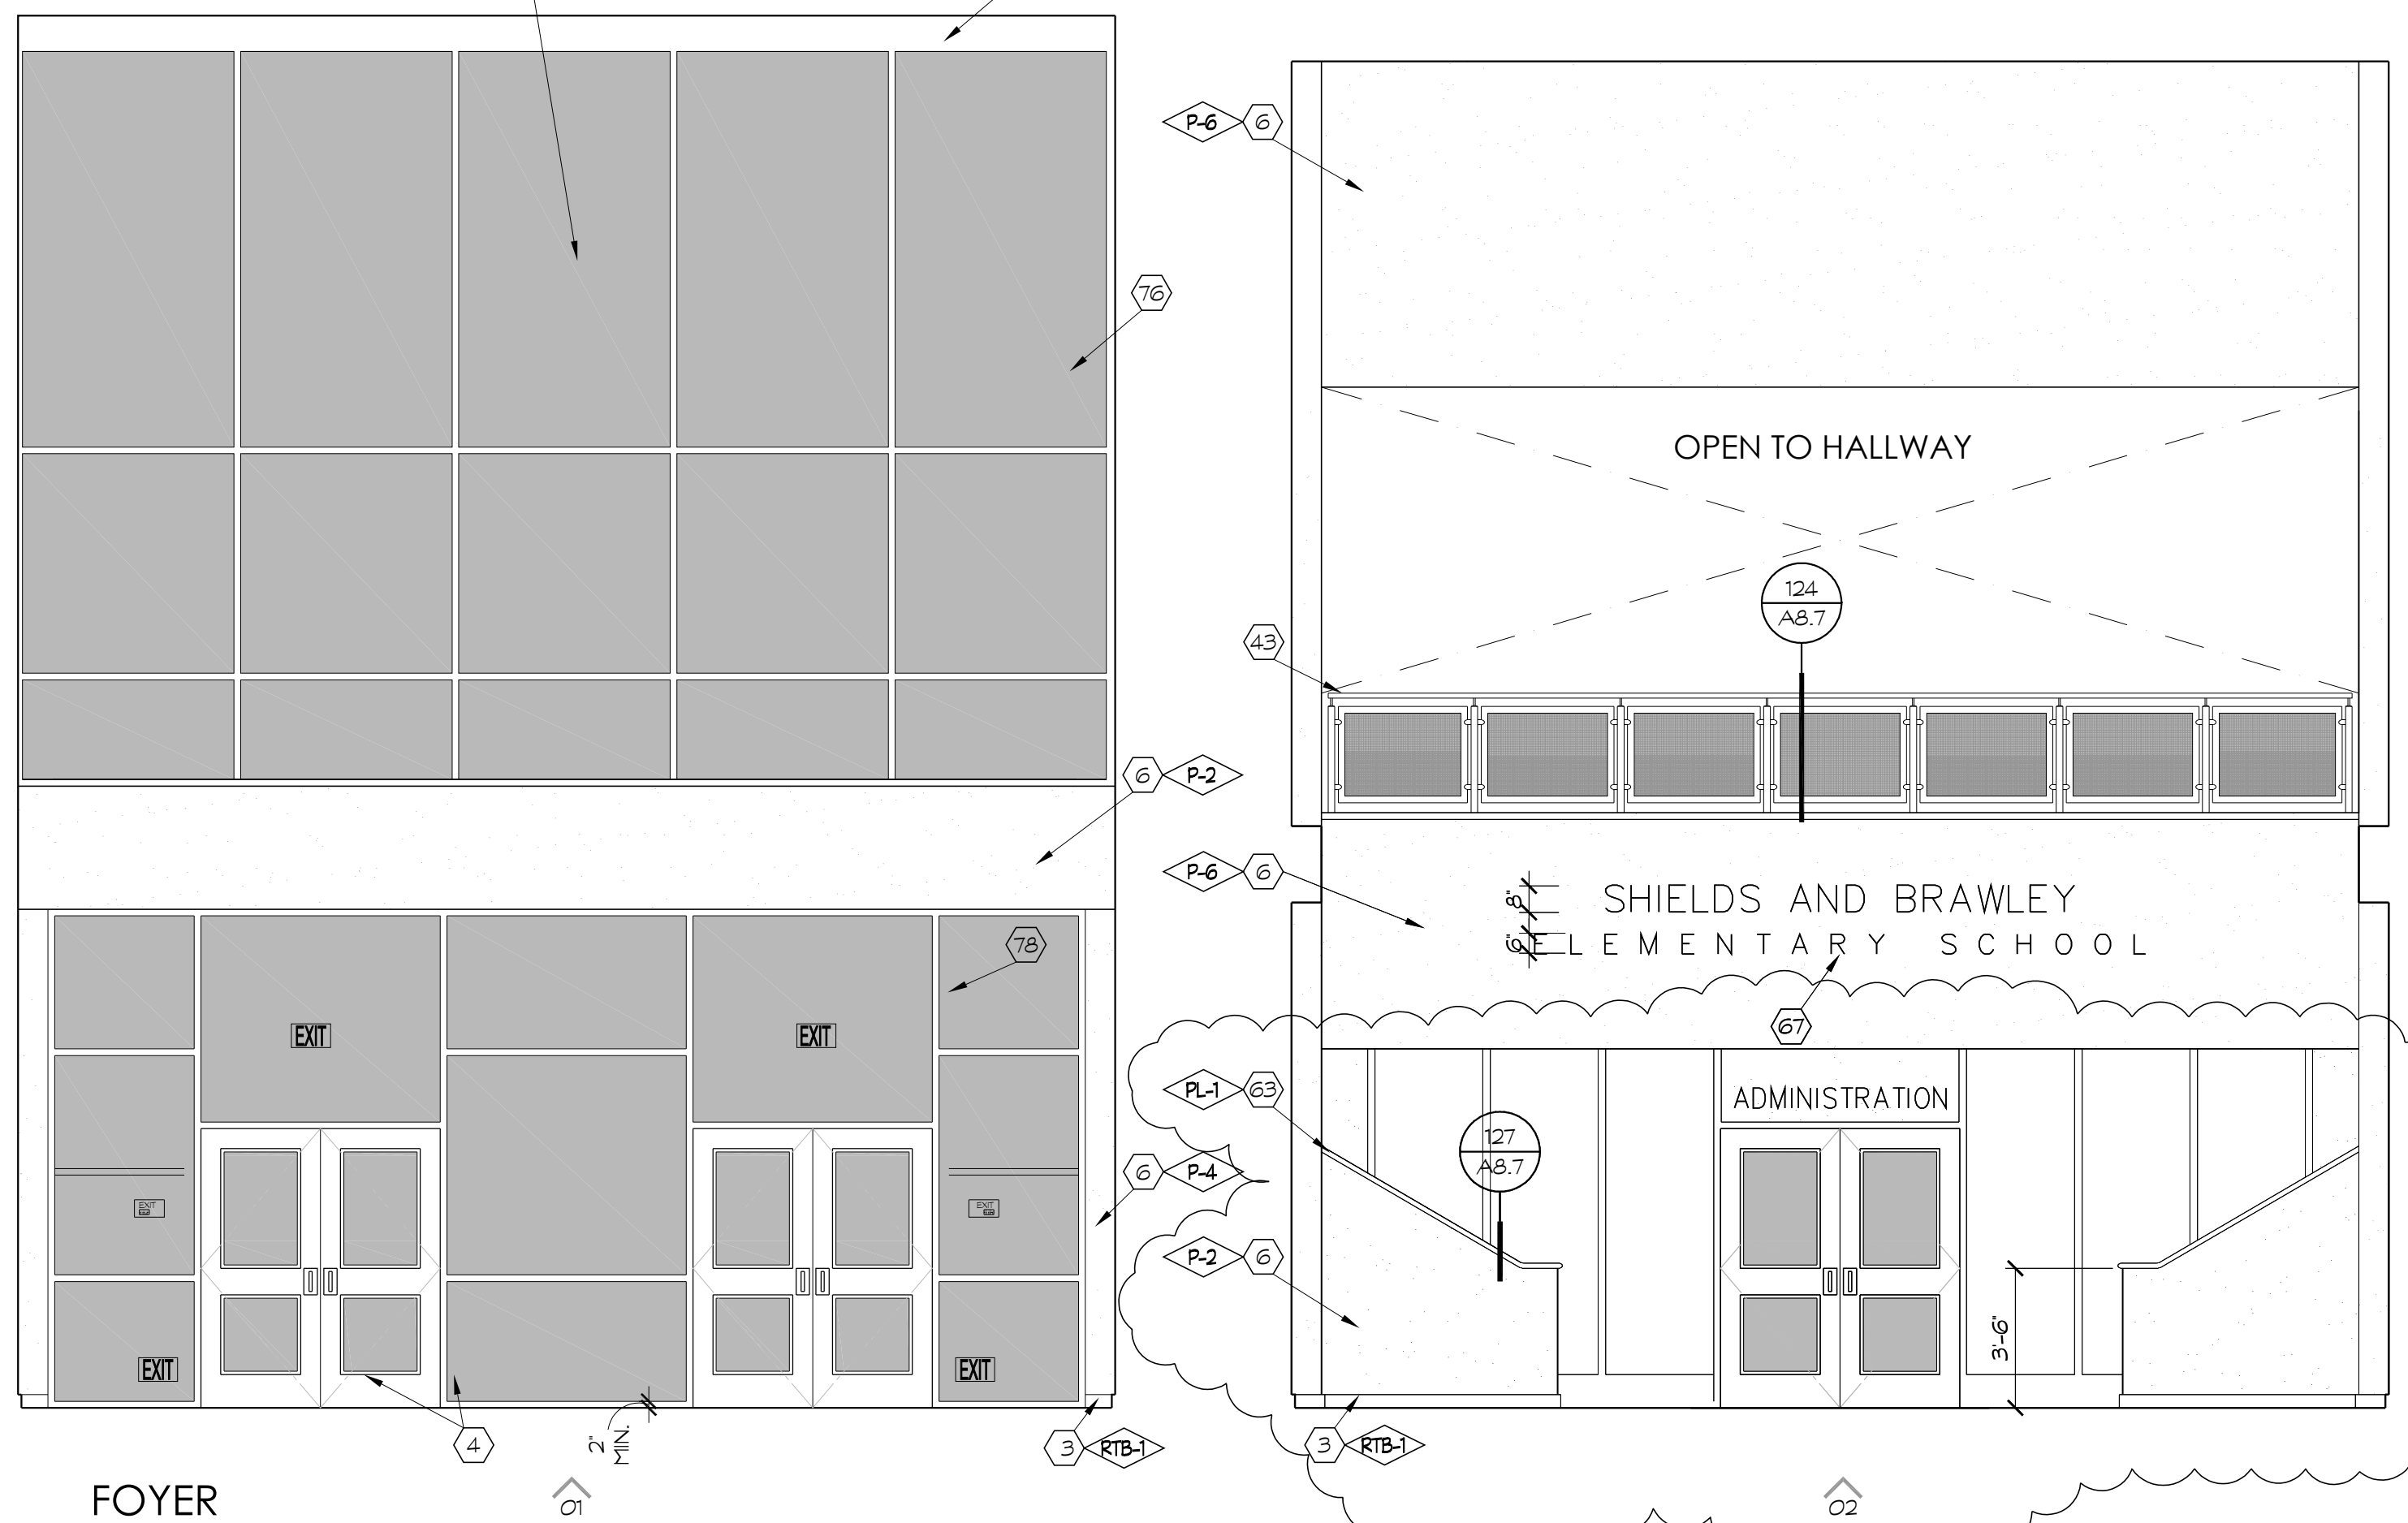


KEYNOTES

1. KNEE SPACE
2. VINYL TACKBOARD @ GYP. BD.
3. RUBBER TOPSET BASE
4. STOREFRONT
5. PAPER TOWEL DISPENSER
6. GYPSUM BOARD, TAPE, TEXTURE & PAINT (PROVIDE 5/8" TYPE X GYP. BD. AT STAIRWAYS AND UNDERSTAIR WALL/CEILING FINISHES, TYP.)
7. ROOF ACCESS LADDER
8. SOFFIT
9. FLOOR SINK - SEE PLUMBING
10. UNDER-COUNTER REFRIGERATOR
11. FIRE EXTINGUISHER w/ SEMI RECESSED CAB. TYPE 2A10BC
12. PLASTIC LAMINATE CASEWORK
13. W.I.G. 400 STORAGE SHELVING
14. FIBER REINFORCED PANEL
15. PLASTIC LAMINATE BACKSPLASH & COUNTERTOP
16. METAL POST, PER STRUCTURAL
17. SINK - SEE PLUMBING SCHEDULE
18. MAGNETIC MARKER BOARD @ VTB
19. APPLIANCES - SEE SPEC SECTION 11400
20. BUTCHER PAPER HOLDER
21. DISHWASHER
22. HOOD
23. REFRIGERATOR - FULL HEIGHT
24. COOKTOP
25. ROLL-UP DOOR
26. STAINLESS STEEL COUNTERTOP
27. FURNITURE (N.I.C.)
28. DRINKING FOUNTAIN
29. CLOCK/SPEAKER
30. CLEAR GLASS DISPLAY CASE w/ LOCK (SEE SPEC. SECT. 10410)
31. FEMININE NAPKIN DISPOSAL
32. MIRROR
33. TRACK AND CUBICLE CURTAIN
34. STAIRCASE
35. HANDRAIL
36. N/A
37. TRANSLUCENT WALL SYSTEM
38. WOOD BASE
39. WHEEL CHAIR LIFT
40. BELOW STAGE STORAGE
41. SHEET VINYL COVERED BASE
42. ELEVATOR LANTERN
43. RAILING, SPACING SHALL BE SUCH THAT A 4" DIA. SPHERE CANNOT PASS THROUGH ANY OPENING, PER CBC 1013
44. CALL BUTTON
45. ELEVATOR DOORS
46. LAVATORY
47. TOILET PAPER DISPENSER
48. TOILET SEAT COVER DISPENSER
49. DATA RACEWAY. SEE ELECTRICAL DRAWINGS.
50. CLOCK
51. 4" HIGH CORNER GUARD, TYP.
52. SOAP DISPENSER
53. PLASTIC TOILET PARTITION
54. SIGNAGE
55. MANUFACTURED 3"Wx6" MTL. SHELVING, SEE S-1/K-8.0
56. SPEAKER ENCLOSURE AND GRILLE
57. MOP/BROOM HOLDER
58. PLASTIC LAM. DOOR, 1 1/2" THICK
59. PROVIDE 3/4" LAM. PLASTIC SUPPORTS AT STOREFRONT, AT 4'-0" C.
60. RAYTHERMS (N.I.C.)
61. URINAL
62. MICROWAVE (N.I.C.)
63. PLASTIC LAMINATE CAP
64. CERAMIC TILE
65. GRAB BAR
66. WATER CLOSET
67. METAL LETTERS (SEE SPECS)
68. PONY WALL BEHIND
69. ROOM CAPACITY SIGN
70. TECTUM PANELS
71. 2x3 SHAPED WOOD NAILER
72. UTILITY BOX
73. MOVABLE ROD TO BE PLACED AT 44" FOR ADA COMPLIANCE, OPTIONAL
74. MOTORIZED SCREEN, SEE 143/A8.8
75. PLASTIC LAMINATE PANELING AND DOORS
76. WINDOW WALL, SEE T2 FOR DEFERRED ITEMS
77. CLEAR GLASS POSTER CASE w/ LOCK (SEE SPEC. SECT. 10410)
78. 1/2" REVEAL SCREEDS
79. WALL CLOCK, SEE SPEC SECTION 10050
80. MICROWAVE OVEN
81. PLASTIC LAMINATE COUNTERTOP
82. SOLID SURFACE COUNTERTOP
83. PERFORATED DECORATIVE METAL PANEL
84. WALL PROTECTION PANEL
85. ICE MACHINE
86. CARPET BASE
87. TACK STRIPS, 12" LONG BY WALL WALKERS OR EQUAL
88. CORNER GUARD
89. STRUCTURAL MEMBER TO BE PAINTED, SEE STRUCTURAL
90. COVERED BASE
91. CASEWORK
92. TAC-WALL




7790 NORTH PALM AVENUE
FRESNO, CALIFORNIA 93711
T 559.448.8400 F 559.448.8467
www.simprbk.com

PROJECT:
SHIELDS & BRAWLEY ELEMENTARY SCHOOL

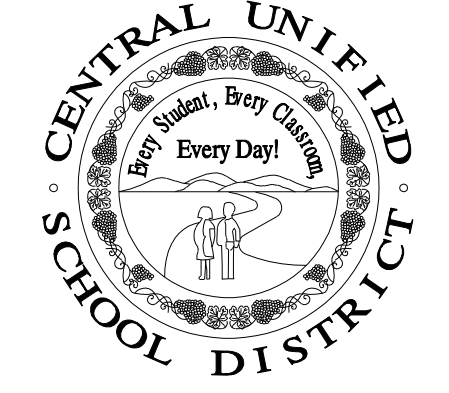

**AD 2-21a
S&B Elementary
02-116800**

JOHN H. SMITH, A.I.A. C15885

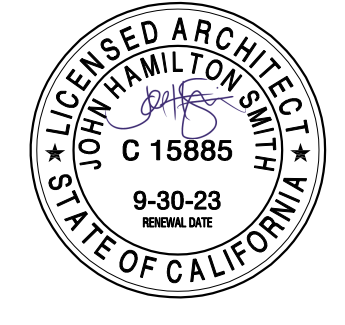

THE FIRM OF SMITH, KWANAGA, MALHOTRA, ARCHITECTS, INC. EXPRESSLY RESERVES ITS COPYRIGHT, LAW COPYRIGHT AND OTHER APPLICABLE PROPERTY RIGHTS IN THESE PLANS. THESE PLANS ARE NOT TO BE REPRODUCED, CHANGED, OR COPIED IN ANY FORM OR MANNER WHATSOEVER, NOR ARE THEY TO BE ASSIGNED TO A THIRD PARTY WITHOUT FIRST OBTAINING THE WRITTEN PERMISSION AND CONSENT OF THE ARCHITECT. IN THE EVENT OF UNAUTHORIZED REUSE OF THESE PLANS BY A THIRD PARTY, THE THIRD PARTY SHALL HOLD THE ARCHITECT HARMLESS, AND SHALL BEAR THE COST OF THE ARCHITECT'S LEGAL FEES, ASSOCIATED WITH DEFENDING AND ENFORCING THESE RIGHTS.






| PROJECT DEVELOPMENT | |
|---------------------|------------|
| DATE | ISSUED FOR |
| | |
| | |

| REVISIONS | | |
|-----------|---------|------------------------|
| No. | DATE | DESCRIPTION |
| 1 | 2.14.23 | DISTRICT MODIFICATIONS |
| 2 | 2.27.23 | DISTRICT MODIFICATIONS |


SHEET DESCRIPTION

INTERIOR ELEVATIONS
MAIN - 1ST FLOOR


| | |
|-----------------------------------|--------------------------|
| PROJECT COORDINATOR JOHN SMITH | SHEET No. A5.1 |
| PROJECT No. 17-67 | DATE 1.27.23 |
| DATE 1.27.23 | SCALE 1/4"=1'-0" |

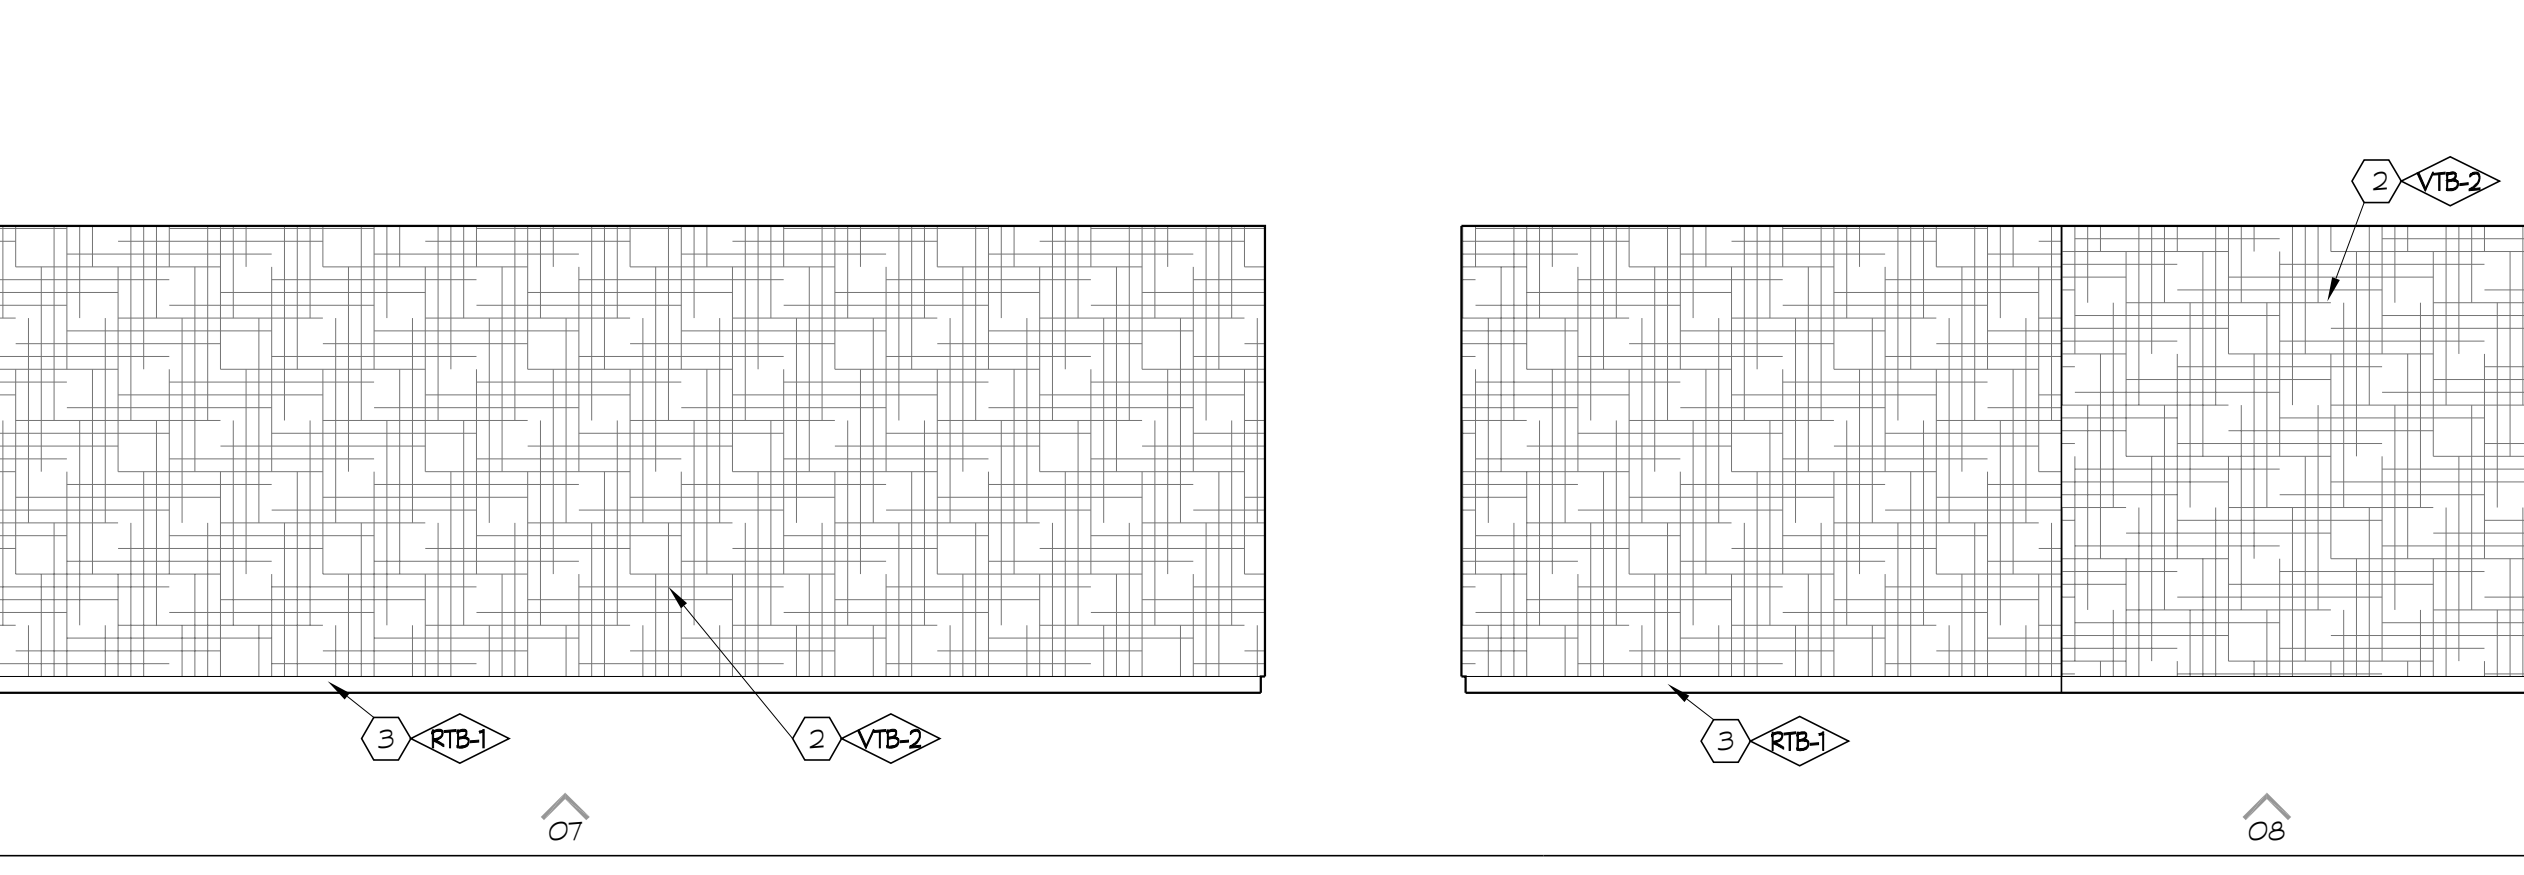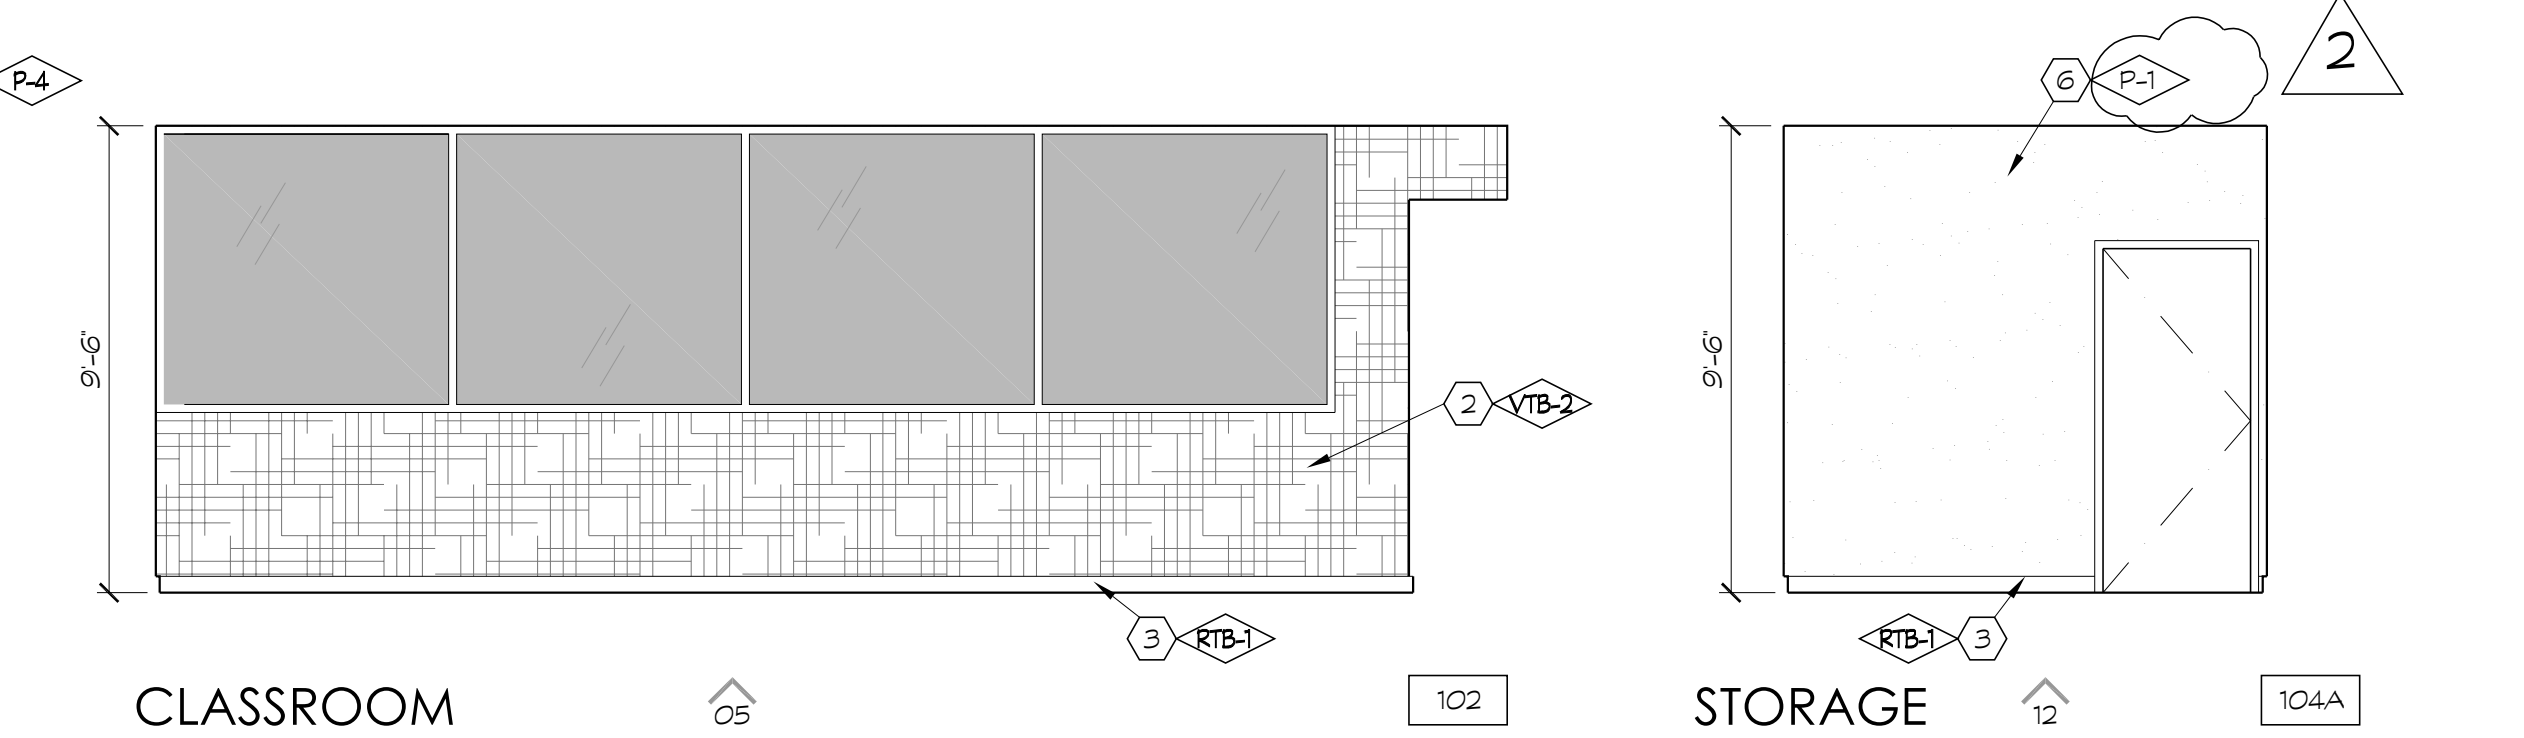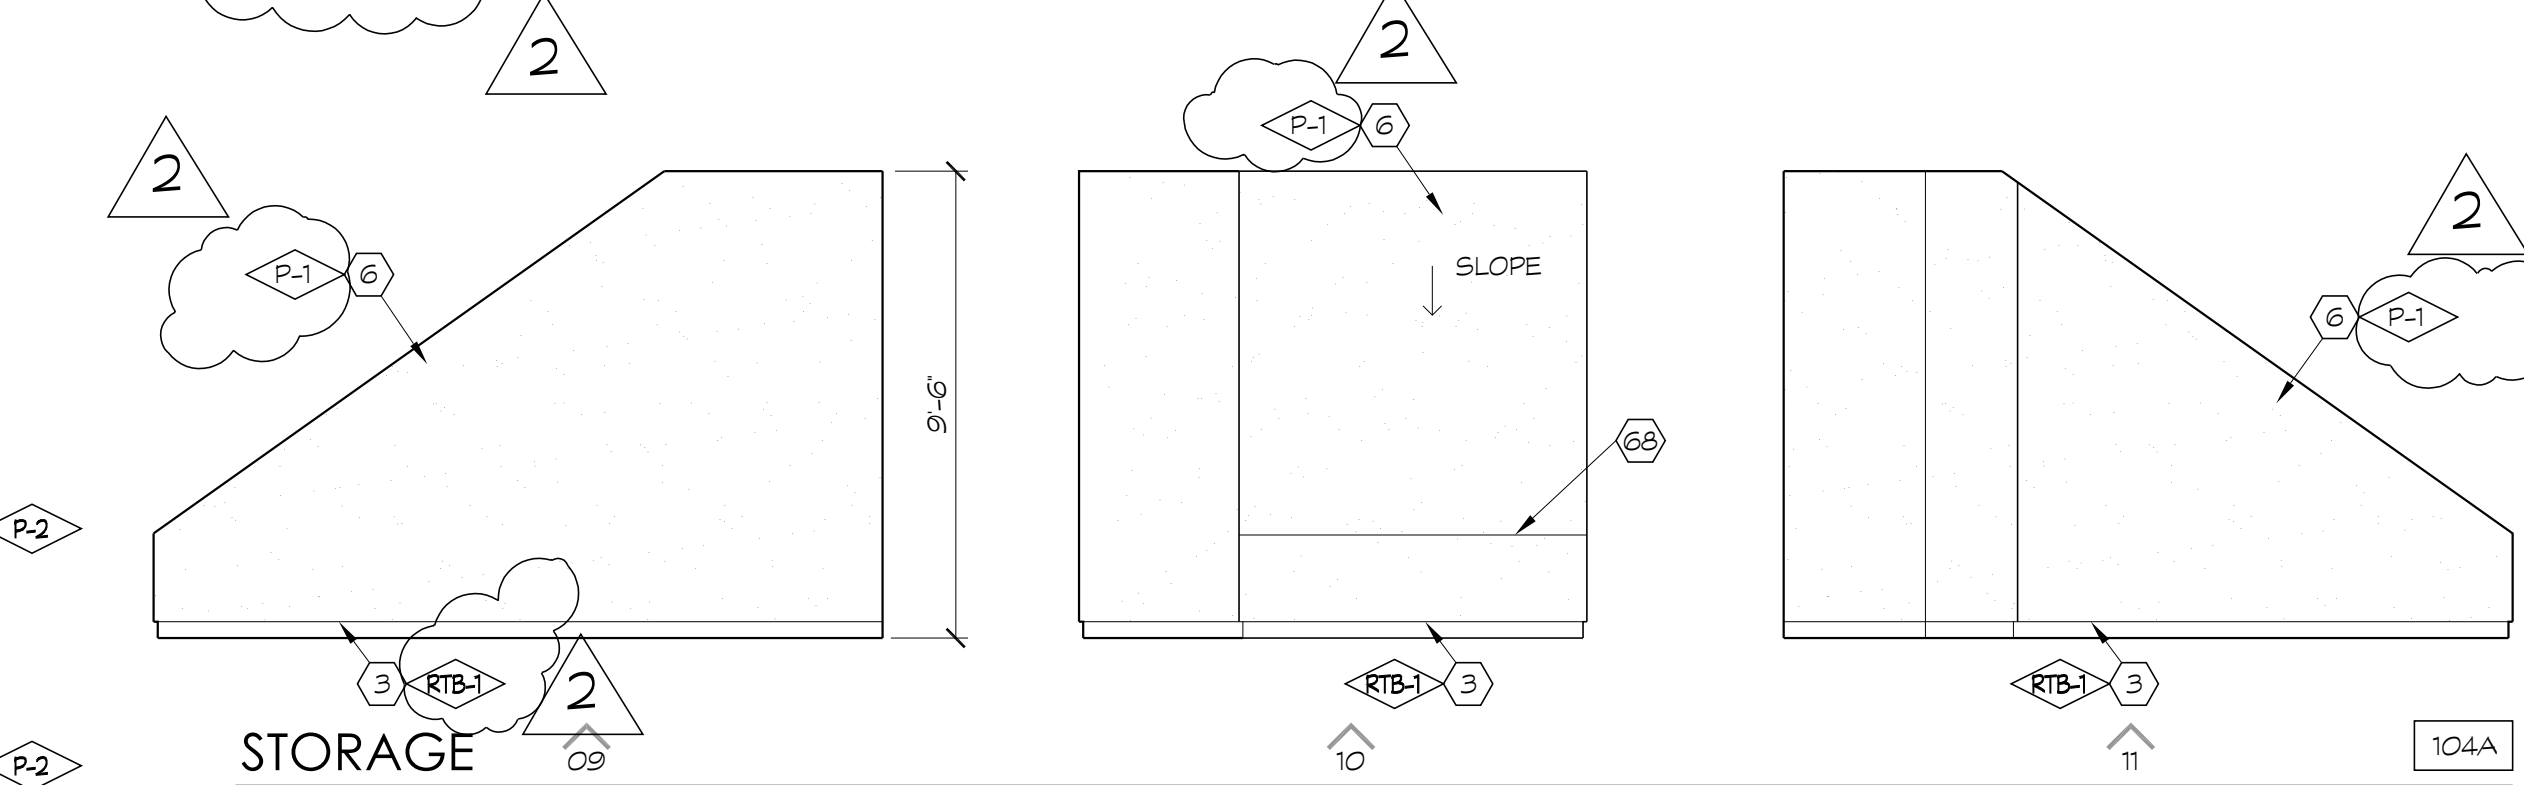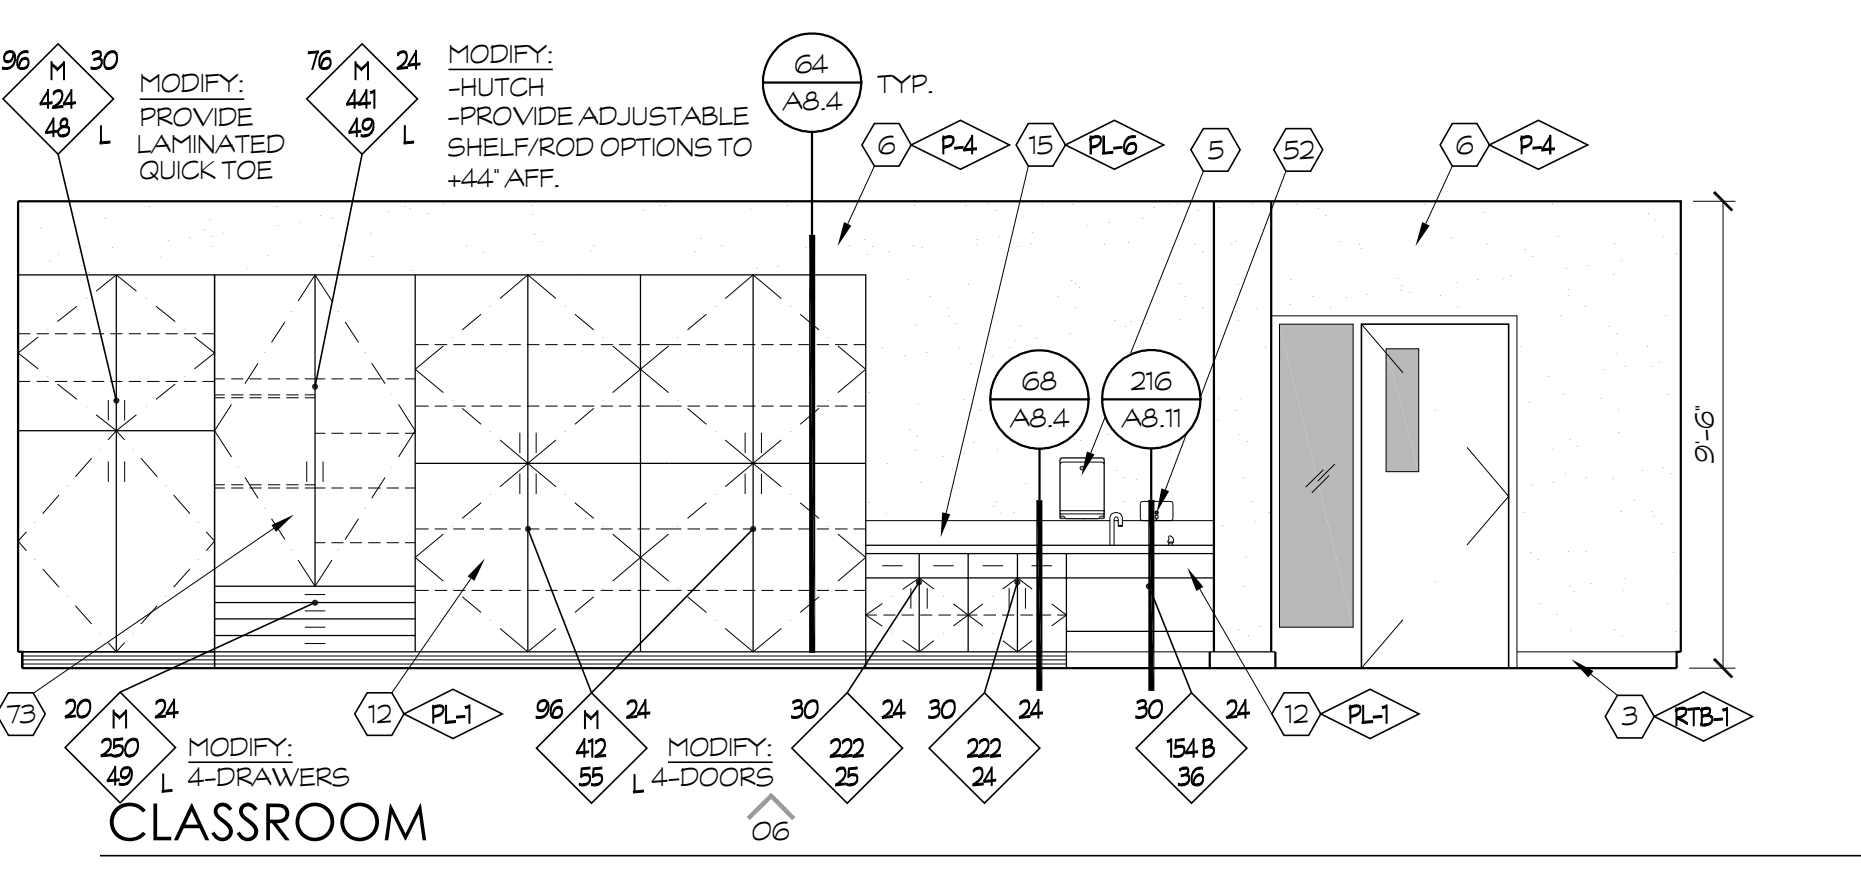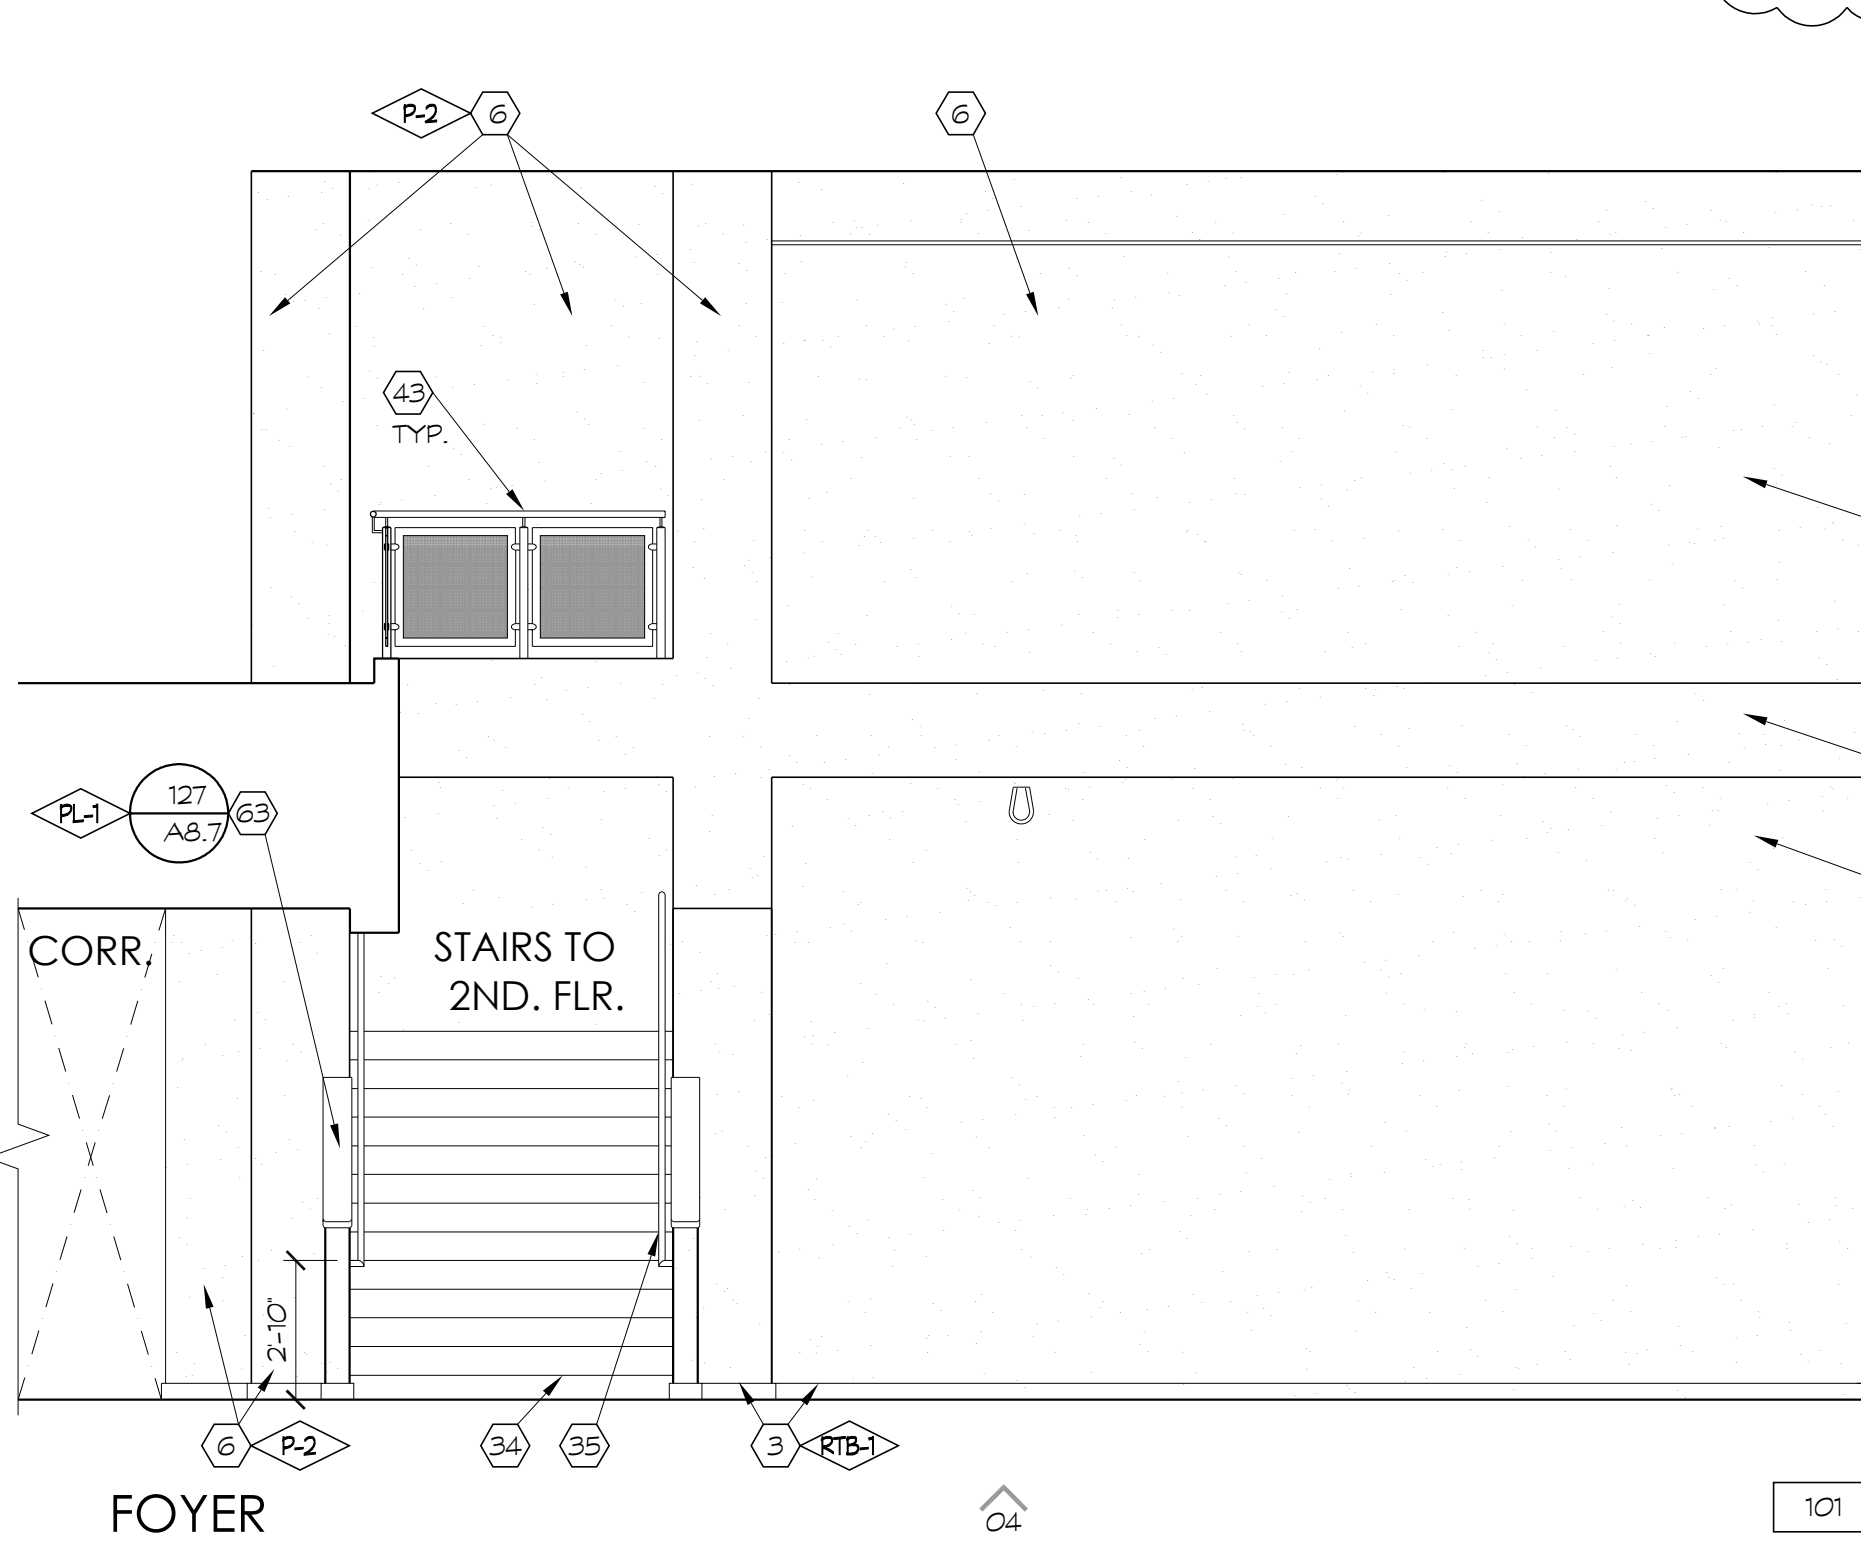




SYMBOL LEGEND

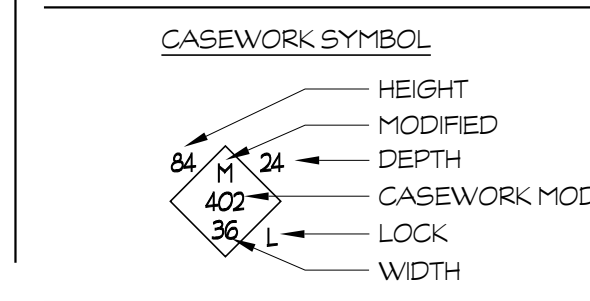


A:\17-67_Shields & Brawley_Elementary\Work\17-67_A5.1_1st_interiors.dwg 05/20/18 2:10

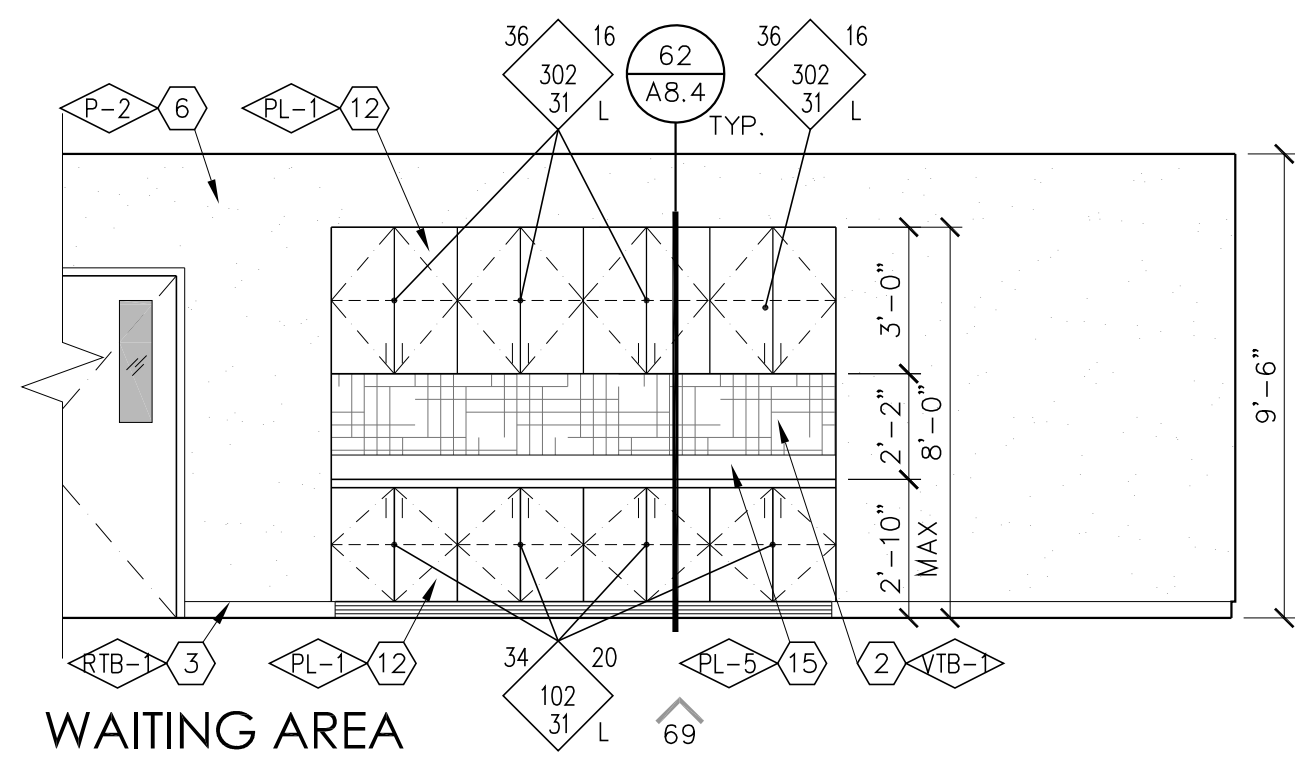


WAITING AREA

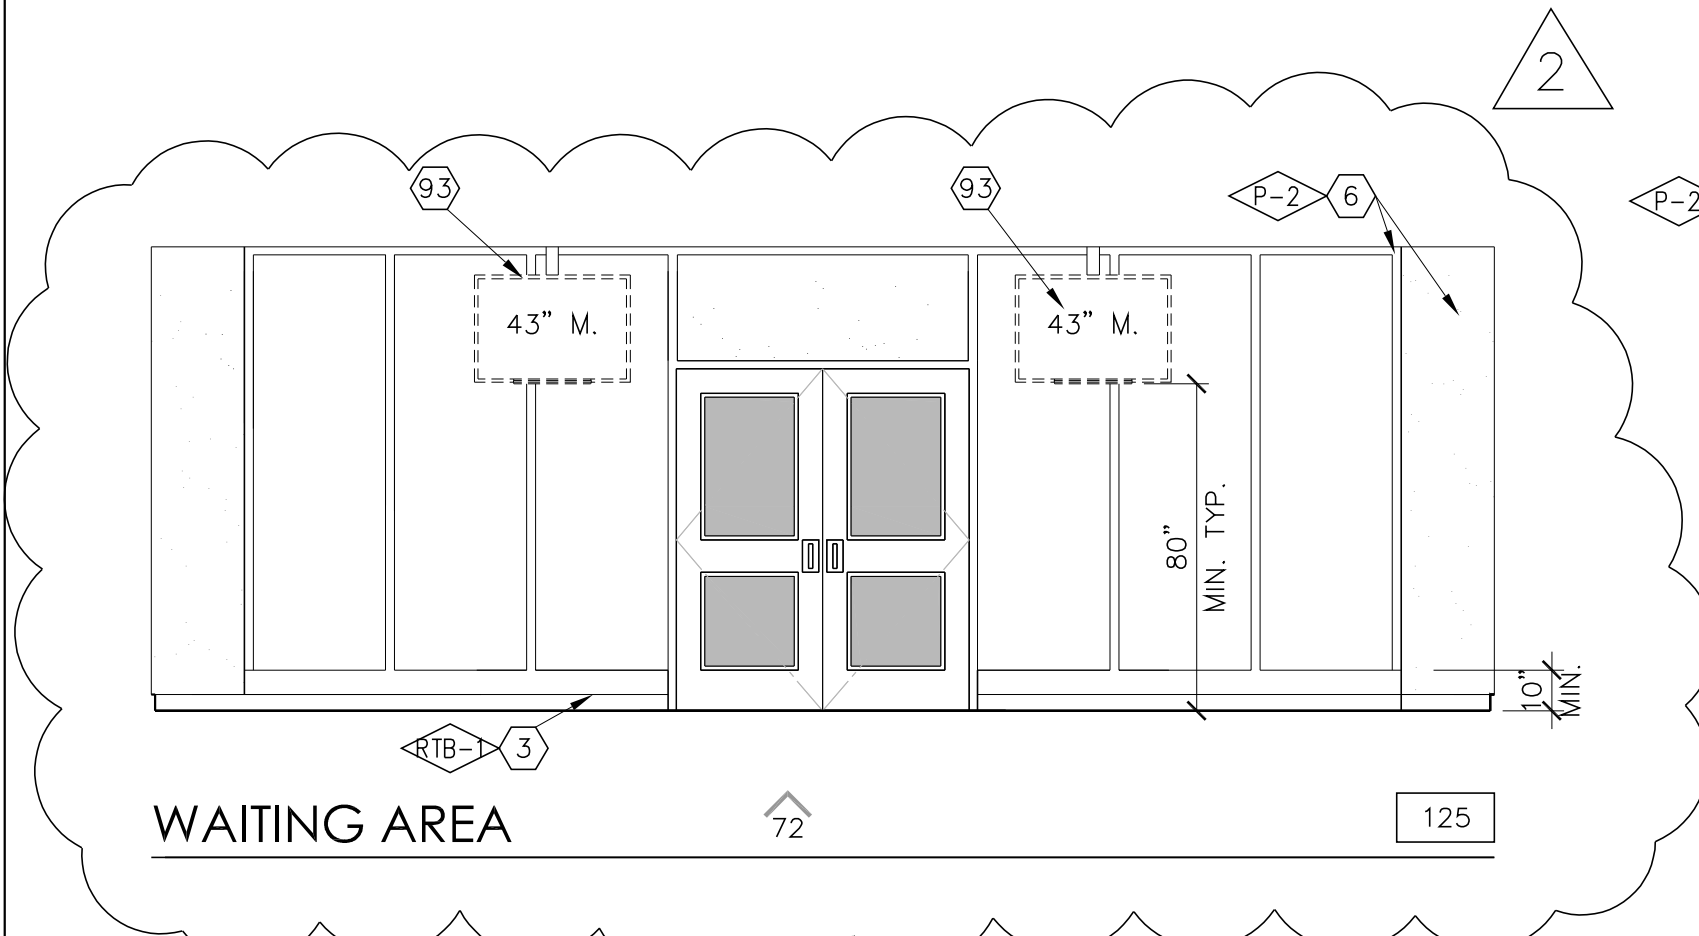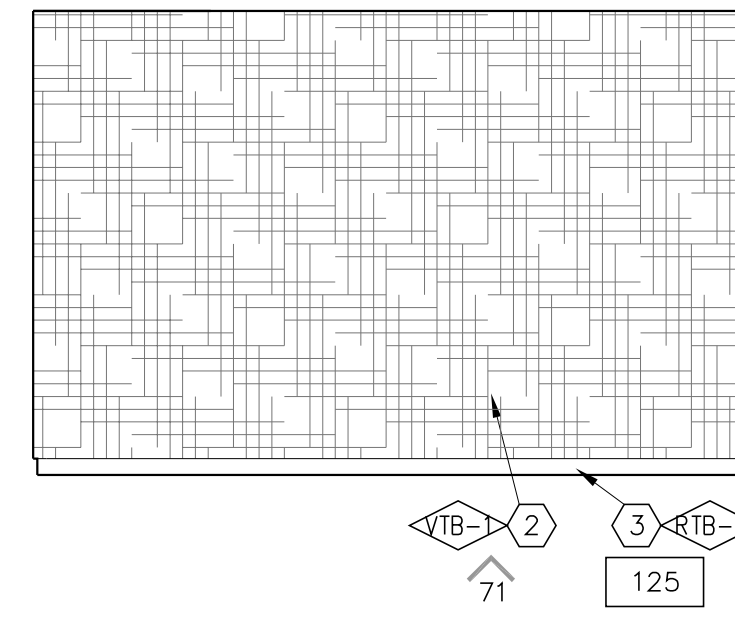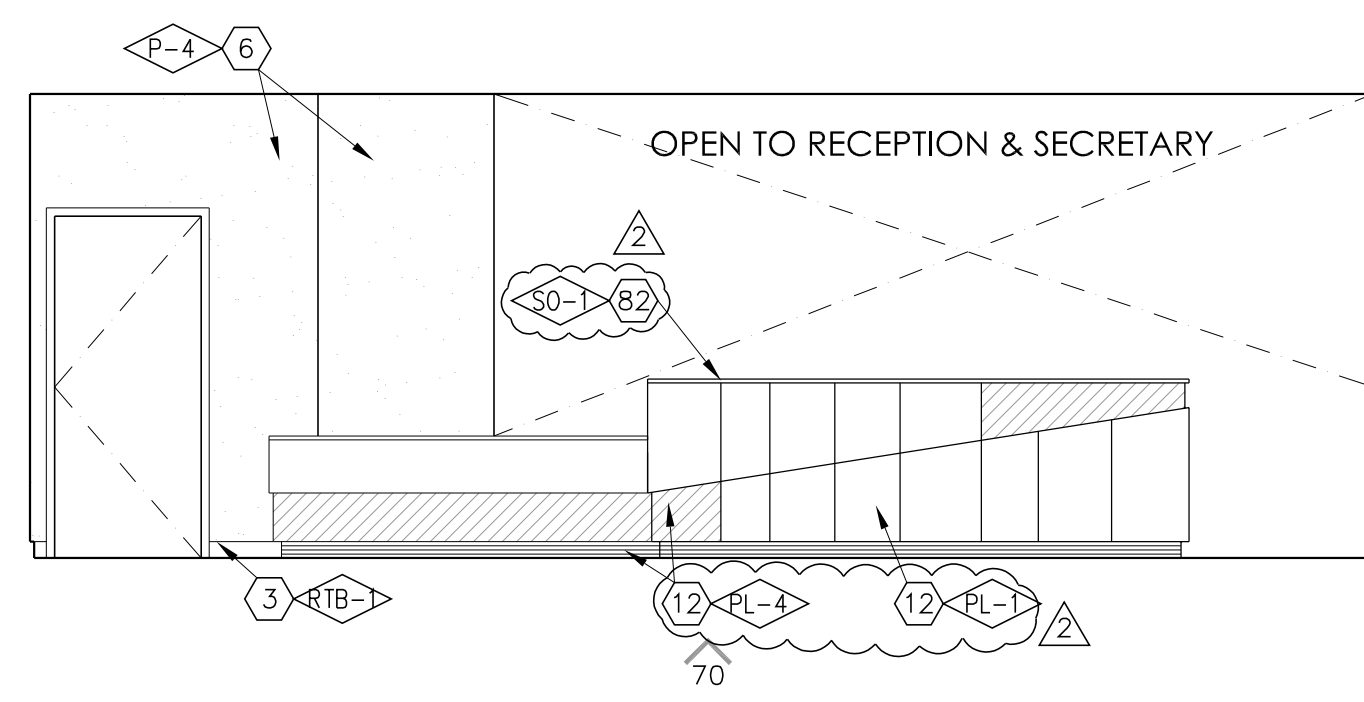


WAITING AREA

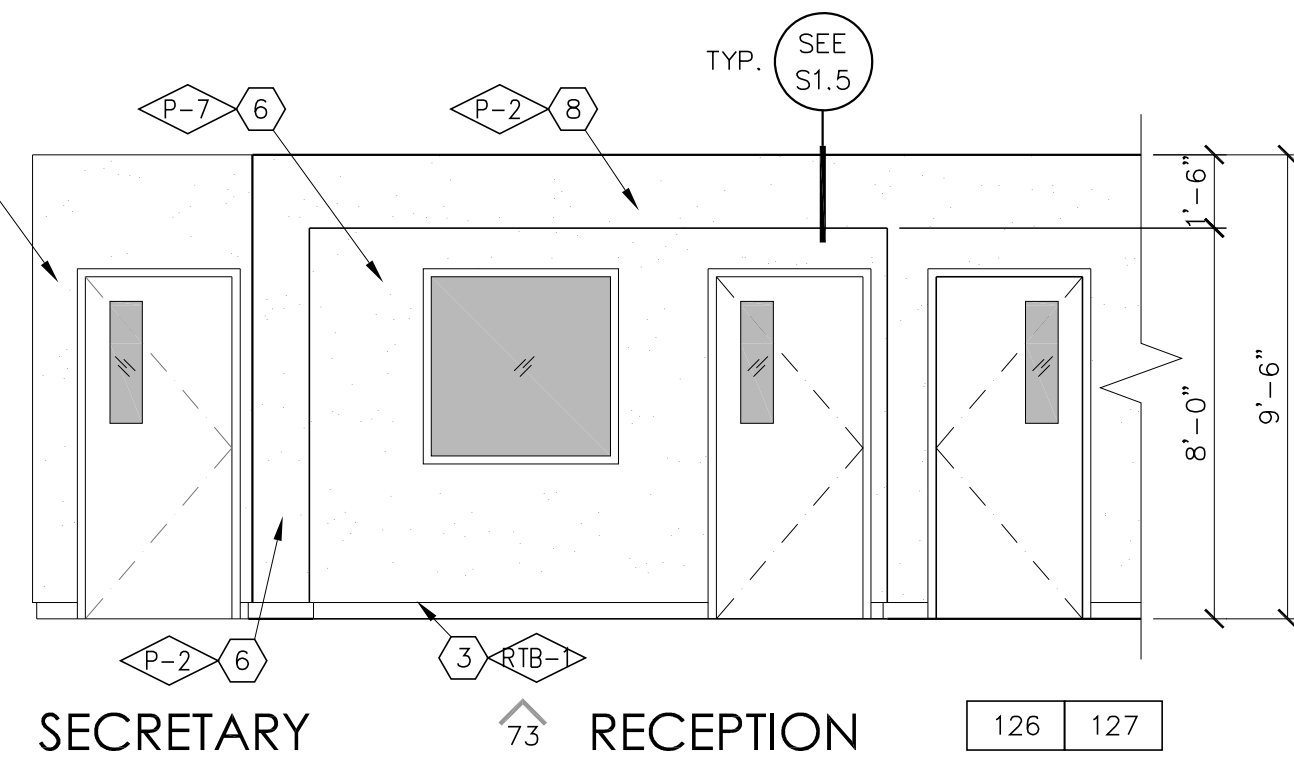


SECRETARY

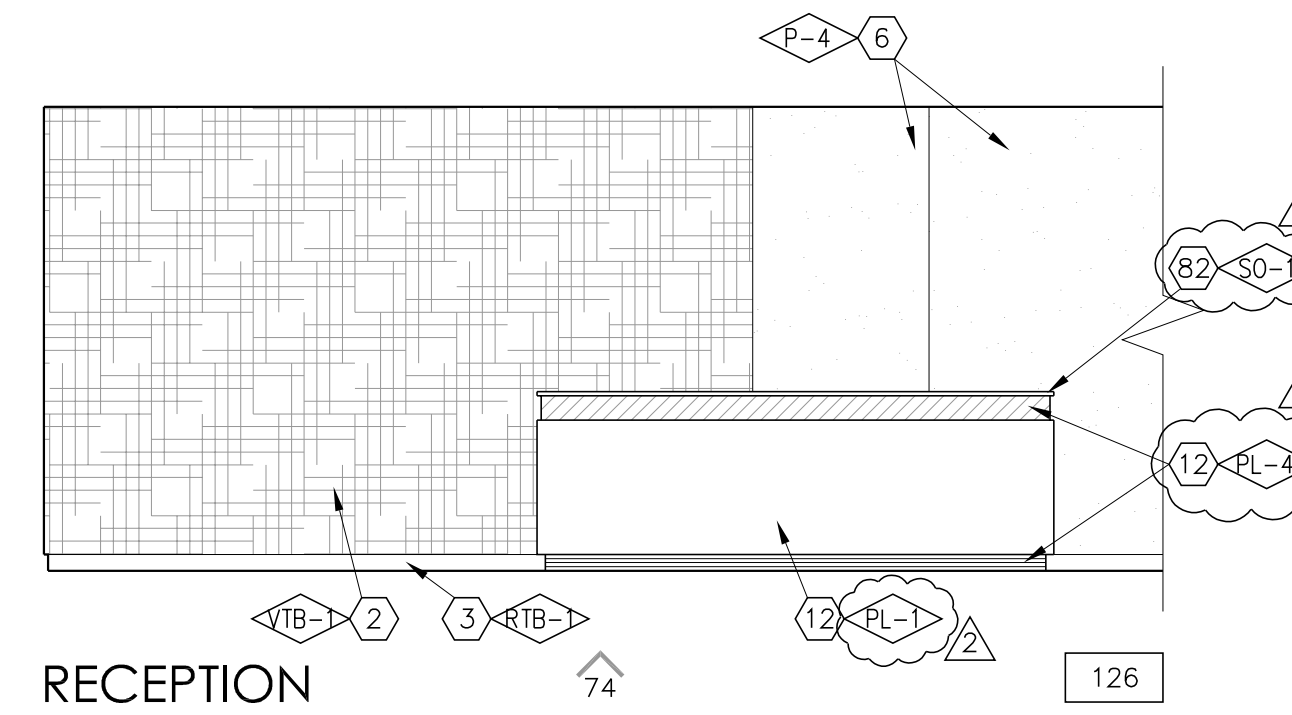


RECEPTION

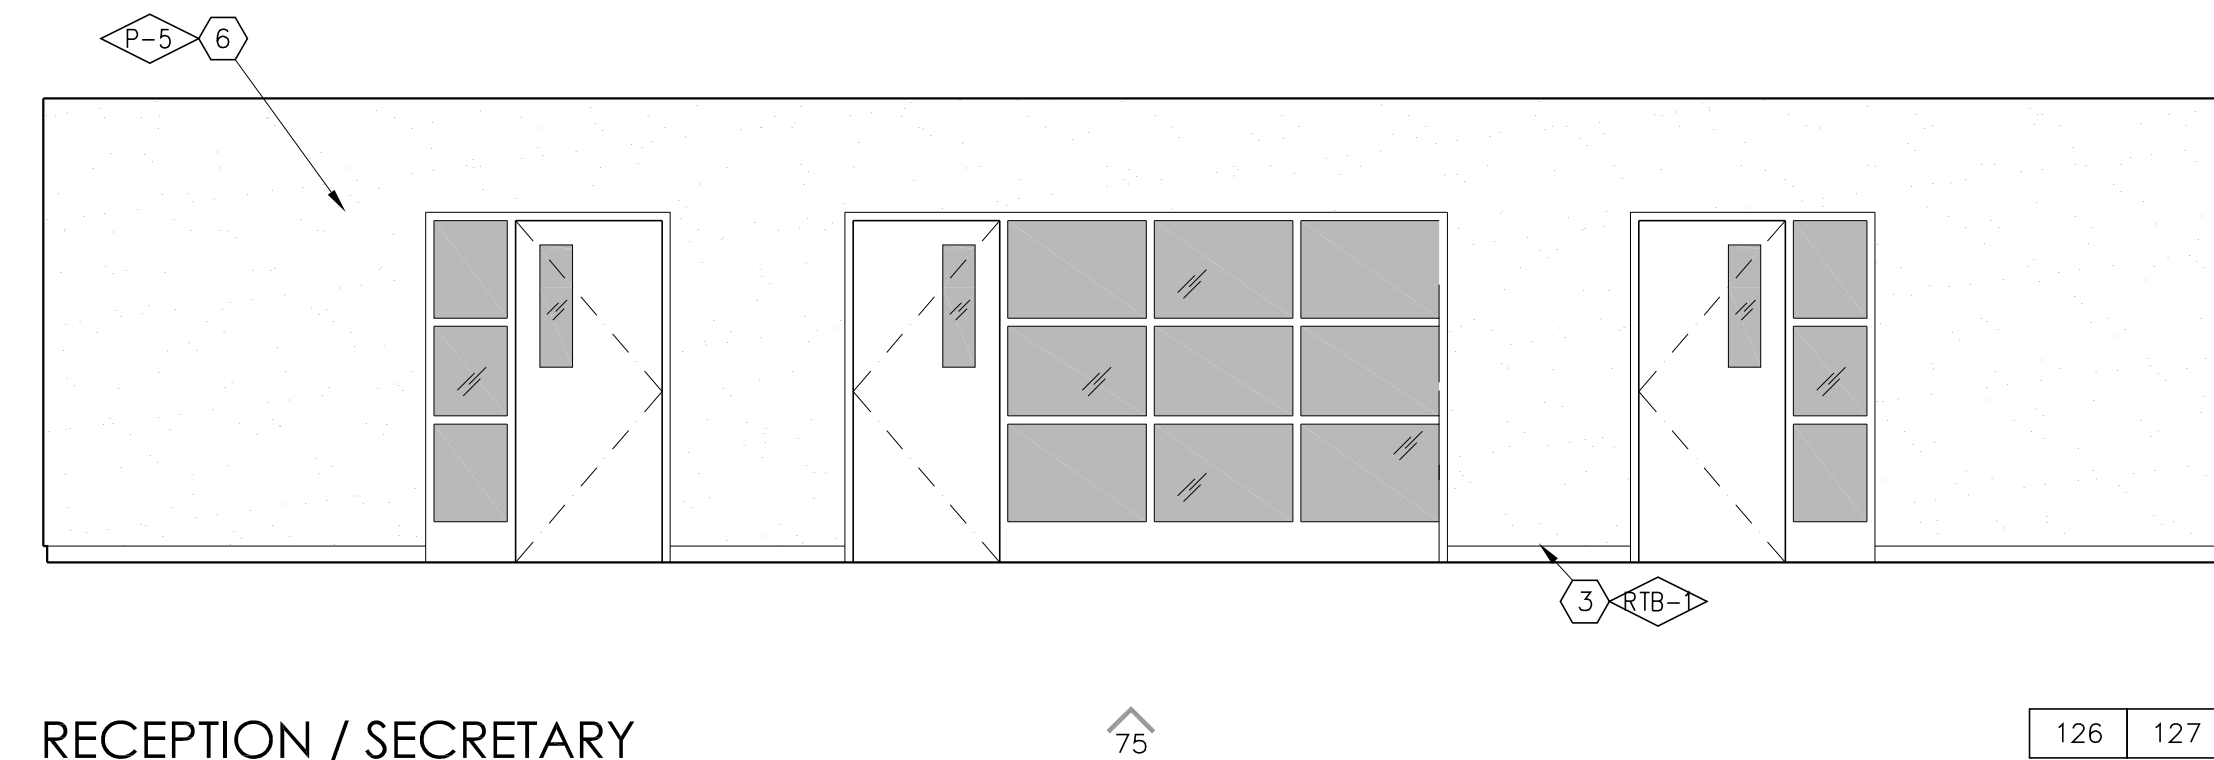


RECEPTION / SECRETARY

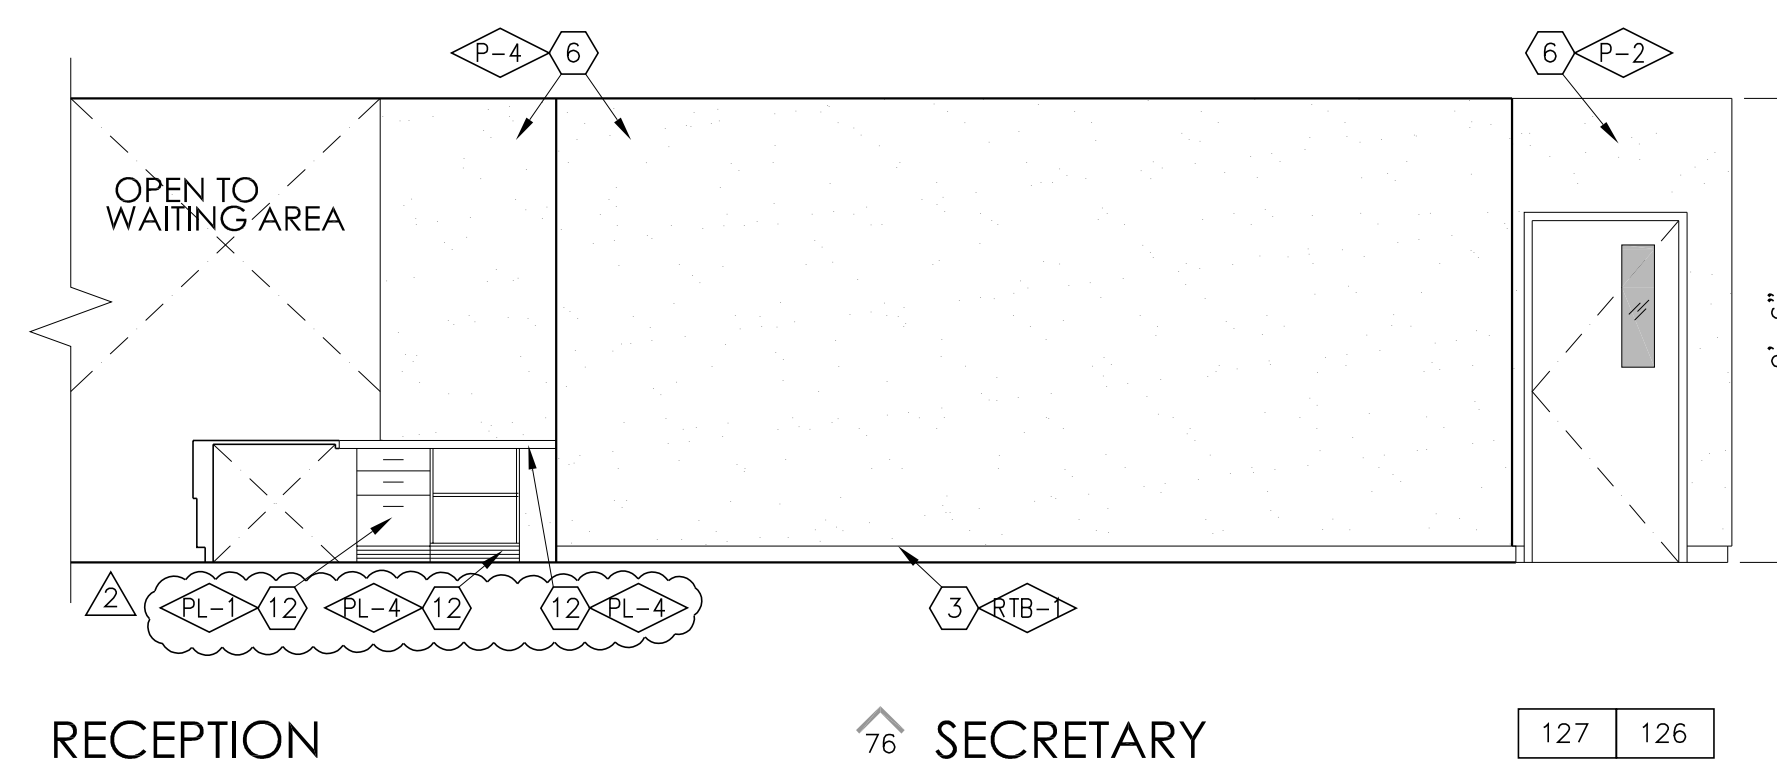


RECEPTION

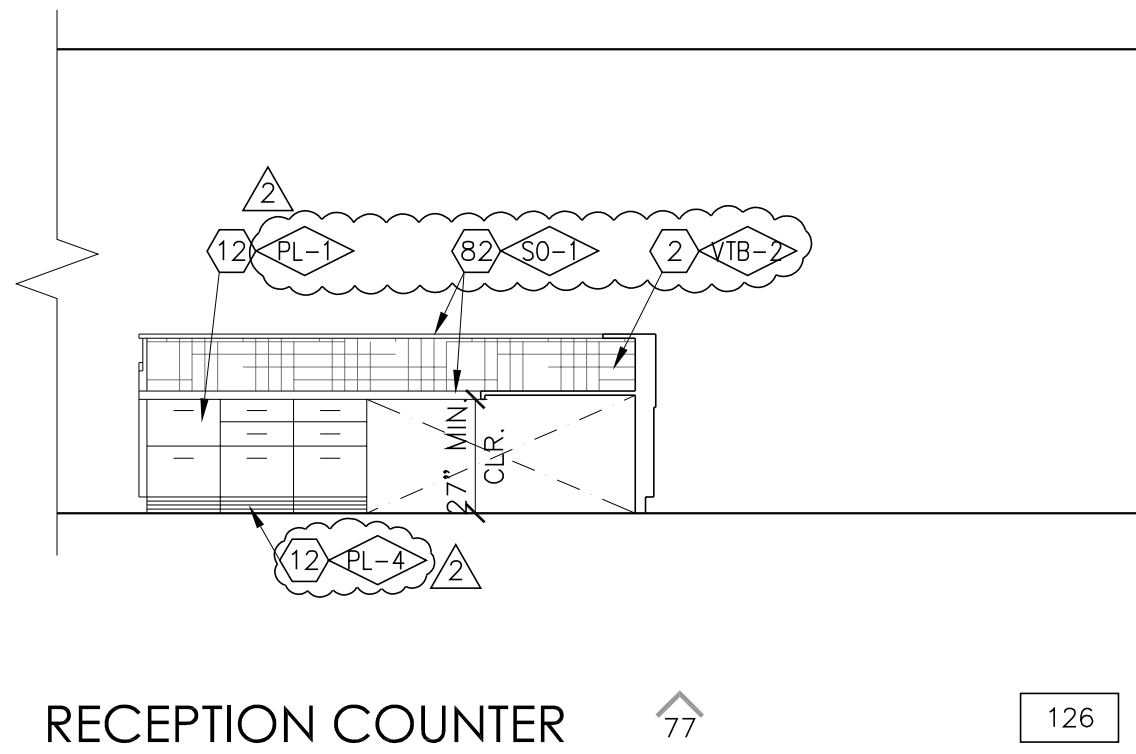


RECEPTION COUNTER

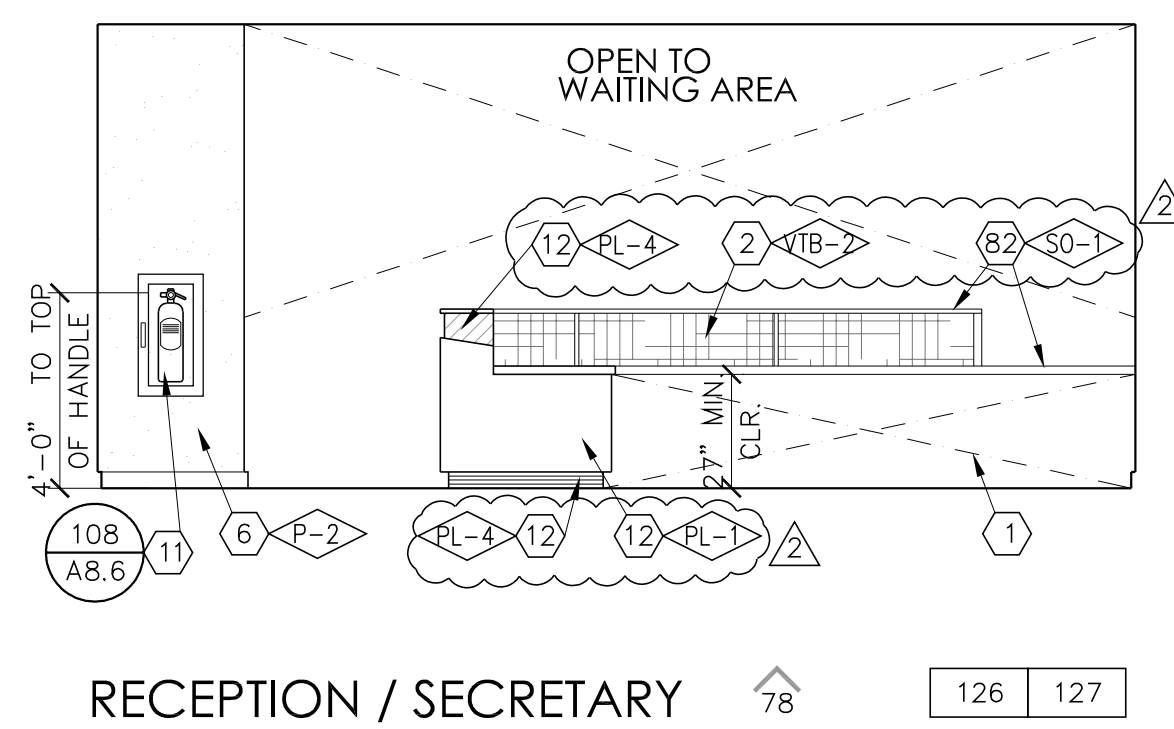


RECEPTION / SECRETARY

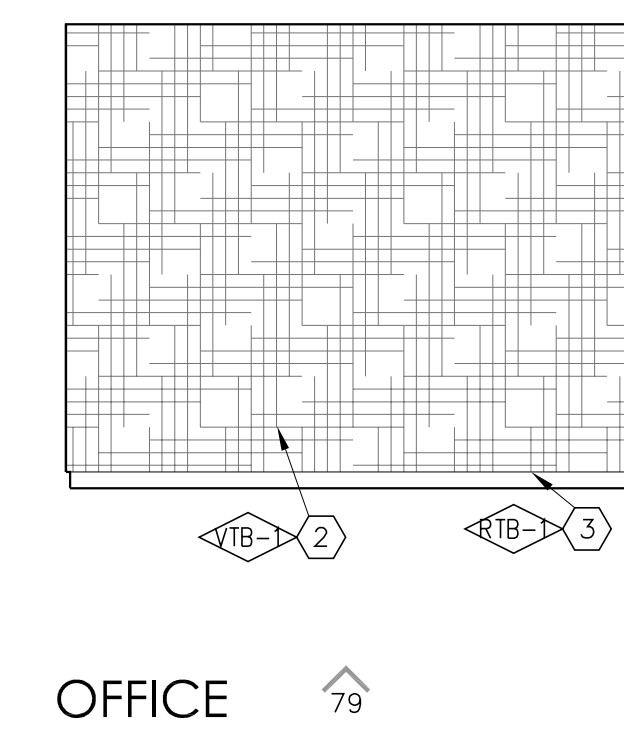


OFFICE

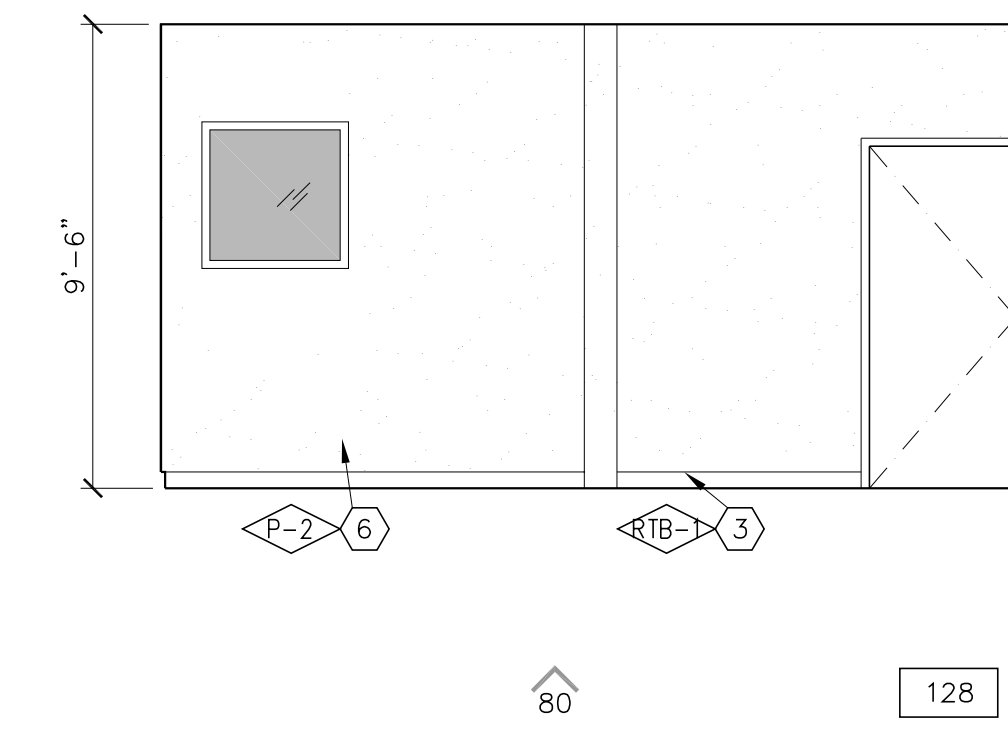


OFFICE

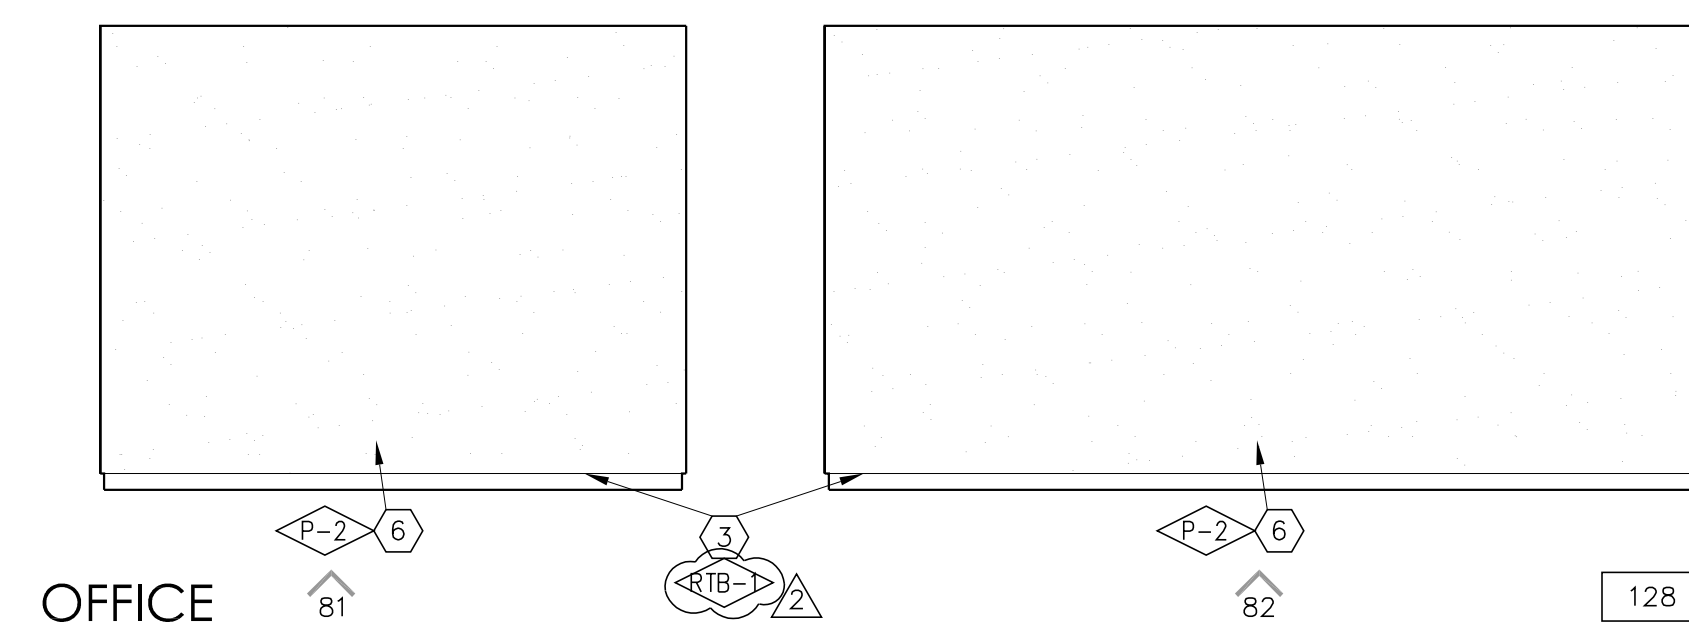

OFFICE

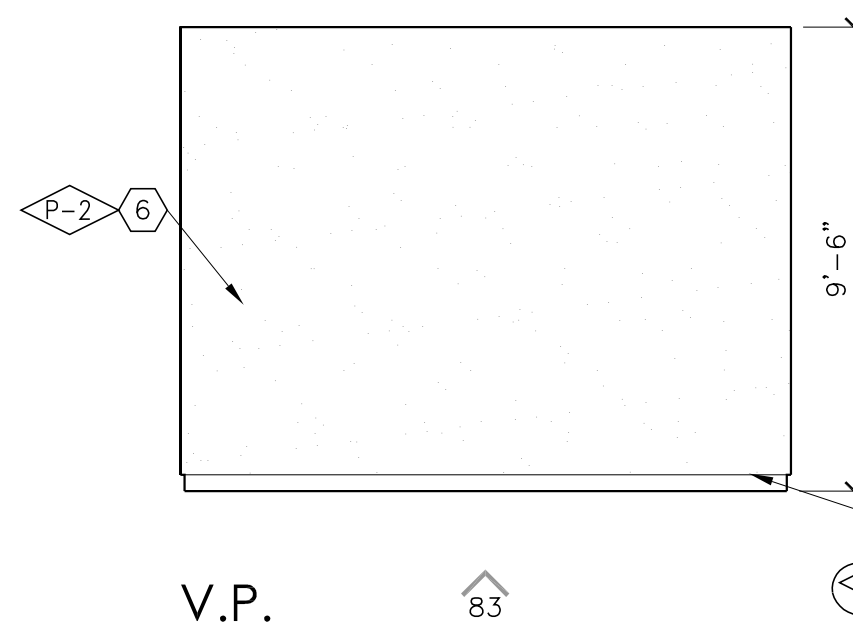

V.P.

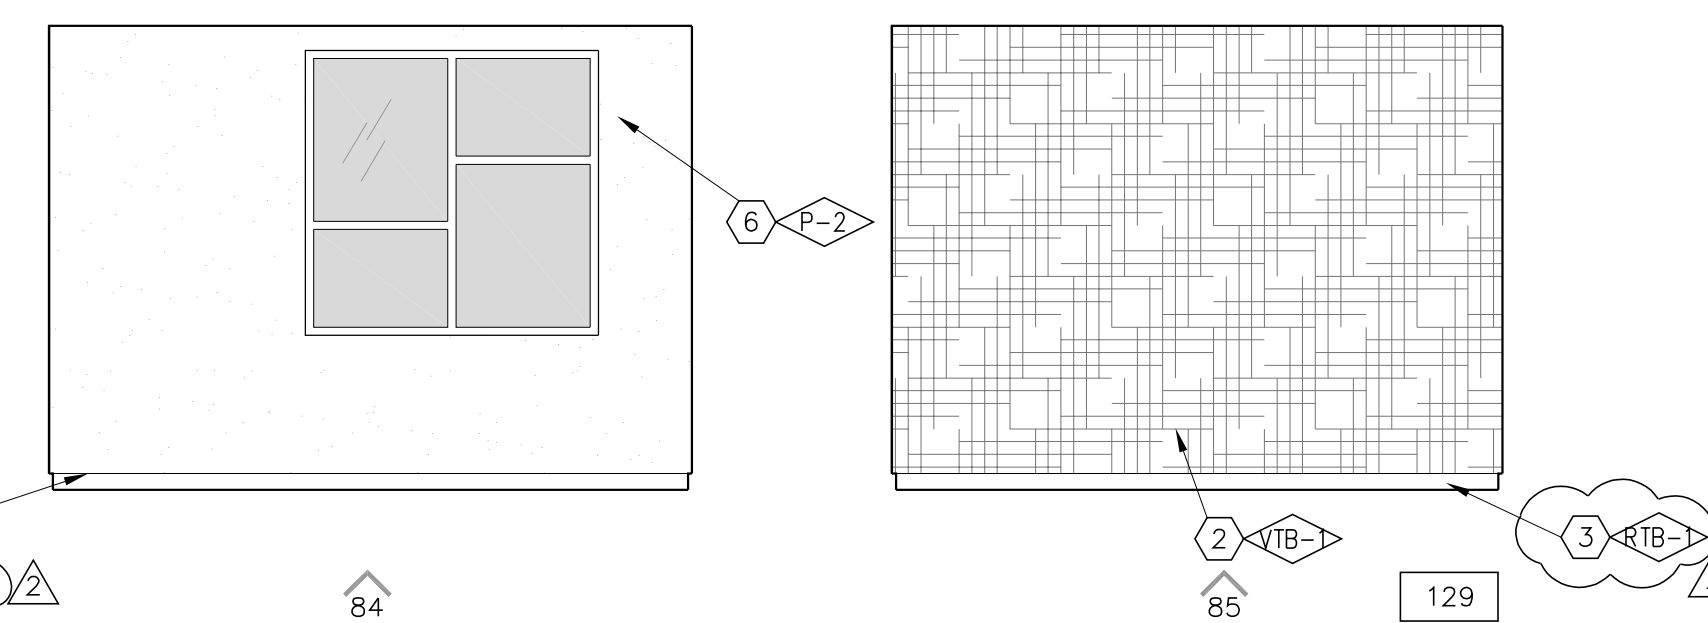


OFFICE

KEYNOTES

- KNEE SPACE
- VINYL TACKBOARD o/ GYP. BD.
- RUBBER TOPSET BASE
- STOREFRONT
- PAPER TOWEL DISPENSER
- GYP. BOARD, TAPE, TEXTURE & PAINT (PROVIDE 5/8" TYPE 'X' GYP. AT STAIRWAYS AND UNDERSTAIR WALL/CEILING FINISHES, TYP.)
- ROOF ACCESS LADDER
- SOFFIT
- FLOOR SINK - SEE PLUMBING
- UNDER-COUNTER REFRIGERATOR
- FIRE EXTINGUISHER w/ SEMI RECESSED CAB. TYPE 2A:10BC
- PLASTIC LAMINATE CASEWORK
- W.I.C. 400 STORAGE SHELVING
- FIBER REINFORCED PANEL
- PLASTIC LAMINATE BACKSPLASH & COUNTERTOP
- METAL POST, PER STRUCTURAL
- SINK - SEE PLUMBING SCHEDULE
- MAGNETIC MARKER BOARD o/VTB
- APPLIANCES - SEE SPEC SECTION 11400
- BUTCHER PAPER HOLDER
- DISHWASHER
- HOOD
- REFRIGERATOR - FULL HEIGHT
- COOKTOP
- ROLL-UP DOOR
- STAINLESS STEEL COUNTERTOP
- FURNITURE (N.I.C.)
- DRINKING FOUNTAIN
- CLOCK/SPEAKER
- CLEAR GLASS DISPLAY CASE w/ LOCK (SEE SPEC. SECT. 10410)
- FEMININE NAPKIN DISPOSAL
- MIRROR
- TRACK AND CUBICLE CURTAIN.
- STAIRCASE
- HANDRAIL
- N/A
- TRANSLUCENT WALL SYSTEM
- WOOD BASE
- WHEEL CHAIR LIFT
- BELOW STAGE STORAGE
- N/A
- ELEVATOR LANTERN
- RAILING, SPACING SHALL BE SUCH THAT A 4" DIA. SPHERE CANNOT PASS THROUGH ANY OPENING, PER CBC 1013
- CALL BUTTON
- ELEVATOR DOORS
- LAVATORY
- TOILET PAPER DISPENSER
- TOILET SEAT COVER DISPENSER
- DATA RACEWAY. SEE ELECTRICAL DRAWINGS.
- CLOCK
- 4" HIGH CORNER GUARD, TYP.
- SOAP DISPENSER
- PLASTIC TOILET PARTITION
- SIGNAGE
- MANUFACTURED 3"Wx6"H MTL. SHELVING, SEE S-1/K8.0
- SPEAKER ENCLOSURE AND GRILLE
- MOP/BROOM HOLDER
- PLASTIC LAM. DOOR, 1 1/2" THICK
- PROVIDE 3/4" LAM. PLASTIC SUPPORTS AT STOREFRONT, AT 4'-0" O.C.
- RAYTHERMS (N.I.C.)
- URINAL
- MICROWAVE (N.I.C.)
- PLASTIC LAMINATE CAP
- CERAMIC TILE
- GRAB BAR
- WATER CLOSET
- METAL LETTERS (SEE SPECS)
- PONY WALL BEHIND
- ROOM CAPACITY SIGN
- TECTUM PANELS
- 2x3 SHAPED WOOD NAILER
- UTILITY BOX
- MOVABLE ROD TO BE PLACED AT 44" FOR ADA COMPLIANCE. OPTIONAL.
- MOTORIZED SCREEN, SEE 143/A8.8
- PLASTIC LAMINATE PANELING AND DOORS
- WINDOW WALL, SEE T2 FOR DEFERRED ITEMS
- CLEAR GLASS POSTER CASE w/LOCK (SEE SPEC. SECT. 10410)
- 1/2" REVEAL SCREEDS
- WALL CLOCK, SEE SPEC SECTION 10050
- MICROWAVE OVEN
- PLASTIC LAMINATE COUNTERTOP
- SOLID SURFACE COUNTERTOP
- PERFORATED DECORATIVE METAL PANEL
- WALL PROTECTION PANEL
- ICE MACHINE
- CARPET BASE
- N/A
- CORNER GUARD
- STRUCTURAL MEMBER TO BE PAINTED, SEE STRUCTURAL
- EPOXY, EPF-1
- CASEWORK
- TAC-WALL PANELS
- (2) 43" MONITORS FOR ADMIN WAITING AREA WITH MONITOR CONTROL DEVICE & HDMI DEVICES

- NOTES:
- SEE DTL. 219/A8.11 FOR ACCESSIBILITY STANDARDS
 - ALL SHELVING WITH SPANS GREATER THAN 30" TO BE 1" THICK REFERENCES, TYP.
 - REFER TO COLOR SCHEDULE (SHEET A2.8) FOR ALL COLOR REFERENCES, TYP.
 - ALL CARPET USES A CARPET BASE #86
 - ALL MONDO RUBBER FLOORS USE A RUBBER TOPSET BASE #3
 - ALL AHRO FLOORS USE SELF-COVER BASE #41
 - ALL STAINED & DYED CONCRETE FLOORS USE TOPSET #3

SYMBOL LEGEND

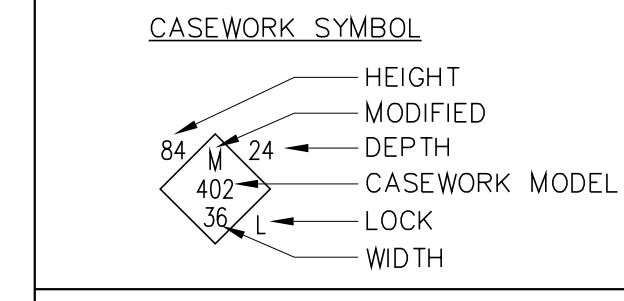

7750 NORTH PALM AVENUE
FRESNO, CALIFORNIA 93711
T 559.448.8400 F 559.448.8467
www.sim-pbk.com

PROJECT:
SHIELDS & BRAWLEY ELEMENTARY SCHOOL



AD 2-22a
S&B Elementary
02-116800








THE FIRM OF SMITH, IWANAGA, MILHOUS, ARCHITECTS, INC. EXPRESSLY RESERVES ITS COMMON LAW COPYRIGHT AND OTHER APPLICABLE PRIORITY RIGHTS IN THESE PLANS. THESE PLANS ARE NOT TO BE REPRODUCED, CHANGED, OR COPIED IN ANY MANNER WITHOUT THE WRITTEN PERMISSION AND CONSENT OF THE ARCHITECT. IN THE EVENT OF UNAUTHORIZED REUSE OF THESE PLANS BY A THIRD PARTY, THE THIRD PARTY SHALL HOLD THE ARCHITECT HARMLESS, AND SHALL BEAR THE COST OF THE ARCHITECT'S LEGAL FEES ASSOCIATED WITH DEFENDING AND ENFORCING THESE RIGHTS.

| PROJECT DEVELOPMENT | |
|---------------------|------------|
| DATE | ISSUED FOR |
| | |
| | |

| REVISIONS | | |
|-----------|---------|------------------------|
| No. | DATE | DESCRIPTION |
| 1 | 2.14.23 | DISTRICT MODIFICATIONS |
| 2 | 2.27.23 | DISTRICT MODIFICATIONS |


| SHEET DESCRIPTION | |
|-----------------------------------|-------------|
| INTERIOR ELEVATIONS | |
| MAIN - 1ST FLOOR | |
| PROJECT COORDINATOR JOHN SMITH | SHEET No. |
| PROJECT NO. 17-67 | A5.5 |
| DATE 1.27.23 | |
| SCALE 1/4" = 1'-0" | |

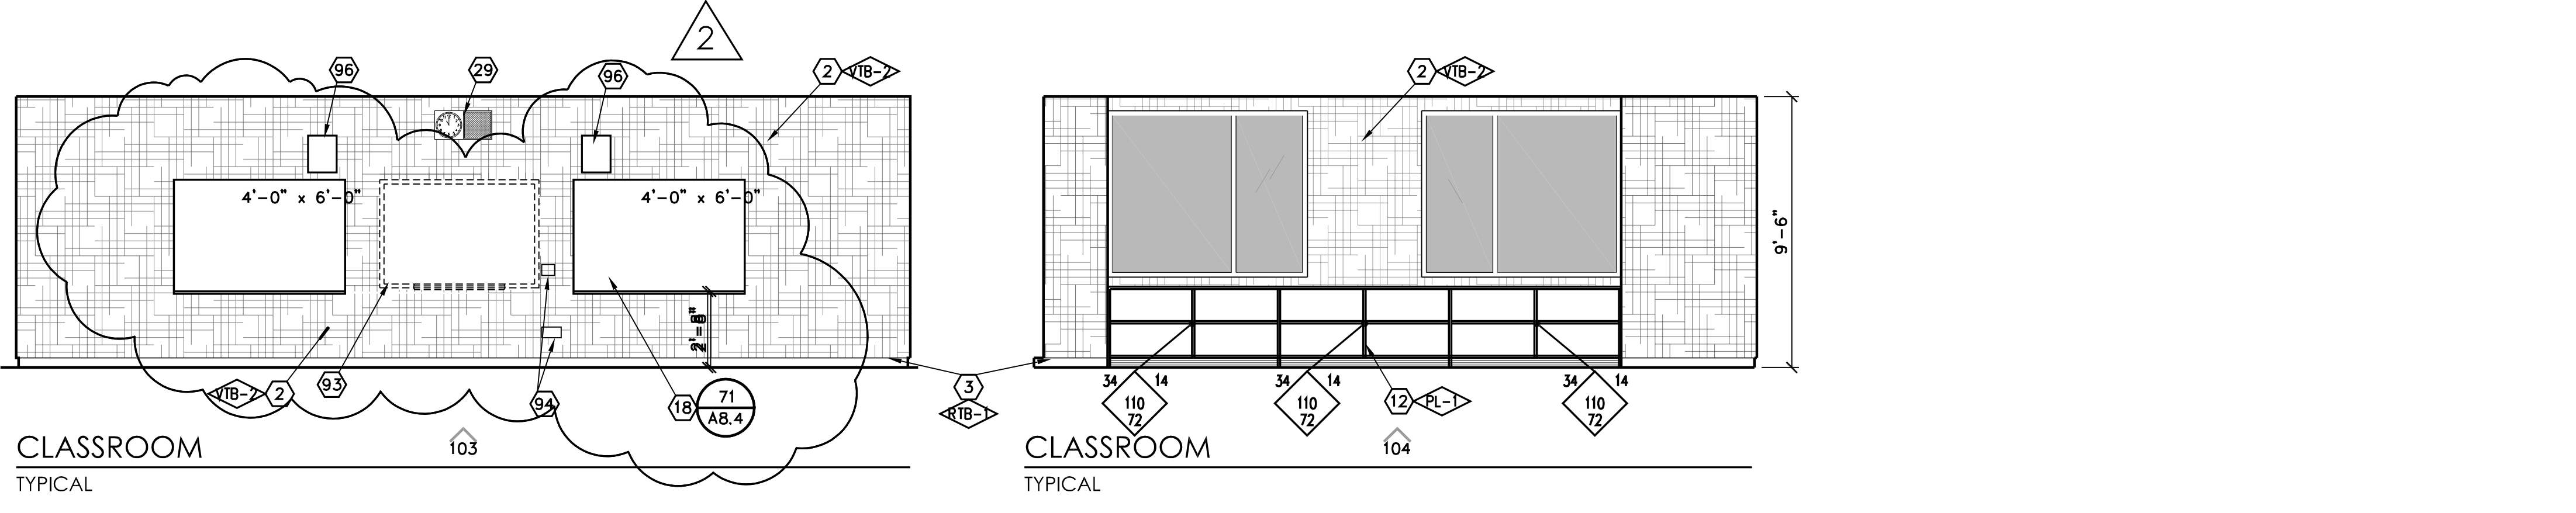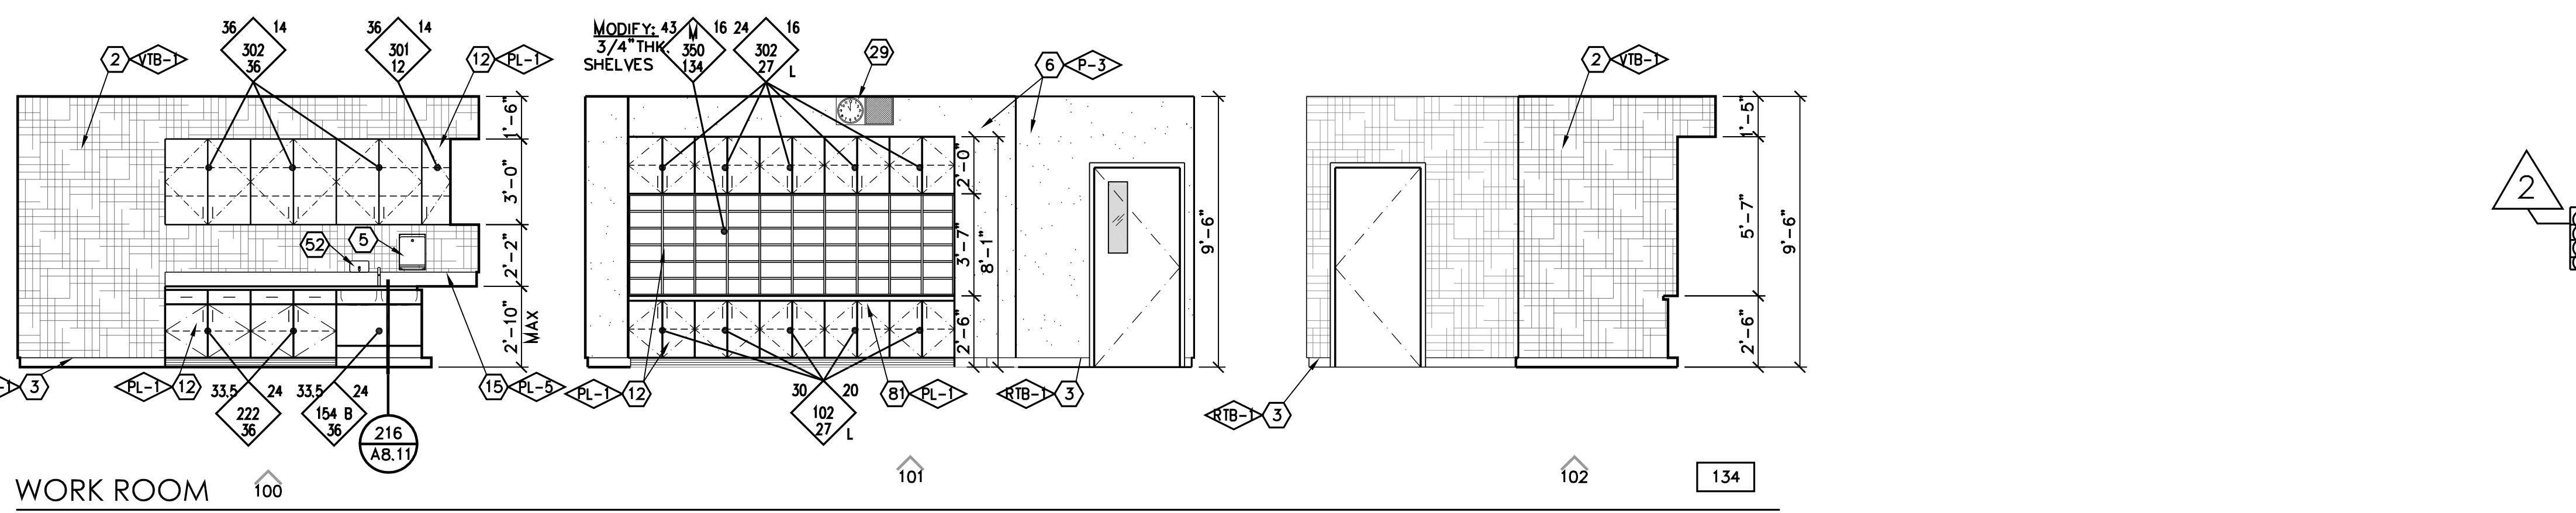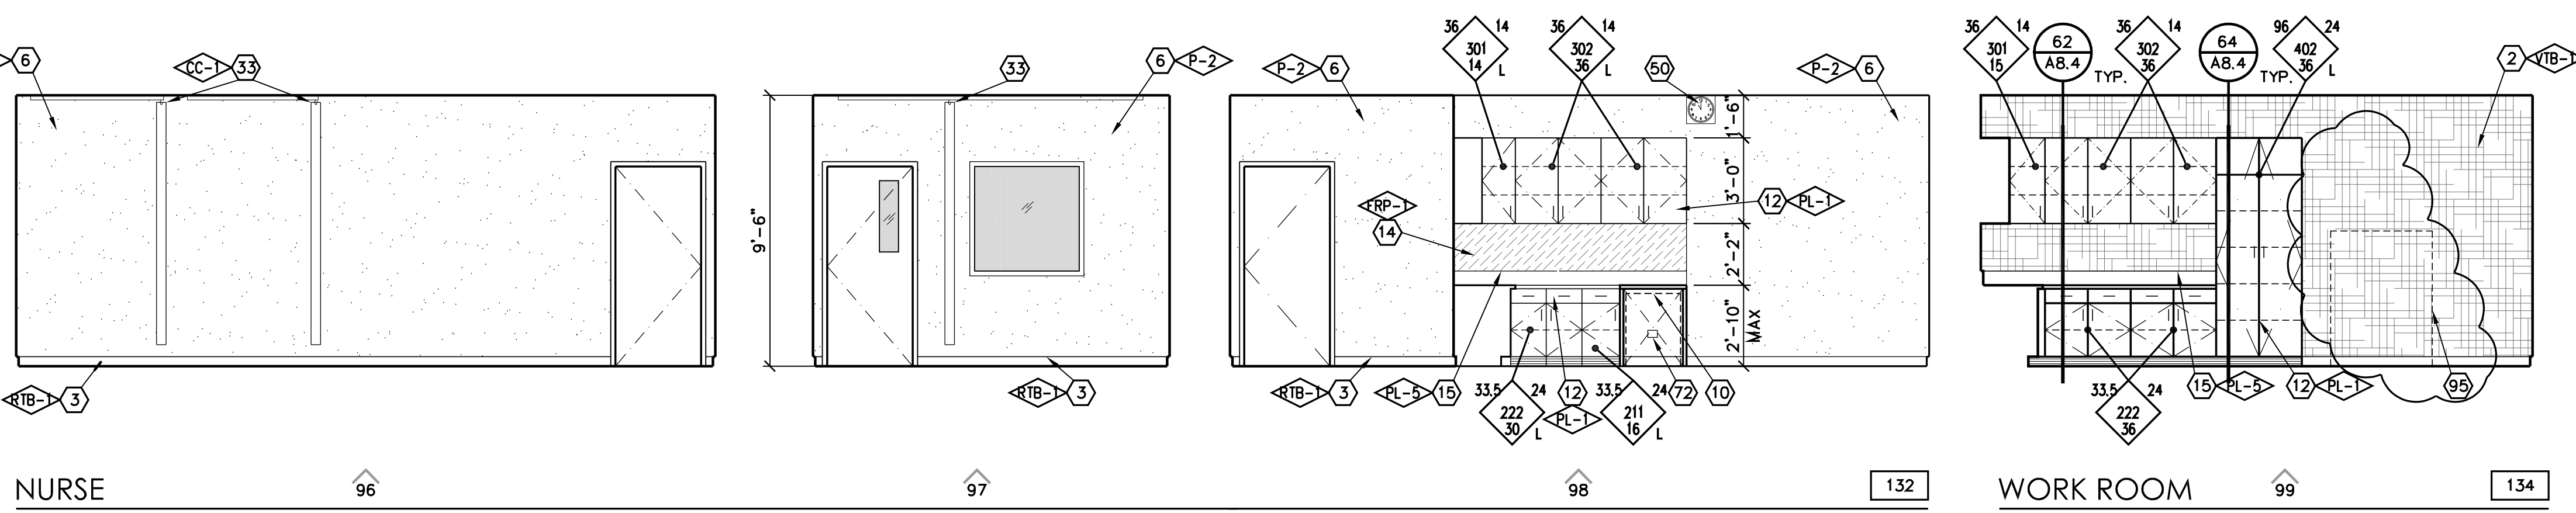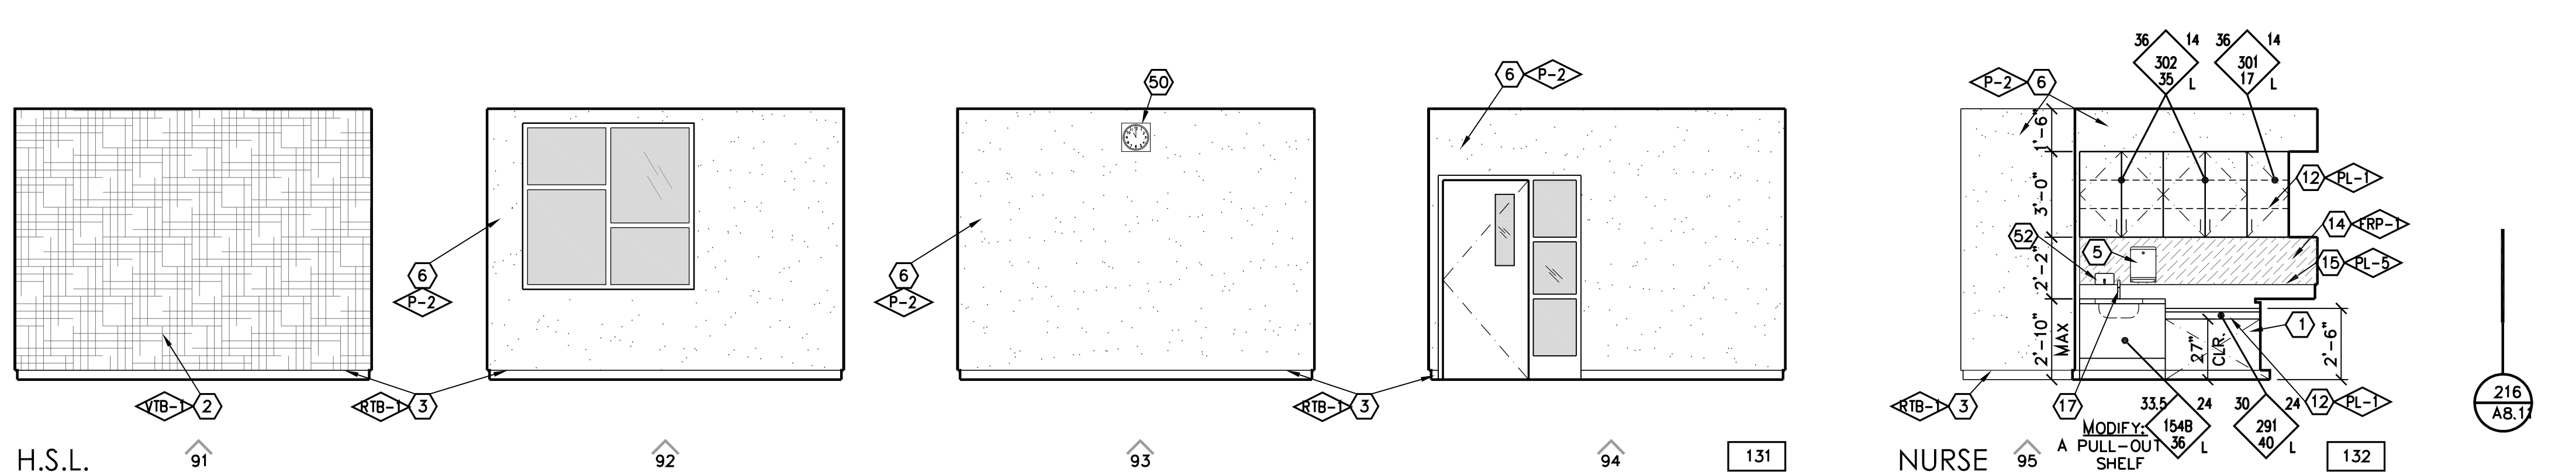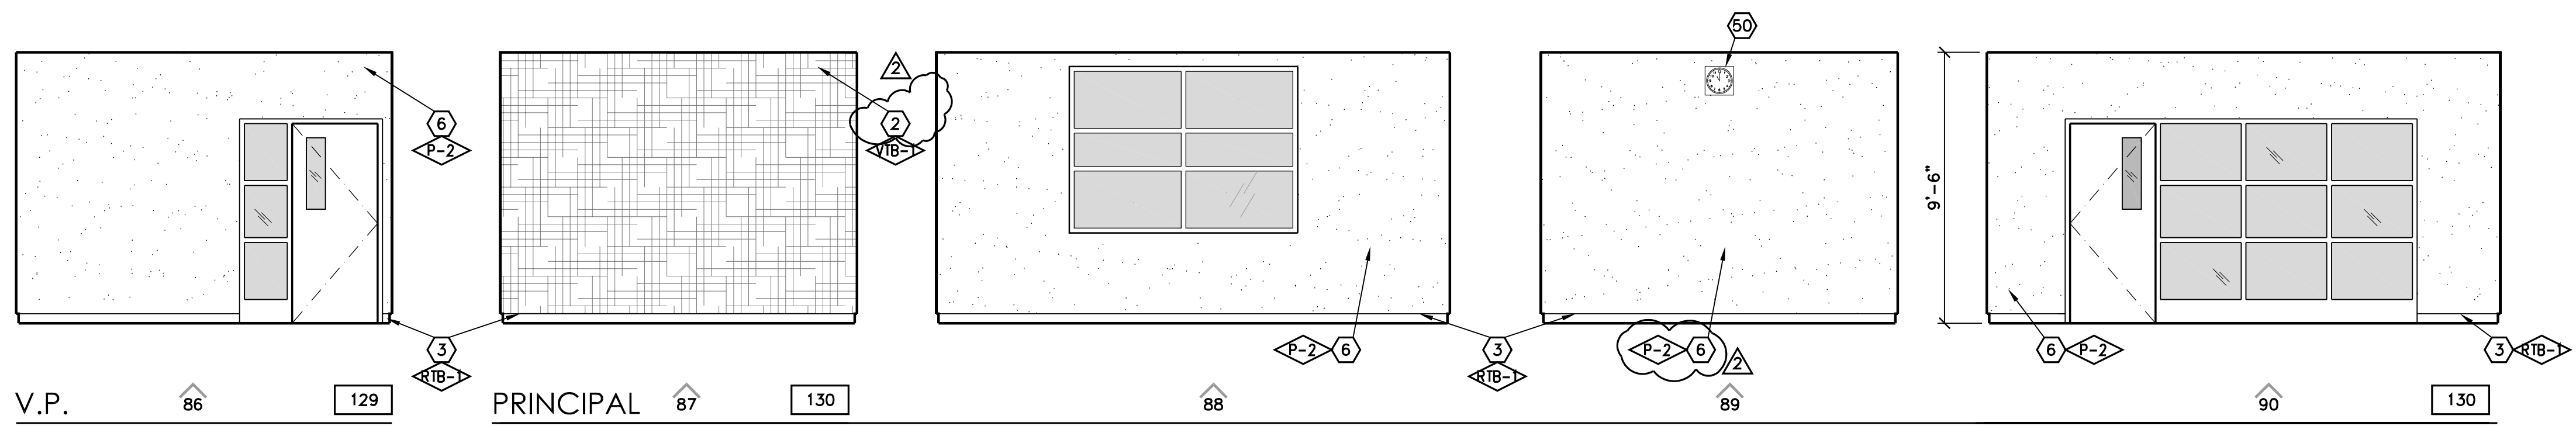

KEYNOTES

1. KNEE SPACE
2. VINYL TACKBOARD o/ GYP. BD.
3. RUBBER TOPSET BASE
4. STOREFRONT
5. PAPER TOWEL DISPENSER
6. GYPSUM BOARD, TAPE, TEXTURE & PAINT (PROVIDE 5/8" TYPE 'X' GYP. AT STAIRWAYS AND UNDERSTAIR WALL/CEILING FINISHES, TYP.)
7. ROOF ACCESS LADDER
8. SOFFIT
9. FLOOR SINK - SEE PLUMBING
10. UNDER-COUNTER REFRIGERATOR
11. FIRE EXTINGUISHER w/ SEMI RECESSED CAB. TYPE 2A:10BC
12. PLASTIC LAMINATE CASEWORK
13. W.I.C. 400 STORAGE SHELVING
14. FIBER REINFORCED PANEL
15. PLASTIC LAMINATE BACKSPLASH & COUNTERTOP
16. METAL POST, PER STRUCTURAL
17. SINK - SEE PLUMBING SCHEDULE
18. MAGNETIC MARKER BOARD o/VTB
19. APPLIANCES - SEE SPEC SECTION 11400
20. BUTCHER PAPER HOLDER
21. DISHWASHER
22. HOOD
23. REFRIGERATOR - FULL HEIGHT
24. COOKTOP
25. ROLL-UP DOOR
26. STAINLESS STEEL COUNTERTOP
27. FURNITURE (N.I.C.)
28. DRINKING FOUNTAIN
29. CLOCK/SPEAKER
30. CLEAR GLASS DISPLAY CASE w/ LOCK (SEE SPEC. SECT. 10410)
31. FEMININE NAPKIN DISPOSAL
32. MIRROR
33. TRACK AND CUBICLE CURTAIN.
34. STAIRCASE
35. HANDRAIL
36. N/A
37. TRANSLUCENT WALL SYSTEM
38. WOOD BASE
39. WHEEL CHAIR LIFT
40. BELOW STAGE STORAGE
41. N/A
42. ELEVATOR LANTERN
43. RAILING, SPACING SHALL BE SUCH THAT A 4" DIA. SPHERE CANNOT PASS THROUGH ANY OPENING, PER CBC 1013
44. CALL BUTTON
45. ELEVATOR DOORS
46. LAVATORY
47. TOILET PAPER DISPENSER
48. TOILET SEAT COVER DISPENSER
49. DATA RACEWAY. SEE ELECTRICAL DRAWINGS.
50. CLOCK
51. 4' HIGH CORNER GUARD, TYP.
52. SOAP DISPENSER
53. PLASTIC TOILET PARTITION
54. SIGNAGE
55. MANUFACTURED 3"Wx6"H MTL. SHELVING, SEE S-1/K8.0
56. SPEAKER ENCLOSURE AND GRILLE
57. MOP/BROOM HOLDER
58. PLASTIC LAM. DOOR, 1 1/2" THICK PROVIDE 3/4" LAM. PLASTIC SUPPORTS AT STOREFRONT, AT 4'-0" O.C.
59. RAYTHERMS (N.I.C.)
60. URINAL
61. MICROWAVE (N.I.C.)
62. PLASTIC LAMINATE CAP
64. CERAMIC TILE
65. GRAB BAR
66. WATER CLOSET
67. METAL LETTERS (SEE SPECS)
68. PONY WALL BEHIND
69. ROOM CAPACITY SIGN
70. TECTUM PANELS
71. 2x3 SHAPED WOOD NAILER
72. UTILITY BOX
73. MOVABLE ROD TO BE PLACED AT 44" FOR ADA COMPLIANCE. OPTIONAL.
74. MOTORIZED SCREEN. SEE 143/AB.8
75. PLASTIC LAMINATE PANELING AND DOORS
76. WINDOW WALL, SEE T2 FOR DEFERRED ITEMS
77. CLEAR GLASS POSTER CASE w/LOCK (SEE SPEC. SECT. 10410)
78. 1/2" REVEAL SCREEDS
79. WALL CLOX, SEE SPEC SECTION 10050
80. MICROWAVE OVEN
81. PLASTIC LAMINATE COUNTERTOP
82. SOLID SURFACE COUNTERTOP
83. PERFORATED DECORATIVE METAL PANEL
84. WALL PROTECTION PANEL
85. ICE MACHINE
86. CARPET BASE
87. N/A
88. CORNER GUARD
89. STRUCTURAL MEMBER TO BE PAINTED, SEE STRUCTURAL
90. EPOXY, EPP-1
91. CASEWORK
92. TAG-WALL PANELS
93. 75" MONITOR WITH
94. MONITOR CONTROL DEVICE & HDMI DEVICES. DISTRICT WILL VERIFY LOCATION
95. COPY MACHINE - NIC
96. WALL MOUNTED SPEAKERS. DISTRICT TO VERIFY LOCATION
97. N/A
98. SEE DET. 216/AB.11 FOR ACCESSIBILITY STANDARDS
99. 2. ALL SHELVING WITH SPANS GREATER THAN 30" TO BE 1" THICK
100. REFER TO COLOR SCHEDULE (SHEET A2.8) FOR ALL COLOR REFERENCES, TYP.
101. 4. ALL CARPET USES A CARPET BASE #86
102. ALL MONDO RUBBER FLOORS USE A RUBBER TOPSET BASE #3
103. ALL AHRO FLOORS USE SELF-COVER BASE #41
104. ALL STAINED & DYED CONCRETE FLOORS USE TOPSET #3

SYMBOL LEGEND

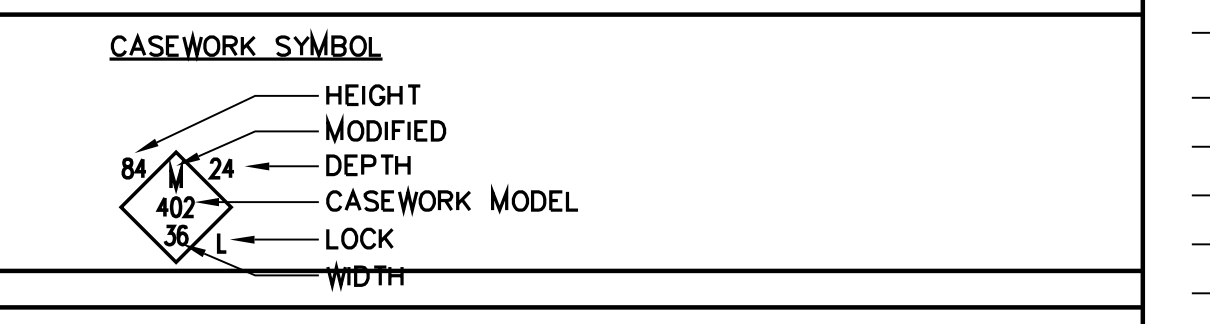

REVISIONS


| No. | DATE | DESCRIPTION |
|---------|------|------------------------|
| 2.14.23 | | DISTRICT MODIFICATIONS |
| 2.27.23 | | DISTRICT MODIFICATIONS |

SHEET DESCRIPTION


| | |
|--|--------------------------|
| INTERIOR ELEVATIONS | |
| MAIN - 1ST FLOOR | |
| PROJECT COORDINATOR JOHN SMITH | SHEET NO. A5.6 |
| PROJECT NO. 17-67 | |
| DATE 1.27.23 | |
| SCALE 1/4"=1'-0" | |



PROJECT:
SHIELDS & BRAWLEY ELEMENTARY SCHOOL

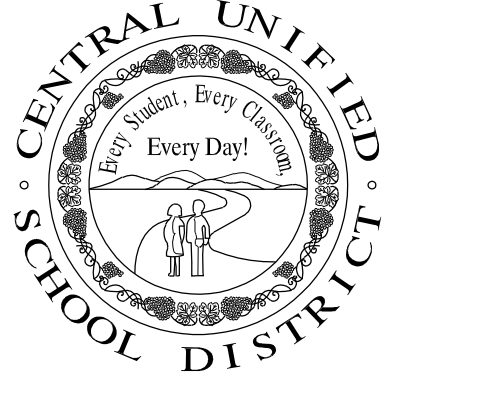



AD 2-23a
S&B Elementary
02-116800

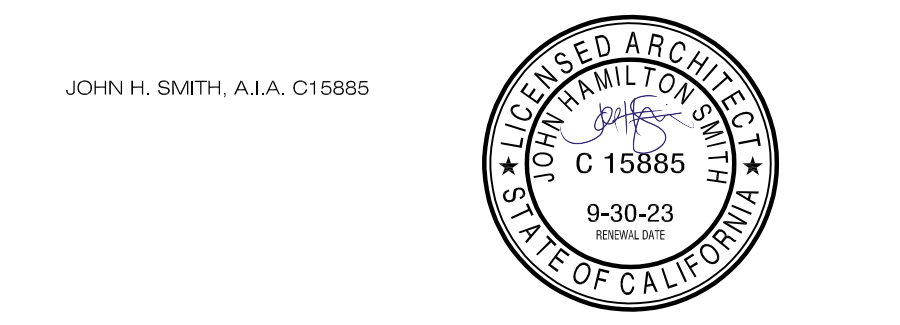

THE FIRM OF SMITH, BRAWLEY, MILHOUS, ARCHITECTS, INC. EXPRESSLY RESERVES ITS COMMON LAW COPYRIGHT AND OTHER APPLICABLE PROPERTY RIGHTS IN THESE PLANS. THESE PLANS ARE NOT TO BE REPRODUCED, CHANGED, OR COPIED IN ANY FORM OR MANNER WHATSOEVER, NOR ARE THEY TO BE ASSIGNED TO A THIRD PARTY WITHOUT FIRST OBTAINING THE WRITTEN PERMISSION AND CONSENT OF THE ARCHITECT. IN THE EVENT OF UNAUTHORIZED REUSE OF THESE PLANS BY A THIRD PARTY, THE THIRD PARTY SHALL HOLD THE ARCHITECT HARMLESS, AND SHALL BEAR THE COST OF THE ARCHITECT'S LEGAL FEES, ASSOCIATED WITH DEFENDING AND ENFORCING THESE RIGHTS.



| PROJECT DEVELOPMENT | |
|---------------------|------------|
| DATE | ISSUED FOR |
| | |
| | |
| | |

17-67-shields & Brawley Elementary Work 17-67-A5.6-11-interior.dwg 05/30/18 22:54

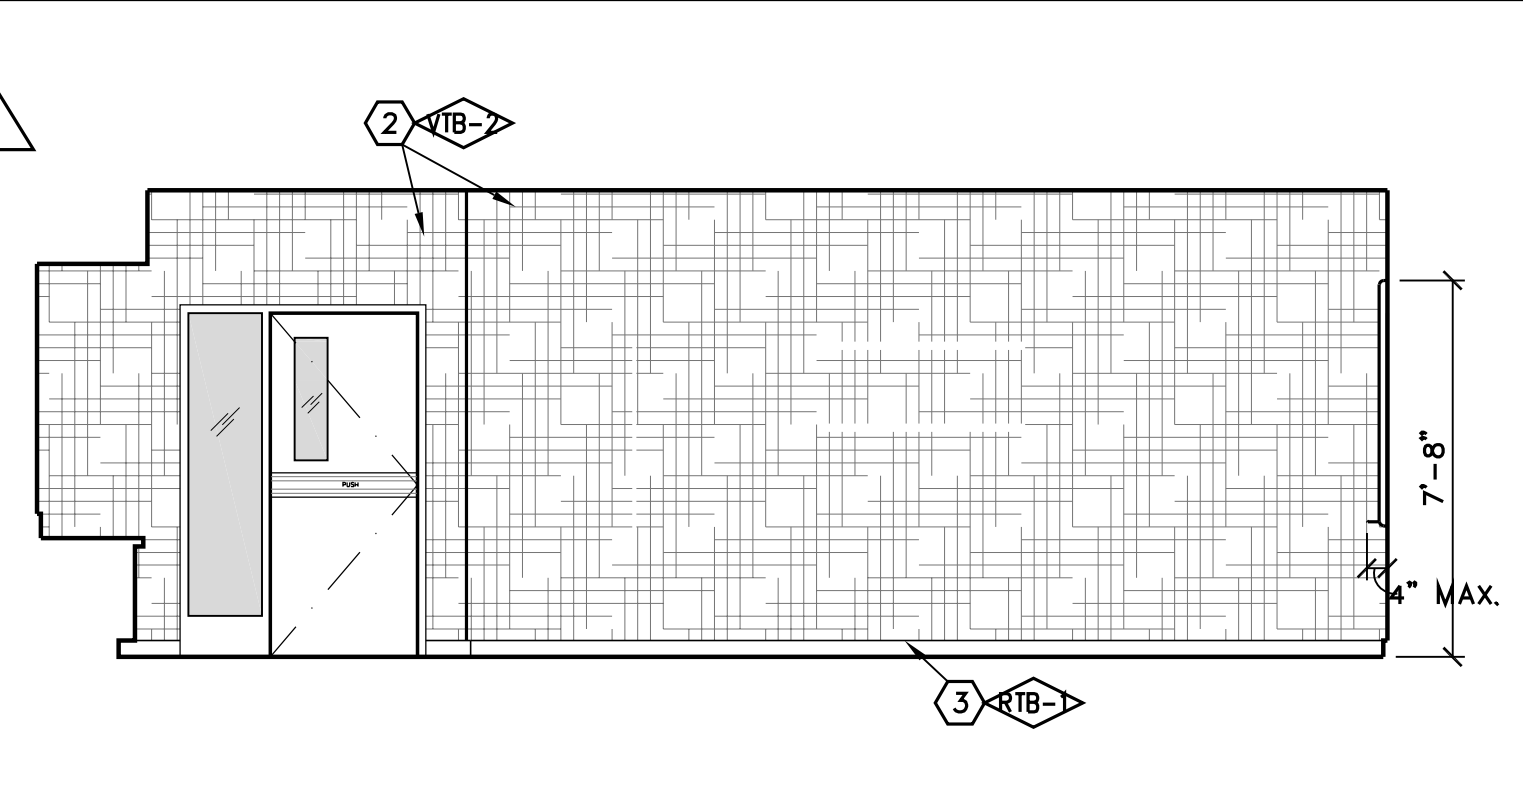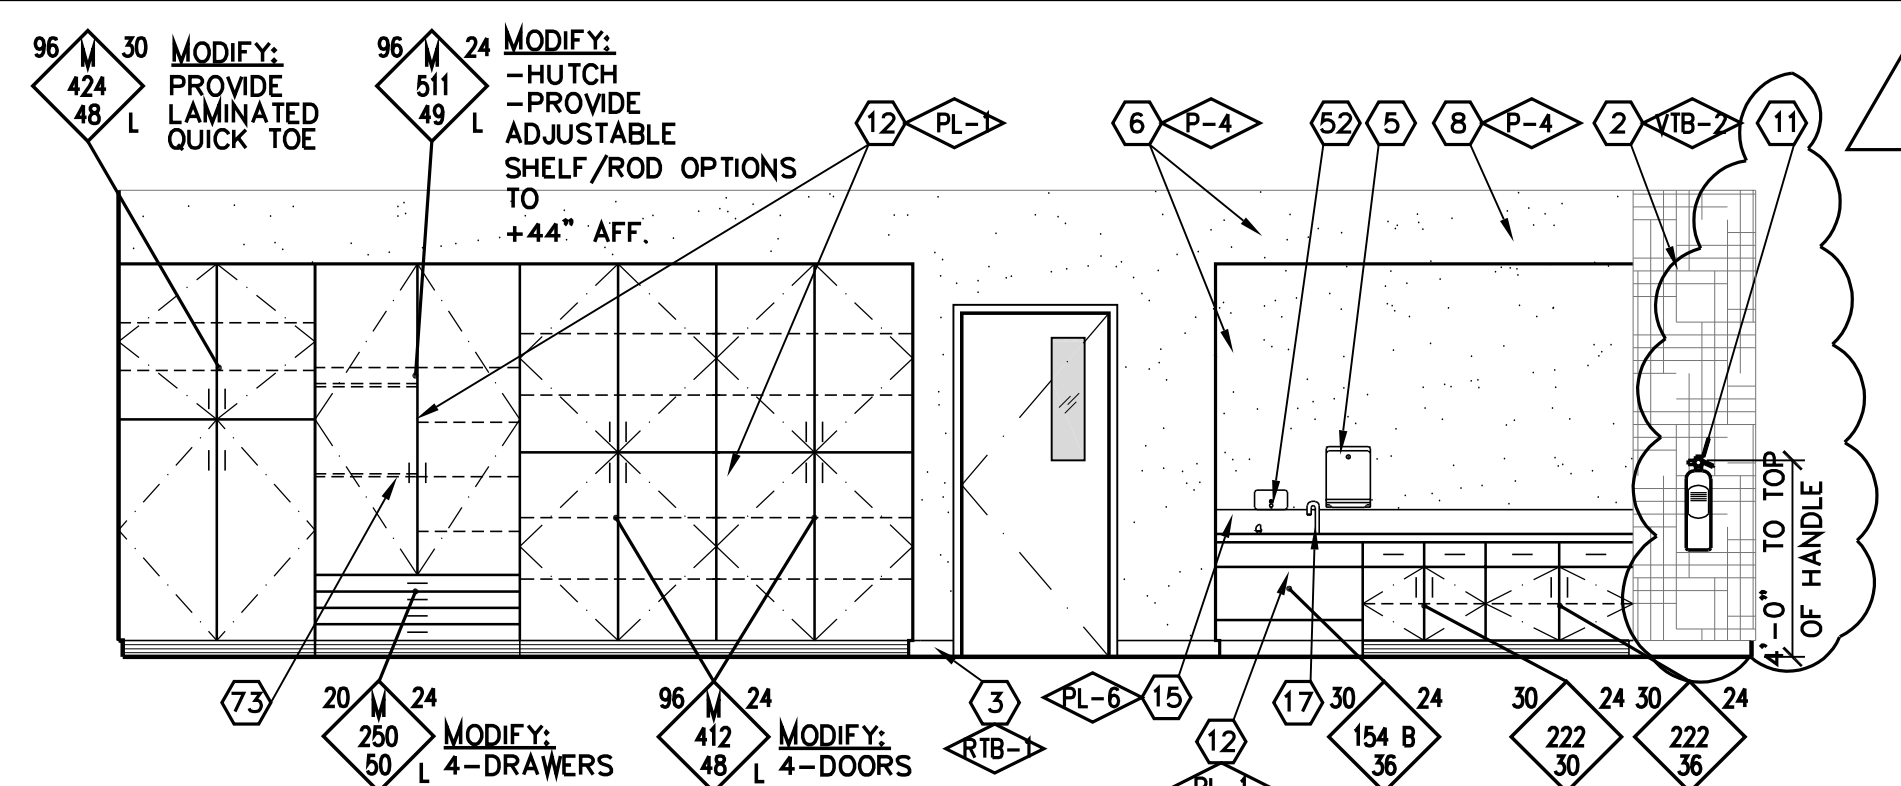



CLASSROOM
TYPICAL

CLASSROOM
TYPICAL

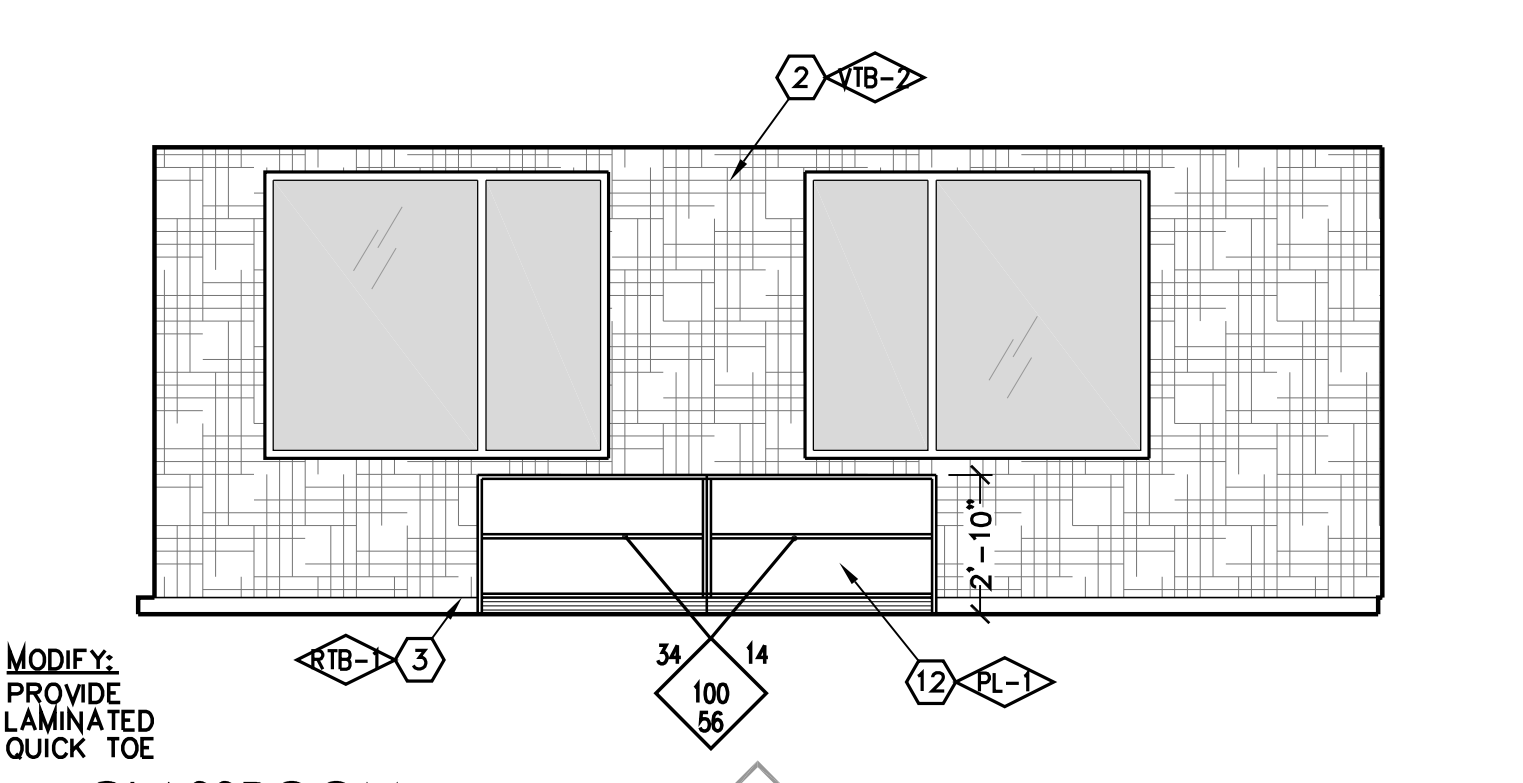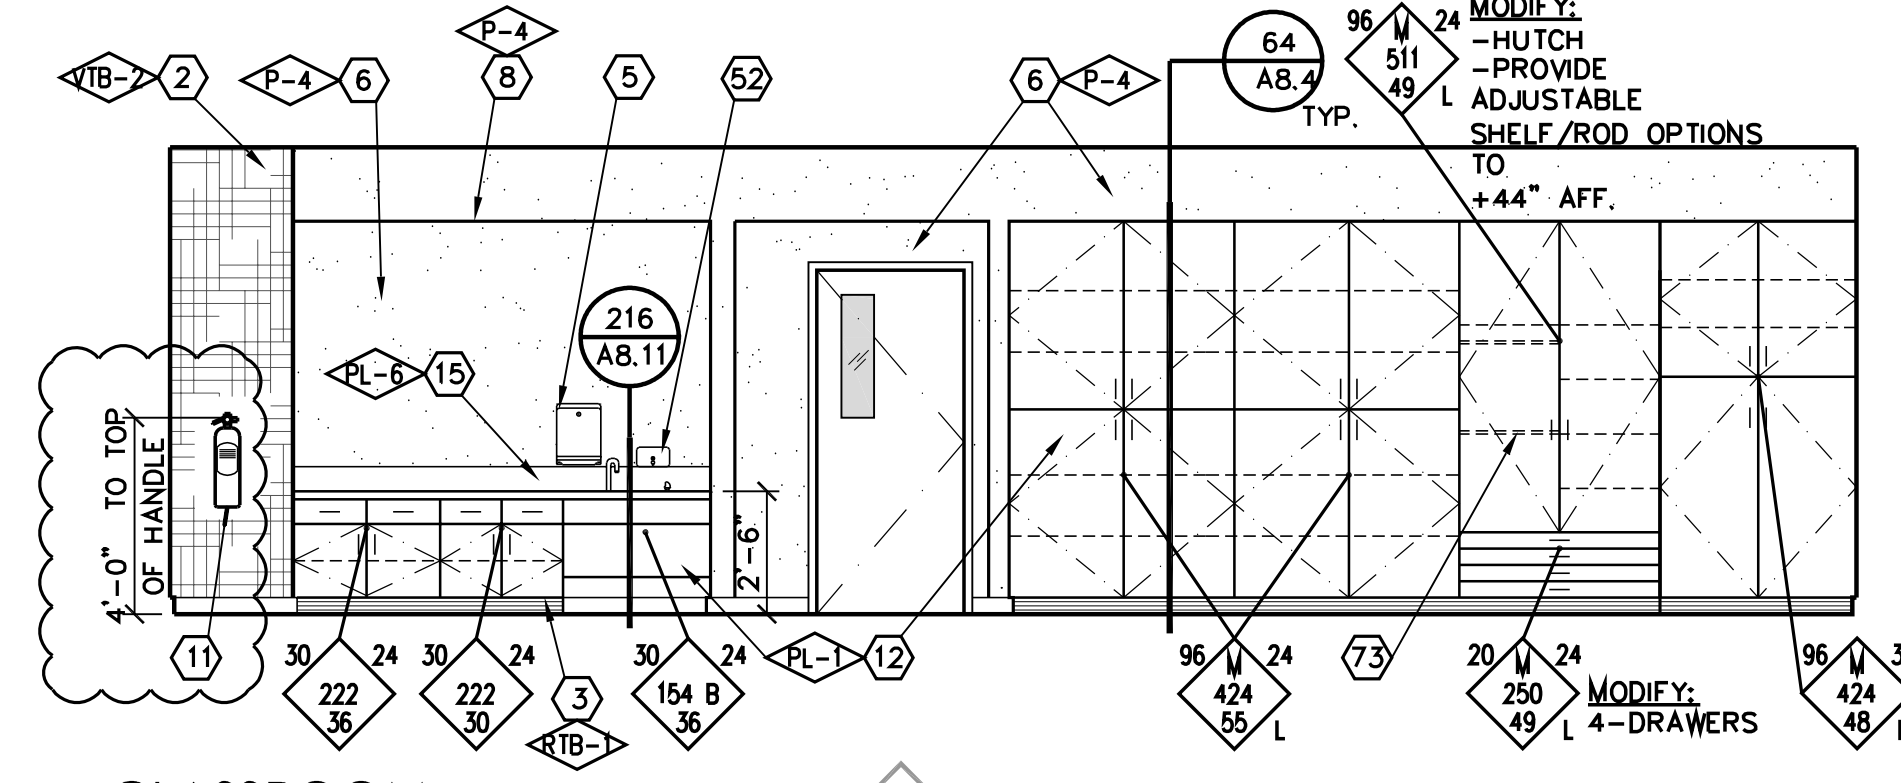


CLASSROOM
TYPICAL

CLASSROOM
TYPICAL

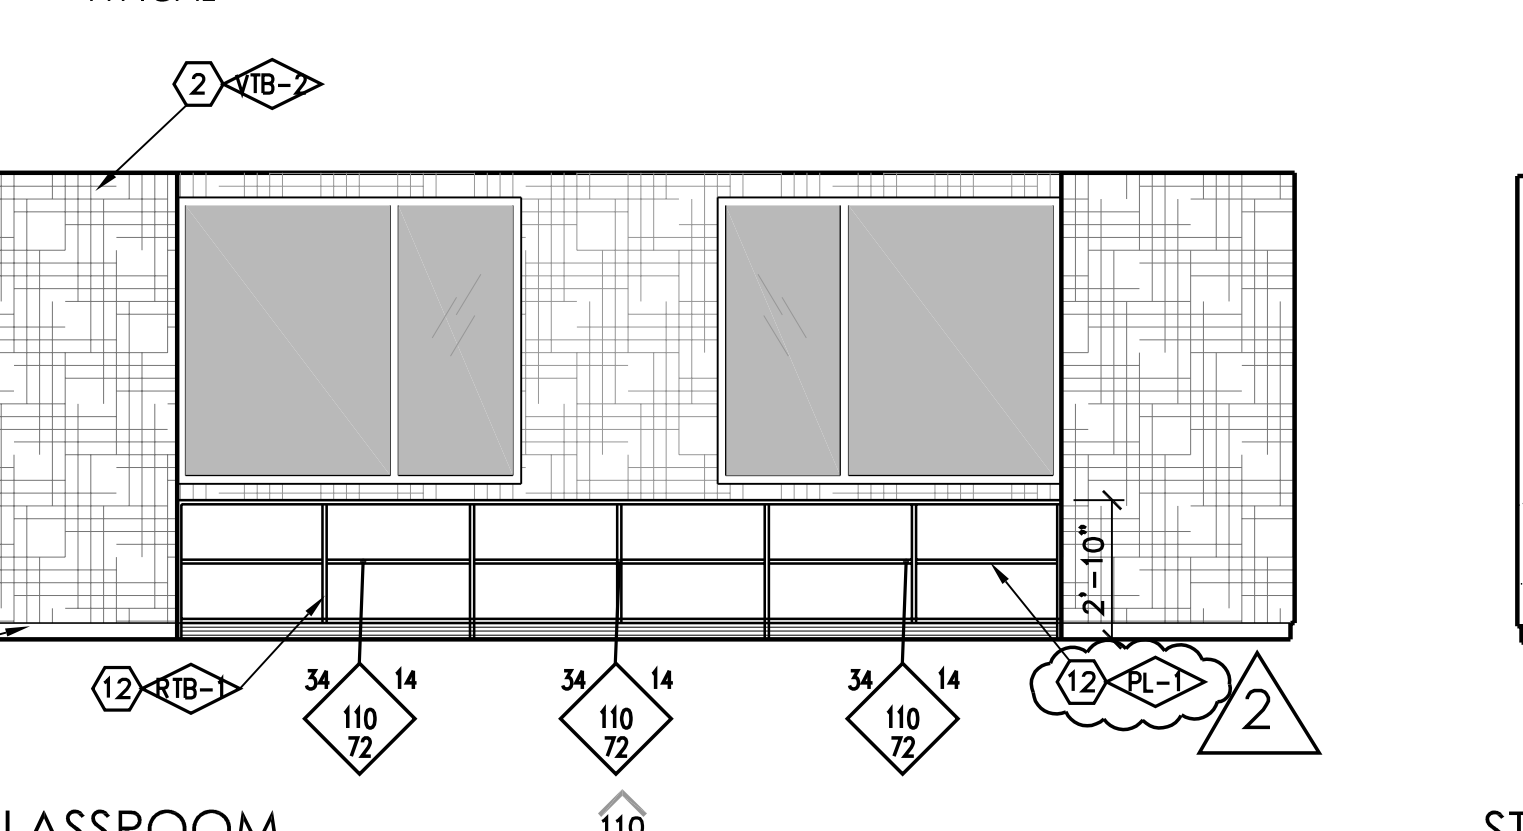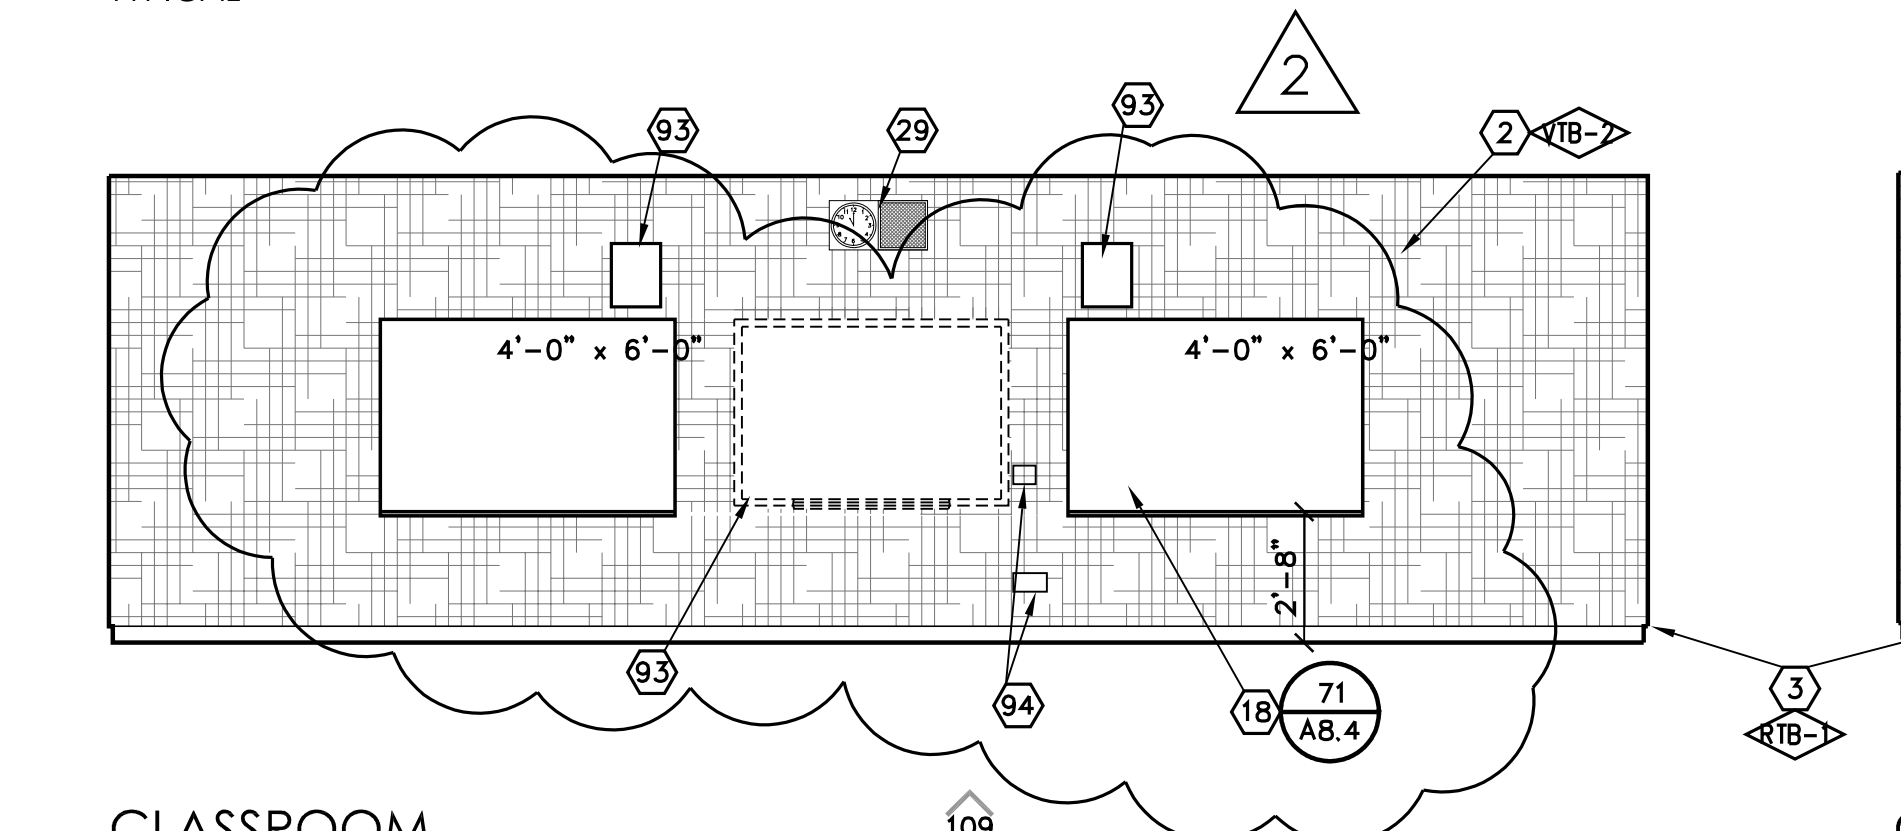


CLASSROOM
TYPICAL


CLASSROOM
TYPICAL

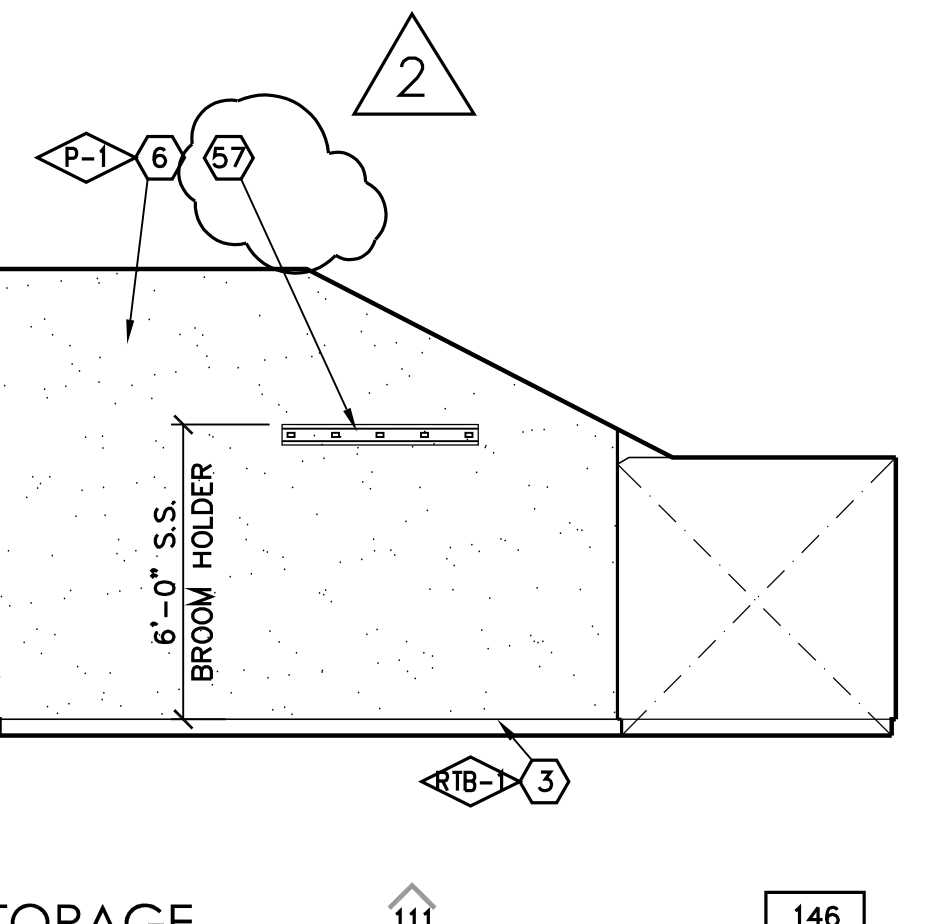


STORAGE
WEST

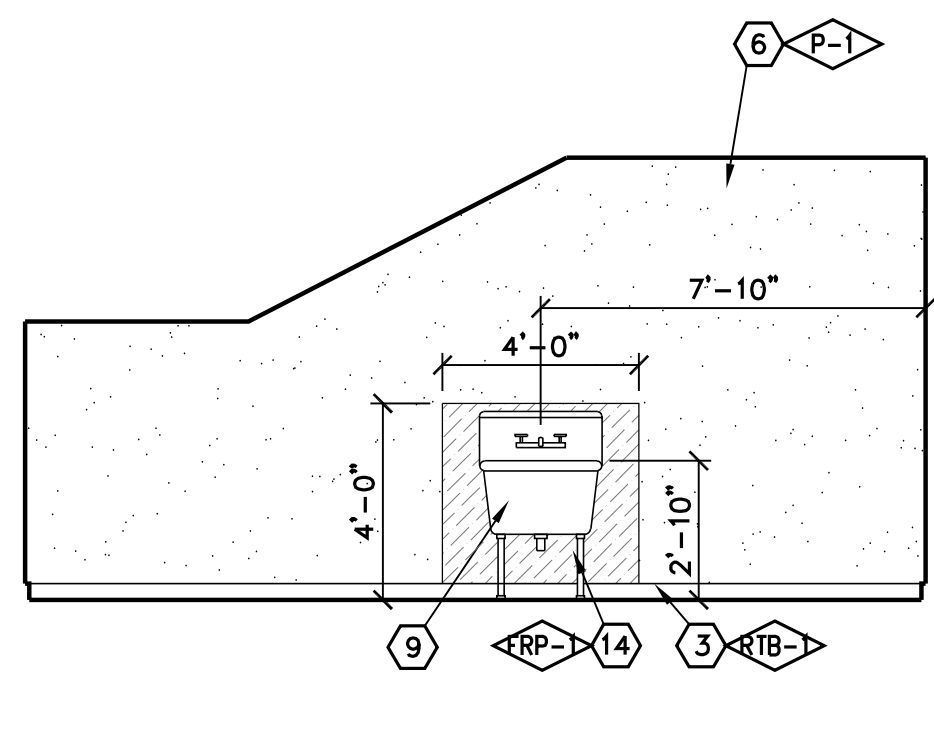


STORAGE

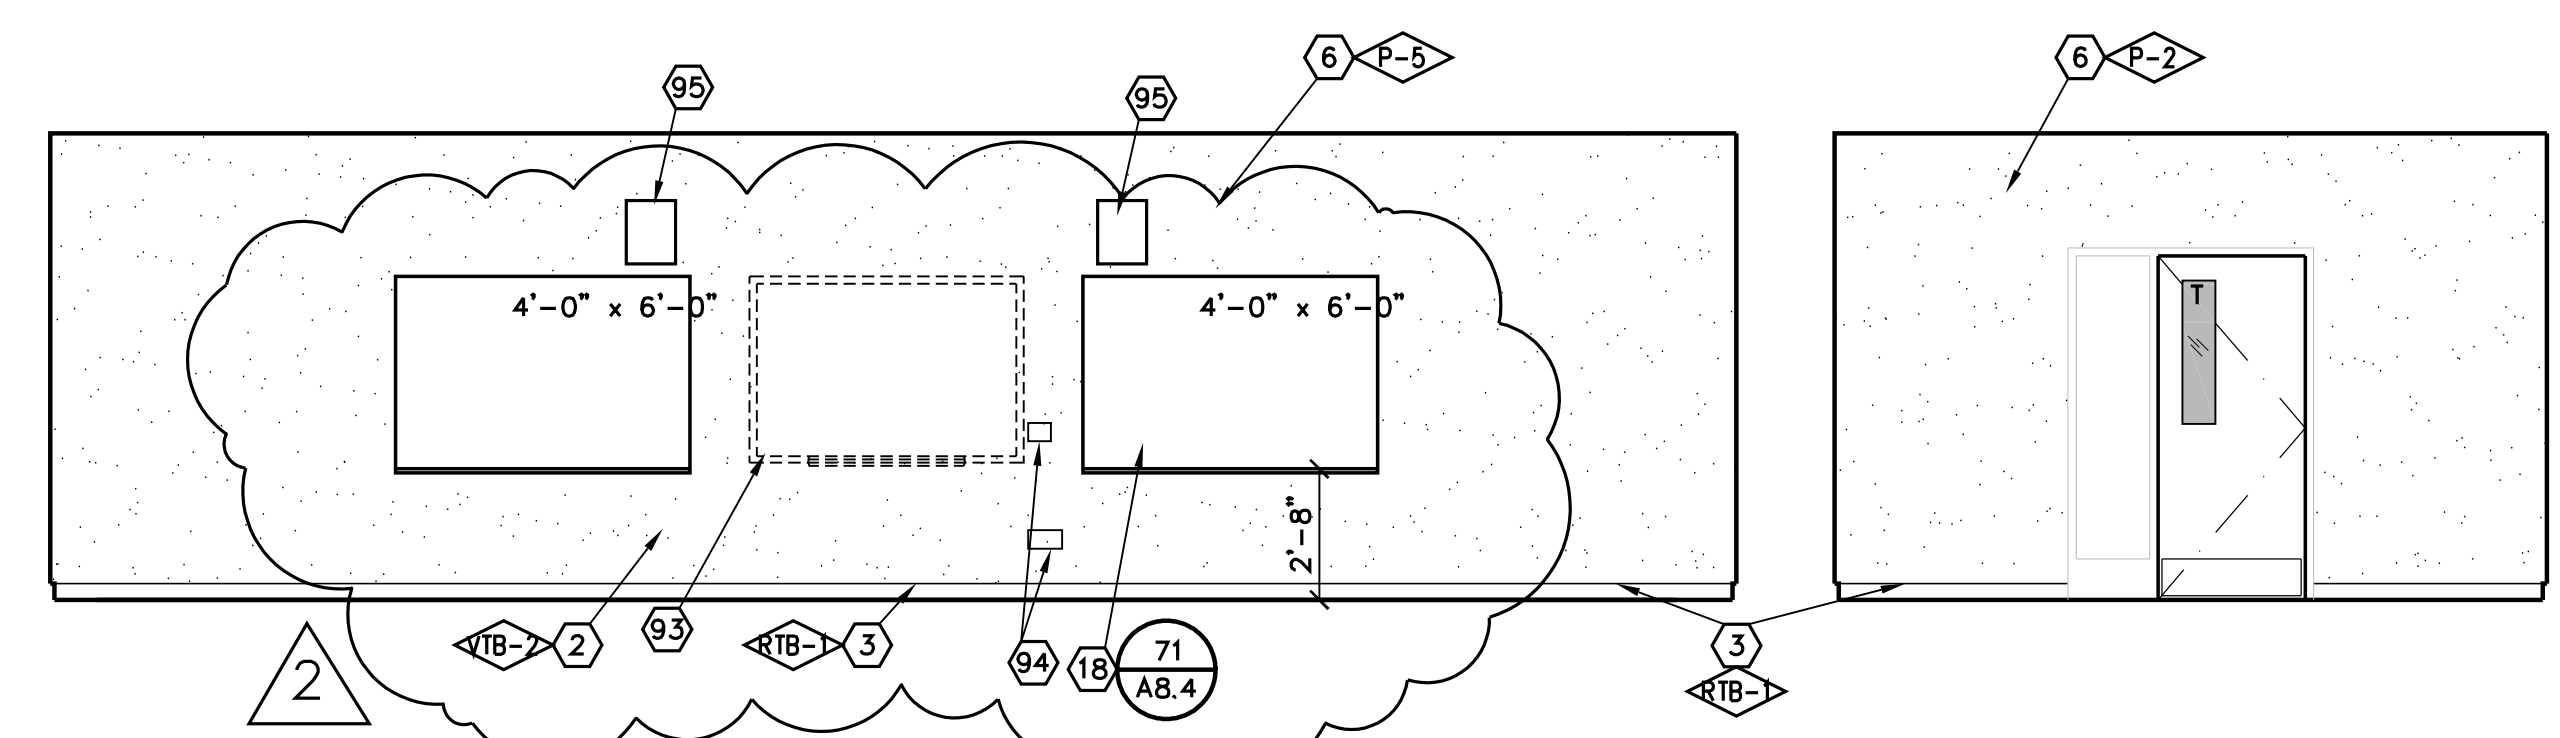


RESOURCE

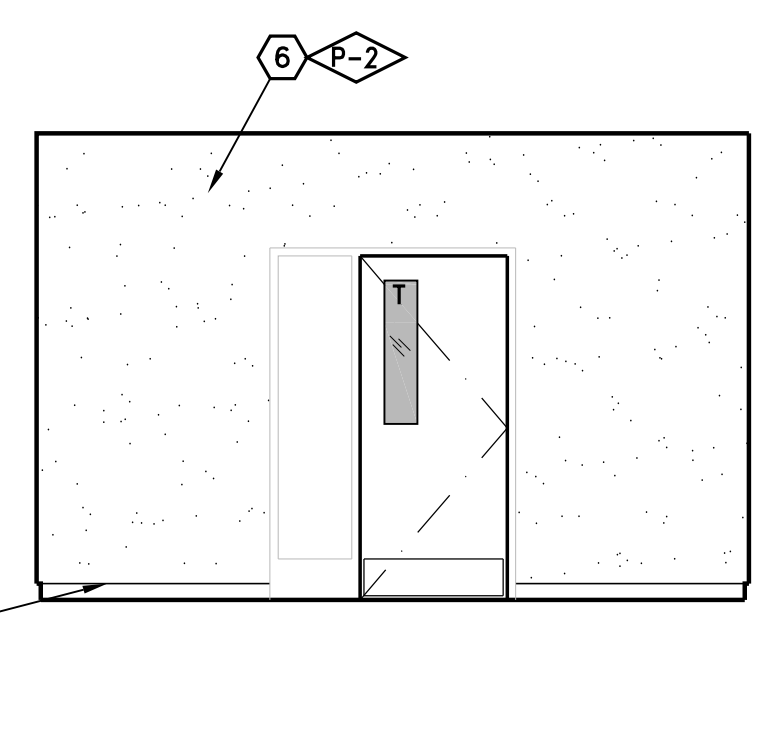


RESOURCE

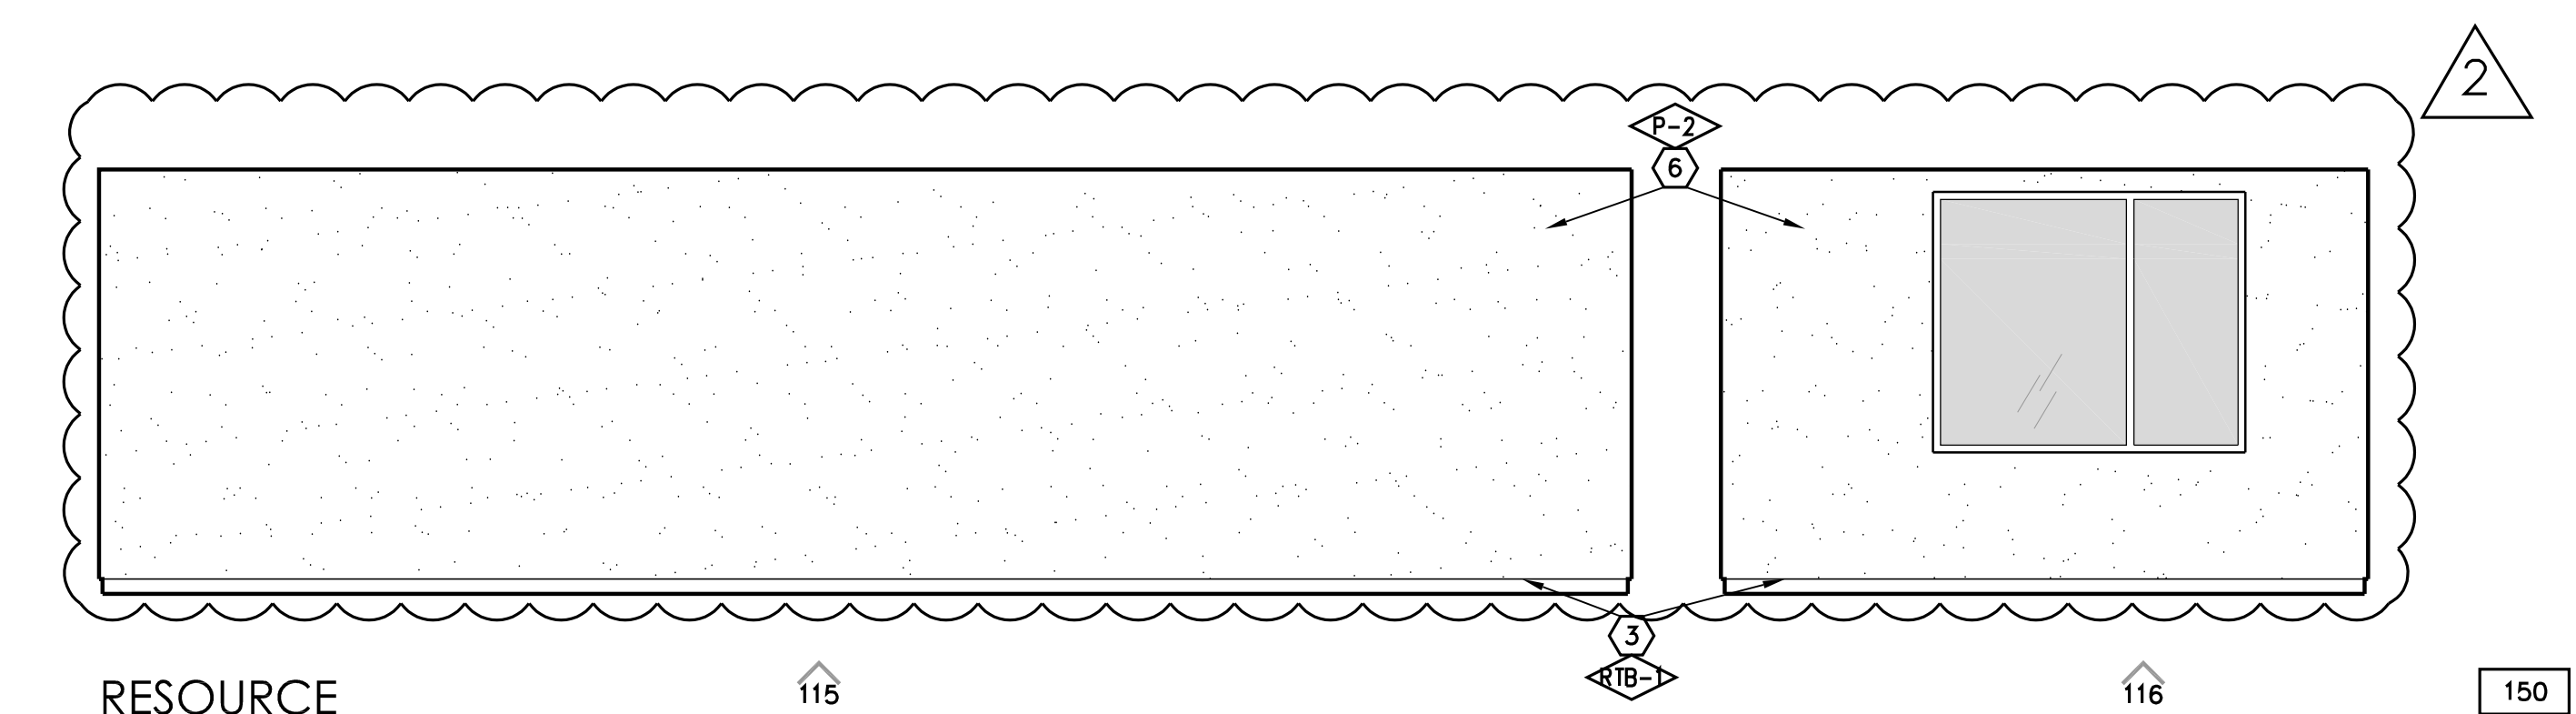

RESOURCE

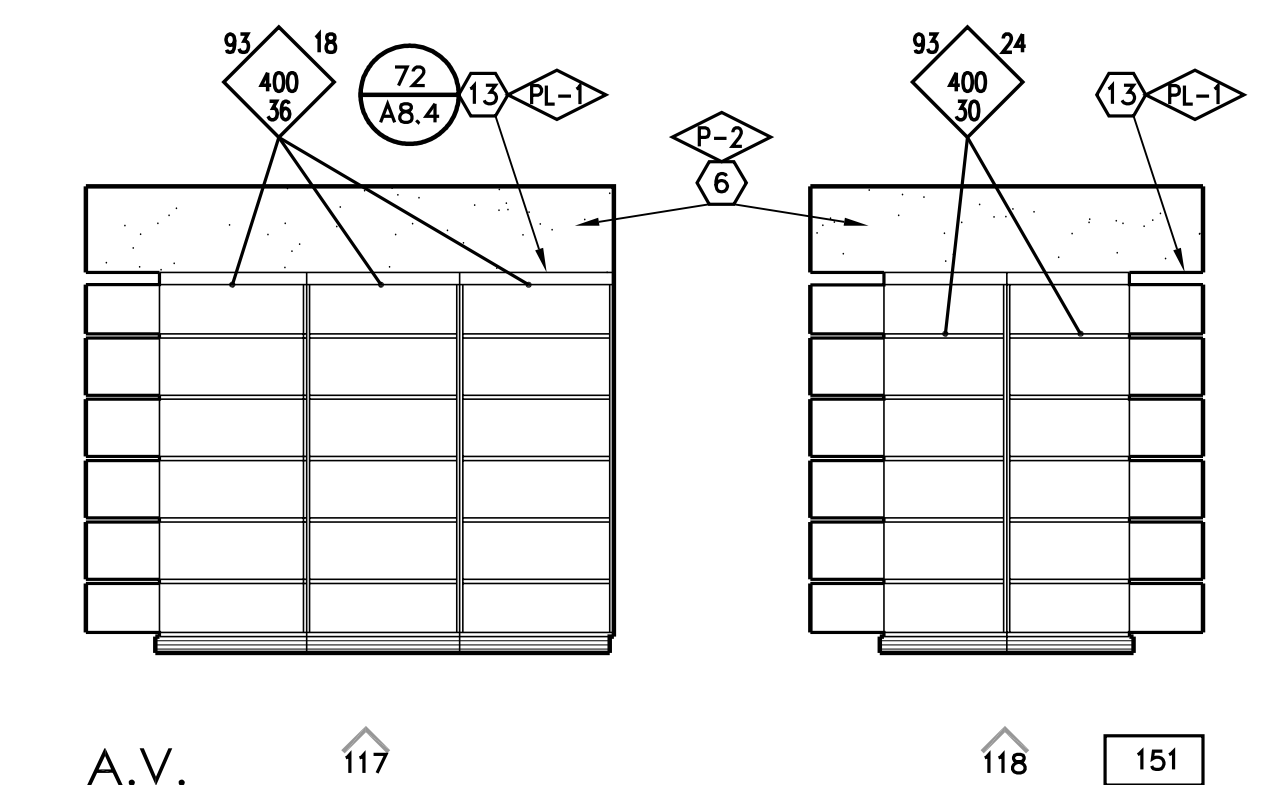

A.V.

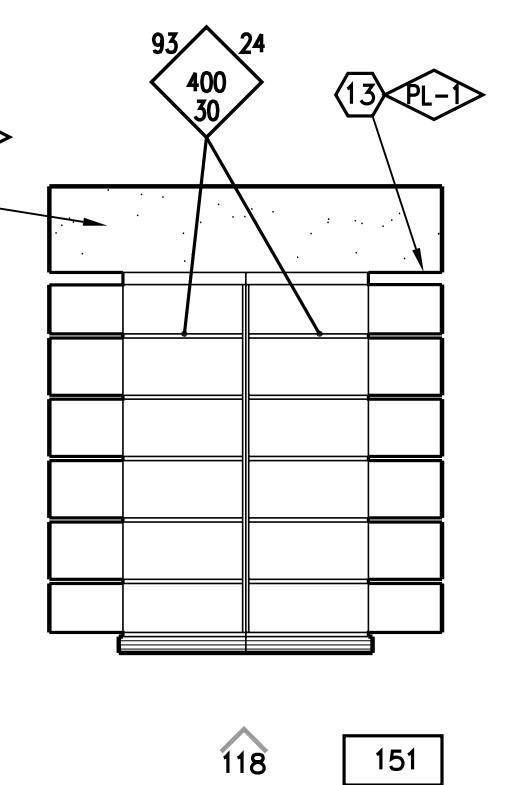


RESOURCE

KEYNOTES

1. KNEE SPACE
2. VINYL TACKBOARD o/ GYP. BD.
3. RUBBER TOPSET BASE
4. STOREFRONT
5. PAPER TOWEL DISPENSER
6. GYPSUM BOARD, TAPE, TEXTURE & PAINT (PROVIDE 5/8" TYPE 'X' GYP. BD. AT STAIRWAYS AND UNDERSTAIR WALL/CEILING FINISHES, TYP.)
7. ROOF ACCESS LADDER
8. SOFFIT
9. FLOOR SINK - SEE PLUMBING
10. UNDER-COUNTER REFRIGERATOR
11. FIRE EXTINGUISHER w/ SEMI RECESSED CAB. TYPE 2A:10BC
12. PLASTIC LAMINATE CASEWORK
13. W.I.C. 400 STORAGE SHELVING
14. FIBER REINFORCED PANEL
15. PLASTIC LAMINATE BACKSPLASH & COUNTERTOP
16. METAL POST, PER STRUCTURAL
17. SINK - SEE PLUMBING SCHEDULE
18. MAGNETIC MARKER BOARD o/VTB
19. APPLIANCES - SEE SPEC SECTION 11400
20. BUTCHER PAPER HOLDER
21. DISHWASHER
22. HOOD
23. REFRIGERATOR - FULL HEIGHT
24. COOKTOP
25. ROLL-UP DOOR
26. STAINLESS STEEL COUNTERTOP
27. FURNITURE (N.I.C.)
28. DRINKING FOUNTAIN
29. CLOCK/SPEAKER
30. CLEAR GLASS DISPLAY CASE w/ LOCK (SEE SPEC. SECT. 10410)
31. FEMINE NAPKIN DISPOSAL
32. MIRROR
33. TRACK AND CUBICLE CURTAIN.
34. STAIRCASE
35. HANDRAIL
36. N/A
37. TRANSLUCENT WALL SYSTEM
38. WOOD BASE
39. WHEEL CHAIR LIFT
40. BELOW STAGE STORAGE
41. SHEET VINYL COVERED BASE
42. ELEVATOR LANTERN
43. RAILING, SPACING SHALL BE SUCH THAT A 4" DIA. SPHERE CANNOT PASS THROUGH ANY OPENING, PER CBC 1013
44. CALL BUTTON
45. ELEVATOR DOORS
46. LAVATORY
47. TOILET PAPER DISPENSER
48. TOILET SEAT COVER DISPENSER
49. DATA RACEWAY. SEE ELECTRICAL DRAWINGS.
50. CLOCK
51. 4" HIGH CORNER GUARD, TYP.
52. SOAP DISPENSER
53. PLASTIC TOILET PARTITION
54. SIGNAGE
55. MANUFACTURED 3"Wx6"H MTL. SHELVING, SEE S-1/K8.0
56. SPEAKER ENCLOSURE AND GRILLE
57. MOP/BROOM HOLDER
58. PLASTIC LAM. DOOR, 1 1/2" THICK
59. PROVIDE 3/4" LAM. PLASTIC SUPPORTS AT STOREFRONT, AT 4'-0" O.C.
60. RAYTHERMS (N.I.C.)
61. URINAL
62. MICROWAVE (N.I.C.)
63. PLASTIC LAMINATE CAP
64. CERAMIC TILE
65. GRAB BAR
66. WATER CLOSET
67. METAL LETTERS (SEE SPECS)
68. PONY WALL BEHIND
69. ROOM CAPACITY SIGN
70. TECTUM PANELS
71. 2x3 SHAPED WOOD NAILER
72. UTILITY BOX
73. MOVABLE ROD TO BE PLACED AT 44" FOR ADA COMPLIANCE. OPTIONAL.
74. MOTORIZED SCREEN. SEE 143/A8.8
75. PLASTIC LAMINATE PANELING AND DOORS
76. WINDOW WALL. SEE T2 FOR DEFERRED ITEMS
77. CLEAR GLASS POSTER CASE w/LOCK (SEE SPEC. SECT. 10410)
78. 1/2" REVEAL SCREENS
79. WALL CLOCK, SEE SPEC SECTION 10050
80. MICROWAVE OVEN
81. PLASTIC LAMINATE COUNTERTOP
82. SOLID SURFACE COUNTERTOP
83. PERFORATED DECORATIVE METAL PANEL
84. WALL PROTECTION PANEL
85. ICE MACHINE
86. CARPET BASE
87. (5) 24"x48" TACKBOARD PANELS. SEE COLOR SCHEDULE REMARK 13/A2.8.
88. CORNER GUARD
89. STRUCTURAL MEMBER TO BE PAINTED, SEE STRUCTURAL
90. COVERED BASE
91. CASEWORK
92. TAC-WALL
93. 75" MONITOR WITH
94. MONITOR CONTROL DEVICE & HDMI DEVICES. DISTRICT WILL VERIFY LOCATION
95. WALL MOUNTED SPEAKERS. DISTRICT TO VERIFY LOCATION

SYMBOL LEGEND

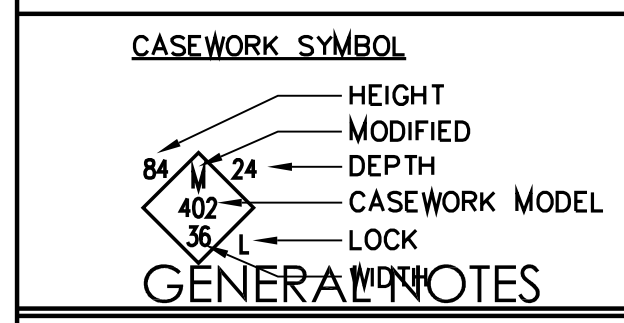

GENERAL NOTES

1. RECESSED CLOCKS AND/OR SPEAKERS ARE PROHIBITED IN FIRE RATED WALLS WHERE OPENING PROTECTION IS REQUIRED.
2. EXCEPTION #4 FROM CBC 11B-606.2 IS BEING APPLIED TO SINKS FOR REDUCED KNEE CLEARANCE.



7790 NORTH PALM AVENUE
FRESNO, CALIFORNIA 93711
T559.448.8400 F559.448.8467
www.simprbk.com

PROJECT:
SHIELDS & BRAWLEY ELEMENTARY SCHOOL



AD 2-24a
S&B Elementary
02-116800



THE FIRM OF SMITH, IWANAGA, McHUGH, ARCHITECTS, INC. EXPRESSLY RESERVES ITS COPYRIGHT, LAW COPYRIGHT AND OTHER APPLICABLE PROPERTY RIGHTS IN THESE PLANS. THESE PLANS ARE NOT TO BE REPRODUCED, CHANGED, OR COPIED IN ANY FORM OR MANNER WHATSOEVER, NOR ARE THEY TO BE ASSIGNED TO A THIRD PARTY WITHOUT FIRST OBTAINING THE WRITTEN PERMISSION AND CONSENT OF THE ARCHITECT. IN THE EVENT OF UNAUTHORIZED REUSE OF THESE PLANS BY A THIRD PARTY, THE THIRD PARTY SHALL HOLD THE ARCHITECT HARMLESS, AND SHALL BEAR THE COST OF THE ARCHITECT'S LEGAL FEES, ASSOCIATED WITH DEFENDING AND ENFORCING THESE RIGHTS.

PROJECT DEVELOPMENT

| DATE | ISSUED FOR |
|------|------------|
| | |
| | |
| | |






REVISIONS

| No. | DATE | DESCRIPTION |
|-----|---------|------------------------|
| △ | 2.14.23 | DISTRICT MODIFICATIONS |
| △ | 2.27.23 | DISTRICT MODIFICATIONS |

SHEET DESCRIPTION

| | |
|--|--------------------------|
| PROJECT COORDINATOR JOHN SMITH | SHEET NO. A5.7 |
| PROJECT NO. 17-67 | DATE 1.27.23 |
| SCALE 1/4"=1'-0" | |


A:\17-67 Shields & Brawley Elementary\17-67-A5.7-14-interior.dwg 05/30/18 2:13

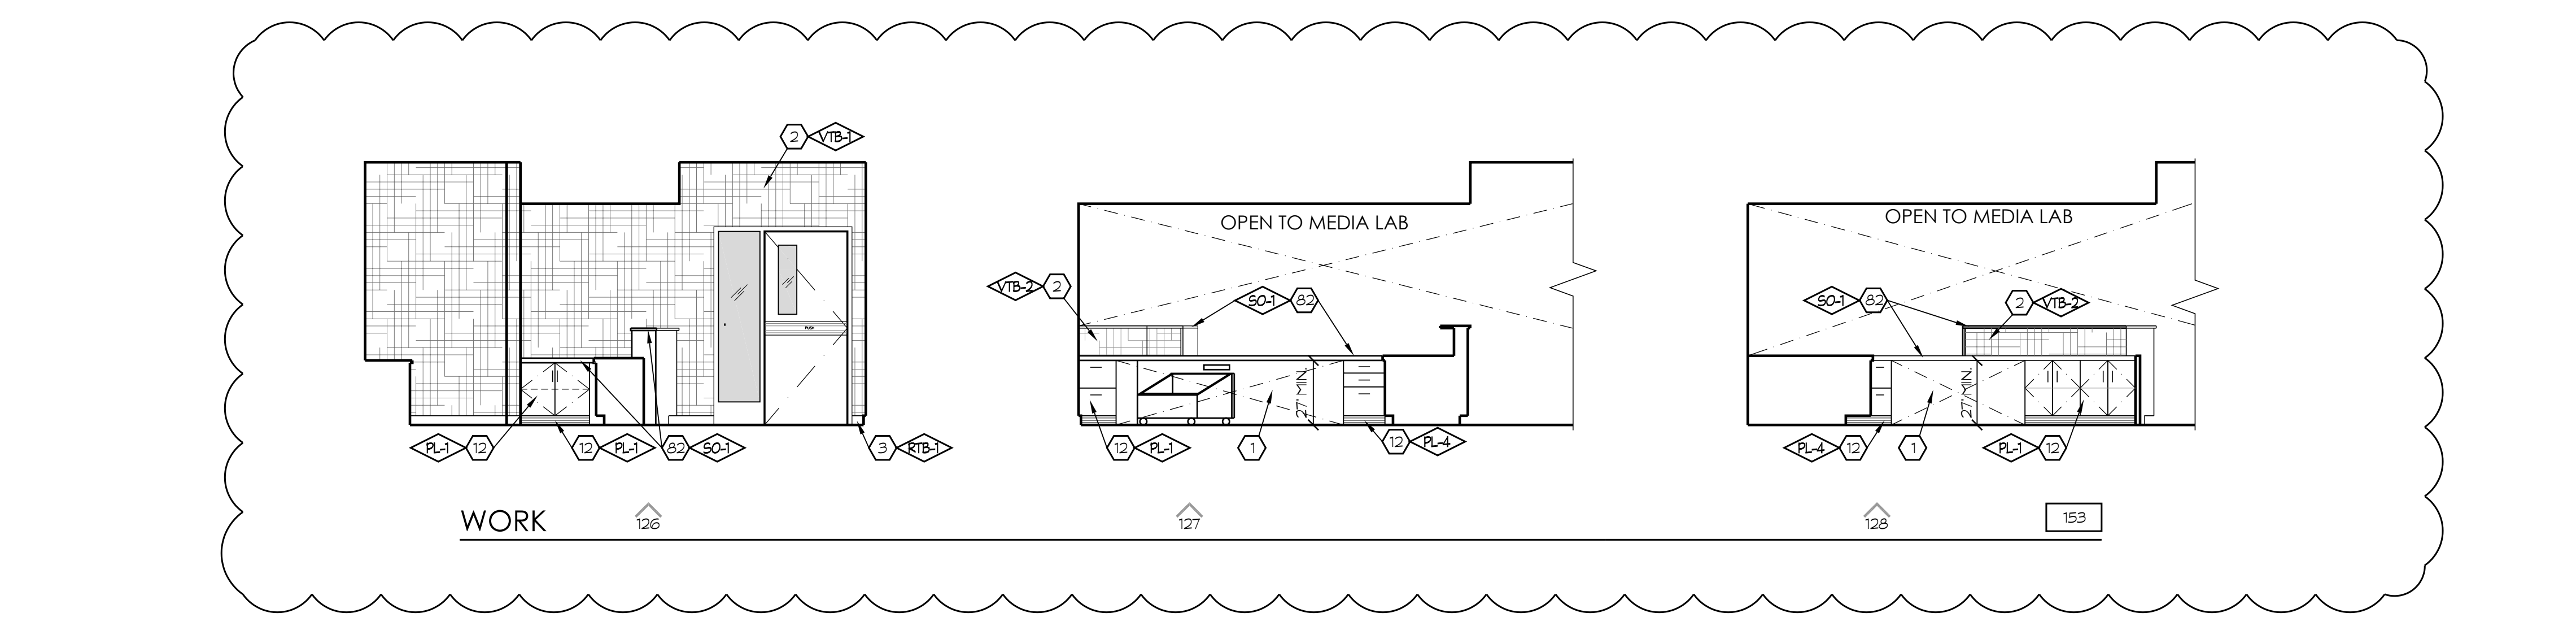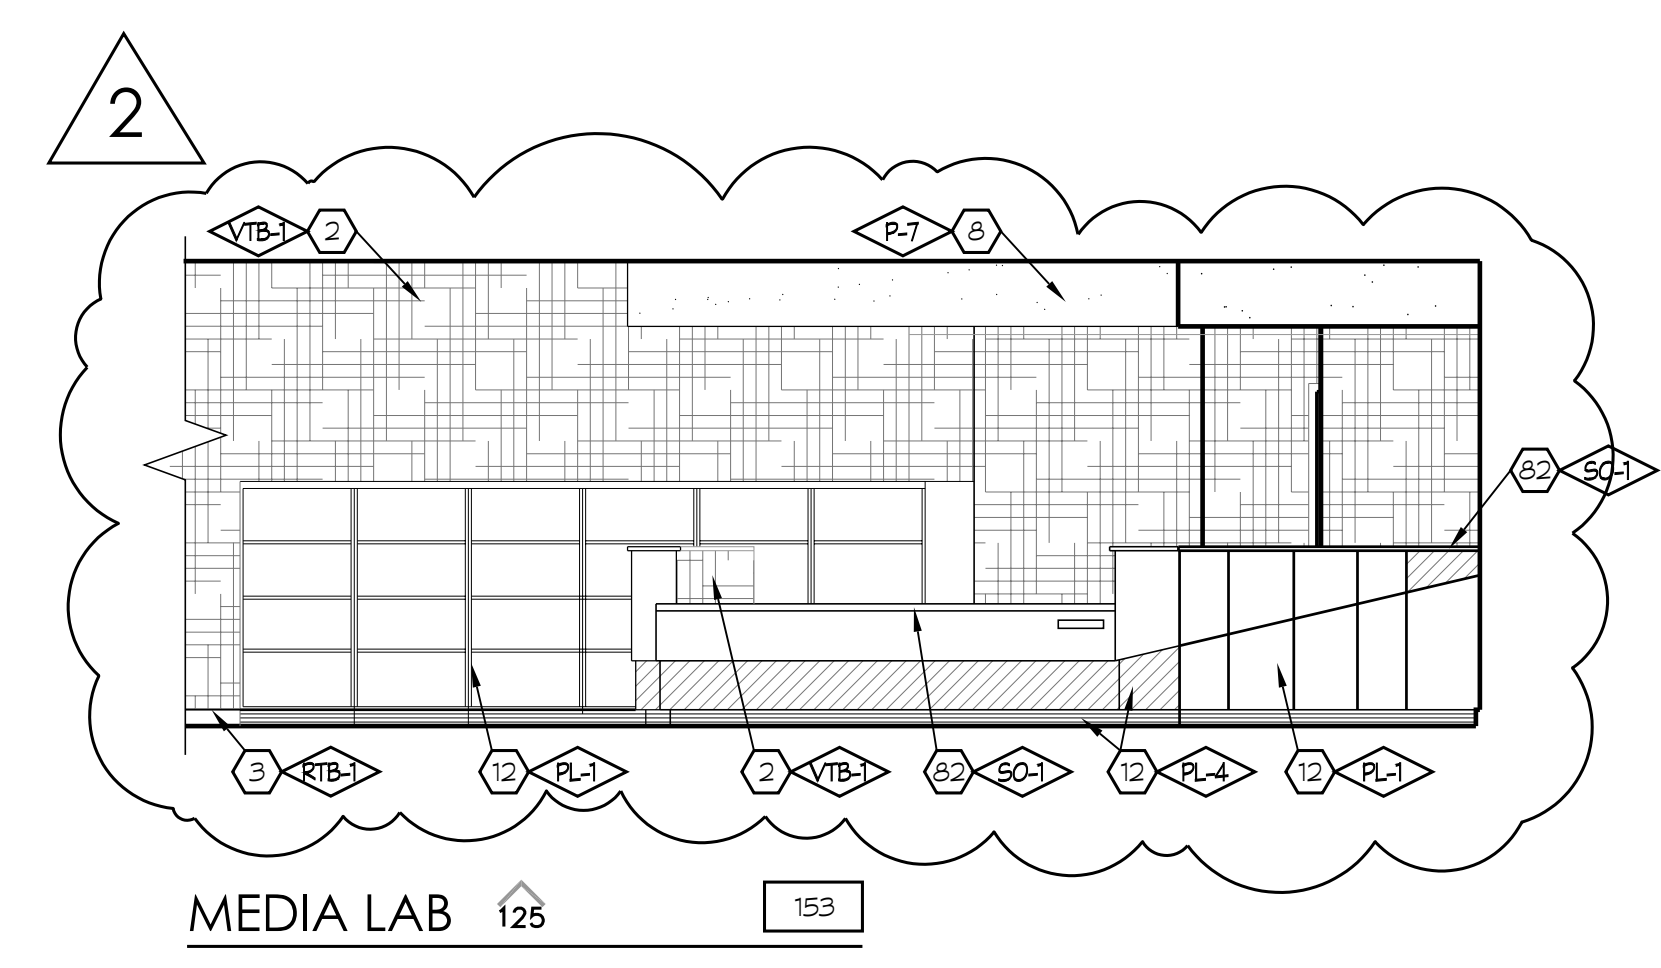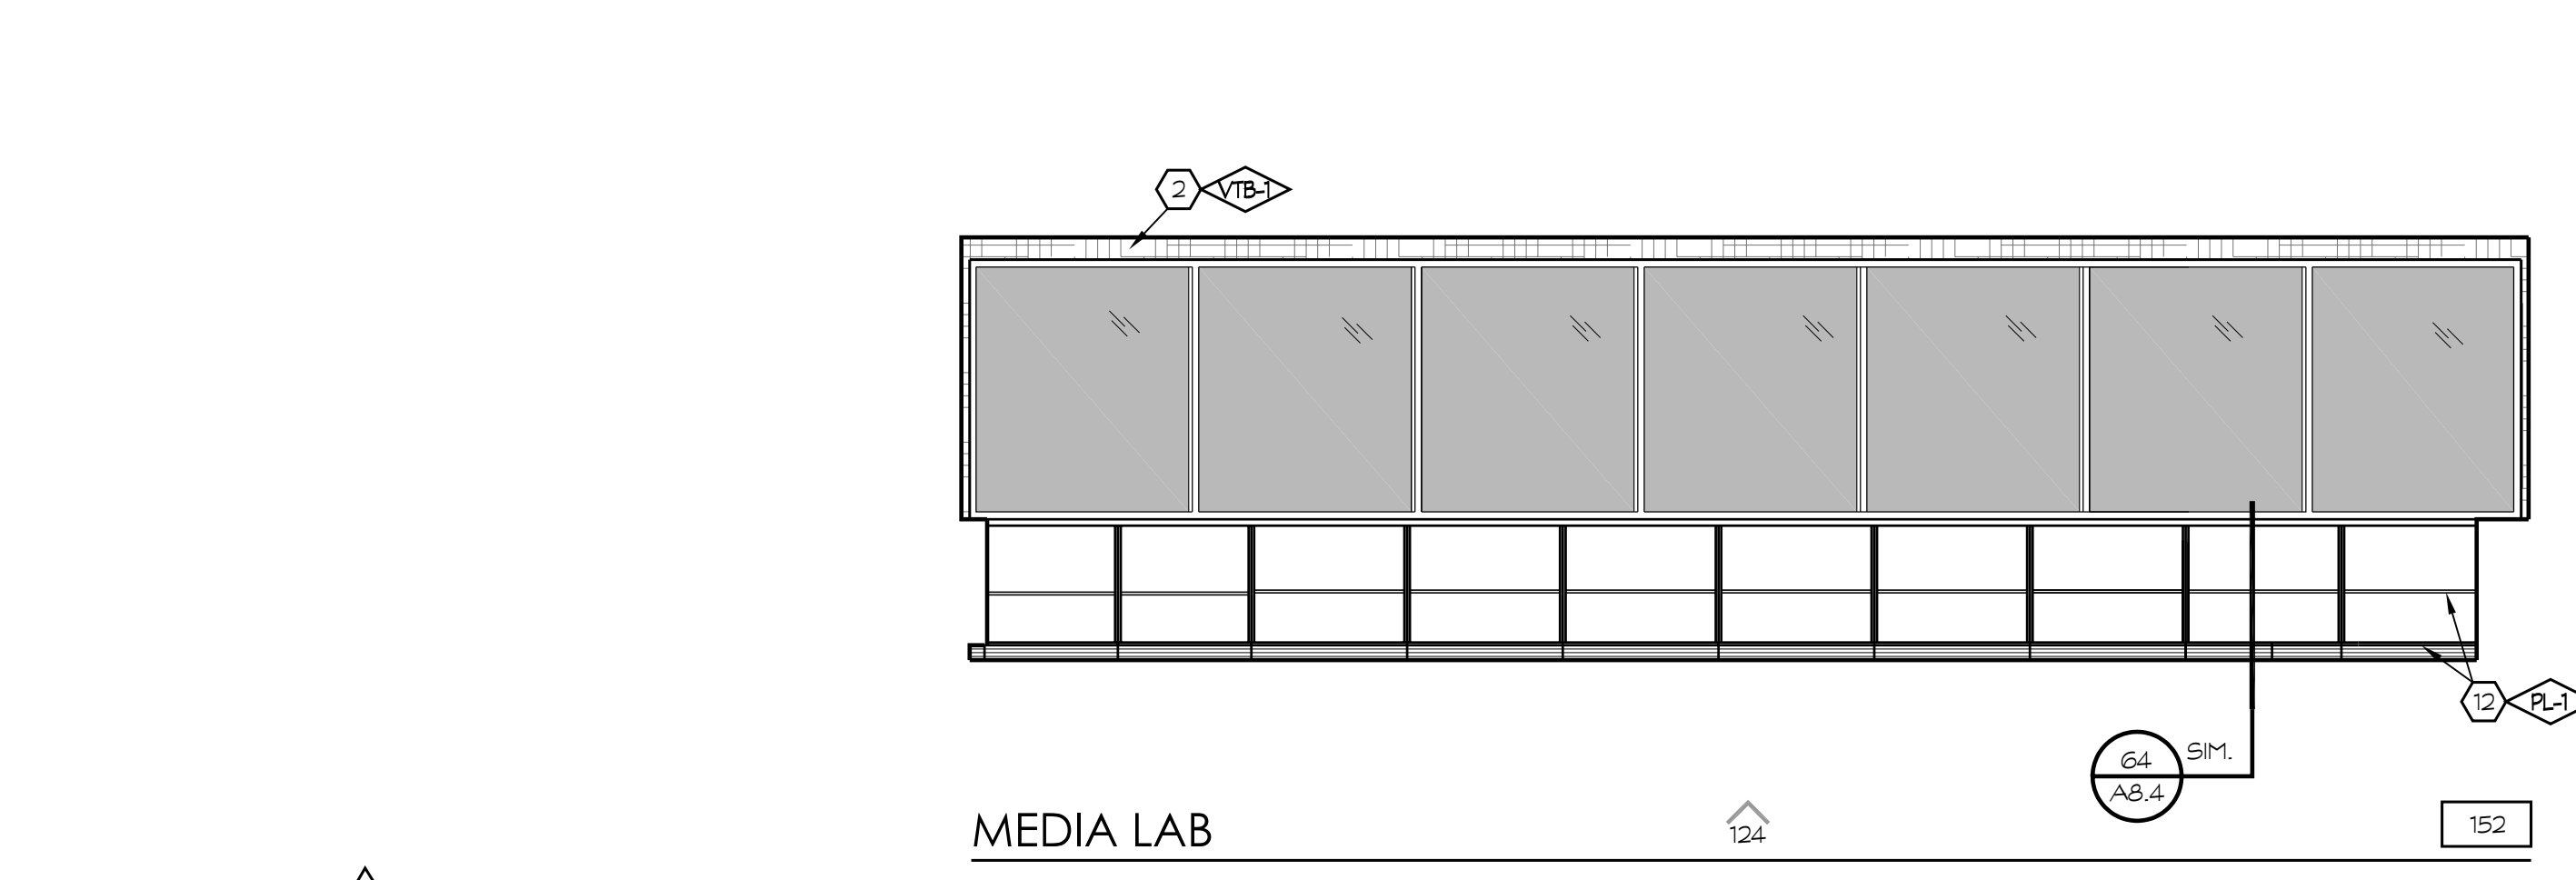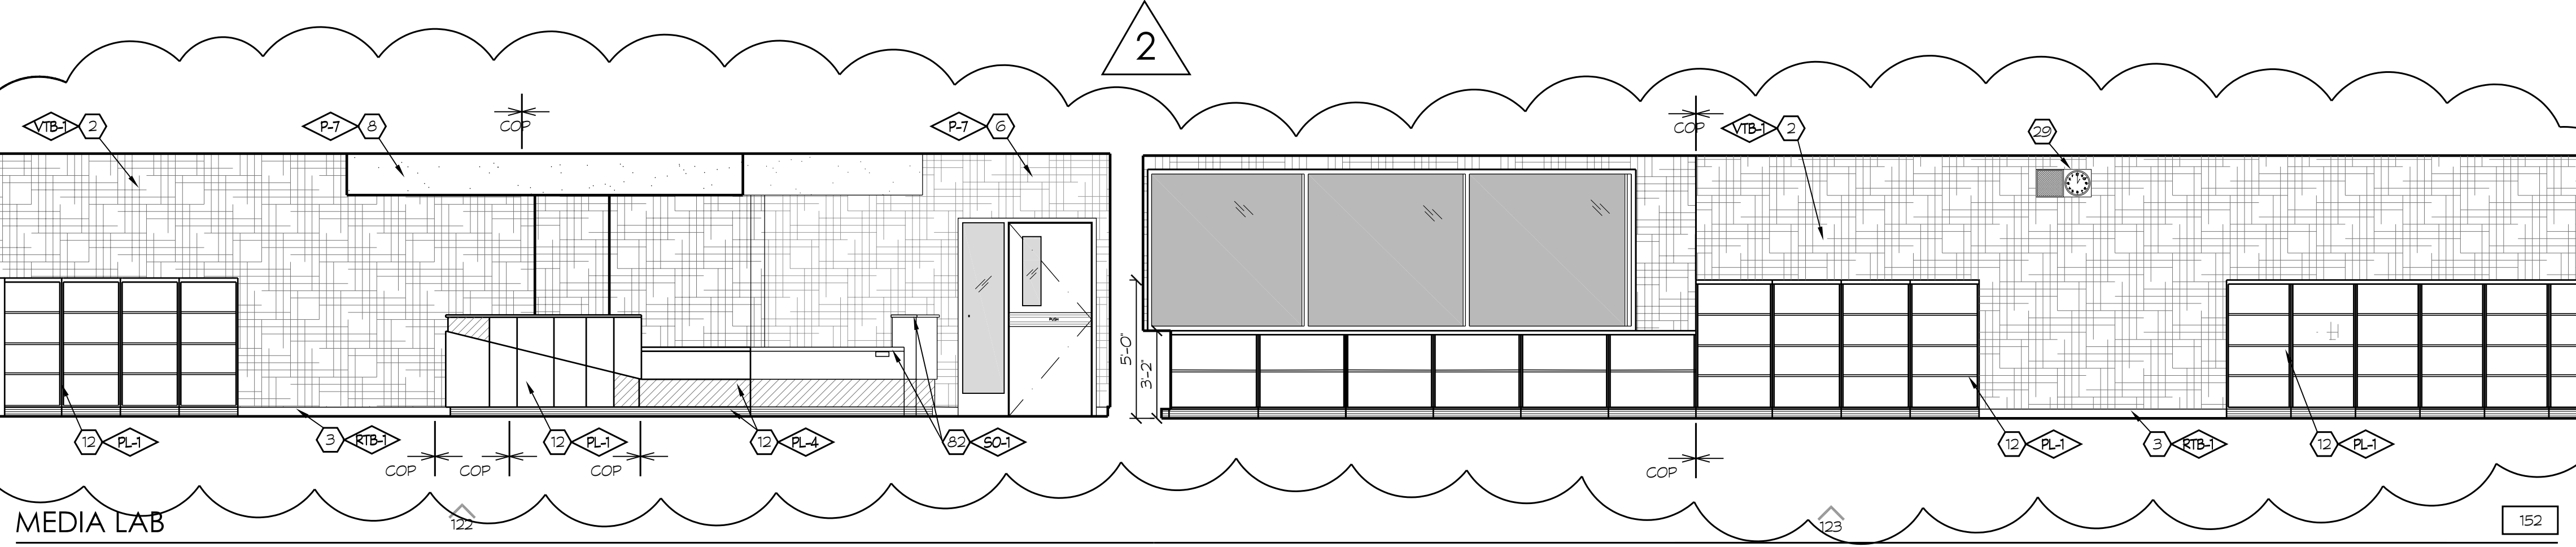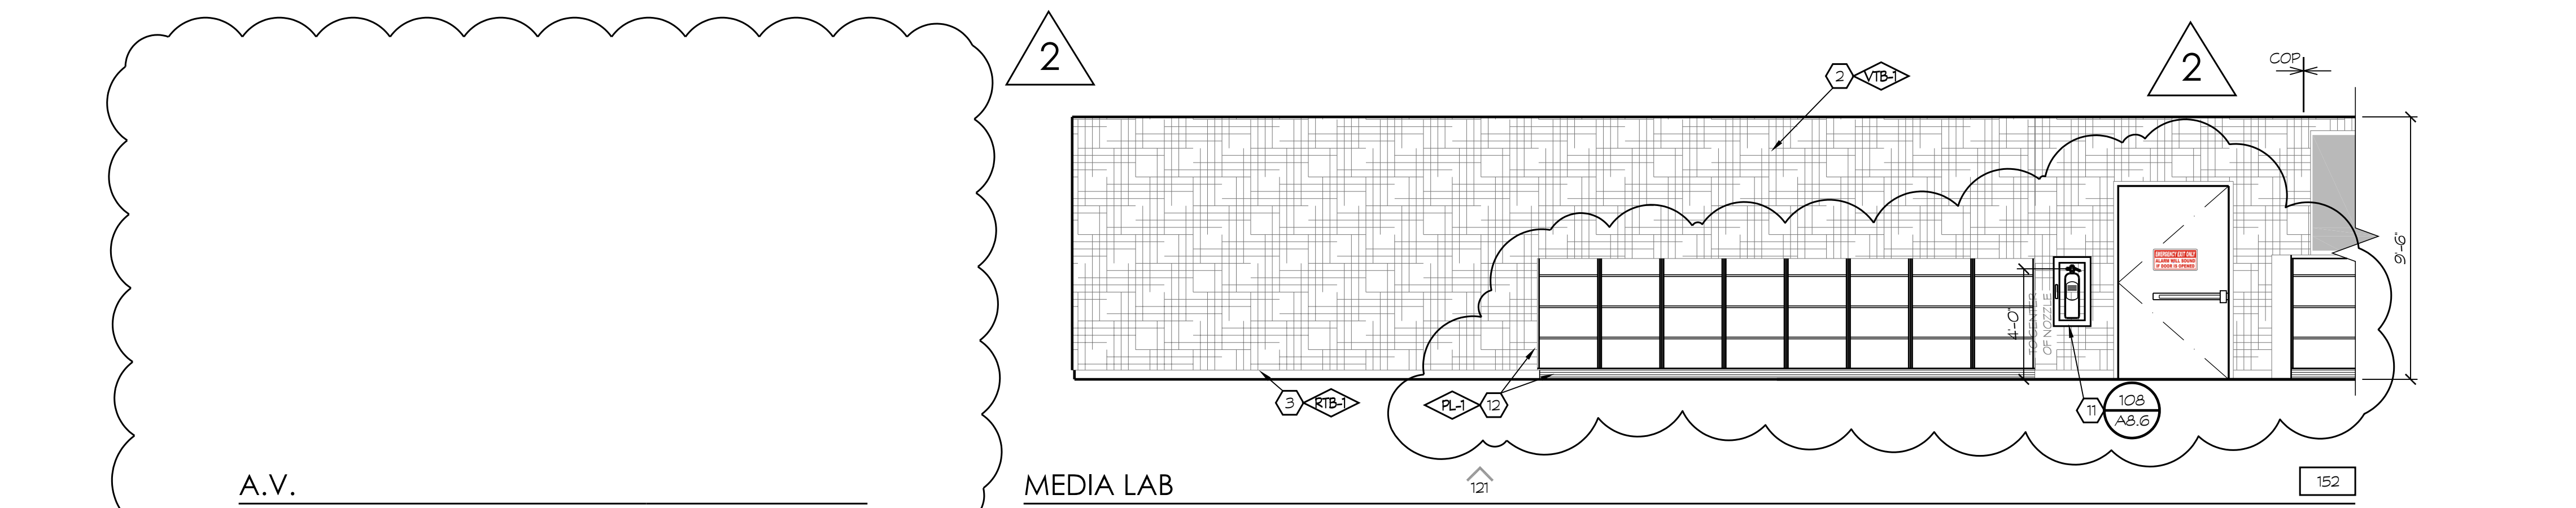

KEYNOTES

1. KNEE SPACE
 2. VINYL TACKBOARD w/ GYP. BD.
 3. RUBBER TOPSET BASE
 4. STOREFRONT
 5. PAPER TOWEL DISPENSER
 6. GYPSUM BOARD, TAPE, TEXTURE & PAINT (PROVIDE 5/8" TYPE X GYP. BD. AT STAIRWAYS AND UNDERSTAIR WALL/CEILING FINISHES, TYP.)
 7. ROOF ACCESS LADDER
 8. SOFFIT
 9. FLOOR SINK - SEE PLUMBING
 10. UNDER-COUNTER REFRIGERATOR
 11. FIRE EXTINGUISHER w/ SEMI RECESSED CAB. TYPE 2A10BC
 12. PLASTIC LAMINATE CASEWORK
 13. W.I.C. 400 STORAGE SHELVING
 14. FIBER REINFORCED PANEL
 15. PLASTIC LAMINATE BACKSPLASH & COUNTERTOP
 16. METAL POST, PER STRUCTURAL
 17. SINK - SEE PLUMBING SCHEDULE
 18. MAGNETIC MARKER BOARD o/VTB
 19. APPLIANCES - SEE SPEC SECTION 11400
 20. BUTCHER PAPER HOLDER
 21. DISHWASHER
 22. HOOD
 23. REFRIGERATOR - FULL HEIGHT
 24. COOKTOP
 25. ROLL-UP DOOR
 26. STAINLESS STEEL COUNTERTOP
 27. FURNITURE (N.I.C.)
 28. DRINKING FOUNTAIN
 29. CLOCK/SPEAKER
 30. CLEAR GLASS DISPLAY CASE w/ LOCK (SEE SPEC. SECT. 10410)
 31. FEMININE NAPKIN DISPOSAL
 32. MIRROR
 33. TRACK AND CUBICLE CURTAIN.
 34. STAIRCASE
 35. HANDRAIL
 36. N/A
 37. TRANSLUCENT WALL SYSTEM
 38. WOOD BASE
 39. WHEEL CHAIR LIFT
 40. BELOW STAGE STORAGE
 41. SHEET VINYL COVERED BASE
 42. ELEVATOR LANTELS
 43. RAILING, SPACING SHALL BE SUCH THAT A 4" DIA. SPHERE CANNOT PASS THROUGH ANY OPENING, PER CBC 1013
 44. CALL BUTTON
 45. ELEVATOR DOORS
 46. LAVATORY
 47. TOILET PAPER DISPENSER
 48. TOILET SEAT COVER DISPENSER
 49. DATA RACEWAY, SEE ELECTRICAL DRAWINGS.
 50. CLOCK
 51. 4" HIGH CORNER GUARD, TYP.
 52. SOAP DISPENSER
 53. PLASTIC TOILET PARTITION
 54. SIGNAGE
 55. SIGN MANUFACTURED 3"Wx8"H TNL. SHELVING, SEE 5-1K8.0
 56. SPEAKER ENCLOSURE AND GRILLE
 57. MOP/BROOM HOLDER
 58. PLASTIC LAM. DOOR, 1 1/2" THICK
 59. PROVIDE 3/4" LAM. PLASTIC SUPPORTS AT STOREFRONT, AT 4'-0" O.C.
 60. RAYTHEMS (N.I.C.)
 61. URINAL
 62. MICROWAVE (N.I.C.)
 63. PLASTIC LAMINATE CAP
 64. CERAMIC TILE
 65. GRAB BAR
 66. WATER CLOSET
 67. METAL LETTERS (SEE SPECS)
 68. PONY WALL BEHIND
 69. ROOM CAPACITY SIGN
 70. TECTUM PANELS
 71. 2x3 SHAPED WOOD NAILER
 72. UTILITY BOX
 73. MOVABLE ROD TO BE PLACED AT 44" FOR ADA COMPLIANCE, OPTIONAL.
 74. MOTORIZED SCREEN, SEE 1A3/AB.8
 75. PLASTIC LAMINATE PANELING AND DOORS
 76. WINDOW WALL, SEE T2 FOR DEFERRED ITEMS
 77. CLEAR GLASS POSTER CASE w/ LOCK (SEE SPEC. SECT. 10410)
 78. 1/2" REVEAL SCREDS
 79. WALL CLOCK, SEE SPEC SECTION 10050
 80. MICROWAVE OVEN
 81. PLASTIC LAMINATE COUNTERTOP
 82. SOLID SURFACE COUNTERTOP
 83. PERFORATED DECORATIVE METAL PANEL
 84. WALL PROTECTION PANEL
 85. ICE MACHINE
 86. CARPET BASE
 87. 100" TACK STRIPS, 12" LONG BY WALLTALKERS OR EQUAL
 88. CORNER GUARD
 89. STRUCTURAL MEMBER TO BE PAINTED, SEE STRUCTURAL
 90. COVERED BASE
 91. CASEWORK
 92. TAC-WALL
- NOTES:
1. SEE DTL 219/AB.11 FOR ACCESSIBILITY STANDARDS
 2. ALL SHELVING WITH SPANS (GREATER THAN 30" TO BE 1" THICK
 3. REFER TO COLOR SCHEDULE (SHEET A2.8) FOR ALL COLOR REFERENCES, TYP.
 4. ALL CARPET USES A CARPET BASE #86
 - ALL MONDO RUBBER FLOORS USE A RUBBER TOPSET BASE #3
 - ALL AHRO FLOORS USE SELF-COVER BASE #41
 - ALL STAINED & DYED CONCRETE FLOORS USE TOPSET #3

SYMBOL LEGEND

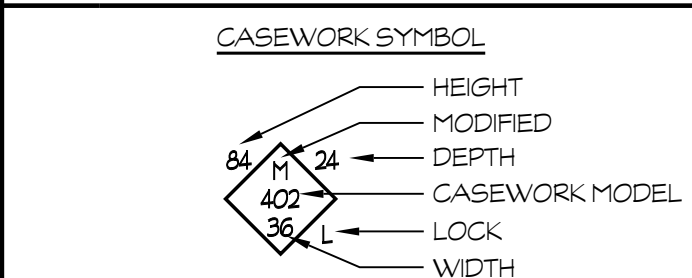

GENERAL NOTES

1. RECESSED CLOCKS AND/OR SPEAKERS ARE PROHIBITED IN FIRE RATED WALLS WHERE OPENING PROTECTION IS REQUIRED.




7790 NORTH PALM AVENUE
 FRESNO, CALIFORNIA 93711
 T 559.448.8400 F 559.448.8467
 www.sfrm-pbk.com

PROJECT:
SHIELDS & BRAWLEY ELEMENTARY SCHOOL



AD 2-25a
S&B Elementary
02-116800

JOHN H. SMITH, A.I.A. C15885

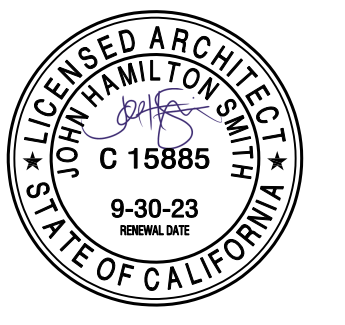

THE FIRM OF SMITH, WATANAGA, MILHOUS, ARCHITECTS, INC. EXPRESSLY RESERVES ITS COMMON LAW COPYRIGHT AND OTHER APPLICABLE PROPERTY RIGHTS IN THESE PLANS. THESE PLANS ARE NOT TO BE REPRODUCED, CHANGED, OR COPIED IN ANY FORM OR MANNER WHATSOEVER, NOR ARE THEY TO BE ASSIGNED TO A THIRD PARTY WITHOUT FIRST OBTAINING THE WRITTEN PERMISSION AND CONSENT OF THE ARCHITECT. IN THE EVENT OF UNAUTHORIZED REUSE OF THESE PLANS BY A THIRD PARTY, THE THIRD PARTY SHALL HOLD THE ARCHITECT HARMLESS, AND SHALL BEAR THE COST OF THE ARCHITECT'S LEGAL FEES, ASSOCIATED WITH DEFENDING AND ENFORCING THESE RIGHTS.

PROJECT DEVELOPMENT


| DATE | ISSUED FOR |
|------|------------|
| | |
| | |
| | |
| | |

REVISIONS

| No. | DATE | DESCRIPTION |
|-----|---------|------------------------|
| △ 1 | 2.14.23 | DISTRICT MODIFICATIONS |
| △ 2 | 2.27.23 | DISTRICT MODIFICATIONS |


SHEET DESCRIPTION

| | |
|-----------------------------------|-------------|
| INTERIOR ELEVATIONS | |
| MAIN - 1ST FLOOR | |
| PROJECT COORDINATOR JOHN SMITH | SHEET NO. |
| PROJECT NO. 17-67 | A5.8 |
| DATE 1.27.23 | |
| SCALE 1/4" = 1'-0" | |

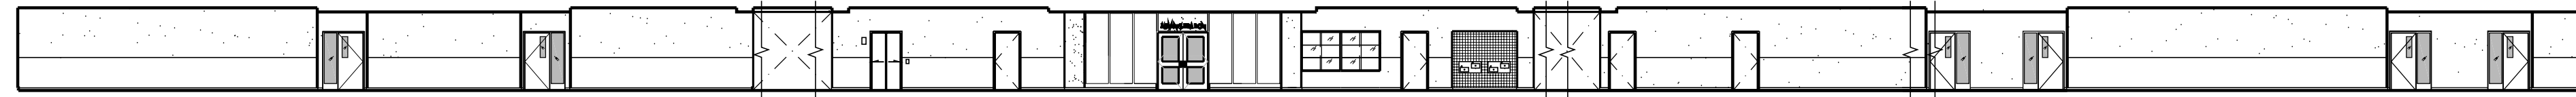


CORRIDOR

SCALE: 1/16"=1'-0"

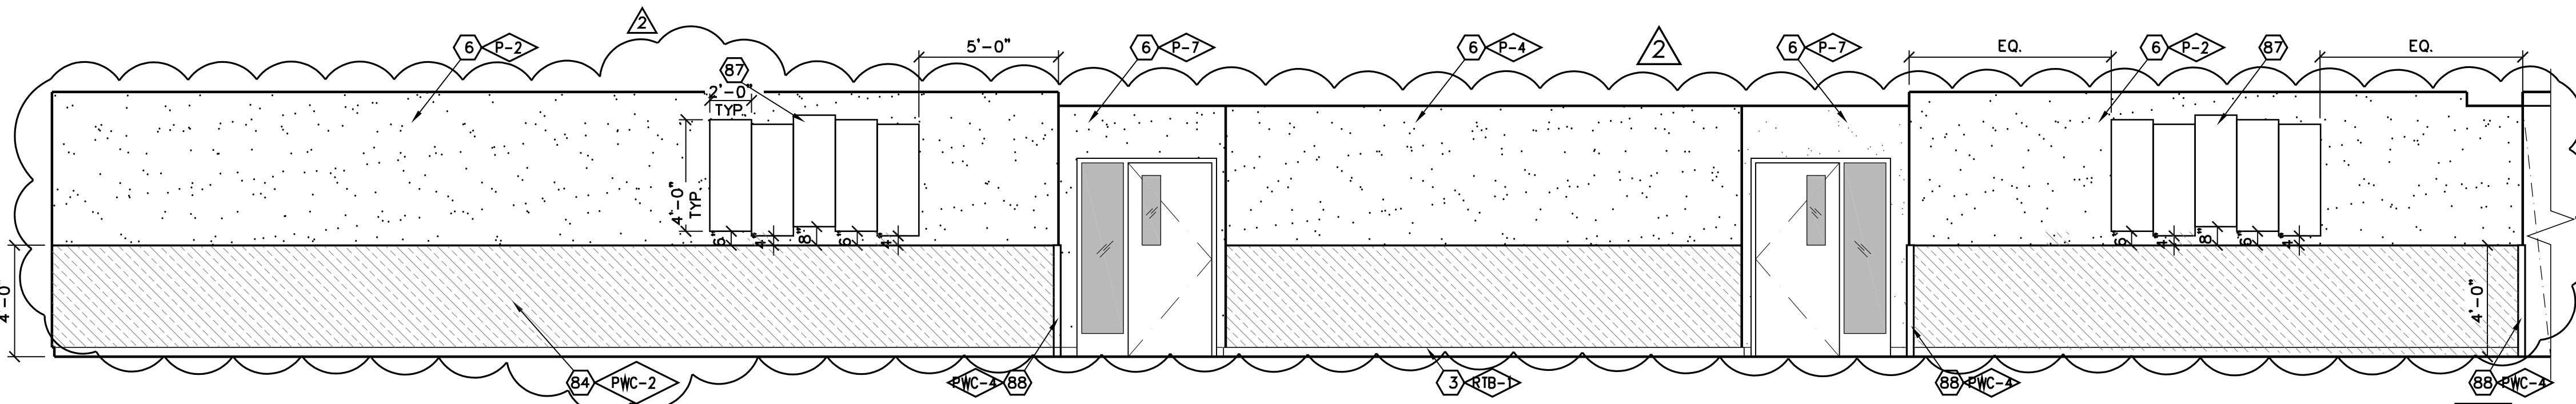


CORRIDOR SOUTH ELEVATION

SCALE: 1/4"=1'-0"

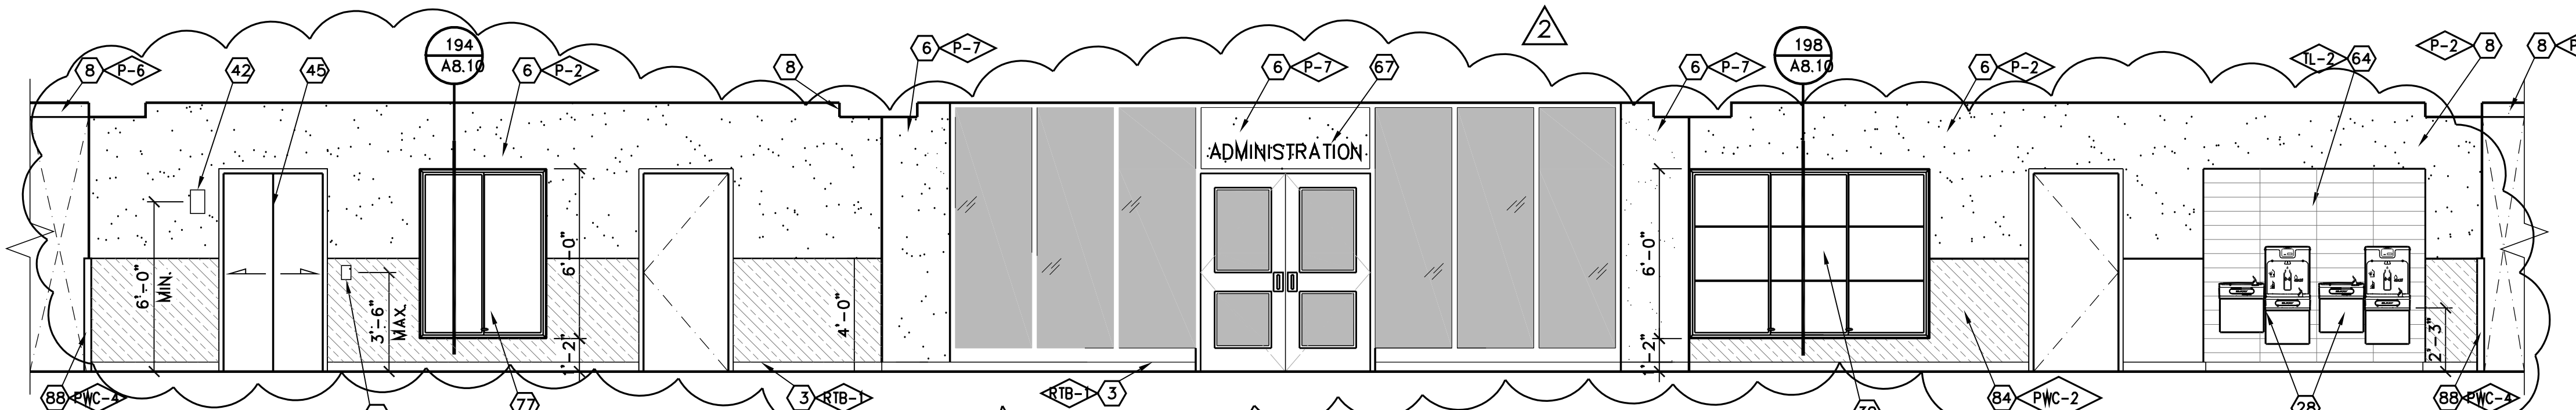


CORRIDOR PARTIAL SOUTH ELEVATION

SCALE: 1/4"=1'-0"

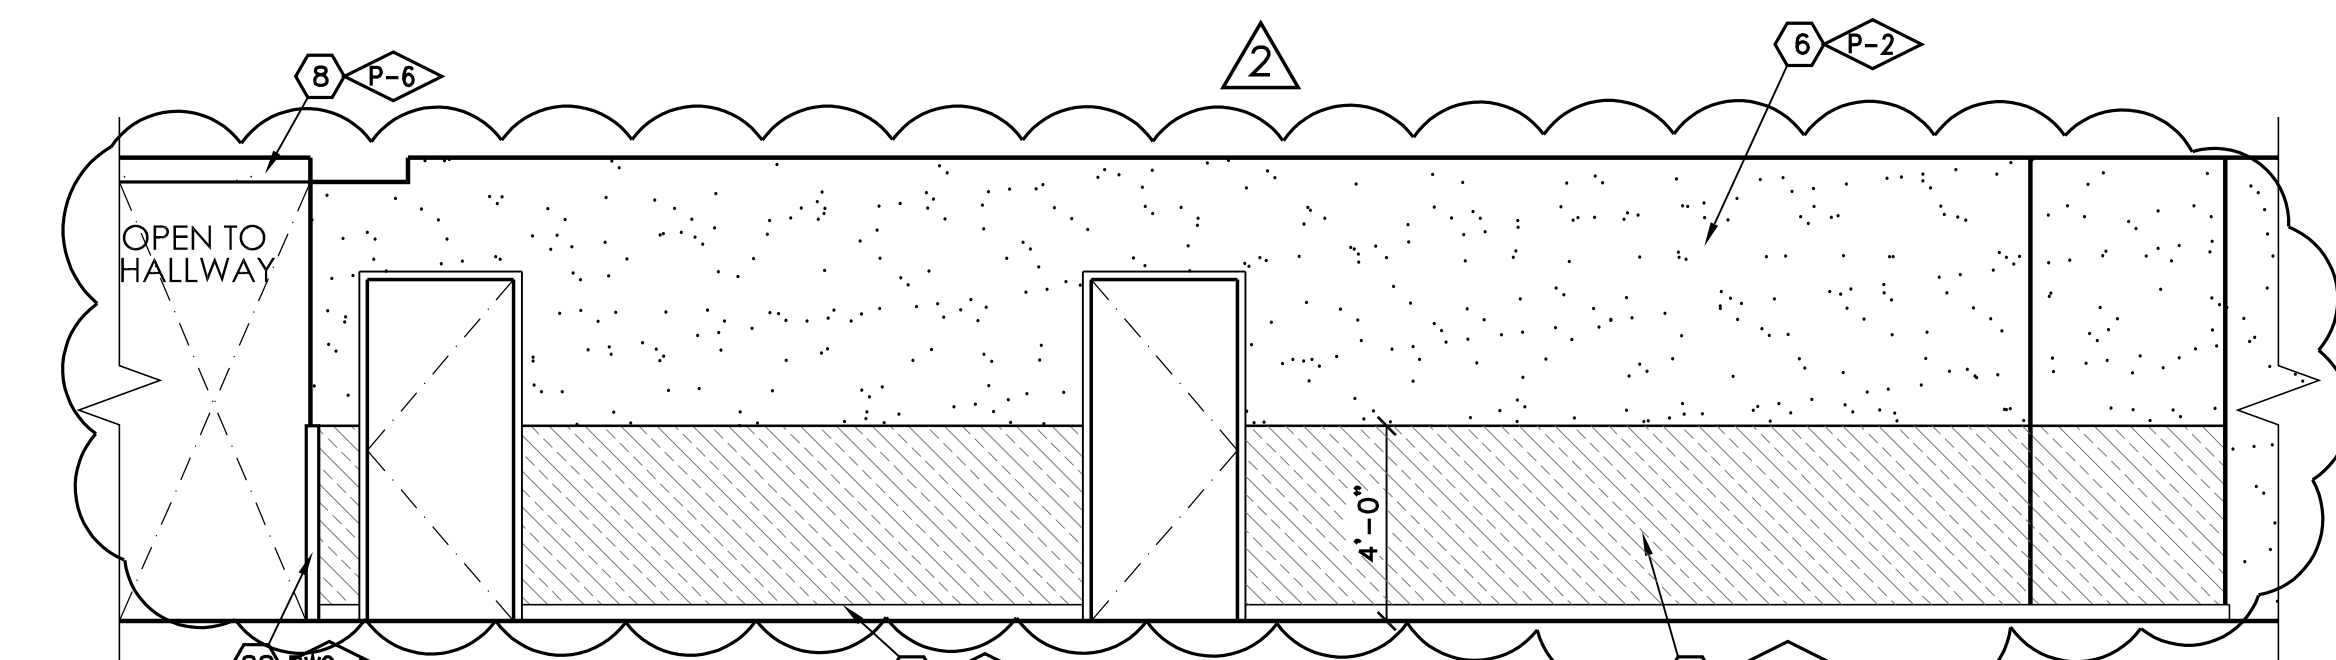

CORRIDOR PARTIAL SOUTH ELEVATION

SCALE: 1/4"=1'-0"

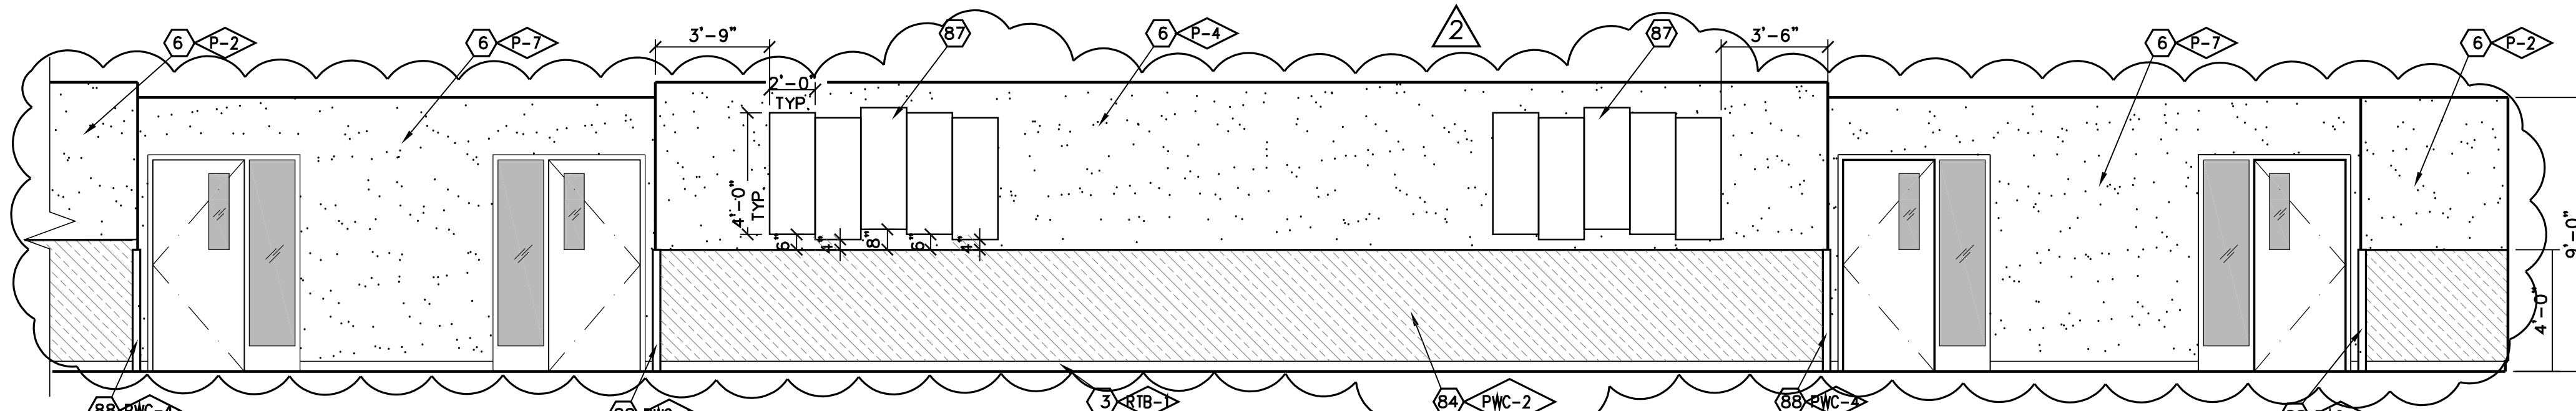

CORRIDOR PARTIAL SOUTH ELEVATION


SCALE: 1/4"=1'-0"

KEYNOTES

1. KNEE SPACE
2. VINYL TACKBOARD o/ GYP. BD.
3. RUBBER TOPSET BASE
4. STOREFRONT
5. PAPER TOWEL DISPENSER
6. GYPSUM BOARD, TAPE, TEXTURE & PAINT (PROVIDE 5/8" TYPE 'X' GYP. BD. AT STAIRWAYS AND UNDERSTAIR WALL/CEILING FINISHES, TYP.)
7. ROOF ACCESS LADDER
8. SOFFIT
9. FLOOR SINK - SEE PLUMBING
10. UNDER-COUNTER REFRIGERATOR
11. FIRE EXTINGUISHER w/ SEMI RECESSED CAB. TYPE 2A:10BC
12. PLASTIC LAMINATE CASEWORK
13. W.I.C. 400 STORAGE SHELVING
14. FIBER REINFORCED PANEL
15. PLASTIC LAMINATE BACKSPASH & COUNTERTOP
16. METAL POST, PER STRUCTURAL
17. SINK - SEE PLUMBING SCHEDULE
18. MAGNETIC MARKER BOARD o/VTB
19. APPLIANCES - SEE SPEC SECTION 11400
20. BUTCHER PAPER HOLDER
21. DISHWASHER
22. HOOD
23. REFRIGERATOR - FULL HEIGHT
24. COOKTOP
25. ROLL-UP DOOR
26. STAINLESS STEEL COUNTERTOP
27. FURNITURE (N.I.C.)
28. DRINKING FOUNTAIN
29. CLOCK/SPEAKER
30. CLEAR GLASS DISPLAY CASE w/ LOCK (SEE SPEC. SECT. 10410)
31. FEMININE NAPKIN DISPOSAL
32. MIRROR
33. TRACK AND CUBICLE CURTAIN.
34. STAIRCASE
35. HANDRAIL
36. N/A
37. TRANSLUCENT WALL SYSTEM
38. WOOD BASE
39. WHEEL CHAIR LIFT
40. BELOW STAGE STORAGE
41. SHEET VINYL COVED BASE
42. ELEVATOR LANTERN
43. RAILING, SPACING SHALL BE SUCH THAT A 4" DIA. SPHERE CANNOT PASS THROUGH ANY OPENING, PER CBC 1013
44. CALL BUTTON
45. ELEVATOR DOORS
46. LAVATORY
47. TOILET PAPER DISPENSER
48. TOILET SEAT COVER DISPENSER
49. DATA RACEWAY. SEE ELECTRICAL DRAWINGS.
50. CLOCK
51. 4" HIGH CORNER GUARD, TYP.
52. SOAP DISPENSER
53. PLASTIC TOILET PARTITION
54. SIGNAGE
55. MANUFACTURED 3'x6'x6" MTL. SHELVING, SEE S-1/K8.0
56. SPEAKER ENCLOSURE AND GRILLE
57. MOP/BROOM HOLDER
58. PLASTIC LAM. DOOR, 1 1/2" THICK
59. PROVIDE 3/4" LAM. PLASTIC SUPPORTS AT STOREFRONT, AT 4'-0" O.C.
60. RAYTHERMS (N.I.C.)
61. URINAL
62. MICROWAVE (N.I.C.)
63. PLASTIC LAMINATE CAP
64. CERAMIC TILE
65. GRAB BAR
66. WATER CLOSET
67. METAL LETTERS (SEE SPECS)
68. PONY WALL BEHIND
69. ROOM CAPACITY SIGN
70. TECTUM PANELS
71. 2x3 SHAPED WOOD NAILER
72. UTILITY BOX
73. MOVABLE ROD TO BE PLACED AT 44" FOR ADA COMPLIANCE. OPTIONAL.
74. MOTORIZED SCREEN, SEE 143/A8.8
75. PLASTIC LAMINATE PANELING AND DOORS
76. WINDOW WALL - SEE T2 FOR DEFERRED ITEMS
77. CLEAR GLASS POSTER CASE w/LOCK (SEE SPEC. SECT. 10410)
78. 1/2" REVEAL SCREEDS
79. WALL CLOCK, SEE SPEC SECTION 10050
80. MICROWAVE OVEN
81. PLASTIC LAMINATE COUNTERTOP
82. SOLID SURFACE COUNTERTOP
83. PERFORATED DECORATIVE METAL PANEL
84. WALL PROTECTION PANEL
85. ICE MACHINE
86. CARPET BASE
87. (5) 24"x48" TACKBOARD PANELS. SEE COLOR SCHEDULE REMARK 13/A2.8
88. CORNER BOARD
89. STRUCTURAL MEMBER TO BE PAINTED, SEE STRUCTURAL
90. COVED BASE
91. CASEWORK
92. TAC-WALL
93. 75" MONITOR WITH
94. MONITOR CONTROL DEVICE & HDMI DEVICES. DISTRICT WILL VERIFY LOCATION
95. WALL MOUNTED SPEAKERS. DISTRICT TO VERIFY LOCATION.

- NOTES:
1. SEE DTL. 219/A8.11 FOR ACCESSIBILITY STANDARDS
 2. ALL SHELVING WITH SPANS GREATER THAN 30" TO BE 1" THICK REFERENCES, TYP.
 3. REFER TO COLOR SCHEDULE (SHEET A2.8) FOR ALL COLOR
 4. ALL CARPET USES A CARPET BASE #86
 5. ALL MONDO RUBBER FLOORS USE A RUBBER TOPSET BASE #3
 6. ALL AHRU FLOORS USE SELF-COVER BASE #41
 7. ALL STAINED & DYED CONCRETE FLOORS USE TOPSET #3

SYMBOL LEGEND

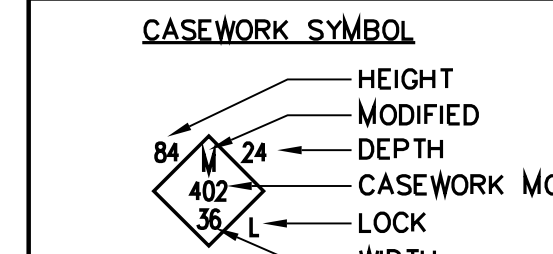

GENERAL NOTES

1. RECESSED CLOCKS AND/OR SPEAKERS ARE PROHIBITED IN FIRE RATED WALLS WHERE OPENING PROTECTION IS REQUIRED.



7790 NORTH PALM AVENUE
 FRESNO, CALIFORNIA 93711
 T559.448.8400 F559.448.8467
 www.slm-bbk.com

PROJECT:
SHIELDS & BRAWLEY ELEMENTARY SCHOOL



AD 2-26a
S&B Elementary
02-116800



THE FIRM OF SMITH, IWANAGA, MILHOUSE, ARCHITECTS, INC. EXPRESSLY RESERVES ITS COMMON LAW COPYRIGHT AND OTHER APPLICABLE PROPERTY RIGHTS IN THESE PLANS. THESE PLANS ARE NOT TO BE REPRODUCED, CHANGED, OR COPIED IN ANY FORM OR MANNER WHATSOEVER, NOR ARE THEY TO BE ASSIGNED TO A THIRD PARTY WITHOUT FIRST OBTAINING THE WRITTEN PERMISSION AND CONSENT OF THE ARCHITECT. IN THE EVENT OF UNAUTHORIZED REUSE OF THESE PLANS BY A THIRD PARTY, THE THIRD PARTY SHALL HOLD THE ARCHITECT HARMLESS, AND SHALL BEAR THE COST OF THE ARCHITECT'S LEGAL FEES ASSOCIATED WITH DEFENDING AND ENFORCING THESE RIGHTS.

PROJECT DEVELOPMENT


| DATE | ISSUED FOR |
|------|------------|
| | |
| | |
| | |

REVISIONS


| No. | DATE | DESCRIPTION |
|-----|---------|------------------------|
| 2 | 2.14.23 | DISTRICT MODIFICATIONS |
| 3 | 2.27.23 | DISTRICT MODIFICATIONS |
| | | |
| | | |

SHEET DESCRIPTION


| ELEVATIONS | |
|--|--------------------------|
| MAIN - 1ST FLOOR | |
| PROJECT COORDINATOR JOHN SMITH | SHEET NO. A5.9 |
| PROJECT NO. 17-67 | DATE 1.27.23 |
| SCALE 1/4"=1'-0" | |

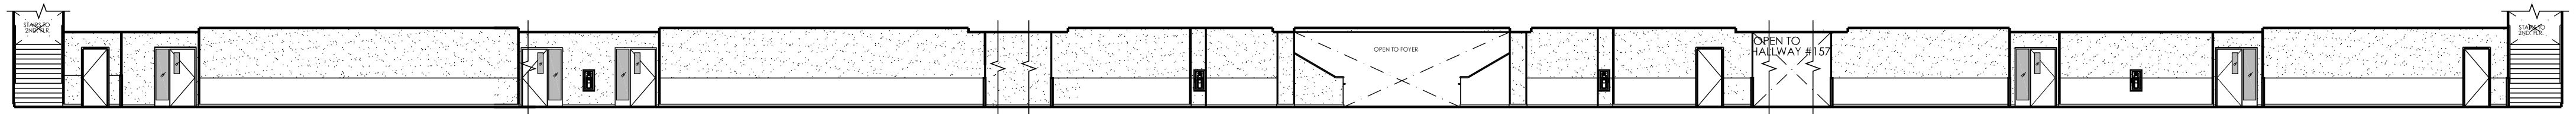


CORRIDOR NORTH ELEVATION SCALE 1/16"=1'-0"

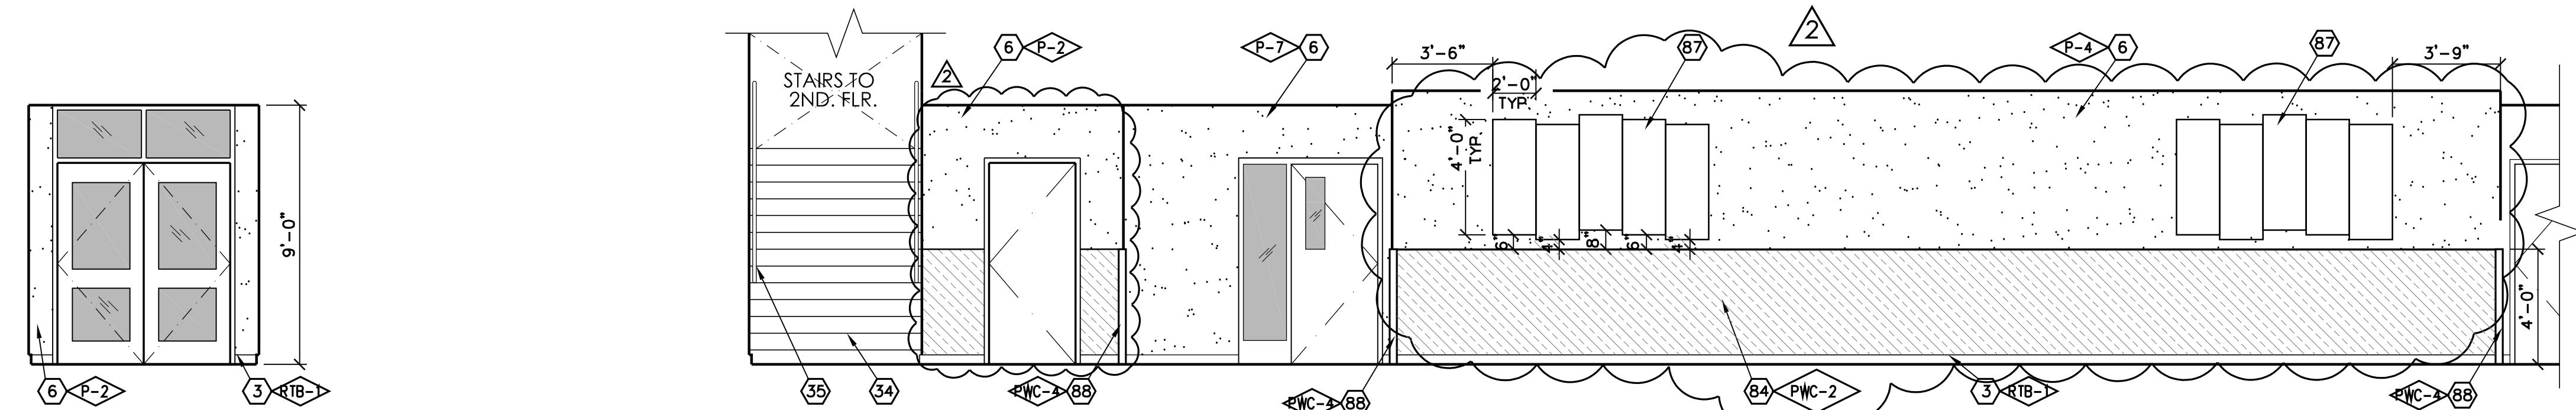


CORRIDOR PARTIAL NORTH ELEVATION SCALE 1/4"=1'-0"

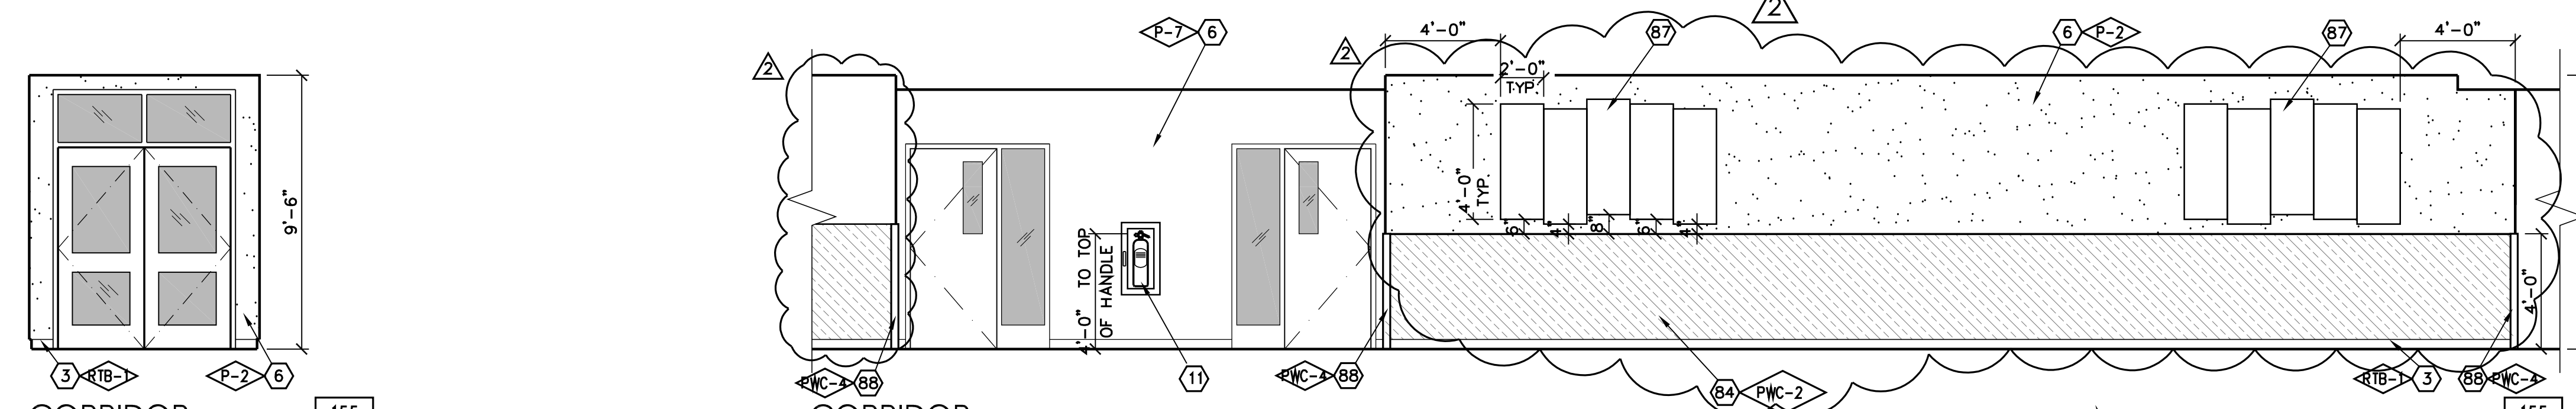

CORRIDOR PARTIAL NORTH ELEVATION SCALE 1/4"=1'-0"

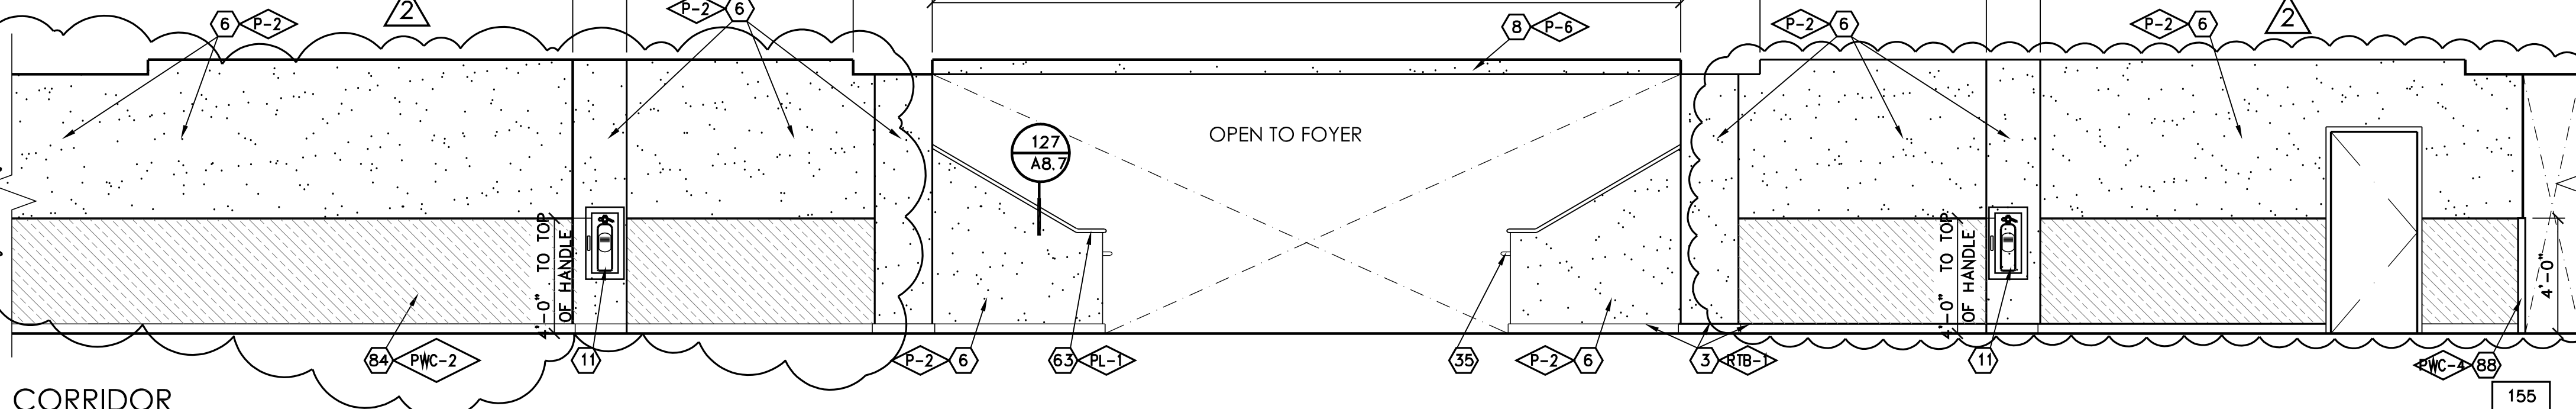

CORRIDOR PARTIAL NORTH ELEVATION SCALE 1/4"=1'-0"

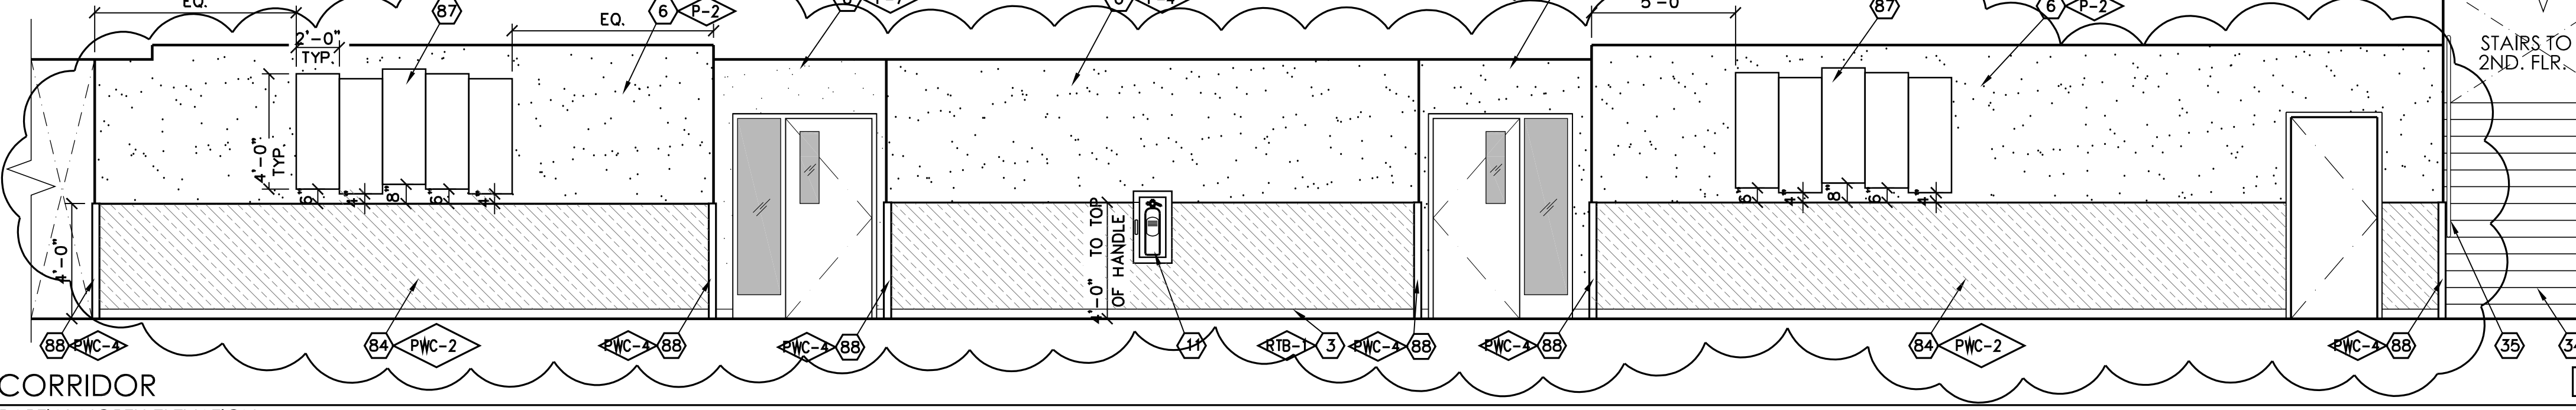

CORRIDOR PARTIAL NORTH ELEVATION SCALE 1/4"=1'-0"

- KNEE SPACE
- VINYL TACKBOARD o/ GYP. BD.
- RUBBER TOPSET BASE
- STOREFRONT
- PAPER TOWEL DISPENSER
- GYPSUM BOARD, TAPE, TEXTURE & PAINT (PROVIDE 5/8" TYPE 'X' GYP. BD. AT STAIRWAYS AND UNDERSTAIR WALL/CEILING FINISHES, TYP.)
- ROOF ACCESS LADDER
- SOFFIT
- FLOOR SINK - SEE PLUMBING
- UNDER-COUNTER REFRIGERATOR
- FIRE EXTINGUISHER w/ SEMI RECESSED CAB. TYPE 2A:10BC
- PLASTIC LAMINATE CASEWORK
- W.I.C. 400 STORAGE SHELVING
- FIBER REINFORCED PANEL
- PLASTIC LAMINATE BACKSPLASH & COUNTERTOP
- METAL POST, PER STRUCTURAL
- SINK - SEE PLUMBING SCHEDULE
- MAGNETIC MARKER BOARD o/VIB
- APPLIANCES - SEE SPEC SECTION 11400
- BUTCHER PAPER HOLDER
- DISHWASHER
- HOOD
- REFRIGERATOR - FULL HEIGHT
- COOKTOP
- ROLL-UP DOOR
- STAINLESS STEEL COUNTERTOP
- FURNITURE (N.I.C.)
- DRINKING FOUNTAIN
- CLOCK/SPEAKER
- CLEAR GLASS DISPLAY CASE w/ LOCK (SEE SPEC. SECT. 10410)
- FEMINE NAPKIN DISPOSAL
- MIRROR
- TRACK AND CUBICLE CURTAIN.
- STAIRCASE
- HANDRAIL
- N/A
- TRANSLUCENT WALL SYSTEM
- WOOD BASE
- WHEEL CHAIR LIFT
- BELOW STAGE STORAGE
- SHEET VINYL COVED BASE
- ELEVATOR LANTERN
- RAILING, SPACING SHALL BE SUCH THAT A 4" DIA. SPHERE CANNOT PASS THROUGH ANY OPENING, PER CBC 1013
- CALL BUTTON
- ELEVATOR DOORS
- LAVATORY
- TOILET PAPER DISPENSER
- TOILET SEAT COVER DISPENSER
- DATA RACEWAY. SEE ELECTRICAL DRAWINGS.
- CLOCK
- 4" HIGH CORNER GUARD, TYP.
- SOAP DISPENSER
- PLASTIC TOILET PARTITION
- SIGNAGE
- MANUFACTURED 3"Wx6"H MTL. SHELVING, SEE S-1/K8.0
- SPEAKER ENCLOSURE AND GRILLE
- MOP/BROOM HOLDER
- PLASTIC LAM. DOOR, 1 1/2" THICK
- PROVIDE 3/4" LAM. PLASTIC SUPPORTS AT STOREFRONT, AT 4'-0" O.C.
- RAYTHERMS (N.I.C.)
- URINAL
- MICROWAVE (N.I.C.)
- PLASTIC LAMINATE CAP
- CERAMIC TILE
- GRAB BAR
- WATER CLOSET
- METAL LETTERS (SEE SPECS)
- PONY WALL BEHIND
- ROOM CAPACITY SIGN
- TECTUM PANELS
- 2x3 SHAPED WOOD NAILER
- UTILITY BOX
- MOVABLE ROD TO BE PLACED AT 44" FOR ADA COMPLIANCE, OPTIONAL.
- MOTORIZED SCREEN, SEE 143/A8.8
- PLASTIC LAMINATE PANELING AND DOORS
- WINDOW WALL, SEE T2 FOR DEFERRED ITEMS
- CLEAR GLASS POSTER CASE w/LOCK (SEE SPEC. SECT. 10410)
- 1/2" REVEAL SCREEDS
- WALL CLOCK, SEE SPEC SECTION 10050
- MICROWAVE OVEN
- PLASTIC LAMINATE COUNTERTOP
- SOLID SURFACE COUNTERTOP
- PERFORATED DECORATIVE METAL PANEL
- WALL PROTECTION PANEL
- ICE MACHINE
- CARPET BASE
- (5) 24"x48" TACKBOARD PANELS SEE COLOR SCHEDULE REMARK 13/A2.8
- CORNER BOARD
- STRUCTURAL MEMBER TO BE PAINTED, SEE STRUCTURAL
- COVERED BASE
- CASEWORK
- TAC-WALL
- 75" MONITOR WITH
- MONITOR CONTROL DEVICE & HDMI DEVICES, DISTRICT WILL VERIFY LOCATION, PROJECT DEVELOPMENT
- WALL MOUNTED SPEAKERS, DISTRICT TO VERIFY LOCATION.

NOTES:

- SEE DTL 219/A8.11 FOR ACCESSIBILITY STANDARDS
- ALL SHELVING WITH SPANS GREATER THAN 30" TO BE 1" THICK
- REFER TO COLOR SCHEDULE (SHEET A2.8) FOR ALL COLOR REFERENCES, TYP.
- ALL CARPET USES A CARPET BASE #86
ALL MONDO RUBBER FLOORS USE A RUBBER TOPSET BASE #3
ALL AHRO FLOORS USE SELF-COVER BASE #41
ALL STAINED & DYED CONCRETE FLOORS USE TOPSET #3

SYMBOL LEGEND

CASEWORK SYMBOL

HEIGHT MODIFIED
DEPTH CASEWORK MODEL
LOCK

GENERAL NOTES

1. RECESSED CLOCKS AND/OR SPEAKERS ARE PROHIBITED IN FIRE RATED WALLS WHERE OPENING PROTECTION IS REQUIRED.



7790 NORTH PALM AVENUE
FRESNO, CALIFORNIA 93711
T559.448.8400 F559.448.8467
www.simprk.com

PROJECT:
SHIELDS & BRAWLEY ELEMENTARY SCHOOL



AD 2-27a
S&B Elementary
02-116800


JOHN H. SMITH, A.I.A. C15885

THE FIRM OF SMITH, SWANAGA, MILHOLZ, ARCHITECTS, INC. EXPRESSLY RESERVES ITS COMMON LAW COPYRIGHT AND OTHER APPLICABLE PROPERTY RIGHTS IN THESE PLANS. THESE PLANS ARE NOT TO BE REPRODUCED, CHANGED, OR COPIED IN ANY FORM OR MANNER WHATSOEVER, NOR ARE THEY TO BE ASSIGNED TO A THIRD PARTY WITHOUT FIRST OBTAINING THE WRITTEN PERMISSION AND CONSENT OF THE ARCHITECT. IN THE EVENT OF UNAUTHORIZED REUSE OF THESE PLANS BY A THIRD PARTY, THE THIRD PARTY SHALL HOLD THE ARCHITECT HARMLESS AND SHALL BEAR THE COST OF THE ARCHITECT'S LEGAL FEES, ASSOCIATED WITH DEFENDING AND ENFORCING THESE RIGHTS.

| PROJECT DEVELOPMENT | | |
|---------------------|------------|------------------------|
| DATE | ISSUED FOR | |
| | | |
| | | |
| REVISIONS | | |
| No. | DATE | DESCRIPTION |
| △ | 2.14.23 | DISTRICT MODIFICATIONS |
| △ | 2.27.23 | DISTRICT MODIFICATIONS |
| | | |
| | | |


| SHEET DESCRIPTION | |
|--|---------------------------|
| INTERIOR ELEVATIONS | |
| MAIN - 1ST FLOOR | |
| PROJECT COORDINATOR JOHN SMITH | SHEET NO. A5.10 |
| PROJECT NO. 17-67 | DATE 1.27.23 |
| SCALE 1/4"=1'-0" | |

E:\17-67_Shields & Brawley_Elementary\Sheet\17-67_A5.10_InteriorElevations.dwg 05/20/23 08:22:30

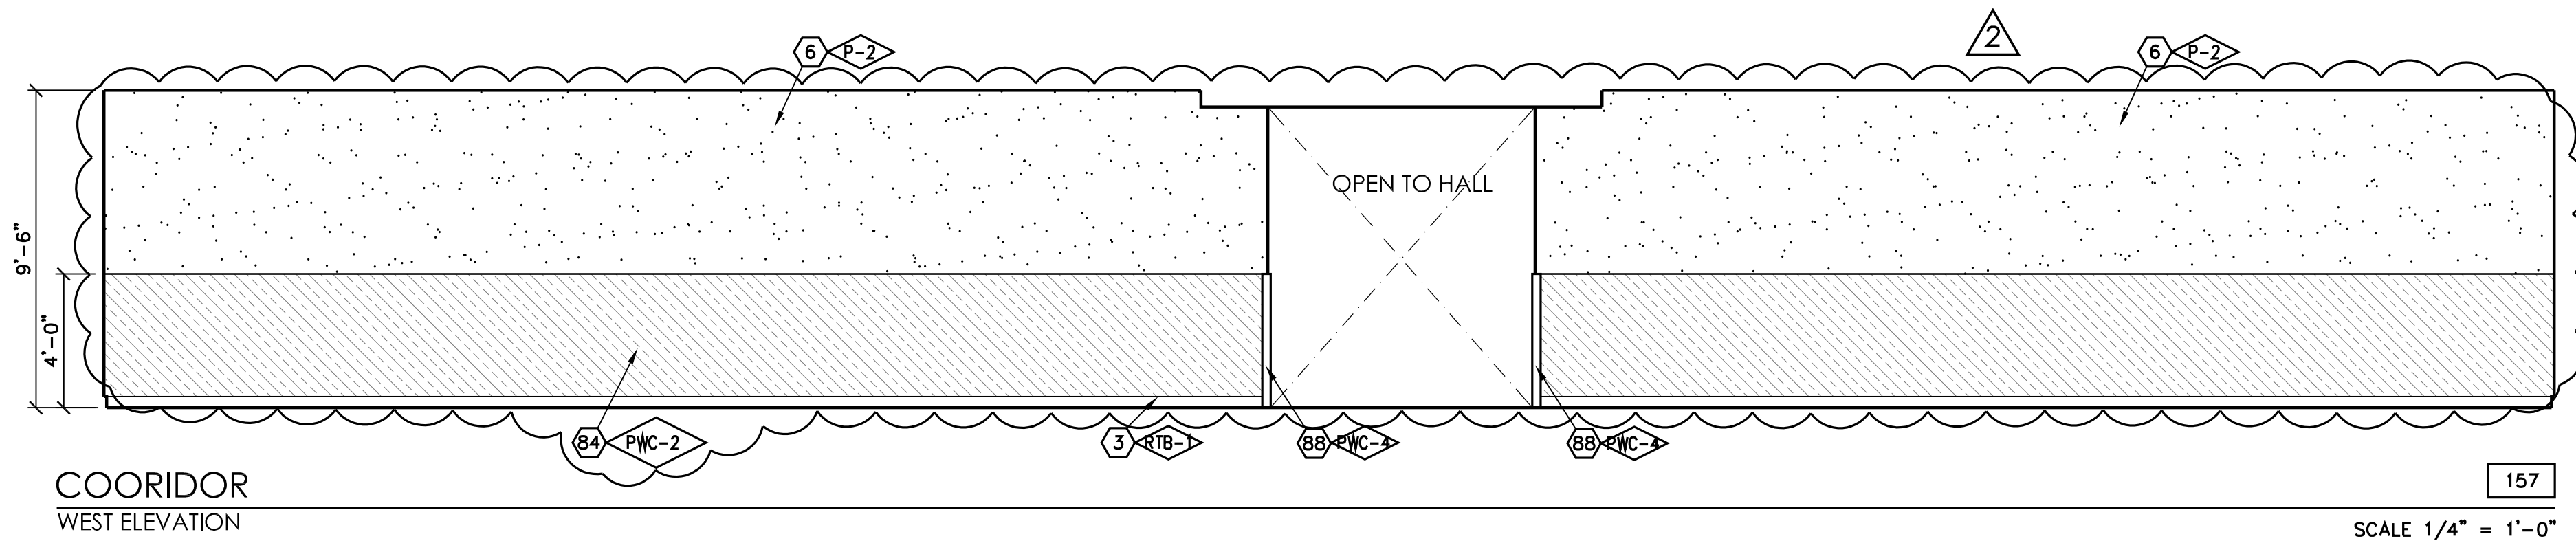


COORIDOR
WEST ELEVATION

SCALE 1/4" = 1'-0"

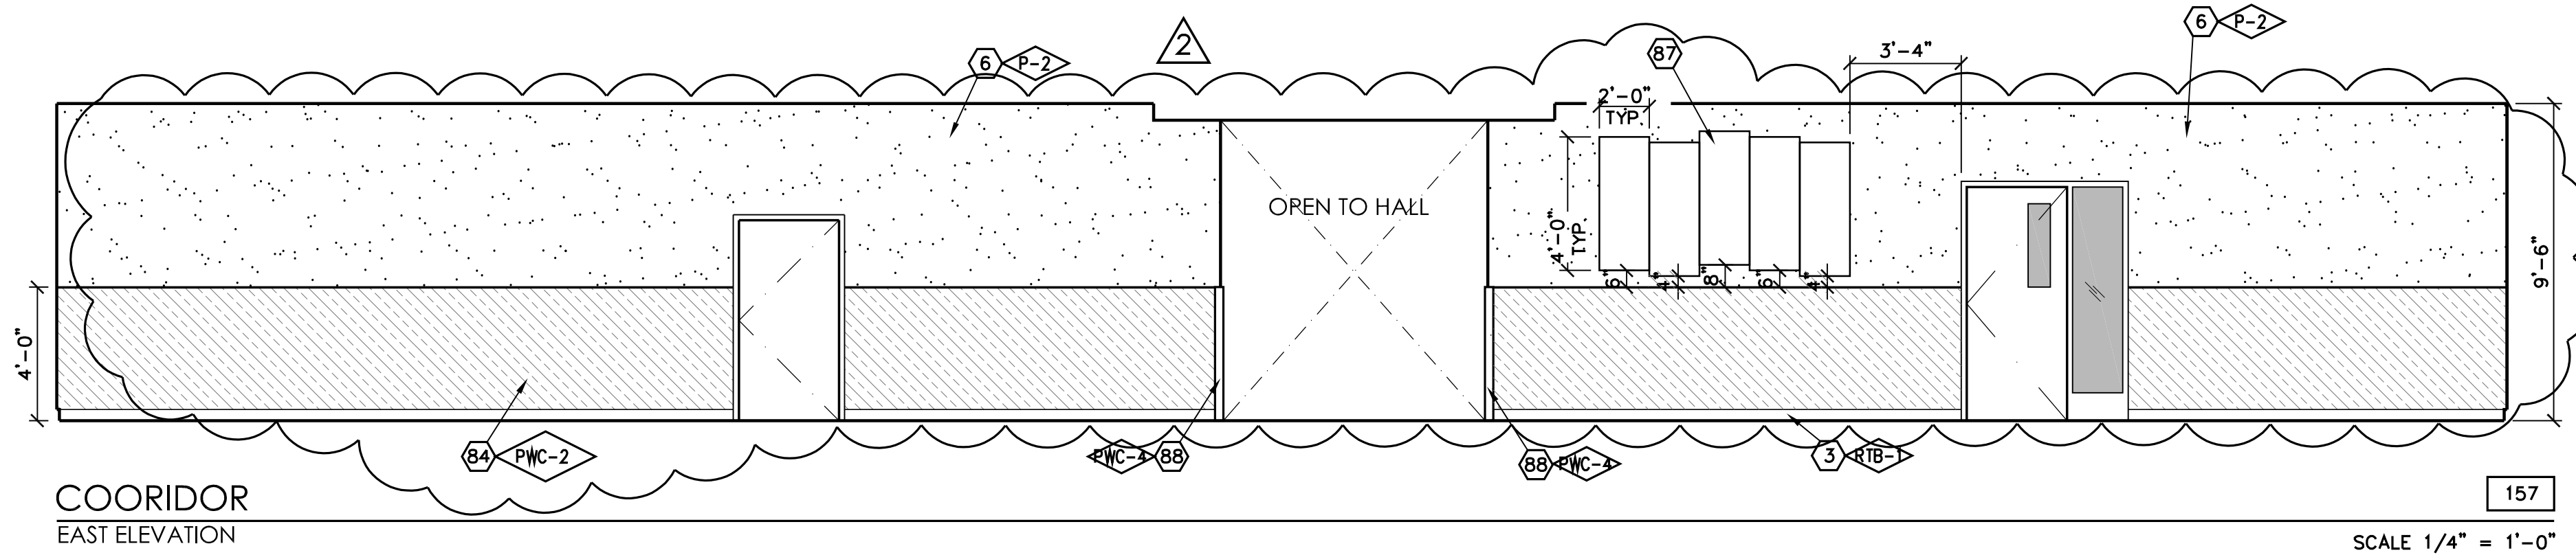

COORIDOR
EAST ELEVATION

SCALE 1/4" = 1'-0"

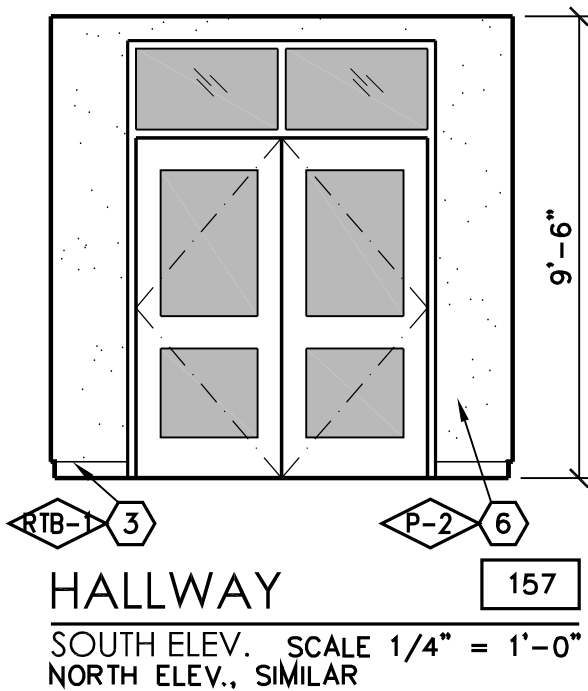


HALLWAY

SOUTH ELEV. SCALE 1/4" = 1'-0"
NORTH ELEV., SIMILAR

KEYNOTES

1. KNEE SPACE
2. VINYL TACKBOARD o/ GYP. BD.
3. RUBBER TOPSET BASE
4. STOREFRONT
5. PAPER TOWEL DISPENSER
6. GYPSUM BOARD, TAPE, TEXTURE & PAINT (PROVIDE 5/8" TYPE 'X' GYP. AT STAIRWAYS AND UNDERSTAIR WALL/CEILING FINISHES, TYP.)
7. ROOF ACCESS LADDER
8. SOFFIT
9. FLOOR SINK - SEE PLUMBING
10. UNDER-COUNTER REFRIGERATOR
11. FIRE EXTINGUISHER w/ SEMI RECESSED CAB. TYPE 2A:10BC
12. PLASTIC LAMINATE CASEWORK
13. W.I.C. 400 STORAGE SHELVING
14. FIBER REINFORCED PANEL
15. PLASTIC LAMINATE BACKSPLASH & COUNTERTOP
16. METAL POST, PER STRUCTURAL
17. SINK - SEE PLUMBING SCHEDULE
18. MAGNETIC MARKER BOARD o/VTB
19. APPLIANCES - SEE SPEC SECTION 11400
20. BUTCHER PAPER HOLDER
21. DISHWASHER
22. HOOD
23. REFRIGERATOR - FULL HEIGHT
24. COOKTOP
25. ROLL-UP DOOR
26. STAINLESS STEEL COUNTERTOP
27. FURNITURE (N.I.C.)
28. DRINKING FOUNTAIN
29. CLOCK/SPEAKER
30. CLEAR GLASS DISPLAY CASE w/ LOCK (SEE SPEC. SECT. 10410)
31. FEMININE NAPKIN DISPOSAL
32. MIRROR
33. TRACK AND CUBICLE CURTAIN.
34. STAIRCASE
35. HANDRAIL
36. N/A
37. TRANSLUCENT WALL SYSTEM
38. WOOD BASE
39. WHEEL CHAIR LIFT
40. BELOW STAGE STORAGE
41. SHEET VINYL COVED BASE
42. ELEVATOR LANTERN
43. RAILING, SPACING SHALL BE SUCH THAT A 4" DIA. SPHERE CANNOT PASS THROUGH ANY OPENING, PER CBC 1013
44. CALL BUTTON
45. ELEVATOR DOORS
46. LAVATORY
47. TOILET PAPER DISPENSER
48. TOILET SEAT COVER DISPENSER
49. DATA RACEWAY. SEE ELECTRICAL DRAWINGS.
50. CLOCK
51. 4" HIGH CORNER GUARD, TYP.
52. SOAP DISPENSER
53. PLASTIC TOILET PARTITION
54. SIGNAGE
55. MANUFACTURED 3"Wx6"H MTL. SHELVING, SEE S-1/K8.0
56. SPEAKER ENCLOSURE AND GRILLE
57. MOP/BROOM HOLDER
58. PLASTIC LAM. DOOR, 1 1/2" THICK
59. PROVIDE 3/4" LAM. PLASTIC SUPPORTS AT STOREFRONT, AT 4'-0" O.C.
60. RAYTHERMS (N.I.C.)
61. URINAL
62. MICROWAVE (N.I.C.)
63. PLASTIC LAMINATE CAP
64. CERAMIC TILE
65. GRAB BAR
66. WATER CLOSET
67. METAL LETTERS (SEE SPECS)
68. PONY WALL BEHIND
69. ROOM CAPACITY SIGN
70. TECTUM PANELS
71. 2x3 SHAPED WOOD NAILER
72. UTILITY BOX
73. MOVABLE ROD TO BE PLACED AT 44" FOR ADA COMPLIANCE. OPTIONAL.
74. MOTORIZED SCREEN, SEE 143/A8.8
75. PLASTIC LAMINATE PANELING AND DOORS
76. WINDOW WALL, SEE T2 FOR DEFERRED ITEMS
77. CLEAR GLASS POSTER CASE w/LOCK (SEE SPEC. SECT. 10410)
78. 1/2" REVEAL SCREEDS
79. WALL CLOCK, SEE SPEC SECTION 10050
80. MICROWAVE OVEN
81. PLASTIC LAMINATE COUNTERTOP
82. SOLID SURFACE COUNTERTOP
83. PERFORATED DECORATIVE METAL PANEL
84. WALL PROTECTION PANEL
85. ICE MACHINE
86. CARPET BASE
87. 24"x48" TACKBOARD PANELS SEE COLOR SCHEDULE REMARK 13/A2.8
88. CORNER BOARD
89. STRUCTURAL MEMBER TO BE PAINTED, SEE STRUCTURAL
90. COVED BASE
91. CASEWORK
92. TAC-WALL
93. 75" MONITOR WITH
94. MONITOR CONTROL DEVICE & HDMI DEVICES, DISTRICT WILL VERIFY LOCATION.
95. WALL MOUNTED SPEAKERS, DISTRICT TO VERIFY LOCATION.

SYMBOL LEGEND

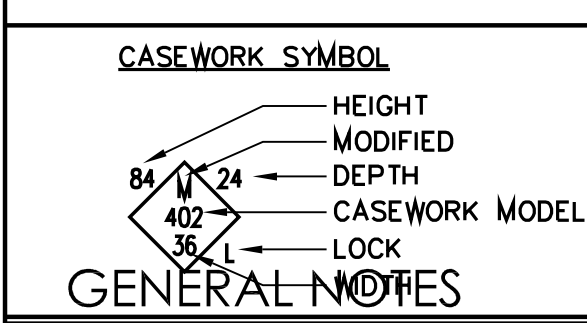

GENERAL NOTES

1. RECESSED CLOCKS AND/OR SPEAKERS ARE PROHIBITED IN FIRE RATED WALLS WHERE OPENING PROTECTION IS REQUIRED.



7790 NORTH PALM AVENUE
FRESNO, CALIFORNIA 93711
T559.448.8400 F559.448.8467
WWW.SIM-DBK.COM

PROJECT:
SHIELDS & BRAWLEY ELEMENTARY SCHOOL



AD 2-28a
S&B Elementary
02-116800



THE FIRM OF SMITH, WATANAGA, MILHOLE, ARCHITECTS, INC. EXPRESSLY RESERVES ITS COMMON LAW COPYRIGHT AND OTHER APPLICABLE PROPERTY RIGHTS IN THESE PLANS. THESE PLANS ARE NOT TO BE REPRODUCED, CHANGED, OR COPIED IN ANY FORM OR MANNER WHATSOEVER, NOR ARE THEY TO BE ASSIGNED TO A THIRD PARTY WITHOUT FIRST OBTAINING THE WRITTEN PERMISSION AND CONSENT OF THE ARCHITECT. IN THE EVENT OF UNAUTHORIZED REUSE OF THESE PLANS BY A THIRD PARTY, THE THIRD PARTY SHALL HOLD THE ARCHITECT HARMLESS, AND SHALL BEAR THE COST OF THE ARCHITECT'S LEGAL FEES, ASSOCIATED WITH DEFENDING AND ENFORCING THESE RIGHTS.

| PROJECT DEVELOPMENT | | |
|---------------------|------------|------------------------|
| DATE | ISSUED FOR | |
| | | |
| | | |
| | | |
| | | |
| REVISIONS | | |
| No. | DATE | DESCRIPTION |
| △ | 2.14.23 | DISTRICT MODIFICATIONS |
| △ | 2.27.23 | DISTRICT MODIFICATIONS |
| | | |
| | | |
| | | |

| SHEET DESCRIPTION | |
|--|---------------------------|
| INTERIOR ELEVATIONS | |
| MAIN - 1ST FLOOR | |
| PROJECT COORDINATOR JOHN SMITH | SHEET NO. A5.11 |
| PROJECT NO. 17-67 | |
| DATE 1.27.23 | |
| SCALE AS NOTED | |


P:\17-67_Shields & Brawley_Elementary\Work\17-67_A5.11-Interior.dwg 05/30/18 2:30

KEYNOTES

1. KNEE SPACE
2. VINYL TACKBOARD o/ GYP. BD.
3. RUBBER TOPSET BASE
4. STOREFRONT
5. PAPER TOWEL DISPENSER
6. GYPSUM BOARD, TAPE, TEXTURE & PAINT (PROVIDE 5/8" TYPE 'X' GYP. AT STAIRWAYS AND UNDERSTAIR WALL/CEILING FINISHES, TYP.)
7. ROOF ACCESS LADDER
8. SOFFIT
9. FLOOR SINK - SEE PLUMBING
10. UNDER-COUNTER REFRIGERATOR
11. FIRE EXTINGUISHER w/ SEMI RECESSED CAB. TYPE 2A:10BC
12. PLASTIC LAMINATE CASEWORK
13. W.I.C. 400 STORAGE SHELVING
14. FIBER REINFORCED PANEL
15. PLASTIC LAMINATE BACKSPLASH & COUNTERTOP
16. METAL POST, PER STRUCTURAL
17. SINK - SEE PLUMBING SCHEDULE
18. MAGNETIC MARKER BOARD o/VTB
19. APPLIANCES - SEE SPEC SECTION 11400
20. BUTCHER PAPER HOLDER
21. DISHWASHER
22. HOOD
23. REFRIGERATOR - FULL HEIGHT
24. COOKTOP
25. ROLL-UP DOOR
26. STAINLESS STEEL COUNTERTOP
27. FURNITURE (N.I.C.)
28. DRINKING FOUNTAIN
29. CLOCK/SPEAKER
30. CLEAR GLASS DISPLAY CASE w/ LOCK (SEE SPEC. SECT. 10410)
31. FEMINE NAPKIN DISPOSAL
32. MIRROR
33. TRACK AND CUBICLE CURTAIN.
34. STAIRCASE
35. HANDRAIL
36. N/A
37. TRANSLUCENT WALL SYSTEM
38. WOOD BASE
39. WHEEL CHAIR LIFT
40. BELOW STAGE STORAGE
41. SHEET VINYL COVERED BASE
42. ELEVATOR LANTERN
43. RAILING, SPACING SHALL BE SUCH THAT A 4" DIA. SPHERE CANNOT PASS THROUGH ANY OPENING, PER CBC 101.3
44. CALL BUTTON
45. ELEVATOR DOORS
46. LAVATORY
47. TOILET PAPER DISPENSER
48. TOILET SEAT COVER DISPENSER
49. DATA RACEWAY. SEE ELECTRICAL DRAWINGS.
50. CLOCK
51. 4" HIGH CORNER GUARD, TYP.
52. SOAP DISPENSER
53. PLASTIC TOILET PARTITION
54. SIGNAGE
55. MANUFACTURED 3'x6'H MTL. SHELVING, SEE S-1/K8.0
56. SPEAKER ENCLOSURE AND GRILLE
57. MOP/BROOM HOLDER
58. PLASTIC LAM. DOOR, 1 1/2" THICK
59. PROVIDE 3/4" LAM. PLASTIC SUPPORTS AT STOREFRONT, AT 4'-0" O.C.
60. RAYTHERMS (N.I.C.)
61. URINAL
62. MICROWAVE (N.I.C.)
63. PLASTIC LAMINATE CAP
64. CERAMIC TILE
65. GRAB BAR
66. WATER CLOSET
67. METAL LETTERS (SEE SPECS)
68. PONY WALL BEHIND
69. ROOM CAPACITY SIGN
70. TECTUM PANELS
71. 2x3 SHAPED WOOD NAILER
72. UTILITY BOX
73. MOVABLE ROD TO BE PLACED AT 44" FOR ADA COMPLIANCE. OPTIONAL.
74. MOTORIZED SCREEN, SEE 143/A8.8
75. PLASTIC LAMINATE PANELING AND DOORS
76. WINDOW WALL, SEE T2 FOR DEFERRED ITEMS
77. CLEAR GLASS POSTER CASE w/LOCK (SEE SPEC. SECT. 10410)
78. 1/2" REVEAL SCREEDS
79. WALL CLOCK, SEE SPEC SECTION 10050
80. MICROWAVE OVEN
81. PLASTIC LAMINATE COUNTERTOP
82. SOLID SURFACE COUNTERTOP
83. PERFORATED DECORATIVE METAL PANEL
84. WALL PROTECTION PANEL
85. ICE MACHINE
86. CARPET BASE
87. (5) 24"x48" TACKBOARD PANELS SEE COLOR SCHEDULE REMARK 13/A2.8
88. CORNER GUARD
89. STRUCTURAL MEMBER TO BE PAINTED, SEE STRUCTURAL
90. COVERED BASE
91. CASEWORK
92. TAG-WALL
93. 75" MONITOR WITH
94. MONITOR CONTROL DEVICE & HDMI DEVICES, DISTRICT WILL VERIFY LOCATION.
95. WALL MOUNTED SPEAKERS, DISTRICT TO VERIFY LOCATION.


NOTES: 1. SEE DTL. 219/A8.11 FOR ACCESSIBILITY STANDARDS
 2. ALL SHELVING WITH SPANS GREATER THAN 30" TO BE 1" THICK
 3. REFER TO COLOR SCHEDULE (SHEET A2.8) FOR ALL COLOR REFERENCES, TYP.
 4. ALL CARPET USES A CARPET BASE #86
 ALL MONO RUBBER FLOORS USE A RUBBER TOPSET BASE #3
 ALL AHRO FLOORS USE SELF-COVER BASE #41
 ALL STAINED & DYED CONCRETE FLOORS USE TOPSET #3

SYMBOL LEGEND

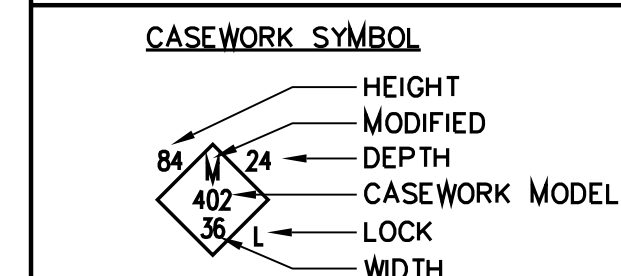


GENERAL NOTES

1. RECESSED CLOCKS AND/OR SPEAKERS ARE PROHIBITED IN FIRE RATED WALLS WHERE OPENING PROTECTION IS REQUIRED.

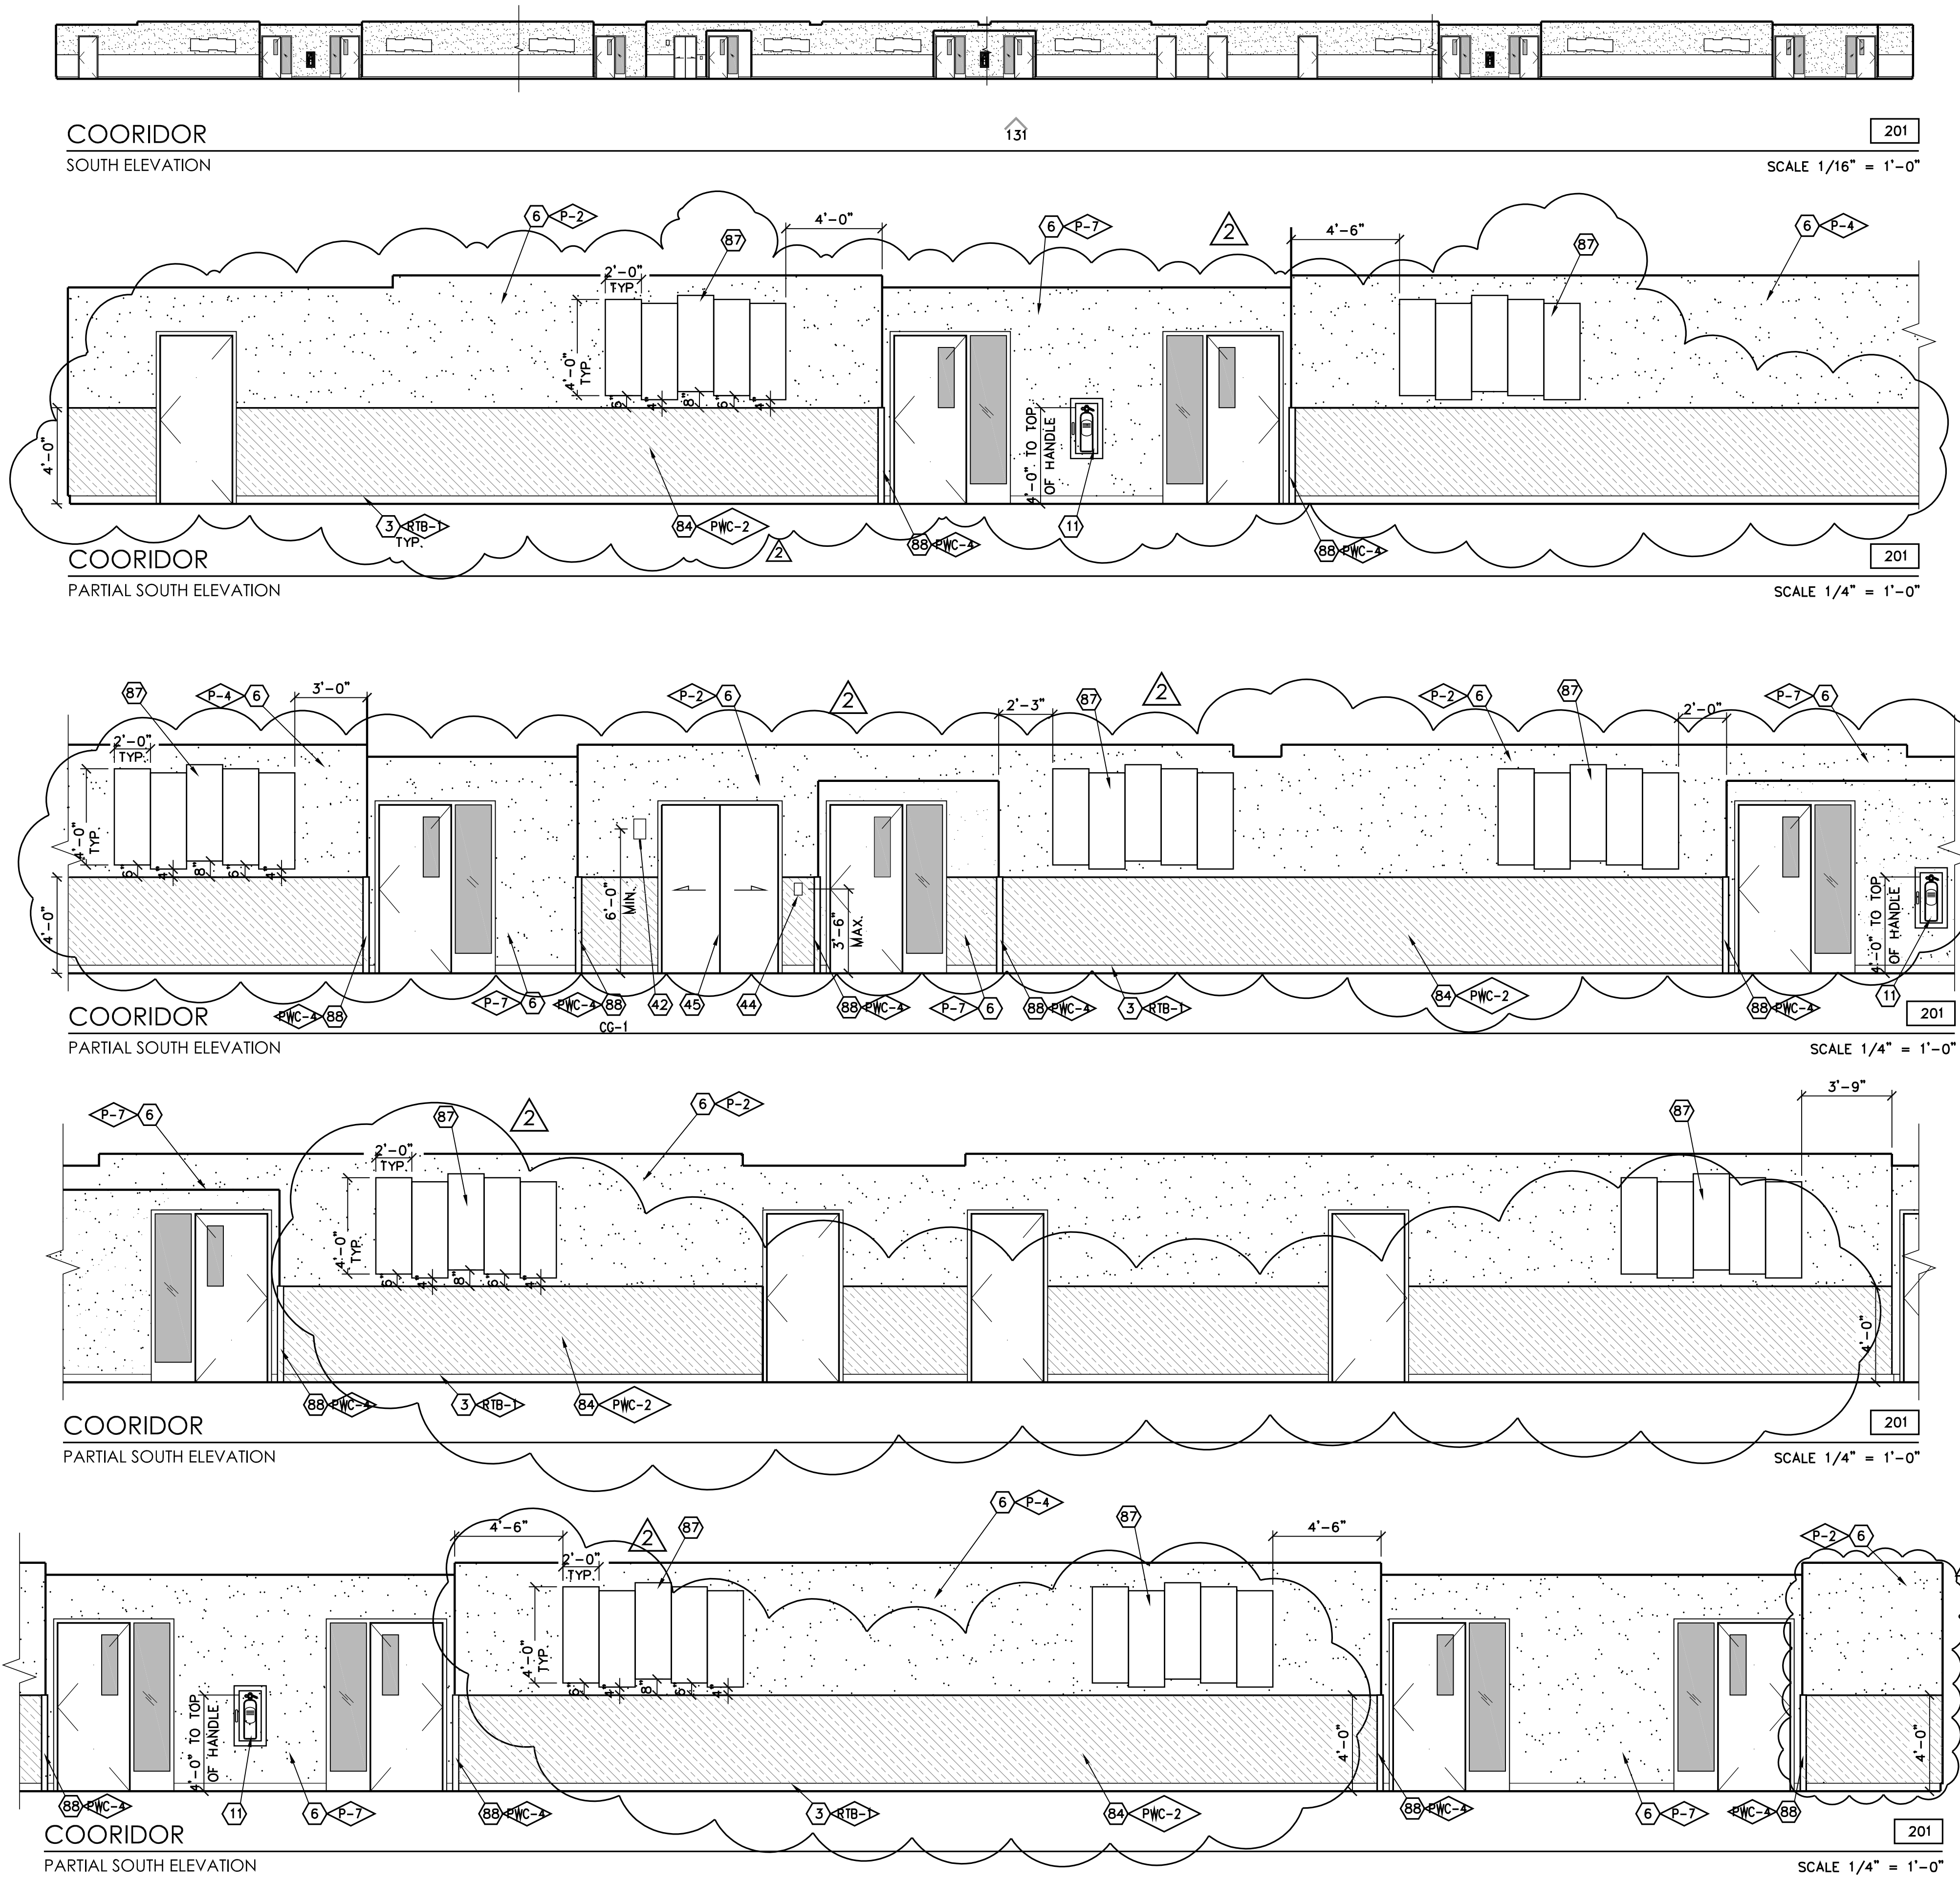


7790 NORTH PALM AVENUE
 FRESNO, CALIFORNIA 93711
 T509.448.8400 F509.448.8467
 www.simprk.com

PROJECT:
SHIELDS & BRAWLEY ELEMENTARY SCHOOL

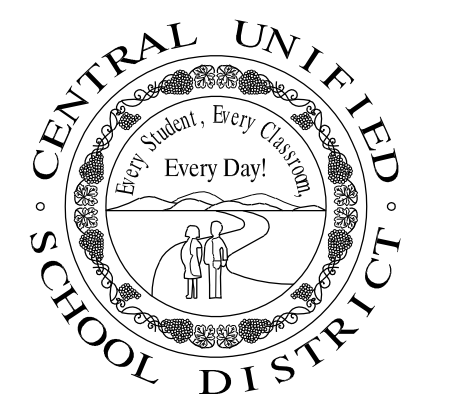

AD 2-29a
S&B Elementary
02-116800

JOHN H. SMITH, A.I.A. C15885

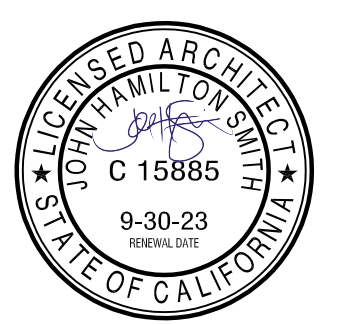

THE FIRM OF SMITH BARAJAS MILAGROS ARCHITECTS, INC. EXPRESSLY RESERVES ALL COMMON LAW COPYRIGHT AND OTHER APPLICABLE PROPERTY RIGHTS IN THESE PLANS. THESE PLANS ARE NOT TO BE REPRODUCED, CHANGED, OR COPIED IN ANY FORM OR MANNER WHATSOEVER, NOR ARE THEY TO BE ASSIGNED TO A THIRD PARTY WITHOUT FIRST OBTAINING THE WRITTEN PERMISSION AND CONSENT OF THE ARCHITECT. IN THE EVENT OF UNAUTHORIZED REUSE OF THESE PLANS BY A THIRD PARTY, THE THIRD PARTY SHALL HOLD THE ARCHITECT HARMLESS AND SHALL BEAR THE COST OF THE ARCHITECT'S LEGAL FEES ASSOCIATED WITH DEFENDING AND ENFORCING THESE RIGHTS.

PROJECT DEVELOPMENT

| DATE | ISSUED FOR |
|------|------------|
| | |
| | |
| | |

REVISIONS


| No. | DATE | DESCRIPTION |
|---------|------|------------------------|
| 2.14.23 | | DISTRICT MODIFICATIONS |
| 2.27.23 | | DISTRICT MODIFICATIONS |

SHEET DESCRIPTION

INTERIOR ELEVATIONS
 MAIN - 2ND FLOOR

| | |
|--|--------------|
| PROJECT COORDINATOR JOHN SMITH | SHEET No. |
| PROJECT NO. 17-67 | A5.12 |
| DATE 1.27.23 | |
| SCALE AS NOTED | |

E:\17-67-Shields & Brawley Elementary\A5.12-67-A5.12_2nd-interior.dwg 05/01/18 07:09

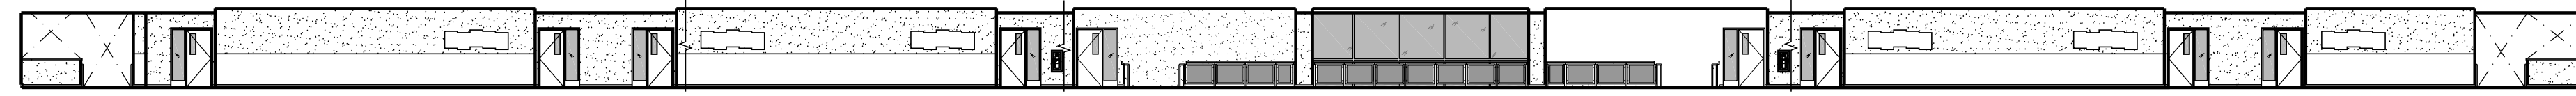


COORIDOR
NORTH ELEVATION

132


201

SCALE 1/16" = 1'-0"

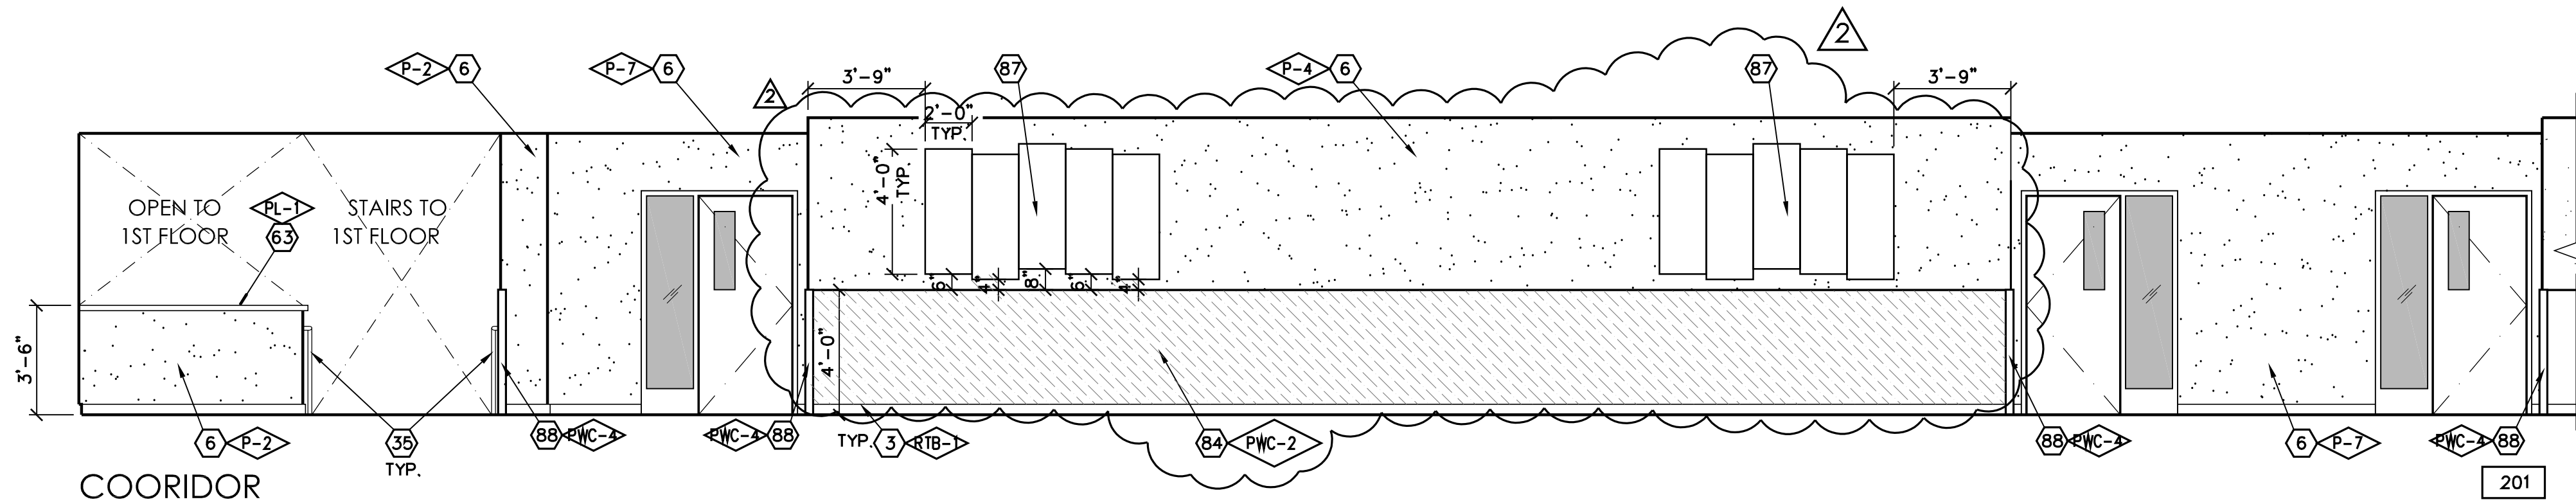


COORIDOR
PARTIAL NORTH ELEVATION

SCALE 1/4" = 1'-0"

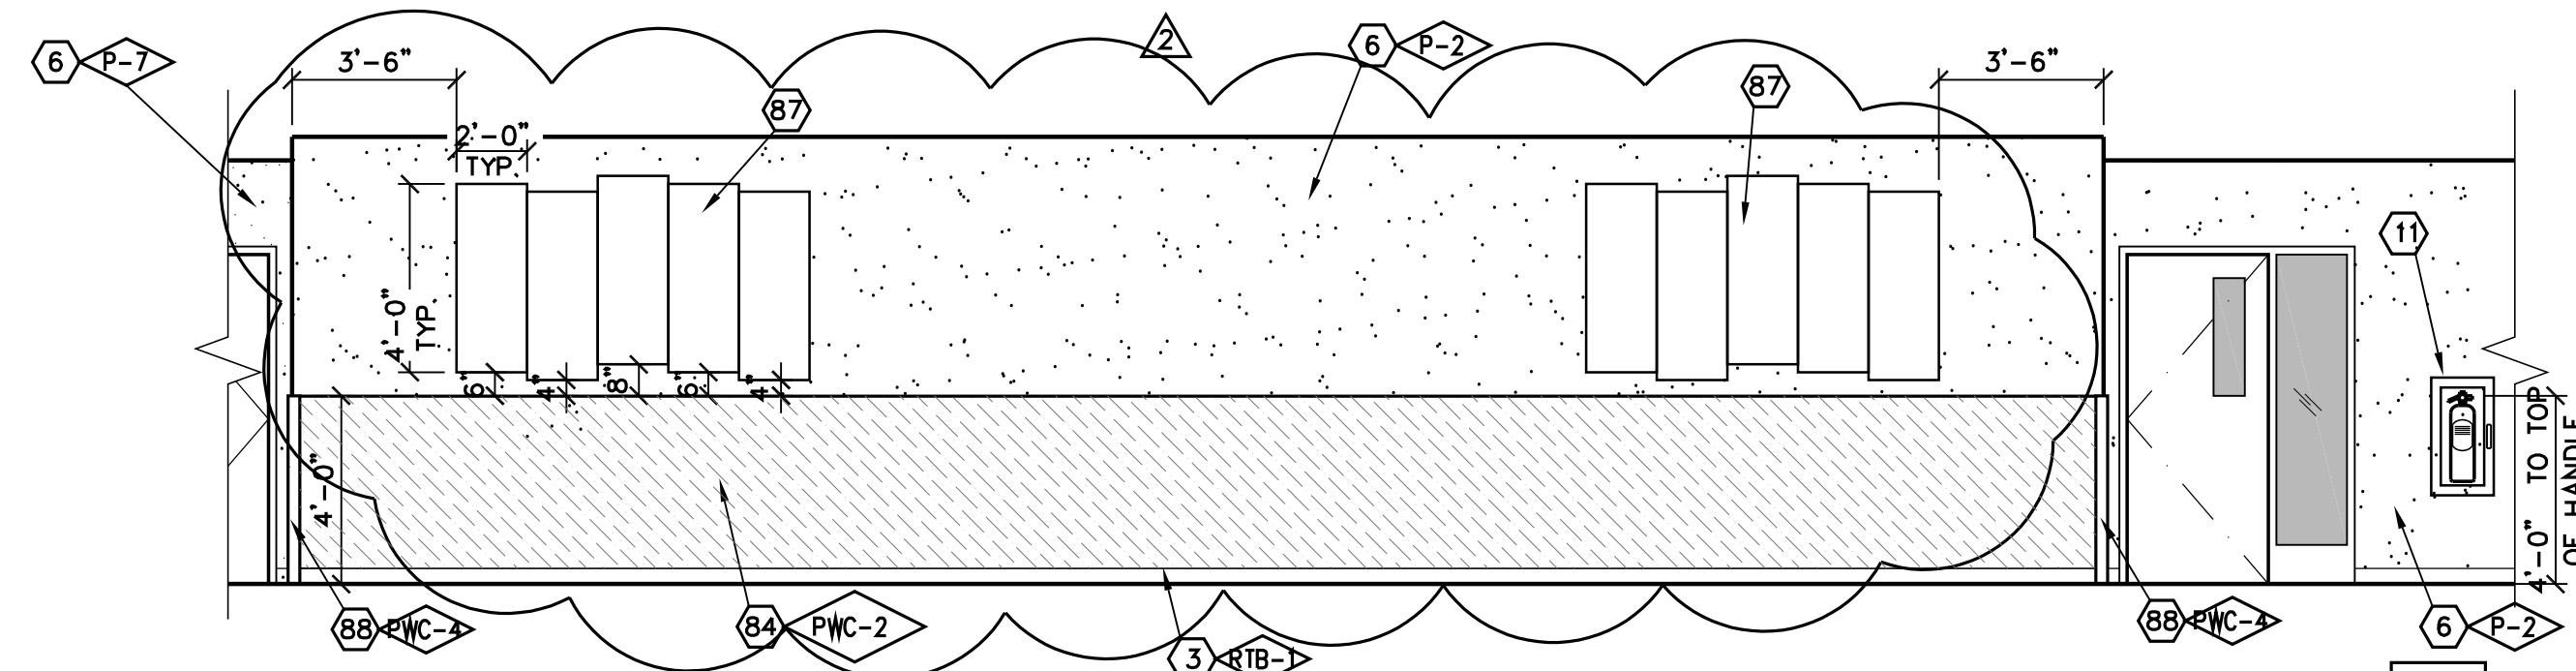


COORIDOR
PARTIAL NORTH ELEVATION

SCALE 1/4" = 1'-0"

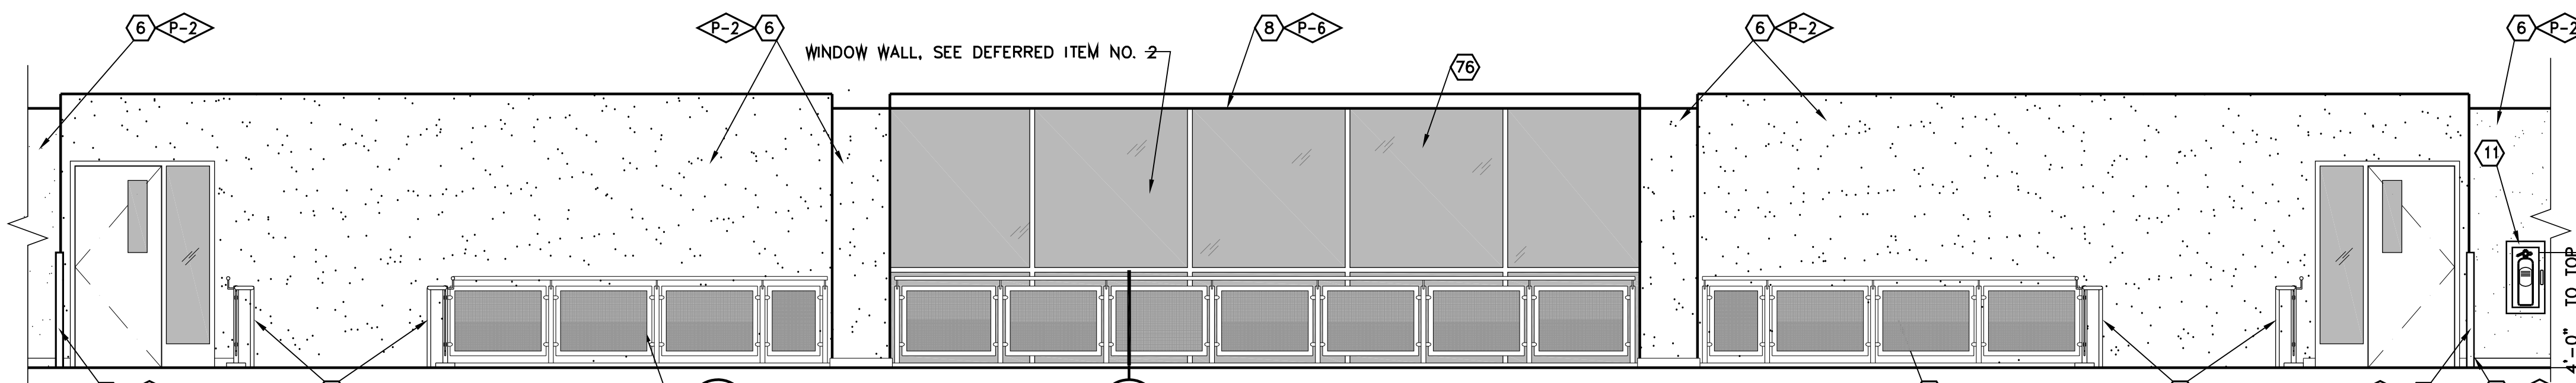

COORIDOR
PARTIAL NORTH ELEVATION

SCALE 1/4" = 1'-0"

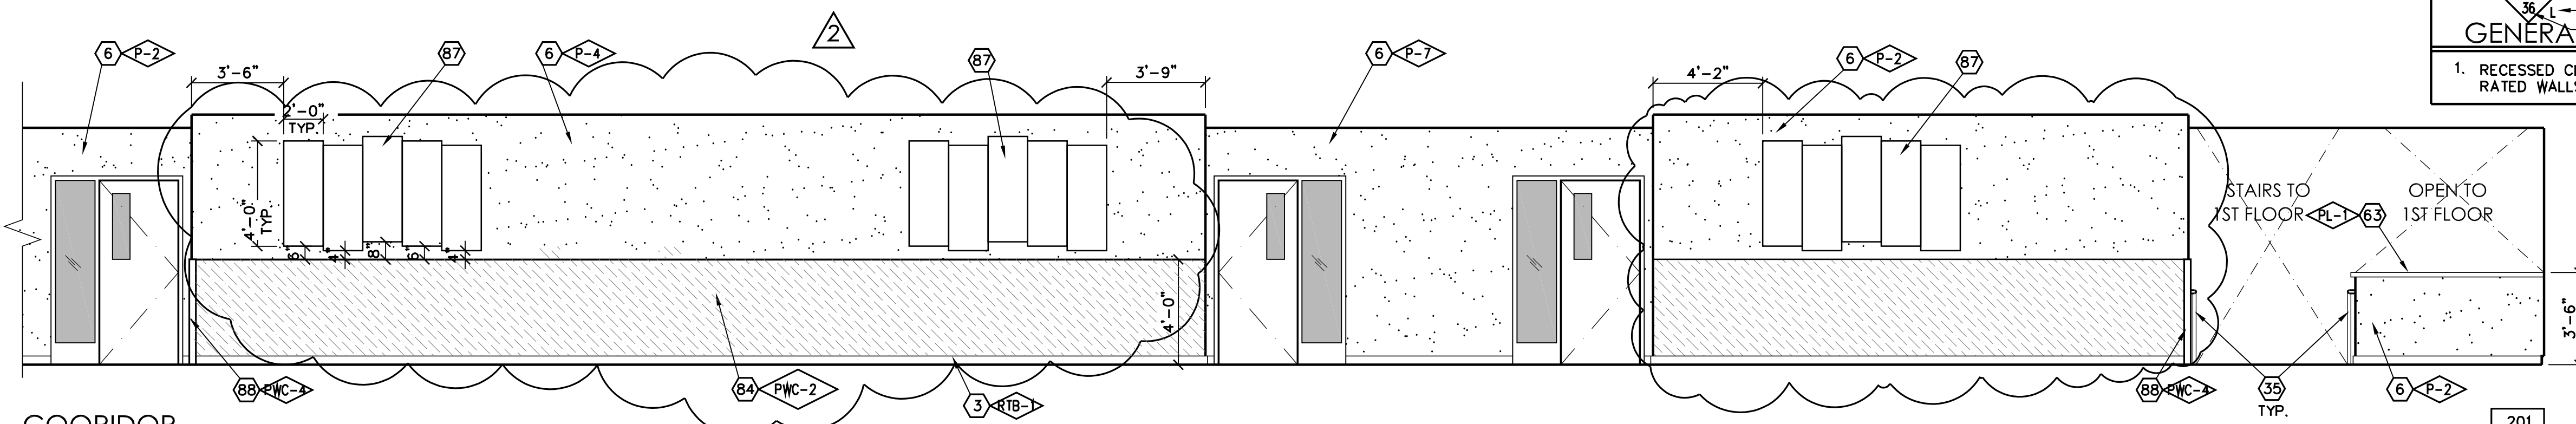

COORIDOR
PARTIAL NORTH ELEVATION


SCALE 1/4" = 1'-0"

KEYNOTES

1. KNEE SPACE
2. VINYL TACKBOARD o/ GYP. BD.
3. RUBBER TOPSET BASE
4. STOREFRONT
5. PAPER TOWEL DISPENSER
6. GYPSUM BOARD, TAPE, TEXTURE & PAINT (PROVIDE 5/8" TYPE 'X' GYP. AT STAIRWAYS AND UNDERSTAIR WALL/CEILING FINISHES, TYP.)
7. ROOF ACCESS LADDER
8. SOFFIT
9. FLOOR SINK - SEE PLUMBING
10. UNDER-COUNTER REFRIGERATOR
11. FIRE EXTINGUISHER w/ SEMI RECESSED CAB. TYPE 2A:10BC
12. PLASTIC LAMINATE CASEWORK
13. W.I.C. 400 STORAGE SHELving
14. FIBER REINFORCED PANEL
15. PLASTIC LAMINATE BACKSPASH & COUNTERTOP
16. METAL POST, PER STRUCTURAL
17. SINK - SEE PLUMBING SCHEDULE
18. MAGNETIC MARKER BOARD o/VTB
19. APPLIANCES - SEE SPEC SECTION 11400
20. BUTCHER PAPER HOLDER
21. DISHWASHER
22. HOOD
23. REFRIGERATOR - FULL HEIGHT
24. COOKTOP
25. ROLL-UP DOOR
26. STAINLESS STEEL COUNTERTOP
27. FURNITURE (N.I.C.)
28. DRINKING FOUNTAIN
29. CLOCK/SPEAKER
30. CLEAR GLASS DISPLAY CASE w/ LOCK (SEE SPEC. SECT. 10410)
31. FEMININE NAPKIN DISPOSAL
32. MIRROR
33. TRACK AND CUBICLE CURTAIN.
34. STAIRCASE
35. HANDRAIL
36. N/A
37. TRANSLUCENT WALL SYSTEM
38. WOOD BASE
39. WHEEL CHAIR LIFT
40. BELOW STAGE STORAGE
41. SHEET VINYL COVED BASE
42. ELEVATOR LANTERN
43. RAILING, SPACING SHALL BE SUCH THAT A 4" DIA. SPHERE CANNOT PASS THROUGH ANY OPENING, PER CBC 1013
44. CALL BUTTON
45. ELEVATOR DOORS
46. LAVATORY
47. TOILET PAPER DISPENSER
48. TOILET SEAT COVER DISPENSER
49. DATA RACEWAY. SEE ELECTRICAL DRAWINGS.
50. CLOCK
51. 4' HIGH CORNER GUARD, TYP.
52. SOAP DISPENSER
53. PLASTIC TOILET PARTITION
54. SIGNAGE
55. MANUFACTURED 3'x6'H MTL. SHELving, SEE S-1/K8.0
56. SPEAKER ENCLOSURE AND GRILLE
57. MOP/BROOM HOLDER
58. PLASTIC LAM. DOOR, 1 1/2" THICK
59. PROVIDE 3/4" LAM. PLASTIC SUPPORTS AT STOREFRONT, AT 4'-0" O.C.
60. RAYTHERMS (N.I.C.)
61. URINAL
62. MICROWAVE (N.I.C.)
63. PLASTIC LAMINATE CAP
64. CERAMIC TILE
65. GRAB BAR
66. WATER CLOSET
67. METAL LETTERS (SEE SPECS)
68. PONY WALL BEHIND
69. ROOM CAPACITY SIGN
70. TECTUM PANELS
71. 2x3 SHAPED WOOD NAILER
72. UTILITY BOX
73. MOVABLE ROD TO BE PLACED AT 44" FOR ADA COMPLIANCE. OPTIONAL.
74. MOTORIZED SCREEN, SEE 143/AB.8
75. PLASTIC LAMINATE PANELING AND DOORS
76. WINDOW WALL, SEE DEFERRED ITEM NO. 2
77. CLEAR GLASS POSTER CASE w/LOCK (SEE SPEC. SECT. 10410)
78. 1/2" REVEAL SCREEDS
79. WALL CLOCK, SEE SPEC SECTION 10050
80. MICROWAVE OVEN
81. PLASTIC LAMINATE COUNTERTOP
82. SOLID SURFACE COUNTERTOP
83. PERFORATED DECORATIVE METAL PANEL
84. WALL PROTECTION PANEL
85. ICE MACHINE
86. CARPET BASE
87. (5) 24"x48" TACKBOARD PANELS SEE COLOR SCHEDULE REMARK 13/A2.8
88. STRUCTURAL MEMBER TO BE PAINTED, SEE STRUCTURAL
89. COVED BASE
90. CASEWORK
91. TAC-WALL
92. TAC-WALL
93. 75" MONITOR WITH
94. MONITOR CONTROL DEVICE & HDMI DEVICES, DISTRICT WILL VERIFY LOCATION.
95. WALL MOUNTED SPEAKERS, DISTRICT TO VERIFY LOCATION.

- NOTES:
1. SEE DTL, 219/AB.11 FOR ACCESSIBILITY STANDARDS
 2. ALL SHELving WITH SPANS GREATER THAN 30" TO BE 1" THICK
 3. REFER TO COLOR SCHEDULE (SHEET A2.8) FOR ALL COLOR REFERENCES, TYP.
 4. ALL CARPET USES A CARPET BASE #86
 5. ALL MONDO RUBBER FLOORS USE A RUBBER TOPSET BASE #3
 6. ALL AHRO FLOORS USE SELF-COVER BASE #41
 7. ALL STAINED & DYED CONCRETE FLOORS USE TOPSET #3

SYMBOL LEGEND

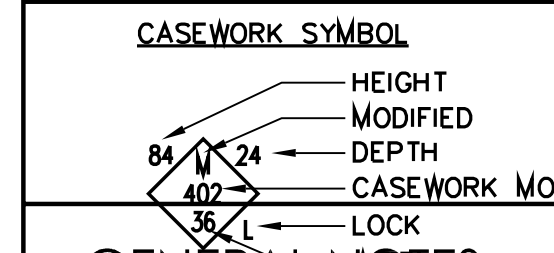

GENERAL NOTES


1. RECESSED CLOCKS AND/OR SPEAKERS ARE PROHIBITED IN FIRE RATED WALLS WHERE OPENING PROTECTION IS REQUIRED.



7790 NORTH PALM AVENUE
FRESNO, CALIFORNIA 93711
T 559.448.8400 F 559.448.8467
www.simprk.com


PROJECT:

SHIELDS
& BRAWLEY
ELEMENTARY
SCHOOL

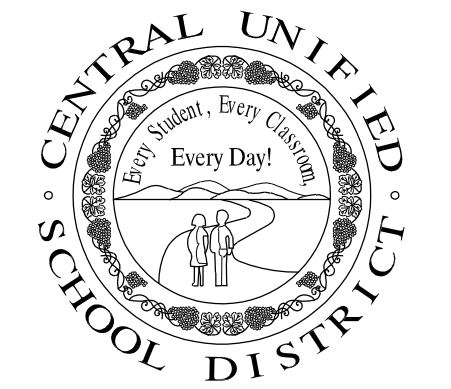

AD 2-30a
S&B Elementary
02-116800

JOHN H. SMITH, A.I.A., C15885

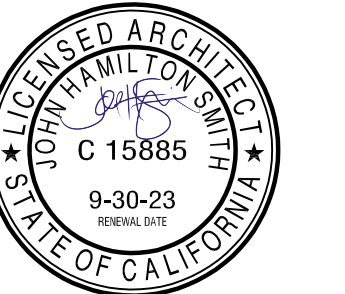

THE FIRM OF SMITH, SHIELDS, & BRAWLEY ARCHITECTS, P.C. EXPRESSLY DISCLAIMS ITS COMMON LAW COPYRIGHT AND OTHER APPLICABLE PROPERTY RIGHTS IN THESE PLANS. THESE PLANS ARE NOT TO BE REPRODUCED, CHANGED, OR COPIED IN ANY FORM OR MANNER WHATSOEVER, NOR ARE THEY TO BE ASSIGNED TO A THIRD PARTY WITHOUT FIRST OBTAINING THE WRITTEN PERMISSION AND CONSENT OF THE ARCHITECT. IN THE EVENT OF UNAUTHORIZED REUSE OF THESE PLANS BY A THIRD PARTY, THE THIRD PARTY SHALL HOLD THE ARCHITECT HARMLESS, AND SHALL BEAR THE COST OF THE ARCHITECT'S LEGAL FEES, ASSOCIATED WITH DEFENDING AND ENFORCING THESE RIGHTS.

PROJECT DEVELOPMENT

| DATE | ISSUED FOR |
|------|------------|
| | |
| | |
| | |






REVISIONS

| No. | DATE | DESCRIPTION |
|-----|---------|------------------------|
| 2 | 2.14.23 | DISTRICT MODIFICATIONS |
| 3 | 2.27.23 | DISTRICT MODIFICATIONS |

SHEET DESCRIPTION

| | |
|--|--------------|
| INTERIOR ELEVATIONS | |
| MAIN - 2ND FLOOR | |
| PROJECT COORDINATOR JOHN SMITH | SHEET No. |
| PROJECT NO. 17-67 | A5.13 |
| DATE 1.27.23 | |
| SCALE AS NOTED | |

A:\17-67_Shields & Brawley_Elementary\17-67_A5.13_2023-11-08.dwg 09/21/18 07:03

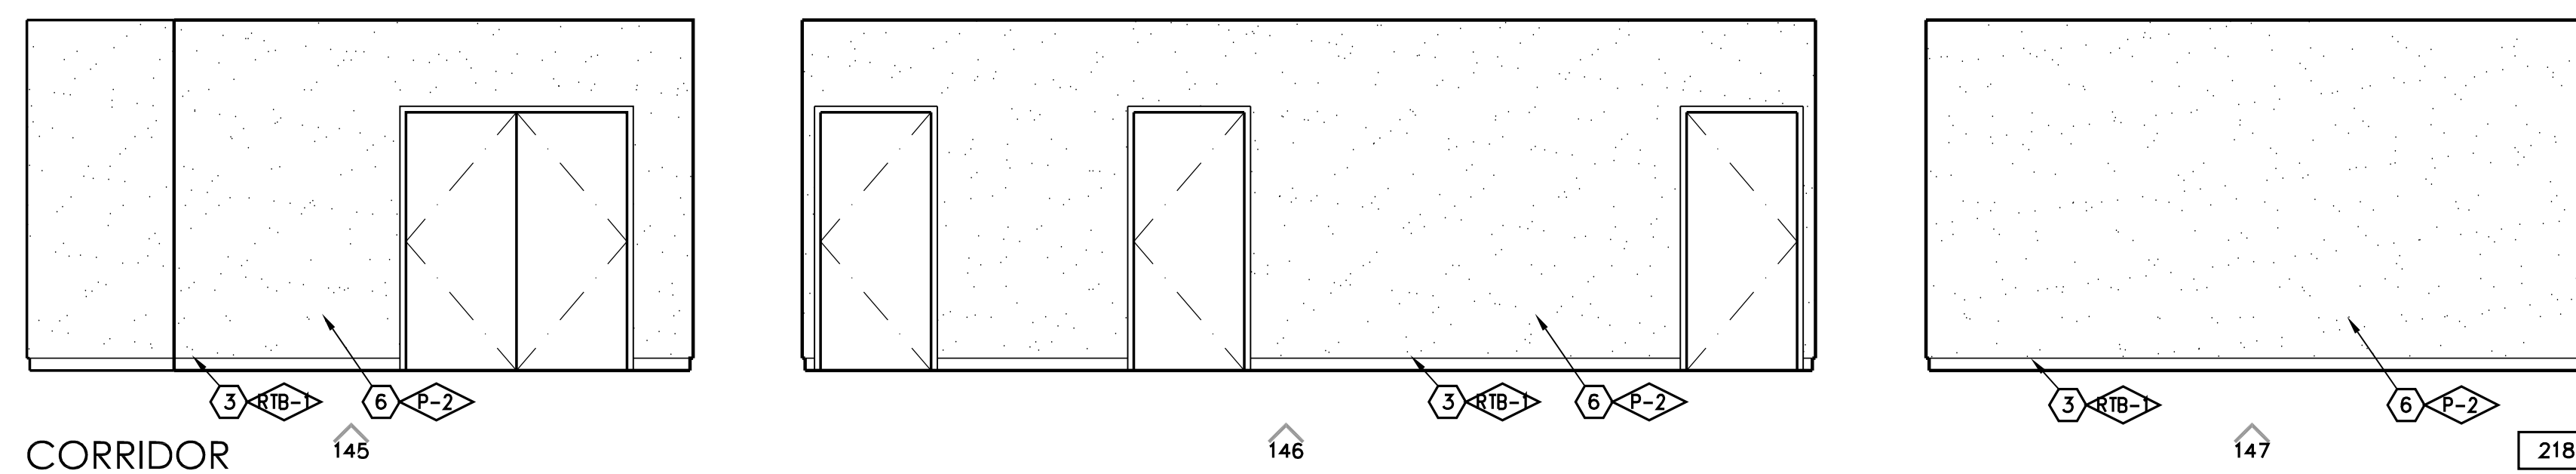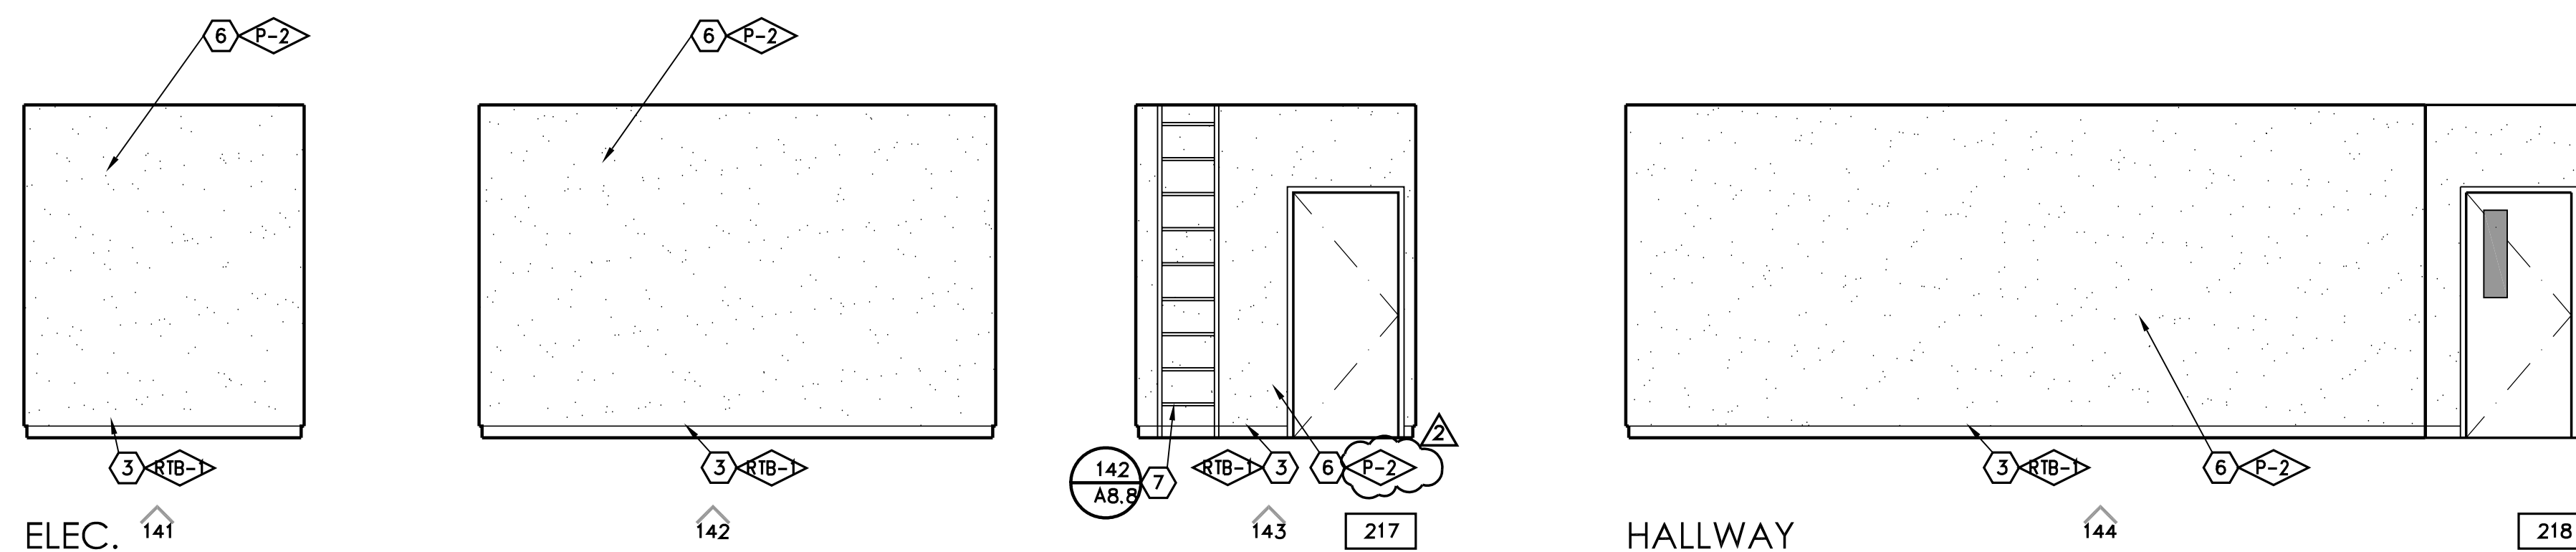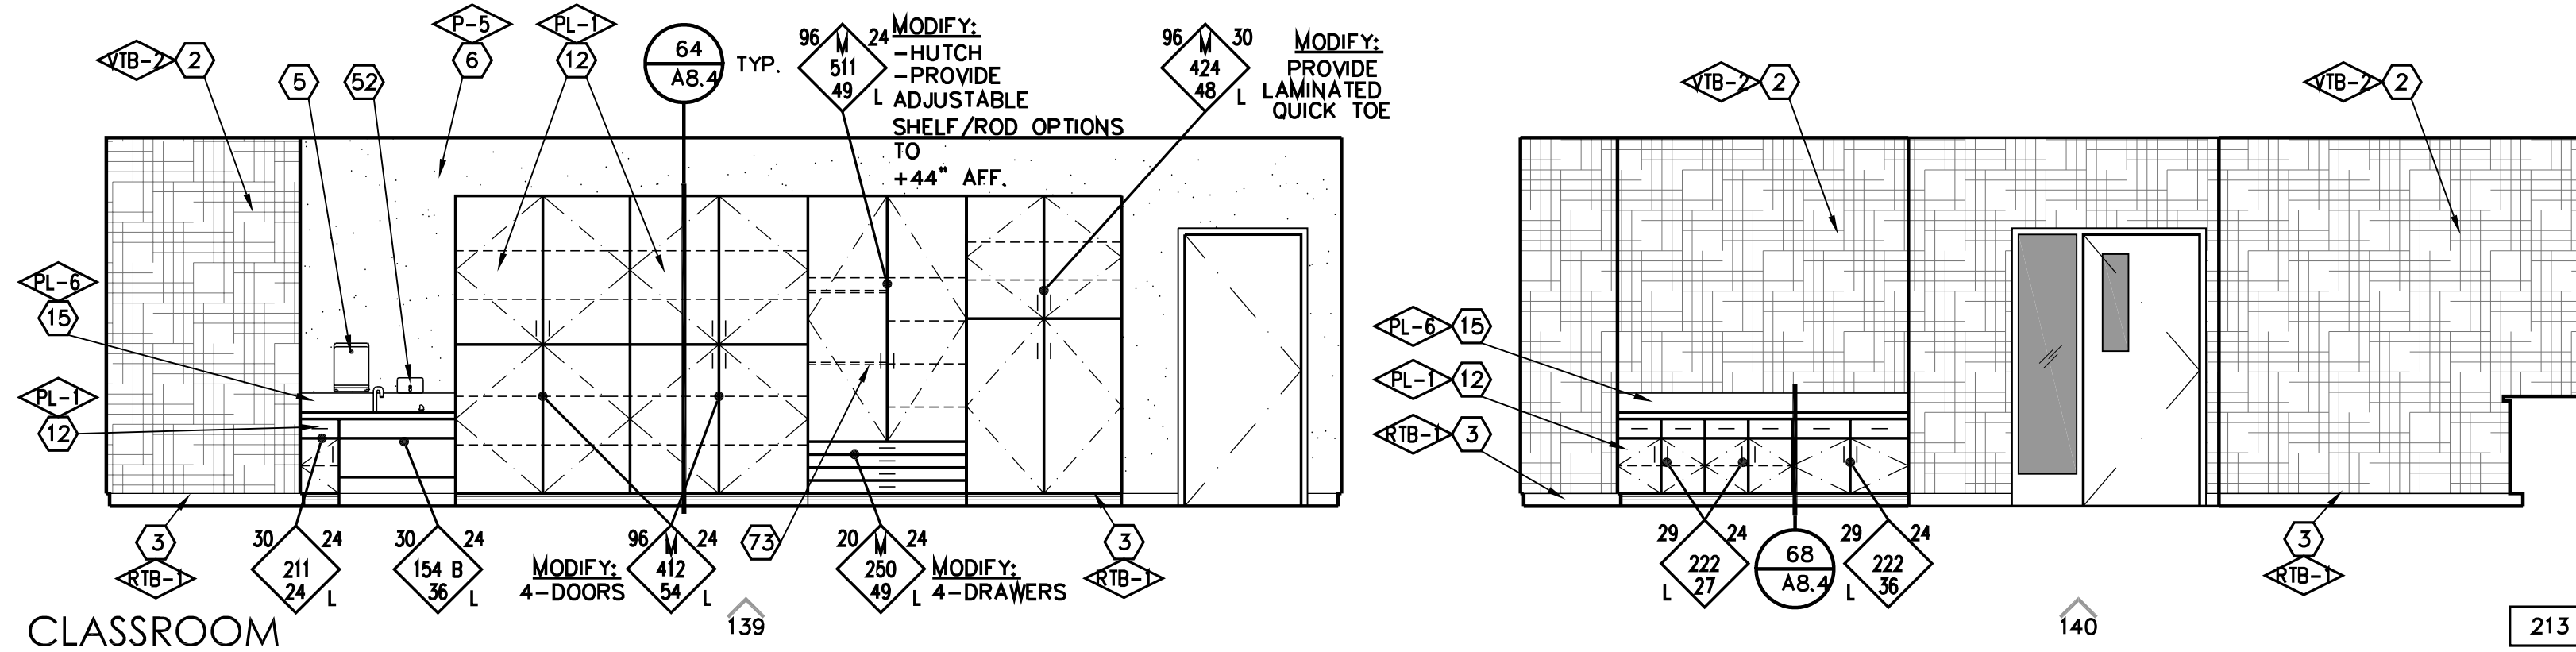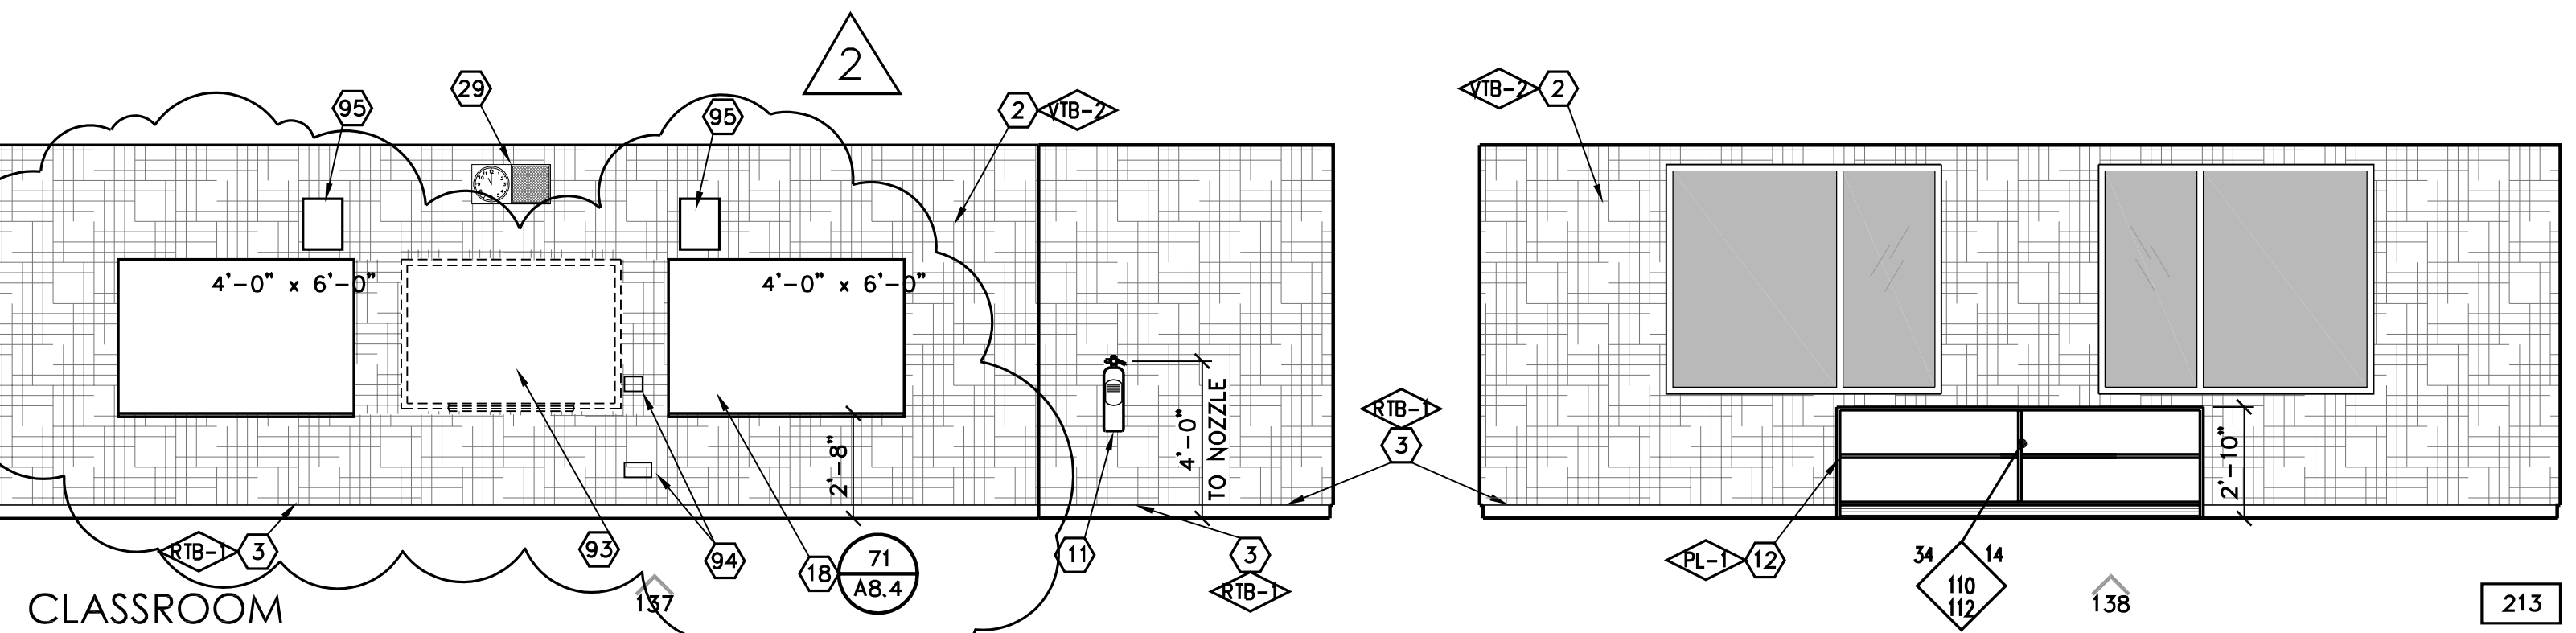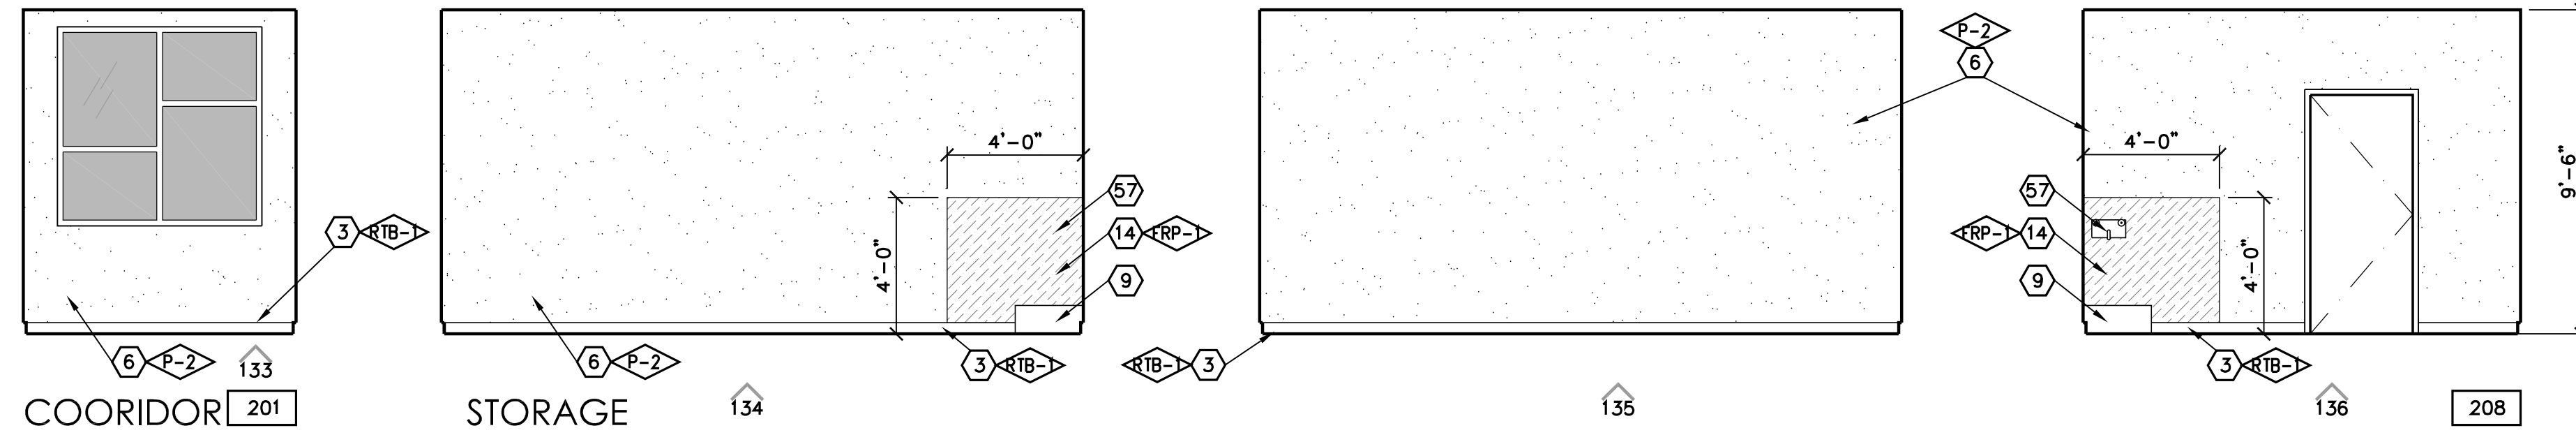


KEYNOTES

1. KNEE SPACE
2. VINYL TACKBOARD o/ GYP. BD.
3. RUBBER TOPSET BASE
4. STOREFRONT
5. PAPER TOWEL DISPENSER
6. GYPSUM BOARD, TAPE, TEXTURE & PAINT (PROVIDE 5/8" TYPE 'X' GYP. AT STAIRWAYS AND UNDERSTAIR WALL/CEILING FINISHES, TYP.)
7. ROOF ACCESS LADDER
8. SOFFIT
9. FLOOR SINK - SEE PLUMBING
10. UNDER-COUNTER REFRIGERATOR
11. FIRE EXTINGUISHER w/ SEMI RECESSED CAB. TYPE 2A:10BC
12. PLASTIC LAMINATE CASEWORK
13. W.I.C. 400 STORAGE SHELVING
14. FIBER REINFORCED PANEL
15. PLASTIC LAMINATE BACKSPLASH & COUNTERTOP
16. METAL POST, PER STRUCTURAL
17. SINK - SEE PLUMBING SCHEDULE
18. MAGNETIC MARKER BOARD o/VTB
19. APPLIANCES - SEE SPEC SECTION 11400
20. BUTCHER PAPER HOLDER
21. DISHWASHER
22. HOOD
23. REFRIGERATOR - FULL HEIGHT
24. COOKTOP
25. ROLL-UP DOOR
26. STAINLESS STEEL COUNTERTOP
27. FURNITURE (N.I.C.)
28. DRINKING FOUNTAIN
29. CLOCK/SPEAKER
30. CLEAR GLASS DISPLAY CASE w/ LOCK (SEE SPEC. SECT. 10410)
31. FEMININE NAPKIN DISPOSAL
32. MIRROR
33. TRACK AND CUBICLE CURTAIN.
34. STAIRCASE
35. HANDRAIL
36. N/A
37. TRANSLUCENT WALL SYSTEM
38. WOOD BASE
39. WHEEL CHAIR LIFT
40. BELOW STAGE STORAGE
41. N/A
42. ELEVATOR LANTERN
43. RAILING, SPACING SHALL BE SUCH THAT A 4" DIA. SPHERE CANNOT PASS THROUGH ANY OPENING, PER CBC 1013
44. CALL BUTTON
45. ELEVATOR DOORS
46. LAVATORY
47. TOILET PAPER DISPENSER
48. TOILET SEAT COVER DISPENSER
49. DATA RACEWAY. SEE ELECTRICAL DRAWINGS.
50. CLOCK
51. 4" HIGH CORNER GUARD, TYP.
52. SOAP DISPENSER
53. PLASTIC TOILET PARTITION
54. SIGNAGE
55. MANUFACTURED 3"Wx6"H MTL. SHELVING, SEE S-1/K8.0
56. SPEAKER ENCLOSURE AND GRILLE
57. MOP/BROOM HOLDER
58. PLASTIC LAM. DOOR, 1 1/2" THICK
59. PROVIDE 3/4" LAM. PLASTIC SUPPORTS AT STOREFRONT, AT 4'-0" O.C.
60. RAYTHERMS (N.I.C.)
61. URINAL
62. MICROWAVE (N.I.C.)
63. PLASTIC LAMINATE CAP
64. CERAMIC TILE
65. GRAB BAR
66. WATER CLOSET
67. METAL LETTERS (SEE SPECS)
68. PONY WALL BEHIND
69. ROOM CAPACITY SIGN
70. TECTUM PANELS
71. 2x3 SHAPED WOOD NAILER
72. UTILITY BOX
73. MOVABLE ROD TO BE PLACED AT 44" FOR ADA COMPLIANCE. OPTIONAL.
74. MOTORIZED SCREEN, SEE 143/AB.8
75. PLASTIC LAMINATE PANELING AND DOORS
76. WINDOW WALL, SEE #2 FOR DEFERRED ITEMS
77. CLEAR GLASS POSTER CASE w/LOCK (SEE SPEC. SECT. 10410)
78. 1/2" REVEAL SCREEDS
79. WALL CLOCK, SEE SPEC SECTION 10050
80. MICROWAVE OVEN
81. PLASTIC LAMINATE COUNTERTOP
82. SOLID SURFACE COUNTERTOP
83. PERFORATED DECORATIVE METAL PANEL
84. WALL PROTECTION PANEL
85. ICE MACHINE
86. CARPET BASE
87. N/A
88. CORNER GUARD
89. STRUCTURAL MEMBER TO BE PAINTED, SEE STRUCTURAL
90. EPOXY, EPF-1
91. CASEWORK
92. TAC-WALL PANELS
93. MONITOR WITH
94. MONITOR CONTROL DEVICE & HDMI DEVICES, DISTRICT WILL VERIFY LOCATION
95. WALL MOUNTED SPEAKERS, DISTRICT TO VERIFY LOCATION

- NOTES:
1. SEE DTL. 219/AB.11 FOR ACCESSIBILITY STANDARDS
 2. ALL SHELVING WITH SPANS GREATER THAN 30" TO BE 1" THICK
 3. REFER TO COLOR SCHEDULE (SHEET A2.8) FOR ALL COLOR REFERENCES, TYP.
 4. ALL CARPET USES A CARPET BASE #86
 5. ALL MONDO RUBBER FLOORS USE A RUBBER TOPSET BASE #3
 6. ALL AHRO FLOORS USE SELF-COVER BASE #41
 7. ALL STAINED & DYED CONCRETE FLOORS USE TOPSET #3

SYMBOL LEGEND

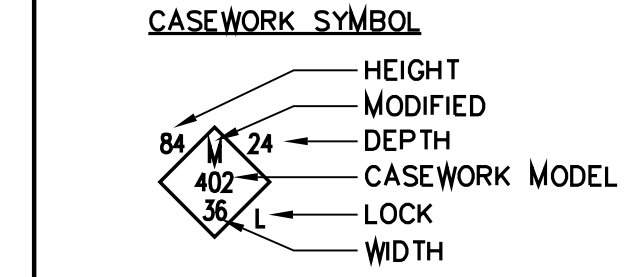


7780 NORTH PALM AVENUE
 FRESNO, CALIFORNIA 93711
 T 559.448.8400 F 559.448.8467
 www.sim-pbk.com

SHIELDS & BRAWLEY ELEMENTARY SCHOOL



AD 2-31a
 S&B Elementary
 02-116800









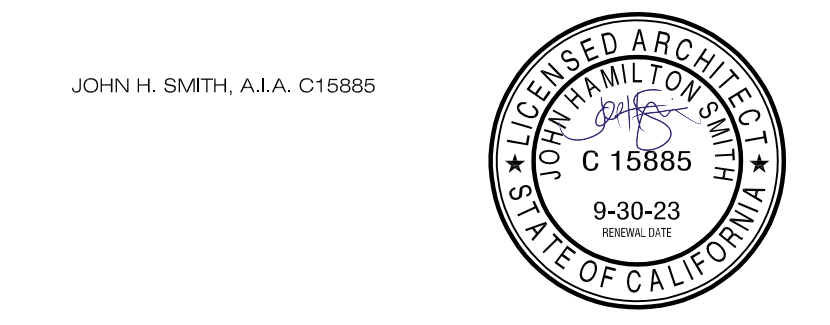


THE FIRM OF SMITH, IWANAGA, MCHUGH, ARCHITECTS, INC. EXPRESSLY RESERVES ITS COMMON LAW COPYRIGHT AND OTHER APPLICABLE PROPERTY RIGHTS IN THESE PLANS. THESE PLANS ARE NOT TO BE REPRODUCED, CHANGED, OR COPIED IN ANY MANNER WITHOUT THE WRITTEN PERMISSION AND CONSENT OF THE ARCHITECT. IN THE EVENT OF UNAUTHORIZED REUSE OF THESE PLANS BY A THIRD PARTY, THE THIRD PARTY SHALL HOLD THE ARCHITECT HARMLESS, AND SHALL BEAR THE COST OF THE ARCHITECT'S LEGAL FEES ASSOCIATED WITH DEFENDING AND ENFORCING THESE RIGHTS.

| PROJECT DEVELOPMENT | |
|---------------------|------------|
| DATE | ISSUED FOR |
| | |
| | |
| REVISIONS | | |
|-----------|---------|------------------------|
| No. | DATE | DESCRIPTION |
| Δ | 2.14.23 | DISTRICT MODIFICATIONS |
| Δ | 2.27.23 | DISTRICT MODIFICATIONS |
| | | |
| | | |
| | | |

| SHEET DESCRIPTION | |
|--|--------------|
| INTERIOR ELEVATIONS | |
| MAIN - 2ND FLOOR | |
| PROJECT COORDINATOR JOHN SMITH | SHEET No. |
| PROJECT NO. 17-67 | A5.14 |
| DATE 1.27.23 | |
| SCALE 1/4"=1'-0" | |

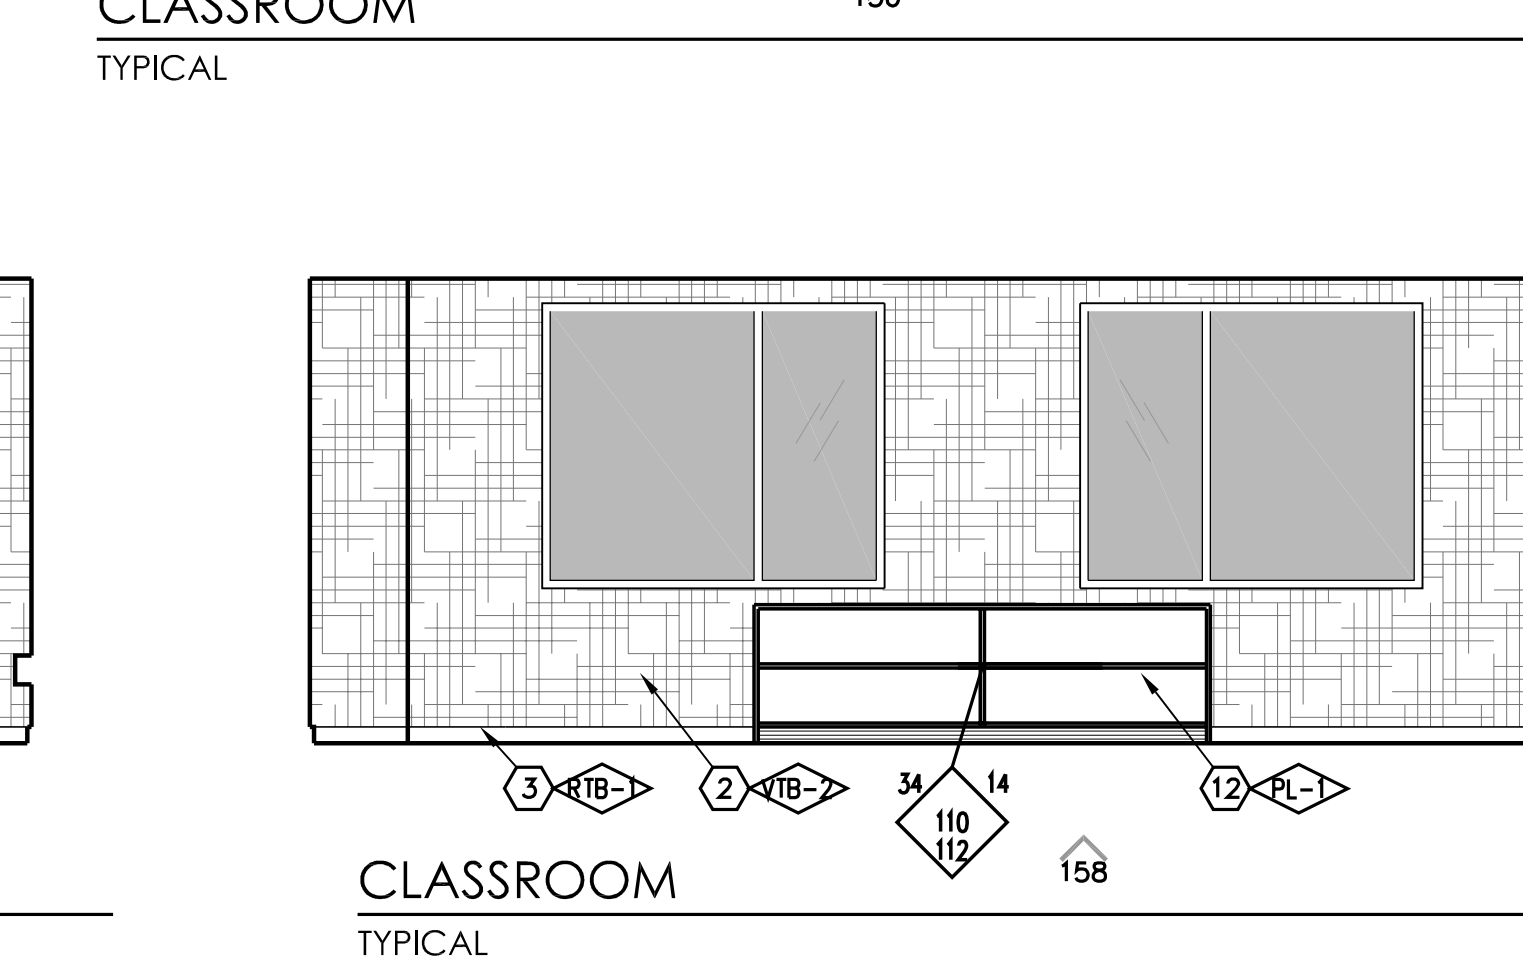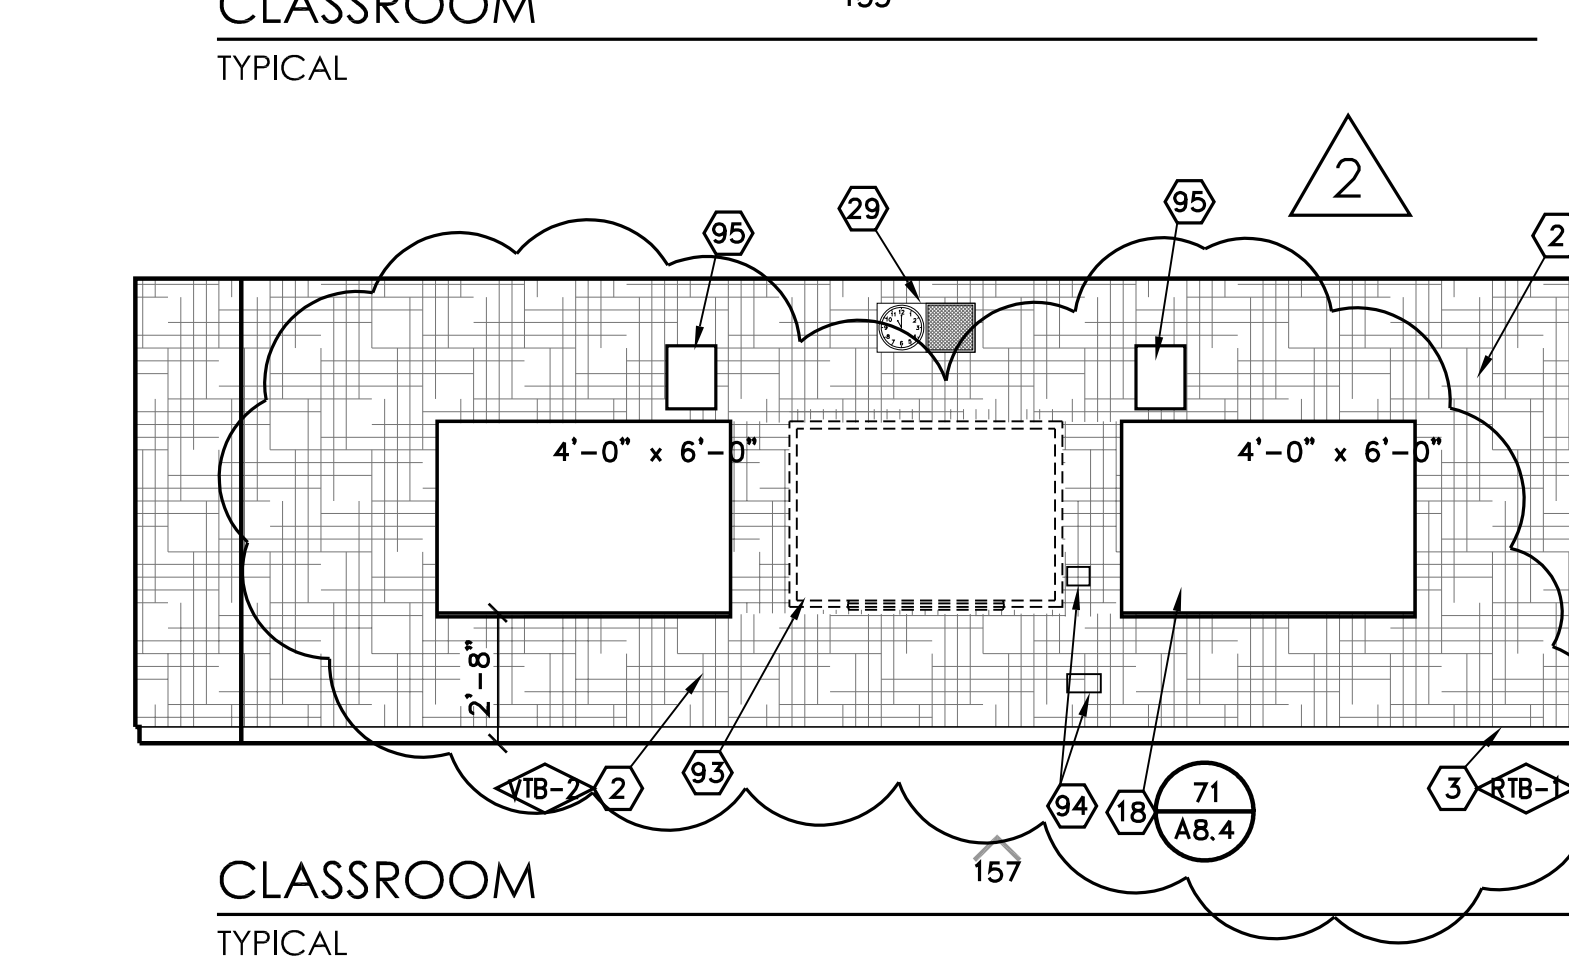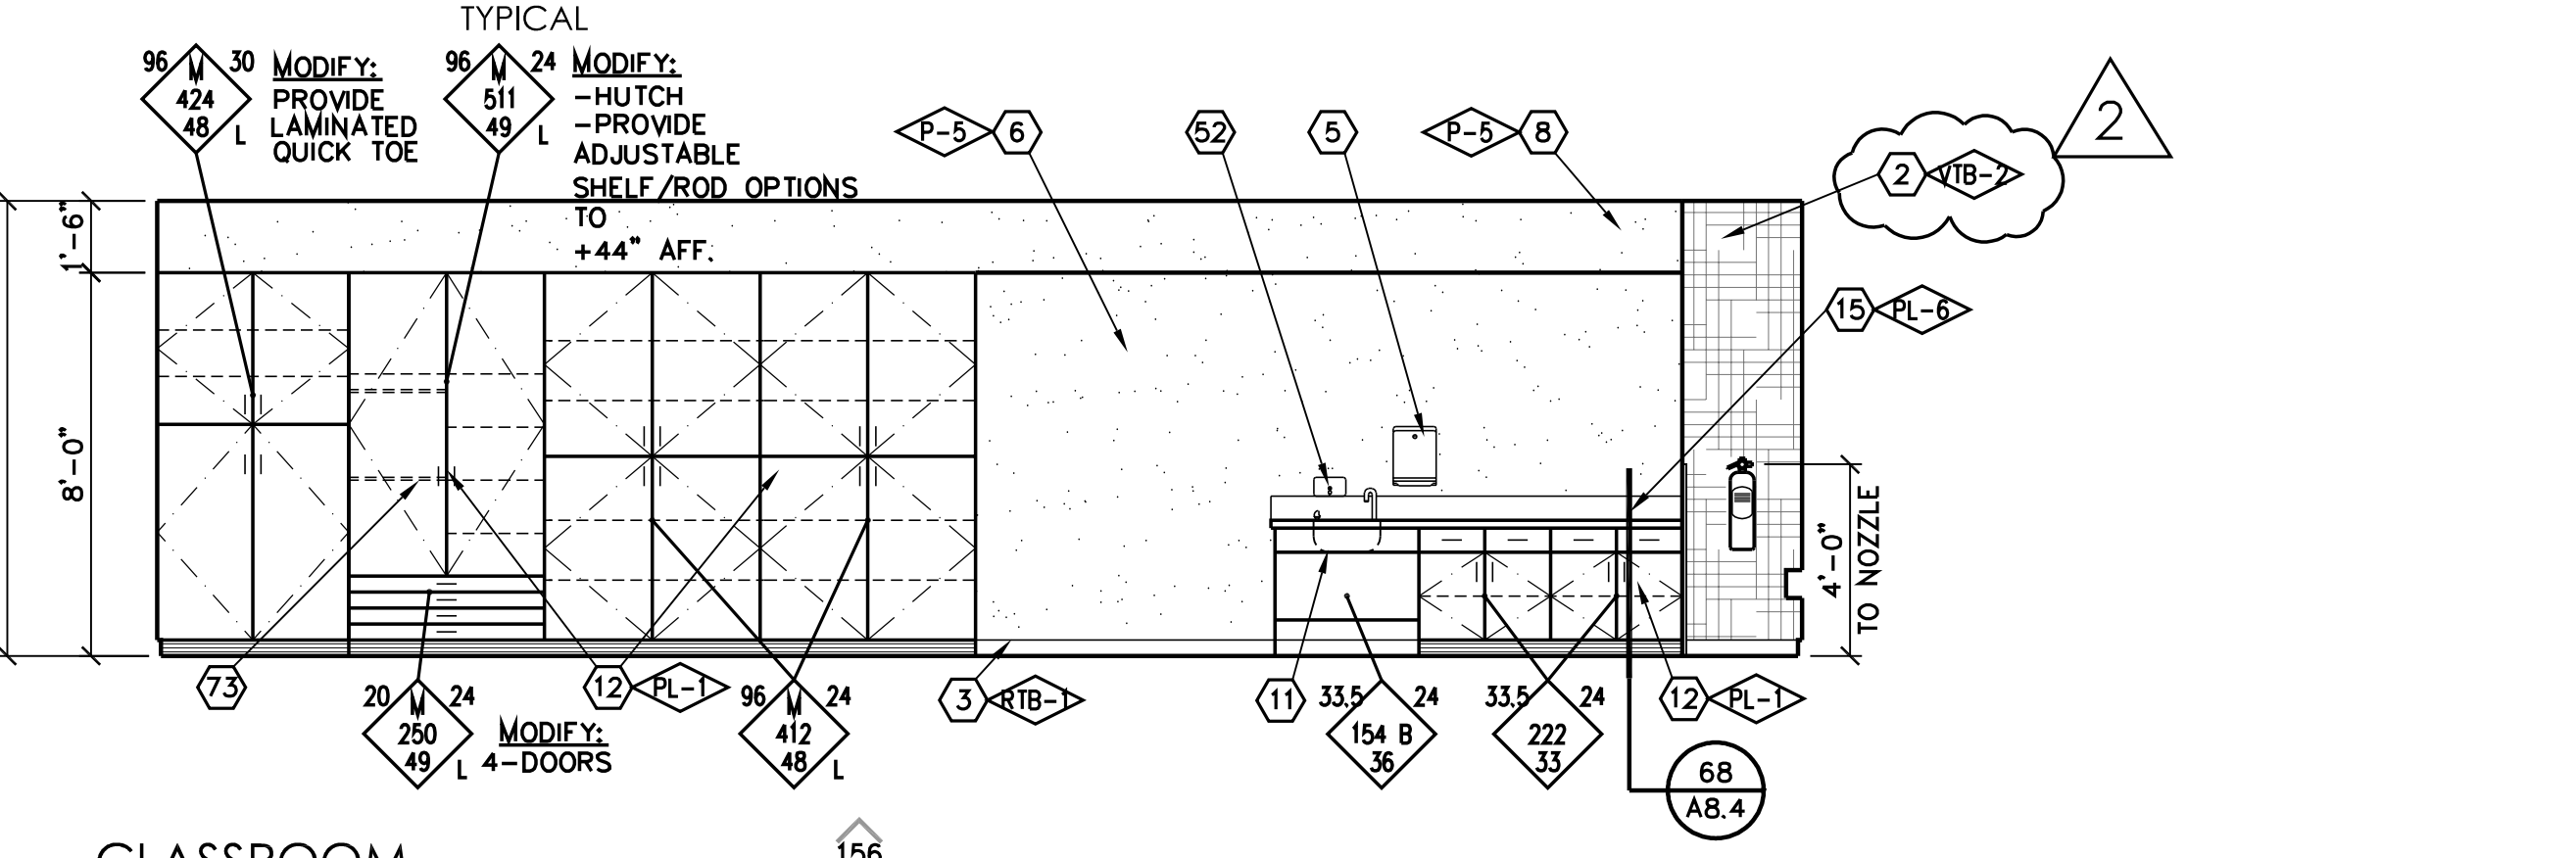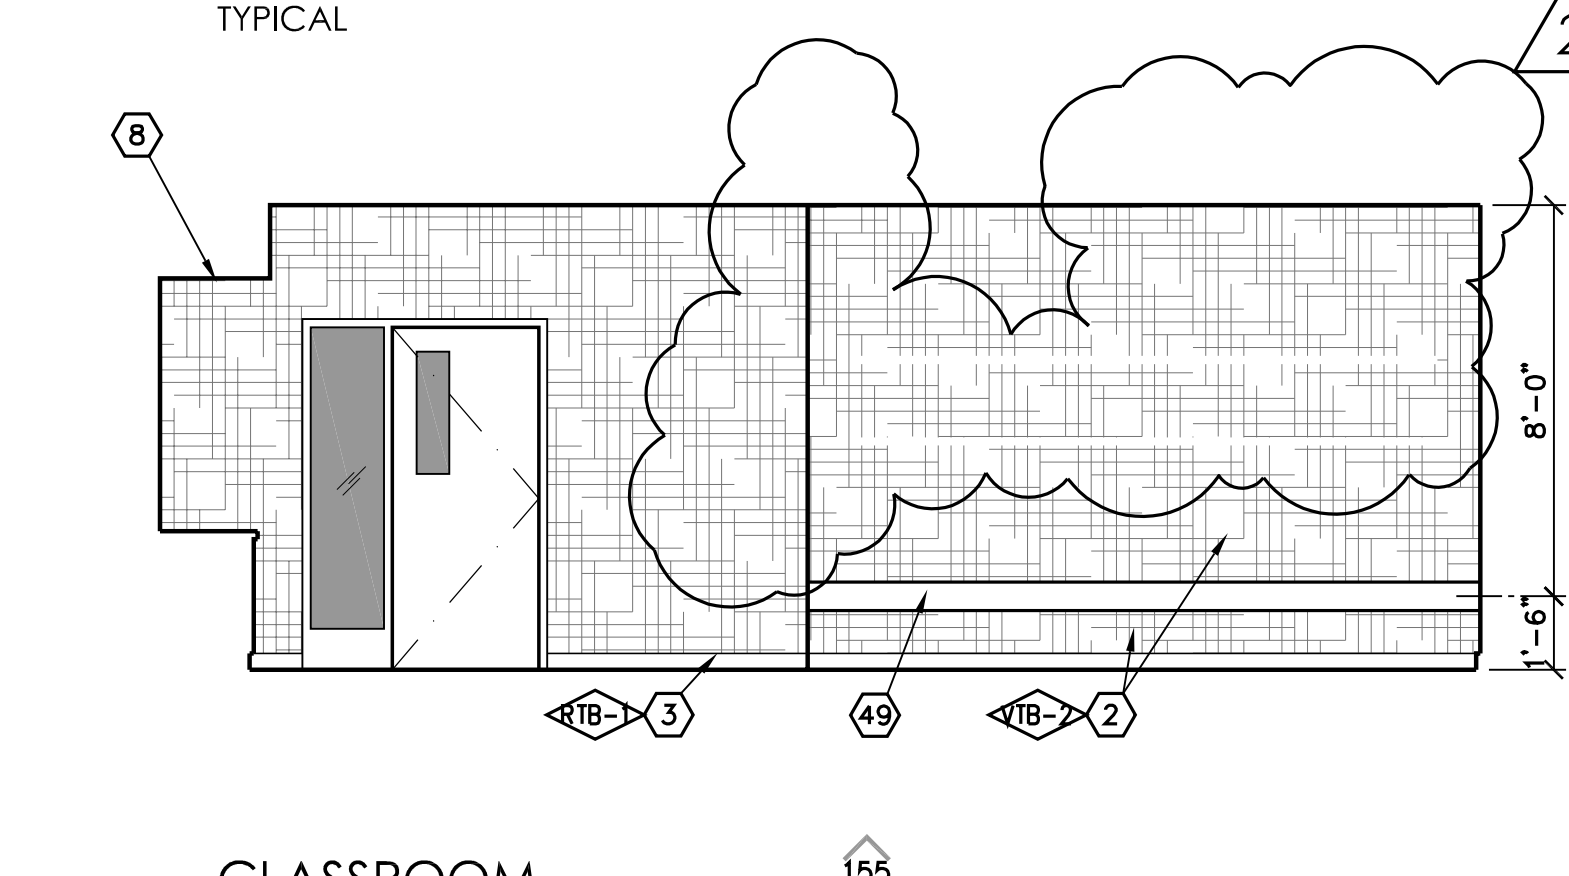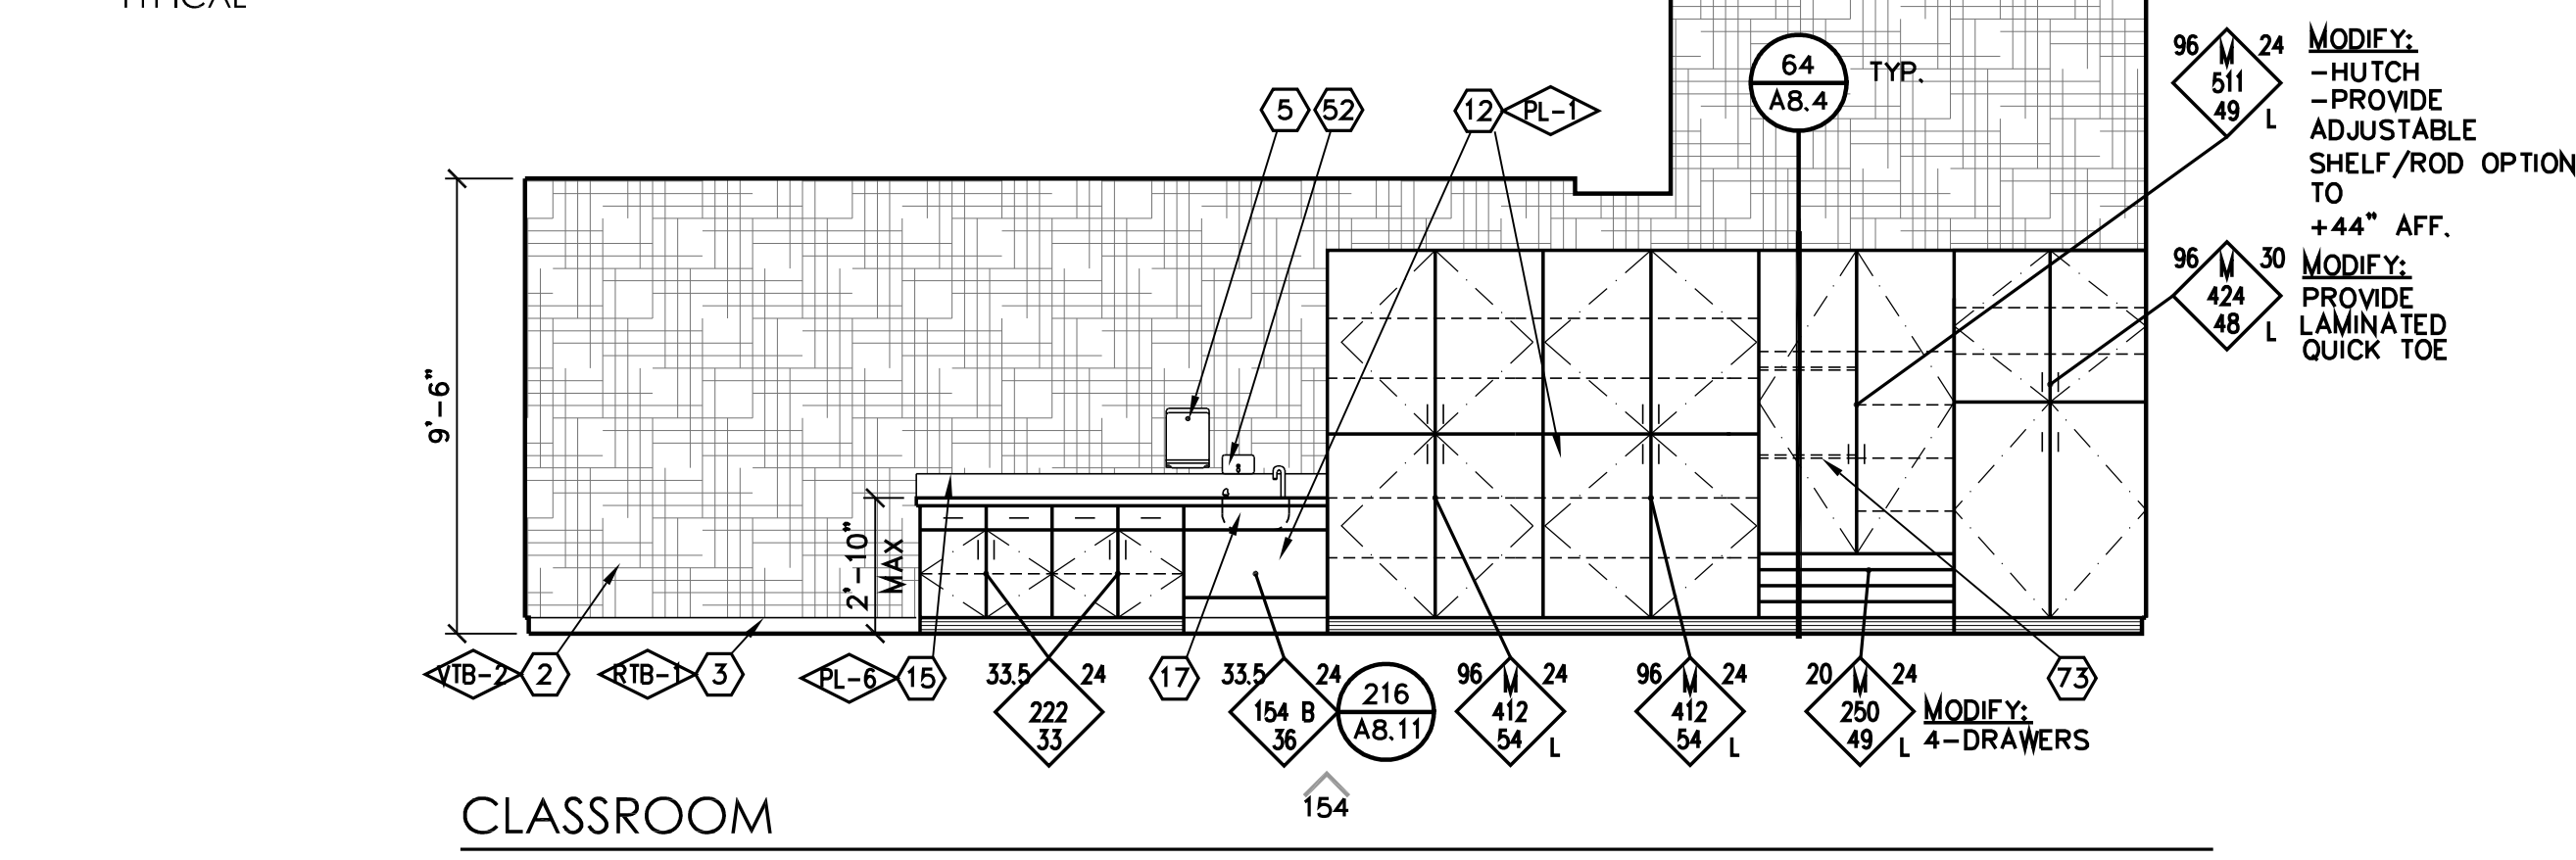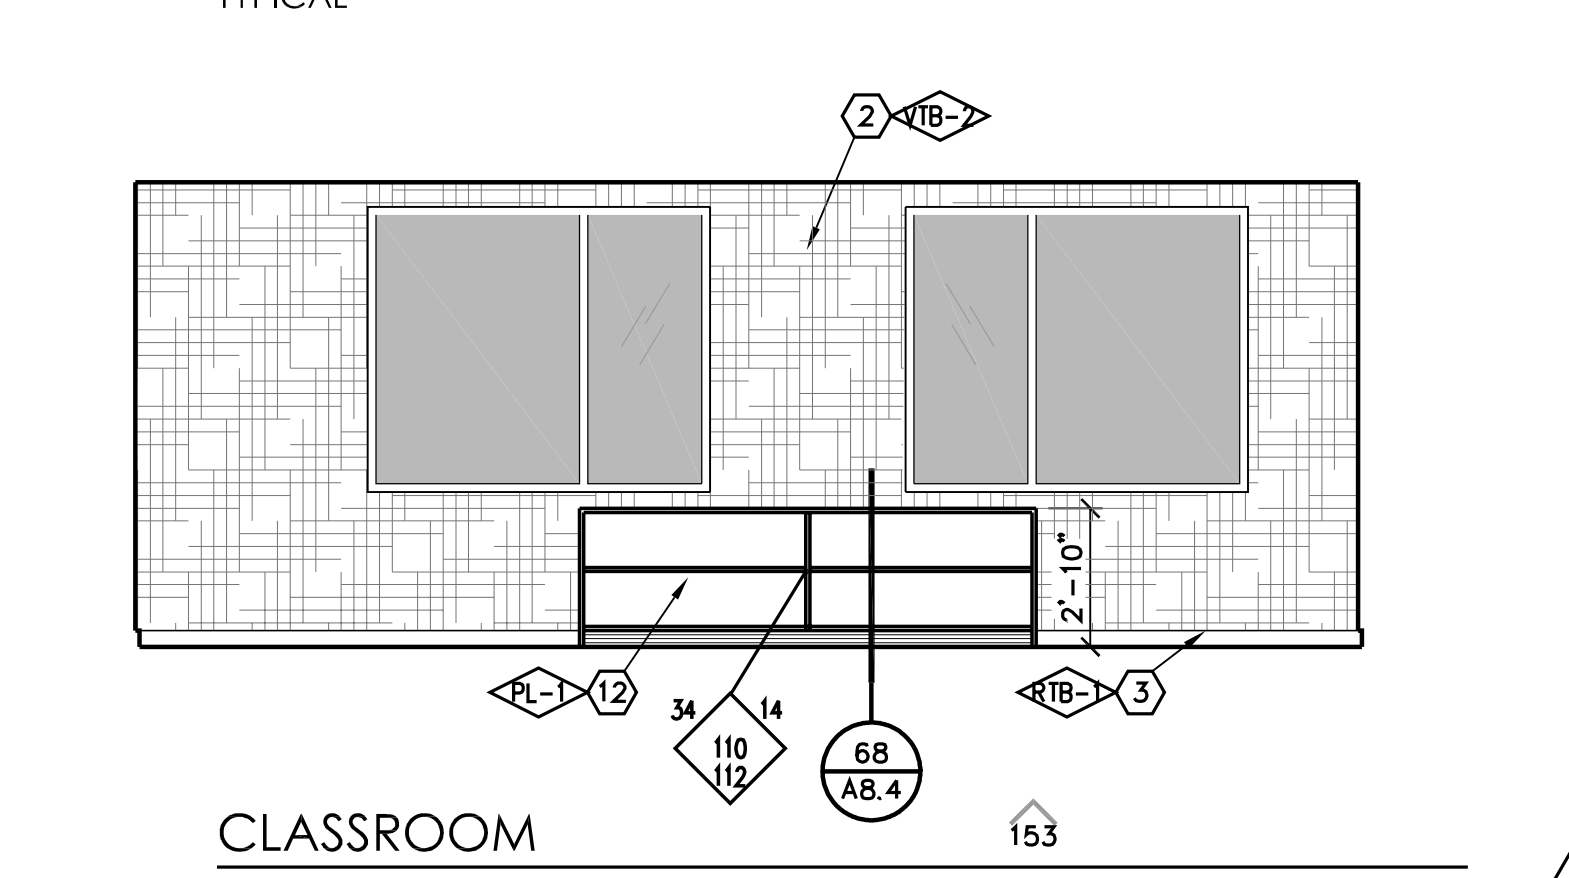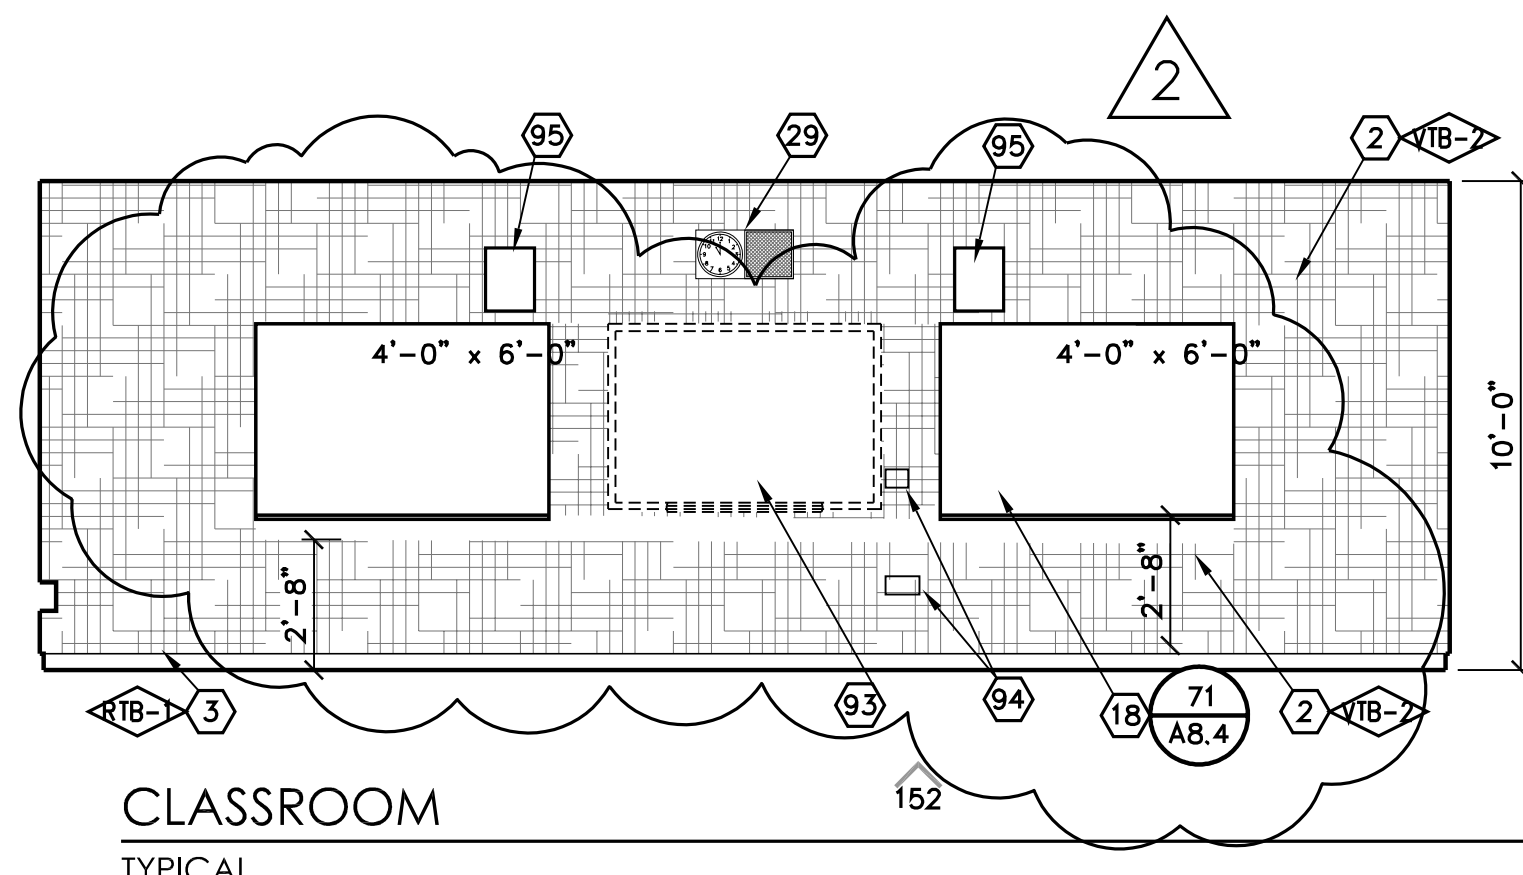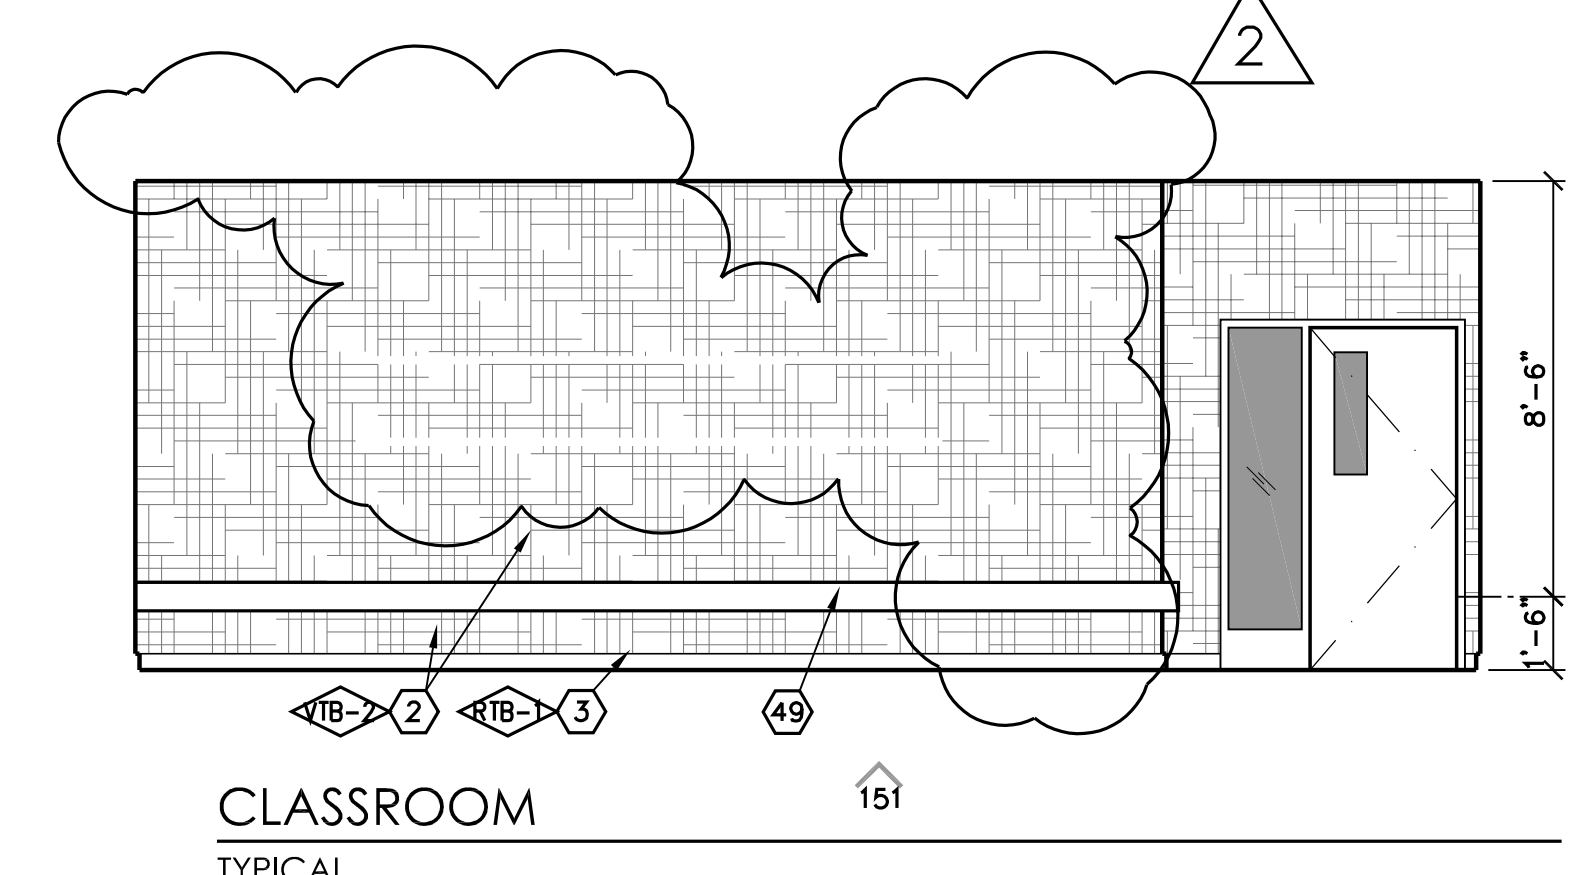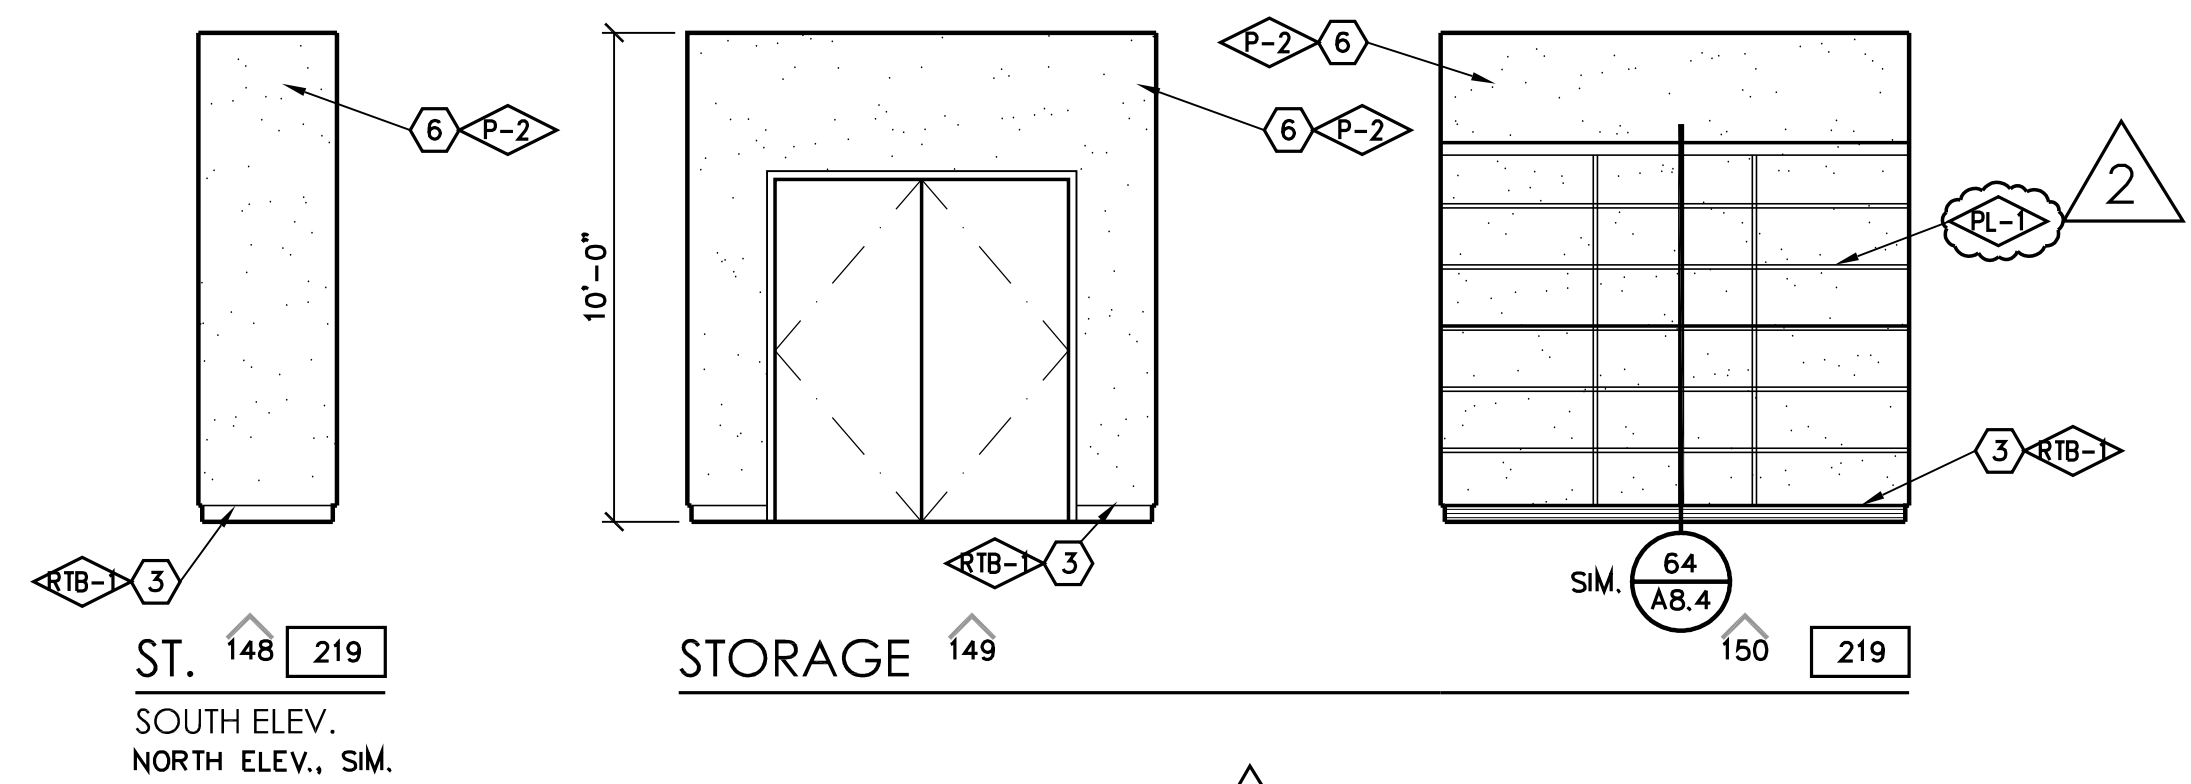


KEYNOTES

1. KNEE SPACE
2. VINYL TACKBOARD o/ GYP. BD.
3. RUBBER TOPSET BASE
4. STOREFRONT
5. PAPER TOWEL DISPENSER
6. GYPSUM BOARD, TAPE, TEXTURE & PAINT (PROVIDE 5/8" TYPE 'X' GYP. BD. AT STAIRWAYS AND UNDERSTAIR WALL/CEILING FINISHES, TYP.)
7. ROOF ACCESS LADDER
8. SOFFIT
9. FLOOR SINK - SEE PLUMBING
10. UNDER-COUNTER REFRIGERATOR
11. FIRE EXTINGUISHER w/ SEMI RECESSED CAB. TYPE 2A:10BC
12. PLASTIC LAMINATE CASEWORK
13. W.I.C. 400 STORAGE SHELVING
14. FIBER REINFORCED PANEL
15. PLASTIC LAMINATE BACKSPLASH & COUNTERTOP
16. METAL POST, PER STRUCTURAL
17. SINK - SEE PLUMBING SCHEDULE
18. MAGNETIC MARKER BOARD o/VTB
19. APPLIANCES - SEE SPEC SECTION 11400
20. BUTCHER PAPER HOLDER
21. DISHWASHER
22. HOOD
23. REFRIGERATOR - FULL HEIGHT
24. COOKTOP
25. ROLL-UP DOOR
26. STAINLESS STEEL COUNTERTOP
27. FURNITURE (N.I.C.)
28. DRINKING FOUNTAIN
29. CLOCK/SPEAKER
30. CLEAR GLASS DISPLAY CASE w/ LOCK (SEE SPEC. SECT. 10410)
31. FEMININE NAPKIN DISPOSAL
32. MIRROR
33. TRACK AND CUBICLE CURTAIN.
34. STAIRCASE
35. HANDRAIL
36. N/A
37. TRANSLUCENT WALL SYSTEM
38. WOOD BASE
39. WHEEL CHAIR LIFT
40. BELOW STAGE STORAGE
41. N/A
42. ELEVATOR LANTERN
43. RAILING, SPACING SHALL BE SUCH THAT A 4" DIA. SPHERE CANNOT PASS THROUGH ANY OPENING, PER CBC 1013
44. CALL BUTTON
45. ELEVATOR DOORS
46. LAVATORY
47. TOILET PAPER DISPENSER
48. TOILET SEAT COVER DISPENSER
49. DATA RACEWAY, SEE ELECTRICAL DRAWINGS.
50. CLOCK
51. 4' HIGH CORNER GUARD, TYP.
52. SOAP DISPENSER
53. PLASTIC TOILET PARTITION
54. SIGNAGE
55. MANUFACTURED 3"Wx6"H WTL. SHELVING, SEE S-1/K8.0
56. SPEAKER ENCLOSURE AND GRILLE
57. MOP/BROOM HOLDER
58. PLASTIC LAM. DOOR, 1 1/2" THICK
59. PROVIDE 3/4" LAM. PLASTIC SUPPORTS AT STOREFRONT, AT 4'-0" O.C.
60. RAYTHERMS (N.I.C.)
61. URINAL
62. MICROWAVE (N.I.C.)
63. PLASTIC LAMINATE CAP
64. CERAMIC TILE
65. GRAB BAR
66. WATER CLOSET
67. METAL LETTERS (SEE SPECS)
68. PONY WALL BEHIND
69. ROOM CAPACITY SIGN
70. TECTUM PANELS
71. 2x3 SHAPED WOOD NAILER
72. UTILITY BOX
73. MOVABLE ROD TO BE PLACED AT 44" FOR ADA COMPLIANCE, OPTIONAL.
74. MOTORIZED SCREEN, SEE 143/A8.8
75. PLASTIC LAMINATE PANELING AND DOORS
76. WINDOW WALL, SEE T2 FOR DEFERRED ITEMS
77. CLEAR GLASS POSTER CASE w/LOCK (SEE SPEC. SECT. 10410)
78. 1/2" REVEAL SCREEDS
79. WALL CLOCK, SEE SPEC SECTION 10050
80. MICROWAVE OVEN
81. PLASTIC LAMINATE COUNTERTOP
82. SOLID SURFACE COUNTERTOP
83. PERFORATED DECORATIVE METAL PANEL
84. WALL PROTECTION PANEL
85. ICE MACHINE
86. CARPET BASE
87. N/A
88. CORNER GUARD
89. STRUCTURAL MEMBER TO BE PAINTED, SEE STRUCTURAL EPOXY, EPF-1
90. CASEWORK
91. TAG-WALL PANELS
92. MONITOR WITH
93. 75" MONITOR WITH
94. MONITOR CONTROL DEVICE & HDMI DEVICES, DISTRICT WILL VERIFY LOCATION
95. WALL MOUNTED SPEAKERS, DISTRICT TO VERIFY LOCATION.

- NOTES:
1. SEE DTL 219/A8.11 FOR ACCESSIBILITY STANDARDS
 2. ALL SHELVING WITH SPANS GREATER THAN 30" TO BE 1" THICK
 3. REFER TO COLOR SCHEDULE (SHEET A2.8) FOR ALL COLOR REFERENCES, TYP.
 4. ALL CARPET USES A CARPET BASE #86
 5. ALL MONDO RUBBER FLOORS USE A RUBBER TOPSET BASE #3
 6. ALL AHRO FLOORS USE SELF-COVER BASE #41
 7. ALL STAINED & DYED CONCRETE FLOORS USE TOPSET #3

SYMBOL LEGEND

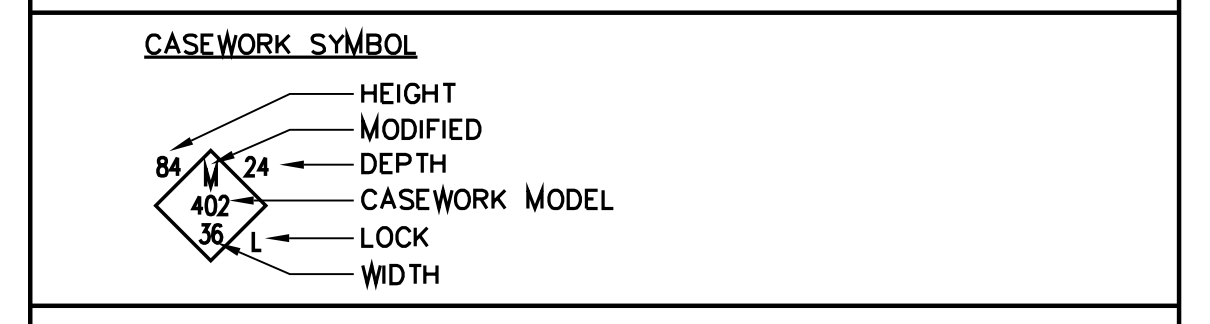

PROJECT DEVELOPMENT

| DATE | ISSUED FOR |
|------|------------|
| | |
| | |
| | |

REVISIONS

| No. | DATE | DESCRIPTION |
|-----|---------|------------------------|
| △ | 2.14.23 | DISTRICT MODIFICATIONS |
| △ | 2.27.23 | DISTRICT MODIFICATIONS |
| | | |
| | | |

SHEET DESCRIPTION


INTERIOR ELEVATIONS
MAIN - 2ND FLOOR

| | |
|--|--------------|
| PROJECT COORDINATOR JOHN SMITH | SHEET No. |
| PROJECT NO. 17-67 | A5.15 |
| DATE 1.27.23 | |
| SCALE 1/4"=1'-0" | |




7790 NORTH PALM AVENUE
FRESNO, CALIFORNIA 93711
T559.448.8400 · F559.448.8467
www.sim-pbk.com


PROJECT:
SHIELDS & BRAWLEY ELEMENTARY SCHOOL

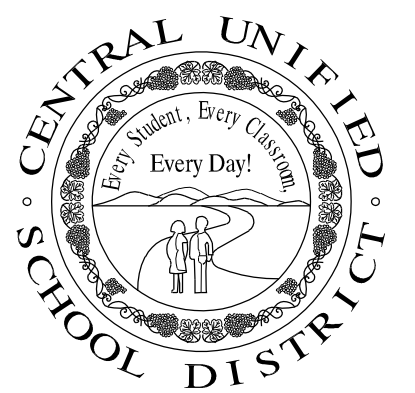


AD 2-32a
S&B Elementary
02-116800

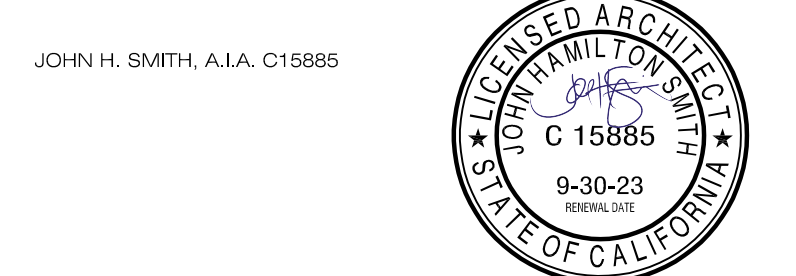


THE FIRM OF SMITH, EVANAGA, MILHOUS, ARCHITECTS, INC. EXPRESSLY RESERVES ITS COMMON LAW COPYRIGHT AND OTHER APPLICABLE PROPERTY RIGHTS IN THESE PLANS. THESE PLANS ARE NOT TO BE REPRODUCED, CHANGED, OR COPIED IN ANY FORM OR MANNER WHATSOEVER, NOR ARE THEY TO BE ASSIGNED TO A THIRD PARTY WITHOUT FIRST OBTAINING THE WRITTEN PERMISSION AND CONSENT OF THE ARCHITECT. IN THE EVENT OF UNAUTHORIZED REUSE OF THESE PLANS BY A THIRD PARTY, THE THIRD PARTY SHALL HOLD THE ARCHITECT HARMLESS, AND SHALL BEAR THE COST OF THE ARCHITECT'S LEGAL FEES, ASSOCIATED WITH DEFENDING AND ENFORCING THESE RIGHTS.

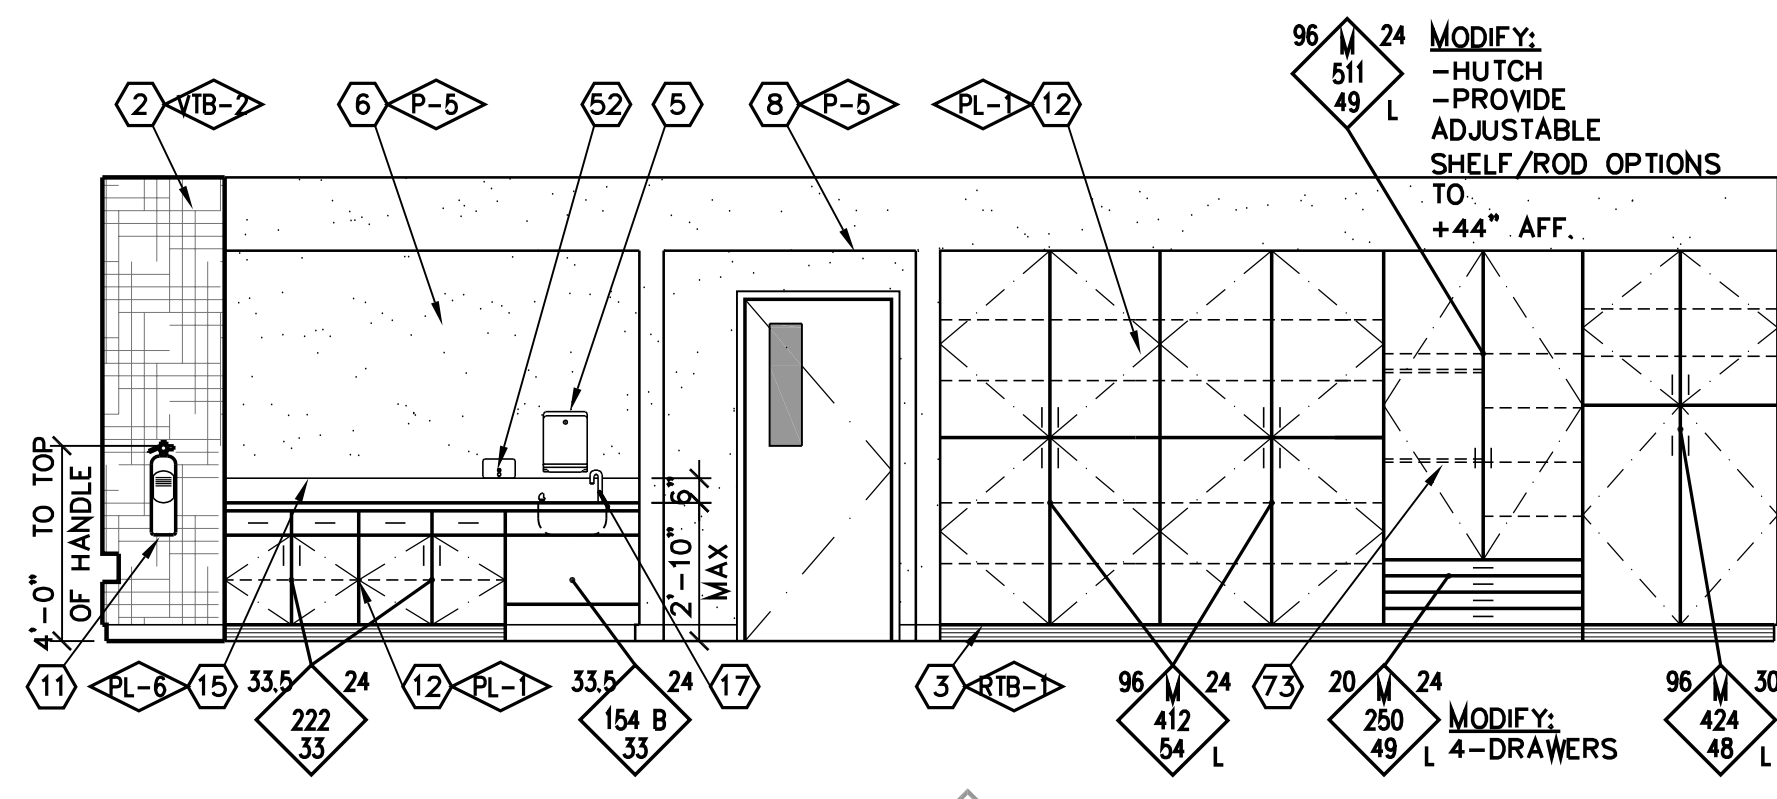


CLASSROOM 159
TYPICAL

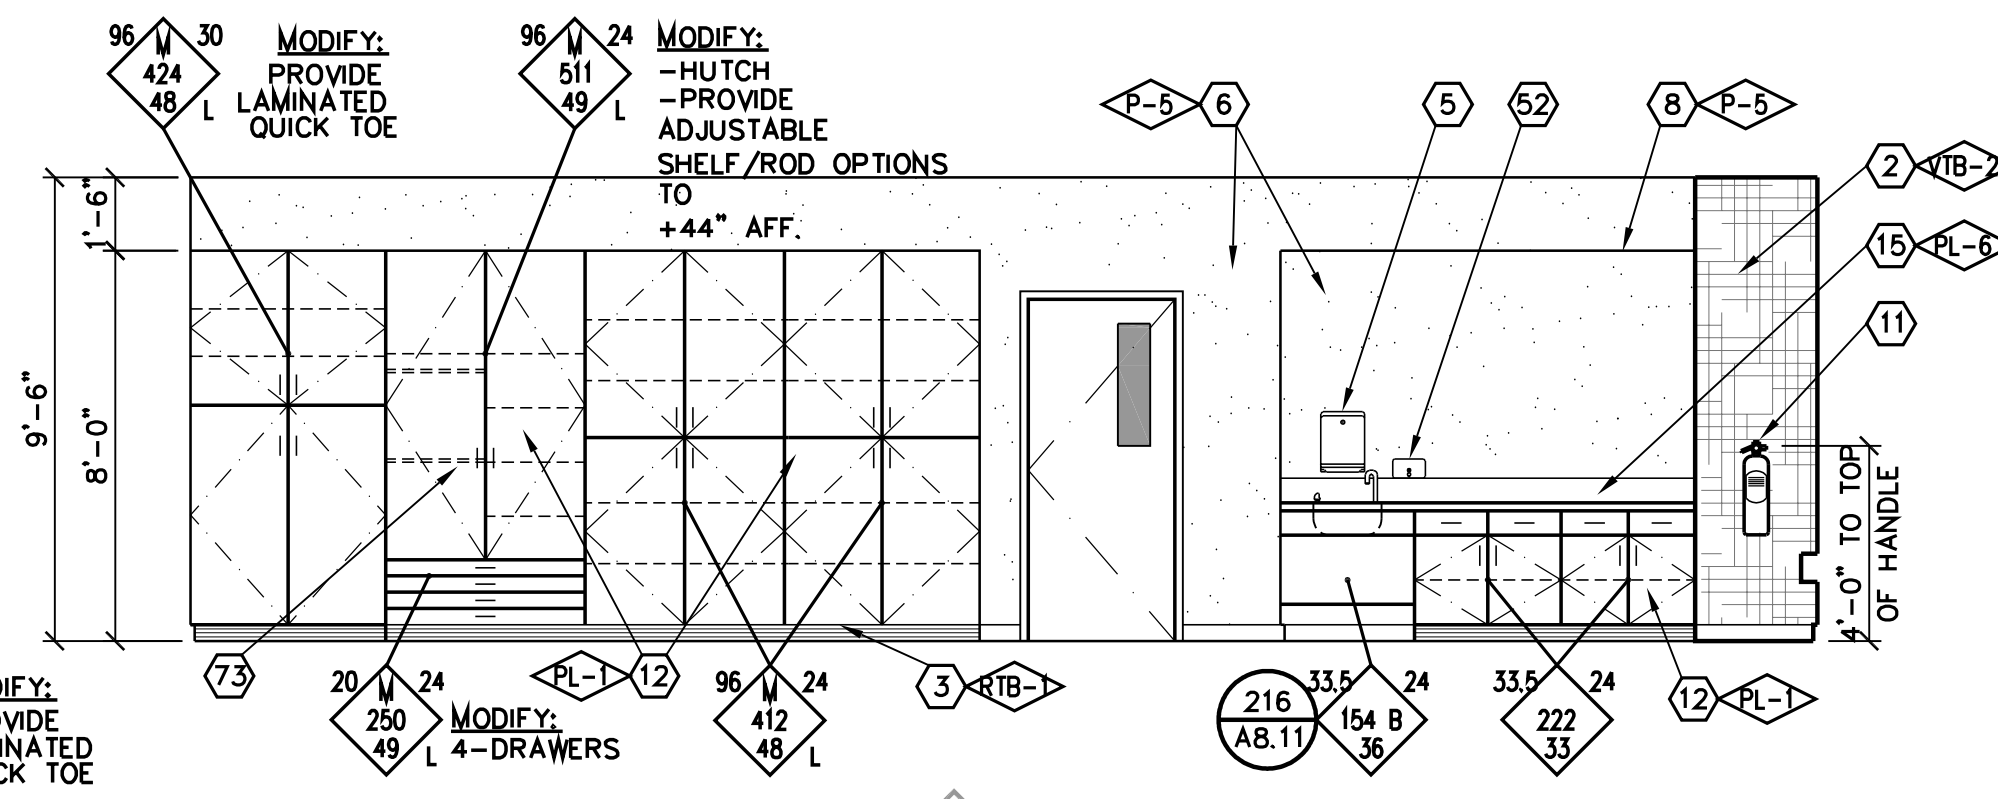


CLASSROOM 160
TYPICAL

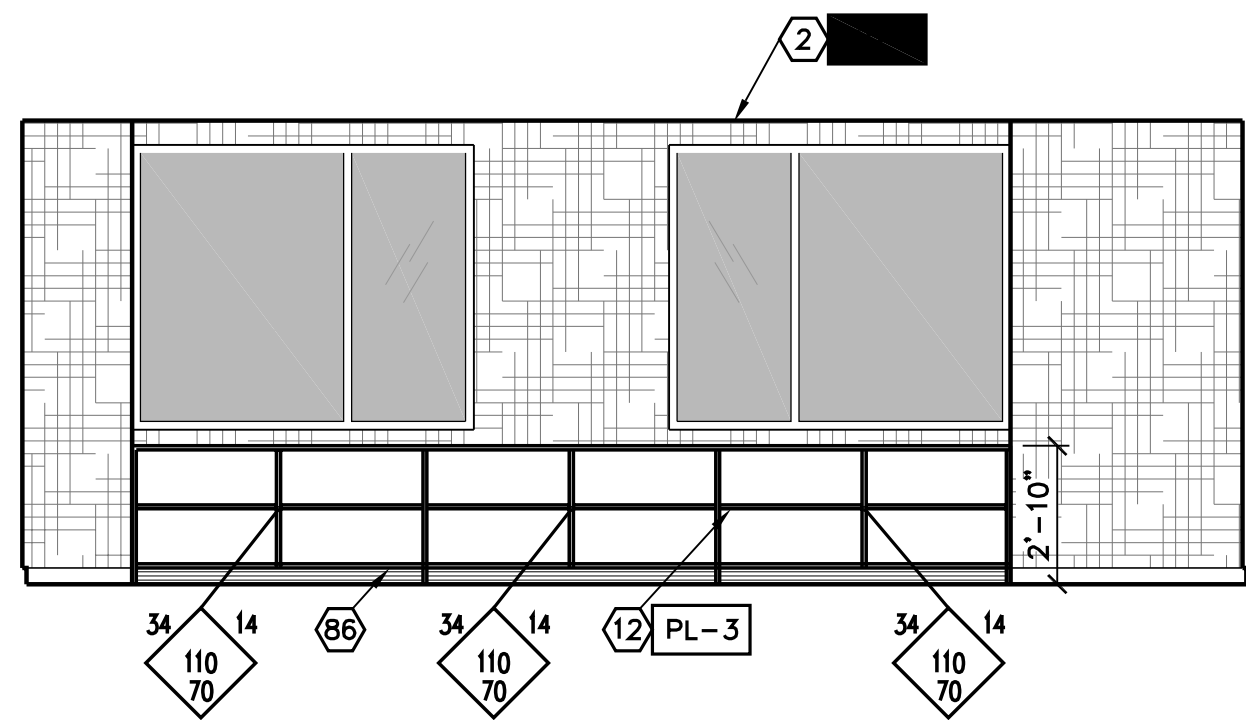


CLASSROOM 161
TYPICAL

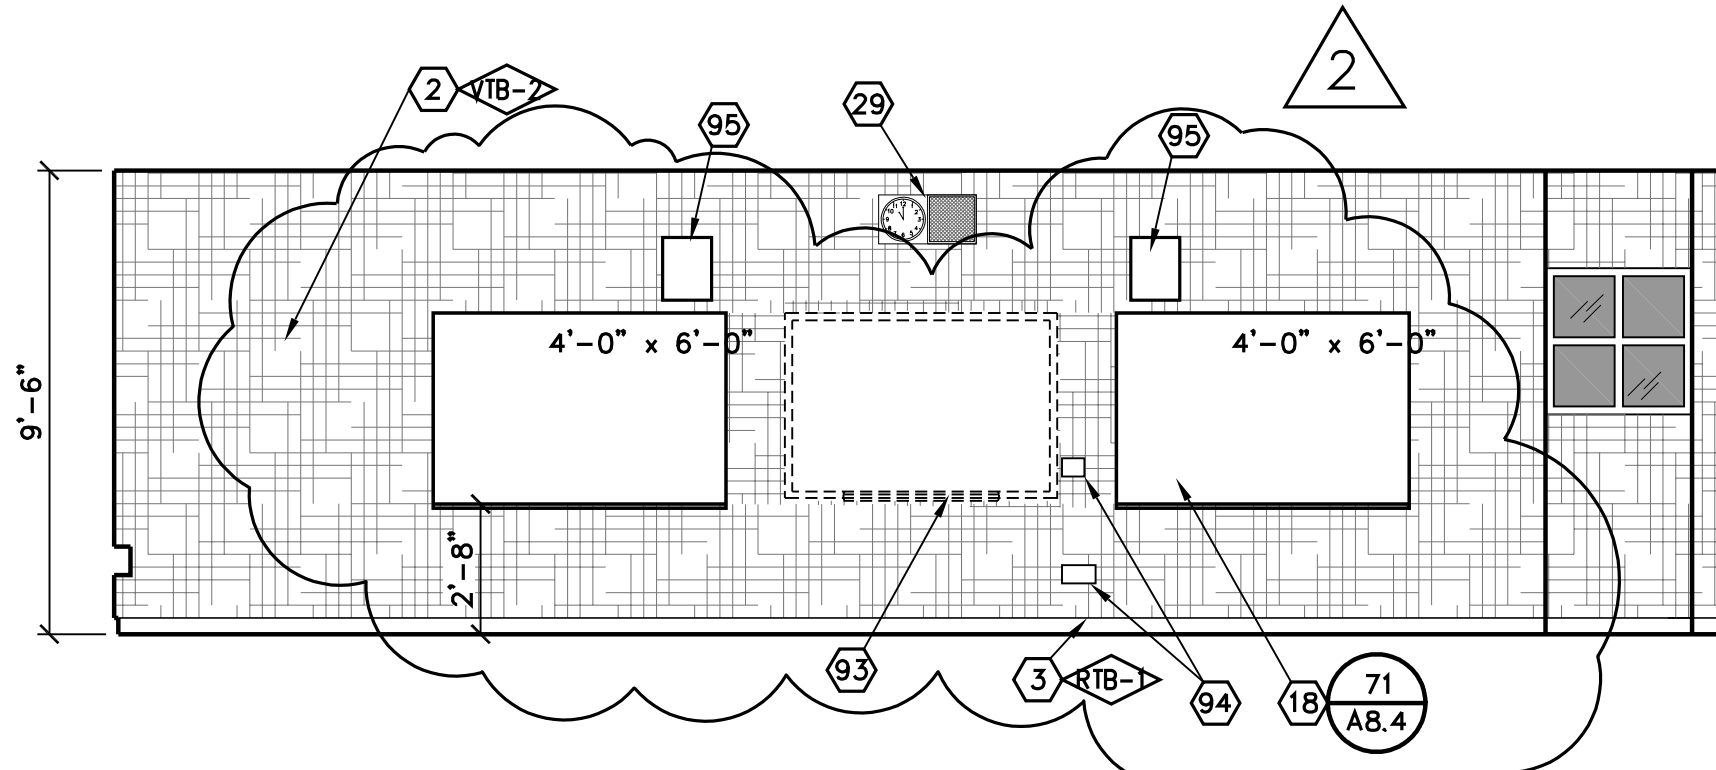


CLASSROOM 162
TYPICAL

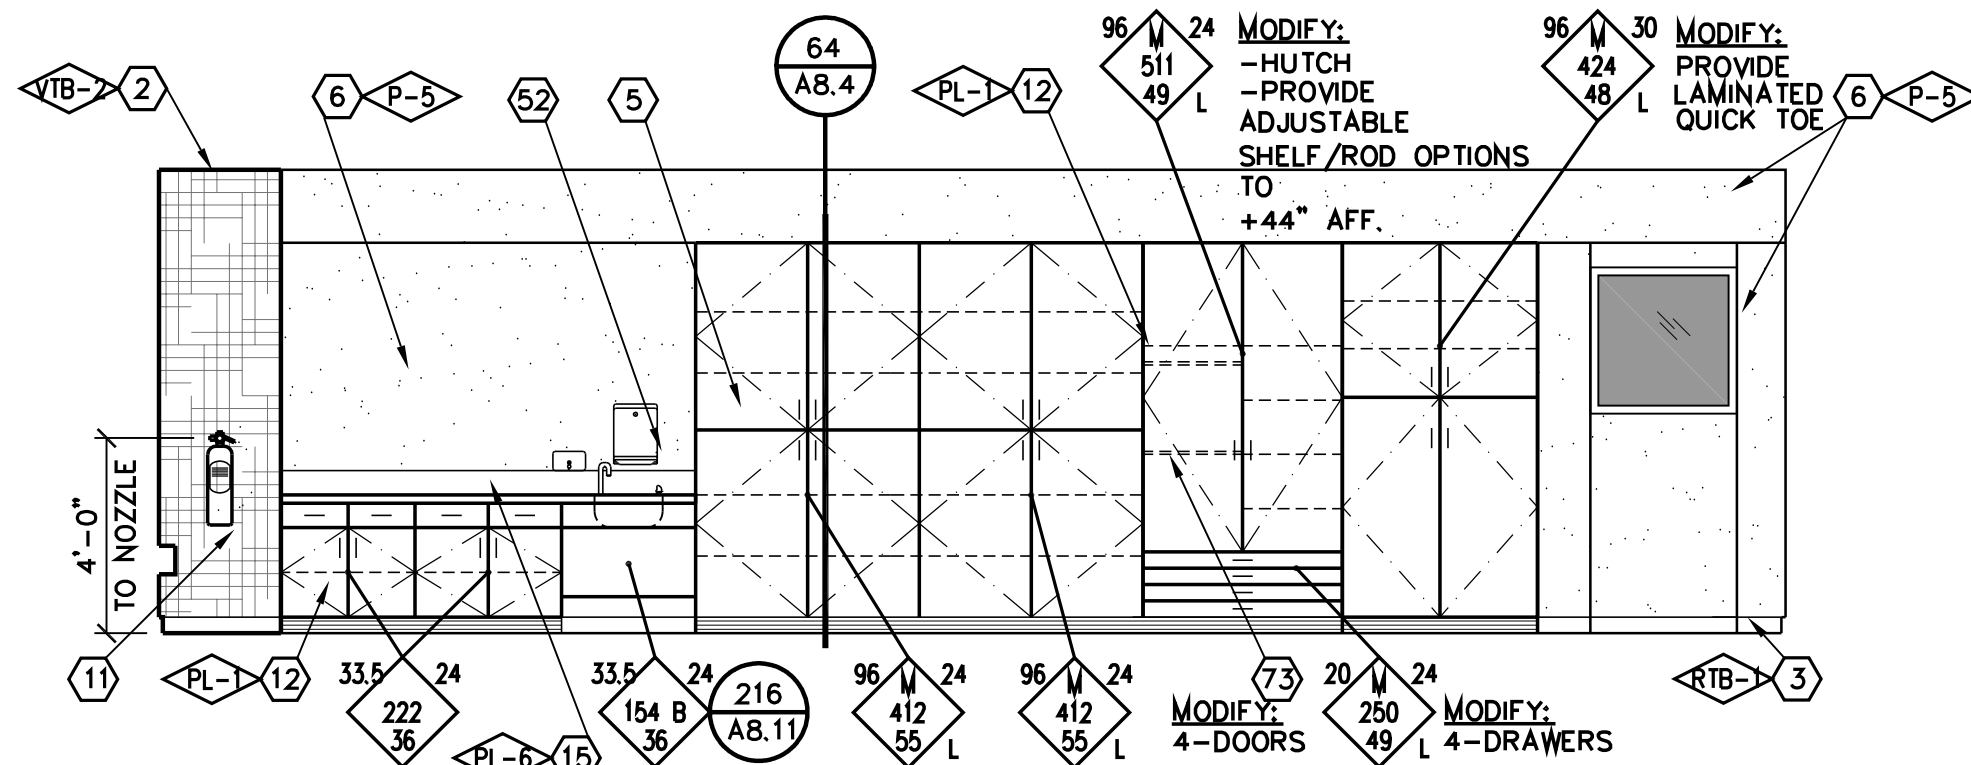


CLASSROOM 163
TYPICAL

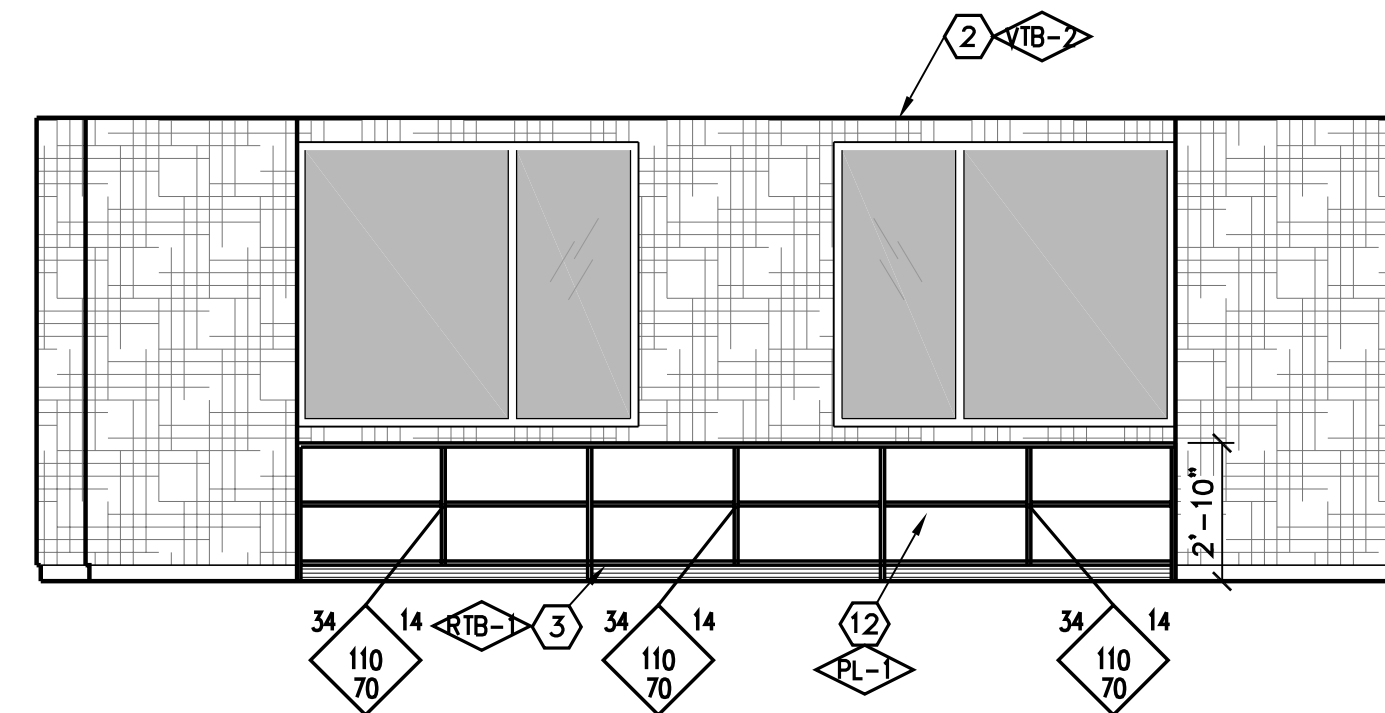

CLASSROOM 164
TYPICAL

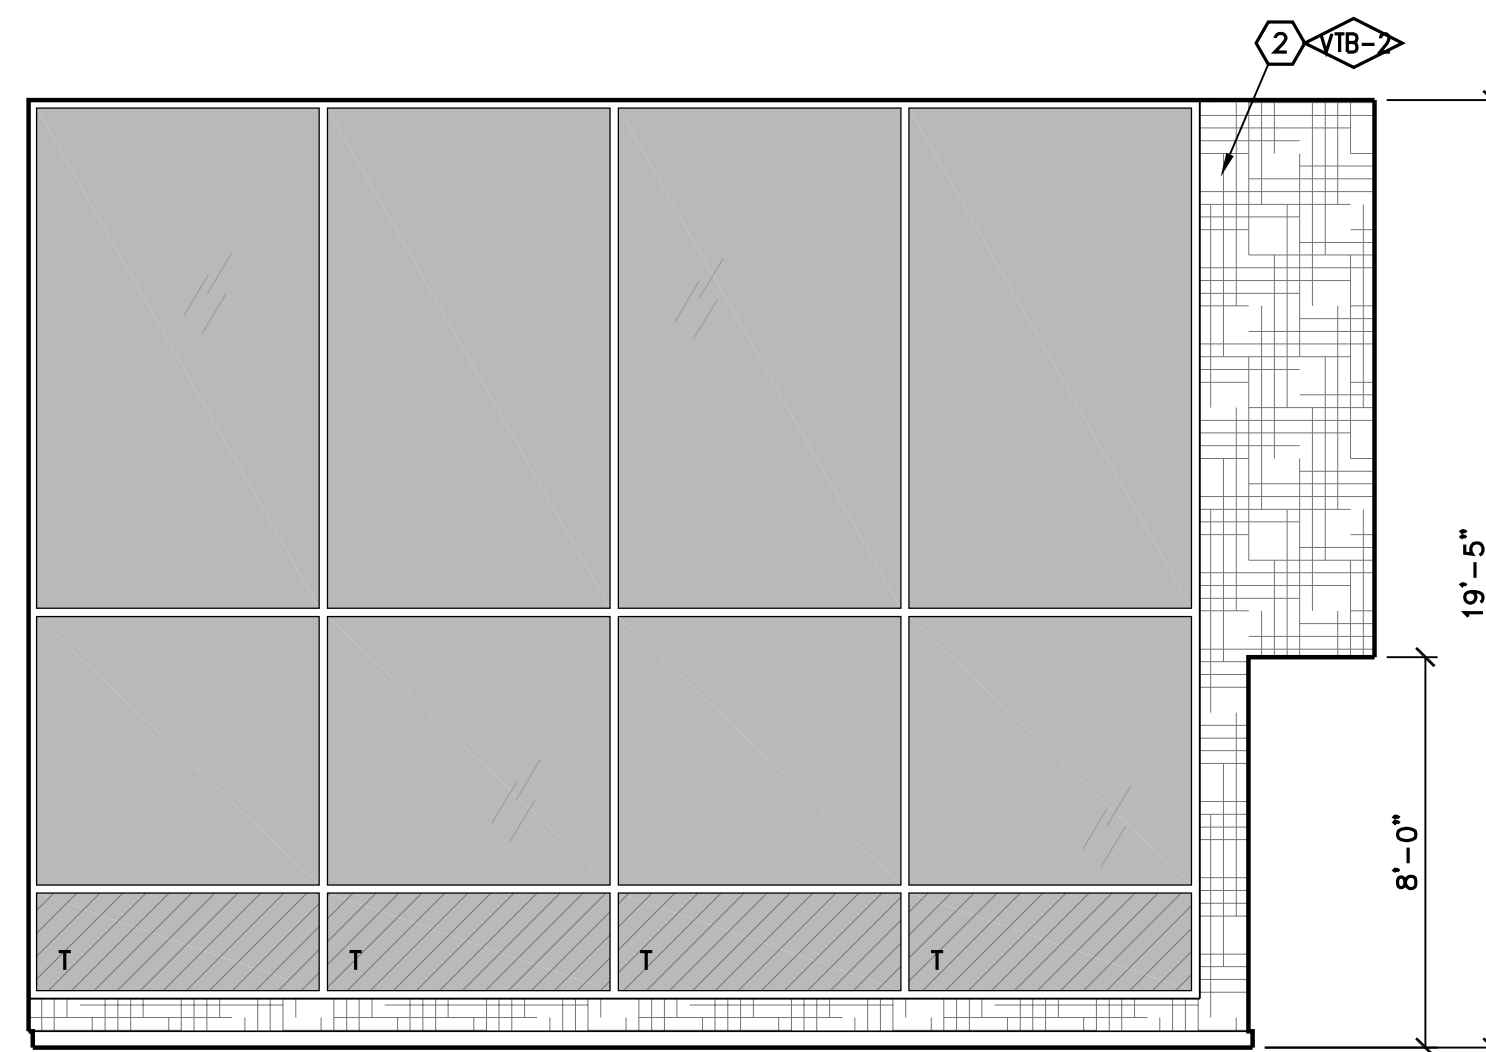

CLASSROOM 165
TYPICAL

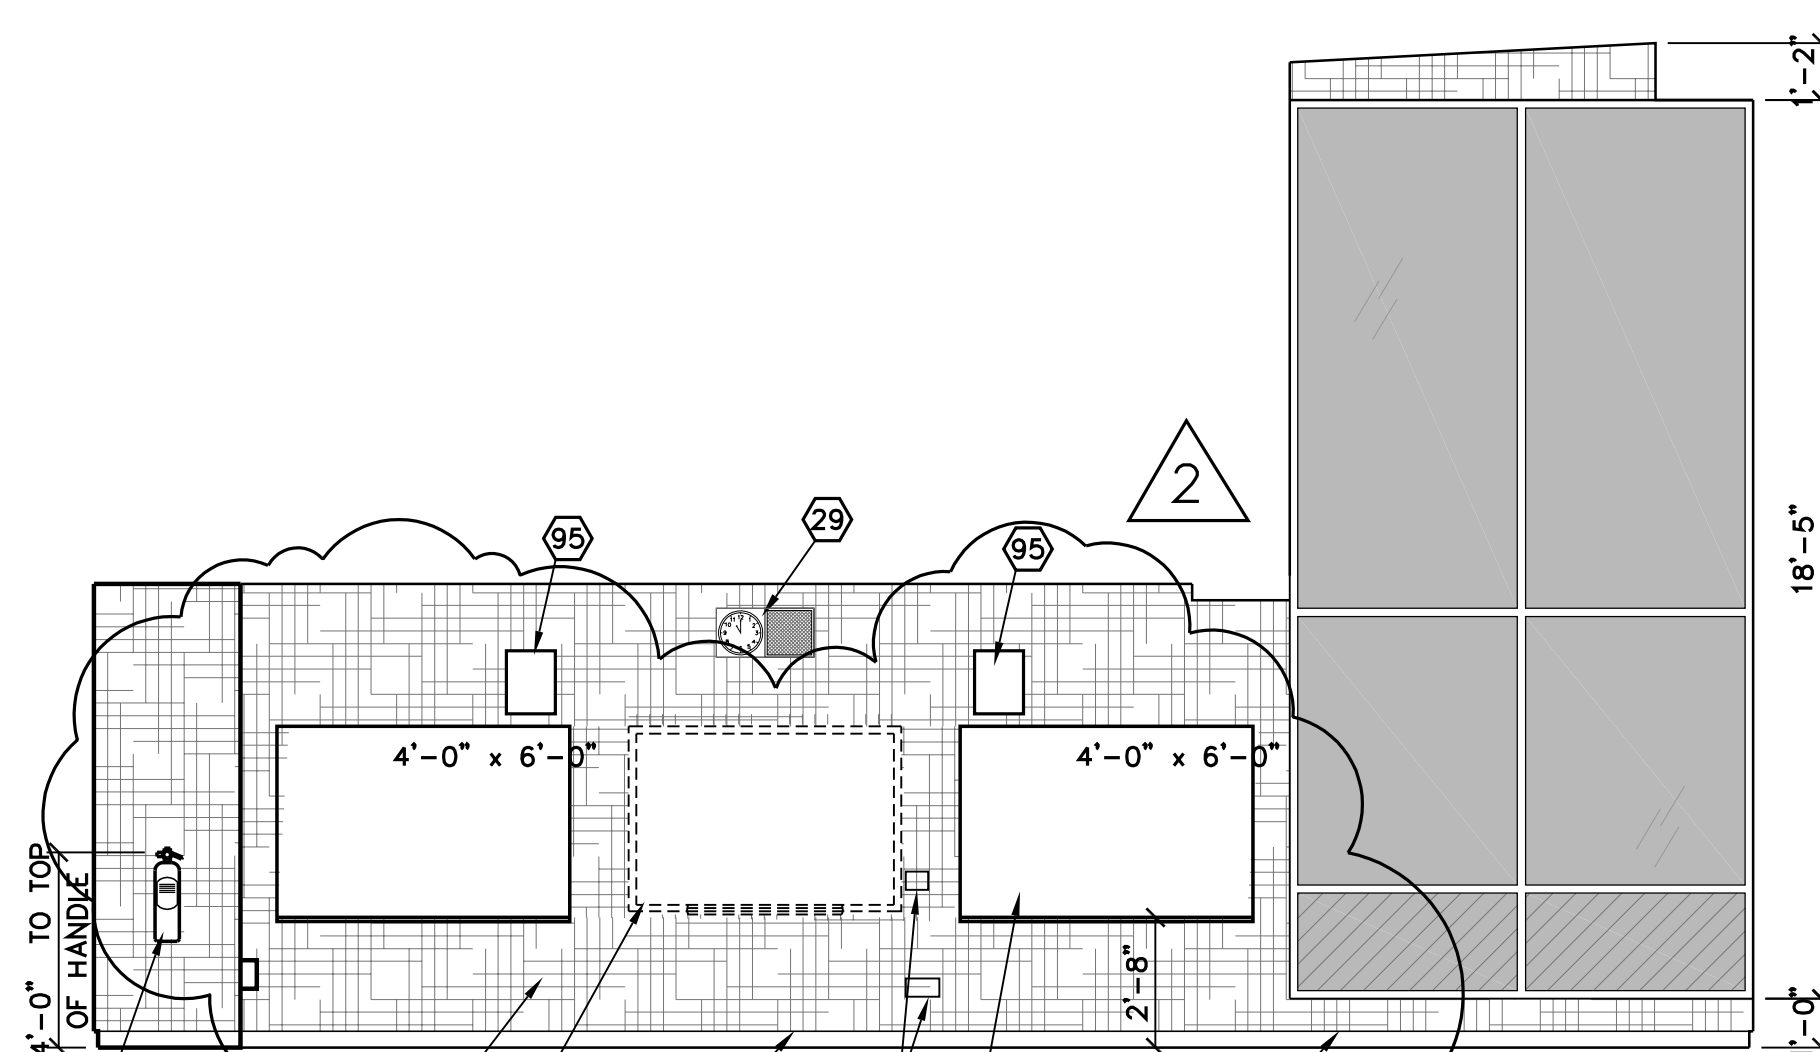

CLASSROOM 166
TYPICAL


KEYNOTES

- KNEE SPACE
- VINYL TACKBOARD o/ GYP. BD.
- RUBBER TOPSET BASE
- STOREFRONT
- PAPER TOWEL DISPENSER
- GYP. BOARD, TAPE, TEXTURE & PAINT (PROVIDE 5/8" TYPE 'X' GYP. BOARD AT STAIRWAYS AND UNDERSTAIR WALL/CEILING FINISHES, TYP.)
- ROOF ACCESS LADDER
- SOFFIT
- FLOOR SINK - SEE PLUMBING
- UNDER-COUNTER REFRIGERATOR
- FIRE EXTINGUISHER w/ SEMI RECESSED CAB. TYPE 2A:10BC
- PLASTIC LAMINATE CASEWORK
- W.I.C. 400 STORAGE SHELVING
- FIBER REINFORCED PANEL
- PLASTIC LAMINATE BACKSPLASH & COUNTERTOP
- METAL POST, PER STRUCTURAL
- SINK - SEE PLUMBING SCHEDULE
- MAGNETIC MARKER BOARD o/VTB
- APPLIANCES - SEE SPEC SECTION 11400
- BUTCHER PAPER HOLDER
- DISHWASHER
- HOOD
- REFRIGERATOR - FULL HEIGHT
- COOKTOP
- ROLL-UP DOOR
- STAINLESS STEEL COUNTERTOP
- FURNITURE (N.I.C.)
- DRINKING FOUNTAIN
- CLOCK/SPEAKER
- CLEAR GLASS DISPLAY CASE w/ LOCK (SEE SPEC. SECT. 10410)
- FEMININE NAPKIN DISPOSAL
- MIRROR
- TRACK AND CUBICLE CURTAIN.
- STAIRCASE
- HANDRAIL
- N/A
- TRANSLUCENT WALL SYSTEM
- WOOD BASE
- WHEEL CHAIR LIFT
- BELOW STAGE STORAGE
- N/A
- ELEVATOR LANTERN
- RAILING SPACING SHALL BE SUCH THAT A 4" DIA. SPHERE CANNOT PASS THROUGH ANY OPENING, PER CBC 1013
- CALL BUTTON
- ELEVATOR DOORS
- LAVATORY
- TOILET PAPER DISPENSER
- TOILET SEAT COVER DISPENSER
- DATA RACEWAY. SEE ELECTRICAL DRAWINGS.
- CLOCK
- 4' HIGH CORNER GUARD, TYP.
- SOAP DISPENSER
- PLASTIC TOILET PARTITION
- SIGNAGE
- MANUFACTURED 3'x6'x6" MTL. SHELVING, SEE S-1/K8.0
- SPEAKER ENCLOSURE AND GRILLE
- MOP/BROOM HOLDER
- PLASTIC LAM. DOOR, 1 1/2" THICK
- PROVIDE 3/4" LAM. PLASTIC SUPPORTS AT STOREFRONT, AT 4'-0" O.C.
- RAYTHERMS (N.I.C.)
- URINAL
- MICROWAVE (N.I.C.)
- PLASTIC LAMINATE CAP
- CERAMIC TILE
- GRAB BAR
- WATER CLOSET
- METAL LETTERS (SEE SPECS)
- PONY WALL BEHIND ROOM CAPACITY SIGN
- TECTUM PANELS
- 2x3 SHAPED WOOD NAILER
- UTILITY BOX
- MOVABLE ROD TO BE PLACED AT 44" FOR ADA COMPLIANCE. OPTIONAL.
- MOTORIZED SCREENS, SEE 143/AB.8
- PLASTIC LAMINATE PANELING AND DOORS
- WINDOW WALL, SEE T2 FOR DEFERRED ITEMS
- CLEAR GLASS POSTER CASE w/ LOCK (SEE SPEC. SECT. 10410)
- 1/2" REVEAL SCREDS
- WALL CLOCK, SEE SPEC SECTION 10050
- MICROWAVE OVEN
- PLASTIC LAMINATE COUNTERTOP
- SOLID SURFACE COUNTERTOP
- PERFORATED DECORATIVE METAL PANEL
- WALL PROTECTION PANEL
- ICE MACHINE
- CARPET BASE
- N/A
- CORNER GUARD
- STRUCTURAL MEMBER TO BE PAINTED, SEE STRUCTURAL
- EPOXY, EPF-1
- CASEWORK
- CASEWORK
- CASEWORK
- 75" MONITOR WITH
- MONITOR CONTROL DEVICE & HDMI DEVICES, DISTRICT TO VERIFY LOCATION
- WALL MOUNTED SPEAKERS, DISTRICT TO VERIFY LOCATION

NOTES:

- SEE DTL. 219/AB.11 FOR ACCESSIBILITY STANDARDS
- ALL SHELVING WITH SPANS GREATER THAN 30" TO BE 1" THICK
- REFER TO COLOR SCHEDULE (SHEET A2.8) FOR ALL COLOR REFERENCES, TYP.
- ALL CARPET USES A CARPET BASE #86
- ALL MONDO RUBBER FLOORS USE A RUBBER TOPSET BASE #3
- ALL AHRO FLOORS USE SELF-COVER BASE #41
- ALL STAINED & DYED CONCRETE FLOORS USE TOPSET #3

SYMBOL LEGEND

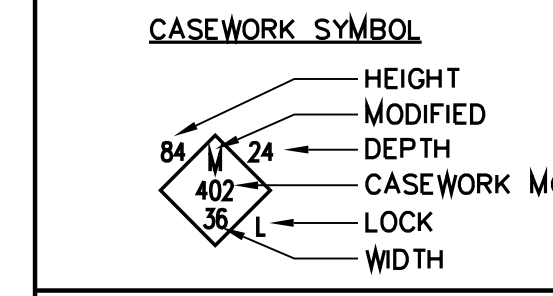

GENERAL NOTES

1. RECESSED CLOCKS AND/OR SPEAKERS ARE PROHIBITED IN FIRE RATED WALLS WHERE OPENING PROTECTION IS REQUIRED.



PROJECT:
SHIELDS & BRAWLEY ELEMENTARY SCHOOL



**AD 2-33a
S&B Elementary
02-116800**



THE FIRM OF SMITH, IWANAGA, MILHOUS, ARCHITECTS, INC. EXPRESSLY RESERVES ITS COMMON LAW COPYRIGHT AND OTHER APPLICABLE PROPERTY RIGHTS IN THESE PLANS. THESE PLANS ARE NOT TO BE REPRODUCED, CHANGED, OR COPIED IN ANY FORM OR MANNER WHATSOEVER, NOR ARE THEY TO BE ASSIGNED TO A THIRD PARTY WITHOUT FIRST OBTAINING THE WRITTEN PERMISSION AND CONSENT OF THE ARCHITECT. IN THE EVENT OF UNAUTHORIZED REUSE OF THESE PLANS BY A THIRD PARTY, THE THIRD PARTY SHALL HOLD THE ARCHITECT HARMLESS, AND SHALL BEAR THE COST OF THE ARCHITECT'S LEGAL FEES, ASSOCIATED WITH DEFENDING AND ENFORCING THESE RIGHTS.

| PROJECT DEVELOPMENT | |
|---------------------|------------|
| DATE | ISSUED FOR |
| | |
| | |

| REVISIONS | | |
|-----------|---------|------------------------|
| No. | DATE | DESCRIPTION |
| △ | 2.14.23 | DISTRICT MODIFICATIONS |
| △ | 2.27.23 | DISTRICT MODIFICATIONS |





SHEET DESCRIPTION

INTERIOR ELEVATIONS
MAIN - 2ND FLOOR

| | |
|--|---------------------------|
| PROJECT COORDINATOR JOHN SMITH | SHEET NO. A5.16 |
| PROJECT NO. 17-67 | |
| DATE 1.27.23 | |
| SCALE 1/4" = 1'-0" | |

S:\17-67_Shields & Brawley Elementary\Work\17-67_A5.16_2023-interiors.dwg 05/31/23 07:00

PLAN-17-67-Shields & Brawley Elementary A5.20-Multi-Purpose Area 09/21/18 07:07

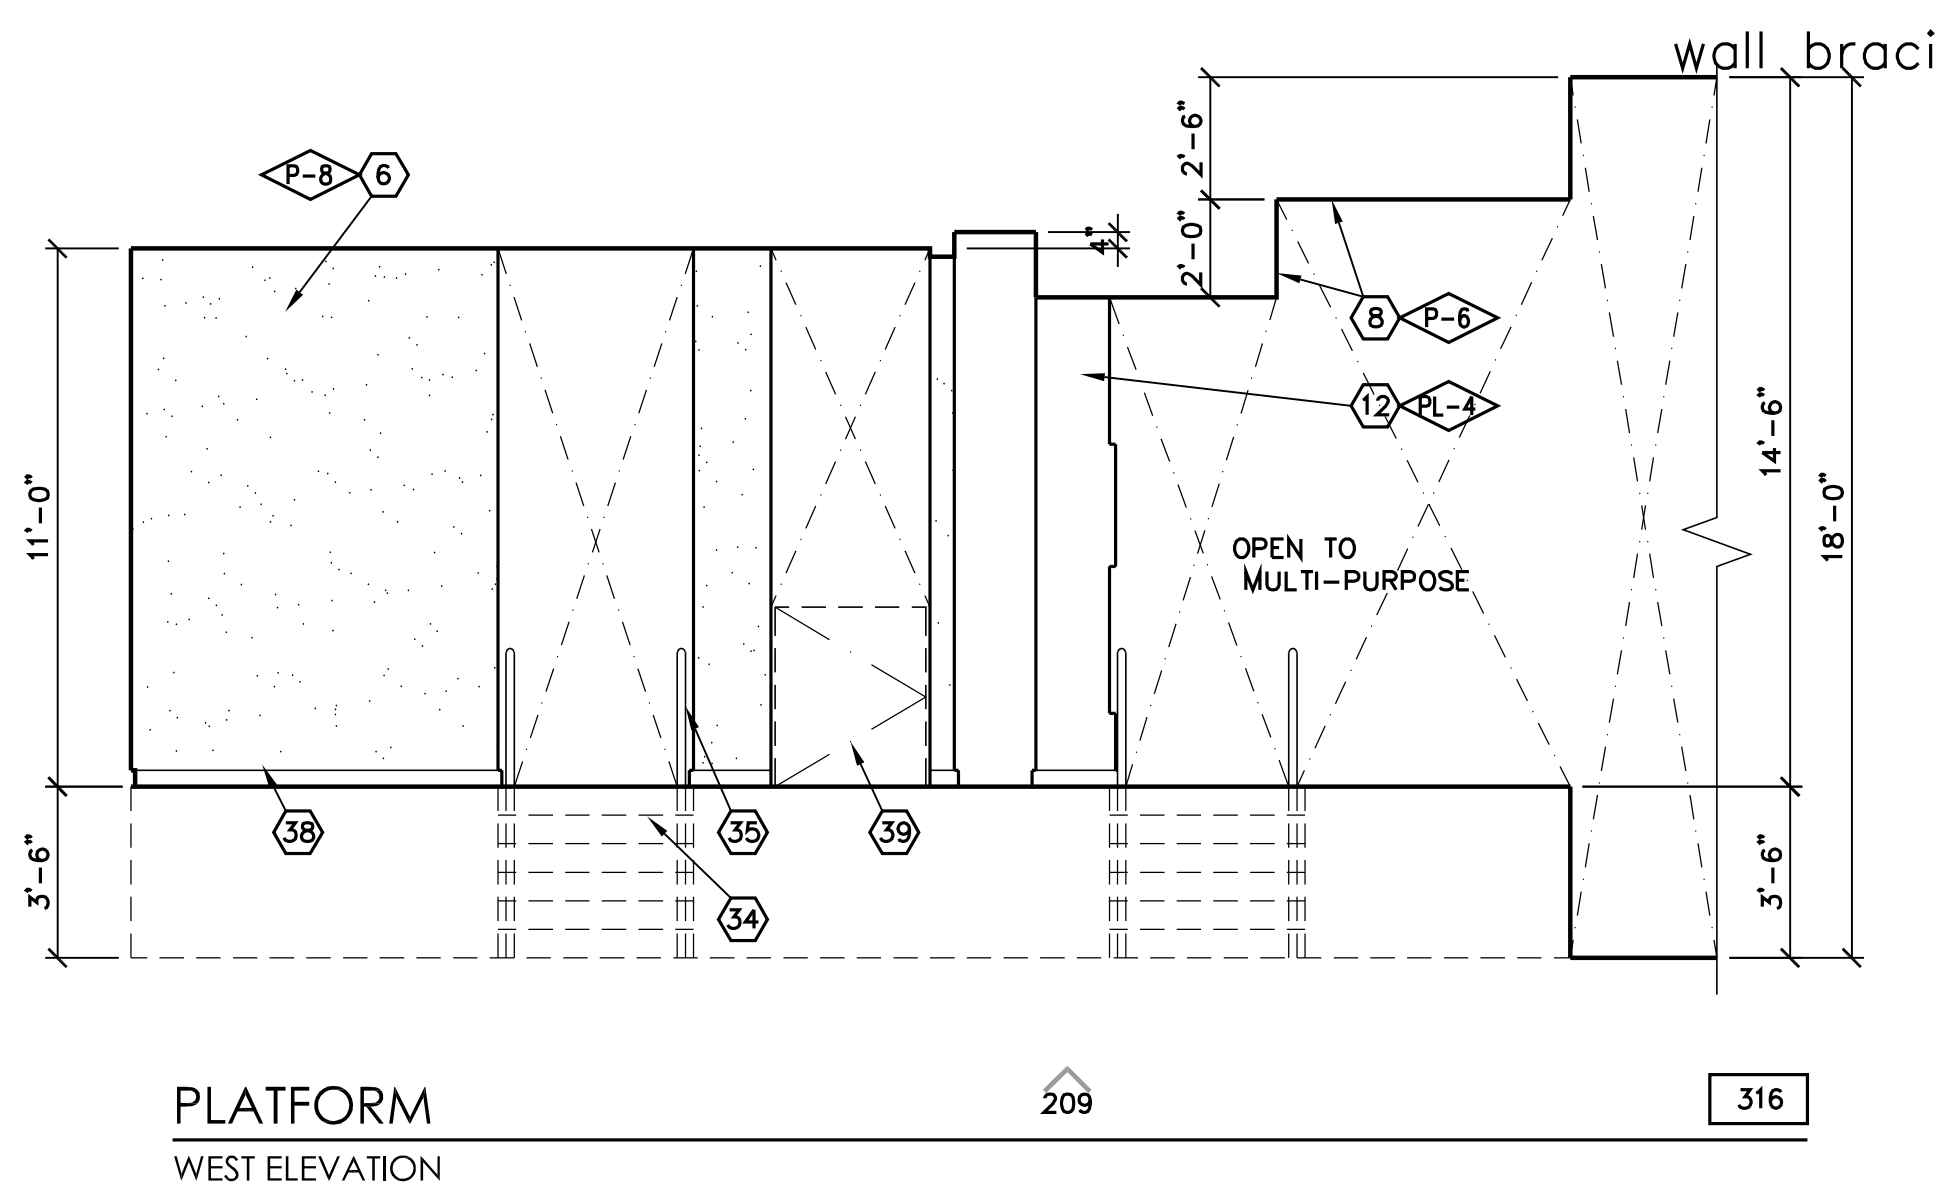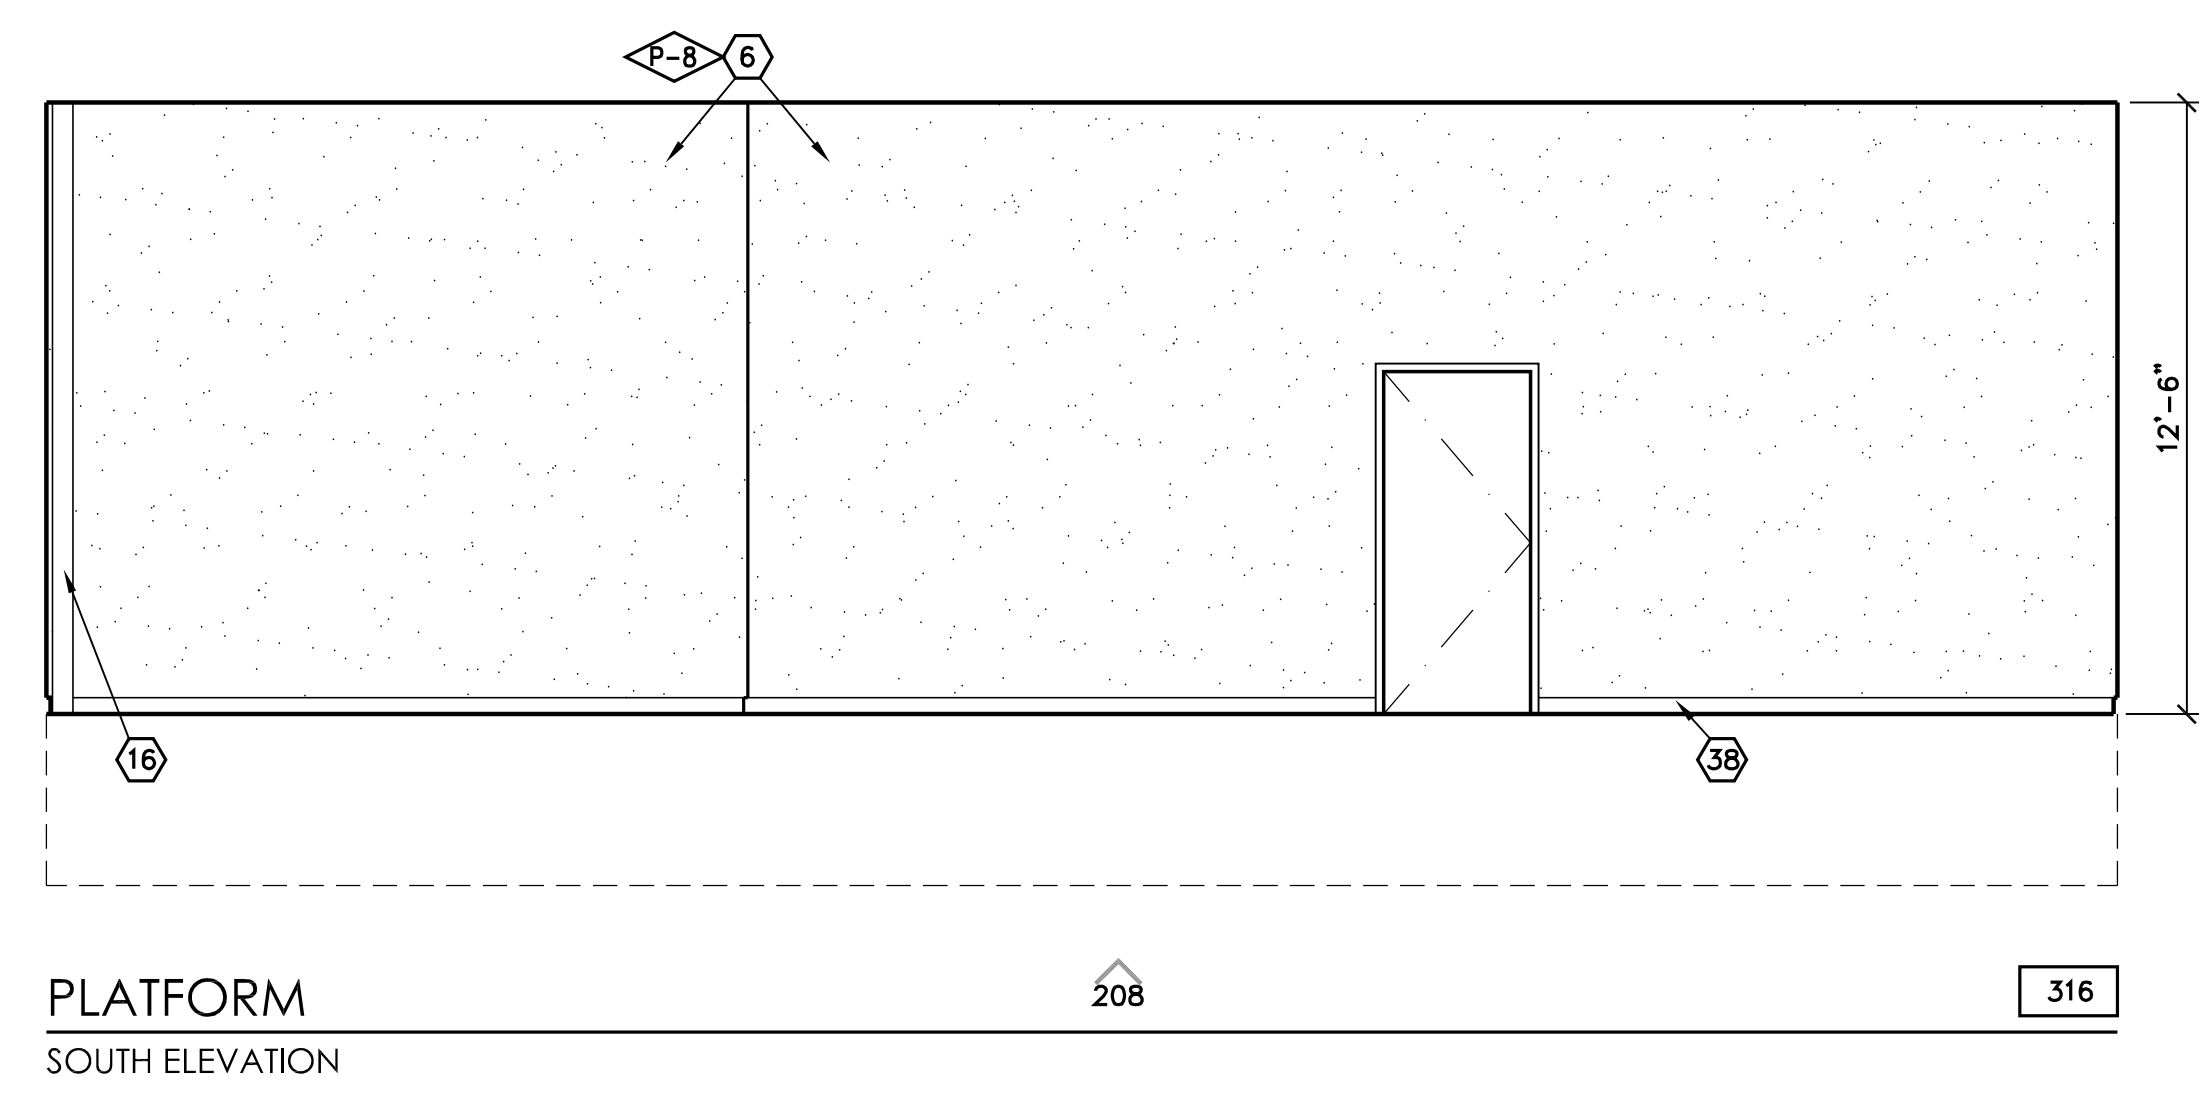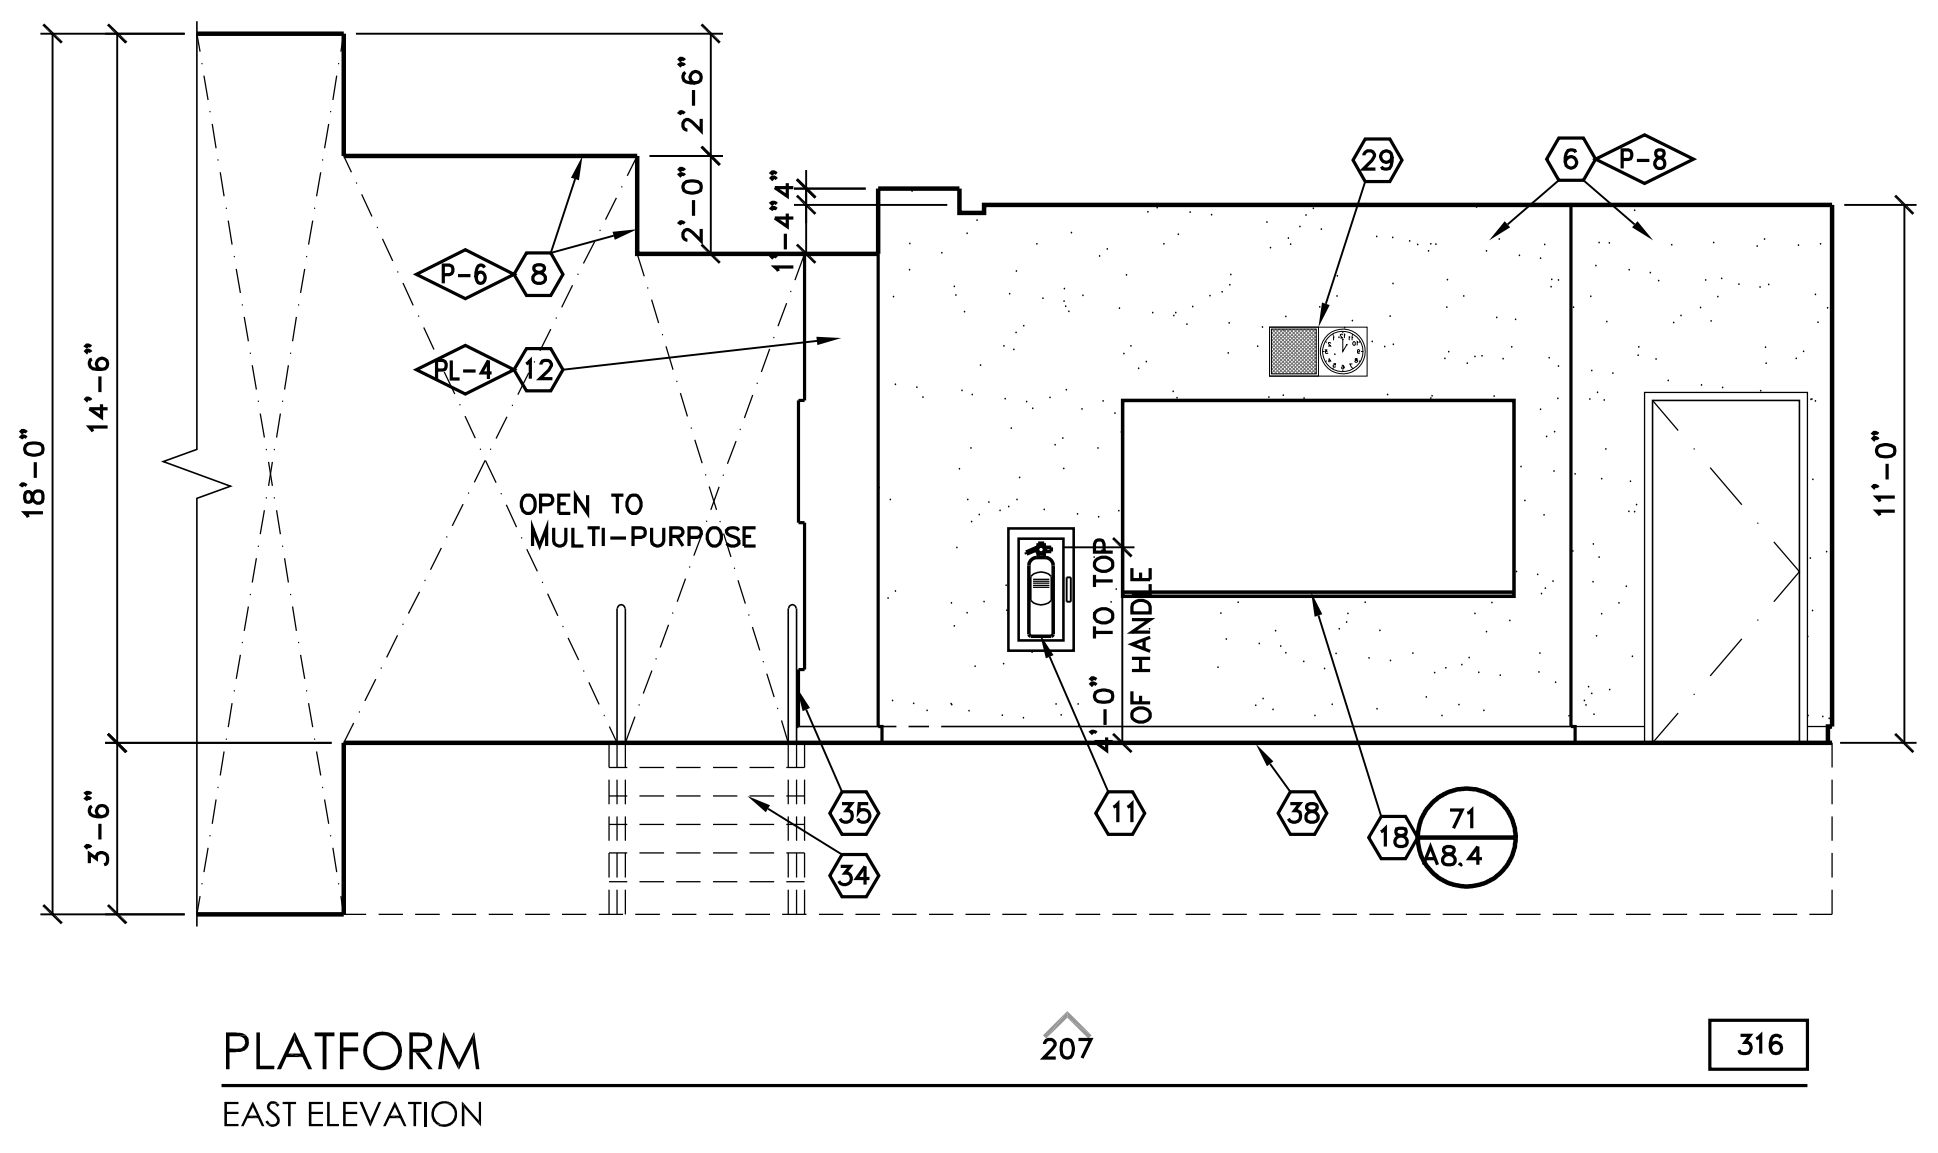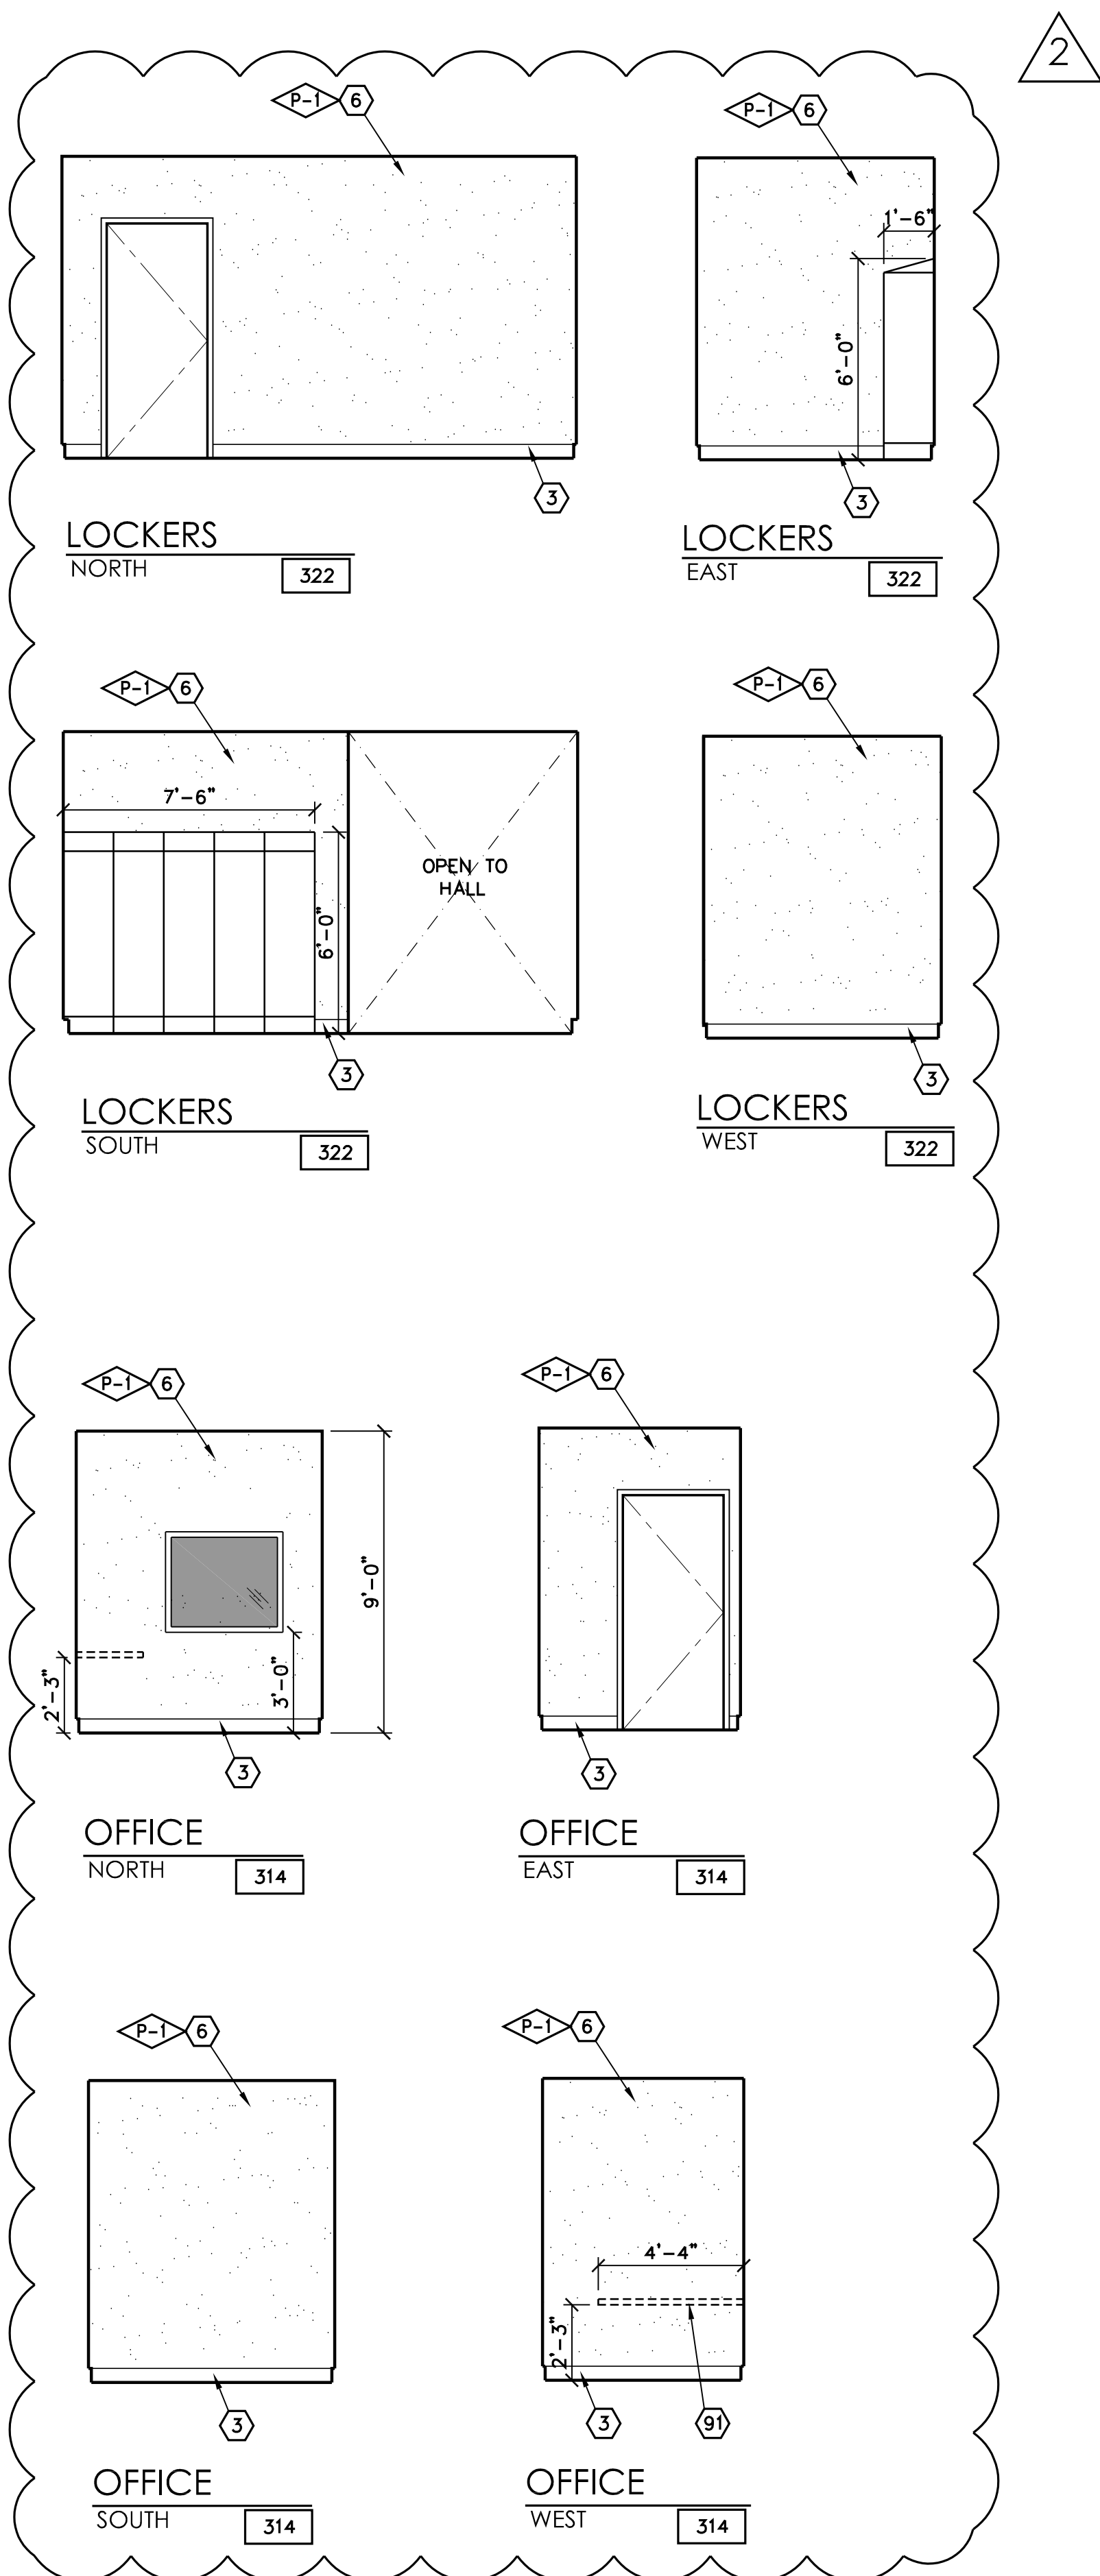


KEYNOTES

1. KNEE SPACE
2. VINYL TACKBOARD o/ GYP. BD.
3. RUBBER TOPSET BASE
4. STOREFRONT
5. PAPER TOWEL DISPENSER
6. GYPSUM BOARD, TAPE, TEXTURE & PAINT (PROVIDE 5/8" TYPE 'X' GYP. AT STAIRWAYS AND UNDERSTAIR WALL/CEILING FINISHES, TYP.)
7. ROOF ACCESS LADDER
8. SOFFIT
9. FLOOR SINK - SEE PLUMBING
10. UNDER-COUNTER REFRIGERATOR
11. FIRE EXTINGUISHER w/ SEMI RECESSED CAB. TYPE 2A:10BC
12. PLASTIC LAMINATE CASEWORK
13. W.I.C. 400 STORAGE SHELVING
14. FIBER REINFORCED PANEL
15. PLASTIC LAMINATE BACKSPLASH & COUNTERTOP
16. METAL POST, PER STRUCTURAL
17. SINK - SEE PLUMBING SCHEDULE
18. MAGNETIC MARKER BOARD o/YTB
19. APPLIANCES - SEE SPEC SECTION 11400
20. BUTCHER PAPER HOLDER
21. DISHWASHER
22. HOOD
23. REFRIGERATOR - FULL HEIGHT
24. COOKTOP
25. ROLL-UP DOOR
26. STAINLESS STEEL COUNTERTOP
27. FURNITURE (N.I.C.)
28. DRINKING FOUNTAIN
29. CLOCK/SPEAKER
30. CLEAR GLASS DISPLAY CASE w/ LOCK (SEE SPEC. SECT. 10410)
31. FEMININE NAPKIN DISPOSAL
32. MIRROR
33. TRACK AND CUBICLE CURTAIN.
34. STAIRCASE
35. HANDRAIL
36. N/A
37. TRANSLUCENT WALL SYSTEM
38. WOOD BASE
39. WHEEL CHAIR LIFT
40. BELOW STAGE STORAGE
41. SHEET VINYL COVED BASE
42. ELEVATOR LANTERN
43. RAILING, SPACING SHALL BE SUCH THAT A 4" DIA. SPHERE CANNOT PASS THROUGH ANY OPENING, PER CBC 1013
44. CALL BUTTON
45. ELEVATOR DOORS
46. LAVATORY
47. TOILET PAPER DISPENSER
48. TOILET SEAT COVER DISPENSER
49. DATA RACEWAY. SEE ELECTRICAL DRAWINGS.
50. CLOCK
51. 4" HIGH CORNER GUARD, TYP.
52. SOAP DISPENSER
53. PLASTIC TOILET PARTITION
54. SIGNAGE
55. MANUFACTURED 3"Wx6"H MTL. SHELVING, SEE S-1/K8.0
56. SPEAKER ENCLOSURE AND GRILLE
57. MOP/BROOM HOLDER
58. PLASTIC LAM. DOOR, 1 1/2" THICK
59. PROVIDE 3/4" LAM. PLASTIC SUPPORTS AT STOREFRONT, AT 4'-0" O.C.
60. RAYTHERMS (N.I.C.)
61. URINAL
62. MICROWAVE (N.I.C.)
63. PLASTIC LAMINATE CAP
64. CERAMIC TILE
65. GRAB BAR
66. WATER CLOSET
67. METAL LETTERS (SEE SPECS)
68. PONY WALL BEHIND
69. ROOM CAPACITY SIGN
70. TECTUM PANELS
71. 2x3 SHAPED WOOD NAILER
72. UTILITY BOX
73. MOVABLE ROD TO BE PLACED AT 44" FOR ADA COMPLIANCE. OPTIONAL.
74. MOTORIZED SCREEN, SEE 143/A8.8
75. PLASTIC LAMINATE PANELING AND DOORS
76. WINDOW WALL, SEE T2 FOR DEFERRED ITEMS
77. CLEAR GLASS POSTER CASE w/LOCK (SEE SPEC. SECT. 10410)
78. 1/2" REVEAL SCREEDS
79. WALL CLOCK, SEE SPEC SECTION 10050
80. MICROWAVE OVEN
81. PLASTIC LAMINATE COUNTERTOP
82. SOLID SURFACE COUNTERTOP
83. PERFORATED DECORATIVE METAL PANEL
84. WALL PROTECTION PANEL
85. ICE MACHINE
86. CARPET BASE
87. (2)2" TACK STRIPS, 12' LONG BY WALLTALKERS OR EQUAL
88. CORNER GUARD
89. STRUCTURAL MEMBER TO BE PAINTED, SEE STRUCTURAL
90. COVED BASE
91. CASEWORK
92. TAC-WALL

NOTES: 1. SEE DTL. 219/A8.11 FOR ACCESSIBILITY STANDARDS
 2. ALL SHELVING WITH SPANS GREATER THAN 30" TO BE 1" THICK
 3. REFER TO COLOR SCHEDULE (SHEET A2.8) FOR ALL COLOR REFERENCES, TYP.
 4. ALL CARPET USES A CARPET BASE #86
 ALL MONDO RUBBER FLOORS USE A RUBBER TOPSET BASE #3
 ALL AHRO FLOORS USE SELF-COVER BASE #41
 ALL STAINED & DYED CONCRETE FLOORS USE TOPSET #3

SYMBOL LEGEND

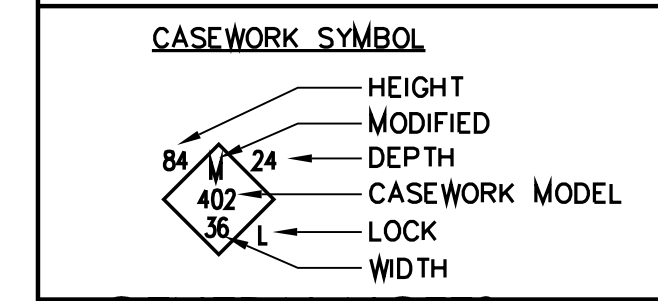

GENERAL NOTES

1. RECESSED CLOCKS AND/OR SPEAKERS ARE PROHIBITED IN FIRE RATED WALLS WHERE OPENING PROTECTION IS REQUIRED.




7790 NORTH PALM AVENUE
 FRESNO, CALIFORNIA 93711
 T 559.448.8400 F 559.448.8467
 www.slm-pbk.com

PROJECT:
SHIELDS & BRAWLEY ELEMENTARY SCHOOL



AD 2-34a
S&B Elementary
02-116800


JOHN H. SMITH, A.I.A. C15885

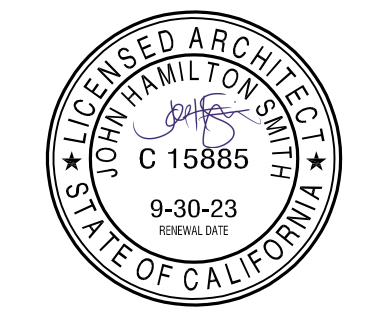

THE FIRM OF SMITH, MANNING, MELHUS, ARCHITECTS, INC. EXPRESSLY RESERVES ITS COMMON LAW COPYRIGHT AND OTHER APPLICABLE PROPERTY RIGHTS IN THESE PLANS. THESE PLANS ARE NOT TO BE REPRODUCED, CHANGED, OR COPIED IN ANY FORM OR MANNER WHATSOEVER, NOR ARE THEY TO BE ASSIGNED TO A THIRD PARTY WITHOUT FIRST OBTAINING THE WRITTEN PERMISSION AND CONSENT OF THE ARCHITECT. IN THE EVENT OF UNAUTHORIZED REUSE OF THESE PLANS BY A THIRD PARTY, THE THIRD PARTY SHALL HOLD THE ARCHITECT HARMLESS, AND SHALL BEAR THE COST OF THE ARCHITECT'S LEGAL FEES ASSOCIATED WITH DEFENDING AND ENFORCING THESE RIGHTS.


| PROJECT DEVELOPMENT | | |
|---------------------|------------|------------------------|
| DATE | ISSUED FOR | |
| | | |
| | | |
| | | |
| REVISIONS | | |
| No. | DATE | DESCRIPTION |
| △ | 2.14.23 | DISTRICT MODIFICATIONS |
| △ | 2.27.23 | DISTRICT MODIFICATIONS |

| SHEET DESCRIPTION | |
|--|---------------------------|
| INTERIOR ELEVATIONS | |
| MULTI-PURPOSE | |
| PROJECT COORDINATOR JOHN SMITH | SHEET NO. A5.20 |
| PROJECT NO. 17-67 | DATE 1.27.23 |
| SCALE 1/4"=1'-0" | |

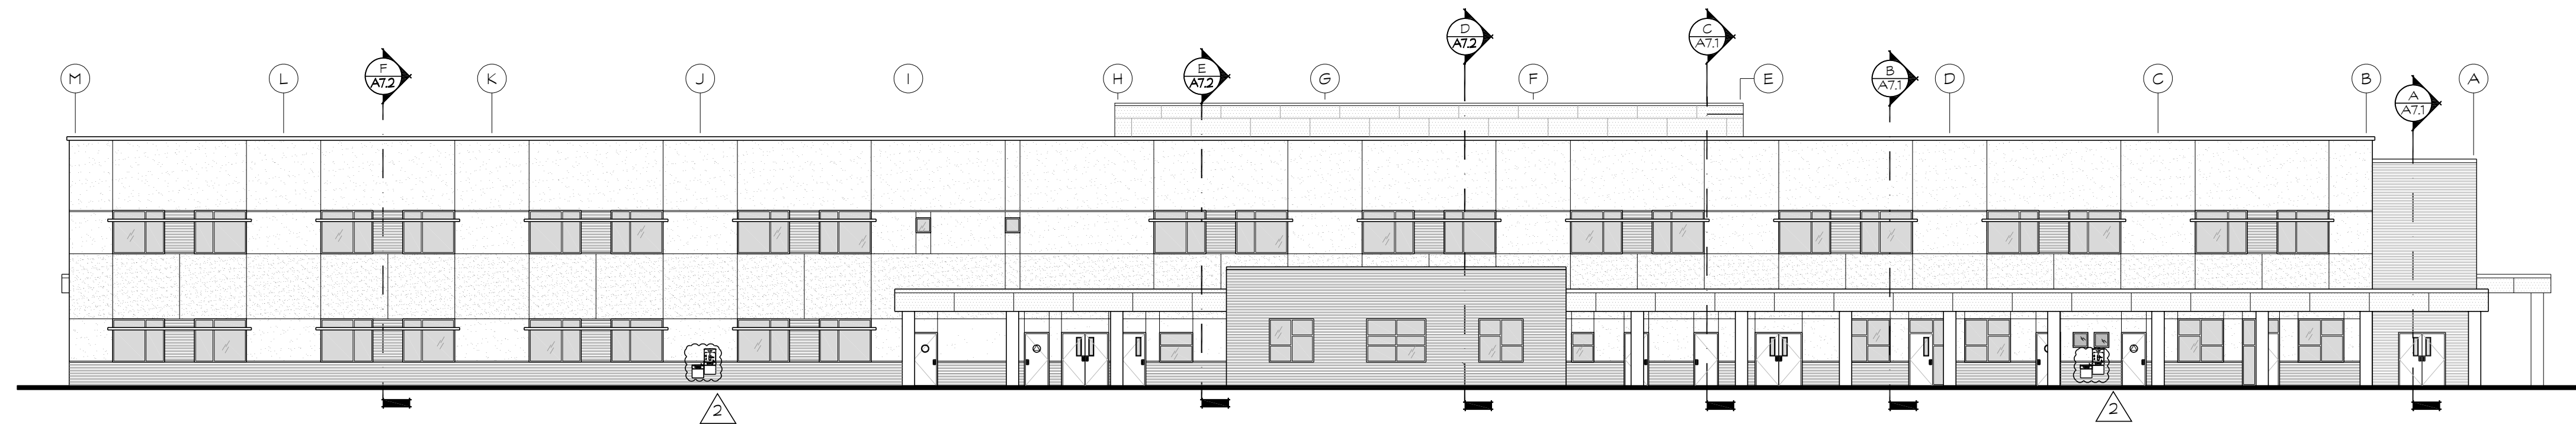


SOUTH ELEVATION

SCALE: 1/16" = 1'-0"

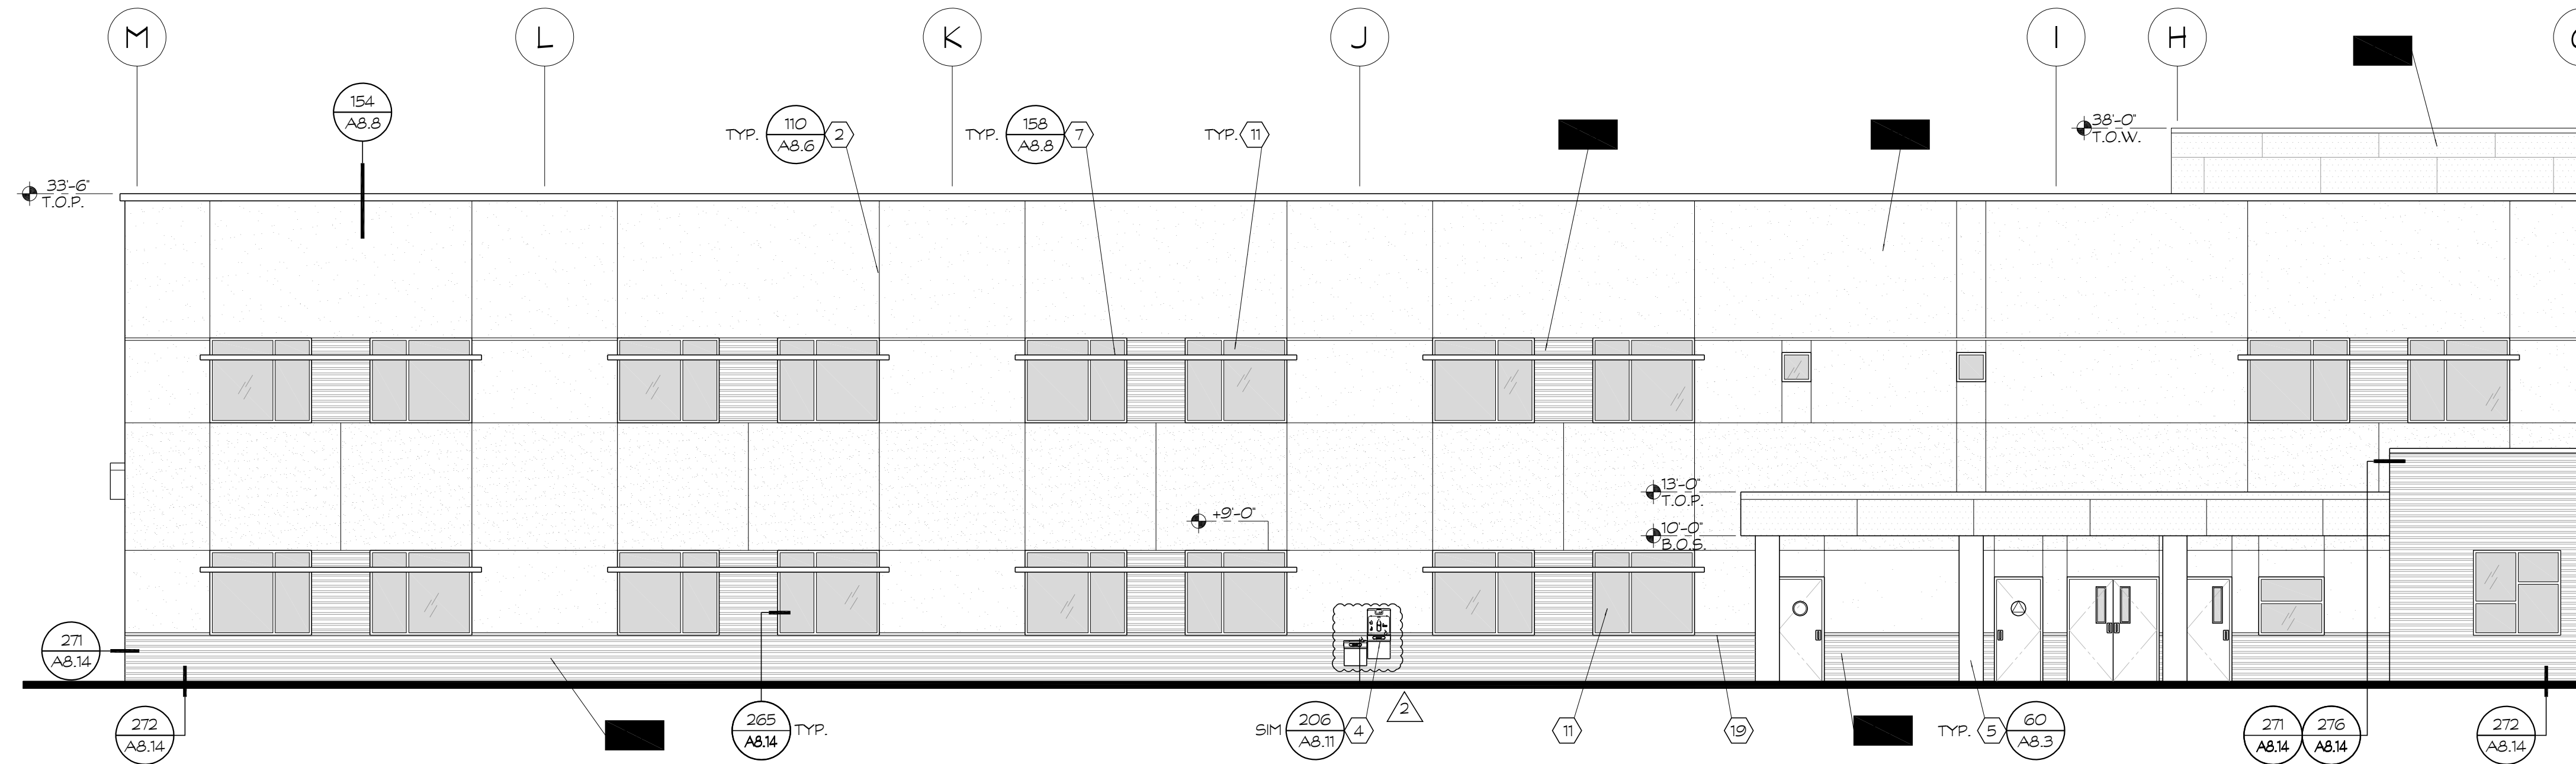

PARTIAL SOUTH ELEVATION

SCALE: 1/8" = 1'-0"

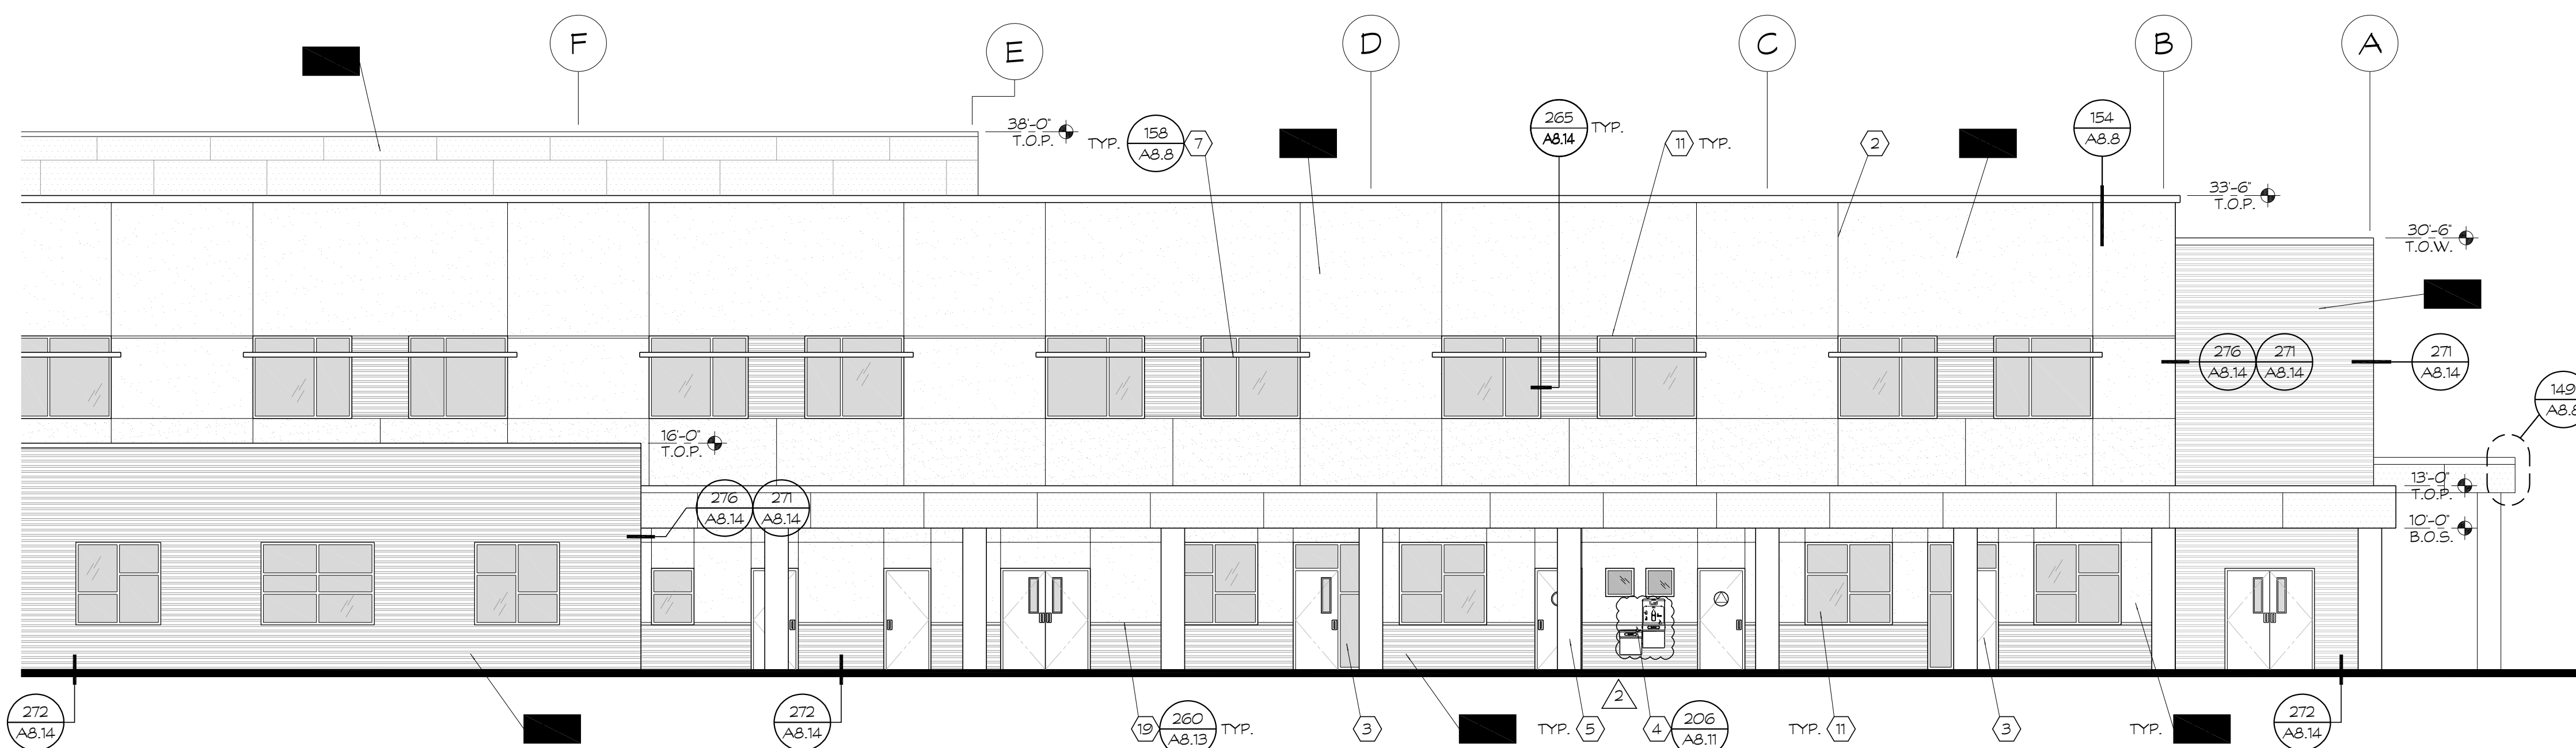

PARTIAL SOUTH ELEVATION

SCALE: 1/8" = 1'-0"

KEYNOTES

1. N/A
2. 1/4" EXPANSION JOINT(S)
3. ALUMINUM STOREFRONT SYSTEM, SEE SCHEDULE
4. DRINKING FOUNTAIN SEE PLUMBING PLANS FOR INFO, SEE DTL. 4/P11A FOR ANCHORAGE
5. 20" DIA. CONC. COLUMN, TYP.
6. CMU WALL
7. DECORATIVE METAL AWNING
8. METAL CANOPY
9. STEEL TRUSS, SEE STRUCTURAL DWGS.
10. N/A
11. WINDOW, SEE SCHEDULES
12. N/A
13. COPING (BY METAL PANEL MANUFACTURER) SEE DTL. 154/A8.8
14. RAISED CONC. PLATFORM
15. STAIR & HANDRAIL/GUARDRAIL
16. SECURITY CAMERA
17. ACCESSIBLE ENTRANCE SIGNAGE, SEE DTL. 209/A8.11
18. METAL LETTERS
19. 4" FOAM PLANT-ON
20. 2" EXPANSION REVEAL, TYP.
21. N/A
22. HSS COLUMN, SEE STRUCTURAL DWGS.
23. ACCESSIBLE RAMP AND HANDRAILS
24. COMPOSITE WOOD DECKING
25. ARCHITECTURAL METAL FASCIA
26. CEMENT PLASTER SHAPED FOAM CORNICE
27. N/A
28. 6" T.S. COLUMN, SEE STRUCT. DWGS.
29. N/A
30. 3/4" EXPANSION JOINT, REFER TO STRUCTURAL DRAWINGS FOR ALL LOCATIONS, SEE DTL. 310/A8.18 FOR TYPICAL FINISH CONDITIONS.

NOTE: REFER TO COLOR SCHEDULE (SHEET A2.8) FOR ALL COLOR REFERENCES, TYP.

METAL PANEL NOTES:

1. CONTRACTOR TO PROVIDE ALL ACCESSORIES REQ'D TO PROVIDE WEATHER TIGHT CONSTRUCTION, COORDINATE W/ MANUFACTURER.
2. CORRUGATED PANELS:
PROVIDE ENDWALL CLOSURES PER DETAIL 279/A8.14 AT ALL APPLICABLE LOCATIONS TO PROVIDE WEATHER TIGHT CONSTRUCTION, COORDINATE W/ METAL PANEL MANUFACTURER.
SMOOTH PANELS:
REFER TO DETAIL 288/A8.15 FOR END CONDITIONS, COORDINATE W/ METAL PANEL MANUFACTURER FOR ANY CONDITIONS NOT SHOWN.
3. REFER TO DETAIL 263/A8.14 FOR ISOMETRIC VIEW AT WINDOWS, TYP.
4. CORRUGATED PANELS:
REFER TO DETAIL 275/A8.14 FOR EXPANSION REVEALS.
SMOOTH PANELS:
REFER TO DETAIL 285/A8.15 FOR EXPANSION REVEALS.


LEGEND:

- SMOOTH PANEL SYSTEM SEE SPEC SECTION 07 42 13.23 SUBSTITUTION SHALL BE REVIEWED & APPROVED BY DSA COLOR: <P-3>
- VERTICAL-CORRUGATED METAL PANEL LATITUDE SERIES BY IMETCO SUBSTITUTIONS SHALL BE REVIEWED & APPROVED BY DSA COLOR: <P-2>
- HORIZONTAL-CORRUGATED METAL PANEL LATITUDE SERIES (PROFILE 1) BY IMETCO SUBSTITUTIONS SHALL BE REVIEWED & APPROVED BY DSA COLOR: <P-2>
- SMOOTH PANEL SYSTEM SEE SPEC SECTION 07 42 13.23 SUBSTITUTION SHALL BE REVIEWED & APPROVED BY DSA COLOR: <P-4>
- CEMENT PLASTER w/ METAL LATH w/ PAPER COLOR: <P-9>
- CEMENT PLASTER w/ METAL LATH w/ PAPER COLOR: <P-10>
- CMU WALL



7790 NORTH PALM AVENUE
FRESNO, CALIFORNIA 93711
T 559.448.8400 F 559.448.8467
WWW.SIMPBK.COM

PROJECT:
SHIELDS & BRAWLEY ELEMENTARY SCHOOL

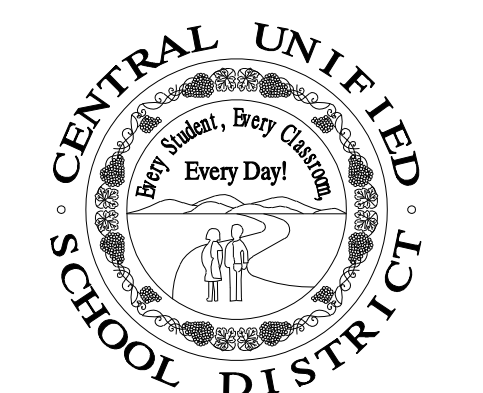

AD 2-35a
S&B Elementary
02-116800




THE FIRM OF SMITH, IWANAGA, MILHOUS, ARCHITECTS, INC. EXPRESSLY RESERVES ITS COMMON LAW COPYRIGHT AND OTHER APPLICABLE PROPERTY RIGHTS IN THESE PLANS. THESE PLANS ARE NOT TO BE REPRODUCED, CHANGED, OR COPIED IN ANY FORM OR MANNER WITHOUT THE WRITTEN PERMISSION AND CONSENT OF THE ARCHITECT. IN THE EVENT OF UNAUTHORIZED REUSE OF THESE PLANS BY A THIRD PARTY, THE THIRD PARTY SHALL HOLD THE ARCHITECT HARMLESS, AND SHALL BEAR THE COST OF THE ARCHITECT'S LEGAL FEES ASSOCIATED WITH DEFENDING AND ENFORCING THESE RIGHTS.

| PROJECT DEVELOPMENT | |
|---------------------|------------|
| DATE | ISSUED FOR |
| | |
| | |
| | |


| REVISIONS | | |
|-----------|---------|------------------------|
| No. | DATE | DESCRIPTION |
| 1 | 2.14.23 | DISTRICT MODIFICATIONS |
| 2 | 2.27.23 | DISTRICT MODIFICATIONS |

| SHEET DESCRIPTION | |
|-----------------------------------|-------------------|
| EXTERIOR ELEVATIONS | |
| MAIN | |
| PROJECT COORDINATOR JOHN SMITH | SHEET NO. A6.3 |
| PROJECT NO. 17-67 | DATE 1.27.23 |
| DATE 1.27.23 | SCALE AS NOTED |


E:\17-67_Shields & Brawley_Elementary\Work\17-67_A6.3_Primary-Exterior.dwg 05/23/18 07:32

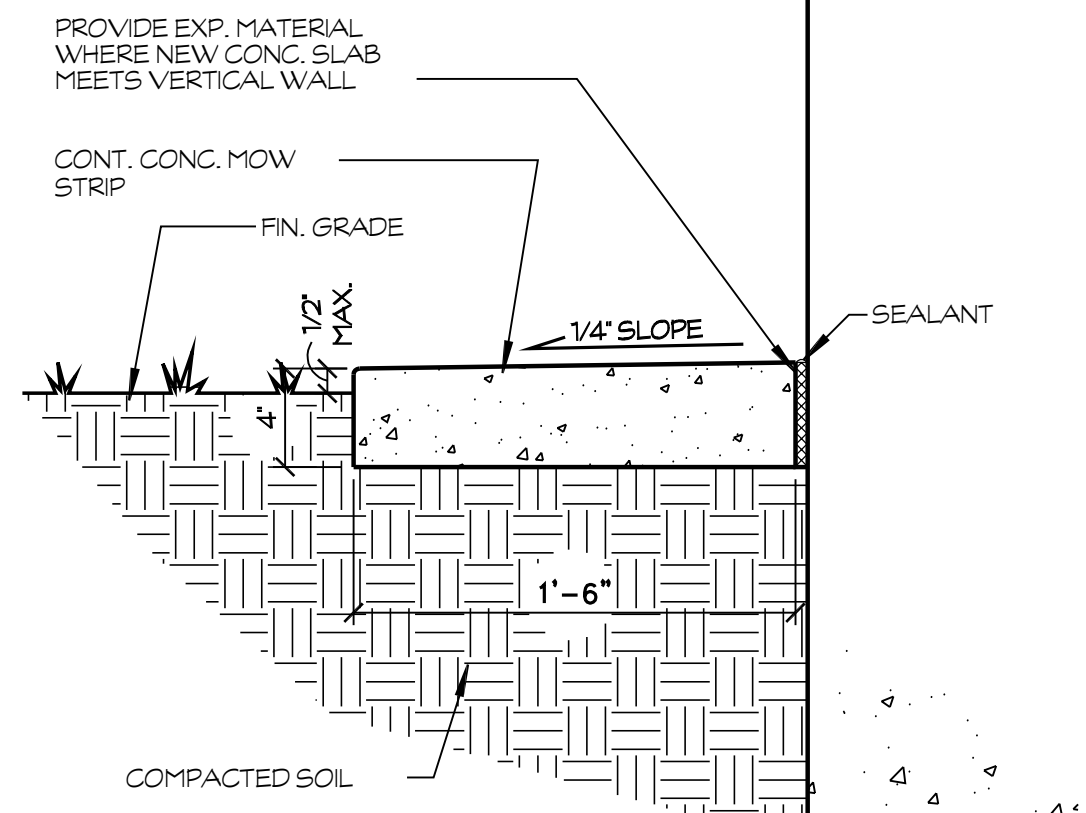


17 CONCRETE MOW STRIP AT WALL
SCALE: 1/2" = 1'-0"
E:\17-67 shields & brawley elementary\details\site\mowstrip.dwg 03/21/18 11:04

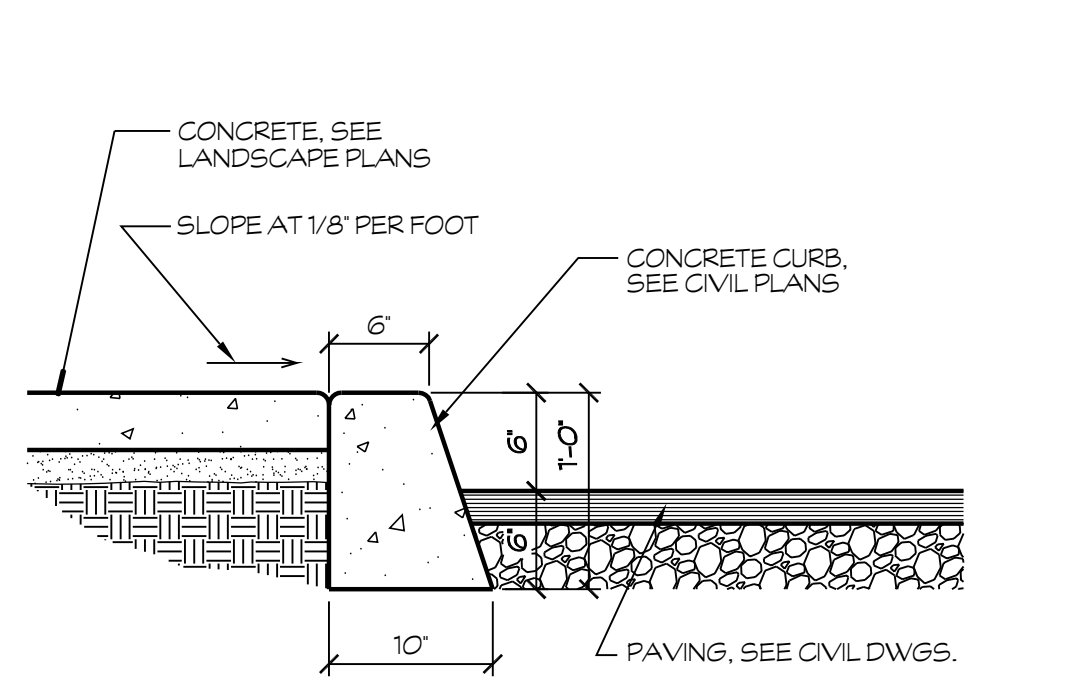


18 CURB AT WALK
SCALE: 1" = 1'-0"
E:\17-67 shields & brawley elementary\details\site\1-25-3.dwg 03/21/18 11:05

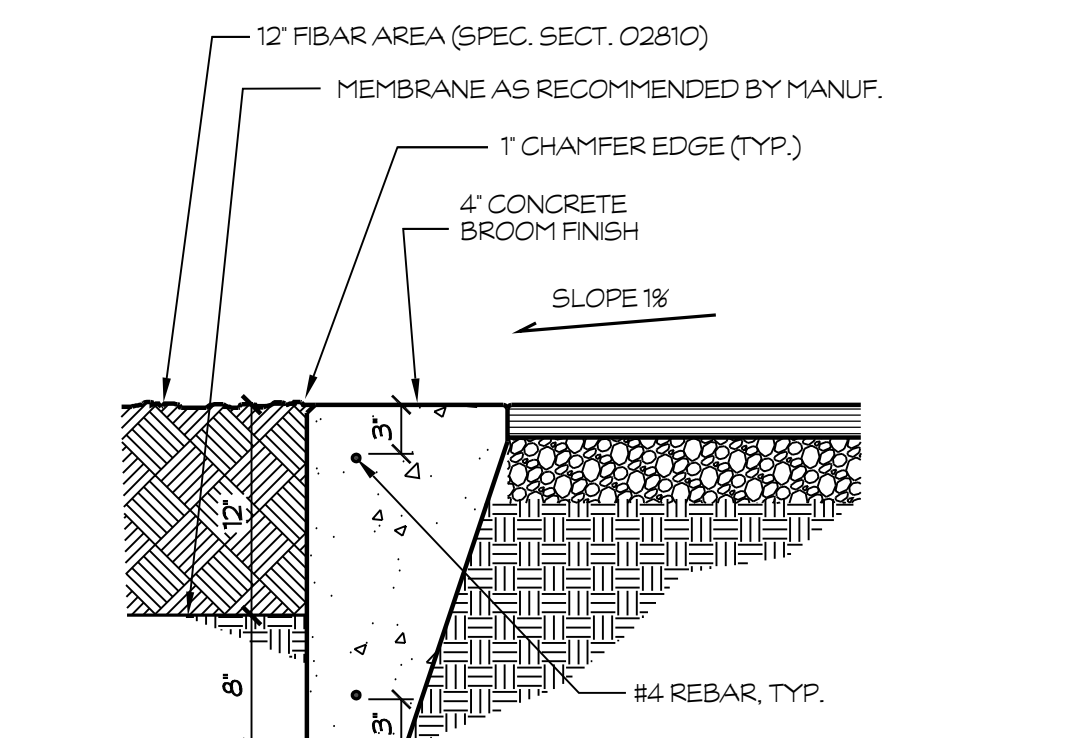


19 FIBAR PLAY AREA AT AC TO CONG.
SCALE: 1" = 1'-0"
E:\17-67 shields & brawley elementary\details\site\1-25-5\Fibar Play Area.dwg 03/21/18 11:06

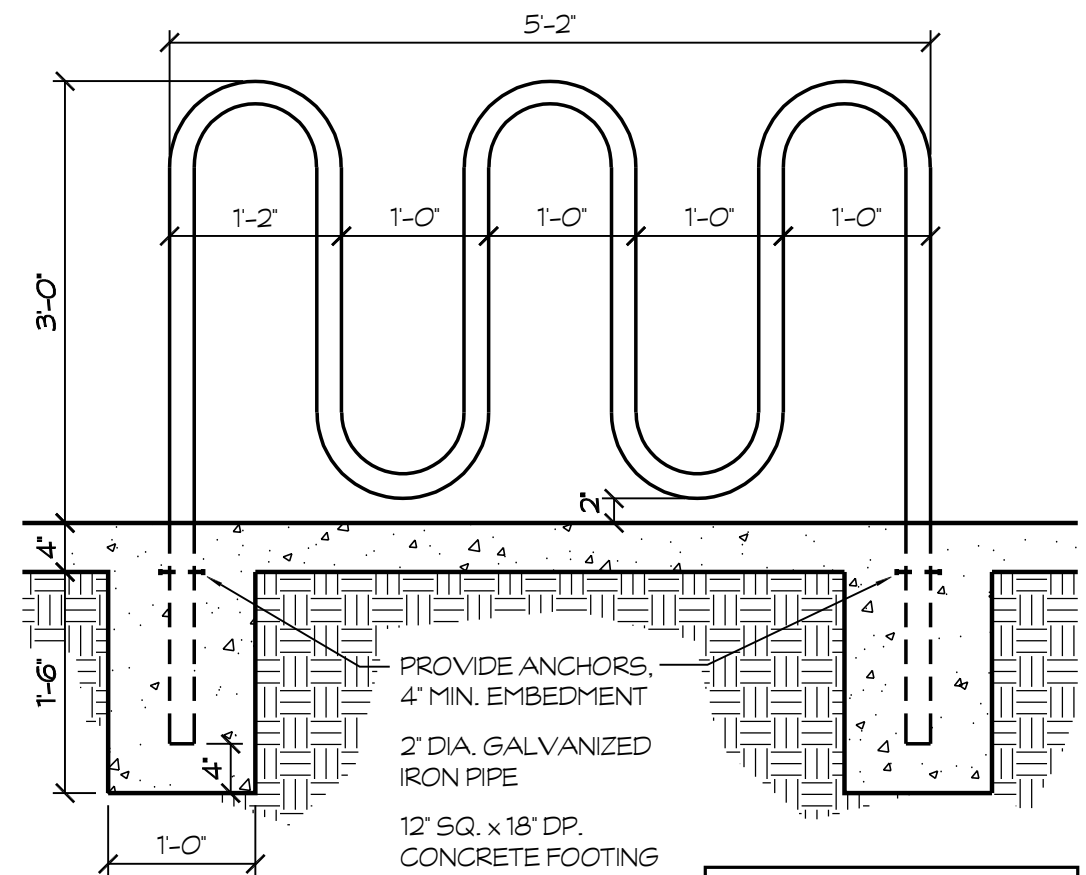


20 BICYCLE RACK @ CONCRETE SLAB
SCALE: 3/4" = 1'-0"
E:\17-67 shields & brawley elementary\details\site\Bike Rack @ Conc. Slab - 01.dwg 03/21/18 11:07

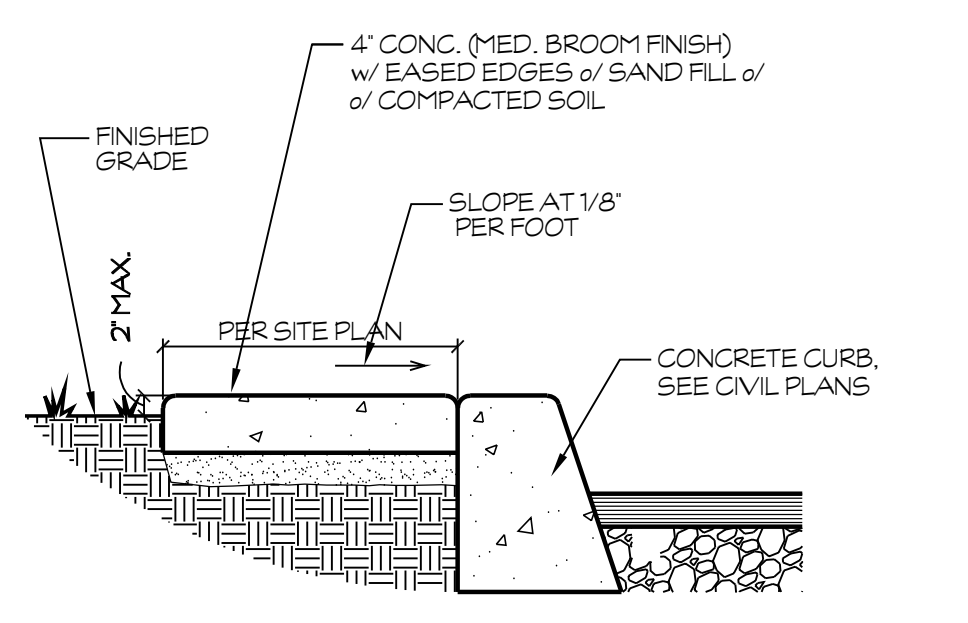


13 MOWSTRIP AT PARKING
SCALE: 1" = 1'-0"
E:\17-67 shields & brawley elementary\details\site\18in...Walk_Grade.dwg 03/21/18 11:07

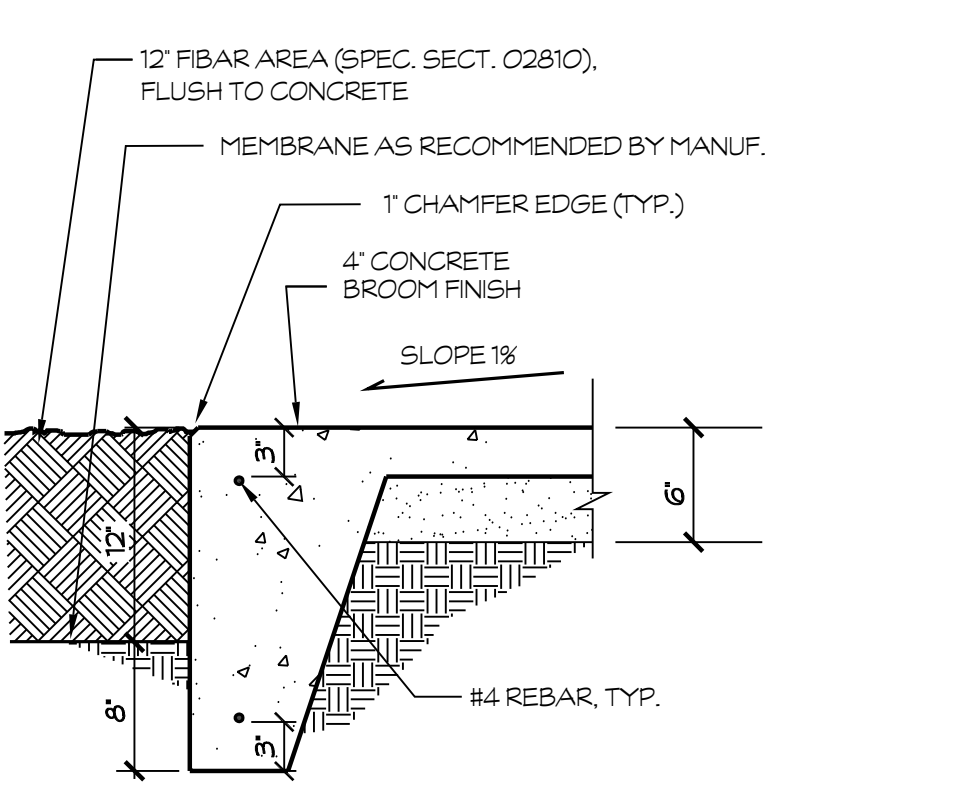


14 FIBAR PLAY AREA
SCALE: 1" = 1'-0"
E:\17-67 shields & brawley elementary\details\site\1-25-5\Fibar Play Area.dwg 03/21/18 11:08

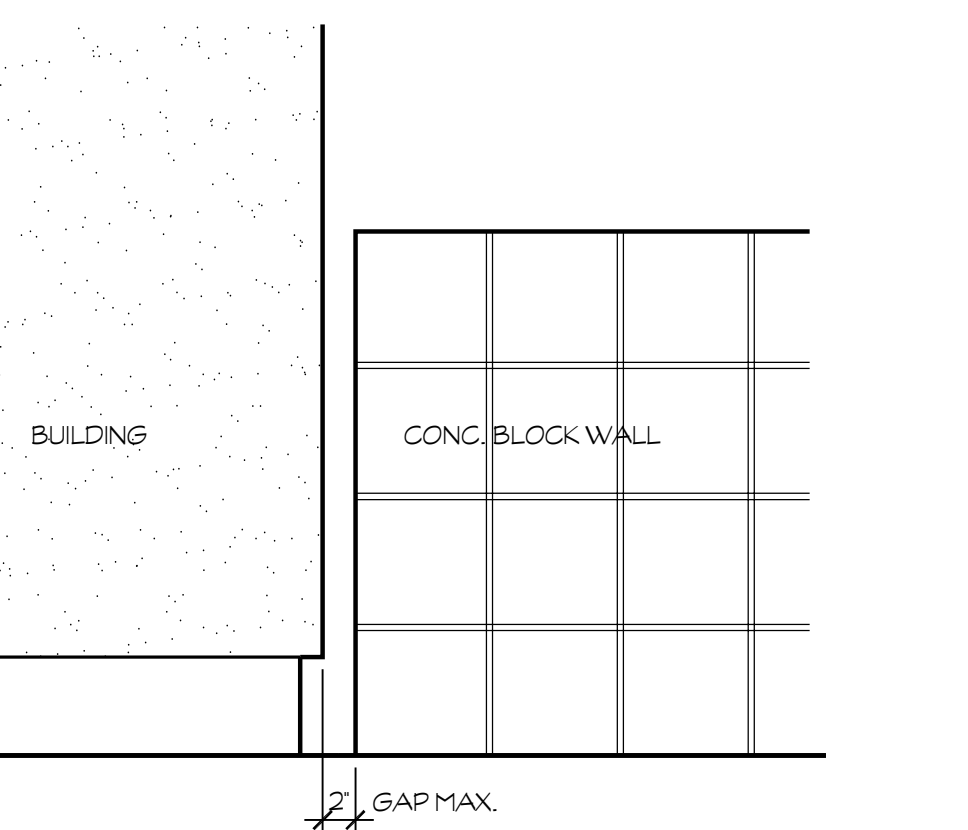


15 CONC. BLOCK WALL AT BUILDING
SCALE: 1" = 1'-0"
E:\17-67 shields & brawley elementary\details\site\04 - C-111 Wall @ Bldg - 2x.dwg 03/21/18 11:09

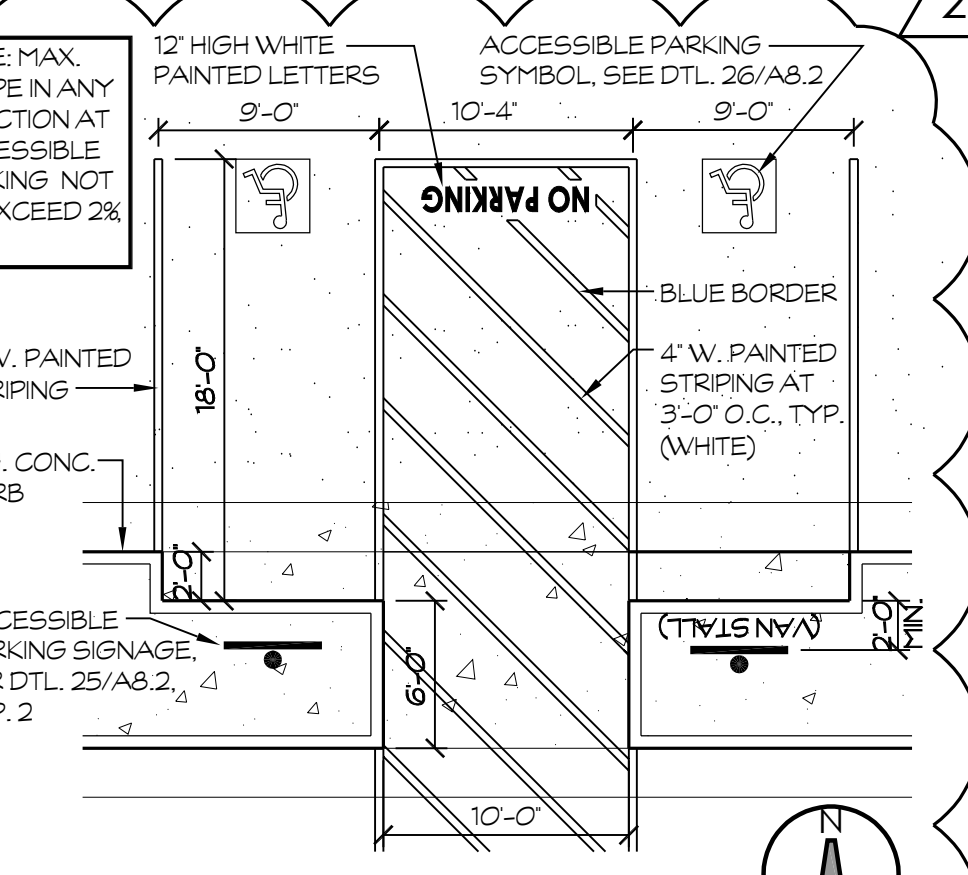


16 SIM. ACCESSIBLE STALLS
SCALE: 1/8" = 1'-0"
E:\17-67 shields & brawley elementary\details\site\ACCESSIBLE PARKING STALLS.dwg 03/21/18 11:10

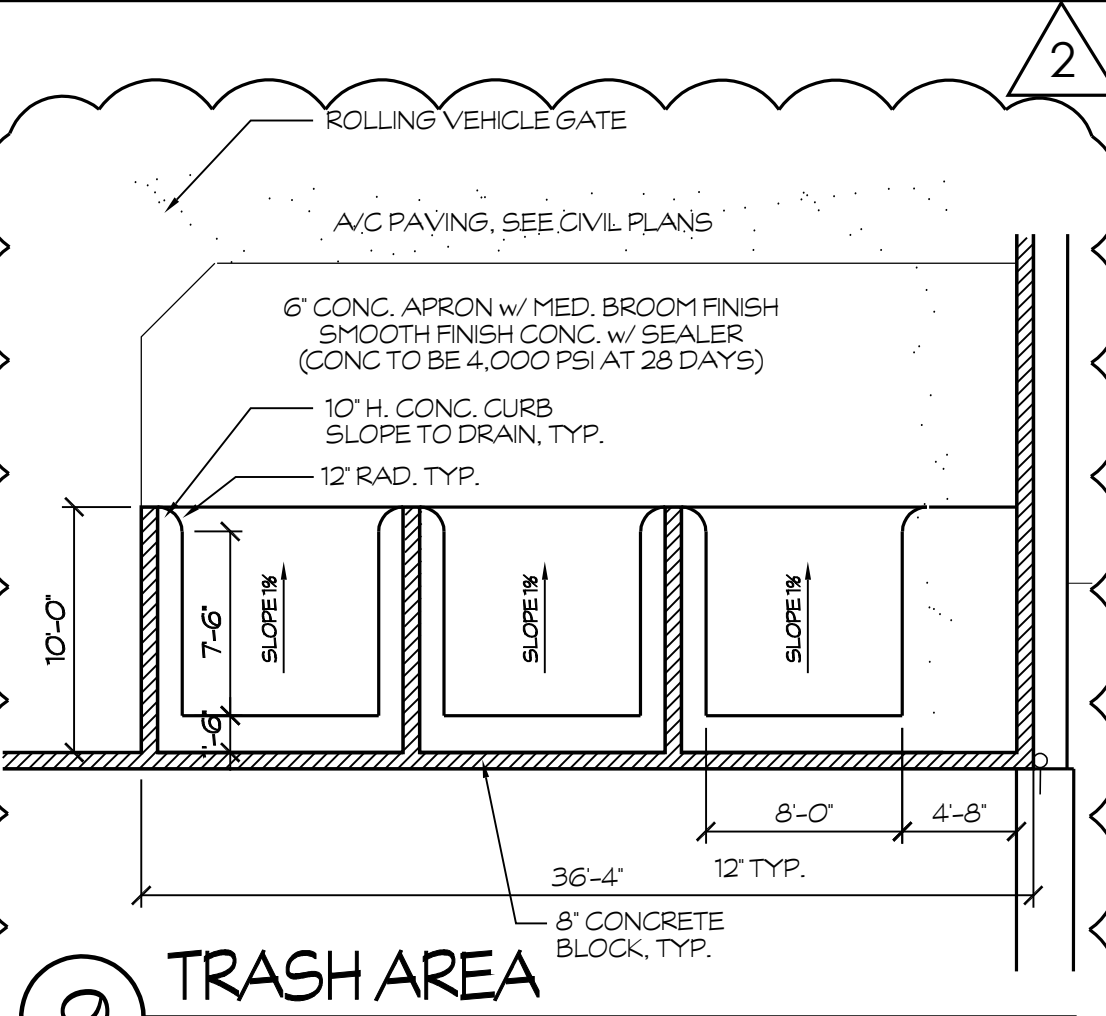


9 TRASH AREA w/ RECYCLE AREA
SCALE: 1/8" = 1'-0"
E:\17-67 shields & brawley elementary\details\site\Enlarg-Trash-Area.dwg 03/21/18 11:18

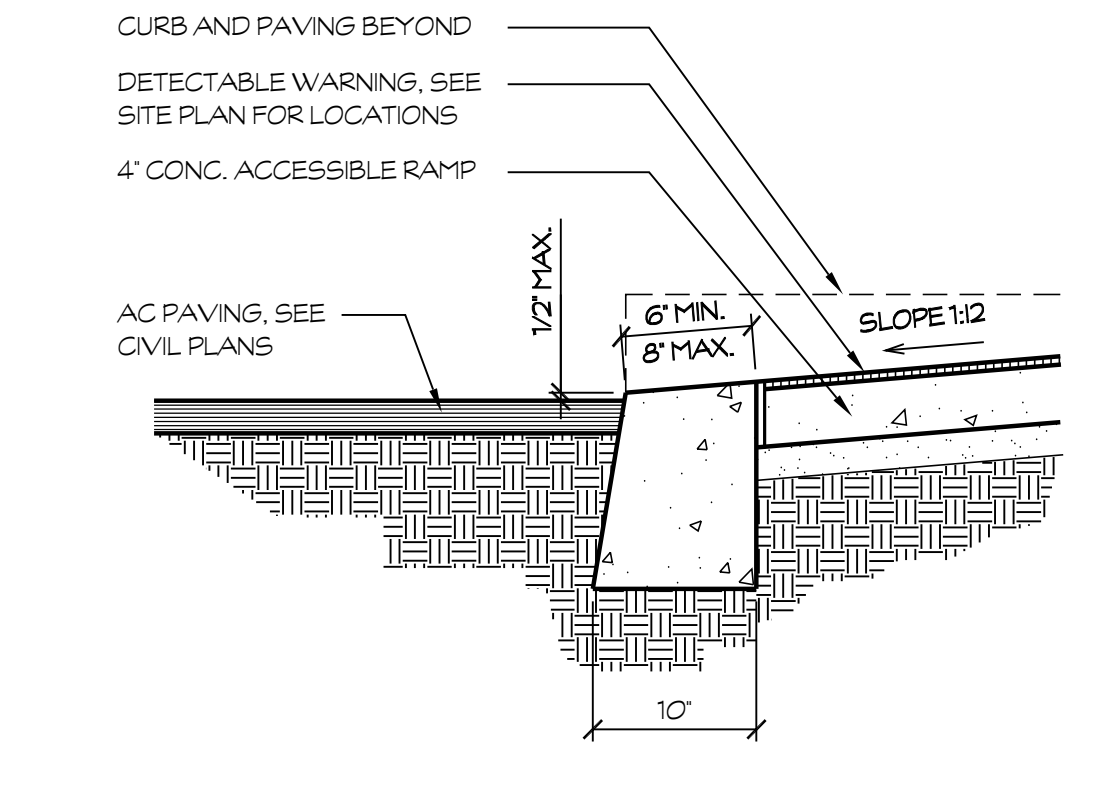


10 ACCESSIBLE RAMP AT CURB BREAK
SCALE: 1" = 1'-0"
E:\17-67 shields & brawley elementary\details\site\VC_Ramp.dwg 03/21/18 11:17

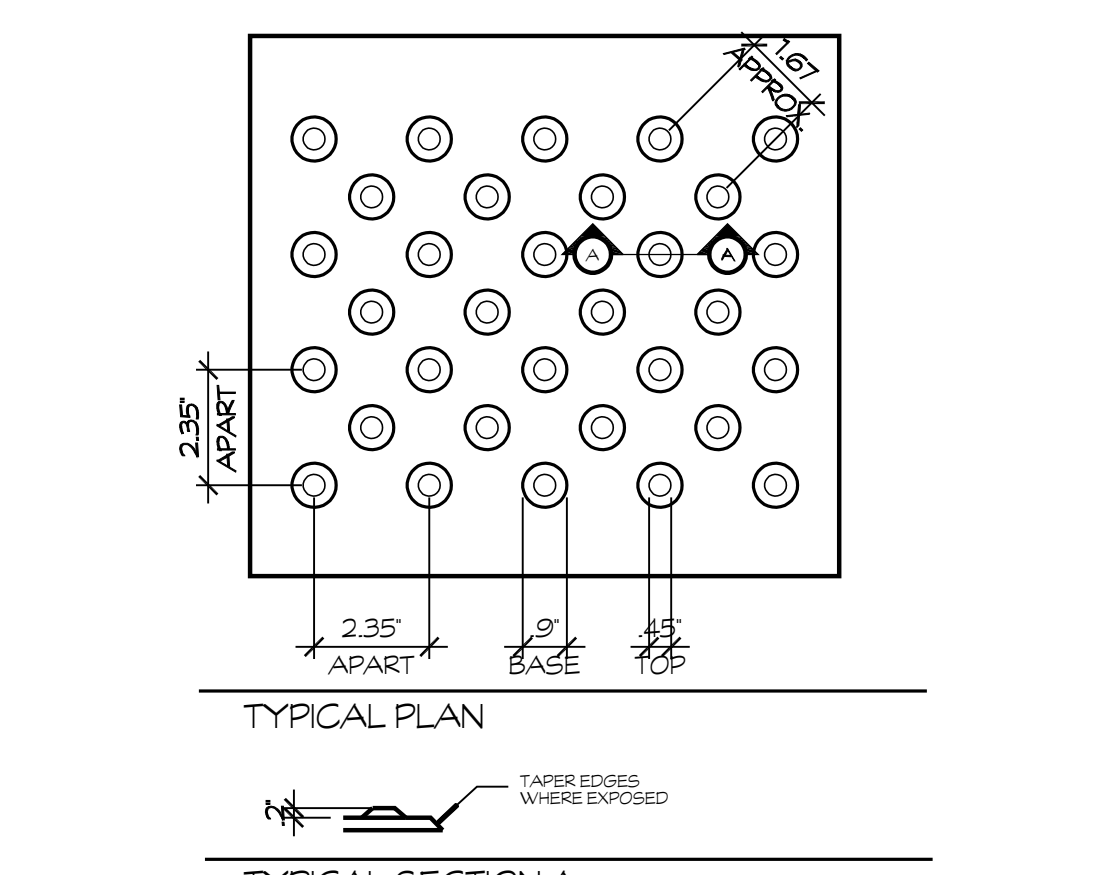


11 DETECTABLE WARNING AT VEHICULAR AREAS
N.T.S.
E:\17-67 shields & brawley elementary\details\site\14-hc\14 DETECTABLE WARNING 02.dwg 03/21/18 11:17

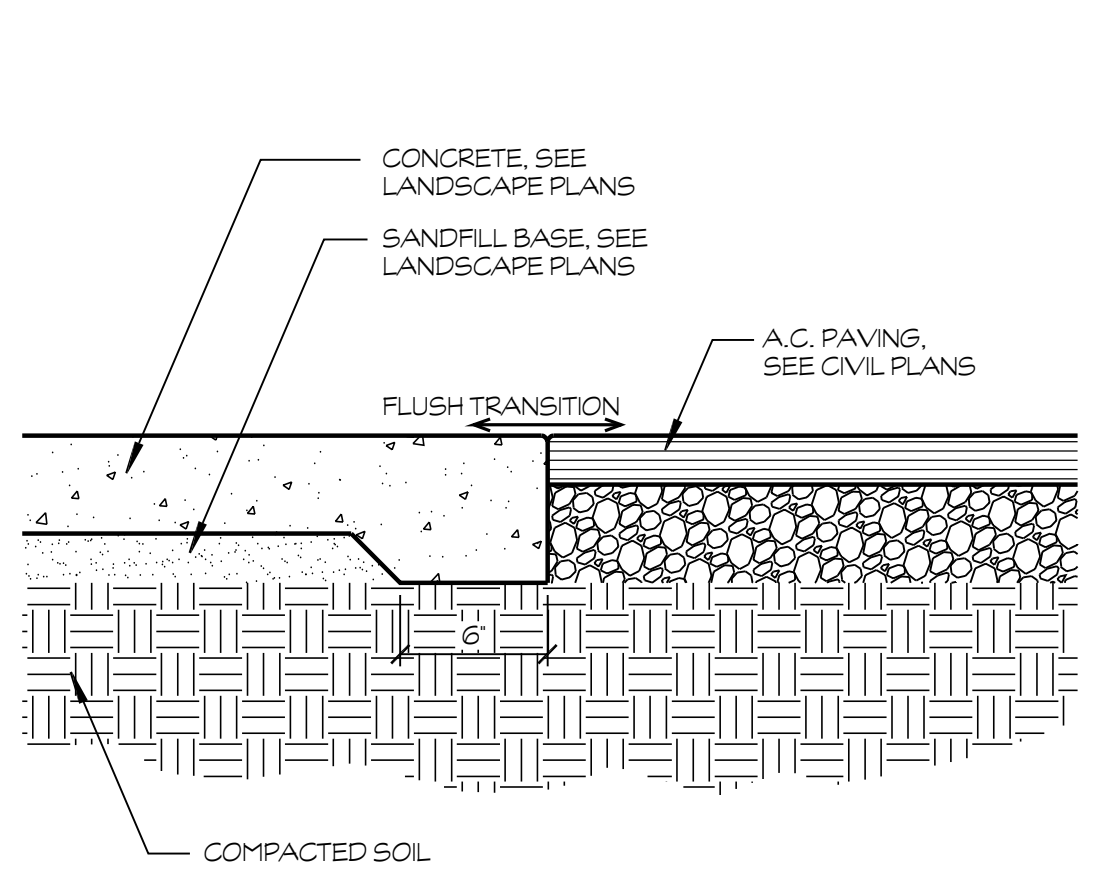


12 CONC. WALK AT A.C. PAVING
SCALE: 1/2" = 1'-0"
E:\17-67 shields & brawley elementary\details\site\AC TO CONG.dwg 03/21/18 11:18

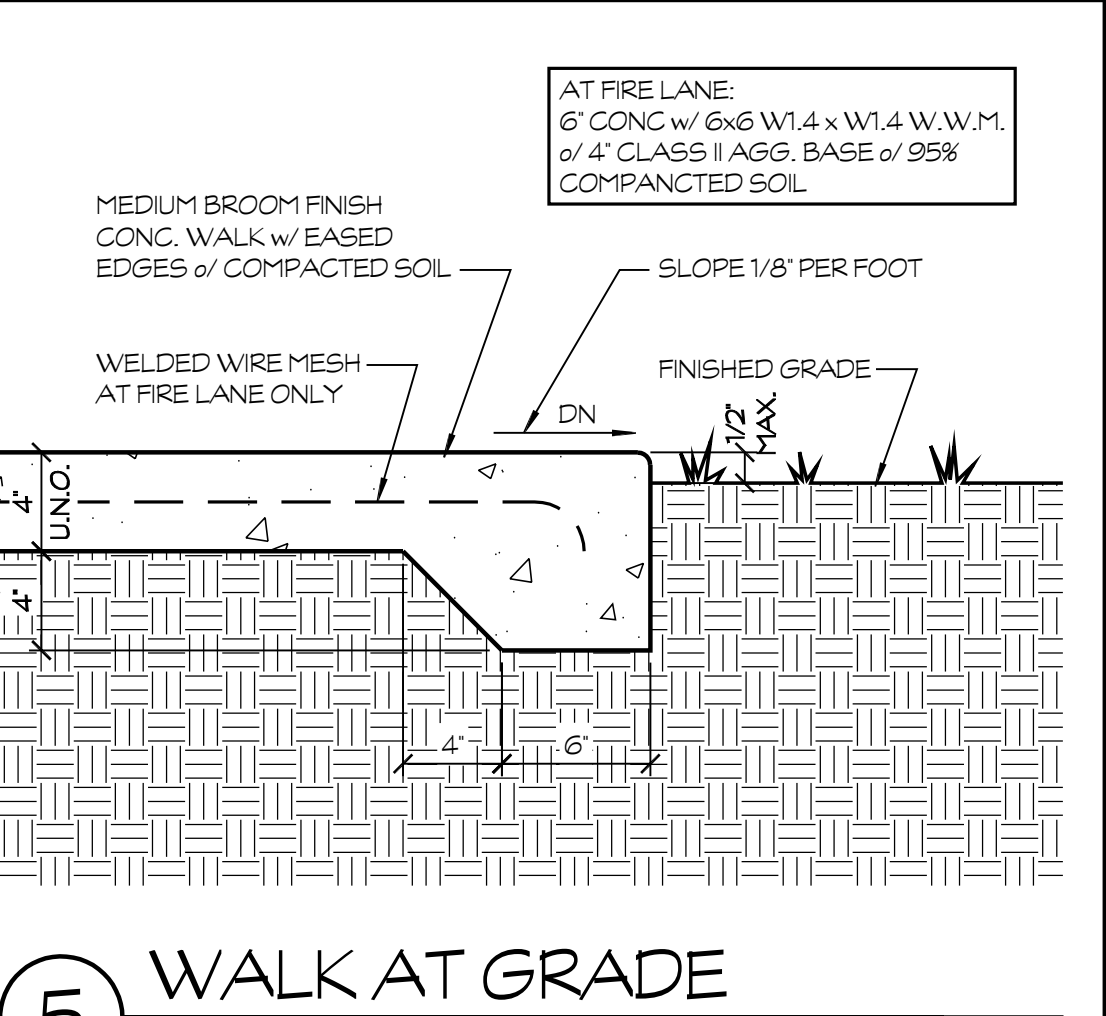


5 WALK AT GRADE
SCALE: 1/2" = 1'-0"
E:\17-67 Shields & Brawley Elementary\Details\Site\01 - Conc. - Walk @ Grade - 01.dwg 05/30/18 11:37

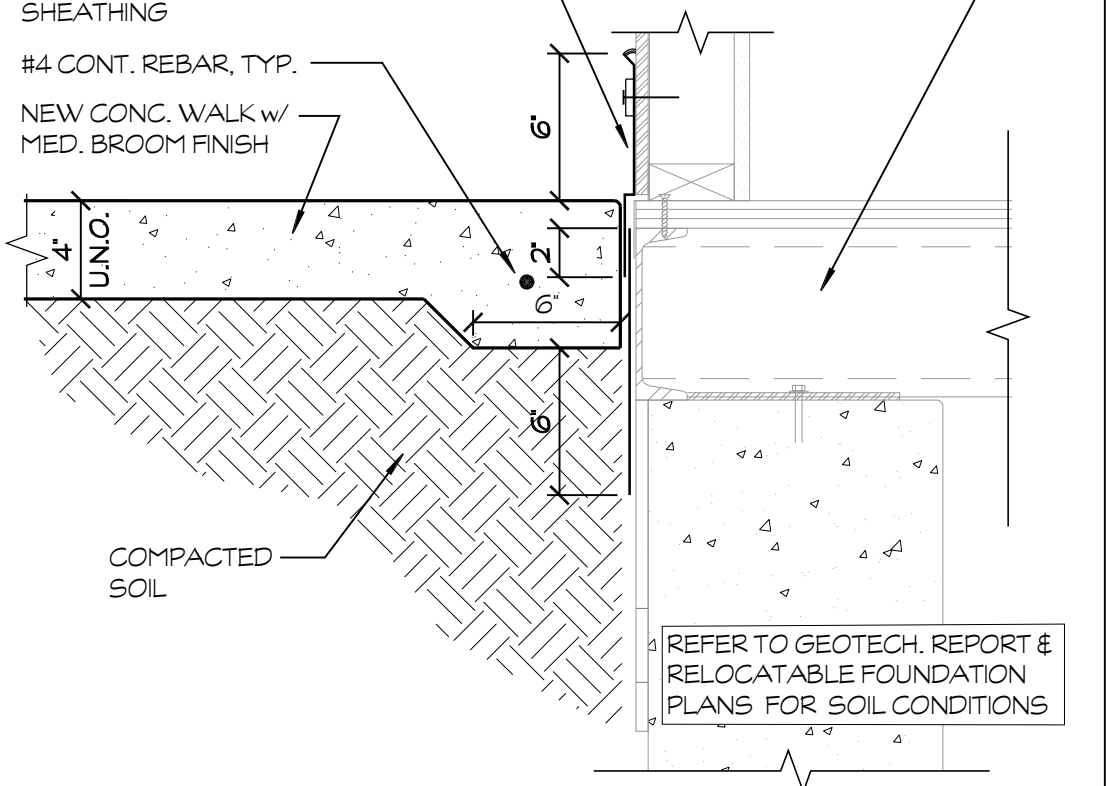


6 PERIMETER FOOTING AT CONC. WALK
SCALE: 1/2" = 1'-0"
E:\17-67 shields & brawley elementary\details\site\Perimeter Footing Walk.dwg 03/21/18 11:37

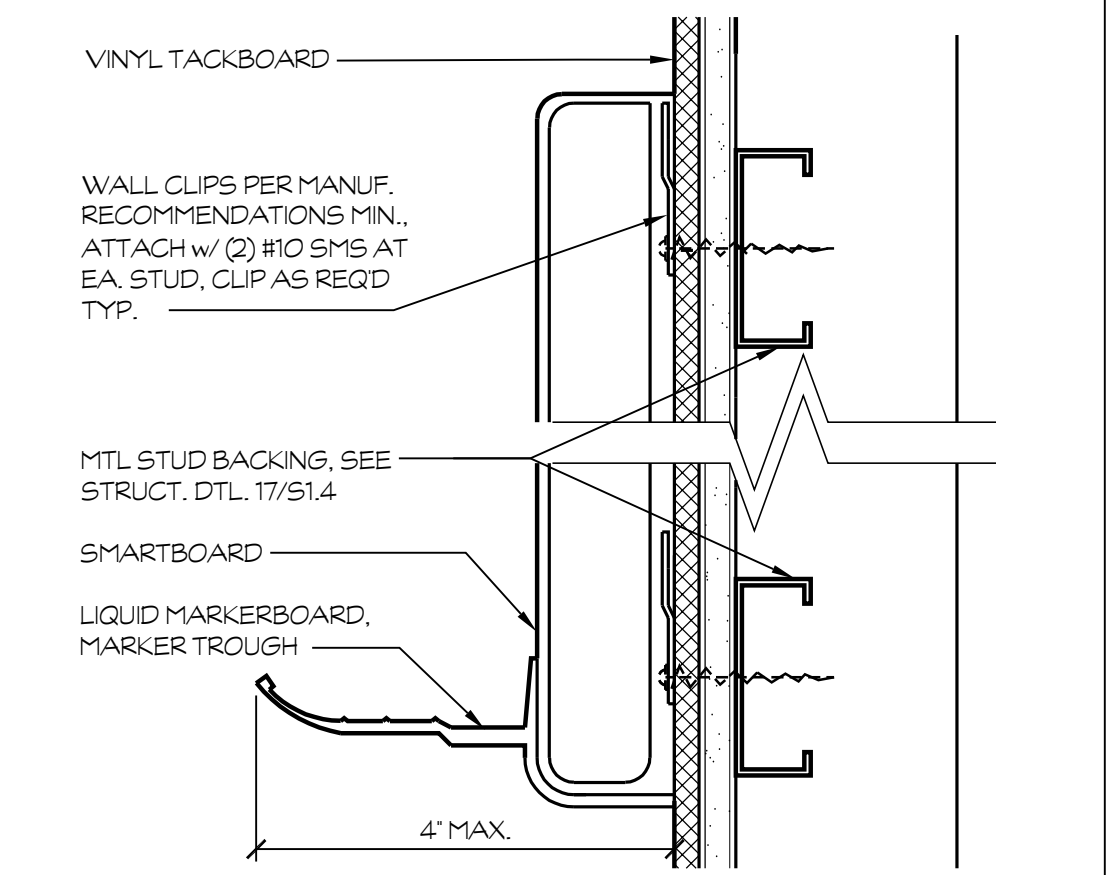


7 SMARTBOARD MOUNTING MINIMUM (3) CLIPS PER BOARD
SCALE: 3" = 1'-0"
E:\17-67 shields & brawley elementary\details\cabinets\Smartboard Mounting.dwg 03/21/18 11:20

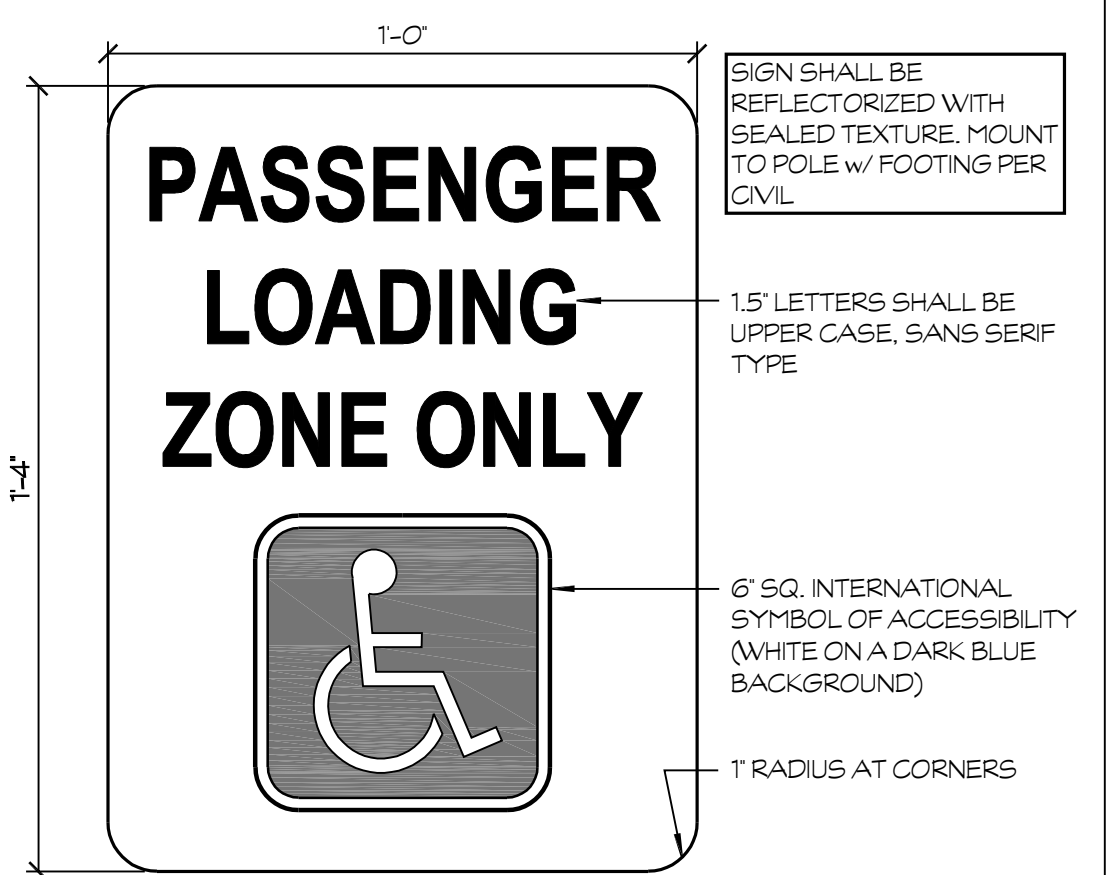


8 PASSENGER LOADING ZONE
SCALE: 3" = 1'-0"
E:\17-67 Shields & Brawley Elementary\Details\Site\Passenger Loading Zone signage.dwg 05/31/18 08:49

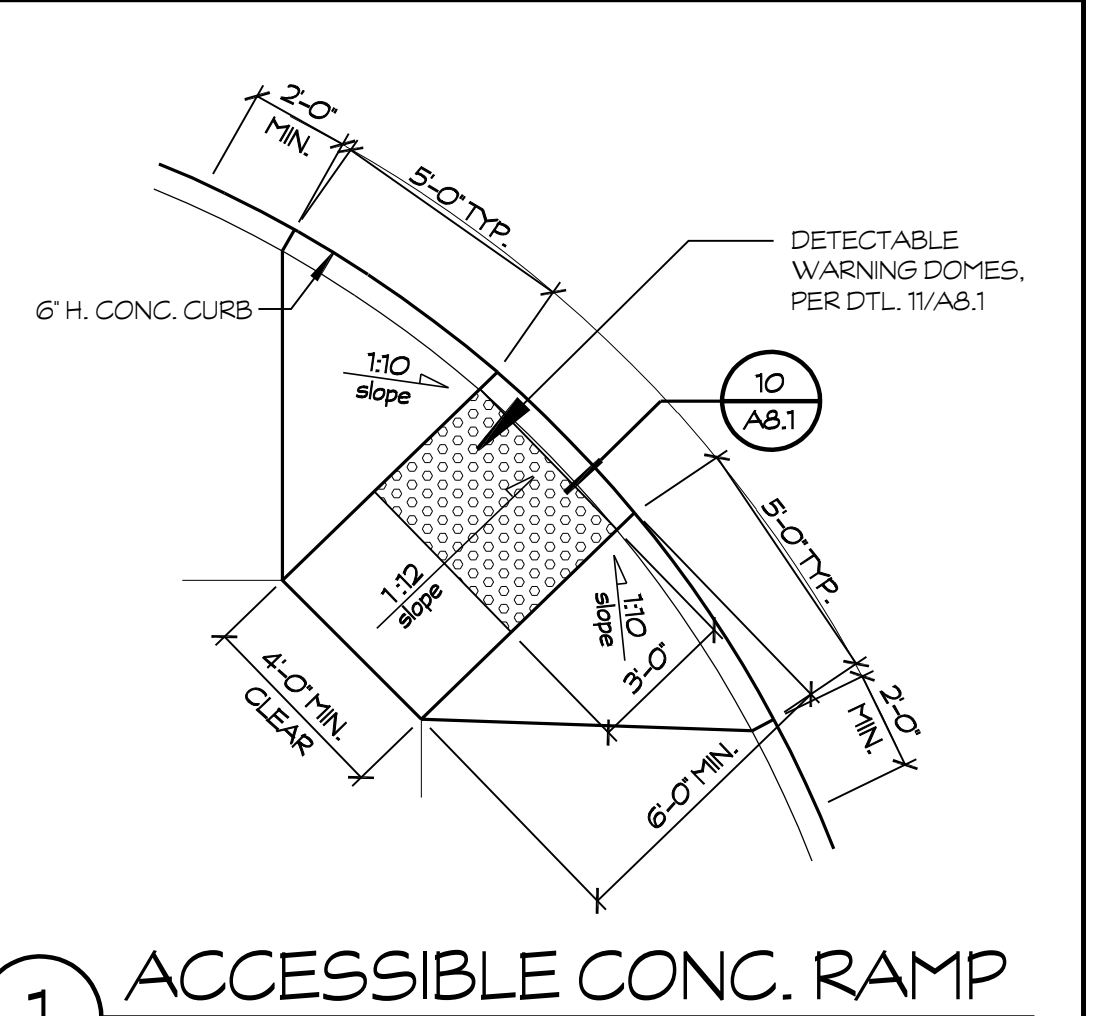

1 ACCESSIBLE CONC. RAMP
SCALE: 1/4" = 1'-0"
E:\17-67 Shields & Brawley Elem School\details\Access Conc Ramp.dwg 10/16/18 13:34

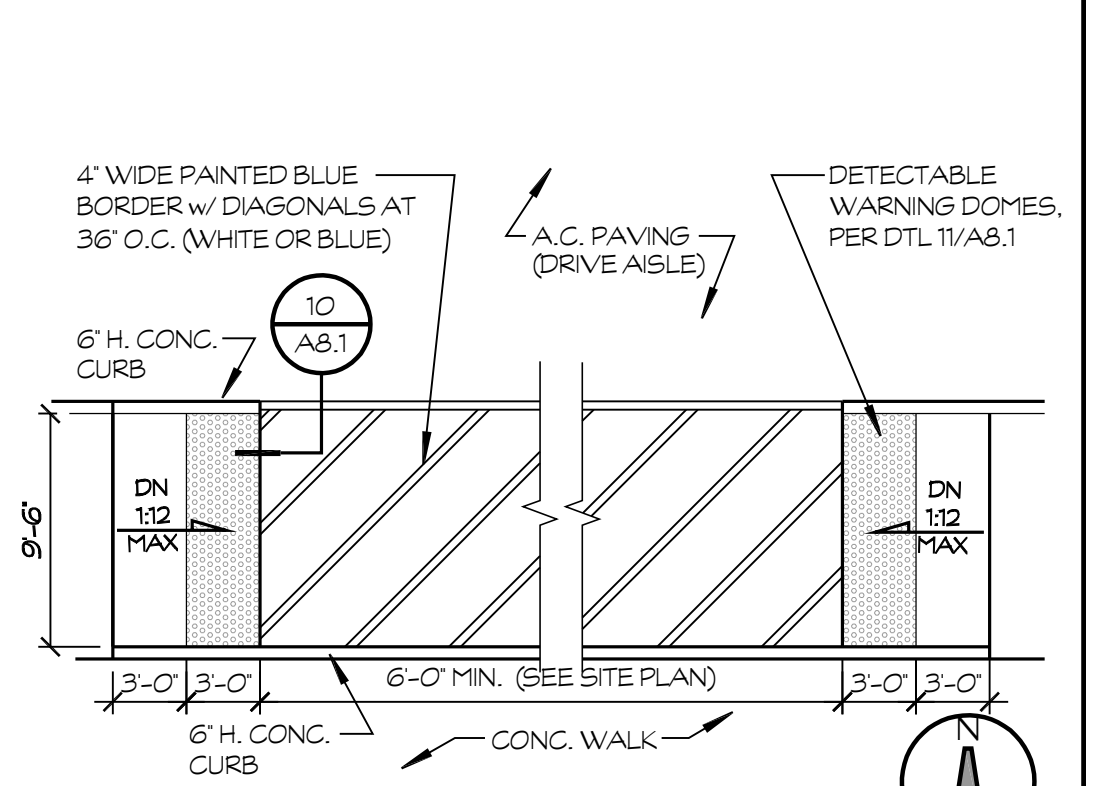

2 PASSENGER LOADING ZONE
SCALE: 1/8" = 1'-0"
E:\17-67 Shields & Brawley Elementary\Details\Site\Passenger Loading Zone.dwg 05/31/18 08:46

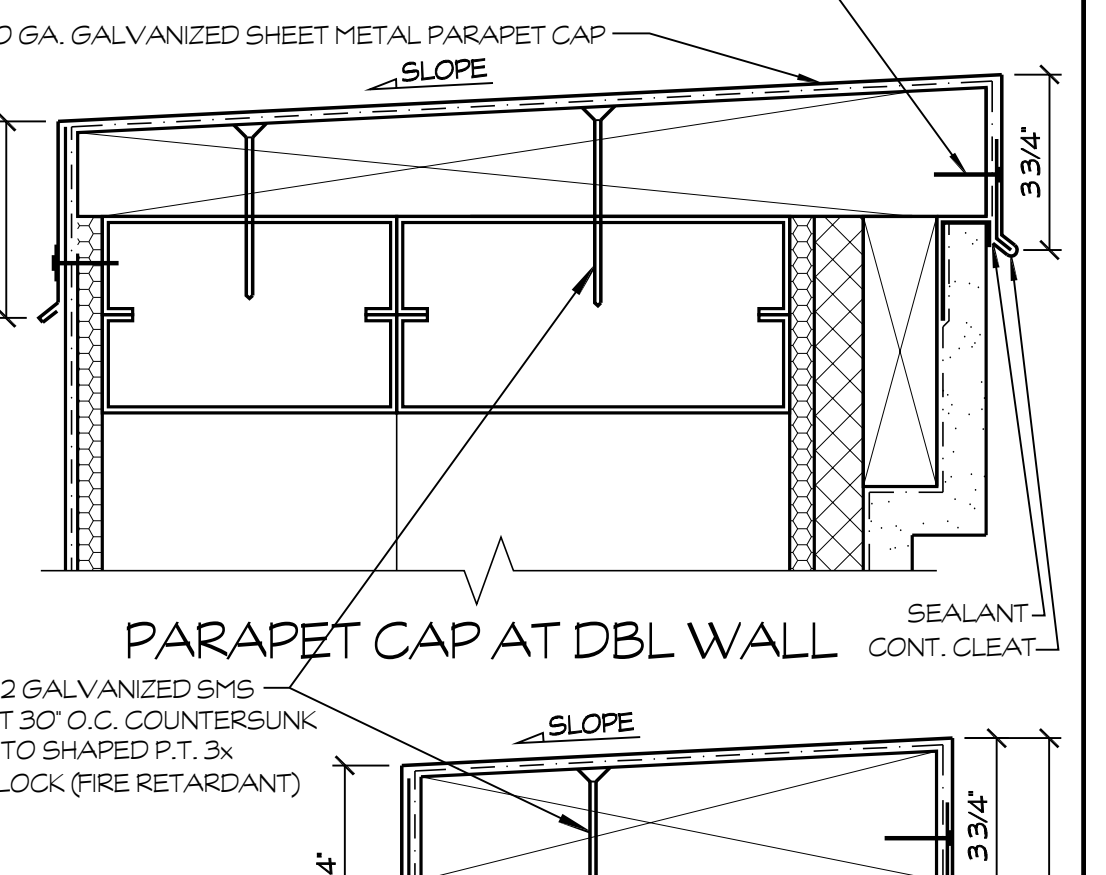


4 PARAPET CAP
SCALE: 3" = 1'-0"
E:\17-67 shields & brawley elementary\details\site\parapet.dwg 05/29/18 16:46



7790 NORTH PALM AVENUE
FRESNO, CALIFORNIA 93711
T 559.448.8400 F 559.448.8467
www.simpbk.com

PROJECT:
SHIELDS & BRAWLEY ELEMENTARY SCHOOL

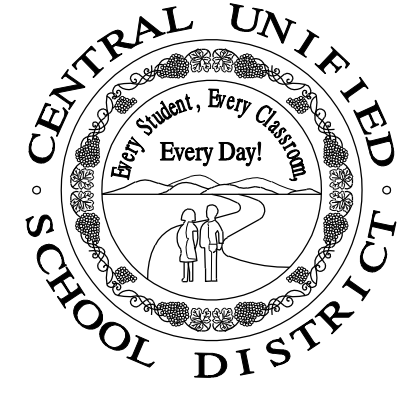

AD 2-36a
S&B Elementary
02-116800



THE FIRM OF SMITH, IWANAGA, MILHOUS, ARCHITECTS, INC. EXPRESSLY RESERVES ITS COMMON LAW COPYRIGHT AND OTHER AVAILABLE PROTECTOR RIGHTS IN THESE PLANS. THESE PLANS ARE NOT TO BE REPRODUCED, CHANGED, OR COPIED IN ANY FORM OR MANNER WHATSOEVER, NOR ARE THEY TO BE ASSIGNED TO A THIRD PARTY WITHOUT FIRST OBTAINING THE WRITTEN PERMISSION AND CONSENT OF THE ARCHITECT. IN THE EVENT OF UNAUTHORIZED REUSE OF THESE PLANS BY A THIRD PARTY, THE THIRD PARTY SHALL HOLD THE ARCHITECT HARMLESS, AND SHALL BEAR THE COST OF THE ARCHITECT'S LEGAL FEES, ASSOCIATED WITH DEFENDING AND ENFORCING THESE RIGHTS.

PROJECT DEVELOPMENT

| DATE | ISSUED FOR |
|------|------------|
| | |
| | |
| | |

















REVISIONS

| No. | DATE | DESCRIPTION |
|-----|---------|------------------------|
| Δ 1 | 2.14.23 | DISTRICT MODIFICATIONS |
| Δ 2 | 2.27.23 | DISTRICT MODIFICATIONS |
| | | |
| | | |

SHEET DESCRIPTION

| PROJECT COORDINATOR | SHEET No. |
|---------------------|-------------|
| JOHN SMITH | A8.1 |
| PROJECT NO. | |
| DATE | |
| SCALE | |


AS NOTED

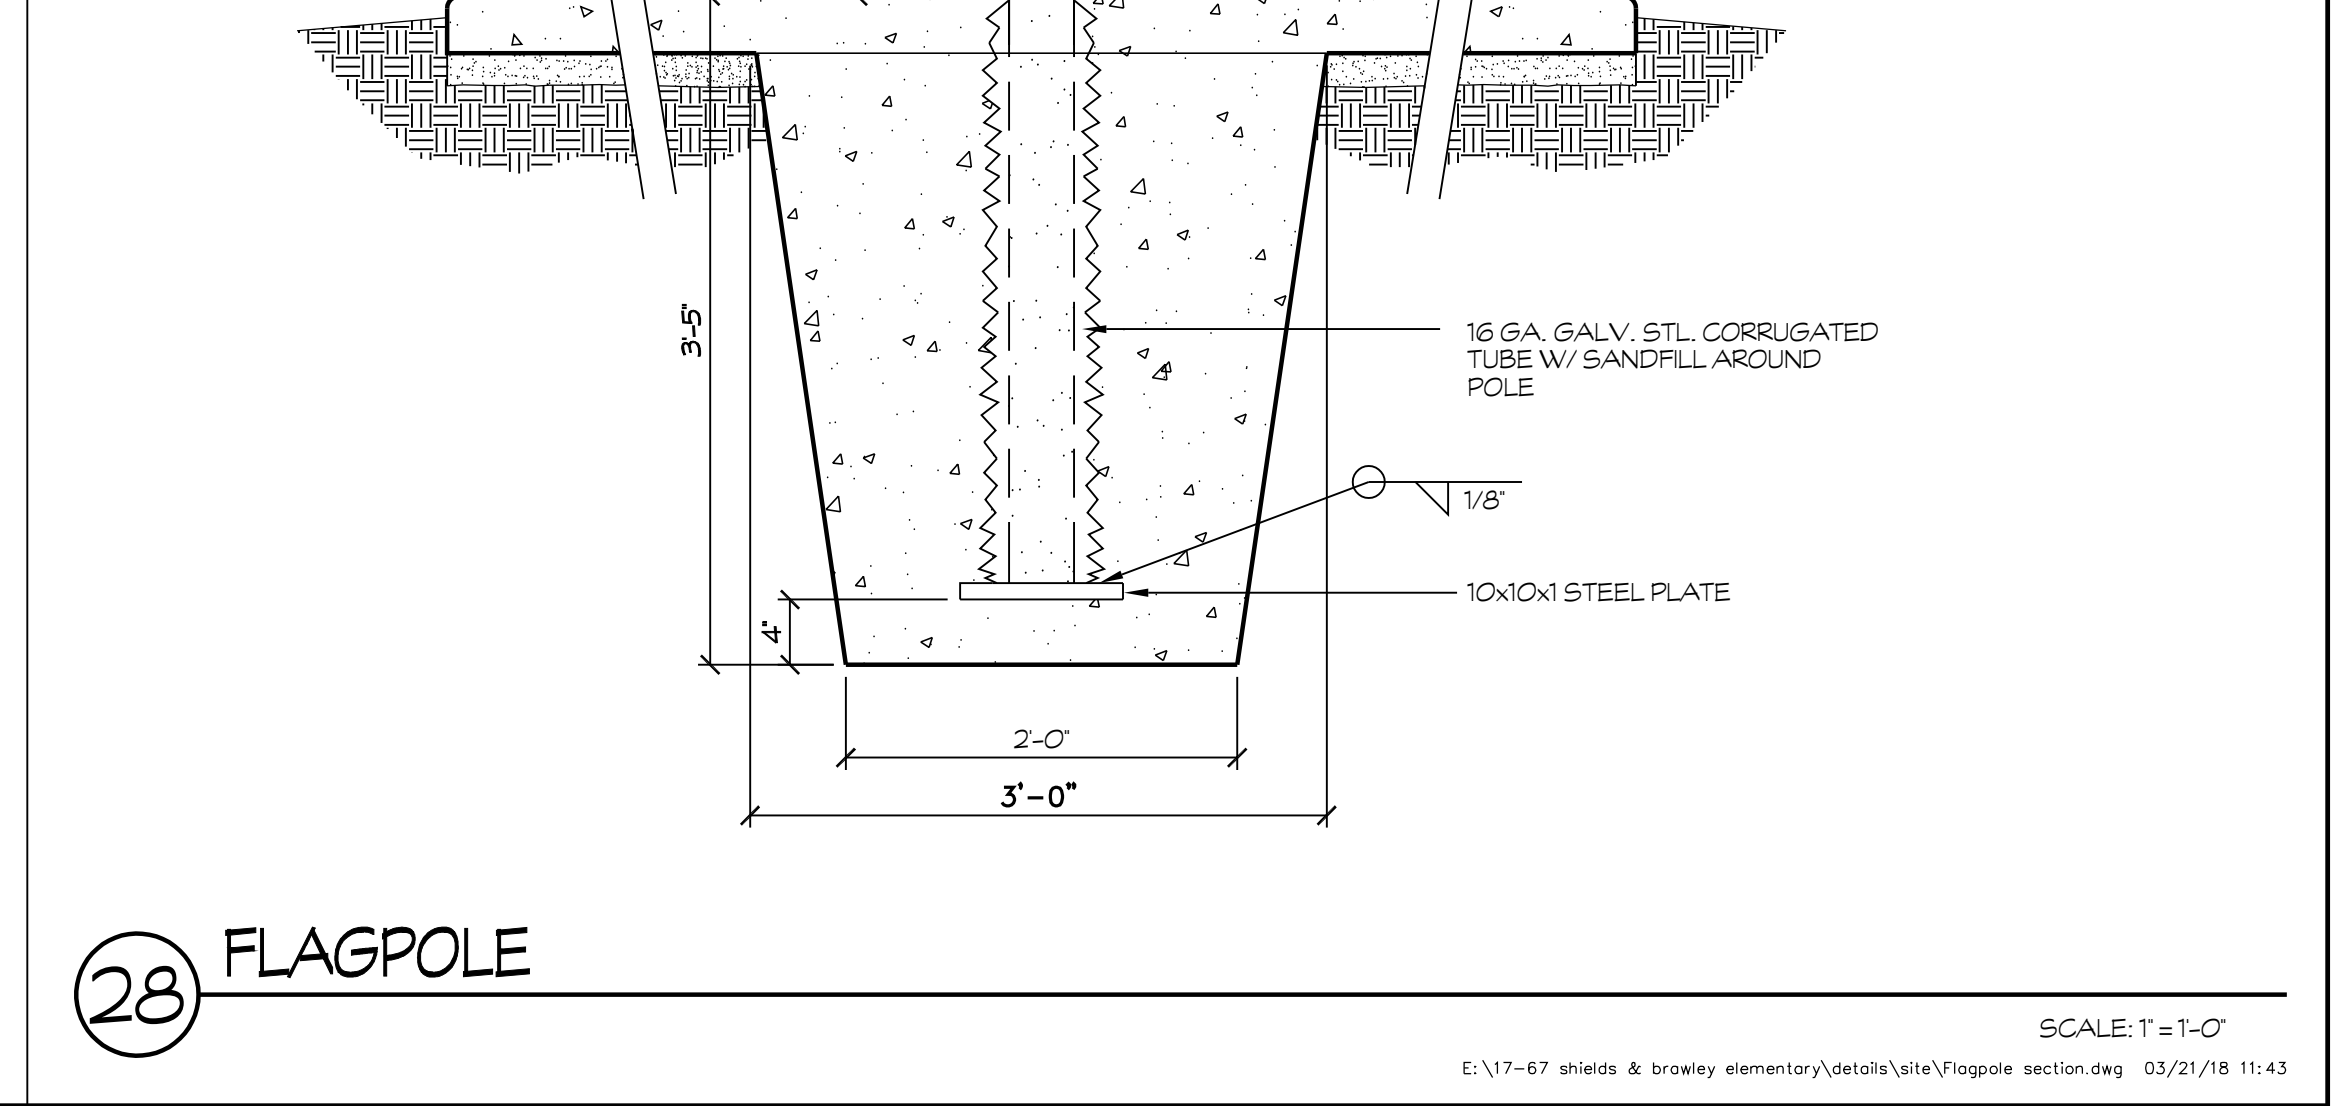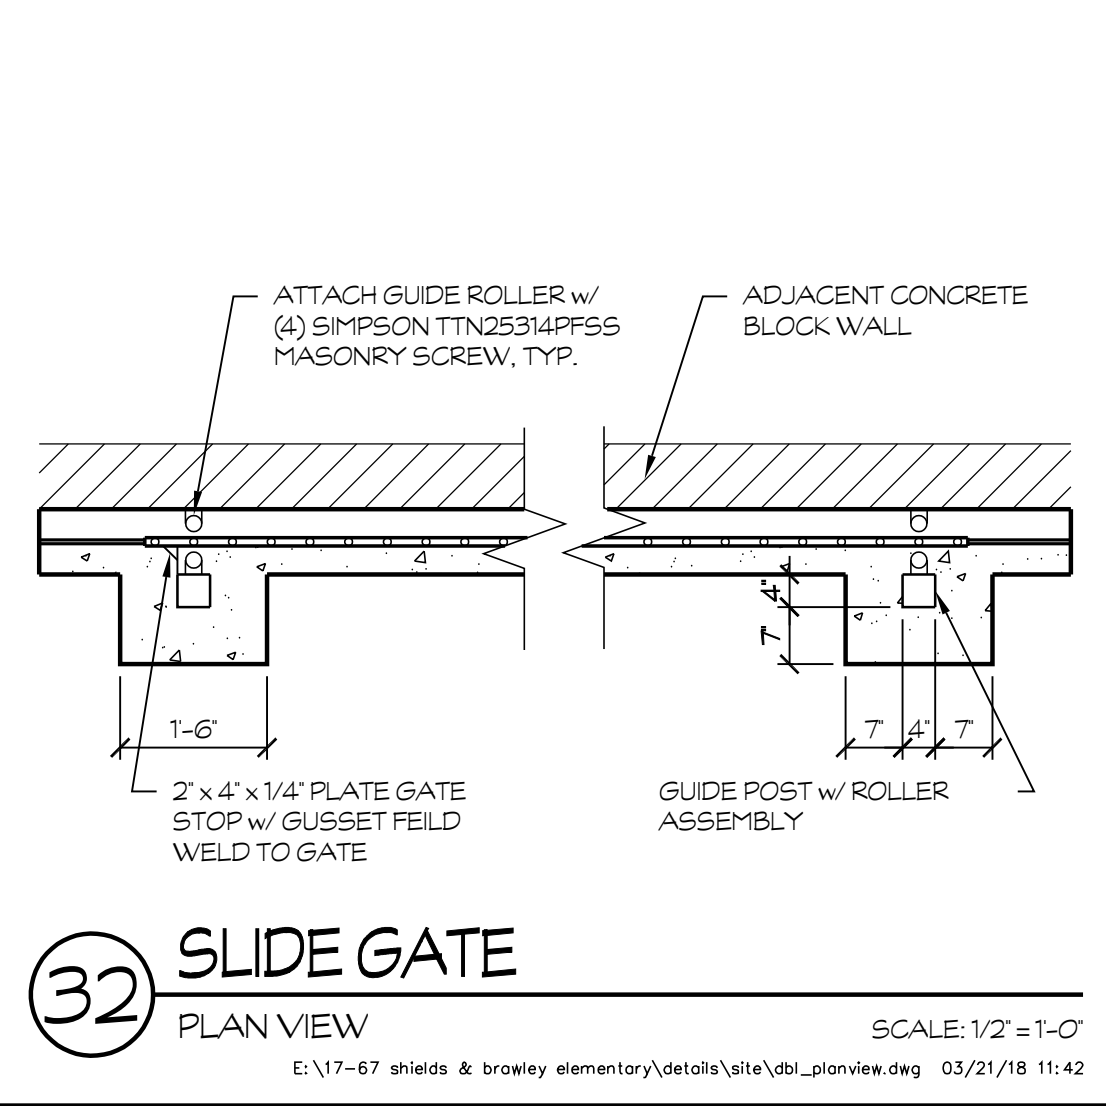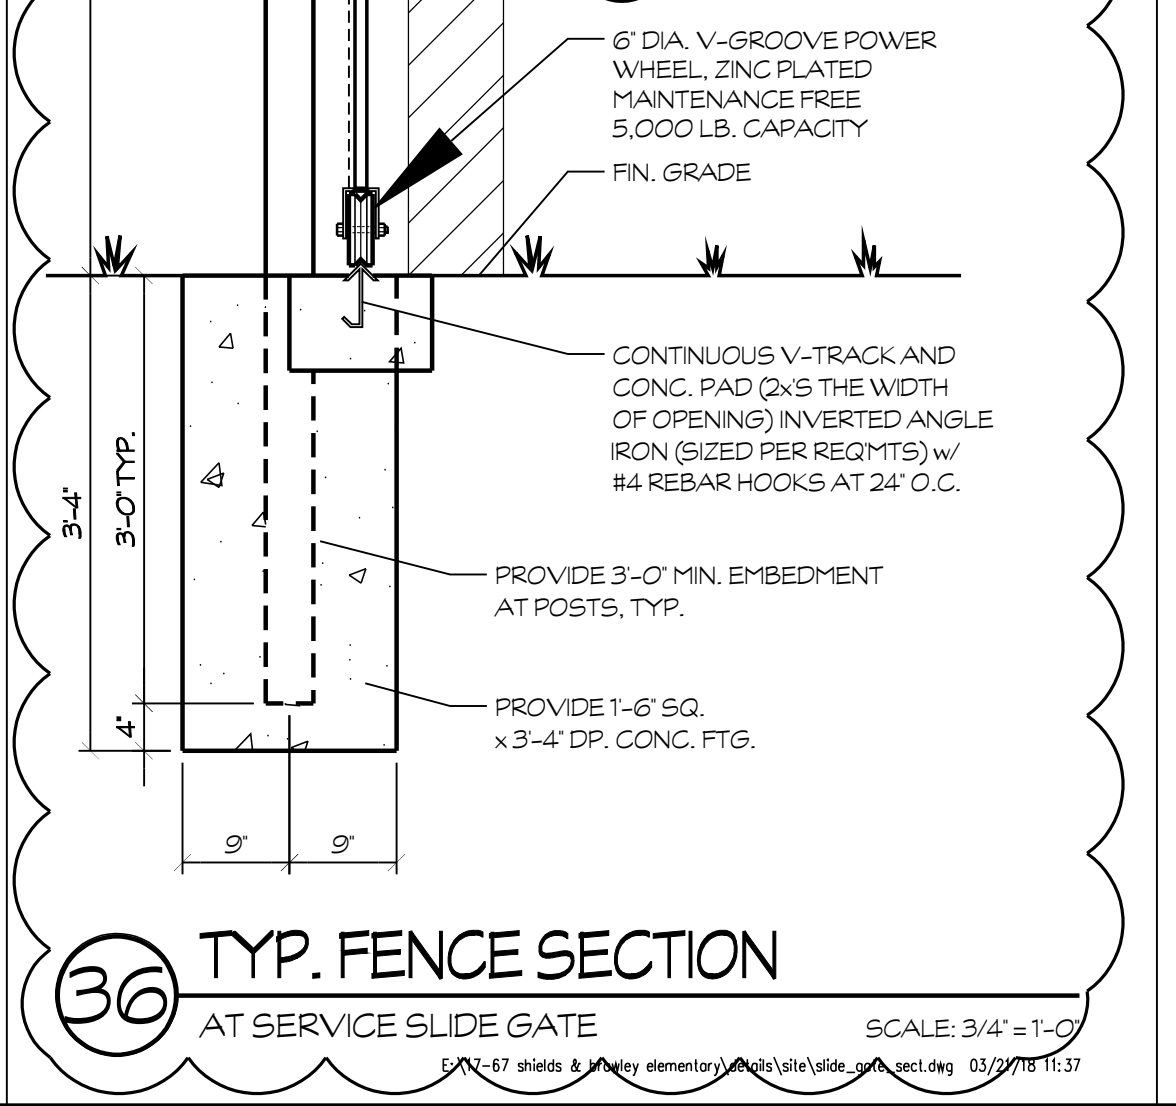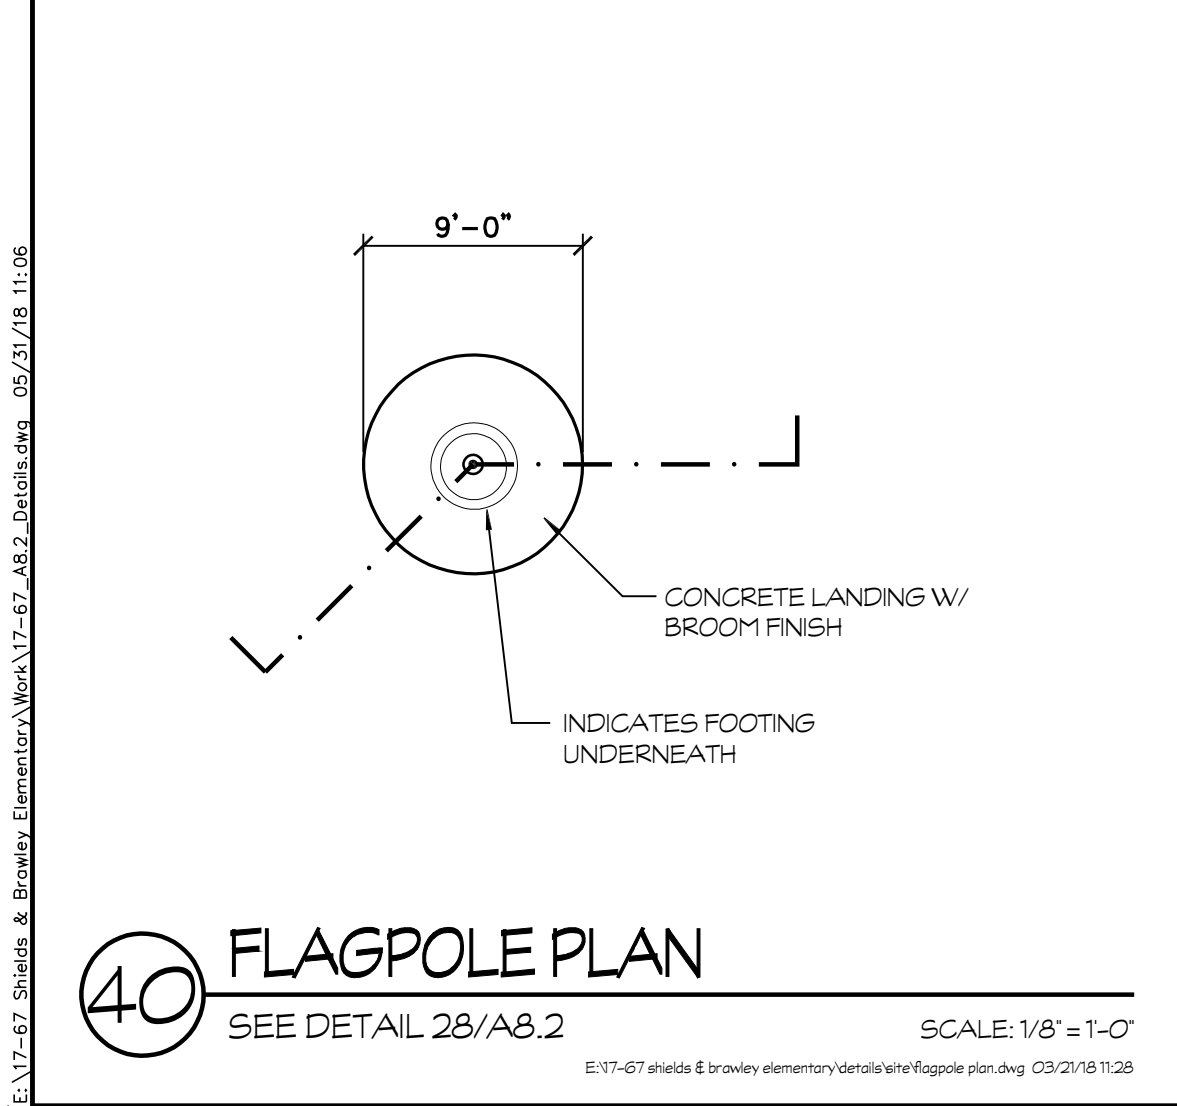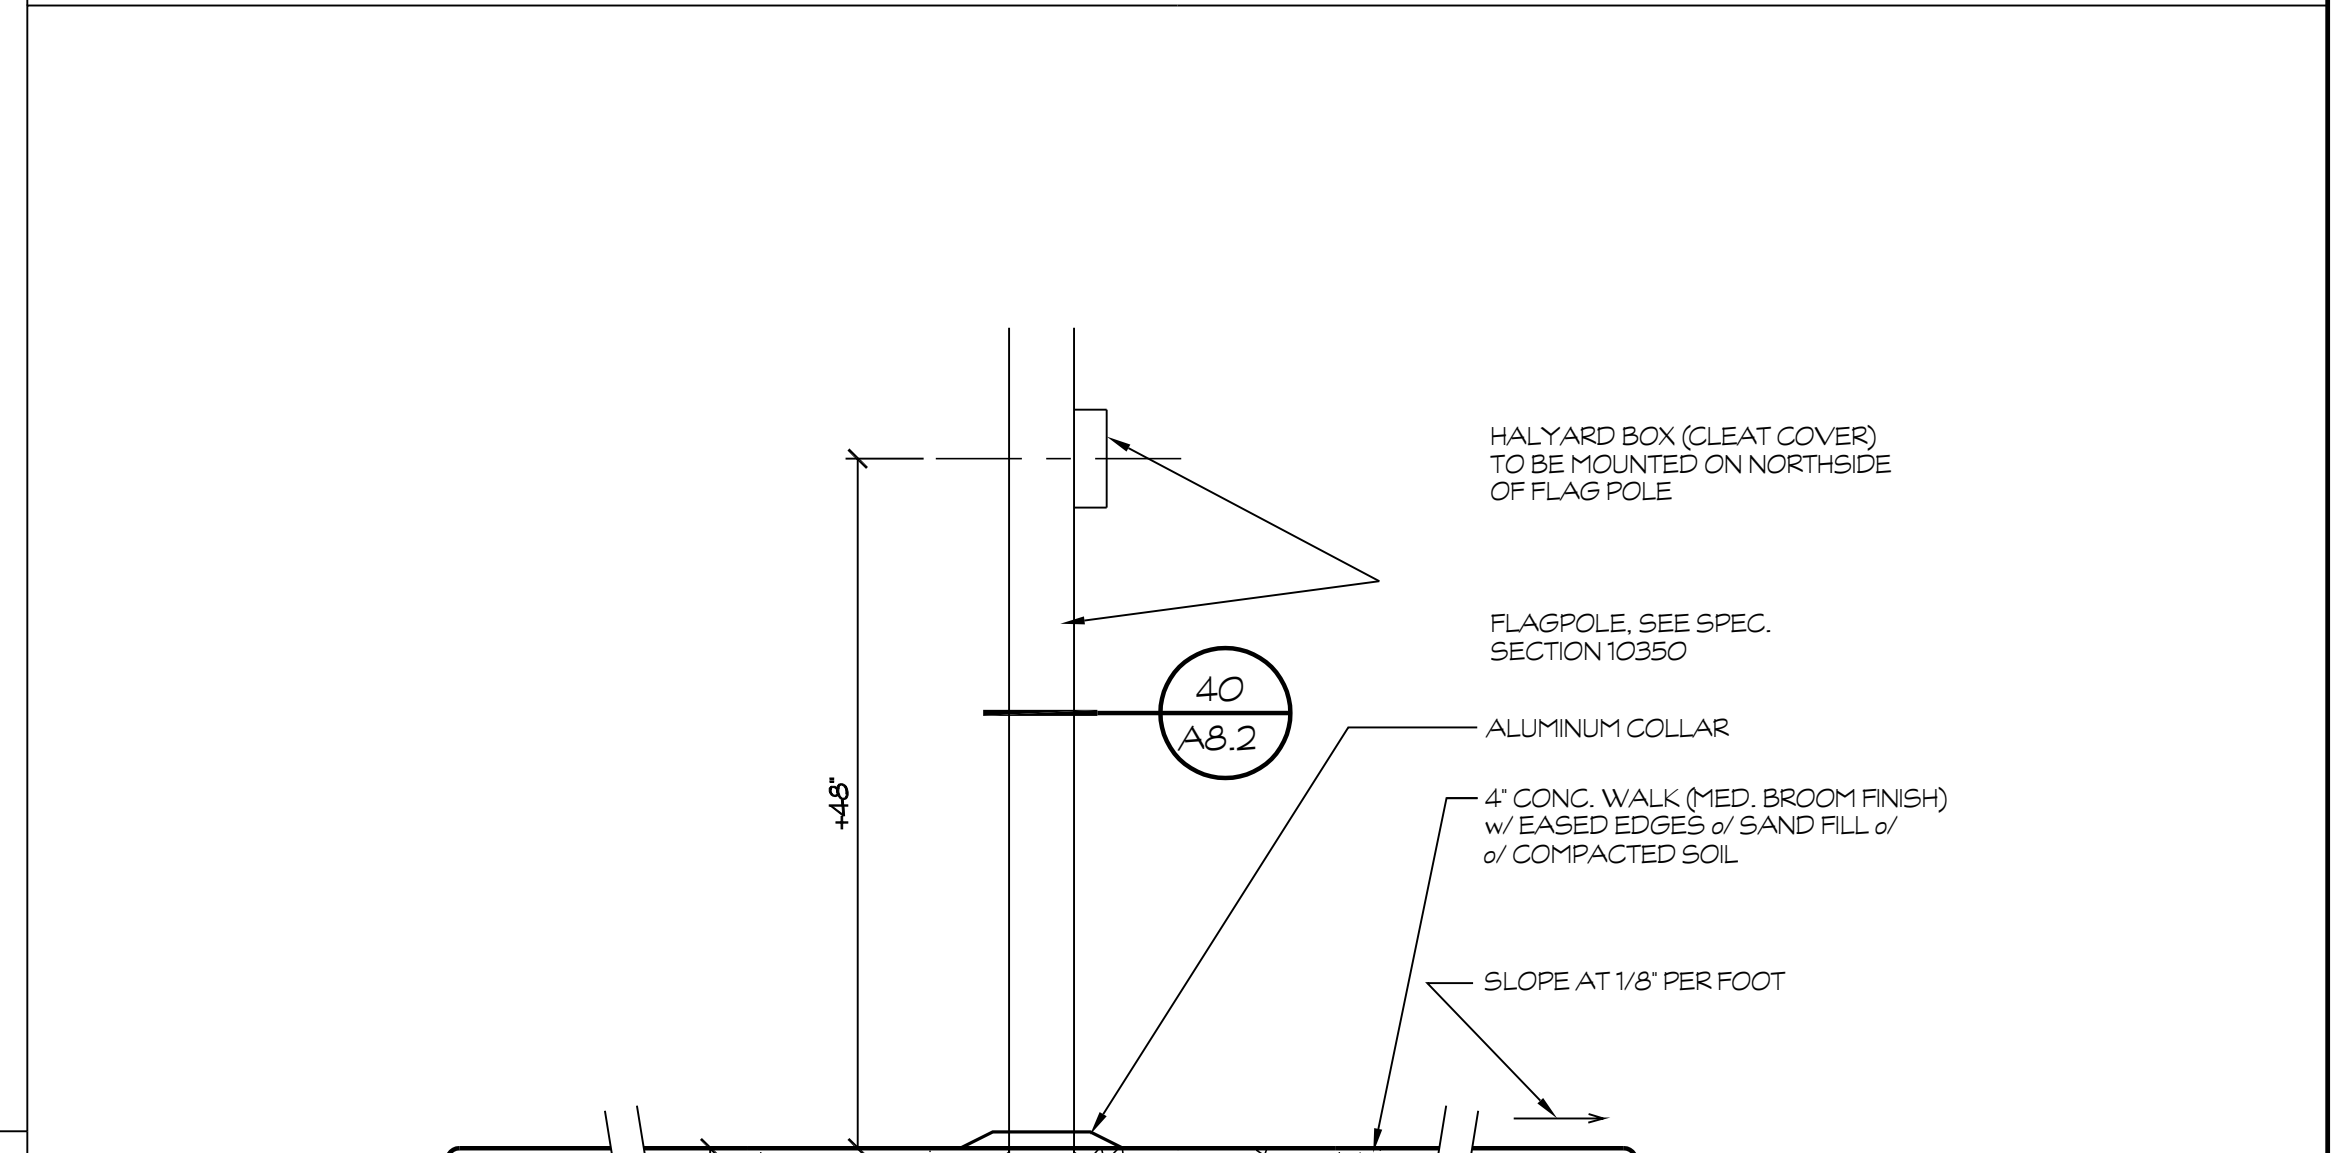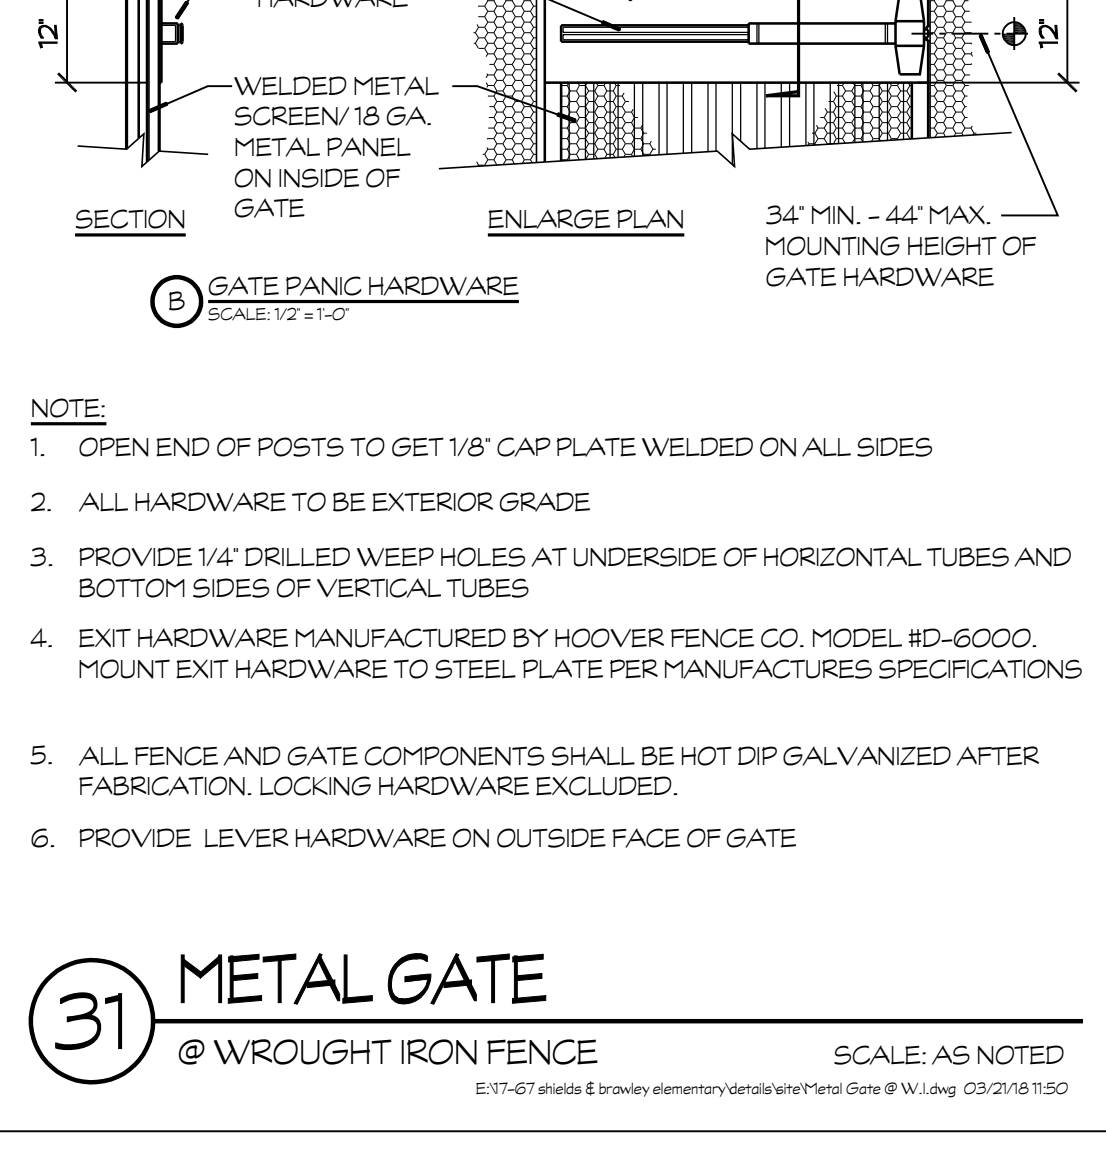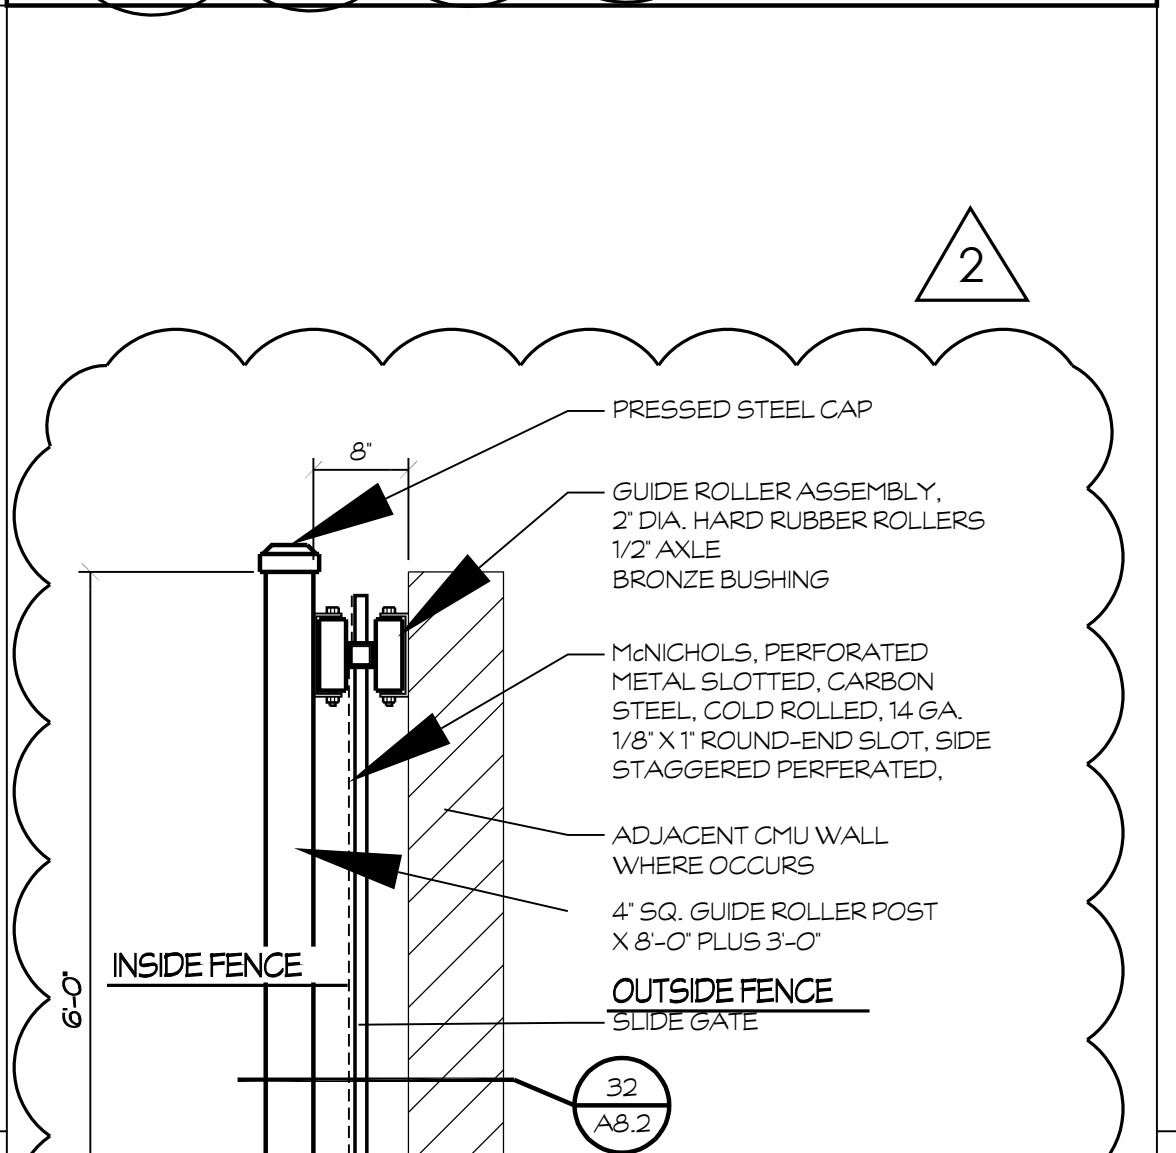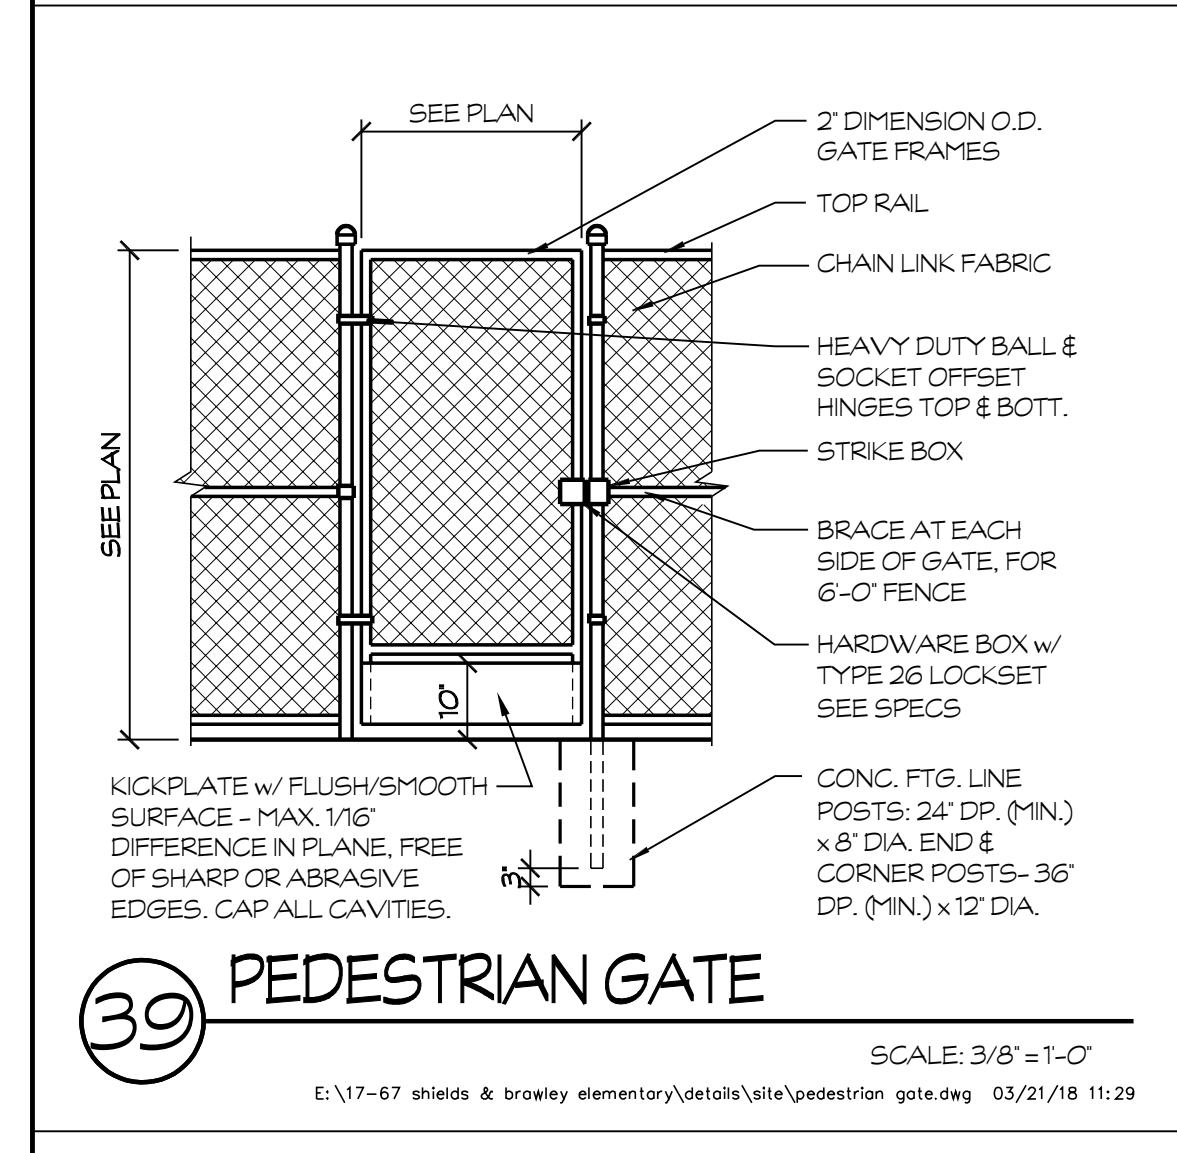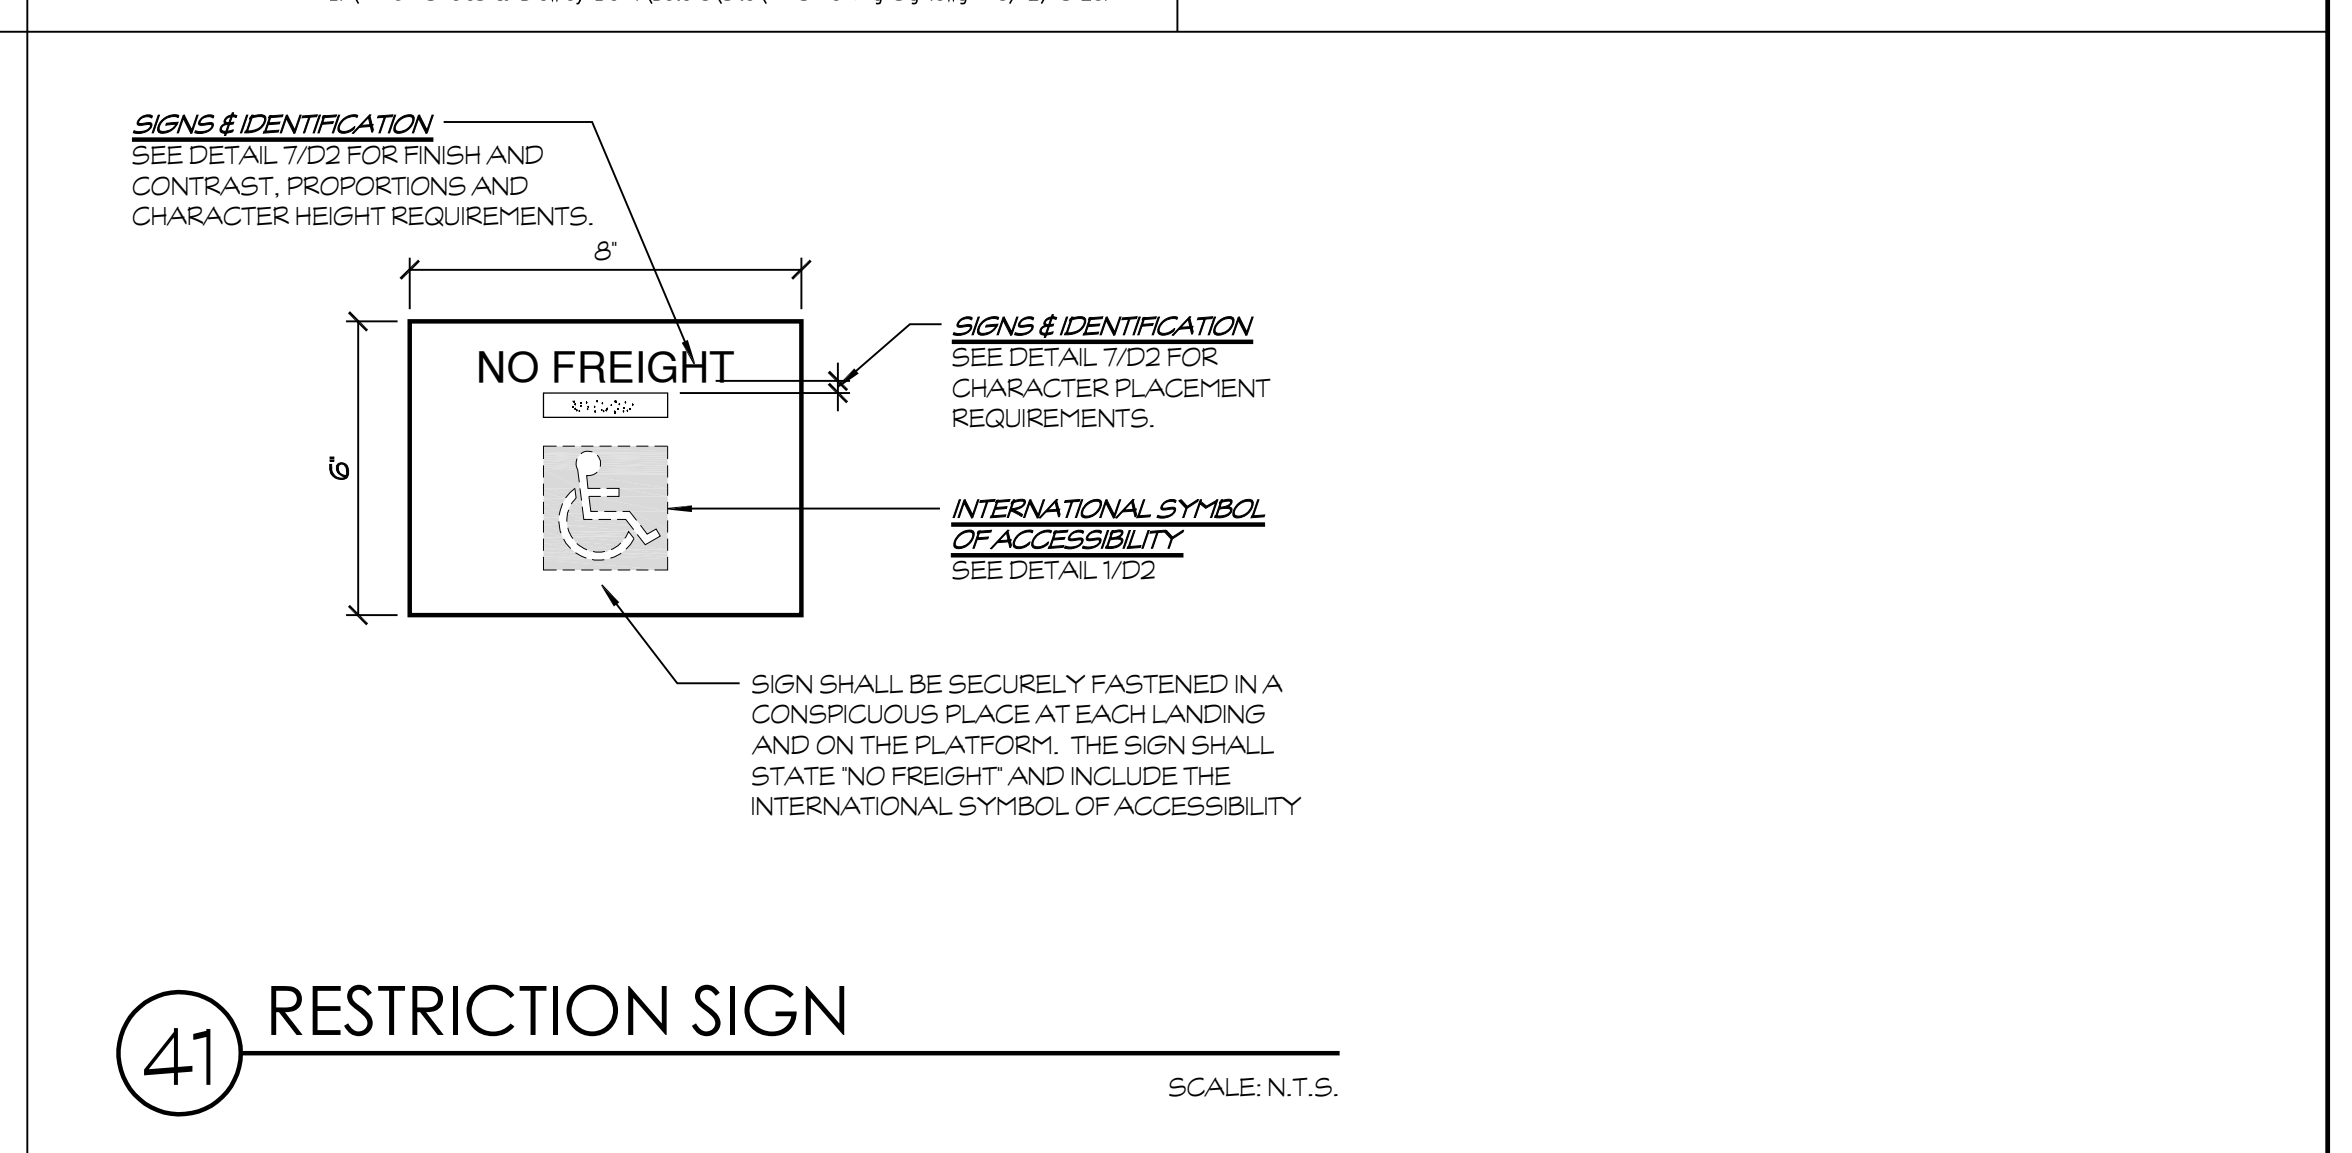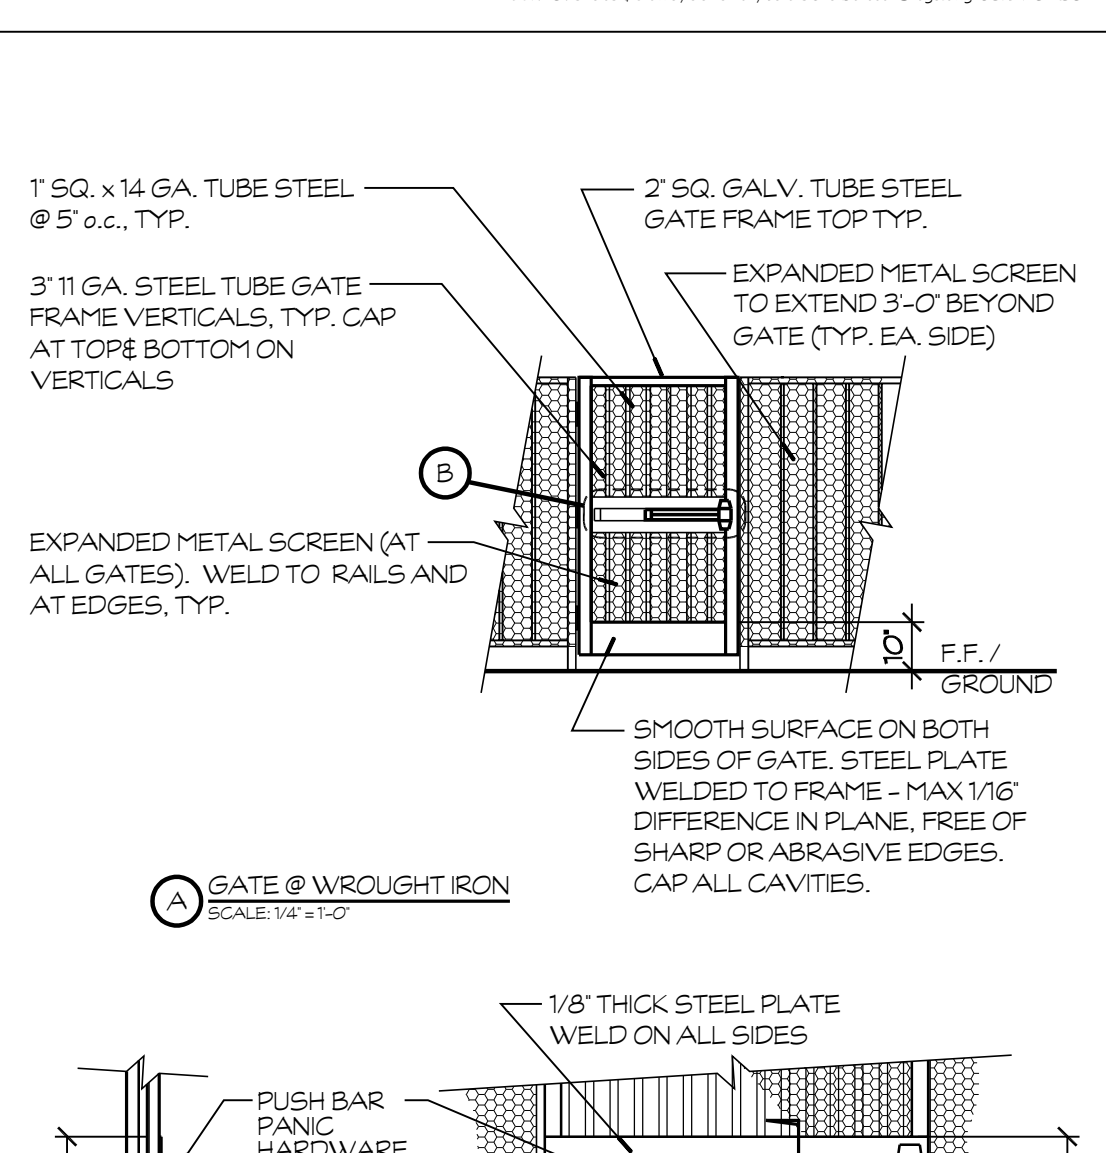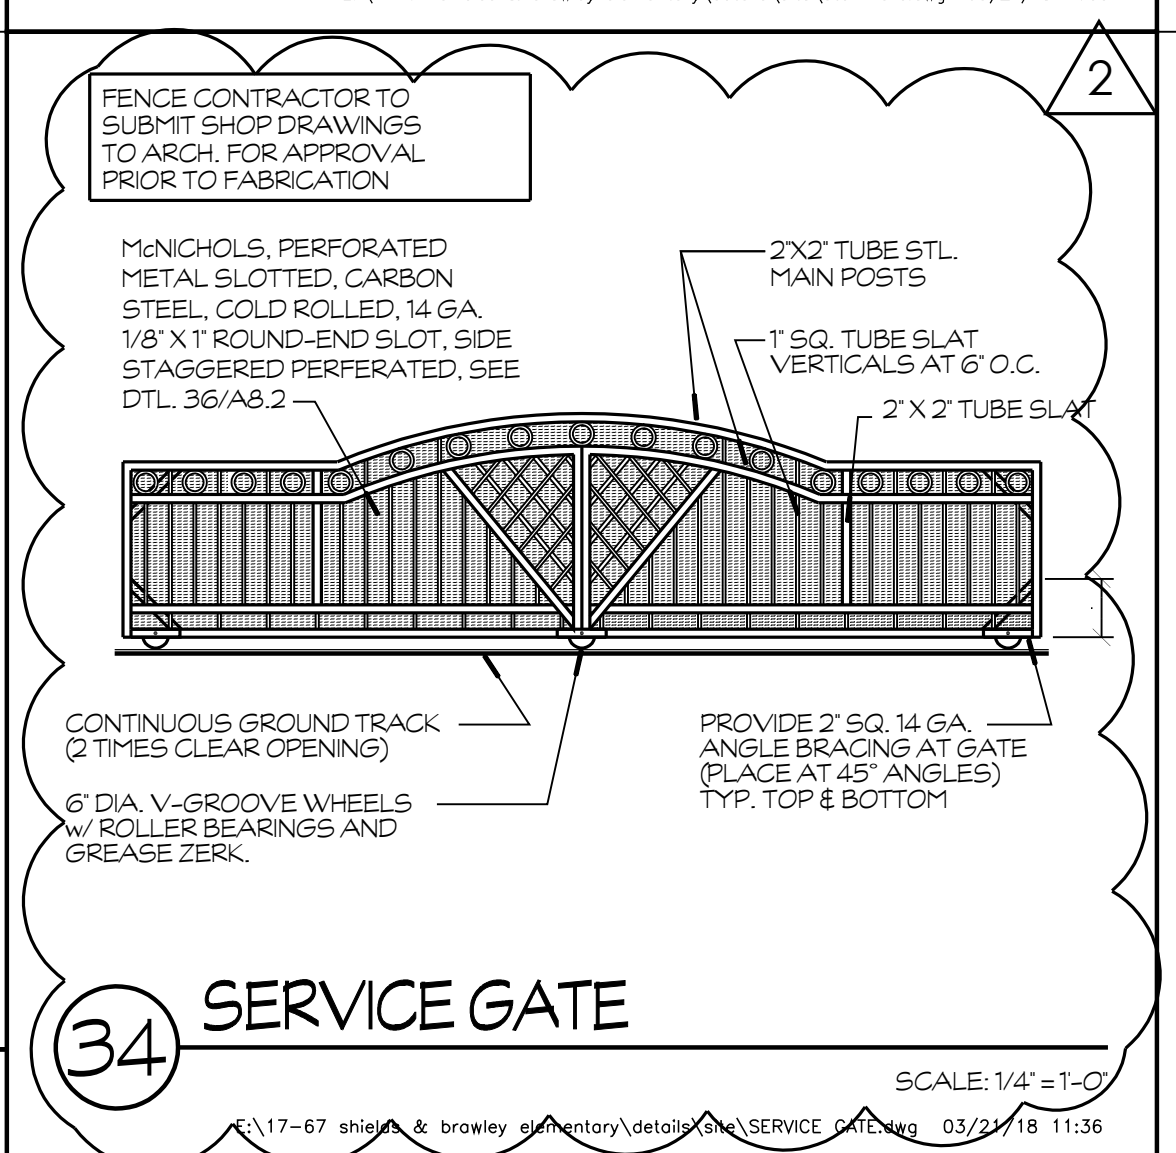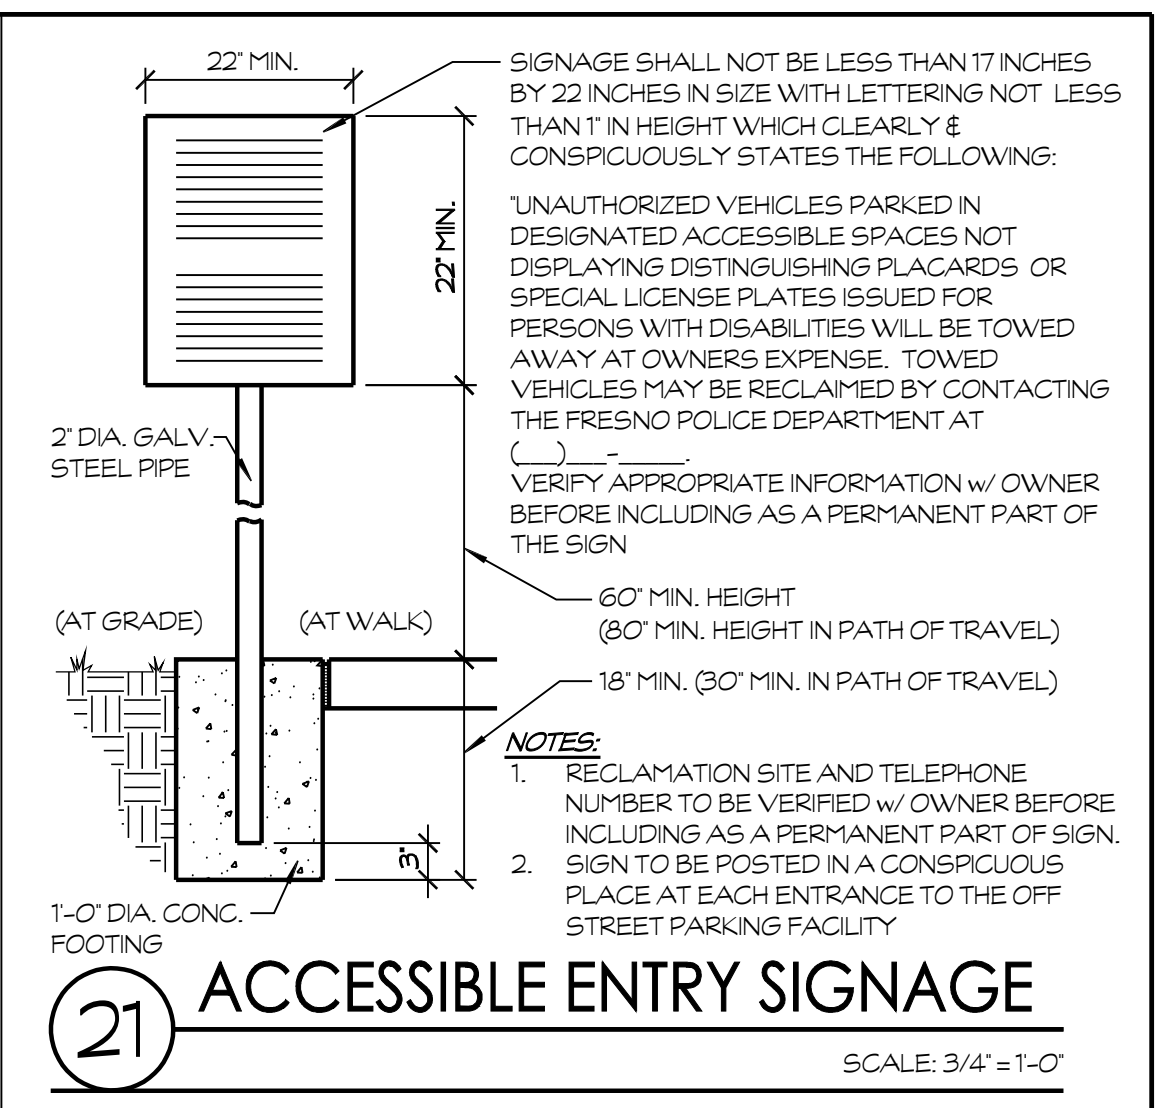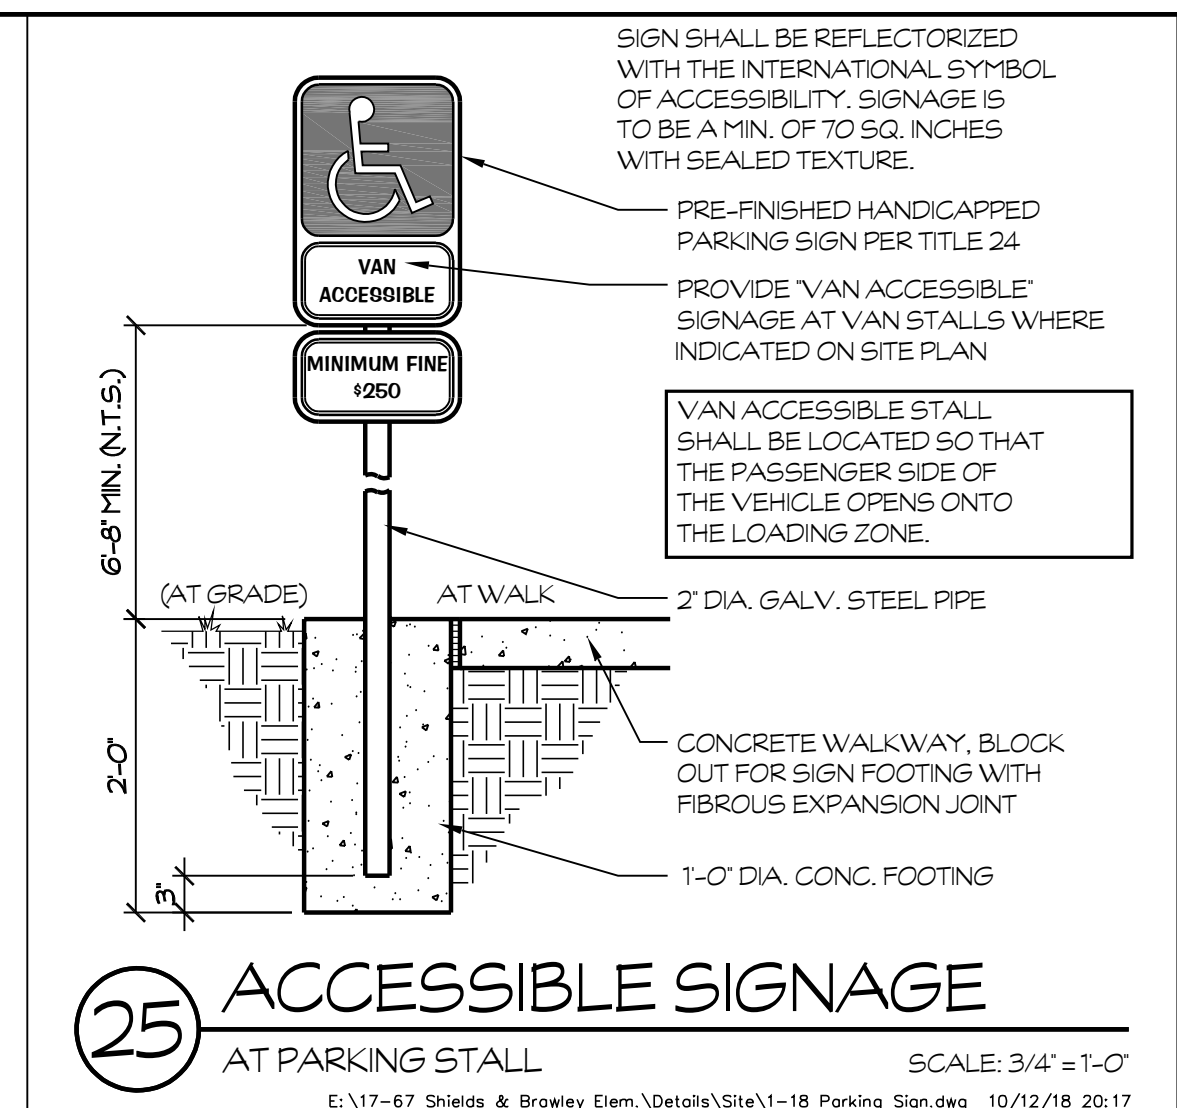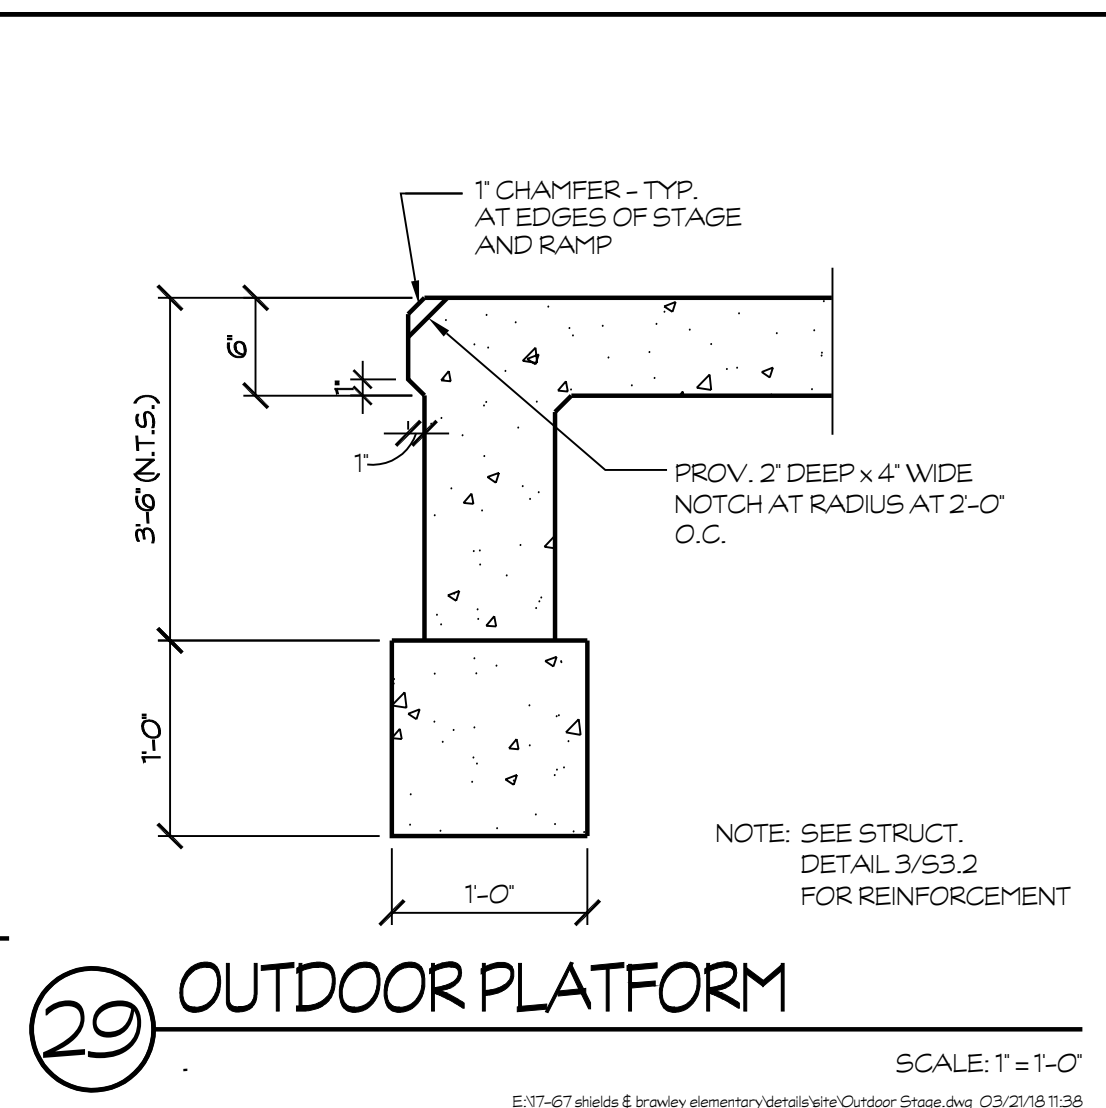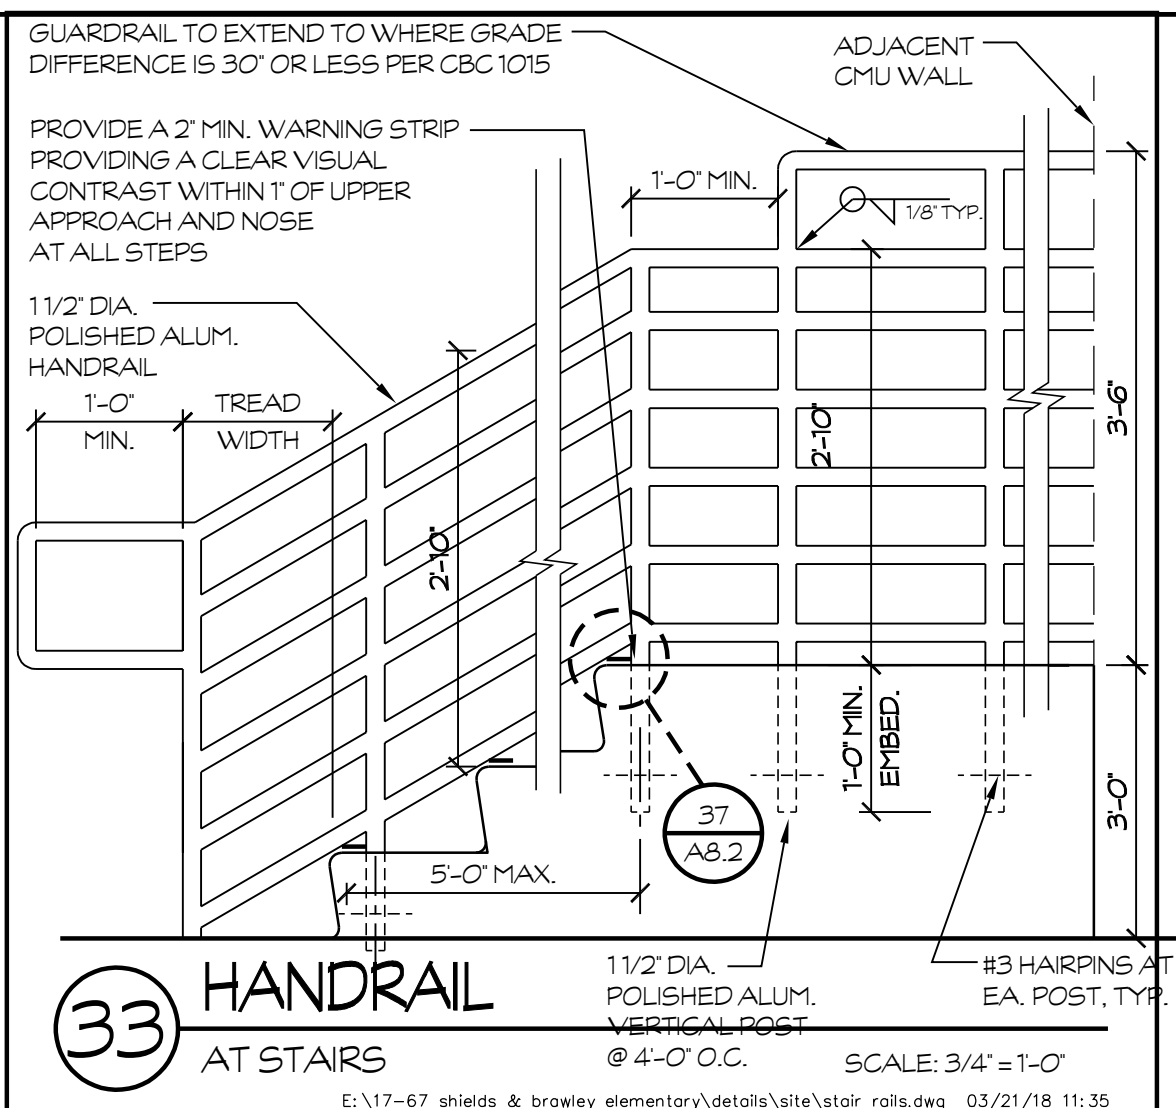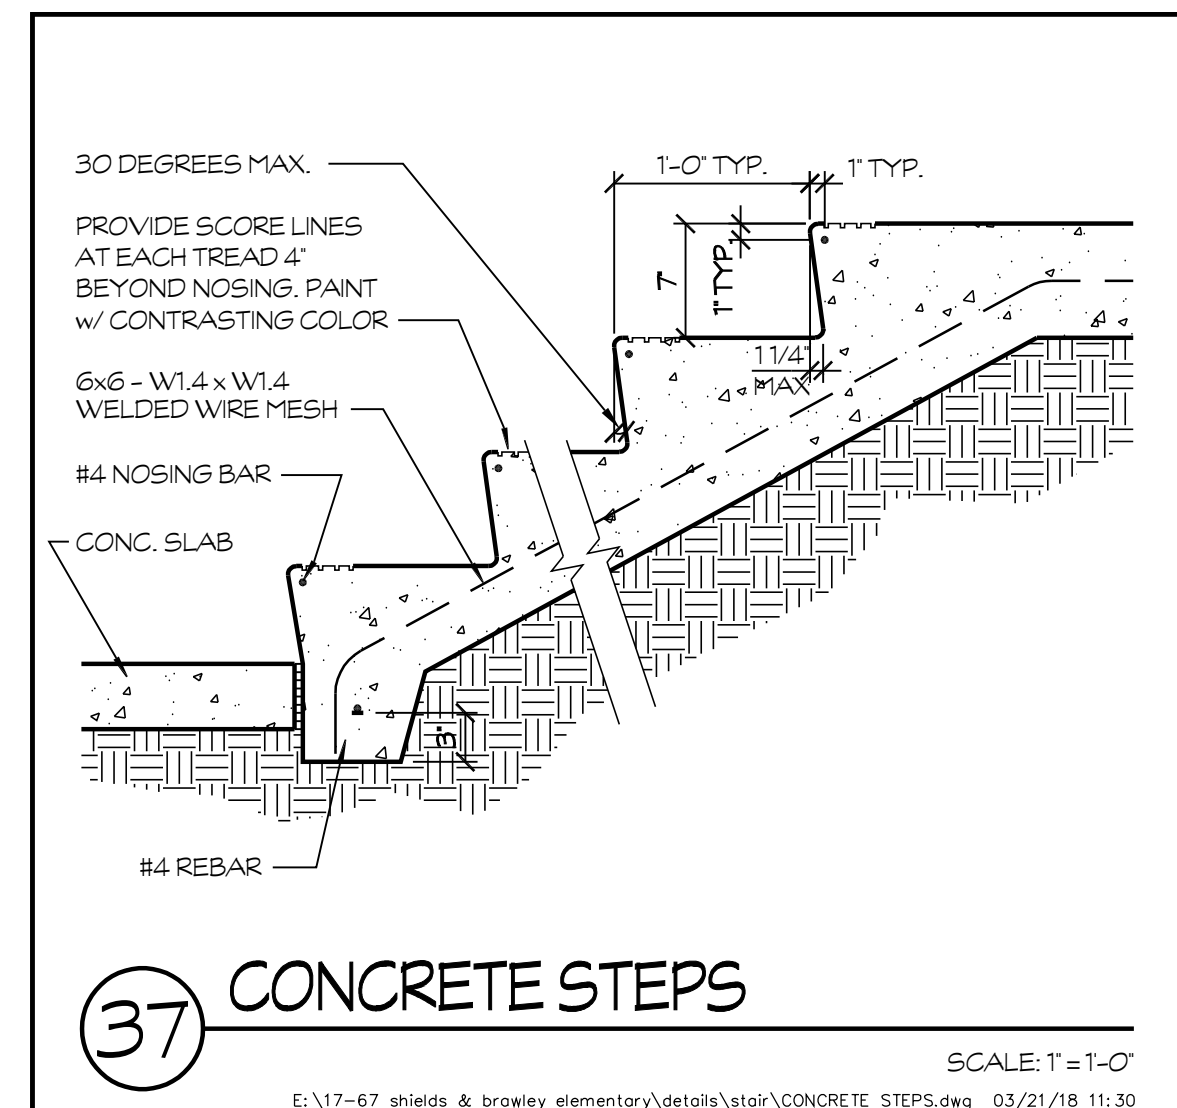

PROJECT: SHIELDS & BRAWLEY ELEMENTARY SCHOOL



AD 2-37a
S&B Elementary
02-116800

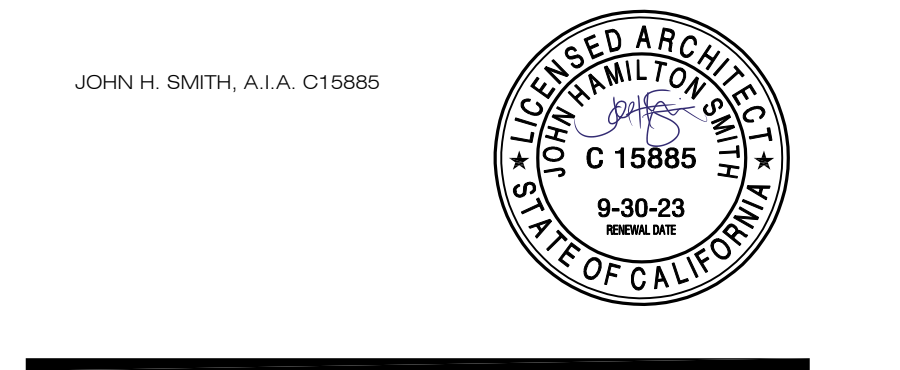


THE FIRM OF SMITH, WANAGA, MILHOUS, ARCHITECTS, INC. EXPRESSLY RESERVES ITS COMMON LAW COPYRIGHT AND OTHER APPLICABLE PROPRIETARY RIGHTS IN THESE PLANS. THESE PLANS ARE NOT TO BE REPRODUCED, CHANGED, OR COPIED IN ANY FORM OR MANNER WHATSOEVER, NOR ARE THEY TO BE ASSIGNED TO A THIRD PARTY WITHOUT FIRST OBTAINING THE WRITTEN PERMISSION AND CONSENT OF THE ARCHITECT. IN THE EVENT OF UNAUTHORIZED REUSE OF THESE PLANS BY A THIRD PARTY, THE THIRD PARTY SHALL HOLD THE ARCHITECT HARMLESS, AND SHALL BEAR THE COST OF THE ARCHITECT'S LEGAL FEES, ASSOCIATED WITH DEFENDING AND ENFORCING THESE RIGHTS.


| PROJECT DEVELOPMENT | |
|---------------------|------------|
| DATE | ISSUED FOR |
| | |
| | |
| | |
| | |

| REVISIONS | | |
|-----------|---------|------------------------|
| No. | DATE | DESCRIPTION |
| Δ | 2.14.23 | DISTRICT MODIFICATIONS |
| Δ | 2.27.23 | DISTRICT MODIFICATIONS |
| | | |
| | | |


| SHEET DESCRIPTION | |
|-----------------------------------|--------------------------|
| DETAILS | |
| PROJECT COORDINATOR JOHN SMITH | SHEET NO. A8.2 |
| PROJECT NO. 17-67 | DATE 1.27.23 |
| SCALE AS NOTED | |

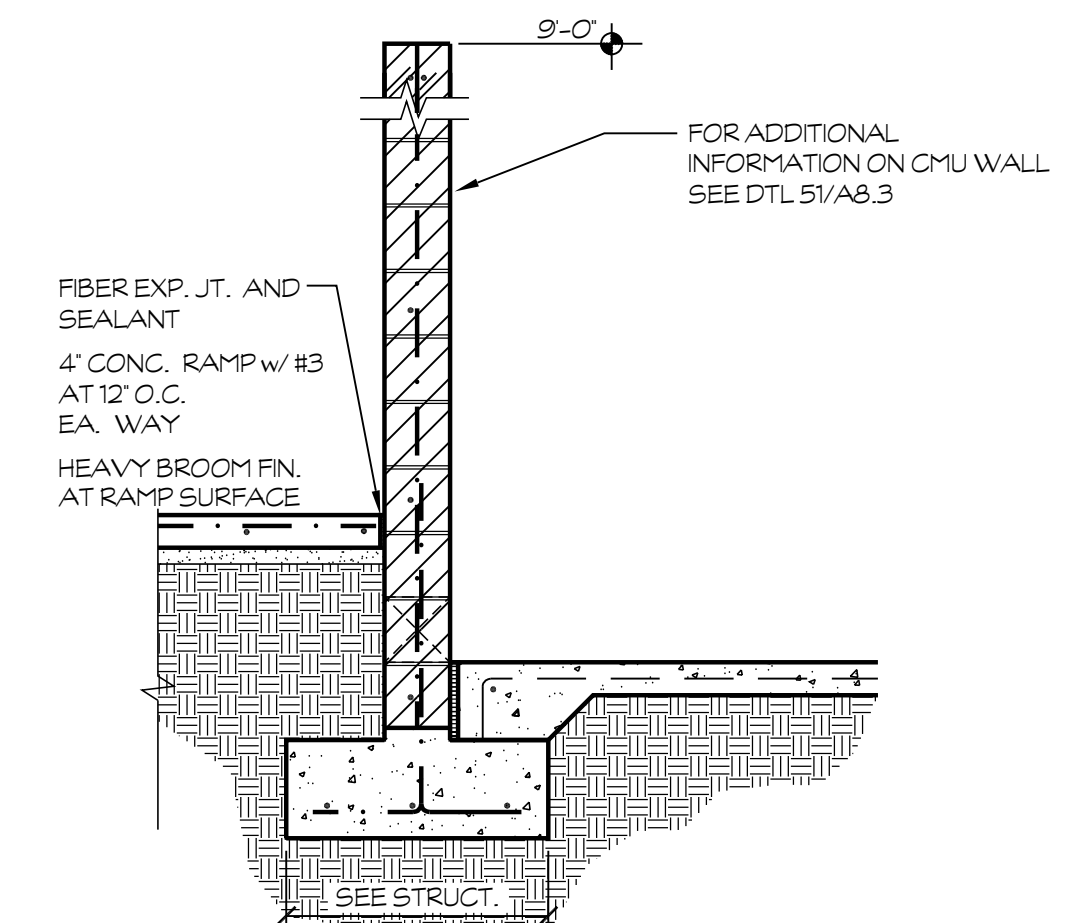


57 CMU BLOCK WALL
@ MPR RAMP
SCALE: 1/2" = 1'-0"
E:\17-67 shields & brawley elementary\details\site\1-04-1 CMU Wall.dwg 03/21/18 13:29

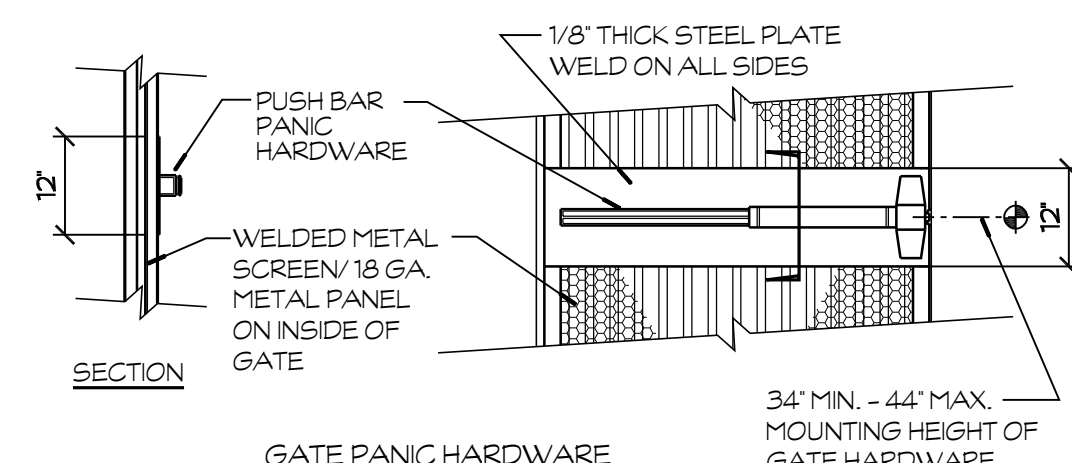


53 METAL GATE
SCALE: AS NOTED
E:\17-67 shields & brawley elementary\details\site\1-01-1 GATE.dwg 03/21/18 13:30

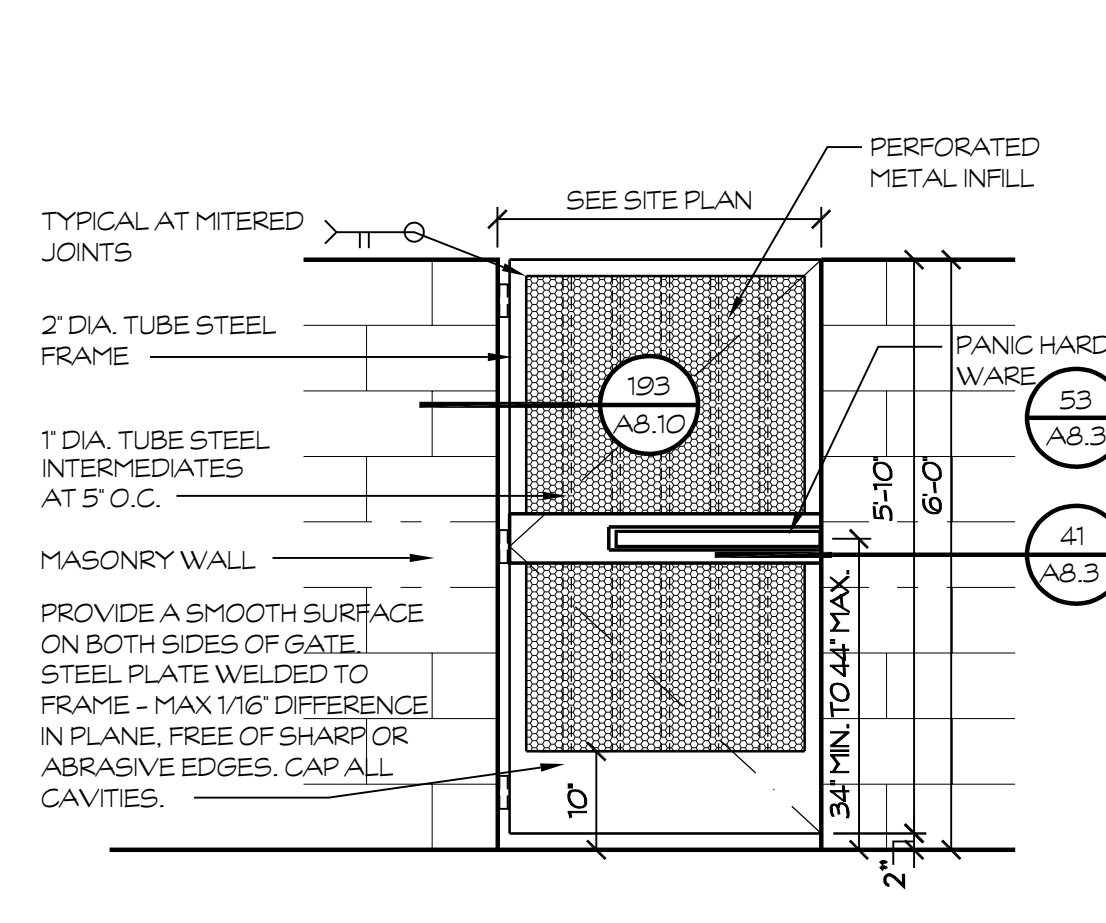


49 STEEL GATE
SCALE: 1/2" = 1'-0"
E:\17-67 shields & brawley elementary\details\site\1-09-1 GATE ELEV.dwg 03/21/18 13:31

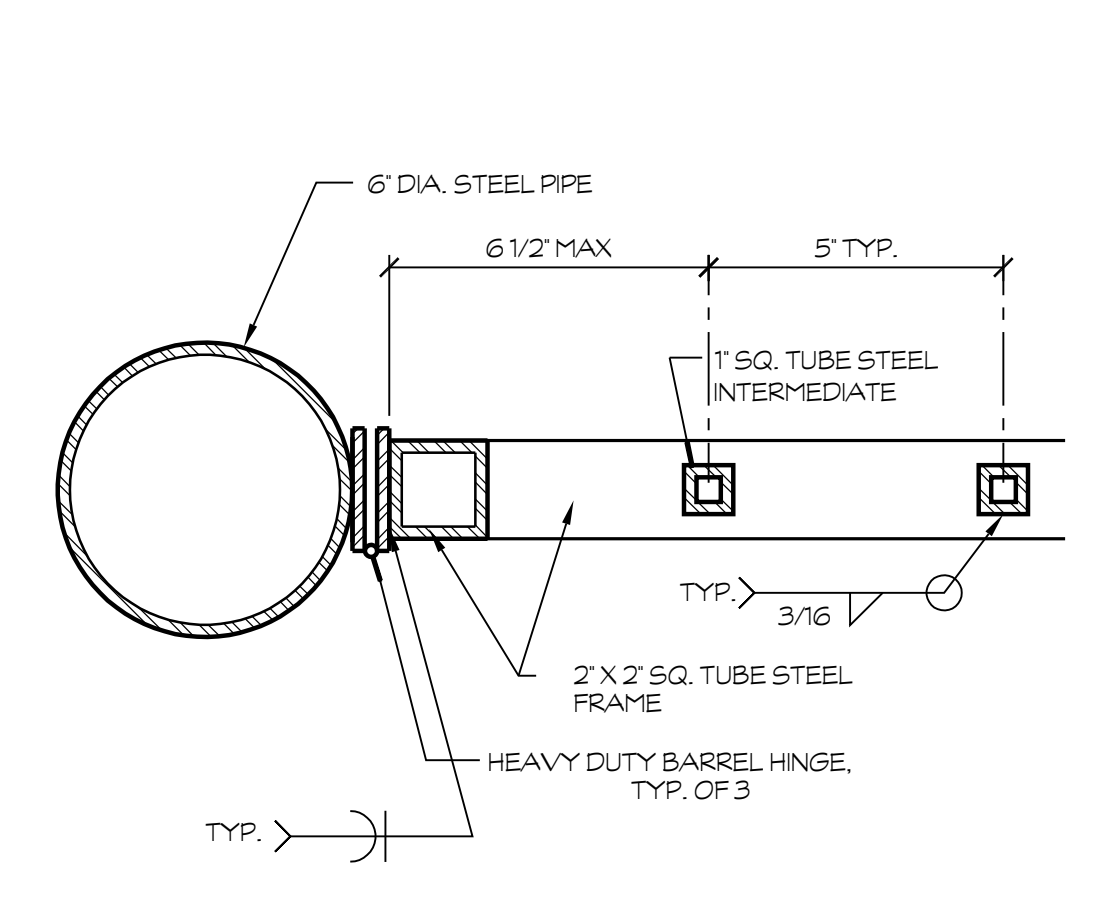


45 STEEL GATE
SCALE: 3" = 1'-0"
E:\17-67 shields & brawley elementary\details\site\1-10-1 GATE HNSE.dwg 03/21/18 13:38

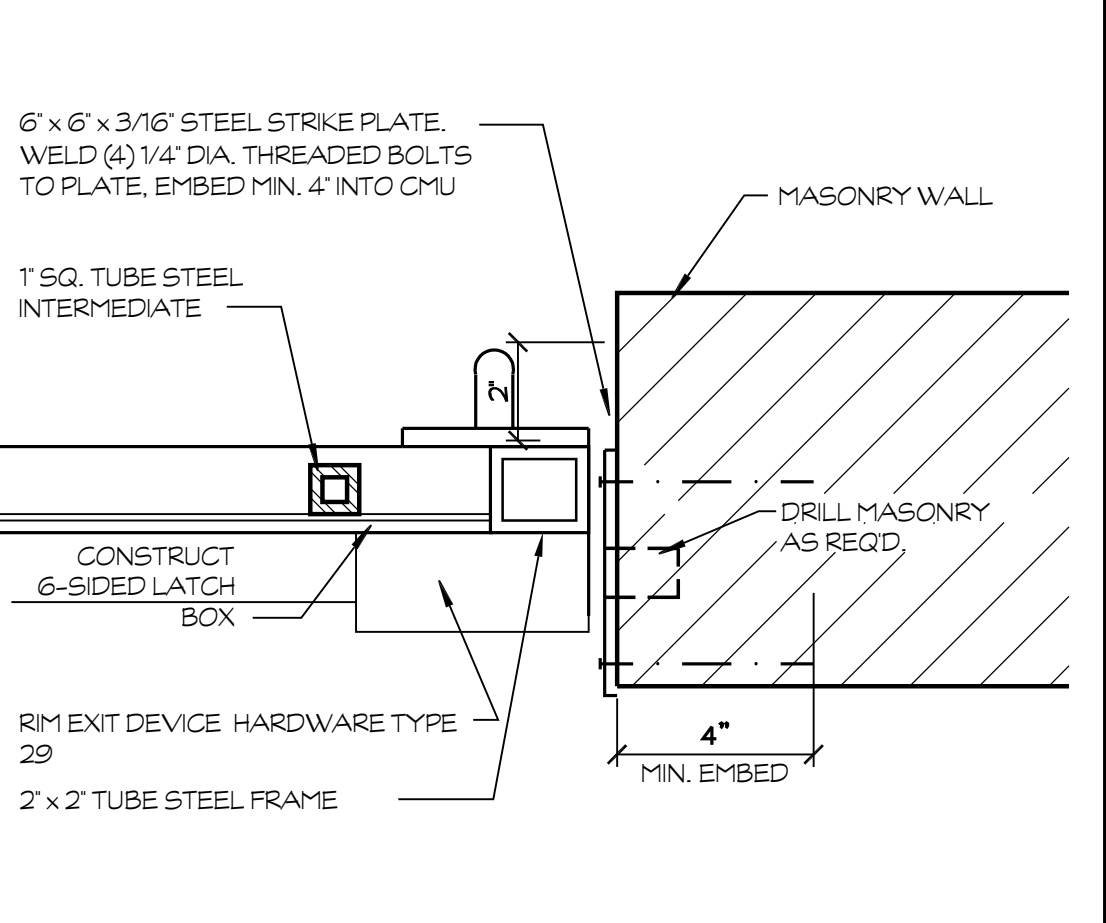


41 GATE LATCH
DOUBLE GATE SIMILAR
SCALE: 3" = 1'-0"
E:\17-67 shields & brawley elementary\details\site\1-71-1 GATE LATCH2.dwg 03/21/18 13:40

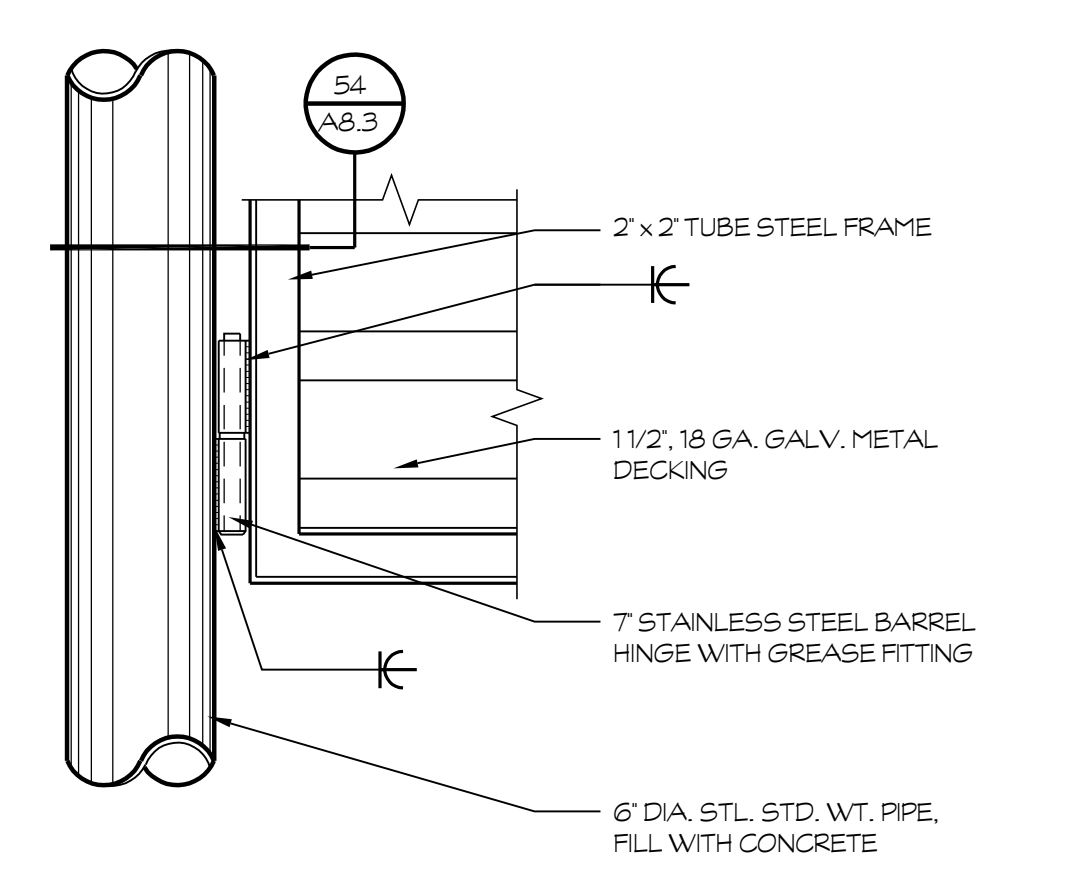


58 HINGE
SCALE: 1 1/2" = 1'-0"
E:\17-67 shields & brawley elementary\details\site\1-61.dwg 03/21/18 13:28

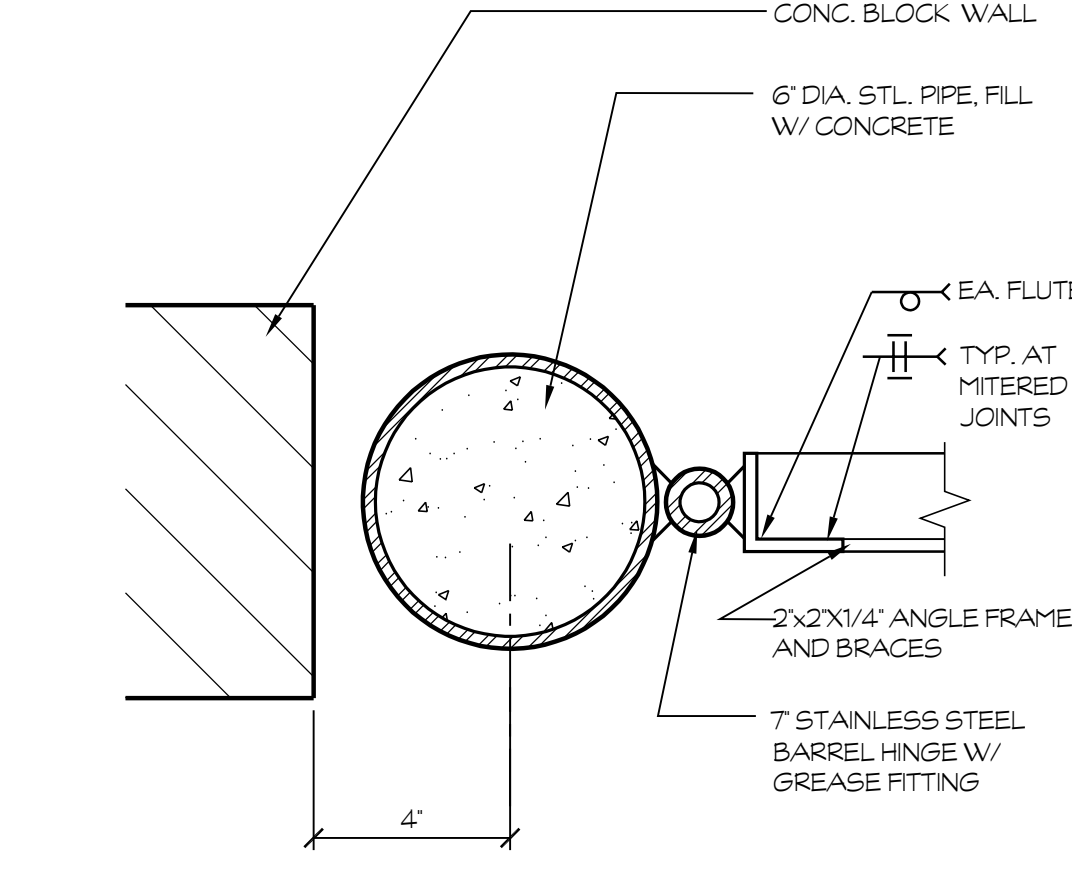


54 JAMB
SCALE: 3" = 1'-0"
E:\17-67 shields & brawley elementary\details\site\1-60.dwg 03/21/18 13:28

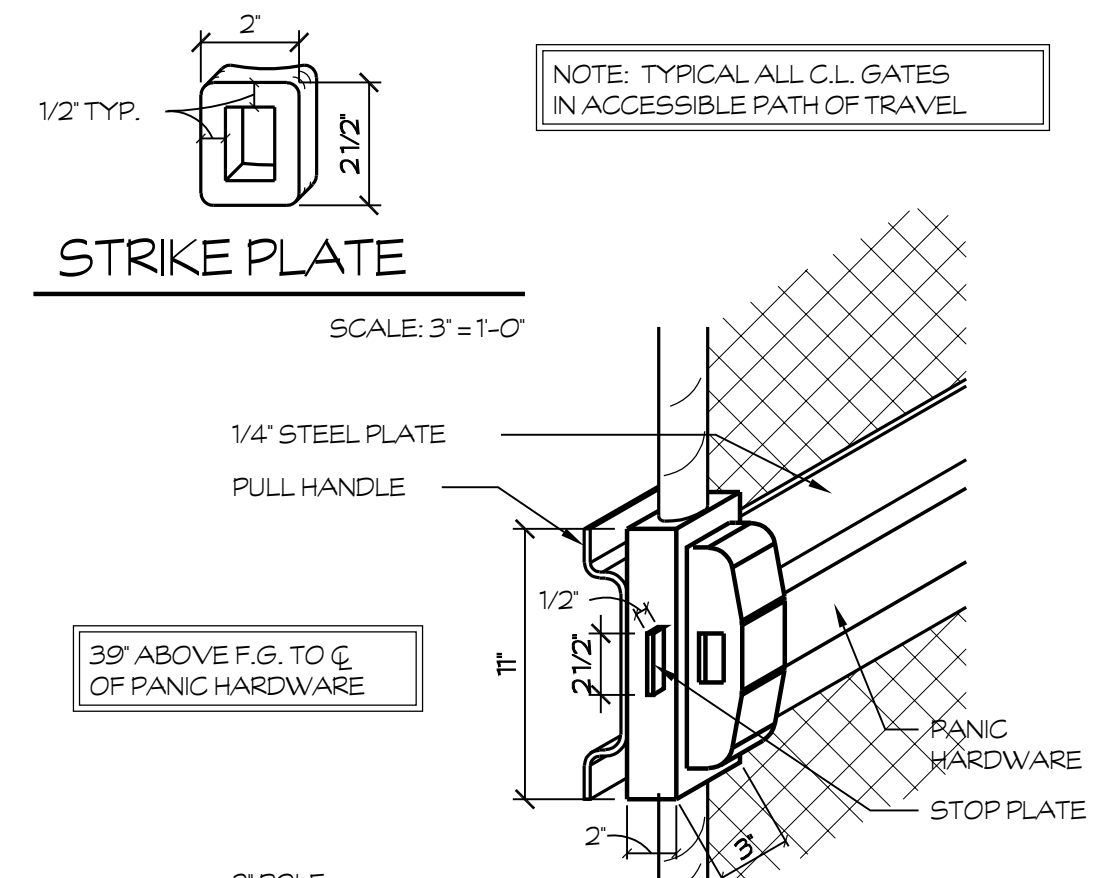


50 PANIC HARDWARE
@ C.L. GATE
SCALE: 1 1/2" = 1'-0"
E:\17-67 shields & brawley elementary\details\site\C.L. Gate - Panic HW.dwg 03/21/18 13:30

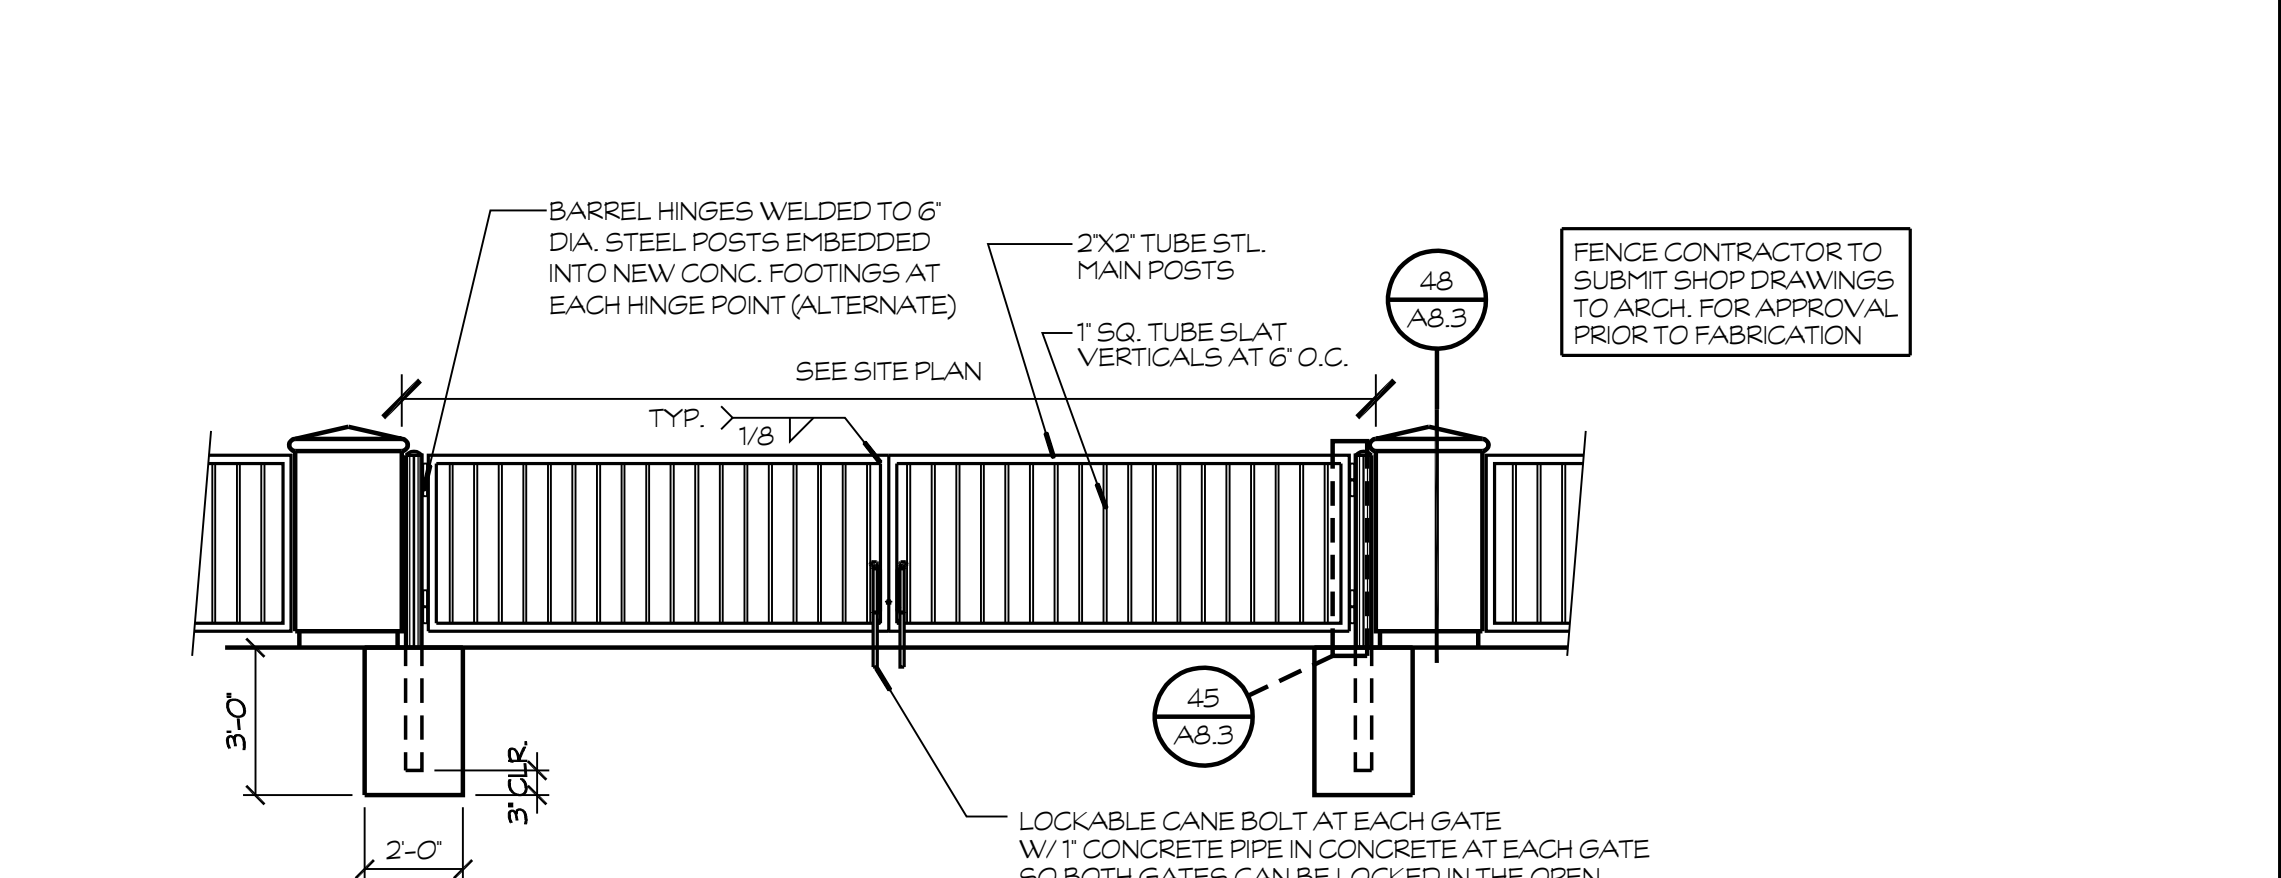


46 ARCHITECTURAL FENCE
ELEVATION
SCALE: 1/4" = 1'-0"
E:\17-67 shields & brawley elementary\details\site\ENTRANCE GATE2.dwg 03/21/18 13:36

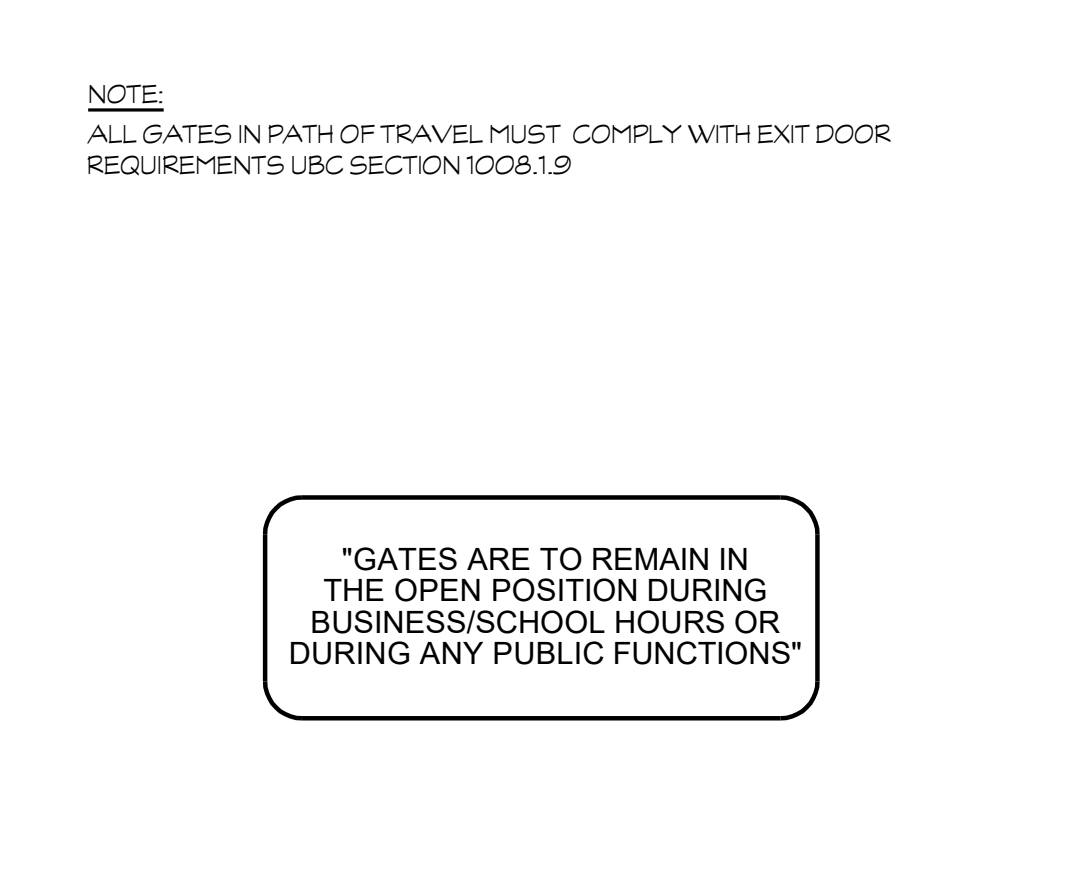


59 GATE SIGN
N.T.S.
E:\17-67 shields & brawley elementary\details\site\gate sign.dwg 03/21/18 13:39

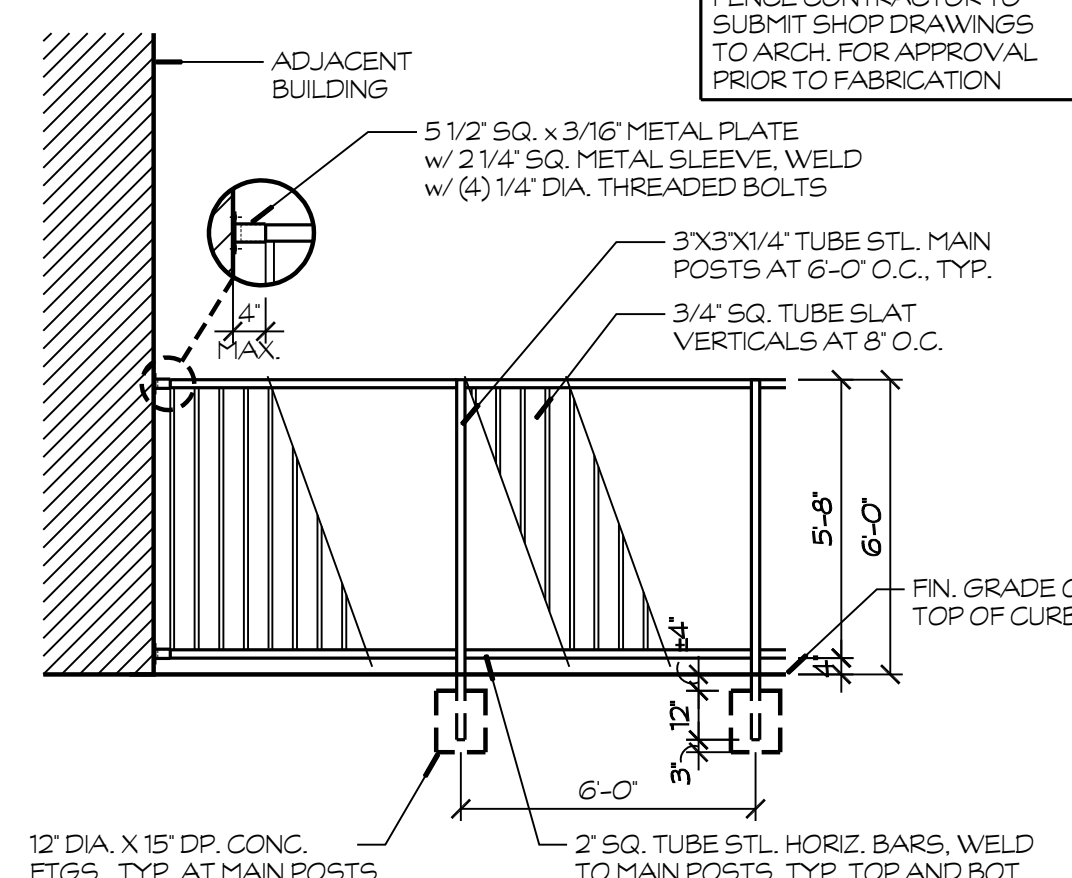


55 ARCHITECTURAL FENCE
ELEVATION / SECTION
SCALE: 1/4" = 1'-0"
E:\17-67 shields & brawley elementary\details\site\01 - Fence - Arch. - Elev. & Sections - 01.dwg 03/21/18 13:27

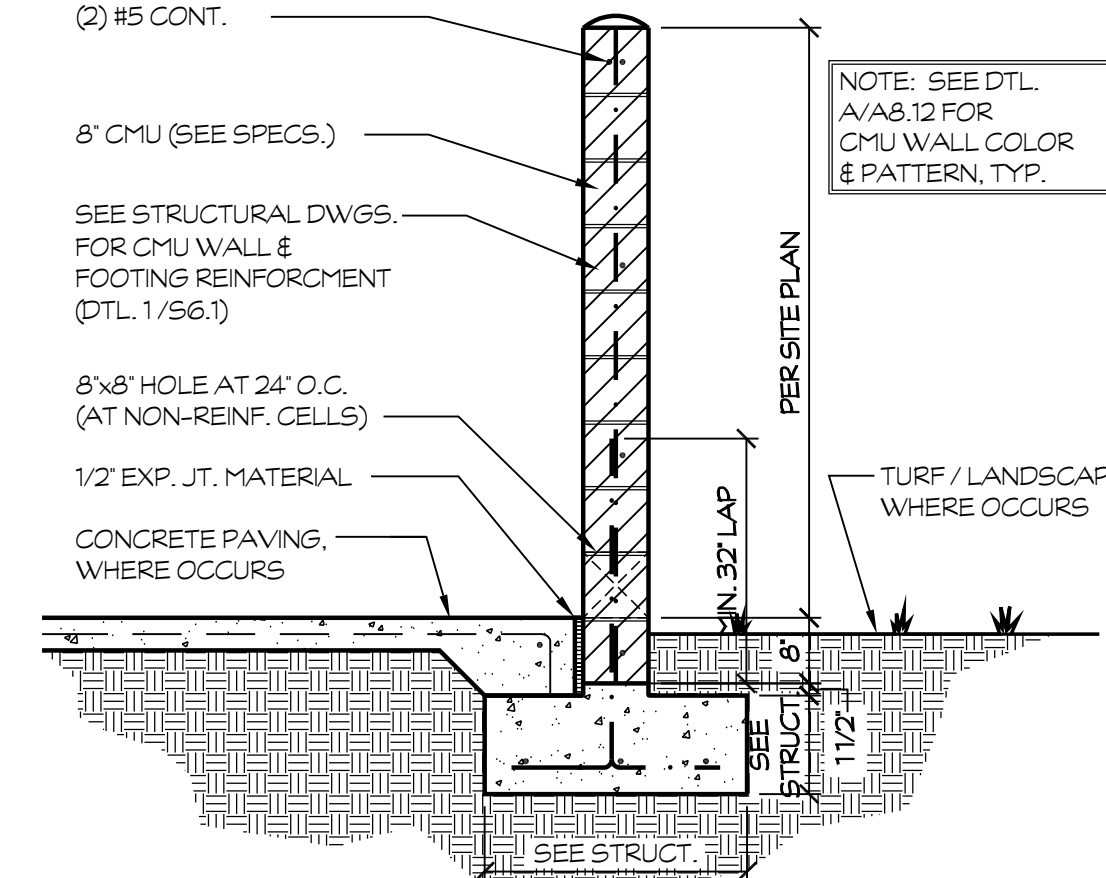


51 CMU BLOCK WALL
SEE SITE PLAN
SCALE: 1/2" = 1'-0"
E:\17-67 shields & brawley elementary\details\site\1-04-1 CMU Wall.dwg 03/21/18 13:29

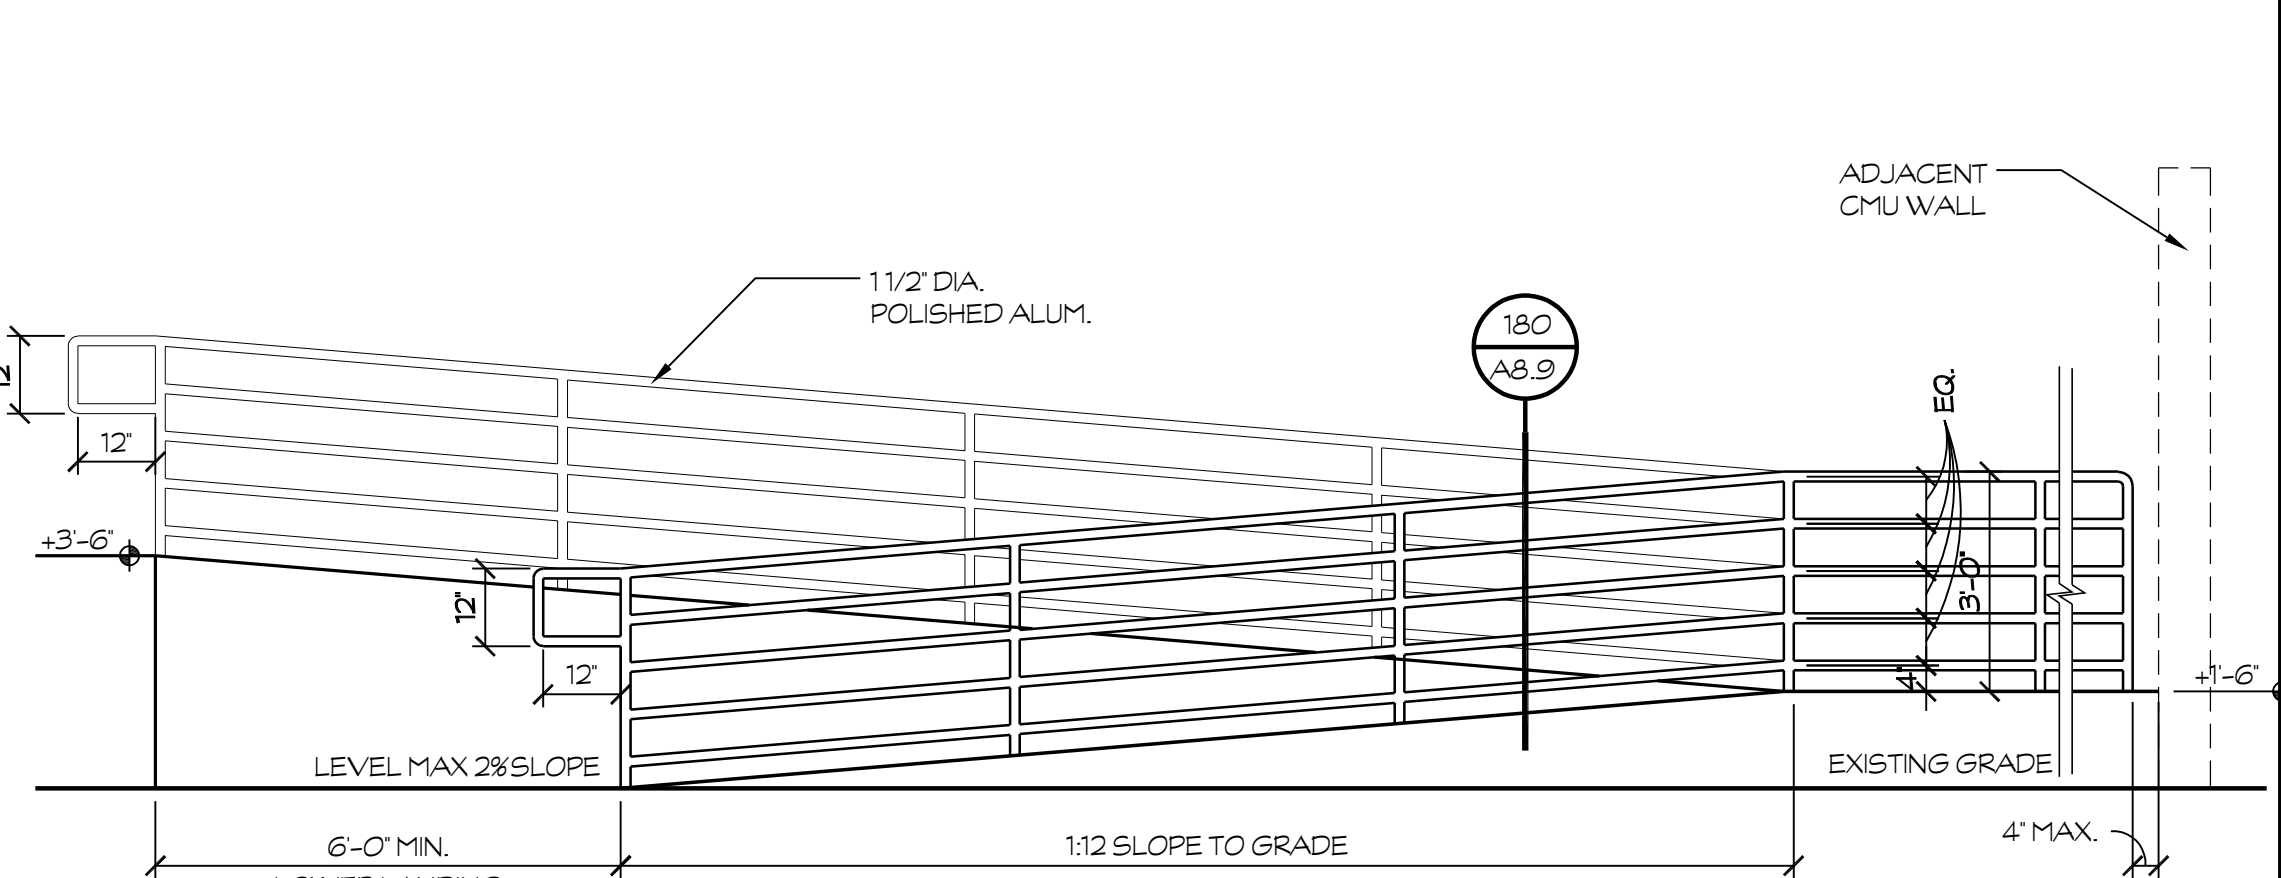


47 ACCESSIBLE RAMP
HANDRAILS REQUIRED ON BOTH SIDES OF RAMP
SCALE: N.T.S.
E:\17-67 shields & brawley elementary\details\site\14 Acc. Ramp 02.dwg 03/21/18 13:44

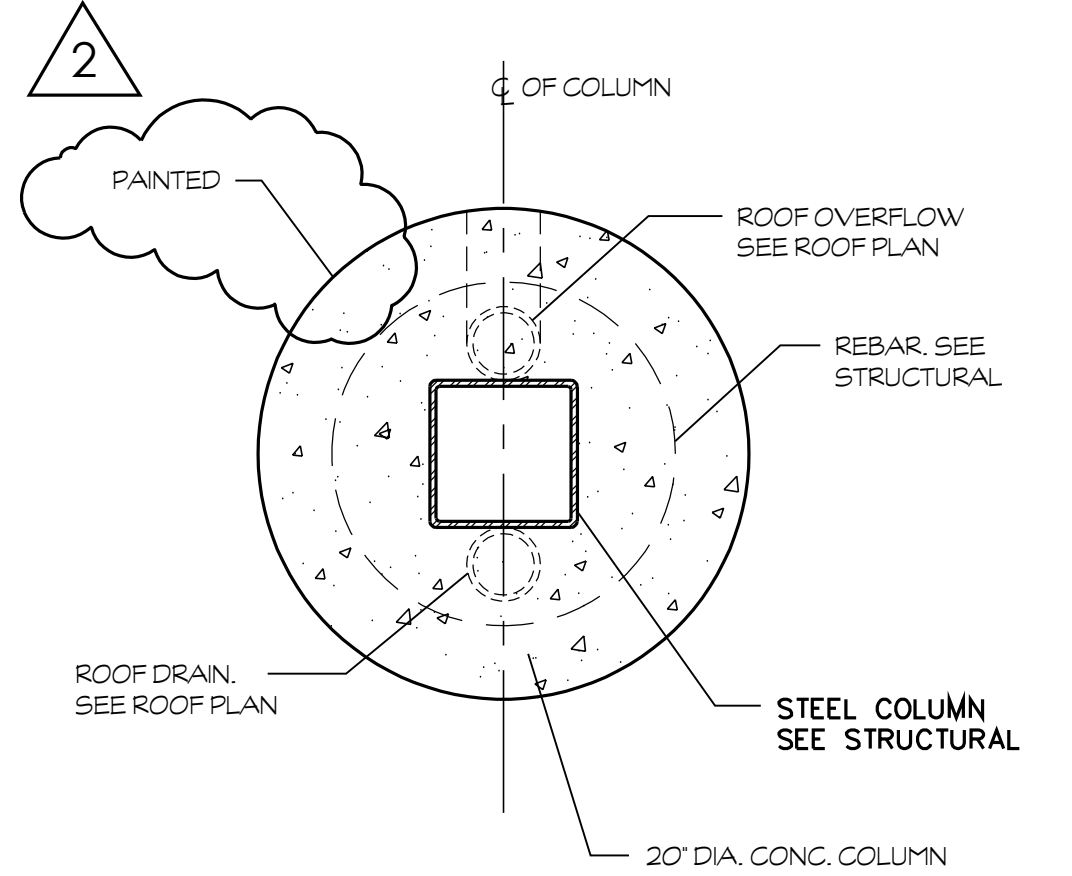


60 COLUMN
SCALE: N.T.S.
E:\17-67 shields & brawley elementary\details\site\column.dwg 03/21/18 13:29

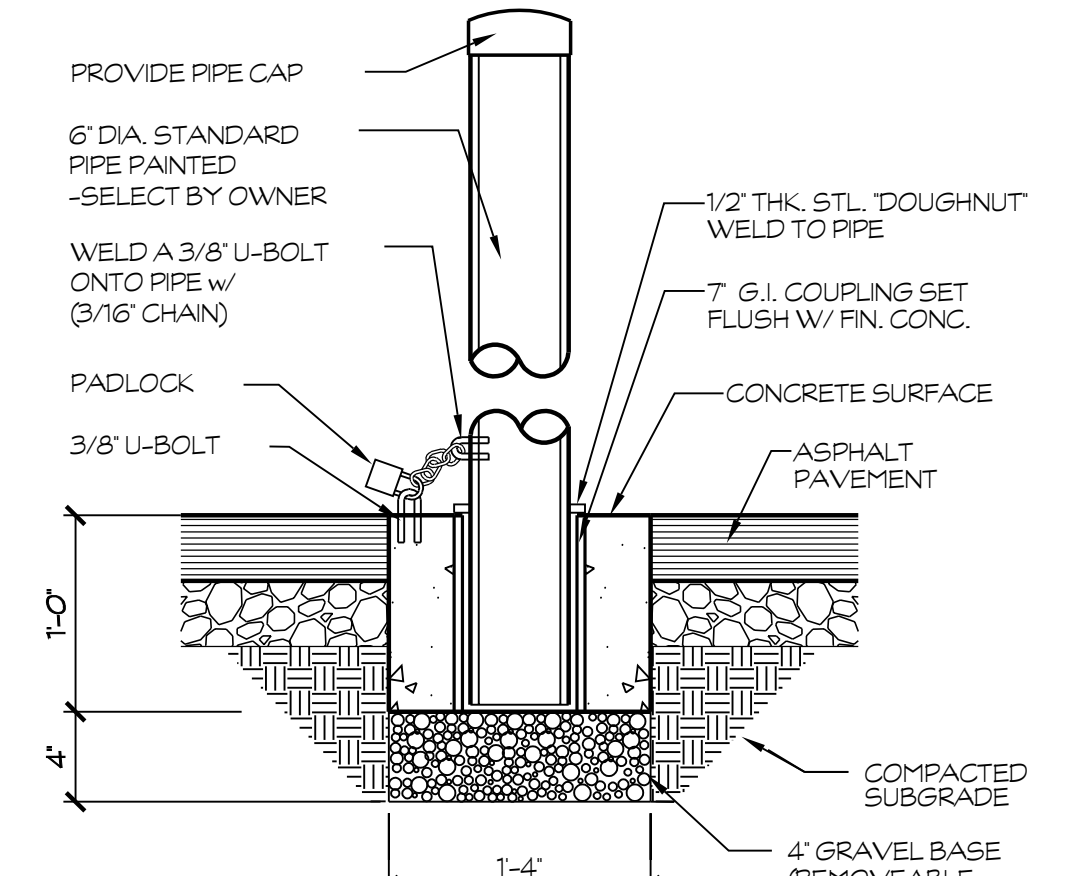


56 BOLLARD CAP (REMOVEABLE)
SCALE: 1" = 1'-0"
E:\17-67 shields & brawley elementary\details\site\1-34-1 Bollard.dwg 03/21/18 13:26

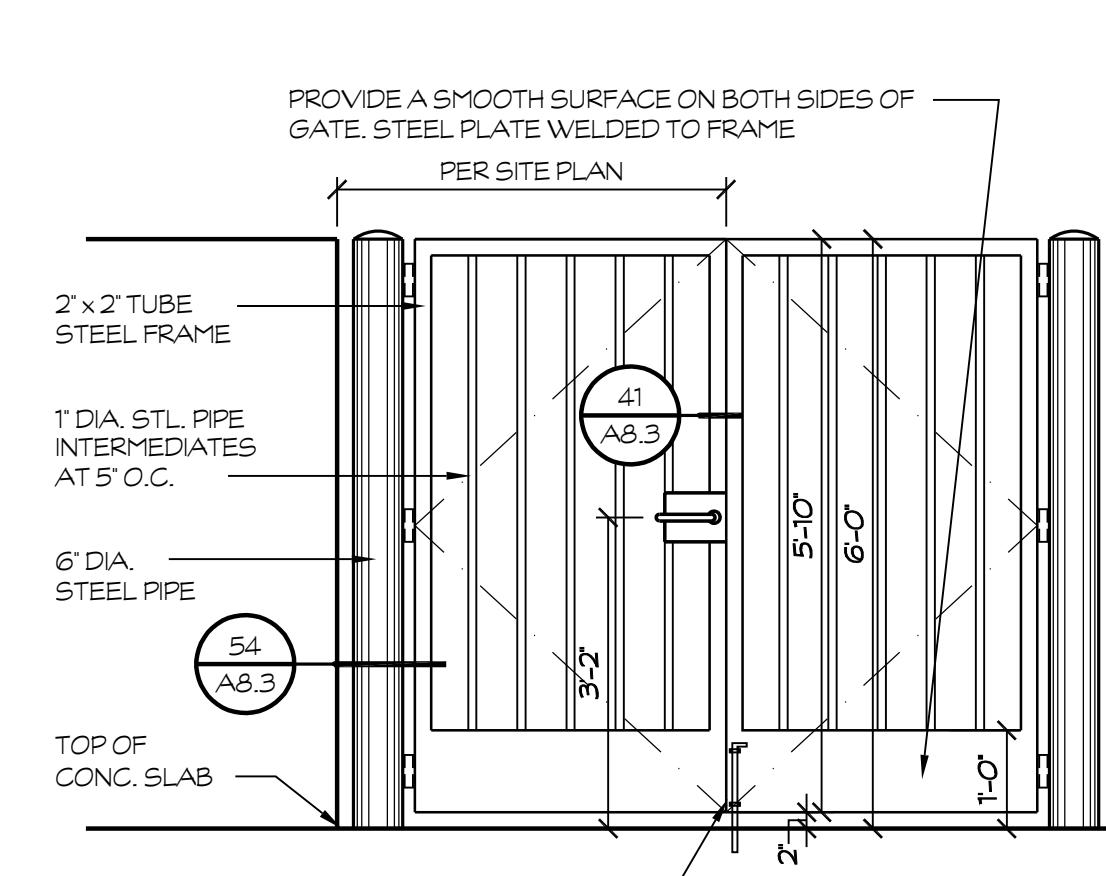

52 DBL. STEEL GATES
SEE SPECS. TYPE 26 FOR LOCKSET
SCALE: 1/2" = 1'-0"
E:\17-67 shields & brawley elementary\details\site\1-72 DBL GATES.dwg 03/21/18 13:29

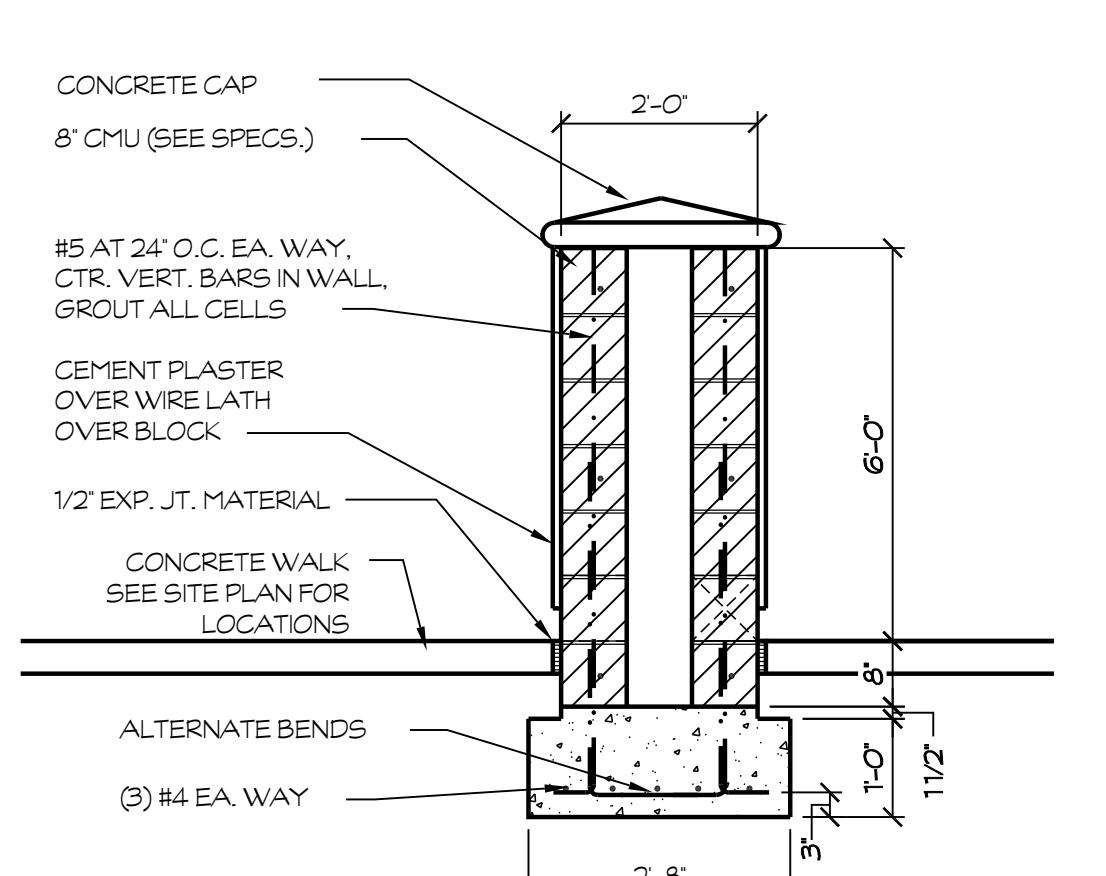

48 PILASTER
SEE SITE PLAN
SCALE: 1/2" = 1'-0"
E:\17-67 shields & brawley elementary\details\site\Entrance Pilaster2.dwg 03/21/18 13:32

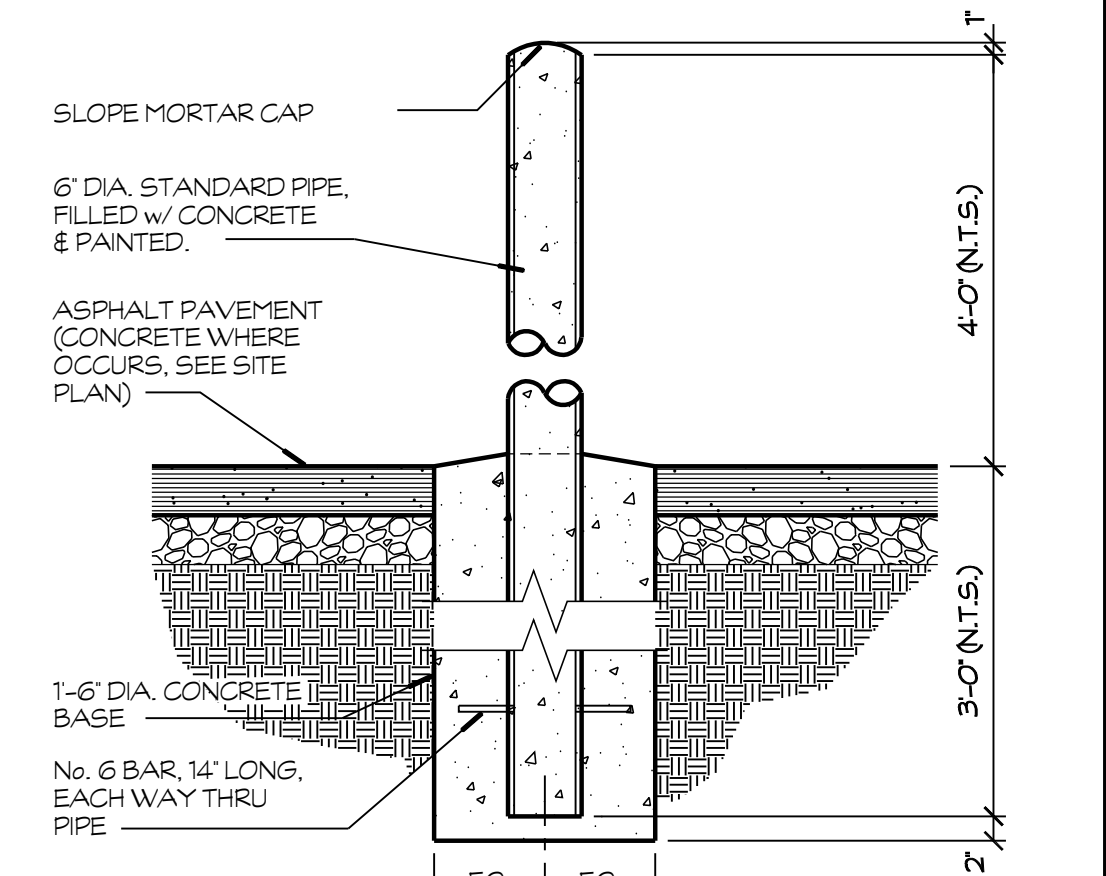


44 STEEL BOLLARD PIPE
SCALE: 3/4" = 1'-0"
E:\17-67 shields & brawley elementary\details\site\1-34-Bollard.dwg 03/21/18 13:43




7790 NORTH PALM AVENUE
FRESNO, CALIFORNIA 93711
T 559.448.8400 F 559.448.8467
WWW.SIMP-RK.COM

PROJECT:
SHIELDS & BRAWLEY ELEMENTARY SCHOOL

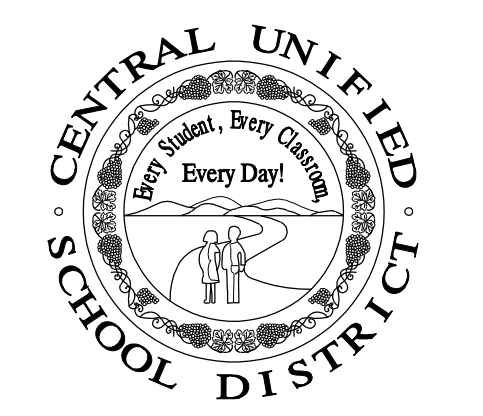

AD 2-38a
S&B Elementary
02-116800

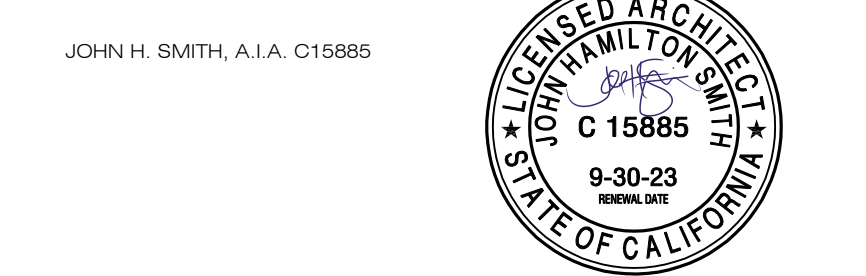


THE FIRM OF SMITH, WANAGA, MELHUS, ARCHITECTS, INC. EXPRESSLY RESERVES ITS COPYRIGHT AND OTHER AVAILABLE PROPERTY RIGHTS IN THESE PLANS. THESE PLANS ARE NOT TO BE REPRODUCED, CHANGED, OR COPIED IN ANY FORM OR MANNER WHATSOEVER, NOR ARE THEY TO BE ASSIGNED TO A THIRD PARTY WITHOUT FIRST OBTAINING THE WRITTEN PERMISSION AND CONSENT OF THE ARCHITECT. IN THE EVENT OF UNAUTHORIZED REUSE OF THESE PLANS BY A THIRD PARTY, THE THIRD PARTY SHALL HOLD THE ARCHITECT HARMLESS, AND SHALL BEAR THE COST OF THE ARCHITECT'S LEGAL FEES ASSOCIATED WITH DEFENDING AND ENFORCING THESE RIGHTS.

| PROJECT DEVELOPMENT | |
|---------------------|------------|
| DATE | ISSUED FOR |
| | |
| | |
| | |

| REVISIONS | | |
|-----------|---------|------------------------|
| No. | DATE | DESCRIPTION |
| 1 | 2.14.23 | DISTRICT MODIFICATIONS |
| 2 | 2.27.23 | DISTRICT MODIFICATIONS |


| SHEET DESCRIPTION | |
|-----------------------------------|--------------------------|
| DETAILS | |
| PROJECT COORDINATOR JOHN SMITH | SHEET NO. A8.3 |
| PROJECT NO. 17-67 | DATE 1.27.23 |
| SCALE AS NOTED | |

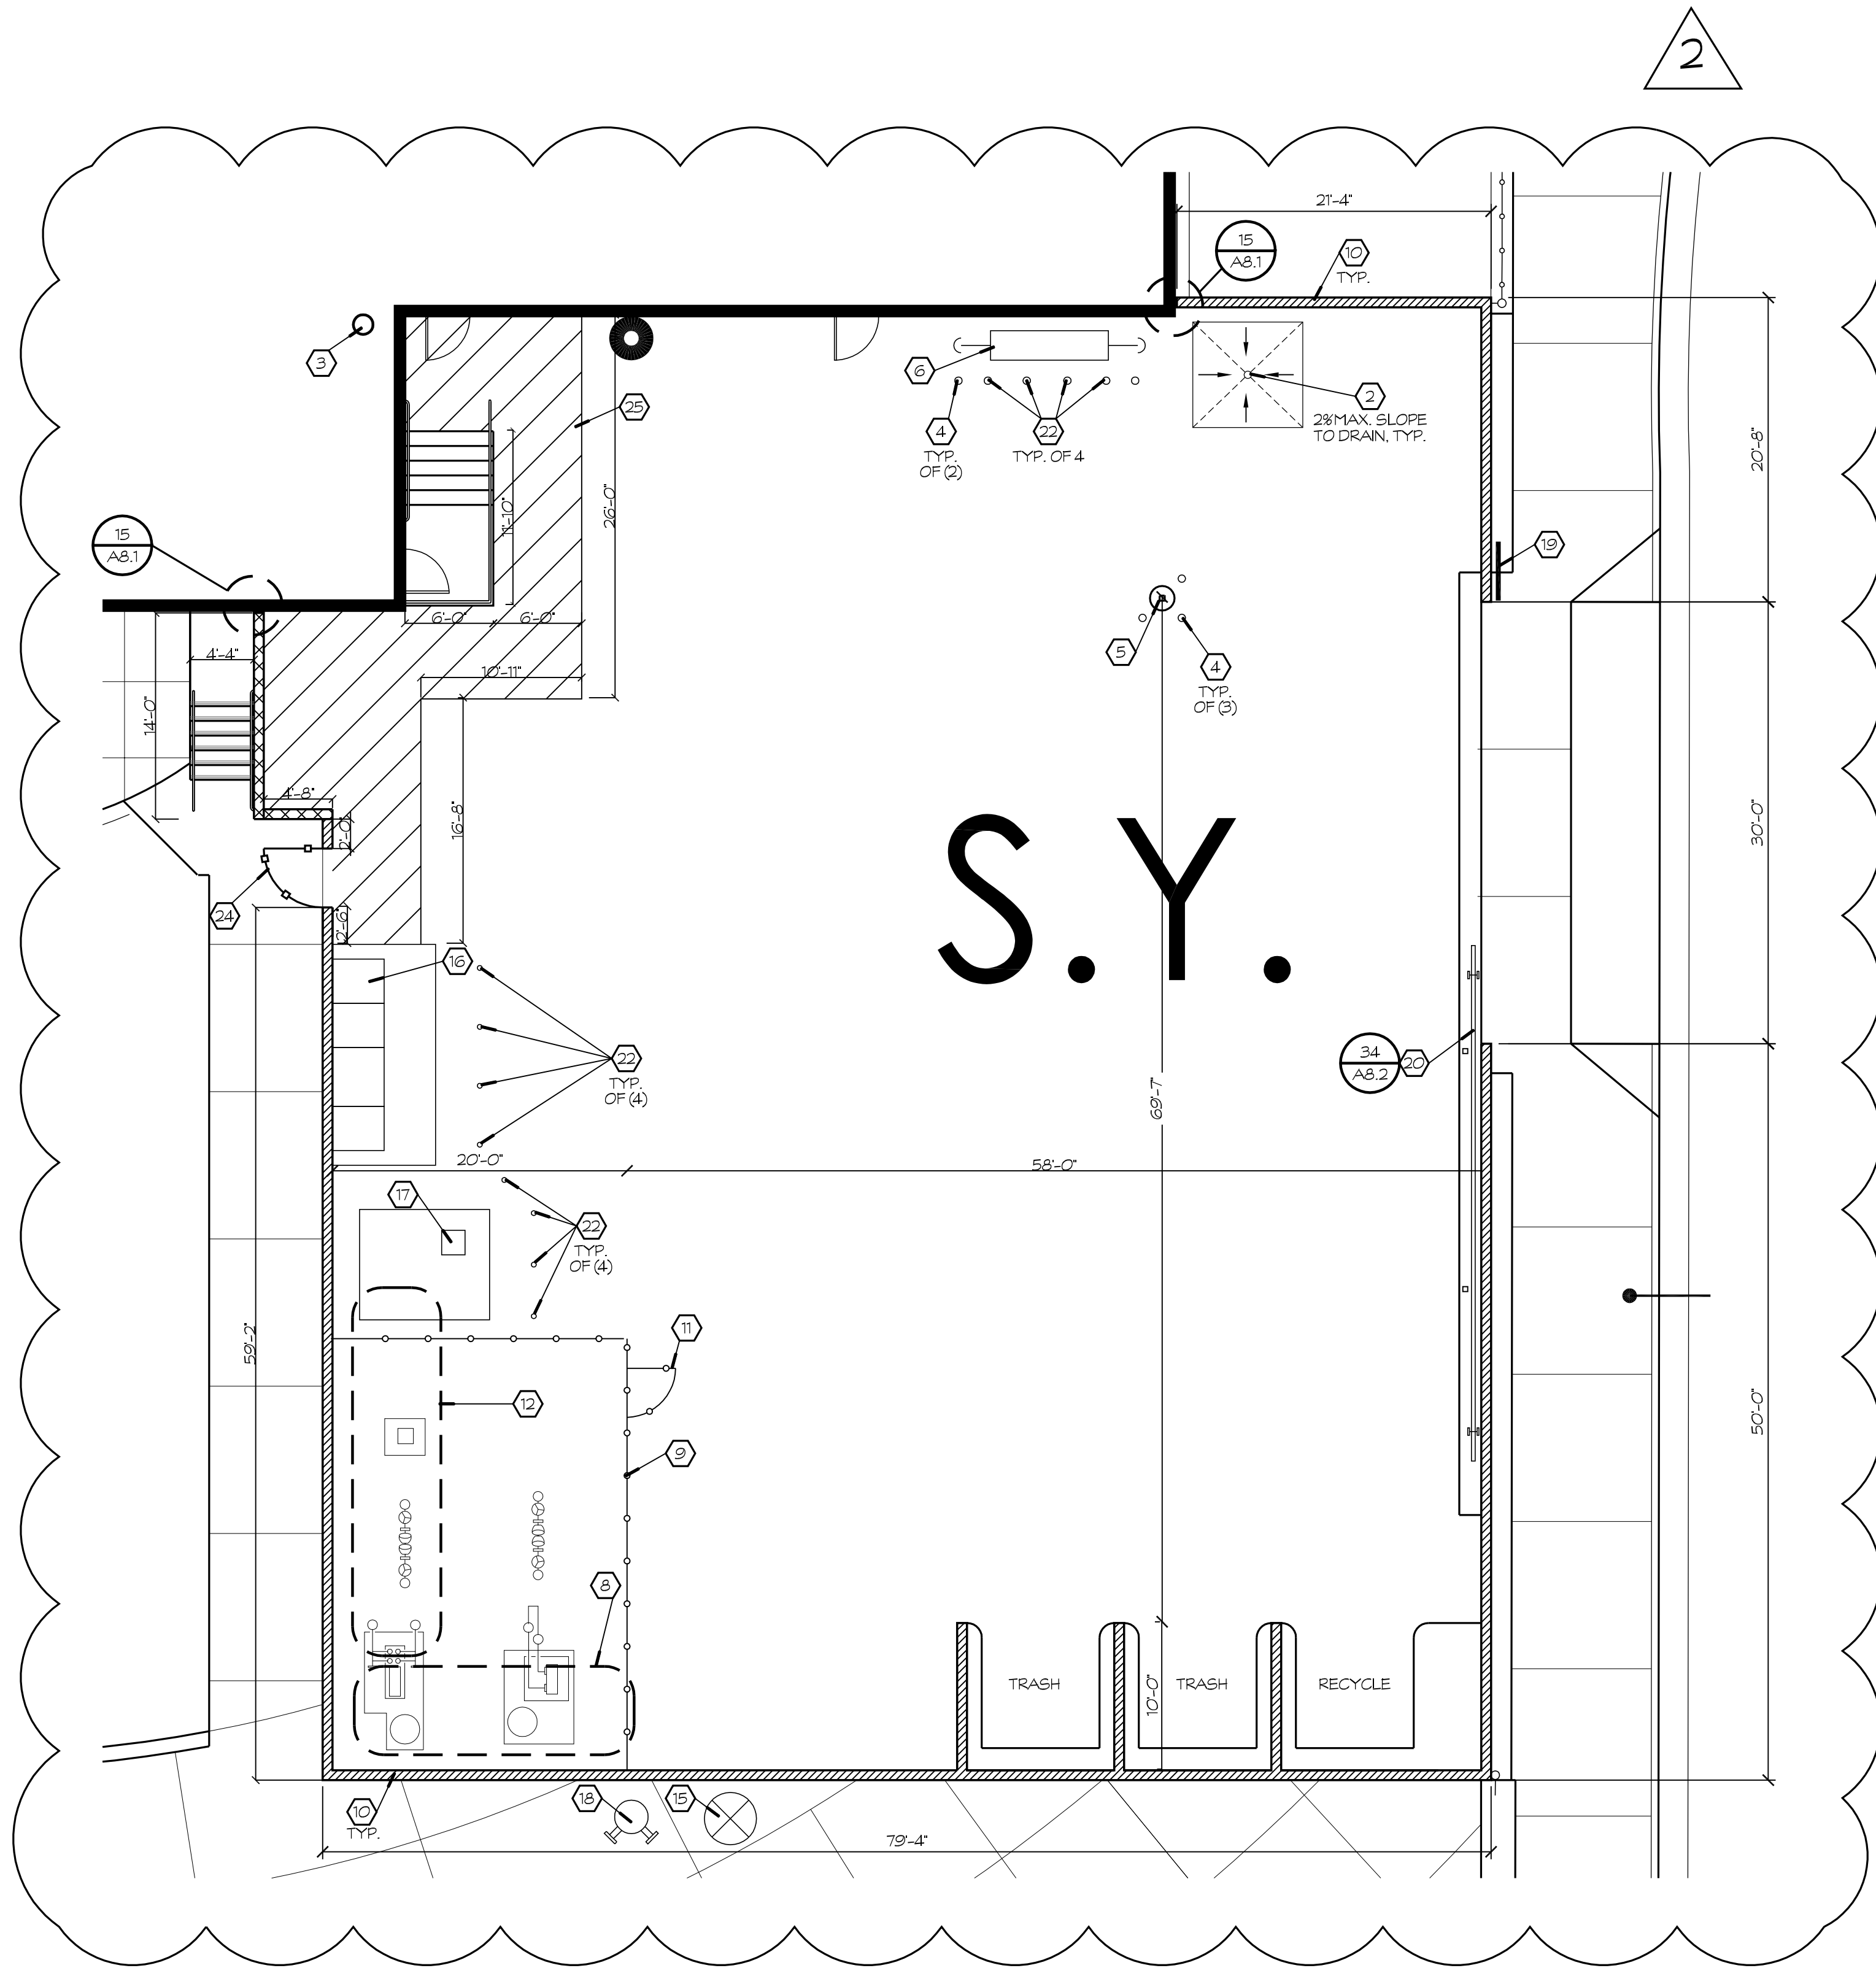

1 ENLARGED SERVICE YARD
SEE SHEET A0.3 FOR SITE LOCATION

KEYNOTES

1. STAIRS, SEE FLOOR PLAN
2. TRASH CAN WASH, SEE PLUMBING PLANS
3. FIRE SPRINKLER RISER LOCATION, SEE CIVIL PLAN
4. STEEL BOLLARD, SEE DTL. 44/A8.3, TYP. U.O.N.
5. COLUMN, SEE FLOOR PLAN
6. GAS METERS
7. W.I. SWING GATES, SEE DTL. 49/A8.3
8. DOMESTIC WATER BOOSTER PUMP SYSTEM, SEE DTL. 1/PI FOR MOUNTING
9. 6'-0" HIGH CHAIN LINK FENCE, SEE CIVIL PLANS
10. 6'-0" HIGH CMU WALL, SEE DTL. 51/A8.3
11. 3'-0" WIDE CHAIN LINK GATE, SEE CIVIL PLANS
12. IRRIGATION BOOSTER PUMP SYSTEM, SEE CIVIL PLANS FOR MOUNTING
13. TRUNCATED DOMES, SEE DTL. 11/A8.1
14. ACCESSIBLE RAMP SIM, SEE DTL. 1/A8.1
15. PV LOCATION, SEE CIVIL PLAN
16. ELECTRICAL PANELS, SEE ELECTRICAL PLANS DTL. 3/EO.4 & 4/EO.5
17. THE UTILITY TRANSFORMER WILL BE INSTALLED BY PG&E AT A LATER DATE
18. FFC LOCATION, SEE CIVIL PLAN
19. SIGNAGE, "SERVICE YARD - AUTHORIZED VEHICLES ONLY"
20. ROLLING CHAIN LINK GATE, SEE CIVIL PLAN
21. STOP SIGN, SEE CIVIL PLAN
22. REMOVABLE STEEL BOLLARD, SEE DTL. 56/A8.3
23. PROVIDE PANIC HARDWARE PER DETAIL 50/A8.3
24. 4'-0" WIDE STEEL GATE w/ PANIC HARDWARE, SEE DTL. 49/A8.3
25. STRIPED CLEAR ACCESSIBLE PATH

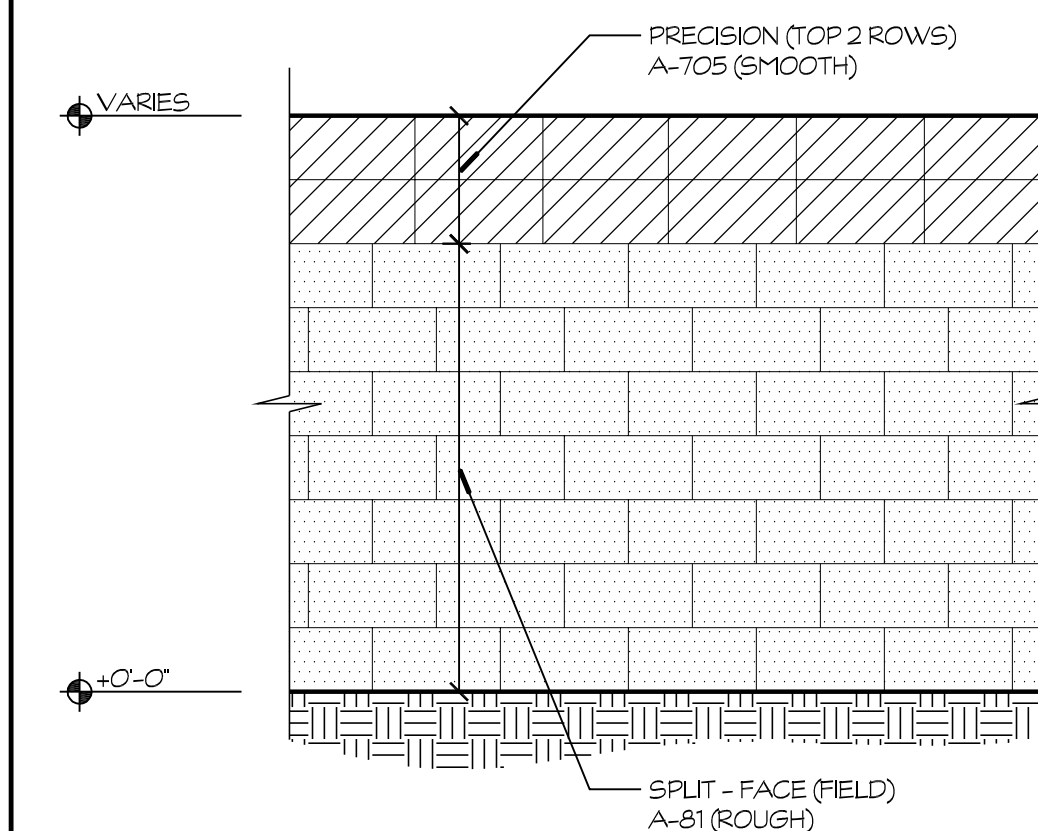

A CMU PATTERN
TYPICAL ALL CMU
SCALE: 1/2" = 1'-0"
E:\17-67 shields & brawley elementary\details\site\CMU Pattern.dwg 05/15/18 13.28

NOTES

1. SEE CIVIL PLANS FOR PARKING LOT DIMENSIONS, DETAILS & INFO
2. SEE LANDSCAPE PLANS FOR FLATWORK DIMENSIONS, DETAILS & INFO.


LEGEND

- 8'-0" H. CMU WALL
- 6'-0" H. CMU WALL
- LANDSCAPE, SEE LANDSCAPE PLANS
- CONCRETE, SEE LANDSCAPE PLANS
- A/C PAVING, SEE CIVIL PLANS
- GRASS, SEE LANDSCAPE PLANS
- FIBAR
- GRAVEL, SEE CIVIL PLANS




7790 NORTH PALM AVENUE
FRESNO, CALIFORNIA 93711
T 559.448.8400 · F 559.448.8467
www.simprk.com

PROJECT:
SHIELDS & BRAWLEY ELEMENTARY SCHOOL

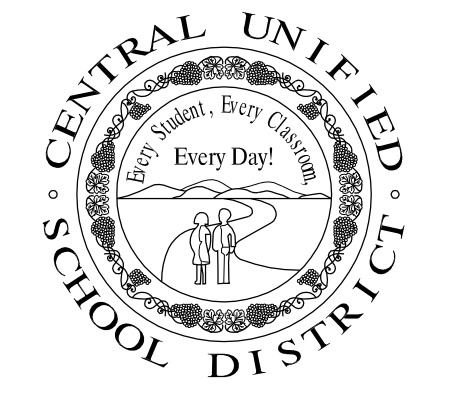

AD 2-39a
S&B Elementary
02-116800

JOHN H. SMITH, AIA, C15885

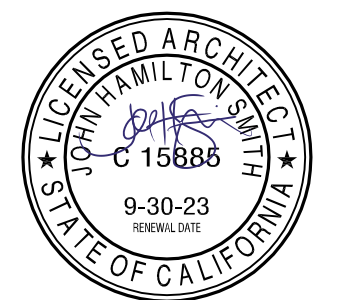

THE FIRM OF SMITH, WANAGA, MILLER, ARCHITECTS, INC. EXPRESSLY RESERVES ITS OWNERSHIP, LAW COPYRIGHT AND OTHER APPLICABLE PROPERTY RIGHTS IN THESE PLANS. THESE PLANS ARE NOT TO BE REPRODUCED, CHANGED, OR COPIED IN ANY FORM OR MANNER WHATSOEVER, NOR ARE THEY TO BE ASSIGNED TO A THIRD PARTY WITHOUT FIRST OBTAINING THE WRITTEN PERMISSION AND CONSENT OF THE ARCHITECT. IN THE EVENT OF UNAUTHORIZED REUSE OF THESE PLANS BY A THIRD PARTY, THE THIRD PARTY SHALL HOLD THE ARCHITECT HARMLESS, AND SHALL BEAR THE COST OF THE ARCHITECT'S LEGAL FEES ASSOCIATED WITH DEFENDING AND ENFORCING THESE RIGHTS.


| PROJECT DEVELOPMENT | |
|---------------------|------------|
| DATE | ISSUED FOR |
| | |
| | |
| | |

| REVISIONS | | |
|-----------|---------|------------------------|
| No. | DATE | DESCRIPTION |
| Δ | 2.14.23 | DISTRICT MODIFICATIONS |
| Δ | 2.27.23 | DISTRICT MODIFICATIONS |
| | | |
| | | |

SHEET DESCRIPTION


SERVICE YARD PLAN

| | |
|-----------------------------------|---------------------------|
| PROJECT COORDINATOR JOHN SMITH | SHEET No. A8.12 |
| PROJECT NO. 17-67 | |
| DATE 1.27.23 | |
| SCALE AS NOTED | |

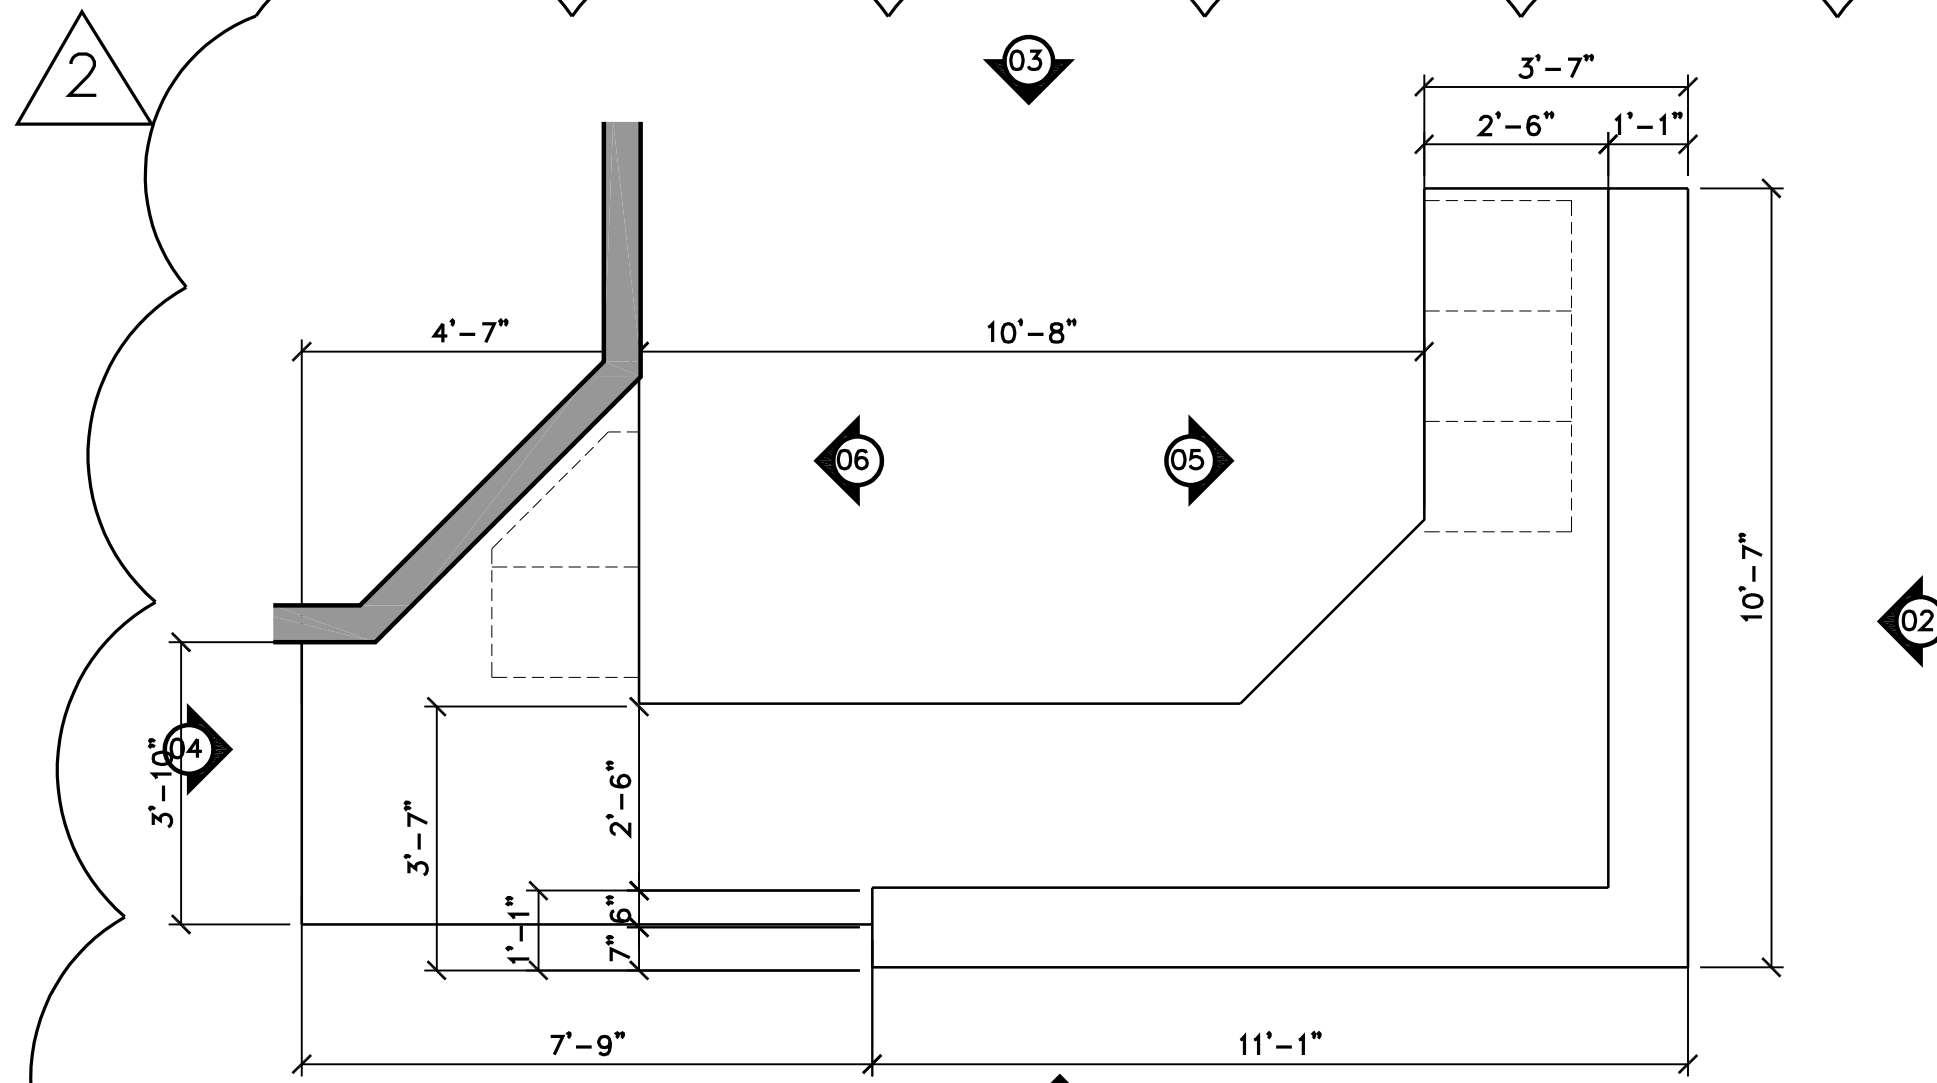


A ADMIN RECEPTION DESK
ADMINISTRATION

SCALE: 3/8" = 1'-0"

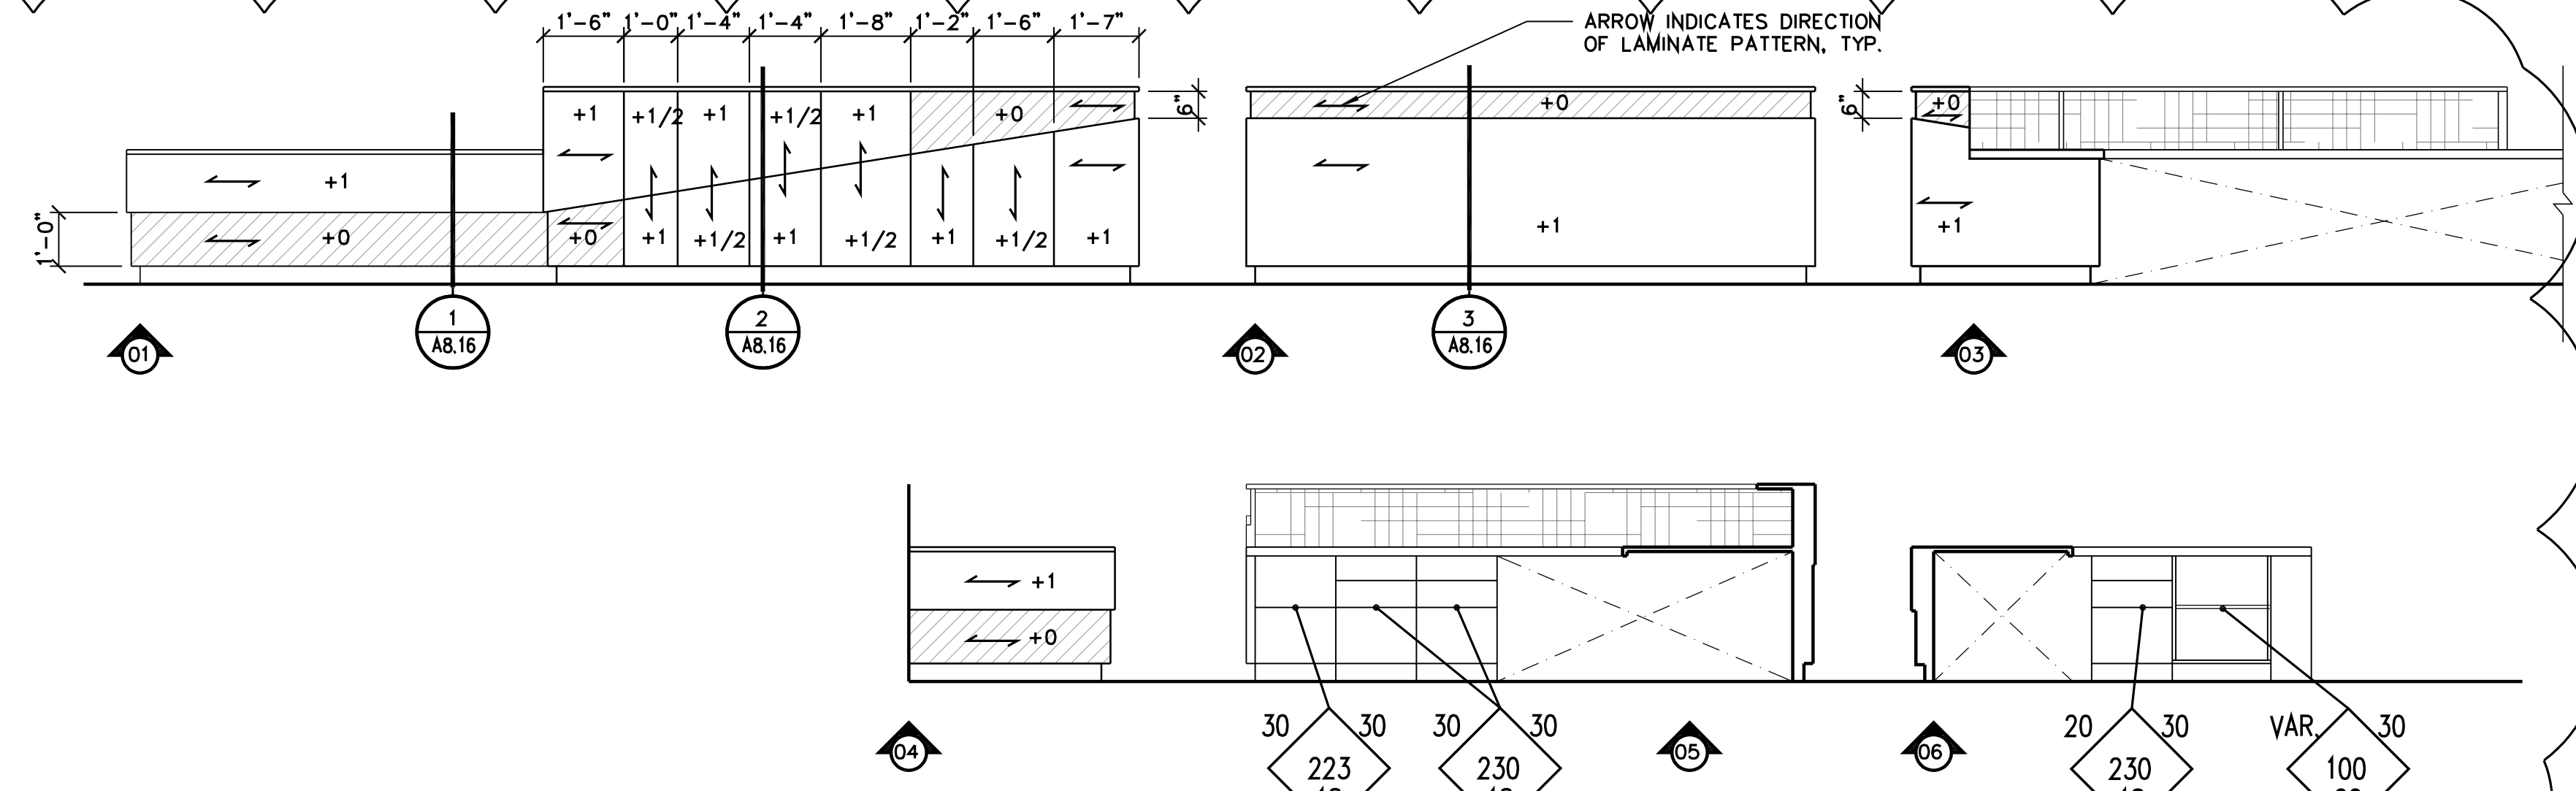


ADMIN RECEPTION DESK
INTERIOR ELEVATIONS

SCALE: 3/8" = 1'-0"

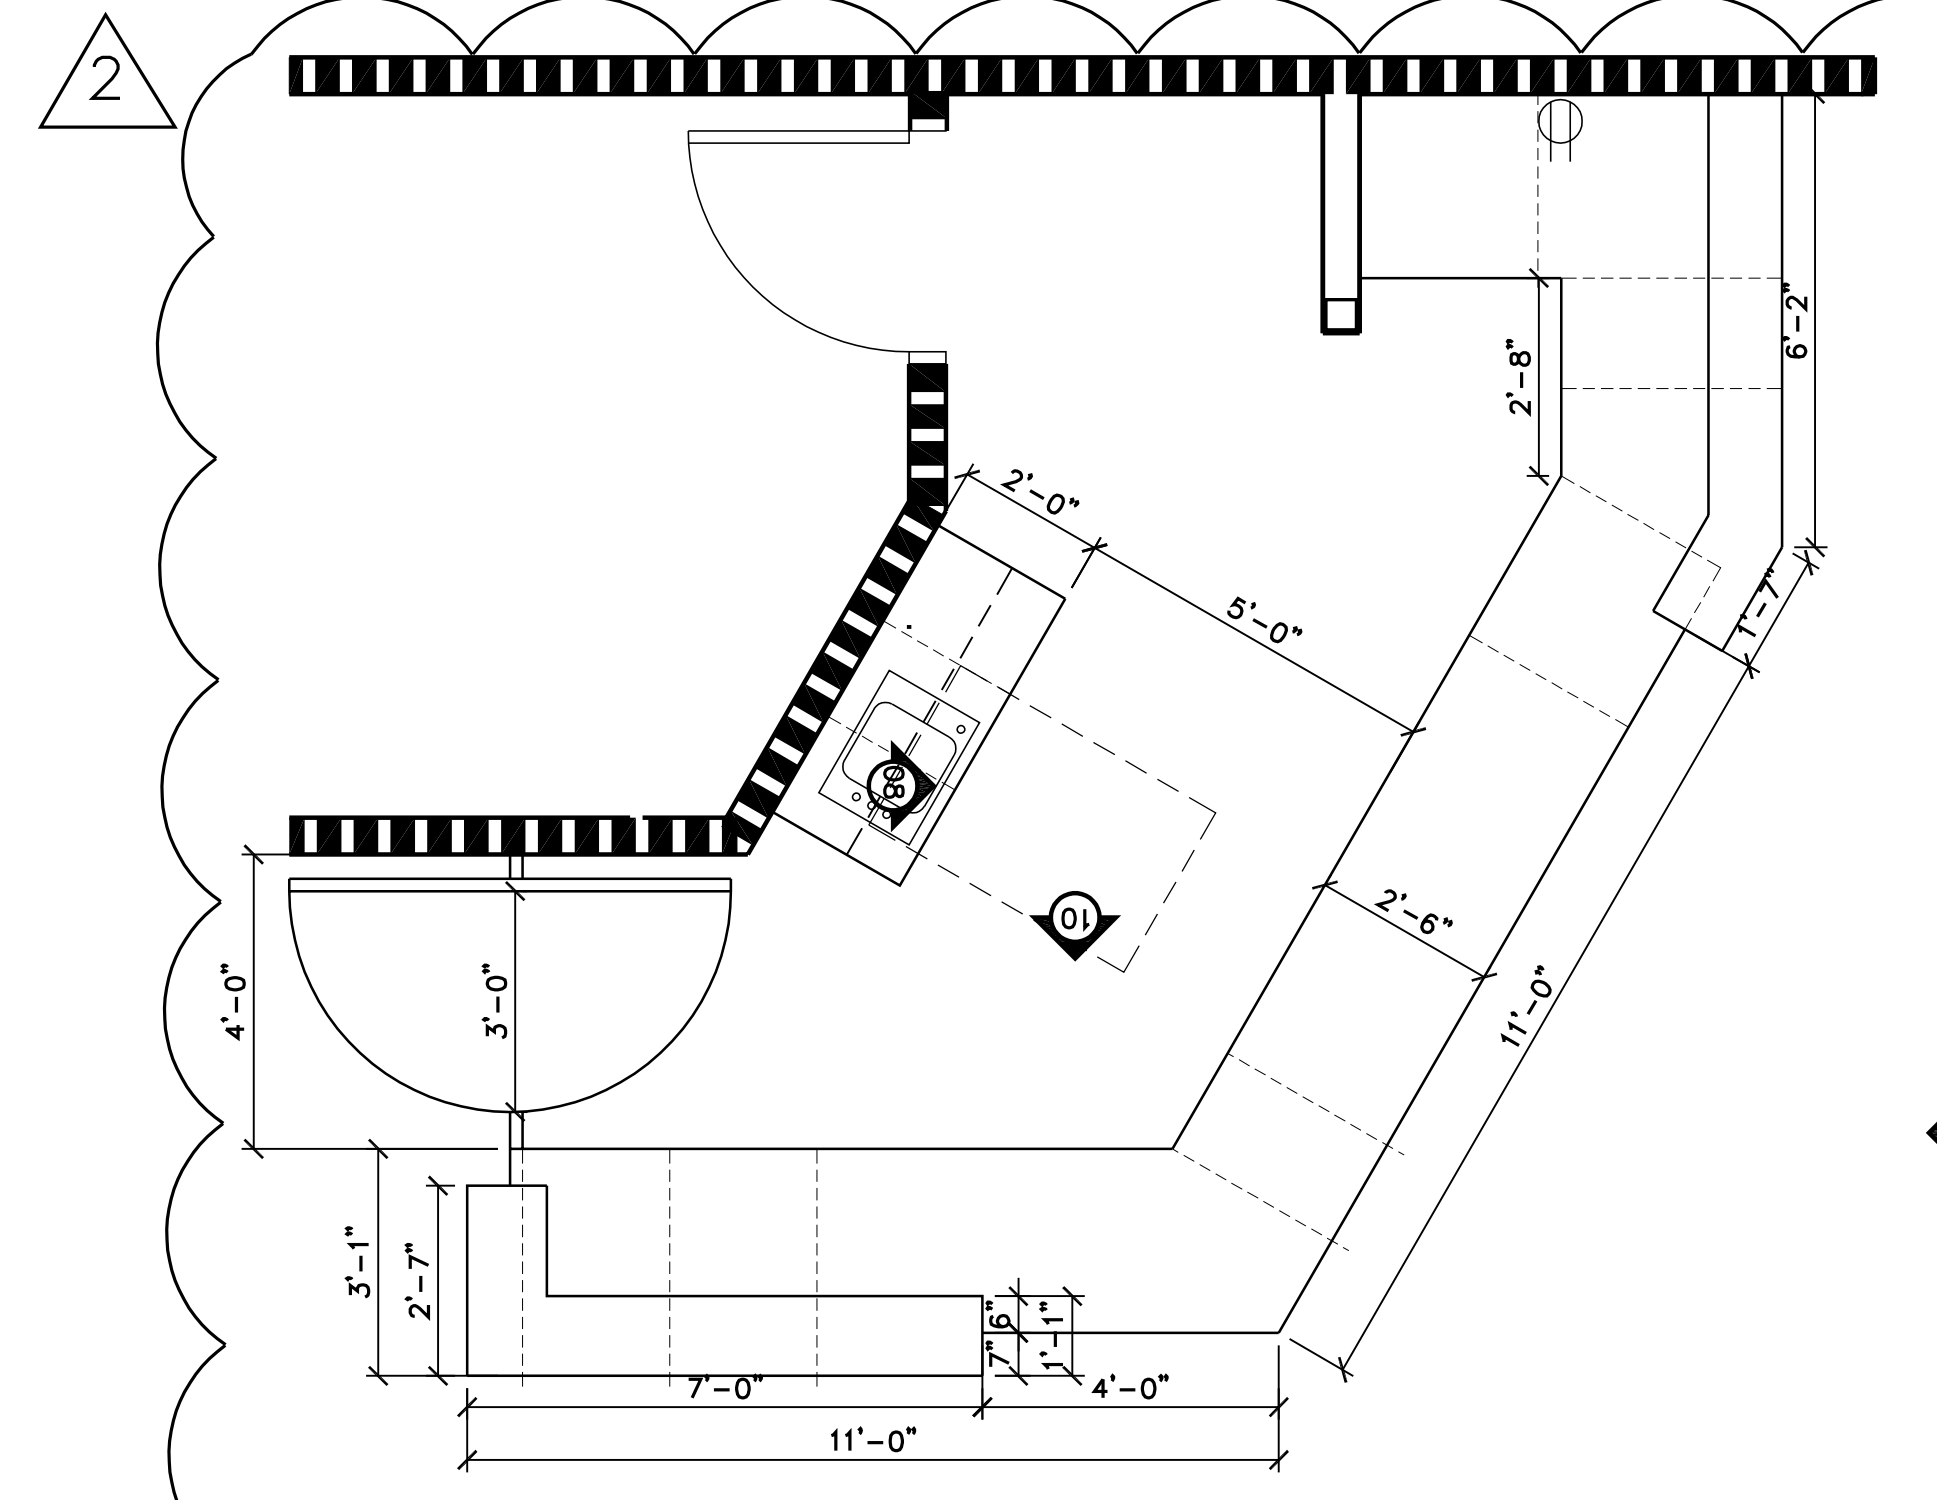


B LIBRARY RECEPTION DESK
ENLARGED FLOOR PLAN

SCALE: 3/8" = 1'-0"

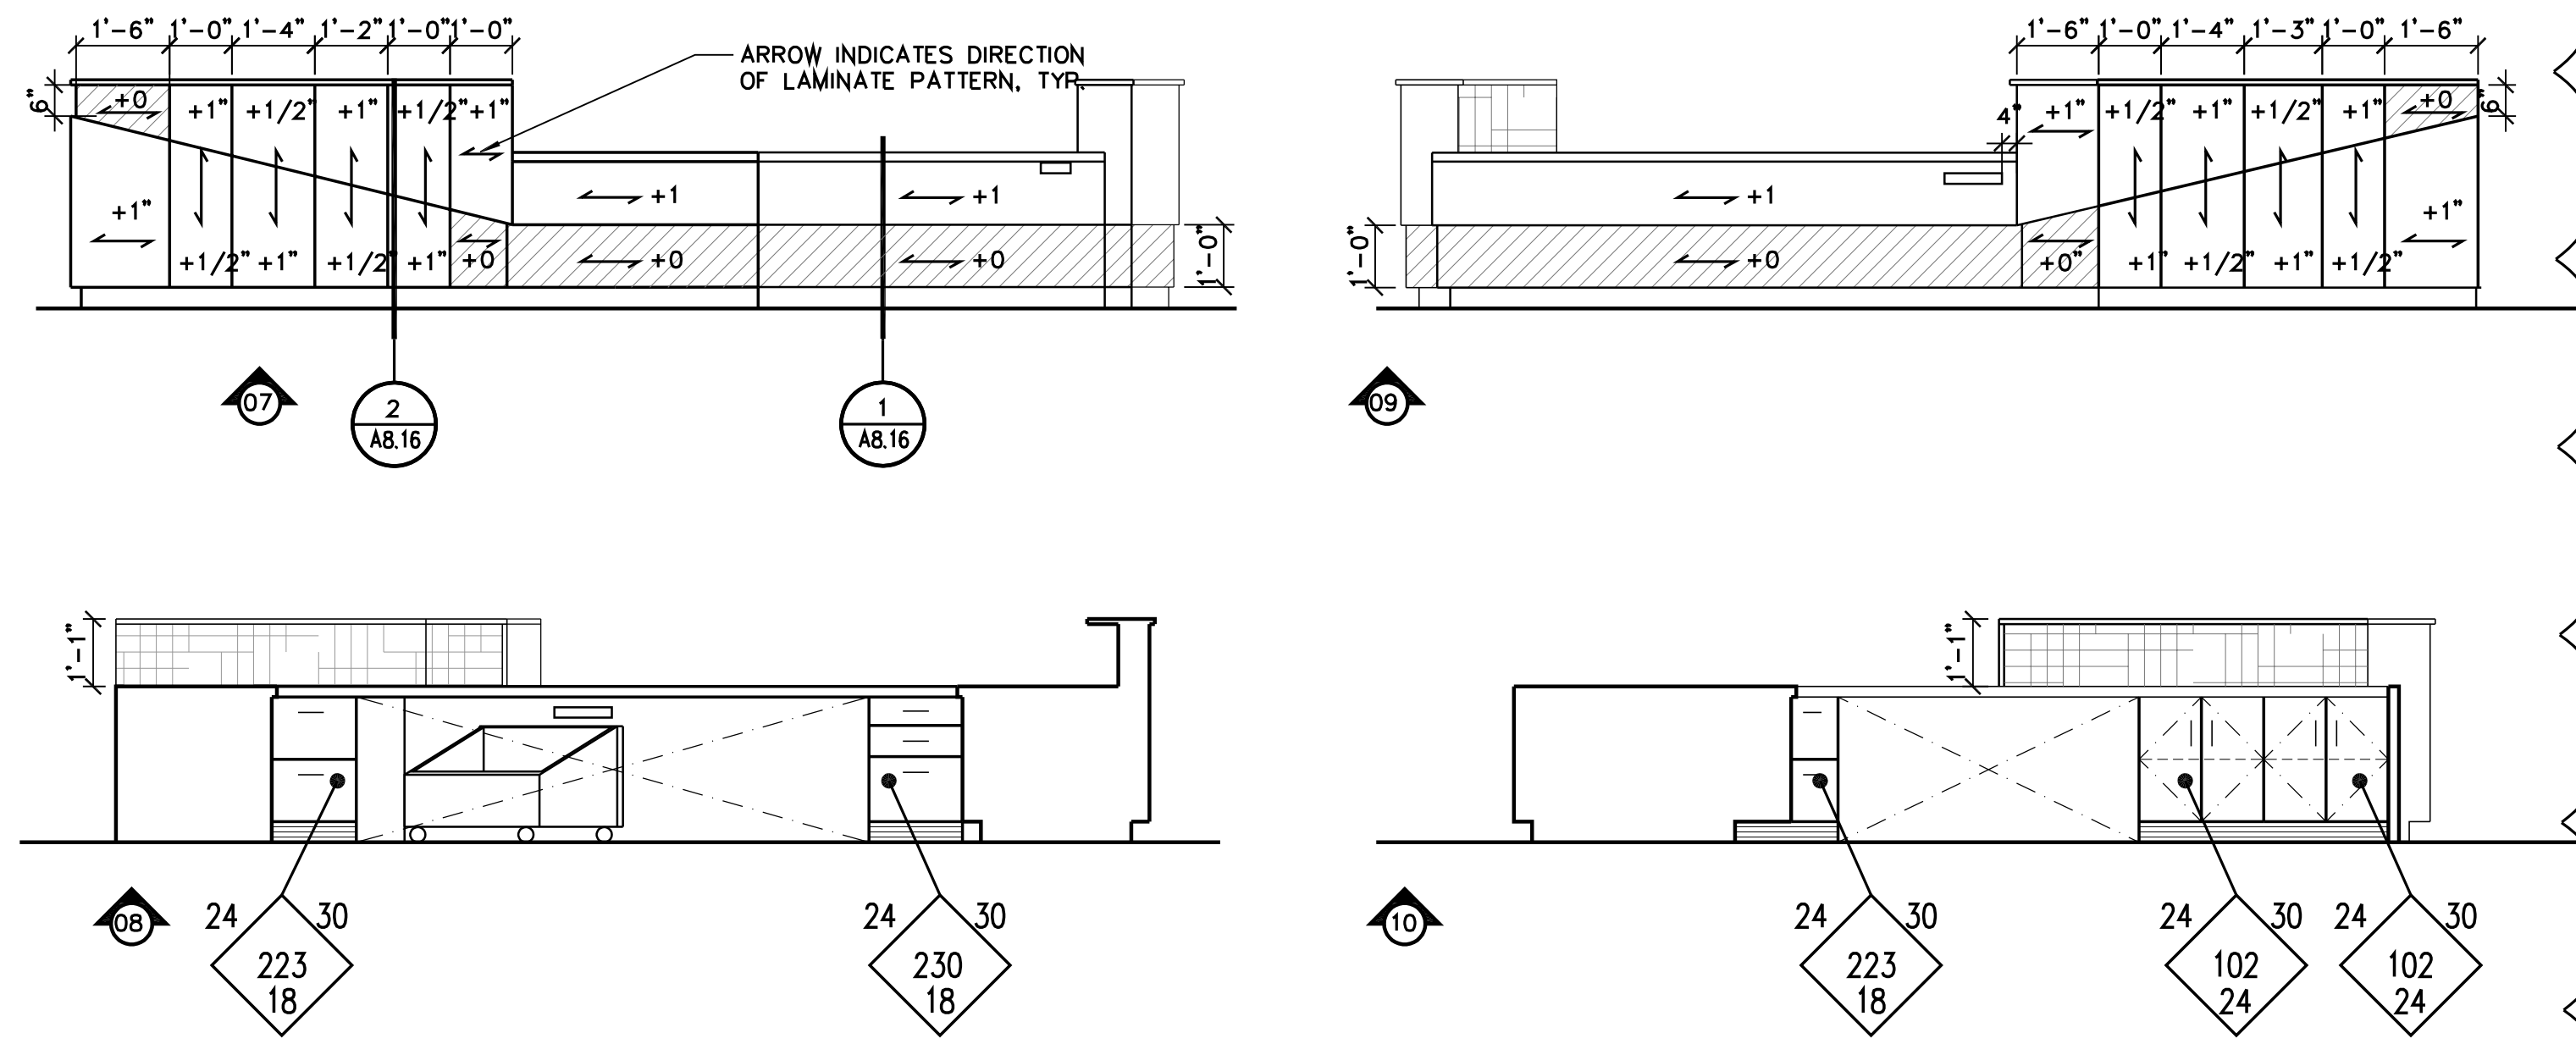


LIBRARY RECEPTION DESK
INTERIOR ELEVATIONS

SCALE: 3/8" = 1'-0"

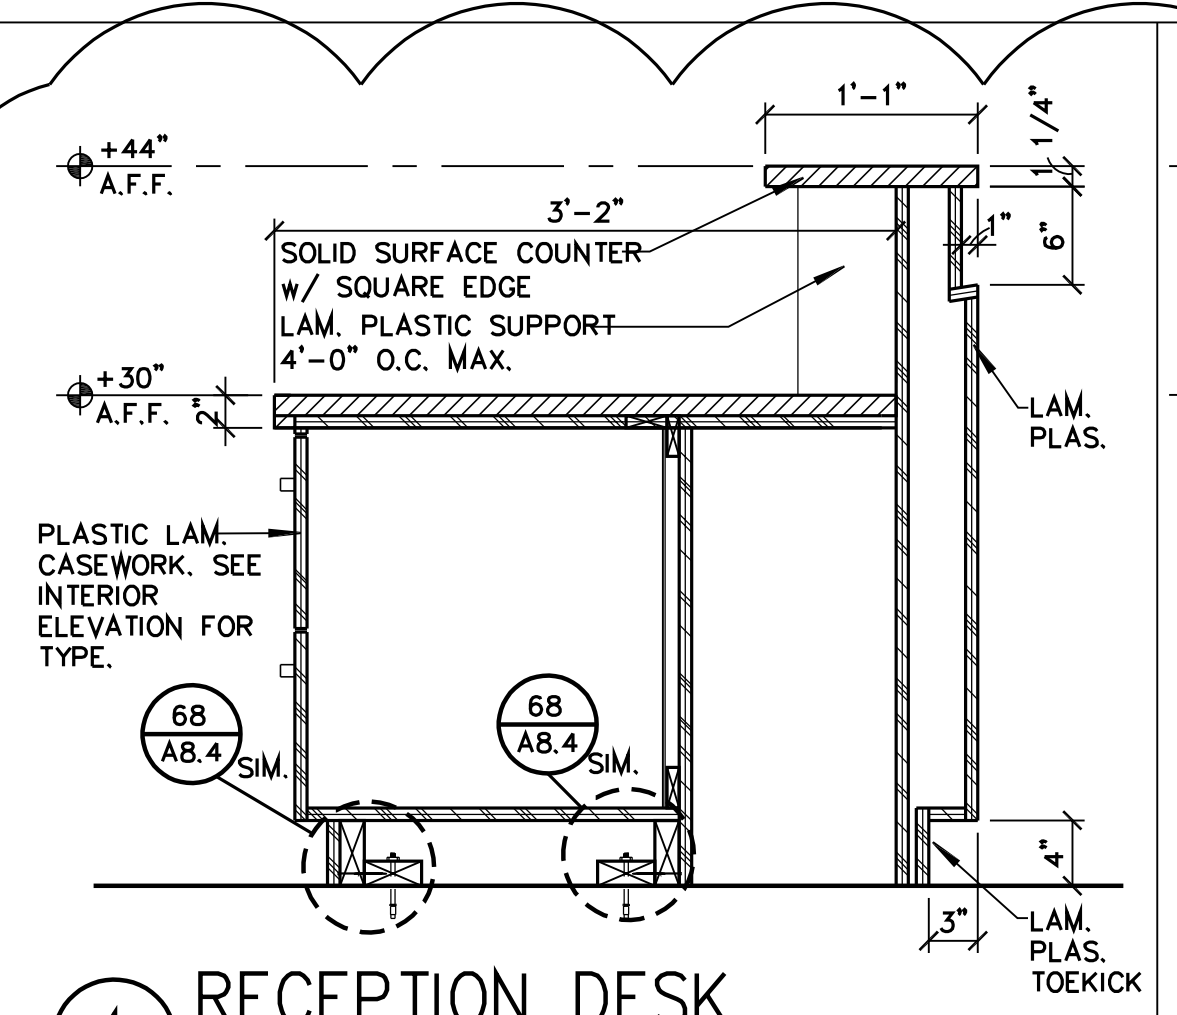


1 RECEPTION DESK

SCALE: 1" = 1'-0"

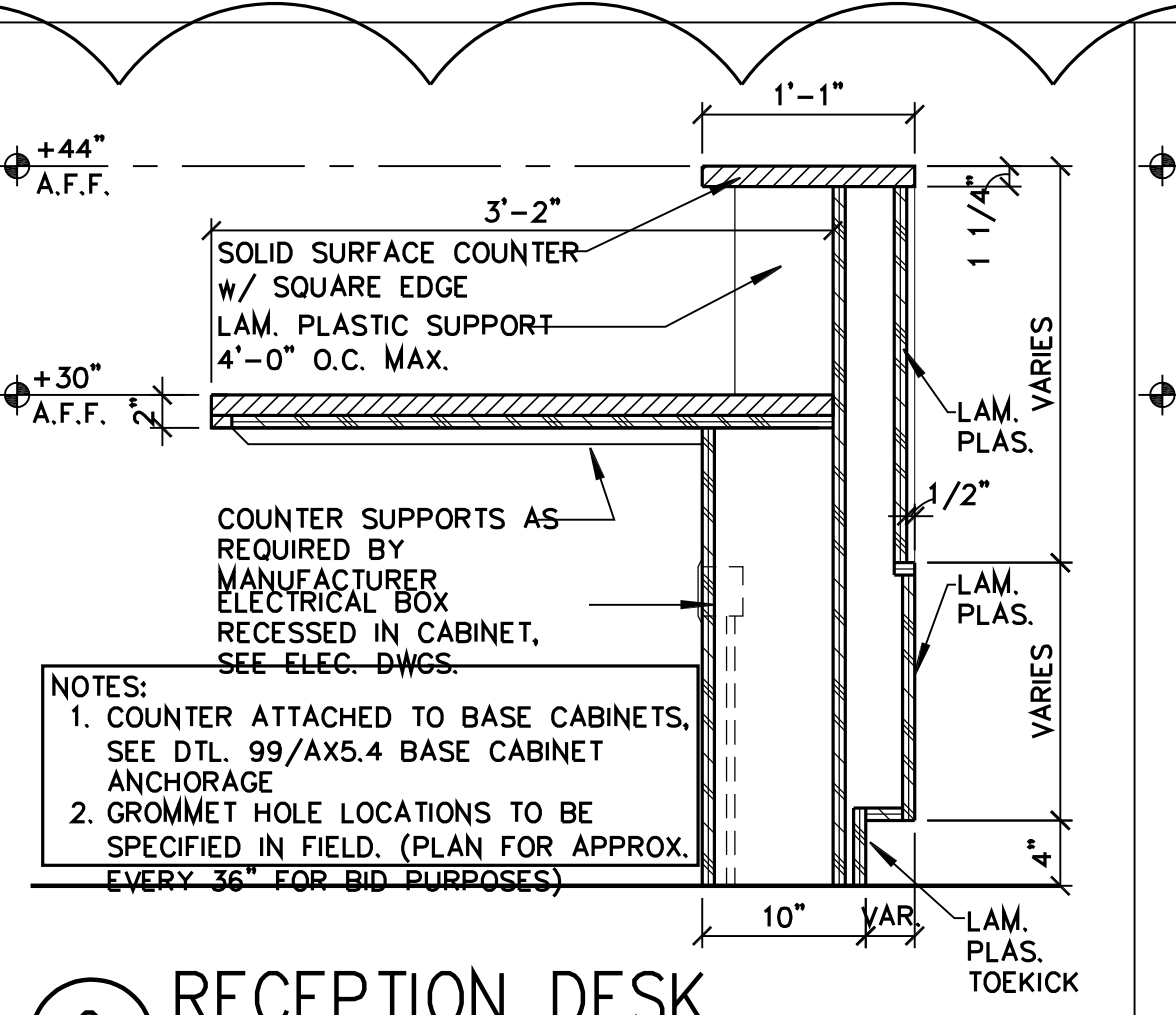

2 RECEPTION DESK

SCALE: 1" = 1'-0"

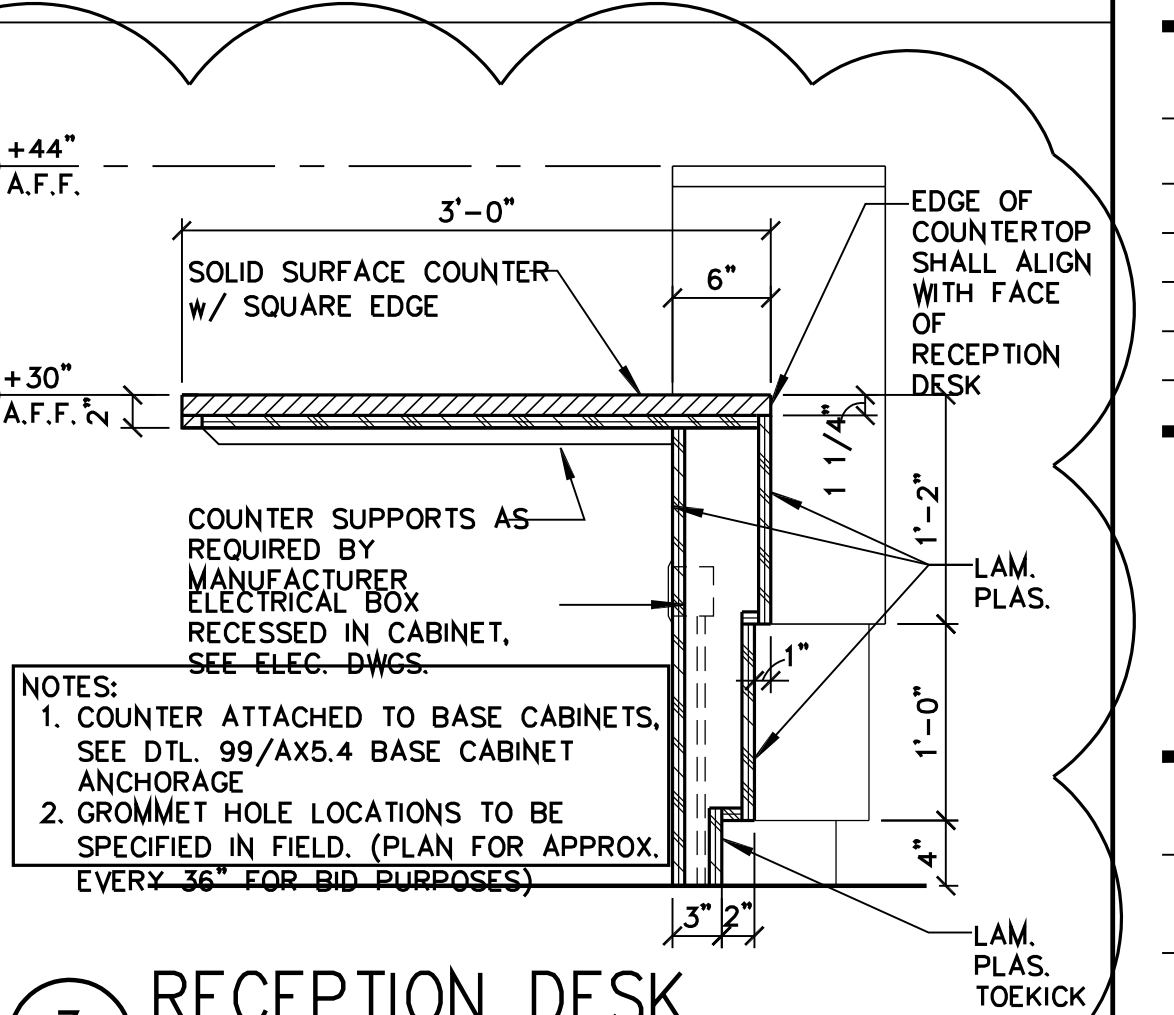

3 RECEPTION DESK

SCALE: 1" = 1'-0"




7790 NORTH PALM AVENUE
FRESNO, CALIFORNIA 93711
T 559.448.8400 F 559.448.8467
www.sim-prbk.com

PROJECT:
**SHIELDS & BRAWLEY
ELEMENTARY
SCHOOL**



**AD 2-40a
S&B Elementary
02-116800**

JOHN H. SMITH, A.I.A. C15885

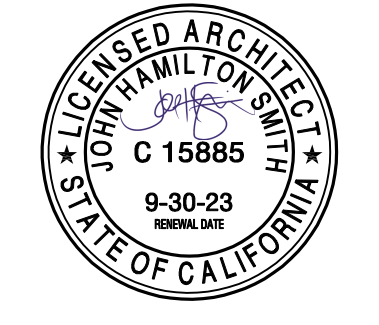


THE FIRM OF SMITH, IWANAGA, MELHUIS, ARCHITECTS, INC. EXPRESSLY RESERVES ITS COMMON LAW COPYRIGHT AND OTHER APPLICABLE PROPERTY RIGHTS IN THESE PLANS. THESE PLANS ARE NOT TO BE REPRODUCED, CHANGED, OR COPIED IN ANY FORM OR MANNER WHATSOEVER, NOR ARE THEY TO BE ASSIGNED TO A THIRD PARTY WITHOUT FIRST OBTAINING THE WRITTEN PERMISSION AND CONSENT OF THE ARCHITECT. IN THE EVENT OF UNAUTHORIZED REUSE OF THESE PLANS BY A THIRD PARTY, THE THIRD PARTY SHALL HOLD THE ARCHITECT HARMLESS, AND SHALL BEAR THE COST OF THE ARCHITECT'S LEGAL FEES, ASSOCIATED WITH DEFENDING AND ENFORCING THESE RIGHTS.

| PROJECT DEVELOPMENT | |
|---------------------|------------|
| DATE | ISSUED FOR |
| | |
| | |
| | |



| REVISIONS | | |
|-----------|---------|------------------------|
| No. | DATE | DESCRIPTION |
| △ 2 | 2.14.23 | DISTRICT MODIFICATIONS |
| △ 3 | 2.27.23 | DISTRICT MODIFICATIONS |
| | | |

| SHEET DESCRIPTION | |
|--|--------------|
| DETAILS | |
| PROJECT COORDINATOR JOHN SMITH | SHEET No. |
| PROJECT NO. 17-67 | A8.16 |
| DATE 1.27.23 | |
| SCALE AS NOTED | |


E:\17-67 Shields & Brawley Elementary\Shields & Brawley Elementary\Interior\RECEPTION COUNTERTOP.dwg 03/22/18 08:31

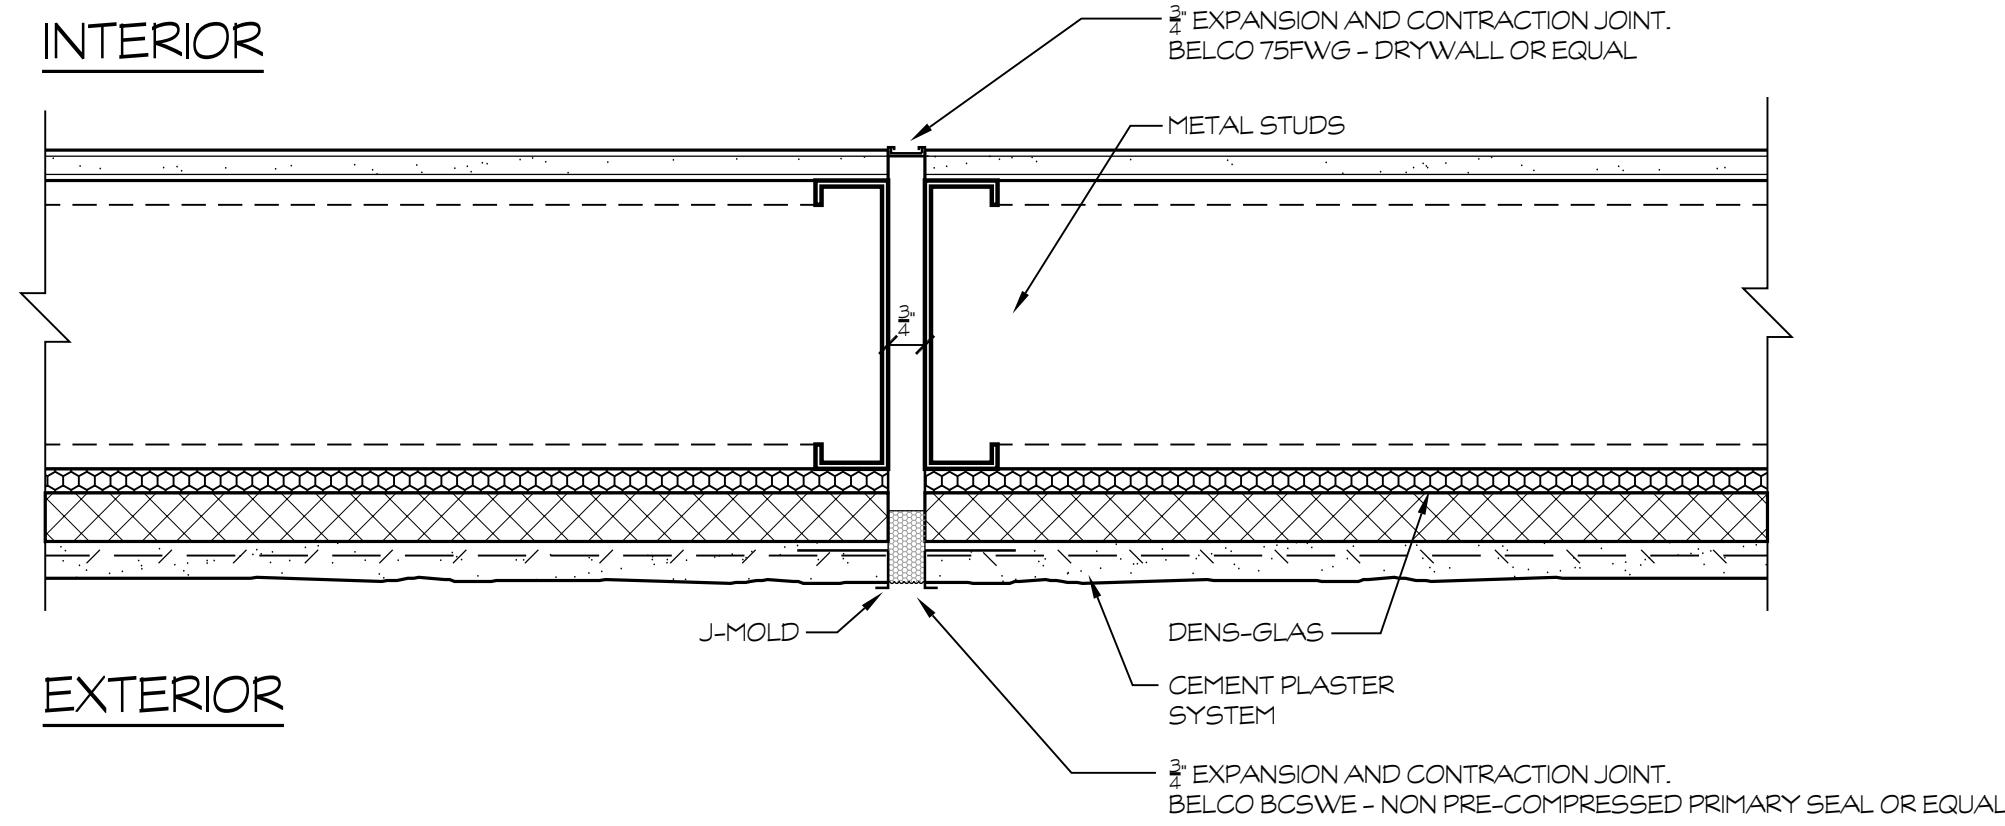


309 EXTERIOR WALL EXPANSION JOINT
SCALE: 3" = 1'-0"
E:\08-47 shields & brawley\interior\details\comp\309\309 Final Suffix at In Corner 02.dwg 03/22/13 15:16

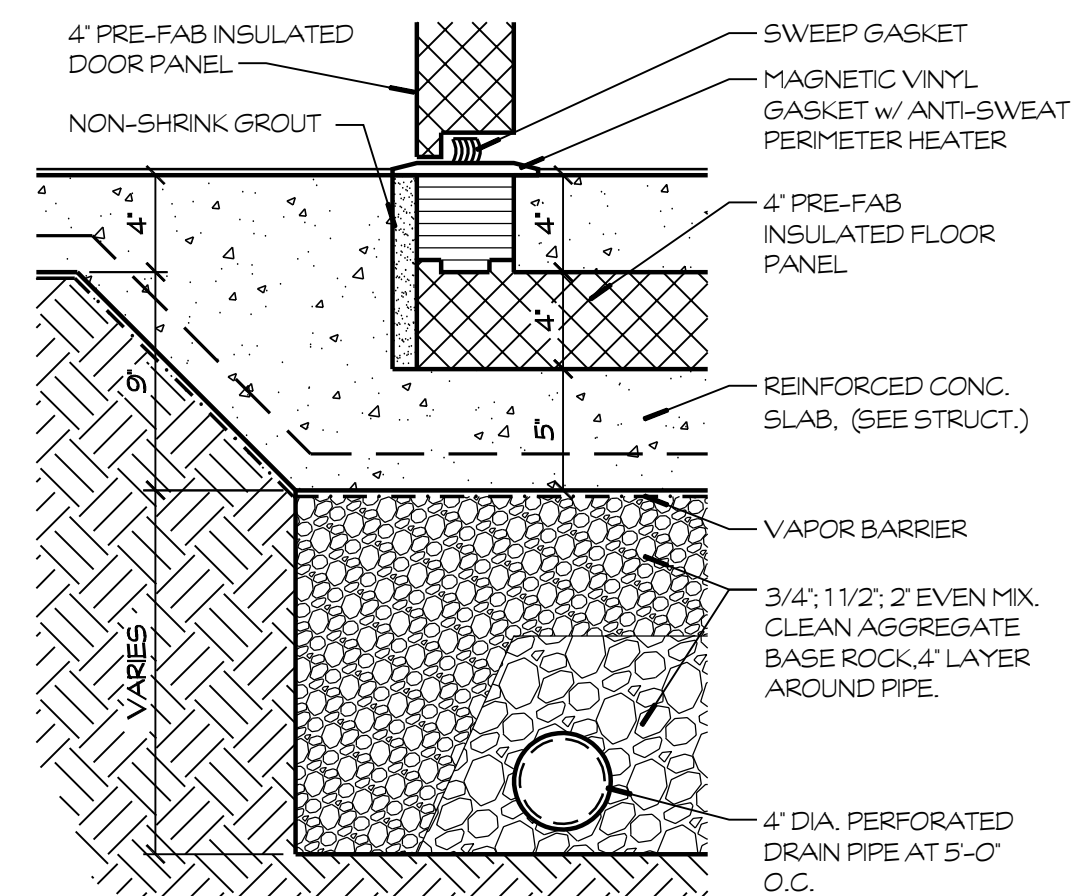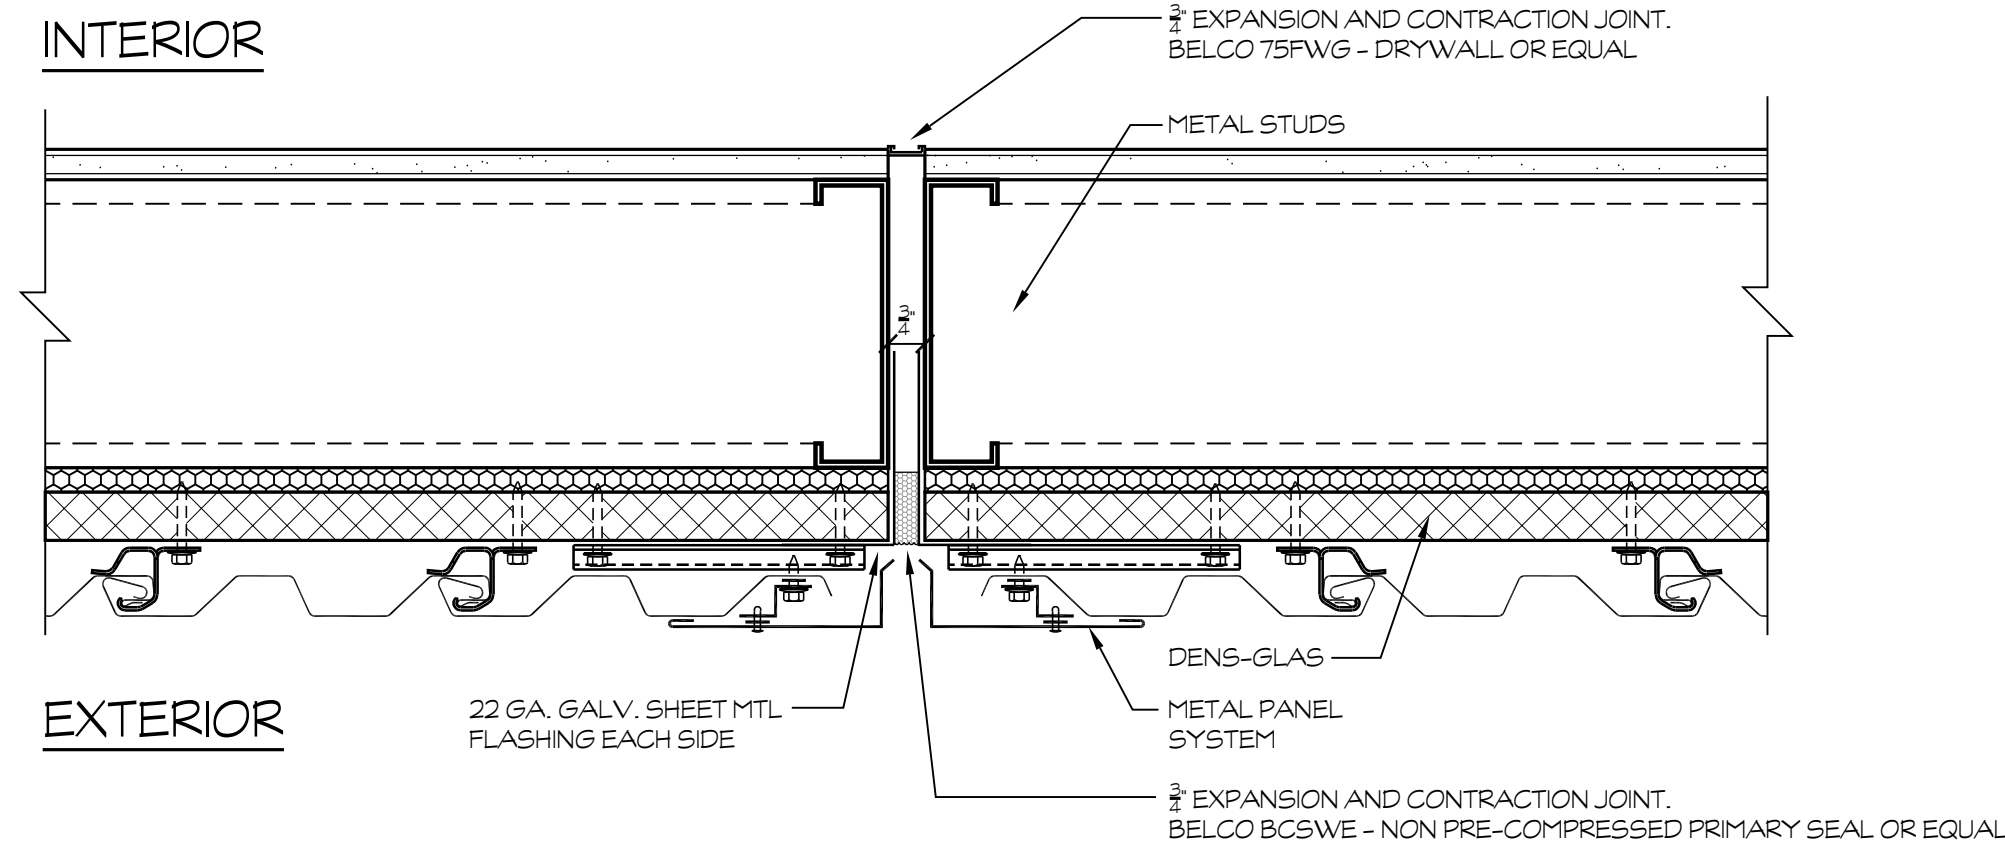


301 DOOR THRESHOLD
AT FREEZER FLOOR
SCALE: 1 1/2" = 1'-0"
E:\08-47 central high school\details\interior\Freezer-Cooler Threshold.dwg 02/21/13 15:18

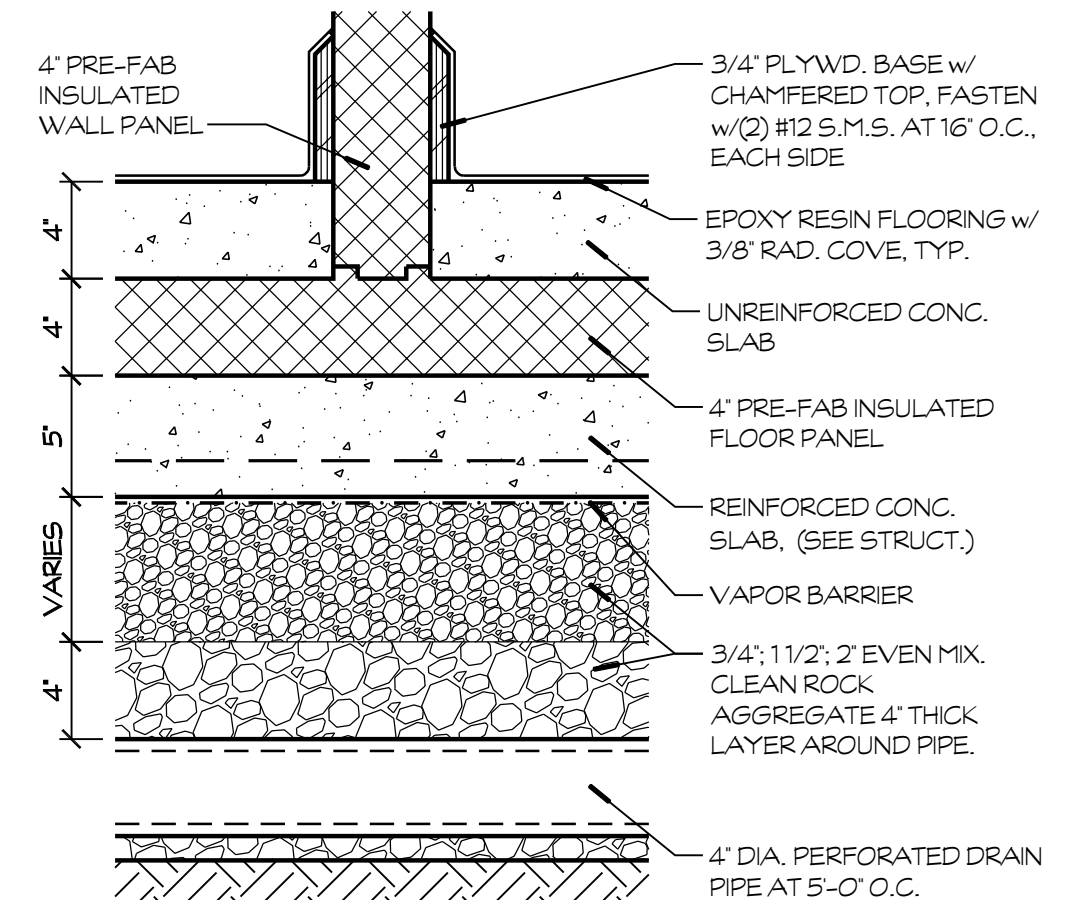


302 INSULATED PARTITION
AT FREEZER/COOLER BOX
SCALE: 1 1/2" = 1'-0"
E:\08-47 central high school\details\interior\Freezer-Cooler Partition.dwg 02/21/13 15:16

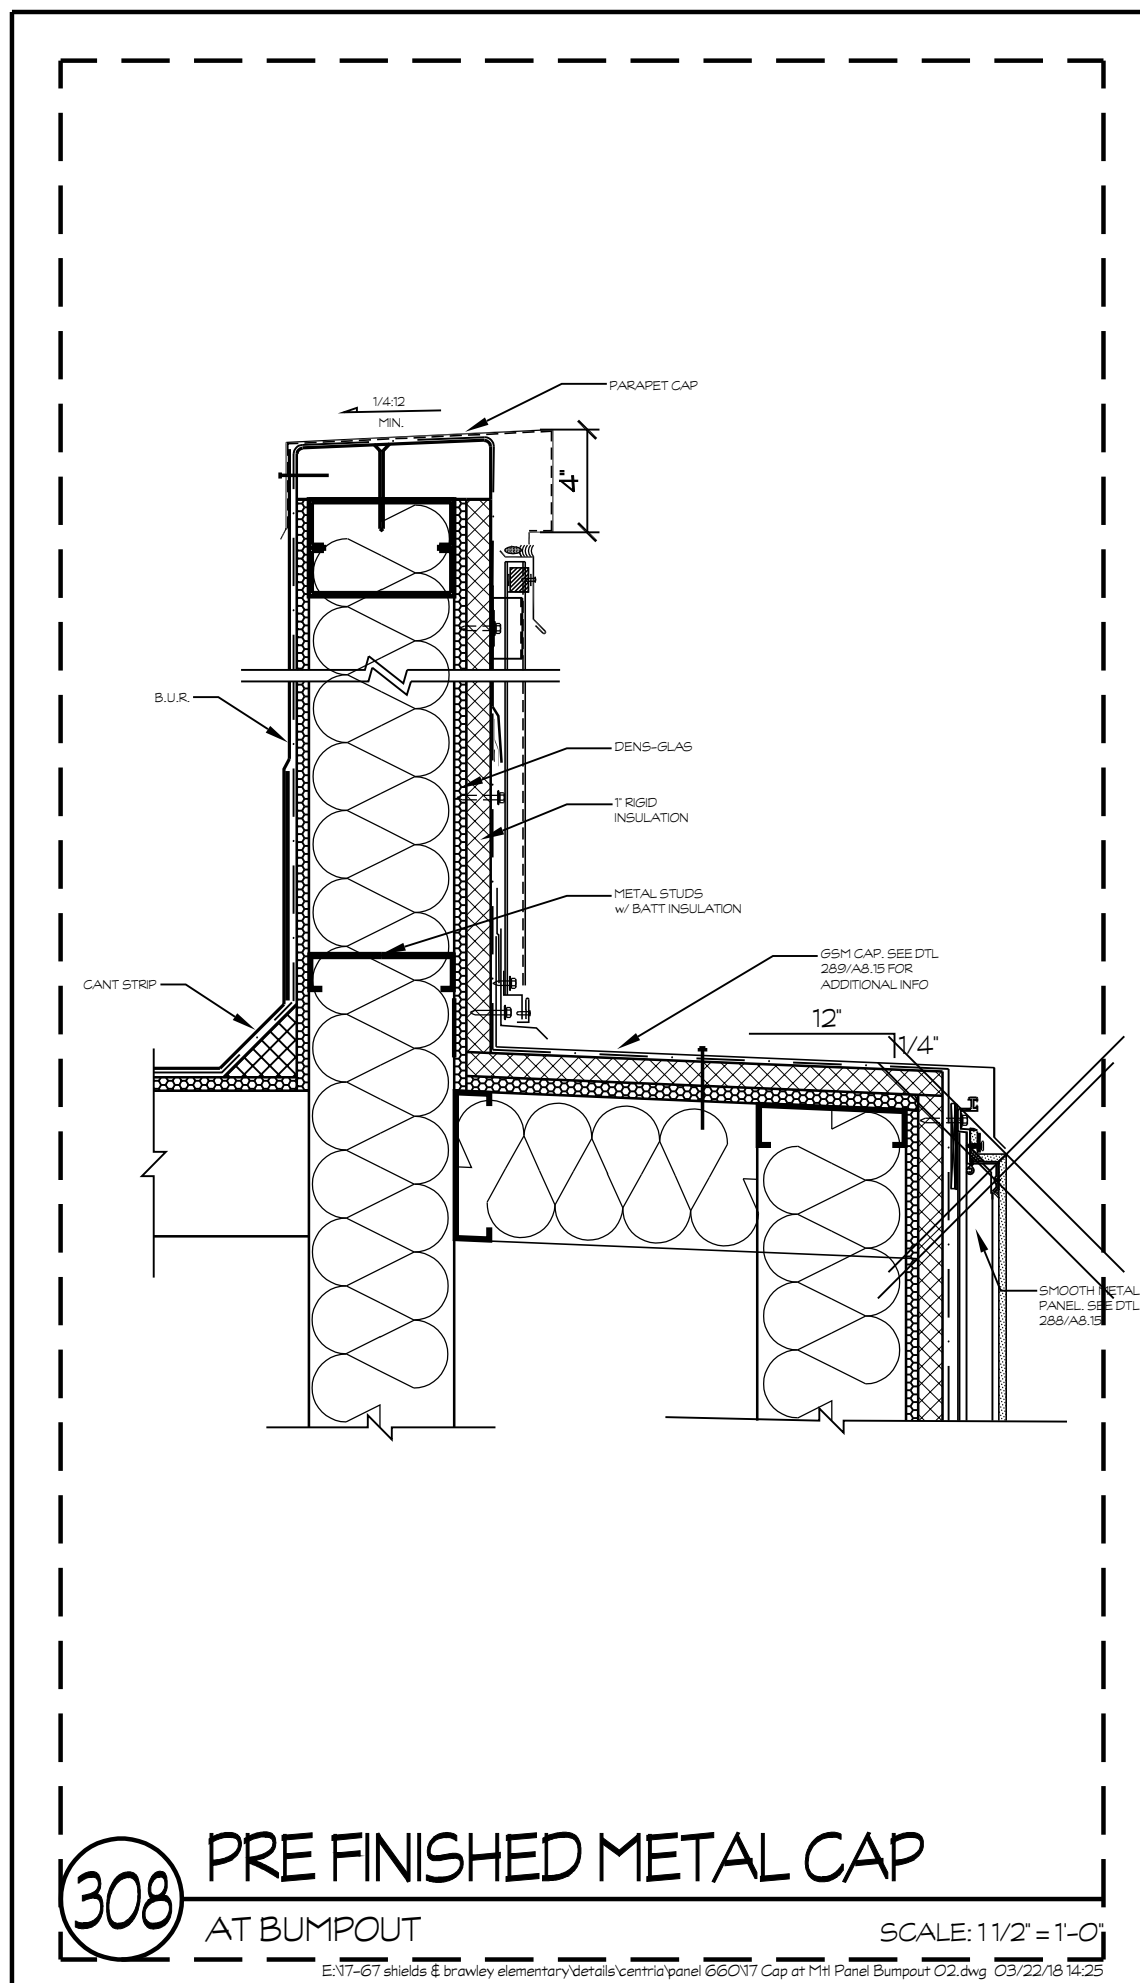

308 PRE FINISHED METAL CAP
AT BUMPOUT
SCALE: 1 1/2" = 1'-0"
E:\08-47 shields & brawley\interior\details\comp\308\308 Final Suffix at In Corner 02.dwg 03/22/13 15:25

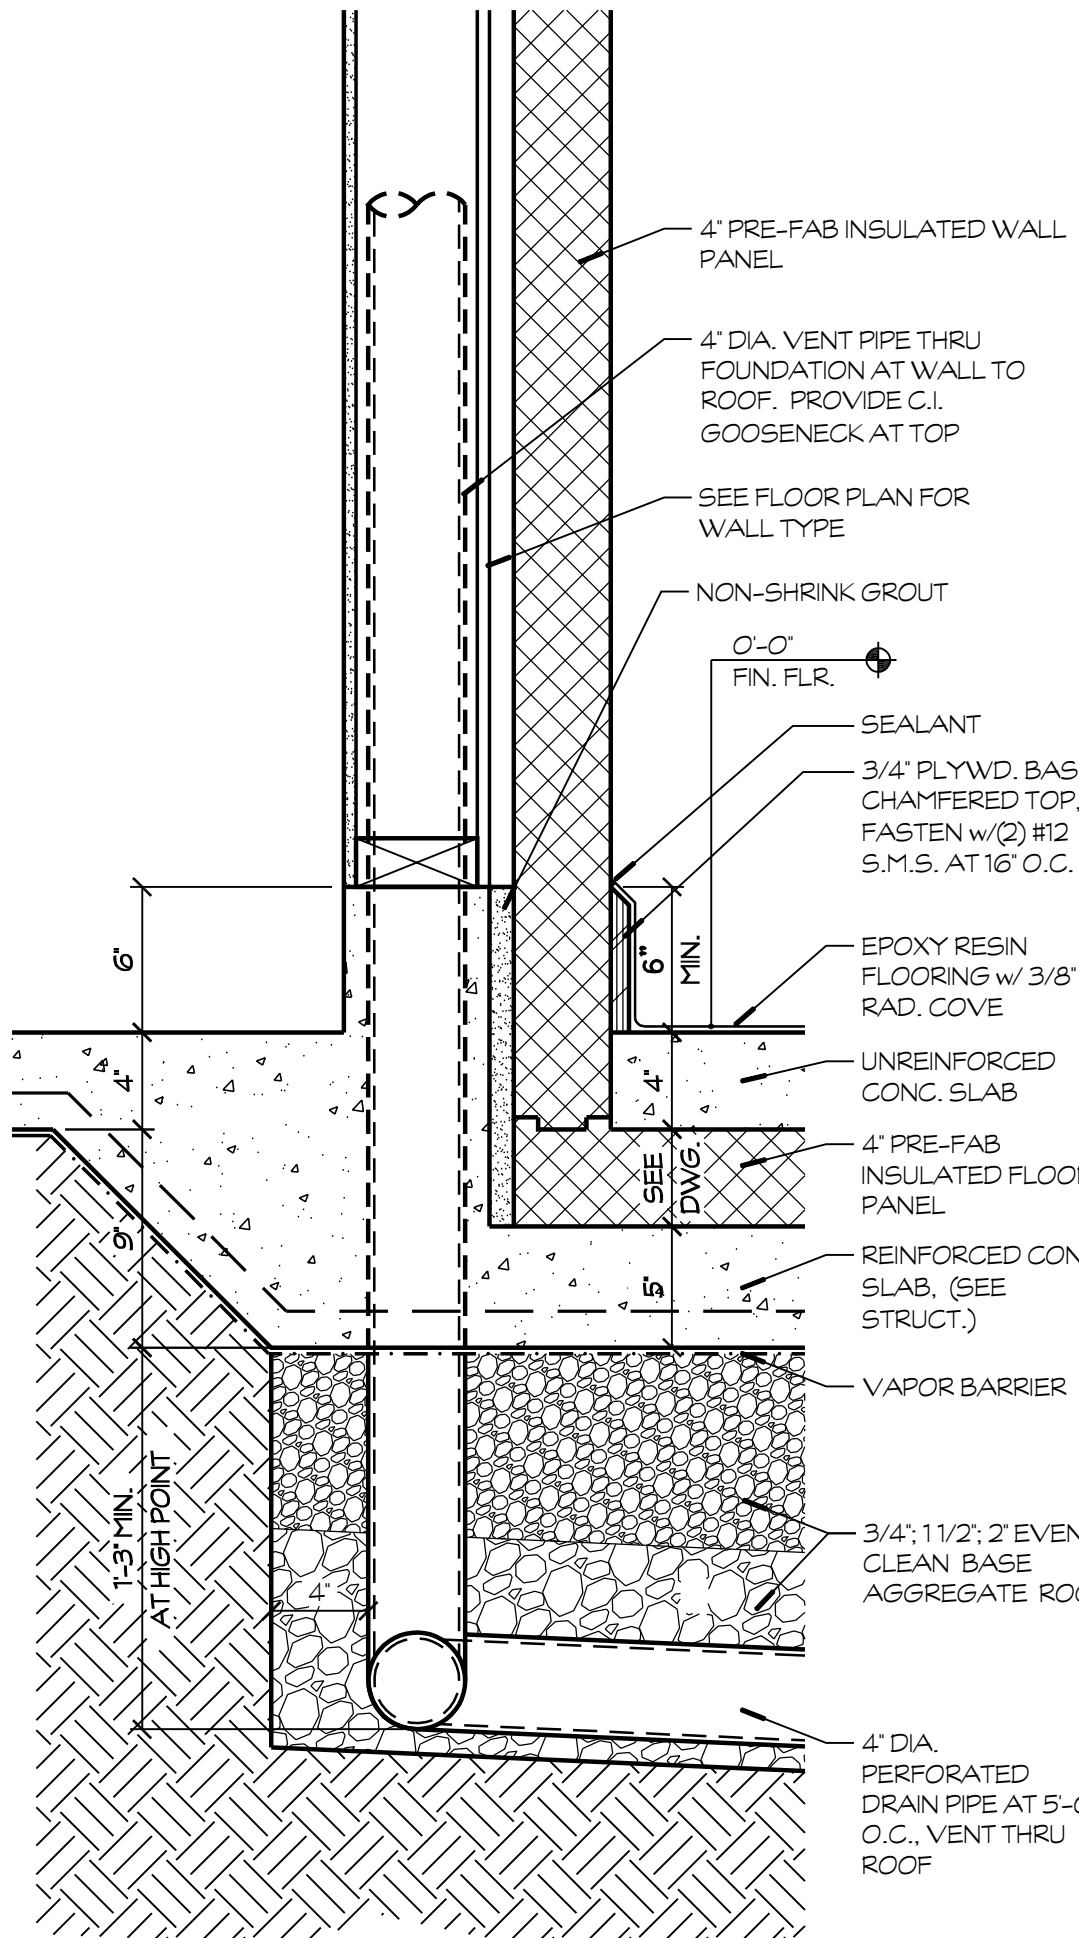


304 DRAIN AND VENT PIPE
AT FREEZER FLOOR
SCALE: 1 1/2" = 1'-0"
E:\08-47 central high school\details\interior\Perforated Drain and Vent Pipes.dwg 02/21/13 15:19

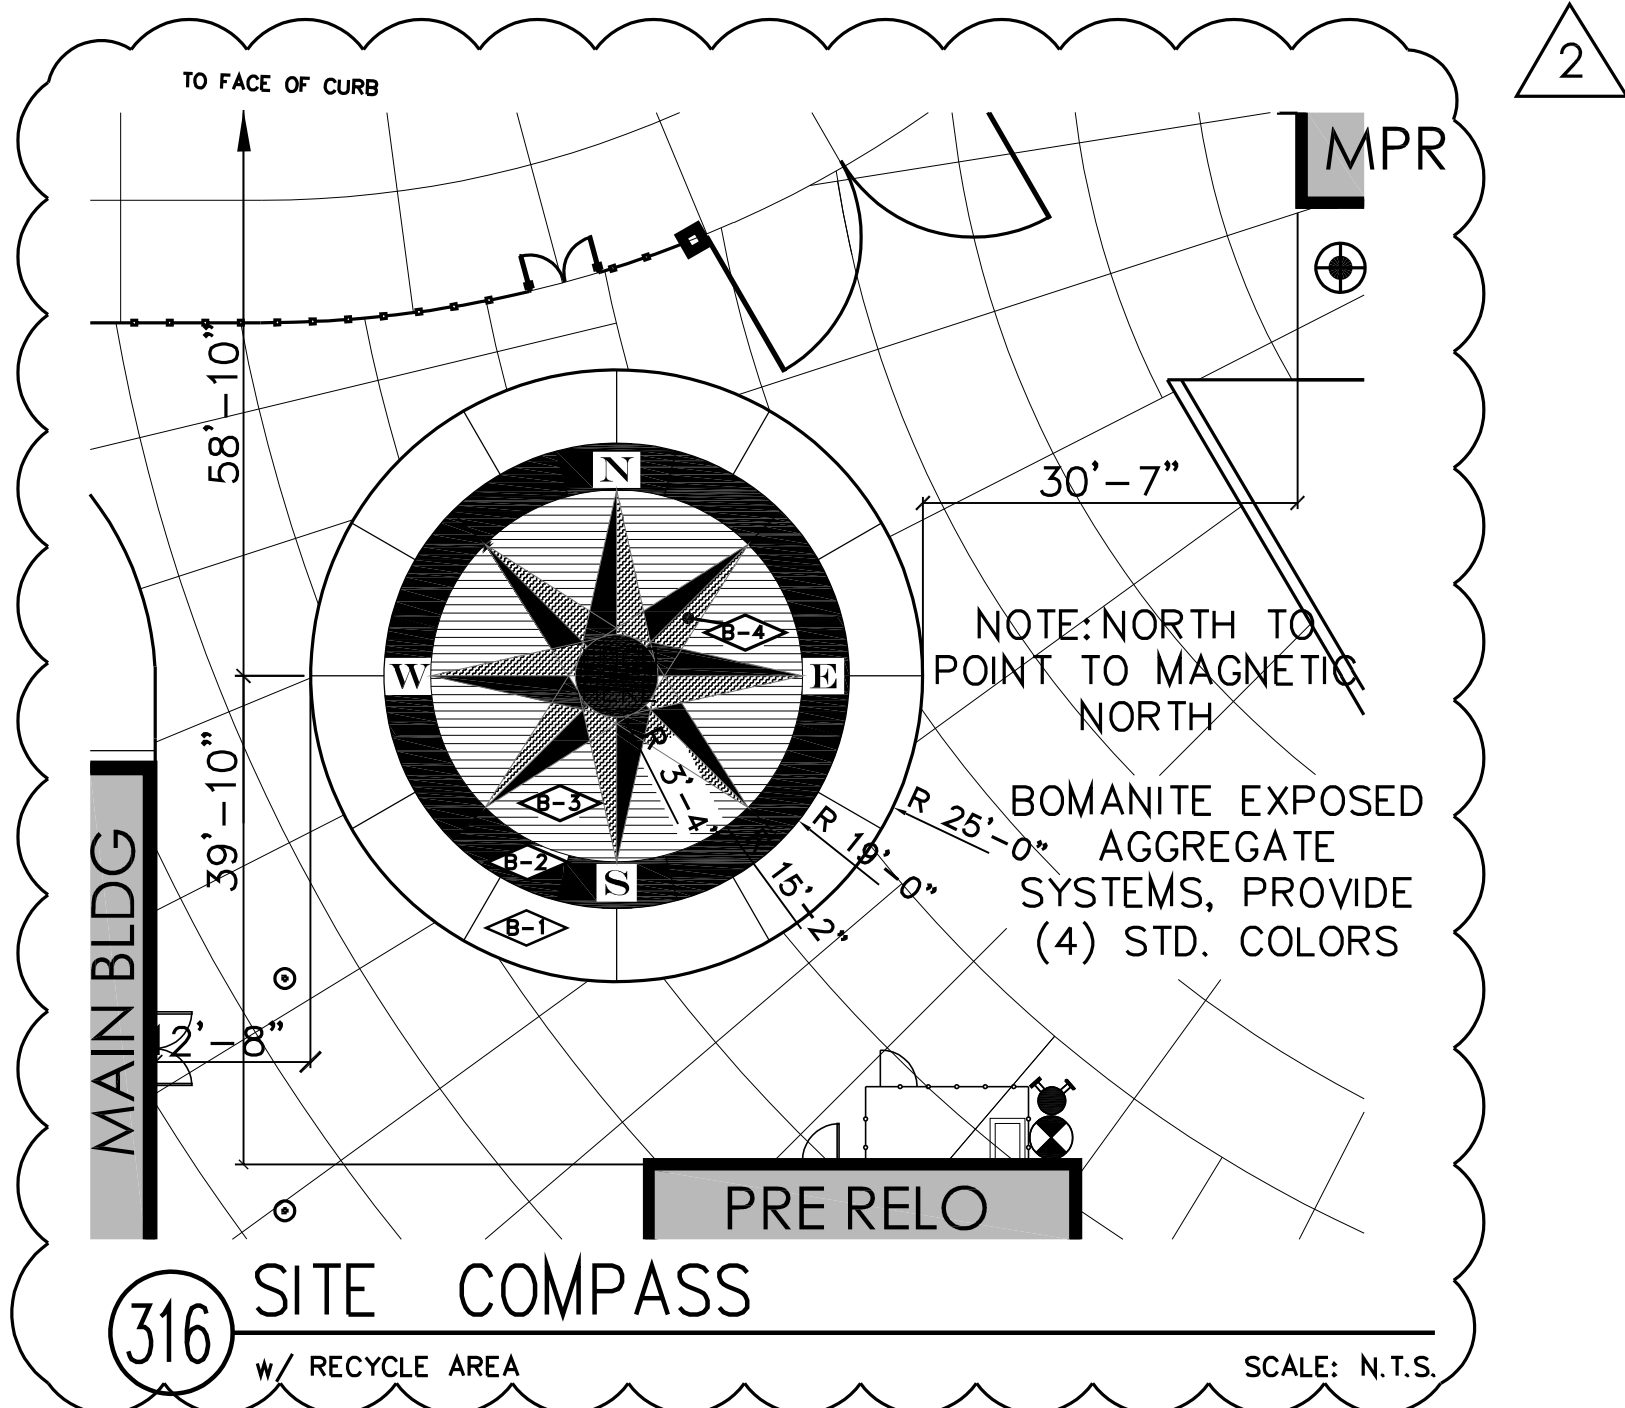

316 SITE COMPASS
SCALE: N.T.S.

SIMPRK
7790 NORTH PALM AVENUE
FRESNO, CALIFORNIA 93711
T 559.448.8400 · F 559.448.8467
www.sim-prk.com

PROJECT:
SHIELDS & BRAWLEY ELEMENTARY SCHOOL

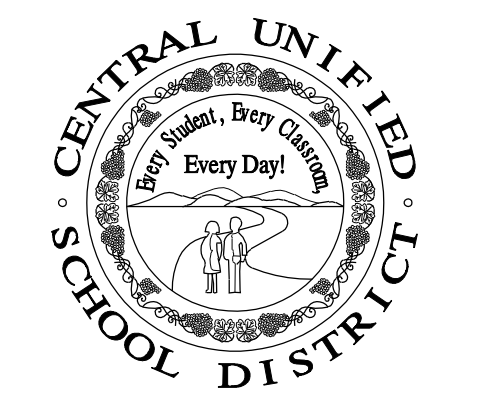

AD 2-41a
S&B Elementary
02-116800

JOHN H. SMITH, A.I.A. C15885
JOHN HAMILTON SMITH ARCHITECTS
C 15885
9-30-23
RENEWAL
STATE OF CALIFORNIA

THE FIRM OF SMITH HAMILTON SMITH ARCHITECTS, P.C. EXPRESSLY RESERVES ITS COMMON LAW COPYRIGHT AND OTHER APPLICABLE PROPERTY RIGHTS IN THESE PLANS. THESE PLANS ARE NOT TO BE REPRODUCED, CHANGED, OR LOANED IN ANY FORM OR MANNER WHATSOEVER, NOR ARE THEY TO BE ASSIGNED TO A THIRD PARTY WITHOUT FIRST OBTAINING THE WRITTEN PERMISSION AND CONSENT OF THE ARCHITECT. IN THE EVENT OF UNAUTHORIZED REUSE OF THESE PLANS BY A THIRD PARTY, THE THIRD PARTY SHALL HOLD THE ARCHITECT HARMLESS, AND SHALL BEAR THE COST OF THE ARCHITECT'S LEGAL FEES, ASSOCIATED WITH DEFENDING AND ENFORCING THESE RIGHTS.

| PROJECT DEVELOPMENT | |
|---------------------|------------|
| DATE | ISSUED FOR |
| | |
| | |
| | |

| REVISIONS | | |
|-----------|---------|------------------------|
| No. | DATE | DESCRIPTION |
| △ 2 | 2.14.23 | DISTRICT MODIFICATIONS |
| △ 1 | 2.27.23 | DISTRICT MODIFICATIONS |

| SHEET DESCRIPTION | |
|-----------------------------------|---------------------------|
| DETAILS | |
| PROJECT COORDINATOR JOHN SMITH | SHEET NO. A8.18 |
| PROJECT NO. 17-67 | |
| DATE 1.27.23 | |
| SCALE AS NOTED | |




7790 NORTH PALM AVENUE
 FRESNO, CALIFORNIA 93711
 T 559.448.8400 F 559.448.8467
 www.sim-pbk.com

PROJECT:
**SHIELDS
 & BRAWLEY
 ELEMENTARY
 SCHOOL**



601 POLLASKY AVE., STE. 301 TEL: (559) 449-2400
 CLOVIS, CA 93612 WWW.QKINC.COM
 © COPYRIGHT BY QK INC. UNAUTHORIZED USE PROHIBITED.

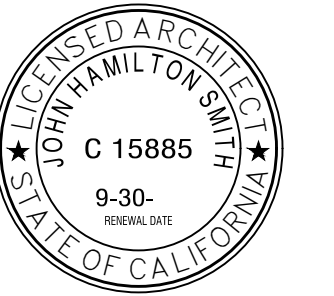

JOHN H. SMITH, A.I.A. C15885

THE FIRM OF SMITH, WANAMAKER, MILHOUSE, ARCHITECTS, INC. EXPRESSLY RESERVES ITS COMMON LAW COPYRIGHT AND OTHER AVAILABLE INHERENT RIGHTS IN THESE PLANS. THESE PLANS ARE NOT TO BE REPRODUCED, CHANGED, OR COPIED IN ANY FORM OR MANNER WITHOUT THE WRITTEN PERMISSION OF THE ARCHITECT. IN THE EVENT OF UNAUTHORIZED REUSE OF THESE PLANS BY A THIRD PARTY, THE THIRD PARTY SHALL HOLD THE ARCHITECT HARMLESS, AND SHALL BEAR THE COST OF THE ARCHITECT'S LEGAL FEES, ASSOCIATED WITH DEFENDING AND ENFORCING THESE RIGHTS.

**AD 2-44a
 S&B Elementary
 02-116800**


REVISIONS

| No. | DATE | DESCRIPTION |
|-----|---------|------------------------|
| △ | 2.14.23 | DISTRICT MODIFICATIONS |
| △ | 2.27.23 | DISTRICT MODIFICATIONS |

SHEET DESCRIPTION


DETAILS

| | |
|--|--------------------------|
| PROJECT COORDINATOR JOHN SMITH | SHEET No. C6.8 |
| PROJECT NO. 17-67 | |
| DATE 1.27.23 | |
| SCALE AS SHOWN | |

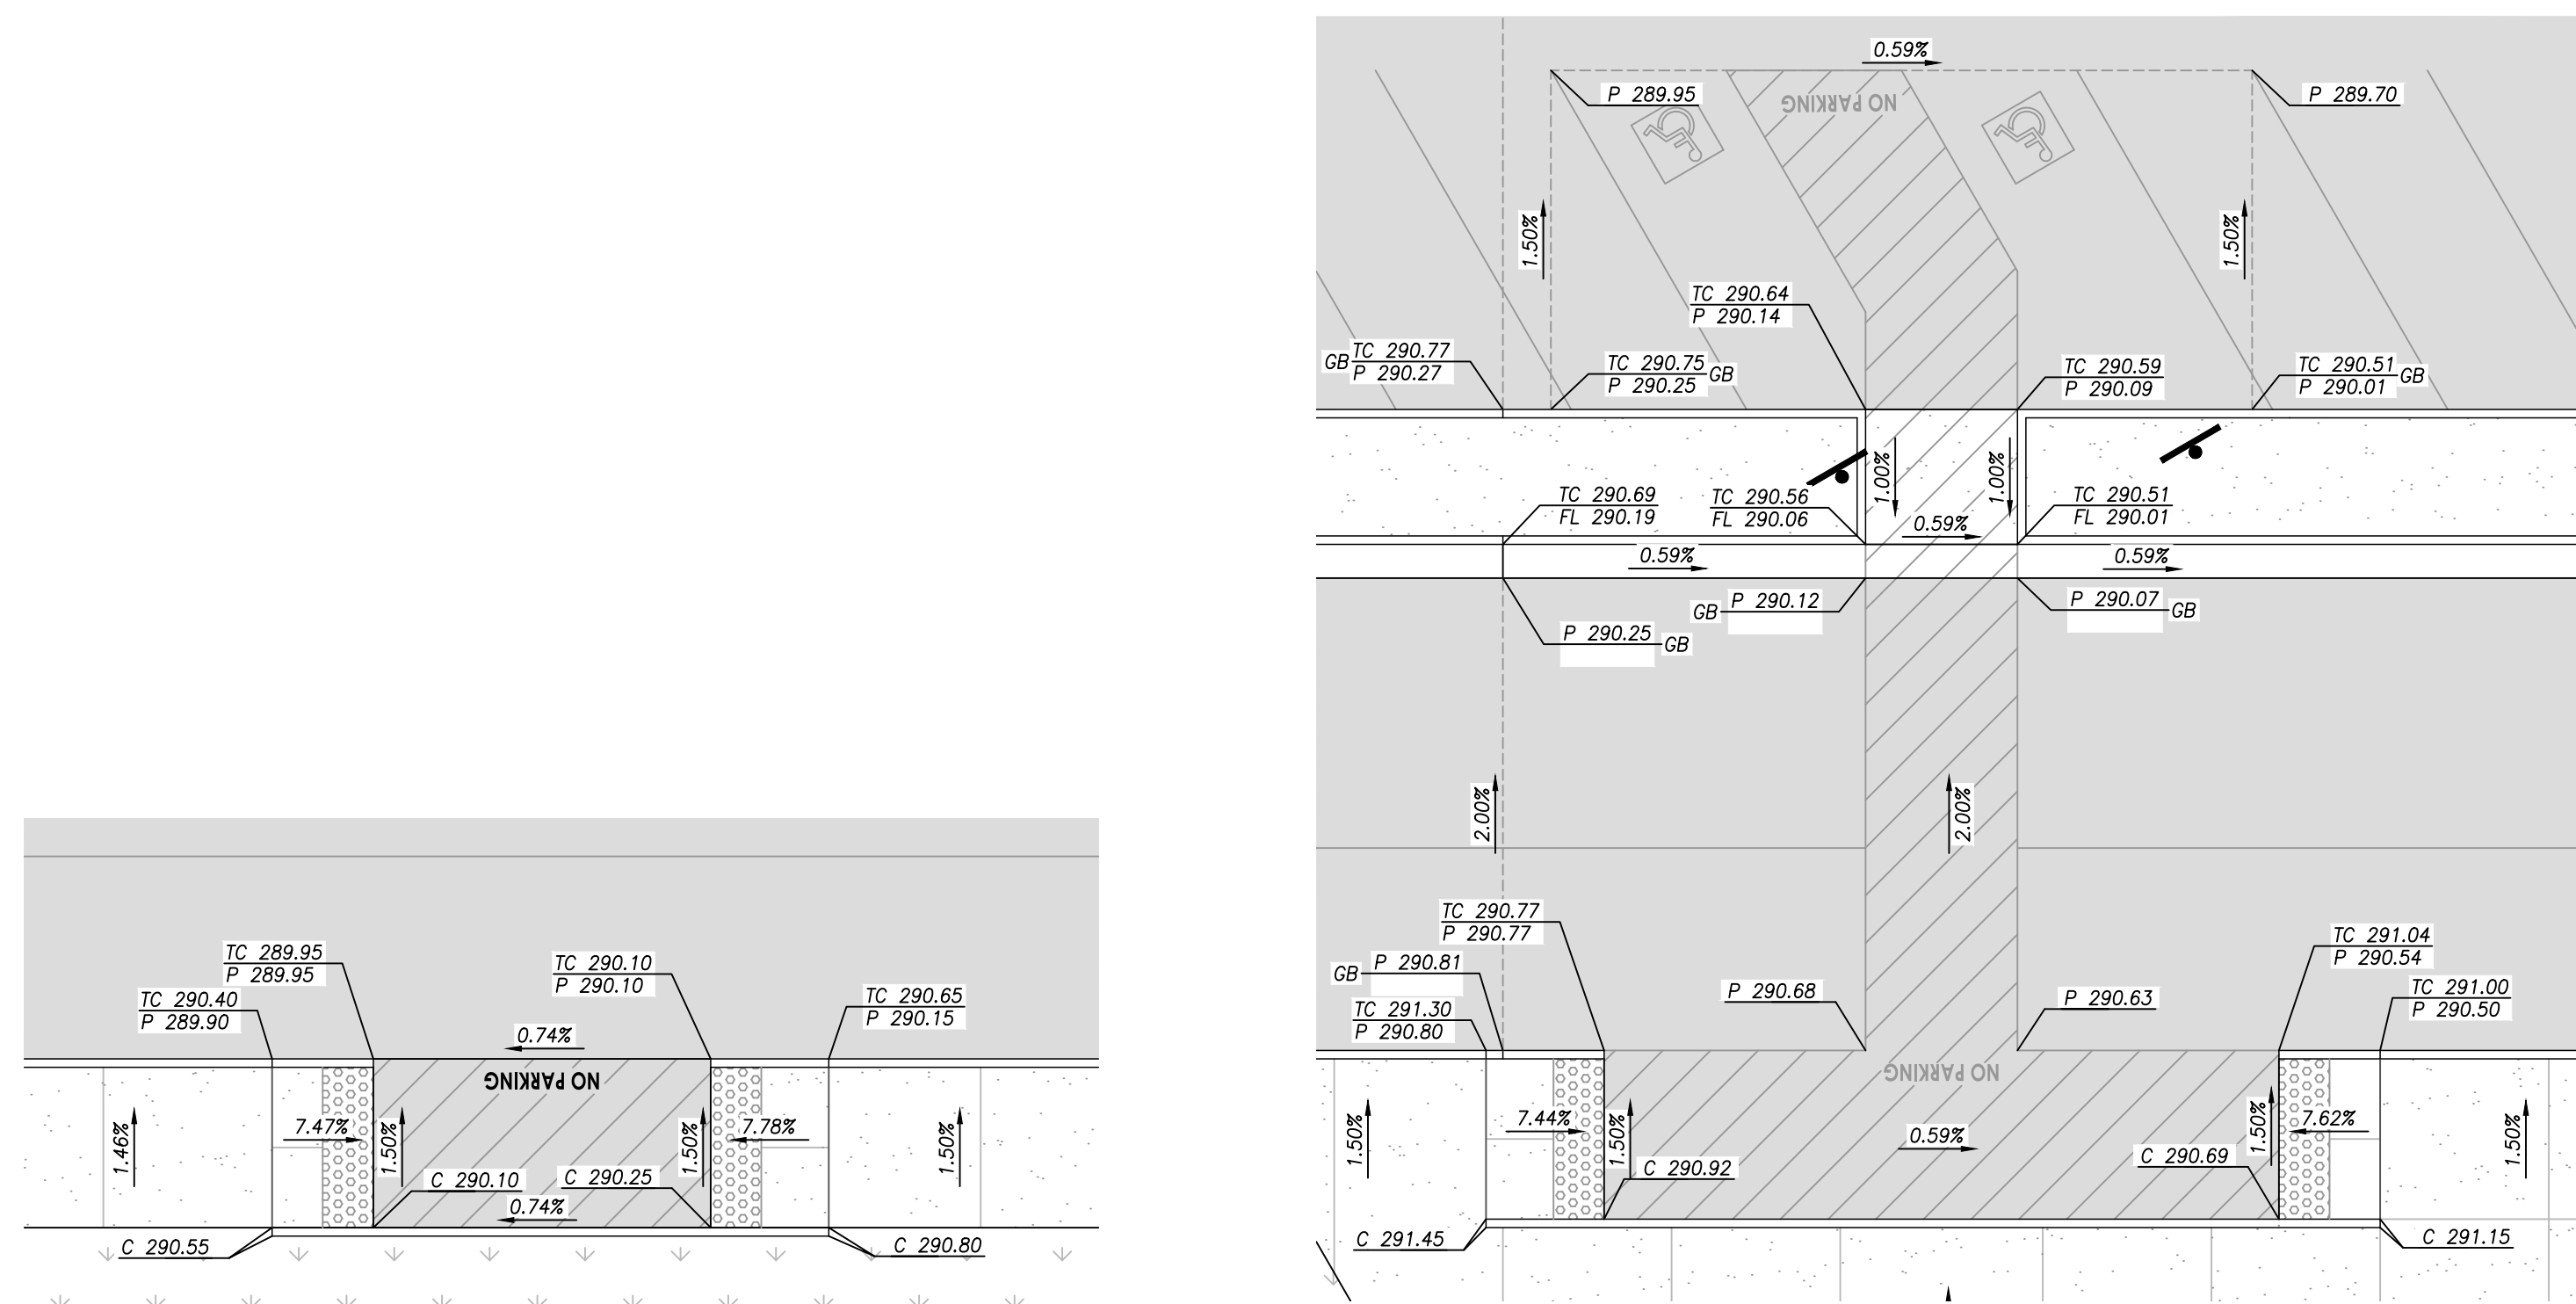


DETAIL A - CURB RAMP
 SCALE: 1"=10'

DETAIL B - CURB RAMP
 SCALE: 1"=10'

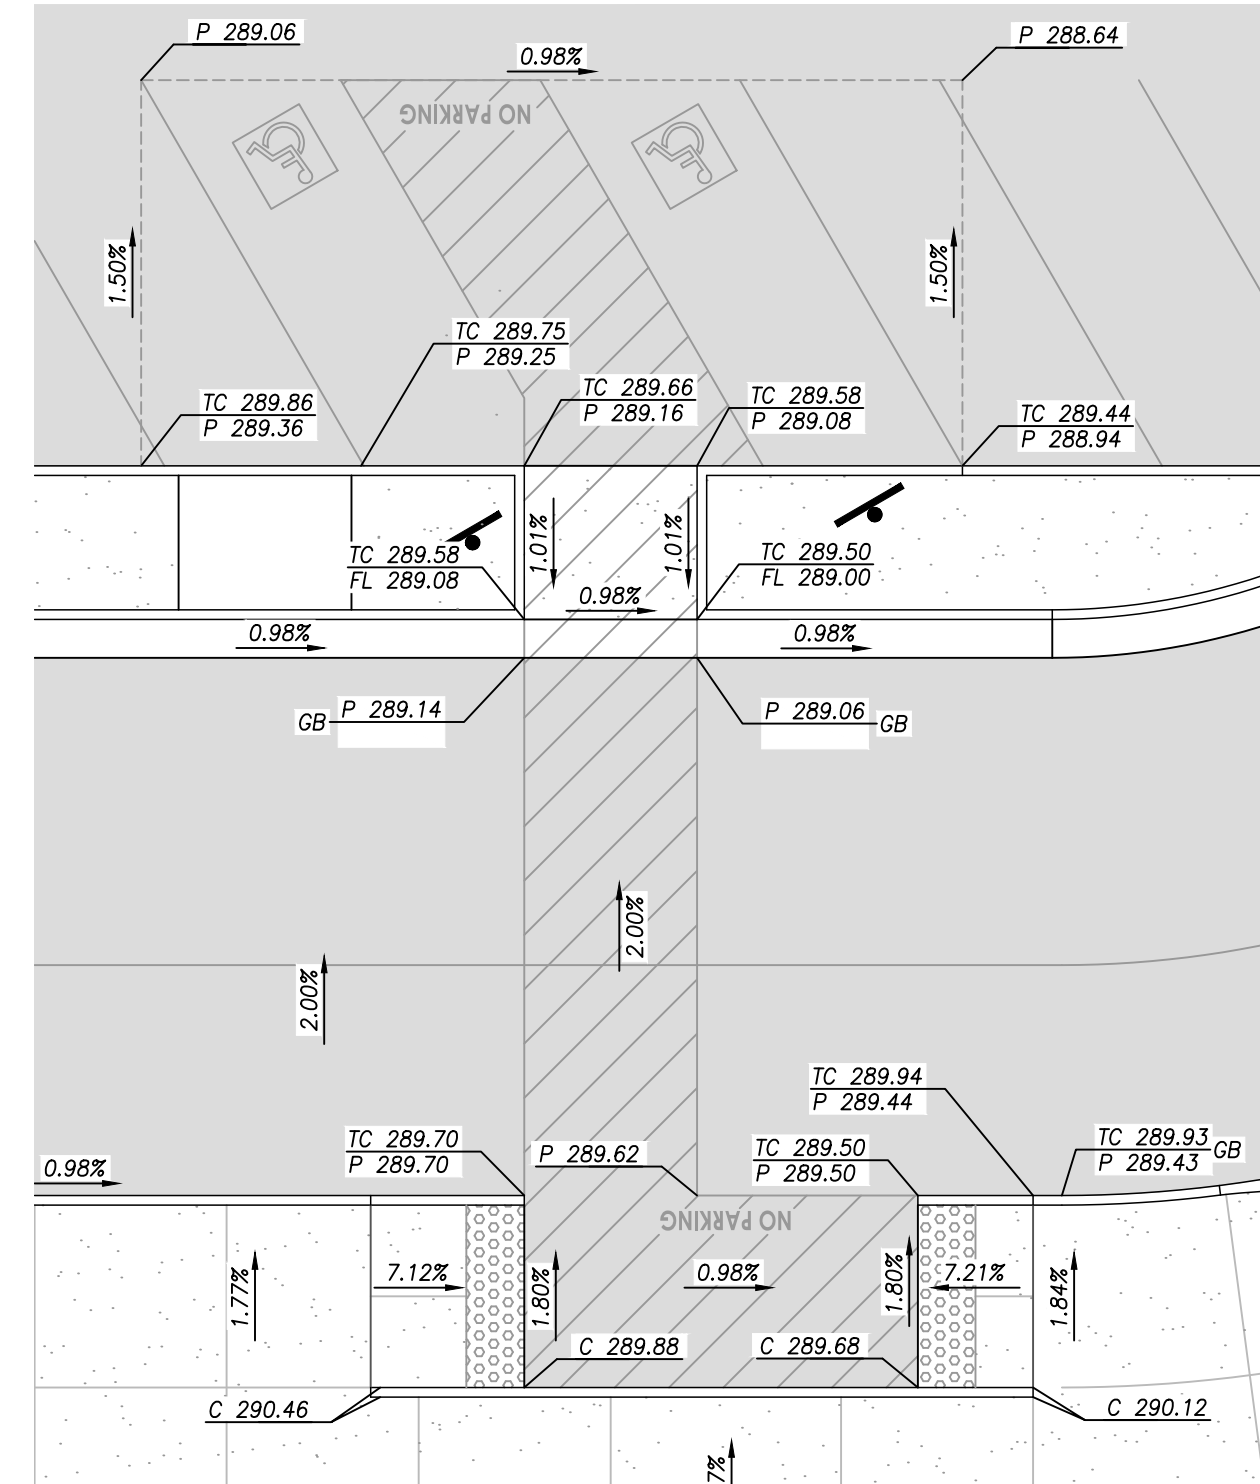

DETAIL C - CURB RAMP
 SCALE: 1"=10'





DETAIL E - CURB RAMP
 SCALE: 1"=10'

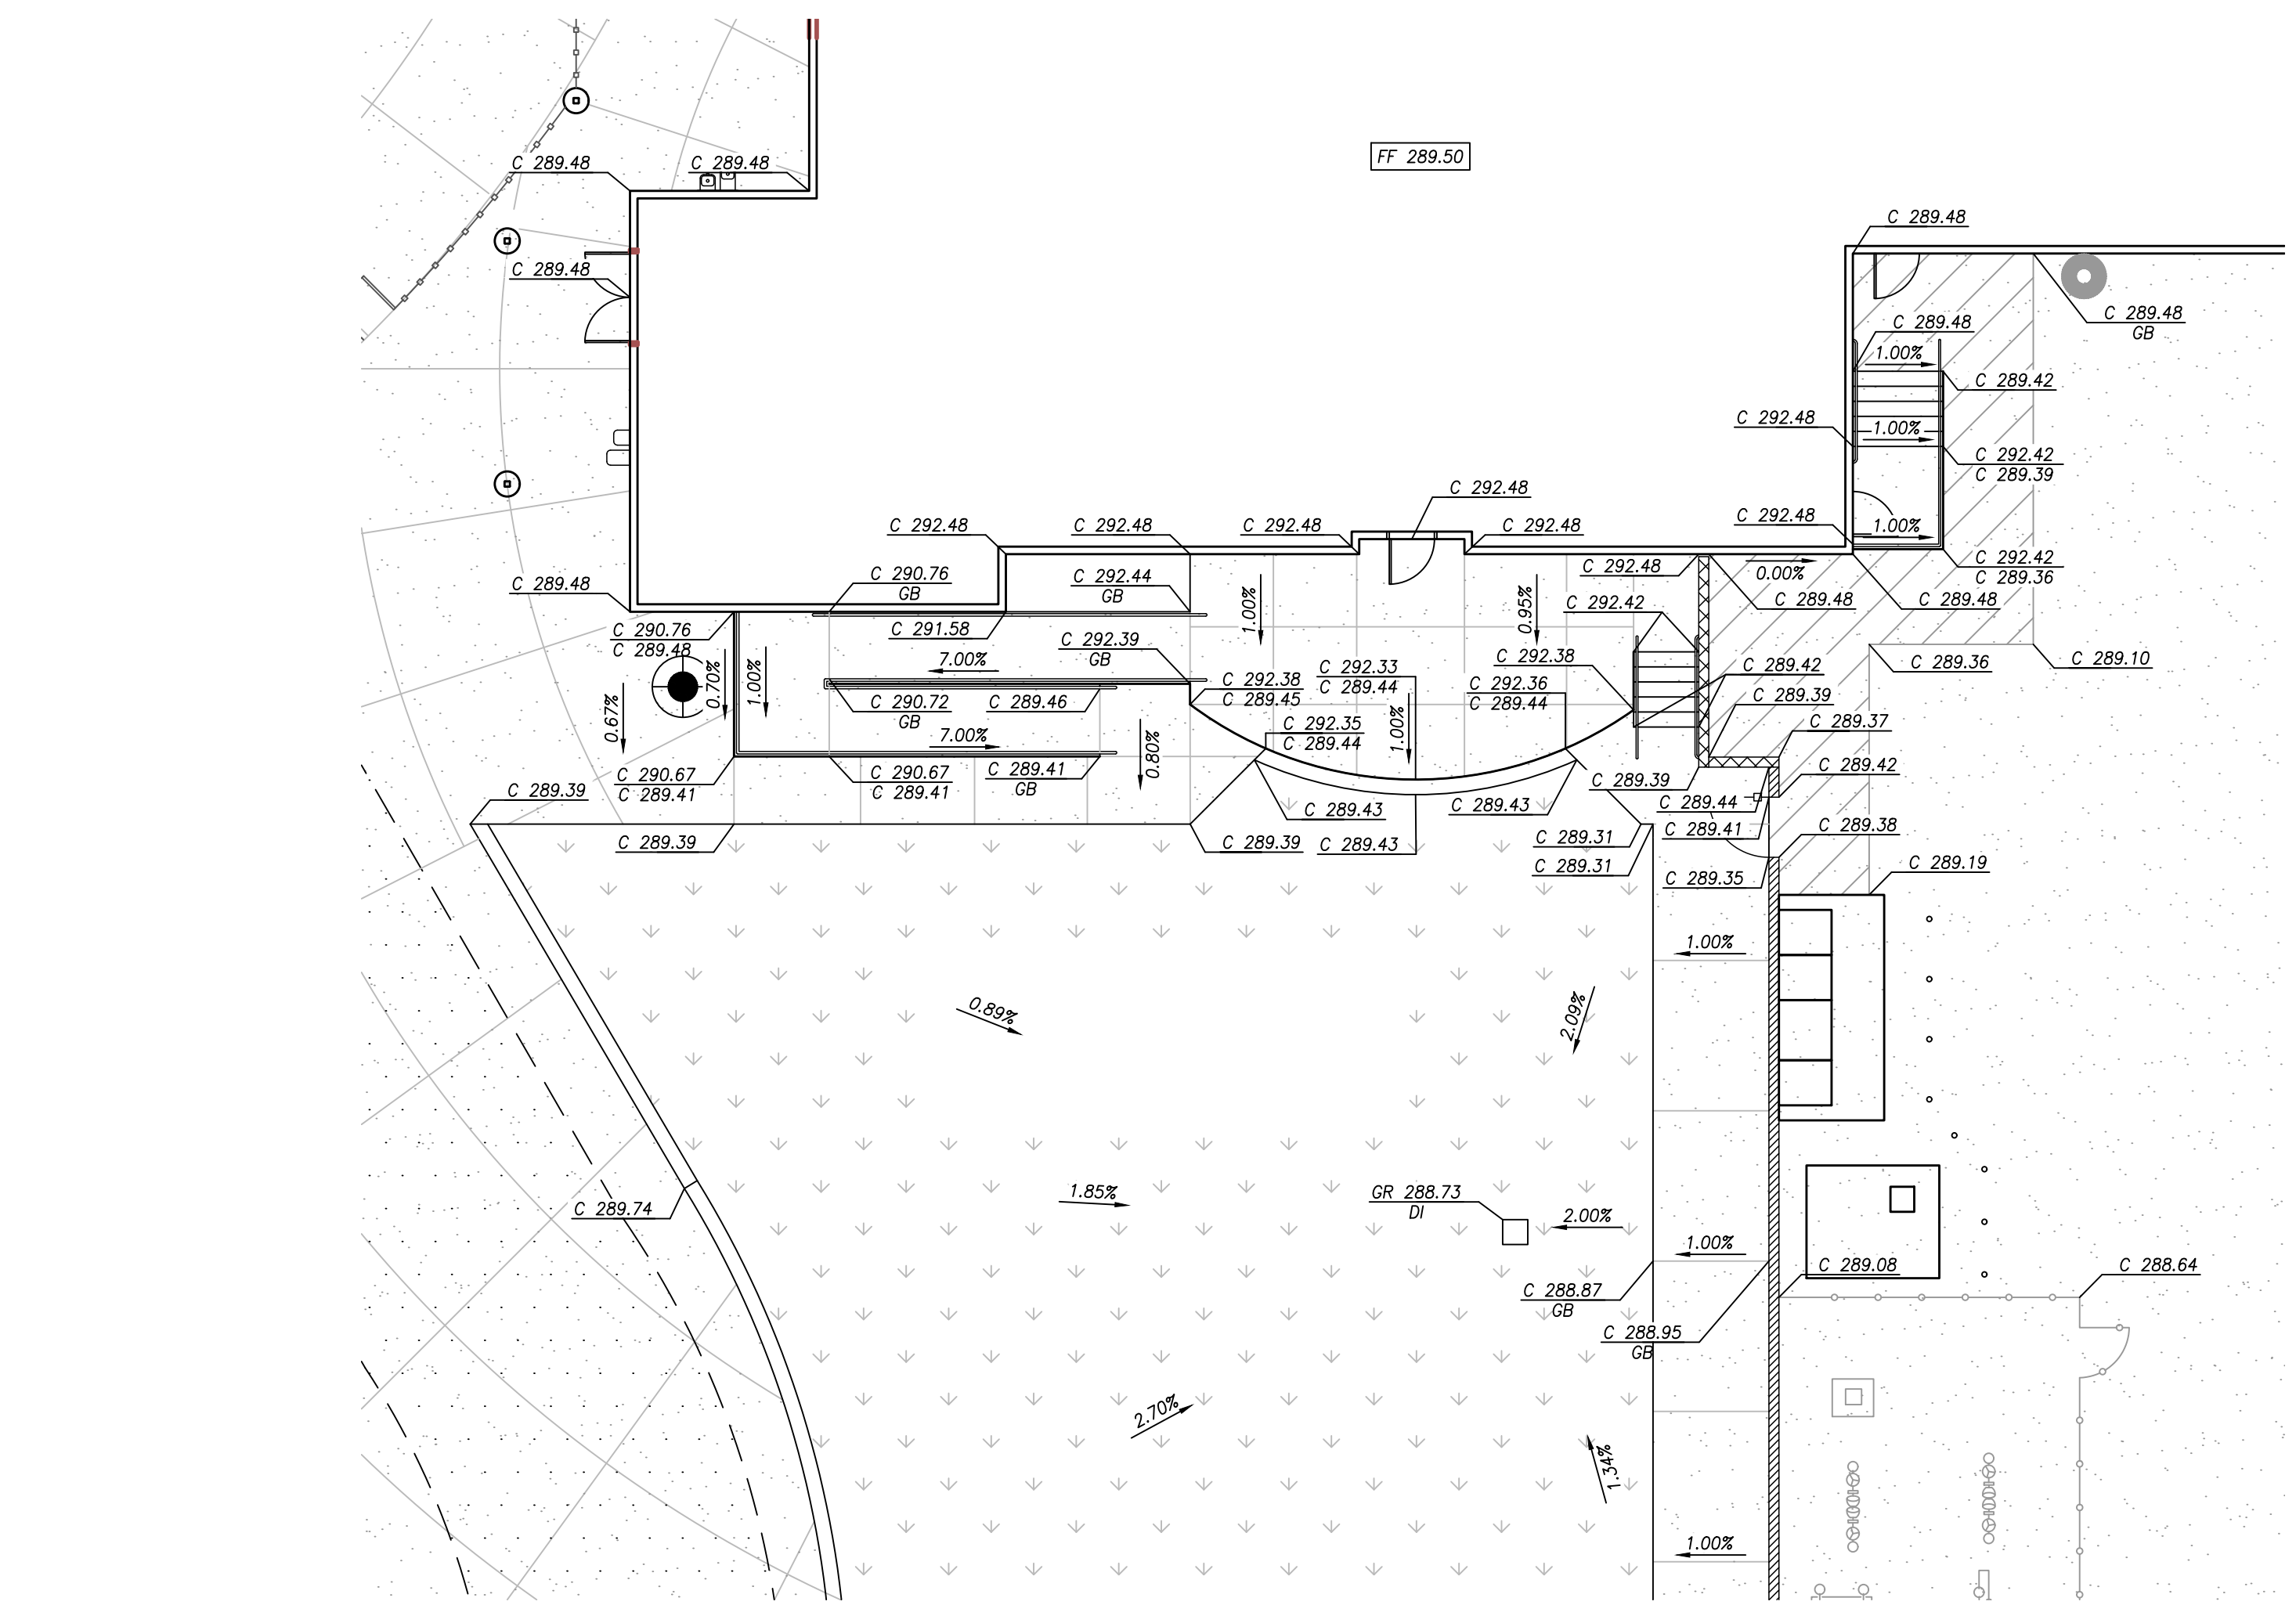

DETAIL D - AMPHITHEATER DETAIL
 SCALE: 1"=10'

I:\PROJECTS\2018\180155\ACAD\IMPROVEMENTS\180155-C6A01G-DTL.DWG 2/16/2023 4:01 PM

2

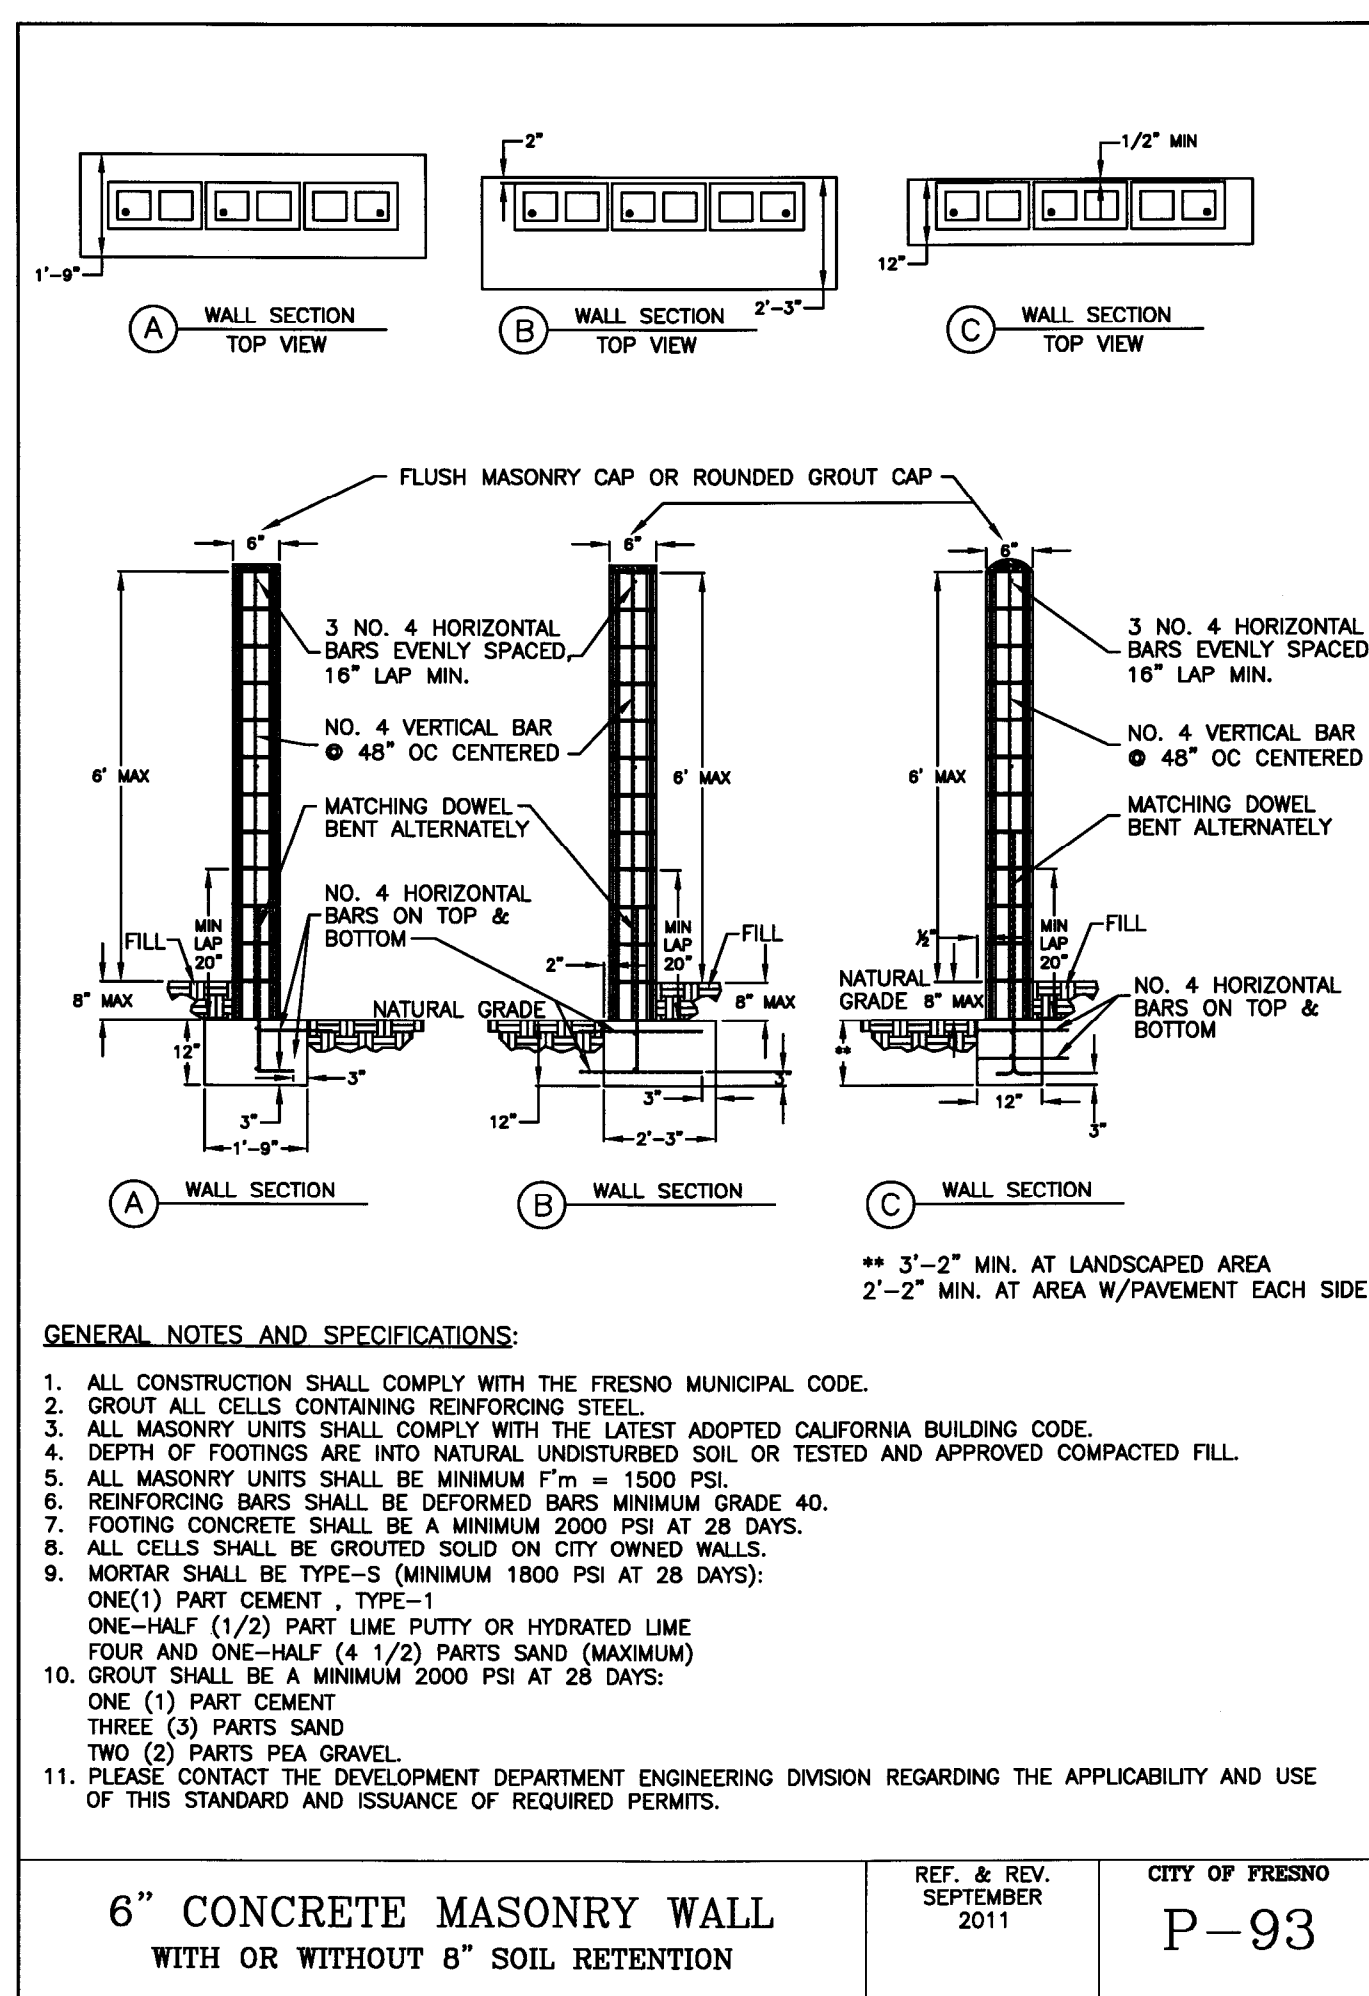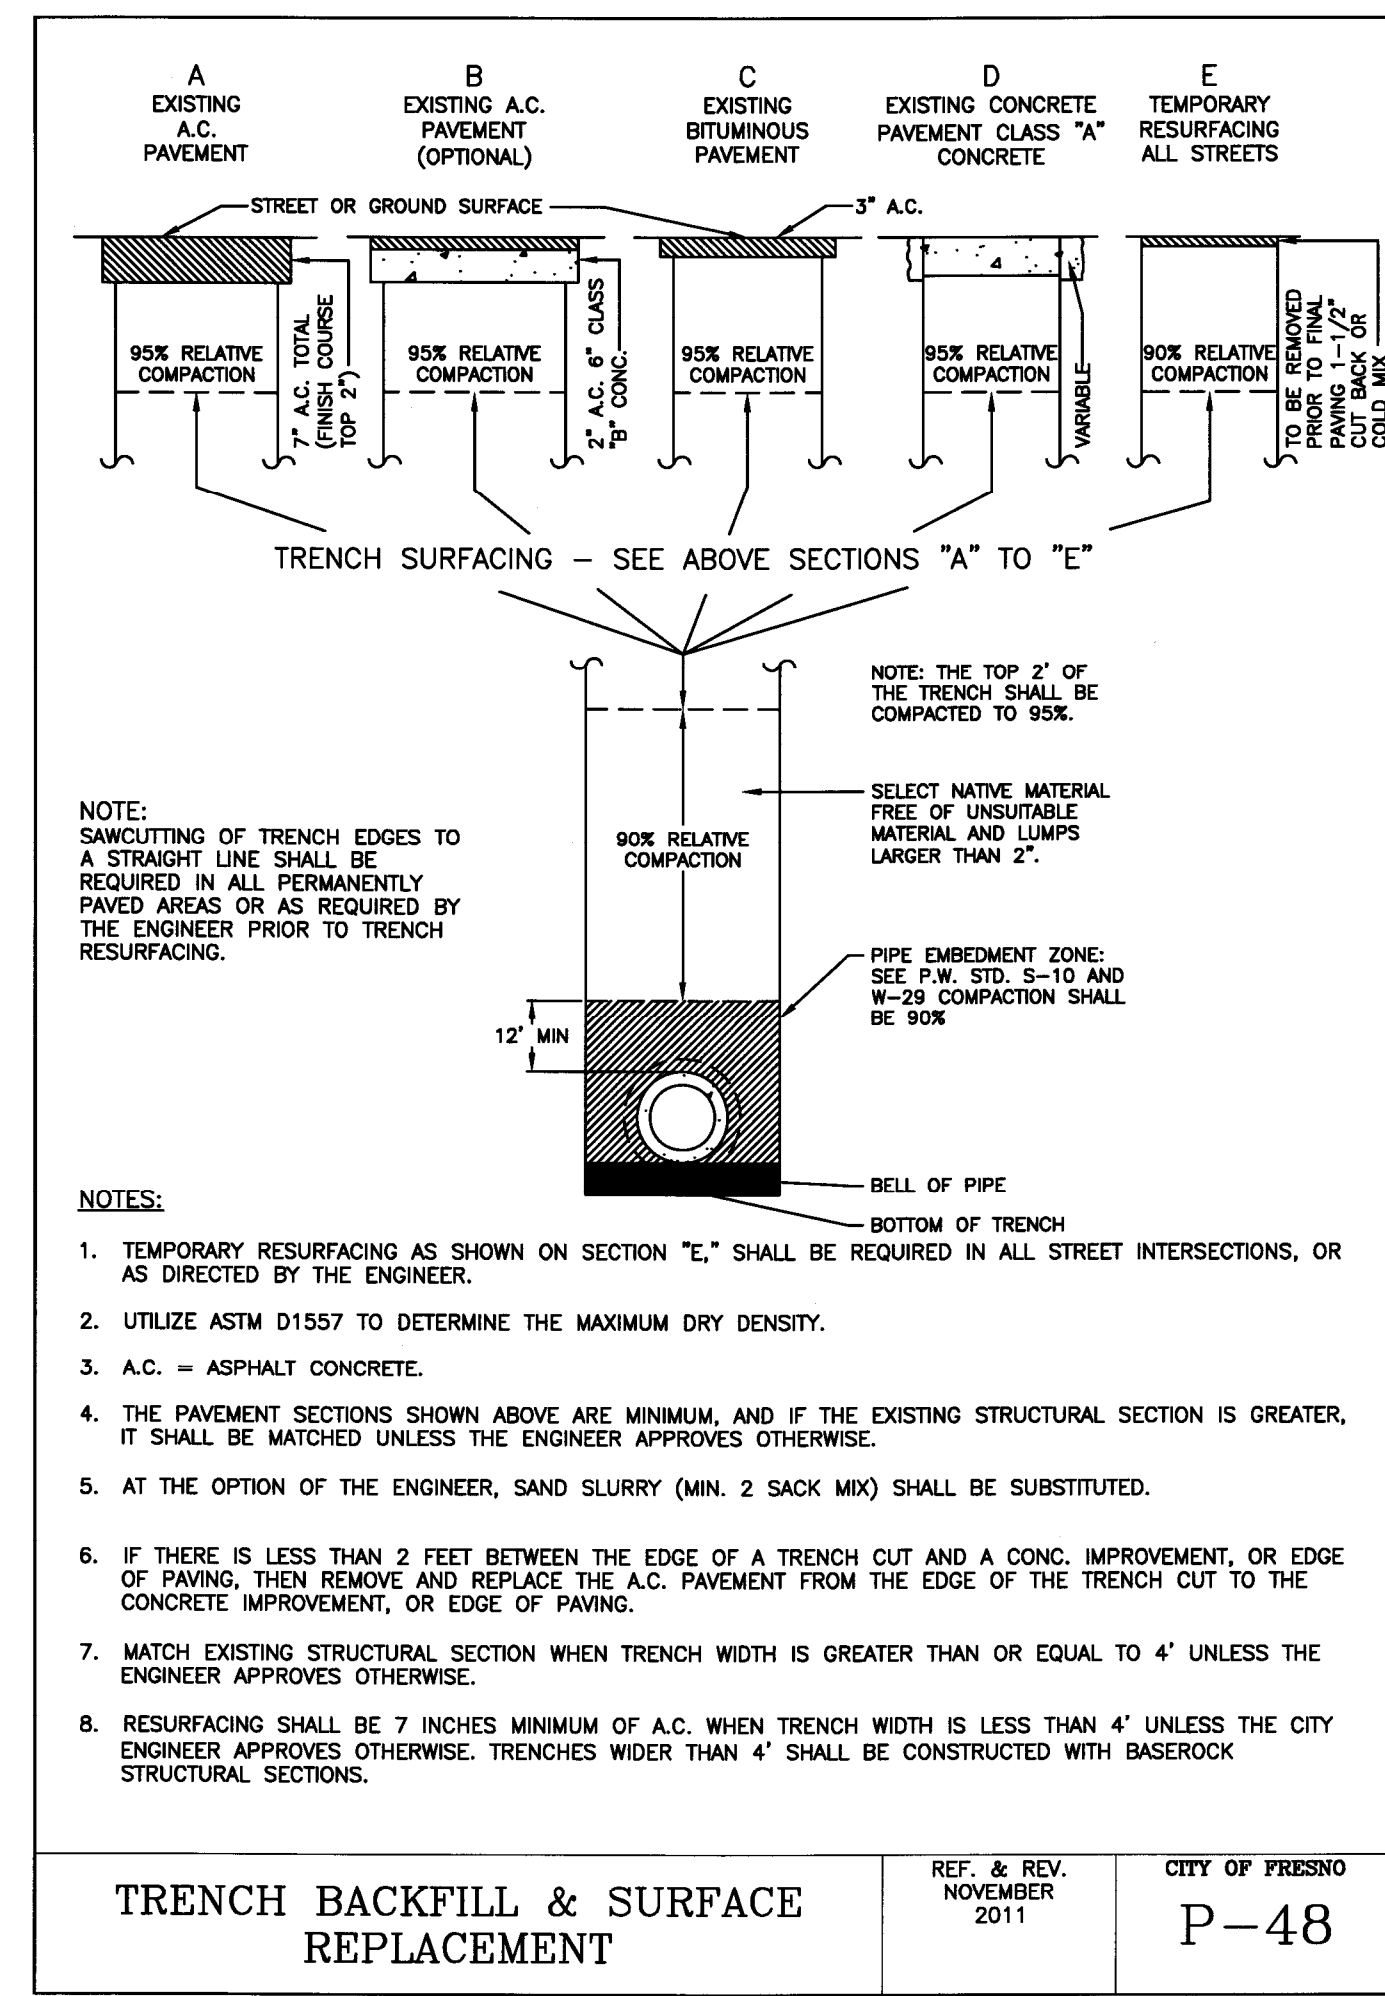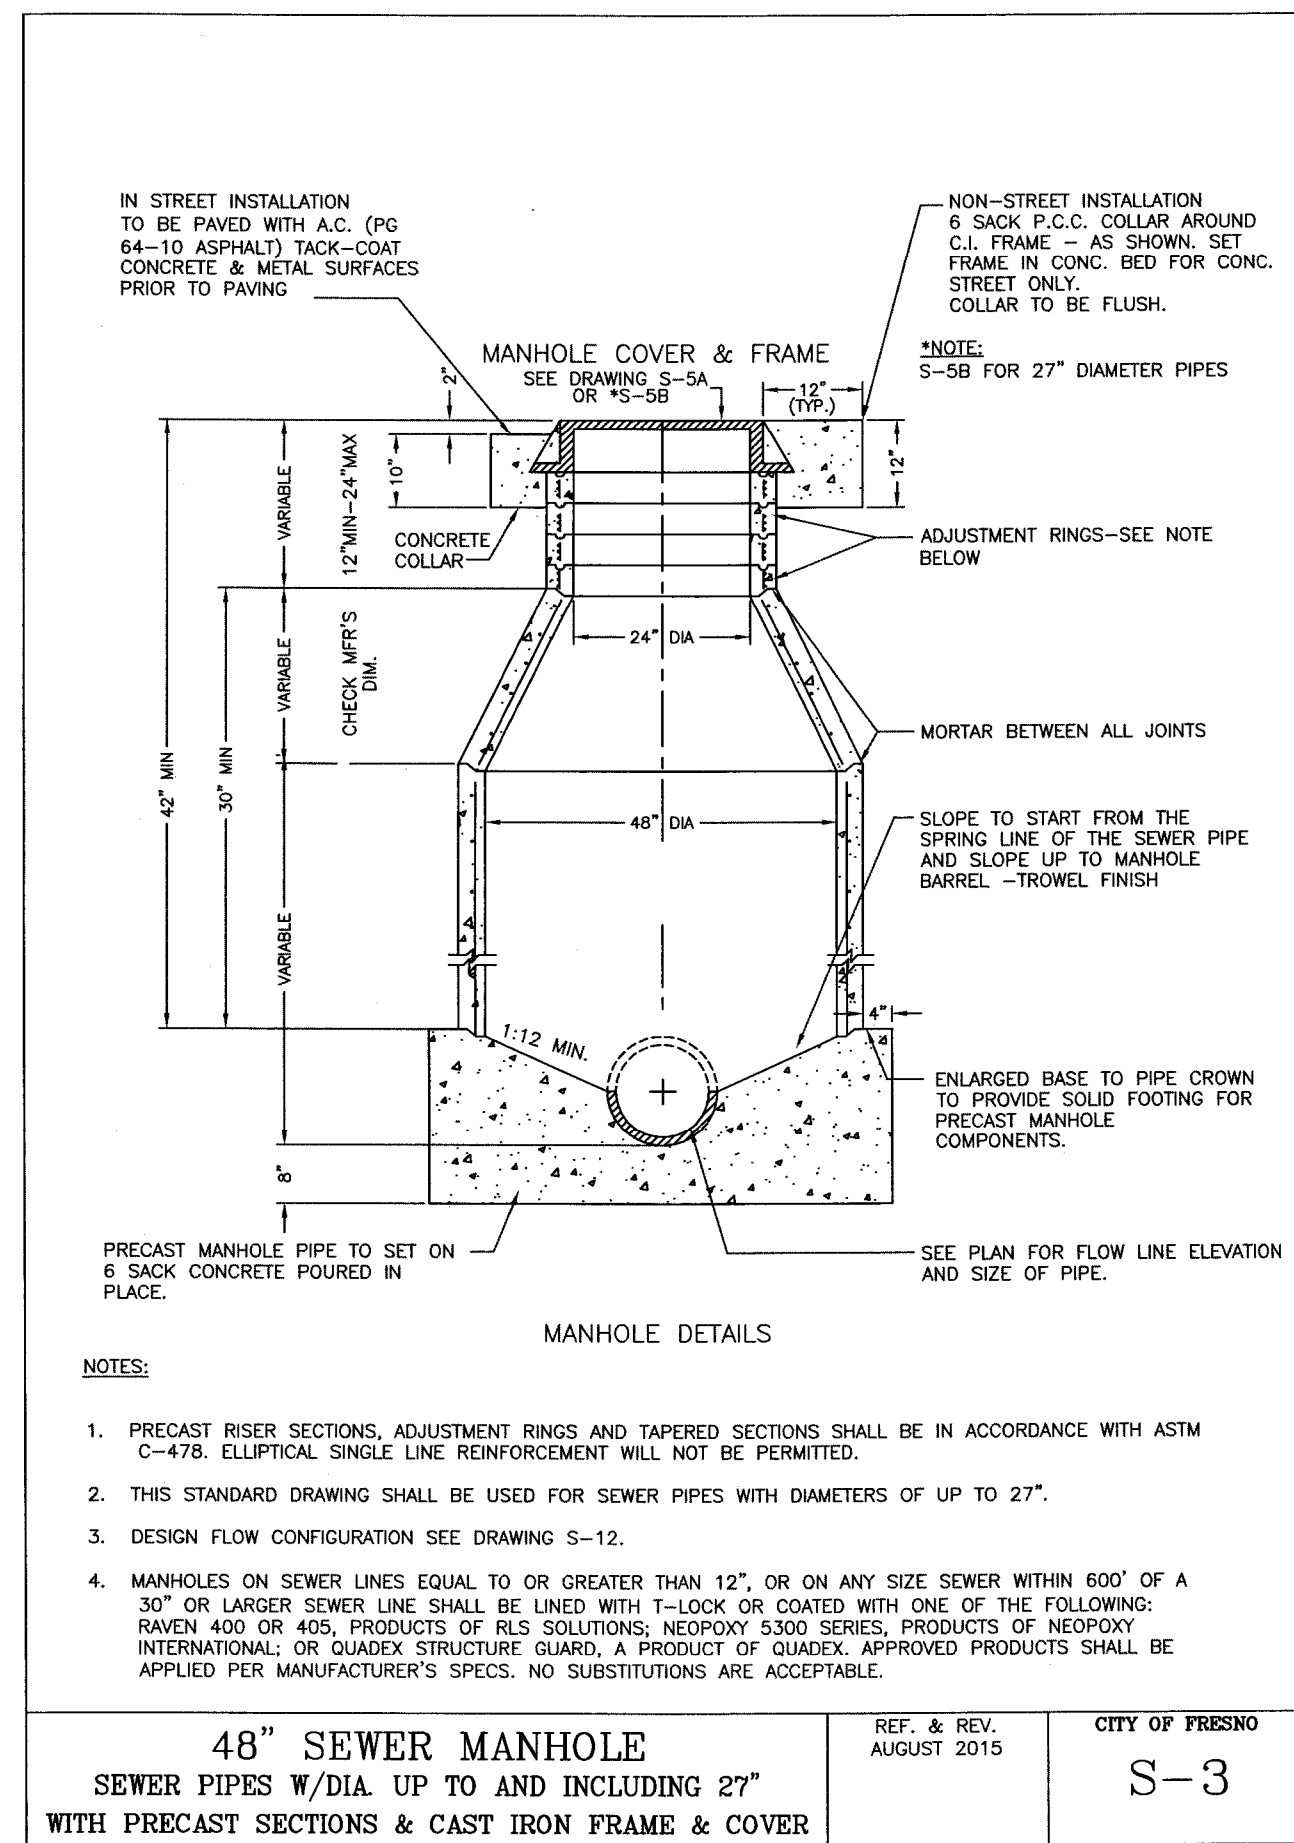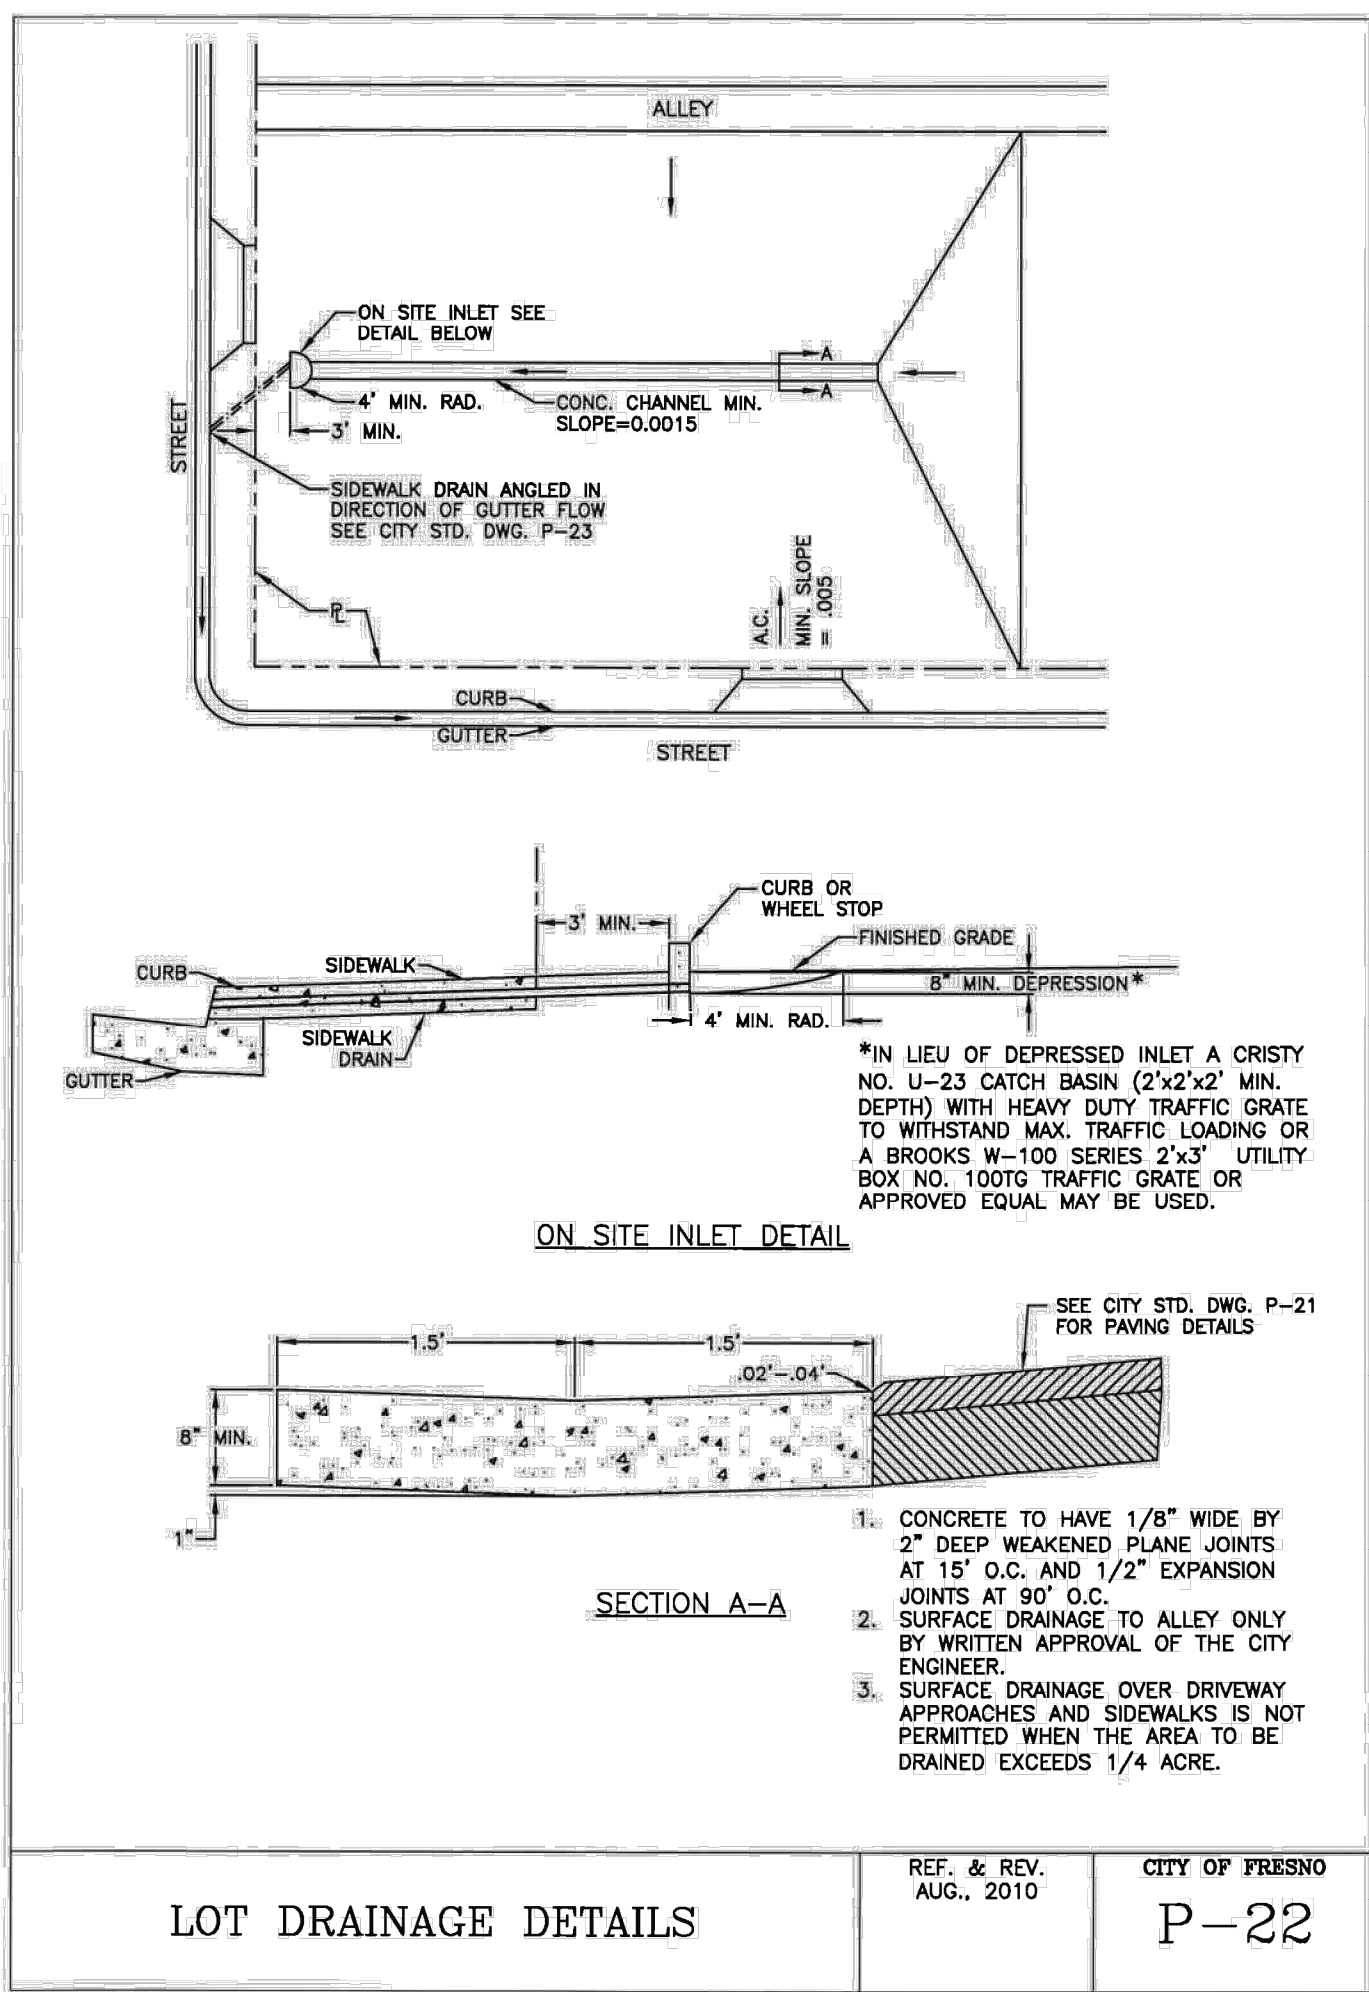


THRUST BLOCK SCHEDULE

| PIPE SIZE | FITTING | TYPE OF SOIL | | | | | | | | |
|-----------|-----------------|-----------------------------|------------------|-----------------------------|------------------|-----------------------------|------------------|------|-----|-----|
| | | SOFT CLAY (100 P.S.F.) | | SAND (2000 P.S.F.) | | ROCK (3000 P.S.F.) | | | | |
| | | MIN. BEARING AREA (SQ. FT.) | DIMENSION (FEET) | MIN. BEARING AREA (SQ. FT.) | DIMENSION (FEET) | MIN. BEARING AREA (SQ. FT.) | DIMENSION (FEET) | | | |
| 6" | PLUG, CAP | 6 | 3 | 2 | 3 | 2 | 1.5 | 2 | 2 | 1 |
| | 90° ELL | 6 | 3.2 | 2.5 | 4.1 | 2.7 | 1.5 | 3 | 2 | 1.5 |
| | 45° ELL | 4.4 | 2.2 | 2 | 2.3 | 1.5 | 1.5 | 1.5 | 1.5 | 1 |
| | TEE W/ 90° ELL | 2.3 | 1.5 | 1.5 | 1 | 1 | 1 | 1 | 1 | 1 |
| 8" | PLUG, CAP | 10 | 4 | 2.5 | 5 | 2.5 | 2 | 3.5 | 2.2 | 1.5 |
| | 90° ELL | 14 | 4 | 3.5 | 7 | 2.8 | 2.5 | 3 | 2.5 | 2 |
| | 45° ELL | 7.5 | 3 | 2.5 | 3.8 | 2 | 1.9 | 2.8 | 1.7 | 1.5 |
| | TEE W/ 90° ELL | 4 | 2 | 2 | 2 | 2 | 1 | 1.5 | 1.5 | 1 |
| 12" | PLUG, CAP | 24 | 6 | 4 | 12 | 4 | 3 | 7.5 | 3 | 2.5 |
| | 90° ELL | 32.5 | 6.5 | 5 | 16.1 | 4.6 | 3.5 | 10.8 | 3.6 | 3 |
| | 45° ELL | 17.5 | 5 | 3.5 | 8.8 | 3.5 | 2.5 | 6 | 3 | 2 |
| | TEE W/ 90° ELL | 9 | 3.6 | 2.5 | 4.6 | 2.3 | 2 | 3 | 2 | 1.5 |
| 14" | PLUG, CAP | 31.5 | 6.3 | 5 | 15.8 | 4.5 | 3.5 | 10.5 | 3.5 | 3 |
| | 90° ELL | 44.4 | 7.4 | 6 | 22 | 5.5 | 4 | 14.7 | 4.2 | 3.5 |
| | 45° ELL | 24 | 6 | 4 | 12 | 4 | 3 | 8.1 | 3 | 2.7 |
| | TEE W/ 140° ELL | 31.5 | 6.3 | 5 | 15.8 | 4.5 | 3.5 | 10.5 | 3.5 | 3 |
| 16" | PLUG, CAP | 40.7 | 7.4 | 5.5 | 20 | 5 | 4 | 13.5 | 4.5 | 3 |
| | 90° ELL | 56 | 8 | 7 | 28.8 | 6.4 | 4.5 | 20 | 5 | 4 |
| | 45° ELL | 31 | 6.2 | 5 | 15.8 | 4.5 | 3.5 | 10.5 | 3.5 | 3 |
| | TEE W/ 160° ELL | 15.8 | 4.5 | 3.5 | 7.8 | 3 | 2.6 | 5.2 | 2.6 | 2 |
| 18" | PLUG, CAP | 52 | 8 | 6.5 | 28.4 | 6.8 | 4 | 17.5 | 5 | 3.5 |
| | 90° ELL | 75 | 10 | 7.5 | 37 | 7.4 | 5 | 24.8 | 6.2 | 4 |
| | 45° ELL | 40.7 | 7.4 | 5.5 | 20 | 5 | 4 | 14 | 4 | 3.5 |
| | TEE W/ 180° ELL | 20 | 5 | 4 | 10.5 | 3.5 | 3 | 6.9 | 3 | 2.3 |

GENERAL NOTES AND SPECIFICATIONS:

- THRUST BLOCKS DESIGNED FOR A MAXIMUM OF 150 PSI WATER PRESSURE.
- ALL CONCRETE SHALL CONTAIN 6 SACKS OF CEMENT PER CUBIC YARD.
- THRUST BLOCKS SHALL BE POURED AGAINST UNDISTURBED SOIL.
- KEEP ALL CONCRETE CLEAR OF THE JOINTS ON ALL FITTINGS.
- FORMS ARE REQUIRED ON ALL THRUST BLOCKS AND TO BE SUPPLIED BY CONTRACTOR.
- ALL FITTINGS TO BE WRAPPED WITH POLYETHYLENE PRIOR TO POURING THRUST BLOCKS.

CW 435R4 TYPICAL THRUST BLOCK INSTALLATION

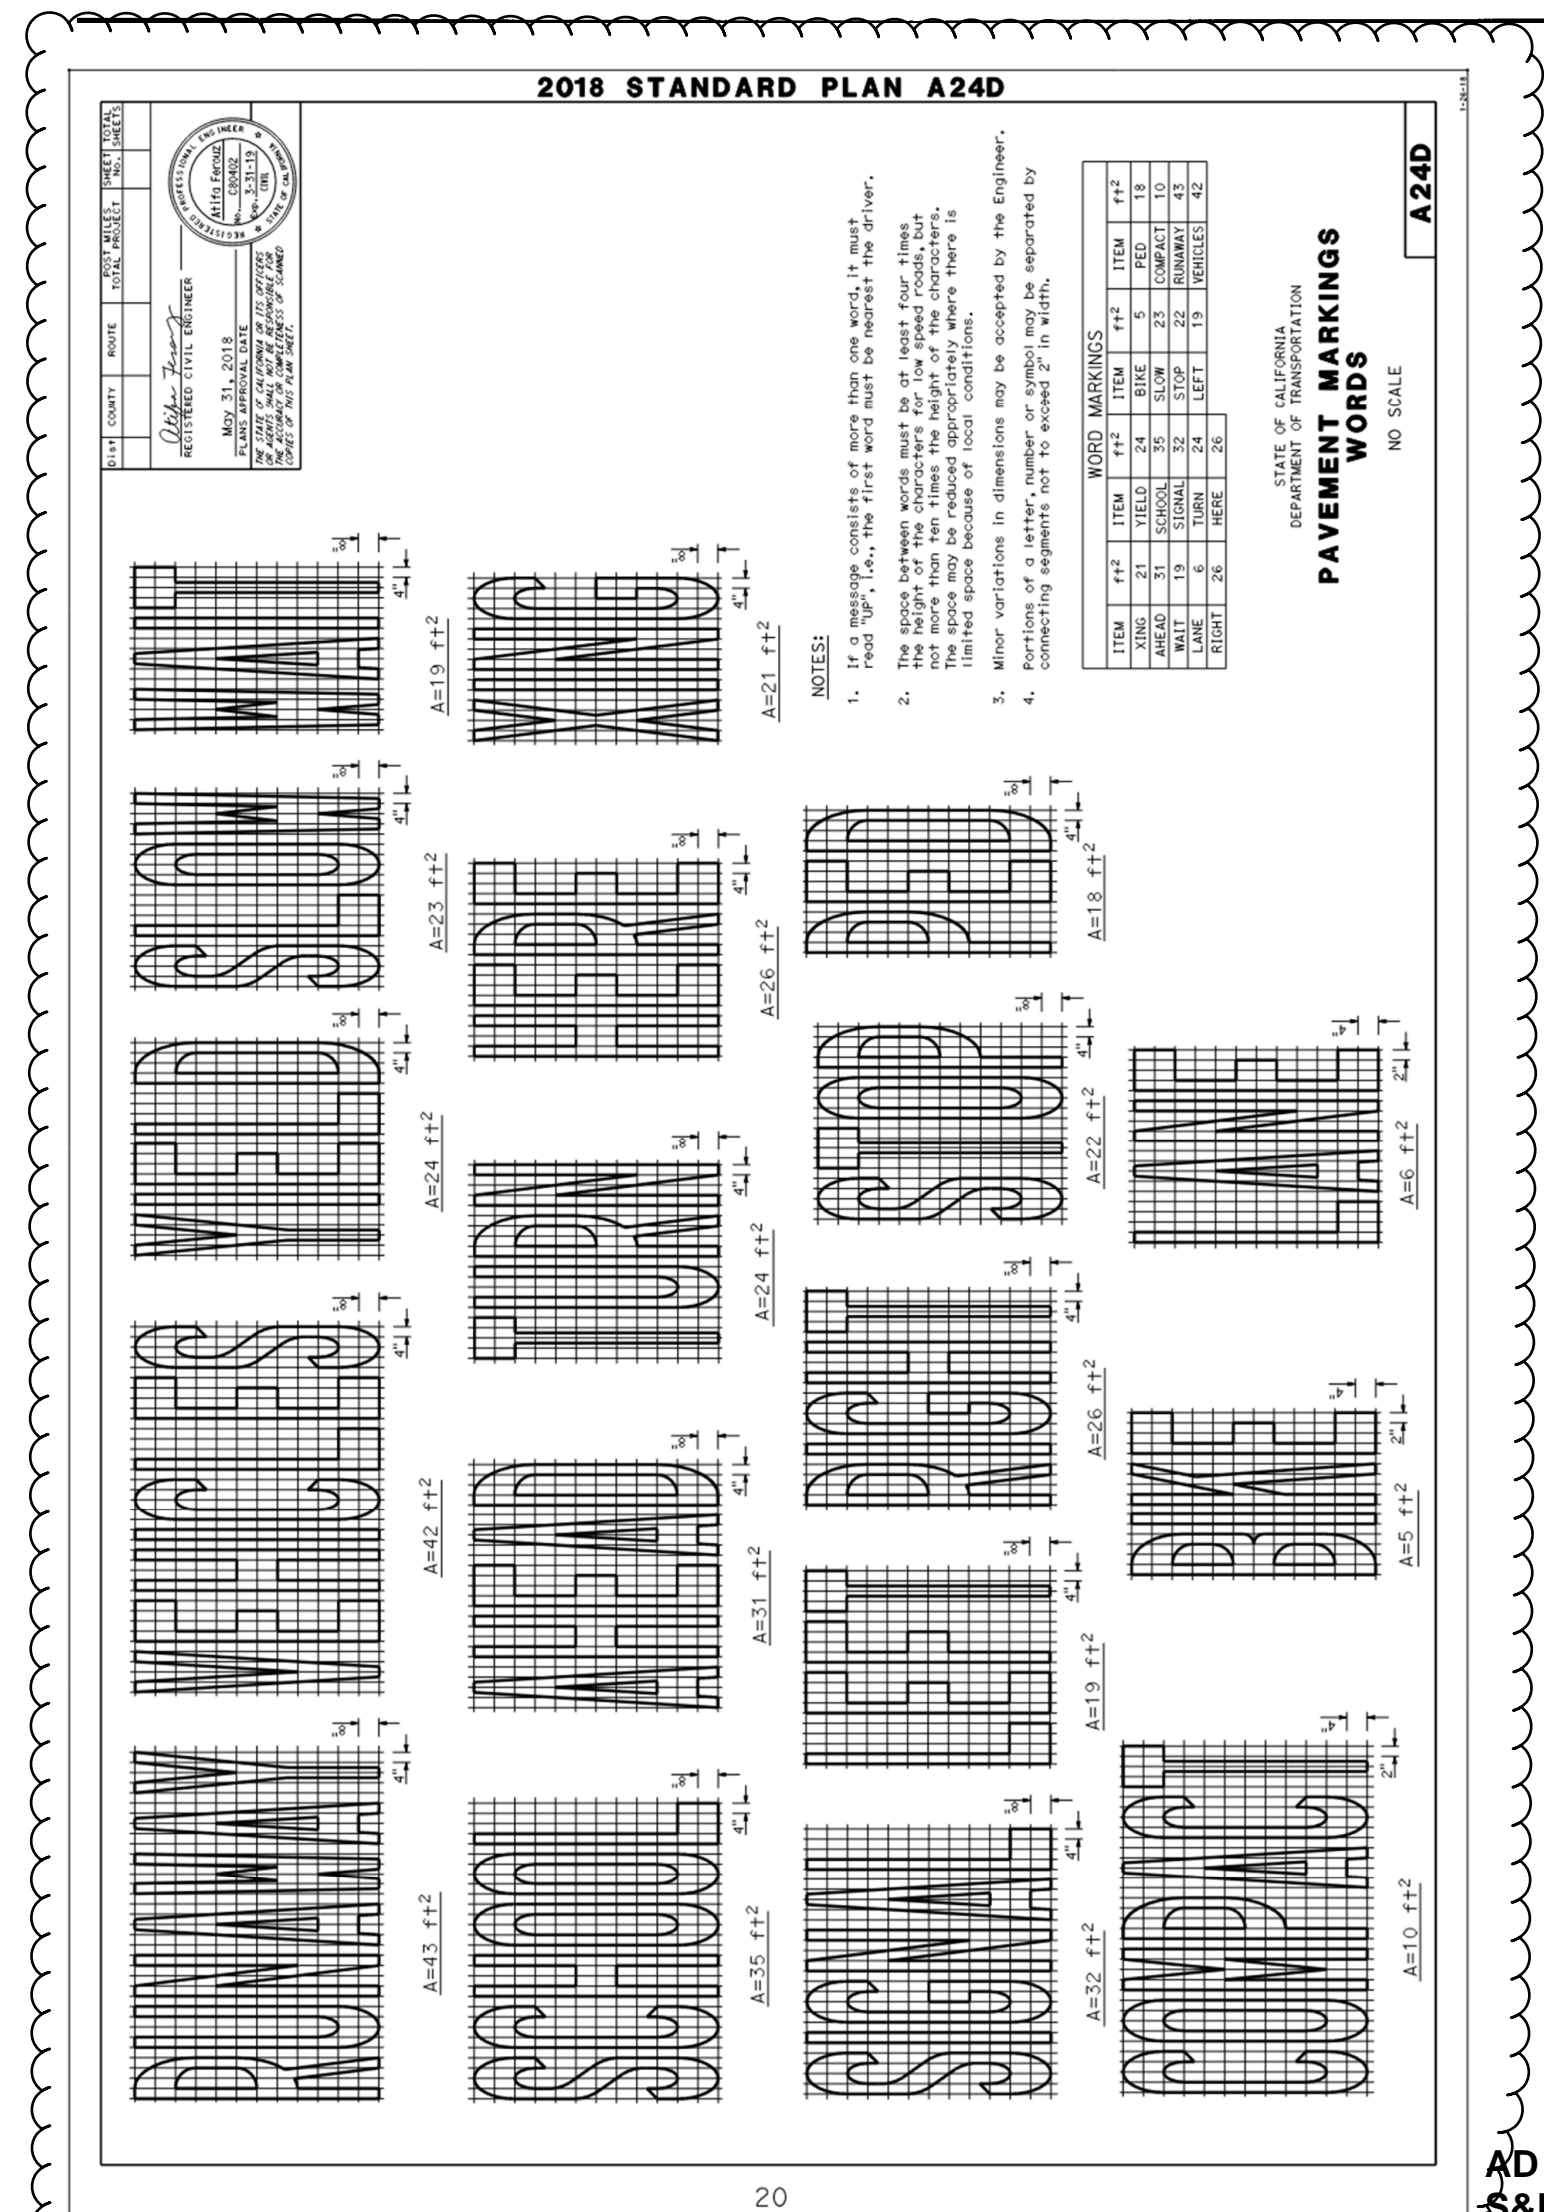

SIMPRK

7790 NORTH PALM AVENUE
 FRESNO, CALIFORNIA 93711
 T559.448.8400 - F559.448.8467
 www.simp-rk.com

PROJECT:
SHIELDS & BRAWLEY ELEMENTARY SCHOOL



QK

601 POLLASKY AVE., STE. 301 TEL: (559) 449-2400
 CLOVIS, CA 93612 WWW.QKCON.COM
 © COPYRIGHT BY QUAD KNOPP, INC. UNAUTHORIZED USE PROHIBITED.

JOHN H. SMITH, A.I.A. C15885

JOHN HAMILTON SMITH ARCHITECTS
 C 15885
 9-30-1999
 STATE OF CALIFORNIA

THE FIRM OF SMITH, HAMILTON, ARCHITECTS, INC. EXPRESSLY RESERVES ITS COMMON LAW COPYRIGHT AND OTHER INALIENABLE PROPERTY RIGHTS IN THESE PLANS. THESE PLANS ARE NOT TO BE REPRODUCED, CHANGED, OR COPIED IN ANY FORM OR MANNER WITHOUT THE WRITTEN PERMISSION AND CONSENT OF THE ARCHITECT. IN THE EVENT OF UNAUTHORIZED REUSE OF THESE PLANS BY A THIRD PARTY, THE THIRD PARTY SHALL HOLD THE ARCHITECT HARMLESS, AND SHALL BEAR THE COST OF THE ARCHITECT'S LEGAL FEES, ASSOCIATED WITH DEFENDING AND ENFORCING THESE RIGHTS.

AD 2-45a
S&B Elementary
02-116800

REVISIONS

| No. | DATE | DESCRIPTION |
|-----|---------|------------------------|
| △ | 2.14.23 | DISTRICT MODIFICATIONS |
| △ | 2.27.23 | DISTRICT MODIFICATIONS |

SHEET DESCRIPTION

CITY OF FRESNO DETAILS

| | |
|--|--------------------------|
| PROJECT COORDINATOR JOHN SMITH | SHEET No. C6.9 |
| PROJECT NO. 17-67 | |
| DATE 1.27.23 | |
| SCALE AS SHOWN | |


AD 5-01a
 S&B Elementary
 02-116800

City of FRESNO

County of FRESNO

State of California

SHIELDS AND BRAWLEY ELEMENTARY SCHOOL 4108 WEST SHIELDS AVENUE FRESNO, CA 93722 FIRE DEPARTMENT PLANS

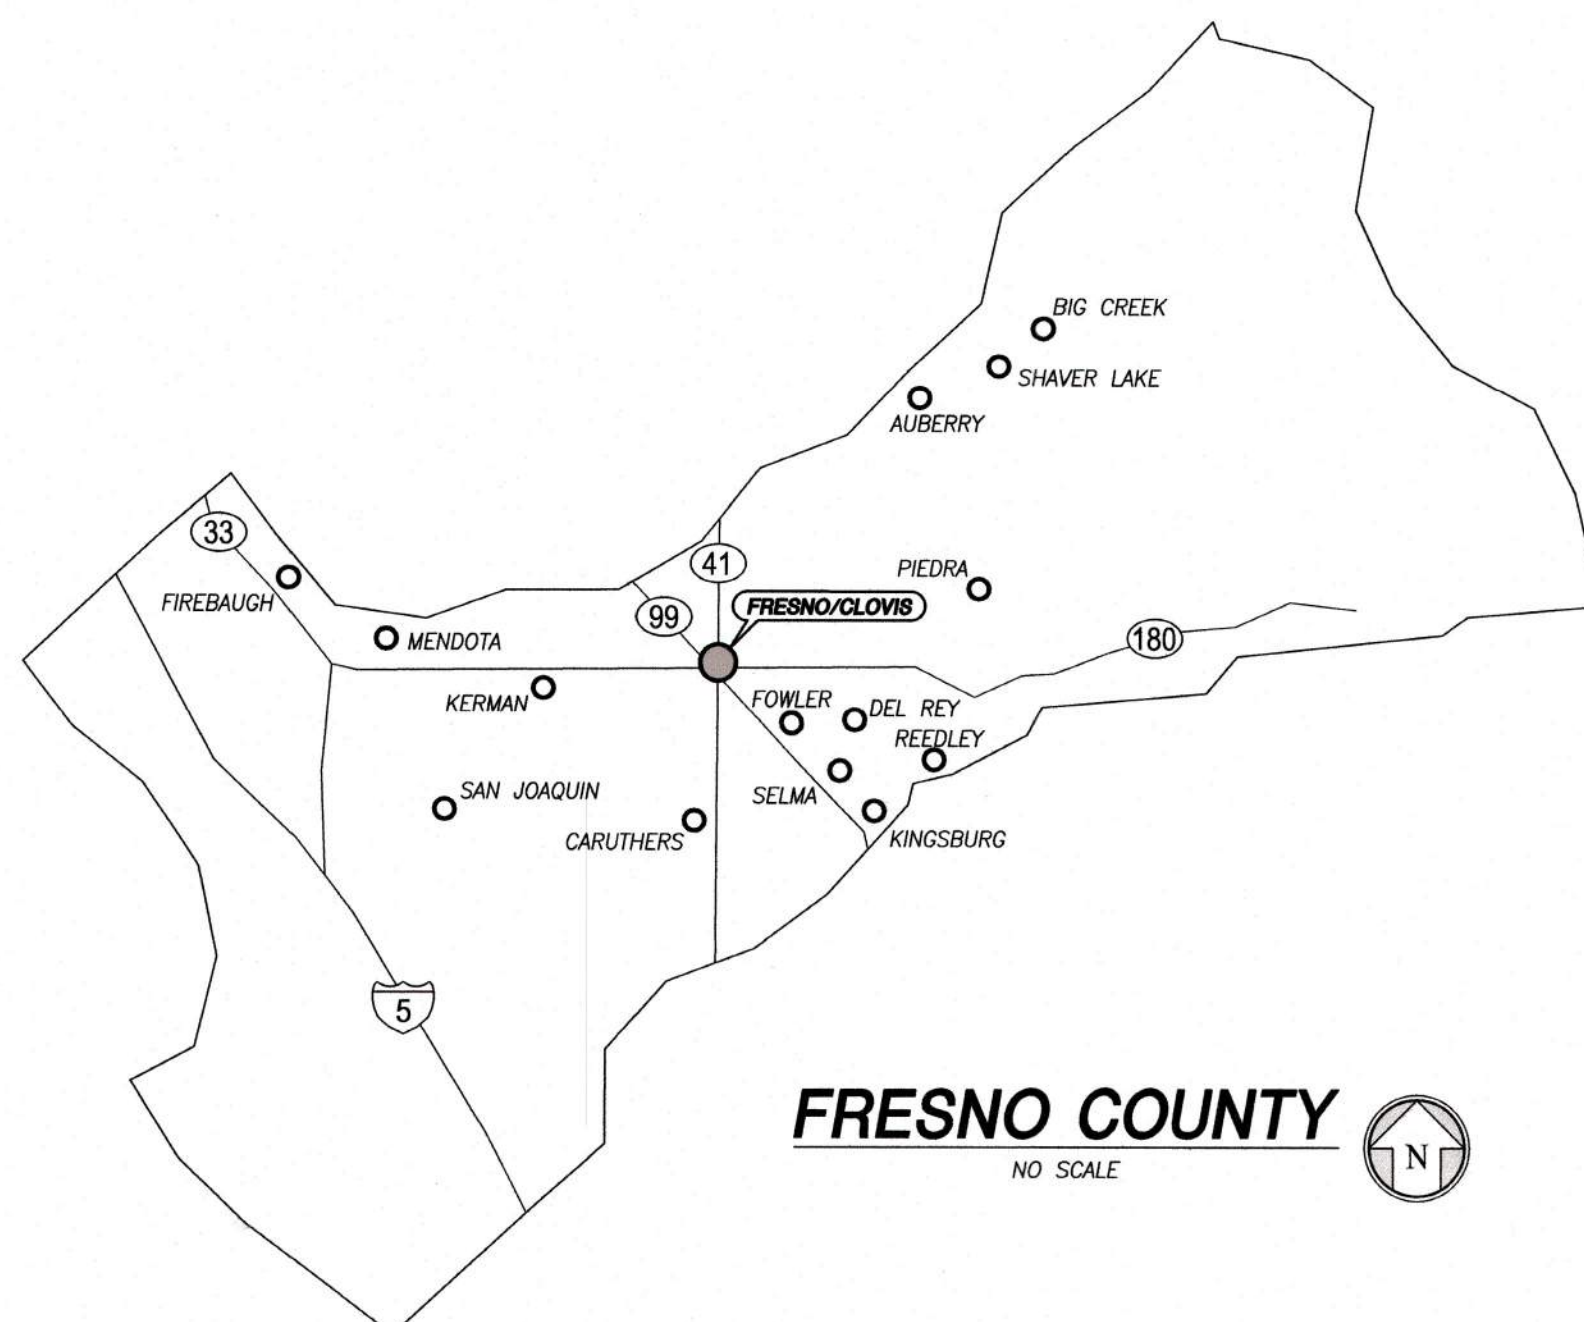

SHEET INDEX

- 1 COVER SHEET
- 2 SITE PLAN



7790 NORTH PALM AVENUE
FRESNO, CALIFORNIA 93711
T509.448.8400 • F559.448.8467
www.sim-pbk.com

PROJECT:
**SHIELDS
& BRAWLEY
ELEMENTARY
SCHOOL**



THE FIRM OF SMITH HAMILTON ARCHITECTS, INC. EXPRESSLY RESERVES ITS COMMON LAW COPYRIGHT AND OTHER APPLICABLE PROPERTY RIGHTS IN THESE PLANS. THESE PLANS ARE NOT TO BE REPRODUCED, CHANGED, OR COPIED IN ANY MANNER OR MANNER WHATSOEVER, NOR ARE THEY TO BE ASSIGNED TO A THIRD PARTY WITHOUT FIRST OBTAINING THE WRITTEN PERMISSION AND CONSENT OF THE ARCHITECT. IN THE EVENT OF UNAUTHORIZED REUSE OF THESE PLANS BY A THIRD PARTY, THE THIRD PARTY SHALL HOLD THE ARCHITECT HARMLESS AND SHALL BEAR THE COST OF THE ARCHITECT'S LEGAL FEES, ASSOCIATED WITH DEFENDING AND ENFORCING THESE RIGHTS.

**AD 2-46a
S&B Elementary
02-116800**

| REVISIONS | | |
|-----------|---------|------------------------|
| No. | DATE | DESCRIPTION |
| △ | 2.14.23 | DISTRICT MODIFICATIONS |
| △ | 2.27.23 | DISTRICT MODIFICATIONS |


| SHEET DESCRIPTION | |
|--|------------|
| FIRE DEPARTMENT PLAN | |
| PROJECT COORDINATOR JOHN SMITH | SHEET No. |
| PROJECT No. 17-67 | FD1 |
| DATE 1.27.23 | |
| SCALE AS SHOWN | |

APPROVED
As No. 102
MAR-7 2023
FRESNO FIRE DEPARTMENT
811

Know what's below.
Call before you dig.
*Contact Planning for new
w. Fountain address*

PROJECTS 2018 180155 (CAD) IMPROVEMENTS 180155-FD-COV.DWG 3/2/2023 8:15 AM

PRELIMINARY NOT FOR CONSTRUCTION

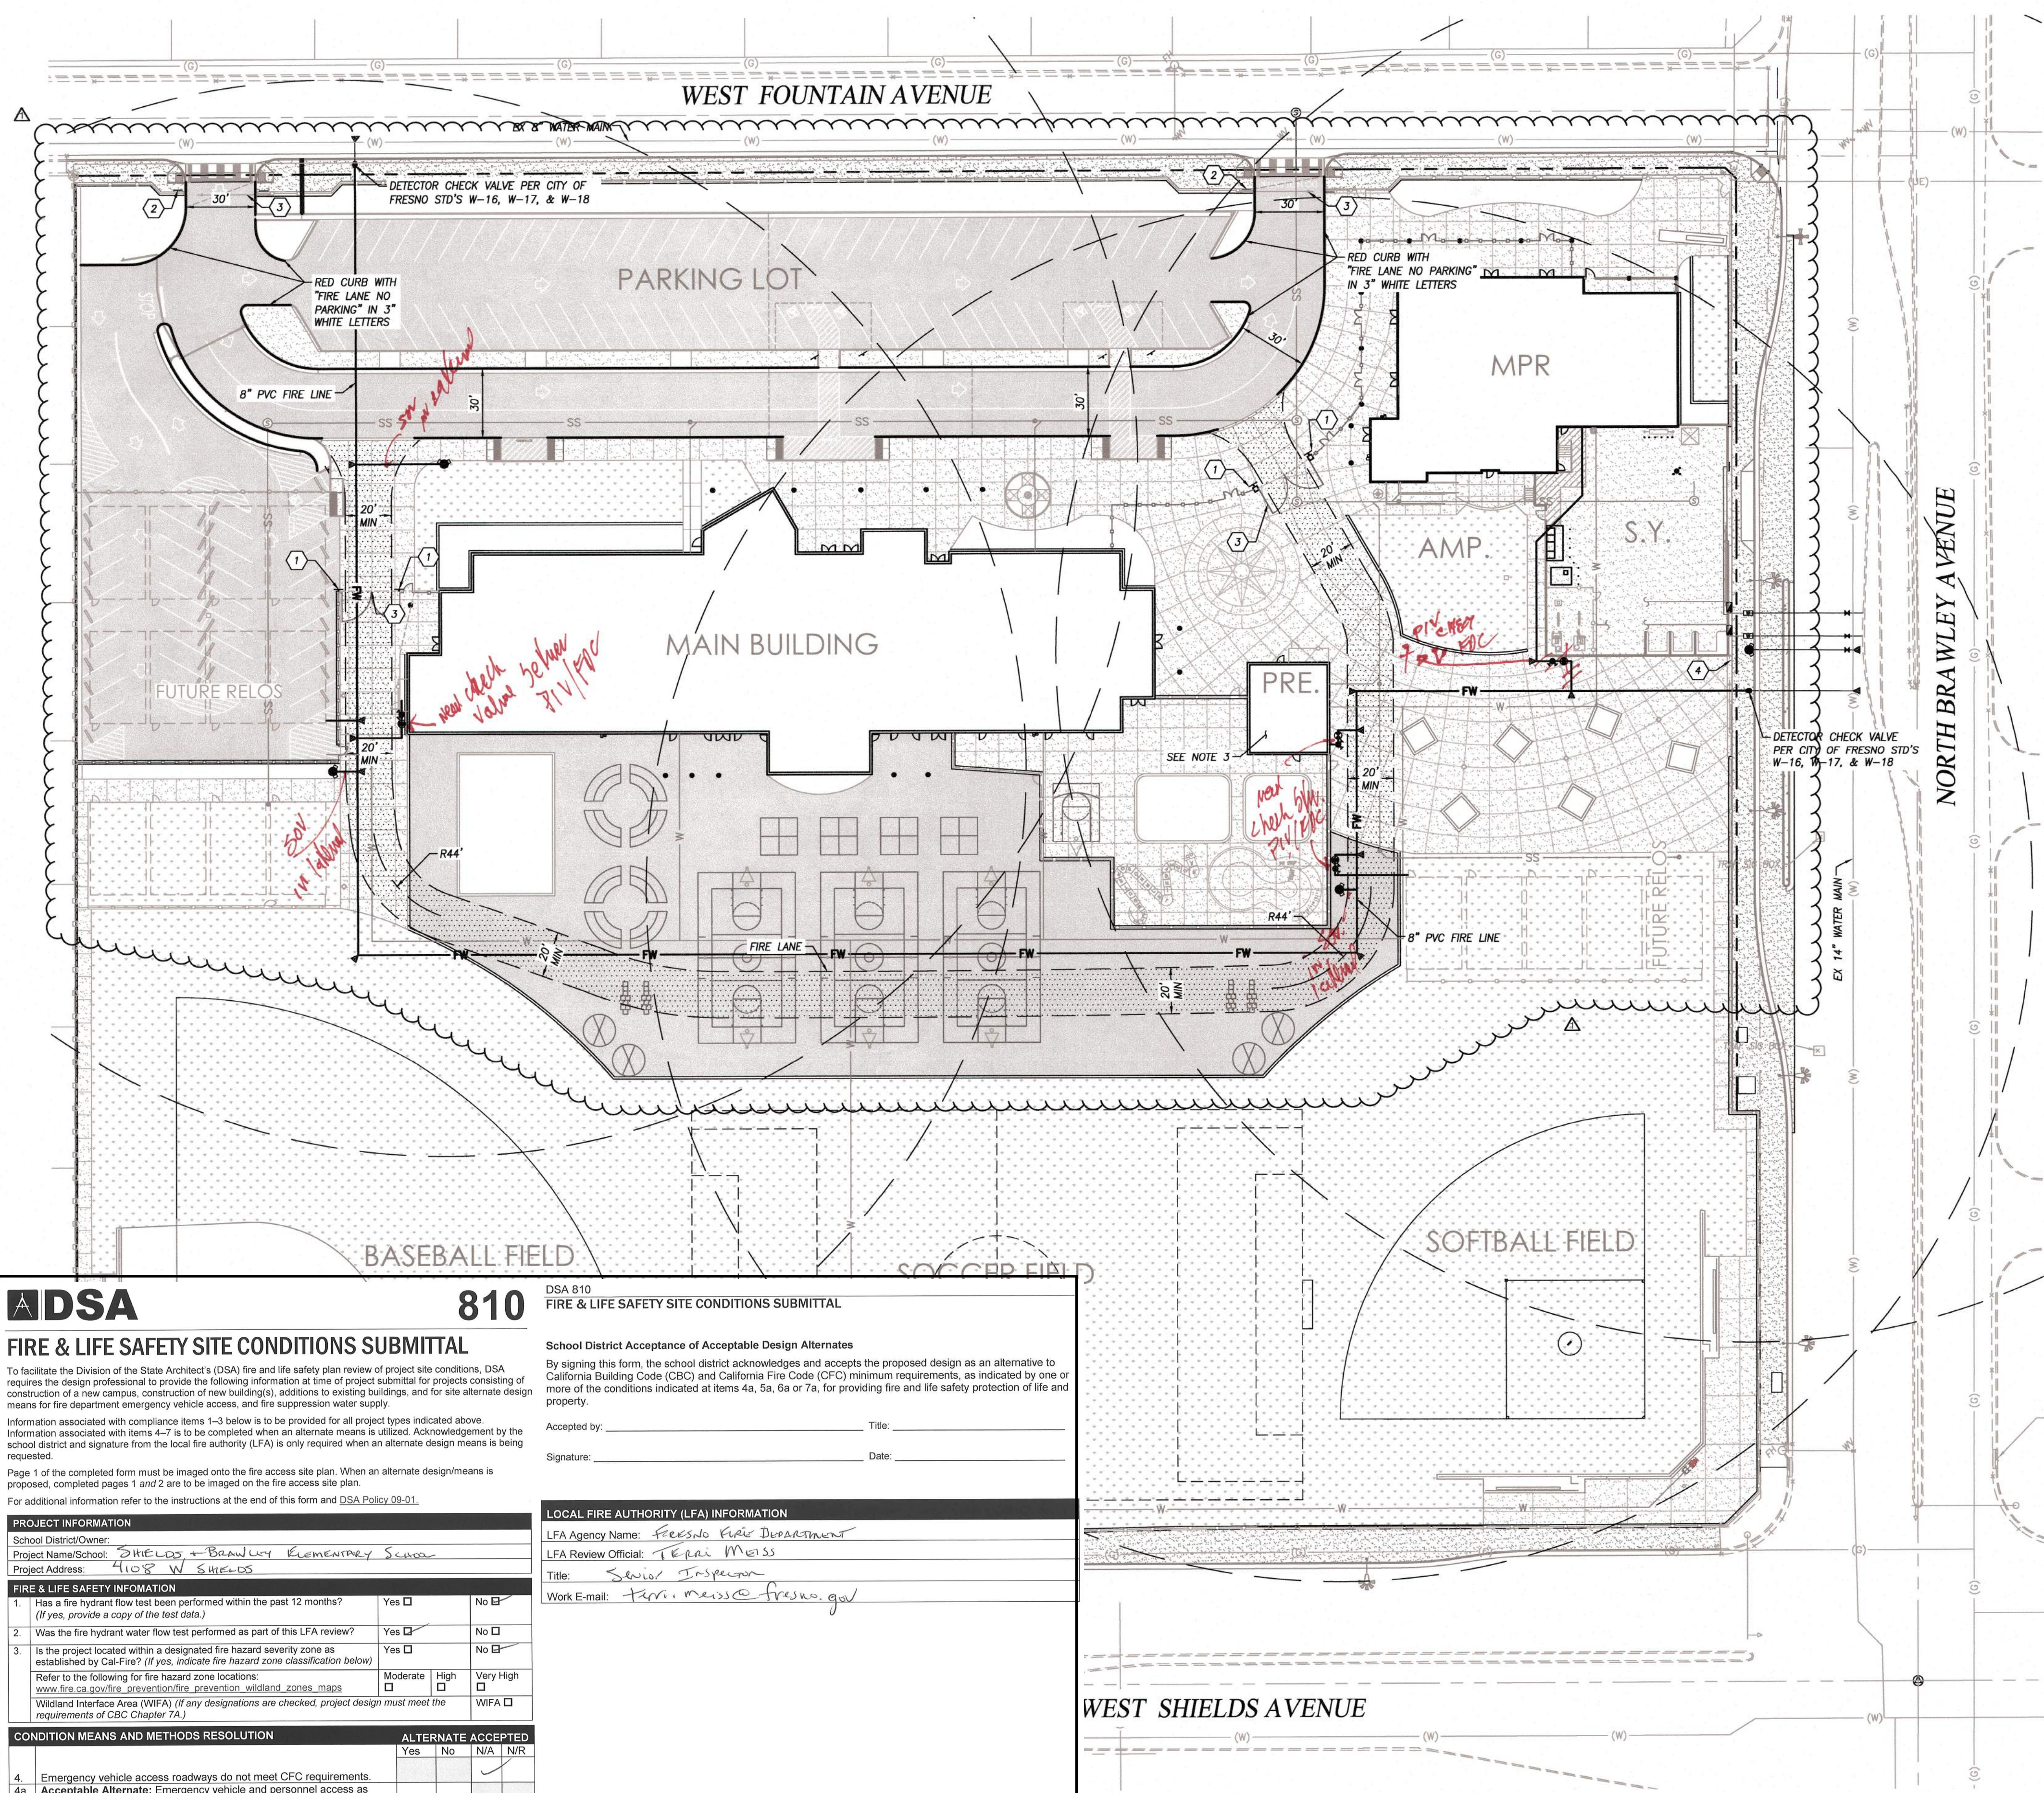

LEGEND

- FIRE DEPARTMENT CONNECTION (FDC)
- POST INDICATOR VALVE (PIV)
- FIRE HYDRANT
- EXISTING FIRE HYDRANT
- FIRE LANE
- THRUST BLOCK
- PROPOSED 8" PVC FIRE WATER LINE

NOTES:

1. 300' RADIUS CENTERED ON FIRE HYDRANT LOCATION
2. EMERGENCY VEHICLE ACCESS SHALL BE DESIGNATED BY PAINTING THE CURB RED (TOP AND SIDE) AND STENCILING "FIRE LANE NO PARKING" IN 3-INCH WHITE LETTERS ON THE MOST VERTICAL CURB, AT LEAST EVERY 50 FEET. IF NO CURB IS PRESENT, A MINIMUM 6-INCH WIDE RED STRIPE SHALL BE PAINTED ALONG THE EDGE OF THE ROADWAY WITH "FIRE LANE" IN 3-INCH WHITE LETTERS AT LEAST EVERY 50 FEET PER FFD DEVELOPMENT POLICY 403.005
3. PRESCHOOL BUILDING IS REQUIRED TO BE EQUIPPED WITH FIRE SPRINKLER PROTECTION PER 2016 CFC, SECTION 903.2.19.1


KEYNOTES:

1. INSTALL SIGN WITH "FIRE LANE" (6" LETTERS) "VEHICLES REMOVED AT OWNER'S EXPENSE" 2" LETTERS "FRESNO POLICE DEPARTMENT @ (559) 621-7000" (1" LETTERS)
2. INSTALL 17"x22" SIGN WITH "WARNING-VEHICLES STOPPED, PARKED OR LEFT STANDING IN FIRE LANES WILL BE IMMEDIATELY REMOVED AT OWNER'S EXPENSE--22568(A) CALIFORNIA VEHICLE CODE--FRESNO POLICE DEPARTMENT 621-2300"
3. INSTALL INGRESS AND EGRESS SECURITY GATE WITH BEST/X-1 PLICE/FIRE BYPASS LOCK
4. INSTALL BEST/X-1 POLICE/FIRE BYPASS LOCK ON PEDESTRIAN GATE



7790 NORTH PALM AVENUE
 FRESNO, CALIFORNIA 93711
 T559.448.8400 • F559.448.8467
 WWW.SIMPRK.COM

PROJECT:
SHIELDS & BRAWLEY ELEMENTARY SCHOOL

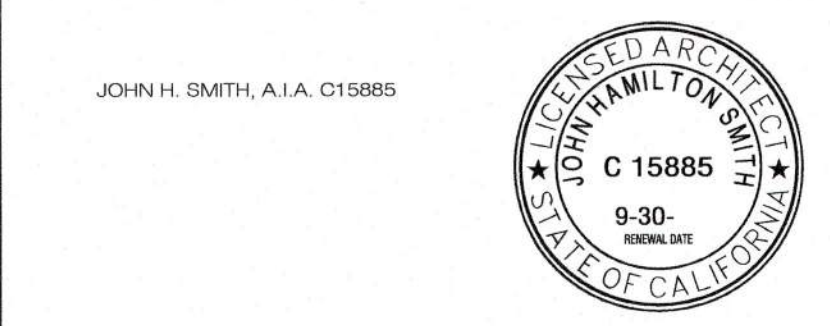

THE FIRM OF SMITH, MANAGA, MILHOUS, ARCHITECTS, INC. EXPRESSLY RESERVES ITS COMMON LAW COPYRIGHT AND OTHER APPLICABLE PRIORITY RIGHTS IN THESE PLANS. THESE PLANS ARE NOT TO BE REPRODUCED, CHANGED, OR COPIED IN ANY FORM OR MANNER WHATSOEVER, NOR ARE THEY TO BE ASSIGNED TO A THIRD PARTY WITHOUT FIRST OBTAINING THE WRITTEN PERMISSION AND CONSENT OF THE ARCHITECT. IN THE EVENT OF UNAUTHORIZED REUSE OF THESE PLANS BY A THIRD PARTY, THE THIRD PARTY SHALL HOLD THE ARCHITECT HARMLESS, AND SHALL BEAR THE COST OF THE ARCHITECT'S LEGAL FEES, ASSOCIATED WITH DEFENDING AND ENFORCING THESE RIGHTS.

AD 2-47a
S&B Elementary
02-116800

REVISIONS

| No. | DATE | DESCRIPTION |
|-----|---------|------------------------|
| 1 | 2.14.23 | DISTRICT MODIFICATIONS |

SHEET DESCRIPTION

FIRE DEPARTMENT PLAN

| | |
|--|-------------------------|
| PROJECT COORDINATOR JOHN SMITH | SHEET No. FD2 |
| PROJECT NO. 17-87 | |
| DATE 1.27.23 | |
| SCALE AS SHOWN | |

DSA 810
FIRE & LIFE SAFETY SITE CONDITIONS SUBMITTAL

DSAS 810
FIRE & LIFE SAFETY SITE CONDITIONS SUBMITTAL

To facilitate the Division of the State Architect's (DSA) fire and life safety plan review of project site conditions, DSA requires the design professional to provide the following information at time of project submittal for projects consisting of construction of a new campus, construction of new buildings, additions to existing buildings, and for site alternate design means for fire department emergency vehicle access, and fire suppression water supply.

Information associated with compliance items 1-3 below is to be provided for all project types indicated above. Information associated with items 4-7 is to be completed when an alternate means is utilized. Acknowledgement by the school district and signature from the local fire authority (LFA) is only required when an alternate design means is being requested.

Page 1 of the completed form must be imaged onto the fire access site plan. When an alternate design/means is proposed, completed pages 1 and 2 are to be imaged on the fire access site plan.

For additional information refer to the instructions at the end of this form and DSA Policy 09-01.

| PROJECT INFORMATION | | |
|------------------------|-------------------------------------|--|
| School District/Owner: | SHIELDS & BRAWLEY ELEMENTARY SCHOOL | |
| Project Name/School: | HOSP W SHIELDS | |
| Project Address: | HOSP W SHIELDS | |

| FIRE & LIFE SAFETY INFORMATION | | | |
|---|-----------------------------------|-------------------------------|------------------------------------|
| 1. Has a fire hydrant flow test been performed within the past 12 months? (If yes, provide a copy of the test data.) | Yes <input type="checkbox"/> | No <input type="checkbox"/> | |
| 2. Was the fire hydrant water flow test performed as part of this LFA review? | Yes <input type="checkbox"/> | No <input type="checkbox"/> | |
| 3. Is the project located within a designated fire hazard severity zone as established by Cal-Fire? (If yes, indicate fire hazard zone classification below) | Yes <input type="checkbox"/> | No <input type="checkbox"/> | |
| Refer to the following for fire hazard zone locations: www.fire.ca.gov/files_prevention_fire_protection/wildland_zones_maps | Moderate <input type="checkbox"/> | High <input type="checkbox"/> | Very High <input type="checkbox"/> |
| Wildland Interface Area (WIFA) (If any designations are checked, project design must meet the requirements of CBC Chapter 7A.) | Yes <input type="checkbox"/> | No <input type="checkbox"/> | WIFA <input type="checkbox"/> |


| CONDITION MEANS AND METHODS RESOLUTION | | | |
|---|--------------------|----|-----------|
| | ALTERNATE ACCEPTED | | |
| | Yes | No | N/A / N/R |
| 4. Emergency vehicle access roadways do not meet CFC requirements. | | | |
| 4a. Acceptable Alternate: Emergency vehicle and personnel access as proposed by the project architect is acceptable for providing fire suppression and protection of life and property. | | | |
| 5. Fire Hydrants: Number and spacing does not meet CFC requirements. | | | |
| 5a. Acceptable Alternate: Number of fire hydrants and spacing as proposed by the project architect is acceptable for fire suppression and protection of life and property. | | | |
| 6. Fire Hydrants: Water flow and pressure are less than CFC minimum. | | | |
| 6a. Acceptable Alternate: The available flow and pressure is acceptable for providing fire suppression and protection of life and property. | | | |
| 7. Location of fire department connection(s) serving fire sprinkler systems or standpipe systems does not meet CFC requirements. | | | |
| 7a. Acceptable Alternate: The location of fire department connection serving the fire sprinkler system and/or standpipe system is acceptable for providing fire suppression and protection of life and property. | | | |

Accepted by: _____ Title: _____
 Signature: _____ Date: _____

LOCAL FIRE AUTHORITY (LFA) INFORMATION

LFA Agency Name: FRESNO FIRE DEPARTMENT
 LFA Review Official: TERAN MESS
 Title: Senior Inspector
 Work E-mail: Teran.Mess@fresno.gov

APPROVED
as noted
 MHA
 BFD
FRESNO FIRE DEPARTMENT

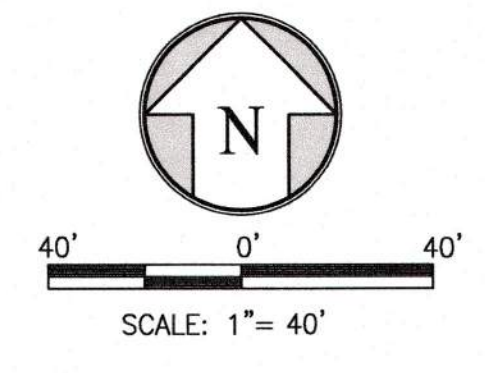

AD 5-01a
S&B Elementary
02-116800

I:\PROJECTS\2017\AD 155\ACAD IMPROVEMENTS\180155-FD-PLAN.DWG, 2/16/2023 4:31 PM