

Kitchell RFC 55



Karsyn Construction Inc.
4697 W. Jacquelyn Ave.
Fresno, Ca. 93722

PH: 559.271.2900
FX: 559.271.2908

REQUEST FOR INFORMATION

RFI #: 10
GC RFI#:
DATE: 5/23/2023
PHONE:
FAX:

TO:	Kitchell Corporation	REASON FOR REQUEST	ACTION REQUESTED	PROBABLE EFFECT
ATTN:	Luz Gonzales	INSUFFICIENT INFORMATION	CLARIFICATION	INCREASE COST
		ENGINEERING CONFLICT	DIRECTION	DECREASE COST
		ALTERNATE PROPOSAL	APPROVAL	UNKNOWN COST
		RESPONSE REQUIRED BY:		INCREASE TIME
PHONE:	559.271.2900			DECREASE TIME
FAX:	559.271.2908			UNKNOWN
FROM:	Jason Coronado			

REFERENCE: Shields & Brawley E.S.

DRAWING #: S5.4, S7.8/18


SPECIFICATION #:

SUBJECT: Structural Detail Callout

INFORMATION NEEDED:

On S5.4, near gridline D between 8 and 6, detail 18 on S7.8 is called out. This detail and page cannot be located.


Please clarify or locate correct page/detail for this location.

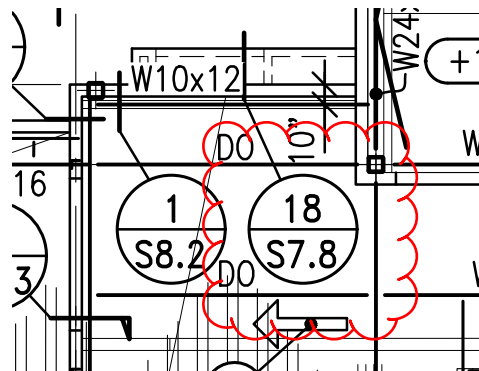

RECOMMENDATION:

[ASDi response:](#)
[See new detail XS-1 \(PENDING DSA APPROVAL\).](#)

Jack Brewer, SE
5-25-2023

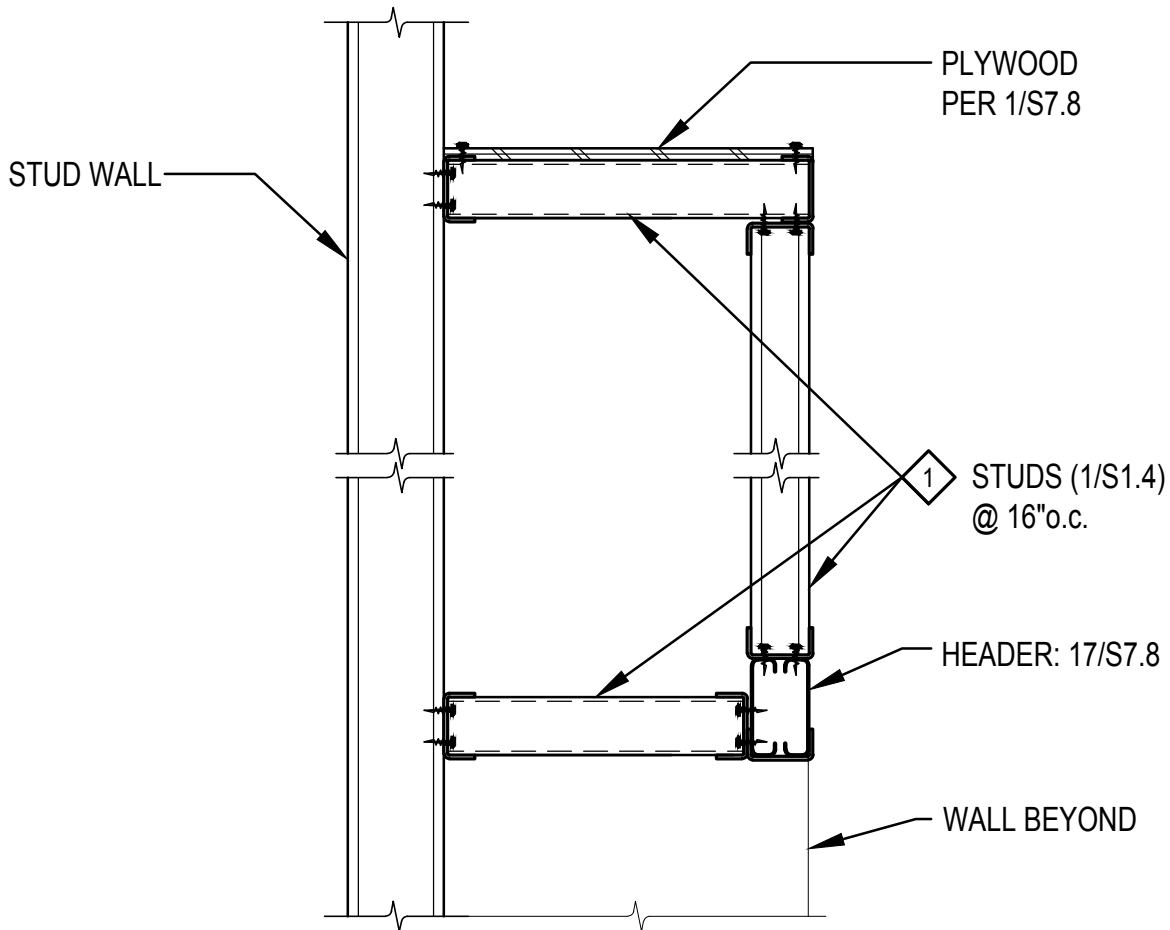


DET. AT DRINKING FOUNTAIN

1" ~ 1'-0"

REF: KITCHELL RFC #55

SCOPE: DETAIL AT DRINKING FOUNTAIN WAS NOT INCLUDED IN DSA APPROVED SET.

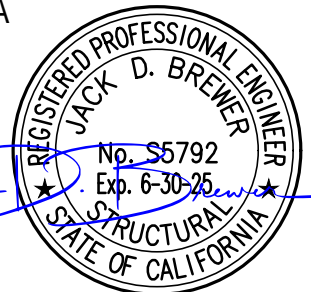

7790 NORTH PALM AVENUE
FRESNO, CALIFORNIA 93711
T559.448.8400
F559.448.8467
www.sim-pbk.com

PROJECT

SHIELDS & BRAWLEY ELEMENTARY SCHOOL

PROJECT No.

17-67

SHEET DESCRIPTION

DETAIL AT DRINKING FOUNTAIN

SCALE

AS NOTED

DATE

5/25/2023

SHEET No.

XS-1

PROJECT COORDINATOR

JEFF URABE