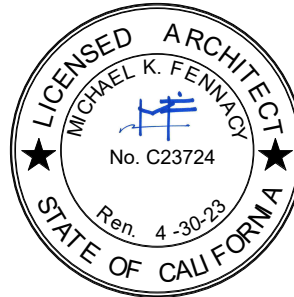


ADDENDUM NO. 6**DATE: 08/21/2023**DARDEN PROJECT NO.
DSA Application Number2180
02-120251**PROJECT:**Mission Oak HS Aquatic Complex
3442 E Bardsley Ave, Tulare, CA 93274
Bid No 2301**OWNER:**Tulare Joint Union High School District
426 N Blackstone St,
Tulare, CA 93274**ARCHITECT:**DARDEN ARCHITECTS, INC.
Attention: Fred Messias
6790 N. West Avenue
Fresno, California 93711
T. (559) 448-8051
F. (559) 446-1765**CONSTRUCTION MANAGER**CM Construction Services
Attention: Chris Hale
P.O. BOX 6237
Visalia, CA 93290
T. (559) 735-9556
M. (669) 804-6685**BID QUESTIONS**NON-MANDATORY JOB WALK
BID QUESTIONS, Submit By
BID OPENING DATE**Chris Hale**chris@cmconstructionservices.com08/08/2023 3:30 PM
08/22/2023 2:00 PM
08/31/2023 Before 2:00 PM

It will be the responsibility of the General Contractor to submit the information contained in this addendum to all its subcontractors and suppliers. Acknowledge receipt of this Addendum in the space provided on the Bid Form. Failure to do so may subject Bidder to disqualification.

The following additions, deletions, and revisions to the SHEETS and Project Manual are hereby made and do become a part of these Contract Documents.

GENERAL NOTE: ADDENDA NOS. 1 THRU 4 HAVE BEEN REMOVED FROM THIS PROJECT.

PROJECT: Mission Oak HS Aquatic Complex (Re-Bid)

ADDENDUM NO. 6..... **08/21/2023**

PAGE 2

INDEX OF ADDENDA TRANSMITTED HEREWITH

ATTACHMENTS:

DOCUMENTS OR SPECIFICATIONS:

Full Size Drawings..... 1 sheets

PROJECT MANUAL:

BIDDING AND CONTRACT REQUIREMENTS:

CHANGES TO PROCUREMENT REQUIREMENTS:

AD6-CPR01 Refer to the NOTICE TO CONTRACTORS:

1. Revise the DVBE declaration date to be on the same date as the bid. It shall read as follows.

The *DVBE Declaration of Good Faith Efforts* to Use Disabled Veteran Business Enterprises must be signed and filed in the Business Office of the Owner before 2:00 p.m. on **August 31, 2023**, at which time the bids (including the Declaration of Good Faith Efforts to Use Disabled Veteran Business Enterprises) will be opened in public.

SPECIFICATIONS:

CHANGES TO SPECIFICATIONS:

AD6-SP01 Omit and replace the following specification sections.

000110	TABLE OF CONTENTS
012300	ALTERNATES
042200	CONCRETE MASONRY UNITS
230923	DIRECT DIGITAL CONTROL AND ENERGY MANAGEMENT SYSTEM – <u>New Section</u>

CHANGES TO DRAWINGS:

AD6-A01 Refer to the Bid Set of Drawings.

1. The Bid Set of Drawing (Revision 1) is not DSA approved.
2. When DSA approves the revision drawings, they will be issued to the contractor (after the bid opening date).

AD6-A02 Refer to the Bid Set of Drawings.

1. The Bid Set of Drawings is based on a revised scope of work for re-bidding this project. (The 1st Bid was in March 2023 and not awarded).
2. The Bid Set of Drawings includes the current bid scope reductions (revisions).
3. The Division of the State Architects Office (DSA) was provided with a Revision Set of Drawings, and they have commented on the Revision Set of Drawings. The A/E team has updated the drawings to satisfy the DSA comments.
4. These drawings are being re-issued, as they contain the most up-to-date information.
5. A few new drawings have been created, noted as "New Sheet".
6. Omit and replace the following drawings.

GENERAL INFORMATION

G000	COVER SHEET
G001	COVER SHEET
G101	REGULATORY SITE PLAN
G102	REGULATORY FLOOR PLAN

CIVIL

SITE DEVELOPMENT

SD/C2.1	SITE DEMOLITION PLAN
SD/C3.1	GRADING AND DRAINAGE PLAN
SD/C3.1.1	ALTERNATE BID- GRADING AND DRAINAGE PLAN – <u>New Sheet</u>
SD/C3.2	ENLARGED GRADING PLANS
SD/C4.1	WET PIPING PLAN
SD/C4.1.1	ALTERNATE BID - WET PIPING PLAN – <u>New Sheet</u>
SD/C4.2	WET PIPING PLAN
SD/C4.2.1	ALTERNATE BID - WET PIPING PLAN – <u>New Sheet</u>
SD/C5.1	PAVING PLAN
SD/C7.1	CIVIL DETAILS

OFFSITE IMPROVEMENTS

SD/C6.1	BARDSLEY AVE OFFSITES
---------	-----------------------

ARCHITECTURAL

SITE DEVELOPMENT

SD/A010	OVERALL SITE DEMOLITION PLAN
SD/A011	SITE DEMOLITION PLAN & EARTHWORK
SD/A100	OVERALL SITE PLAN
SD/A101	PARTIAL SITE PLAN
SD/A201	PARTIAL SITE DIMENSION PLAN
SD/A301	ENLARGED SITE PLANS
SD/A303	DETAILS - ACCESSIBLE ELEMENTS
SD/A401	SITE OPENING SCHEDULE
SD/A404	DETAILS - ORNAMENTAL METAL ACCESSIBLE GATES
SD/A407	DETAILS - ENCLOSURE DETAILS
SD/A701	SIGNAGE PLAN AND SCHEDULE
SD/L101	LANDSCAPING PLAN

TYPICAL INFORMATION

X/A201	INTERIOR & EXTERIOR FINISH SCHEDULE
X/A401	OPENING SCHEDULES, FRAME ELEVATIONS
X/A502	EXTERIOR DETAILS
X/A601	INTERIOR & SIGNAGE DETAILS
X/A602	INTERIOR DETAILS

BUILDING P

P/A101	FLOOR PLANS
P/A101.1	ALTERNATE BID - BUILDING P2 - SNACK BAR BUILDING
P/A103	ENLARGED FLOOR PLANS
P/A201	REFLECTED CEILING PLANS
P/A301	ROOF PLANS
P/A401	EXTERIOR ELEVATIONS - P2 & P3
P/A402	EXTERIOR ELEVATIONS - P3 - P4
P/A501	BUILDING SECTIONS - P2 & P3
P/A504	BUILDING P4 - POOL STORAGE DETAILS
P/A601	INTERIOR ELEVATIONS - ROOMS P201 - P205
P/A602	INTERIOR ELEVATIONS - ROOMS P301 - P302
P/A603	INTERIOR ELEVATIONS - ROOMS P303 - P306
P/A604	INTERIOR ELEVATIONS - ROOMS P401 - P403
P/A605	INTERIOR ELEVATIONS - ROOMS P404a - P404d
P/A606	INTERIOR ELEVATIONS - ROOMS P404e, P410 & P420
P/A701	SIGNAGE PLANS AND SCHEDULE
P/A801	INTERIOR DESIGN PLANS

STRUCTURAL

BUILDING P

P/S201	FOUNDATION PLANS
P/S201.1	ALTERNATE BID -BUILDING P2 – <i>New Sheet</i>
P/S301	ROOF FRAMING PLANS
P/S401	WALL ELEVATIONS
P/S401.1	ALTERNATE BID -WALL ELEVATIONS – <i>New Sheet</i>
P/S403	WALL ELEVATIONS
P/S405	BUILDING SECTIONS
P/S601	FRAMING DETAILS
P/S602	FRAMING DETAILS

PLUMBING

SITE DEVELOPMENT

SD/P102	PARTIAL PLUMBING SITE PLAN
---------	----------------------------

TYPICAL INFORMATION

X/P101	PLUMBING SCHEDULE, LEGENDS, AND NOTES
X/P102	PLUMBING DETAILS

BUILDING P

P/P101	PLUMBING PLANS
P/P102	ENLARGED PLUMBING PLANS
P/P301	PLUMBING ROOF PLANS

MECHANICAL

SITE DEVELOPMENT

SD/M102	PARTIAL MECHANICAL SITE PLAN
---------	------------------------------

TYPICAL INFORMATION

X/M101	MECHANICAL SCHEDULES, LEGENDS, AND NOTES
X/M102	MECHANICAL DETAILS
X/M103	TITLE 24 DOCUMENTATION
X/M104	TITLE 24 DOCUMENTATION

BUILDING P

P/M101	MECHANICAL FLOOR PLANS
P/M301	MECHANICAL ROOF PLANS

FIRE PROTECTION

TYPICAL INFORMATION

FP001 PROJECT INFORMATION

SITE DEVELOPMENT

FP002 SITE PLAN

BUILDING P

FP100 PIPING PLANS
FP200 REFLECTED CEILING PLANS
FP400 BLDG. P2 & P3 SECTION VIEWS
FP401 BLDG. P4 SECTION VIEWS
FP500 FIRE PROTECTION DETAILS

ELECTRICAL

SITE DEVELOPMENT

SD/E101 SITE DEVELOPMENT - ELECTRICAL OVERALL SITE PLAN
SD/E102 SITE DEVELOPMENT - ENLARGED ELECTRICAL SITE PLAN

TYPICAL INFORMATION

X/E101 TYPICAL INFORMATION - ELECTRICAL SYSTEMS - SYMBOLS, NOTES, AND DETAILS
X/E102 TYPICAL INFORMATION - LIGHTING SYSTEMS - FIXTURE SCHEDULE AND DETAILS
X/E103 POWER SYSTEMS - SINGLE LINE DIAGRAM AND DETAILS – V2 Sheet
X/E104 TYPICAL INFORMATION - POWER SYSTEMS - PANEL SCHEDULES
X/E105 ELECTRONICS SYSTEMS - LINE DIAGRAM AND DETAILS – V2 Sheet
X/E107 TYPICAL INFORMATION - POWER AND LOW VOLTAGE SYSTEMS - DETAILS
X/E201 TYPICAL INFORMATION - FIRE ALARM SYSTEM - SYMBOLS, NOTES, AND DETAILS
X/E202 TYPICAL INFORMATION - FIRE ALARM SYSTEM - SINGLE LINE DIAGRAM
X/E203 TYPICAL INFORMATION - FIRE ALARM SYSTEM - CALCULATIONS

BUILDING P

P/E101 BUILDINGS P2, P3, P4 - LIGHTING PLANS
P/E102 BUILDINGS P2, P3, P4 - POWER & DATACOMM PLANS
P/E103 BUILDINGS P2, P3, P4 - PA & INTRUSION SYSTEMS PLANS
P/E104 BUILDINGS P2, P3, P4 - FIRE ALARM PLANS
P/E105 ENLARGED ELECTRICAL PLANS
P/E106 BUILDINGS P2 - ALTERNATE BID - LIGHTING, POWER & DATACOMM, PA & INTRUSION SYSTEMS, AND FIRE ALARM PLANS – New Sheet

AQUATICS

DP-1 POOL AREA DECK PLAN
CP-3 COMPETITION AND LEARNING POOL PLUMBING PLAN
CP-3.1 DECK HOSE BIBB PLAN
CP-4 UNDERWATER LIGHTING AND TIMING PLAN
CP-12 DETAILS
MT1 NOTES, FOUNDATION DETAILS

STRUCTURAL DRAWINGS

AD6-S01 Refer to the attached Structural Drawing P/S301


1. Refer to Detail A7, Roof Framing Plan.
2. Refer to the Column to CMU at Grid Line 32 and add the following note.

*For the W18 to CMU connection, see Detail J11-X/S601.
Typical each end.*


3. Refer to the Column to Beam at Grids 32 and 3Ba and add the following note.

See Typical Detail J11-X/S105

EXAMPLE

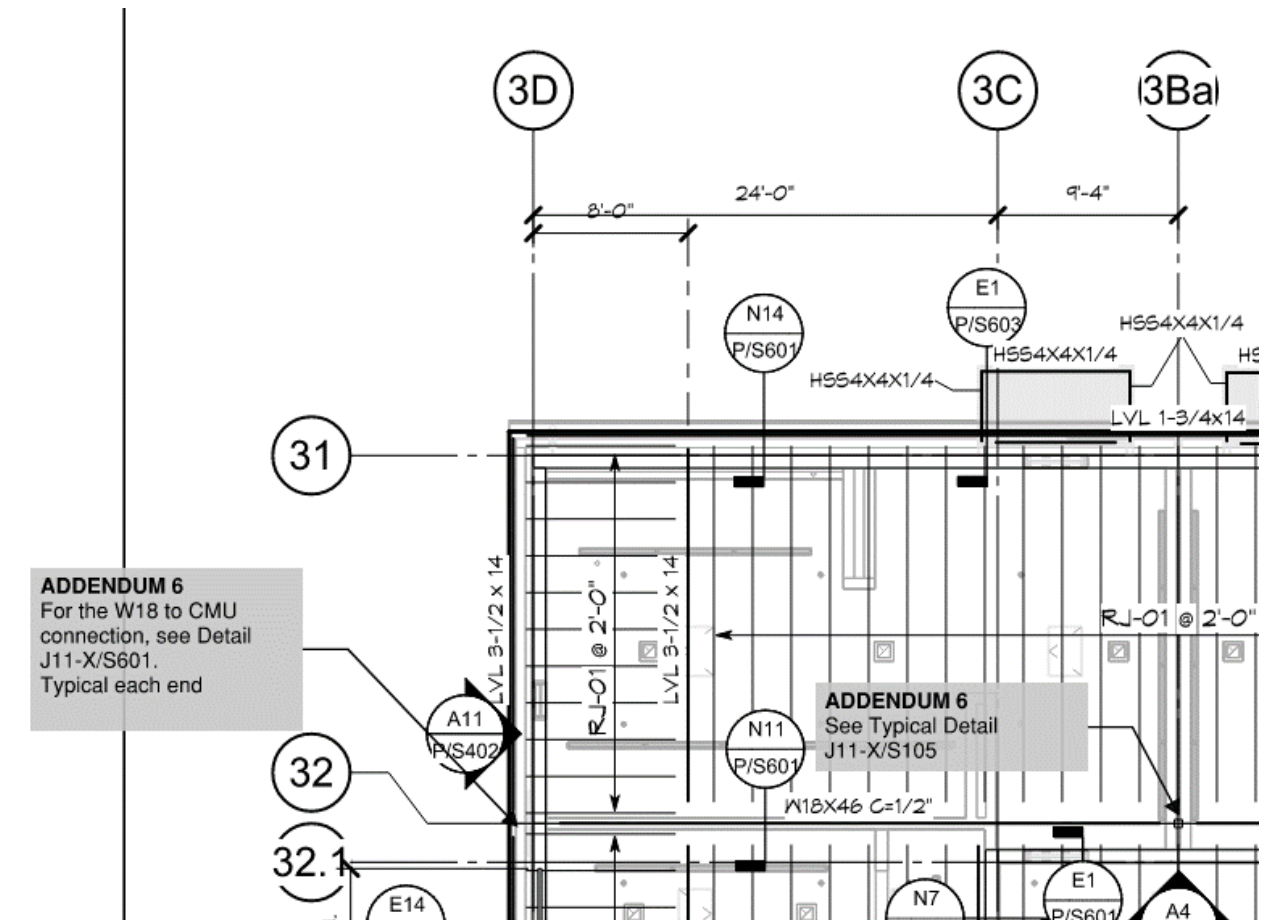

END OF ADDENDUM NO. 6

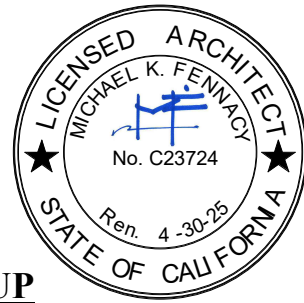

PROJECT MANUAL TABLE OF CONTENTS

PROCUREMENT AND CONTRACTING REQUIREMENTS GROUP

DIVISION 00 - PROCUREMENT AND CONTRACTING REQUIREMENTS

Michael K Fennacy
08/21/2023

INTRODUCTORY INFORMATION

00 01 01	PROJECT TITLE PAGE
00 01 10	PROJECT MANUAL TABLE OF CONTENTS
00 23 13.03	SUPPLEMENTARY INSTRUCTIONS FOR BIDDERS

PROCUREMENT REQUIREMENTS

Provided by Owner

CONTRACT REQUIREMENTS

Provided by Owner

SPECIFICATIONS GROUP

GENERAL REQUIREMENTS SUBGROUP

DIVISION 01 – GENERAL REQUIREMENTS

01 11 13	SUMMARY OF WORK
01 23 00	ALTERNATES
01 25 00	SUBSTITUTION PROCEDURES
01 29 73.01	SCHEDULE OF VALUES
01 31 13	CONTRACTOR'S "PROJECT MANAGEMENT" AND COORDINATION
01 32 16.01	CONSTRUCTION SCHEDULES
01 32 26	FORMS AND REPORTS
01 33 00	SUBMITTAL PROCEDURES
01 41 00	REGULATORY REQUIREMENTS
01 42 00	REFERENCES
01 45 23	TESTING AND INSPECTION SERVICES
01 45 29	TESTING LABORATORY SERVICES
01 50 00	TEMPORARY FACILITIES AND CONTROLS
01 57 23	STORM WATER POLLUTION PREVENTION PLAN (SWPPP)
01 64 00	OWNER-FURNISHED ITEMS
01 71 23	FIELD ENGINEERING
01 73 29	CUTTING AND PATCHING
01 74 19	CONSTRUCTION WASTE MANAGEMENT AND DISPOSAL
01 77 20	PROJECT CLOSEOUT
01 78 36	WARRANTIES
01 78 39	PROJECT DOCUMENTS

FACILITY CONSTRUCTION SUBGROUP

DIVISION 02 – EXISTING CONDITIONS

02 01 10	EXISTING LANDSCAPE MAINTENANCE
02 41 19	SELECTIVE DEMOLITION

DIVISION 03 – CONCRETE

03 11 01	CONCRETE FORMWORK
03 15 14	DRILLED ANCHORS
03 20 00	REINFORCEMENT
03 30 00	CAST-IN-PLACE CONCRETE
03 35 10	POLISHED CONCRETE FINISHING

DIVISION 04 – MASONRY

04 22 00	CONCRETE MASONRY UNITS
----------	------------------------

DIVISION 05 – METALS

05 12 00	STEEL AND FABRICATIONS
05 30 00	METAL DECK

DIVISION 06 – WOOD, PLASTICS, AND COMPOSITES

06 10 00	ROUGH CARPENTRY
06 17 13	COMPOSITE LUMBER
06 17 33	WOOD JOISTS
06 41 23	MODULAR CASEWORK

DIVISION 07 – THERMAL AND MOISTURE PROTECTION

07 14 16	FLUID-APPLIED WATERPROOFING
07 18 50	VAPOR-ALKALINITY CONTROL
07 21 00	INSULATION
07 41 13	METAL SHINGLES
07 60 00	SHEET METAL
07 72 00	ROOF ACCESSORIES
07 92 00	SEALANTS

DIVISION 08 – OPENINGS

08 16 13	FIBERGLASS DOORS AND FRAMES
08 31 13	ACCESS DOORS AND FRAMES
08 33 00	COILING DOORS
08 70 00	HARDWARE
08 70 00.1	HARDWARE SCHEDULE
08 80 00	GLASS

DIVISION 09 – FINISHES

09 22 16	METAL FRAMING
09 24 00	CEMENT PLASTER
09 29 00	GYPSON BOARD
09 30 00	TILE
09 65 10	RESILIENT BASE AND ACCESSORIES
09 72 00	WALL COVERINGS
09 91 00	PAINTING

DIVISION 10 – SPECIALTIES

10 05 00	MISCELLANEOUS SPECIALTIES
10 14 00	IDENTIFYING DEVICES
10 14 53	ROAD AND PARKING SIGNAGE
10 21 13	TOILET PARTITIONS
10 26 00	WALL AND CORNER GUARDS
10 28 13	TOILET ACCESSORIES
10 44 00	FIRE PROTECTION SPECIALTIES

DIVISION 11 – EQUIPMENT

11 40 00 FOOD SERVICE EQUIPMENT

DIVISION 13 – SPECIAL CONSTRUCTION

13 11 00 SWIMMING POOL GENERAL REQUIREMENTS
 13 11 01 SWIMMING POOL EXCAVATION
 13 11 02 SWIMMING POOL CONCRETE
 13 11 03 SWIMMING POOL SHOTCRETE
 13 11 04 SWIMMING POOL CERAMIC TILE
 13 11 06 SWIMMING POOL EQUIPMENT
 13 11 07 SWIMMING POOL MECHANICAL
 13 11 08 SWIMMING POOL ELECTRICAL
 13 11 09 SWIMMING POOL PREFABRICATED SWIMMING POOL
 13 11 10 SWIMMING POOL WATERPROOFING

FACILITY SERVICES SUBGROUP**DIVISION 21 – FIRE SUPPRESSION**

21 05 17 SLEEVES AND SLEEVE SEALS FOR FIRE-SUPPRESSION PIPING
 21 05 18 ESCUTCHEONS FOR FIRE-SUPPRESSION PIPING
 21 05 23 GENERAL-DUTY VALVES FOR FIRE PROTECTION PIPING
 21 05 29 HANGERS AND SUPPORTS
 21 05 48 VIBRATION AND SEISMIC CONTROLS
 21 05 53 IDENTIFICATION FOR FIRE-SUPPRESSION PIPING AND EQUIPMENT
 21 11 00 FACILITY FIRE-SUPPRESSION WATER-SERVICE PIPING
 21 11 19 FIRE DEPARTMENT CONNECTIONS
 21 13 13 WET PIPE SPRINKLER SYSTEMS

DIVISION 22 – PLUMBING

22 00 00 GENERAL PLUMBING PROVISIONS
 22 00 50 PLUMBING
 22 11 13 FACILITY WATER DISTRIBUTION PIPING
 22 13 13 FACILITY SANITARY SEWERS

DIVISION 23 – HEATING VENTILATING AND AIR CONDITIONING

23 01 00 GENERAL MECHANICAL PROVISIONS
 23 05 00 COMMON WORK RESULTS FOR HVAC
 23 05 13 COMMON MOTOR REQUIREMENTS FOR HVAC EQUIPMENT
 23 05 29 HANGERS AND SUPPORTS FOR HVAC PIPING AND EQUIPMENT
 23 05 53 IDENTIFICATION FOR HVAC PIPING AND EQUIPMENT
 23 05 93 TESTING, ADJUSTING, AND BALANCING FOR HVAC
 23 07 00 HVAC INSULATION
 23 08 00 COMMISSIONING OF HVAC
 23 09 23 DIRECT DIGITAL CONTROL AND ENERGY MANAGEMENT SYSTEM *New Section*
 23 23 00 REFRIGERANT PIPING
 23 31 13 METAL DUCTS
 23 31 16 NONMETAL DUCTS
 23 33 00 AIR DUCT ACCESSORIES
 23 34 23 HVAC POWER VENTILATORS
 23 34 33 AIR CURTAINS
 23 54 00 FURNACES
 23 81 26 SPLIT SYSTEM AIR CONDITIONERS

DIVISION 26 – ELECTRICAL

26 00 00	ELECTRICAL
26 05 00	COMMON WORK RESULTS FOR ELECTRICAL
26 40 00	LOW VOLTAGE ELECTRICAL TRANSMISSION
26 50 00	LIGHTING FIXTURES

DIVISION 27 – COMMUNICATIONS

27 00 00	COMMUNICATIONS GENERAL
27 05 28	COMMUNICATIONS INFRASTRUCTURE SYSTEM
27 10 00	STRUCTURED CABLING SYSTEM
27 51 13	NOTIFICATION PAGING & CLOCK SYSTEMS

DIVISION 28 – ELECTRONIC SAFETY AND SECURITY

28 31 00	FIRE ALARM AND DETECTION
----------	--------------------------

SITE AND INFRASTRUCTURE SUBGROUP**DIVISION 31 – EARTHWORK**

31 00 00	OFFSITE DEVELOPMENT
31 10 00	SITE CLEARING
31 11 00	CLEARING AND DEMOLITION
31 20 00	EARTHWORK
31 31 00	SOIL TREATMENT

DIVISION 32 – EXTERIOR IMPROVEMENTS

32 12 00	PAVEMENT
32 13 13	CONCRETE PAVING
32 13 14	MISCELLANEOUS CONCRETE FLATWORK AND SITE WORK
32 13 73	CONCRETE PAVING JOINT SEALANTS
32 19 19	ORNAMENTAL METAL
32 31 13	CHAIN LINK

DIVISION 33 – UTILITIES

33 41 00	STORM UTILITY DRAINAGE PIPING
----------	-------------------------------

APPENDICES

APPENDIX “B”	– INTERIOR COLOR SCHEDULE
APPENDIX “C”	– EXTERIOR COLOR SCHEDULE

END OF SECTION

SECTION 012300 – ALTERNATES

PART 1 - GENERAL

1.1 SUMMARY

- A. This Section includes the following:
 - 1. Provide all material, labor, equipment and services necessary to completely install or remove all materials, accessories and other related items necessary to add or delete from the Project as indicated by the alternates in the Contract Documents.
 - a. Any services such as utilities that are meant to pass thru the Alternate areas that serve other areas not involved shall be maintained as part of the Base Bid whether indicated or not.
- B. Related Sections: The following Project Manual Sections contain requirements that relate to this section:
 - 1. ALL DIVISION 00 SPECIFICATION SECTIONS.
 - 2. ALL DIVISION 01 SPECIFICATION SECTIONS.
 - 3. ALL SPECIFICATION SECTIONS IN THE FACILITY CONSTRUCTION SUBGROUP.
 - 4. ALL SPECIFICATION SECTIONS IN THE FACILITY SERVICES SUBGROUP.
 - 5. ALL SPECIFICATION SECTIONS IN THE SITE AND INFRASTRUCTURE SUBGROUP.

1.2 DEFINITIONS

- A. Alternate: An amount proposed by bidders and stated on the BID FORM for certain work defined in the Bidding Requirements that may be added to or deducted from the Base Bid amount if the Owner decides to accept a corresponding change either in the amount of construction to be completed or in the products, materials, equipment, systems, or installation methods described in the Contract Documents.
 - 1. The cost or credit for each alternate is the net addition to or deduction from the Contract Sum to incorporate alternate into the work. No other adjustments are made to the Contract Sum.

1.3 SUBMITTALS

- A. Submit in accordance with Specification Section - SUBMITTAL PROCEDURES:
 - 1. Quality Assurance/Control Submittals:
 - a. Notification Letter:
 - 1) Submit three (3) copies of Notification Letter to all concerned on the status of all ALTERNATES.

1.4 QUALITY ASSURANCE

- A. Procedures:
 - 1. Coordination: Modify or adjust affected adjacent work as necessary to completely integrate work of the alternate into the Project.

- a. Include as part of each alternate, miscellaneous devices, accessory objects, and similar items incidental to or required for a complete installation whether or not indicated as part of alternate.
- a. Provide Lump Sum Price (and all itemized prices) for construction of the Base Bid and each Alternate Bid on the BID FORM.
- 2. Notification: Immediately following award of the Contract, notify each party involved, in writing, of the status of each alternate. Indicate if alternates have been accepted, rejected, or deferred for later consideration. Include a complete description of negotiated modifications to alternates.
- 3. Execute accepted alternate under the same conditions as other work of the Contract.

PART 2 - PRODUCTS

NOT APPLICABLE

PART 3 - EXECUTION

3.1 SCHEDULE OF ALTERNATES

- A. General: All Alternate descriptions are general in nature. Refer to the contract drawings for specific scope of work.

B. ADDITIVE ALTERNATE – SNACK BAR BUILDING P2

- 1. Base Bid:
 - a. BUILDING: Add Electrical Building P2, (as defined in the Architectural Sheets).
 - b. UTILITIES: Add all associated work defined by the Plumbing, Fire Sprinklers, and Mechanical and Electrical and Civil Storm Drain connections.
- 2. Alternate Bid:
 - a. BUILDING: Add Snack Bar Building P2, (as defined in the Architectural Sheets)
 - b. UTILITIES: Add all associated work defined by the Plumbing, Fire Sprinklers, and Mechanical and Electrical and Civil Storm Drain connections.

END OF SECTION

SECTION 042200 – CONCRETE MASONRY UNITS

PART 1 - GENERAL

1.1 SUMMARY

- A. This Section includes the following:
1. Provide all material, labor, equipment and services necessary to completely install all Concrete Masonry Unit (CMU) materials, accessories and other related items necessary to complete the Project as indicated by the Contract Documents.
 - a. Section includes liquid water-repellent admixture added to the concrete masonry units at the time of manufacture.
- B. Related Sections: The following Project Manual Sections contain requirements that relate to this section:
1. ALL DIVISION 00 SPECIFICATION SECTIONS.
 2. ALL DIVISION 01 SPECIFICATION SECTIONS.
 3. 03 11 01 CONCRETE FORMWORK
 4. 03 15 14 DRILLED ANCHORS
 5. 03 20 00 REINFORCEMENT
 6. 03 30 00 CAST-IN-PLACE CONCRETE
 7. 05 12 00 STEEL AND FABRICATIONS
 8. 05 30 00 METAL DECK
 9. 06 10 00 ROUGH CARPENTRY
 10. 06 41 23 MODULAR CASEWORK
 11. 07 14 16 FLUID-APPLIED WATERPROOFING
 12. 07 21 00 INSULATION
 13. 07 60 00 SHEET METAL
 14. 07 92 00 SEALANTS
 15. 08 16 13.01 FIBERGLASS DOORS AND FRAMES
 16. 08 33 00 COILING DOORS
 17. 09 22 16 METAL FRAMING
 18. 09 24 00 CEMENT PLASTER
 19. 09 29 00 GYPSUM BOARD
 20. 09 65 10 RESILIENT BASE AND ACCESSORIES
 21. 09 91 00 PAINTING
 22. 10 14 00 IDENTIFYING DEVICES
 23. 10 21 13 TOILET PARTITIONS
 24. 10 28 13 TOILET ACCESSORIES
 25. 10 44 00 FIRE PROTECTION SPECIALTIES
 26. 31 20 00 EARTHWORK
 27. 32 31 13 CHAIN LINK
 28. ALL SPECIFICATION SECTIONS IN THE FACILITY SERVICES SUBGROUP.
 29. ALL SPECIFICATION SECTIONS IN THE SITE AND INFRASTRUCTURE SUBGROUP.

1.2 REFERENCES

- A. Standards:
1. In accordance with the following standards:
 - a. ACI American Concrete Institute

- b. ASTM American Society of Testing Materials
- c. CMACN Concrete Masonry Association of California and Nevada
- d. NCMA National Concrete Masonry Association
 - 1) TEK Bulletins
- e. TMS The Masonry Society

1.3 DEFINITIONS

- A. The following definitions occur within the CMU Industry:
 - 1. Grout: The filler within the Cells of the Concrete Masonry Units.
 - 2. Mortar: The joint material between the Concrete Masonry Units, both Top and Bottom and on the Ends.

1.4 SUBMITTALS

- A. Submit in accordance with Specification Section - SUBMITTAL PROCEDURES:
 - 1. Product Data: For each type of product specified.
 - a. Manufacturer's standard color range for selection by the Architect.
 - b. All data regarding Concrete Masonry Unit, type, and aggregate to be provided.
 - c. All data regarding mortar and grout materials, and mix designs to be provided.
 - d. All data regarding accessories to be provided.
 - 2. Shop Drawings: For the following.
 - a. Masonry Units: Show sizes, profiles, coursing, and locations of special shapes.
 - b. Reinforcing Steel: Detail bending and placement of concrete masonry unit reinforcing bars.
 - 3. Samples. For each type, texture and color selected.
 - a. Provide 4" x 4" x 1" nominal size Concrete Masonry samples for texture, color, finish and dimension provided on this project as examples of the major CMU Units for the project.
 - 1) Provide other chips for all others.
 - b. Pigmented Mortar: Make samples using the same sand and mortar ingredients to be used on this project.
 - 1) Label samples to indicate types and amount of pigments used.
 - 4. Quality Assurance/Control Submittals:
 - a. Test Reports:
 - 1) Concrete Masonry Units: Lineal Shrinkage and Compressive Strength per ASTM C 140 "Test Methods for Sampling and Testing Concrete Masonry Units and Related Units" and ASTM C 426 "Standard Test Method for Linear Drying Shrinkage of Concrete Masonry Units."
 - 2) Mortar and Grout: Grout Compressive Strength and Mortar Properties per ASTM C 270 "Specification for Mortar for Unit Masonry."
 - 3) Masonry Core test shall be in accordance with CBC Section 2105A.4.
 - b. Certificates:
 - 1) Concrete Masonry Unit Manufacturers Certification per ASTM C 90 "Specification for Loadbearing Concrete Masonry Units."
 - 2) Concrete Masonry Unit Accessory Material Suppliers Certification.
 - 3) CMU producer shall be certified by the manufacturer of integral CMU water repellent admixture.
 - 4) Installer Certification.
 - 5) Contractors Certification.
 - 5. Project Closeout Submittals:
 - a. Warranty.

- b. Project Record Documents: In accordance with Specification Section – PROJECT CLOSEOUT.

1.5 QUALITY ASSURANCE

- A. Qualifications:
 - 1. Material:
 - a. Manufacturers certification that Concrete Masonry Units furnished meet or exceed the requirements of this Specification Section per ASTM C 90 "Specification for Loadbearing Concrete Masonry Units".
 - 2. Suppliers certification for all grout and mortar materials (including aggregate, cement and admixtures) that items furnished meet or exceed the requirements of this Specification Section and per ASTM C 270 "Specification for Mortar for Unit Masonry" • and ASTM C 476 "Specification for Grout for Masonry."
 - a. Water Permeance of Masonry: ASTM E 514, "Standard Test Method for Water Penetration and Leakage through Masonry."
 - b. Compressive Strength of Masonry Prisms: ASTM C 1314, "Standard Test Method for Constructing and Testing Masonry Prisms Used to Determine Compliance with Specified Compressive Strength of Masonry."
 - c. Drying Shrinkage of CMU: ASTM C 426, "Standard Test Method for Drying Shrinkage of Concrete Masonry Units."
 - 3. Installer:
 - a. Engage an experienced Installer who has successfully completed three (3) projects of similar scope and size to that indicated for this Project.
 - 4. Manufacturer/Supplier:
 - a. Firm experienced in successfully producing/supplying products similar to that indicated for this Project, with sufficient production/supply capacity to produce/supply required units without causing delay in the work.
 - b. Manufacturer belonging to the CMACN.
- B. Regulatory Requirements:
 - 1. In accordance with Specification Section - REGULATORY REQUIREMENTS, and the following:
 - a. CARB Materials and equipment used for this Project shall comply with the current applicable regulations of the California Air Resources Board (CARB) and the Environmental Protection Agency (EPA), in the area where the project is located.
- C. Certificates:
 - 1. Installer's certification that Concrete Masonry Units installation meets or exceeds the requirements of this Specification Section.
 - 2. Contractor's certification that Concrete Masonry Unit materials and installation meets or exceeds the requirements of this Specification Section.
- D. Mockups:
 - 1. Provide a four (4) foot by six (6) foot mock-up wall showing all Concrete Masonry Unit finishes in conjunction with one another, and the mortar joints and tooling required for this Project. Mock-up, once approved, will be the basis for verifying the aesthetic and structural quality of the work for this Project. Protect during construction.
- E. Meetings:
 - 1. Pre-Installation: Schedule prior to the start of work.
 - a. Coordinate the work with other work being performed.

- b. Identify any potential problems, which may impede planned progress and proper installation of work regarding quality of installation and warranty requirements.
- c. Include discussions on the integral water-repellent CMU admixture and water-repellent mortars.
- 2. Progress: Scheduled by the Contractor during the performance of the work.
 - a. Review for proper installation of work progress and properly tooled joints.
 - b. Identify any installation problems and acceptable corrective measures.
 - c. Identify any measures to maintain or regain project schedule if necessary.
- 3. Completion: Scheduled by the Contractor upon proper completion of the work.
 - a. Inspect and identify any problems, which may impede issuance of warranties or guaranties.
 - b. Maintaining installed work until the Notice of Substantial Completion has been executed.

1.6 DELIVERY, STORAGE, AND HANDLING

- A. Packing, Shipping, Handling, and Unloading:
 - 1. Products shall be handled in such a manner as to assure that they are free from spalls, breakage and other damage.
- B. Acceptance at Site:
 - 1. Products must be in manufacturer's original wrapped pallets with labels indicating brand name, model, and grade.
 - 2. Damaged products will not be accepted.
- C. Storage and Protection:
 - 1. Products shall be stored above ground on level platforms, six (6) inches above ground, allowing air circulation under stacked units.
 - a. Cover materials with protective waterproof covering providing for adequate air circulation and ventilation to prevent wetting prior to use.

1.7 PROJECT CONDITIONS

- A. Environmental Requirements:
 - 1. Rain: Work under this section shall not be started or maintained under threat of rain unless the work is protected from the rain.
 - 2. Temperature: Ambient temperature to install products shall be forty (40) degrees Fahrenheit and rising.
- B. Existing Conditions:
 - 1. Examine site and compare it with the drawings and specifications. Thoroughly investigate and verify conditions under which the work is to be performed. No allowance will be made for extra work resulting from negligence or failure to be acquainted with all available information concerning conditions necessary to estimate the difficulty or cost of the work.
 - 2. Conduct work so as not to interfere unnecessarily with adjacent roads, streets, drives and walks.

1.8 WARRANTY

- A. Contractor's General Warranty:
 - 1. In accordance with Specification Section - WARRANTIES.

- B. Manufacturer's Warranty:
 - 1. In accordance with manufacturer's written standard warranty:
 - a. Warranty Period One (1) Year.
- C. Installer's Warranty:
 - 1. In accordance with the terms of the Specification Section - WARRANTIES
 - a. Warranty Period One (1) Year.

PART 2 - PRODUCTS

2.1 MANUFACTURERS

- A. These products listed herein establish the size, pattern, color range and function selected by the Architect for this Project. Manufacturers that are listed as acceptable alternative manufacturers and substitutions must still comply with the requirements of this project and the products listed in order to be approved as an equivalent during the Submittal Process. If the acceptable alternative manufacturers listed or substitutions are not approved during the Submittal Process due to non-compliance with the contract documents, then the Contractor shall submit product specified.
 - 1. Specified Concrete Masonry Unit product manufacturer:
 - a. BASALITE.
 - 2. Specified Integral Water Repellent Admixture for CMU Production:
 - a. "Rheopel" as manufactured by BASF, or
 - b. "RainBloc" as manufactured by ACM CHEMISTRIES, or
 - c. "Dry-Bloc II" as manufactured by W. R. GRACE and CO.
 - 3. Specified Pre-Blended Water Repellent Admixture for Mortar:
 - a. "Rheopel Plus" as manufactured by BASF, or
 - b. "RainBlock" as manufactured by ACM CHEMISTRIES, or
 - c. "Dry-Bloc Integral Water Repellent" as manufactured by W. R. GRACE and CO.
 - 4. Specified Grout Admixture product manufacturer:
 - a. "Grout Aid" by SIKA.
 - 5. Specified Joint Reinforcement, Ties and Anchors product manufacturer:
 - a. HOHMANN AND BARNARD, INC.
- B. Products from other manufacturers not listed must submit in accordance with Specification Section - SUBSTITUTION PROCEDURES.

2.2 MATERIALS

- A. Block:
 - 1. Hollow Load Bearing Units in accordance with CBC Section 2103A.1, and ASTM C 90 "Standard Specification for Loadbearing Concrete Masonry Units," (126 pcf of concrete or greater):
 - a. Primary Aggregate Lightweight Expanded Shale aggregate.
 - 1) The aggregate used for all Precision Faced Units not visible on the exterior or the interior, can be Pumice aggregate.
 - b. All exposed Concrete Masonry Units shall have integral color from manufacturer per material standard ASTM C 979 "Specification for Pigments for Integrally Colored Concrete."
 - 1) Including all colors to maximum dye content of 6 percent.

- c. Maximum lineal shrinkage from saturated to over dry condition of not more than 0.065 percent.
 - d. Twenty-eight day compressive strength of 2,000 psi on net area.
 - e. Integral CMU Water-Repellent:
 - 1) Integral liquid admixture mixed with concrete during production of CMUs.
 - 2) Water Permeance of Masonry: Capable of achieving a Class E Rating when evaluated using ASTM E 514 "Test Method for Water Penetration and Leakage Through Masonry."
 - f. Compressive Strength of Masonry Prisms: No statistically lower compressive strength of prisms shall occur as a result of adding integral water-repellent CMU and mortar admixtures when compared to a control (containing no admixtures) CMU and mortar when tested according to ASTM C 1314 "Test Method for Compressive Strength of Masonry Prisms."
 - g. Drying Shrinkage of CMU: No statistically higher drying shrinkage of the CMU shall occur as a result of adding integral water-repellent CMU admixture when compared to a control (containing no admixtures) CMU when tested according to ASTM C 426 "Standard Test Method for Linear Drying Shrinkage of Concrete Masonry Units."
- 2. Nominal Face Dimensions and Finishes: See drawings for locations of Concrete Masonry Unit types and sizes.
 - 3. CMU Color and Finish:
 - a. Interior Building Faces S-93(R) Precision Face, Light Weight.
 - b. Exterior Building Faces S-93(R) Ground Face, Light Weight.
 - c. Site Wall Faces S-93(R) Ground Face, Light Weight.
- B. Joint Reinforcement, Ties and Anchors:
- 1. General: Comply with requirements below for basic materials, as well as requirements for each form of joint reinforcement, tie, and anchor for size and other characteristics.
 - 2. Hot-Dip Galvanized Steel Wire: Uncoated wire in accordance with ASTM A 82 "Specification for Steel Wire, Plain, for Concrete Reinforcement," with zinc coating applied after prefabrication into units in accordance with ASTM A 123 "Specification for Zinc (Hot-Dip Galvanized) Coatings on Iron and Steel Products," 1.5 oz. per sq. ft. of wire surface.
 - 3. Joint Reinforcement: Welded-wire units prefabricated with deformed continuous side rods and plain cross rods into straight lengths of not less than 10 feet, with prefabricated corner and tee units.
 - a. Width: Approximately 2 inches less than nominal width of walls and partitions, providing mortar cover of not less than 5/8 inch on joint faces exposed to exterior and 1/2 inch elsewhere.
 - b. Wire Size, Side Rods: 10 gage, 0.15 inches.
 - c. Wire Size, Cross Rods: 9 gage, 0.15 inches.
 - d. Wire Size, Two-Piece Adjustable: 9 gage diameter in exterior walls.
 - e. Single-Wythe Configuration: Truss design, continuous diagonal cross rods spaced not more than 16 inches on center.
 - f. Truss type units with side rods spaced for embedment within each face shell of back-up wythe, ties extended to within 1 inch of exterior face of facing wythe.
 - g. Flexible Anchors: Masonry to Structural Framework: Two-piece anchors permitting vertical or horizontal differential movement between wall and framework parallel to, but resisting tension and compression forces perpendicular to, plane of wall.
 - 1) Anchorage to Steel Framework: Manufacturer's standard anchors with crimped 1/4 inch diameter wire anchor section for welding to steel 3/16", triangular-shaped wire tie section sized to extend within 1 inch of exterior face of facing wythe.

- h. Unit Type Masonry Inserts in Concrete: Cast iron or malleable iron inserts of type and size indicated.
 - i. Dovetail Slots: Dovetail slots with filler strips, of slot size as required; 22 gage sheet metal.
 - j. Anchor Bolts: Steel bolts with hex nuts and flat washers, complying with ASTM A 307 "Specification for Carbon Steel Bolts and Standards, 60,000 PSI Tensile Strength," Grade A, hot dip galvanized complying with ASTM A 153 "Specification for Zinc Coating (Hot Dip) on Iron and Steel Hardware• ," Class C; sizes and configurations indicated.
 - k. Reinforcing Bars: In accordance with Specification Section - REINFORCEMENT, deformed steel, per ASTM A 615 "Specification for Deformed and Plain Carbon-Steel Bars for Concrete Reinforcement," Grade 60 for bars No. 3 to No. 18.
4. Miscellaneous Masonry Accessories:
- a. Non-Metallic Expansion Joint Strips: Premolded, flexible cellular neoprene rubber filler strips, complying with ASTM D 1056 "Specification for Flexible Cellular Materials – Sponge or Expanded Rubber," Grade RE41E1, capable of compression up to 35 percent; width and thickness as required.
 - b. Weepholes: Pre-manufactured weeps.
- C. Mortar and Grout:
- 1. In accordance with the following:
 - a. Cement: In accordance with ASTM C 150 "Standard Specification for Portland Cement," Type II.
 - b. Hydrated Lime: In accordance with ASTM C 207 "Standard Specification for Hydrated Lime for Masonry Purposes," Type S, unless otherwise noted.
 - c. Quicklime: In accordance with ASTM C 5 "Standard Specification for Quicklime for Structural Purposes."
 - d. Lime Putty: Made from hydrated lime or quicklime.
 - 1) If made from quicklime, other than processed pulverized quicklime, slake lime and then screen through a No. 16 mesh sieve. Before using, store and protect slaked and screened lime putty for not less than 10 days.
 - 2) Processed pulverized quicklime shall be slaked for not less than 48 hours, and shall be cool when used.
 - 3) Lime putty prepared from hydrated lime may be used immediately after mixing.
 - 4) Lime putty prepared from quicklime or pulverized quicklime shall have a plasticity figure, after slaking and screening, or not less than 200, and shall weigh not less than 83 lbs. per cubic foot. Lime putty prepared from hydrated lime shall conform to ASTM C 207 "Standard Specification for Hydrated Lime for Masonry Purposes," Type S.
 - e. Mortar Sand: In accordance with ASTM C 144 "Standard Specification for Aggregate for Masonry Mortar."
 - f. Modified Mortar Sand:
 - 1) In accordance with ASTM C 144 "Standard Specification for Aggregate for Masonry Mortar" modified to not less than 3 percent shall pass the No. 100 sieve.
 - g. Grout Aggregate: 3/8 inch maximum size and in accordance with ASTM C 404 "Standard Specification for Aggregates for Masonry Grout."
 - h. Grout Admixture: SIKA "Grout Aid," Type II.
 - i. Water: Clean and free of harmful amounts of acid, salts, alkali's, or organic materials.

2.3 MIXES

A. Mortar:

1. In accordance with CBC Section 2103A.2 and ASTM C 270 "Specification for Mortar for Unit Masonry".
2. Pre-Blended Mortar Mix:
 - a. In accordance with ASTM C 270 "Specification for Mortar for Unit Masonry," Type S.
3. Compressive Strength:
 - a. See General Structural Drawings from the Structural Engineer.
 - b. 1,800 psi at 28 days minimum.

B. Grout:

1. In accordance with CBC Section 2103A.3 and ASTM C 476 "Specification for Grout for Masonry."
2. Pre-Blended Bag Grout:
 - a. In accordance with ASTM C 476 "Specification for Grout for Masonry."
3. Coarse Grout Mix unless otherwise noted.
4. Compressive Strength:
 - a. See General Structural Drawings from the Structural Engineer.
 - b. 2,000 psi at 28 days minimum.

2.4 SOURCE QUALITY CONTROL

A. Fabrication Tolerances:

1. All materials, equipment and placing operations shall be subject to inspection, tests and approval at all times. Agent shall have access to all places where Concrete Masonry Unit materials are proportioned, mixed, cured and stored.

B. Tests and Inspection:

1. All tests will be performed by the Owner's Testing laboratory Agency in accordance with the Specification Section – TESTING LABORATORY SERVICES.
2. Concrete Masonry Units shall be tested per ASTM C 140 "Test Methods for Sampling and Testing Concrete Masonry Units and Related Units• " and CBC Section 1705A.4.
 - a. Lineal Shrinkage: In accordance with ASTM C 426 – "Standard Test method for Drying Shrinkage of Concrete Block."
 - b. Compressive Strength: In accordance with ASTM C 140 – "Sampling and Testing of Concrete Masonry Units."
 - c. Test three (3) samples of each type of the Concrete Masonry Unit prior to construction.
3. Mortar Tests: At the beginning of Masonry Work, at least 1 test sample each of mortar and grout shall be taken on 3 successive working days, then once per week with at least one sample taken for each 5,000 square feet of wall area, or fraction thereof.
 - a. Test specimens for mortar shall be made in accordance with ASTM C 780 "Test method for Preconstruction and Construction Evaluation of Mortars for Plain and Reinforced Unit Masonry." Test specimens shall be continuously stored in moist air until tested.
 - b. Mortar shall show a compressive strength of not less than 1,800 psi at 28 days.
4. Grout Tests: At the beginning of Masonry Work, at least 1 test sample each of grout shall be taken on 3 successive working days, then once per week with at least one sample taken for each 5000 square feet of wall area, or fraction thereof.

- a. Test specimens for grout shall be made in accordance with ASTM C 476 "Specification for Grout for Masonry" • and CBC Section 1705A.4 Test specimens shall be continuously stored in moist air until tested.
 - b. Grout shall show a compressive strength of not less than 2,000 psi at 28 days.
- C. Verification of Performance:
1. A special inspector shall be employed during the placement of all units, placement of all reinforcing steel, during all grouting operations and during taking of all test specimens.
 2. Reports:
 - a. Special Inspector shall submit to Architect and to DSA two copies of each report showing results of tests and inspections.
 - b. Report shall state that tests and inspections were made in accordance with specifications.
 - c. Report shall state whether materials were in conformance with specifications.
 3. Cost of testing and inspection will be paid by the Owner, unless otherwise specified. Contractor shall pay all costs of re-inspection and/or re-tests due to non-compliance with specifications as a reimbursement directly to the Owner.

PART 3 - EXECUTION

3.1 EXAMINATION

- A. Site verification of conditions:
1. Prior to the execution of the work under this specification section, inspect the installed work executed under other sections of this Project Manual which, affect the execution of work under this specification section.
 2. Report unacceptable conditions to the Architect. Do not begin work until unacceptable conditions have been corrected.
 3. Execution of work under this specification section shall constitute acceptance of existing conditions.

3.2 PREPARATION

- A. Coordination:
1. Coordinate work under this specification section with work specified under other sections to ensure proper and adequate interface of work.
 - a. Installation of bolts, reinforcing, inserts, etc. as required.
 - b. Check and be responsible for accuracy of dowel locations in concrete where dowels project into Concrete Masonry Unit work.
 2. Control Joints:
 - a. See drawings for type and location of control joints.
 3. Bond Beams:
 - a. Bond beams shall be located where shown and detailed on the drawings, and shall be reinforced as indicated and as here after specified.
 4. Built-in Work:
 - a. Miscellaneous Embedded Items: All items indicated to be embedded in masonry shall be carefully located and anchored to prevent movement during grouting operations. Avoid cutting and patching.
 - 1) Install all anchor bolts and anchors furnished under other sections.
 5. Cutting or Patching:

- a. Obtain approval prior to cutting or fitting any area not indicated or where appearance or strength of masonry work may be impaired.

B. Protection:

1. Protect all adjacent surfaces from drips, spray, air pollution of the surrounding environment, and other damage from work under this specification section.
2. Protect and cover the top of all Concrete Masonry Unit walls at the end of each day's work to minimize water intrusion, regardless of the time of year.
 - a. Continue to temporarily cover the top of the walls until the final parapet cap is installed, and the sealer coats are applied.

C. Surface Preparation:

1. Prepare surface in accordance with manufacturer's written instructions and recommendations.
2. Clean substrates of substances (oil, grease, rolling compounds, incompatible primers, loose mill scale, etc.) which could impair bond of materials specified within this section.
3. Top surfaces of foundation or slab to receive Concrete Masonry Units shall be clean, rough, and free of laitance, as specified in Specification Section - CAST-IN-PLACE CONCRETE, PART 3. Roughness amplitude shall be a minimum of one-fourth inch.

3.3 INSTALLATION

A. General:

1. In accordance with Regulatory Requirements and TMS 602.
2. Set plumb, level, and square.
3. Provide temporary bracing during erection of masonry work. Maintain in place until masonry has set to provide permanent bracing.

B. Layout:

1. Lines shall be straight, true and built accurately to dimension.
2. Masonry lines and levels shall be placed to the following tolerances:
 - a. Variation from unit to adjacent unit: 1/8 inch maximum.
 - b. Variation from plane of wall: 1/4 inch in 10 feet.

C. Reinforcement Bar installation:

1. Installation of Vertical Reinforcement Bars:
 - a. Where possible, bars shall be one length and centered in open end of Concrete Masonry Units unless noted otherwise on drawings.
 - b. Bar may be doweled at top of footing.
 - c. Bars shall be accurately and positively held in place before setting Concrete Masonry Units by wiring to a 2 x 6 properly braced near top of bars and not over 8 feet above foundation or at last Grout pour.
 - d. For Low Lift Grout, corner bars and other bars in closed cell units shall be lapped a minimum of 48 bar diameters, unless indicated otherwise.
 - e. All vertical reinforcing steel shall be braced throughout its height in a manner that will retain the steel in proper position and provide the proper clearance at spacing not to exceed 192 bar diameters.
2. Installation of Horizontal Reinforcing Bars:
 - a. Bars shall be laid in bond beam units directly on top of the cross walls of block webs.
 - b. Lap splice bars a minimum of 48 bar diameters, unless indicated otherwise.
 - c. Reinforcing steel shall be secured to all foundation dowels and held in place at spacing not to exceed 192 bar diameters.

3. Wire horizontal and vertical bars together.
4. Reinforcing steel shall not be bent or straightened in a manner that will injure the material. Bars with kinks or bends not shown on the plans shall not be used. Heating of bars for bending will not be permitted.
5. Bars shall conform accurately to the sizes, shapes, lines and dimensions shown on drawings and with hooks and beds made as detailed. Bars shall be placed as indicated on the drawings and centered on grout space.
6. At the time grout is placed around it, reinforcing steel shall be clean of mill scale or other coatings that will destroy or reduce bond.

D. Setting of Concrete Masonry Units - In accordance with the following:

1. Bonds: Use Running Bond, or as shown on details.
 - a. Place masonry to lines and levels indicated to the following tolerances:
 - 1) Variation from Unit to Adjacent Unit: 1/8-inch max.
 - 2) Variation from Plane of Wall: 1/4-inch in 10 feet.
 - b. Bond: Unless noted otherwise, lay concrete masonry units in bond pattern indicated with vertical joints located over score of unit in course below (and vice versa).
 - c. Maintain masonry courses to uniform width. Make vertical and horizontal joints equal and of uniform thickness.
 - d. Preserve the vertical continuity of cells in concrete unit masonry. The minimum clear horizontal dimensions of vertical cores shall be 3" x 3" for 8-inch wide block.
2. Align vertical cells to maintain vertical continuity of cells to be filled. Open end or notched units may be used to facilitate installation around cells that contain vertical reinforcement. Minimum unobstructed vertical flue 3" x 3". Remove overhanging mortar or other obstructions or debris from inside of cells.
3. Provide bond beam units at cells containing horizontal reinforcement.
4. Integral Water-Repellent CMU:
 - a. Installer shall use only mortar containing compatible integral liquid water-repellent mortar admixture at the manufacturer's recommended addition rate and mixed according to manufacturer's recommended instructions for construction of water repellent masonry exterior walls.
 - b. Cover top of unfinished masonry work to protect it from the weather and to prevent accumulation of water in the cells of the CMU.
 - c. Cleaning:
 - 1) Remove "primary" efflorescent from masonry walls exposed in the finished work in accordance with the manufacturer's recommendations and the NCMA TEK Bulletin #8-3A.
 - 2) Remove dirt or stains from masonry walls exposed in the finished work in accordance with the manufacturer's recommendations and the NCMA TEK Bulletin #8-2A.
 - 3) Promptly remove excess wet mortar and grout containing integral water-repellent mortar admixture from the face of the masonry as work progresses. Do not use strong acids, over-aggressive sandblasting or high-pressure cleaning methods.
 - 4) Comply with applicable environmental laws and restrictions.
5. Joints:
 - a. Set Concrete Masonry Units in full shoveled bed of Mortar.
 - b. Width of joint: 3/8 inch.
 - 1) Depth of joint: Equal to Face Shell Wall Thickness.
 - c. Head joints shall be solidly filled.
 - d. Mortar Joint Finish Method:

- 1) All mortar joints shall be compressed and shaped by a specific designated tool throughout the project. Provide identical tools when more than one worker is scheduled to finish joints.
 - 2) At exposed and concealed surfaces:
 - a) Vertical Joints: Compressed, Raked and Tooled joints.
 - b) Horizontal Joints: Compressed, Raked and Tooled joints.
 - 3) Provide compressed Flush Joints when other material is to be applied directly onto and over Concrete Masonry Units being covered (including areas covered by rubber base).
6. Vertical Control Joints:
- a. Space joints at 25'-4" o.c. maximum, unless specifically noted otherwise. Joints shall be spaced symmetrically and uniformly and shall be subject to the Architect's approval.
 - b. All joints shall be through wall separations with horizontal reinforcing discontinuous.
 - c. All joints shall be sealed with backer rods and urethane sealant on both faces. Refer to Specification Section - SEALANTS for sealant requirements.
7. Prior to grouting, the grout space shall be clean so that all spaces to be filled with grout do not contain mortar projections greater than 1/4 inch, mortar droppings and other foreign material, per CBC Section 2104A.1.3.
8. Do not install cracked, broken, chipped or stained masonry units.
9. Lay only dry concrete masonry units.
10. Lay masonry in full bed of mortar, properly jointed with other work. Deep or excessive furrowing of mortar joints is not permitted.
- a. Block Cap: Lay with full mortar coverage on horizontal and vertical joints.
 - b. Install grout cap where and as indicated.
11. Fully bond intersections and external and internal corners.
12. Do not shift or tap masonry units after mortar has taken initial set. Where adjustments must be made, remove mortar and replace.
13. Remove excess mortar.
14. Perform job-site cutting with proper tools to provide straight unchipped edges. Take care to prevent breaking masonry unit corners or edges.
15. Step back unfinished work for joining with new work. Do not use tothing.
16. Provide cleanouts as indicated in "installation of grout."
- E. Installation of Grout:
1. General:
 - a. All cells shall be grouted solid.
 - b. Use low lift or high lift grouting at Contractor's option.
 - c. Use grout pump, hopper or bucket to place grout.
 - d. Place grout in final position within 1-1/2 hours after introduction of mixing water.
 - e. Place grout and rod with a 3/4 inch flexible cable vibrator sufficiently to case it to flow into all voids between the cells and around the reinforcing steel. Slushing with mortar will not be permitted.
 - f. Stop grout approximately 1-1/2 inches below top of last course, except at top course bring grout to top of wall.
 2. Low Lift Grouting Procedure: In accordance with CBC Section 2104A.1.3.1.2.2, and to be used only if approved by the Architect.
 - a. Set all vertical bars.
 - b. Concrete Masonry Unit walls shall be built up 16 inches high uniformly around one complete building unit. No vertical construction joints will be allowed unless noted and detailed on the drawings.
 - c. Lay Concrete Masonry Units no higher than 24" and clean cells of mortar.
 - d. Lay Concrete Masonry Units a maximum of 48" before grouting.

- e. Set horizontal bars on bond beam unit crosswalls next to verticals.
 - f. If course at top of lift contains horizontal reinforcement, grout all cells to a level 3/4" below the top of the Concrete Masonry Units. This will provide about 1-1/4" grout cover over the horizontal bar. Puddle grout in place using a No. 4 bar or a 1 x 2 stick, and repeat puddling in 30 to 60 minutes.
 - g. Consolidate each lift twice. Once while placing grout and once more after initial absorption of water but before set.
 - h. Repeat steps "c.", "d.", "e." and "f." above until the wall is completed.
3. High Lift Grouting Procedure (only upon prior approval of the Architect, Structural Engineer and DSA) shall be in accordance with CBC Section 2104A.1.3.1.2.3.:
- a. Clean-outs must be provided at the bottom of each pour for each cell.
 - 1) Construct clean out courses with inverted open-bottom bond beam units involved to permit cleaning of all cells by flushing. Cleanouts shall not be less than 3x4 inch openings cut from one full shell. Do not plug cleanout holes until masonry work, reinforcement and final cleaning of the grout spaces have been completed and inspected.
 - b. The Contractor is cautioned that with the high lift method, the walls have very little lateral stability against winds or earthquake before grout has set and it shall be this Contractor's responsibility to adequately brace the walls until the roof sheathing is installed.
 - c. "Dur-O-Wall" reinforcing shall be provided in mortar joints at all wall corners, ends, jambs of openings and wall intersections.
 - d. Lay up walls subject to maximum height limitations of CBC Section 2104A.1.3.1.2.2 or 2104A.1.3.1.2.3.
 - e. Construction procedure shall be as follows:
 - 1) Set all full length vertical bars on center line of wall, centered in cells, and braced as noted above under typical reinforcing.
 - 2) Lay Concrete Masonry Units full height of walls, or 12 feet maximum including wiring horizontal bars to verticals, for one complete building unit. No vertical construction joints will be allowed unless noted and detailed on the drawings.
 - 3) Construct clean out courses with open-bottom bond beam units inverted to permit cleaning of all cells by flushing. Cleanouts shall not be less than 3 x 4 inch openings cut from one full shell. Do not plug cleanout holes until masonry work, reinforcement and final cleaning of the grout spaces have been completed and inspected.
 - 4) Clean all cells and top of foundation wall of mortar by hosing cells with suitable nozzle jet or sandblasting as soon as mortar has partially set. Final cleaning shall be inspected through clean-outs at each cell in base of wall. Remove all mortar fine protruding more than 1/2 inch into the grout space by dislodging the projections with a rod as the work progress or by washing the grout space at least twice a day during erection using a high pressure stream of water.
 - 5) Set vertical bars in closed cells where required; i.e., at wall corners, sides of openings, etc. Wire to horizontals at top and bottom. Use metal spacers at 48" o.c. maximum to hold bars in line.
 - 6) No grout shall be placed until mortar has set a minimum of 3 days in hot weather or 5 days in cold weather, and the top of foundation wall has been thoroughly cleaned and grout plugs have cured a minimum of 48 hours.

- 7) Place grout in lifts not to exceed 4 feet in height, with a waiting period between lifts, dependent on weather and absorption rate of the masonry, in order to place the succeeding lift after the preceding lift becomes plastic but prior to initial set. The first lift shall be consolidated using mechanical vibrators. After the required waiting period, place the second lift and consolidate with the vibrator, reconsolidating the lift below to a depth of 12 to 18 inches. Repeat the waiting, placing and consolidating process until the top of the grout pour is reached. Reconsolidate the top lift after the required waiting period. The high-lift grouting of any section of wall between lateral flow barriers shall be completed to the top of a pour in one working day unless a new series of clean out holes is established and the resulting horizontal construction joint cleaned.
- 8) Repeat items 1 - 7 until all cells are filled. The wall must be grouted to its full height during one working day. No horizontal construction joints will be allowed.
- 9) Above 12 feet level low lift grouting procedures shall be used.

F. Curing:

1. While Concrete Masonry Units are being laid and after, dampen both faces for a period of 3 days using a spray regulated to keep surface damp. After grouting, dampen for a period of 24 hours.

3.4 REPAIR / RESTORATION

A. General:

1. Materials or Workmanship not conforming to appearance or strength specified will be deemed defective and shall be removed and replaced with no change to the contract in time or cost.
2. Remove and replace masonry units which are loose, chipped, broken, stained or otherwise damaged, or if units do not match adjoining units.
3. Pointing: During the tooling of joints, enlarge any voids or holes and completely fill with mortar.
4. Dry brush masonry surface after mortar has set, at the end of each day's work and after final pointing.
5. Leave work and surrounding surface clean and free of mortar sports and droppings.
6. Cleaning: Upon completion of masonry installation, repair all holes. Defective joints shall be cut out and rejointed. Exposed masonry surfaces shall be cleaned free of mortar, or grout stain and efflorescence.

B. Defective Mortar Or Grout:

1. Should the strength of mortar or grout fall below that specified, remainder of Work shall be adjusted to reach required strength. Work in place representing inferior grout and mortar and indicating a strength less than the minimum specified shall be tested by taking and testing core samples. Number and location of cores shall be determined by Structural Engineer.
2. Should compression tests of cores fail to meet required strength, masonry shall be deemed to be defective and shall be removed and replaced at no cost to Owner.
3. Costs relative to taking and testing of core samples shall be paid by the Owner and will be deducted from Contract Amount. Cost of patching core holes shall be borne by the Contractor.

3.5 FIELD QUALITY CONTROL

A. Site Tests:

1. Tests will be performed by the Owner's Testing Laboratory Agency in accordance with the Specification Section – TESTING LABORATORY SERVICES.
2. Mortar and Grout shall be tested per CBC Section 2105A.
 - a. Samples shall be continuously stored in moist air until tested.
 - b. Grout Compressive Strength: For each mix provided, in accordance with ASTM C 1019 "Standard Test Method for Sampling and Testing Grout".
 - c. Mortar Property Specification: For each mix provided in accordance with ASTM C 780 "Standard Test method for Pre-construction and Construction Evaluation of Mortars for Plain and Reinforced Unit Masonry."
3. Masonry Core test shall be in accordance with CBC Section 2105A.4.
4. One set of tests for each 5,000 square feet of wall area or portion thereof.

B. Inspection:

1. Inspections will be performed by the Owner's Project Inspector in accordance with Specification Section – TESTING AND INSPECTION SERVICES.
 - a. Special Project Inspector shall be employed during the placement of all units, placement of all reinforcing steel, during all grouting operations and during taking of all test specimens.
 - 1) Per CBC Section 1701A.4 for DSA/SSS.
2. Schedule inspections and notify the Architect, Project Inspector, Testing Agency and any other regulatory agencies of the time at least 48 hours prior to the inspection.
3. No work shall be without the required inspections.

3.6 CLEANING

A. Clean in accordance with Specification Section - PROJECT CLOSEOUT.

1. At the conclusion of the Concrete Masonry Unit work, the Contractor shall clean down all walls, remove all scaffolding and equipment, clean up all debris, refuse, any surplus materials and remove them from the premises.
2. Concrete Masonry Unit walls shall be brushed daily with a mason's soft hair brush to remove surplus mortar and splattering at scaffolding lines. This must be done immediately after initial, but before final set.
3. Grout or mortar spillage shall be removed by use of clean, plain water before it has a chance to set.
4. In areas not cleaned in accordance with the above, the Architect shall have the right to require sandblasting of the entire wall between concrete columns or piers, between control joints or entire wall unit that includes the affected areas.

B. Removal of Stains and Efflorescence:

1. Removal of Stains: In accordance with NCMA TEK Bulletin #8-2A "Removal of Stains from Concrete Masonry."
2. Removal of Efflorescence: In accordance with NCMA TEK Bulletin #8-3A "Control and Removal of Efflorescence."

3.7 PROTECTION

A. Protection from Weather:

1. Protect newly installed work from temperatures in accordance with CBC 2104A.

CONCRETE MASONRY UNITS

2180

- a. Cold Weather: When ambient air temperature falls below 40 degrees F.
 - b. Hot Weather: When ambient air temperature rises above 100 degrees F.
2. During installation, cover the top of unfinished masonry work to protect it from the weather and to prevent accumulation of water in the cores of the masonry units.

END OF SECTION

SECTION 23 09 23 – BUILDING MANAGEMENT SYSTEM

PART 1 - GENERAL

1.1 GENERAL MECHANICAL PROVISIONS:

- A. The General Mechanical Provisions of Section 23 00 00 shall form a part of this Section with the same force and effect as though repeated here.

1.2 SCOPE:

- A. General: The direct digital control and energy management system (DDC/EMS) includes control panels, control devices, valves, actuators, all line and low voltage control and interlock wiring (including wiring to controllers, switches, timers, relays, etc.) and conduit and related equipment, as required for proper operation of all equipment. Provide all equipment, programming, labor, materials and services necessary for a complete, lawful and operating DDC/EMS as shown or noted on the drawings and as specified herein. All control wiring, line and low voltage shall be installed in conduit. Power wiring, power to DDC/EMS control panels and disconnect switches are included in the Electrical Specifications, except that power wiring for control devices such as controllers, valves, etc., is included in the control system. Electrical work shall be in accordance with Electrical Specifications. The system shall be direct digital control/electric. **The control system shall be direct digital. Johnson Metasys, without substitution, to match existing campus standards. The system shall be Niagara 4 (or later to tie into and match existing campus version), HTML5 based, with open license supervisory controller.** The system shall communicate over the District's Ethernet LAN/WAN, and shall include the latest upgrading (software and firmware) during the warranty period. The data wiring shall have an Ethernet connection at the DDC/EMS panel. A Graphical User Interface (GUI) shall be provided. Coordinate with Section 23 00 01, Heating, Ventilating and Air Conditioning and with Division 26. Comply with ASHRAE 55 and Title 24.
 - 1. All work described in this section shall be installed, wired, circuit tested and calibrated by factory certified technicians qualified for this work.
 - 2. Coordinate and cooperate with commission agent as required by Section 01 91 13.
- B. Contractor Qualifications: All controls shall be furnished and installed by a Contractor who is licensed, certified and approved by the controls manufacturer for design, installation, start-up and service of their product. The Contractor must have sufficient personnel to respond to a trouble call at the site within four hours. The Contractor's local manager shall have a minimum of five years' experience in the design, installation, start-up and service of similar systems. The Contractor shall submit a list of at least five projects which are similar in size, scope and contract value to this project. This list shall include the Owner's contact person, phone number and controls contract value.
- C. Submittals: Within 60 days of contract award, submit eight (8) copies of shop drawings showing the following aspects of the DDC/EMS system (CAD file with DXF format if required of floor and site plans can be secured from the Architect).

1. All termination points, terminal cabinets, and cabling.
 2. Schedule of input and output points.
 3. Locations of all visible DDC/EMS system components (i.e. interior and exterior sensors, terminal strips, panels, trench and pull boxes, etc.), identifying specifically any exposed conduit.
 4. Descriptive literature for all material and equipment items shall include manufacturer's name and catalog numbers, dimensions, capacities, and all other characteristics and accessories as listed in the specifications or on the drawings.
 5. Submit copies of forms to be used for testing and verification showing all data which is to be recorded. Three copies of complete report shall be submitted for review.
 6. Complete written sequence of operation for all controlled equipment.
- D. Installation and Operation Manuals: Furnish Installation and Operating Manuals for all components. These manuals shall contain full documentation which shall include, without being limited to, the following:
1. General description and specifications.
 2. Installation and initial checkout procedures.
 3. Complete alignment and calibration procedures for all components.
 4. Detailed schematics and assembly drawings and communication trunk diagram with control unit addresses.
 5. BACNet architecture diagrams
 6. Sequence of Operations.
 7. Controller points lists.

1.3 SYSTEM ARCHITECTURE

- A. DDC/EMS Equipment: The main controller shall contain the network communications and information management programs providing integrated global control, trend logging, local and remote alarming and fully menu driven user interface. The local network controller must be an intelligent, stand-alone microprocessor based controller which can have a variety of configurations based on their application.
- B. Campus-Wide Data Transfer System: The DDC/EMS shop drawings shall indicate where all equipment items are to be located for input and output to complete the system. The conduit/cabling system shall inter-tie these points as required to complete one system to meet the design criteria herein. Conduit shall be used for all EMS wiring whenever access is limited (hard-lid, walls, etc). When EMS wiring is installed in/above accessible areas (such as T-bar ceilings), free-air with J-hooks and wire-ties is acceptable. However, EMS wiring cannot be intermixed or bundled with any other cabling/wiring (Fire Alarm, internet, etc). System high speed communication shall be hardwired using a Belden shielded cable as recommended by DDC manufacturer.
- C. User Interface Communication: The user may communicate with the DDC/EMS system with a workstation located at the District Office over the WAN, with a remote workstation, with an On-Campus Operator Workstation, or with a Lap-Top computer (Service Tool).
- D. Standard Network Support: All Master Controllers, Workstation(s) and File Server shall be capable of residing directly on the owner's Ethernet TCP/IP LAN/WAN. Furthermore,

the Master Controllers, Workstation(s) and File Server shall be capable of using standard, commercially available, off-the-shelf Ethernet infrastructure components such as routers, switches and hubs. With this design the owner may utilize the investment of an existing or new enterprise network or structured cabling system. This also allows the option of the maintenance of the LAN/WAN to be performed by the owner's Information Technology Department as all devices utilize standard TCP/IP components. If the DDC/EMS contractor needs an additional data port that is not already provided, its installation must be coordinated with the District's IT department (and IT infrastructure contractor if applicable) and shall be installed at the DDC/EMS contractor's expense. As a result, the DDC/EMS contractor shall ensure any additional data port locations are clearly indicated and that the existing EMS data ports they intend to utilize are addressed/identified prior to construction so they are not damaged or removed. This coordination shall occur between the District's Construction Office, IT department, DDC/EMS operator, IT infrastructure contractor (if applicable), and the project's general construction contractor manager.

PART 2 - PRODUCTS

2.1 GENERAL:

- A. General Requirements: The Electronic Microprocessor Based Direct Digital Control and Energy Management System (DDC/EMS) shall monitor the data environment and perform control functions in relation to a programmed strategy and the status of the data environment. The system shall use solid state computer based digital and analog technology. The system shall be standard with the manufacturer to insure on going parts availability and trained technical support. The DDC/EMS shall be of the user programmable type requiring no special computer education for operation. All necessary instruction manuals and user orientation training shall be supplied by the manufacturer or agent thereof. The DDC/EMS shall be UL listed as a Direct Digital Control and Energy Management System. The programmable control requirements of the DDC/EMS shall include, but not be limited to:

OPTIMUM START/STOP (BASED ON HISTORICAL DATA)
TIME OF DAY ROUTINES
SCHEDULED OCCUPANCY ROUTINES INCLUDING HOLIDAYS
CUSTOM TAILORED REPORTING
ACCUMULATING RUN TIME
CRITICAL CONDITION ALARMING
FLUID FLOW SWITCH AND CONTROL ALARMING
PID CONTROL ON ANALOG OUTPUTS
HOT WATER RESET
DAY/NIGHT SETBACK
ECONOMIZER/PURGE
CUSTOM TAILORED REPORTING
ACCUMULATING RUN TIME
POINT OVERRIDE ABILITY FOR EVERY DIGITAL AND ANALOG OUTPUT
SEPARATE MODES AS REQUIRED BY CONTROL SEQUENCE
ALL EXTERIOR LIGHTING CIRCUITS CONTROLLED BY SYSTEM

- B. Environment: The DDC/EMS shall operate in an environment of 40 120 degrees F and 10 95% relative humidity. Sensors and control elements shall operate under the temperature, pressure, humidity, and vibration conditions normally encountered in the installed location. The DDC/EMS shall maintain accuracy as follows:
1. +/- 0.5 F for the space temperatures in the 0 F 130 F range.
 2. +/- 0.5 F for duct temperatures in the 40 F 130 F range.
 3. +/- 1.0 F for outside air temperatures in the 30 230 F range.
 4. +/- 1.0 F for water temperature in the 30 230 F range.
 5. KWH and KW monitoring within 1.0%.
- C. Battery Backup: The system shall be tolerant of power failure and hold memory for a minimum of 12 hours. On power restoration, the system shall automatically and without operator intervention of execution of manual restart procedures:
1. Come On Line.
 2. Update all monitored functions.
 3. Resume operation based on current time and status.
 4. Implement special building start up strategies as required.
 5. Log time of power outages and start ups.
- D. Program Storage: All JACE 8000 hardware licenses and certificates shall be stored on local MicroSD memory card employing encrypted “safe boot” technology.
- E. Protocol: Protocol shall be BACNet. The Main Controller shall be enabled to support and shall be licensed with the following Open protocol drivers (client and server) by default.
1. BACNet
 2. Lon
 3. Modbus
 4. SNMP
 5. KNX
- F. The Main Controller shall provide the following hardware features as a minimum:
1. Two 10/100 Mbps Ethernet ports.
 2. Two Isolated RS-485 ports with biasing switches.
 3. 1 GB RAM
 4. 4 GB Flash Total Storage / 2 GB User Storage
 5. Wi-Fi (Client or WAP)
 6. USB Flash Drive
 7. High Speed Field Bus Expansion
 8. -20-60°C Ambient Operating Temperature
 9. Integrated 24 VAC/DC Global Power Supply
 10. MicroSD Memory Card Employing Encrypted Safe Boot Technology
- G. The Main Controller shall be provided with a 5 Year (SMA) Software Maintenance Agreement. Labor to implement not included.

2.2 SYSTEMS DESCRIPTION:

- A. Modular Design/Expandability: The DDC/EMS shall be of a modular design providing distributed processing capability, and allowing future expansion of both input/output

points and processing/control functions. The modular DDC/EMS shall be configured on the main/local concept. The main controller shall have the capability of adding local controllers and the local controllers shall be capable of adding I/O modules.

- B. Existing Main (Master) Description: The master functions as the overall system coordinator, accept control programs, perform automated energy management functions, control peripheral devices and perform all necessary mathematical calculations.
- C. Local Controller Units: The local units function as a stand-alone controller and as an Input/Output interface of the DDC/EMS and the Data Environment.
 - 1. HVAC units must be fully controlled by a controller connected to the DDC/EMS that can be fully programmed by the DDC/EMS contractor.
 - 2. Monitoring: Local units shall be used to connect the data environment to the system and contain all necessary Input/Output functions to read field sensors and operate controlled equipment based on internal instructions or instructions from the Master. The units shall be fully supervised to detect failures. The units shall report the status of all points in its data environment at the rate of at least once every second. Local units shall connect directly to the Master with a twisted pair shielded RS-485 interface. al unit failure.
 - 3. Unit Failure: Upon failure of the unit (including transmission failure), the unit shall automatically fail off or to a predetermined state for three-way valves. All local units must run independently in the event of a central unit failure (including transmission failure) in bypass mode via the thermostat.
 - 4. Power: The unit shall operate from 120 VAC, +/-20%, 60 Hz, 220 VAC, +/-20%, 50 Hz or 24 VAC +/- 20%, 50/60 Hz power. For voltages below the operating threshold the unit shall totally shutdown and de energize its outputs.
 - 5. LAN and/or Field Bus: Each unit shall communicate with any unit through the RS-485 interface LAN and/or field bus.
 - 6. Auxiliary Port: Each unit shall be equipped with an auxiliary port to allow local interrogation of input and output values, and keyboard override of outputs through laptop.

2.3 INPUT/OUTPUT CAPABILITY:

- A. Inputs: The DDC/EMS shall accept information in the form of a temperature, voltage, digital signal (on off) or pulse counter.
 - 1. Analog Inputs: The Analog Input (AI) function shall monitor each analog input, perform A/D conversion, and hold the digital value in a buffer for interrogation. The A/D conversion shall have a minimum resolution of 10 bits. Input ranges shall be within the range of 0-10 VDC.
 - 2. Digital Inputs: The Digital Input (DI) function shall accept dry contact closures and voltage level or resistance level (5VDC reference voltage) transitions. A voltage level below 1 volt or a resistance below 500 ohms shall be read as ON (closed), a voltage level above 3 volts or a resistance above 1400 ohms shall be read as OFF (open).
 - 3. Pulse Accumulator Inputs: The pulse accumulator function shall have the same characteristics as the DI, except that, in addition, a buffer shall be included to totalize pulses between interrogations. Each input shall accept pulses at a minimum of 2 per second.
 - 4. Temperature Inputs: Temperature inputs originating from a thermistor, shall be monitored and buffered as an AI, except that, automatic conversion to degrees F shall occur without any additional signal conditioning.
 - 5. Input Wiring: All analog inputs shall be two wire devices, with shielded wire for accurate operation.

- B. Outputs:
1. Master and local controllers - Form C relay outputs rated at 5 amp, 24 VAC/DC or 2 amp, 30 VAC for on/off or Pulse Width Modulation for maintained operation of field devices. Output pulse width shall be selectable between 0.1 and 3200 seconds with a minimum resolution of 0.1 seconds. Isolation and protection against voltage surges shall be provided. Central plant controllers shall be equipped with an ON/OFF/AUTO switch to manually obtain either output state. Manual overrides shall be reported to the master at each update. An LED shall be provided to indicate the state of each digital output.
 2. All digital and analog output points on every controller must have an override (highest priority) input point in the controller's point list in the JACE. This override point must be clearly labeled and identifiable. For example, "DO1ovrd" would be the point to override Digital Output 1.

2.4 SOFTWARE:

- A. User Software: HTML5 based. Provide software (required upgrades) for Laptop Computer (Service Tool) and District office workstation, as required.
- B. Software Features:
1. Mathematical Requirements: The DDC/EMS shall have a math package capable of addition, subtraction, multiplication, division, square root, greater than and less than functions, minimum and maximum selection functions, and up to five levels of parenthesis for computation of variables. Control commands may be executed based on these calculated variables which are available to the program on a global basis. Math expressions may be used in action and exit commands of control program. The mathematical software shall be capable of mixed mode arithmetic, utilizing Boolean logic statements in combination with basic arithmetic to provide conditional mathematical computations.
 2. Passwords: The DDC/EMS shall have multiple levels of user programmable passwords in addition to a master password, for programming security. Separate passwords may be user programmed. Level of password will define user's access level and ability to change system.
 3. Trend Logging: The DDC/EMS shall trend log variables. Any system variable (inputs, outputs, numerals, can be trend logged.
 4. Messages: The DDC/EMS shall provide alarming, preventative maintenance and status reporting messages.
 5. Documentation Format: The programming language of the DDC/EMS shall be plain English based such that a printout of the control program shall serve as the primary documentation for the system.
 6. Micro Processor Integrity Checking: Each DDC/EMS microprocessor shall continuously monitor and check itself and produce error messages in the event of a malfunction.
 7. Data Plotting: The DDC/EMS shall provide plots of values of system variables on a graph. Graphs may consist of combinations of up to 3 system variables at a time from the history logs.
- C. Color Graphics Requirements Provide HTML5 based color graphics which allow user to access and change (based on user access level) all schedules and setpoints (including damper or control valve positions) directly through the user graphics. Real time data shall continuously be updated. Navigation between the screens (forward and backwards) shall be accomplished with the use of a mouse. The minimum graphic screens shall include the following:
1. Site lay-out locations of all equipment being controlled, control component locations, and spaces served. Provide multiple screens-minimum of 1 screen per

building plus site and others as needed for clarity. By "clicking" mouse on the desired equipment area a flow diagram will be displayed for the related equipment (as described below - Item 2). By "clicking" the mouse on a conditioned space, a graphic display of the zone conditions (as described below - Item 3) will be displayed.

2. Each building must have a graphical summary page of all the zones in that building that displays zone temperature, set point, discharge air temperature, and fan command.
 3. Zone & HVAC Equipment Description on GUI: Each item of HVAC equipment must be clearly identified by what area it serves and its unit number. For example, if HC-2A serves Classroom 4, the GUI should list it as "Classroom 4, HC-2A." It should NOT be listed as only "HC-2A" or "Classroom 4."
 4. Flow diagrams shall be provided for each HVAC system, such as air-handling system, chilled water system, hot water system, condenser water system, package unit system, brine system with all inputs and outputs dynamically displayed.
 5. Each temperature control zone shall have a screen providing set points, temperatures, and related HVAC system status data.
 6. Scheduling screens allowing On/Off times to be set.
- D. Software Manual: The software manual shall describe programming and testing, starting with a system overview and proceeding to a detailed description of each software feature. The manual shall instruct the user on programming or reprogramming any portion of the system. This shall include all control programs, variables, set points, time periods, messages, passwords and other information necessary to load, alter, test and execute the system. The manual shall include commands, editing and writing control programs, printouts and logs, mathematical calculations, and instructions on modifying any control point, verifying error status, changing passwords, and initiating or disabling control programs.
- E. Software Licenses: The owner shall be named the license holder of all software associated with any and all incremental work on the project(s). All Niagara 4 software licenses shall have the "accept.station.in=*"; "accept.station.out=*"; "accept.wb.in=*"; and "accept.we.out=*" section of the software licenses. The intent is to insure that the installed Niagara 4 products may be completely open for integrations. Owner shall be free to direct the modification of the software license, regardless of supplier. In addition, the Owner shall receive ownership of all job-specific software configuration documentation, data files, and application-level software developed for this project. This shall include all custom, job-specific software code and documentation for all configuration and programming that is generated for a given project and/or configured for use within Niagara Framework (Niagara 4) based controllers and/or servers and any related LAN/WAN/Intranet and Internet connected routers and devices. Any and all required IDs and passwords for access to any component or software program shall be provided to the Owner.

2.5 USER INTERFACE:

- A. LAN Connections: If an additional LAN connection is needed, the conduit and cable from LAN rack is to be installed by electrical contractor. The planned location of all LAN connections (new and existing) to EMS equipment must be coordinated with the District's networking staff and EMS staff as early as possible. Final connections shall be made by DDC/EMS Contractor.
- B. Direct Computer Communication: The DDC/EMS shall have a computer compatible communication mode for communication with other intelligent devices, which performs data integrity checking, with automatic retransmission of data when errors are detected.

- C. JACE software must include all applications to make all folders viewable and accessible in the JACE.

2.6 SYSTEM COMPONENTS:

A. Control Components:

1. Wall Switches: Plates for all wall switches and timers shall match those specified in Division 26.
2. Labels: All labels, signs, etc. shall be engraved, laminated plastic, white on black background, 1/8" high lettering, minimum.
3. Temperature Sensors:
 - a. Sensor Type: All temperature sensors shall be made of a highly stable, precision thermistor material accurate to within ± 0.36 Degrees F. Identify each temperature sensor with a "Lamicoid" label keyed to the control system as-built drawings.
 - b. Room Sensor: Room temperature sensor shall have Executive Decorator housing with programmable visible temperature indication. Housing shall include an occupancy override, temperature setpoint adjustment and a service tool jack.
 - c. Vandal Resistant Room Sensor: Where noted, shall be a blank stainless steel wall plate with the sensing element bonded to the back side. The plate back shall be insulated to reduce wall temperature influence.
 - d. Duct Sensor: Duct temperature sensor shall be a probe type element with 9 inch insertion length. Element shall be installed where air mixture provides a true temperature indication. Where adequate mixing is not practical, the duct temperature sensor shall have an averaging type thermistor element, installed across the entire cross section of the duct.
 - e. Outdoor Air Sensor: Outdoor air temperature sensor shall be a probe type element mounted in a ventilated, treated white PVC sun shield to minimize radiant energy effects. The sensor and sun shield shall be mounted on a weatherproof outlet box for outdoor installation.
 - f. Low Differential Air Pressure Applications (0" to 5" W.C.): The differential pressure transmitter shall be of industrial quality and transmit a linear, 4 to 20 mA output in response to variation of differential pressure or air pressure sensing points. Non-interactive zero and span adjustments, adjustable from the outside cover. (0.00 - 1.00" to 5.00") W.C. input differential pressure ranges. 4-20 mA output. Maintain accuracy up to 20 to 1 ratio turndown. Reference Accuracy: +0.2% of full span.
 - g. CO2 Sensor: The sensor shall have a five year recommended calibration interval. In addition, the sensor shall be provided with a five-year calibration guarantee, providing for free factory replacement if the sensor is found to be out of calibration within five years of the purchase date. The sensor shall have accuracy of ± 50 ppm and repeatability of ± 20 ppm. All adjustments to the sensor including output scaling, elevation adjustment, relay set point, relay dead-band, linear or exponential output, and single point calibration shall be made via on-board push buttons and LCD display. The LCD display must be covered by a solid door and only viewable when the door is opened for adjustments.
4. Temperature Control Panels: Each panel and each control device or readout on the front of the panel shall be identified with a laminated plastic label with 1/4" high engraved lettering, white on black background. Pilot lights shall be the push to test type.
5. Smoke Detectors: Furnished and installed by Division 26. Power and fire alarm wiring by Division 28. Control wiring by Division 23. Coordinate with Division

- 26.
6. Status Sensor: Current sensing status sensor (with sensitivity adjustment for belt loss detection).
- B. Conduit: Conduit to be a minimum 1" diameter, and to have at least 25% spare capacity, except drops to room sensors may be run in ½" conduit. Conduit shall be run in electrical or mechanical trenches wherever possible. Site conduit (building to building) will be installed (and terminated inside the building) by Division 26.

PART 3 - EXECUTION

3.1 GENERAL INSTALLATION:

- A. General: All electrical work shall be in accordance with the California Electrical Code and the Electrical Specification Sections. All electric/electronic systems shall be hardwired in conduit, except as specifically allowed by 1.3, B. Wiring shall be concealed in walls, above the ceilings, or below grade unless otherwise noted. Exposed wiring shall run parallel to room surfaces; location shall be approved by the Architect. No structural member shall be weakened by cutting, notching, boring or otherwise. Provide a 120 volt circuit for each device requiring external power. Dedicated circuits shall be provided where required. Any devices or wiring exposed to the weather shall be protected in weatherproof enclosures such as NEMA 3R and weatherproof conduit.
- B. Labeling of System: DDC/EMS Contractor shall provide complete labeling of all terminals at all panels or equipment terminal strips and wiring. Equal to Brady marking on wires and number on terminals in sequence corresponding to control diagram.
- C. Programming:
1. The Direct Digital Control and Energy Management System (DDC/EMS) operational program shall be provided by the DDC/EMS Contractor. The DDC/EMS Contractor shall be responsible for programming the system and shall coordinate the scheduling (on/off times) with the Owner. Prior to start-up, the DDC/EMS Contractor shall provide any testing program he feels necessary to fully test the operation of the various components.
 2. The DDC/EMS Contractor shall load the operational program into the DDC/EMS controller from his office via the District's network (via VPN) or at the job site via a direct connect cable. Prior to starting up the system, the DDC/EMS Contractor shall:
 - a. Confirm that the control system has been connected to the District's LAN/WAN and that the LAN/Wan is working.
 - b. Confirm the functionality of the DDC/EMS controllers and all input points by reading the input values, and comparing them with a measured temperature, pressure, voltage, current, or resistance as appropriate. Calibrate all transducers as required.
 - c. Confirm the functionality of all digital output points by manual operational of the relay contacts. Use proper discretion in starting and stopping equipment.
 - d. Confirm the functionality of all analog output points by manually imposing an adjustable voltage on the appropriate circuit to check proper operation of the controlled device. Calibrate all transducers as required.
 - e. The DDC/EMS Contractor shall notify the General Contractor (one week in advance of) when the system will be ready for loading and testing the operational program. The DDC/EMS Contractor's start-up technician shall be present while the program is being loaded and shall communicate with the programmer prior and after program loading to

confirm proper operation.

- D. Training: Prior to final acceptance, the DDC/EMS Contractor shall provide operational training to the Owner's personnel. The training sessions shall include a complete demonstration of the system. Dates and times of the training sessions shall be coordinated through the Owner not less than one week prior to session. A total of 40 hours of instruction shall be provided. The DDC/EMS Contractor shall maintain a log of training sessions including dates, times and names/titles of those attending. The DDC/EMS Contractor shall submit a copy of this log on request. Contractor shall provide 1 week factory certified training schedule and class at owners' discretion.
- E. Testing and Acceptance: The DDC/EMS Contractor shall furnish a complete and operating system. The DDC/EMS Contractor shall also verify, in the presence of the Owner, the system accuracy and proper function of each controlled device and sensor. The following items shall be successfully demonstrated prior to acceptance by the Owner:
1. All system outputs including controllers, relays, and other control devices shall be addressed and start/stop functions demonstrated.
 2. All inputs shall be displayed and all event-initiated functions shall be demonstrated.
 3. Demonstrate program integrity and power restore sequence during and after a power failure and restoration.
 4. Deliver all Record Drawings, wiring diagrams, equipment specifications, installation and Operation Manuals and other documentation as required to describe the system.
 5. Complete operator training in the use, programming, and operation of the system.
- F. Start-up of the System:
1. The start-up period starts when the following conditions are met:
 - a. The DDC/EMS system and all involved HVAC equipment have been installed, connected to the DDC/EMS system and are ready to operate.
 - b. A start-up meeting has been conducted with representative of the General Contractor, Architect/Engineer, maintenance staff, and the DDC/EMS Contractor.
 - c. Consensus is reached, by the representatives at the above referenced meeting that it is appropriate for the start-up process to start.
 2. The alarm pagers called by the control system during the start-up period shall be the pagers carried by the Mechanical Contractor and/or DDC/EMS Contractor as appropriate. The Mechanical Contractor and DDC/EMS Contractor shall respond to all pages from the control system and work cooperatively to insure that the building environmental standards are maintained.
 3. The start-up process shall be completed and the warranty period shall start when the following conditions are met.
 - a. All training to be provided as part of the project has been completed.
 - b. No "alarm" or "condition reports" are being generated by the DDC/EMS system for seven (7) calendar days (168 hours) due to incomplete or inaccurate installation or programming.
 - c. All adjustments and "fine tuning" of the system have been completed.
- G. Verification: A written testing and start-up report must be submitted for approval before acceptance. In addition to the DDC/EMS Contractor's testing and start-up report, the Owner may independently verify the test results. The report on test results shall include setpoints and operating ranges of all components.

3.2 SEQUENCE OF OPERATION: The below sequences of operation are to be used as a primary guideline for DDC/EMS control logic sequence development. Any/all variations from the below

operation sequences must be approved by the District's DDC/EMS operator prior to implementation. All fans providing ventilation to meet minimum outside air requirements shall run continuously during occupied hours. Airside equipment (air handlers, etc.) shall start by normally open relay and signal from DDC/EMS.

- A. Provide graphics meeting District standards using the existing control sequences.
- B. System Operation Schedule: The equipment shall operate at the schedule set by the District.
- C. Split-System Heat Pump (IDU/ODU): Shall be activated by BAS. Unit shall be controlled by integral controls. Provide temperature sensor for the area being controlled and status sensors for indoor and outdoor units.
- D. Exhaust Fans: Exhaust fans serving restroom and snack bar (EF-1, EF-2) shall operate continuously during occupied hours. Exhaust fans serving hazardous areas (EF-3, EF-4, EF-5) shall have continuous operation.
- E. Fly Fan: Shall start/stop by wall switch at window. Current sensor shall report Fly Fan status to BAS.
- F. Domestic Hot Water Circulating Pump: Shall start/stop by BAS signal. Current sensor shall report pump status to BAS.
- G. Fire/Smoke Damper: Close the fire/smoke damper on alarm and shut down the air moving equipment serving the damper and signal fire alarm system.
- H. Lighting: BAS shall energize exterior lighting. Provide relay with an override switch.
- I. Provide monitoring points for the following plumbing equipment:
 - WH-1 Water Heater: Run Time, Alarm
 - P-1 Domestic Water Booster Pump: Alarm

END OF SECTION

GENERAL INFORMATION

Table with 2 columns: Code (G000-G102) and Description (COVER SHEET, REGULATORY SITE PLAN, REGULATORY FLOOR PLAN)

CIVIL

SITE DEVELOPMENT

Table with 2 columns: Code (SD/C0.1-SD/C7.1) and Description (CIVIL COVER SHEET, PARTIAL TOPOGRAPHIC SURVEY, etc.)

OFFSITE IMPROVEMENTS

Table with 2 columns: Code (SD/C0.2-SD/C8.1) and Description (OFFSITE COVER SHEET & NOTES, BARDSLEY AVE. OFFSITES, CIVIL DETAILS)

ARCHITECTURAL

SITE DEVELOPMENT

Table with 2 columns: Code (SD/A010-SDL101) and Description (OVERALL SITE DEMOLITION PLAN, SITE DEMOLITION PLAN & EARTHWORK, etc.)

TYPICAL INFORMATION

Table with 2 columns: Code (X/A101-X/A602) and Description (WALL ASSEMBLIES, INTERIOR & EXTERIOR FINISH SCHEDULE, etc.)

BUILDING P

Table with 2 columns: Code (P/A101-P/A801) and Description (FLOOR PLANS, ALTERNATE BID - BUILDING P2 - SNACK BAR BUILDING, etc.)

STRUCTURAL

TYPICAL INFORMATION

Table with 2 columns: Code (X/S101-X/S107) and Description (TYPICAL PROJECT NOTES, TYPICAL CONCRETE NOTES & DETAILS, etc.)

BUILDING P

Table with 2 columns: Code (P/S201-P/S603) and Description (FOUNDATION PLANS, ALTERNATE BID - BUILDING P2, etc.)

PLUMBING

SITE DEVELOPMENT

Table with 2 columns: Code (SD/P102) and Description (PARTIAL PLUMBING SITE PLAN)

TYPICAL INFORMATION

Table with 2 columns: Code (X/P101-X/P102) and Description (PLUMBING SCHEDULE, LEGENDS, AND NOTES, PLUMBING DETAILS)

BUILDING P

Table with 2 columns: Code (P/P101-P/P301) and Description (PLUMBING PLANS, ENLARGED PLUMBING PLANS, PLUMBING ROOF PLANS)

MECHANICAL

SITE DEVELOPMENT

Table with 2 columns: Code (SD/M102) and Description (PARTIAL MECHANICAL SITE PLAN)

TYPICAL INFORMATION

Table with 2 columns: Code (X/M101-X/M104) and Description (MECHANICAL SCHEDULES, LEGENDS, AND NOTES, MECHANICAL DETAILS, etc.)

BUILDING P

Table with 2 columns: Code (P/M101-P/M301) and Description (MECHANICAL FLOOR PLANS, MECHANICAL ROOF PLANS)

FIRE PROTECTION

TYPICAL INFORMATION

Table with 2 columns: Code (FP001) and Description (PROJECT INFORMATION)

SITE DEVELOPMENT

Table with 2 columns: Code (FP002) and Description (SITE PLAN)

BUILDING P

Table with 2 columns: Code (FP100-FP500) and Description (PIPING PLANS, REFLECTED CEILING PLANS, BLDG. P2 & P3 SECTION VIEWS, etc.)

ELECTRICAL

SITE DEVELOPMENT

Table with 2 columns: Code (SD/E101-SD/E102) and Description (ELECTRICAL OVERALL SITE PLAN, ENLARGED ELECTRICAL SITE PLAN)

TYPICAL INFORMATION

Table with 2 columns: Code (X/E101-X/E306) and Description (ELECTRICAL SYSTEMS - SYMBOLS, NOTES, AND DETAILS, LIGHTING SYSTEMS - FIXTURE SCHEDULE AND DETAILS, etc.)



BUILDING P

Table with 2 columns: Code (P/E101-P/E106) and Description (BUILDINGS P2, P3, P4 - LIGHTING PLANS, BUILDINGS P2, P3, P4 - POWER & DATA/COMM PLANS, etc.)

AQUATICS

Table with 2 columns: Code (DP-1-MR-9) and Description (POOL AREA DECK PLAN, LEARNING POOL PLAN, LEARNING POOL SLAB PLAN, etc.)

SHEET COUNT: 168

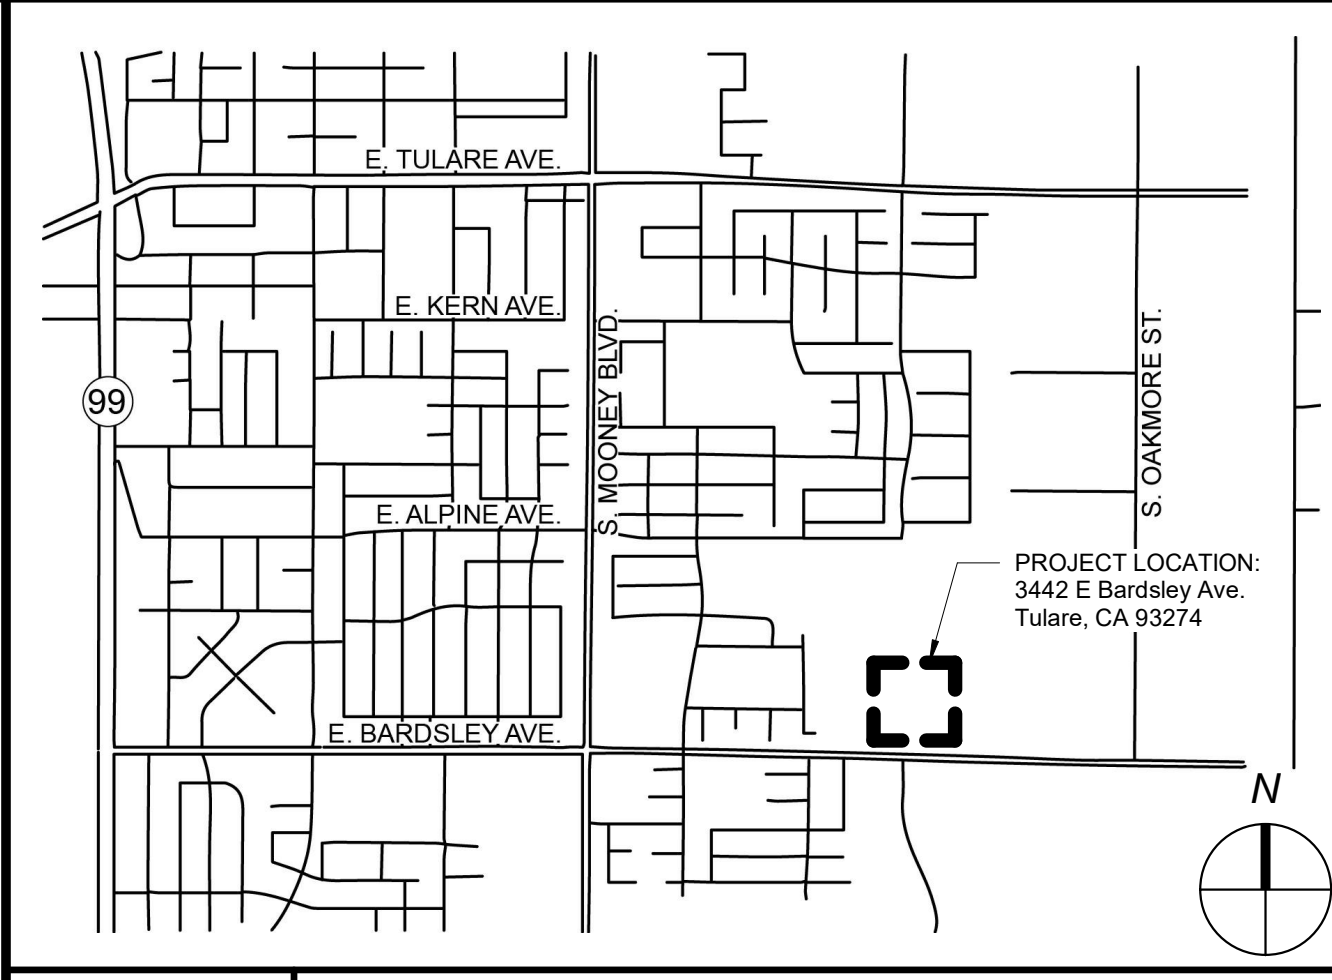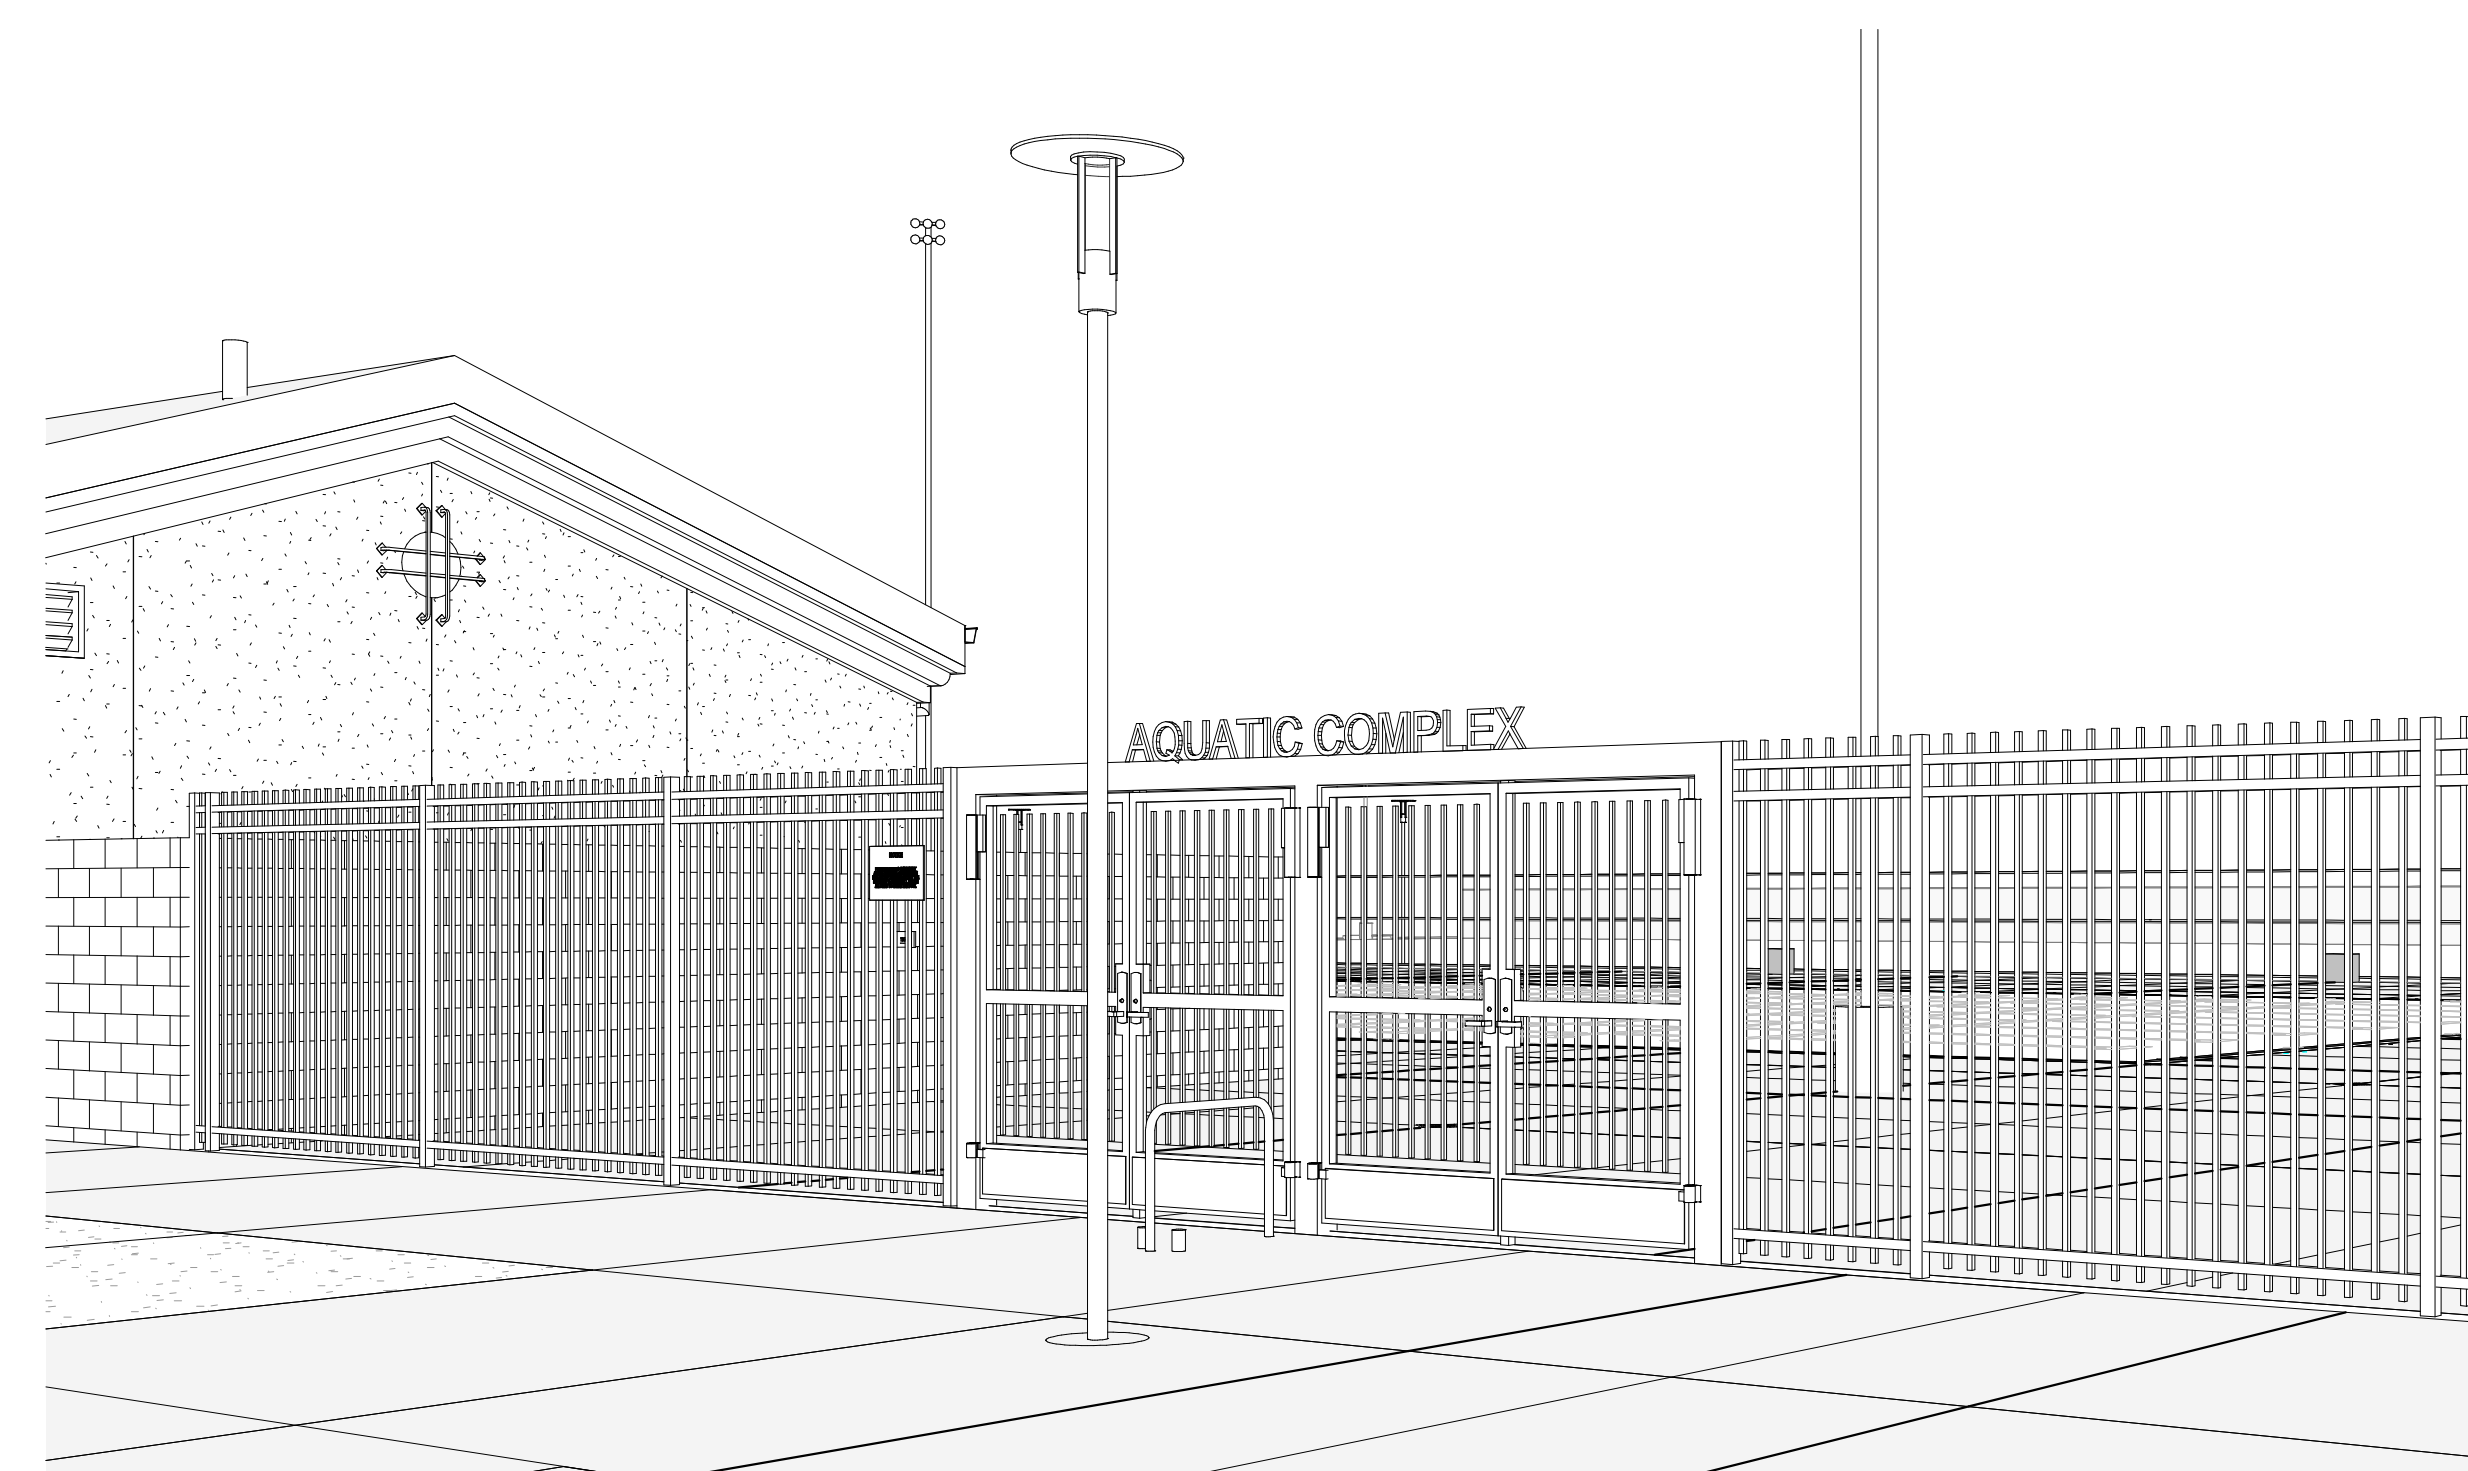

N14 Vicinity Map

Table with 2 columns: Code (J14) and Description (Applicable Codes). Lists various codes and standards including California Code of Regulations (CCR), California Building Standards Administrative Code, and NFPA.

Table with 2 columns: Code (J14) and Description (Deferred Approval). Includes a table for Description of Deferred Item with entries for None, -, and .

G14 Deferred Approval

Table with 2 columns: Code (A14) and Description (Project Description). Contains project details and notes regarding materials and labor.

A14 Project Description

DSA File No.: 54-H11
DSA Application No.: 02-120251
Agency Approval

Project Location: 3442 E Bardsley Ave, Tulare, CA 93274

AQUATICS
Aquatic Design Group
1100 N. California St.
Ceres, CA 95208
(800) 938-0542

ELECTRICAL
Hardin-Davidson Engineering
1100 N. California St.
Ceres, CA 95208
(559) 323-4995
F (559) 323-4928

MECHANICAL
Net Positive Consulting Engineers
1100 N. California St.
Ceres, CA 95208
(559) 940-7293

STRUCTURAL
Brooks Ransom Associates
1100 N. California St.
Ceres, CA 95208
(559) 449-8444
F (559) 449-8404

CIVIL
Lane Engineers, Inc.
1100 N. California St.
Tulare, CA 93274
(559) 688-5263

ARCHITECTURAL
Darden Architects, Inc.
6790 N. West Avenue
Fresno, CA 93711
(559) 448-8051
F (559) 448-1785

Project Information section with logo for Darden Architects, Inc. and contact information.

Revision table with columns: No., Revision/Submission, Date. Shows revision 1 on 05/31/2023.

Footer area with 'darden architects, inc.' logo, 'ARCHITECTURE PLANNING INTERIORS', and a 'GOOD' stamp.

Mission Oak HS Aquatic Complex
Tulare Joint Union High School District
Tulare, CA 93274
Darden Project Number: 2180
Date: 03/28/2023



R
Q
P
N
M
L
K
J
H
G
F
E
D
C
B
A

SPORTS LIGHTING

- MT1 NOTES, FOUNDATION DETAIL
- MS1 POLE DETAIL
- MD1 ATTACHMENT DETAILS
- MD2 ATTACHMENT DETAILS
- MD3 ATTACHMENT DETAILS

DSA File No.: 54-H11

DSA Application No.: 02-120251

Agency Approval

AQUATICS
 Aquatic Design Group
 1000 N. Main Street
 Carlsbad, CA 92008
 (800) 938-0542

ELECTRICAL
 Hardin-Davidson Engineering
 1000 S. Main Street, Suite 200
 Coalinga, CA 93238
 T (559) 323-4995
 F (559) 323-4928

MECHANICAL
 Neil Positive Consulting Engineers
 100 S. Main Street #102
 Coalinga, CA 93238
 (559) 940-7293


STRUCTURAL
 Brooke Ransom Associates
 1000 N. Main Street, Ste 100
 Fresno, CA 93711
 T (559) 449-8444
 F (559) 449-8404

CIVIL
 Lane Engineers, Inc.
 1000 N. Main Street, Ste 100
 Tulare, CA 93274
 (559) 688-5263

ARCHITECTURAL
 Darden Architects, Inc.
 6790 N. West Avenue
 Fresno, CA 93711
 T (559) 448-8051
 F (559) 448-1785

Mission Oak HS Aquatic Complex
Tulare Joint Union High School District
 Tulare, CA 93274

Darden Project Number: 2180
 Date: 03/28/2023

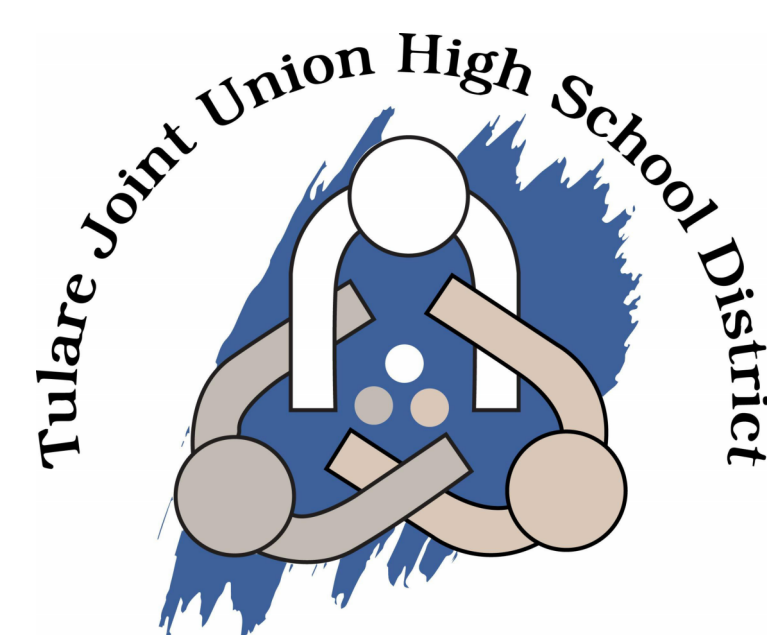

ALL WORK SHALL CONFORM TO 2019 TITLE 24, CALIFORNIA CODE OF REGULATIONS (CCR).
 CHANGES TO THE APPROVED DRAWINGS AND SPECIFICATIONS SHALL BE MADE BY AN ADDENDUM OR A CONSTRUCTION CHANGE DOCUMENT (CCD) APPROVED BY THE DIVISION OF THE STATE ARCHITECT, AS REQUIRED BY SECTION 4-338, PART 1, TITLE 24, CCR.
 Substitutions affecting DSA-regulated items shall be considered as construction documents (CCDs) and shall be approved prior to fabrication and installation per DSA IR 4-6 and Section 338(c) Part 1, Title 24, CCR.
 A "DSA CERTIFIED" PROJECT INSPECTOR (CLASS 1) EMPLOYED BY THE DISTRICT (OWNER) AND APPROVED BY THE DSA SHALL PROVIDE CONTINUOUS INSPECTION OF THE WORK. THE DUTIES OF THE INSPECTOR ARE DEFINED IN SECTION 4-342, PART 1, TITLE 24, CCR.
 A DSA ACCEPTED TESTING LABORATORY DIRECTLY EMPLOYED BY THE DISTRICT (OWNER) SHALL CONDUCT ALL THE REQUIRED TESTS AND INSPECTIONS FOR THE PROJECT.
 THE INTENT OF THESE DRAWINGS AND SPECIFICATIONS IS THAT THE WORK OF THE ALTERATION, REHABILITATION OR RECONSTRUCTION IS TO BE IN ACCORDANCE WITH TITLE 24, CCR. SHOULD ANY EXISTING CONDITIONS SUCH AS DETERIORATION OR NON-COMPLYING CONSTRUCTION BE DISCOVERED WHICH IS NOT COVERED BY THE CONTRACT DOCUMENTS WHEREIN THE FINISHED WORK WILL NOT COMPLY WITH TITLE 24, CCR, A CONSTRUCTION CHANGE DOCUMENT (CCD), OR A SEPARATE SET OF PLANS AND SPECIFICATIONS, DETAILING AND SPECIFYING THE REQUIRED WORK SHALL BE SUBMITTED TO AND APPROVED BY DSA BEFORE PROCEEDING WITH THE WORK. (SECTION 4-317(C), PART 1, TITLE 24, CCR).
 GRADING PLANS, DRAINAGE IMPROVEMENTS, ROAD AND ACCESS REQUIREMENTS AND ENVIRONMENTAL HEALTH CONSIDERATIONS SHALL COMPLY WITH ALL LOCAL ORDINANCES.

Statement of General Conformance

FOR ARCHITECTS/ENGINEERS WHO UTILIZE PLANS, INCLUDING BUT NOT LIMITED TO, SHOP DRAWINGS PREPARED BY OTHER LICENSED DESIGN PROFESSIONAL AND/OR CONSULTANTS

Application No. 02-119662 File No. 10-H14

The drawings or sheets listed on the cover or index sheet

This drawing, page of specifications/calculations


Have/has been prepared by other design professionals or consultants who are licensed and/or authorized to prepare such drawings in this state. It has been examined by me for:

- design intent, and appears to meet the appropriate requirements of Title 24, California Code of Regulations, and the project specification prepared by me, and
- coordination with my plans and specifications, and is acceptable for incorporation into the construction of this project.

The Statement of General Conformance "shall not be construed as relieving me of my rights, duties, and responsibilities under Sections 17302 and 81138 of the Education Code, and Sections 4-336, 4-341 and 4-344" of Title 24, Part 1 (Title 24, Part 1, Section 4-317 (b)).

I find that: All drawings or sheets listed on the cover or index sheet This Drawing or Page

<input checked="" type="checkbox"/> is/are in general conformance with the project design intent, and	<input type="checkbox"/> is/are in general conformance with the project design intent, and
<input checked="" type="checkbox"/> has/have been coordinated with the project plans and specifications	<input type="checkbox"/> has/have been coordinated with the project plans and specifications

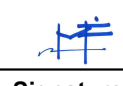	08/18/2023	Signature	Date
Architect or Engineer designated to be in general responsible charge		Architect or Engineer delegated responsibility for this portion of the work	
Michael K. Fennacy			
Print Name	04/30/23	Print Name	
C23753	Expiration	License Number	Expiration

B14
 1/2" = 1'-0"

Project Information



ARCHITECTURE PLANNING INTERIORS
 www.dardenarchitects.com
 6790 N. West Ave. • Fresno, CA 93711 • T. 559.448.8051



Architect

No.	Revision/Submission	Date
1	REVISION_01	05/31/2023

Revision

Copyright © 2023 Darden Architects

G001


NOTES
 Mandatory Measures for Infrastructure: Pathway and pullboxes shall be installed from main service or subpanel, and terminated at an enclosure or pull box. Refer to the electrical drawings. This work is in Contract.
 No charging equipment, surface ID markings (EV CHARGING ONLY) and signage for the EVCS spaces will be installed. Until such time as the EVCS spaces are constructed for use. When installed the operable parts on all new and altered EV chargers shall comply with the requirements of CBC 11B-309.4. This work is indicated as Future (F).
ABBREVIATIONS
 EV-A Ambulatory
 EV-S Standard Accessible
 EV-V Van Accessible
 EV Electric Vehicle Charging Station
 (F) Future

Parking Lot	Accessible Parking Spaces CBC Table 11B-208.2				Electric Charging Spaces Table 11B-228.3.2.1			
	Total Spaces	Required Accessible	Van Accessible	Standard Accessible	Total EV	EV-V	EV-S	V-A
Lot 1	122	6	1	5	6	6	1	1
Lot 2	77	4	1	3	0	0	0	0
Lot 3	10	1	1	1	0	0	0	0
Lot 4	310	13	2	11	0	0	0	0
Lot 5	13	1	1	1	0	0	0	0

BLDG NO.	BUILDING PER ASSUMED PROPERTY LINE	OCCUPANCY GROUP	CONSTRUCTION TYPE	FIRE SPRINKLER SYSTEM	BASIC ALLOWABLE AREA	ALLOWABLE AREA INCREASE	INCREASED ALLOWABLE AREA	ACTUAL BUILDING & FIRE AREA SYSTEM	FIRE FLOW AND DURATION	DSA APPLICATION NUMBER	DSA APPROVAL DATES	APPLICABLE BUILDING CODE	REMARKS
A	Administration	B, E - 1	Type V-N	None	-	-	-	-	-	02-107359	2006	-	-
B	Media Center	E - 1	Type V-N	None	-	-	-	-	-	02-107359	2006	-	-
C	Classroom	E - 1	Type II (1Hr)	None	-	-	-	-	-	02-107359	2006	-	-
D	Classroom	E - 1	Type V-N	None	-	-	-	-	-	02-107359	2006	-	-
G	Gym/Wrestling	A-2.1	Type II (1Hr)	None	-	-	-	-	-	02-107359	2006	-	-
H	Locker/Shower	E - 1	Type V-N	None	-	-	-	-	-	02-107359	2006	-	-
I	Music/Business	E - 1	Type V-N	None	-	-	-	-	-	02-107359	2006	-	-
L	Multi-Purpose	A-3	Type II (1Hr)	None	-	-	-	-	-	02-107359	2006	-	-
800	Classroom	E - 1	Type V-B	Fully Sprinkled	-	-	-	-	-	02-110051	2013	-	-
600	Classroom	E - 1	Type V-B	Fully Sprinkled	-	-	-	-	-	02-112950	2006	-	-
P2	Electrical/Storage	S-2	Type V-B	Fully Automatic (Area Increase)	36,000 SF	-	36,000 SF	409 SF	1,500 GPM @ 20 PSI 2 HR. Duration	02-120251	-	2019 Ca. Building Code CCR Title 24	F.S. System Reduction of 75% 2,750 x .75 = 2,062.5 2,750 - 2,062.5 = 17,875.5 = 1,500 GPM
P3	Restroom/Shower	E, B	Type V-B	Fully Automatic (Area Increase)	36,000 SF	-	36,000 SF	1,618 SF	1,500 GPM @ 20 PSI 2 HR. Duration	02-120251	-	2019 Ca. Building Code CCR Title 24	F.S. System Reduction of 75% 2,750 x .75 = 2,062.5 2,750 - 2,062.5 = 17,875.5 = 1,500 GPM
P4	Pool Equipment/Storage	S-2	Type V-B	Fully Automatic (Area Increase)	36,000 SF	-	36,000 SF	1,635 SF	1,500 GPM @ 20 PSI 2 HR. Duration	02-120251	-	2019 Ca. Building Code CCR Title 24	F.S. System Reduction of 75% 2,750 x .75 = 2,062.5 2,750 - 2,062.5 = 17,875.5 = 1,500 GPM
*P2 - P4 Combined - does not meet required separation Actual Area is Less Than Basic Allowable Area - OK		Building Accessory		36,000 SF		> 3,662 SF Total OK							
P2	Add Alternate Snack Bar	S-2	Type V-B	Fully Automatic (Area Increase)	36,000 SF	-	36,000 SF	1,063 SF	1,500 GPM @ 20 PSI 2 HR. Duration	02-120251	-	2019 Ca. Building Code CCR Title 24	F.S. System Reduction of 75% 2,750 x .75 = 2,062.5 2,750 - 2,062.5 = 17,875.5 = 1,500 GPM
Building Accessory		36,000 SF		> 4,316 SF Total OK									

L8 Building Data Table
 1/4" = 1'-0"

P1 Parking Lot Table
 3/32" = 1'-0"

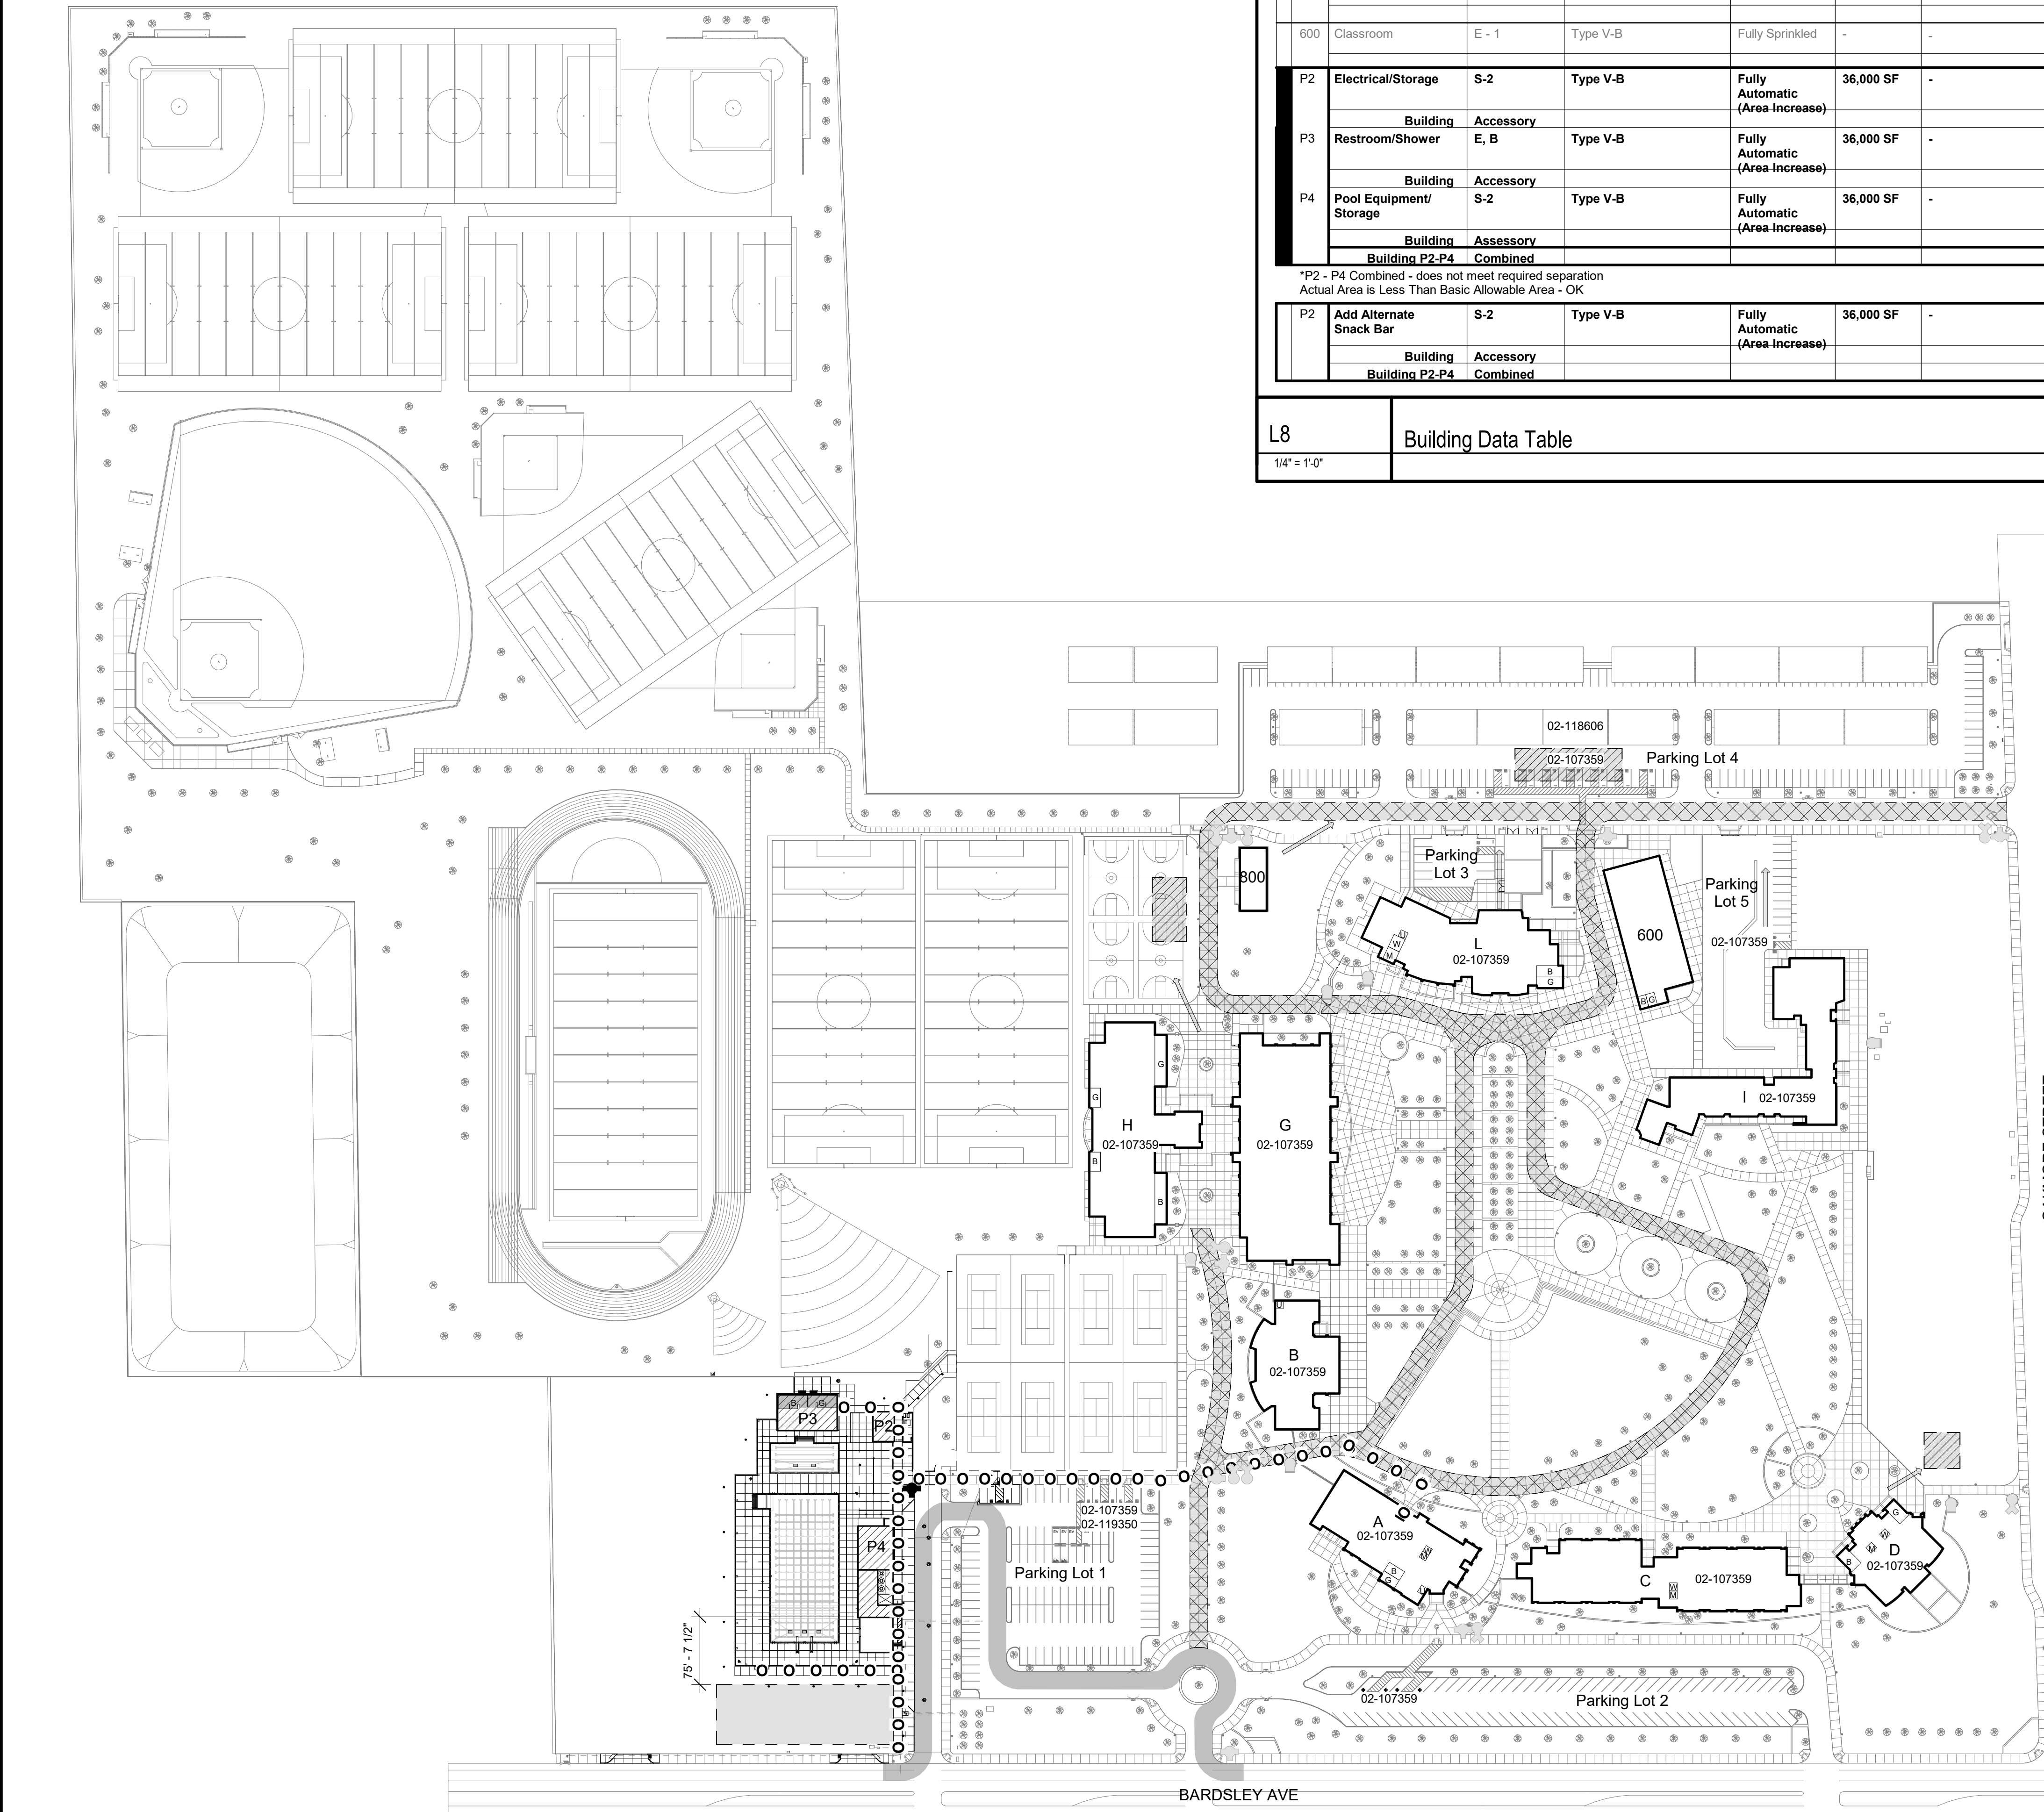

DSA 810

FIRE & LIFE SAFETY SITE CONDITIONS SUBMITTAL

Division of the State Architect (DSA) documents referenced within this publication are available on the DSA Forms or DSA Publications webpages.
 To facilitate the Division of the State Architect's (DSA) fire and life safety plan review of project site conditions, DSA requires the design professional to provide the following information at time of project submittal for projects consisting of construction of a new campus, construction of new buildings, additions to existing buildings, and for site alternate design means for fire department emergency vehicle access, and fire suppression water supply information associated with compliance items 1 through 3 below to be provided for all project types indicated above. Information associated with items 4 through 7a to be completed when an alternate means is utilized. Acknowledgment by the school district and signature from the Local Fire Authority (LFA) is only required when an alternate design means is being requested.
 The Project Information and Fire & Life Safety Information sections are to be completed for all projects and imaged onto the fire access site plan. When an alternate design/means is proposed, all sections on pages 1 and 2 are to be completed and imaged on the fire access site plan.
 For additional information refer to the instructions at the end of this form and DSA Policy PL 09-01: Fire Flow for Buildings.

PROJECT INFORMATION

School District/Owner: Tulare Joint Union High School District
 Project Name/School: Mission Oak HS Aquatic Complex
 Project Address: 3442 E Bardsley Ave, Tulare, CA 93274

FIRE & LIFE SAFETY INFORMATION

1. Has a fire hydrant flow test been performed within the past 12 months? Yes No
 (If yes, provide a copy of the test data.)

2. Was the fire hydrant water flow test performed as part of this LFA review? Yes No

3. Is the project located within a designated fire hazard severity zone (FHSZ) as established by Cal Fire? (If yes, indicate FHSZ classification below) Yes No
 Refer to the following website for FHSZ locations: <https://www.cal-fire.com/>
 Moderate High Very High

Wildland Interface Area (WIFA) (If any designations are checked, project design must meet the requirements of CBC Chapter 7A.) WIFA

DSA 810 FIRE & LIFE SAFETY SITE CONDITIONS SUBMITTAL

CONDITION MEANS AND METHODS RESOLUTION	ALTERNATE ACCEPTED		
	Yes	No	N/A
4. Emergency vehicle access roadways do not meet CFC requirements.			<input checked="" type="checkbox"/>
4a. Acceptable Alternate: Emergency vehicle and personnel access as proposed by the project architect is acceptable for providing fire suppression and protection of life and property.			<input checked="" type="checkbox"/>
5. Fire Hydrants: Number and spacing does not meet CFC requirements.			<input checked="" type="checkbox"/>
5a. Acceptable Alternate: Number of fire hydrants and spacing as proposed by the project architect is acceptable for fire suppression and protection of life and property.	<input checked="" type="checkbox"/>		
6. Fire Hydrants: Water flow and pressure are less than CFC minimum.			<input checked="" type="checkbox"/>
6a. Acceptable Alternate: The available flow and pressure is acceptable for providing fire suppression and protection of life and property.			<input checked="" type="checkbox"/>
7. Location of fire department connection(s) serving fire sprinkler systems or standpipe systems does not meet CFC requirements.			<input checked="" type="checkbox"/>
7a. Acceptable Alternate: The location of fire department connection serving the fire sprinkler system and/or standpipe system is acceptable for providing fire suppression and protection of life and property.			<input checked="" type="checkbox"/>

School District Acceptance of Acceptable Design Alternates
 By signing this form, the school district acknowledges and accepts the proposed design as an alternative to California Building Code (CBC) and California Fire Code (CFC) minimum requirements, as indicated by one or more of the conditions indicated at items 4a, 5a, 6a or 7a, for providing fire and life safety protection of life and property.
 Accepted by: Vivian Hamilton Title: Chief Business Officer
 Signature: *Vivian Hamilton* Date: 3/13/2023

LOCAL FIRE AUTHORITY (LFA) INFORMATION
 LFA Agency Name: City of Tulare Fire
 LFA Review Official: Ryan Leonardo
 Title: Fire Marshal Work Phone: (559) 684-4365
 Work Email: rleonardo@tulare.ca.gov
 LFA Reviewer's Signature: *Ryan Leonardo* Date: 01/11/23

DSA File No.: 54-H11

DSA Application No.: 02-120251

Agency Approval

SYMBOLS

- 1 Hr Fire Barrier
- Assumed Property Line
- Building Overhang
- Chain Link Fence
- Accessible Path of Travel
- Fire Truck Access Lane
- Existing Fire Truck Access Lane
- Aquatic Complex Safe Dispersal Area
3,183 Occupants x 5 SF per Occupant = 15,915 SF
- Main Campus Safe Dispersal Area
1,613 Enrolled Occupants x 5 SF per Occupant = 8,065 SF
- Fire Hydrant (FH)
- Fire Department Connection (FDC/Slamase)
- Post Indicator Valve (PIV)
- Accessible Restroom:
B = Boys
G = Girls
M = Men
W = Women
U = Unisex
S = Staff
- Existing Building not included in this project
- New Addition and Existing Building included in this project

ABBREVIATIONS

- DF ACCESSIBLE DRINKING FOUNTAIN LOCATION
 (HA = High Adult)
 (LA = Low Adult)

NOTES

- Site Gates, Site Ramps, and Site Stair locations in the "Path of Travel" are indicated on Drawing REGULATORY COMPLIANCE SITE PLAN and FLOOR PLAN.
- The Path of Travel slopes shall not exceed a running slope of 1:20 (5%). The Path of Travel slopes shall not exceed a cross slope of 1:50 (2%). The Path of Travel shall not have overhead obstructions within 80" above the walking surface or obstructions protruding more than 4" between 27" and 80" above the walking surface.
- The "Path of Travel" as shown on the REGULATORY COMPLIANCE SITE PLAN, shall not have any unprotected vertical drop exceeding 4 inches at the time of the preparation of the contract documents and DSA approval. Contractor shall verify and bring any non-complying items to the attention of the Architect.
- All new concrete surface within the "Path of Travel" shall have a non-slip medium broom finish as called for in Specification Section CAST-IN-PLACE CONCRETE. A heavy broom finish shall be used on all slopes greater than 6%.

G18 Regulatory Compliance Site Plan Legend

Mission Oak HS Aquatic Complex
 Tulare Joint Union High School District
 Tulare, CA 93274 Project

GENERAL INFORMATION
 REGULATORY SITE PLAN Drawing

ARCHITECTURE PLANNING INTERIORS
 darden architects www.dardenarchitects.com
 6790 N. West Ave. • Fresno, CA 93711 • T. 559.448.8051
 ARCHITECT
 No. C23724
 STATE OF CALIFORNIA

No.	Revision/Submission	Date
1	REVISION_01	05/31/2023

Revision
 Designed By: MF Copyright 2022 Darden Architects
 Scale: As indicated Drawn By: FM
 Project Number: 2180 Checked By: -
 Date: 03/28/2023 Reviewed By: MF

G101

P2 Occupancy = 1
P3 Occupancy = 0
P4 Occupancy = 12
Competition Pool Occupancy = 254
Warm Up Pool Occupancy = 51
Pool Deck Occupancy = 1637

Total Occupancy = 1955

DSA File No.: 54-H11
Agency Approval
DSA Application No.: 02-120251

DOORWAYS

SINGLE 3'-0" DOORWAY	= 32.75' / 0.2 = 163 OCCUPANTS
SINGLE 4'-0" DOORWAY	= 46.75' / 0.2 = 233 OCCUPANTS
1 PAIR 3'-0" DOORWAY	= 68.75' / 0.2 = 343 OCCUPANTS
1 PAIR 4'-0" DOORWAY	= 92.75' / 0.2 = 463 OCCUPANTS
1-1/2 PAIR 3'-0" DOORWAY	= 104.25' / 0.2 = 521 OCCUPANTS
1-1/2 PAIR 4'-0" DOORWAY	= 138.50' / 0.2 = 692 OCCUPANTS
2 PAIR 3'-0" DOORWAY	= 137.50' / 0.2 = 687 OCCUPANTS
2 PAIR 4'-0" DOORWAY	= 185.50' / 0.2 = 927 OCCUPANTS

M18	Exit Width Schedule
No Scale	

SYMBOLS

- Indicates Point of Exit or Exit Discharge Direction
- CPET Indicates Common Path of Exit Travel
- Exit Access #/# Indicates Exit Access See EGRESS DATA Schedule for total Travel Distance
- Indicates Required Accessible Clearance Space
- 1 Hr. Horizontal Assembly
- Accessible Restroom Location:
B = Boys
G = Girls
M = Men
W = Women
U = Unisex

ABBREVIATIONS

DF	ACCESSIBLE DRINKING FOUNTAIN LOCATION (H/A = High Adult) (L/A = Low Adult)
FEC	FIRE PROTECTION SPECIALTIES, Fire Extinguisher and Cabinet. Provide Fire Rated Cabinet at Rated Walls.
FBC	FIRE PROTECTION SPECIALTIES, Fire Extinguisher, Blanket and Cabinet. Provide Fire Rated Cabinet at Rated Walls.
WB-1	FIRE PROTECTION SPECIALTIES, Fire Extinguisher and Bracket.

G18	Regulatory Compliance Floor Plan Legend
No Scale	

Mission Oak HS Aquatic Complex
Tulare Joint Union High School District
Tulare, CA 93274
Project


GENERAL INFORMATION
REGULATORY FLOOR PLAN
Drawing

darden architects ARCHITECTURE PLANNING INTERIORS
www.dardenarchitects.com
6790 N. West Ave. • Fresno, CA 93711 • T. 559.448.8051
Architect


No.	Revision/Submission	Date
1	REVISION_01	05/31/2023

Revision


Designed By: MF Copyright 2022 Darden Architects
Scale: As indicated Drawn By: FM
Project Number: 2180 Checked By: -
Date: 03/28/2023 Reviewed By: MF

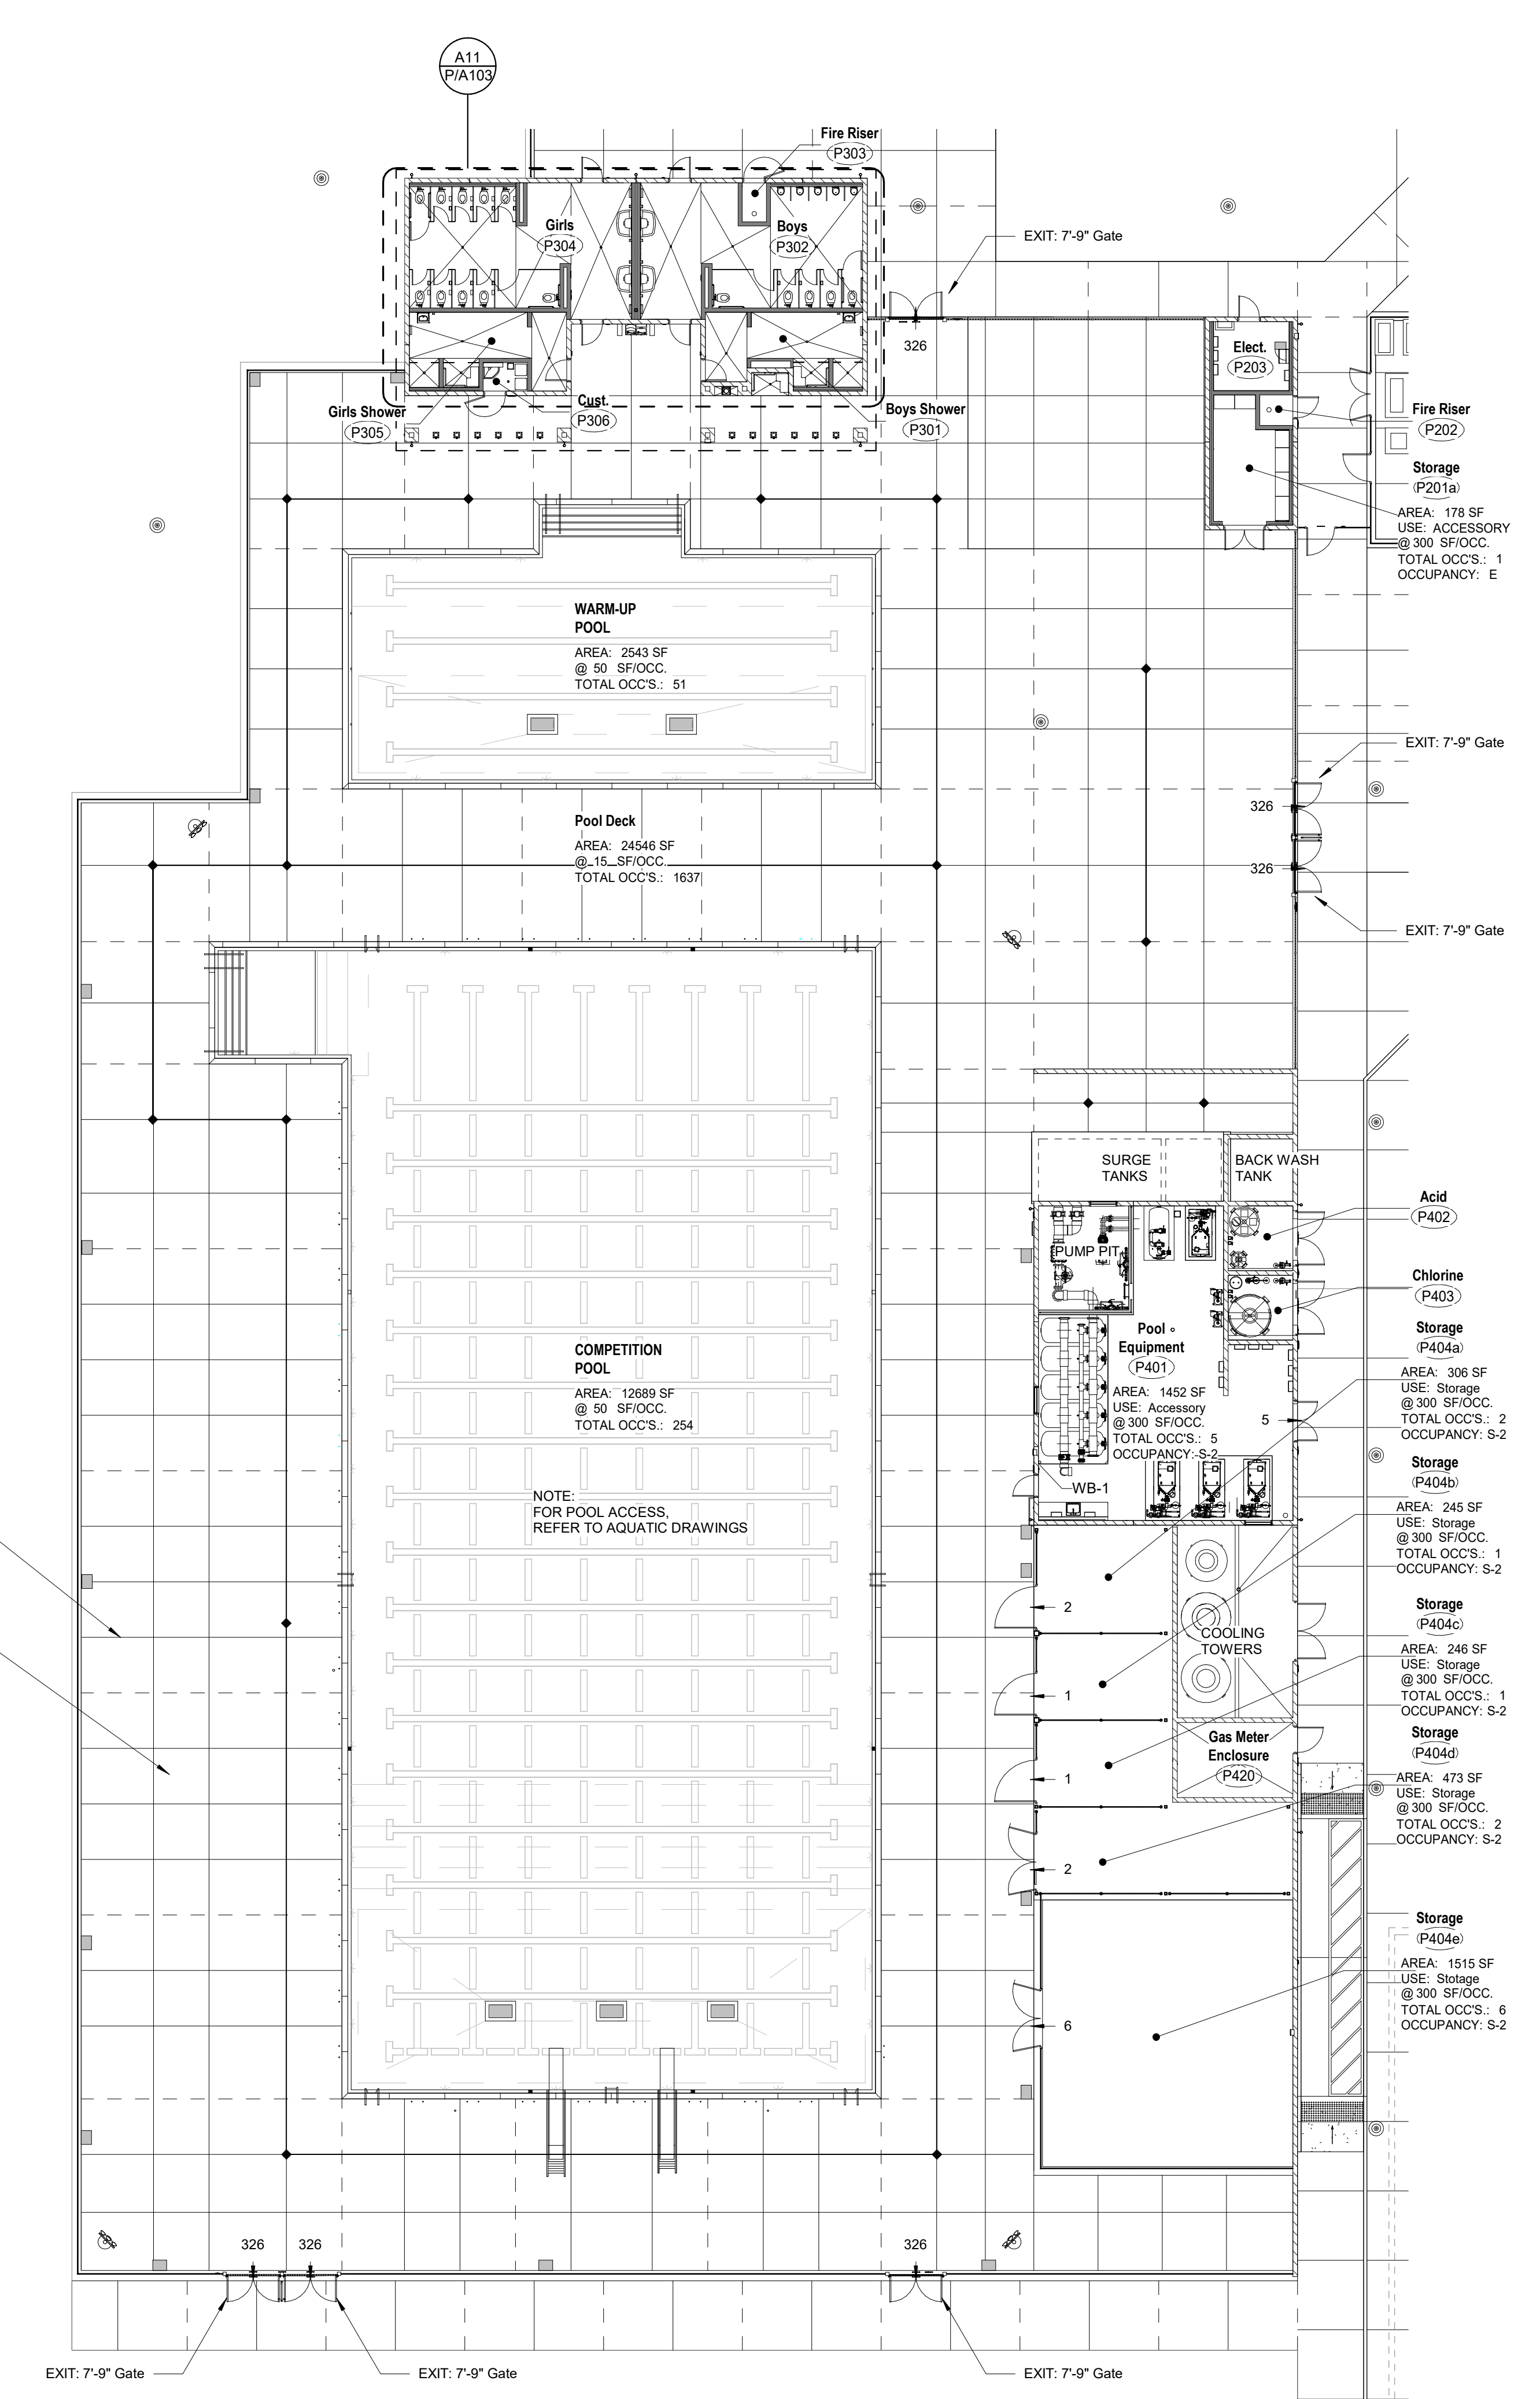

Future Item, Aluminum Bleachers.
Future Item, Shade Structure.

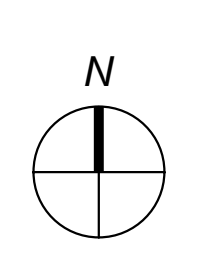


8/18/2023 4:28:40 PM e:\Users\alvin\Documents\180 Mission Oak HS Aquatic Complex_RD01_VZ2_A\winV.nt

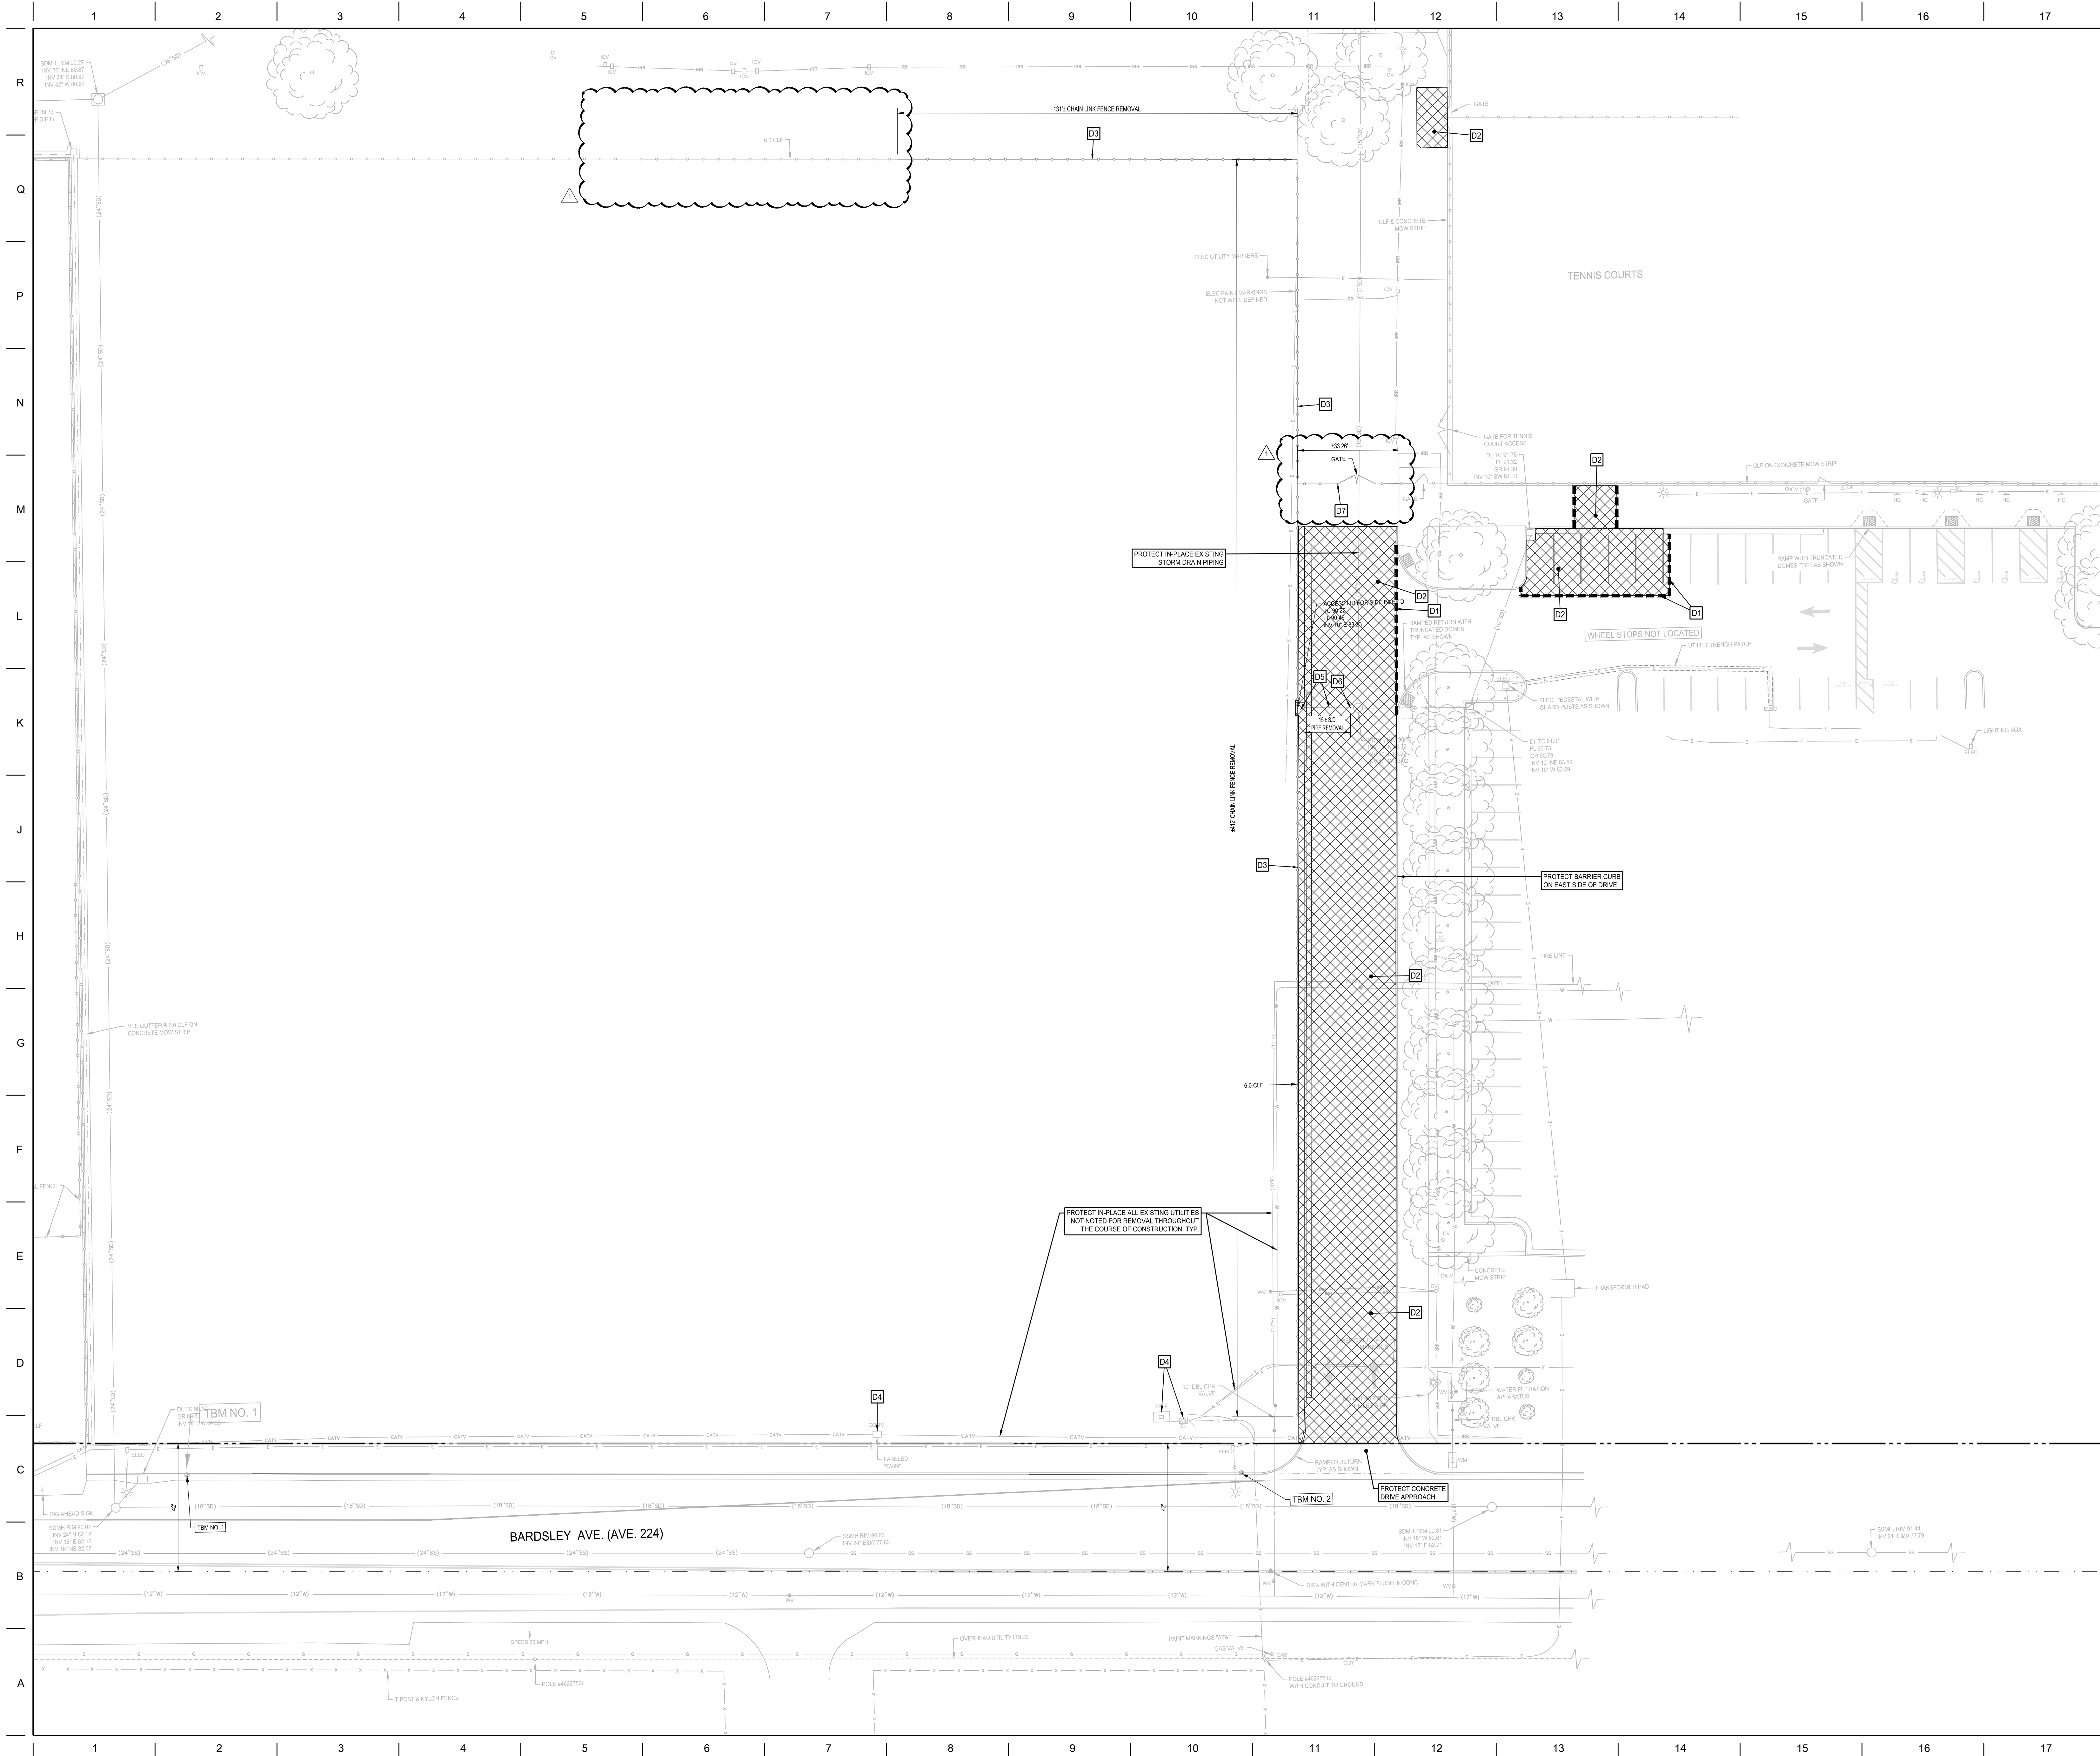

DSA File No.: 54-H11
 DSA Application No.: 02-120251
 Agency Approval

- DEMOLITION NOTES** (THIS SHEET ONLY)
- REFER TO SHEET SD/C2.1 FOR BENCHMARKS, GENERAL NOTES AND INFORMATION.
 - EXISTING IMPROVEMENTS ON THE TOPOGRAPHIC SURVEY ARE SHOWN FADED ON THIS DRAWING.
 - ALL INFRASTRUCTURE NOT NOTED FOR SALVAGE, REMOVAL, OR RELOCATION SHALL BE PROTECTED IN PLACE.
 - ALL ITEMS NOTED TO BE SALVAGED SHALL BE REMOVED WITHOUT DAMAGING AND STORED ON THE OWNER'S PROPERTY IN A LOCATION DESIGNATED BY THE OWNER UNTIL THEY ARE RE-INSTALLED AS SHOWN ON THE PLANS.
 - ALL HOLES AND TRENCHES CREATED FROM INFRASTRUCTURE REMOVAL SHALL BE BACKFILLED AND COMPACTED IN ACCORDANCE WITH THE REQUIREMENTS NOTED ON THESE PLANS.
 - IT SHALL BE THE CONTRACTOR'S RESPONSIBILITY TO FIELD VERIFY ALL ITEMS NOTED FOR REMOVAL WITH THE OWNER AND THE CITY. PRIOR TO CONSTRUCTION, THE CONTRACTOR SHALL VERIFY DIMENSIONS FOR DEMOLITION SHOWN ON THIS PLAN WITH THE PROPERTY OWNER AND THE CITY.
 - ANY EXISTING SURFACE STRUCTURES OR IMPROVEMENTS (E.G. UTILITY BOXES, TRASH BINS, BENCHES, SIGNS, STREET LIGHTS, ETC.) THAT ARE DAMAGED OR TEMPORARILY REMOVED DURING DEMOLITION SHALL BE REPLACED IN KIND U.N.O.
 - ANY EXISTING REGULATORY OR WARNING SIGNS REMOVED FOR CONSTRUCTION SHALL BE REPLACED WITH TEMPORARY SIGNS AS NECESSARY TO SAFELY DIRECT TRAFFIC UNTIL THE NEW PERMANENT SIGNS ARE INSTALLED IN THEIR PERMANENT LOCATIONS PER THESE OR ACCOMPANYING PLANS.

- DEMOLITION KEYNOTES** (THIS SHEET ONLY)
- D1 SAWCUT PAVEMENT OR CONCRETE TO A CLEAN, VERTICAL EDGE
 INDICATED THUS: [Symbol]
- D2 REMOVE CURB & GUTTER, CONCRETE/ASPHALT PAVEMENT, AND/OR SIDEWALK, PAVEMENT STRIPING AND TRUNCATED DOMES.
 INDICATED THUS: [Symbol]
- D3 REMOVE CHAIN LINK FENCE, GATES, FENCE POSTS, FOOTINGS AND CONC. MOW STRIP AS REQ'D. BACKFILL EXCAVATION FROM FOOTINGS PER DETAIL 11 SHEET SD/C7.1.
- D4 UTILITY BOX - PROTECT IN PLACE. ADJUST TO FINISH GRADE - SEE GRADING PLAN FOR ADD'L. INFO.
- D5 REMOVE DRAIN INLET & STORM DRAIN PIPING AS SHOWN. BACKFILL VOID FROM DRAIN INLET AND STORM DRAIN PIPING REMOVAL PER DETAIL 11 SHEET SD/C7.1.
- D6 PLUG 10' S.D. LINE WITH CONCRETE AT 1' AWAY FROM MANHOLE.
- D7 REMOVE CHAIN LINK FENCE/GATE INCLUDING POSTS & FOOTINGS FOR NEW CONCRETE IMPROVEMENTS. SEE ARCHITECTURAL DRAWINGS FOR FENCE RE-INSTALLATION.

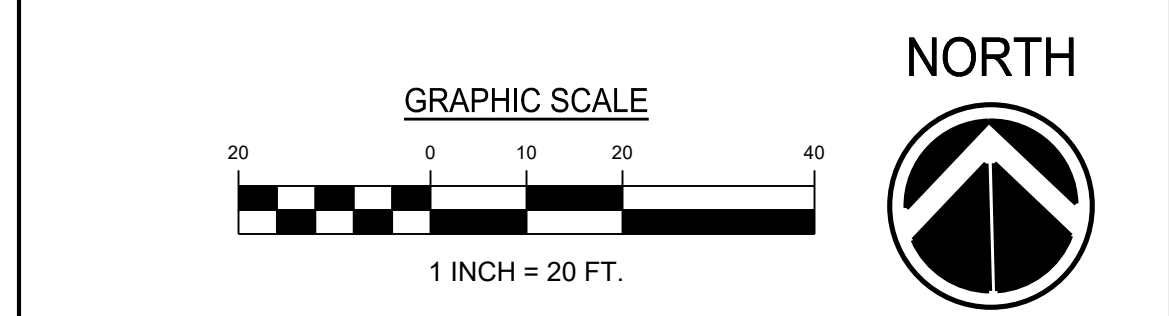

LANE ENGINEERS INC.
 CIVIL & STRUCTURAL & SURVEYING
 979 N. BLACKSTONE
 TULARE, CALIFORNIA 93274
 (559) 868-5283

08/11/2023
 CIVIL
 STATE OF CALIFORNIA

Consultant

Mission Oak HS Aquatic Complex
 Tulare Joint Union High School District
 Tulare, CA

Project

SITE DEVELOPMENT
 SITE DEMOLITION PLAN

Drawing

ARCHITECTURE
 PLANNING
 INTERIORS
 www.dardenarchitects.com
 6790 N. West Ave. • Fresno, CA 93711 • T. 559.448.8051


ARCHITECT

No.	Revision/Submission	Date

Revision

Designed By: WV Copyright 2022 Darden Architects
 Drawn By: WV
 Project Number: 2180 Checked By: AO
 Date: 08-02-22 Reviewed By: AO

Scale: 1" = 20'
 SD/ C2.1
 Sheet: 1 of 1

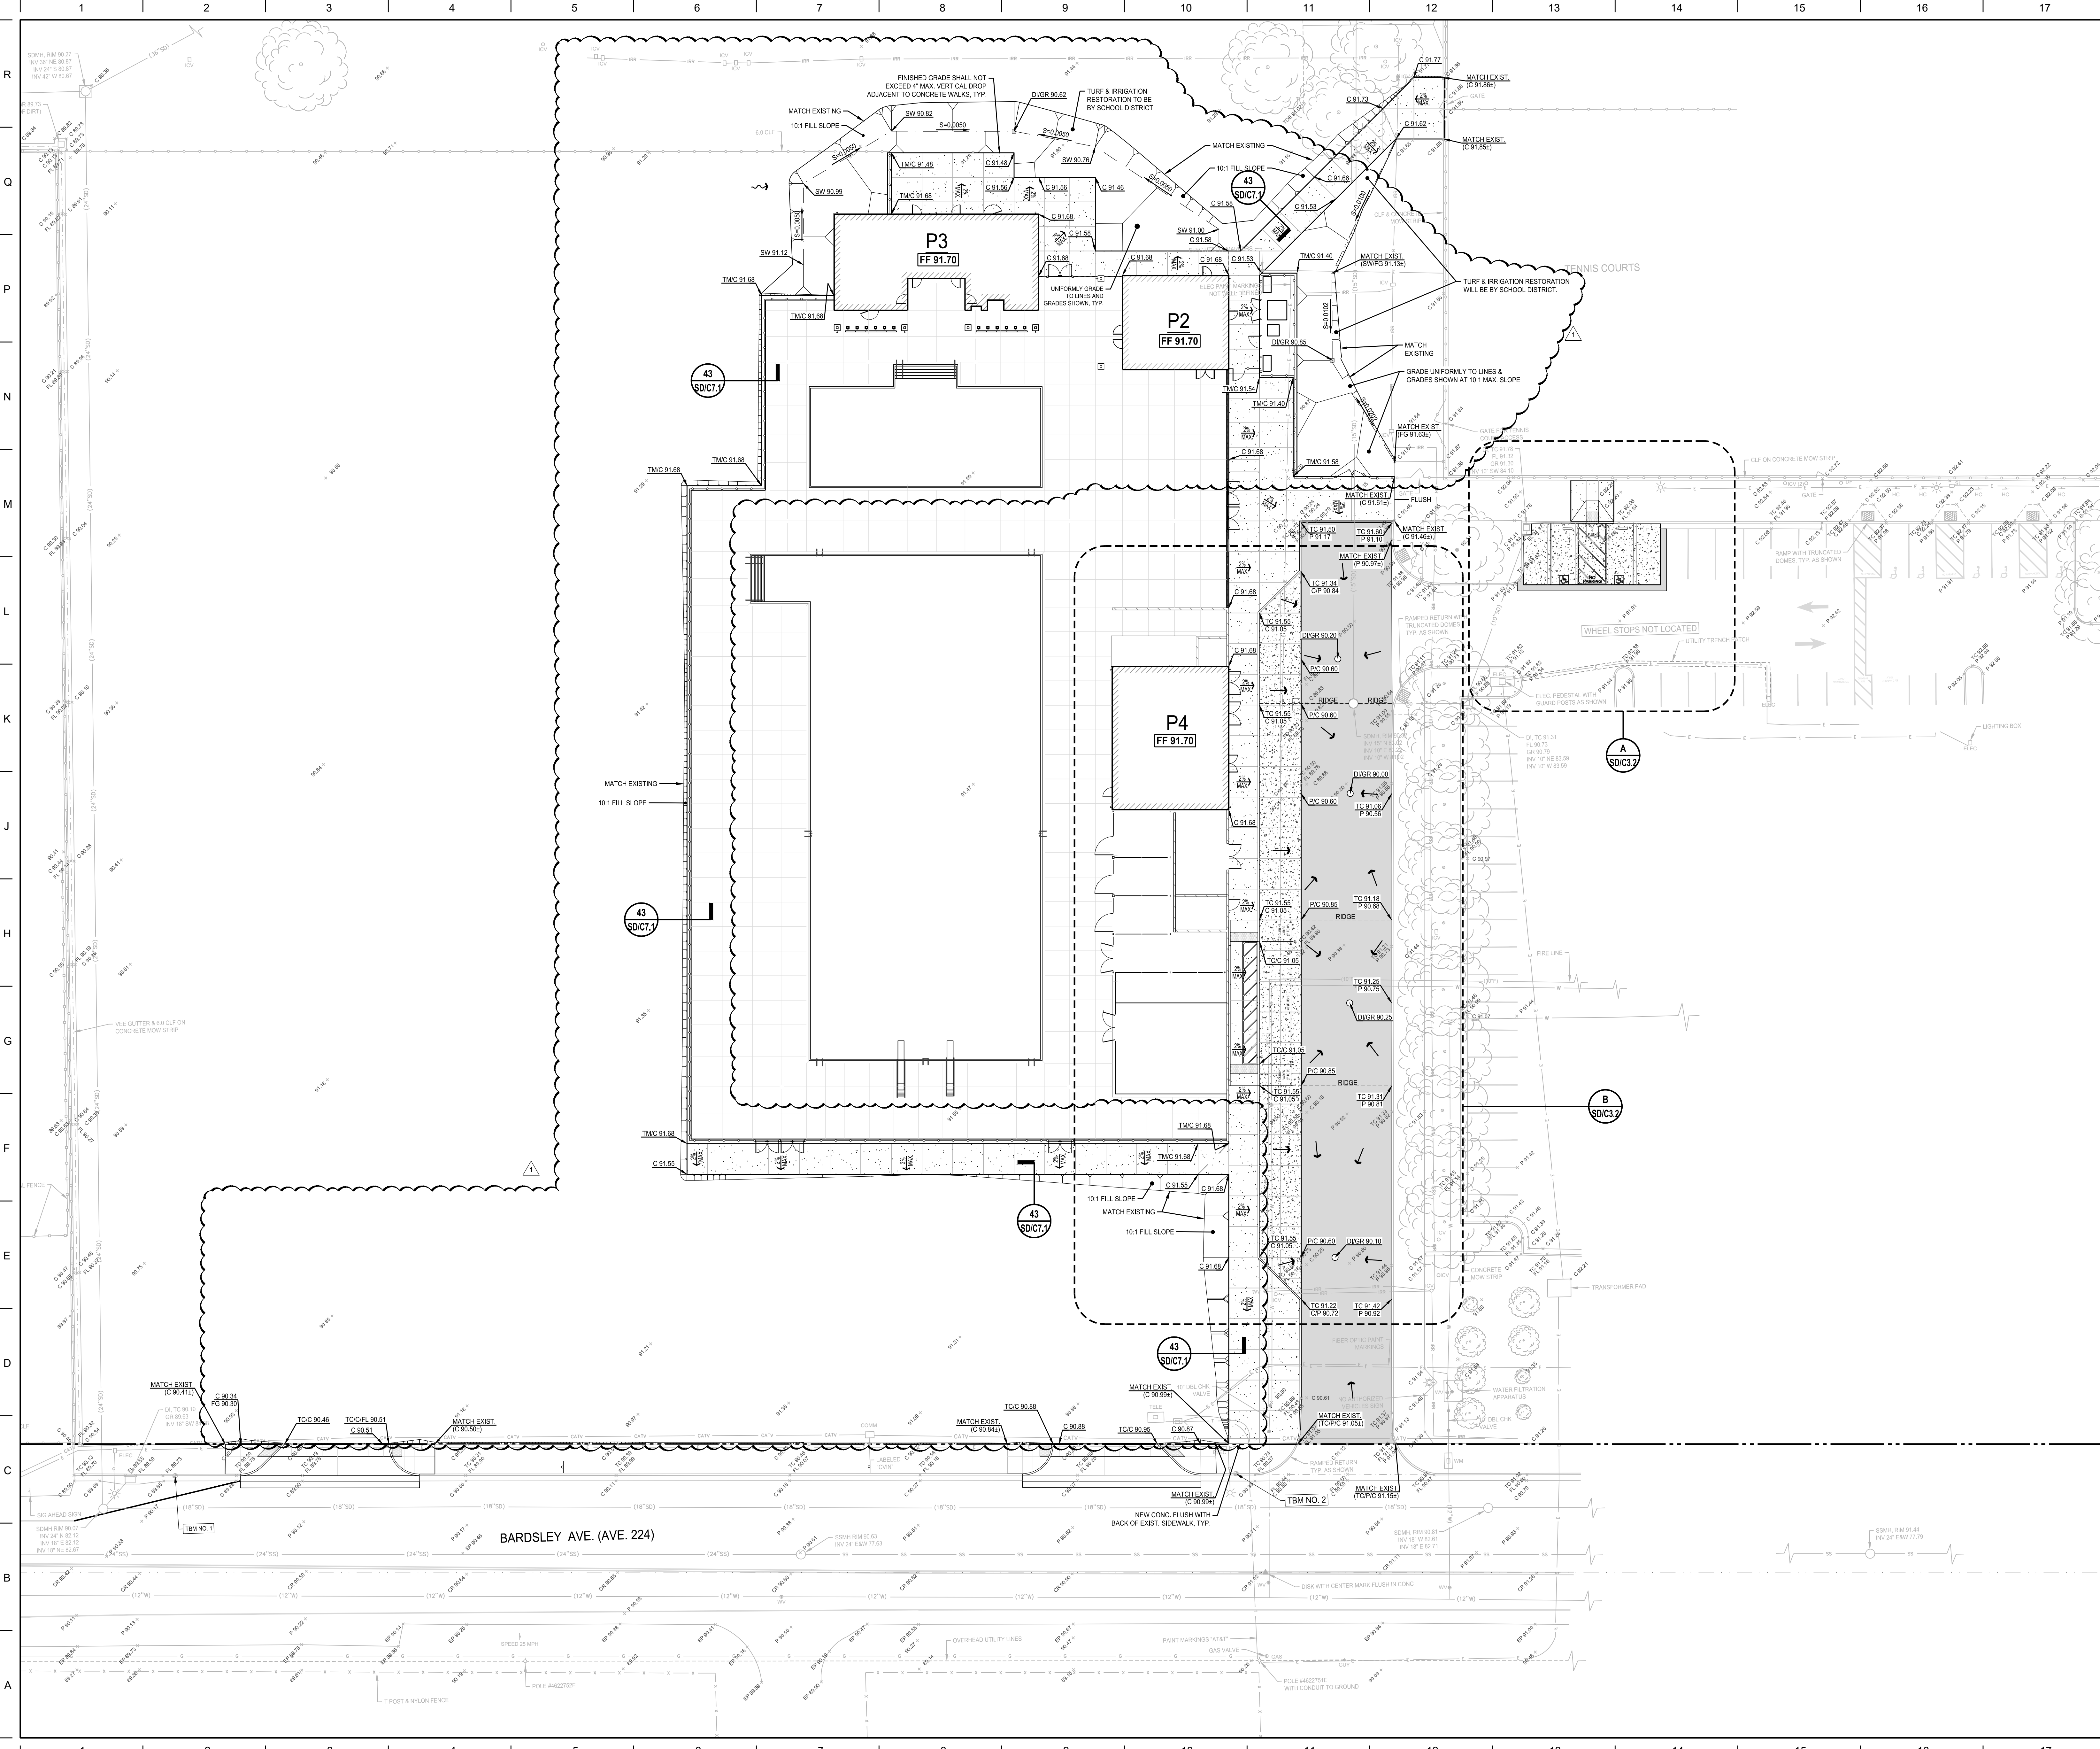


DSA File No.: 54-H11

DSA Application No.: 02-120251

Agency Approval

- NOTES**
- REFER TO SHEETS SD/C1.1 FOR BENCHMARKS, GENERAL NOTES & INFORMATION.
 - UNLESS SHOWN OR NOTED OTHERWISE, WHERE FINISH GRADE ABUTS NEW CONCRETE WALKS, MOW STRIP, CONCRETE PAVEMENT, BACK OF CURBS, FINISH GRADE ELEVATION SHALL BE 1 INCH LOWER THAN ADJACENT CONCRETE ELEVATION IN SHRUB AREAS AND 1/2 INCH LOWER IN TURF AREAS.
 - FINISHED PAVEMENT ELEVATION IS 0.5 BELOW TOP OF BARRIER/LANDSCAPE CURB IN THE PARKING LOT AND DRIVE AREAS UNLESS SHOWN OR NOTED OTHERWISE ON THE DRAWINGS.
 - CROSS SLOPE AT ALL PEDESTRIAN WALKS AND SIDEWALKS SHALL BE 1% MIN., BUT SHALL NOT EXCEED 2.0%.
 - FINISHED PAVEMENT SLOPES AT ALL ACCESSIBLE PARKING SPACES AND ACCESS AISLES SHALL NOT EXCEED 2.0%.
 - EXTERIOR CONCRETE SHALL BE 1/2 BELOW FINISHED FLOOR AT ALL EXTERIOR DOORS TYP., UNL.O.
 - FIELD VERIFY ALL ELEVATIONS SHOWN WHERE PROPOSED IMPROVEMENTS ABUT EXISTING IMPROVEMENTS. IMMEDIATELY NOTIFY PROJECT ARCHITECT OF ANY DISCREPANCIES.
 - REFER TO ARCHITECTURAL DRAWINGS FOR ADDITIONAL SITE INFORMATION AND DETAILS.
 - REFER TO SHEETS SD/C4.1 - SD/C4.2 FOR STORM DRAIN PIPING AND DRAIN INLET INFORMATION.
 - ALL EXISTING VALVE BOXES AND MANHOLES TO REMAIN SHALL BE ADJUSTED AS REQUIRED SO THAT THE TOP OF COVERS ARE FLUSH WITH FINISH GRADES.
 - SEE PLANS PREPARED BY "AQUATICS DESIGN GROUP" AND ARCHITECTURAL DRAWINGS FOR IMPROVEMENTS INSIDE POOL COMPLEX INCLUDING GRADING AND DRAINAGE.

- LEGEND**
- NEW CONCRETE SIDEWALK/FLATWORK
 - NEW ASPHALT CONCRETE PAVEMENT
 - NEW CONCRETE PAVEMENT SURFACE
 - PROPERTY LINE/RIGHT OF WAY

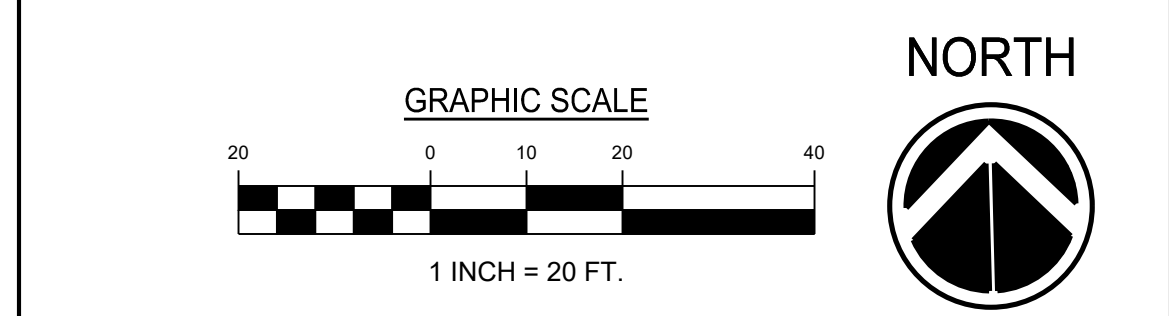

LANE ENGINEERS INC.
 CIVIL & STRUCTURAL ENGINEERING
 979 N. BLACKSTONE
 TULARE, CALIFORNIA 93274
 (559) 688-5263

Consultant



Mission Oak HS Aquatic Complex
 Tulare Joint Union High School District
 Tulare, CA

Project

SITE DEVELOPMENT
 ALTERNATE BID- GRADING AND DRAINAGE PLAN


Drawing

darden ARCHITECTURE
 PLANNING
 INTERIORS

www.dardenarchitects.com

6790 N. West Ave. • Fresno, CA 93711 • T. 559.448.8051

Architect

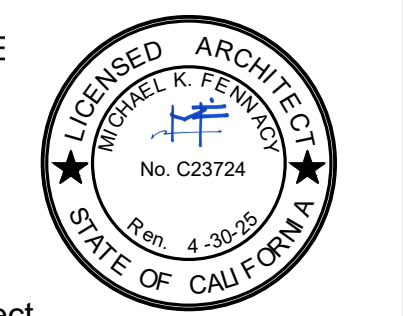

No.	Revision/Submission	Date


Revision

Designed By: WV Copyright 2022 Darden Architects
 Drawn By: WV
 Project Number: 2180 Checked By: AO
 Date: 08-02-22 Reviewed By: AO

Scale: 1" = 20'

SD/C3.1.1

Sheet: 1 of 1

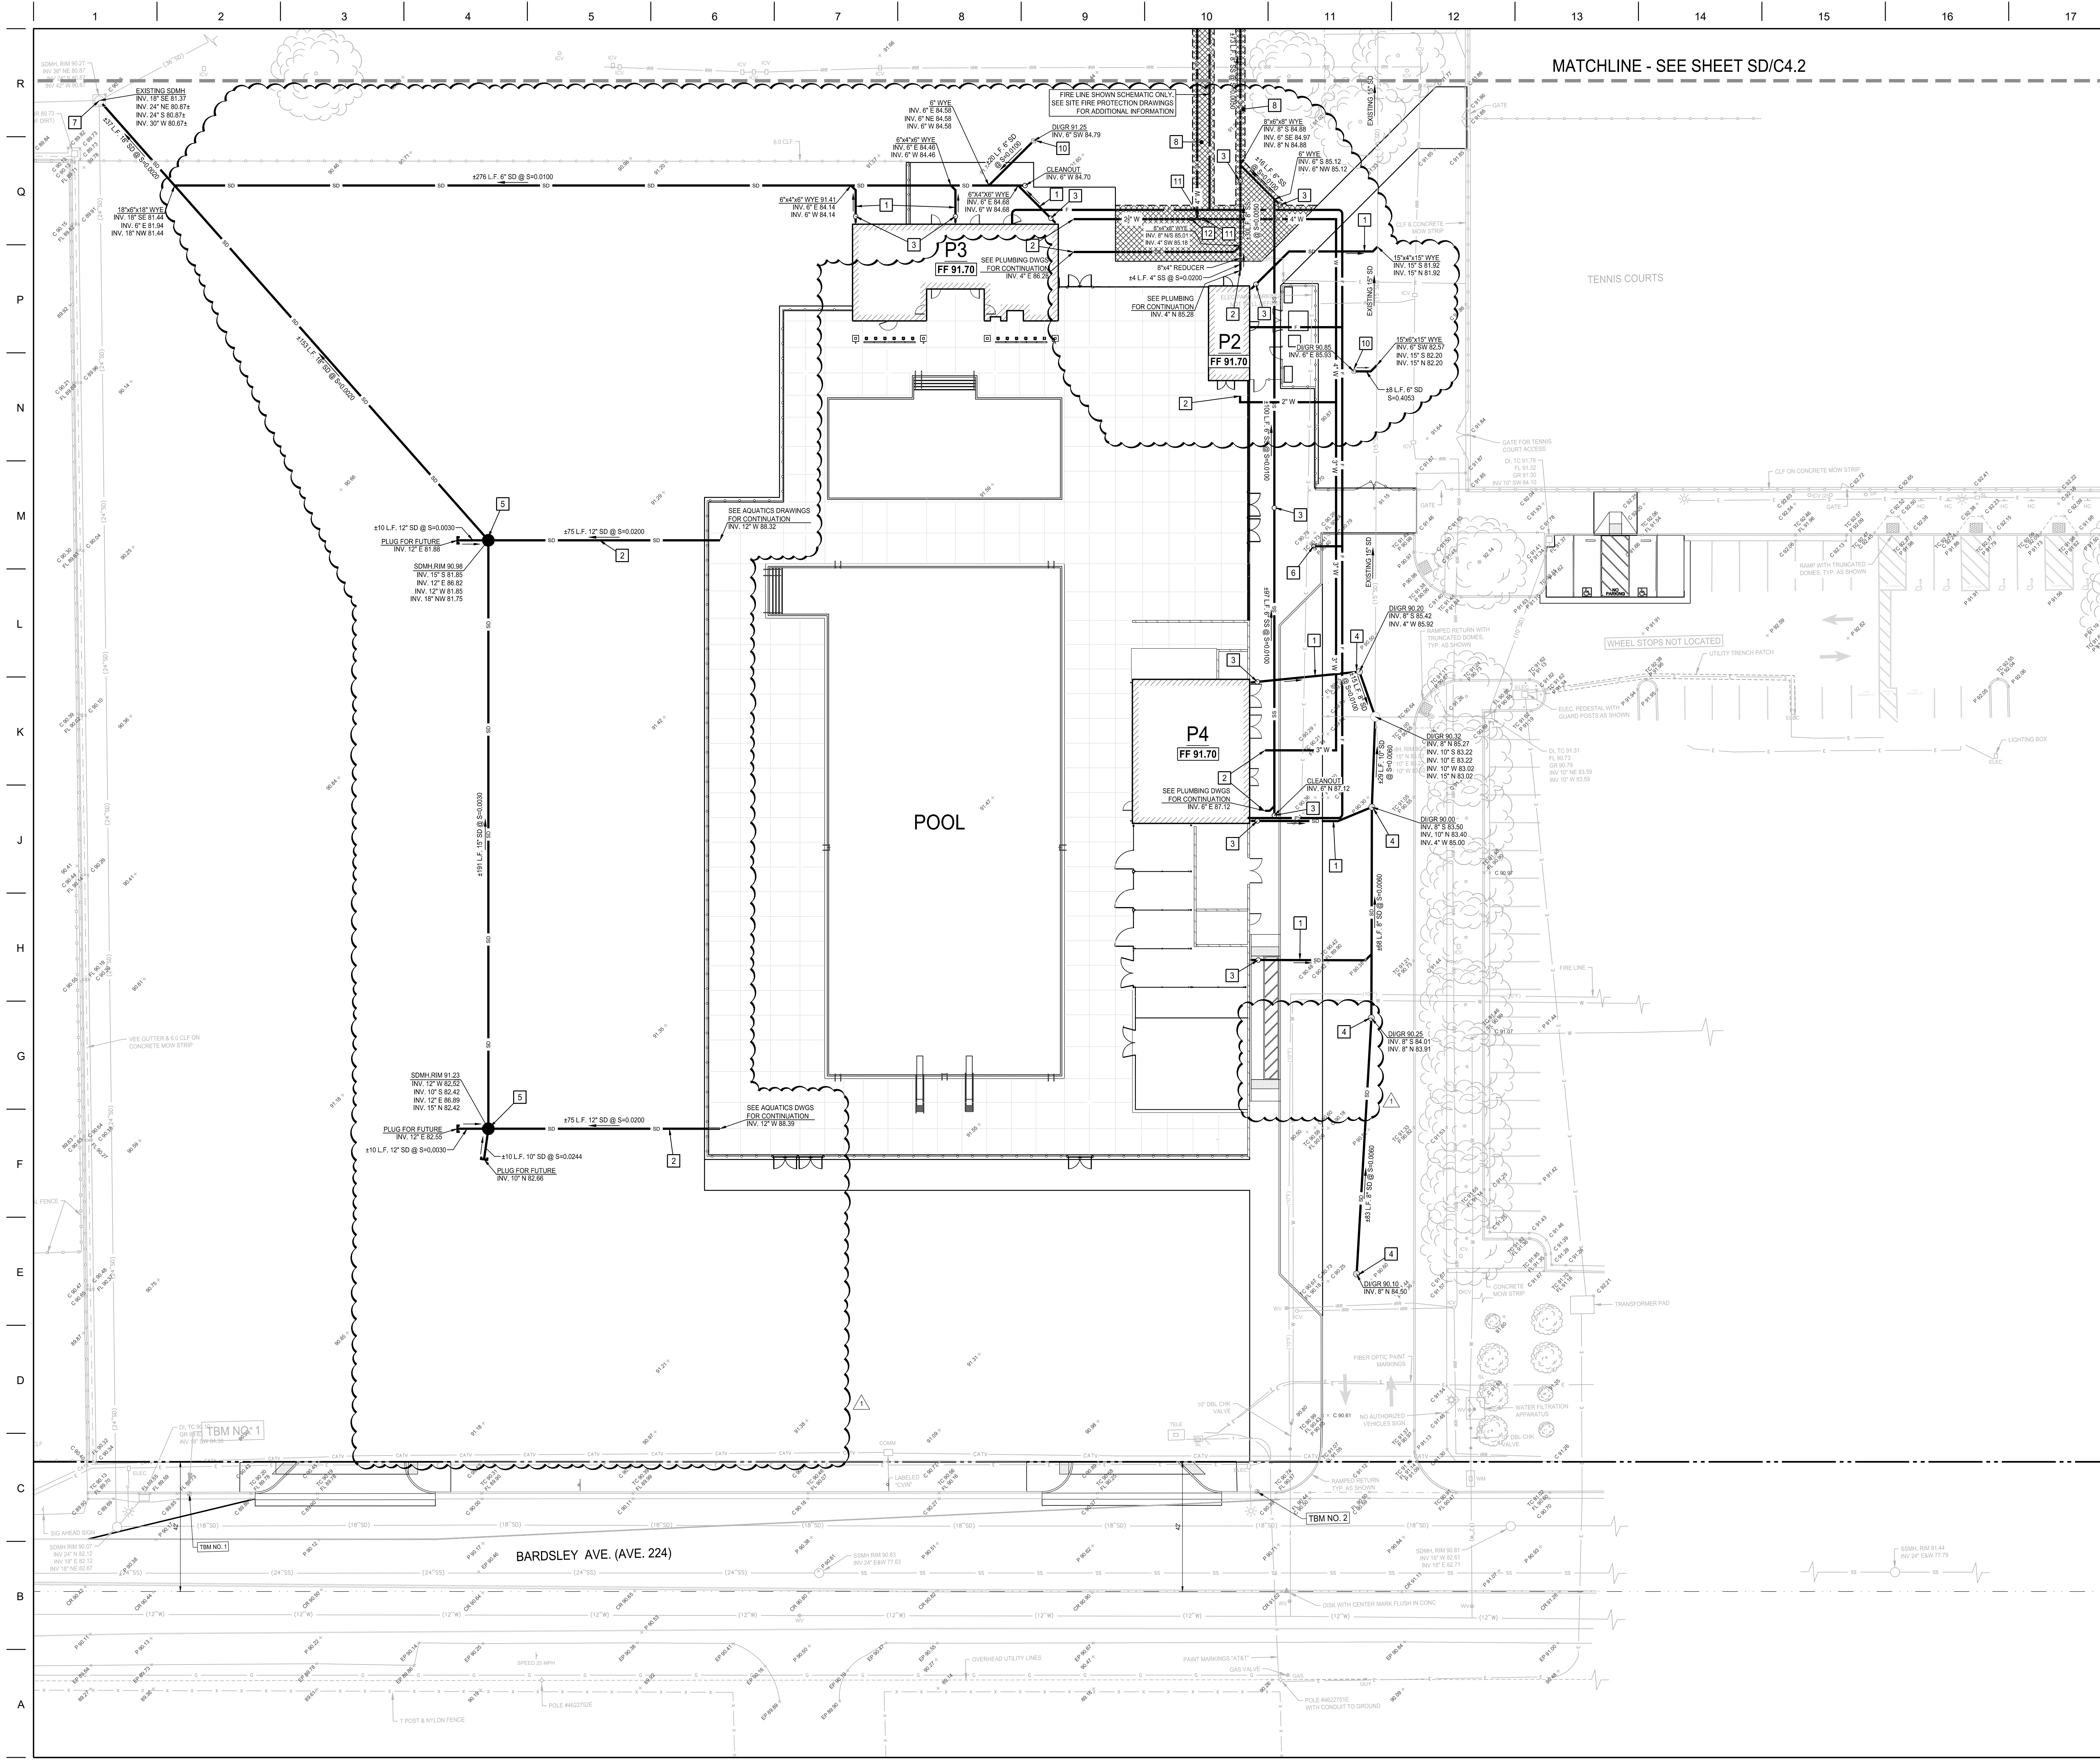


MATCHLINE - SEE SHEET SD/C4.2

DSA File No.: 54-H11
 DSA Application No.: 02-120251
 Agency Approval

- NOTES**
- REFER TO SHEETS SD/C4.1 FOR BENCHMARKS, GENERAL NOTES & INFORMATION.
 - SEE ARCHITECTURAL DWGS. FOR ADDITIONAL SITE INFORMATION AND DETAILS. SEE PLUMBING DRAWINGS FOR ADDITIONAL WET UTILITY PIPING.
 - ALL STORM DRAIN PIPING AND LATERALS SHALL HAVE A MINIMUM OF 3% OF COVER.
 - ALL TRENCHES ON-SITE SHALL BE BACKFILLED IN ACCORDANCE WITH DETAIL 11 SHEET SD/C4.1. PROVIDE NEW TURF SURFACE WHERE EXISTING HAS BEEN REMOVED DUE TO NEW PIPE TRENCHING. SEE LANDSCAPING SPECIFICATIONS FOR TURF REQUIREMENTS.
 - ANY EXISTING IRRIGATION SYSTEMS THAT ARE DAMAGED OR REMOVED DUE TO NEW UTILITY PIPE INSTALLATION SHALL BE REPAIRED AS REQUIRED.
 - DUE TO THE SCALE OF THE DRAWINGS, IT IS NOT POSSIBLE TO INDICATE ALL OFFSETS, PIPE SLOPES, FITTINGS, ETC., WHICH MAY BE REQUIRED. IT SHALL BE THE RESPONSIBILITY OF THE CONTRACTOR TO REVIEW THESE DRAWINGS AND FURNISH ALL FITTINGS, ETC. NECESSARY TO COMPLETE A FULLY FUNCTIONAL PIPING SYSTEM AND AVOID ANY CONFLICTS WITH OTHER UTILITIES.

- LEGEND**
- RIGHT OF WAY/PROPERTY LINE
 - NEW STORM DRAIN PIPING
 - NEW SANITARY SEWER PIPING
 - NEW WATER PIPING
 - NEW FIRE PIPING (SEE FIRE PROTECTION DRAWINGS)

- CONSTRUCTION KEYNOTES** (SHEETS C4.1 & C4.2)
- 4" STORM DRAIN LATERAL TO ROOF DOWNSPOUTS. ALL LATERALS SHALL HAVE A MIN. SLOPE OF 2.0% LAND. SEE ARCHITECTURAL DRAWINGS FOR STORM DRAIN TO ROOF DOWNSPOUT CONNECTIONS. CONTRACTOR SHALL VERIFY LOCATION OF ROOF DOWNSPOUTS WITH ARCHITECTURAL DRAWINGS.
 - POC - SEE PLUMBING/AQUATICS DRAWINGS FOR CONNECTION/CONTINUATION.
 - CONSTRUCT SURFACE CLEAN OUT (COTO) - SEE DETAIL 21 SHEET SD/C4.1.
 - CONSTRUCT AREA DRAIN - SEE DETAIL 32 SHEET SD/C4.1.
 - CONSTRUCT STORM DRAIN MANHOLE WITH SOLID LID COVER - SEE DETAILS 13, 22 & 24 SHEET SD/C4.1.
 - NEW FIRE HYDRANT - SEE SITE FIRE PROTECTION DRAWINGS FOR ADDITIONAL INFORMATION.
 - CONNECT TO EXISTING CONTRACTOR TO VERIFY LOCATION AND DEPTHS OF EXISTING UTILITIES AT POINT OF CONNECTION PRIOR TO NEW INSTALLATION. TYP. NOTIFY ARCHITECT OF RECORD OF ANY DISCREPANCIES.
 - TRENCH BACKFILL & REPAIR LANDSCAPING ALONG NEW PIPE. RESTORE TURF WITH NEW TURF TIE-WAY SOO, AND BLEND INTO THE EXISTING TURF FOR A SEAMLESS TRANSITION.
APPROX. REPAIR AREA SHOWN THIS: [Hatched Pattern]
 - TRENCH BACKFILL & REPAIR CONCRETE WALK ALONG NEW PIPE.
APPROX. REPAIR AREA SHOWN THIS: [Hatched Pattern]
 - CONSTRUCT DRAIN INLET WITH CAST IRON GRATE - SEE DETAIL 14 SHEET SD/C4.1.
 - FURNISH & INSTALL 4" DOMESTIC WATER GATE VALVE.
 - FURNISH & INSTALL 2" DOMESTIC WATER GATE VALVE.

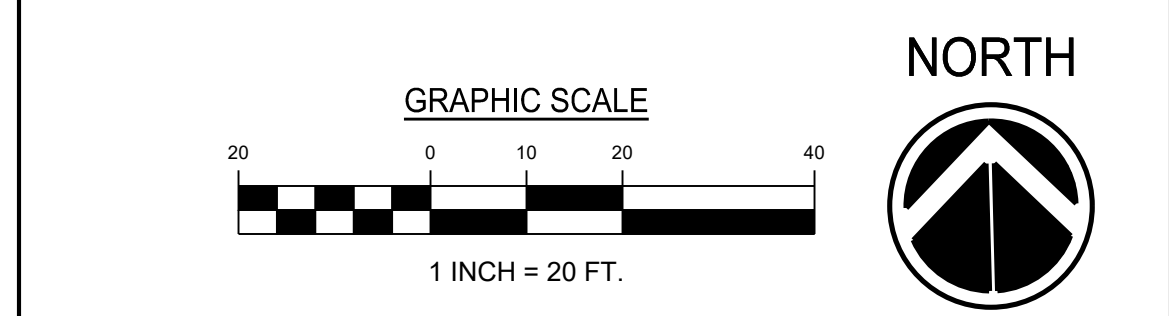


LANE ENGINEERS INC.
 CIVIL & STRUCTURAL ENGINEERING
 979 N. BLACKSTONE
 TULARE, CALIFORNIA 93274
 (559) 688-5283
 Consultant

Mission Oak HS Aquatic Complex
 Tulare Joint Union High School District
 Tulare, CA
 Project

SITE DEVELOPMENT
 WET PIPING PLAN
 Drawing

darden architects ARCHITECTURE PLANNING INTERIORS
 www.dardenarchitects.com
 6790 N. West Ave. • Fresno, CA 93711 • T. 559.448.8051
 Architect

No.	Revision/Submission	Date
Revision		
Scale:	1" = 20"	Designed By: WV Copyright 2022 Darden Architects
Project Number:	2180	Drawn By: WV
Date:	08-02-22	Checked By: AO
		Reviewed By: AO
		SD/ C4.1
		Sheet: 1 of 1

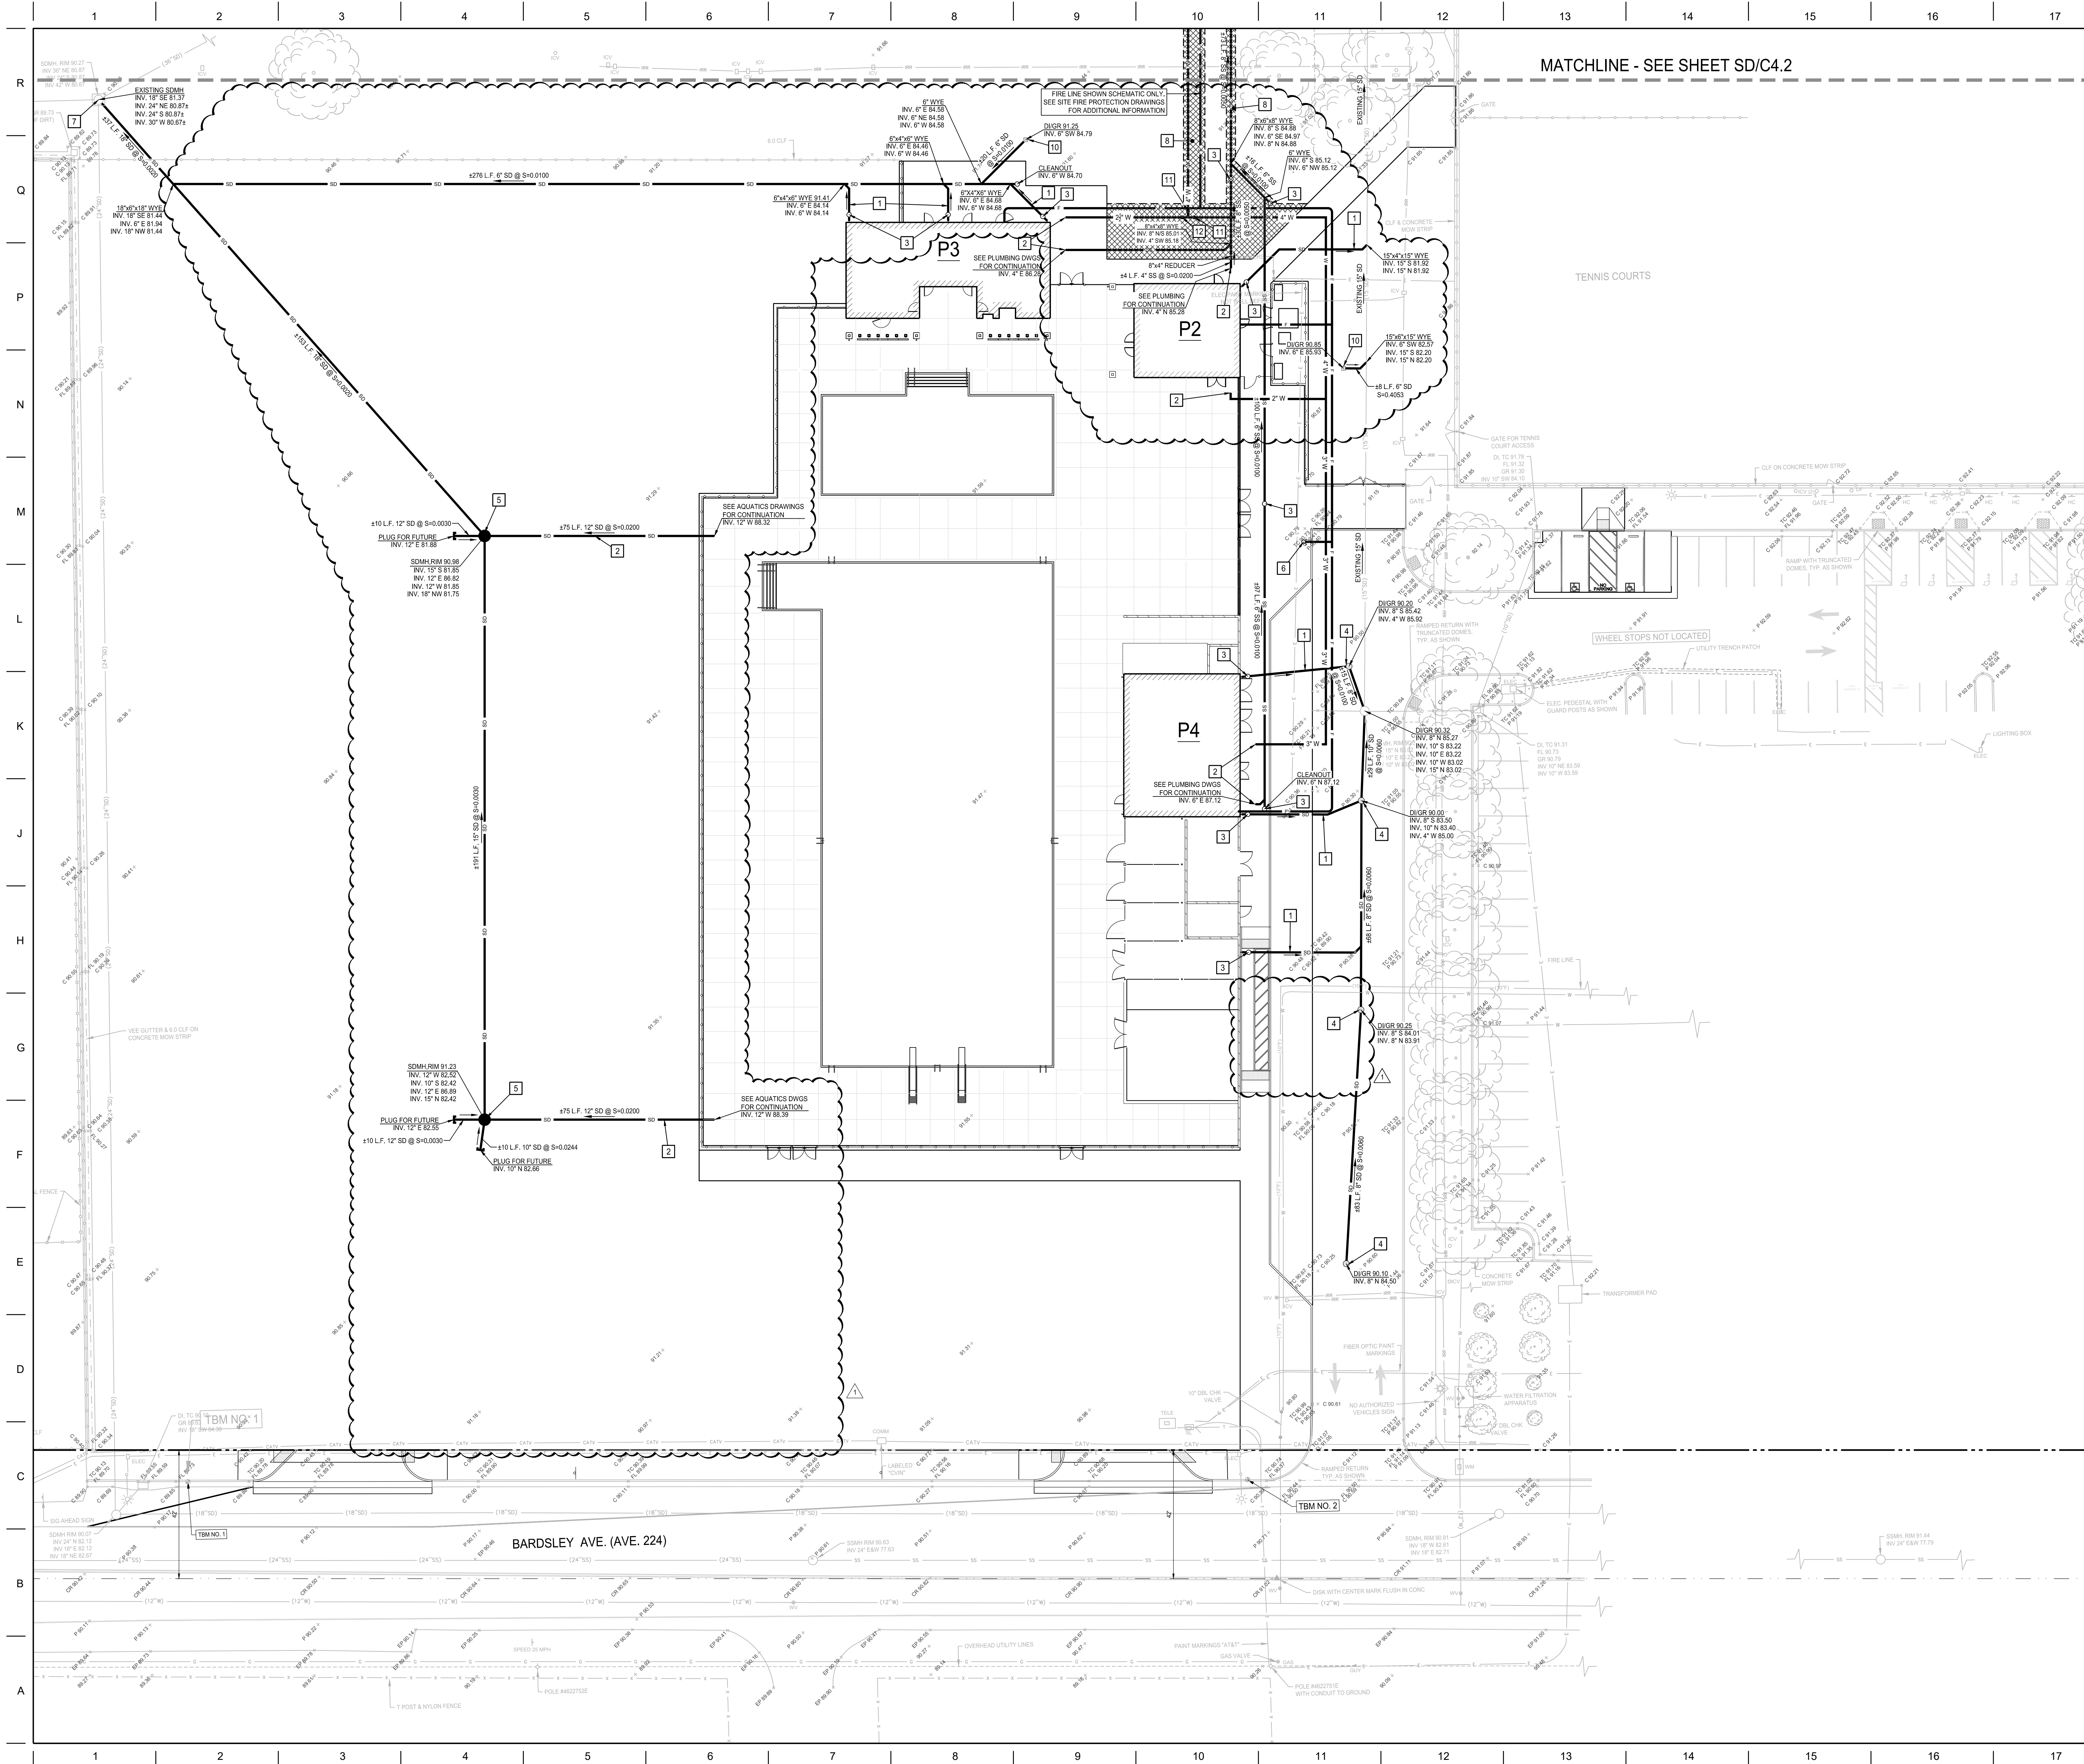


MATCHLINE - SEE SHEET SD/C4.2

DSA File No.: 54-H11
 DSA Application No.: 02-120251
 Agency Approval

- NOTES**
- REFER TO SHEETS SD/C4.1 FOR BENCHMARKS, GENERAL NOTES & INFORMATION.
 - SEE ARCHITECTURAL DWGS. FOR ADDITIONAL SITE INFORMATION AND DETAILS. SEE PLUMBING DRAWINGS FOR ADDITIONAL WET UTILITY PIPING.
 - ALL STORM DRAIN PIPING AND LATERALS SHALL HAVE A MINIMUM OF 3% OF COVER.
 - ALL TRENCHES ON-SITE SHALL BE BACKFILLED IN ACCORDANCE WITH DETAIL 11 SHEET SD/C4.1. PROVIDE NEW TURF SURFACE WHERE EXISTING HAS BEEN REMOVED DUE TO NEW PIPE TRENCHING. SEE LANDSCAPING SPECIFICATIONS FOR TURF REQUIREMENTS.
 - ANY EXISTING IRRIGATION SYSTEMS THAT ARE DAMAGED OR REMOVED DUE TO NEW UTILITY PIPE INSTALLATION SHALL BE REPAIRED AS REQUIRED.
 - DUE TO THE SCALE OF THE DRAWINGS, IT IS NOT POSSIBLE TO INDICATE ALL OFFSETS, PIPE SLOPES, FITTINGS, ETC., WHICH MAY BE REQUIRED. IT SHALL BE THE RESPONSIBILITY OF THE CONTRACTOR TO REVIEW THESE DRAWINGS AND FURNISH ALL FITTINGS, ETC. NECESSARY TO COMPLETE A FULLY FUNCTIONAL PIPING SYSTEM AND AVOID ANY CONFLICTS WITH OTHER UTILITIES.

- LEGEND**
- RIGHT OF WAY/PROPERTY LINE
 - NEW STORM DRAIN PIPING
 - S NEW SANITARY SEWER PIPING
 - W NEW WATER PIPING
 - F NEW FIRE PIPING (SEE FIRE PROTECTION DRAWINGS)

- CONSTRUCTION KEYNOTES** (SHEETS C4.1 & C4.2)
- 4" STORM DRAIN LATERAL TO ROOF DOWNSPOUTS. ALL LATERALS SHALL HAVE A MIN. SLOPE OF 2.0% UNAD. SEE ARCHITECTURAL DRAWINGS FOR STORM DRAIN TO ROOF DOWNSPOUT CONNECTIONS. CONTRACTOR SHALL VERIFY LOCATION OF ROOF DOWNSPOUTS WITH ARCHITECTURAL DRAWINGS.
 - POC - SEE PLUMBING/AQUATICS DRAWINGS FOR CONNECTION/CONTINUATION.
 - CONSTRUCT SURFACE CLEAN OUT (COTO) - SEE DETAIL 21 SHEET SD/C4.1.
 - CONSTRUCT AREA DRAIN - SEE DETAIL 32 SHEET SD/C4.1.
 - CONSTRUCT STORM DRAIN MANHOLE WITH SOLID LID COVER - SEE DETAILS 13, 22 & 24 SHEET SD/C4.1.
 - NEW FIRE HYDRANT - SEE SITE FIRE PROTECTION DRAWINGS FOR ADDITIONAL INFORMATION.
 - CONNECT TO EXISTING CONCRETE TOWER/PIPER LOCATOR AND DEPTHS OF EXISTING UTILITIES AT POINT OF CONNECTION PRIOR TO NEW INSTALLATION. TYP. NOTIFY ARCHITECT OF RECORD OF ANY DISCREPANCIES.
 - TRENCH BACKFILL & REPAIR LANDSCAPING ALONG NEW PIPE. RESTORE TURF WITH NEW TURF TIE-WAY 300, AND BLEND INTO THE EXISTING TURF FOR A SEAMLESS TRANSITION.
APPROX. REPAIR AREA SHOWN THIS: [Pattern]
 - TRENCH BACKFILL & REPAIR CONCRETE WALK ALONG NEW PIPE.
APPROX. REPAIR AREA SHOWN THIS: [Pattern]
 - CONSTRUCT DRAIN INLET WITH CAST IRON GRATE - SEE DETAIL 14 SHEET SD/C4.1.
 - FURNISH & INSTALL 4" DOMESTIC WATER GATE VALVE.
 - FURNISH & INSTALL 2" DOMESTIC WATER GATE VALVE.

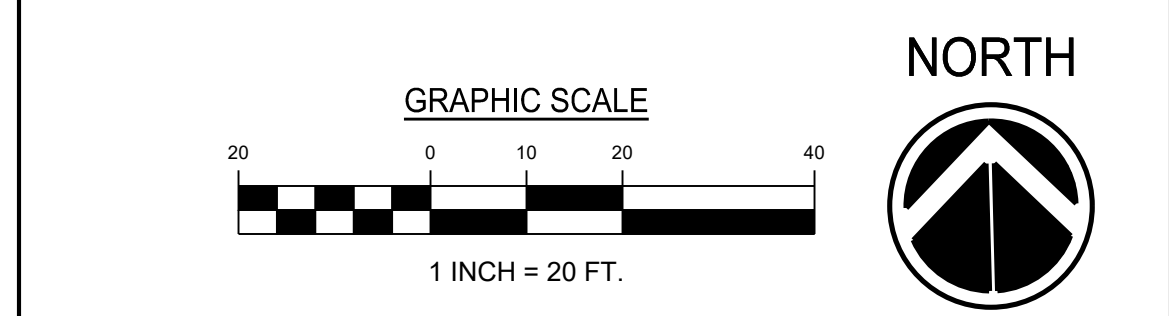



LANE ENGINEERS INC.
 CIVIL & STRUCTURAL ENGINEERING
 979 N. BLACKSTONE
 TULARE, CALIFORNIA 93274
 (559) 688-5283
 Consultant

Mission Oak HS Aquatic Complex
 Tulare Joint Union High School District
 Tulare, CA
 Project

SITE DEVELOPMENT
 ALTERNATE BID - WET PIPING PLAN
 Drawing

darden architects ARCHITECTURE PLANNING INTERIORS
 www.dardenarchitects.com
 6790 N. West Ave. • Fresno, CA 93711 • T. 559.448.8051
 Architect

No.	Revision/Submission	Date
Revision		
Scale:	1" = 20"	Designed By: WV Copyright 2022 Darden Architects
Project Number:	2180	Drawn By: WV
Date:	08-02-22	Checked By: AO Reviewed By: AO
		SD/C4.1.1
		Sheet: 1 of 1

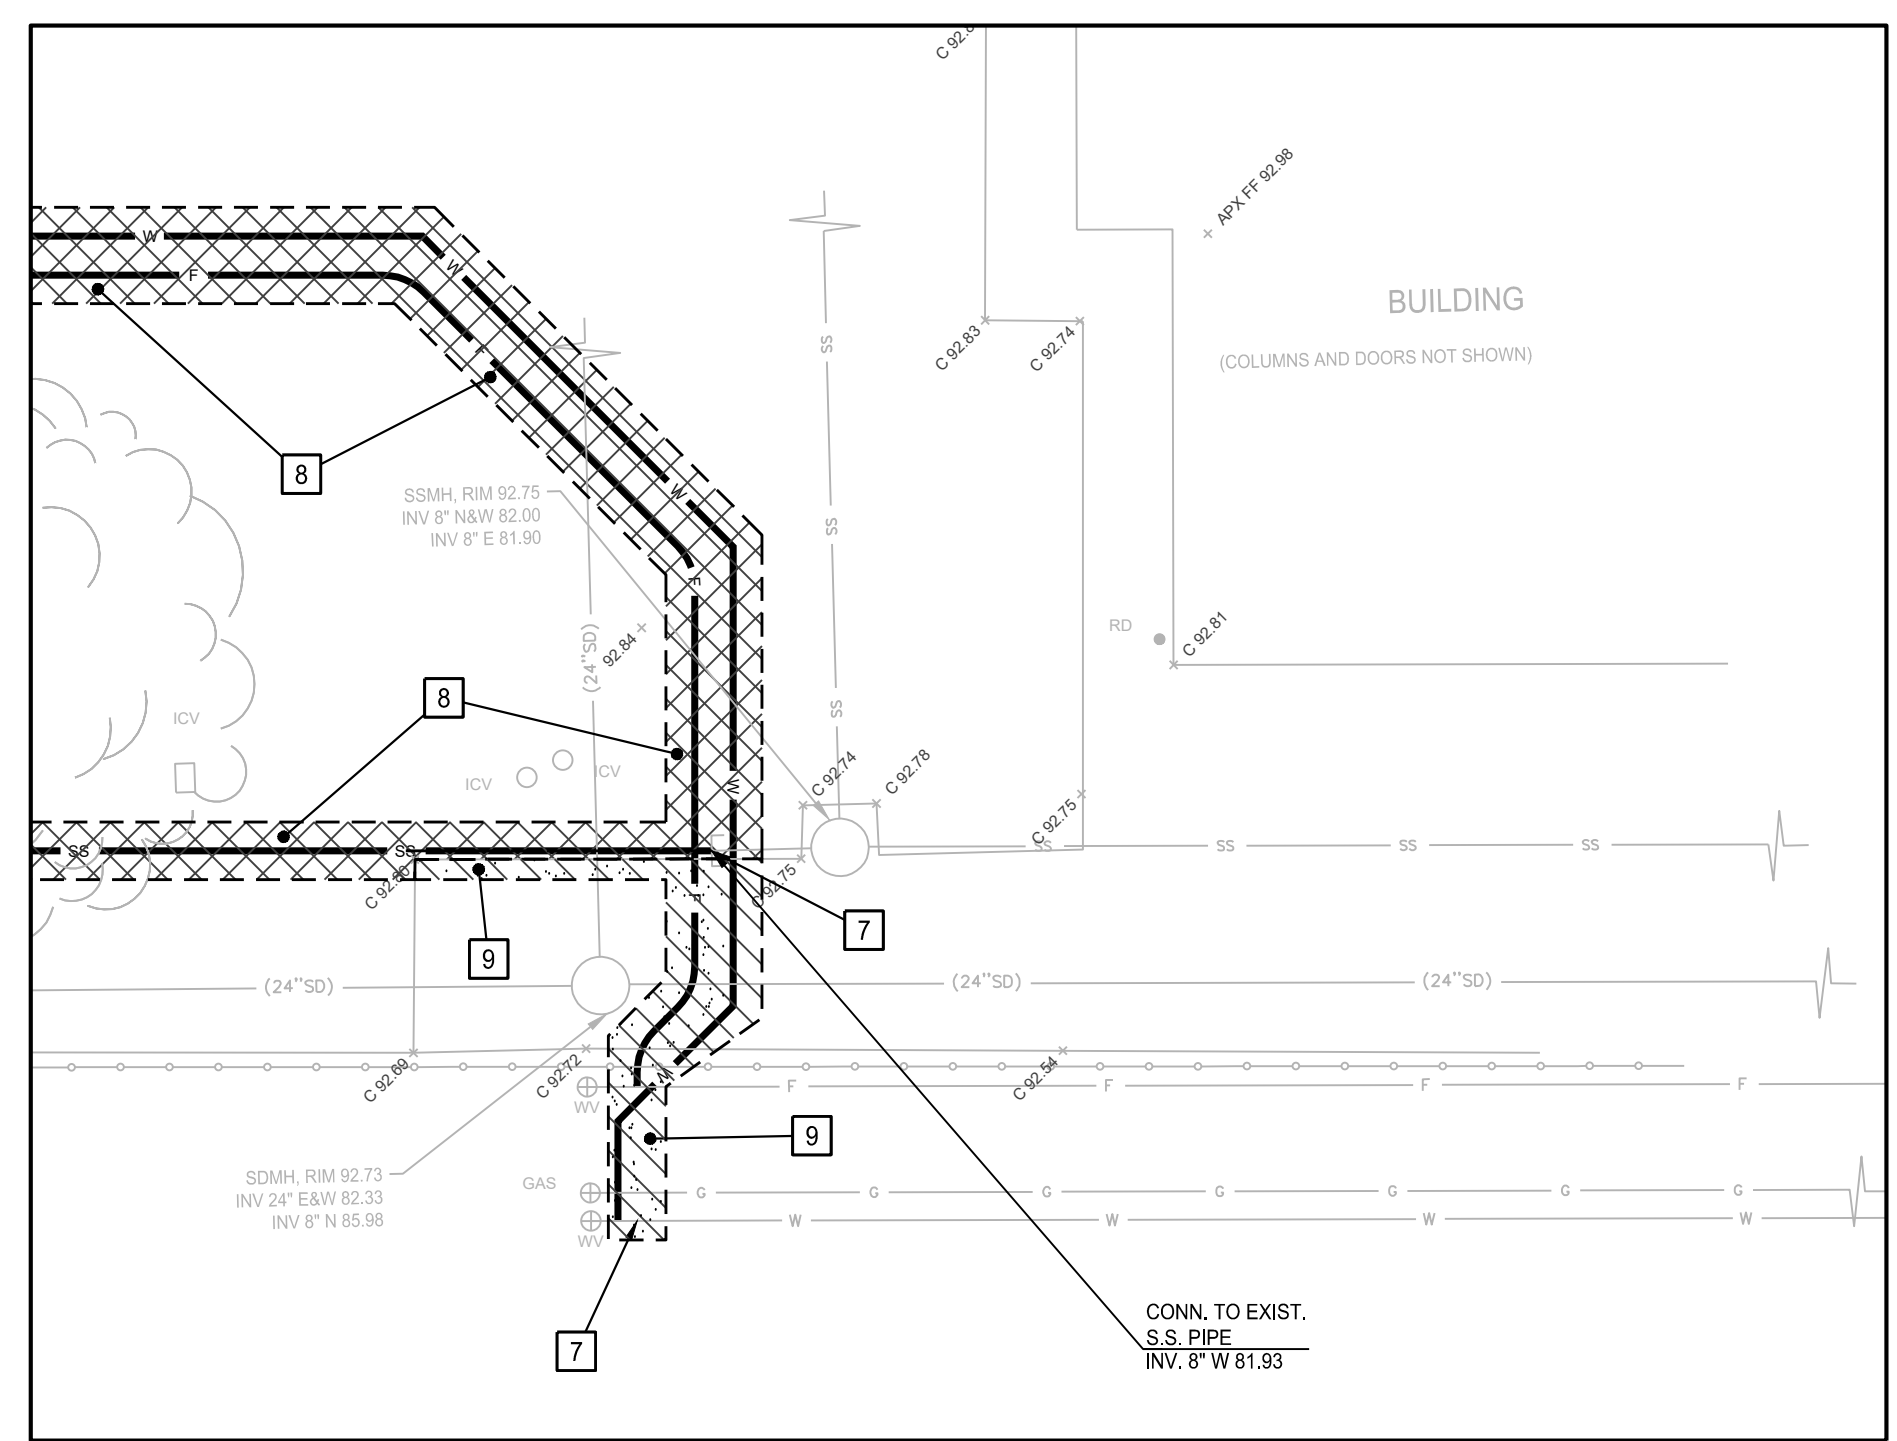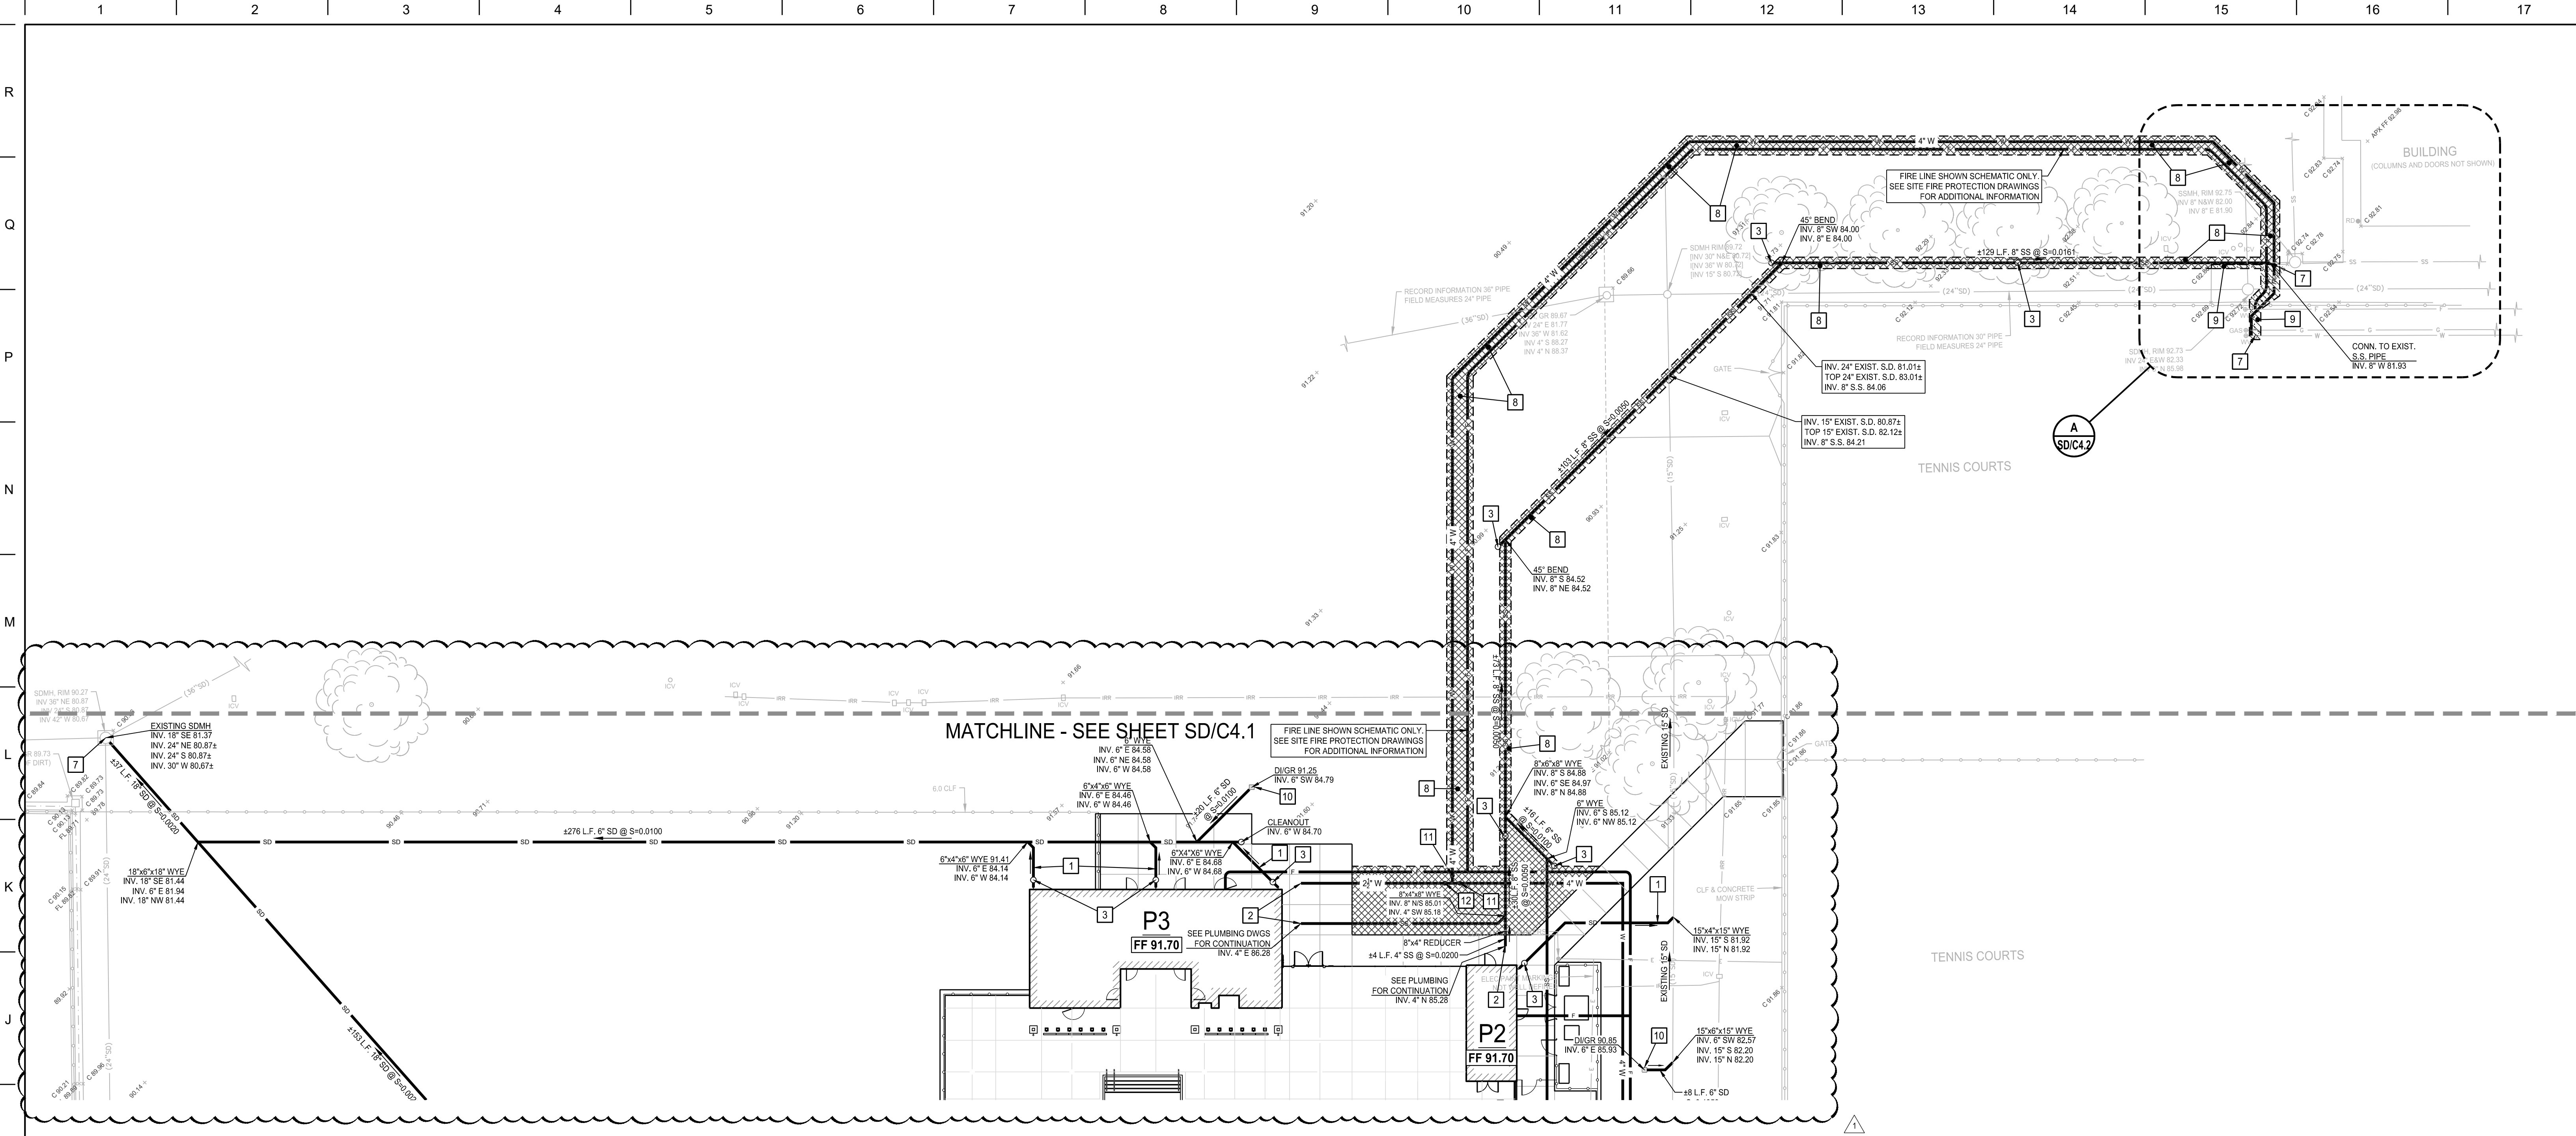


(A) ENLARGED WET PIPING DETAIL
SCALE: 1"=10'

DSA File No.: 54-H11
 DSA Application No.: 02-120251
 Agency Approval

- NOTES**
- REFER TO SHEETS SD/C4.1 FOR BENCHMARKS, GENERAL NOTES & INFORMATION.
 - SEE ARCHITECTURAL DWGS. FOR ADDITIONAL SITE INFORMATION AND DETAILS. SEE PLUMBING DRAWINGS FOR ADDITIONAL WET UTILITY PIPING.
 - ALL STORM DRAIN PIPING AND LATERALS SHALL HAVE A MINIMUM OF 3% OF COVER.
 - ALL TRENCHES ON SITE SHALL BE BACKFILLED IN ACCORDANCE WITH DETAIL 14 SHEET SD/C7.1. PROVIDE NEW TURF SURFACE WHERE EXISTING HAS BEEN REMOVED DUE TO NEW PIPE TRENCHING. SEE LANDSCAPING SPECIFICATIONS FOR TURF REQUIREMENTS.
 - ANY EXISTING IRRIGATION SYSTEMS THAT ARE DAMAGED OR REMOVED DUE TO NEW UTILITY PIPE INSTALLATION SHALL BE REPAIRED AS REQUIRED.
 - DUE TO THE SCALE OF THE DRAWINGS, IT IS NOT POSSIBLE TO INDICATE ALL OFFSETS, PIPE SLOPES, FITTINGS, ETC., WHICH MAY BE REQUIRED. IT SHALL BE THE RESPONSIBILITY OF THE CONTRACTOR TO REVIEW THESE DRAWINGS AND FURNISH ALL FITTINGS, ETC. NECESSARY TO COMPLETE A FULLY FUNCTIONAL PIPING SYSTEM AND AVOID ANY CONFLICTS WITH OTHER UTILITIES.

- LEGEND**
- RIGHT OF WAY/PROPERTY LINE
 - NEW STORM DRAIN PIPING
 - NEW SANITARY SEWER PIPING
 - NEW WATER PIPING
 - NEW FIRE PIPING (SEE FIRE PROTECTION DRAWINGS)

- CONSTRUCTION KEYNOTES** (SHEETS C4.1 & C4.2)
- 4" S.D. STORM DRAIN LATERAL TO ROOF DOWNSPOUTS. ALL LATERALS SHALL HAVE A MIN. SLOPE OF 2.0% UN.D. SEE ARCHITECTURAL DRAWINGS FOR STORM DRAIN TO ROOF DOWNSPOUT CONNECTIONS. CONTRACTOR SHALL VERIFY LOCATION OF ROOF DOWNSPOUTS WITH ARCHITECTURAL DRAWINGS.
 - POC - SEE PLUMBING/AQUATICS DRAWINGS FOR CONNECTION/CONTINUATION.
 - CONSTRUCT SURFACE CLEAN OUT (COTO) - SEE DETAIL 21 SHEET SD/C7.1.
 - CONSTRUCT AREA DRAIN - SEE DETAIL 32 SHEET SD/C7.1.
 - CONSTRUCT STORM DRAIN MANHOLE WITH SOLID LID COVER - SEE DETAILS 13, 22 & 24 SHEET SD/C4.1.
 - NEW FIRE HYDRANT - SEE SITE FIRE PROTECTION DRAWINGS FOR ADDITIONAL INFORMATION.
 - CONNECT TO EXISTING. CONTRACTOR TO VERIFY LOCATION AND DEPTHS OF EXISTING UTILITIES AT POINT OF CONNECTION PRIOR TO NEW INSTALLATION. TYP. NOTIFY ARCHITECT OF RECORD OF ANY DISCREPANCIES.
 - TRENCH BACKFILL & REPAIR LANDSCAPING ALONG NEW PIPE. RESTORE TURF WITH NEW TURF TIE-WAY SOO, AND BLEND INTO THE EXISTING TURF FOR A SEAMLESS TRANSITION.
APPROX. REPAIR AREA SHOWN THIS: [Symbol]
 - TRENCH BACKFILL & REPAIR CONCRETE WALK ALONG NEW PIPE.
APPROX. REPAIR AREA SHOWN THIS: [Symbol]
 - CONSTRUCT DRAIN INLET WITH CAST IRON GRATE - SEE DETAIL 14 SHEET SD/C7.1.
 - FURNISH & INSTALL 4" DOMESTIC WATER GATE VALVE.
 - FURNISH & INSTALL 2" DOMESTIC WATER GATE VALVE.

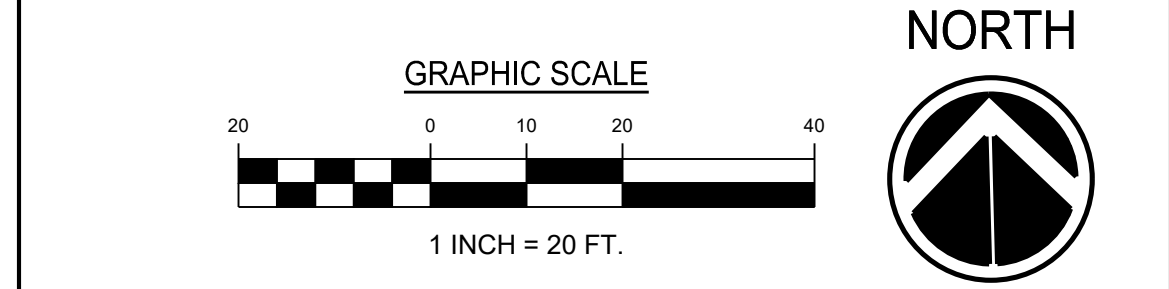

LANE ENGINEERS INC.
 CIVIL & STRUCTURAL ENGINEERING
 979 N. BLACKSTONE
 TULARE, CALIFORNIA 93274
 (559) 688-9283
 Consultant
 08/11/2023
 CIVIL ENGINEER
 STATE OF CALIFORNIA

Mission Oak HS Aquatic Complex
 Tulare Joint Union High School District
 Tulare, CA
 Project


SITE DEVELOPMENT
 WET PIPING PLAN
 Drawing

darden architects ARCHITECTURE PLANNING INTERIORS
 www.dardenarchitects.com
 6790 N. West Ave. • Fresno, CA 93711 • T. 559.448.8051
 Architect

No.	Revision/Submission	Date

Revision

Scale: AS INDICATED	Designed By: WV	Copyright 2022 Darden Architects
Project Number: 2180	Drawn By: WV	SD/ C4.2
Date: 08-02-22	Checked By: AO	
	Reviewed By: AO	Sheet: 1 of 1


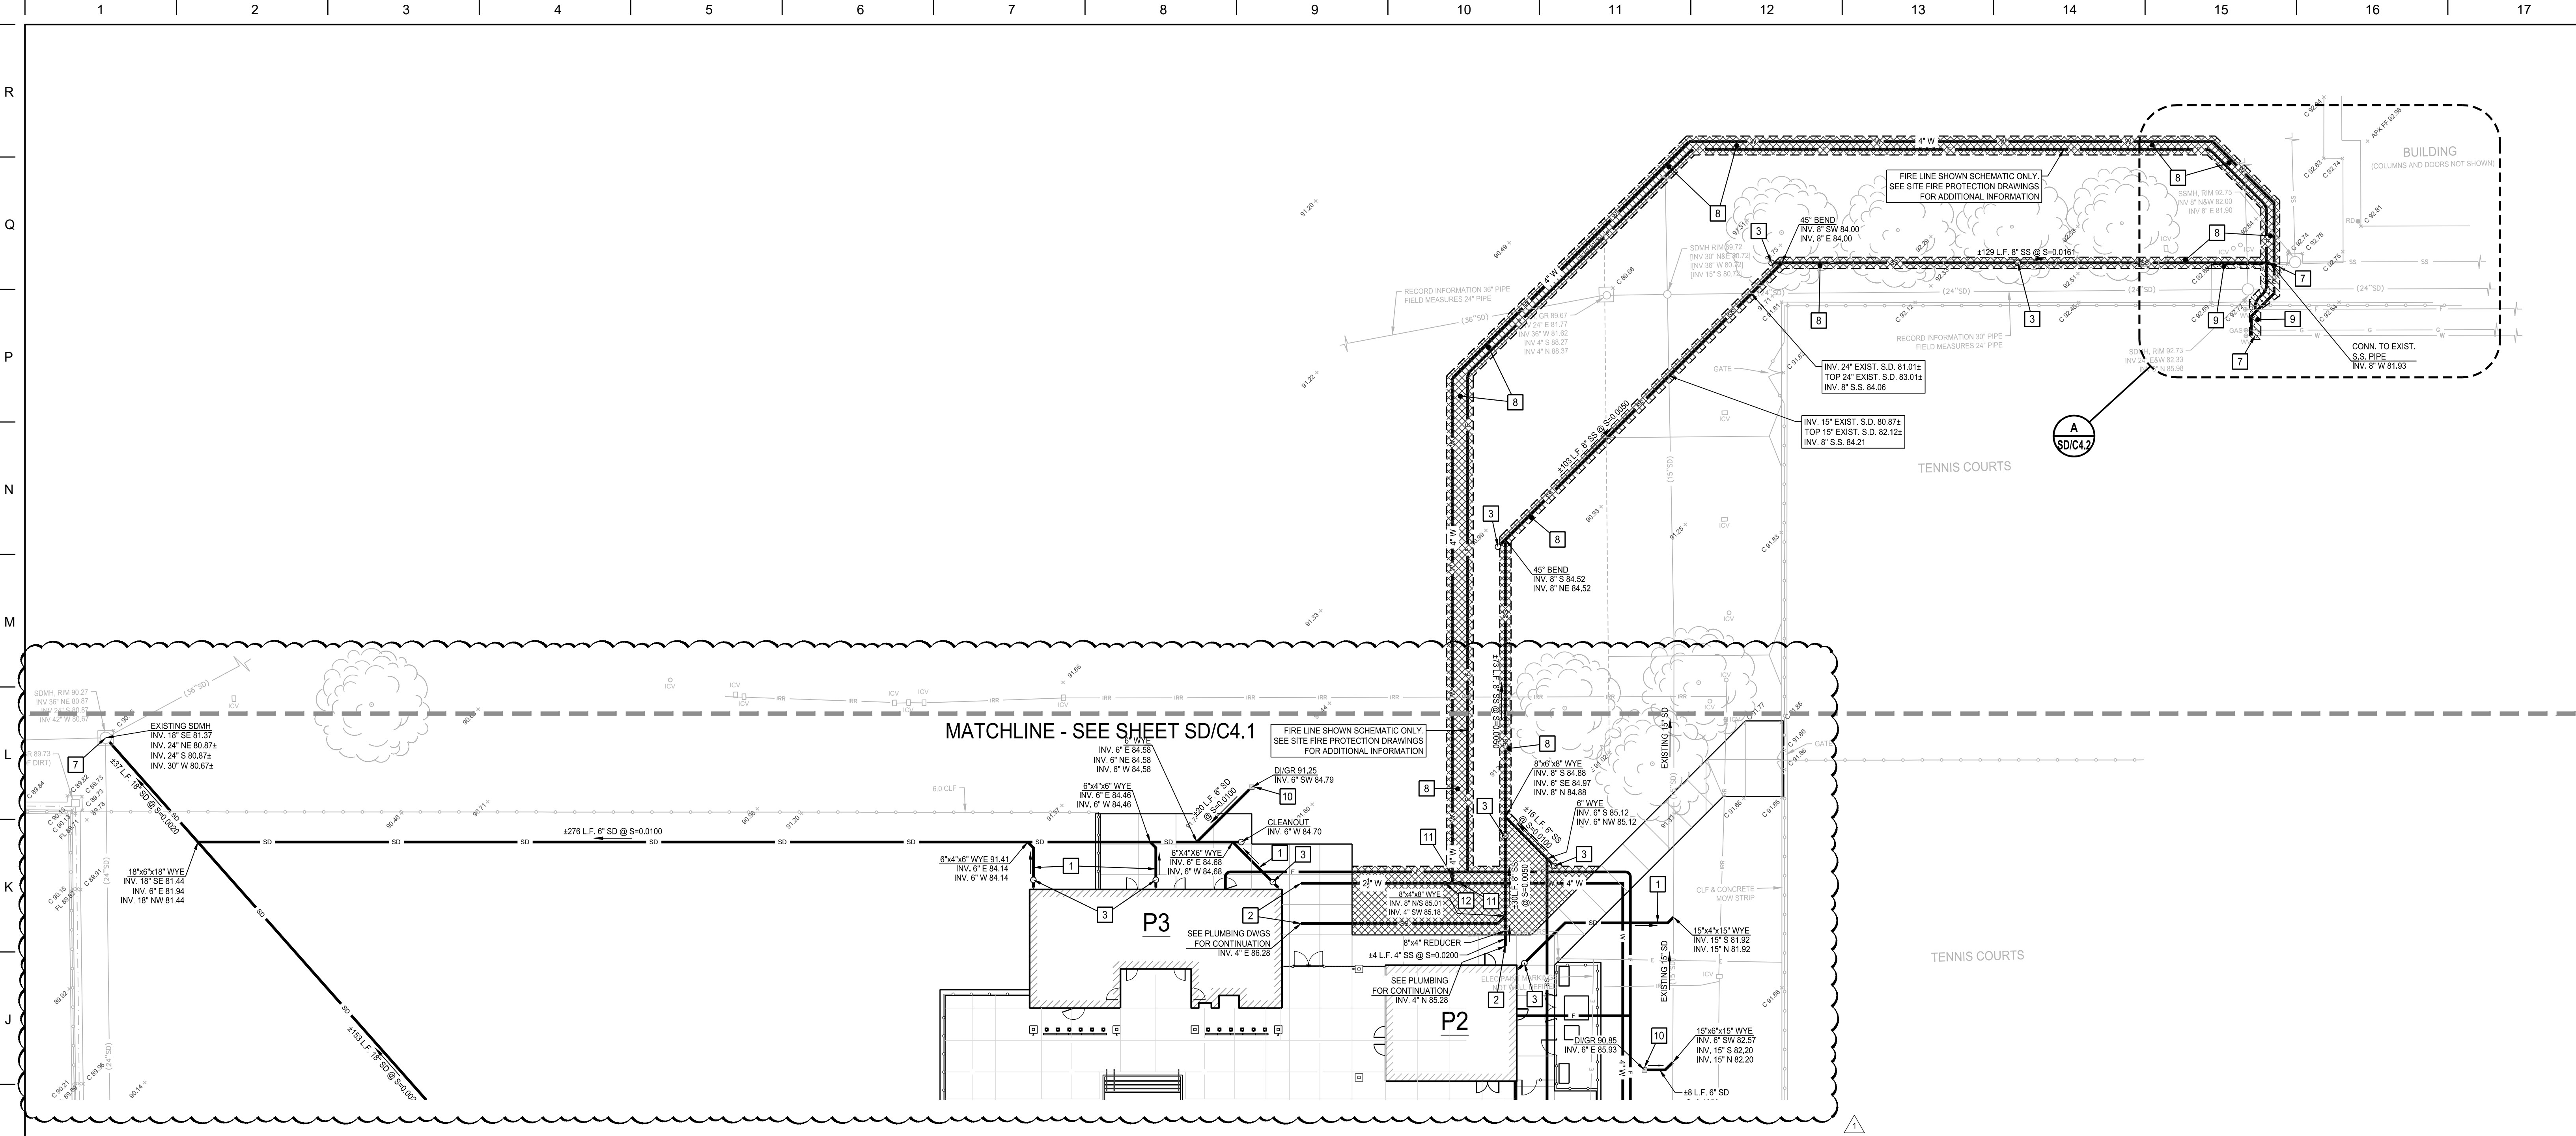


DSA File No.: 54-H11
 DSA Application No.: 02-120251
 Agency Approval

- NOTES**
- REFER TO SHEETS SD/C4.1 FOR BENCHMARKS, GENERAL NOTES & INFORMATION.
 - SEE ARCHITECTURAL DWGS. FOR ADDITIONAL SITE INFORMATION AND DETAILS. SEE PLUMBING DRAWINGS FOR ADDITIONAL WET UTILITY PIPING.
 - ALL STORM DRAIN PIPING AND LATERALS SHALL HAVE A MINIMUM OF 3% OF COVER.
 - ALL TRENCHES ON SITE SHALL BE BACKFILLED IN ACCORDANCE WITH DETAIL 14 SHEET SD/C7.1. PROVIDE NEW TURF SURFACE WHERE EXISTING HAS BEEN REMOVED DUE TO NEW PIPE TRENCHING. SEE LANDSCAPING SPECIFICATIONS FOR TURF REQUIREMENTS.
 - ANY EXISTING IRRIGATION SYSTEMS THAT ARE DAMAGED OR REMOVED DUE TO NEW UTILITY PIPE INSTALLATION SHALL BE REPAIRED AS REQUIRED.
 - DUE TO THE SCALE OF THE DRAWINGS, IT IS NOT POSSIBLE TO INDICATE ALL OFFSETS, PIPE SLOPES, FITTINGS, ETC., WHICH MAY BE REQUIRED. IT SHALL BE THE RESPONSIBILITY OF THE CONTRACTOR TO REVIEW THESE DRAWINGS AND FURNISH ALL FITTINGS, ETC. NECESSARY TO COMPLETE A FULLY FUNCTIONAL PIPING SYSTEM AND AVOID ANY CONFLICTS WITH OTHER UTILITIES.


- LEGEND**
- RIGHT OF WAY/PROPERTY LINE
 - NEW STORM DRAIN PIPING
 - NEW SANITARY SEWER PIPING
 - NEW WATER PIPING
 - NEW FIRE PIPING (SEE FIRE PROTECTION DRAWINGS)

- CONSTRUCTION KEYNOTES** (SHEETS C4.1 & C4.2)
- 4" STORM DRAIN LATERAL TO ROOF DOWNSPOUTS. ALL LATERALS SHALL HAVE A MIN. SLOPE OF 2.0% UN.D. SEE ARCHITECTURAL DRAWINGS FOR STORM DRAIN TO ROOF DOWNSPOUT CONNECTIONS. CONTRACTOR SHALL VERIFY LOCATION OF ROOF DOWNSPOUTS WITH ARCHITECTURAL DRAWINGS.
 - POC - SEE PLUMBING/AQUATICS DRAWINGS FOR CONNECTION/CONTINUATION.
 - CONSTRUCT SURFACE CLEAN OUT (COTO) - SEE DETAIL 21 SHEET SD/C7.1.
 - CONSTRUCT AREA DRAIN - SEE DETAIL 32 SHEET SD/C7.1.
 - CONSTRUCT STORM DRAIN MANHOLE WITH SOLID LID COVER - SEE DETAILS 13, 22 & 24 SHEET SD/C4.1.
 - NEW FIRE HYDRANT - SEE SITE FIRE PROTECTION DRAWINGS FOR ADDITIONAL INFORMATION.
 - CONNECT TO EXISTING. CONTRACTOR TO VERIFY LOCATION AND DEPTHS OF EXISTING UTILITIES AT POINT OF CONNECTION PRIOR TO NEW INSTALLATION. TYP. NOTIFY ARCHITECT OF RECORD OF ANY DISCREPANCIES.
 - TRENCH BACKFILL & REPAIR LANDSCAPING ALONG NEW PIPE. RESTORE TURF WITH NEW TURF TIE-WAY SOO, AND BLEND INTO THE EXISTING TURF FOR A SEAMLESS TRANSITION.
APPROX. REPAIR AREA SHOWN THIS: [Hatched Pattern]
 - TRENCH BACKFILL & REPAIR CONCRETE WALK ALONG NEW PIPE.
APPROX. REPAIR AREA SHOWN THIS: [Hatched Pattern]
 - CONSTRUCT DRAIN INLET WITH CAST IRON GRATE - SEE DETAIL 14 SHEET SD/C7.1.
 - FURNISH & INSTALL 4" DOMESTIC WATER GATE VALVE.
 - FURNISH & INSTALL 2" DOMESTIC WATER GATE VALVE.

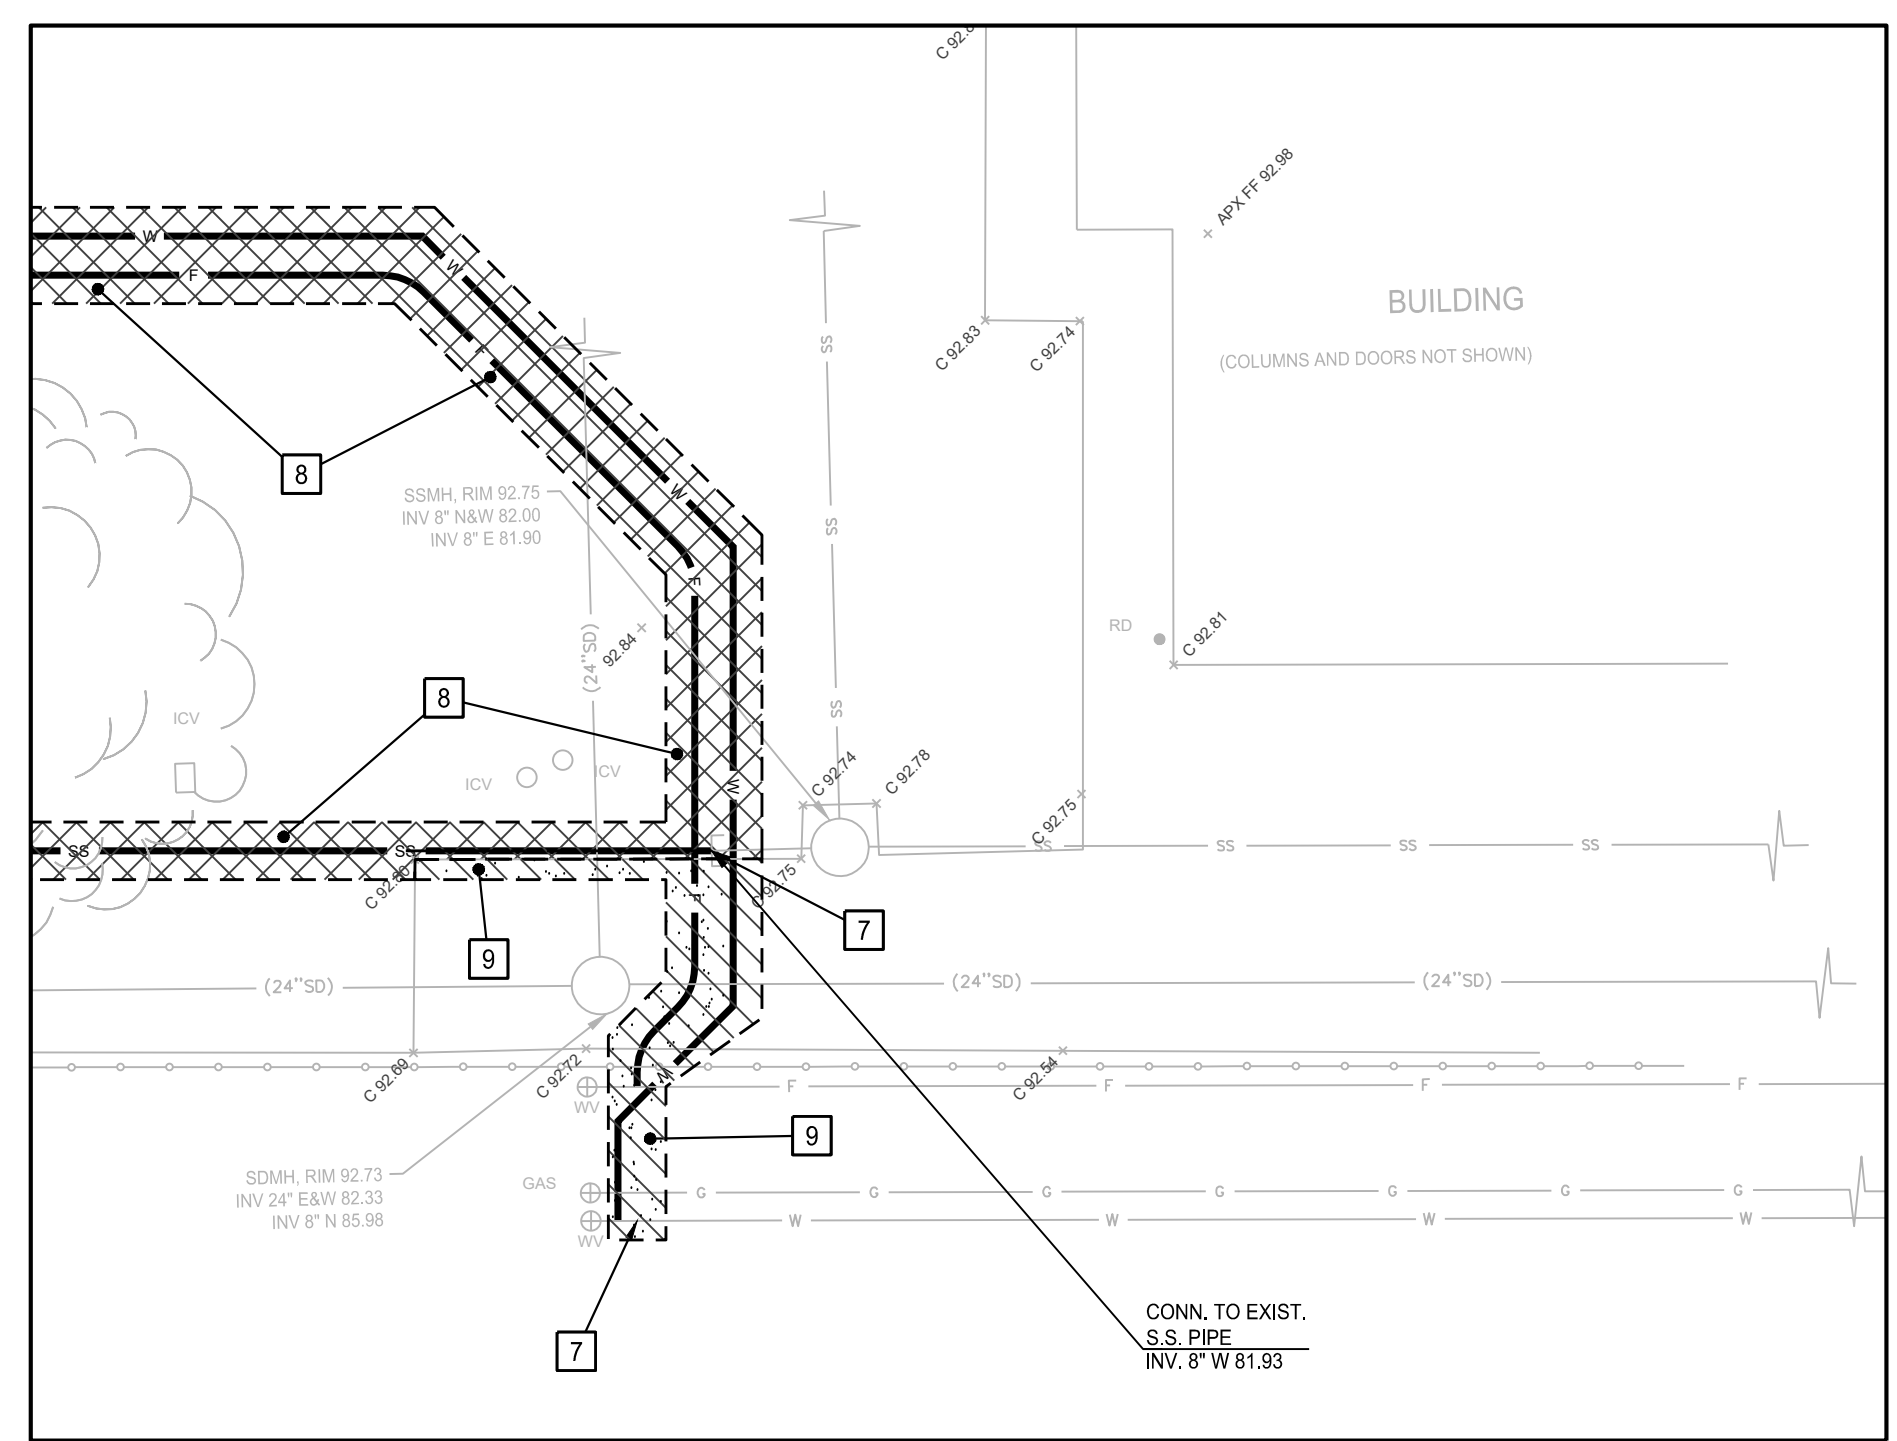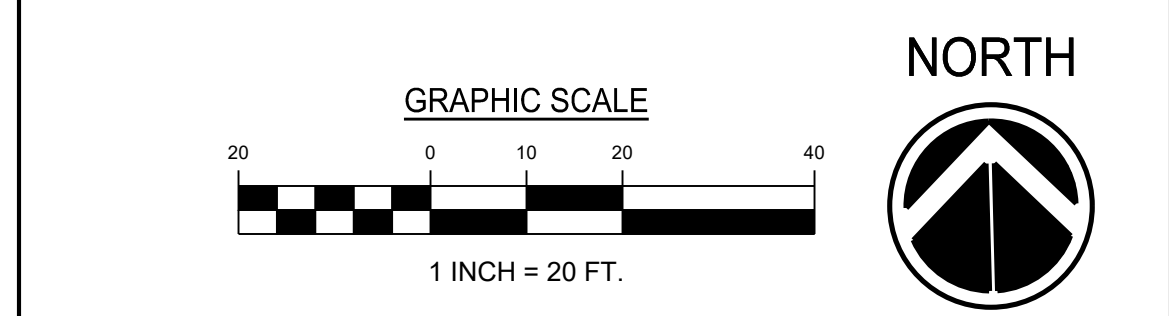

(A) ENLARGED WET PIPING DETAIL
 SCALE: 1"=10'
 NORTH


LANE ENGINEERS INC.
 CIVIL & STRUCTURAL ENGINEERING
 979 N. BLACKSTONE
 TULARE, CALIFORNIA 93274
 (559) 688-9283
 Consultant

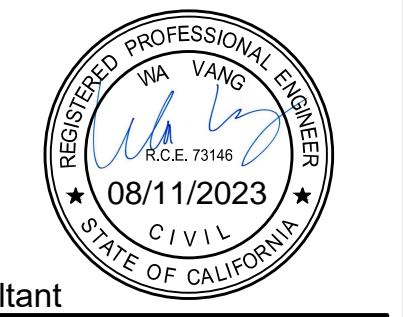

Mission Oak HS Aquatic Complex
 Tulare Joint Union High School District
 Tulare, CA
 Project































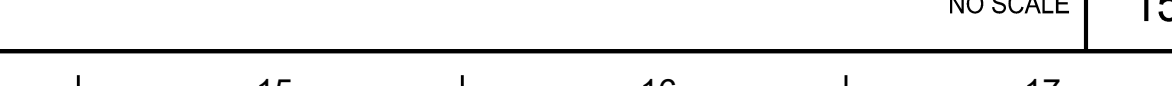
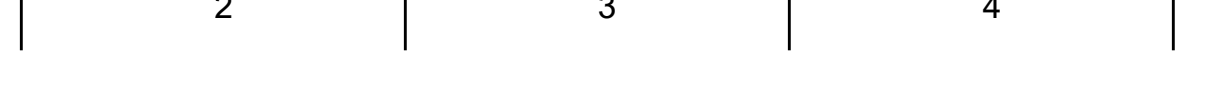

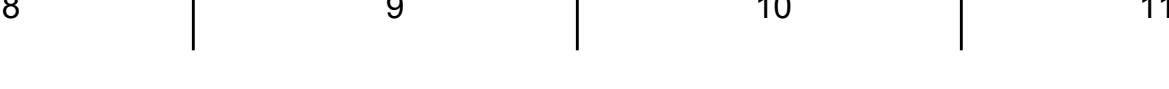




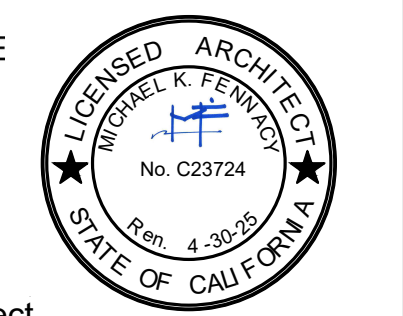


SITE DEVELOPMENT
 ALTERNATE BID - WET PIPING PLAN
 Drawing




darden architects ARCHITECTURE PLANNING INTERIORS
 www.dardenarchitects.com
 6790 N. West Ave. • Fresno, CA 93711 • T. 559.448.8051
 Architect

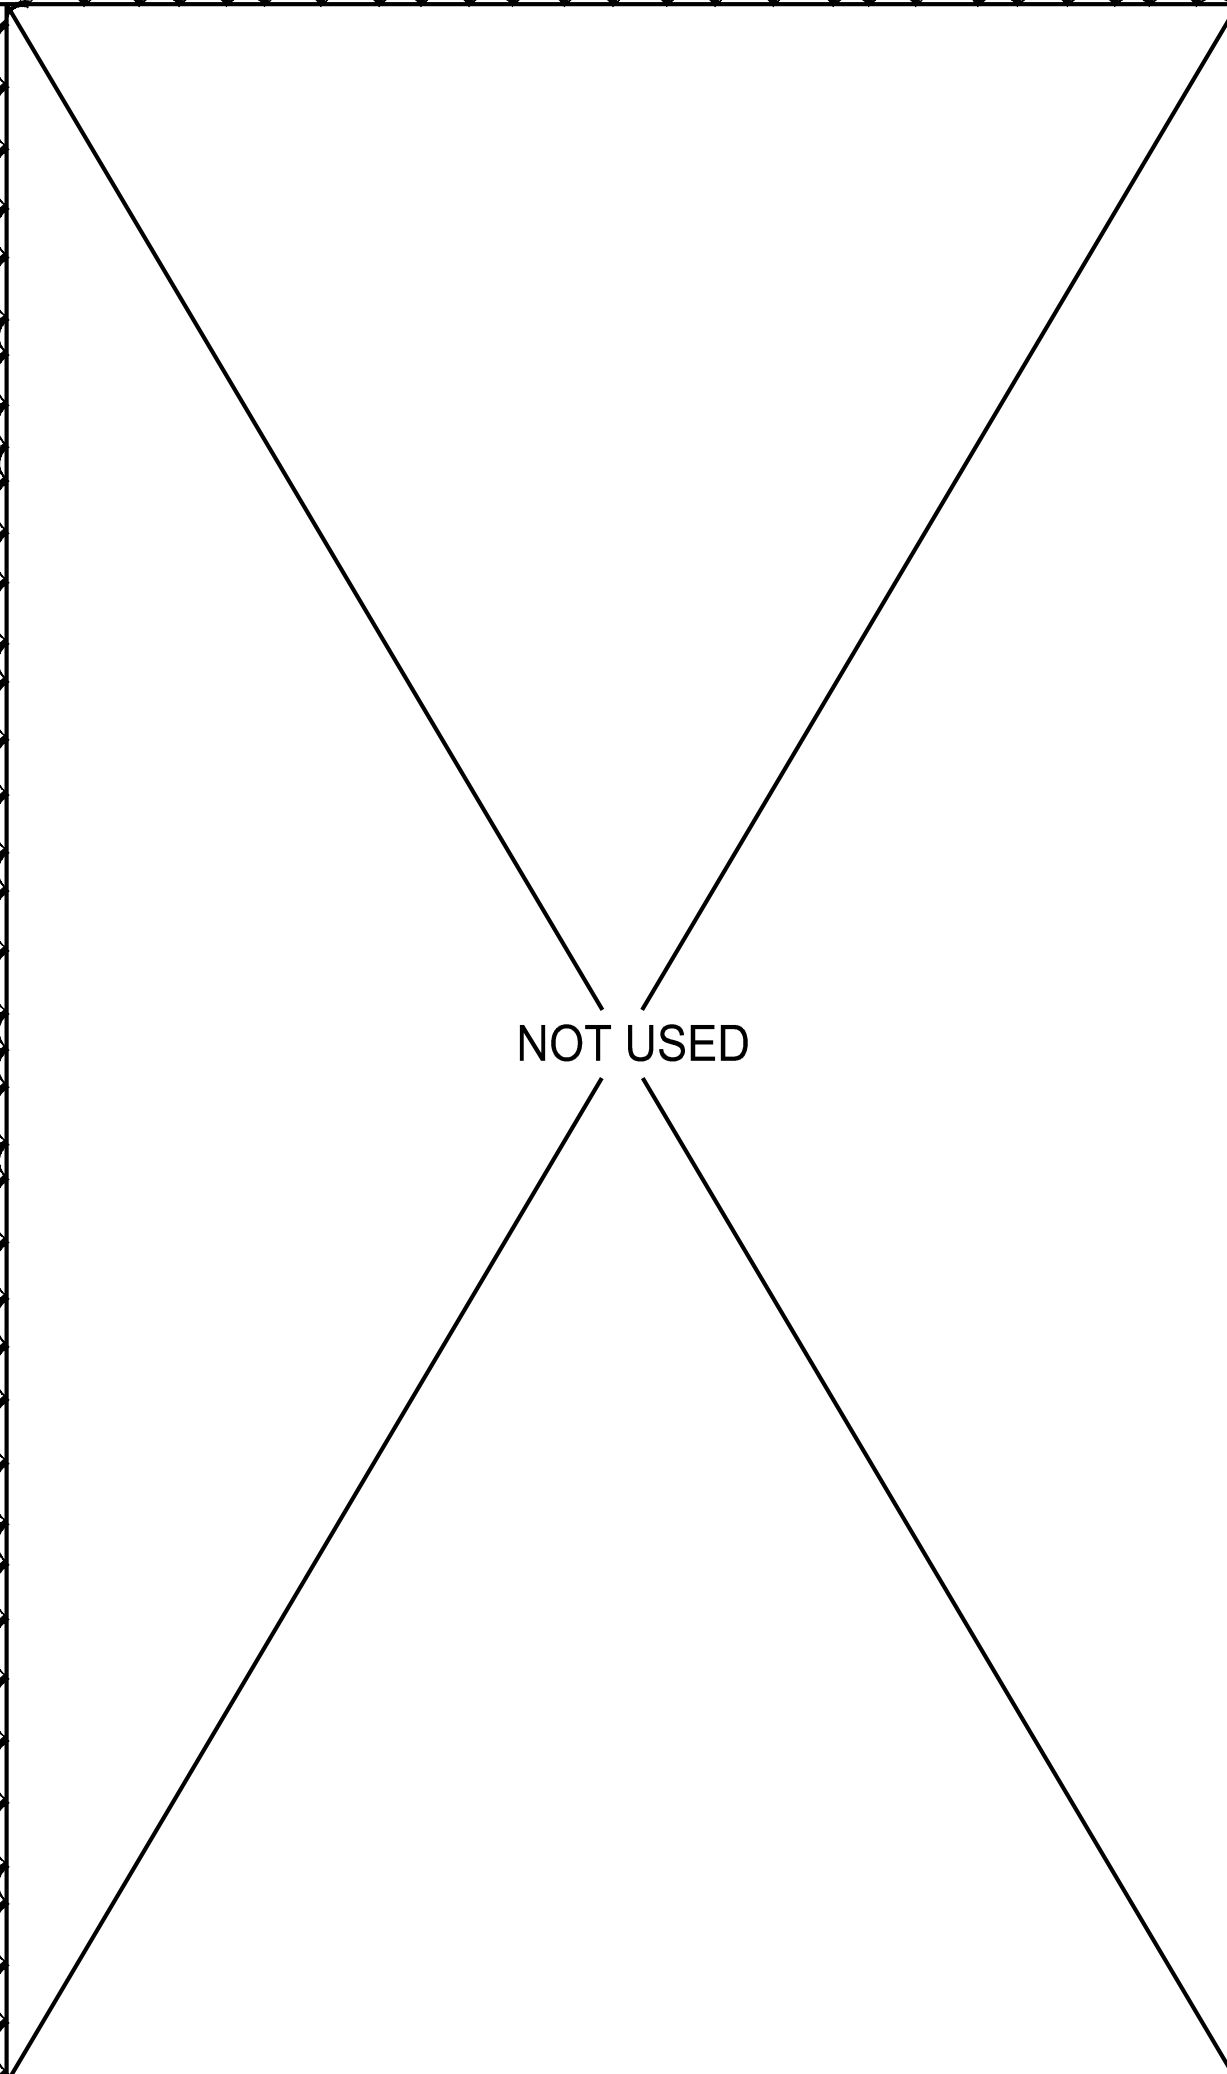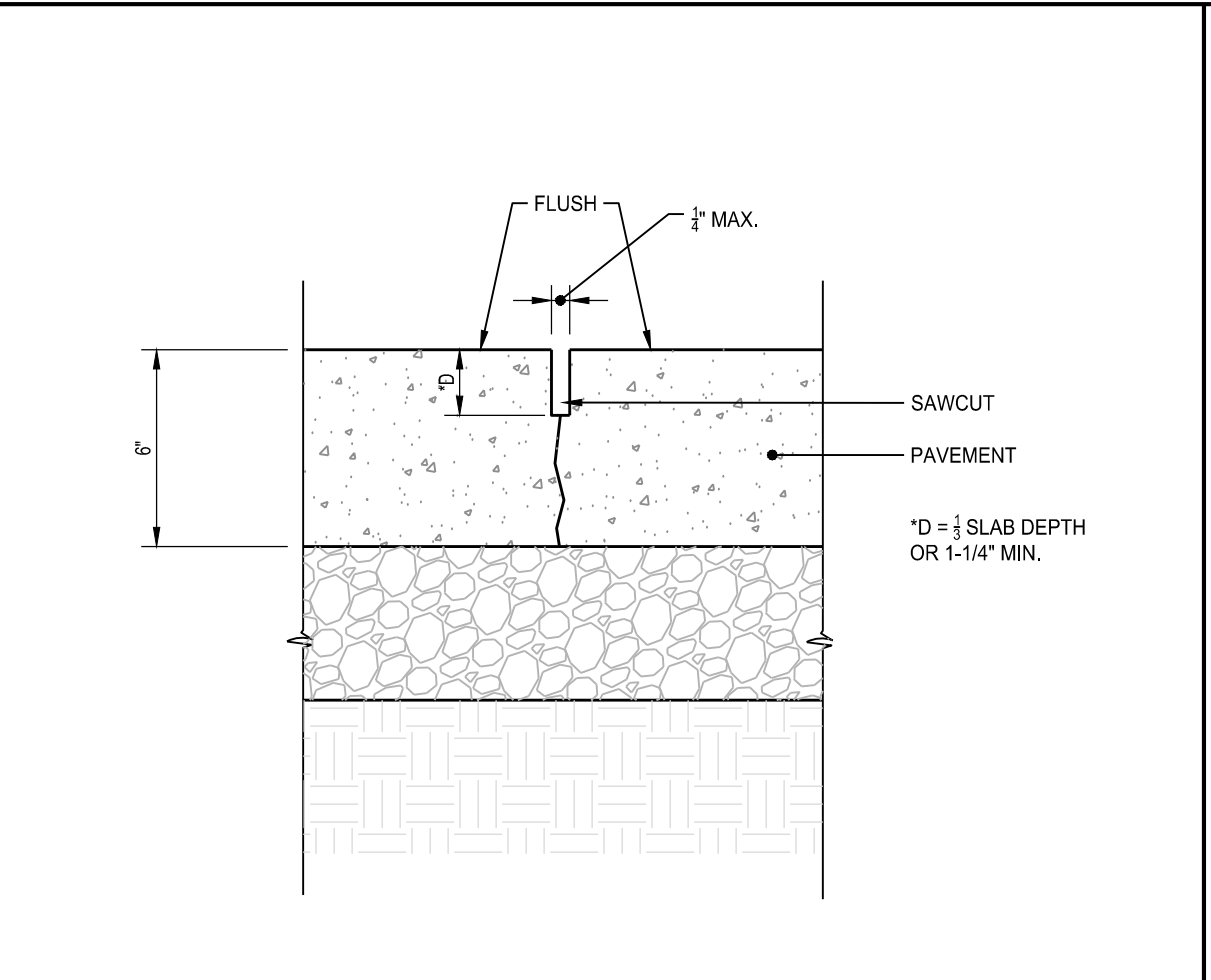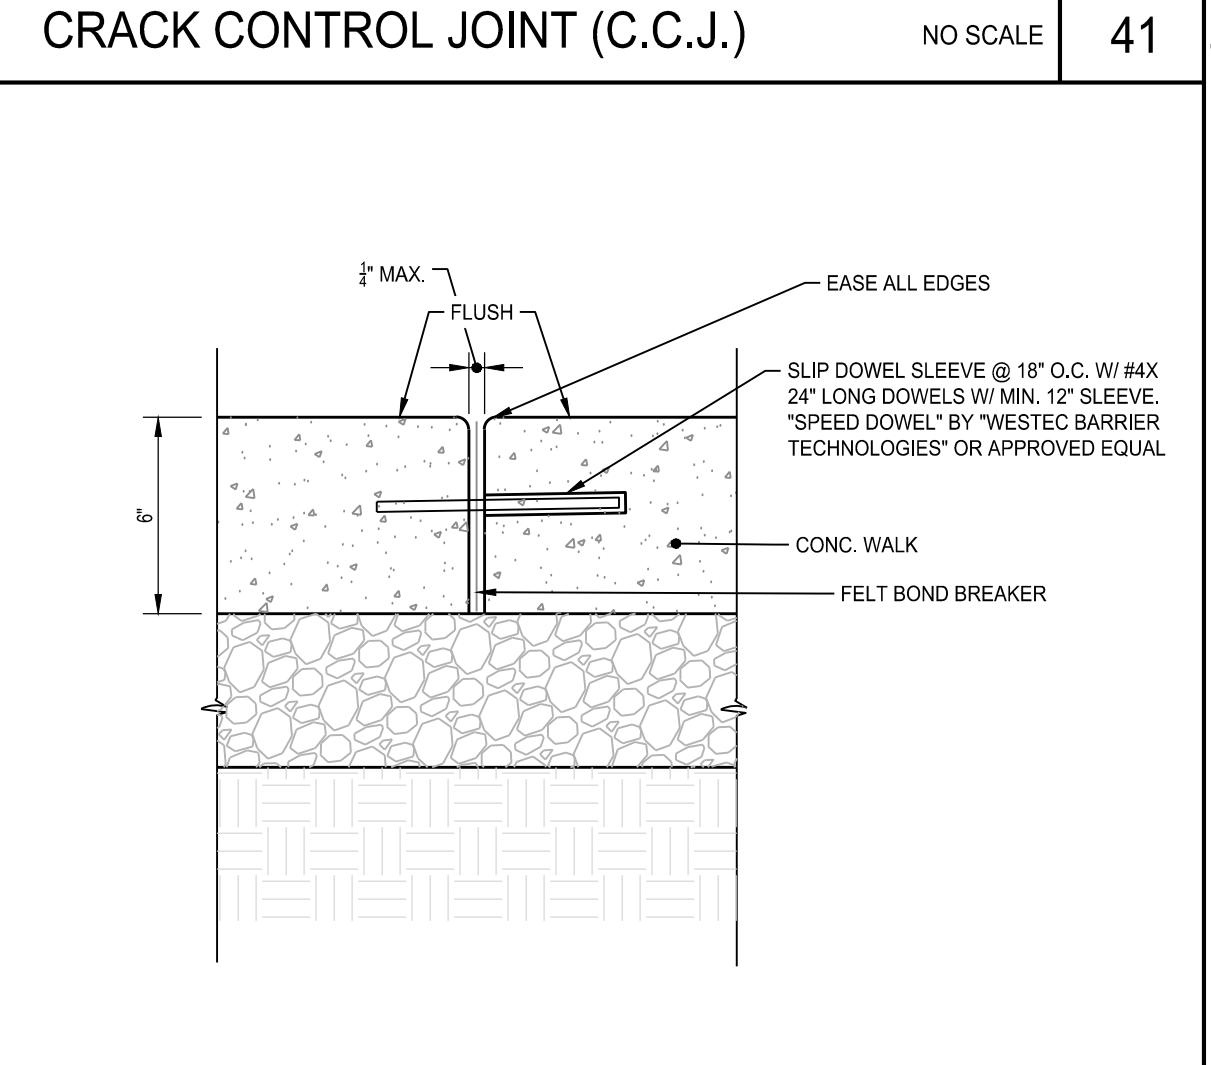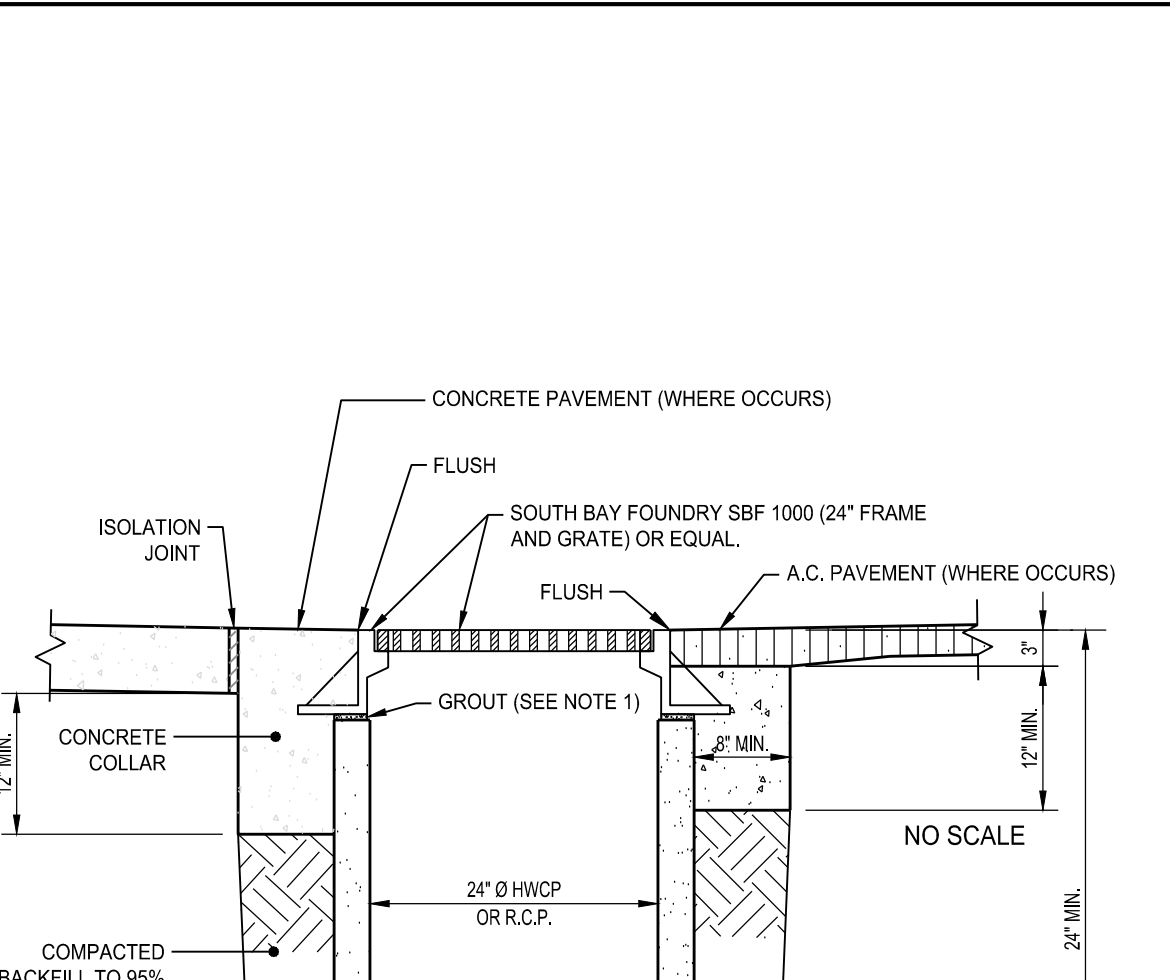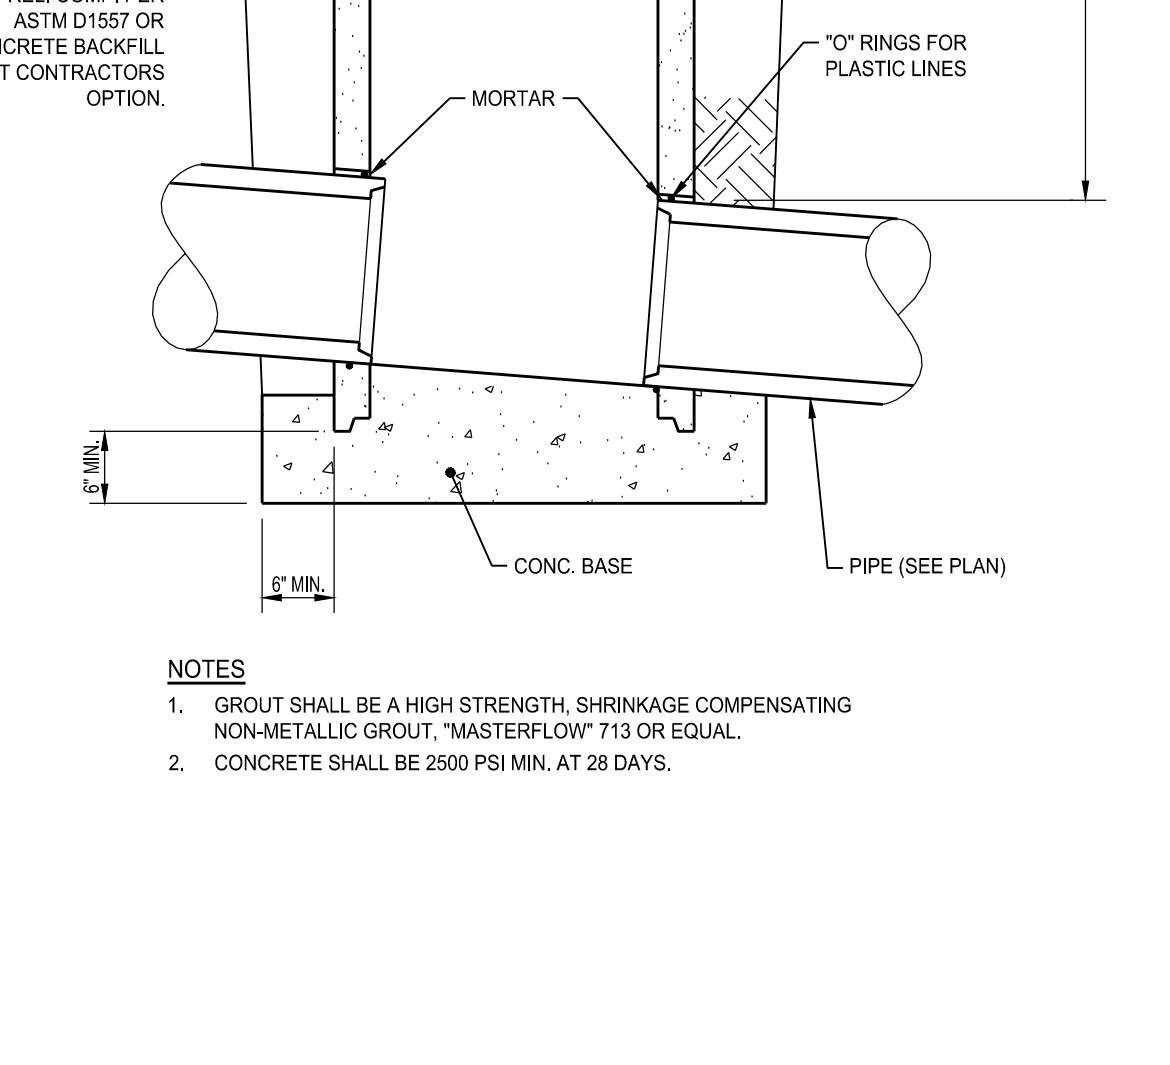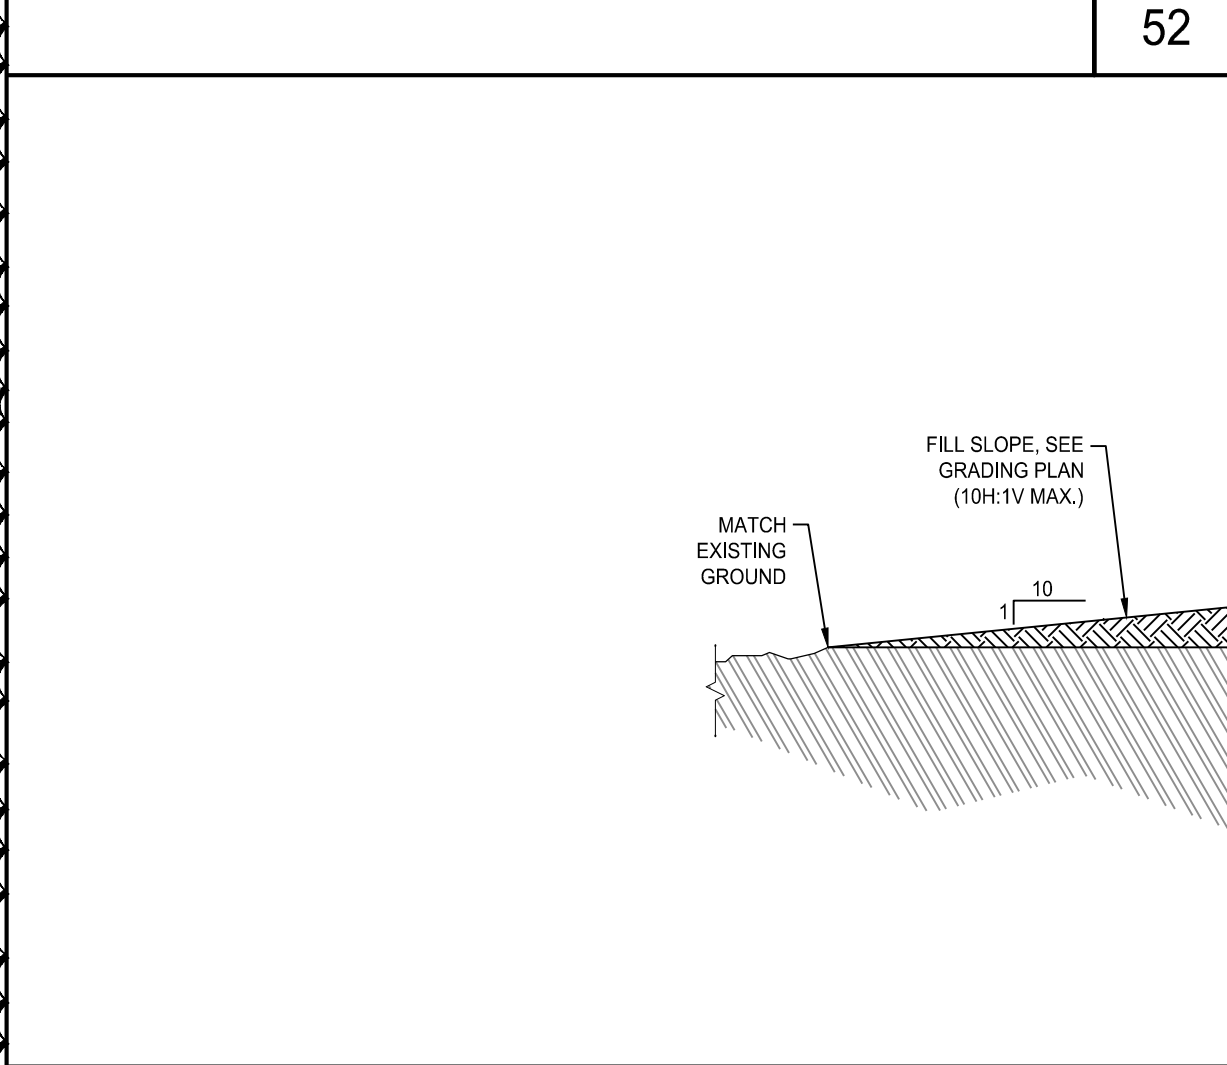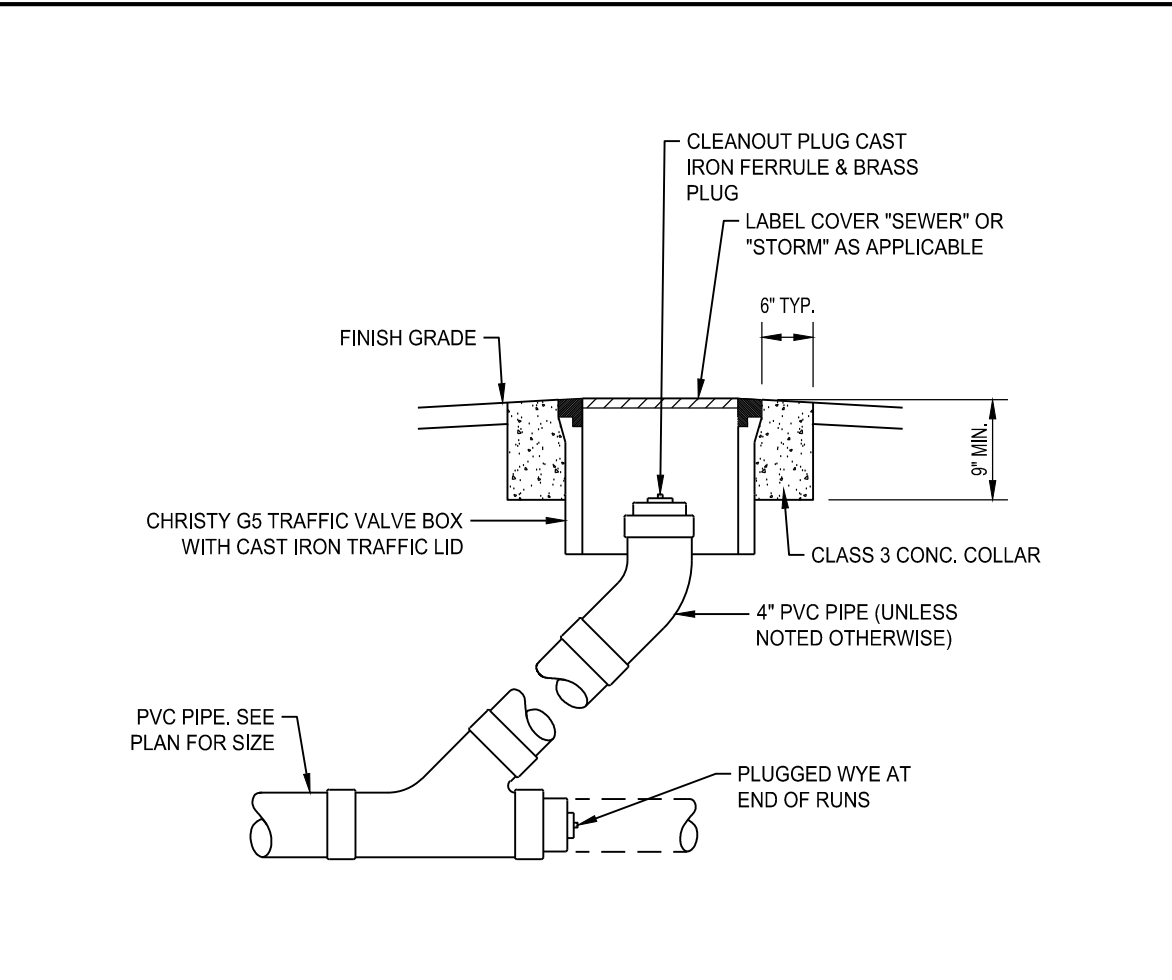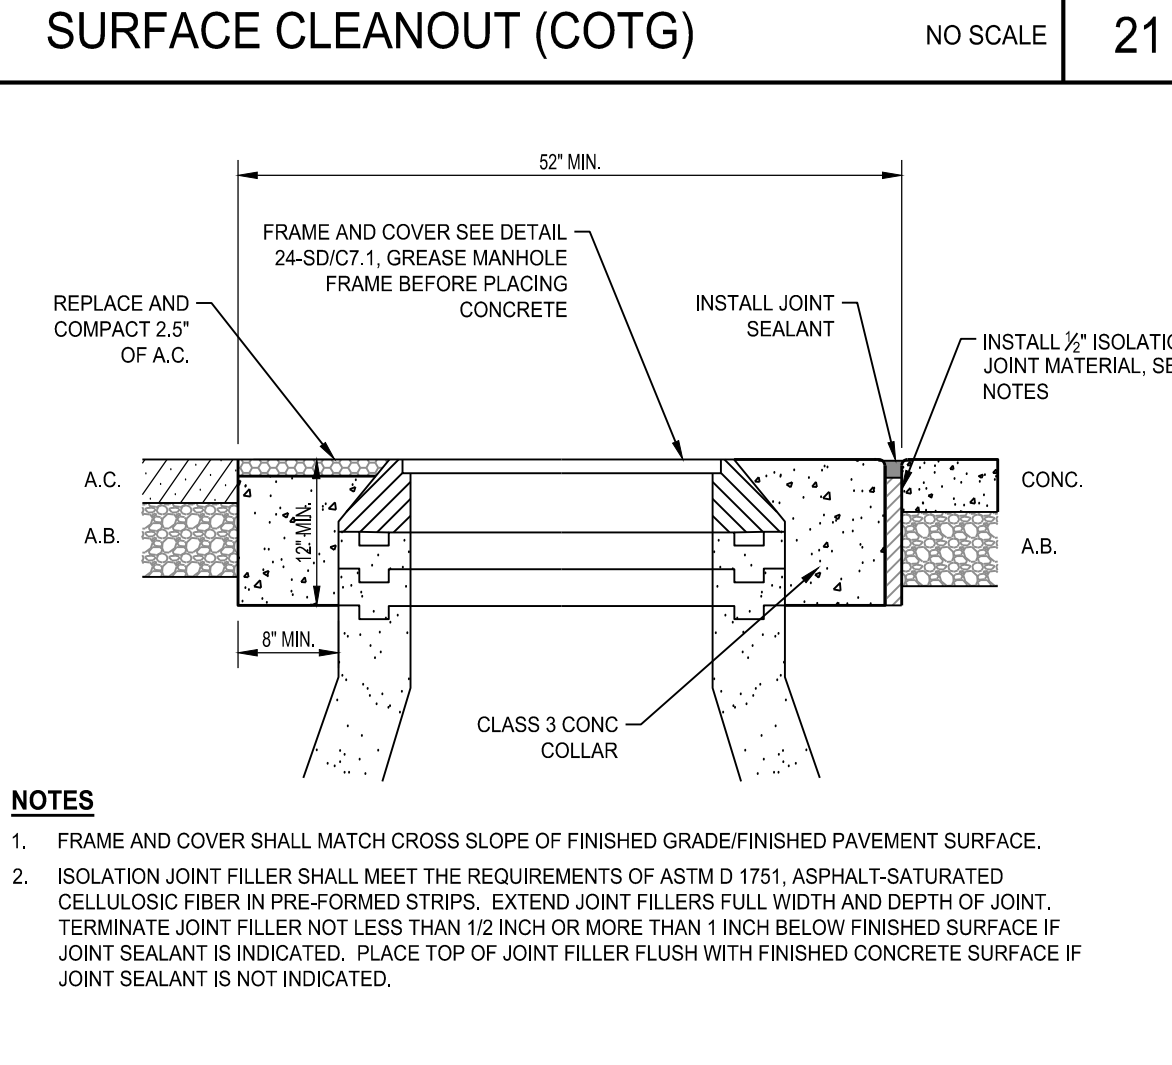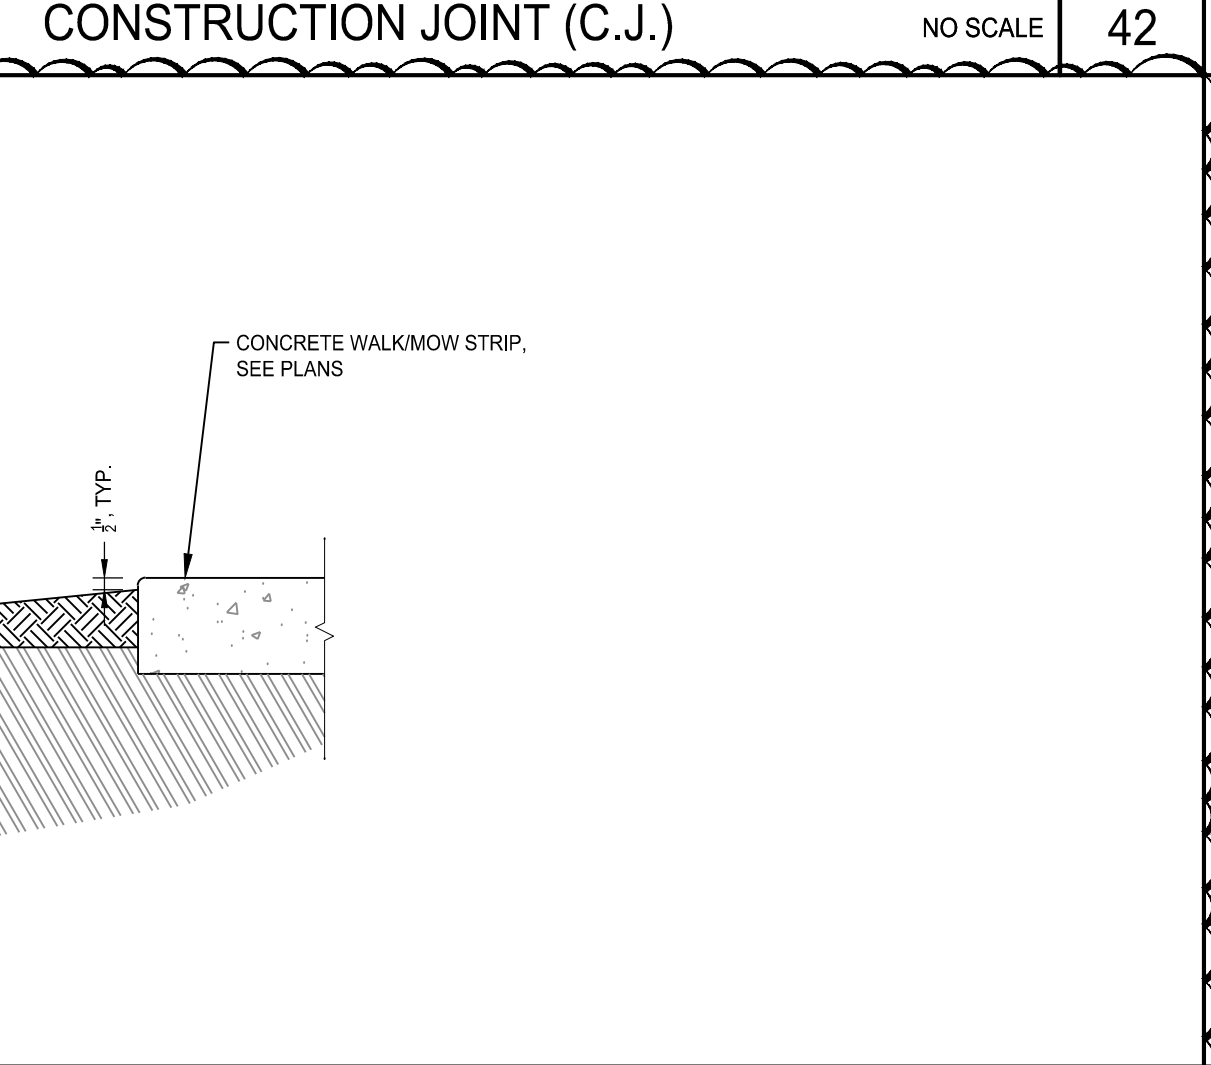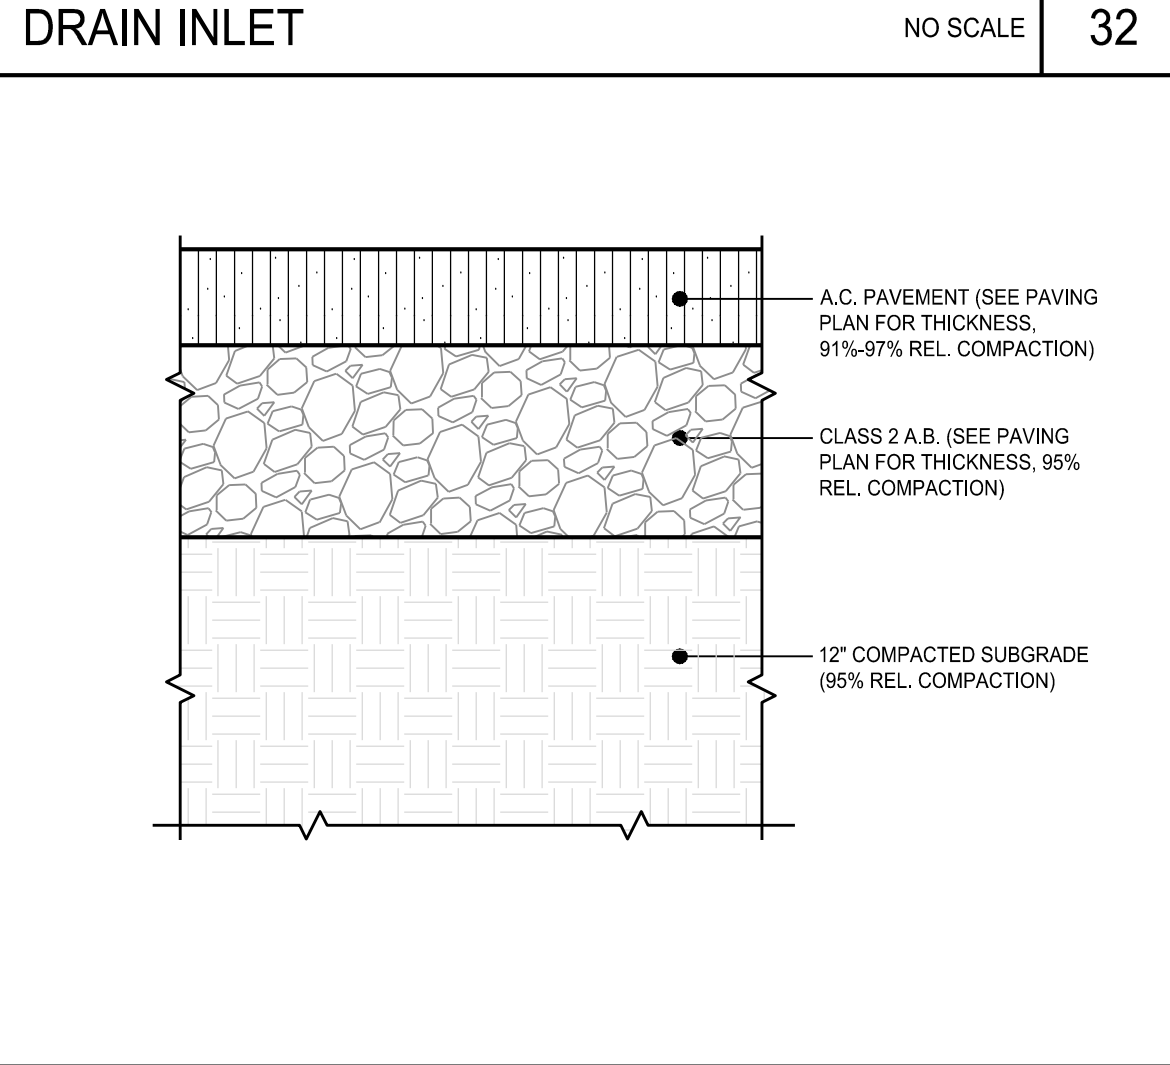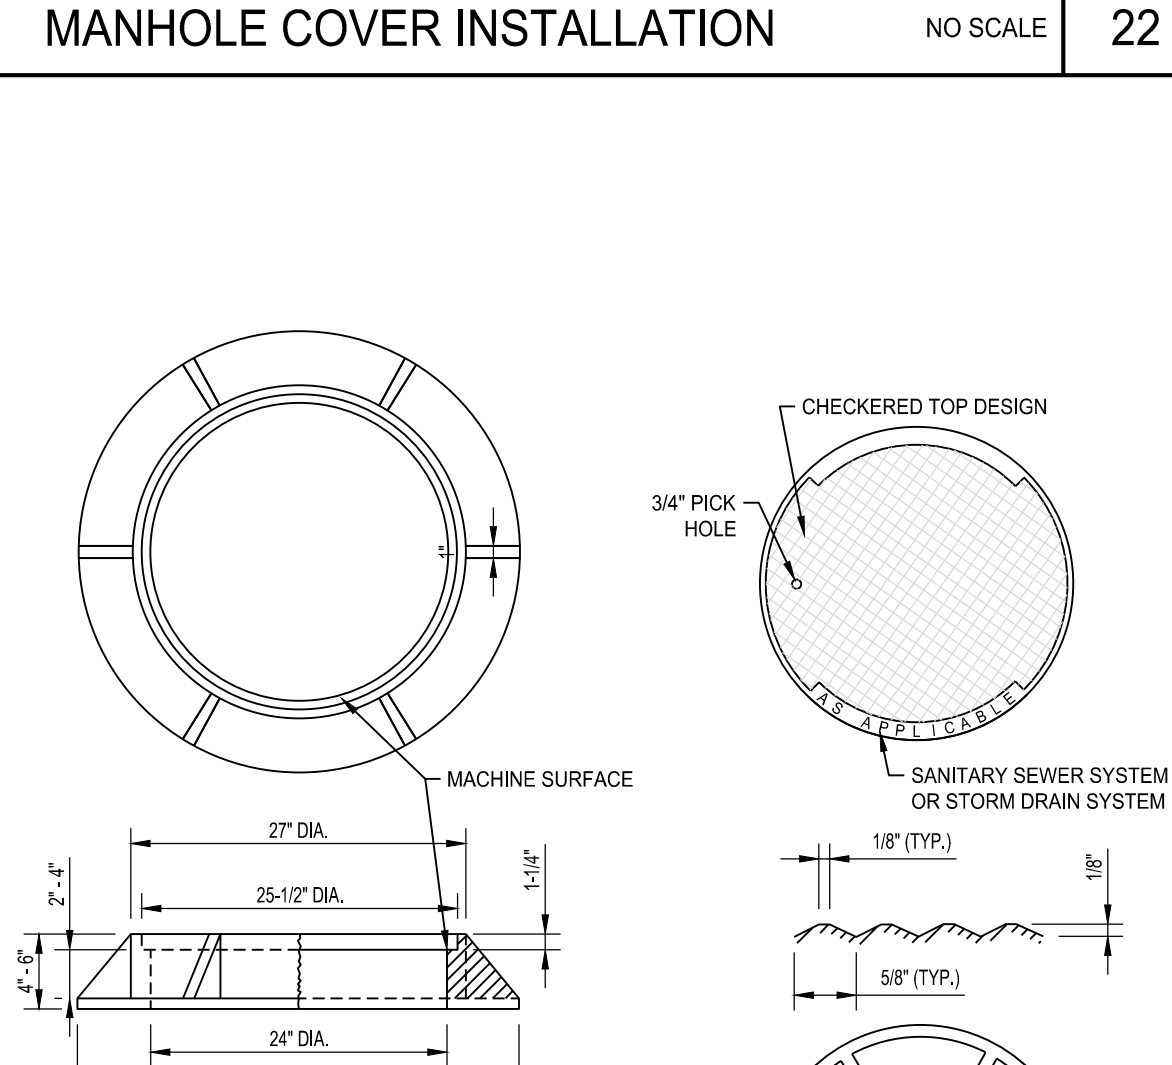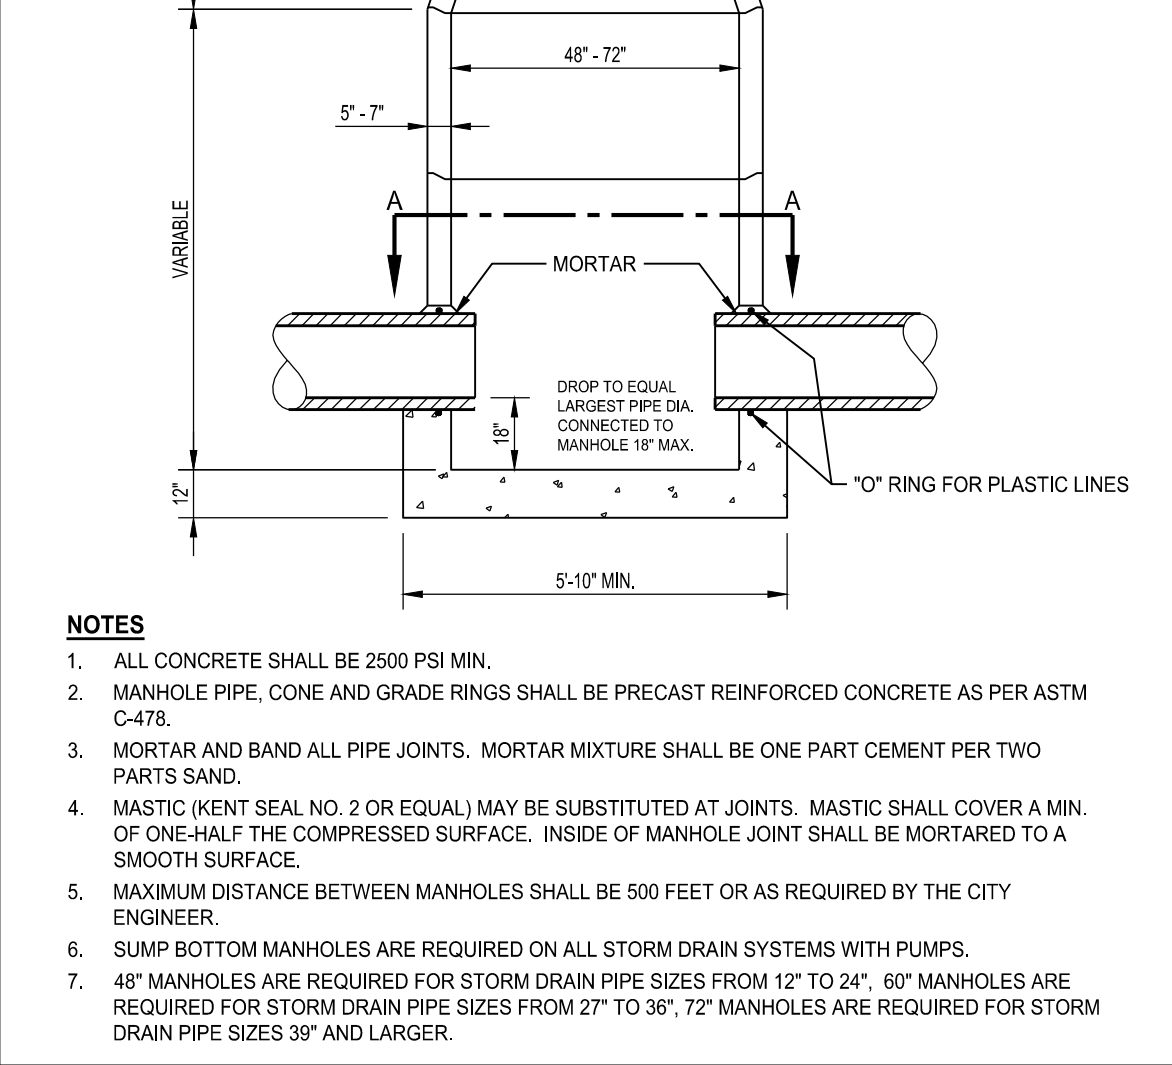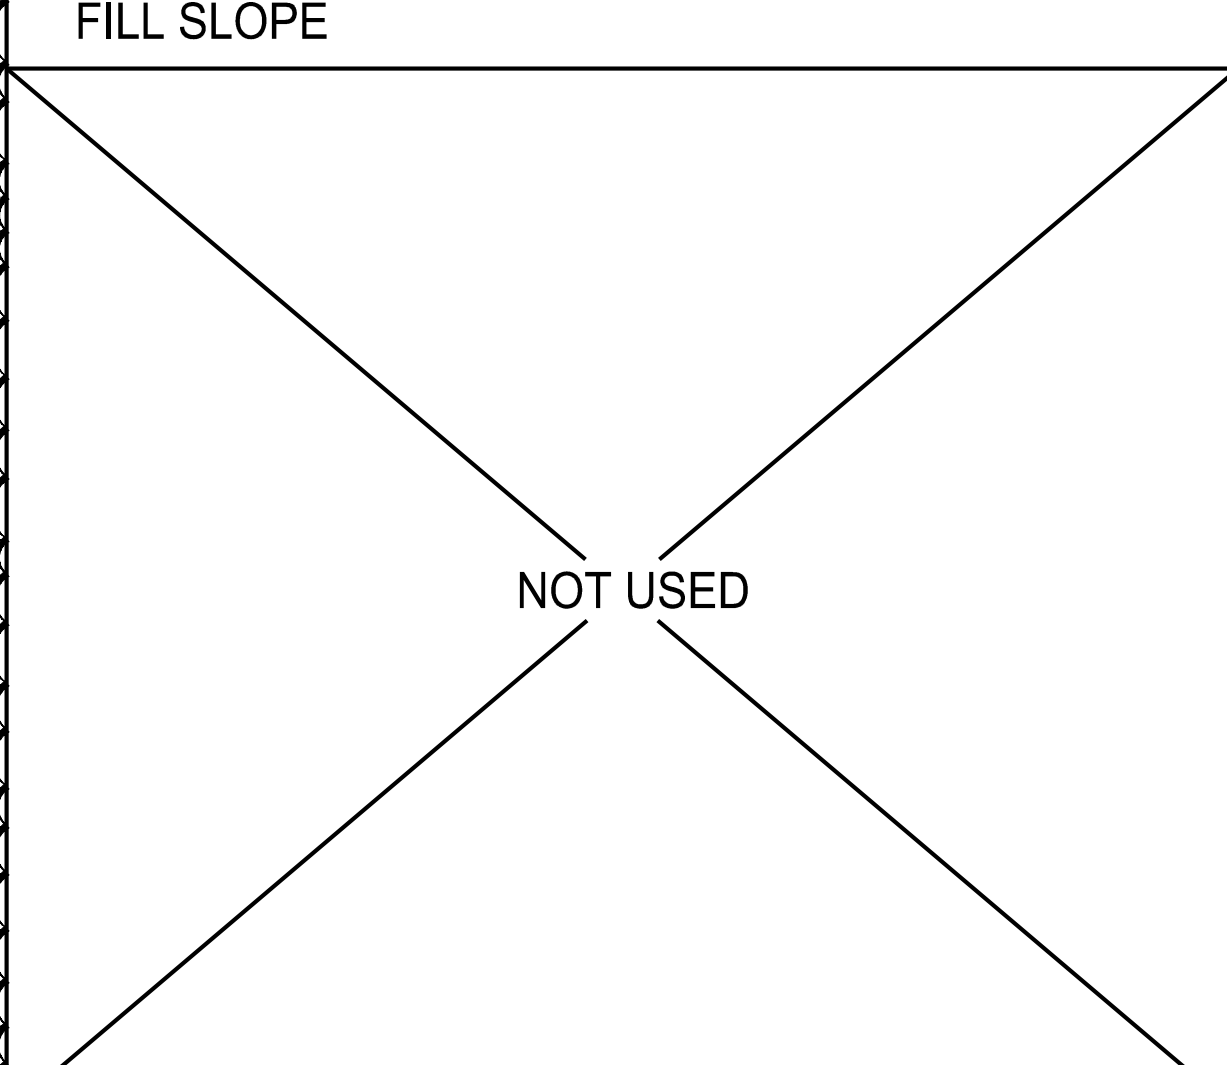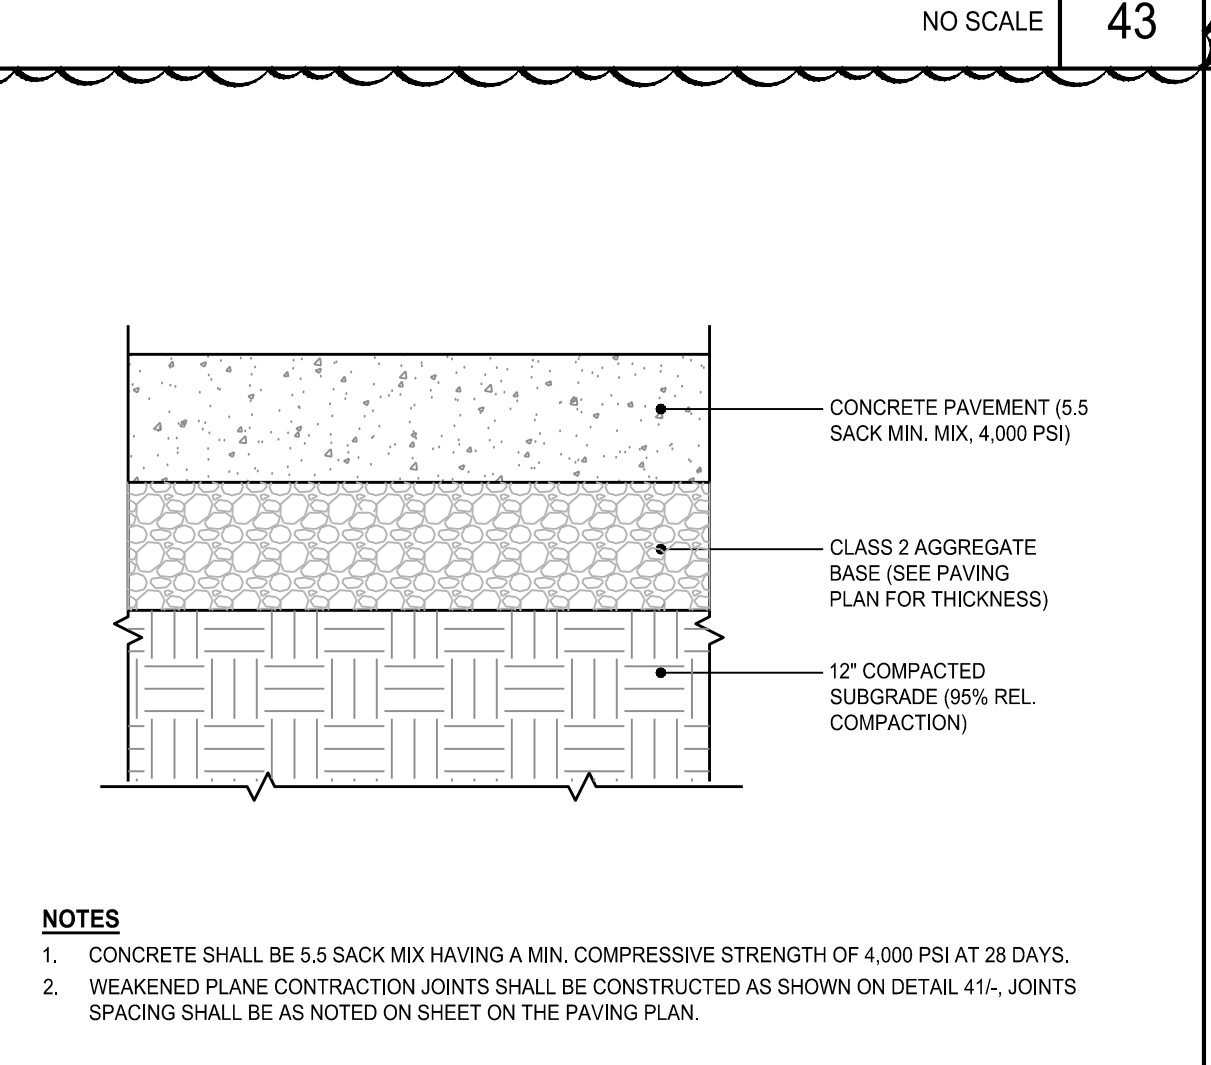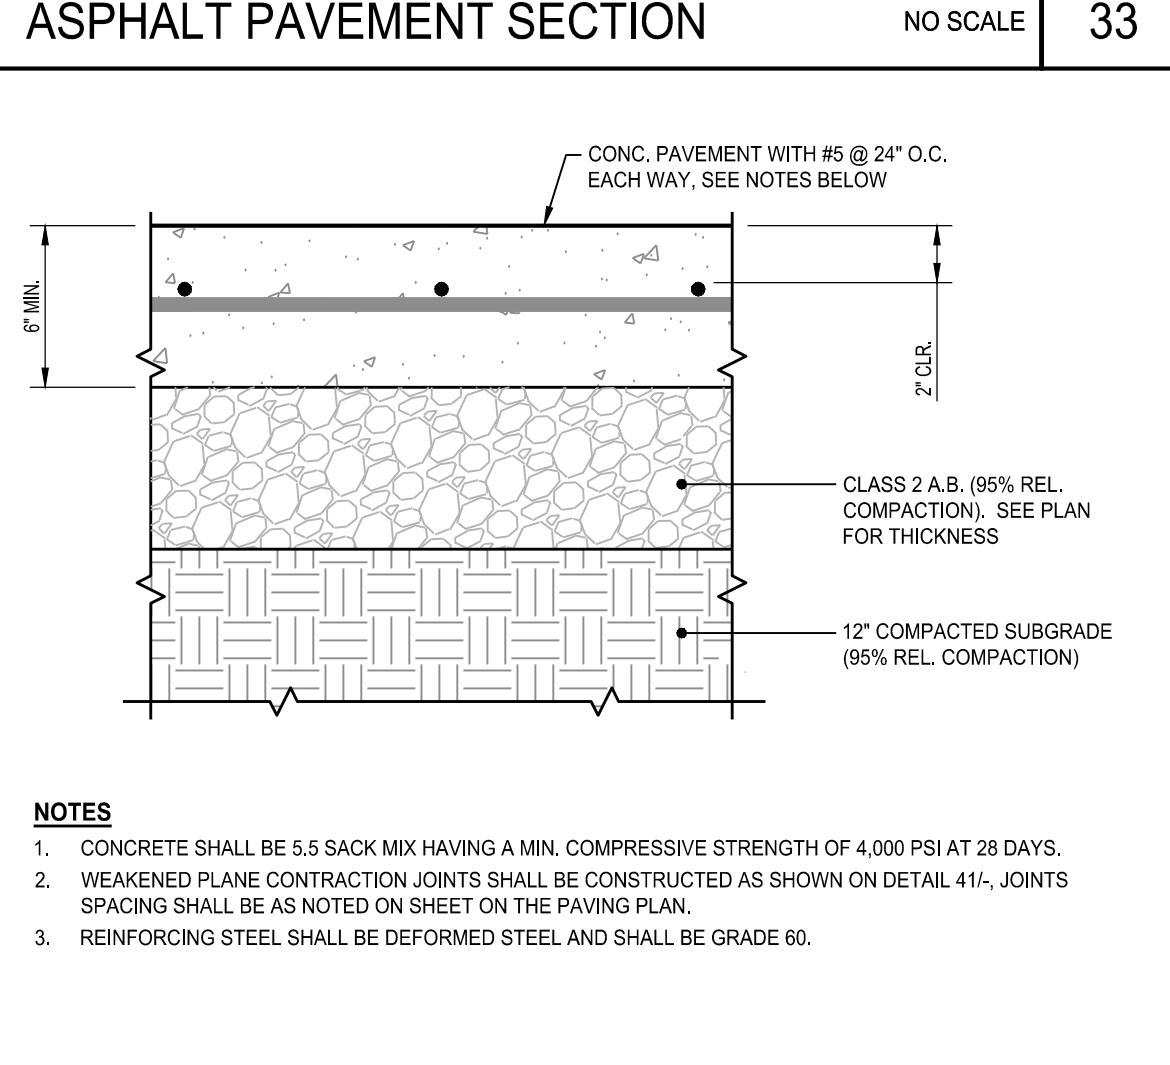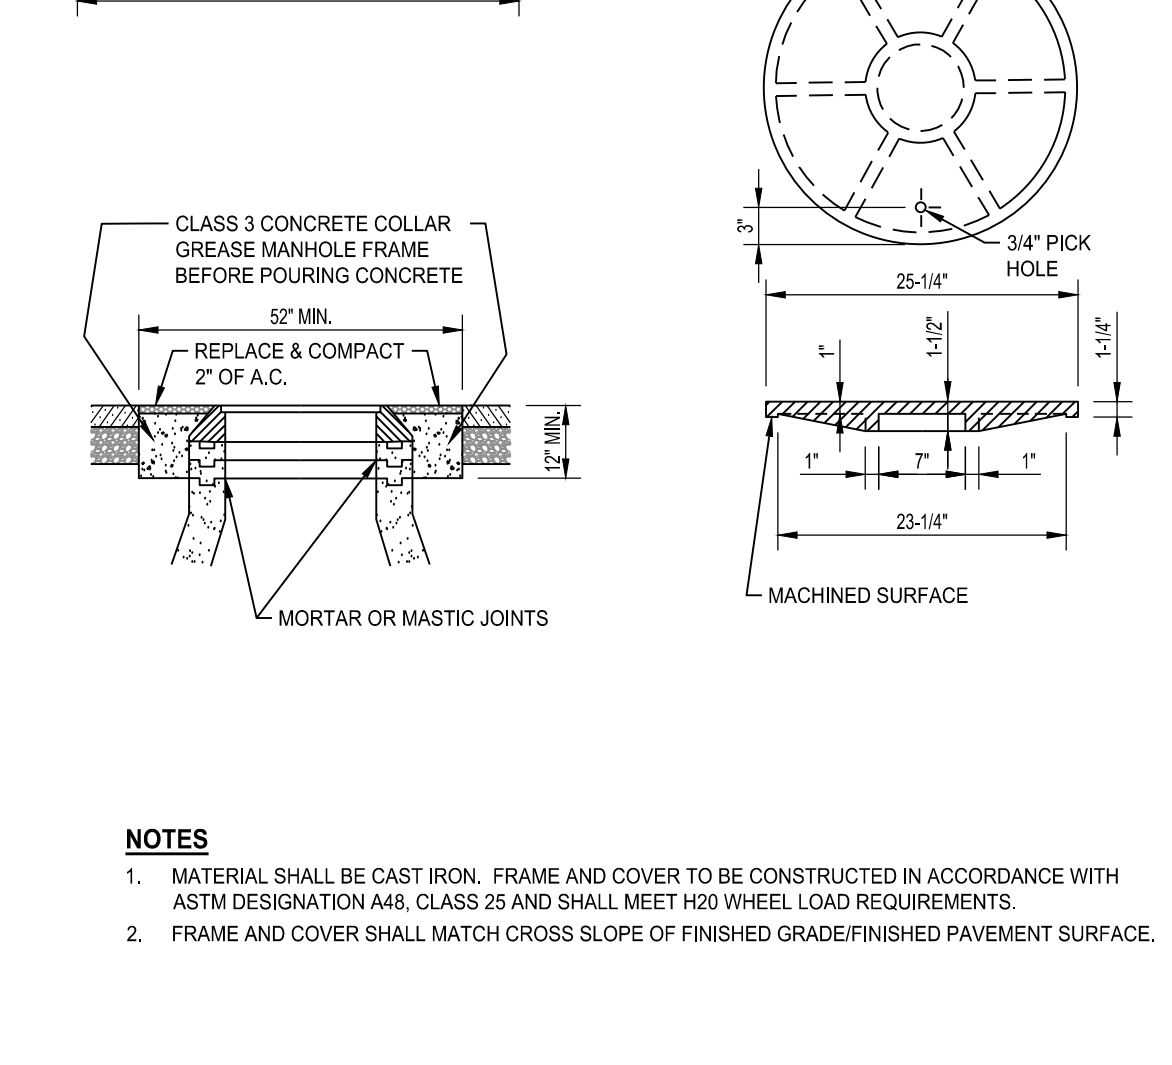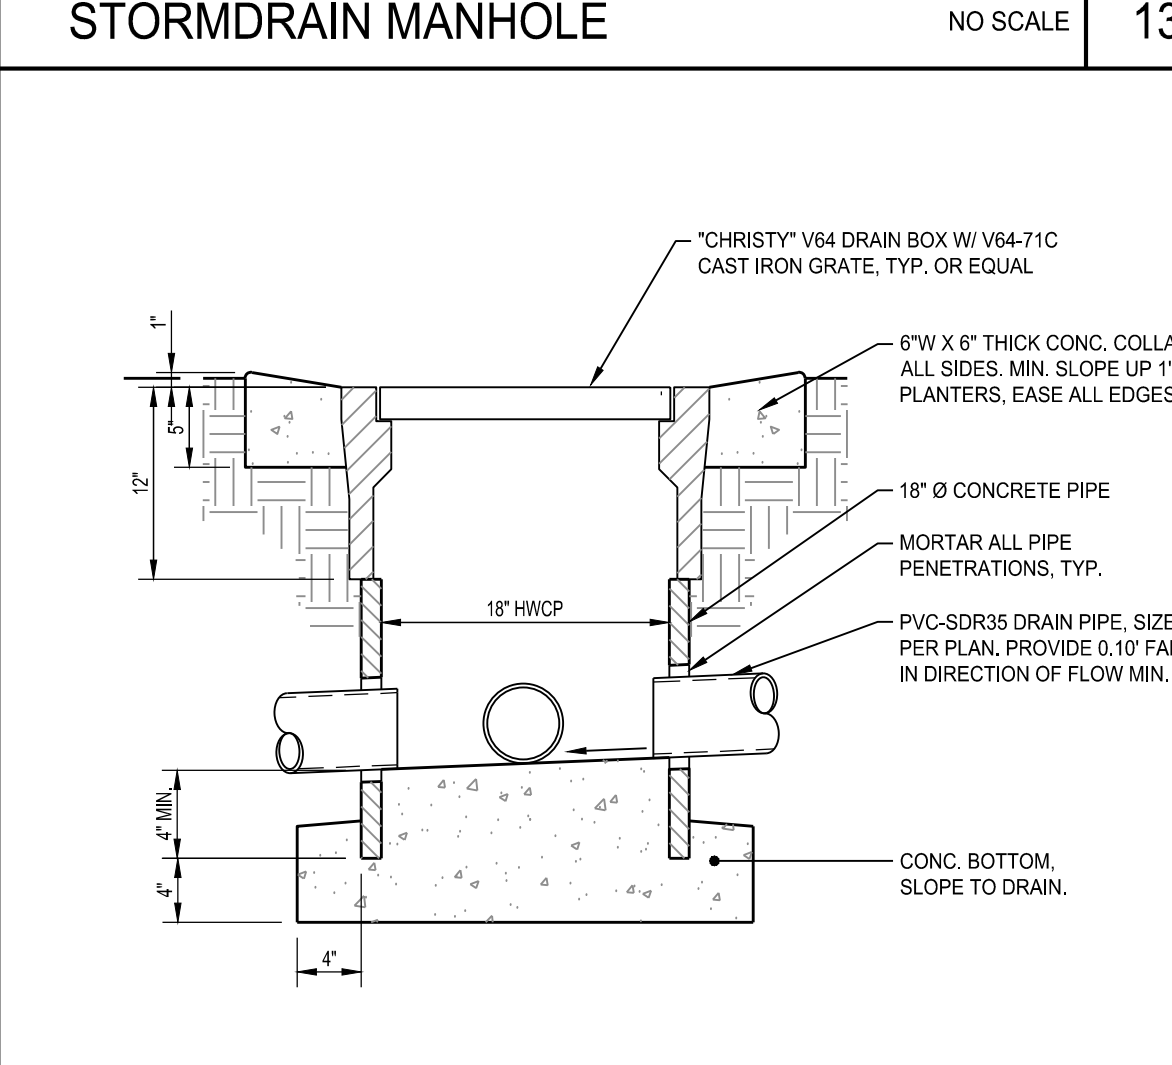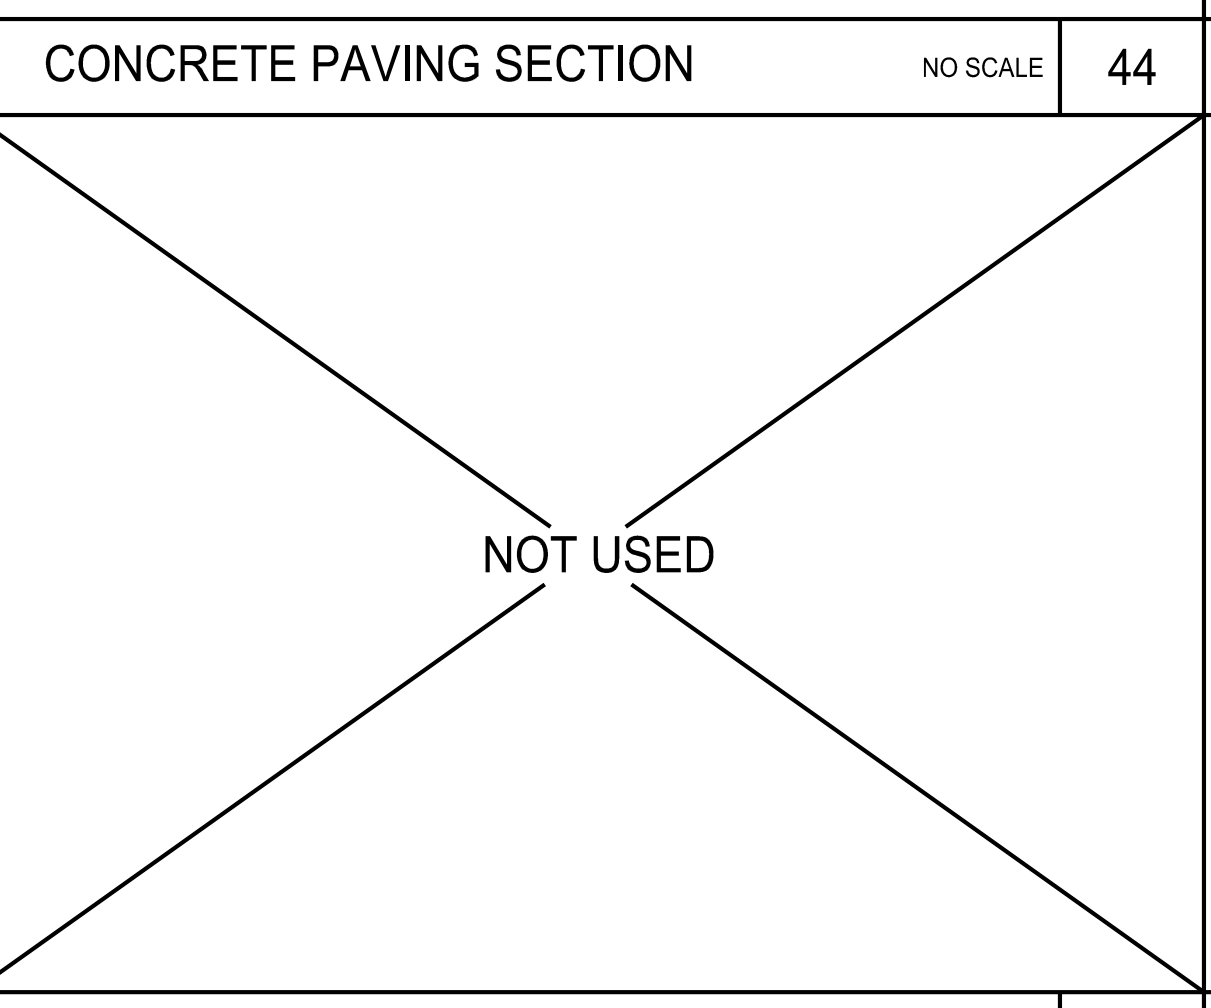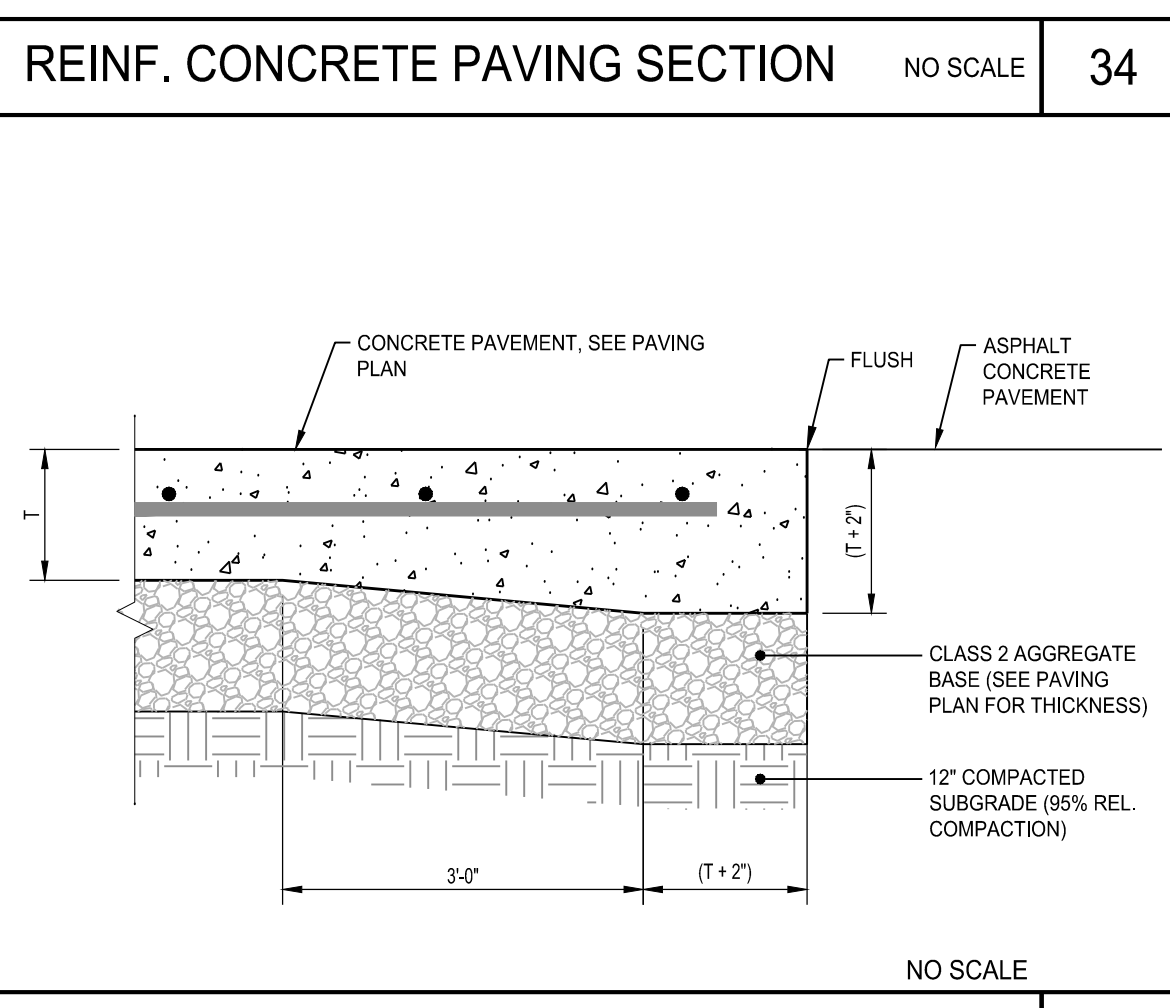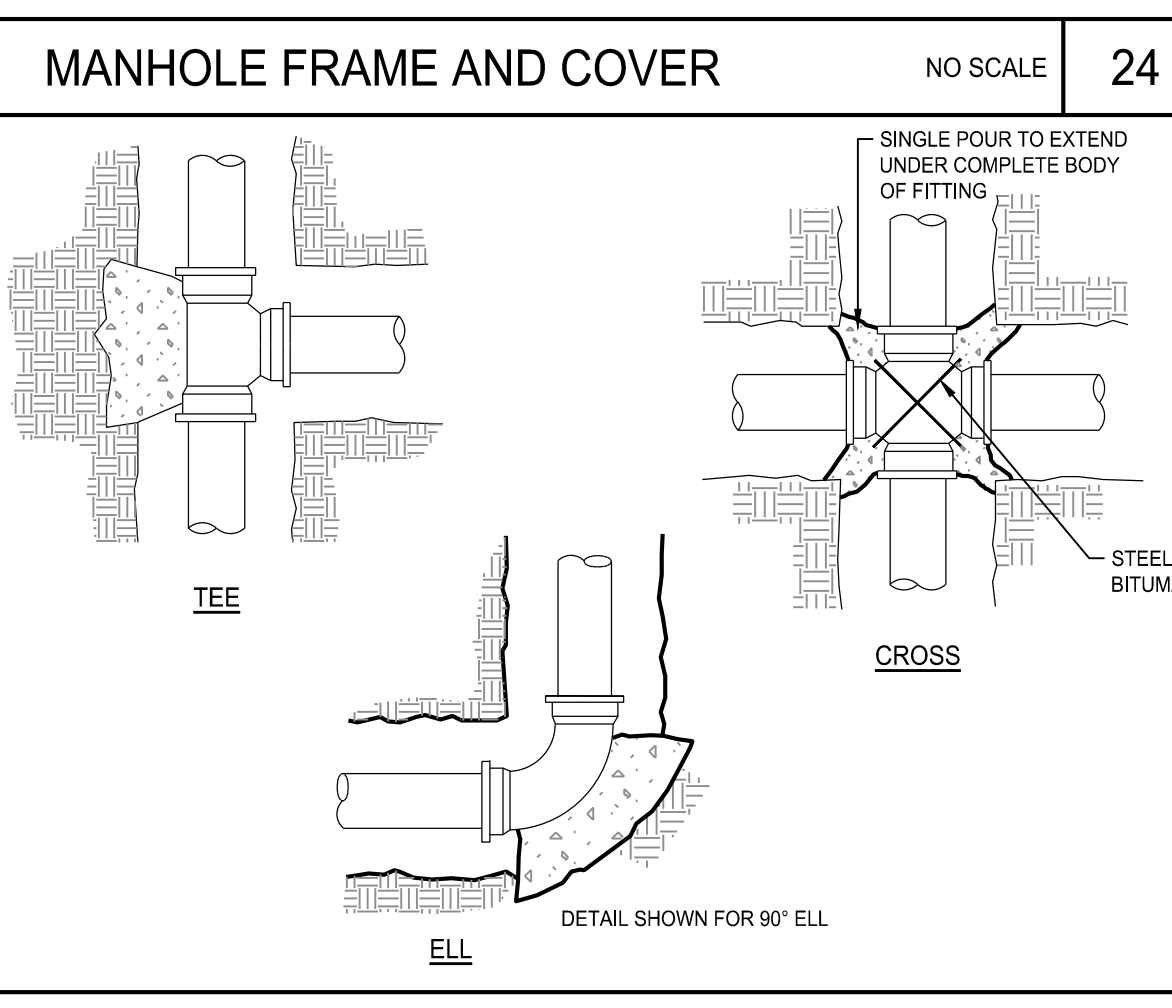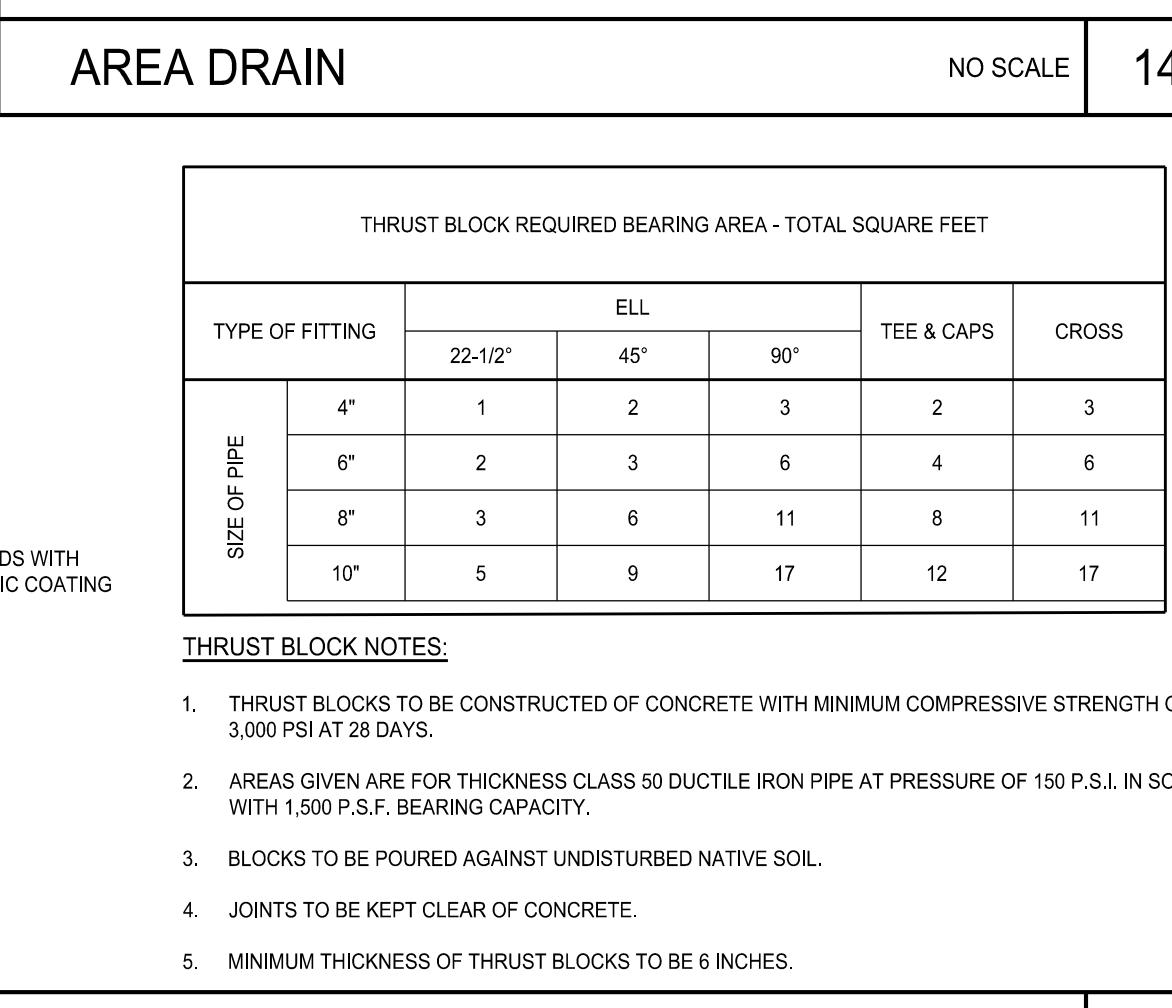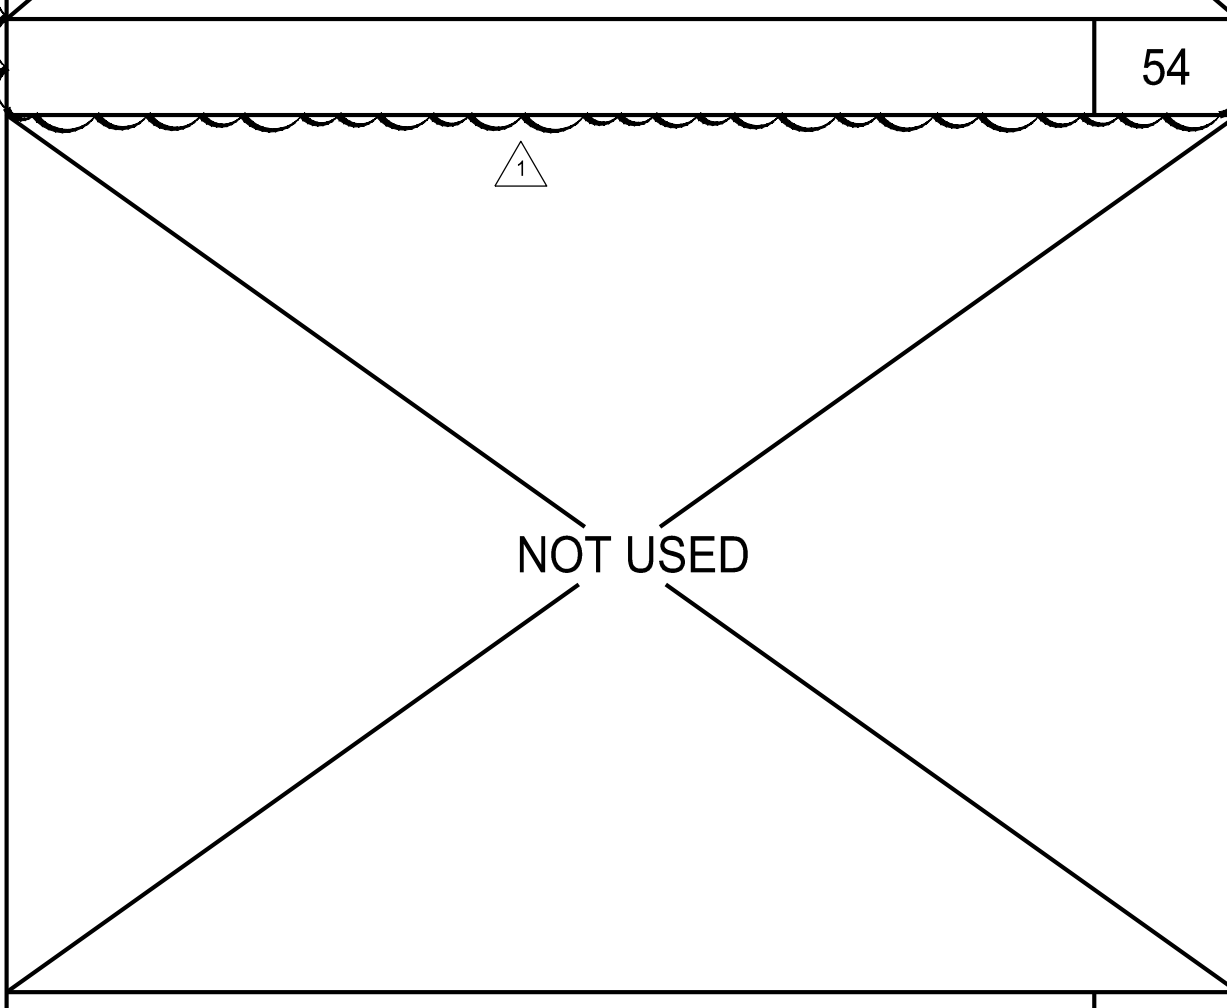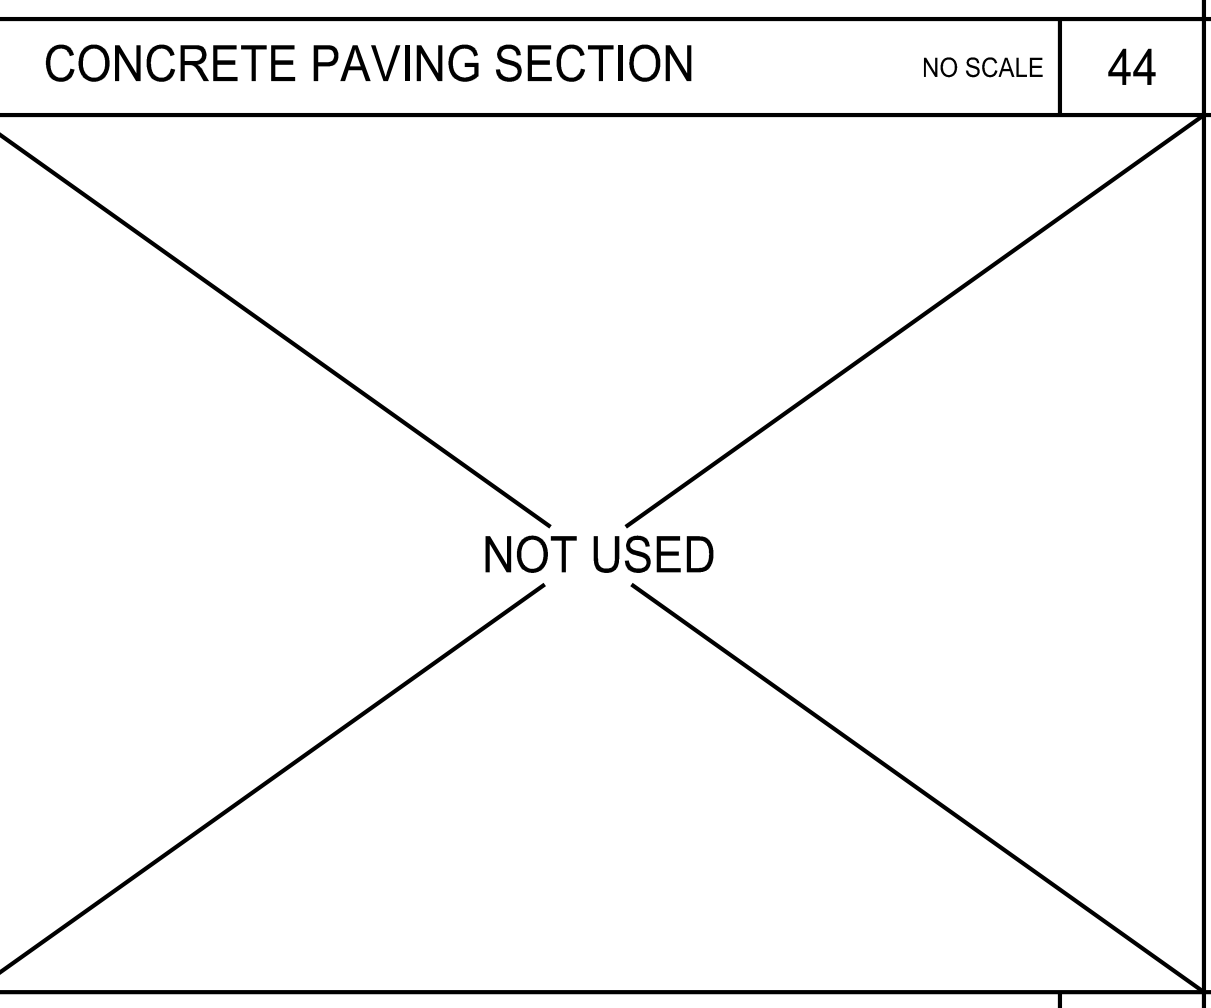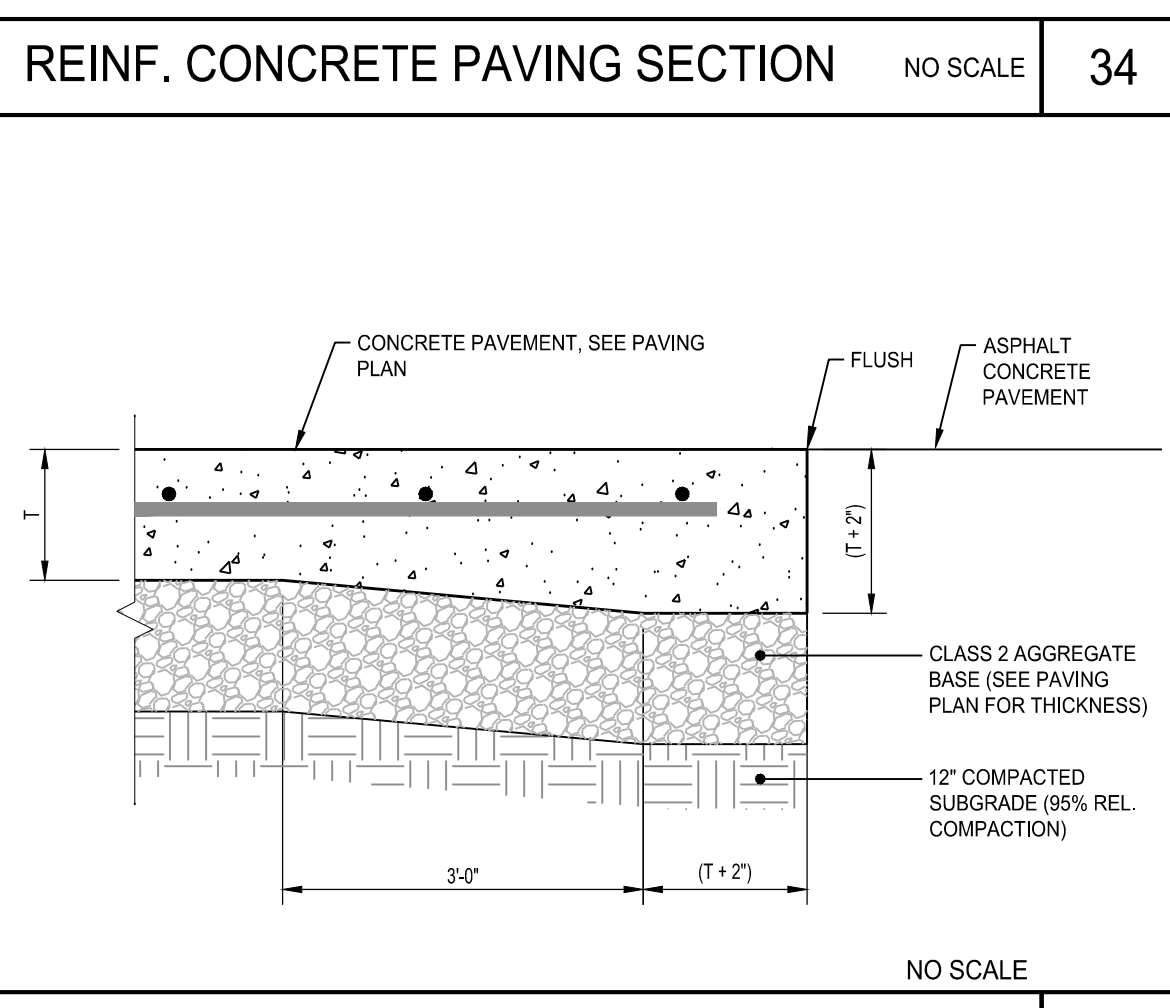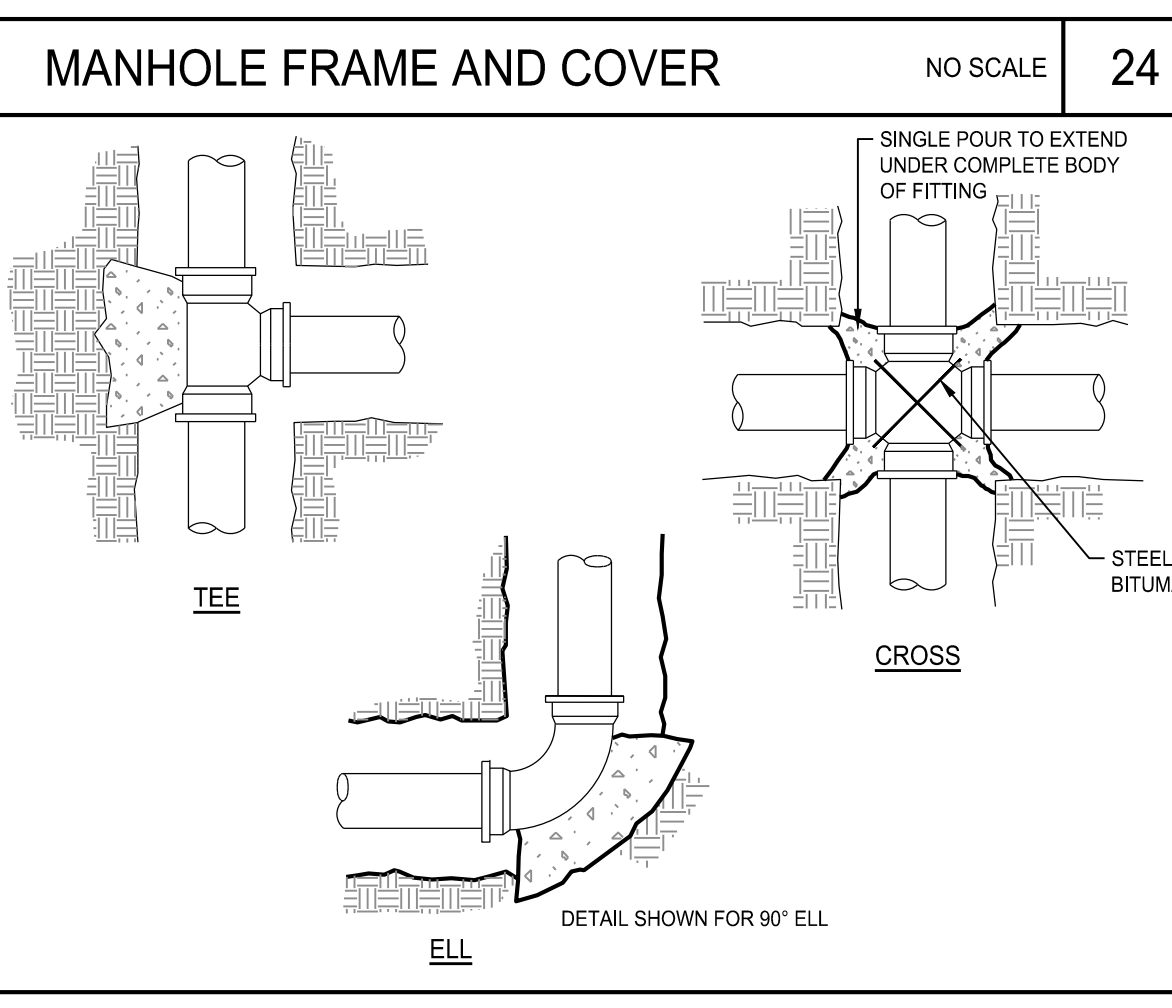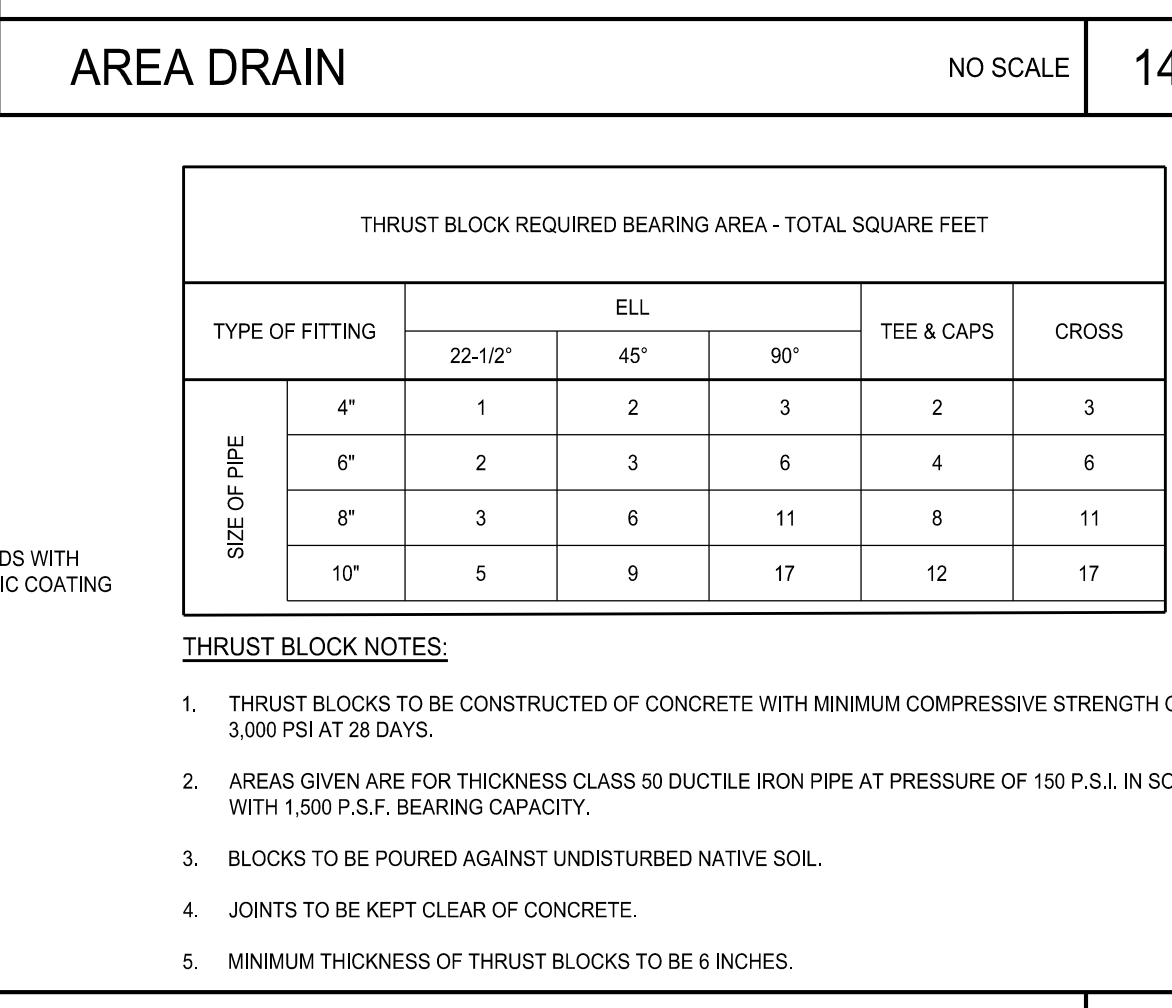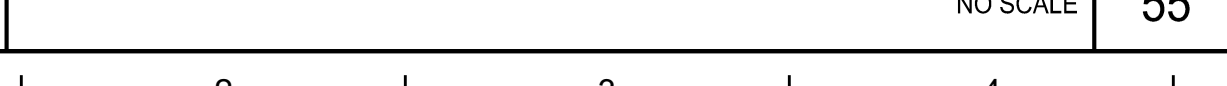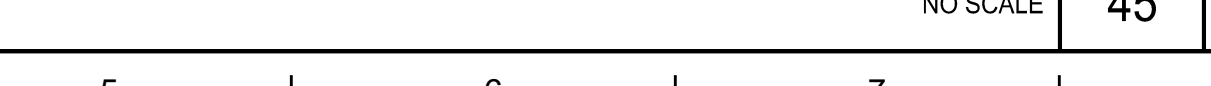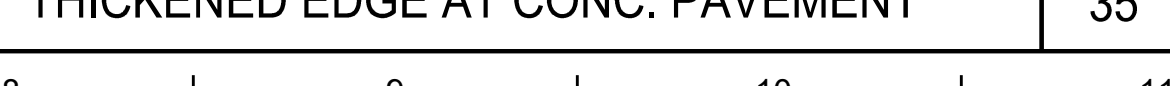


No.	Revision/Submission	Date

Scale: AS INDICATED	Designed By: WV	Copyright 2022 Darden Architects
Project Number: 2180	Drawn By: WV	SD/C4.2.1
Date: 08-02-22	Checked By: AO	
	Reviewed By: AO	Sheet: 1 of 1

1	2	3	4	5	6	7	8	9	10	11	12	13	14	15	16	17	18	19	20																					
R																	 <p>CRACK CONTROL JOINT (C.C.J.) NO SCALE 41</p>	 <p>CONSTRUCTION JOINT (C.J.) NO SCALE 42</p>																						
Q																	 <p>DRAIN INLET NO SCALE 32</p>	 <p>MANHOLE COVER INSTALLATION NO SCALE 22</p>																						
P																	 <p>SURFACE CLEANOUT (COTG) NO SCALE 21</p>	 <p>TYP. TRENCH BACKFILL AND PAVING NO SCALE 11</p>																						
N																	 <p>FILL SLOPE NO SCALE 43</p>	 <p>ASPHALT PAVEMENT SECTION NO SCALE 33</p>	 <p>MANHOLE FRAME AND COVER NO SCALE 24</p>	 <p>STORMDRAIN MANHOLE NO SCALE 13</p>																				
M																	 <p>CONCRETE PAVING SECTION NO SCALE 44</p>	 <p>REINF. CONCRETE PAVING SECTION NO SCALE 34</p>	 <p>MANHOLE FRAME AND COVER NO SCALE 24</p>	 <p>AREA DRAIN NO SCALE 14</p>																				
L																	 <p>THICKENED EDGE AT CONC. PAVEMENT NO SCALE 45</p>	 <p>CONCRETE THRUST BLOCK NO SCALE 35</p>	 <p>CONCRETE THRUST BLOCK NO SCALE 15</p>	 <p>THRUST BLOCK TABLE</p> <table border="1"> <thead> <tr> <th colspan="6">THRUST BLOCK REQUIRED BEARING AREA - TOTAL SQUARE FEET</th> </tr> <tr> <th>TYPE OF FITTING</th> <th>22-1/2"</th> <th>45"</th> <th>90"</th> <th>TEE & CAPS</th> <th>CROSS</th> </tr> </thead> <tbody> <tr> <td>4"</td> <td>1</td> <td>2</td> <td>3</td> <td>2</td> <td>3</td> </tr> <tr> <td>6"</td> <td>2</td> <td>3</td> <td>6</td> <td>4</td> <td>6</td> </tr> <tr> <td>8"</td> <td>3</td> <td>6</td> <td>11</td> <td>8</td> <td>11</td> </tr> <tr> <td>10"</td> <td>5</td> <td>9</td> <td>17</td> <td>12</td> <td>17</td> </tr> </tbody> </table> <p>THRUST BLOCK NOTES:</p> <ol style="list-style-type: none"> THRUST BLOCKS TO BE CONSTRUCTED OF CONCRETE WITH MINIMUM COMPRESSIVE STRENGTH OF 3000 PSI AT 28 DAYS. AREAS GIVEN ARE FOR THICKNESS CLASS 90 DUCTILE IRON PIPE AT PRESSURE OF 150 P.S.I. IN SOIL WITH 1,500 P.S.F. BEARING CAPACITY. BLOCKS TO BE POURED AGAINST UNDISTURBED NATIVE SOIL. JOINTS TO BE KEPT CLEAR OF CONCRETE. MINIMUM THICKNESS OF THRUST BLOCKS TO BE 6 INCHES. 	THRUST BLOCK REQUIRED BEARING AREA - TOTAL SQUARE FEET						TYPE OF FITTING	22-1/2"	45"	90"	TEE & CAPS	CROSS	4"	1	2	3	2	3	6"	2
THRUST BLOCK REQUIRED BEARING AREA - TOTAL SQUARE FEET																																								
TYPE OF FITTING	22-1/2"	45"	90"	TEE & CAPS	CROSS																																			
4"	1	2	3	2	3																																			
6"	2	3	6	4	6																																			
8"	3	6	11	8	11																																			
10"	5	9	17	12	17																																			
K																	 <p>CONCRETE THRUST BLOCK NO SCALE 45</p>	 <p>CONCRETE THRUST BLOCK NO SCALE 35</p>	 <p>CONCRETE THRUST BLOCK NO SCALE 15</p>	 <p>CONCRETE THRUST BLOCK NO SCALE 15</p>																				
J																																	 <p>CONCRETE THRUST BLOCK NO SCALE 45</p>	 <p>CONCRETE THRUST BLOCK NO SCALE 35</p>	 <p>CONCRETE THRUST BLOCK NO SCALE 15</p>	 <p>CONCRETE THRUST BLOCK NO SCALE 15</p>				
H																																	 <p>CONCRETE THRUST BLOCK NO SCALE 45</p>	 <p>CONCRETE THRUST BLOCK NO SCALE 35</p>	 <p>CONCRETE THRUST BLOCK NO SCALE 15</p>	 <p>CONCRETE THRUST BLOCK NO SCALE 15</p>				
G																																	 <p>CONCRETE THRUST BLOCK NO SCALE 45</p>	 <p>CONCRETE THRUST BLOCK NO SCALE 35</p>	 <p>CONCRETE THRUST BLOCK NO SCALE 15</p>	 <p>CONCRETE THRUST BLOCK NO SCALE 15</p>				
F																																	<p>CONCRETE THRUST BLOCK NO SCALE 45</p>	<p>CONCRETE THRUST BLOCK NO SCALE 35</p>	<p>CONCRETE THRUST BLOCK NO SCALE 15</p>	<p>CONCRETE THRUST BLOCK NO SCALE 15</p>				
E																																	<p>CONCRETE THRUST BLOCK NO SCALE 45</p>	<p>CONCRETE THRUST BLOCK NO SCALE 35</p>	<p>CONCRETE THRUST BLOCK NO SCALE 15</p>	<p>CONCRETE THRUST BLOCK NO SCALE 15</p>				
D																																	<p>CONCRETE THRUST BLOCK NO SCALE 45</p>	<p>CONCRETE THRUST BLOCK NO SCALE 35</p>	<p>CONCRETE THRUST BLOCK NO SCALE 15</p>	<p>CONCRETE THRUST BLOCK NO SCALE 15</p>				
																																	<p>CONCRETE THRUST BLOCK NO SCALE 45</p>	<p>CONCRETE THRUST BLOCK NO SCALE 35</p>	<p>CONCRETE THRUST BLOCK NO SCALE 15</p>	<p>CONCRETE THRUST BLOCK NO SCALE 15</p>				
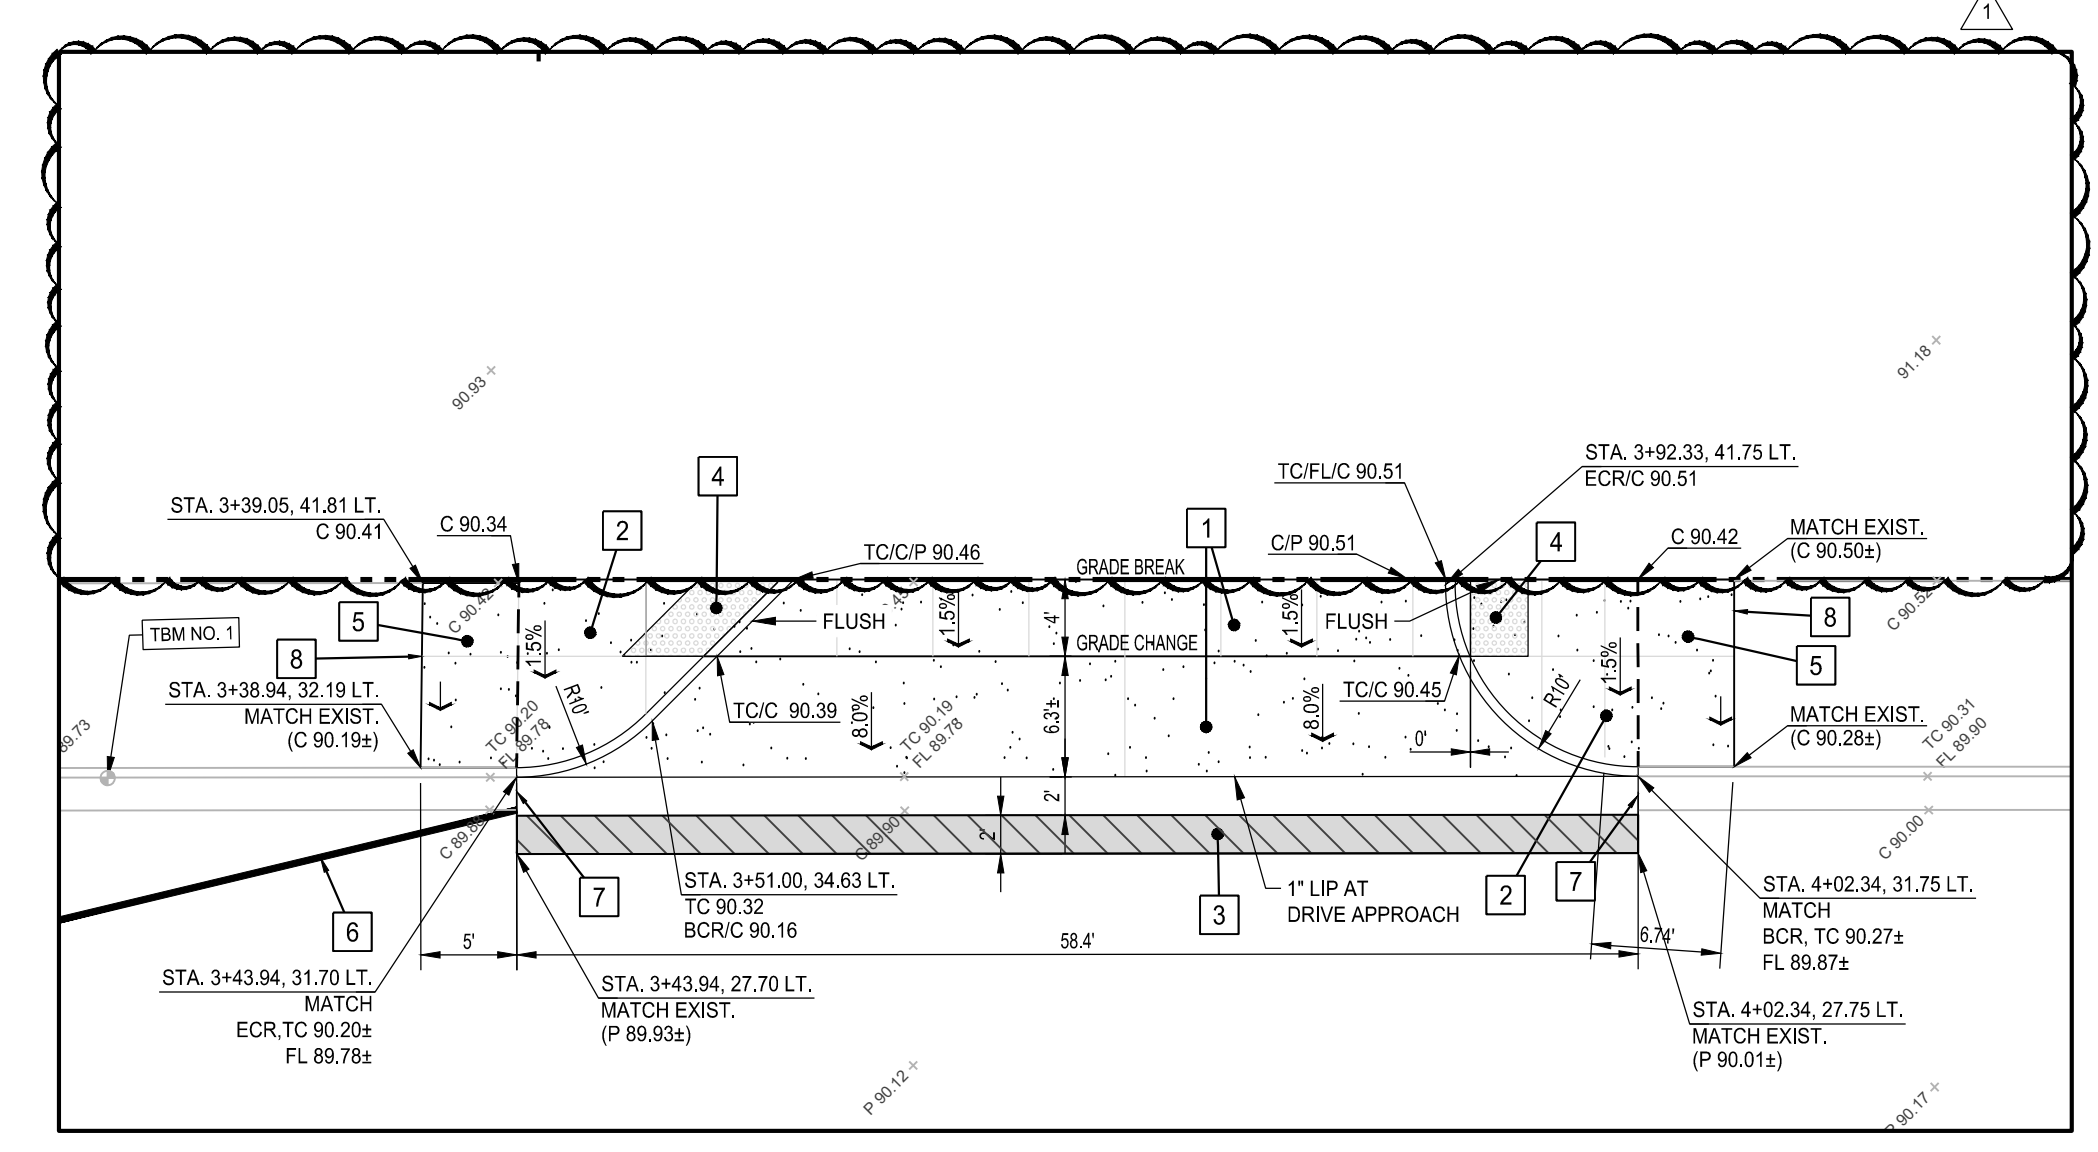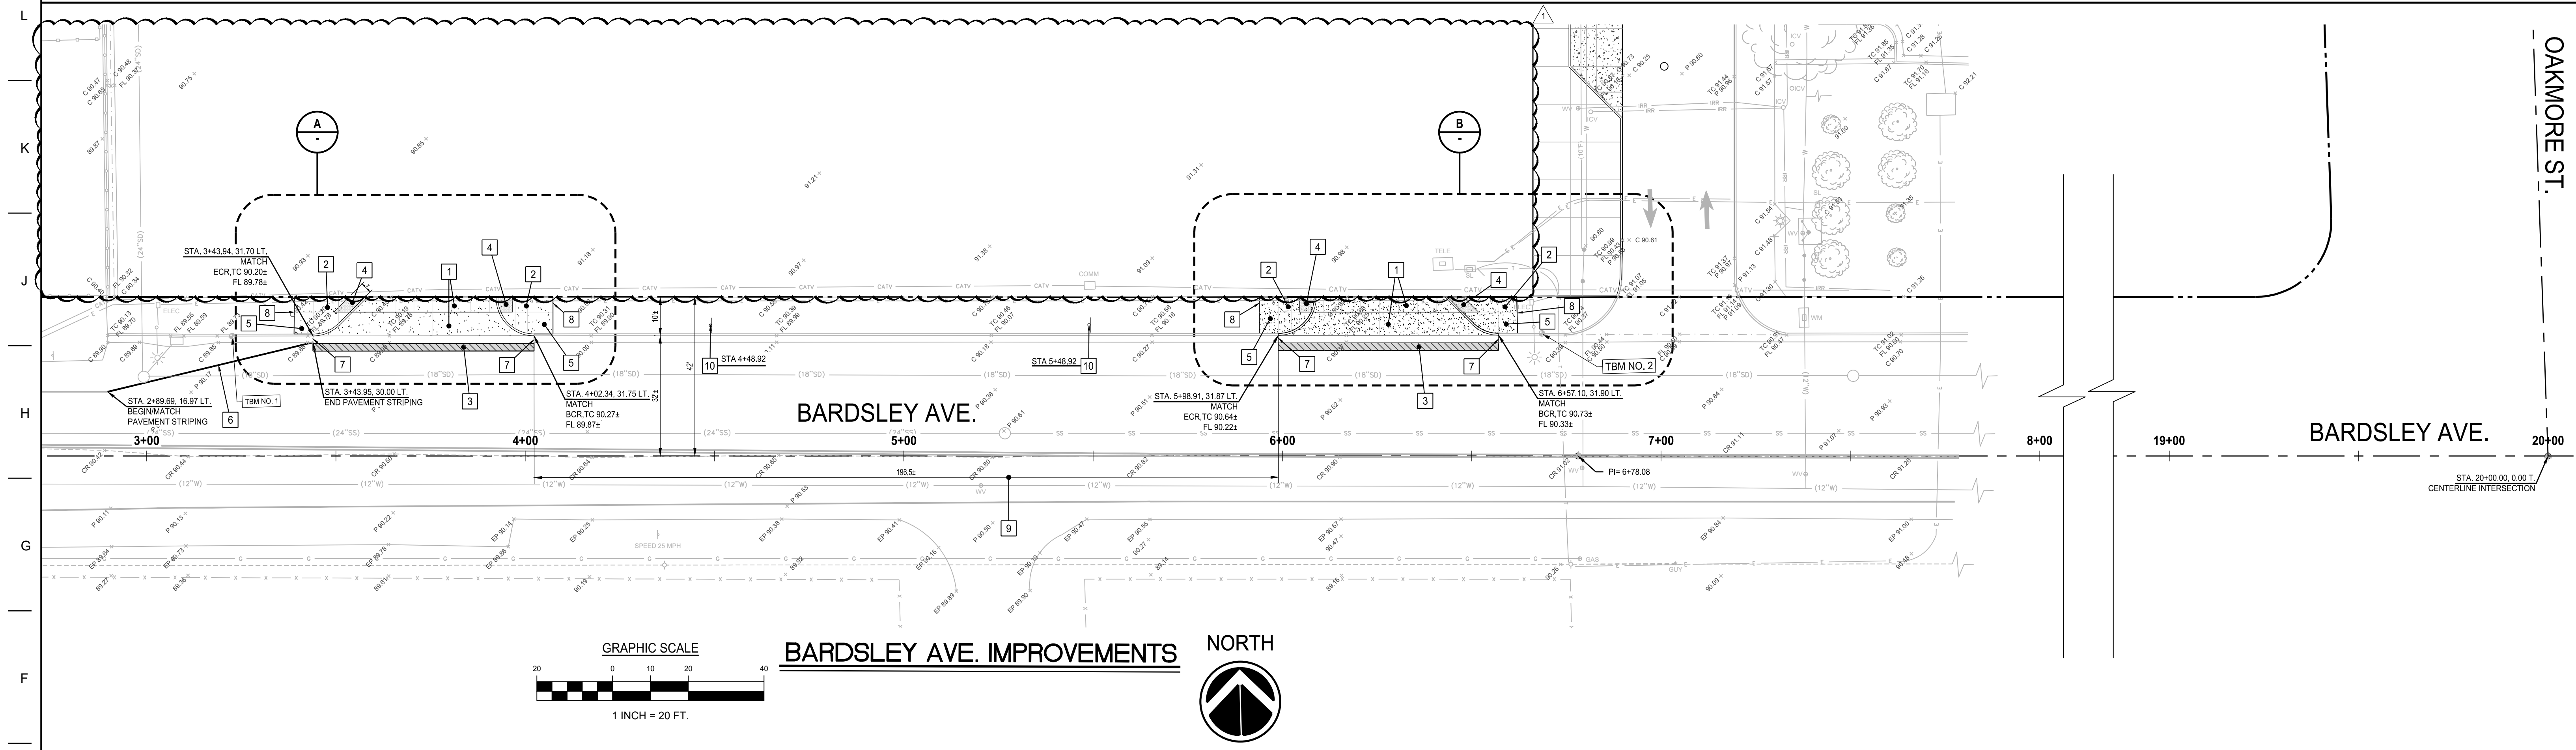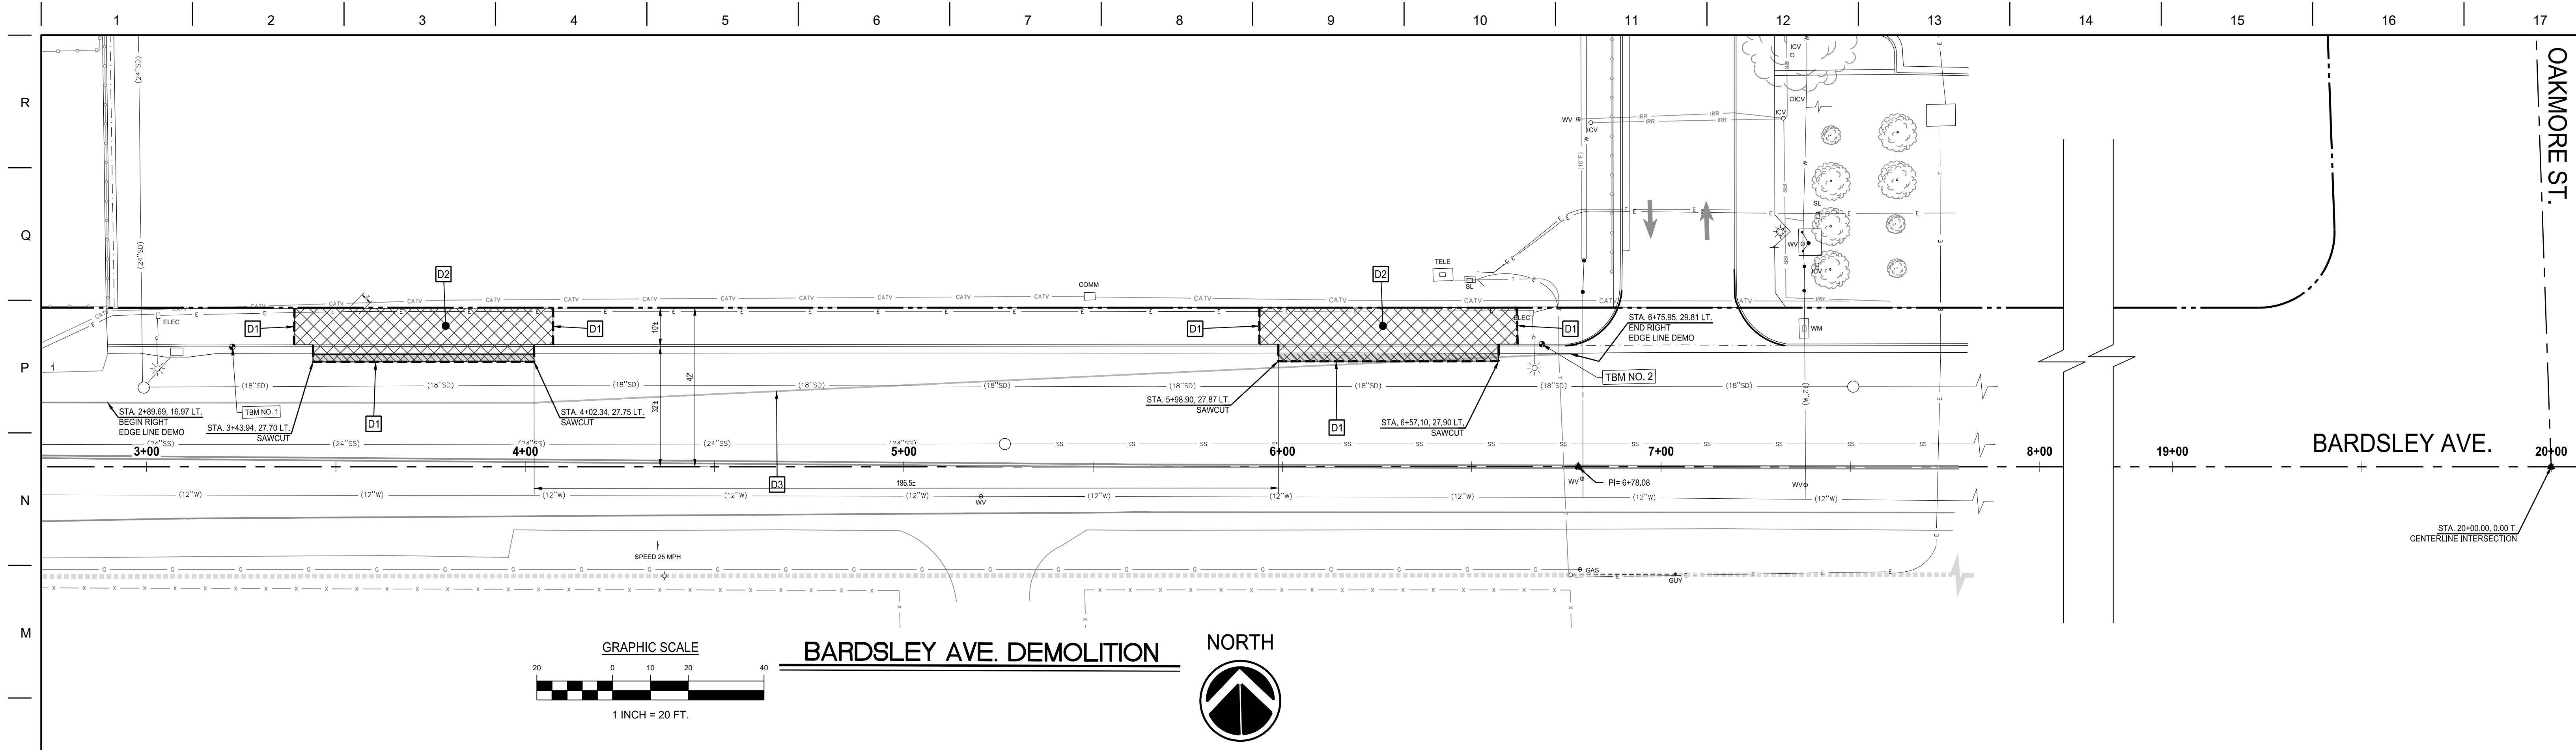

A ENLARGED DRIVE APPROACH DETAIL
SCALE: 1"=10'

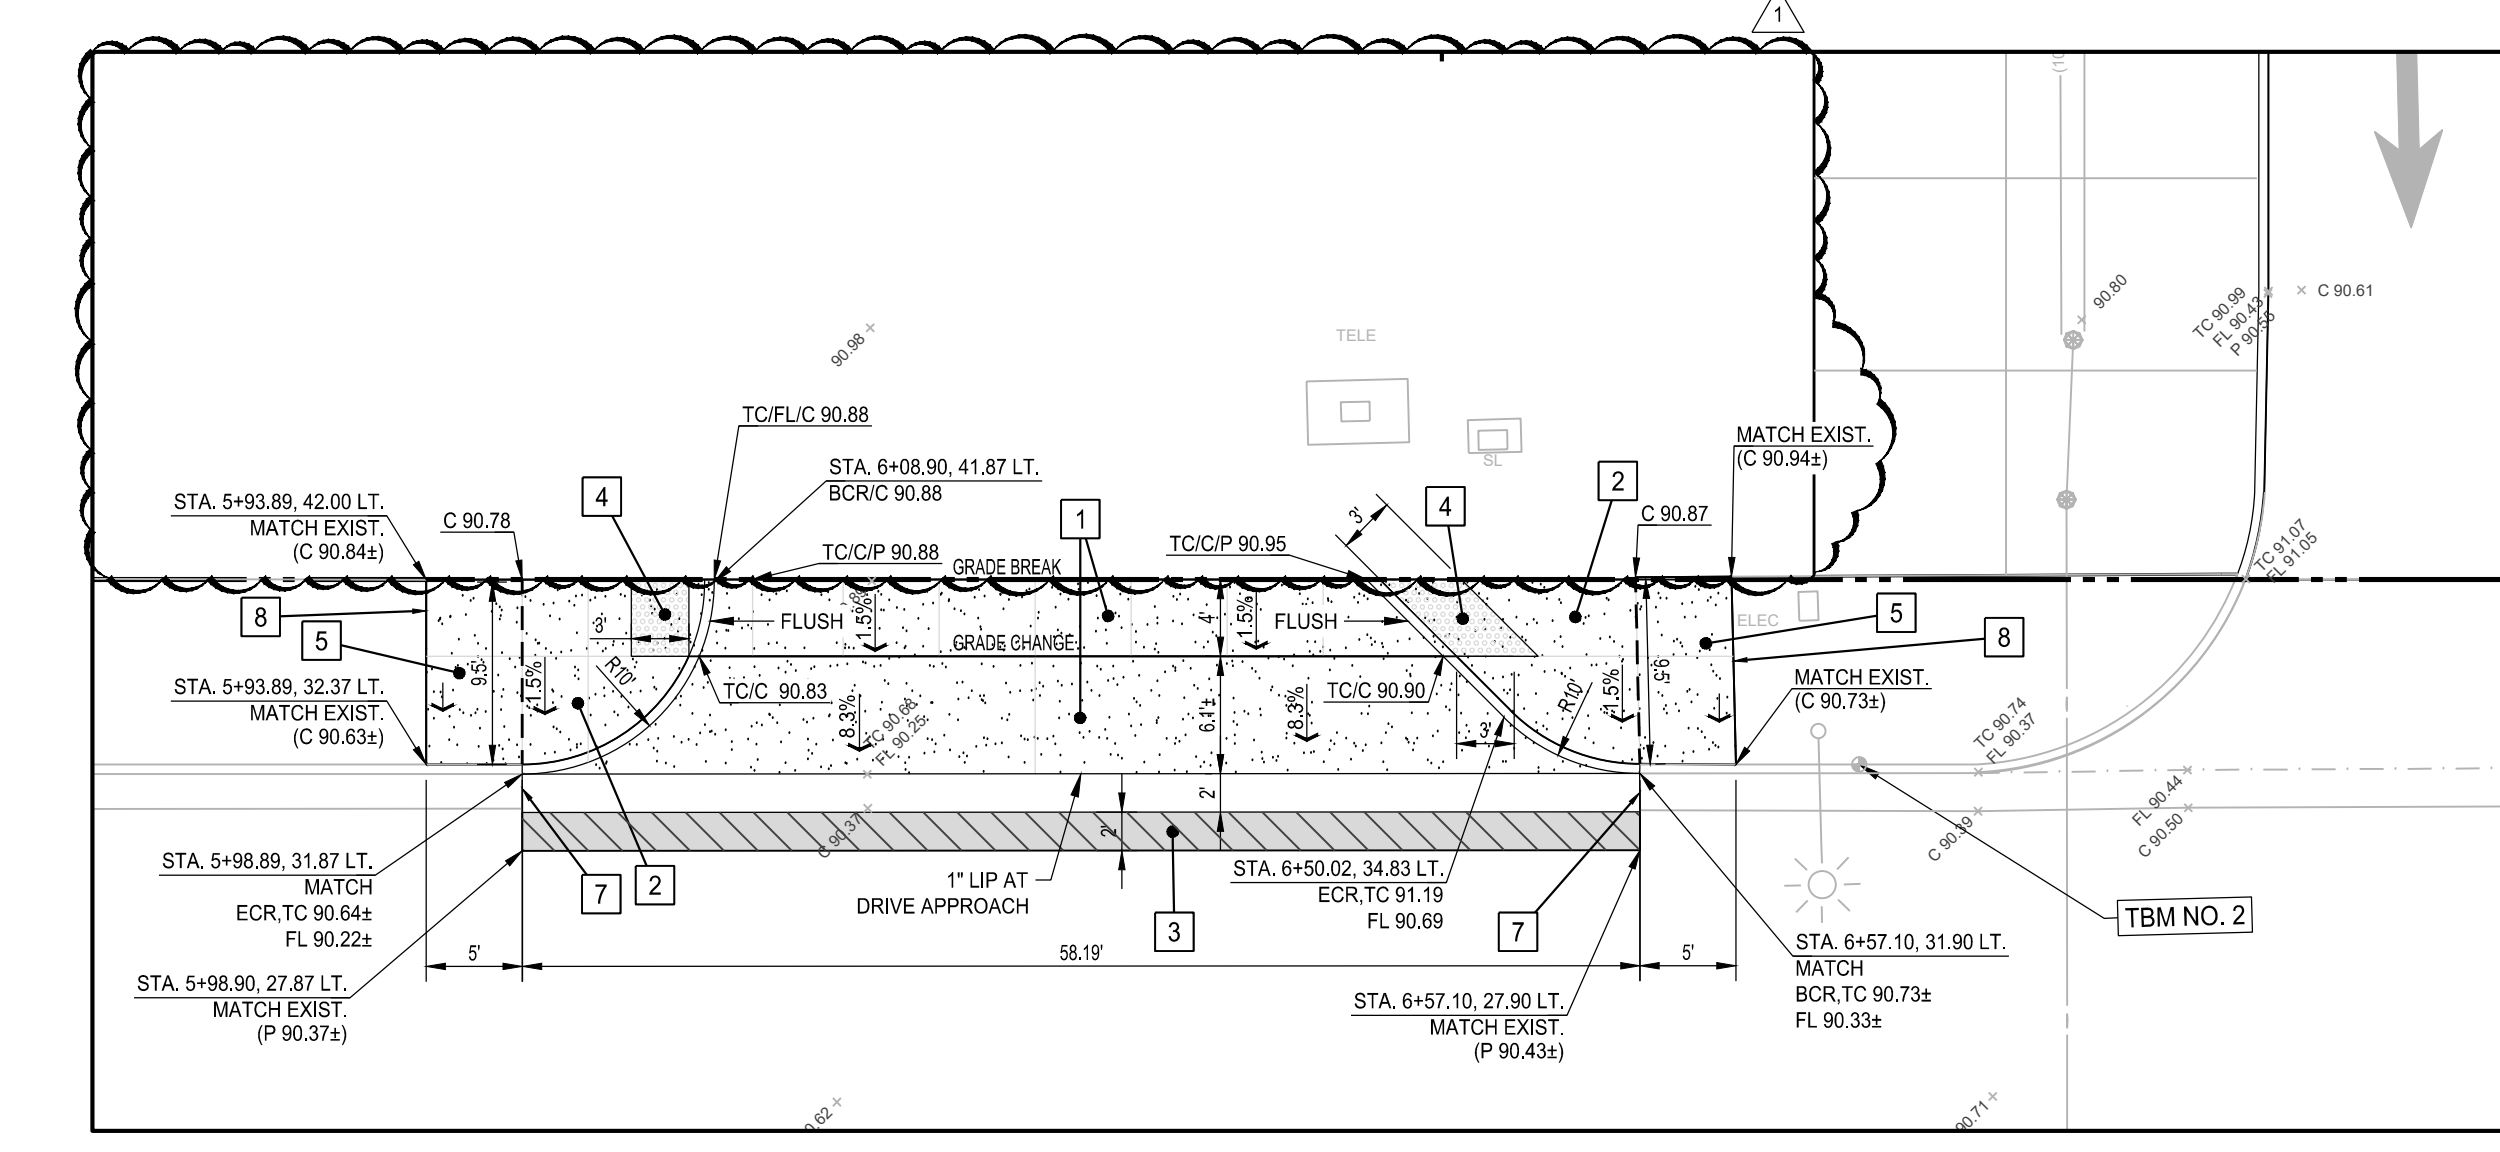

B ENLARGED DRIVE APPROACH DETAIL
SCALE: 1"=10'

- DEMOLITION NOTES** (THIS SHEET ONLY)
- REFER TO SHEET C0.2 FOR BENCHMARKS, GENERAL NOTES & INFORMATION.
 - INFRASTRUCTURE NOT NOTED FOR SALVAGE, REMOVAL, OR RELOCATION SHALL BE PROTECTED IN PLACE.
 - ITEMS NOTED TO BE SALVAGED SHALL BE REMOVED WITHOUT DAMAGING AND STORED UNTIL THEY ARE RE-INSTALLED AS SHOWN ON THE PLANS.
 - STRIPING & PAVEMENT MARKINGS NOTED TO BE REMOVED COMPLETELY BY LIGHTLY SPRINKLING.
 - ALL HOLES AND TRENCHES CREATED FROM INFRASTRUCTURE REMOVAL SHALL BE BACKFILLED AND COMPACTED IN ACCORDANCE WITH PROJECT EARTHWORK AND TRENCHING REQUIREMENTS.
 - IT SHALL BE THE CONTRACTOR'S RESPONSIBILITY TO FIELD VERIFY ALL ITEMS NOTED FOR REMOVAL WITH THE OWNER. PRIOR TO CONSTRUCTION, THE CONTRACTOR SHALL VERIFY DIMENSIONS FOR DEMOLITION SHOWN ON THIS PLAN WITH THE PROPERTY OWNER.
 - EXISTING STRUCTURES OR IMPROVEMENTS (I.E. UTILITY BOXES, VALVE BOXES, SIGNS, LIGHTS, ETC.) THAT ARE DAMAGED OR TEMPORARILY REMOVED DURING DEMOLITION SHALL BE REPLACED IN KIND, U/A/C.
 - CONTRACTOR SHALL PREPARE A TRAFFIC CONTROL PLAN AND OBTAIN APPROVAL FROM THE CITY ENGINEER PRIOR TO COMMENCING CONSTRUCTION.

- LEGEND**
- RIGHT OF WAY
 - STREET CENTERLINE

- DEMOLITION KEYNOTES** (THIS SHEET ONLY)
- D1** SAWCUT EDGE CONCRETE/ASPHALT TO A NEAT VERTICAL EDGE FOR CONCRETE REMOVAL.
SAWCUT LINE SHOWN THIS: - - - - -
 - D2** UNLESS NOTED OTHERWISE, DEMOLISH AND REMOVE ALL EXISTING SURFACE SITE IMPROVEMENTS (CONCRETE, ASPHALT PAVEMENT, CURBS, GUTTERS, ETC.) WITHIN DEMOLITION LIMITS.
SHOWN THIS: [Hatched Box]
 - D3** REMOVE 4\"/>

- CONSTRUCTION NOTES** (THIS SHEET ONLY)
- REFER TO SHEET C0.2 FOR BENCHMARKS, GENERAL NOTES & INFORMATION.
 - PRIOR TO DOING ANY WORK WITHIN CITY RIGHT OF WAY, CONTRACTOR SHALL OBTAIN ENCROACHMENT PERMIT FROM THE CITY OF TULARE.
 - ALL WORK WITHIN CITY OF TULARE RIGHT-OF-WAY SHALL CONFORM TO THE CITY OF TULARE PUBLIC IMPROVEMENT STANDARDS AND SPECIFICATIONS UNLESS OTHERWISE NOTED.
 - FIELD VERIFY ALL ELEVATIONS SHOWN WHERE EXISTING IMPROVEMENTS ABUT PROPOSED IMPROVEMENTS. IMMEDIATELY NOTIFY ENGINEER OF ANY DISCREPANCIES.
 - ALL DIMENSIONS SHOWN TO CURB ARE TO FACE OF CURB UNLESS OTHERWISE SHOWN OR NOTED.
 - FLOW LINE ELEVATION IS 0.5 BELOW TOP OF CURB UNLESS OTHERWISE SHOWN OR NOTED.
 - CROSS-SLOPES AT SIDEWALKS SHALL BE 1.5% UNLESS OTHERWISE SHOWN OR NOTED. IN NO CASE SHALL THE CROSS SLOPE EXCEED 2%.
 - GUTTER PAN AT BOTTOM OF ACCESSIBLE RAMP SHALL BE WARPED TO HAVE A SLOPE NOT EXCEEDING 5.0% IN THE DIRECTION OF TRAVEL.
 - ADJUST ALL EXISTING MANHOLES, GATE VALVES, UTILITY BOXES, AND WATER METERS TO BE FLUSH WITH FINISH GRADES.

- LEGEND**
- BARDSLEY AVE. PAVEMENT REPAIR AT DRIVE APPROACH
 - RIGHT OF WAY
 - STREET CENTERLINE

- CONSTRUCTION KEYNOTES** (THIS SHEET ONLY)
- CONSTRUCT DRIVE APPROACH WITH 4\"/>

LANE ENGINEERS INC.
CIVIL & STRUCTURAL ENGINEERING
979 N. BLACKSTONE
TULARE, CALIFORNIA 93274
(559) 898-5283

06/01/2023
CIVIL

Consultant

Mission Oak HS Aquatic Complex
Tulare Joint Union High School District
Tulare, CA

Project

OFFSITE IMPROVEMENTS
BARDSLEY AVE. OFFSITES

Drawing


darden architects
ARCHITECTURE
PLANNING
INTERIORS
www.dardenarchitects.com
6790 N. West Ave. • Fresno, CA 93711 • T. 559.448.8051

Architect

No.	Revision/Submission	Date
1	REVISION 01	5/31/23

Revision		
Scale:	Designed By:	Copyright
VARIABLES (SEE PLAN)	WV	2022 Darden Architects
Project Number: 2180	Checked By: AO	SD/C6.1
Date: 10-24-22	Reviewed By: AO	
Sheet: 1 of 1		

(NOT FOR DSA APPROVAL)

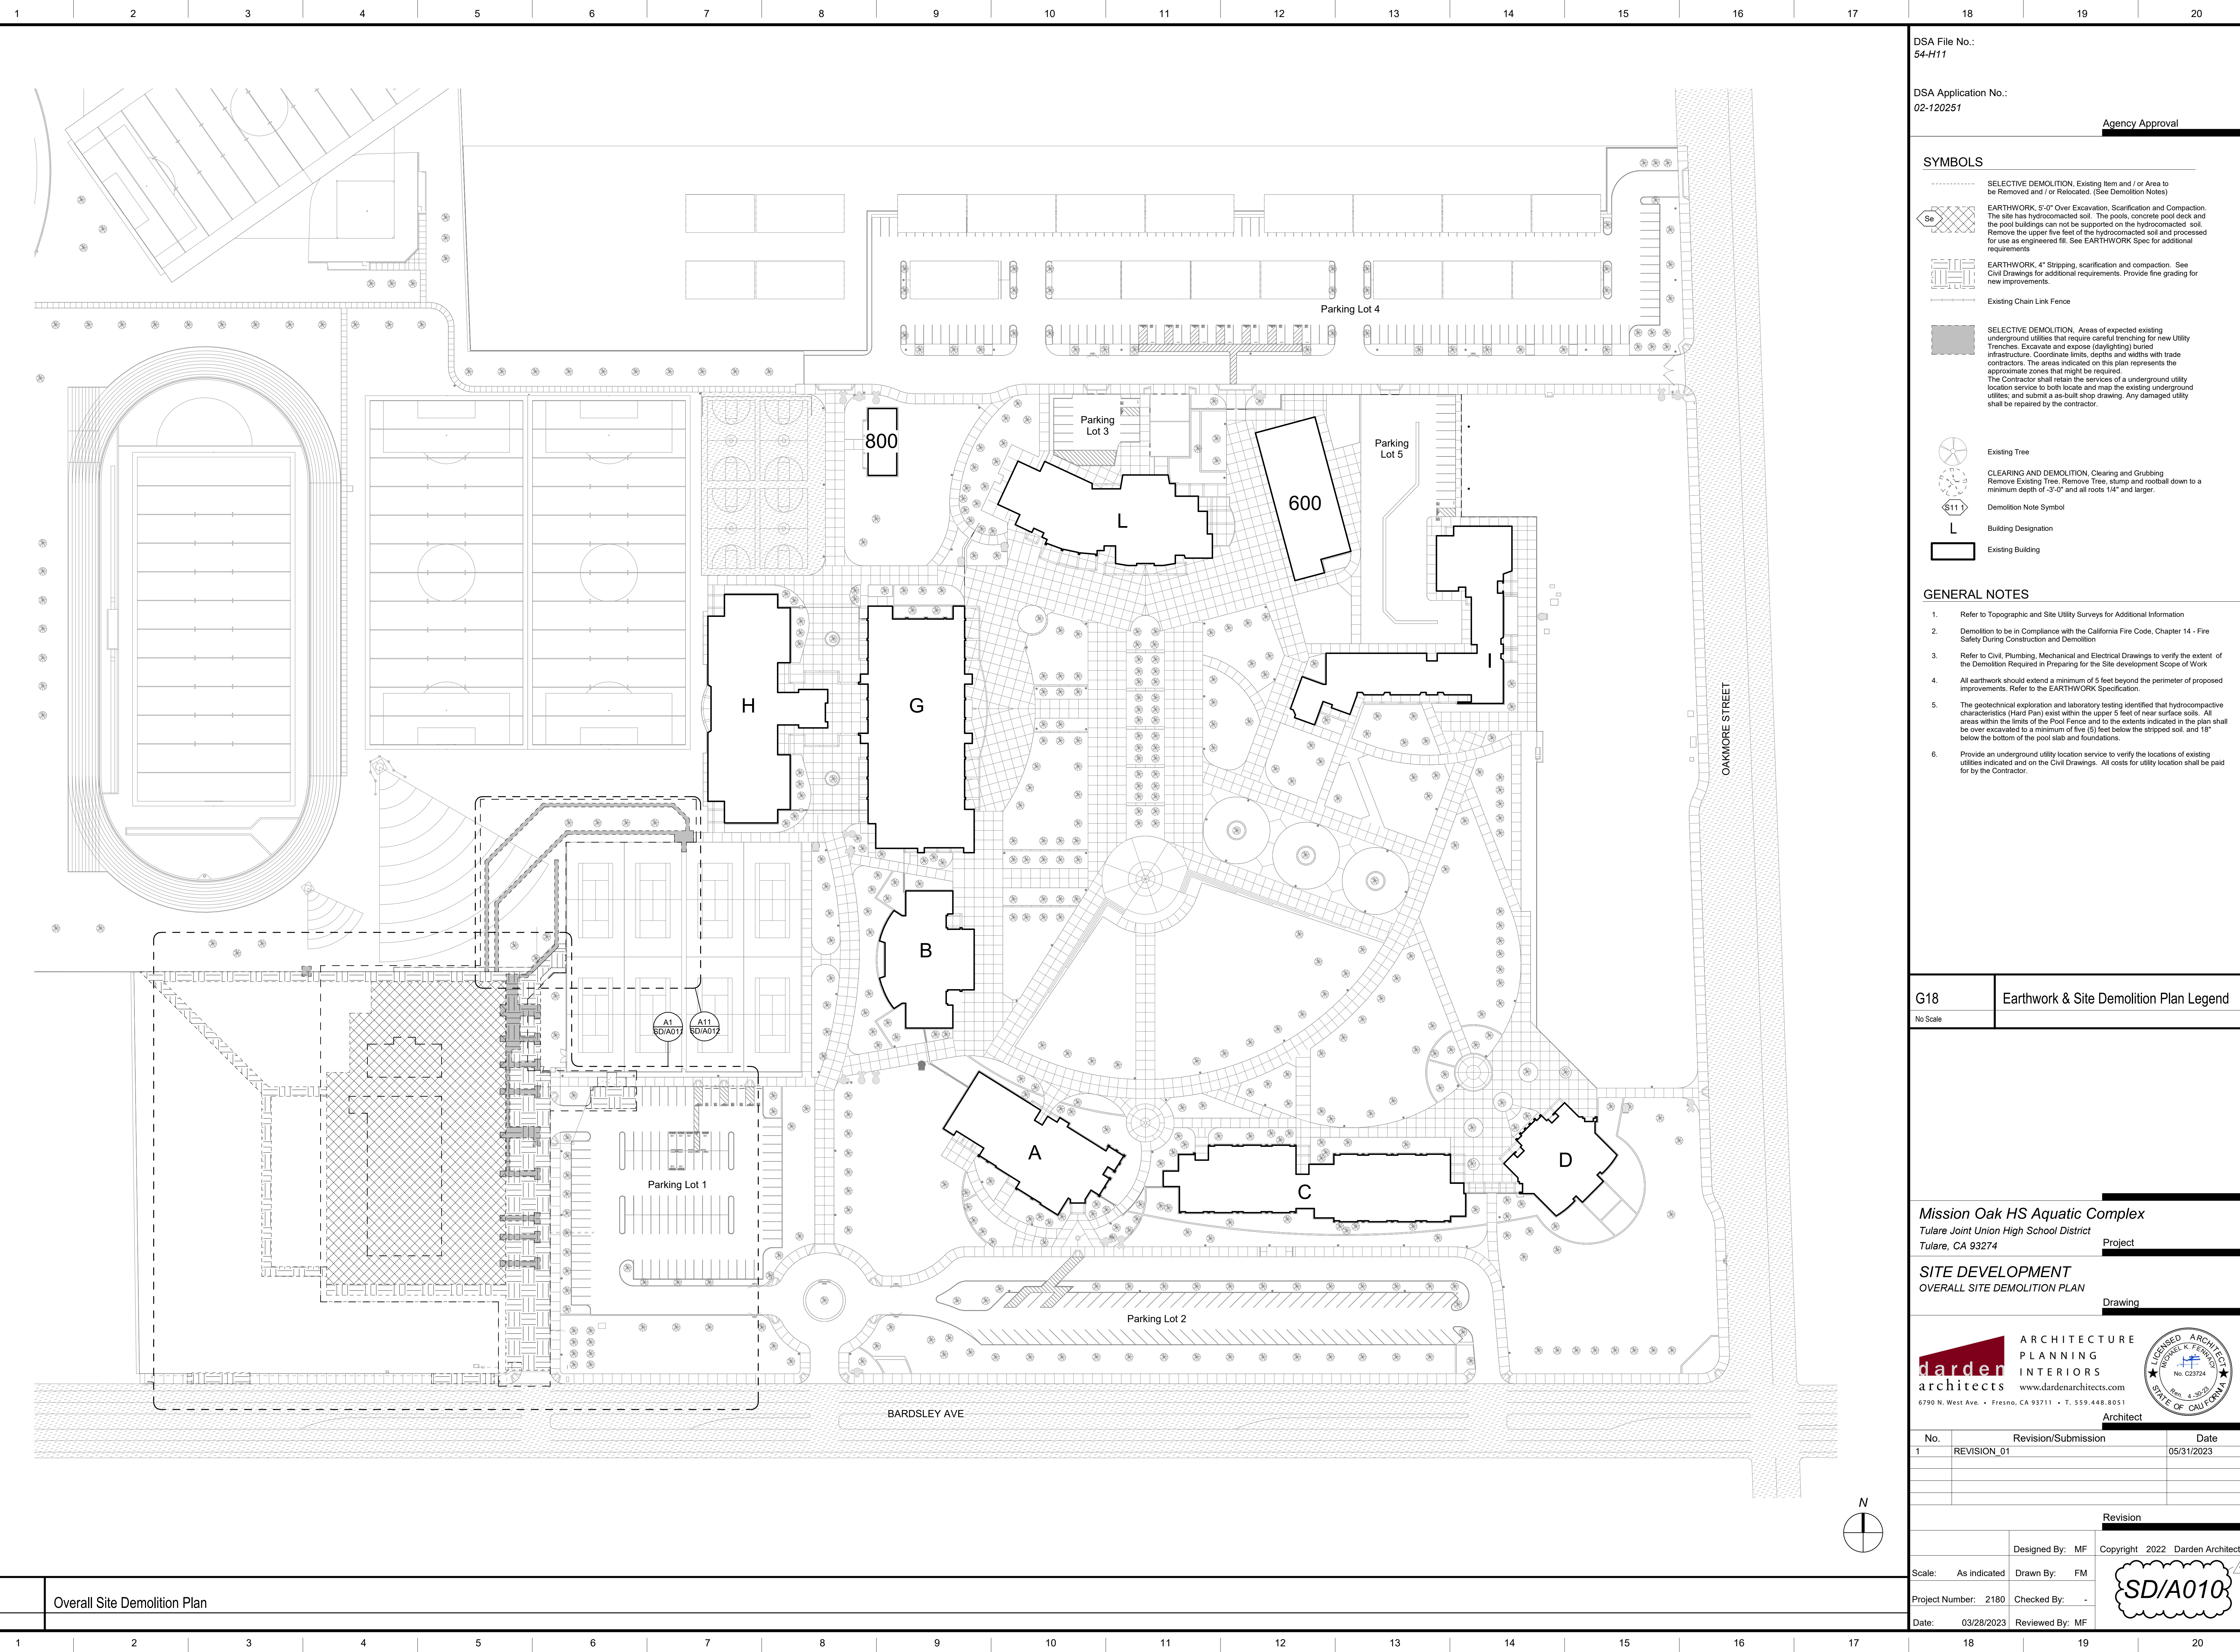

DSA File No.: 54-H11

DSA Application No.: 02-120251

Agency Approval

- SYMBOLS**
- SELECTIVE DEMOLITION, Existing Item and / or Area to be Removed and / or Relocated. (See Demolition Notes)
 - EARTHWORK, 5'-0" Over Excavation, Scarification and Compaction. The site has hydrocompacted soil. The pools, concrete pool deck and the pool buildings can not be supported on the hydrocompacted soil. Remove the upper five feet of the hydrocompacted soil and processed for use as engineered fill. See EARTHWORK Spec for additional requirements.
 - EARTHWORK, 4" Stripping, scarification and compaction. See Civil Drawings for additional requirements. Provide fine grading for new improvements.
 - Existing Chain Link Fence
 - SELECTIVE DEMOLITION, Areas of expected existing underground utilities that require careful trenching for new Utility Trenches. Excavate and expose (daylight) buried infrastructure. Coordinate limits, depths and widths with trade contractors. The areas indicated on this plan represents the approximate zones that might be required. The Contractor shall retain the services of a underground utility location service to both locate and map the existing underground utilities; and submit a as-built shop drawing. Any damaged utility shall be repaired by the contractor.
 - Existing Tree
 - CLEARING AND DEMOLITION, Clearing and Grubbing Remove Existing Tree, Remove Tree, stump and rootball down to a minimum depth of -3'-0" and all roots 1/4" and larger.
 - Demolition Note Symbol
 - Building Designation
 - Existing Building

- GENERAL NOTES**
1. Refer to Topographic and Site Utility Surveys for Additional Information
 2. Demolition to be in Compliance with the California Fire Code, Chapter 14 - Fire Safety During Construction and Demolition
 3. Refer to Civil, Plumbing, Mechanical and Electrical Drawings to verify the extent of the Demolition Required in Preparing for the Site development Scope of Work
 4. All earthwork should extend a minimum of 5 feet beyond the perimeter of proposed improvements. Refer to the EARTHWORK Specification.
 5. The geotechnical exploration and laboratory testing identified that hydrocompactive characteristics (Hard Pan) exist within the upper 5 feet of near surface soils. All areas within the limits of the Pool Fence and to the extents indicated in the plan shall be over excavated to a minimum of five (5) feet below the stripped soil, and 18" below the bottom of the pool slab and foundations.
 6. Provide an underground utility location service to verify the locations of existing utilities indicated and on the Civil Drawings. All costs for utility location shall be paid for by the Contractor.

G18 Earthwork & Site Demolition Plan Legend
No Scale

Mission Oak HS Aquatic Complex
Tulare Joint Union High School District
Tulare, CA 93274 Project

SITE DEVELOPMENT
OVERALL SITE DEMOLITION PLAN
Drawing

darden architects ARCHITECTURE PLANNING INTERIORS
www.dardenarchitects.com
6790 N. West Ave. • Fresno, CA 93711 • T. 559.448.8051
Architect

No.	Revision/Submission	Date
1	REVISION_01	05/31/2023


Revision
Designed By: MF Copyright 2022 Darden Architects

Scale: As indicated Drawn By: FM
Project Number: 2180 Checked By: -
Date: 03/28/2023 Reviewed By: MF

SD/A010

8/18/2023 4:28:38 PM e:\Users\alvin\Documents\180 Mission Oak HS Aquatic Complex_RD01_VZ2_A\invtv.nt

A1 Overall Site Demolition Plan
1" = 60'-0"

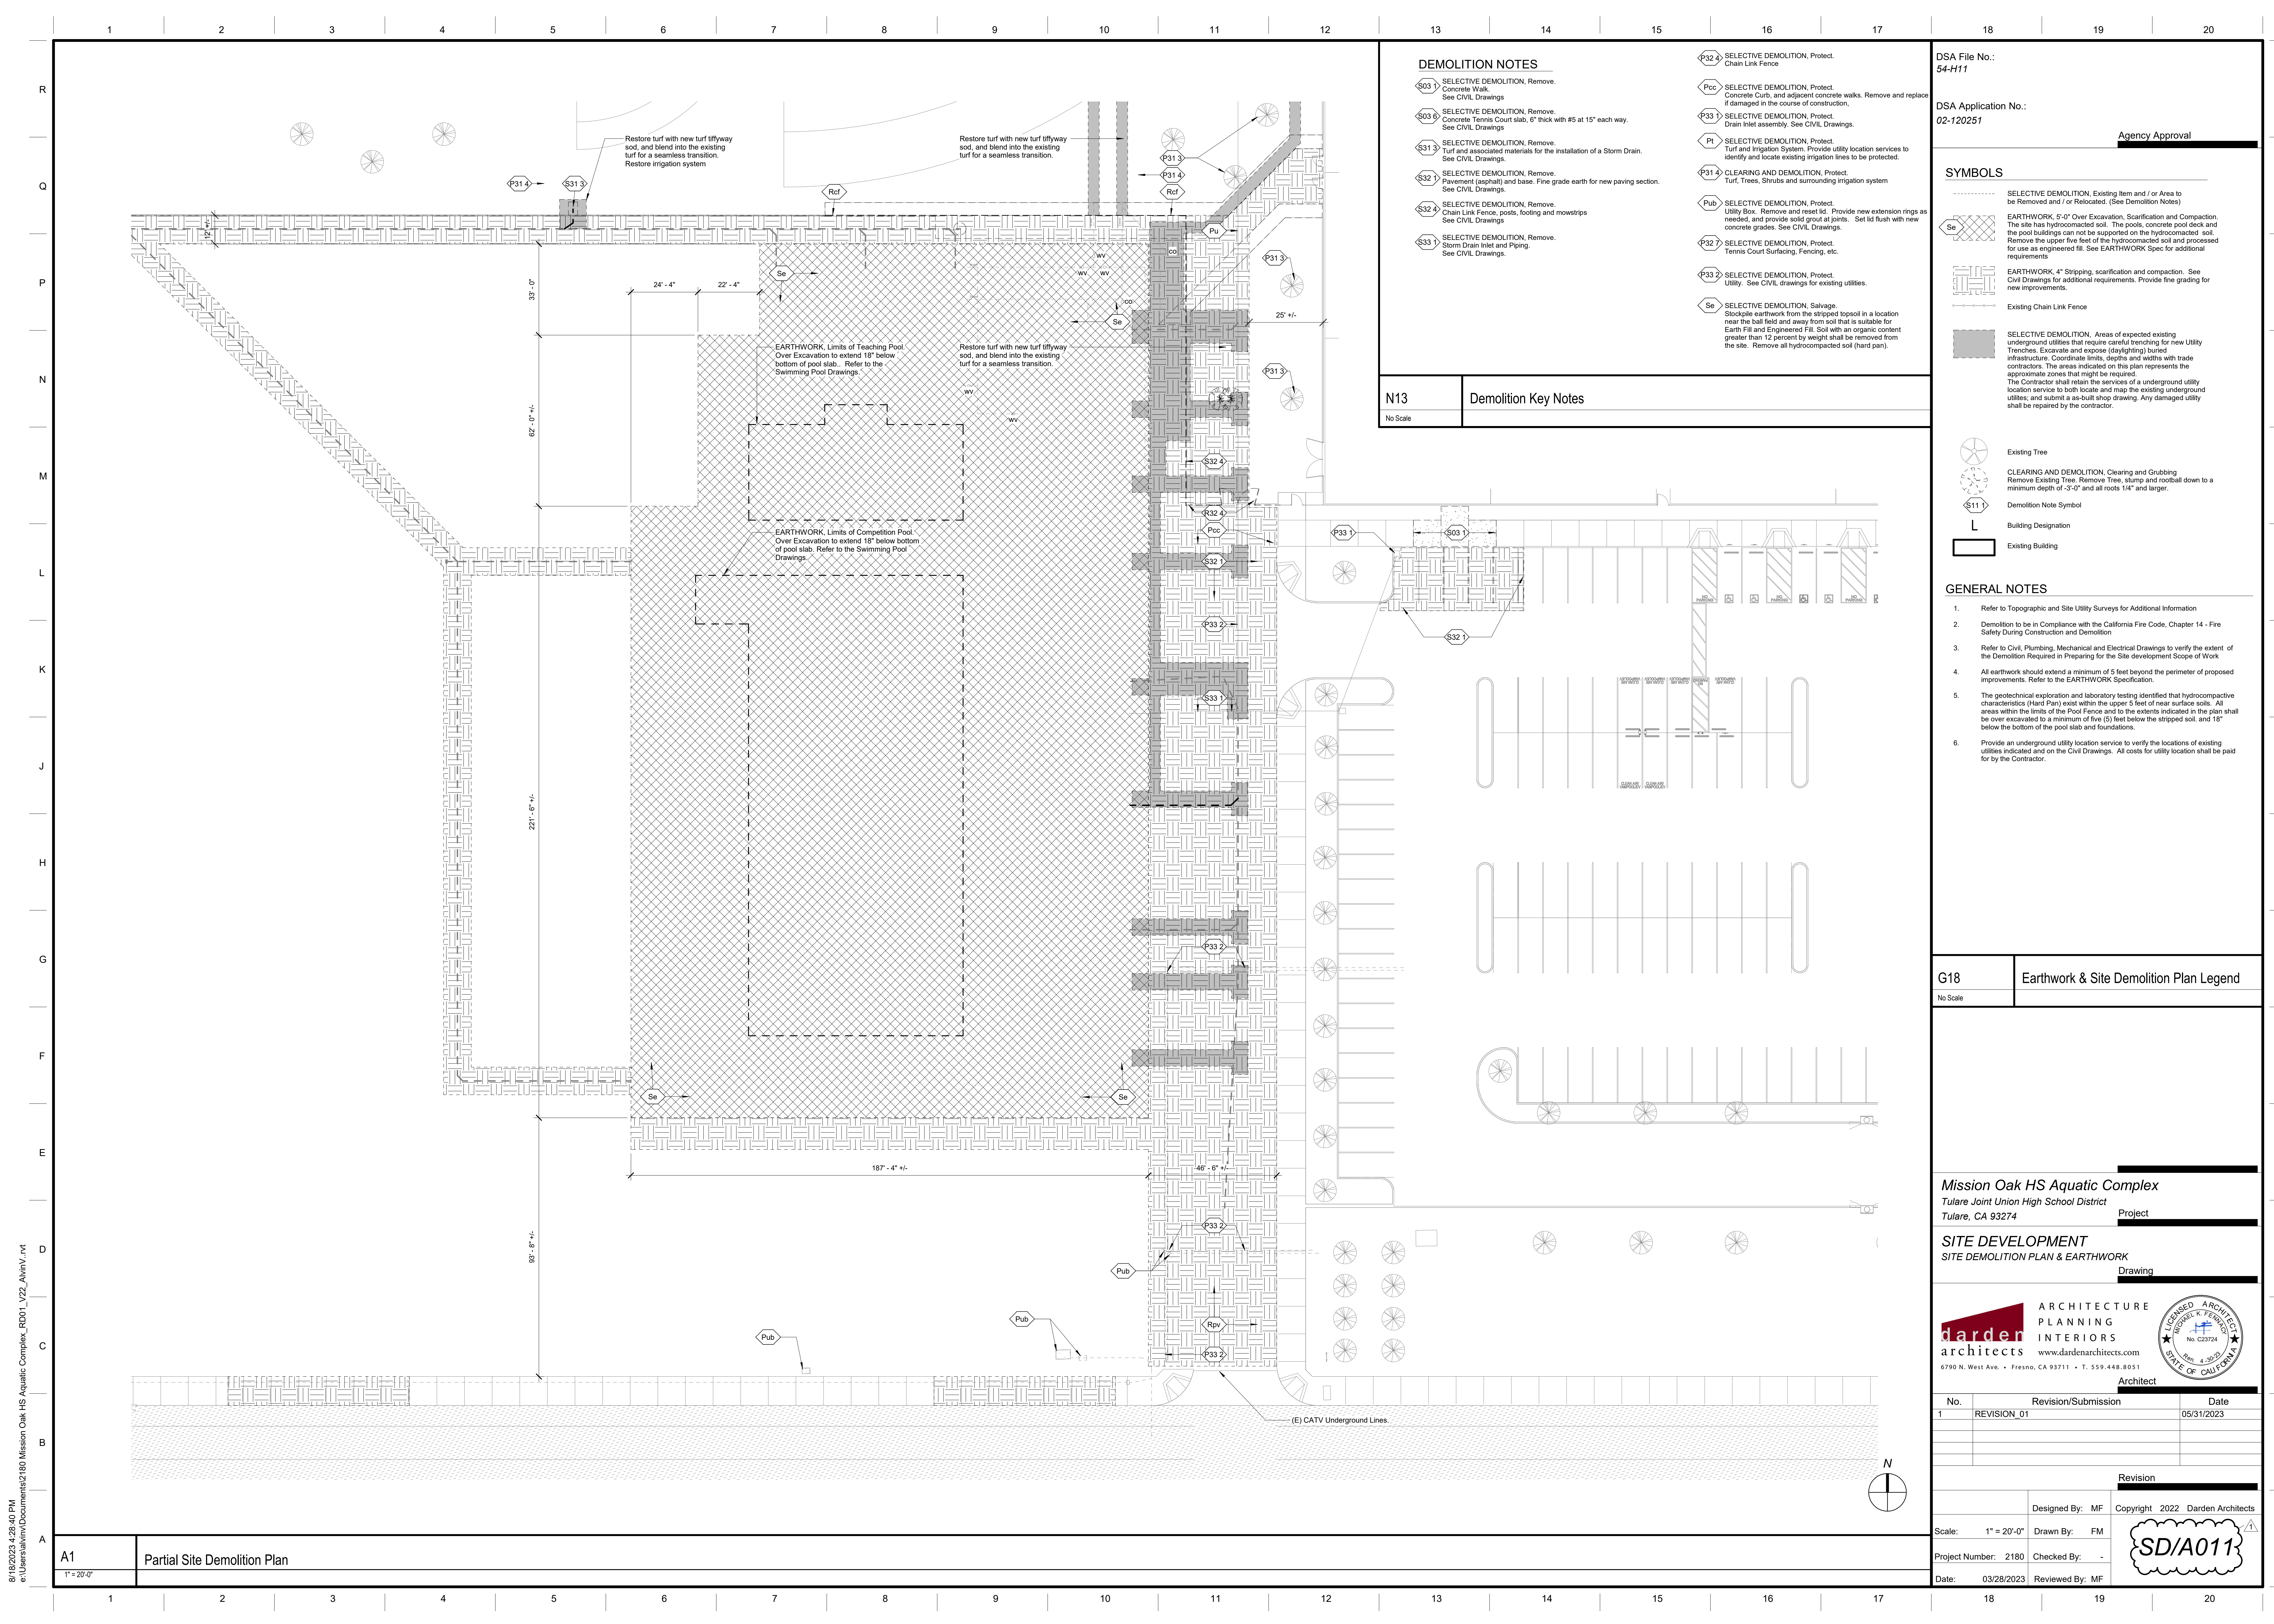

- ### DEMOLITION NOTES
- S031 SELECTIVE DEMOLITION, Remove. Concrete Walk. See CIVIL Drawings.
 - S032 SELECTIVE DEMOLITION, Remove. Concrete Tennis Court slab, 6" thick with #5 at 15" each way. See CIVIL Drawings.
 - S033 SELECTIVE DEMOLITION, Remove. Turf and associated materials for the installation of a Storm Drain. See CIVIL Drawings.
 - S034 SELECTIVE DEMOLITION, Remove. Pavement (asphalt) and base. Fine grade earth for new paving section. See CIVIL Drawings.
 - S035 SELECTIVE DEMOLITION, Remove. Chain Link Fence, posts, footing and mowstrips. See CIVIL Drawings.
 - S036 SELECTIVE DEMOLITION, Remove. Storm Drain Inlet and Piping. See CIVIL Drawings.
 - P032 SELECTIVE DEMOLITION, Protect. Chain Link Fence.
 - P033 SELECTIVE DEMOLITION, Protect. Concrete Curb, and adjacent concrete walks. Remove and replace if damaged in the course of construction.
 - P034 SELECTIVE DEMOLITION, Protect. Drain Inlet assembly. See CIVIL Drawings.
 - P1 SELECTIVE DEMOLITION, Protect. Turf and irrigation system. Provide utility location services to identify and locate existing irrigation lines to be protected.
 - P314 CLEARING AND DEMOLITION, Protect. Turf, Trees, Shrubs and surrounding irrigation system.
 - Pub SELECTIVE DEMOLITION, Protect. Utility Box. Remove and reset lid. Provide new extension rings as needed, and provide solid grout at joints. Set lid flush with new concrete grades. See CIVIL Drawings.
 - P327 SELECTIVE DEMOLITION, Protect. Tennis Court Surfacing, Fencing, etc.
 - P332 SELECTIVE DEMOLITION, Protect. Utility. See CIVIL drawings for existing utilities.
 - Se SELECTIVE DEMOLITION, Salvage. Stockpile earthwork from the stripped topsoil in a location near the ball field and away from soil that is suitable for Earth Fill and Engineered Fill. Soil with an organic content greater than 12 percent by weight shall be removed from the site. Remove all hydrocompacted soil (hard pan).

N13 Demolition Key Notes
No Scale

DSA File No.: 54-H11
 DSA Application No.: 02-120251
 Agency Approval

SYMBOLS

- SELECTIVE DEMOLITION, Existing Item and / or Area to be Removed and / or Relocated. (See Demolition Notes)
- EARTHWORK, 5'-0" Over Excavation, Scarification and Compaction. The site has hydrocompacted soil. The pools, concrete pool deck and the pool buildings can not be supported on the hydrocompacted soil. Remove the upper five feet of the hydrocompacted soil and processed for use as engineered fill. See EARTHWORK Spec for additional requirements.
- EARTHWORK, 4" Stripping, scarification and compaction. See Civil Drawings for additional requirements. Provide fine grading for new improvements.
- Existing Chain Link Fence
- SELECTIVE DEMOLITION, Areas of expected existing underground utilities that require careful fencing for new Utility Trenches. Excavate and expose (daylighting) buried infrastructure. Coordinate limits, depths and widths with trade contractors. The areas indicated on this plan represents the approximate zones that might be required. The Contractor shall retain the services of a underground utility location service to both locate and map the existing underground utilities, and submit a as-built shop drawing. Any damaged utility shall be repaired by the contractor.
- Existing Tree
- CLEARING AND DEMOLITION, Clearing and Grubbing. Remove Existing Tree, Remove Tree, stump and rootball down to a minimum depth of -3'-0" and all roots 1/4" and larger.
- Demolition Note Symbol
- Building Designation
- Existing Building

- ### GENERAL NOTES
1. Refer to Topographic and Site Utility Surveys for Additional Information
 2. Demolition to be in Compliance with the California Fire Code, Chapter 14 - Fire Safety During Construction and Demolition
 3. Refer to Civil, Plumbing, Mechanical and Electrical Drawings to verify the extent of the Demolition Required in Preparing for the Site development Scope of Work
 4. All earthwork should extend a minimum of 5 feet beyond the perimeter of proposed improvements. Refer to the EARTHWORK Specification.
 5. The geotechnical exploration and laboratory testing identified that hydrocompacted characteristics (Hard Pan) exist within the upper 5 feet of near surface soils. All areas within the limits of the Pool Fence and to the extents indicated in the plan shall be over excavated to a minimum of five (5) feet below the stripped soil, and 18" below the bottom of the pool slab and foundations.
 6. Provide an underground utility location service to verify the locations of existing utilities indicated and on the Civil Drawings. All costs for utility location shall be paid for by the Contractor.

G18 Earthwork & Site Demolition Plan Legend
No Scale

Mission Oak HS Aquatic Complex
 Tulare Joint Union High School District
 Tulare, CA 93274 Project

SITE DEVELOPMENT
 SITE DEMOLITION PLAN & EARTHWORK
 Drawing

darden ARCHITECTURE
 PLANNING
 INTERIORS
 architects www.dardenarchitects.com
 6790 N. West Ave. • Fresno, CA 93711 • T. 559.448.8051
 LICENSED ARCHITECT
 ARCHITECT C.F. No. C23724
 STATE OF CALIFORNIA
 Architect

No.	Revision/Submission	Date
1	REVISION 01	05/31/2023



Revision

Designed By: MF Copyright 2022 Darden Architects
 Scale: 1" = 20'-0" Drawn By: FM
 Project Number: 2180 Checked By: -
 Date: 03/28/2023 Reviewed By: MF

SD/A011

8/18/2023 4:28:40 PM e:\Users\alvin\Documents\180 Mission Oak HS Aquatic Complex_RD01_VZ2_A\winV.nt

A1 Partial Site Demolition Plan
1" = 20'-0"

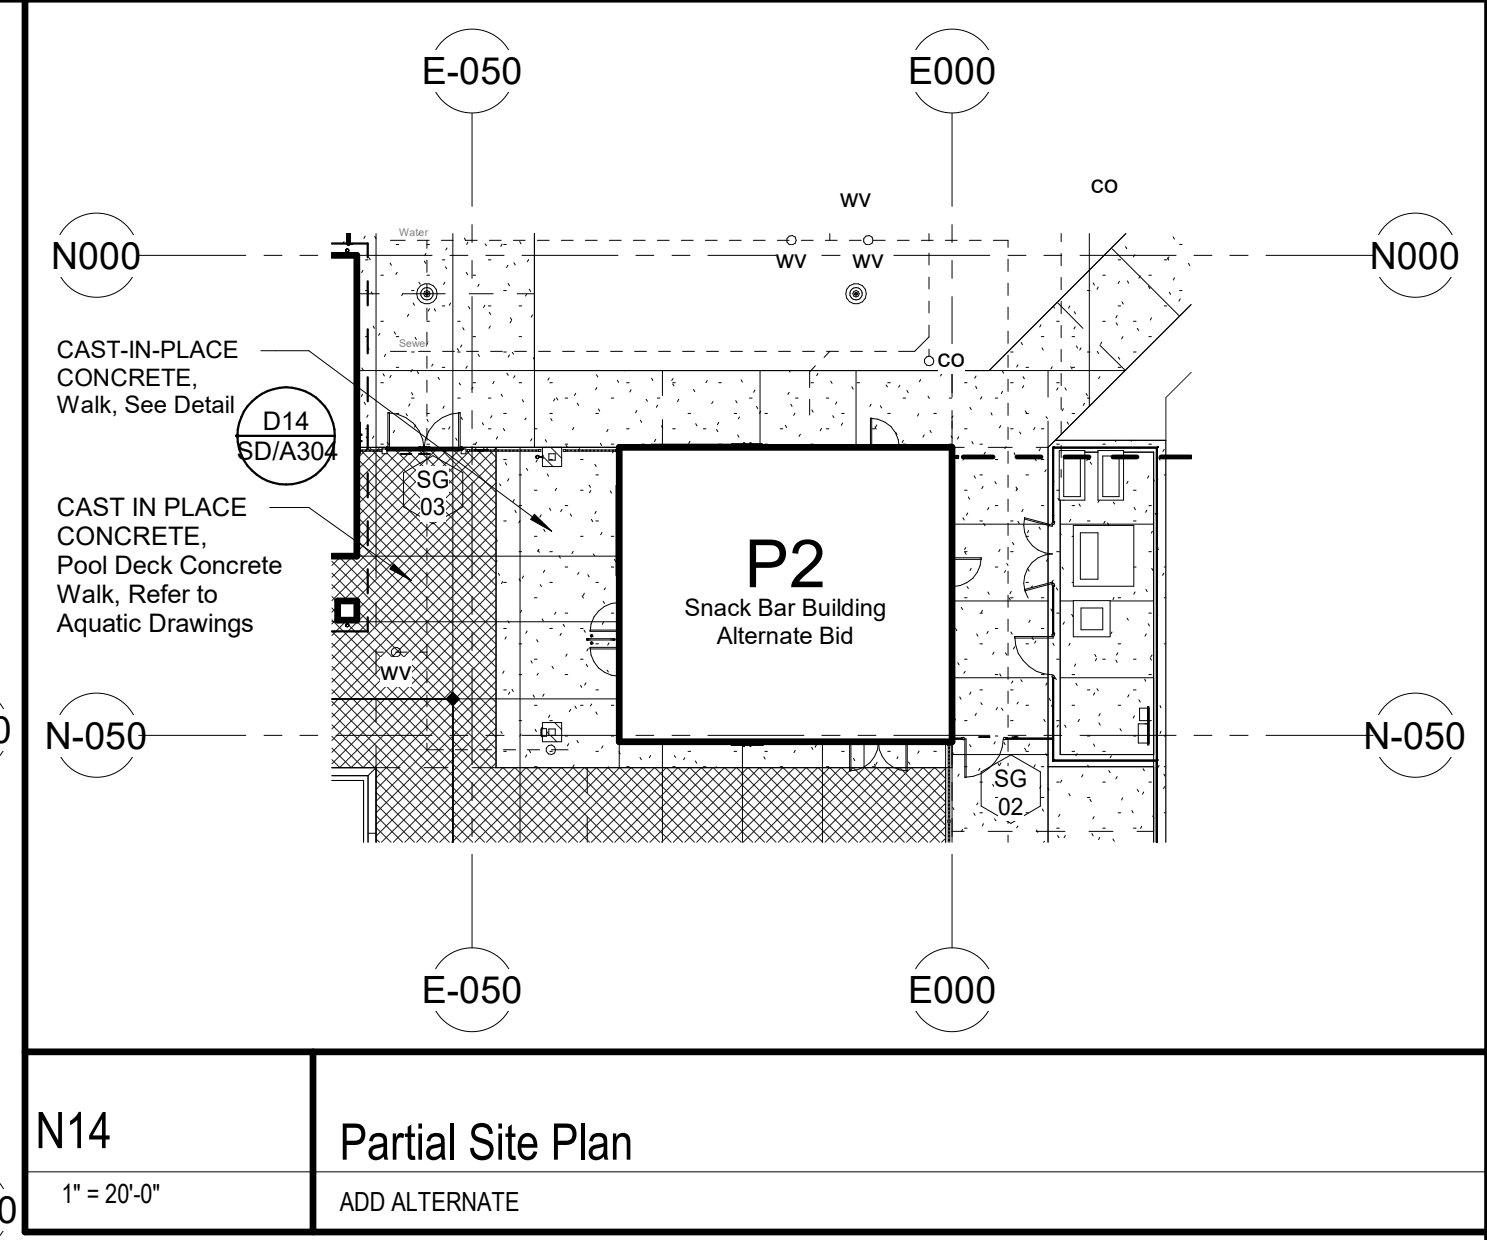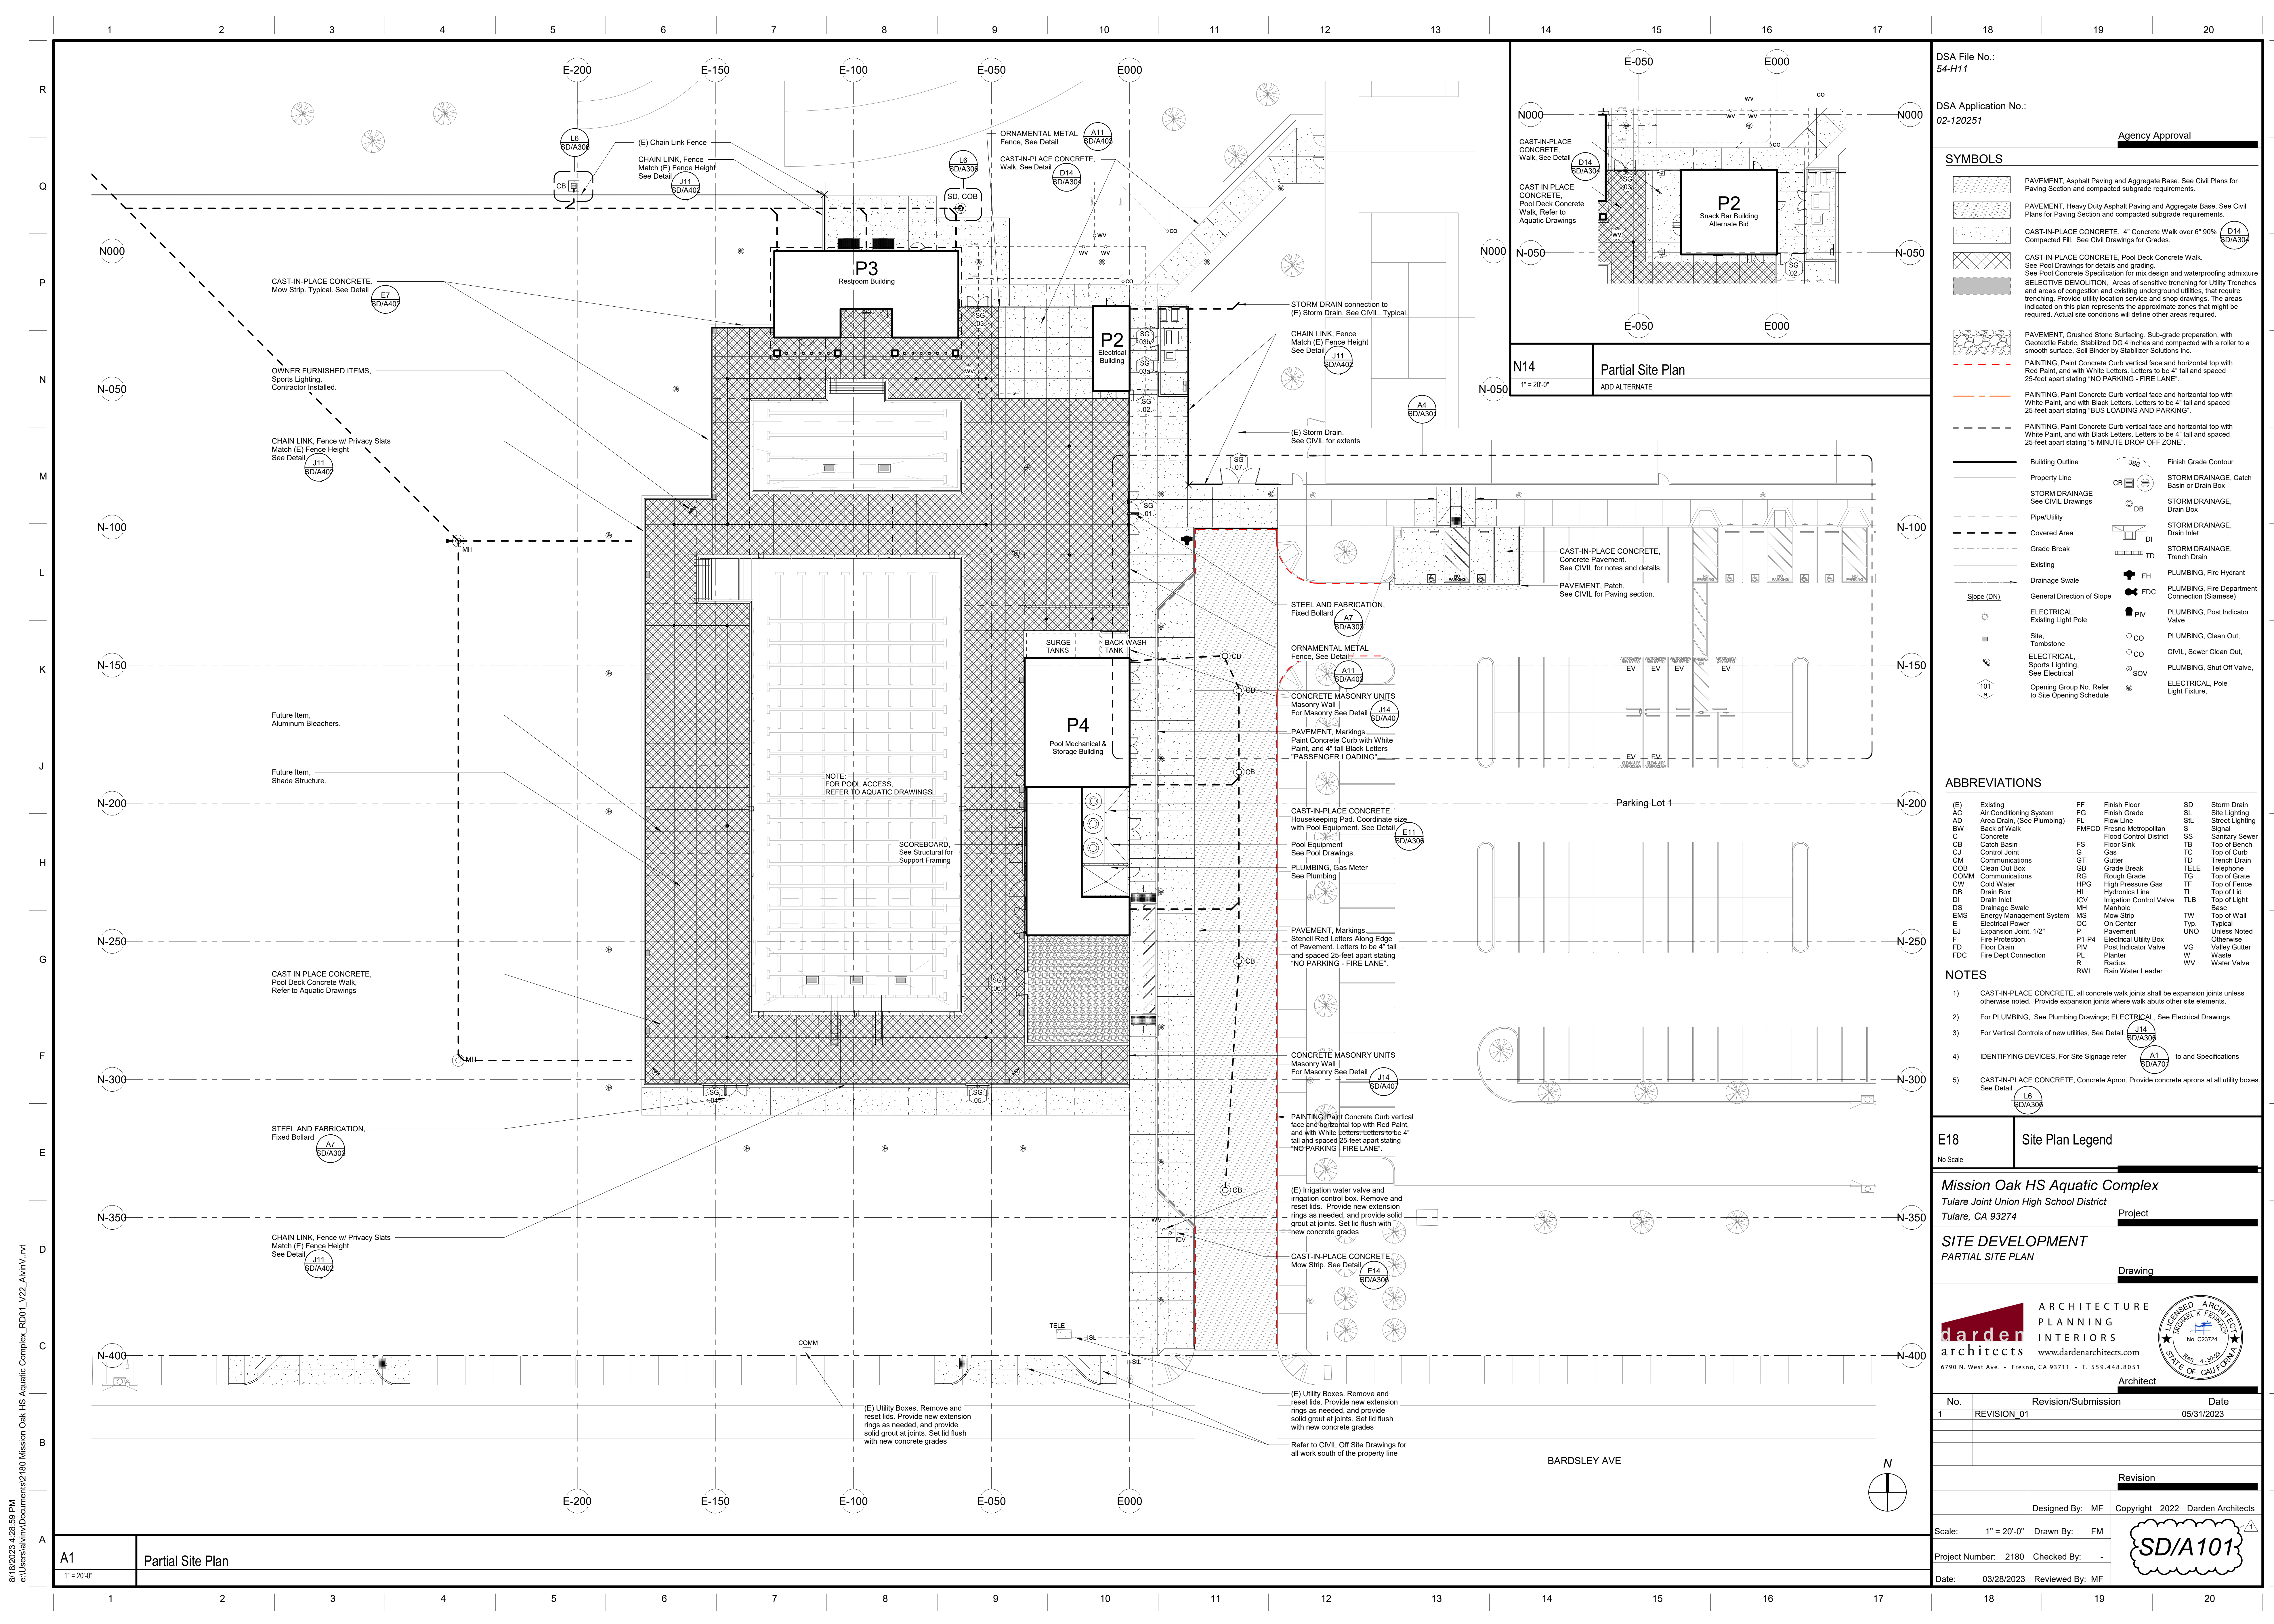

DSA File No.: 54-H11
 DSA Application No.: 02-120251
 Agency Approval

SYMBOLS

- PAVEMENT, Asphalt Paving and Aggregate Base. See Civil Plans for Paving Section and compacted subgrade requirements.
- PAVEMENT, Heavy Duty Asphalt Paving and Aggregate Base. See Civil Plans for Paving Section and compacted subgrade requirements.
- CAST-IN-PLACE CONCRETE, 4" Concrete Walk over 6" 90% Compacted Fill. See Civil Drawings for Grades.
- CAST-IN-PLACE CONCRETE, Pool Deck Concrete Walk. See Pool Drawings for details and grading.
- SELECTIVE DEMOLITION. Areas of sensitive trenching for Utility Trenches and areas of congestion and existing underground utilities, that require trenching. Provide utility location service and shop drawings. The areas indicated on this plan represents the approximate zones that might be required. Actual site conditions will define other areas required.
- PAVEMENT, Crushed Stone Surfacing. Sub-grade preparation, with Geotextile Fabric, Stabilized DG 4 inches and compacted with a roller to a smooth surface. Soil Binder by Stabilizer Solutions Inc.
- PAINTING, Paint Concrete Curb vertical face and horizontal top with Red Paint, and with White Letters. Letters to be 4" tall and spaced 25-feet apart stating "NO PARKING - FIRE LANE".
- PAINTING, Paint Concrete Curb vertical face and horizontal top with White Paint, and with Black Letters. Letters to be 4" tall and spaced 25-feet apart stating "BUS LOADING AND PARKING".
- PAINTING, Paint Concrete Curb vertical face and horizontal top with White Paint, and with Black Letters. Letters to be 4" tall and spaced 25-feet apart stating "5-MINUTE DROP OFF ZONE".

ABBREVIATIONS

(E) Existing	FF Finish Floor	SD Storm Drain
AC Air Conditioning System	FG Finish Grade	SL Site Lighting
AD Area Drain, (See Plumbing)	FL Flow Line	SLR Street Lighting
BW Back of Walk	FM/CD Fresno Metropolitan Flood Control District	S Signal
C Concrete	FS Floor Sink	SS Sanitary Sewer
CB Catch Basin	G Gas	TB Top of Bench
CJ Control Joint	GT Gutter	TD Top of Drain
CM Communications	GB Grade Break	TELE Telephone
COB Clean Out Box	RC Rough Grade	TF Top of Fence
COMM Communications	HFG High Pressure Gas	TL Top of Lid
CW Cold Water	HL Hydronics Line	TLB Top of Light Base
DB Drain Box	ICV Irrigation Control Valve	UNO Unless Noted
DI Drain Inlet	MH Manhole	VG Valley Gutter
DS Drainage Swale	MS Mow Strip	W Waste
EMS Energy Management System	OC On Center	WV Water Valve
E Electrical Power	P Pavement	
EJ Expansion Joint, 1/2"	P1-P4 Electrical Utility Box	
FP Fire Protection	PV Post Indicator Valve	
F Floor Drain	PL Planter	
FDC Fire Dept Connection	R Radius	
	RWL Rain Water Leader	

NOTES

- CAST-IN-PLACE CONCRETE, all concrete walk joints shall be expansion joints unless otherwise noted. Provide expansion joints where walk abuts other site elements.
- For PLUMBING, See Plumbing Drawings; ELECTRICAL, See Electrical Drawings.
- For Vertical Controls of new utilities, See Detail J14 (SD/A308).
- IDENTIFYING DEVICES, For Site Signage refer to A1 (SD/A70) and to Specifications.
- CAST-IN-PLACE CONCRETE, Concrete Apron. Provide concrete aprons at all utility boxes. See Detail L6 (SD/A308).

E18 Site Plan Legend

No Scale

Mission Oak HS Aquatic Complex
 Tulare Joint Union High School District
 Tulare, CA 93274 Project

SITE DEVELOPMENT
 PARTIAL SITE PLAN

ARCHITECTURE
darden PLANNING INTERIORS
 architects www.dardenarchitects.com
 6790 N. West Ave. • Fresno, CA 93711 • T. 559.448.8051

ARCHITECT

No.	Revision/Submission	Date
1	REVISION 01	05/31/2023



Revision

Designed By: MF Copyright 2022 Darden Architects
 Drawn By: FM
 Project Number: 2180 Checked By: -
 Date: 03/28/2023 Reviewed By: MF

Scale: 1" = 20'-0"

SD/A101

8/18/2023 4:28:59 PM e:\Users\alvin\Documents\c180 Mission Oak HS Aquatic Complex_RD01_VZ2_A\InV.nt

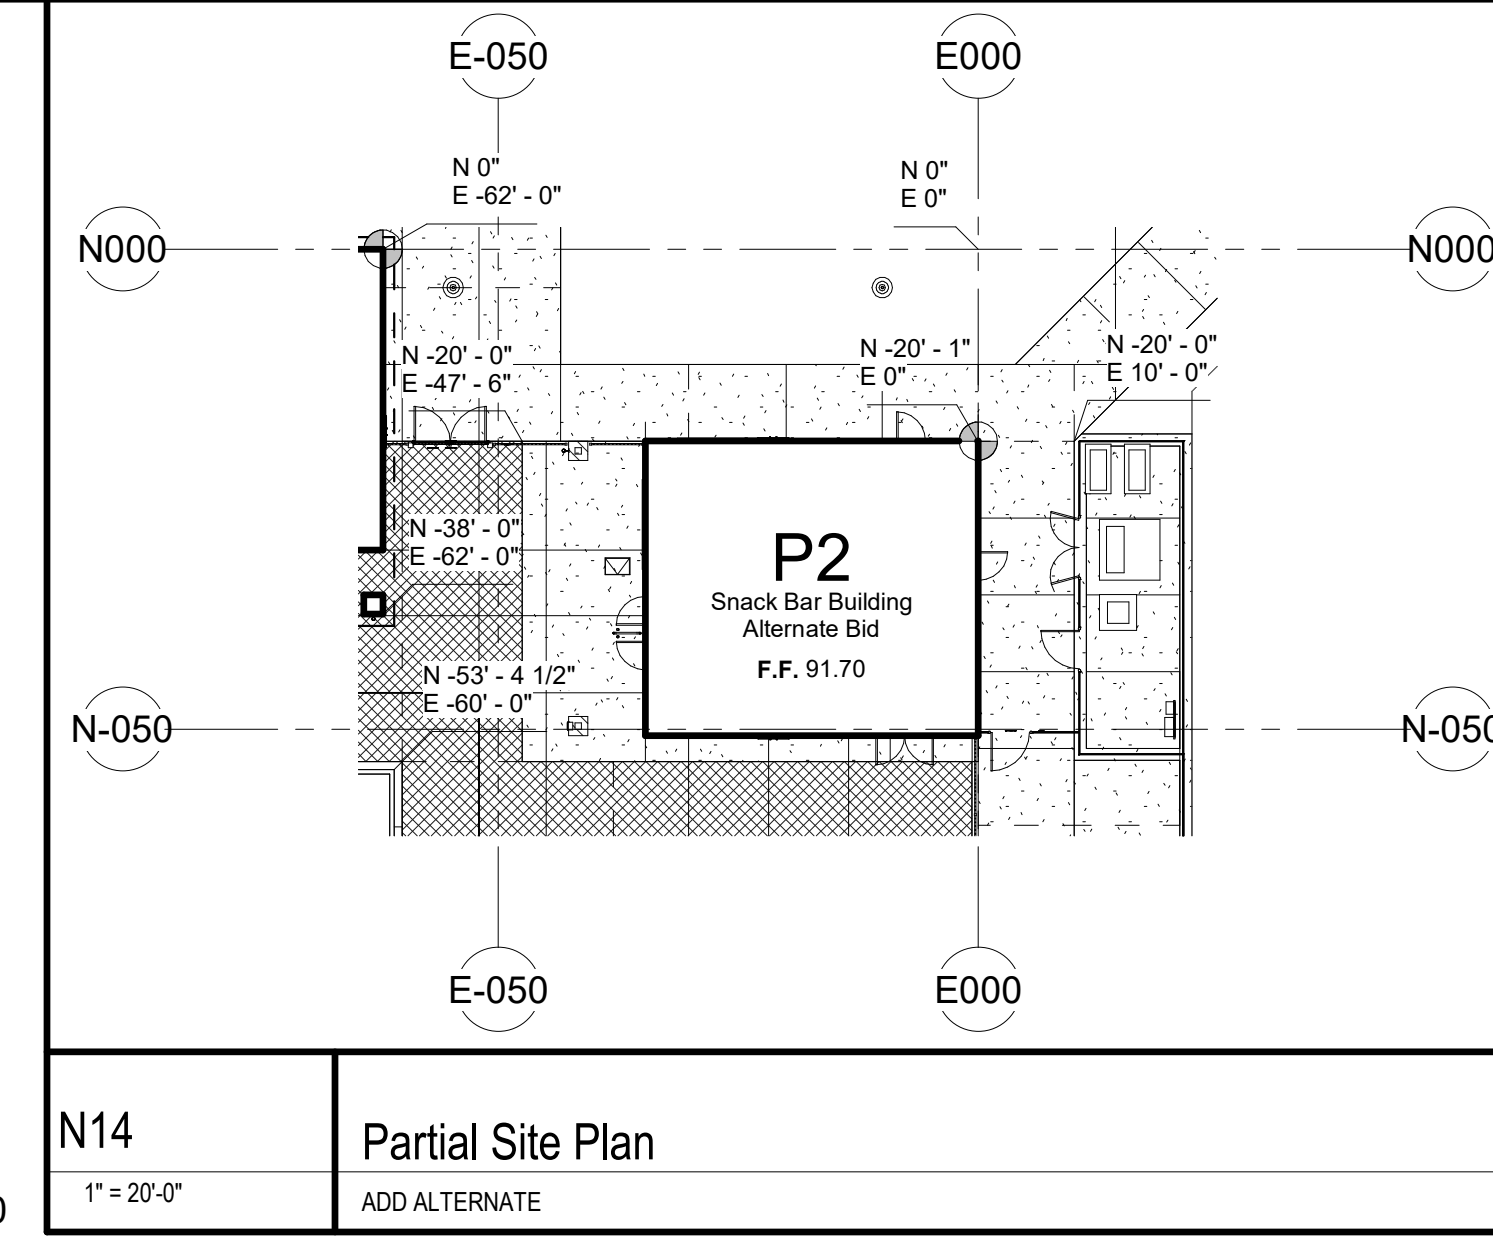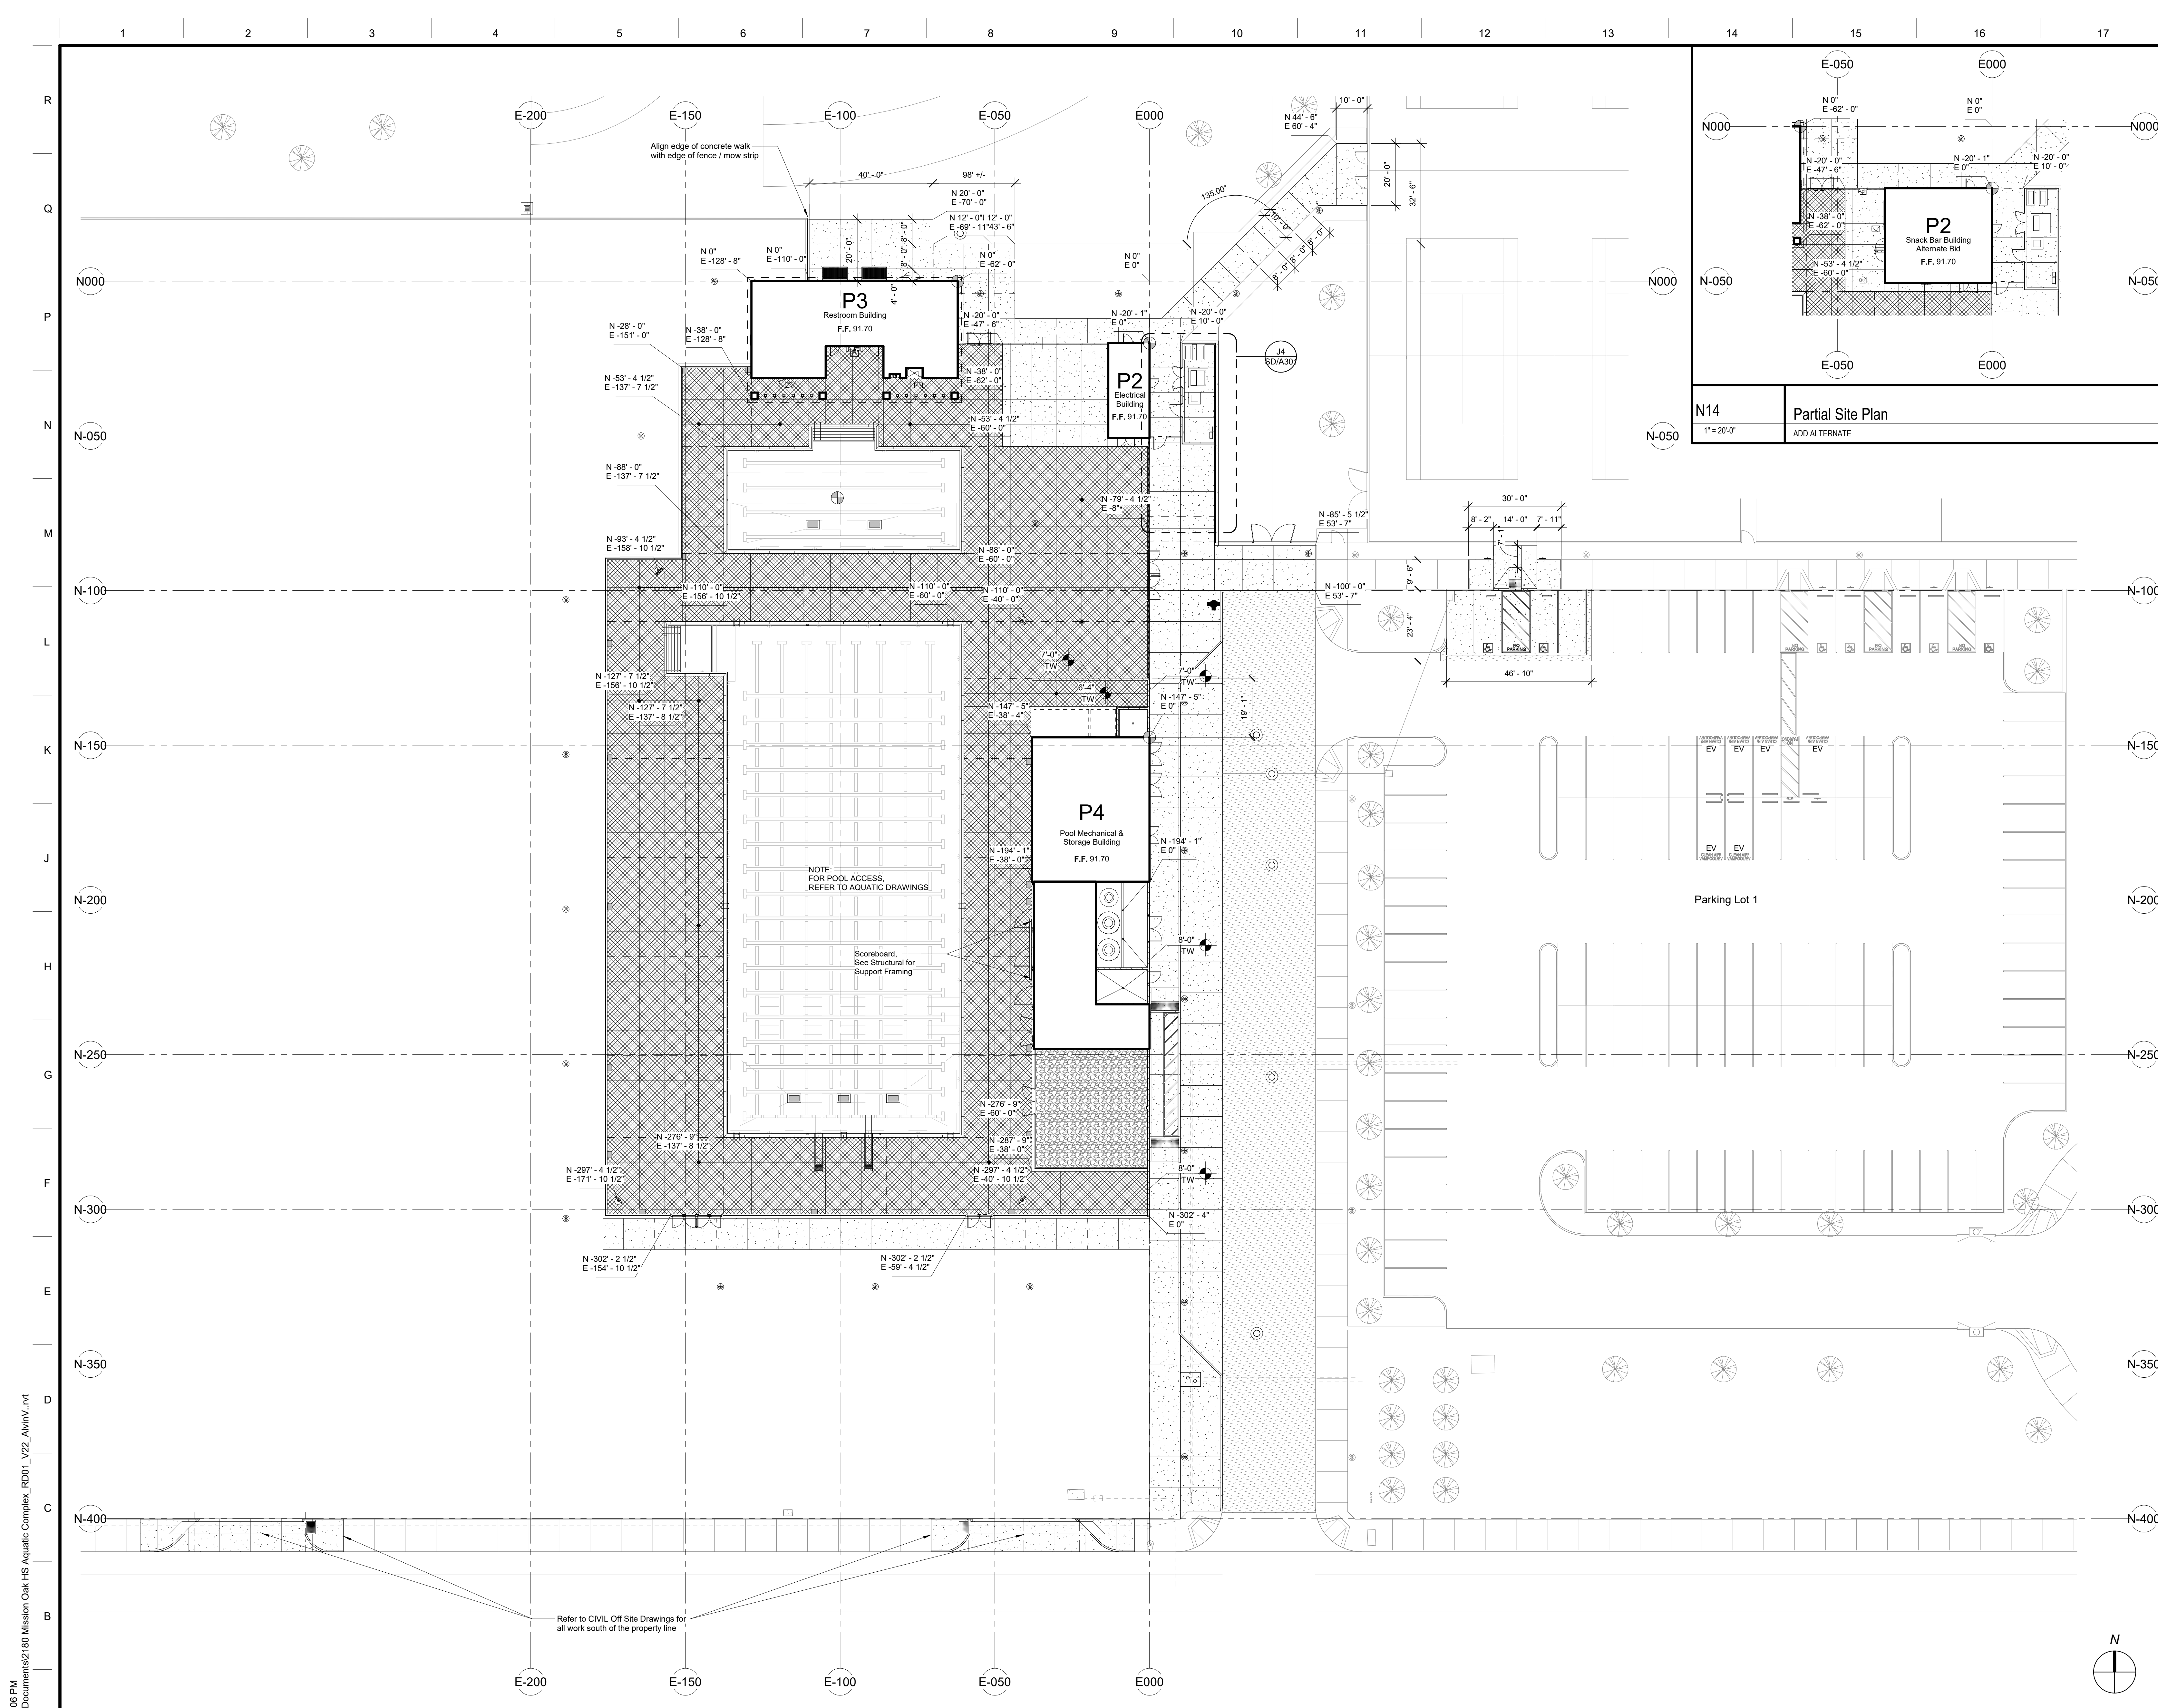

DSA File No.: 54-H11
DSA Application No.: 02-120251

Agency Approval

SYMBOLS

- PAVEMENT, Asphalt Paving and Aggregate Base. See Civil Plans for Paving Section and compacted subgrade requirements.
- PAVEMENT, Heavy Duty Asphalt Paving and Aggregate Base. See Civil Plans for Paving Section and compacted subgrade requirements.
- CAST-IN-PLACE CONCRETE, 4" Concrete Walk over 6" 90% Compacted Fill. See Civil Drawings for Grades.
- CAST-IN-PLACE CONCRETE, Pool Deck Concrete Walk. See Pool Drawings for details and grading.
- SELECTIVE DEMOLITION. Areas of sensitive trenching for Utility Trenches and areas of congestion and existing underground utilities, that require trenching. Provide utility location service and shop drawings. The areas indicated on this plan represents the approximate zones that might be required. Actual site conditions will define other areas required.
- PAVEMENT, Crushed Stone Surfacing. Sub-grade preparation, with Geotextile Fabric, Stabilized DG 4 inches and compacted with a roller to a smooth surface. Soil Binder by Stabilizer Solutions Inc.
- PAINTING, Paint Concrete Curb vertical face and horizontal top with Red Paint, and with White Letters. Letters to be 4" tall and spaced 25-feet apart stating "NO PARKING - FIRE LANE".
- PAINTING, Paint Concrete Curb vertical face and horizontal top with White Paint, and with Black Letters. Letters to be 4" tall and spaced 25-feet apart stating "BUS LOADING AND PARKING".
- PAINTING, Paint Concrete Curb vertical face and horizontal top with White Paint, and with Black Letters. Letters to be 4" tall and spaced 25-feet apart stating "5-MINUTE DROP OFF ZONE".

ABBREVIATIONS

(E) Existing	FF Finish Floor	SD Storm Drain
AC Air Conditioning System	FG Finish Grade	SL Site Lighting
AD Area Drain, (See Plumbing)	FL Flow Line	SLR Street Lighting
BW Back of Walk	FMFCD Fresno Metropolitan Flood Control District	S Signal
C Concrete	FS Floor Sink	SS Sanitary Sewer
CB Catch Basin	G Gas	TB Top of Bench
CJ Control Joint	GT Gutter	TC Top of Curb
CM Communications	GB Grade Break	TD Trench Drain
COB Clean Out Box	RC Rough Grade	TG Top of Grade
COMM Communications	HG High Pressure Gas	TF Top of Fence
CW Cold Water	HL Hydronics Line	TL Top of Lid
DB Drain Box	ICV Irrigation Control Valve	TLB Top of Light Base
DI Drain Inlet	MH Manhole	TW Top of Wall
DS Drainage Swale	MS Mow Strip	Typ Typical
EMS Energy Management System	OC On Center	UNO Unless Noted
E Electrical Power	P Pavement	Other Otherwise
EJ Expansion Joint, 1/2"	P1-P4 Electrical Utility Box	VG Valley Gutter
F Fire Protection	Piv Post Indicator Valve	W Waste
FD Floor Drain	PL Planter	WV Water Valve
FDC Fire Dept Connection	R Radius	
	RWL Rain Water Leader	

NOTES

- CAST-IN-PLACE CONCRETE, all concrete walk joints shall be expansion joints unless otherwise noted. Provide expansion joints where walk abuts other site elements.
- For PLUMBING, See Plumbing Drawings; ELECTRICAL, See Electrical Drawings.
- For Vertical Controls of new utilities, See Detail J14 (SD/A306).
- IDENTIFYING DEVICES, For Site Signage refer to A1 (SD/A170) and to Specifications.
- CAST-IN-PLACE CONCRETE, Concrete Apron. Provide concrete apron at all utility boxes. See Detail L6 (SD/A306).

E18 Site Plan Legend

No Scale

Mission Oak HS Aquatic Complex
Tulare Joint Union High School District
Tulare, CA 93274 Project

SITE DEVELOPMENT
PARTIAL SITE DIMENSION PLAN
Drawing

darden ARCHITECTURE
PLANNING
INTERIORS
architects www.dardenarchitects.com
6790 N. West Ave. • Fresno, CA 93711 • T. 559.448.8051
Architect

No.	Revision/Submission	Date
1	REVISION 01	05/31/2023

Revision

Designed By: MF
Copyright 2022 Darden Architects

Scale: 1" = 20'-0"
Project Number: 2180
Date: 03/28/2023

Drawn By: FM
Checked By: -
Reviewed By: MF



8/18/2023 4:29:06 PM
e:\Users\alvin\Documents\180 Mission Oak HS Aquatic Complex_R01_VZ2_A\Inv.vnt

DSA File No.: 54-H11
DSA Application No.: 02-120251
Agency Approval

SYMBOLS

	PAVEMENT, Asphalt Paving and Aggregate Base. See Civil Plans for Paving Section and compacted subgrade requirements.
	PAVEMENT, Heavy Duty Asphalt Paving and Aggregate Base. See Civil Plans for Paving Section and compacted subgrade requirements.
	CAST-IN-PLACE CONCRETE, 4" Concrete Walk over 6" 90% Compacted Fill. See Civil Drawings for Grades.
	CAST-IN-PLACE CONCRETE, Pool Deck Concrete Walk. See Pool Drawings for details and grading.
	SELECTIVE DEMOLITION. Areas of sensitive trenching for Utility Trenches and areas of congestion and existing underground utilities, that require trenching. Provide utility location service and shop drawings. The areas indicated on this plan represents the approximate zones that might be required. Actual site conditions will define other areas required.
	PAVEMENT, Crushed Stone Surfacing. Sub-grade preparation, with Geotextile Fabric, Stabilized DG 4 inches and compacted with a roller to a smooth surface. Soil Binder by Stabilizer Solutions Inc.
	PAINTING, Paint Concrete Curb vertical face and horizontal top with Red Paint, and with White Letters. Letters to be 4" tall and spaced 25-feet apart stating "NO PARKING - FIRE LANE".
	PAINTING, Paint Concrete Curb vertical face and horizontal top with White Paint, and with Black Letters. Letters to be 4" tall and spaced 25-feet apart stating "BUS LOADING AND PARKING".
	PAINTING, Paint Concrete Curb vertical face and horizontal top with White Paint, and with Black Letters. Letters to be 4" tall and spaced 25-feet apart stating "5-MINUTE DROP OFF ZONE".
	Building Outline
	Property Line
	STORM DRAINAGE, Catch Basin or Drain Box
	STORM DRAINAGE, Drain Box
	STORM DRAINAGE, Drain Inlet
	STORM DRAINAGE, Trench Drain
	PLUMBING, Fire Hydrant
	PLUMBING, Fire Department Connection (Siamese)
	PLUMBING, Post Indicator Valve
	PLUMBING, Clean Out
	CIVIL, Sewer Clean Out
	PLUMBING, Shut Off Valve
	ELECTRICAL, Pole Light Fixture
	Finish Grade Contour
	STORM DRAINAGE, Catch Basin or Drain Box
	STORM DRAINAGE, Drain Box
	STORM DRAINAGE, Drain Inlet
	STORM DRAINAGE, Trench Drain
	PLUMBING, Fire Hydrant
	PLUMBING, Fire Department Connection (Siamese)
	PLUMBING, Post Indicator Valve
	PLUMBING, Clean Out
	CIVIL, Sewer Clean Out
	PLUMBING, Shut Off Valve
	ELECTRICAL, Pole Light Fixture

ABBREVIATIONS

(E) Existing	FF Finish Floor	SD Storm Drain
AC Air Conditioning System	FG Finish Grade	SL Site Lighting
AD Area Drain (See Plumbing)	FL Flow Line	SIL Street Lighting
BW Back of Walk	FMFCD Fresno Metropolitan Flood Control District	S Signal
C Concrete	FS Floor Sink	SS Sanitary Sewer
CB Catch Basin	G Gas	TB Top of Bench
CJ Control Joint	GT Gutter	TC Top of Curb
CM Communications	GB Grade Break	TD Trench Drain
COB Clean Out Box	RG Rough Grade	TELE Telephone
COMM Communications	HFG High Pressure Gas	TG Top of Grate
CW Cold Water	HL Hydronics Line	TF Top of Fence
DB Drain Box	ICV Irrigation Control Valve	TL Top of Lid
DI Drain Inlet	MH Manhole	TLB Top of Light Base
DS Drainage Swale	MS Mow Strip	TW Top of Wall
EMS Energy Management System	OC On Center	Typ Typical
E Electrical Power	P Pavement	UNO Unless Noted
EJ Expansion Joint, 1/2"	P1-P4 Electrical Utility Box	Other Otherwise
F Fire Protection	PIV Post Indicator Valve	VG Valley Gutter
FD Floor Drain	PL Planter	W Waste
FDC Fire Dept Connection	R Radius	WV Water Valve
	RWL Rain Water Leader	

- NOTES**
- CAST-IN-PLACE CONCRETE, all concrete walk joints shall be expansion joints unless otherwise noted. Provide expansion joints where walk abuts other site elements.
 - For PLUMBING, See Plumbing Drawings; ELECTRICAL, See Electrical Drawings.
 - For Vertical Controls of new utilities, See Detail J14 SD/A304
 - IDENTIFYING DEVICES, For Site Signage refer to and Specifications A1 SD/A70
 - CAST-IN-PLACE CONCRETE, Concrete Apron. Provide concrete aprons at all utility boxes. See Detail L6 SD/A304

E18 Site Plan Legend
No Scale

Mission Oak HS Aquatic Complex
Tulare Joint Union High School District
Tulare, CA 93274 Project


SITE DEVELOPMENT
ENLARGED SITE PLANS
Drawing

ARCHITECTURE PLANNING INTERIORS
www.dardenarchitects.com
6790 N. West Ave. • Fresno, CA 93711 • T. 559.448.8051
Architect


No.	Revision/Submission	Date
1	REVISION_01	05/31/2023

Revision


Designed By: MF
Copyright © 2022 Darden Architects
Scale: As indicated
Drawn By: FM
Project Number: 2180
Checked By: -
Date: 03/28/2023
Reviewed By: MF

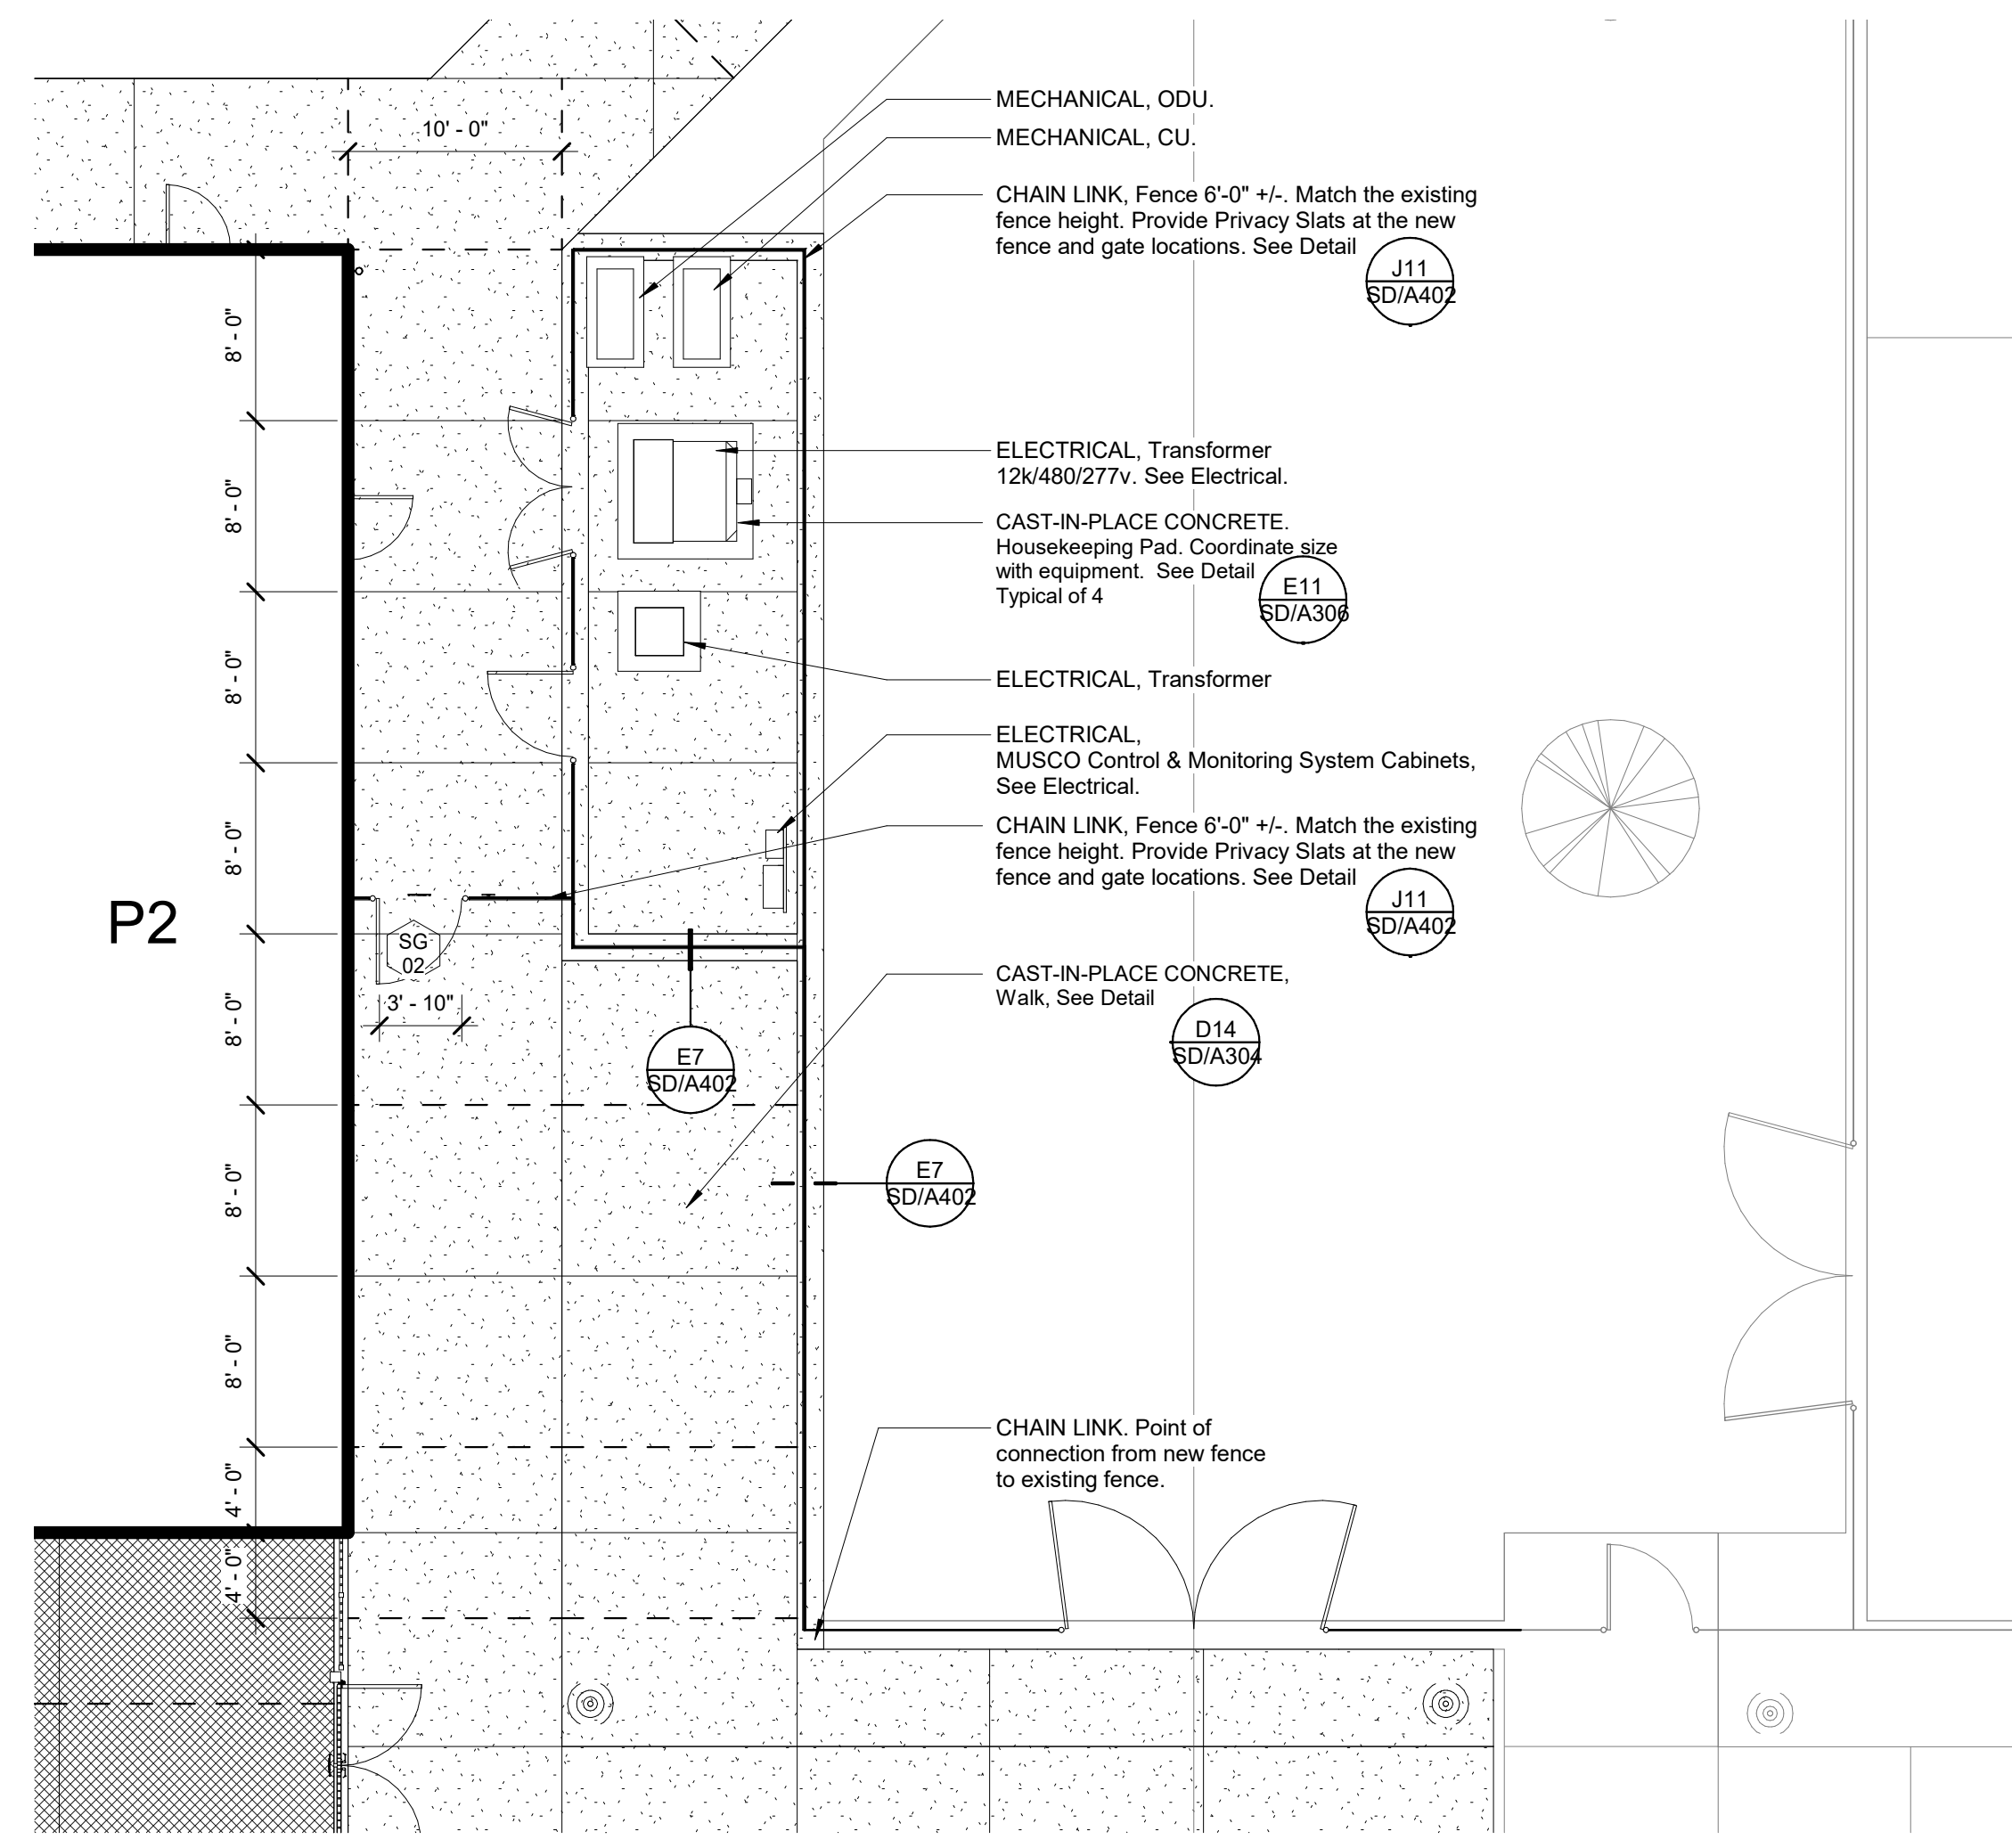

J4 Partial Site Plan, Chain Link Enclosure
1/8" = 1'-0"

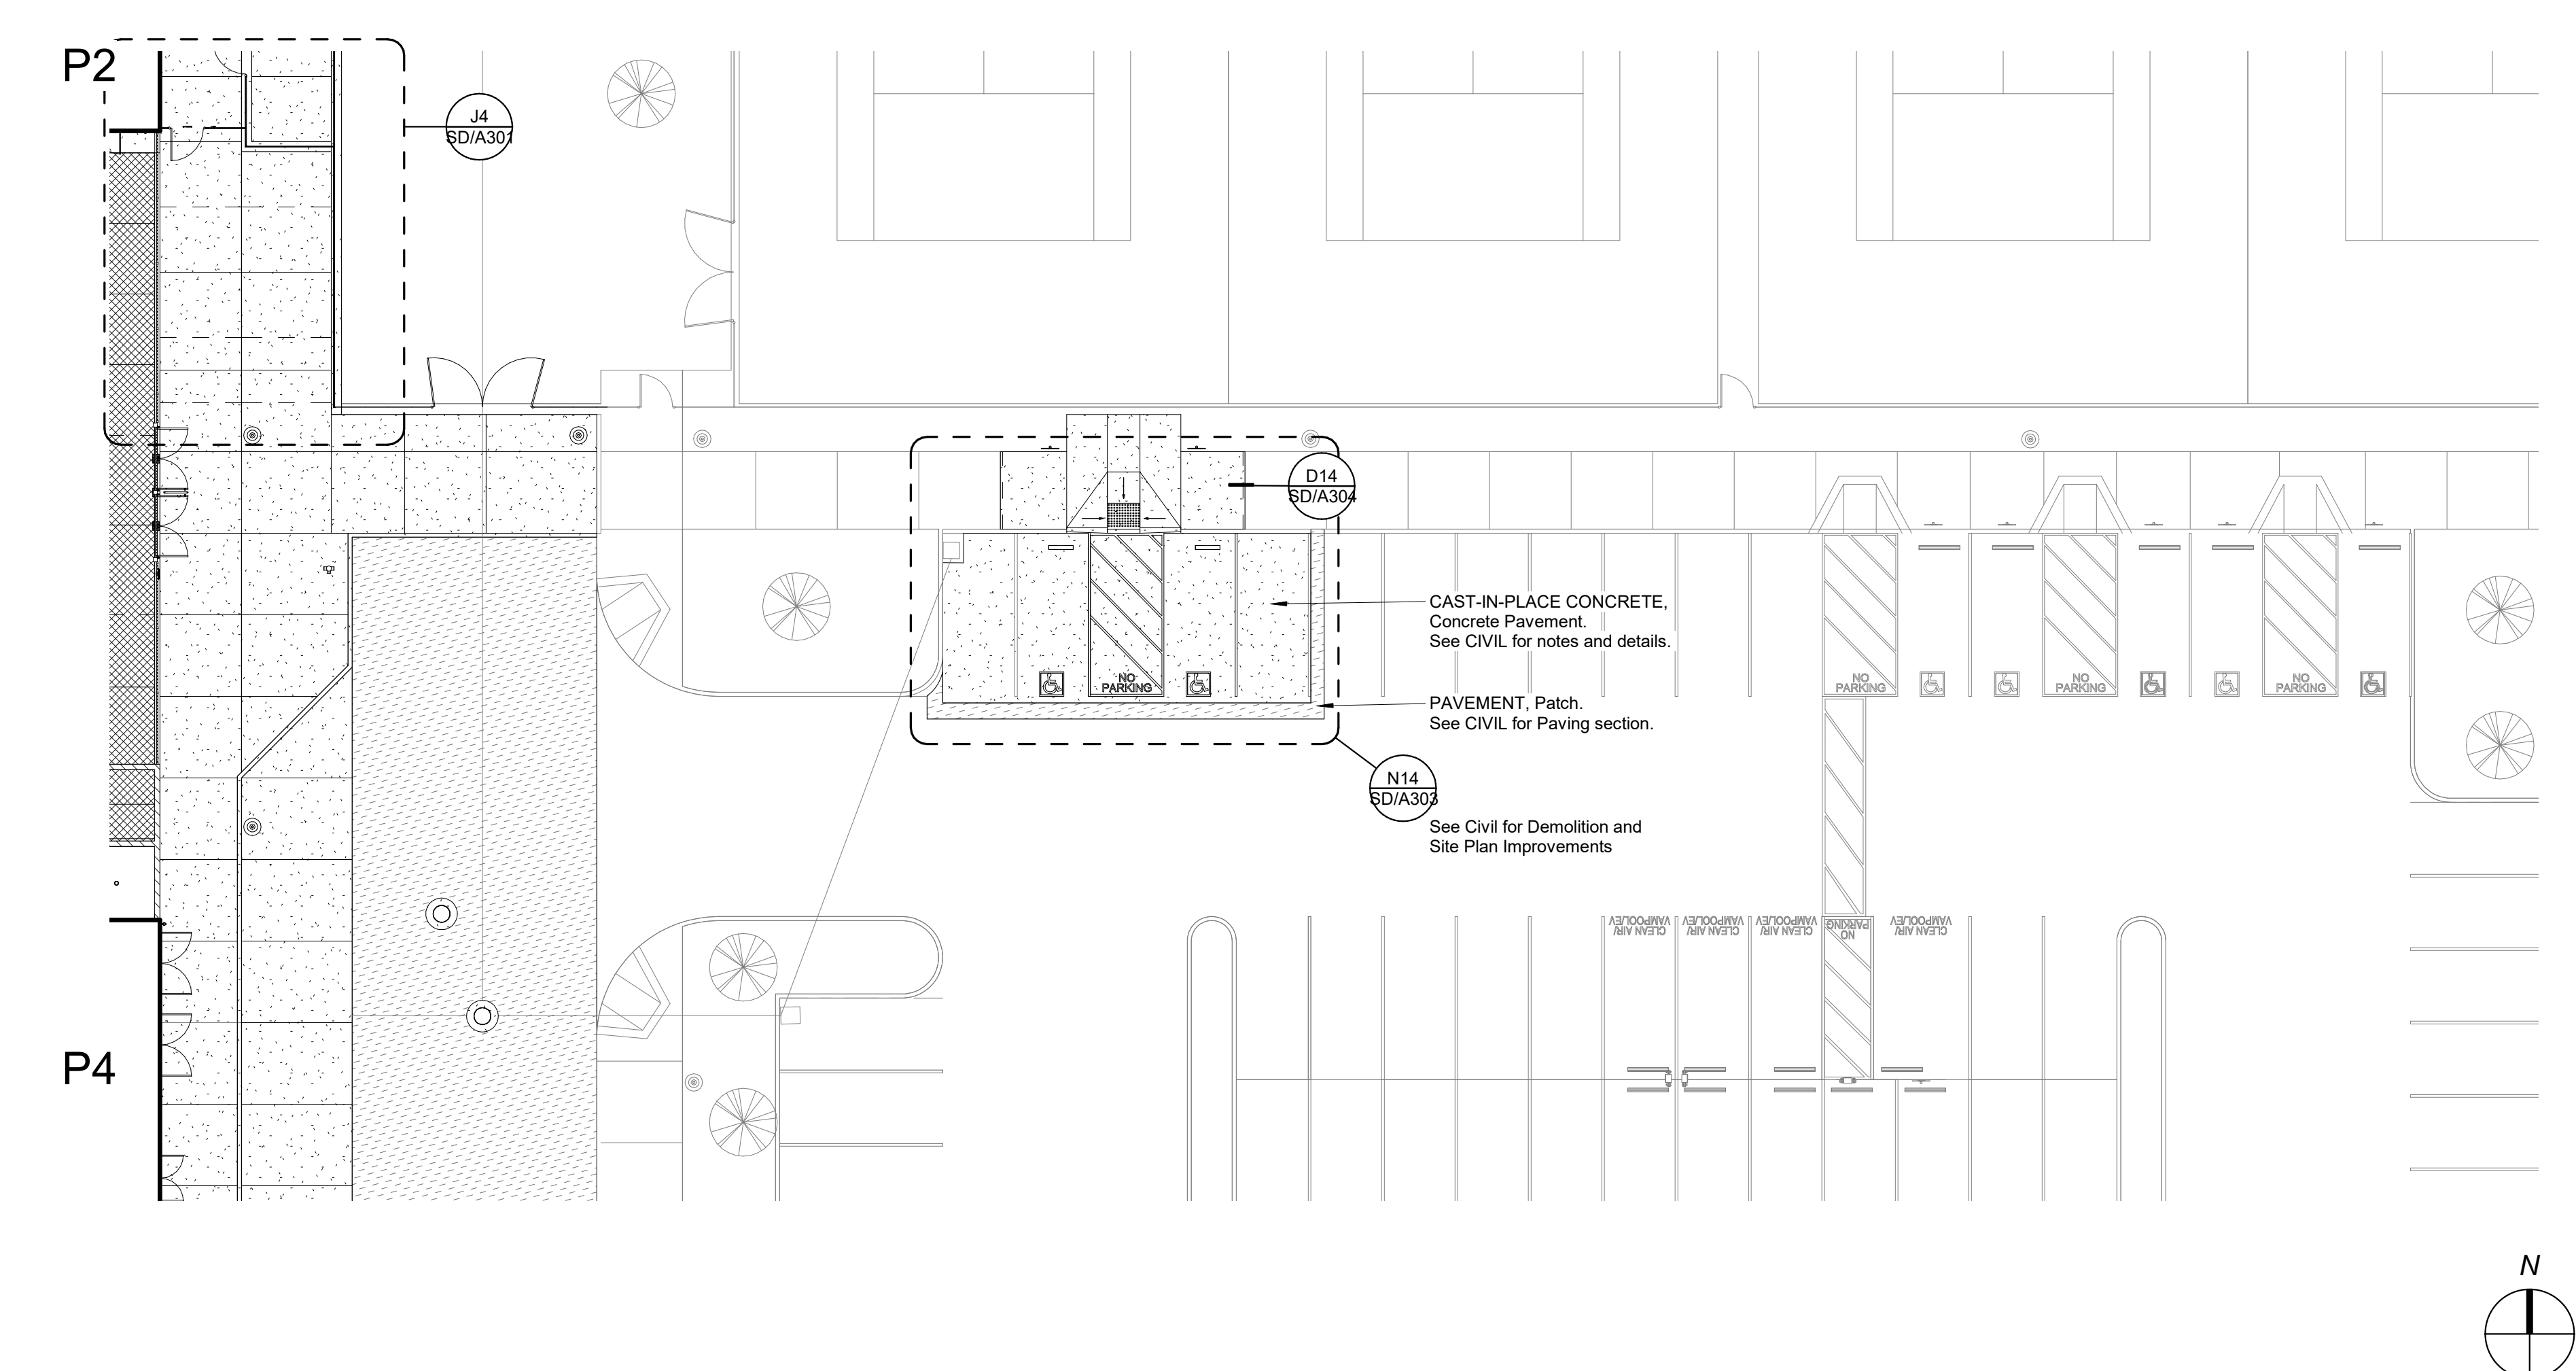

A4 Enlarges Site Plan, Accessible Parking
1/16" = 1'-0"

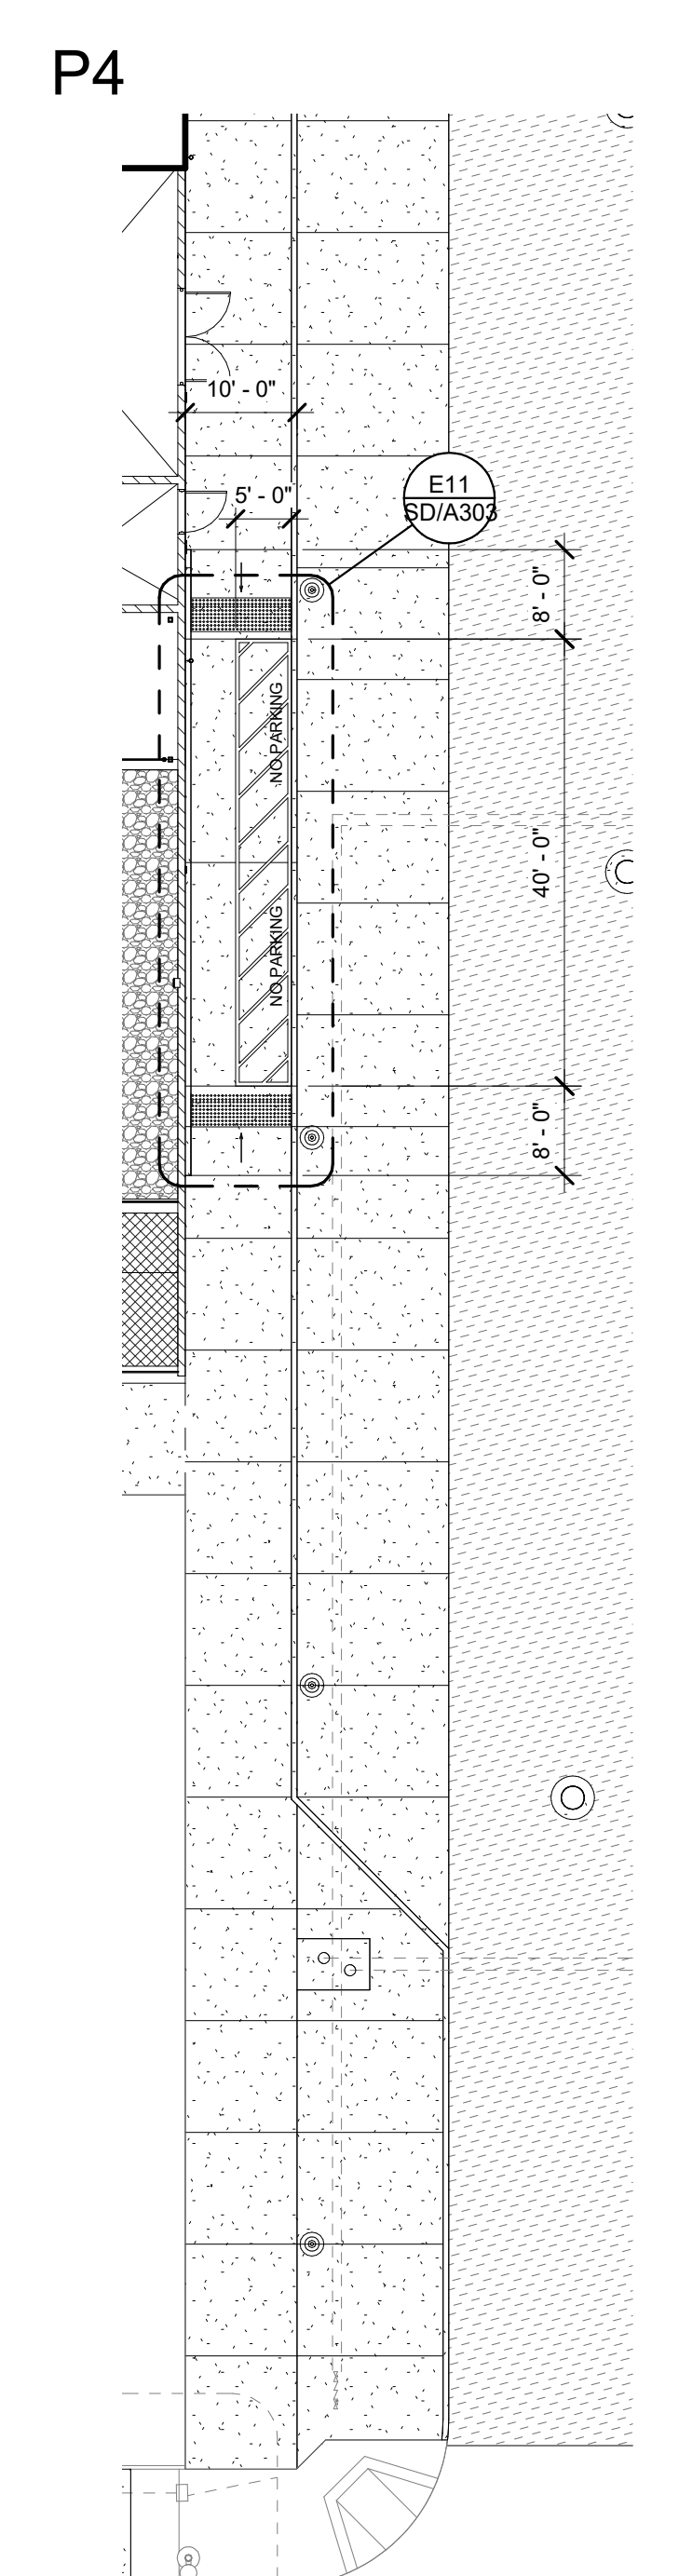

A14 Enlarged Site Plan, Bus Drop Off Lane
1/16" = 1'-0"

8/18/2023 4:29:11 PM
e:\Users\alvin\Documents\180 Mission Oak HS Aquatic Complex_RD01_VZ2_A\winv.nt

					<p>DSA File No.: 54-H11</p> <p>DSA Application No.: 02-120251</p> <p style="text-align: right;">Agency Approval</p>
					<p>N11 CAST-IN-PLACE CONCRETE, Truncated Domes 6" = 1'-0"</p> <p>N14 PAVEMENT, Accessible Parking Stall at Perpendicular Curb Ramp 18" = 1'-0"</p>
					<p>J4 ROAD AND PARKING SIGNAGE, Passenger Loading Only 1 1/2" = 1'-0"</p> <p>J7 PAVMENT, ISA Symbol @ Parking Stall 1" = 1'-0"</p> <p>J14 CAST-IN-PLACE CONCRETE, Accessible Ramp @ Curb 14" = 1'-0"</p>
					<p>E11 CAST-IN-PLACE CONCRETE, Drop Off Lane 14" = 1'-0"</p> <p>A4 ROAD AND PARKING SIGNAGE, Accessible Parking & Entrance Sign 1" = 1'-0"</p> <p>A7 STEEL AND FABRICATIONS Doorstop Bollard 3/4" = 1'-0"</p> <p>A11 SD-A404 Accessible Drop Off Section 1 1/2" = 1'-0"</p>

Mission Oak HS Aquatic Complex
Tulare Joint Union High School District
Tulare, CA 93274

SITE DEVELOPMENT
DETAILS - ACCESSIBLE ELEMENTS

Drawing

darden ARCHITECTURE
PLANNING
INTERIORS
architects
www.dardenarchitects.com
6790 N. West Ave. • Fresno, CA 93711 • T. 559.448.8051

ARCHITECT
No. 43024
STATE OF CALIFORNIA

No.	Revision/Submission	Date
1	REVISION_01	05/31/2023

Revision

Designed By: MF
Copyright © 2022 Darden Architects

Scale: As indicated
Drawn By: FM
Project Number: 2180
Checked By: -
Date: 03/28/2023
Reviewed By: MF

SD/A303

Sheet: _____ of: _____

Opening Schedule - Site												
Door No.	Frame Type	Size			Door Material	Hardware					Comments	
		Width	Height	Thickness		Head	Jamb	Threshold	Group	Keying Room No		
SG 01	OM-1	15' - 6"	8' - 0"	2"	ORNAMENTAL METAL	-	A10-SD/A404	E1-SD/A404	982OM	-	2	
SG 02	ACL-1	4' - 0"	6' - 0"	1 3/4"	CHAIN LINK	-	J11-SD/A402	A4-SD/A402	98G	-	3	
SG 03	OM-2	7' - 9"	8' - 0"	2"	ORNAMENTAL METAL	-	A4-SD/A404	E1-SD/A404	982OM	-	1	
SG 03a	CL-1	4' - 0"	6' - 0"	1 3/4"	CHAIN LINK	-	J11-SD/A402	A4-SD/A402	-	-	4	
SG 03b	CL-2	6' - 0"	6' - 0"	1 3/4"	CHAIN LINK	-	J11-SD/A402	A4-SD/A402	-	-	5	
SG 04	OM-1	15' - 6"	8' - 0"	2"	ORNAMENTAL METAL	-	A10-SD/A404	E1-SD/A404	982OM	-	2	
SG 05	OM-2	7' - 9"	8' - 0"	2"	ORNAMENTAL METAL	-	A4-SD/A404	E1-SD/A404	982OM	-	1	
SG 06	CL-2	8' - 0"	8' - 0"	1 3/4"	CL	-	J11-SD/A402	A4-SD/A402	998G	-		
SG 07	CL-2	12' - 0"	8' - 0"	1 3/4"	Chainlink	-	J11-SD/A402	A4-SD/A402	998G	-		

DSA File No.: 54-H11

DSA Application No.: 02-120251

Agency Approval

ABBREVIATIONS:

SG - Steel Gate	SS - Stainless Steel
STL - Steel	CL - Chain Link
HM - Hollow Metal	GALV - Galvanized Finish
SG - Site Gate	S&F - Steel and Fabrications
SPF - Steel Post Fence	OM - Ornamental Metal


- GENERAL NOTES:**
- This schedule is provided for the convenience of the General Contractor. Dimensions indicated are nominal dimensions.
 - The General Contractor is responsible for all coordination and review of drawings and verifying all field conditions and dimensions prior to fabrication. Not all detail references are included in the schedule.
 - All details, materials and finishes shall be considered typical for all similar conditions unless noted otherwise.
 - Gate Types are shown on This Sheet.
 - Frame Types are shown on This Sheet.
 - Exit Doors shall be operable from inside without the use of a key or any special knowledge or effort.
 - Method of EMERGENCY SERVICES ACCESS: By Means of the Master Key locked in a MISCELLANEOUS SPECIALTIES, Knox Box located at the Main Entrance of the ADMINISTRATION BUILDING G.

- OPENING SCHEDULE COMMENTS:**
- ORNAMENTAL METAL. Pair of accessible pool gates, with a set of door bumpers. See Details.
 - ORNAMENTAL METAL. Two (2) pair of accessible pool gates, with a set of door bumpers and a fixed bollard / railing. See Details.
 - CHAIN LINK. Accessible Gate with Privacy Slats, and Door Stop / Holder. See
 - CHAIN LINK. Maintenance gate with butterfly latch, padlock and Privacy Slats
 - CHAIN LINK. Pair of maintenance gates with drop rod, butterfly latch, padlock and privacy slats
 - ORNAMENTAL METAL. Pair of maintenance pool gates
 - STEEL AND FABRICATIONS, Bus lane gates.

- DSA REVIEW:**
- "Open Mesh Fences", "Ornamental Metal Fencing", and "Solid Clad Fences" per California Administrative Code Sec. 4.314 are exempt from DSA review and not part of the DSA Structural Safety approval.
 - DSA IR A-22, Item 12 "Open Mesh Fences", requires only DSA Access review and approval for gates and access.

J18	Opening Schedule Legend
No Scale	

J7 Opening Schedule Site Gates

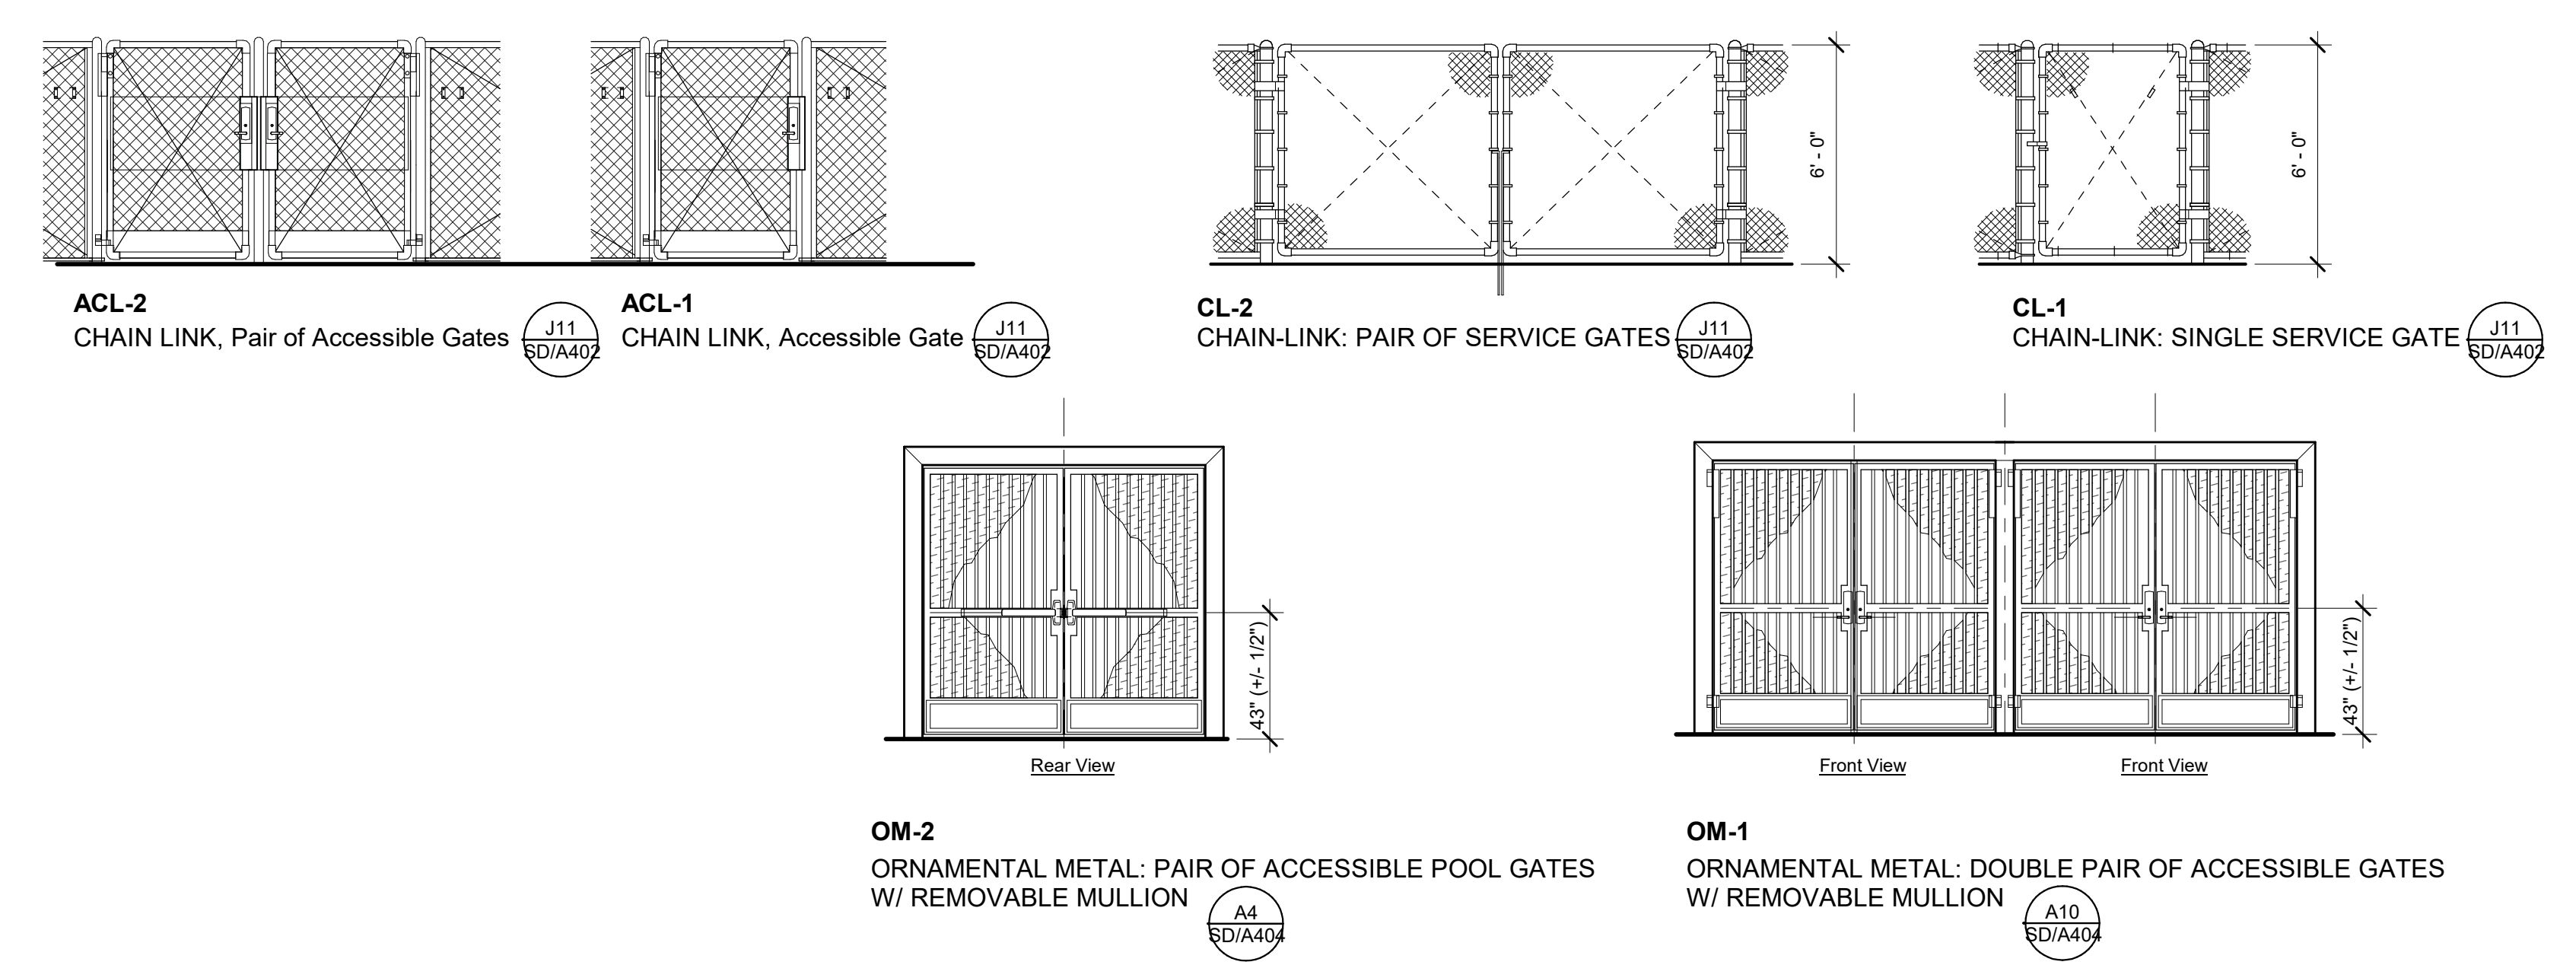

Mission Oak HS Aquatic Complex
Tulare Joint Union High School District
Tulare, CA 93274

SITE DEVELOPMENT
SITE OPENING SCHEDULE

ARCHITECTURE PLANNING INTERIORS
www.dardenarchitects.com
6790 N. West Ave. • Fresno, CA 93711 • T. 559.448.8051

No.	Revision/Submission	Date
1	REVISION_01	05/31/2023

Designed By: MF
Copyright © 2022 Darden Architects

Scale: 1/4" = 1'-0"
Drawn By: FM

Project Number: 2180
Checked By: -

Date: 03/28/2023
Reviewed By: MF

SD/A401


A7 SITE GATE OPENING TYPES
1/4" = 1'-0"

8/18/2023 4:29:15 PM e:\Users\alvin\Documents\2180 Mission Oak HS Aquatic Complex_RD01_VZ2_A\inv.rvt



DSA File No.:
54-H11

DSA Application No.:
02-120251

Agency Approval

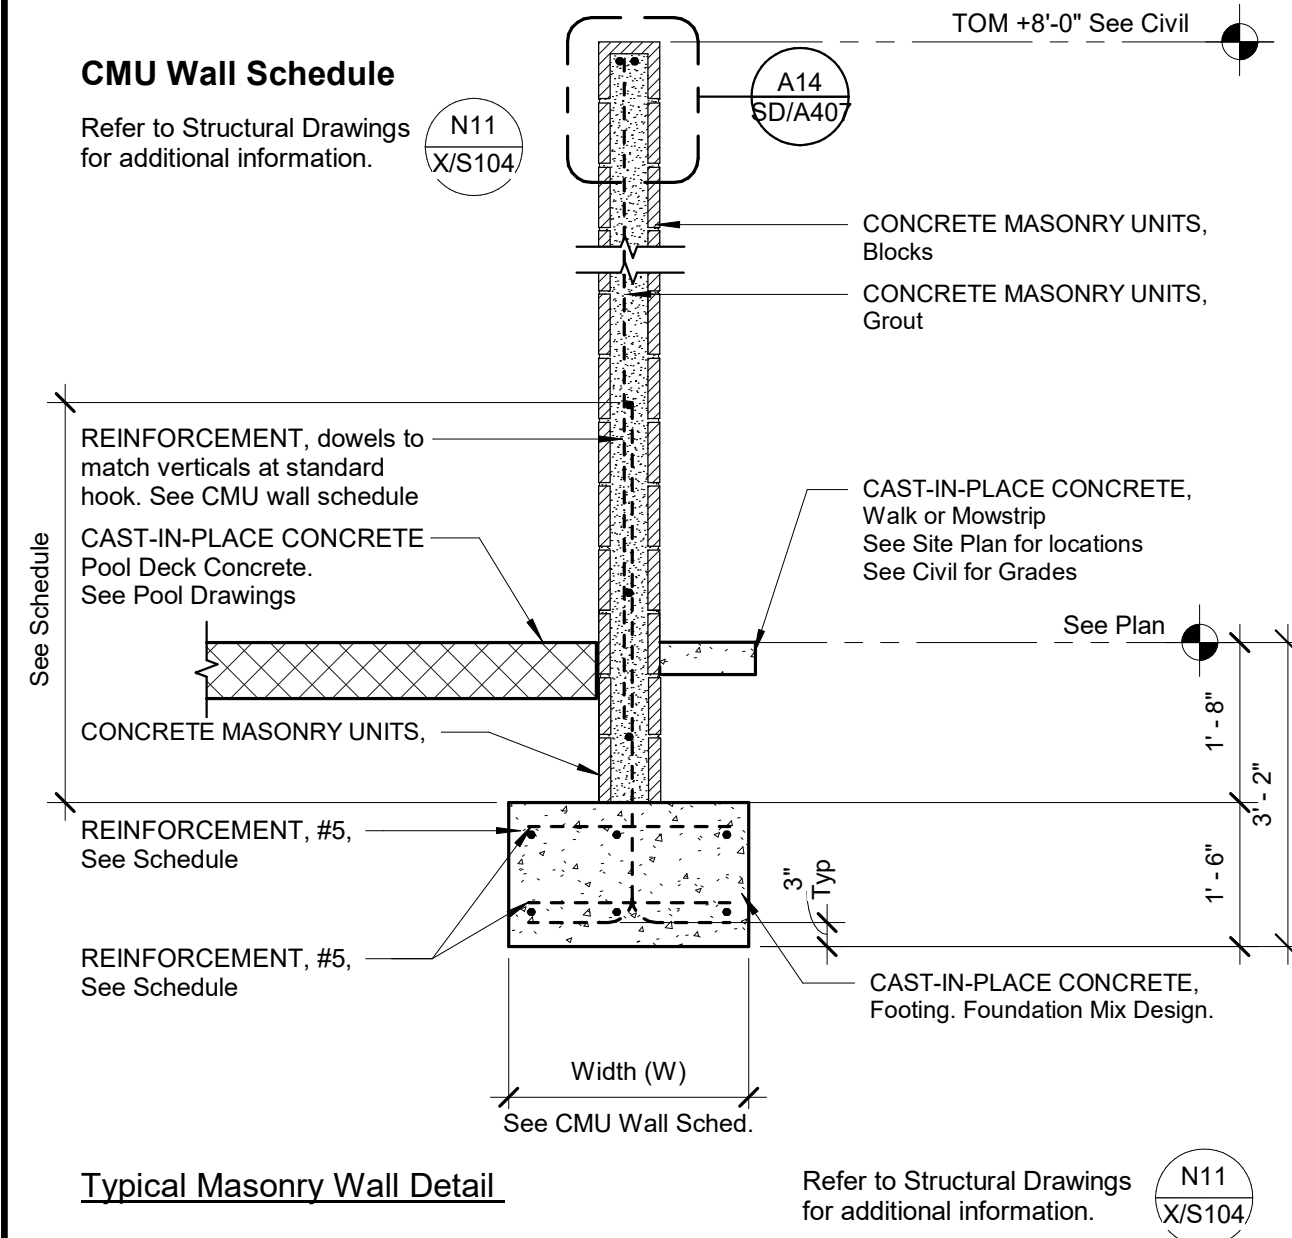

J14
CONCRETE MASONRY UNITS, Wall & Footing Details
1/2" = 1'-0"

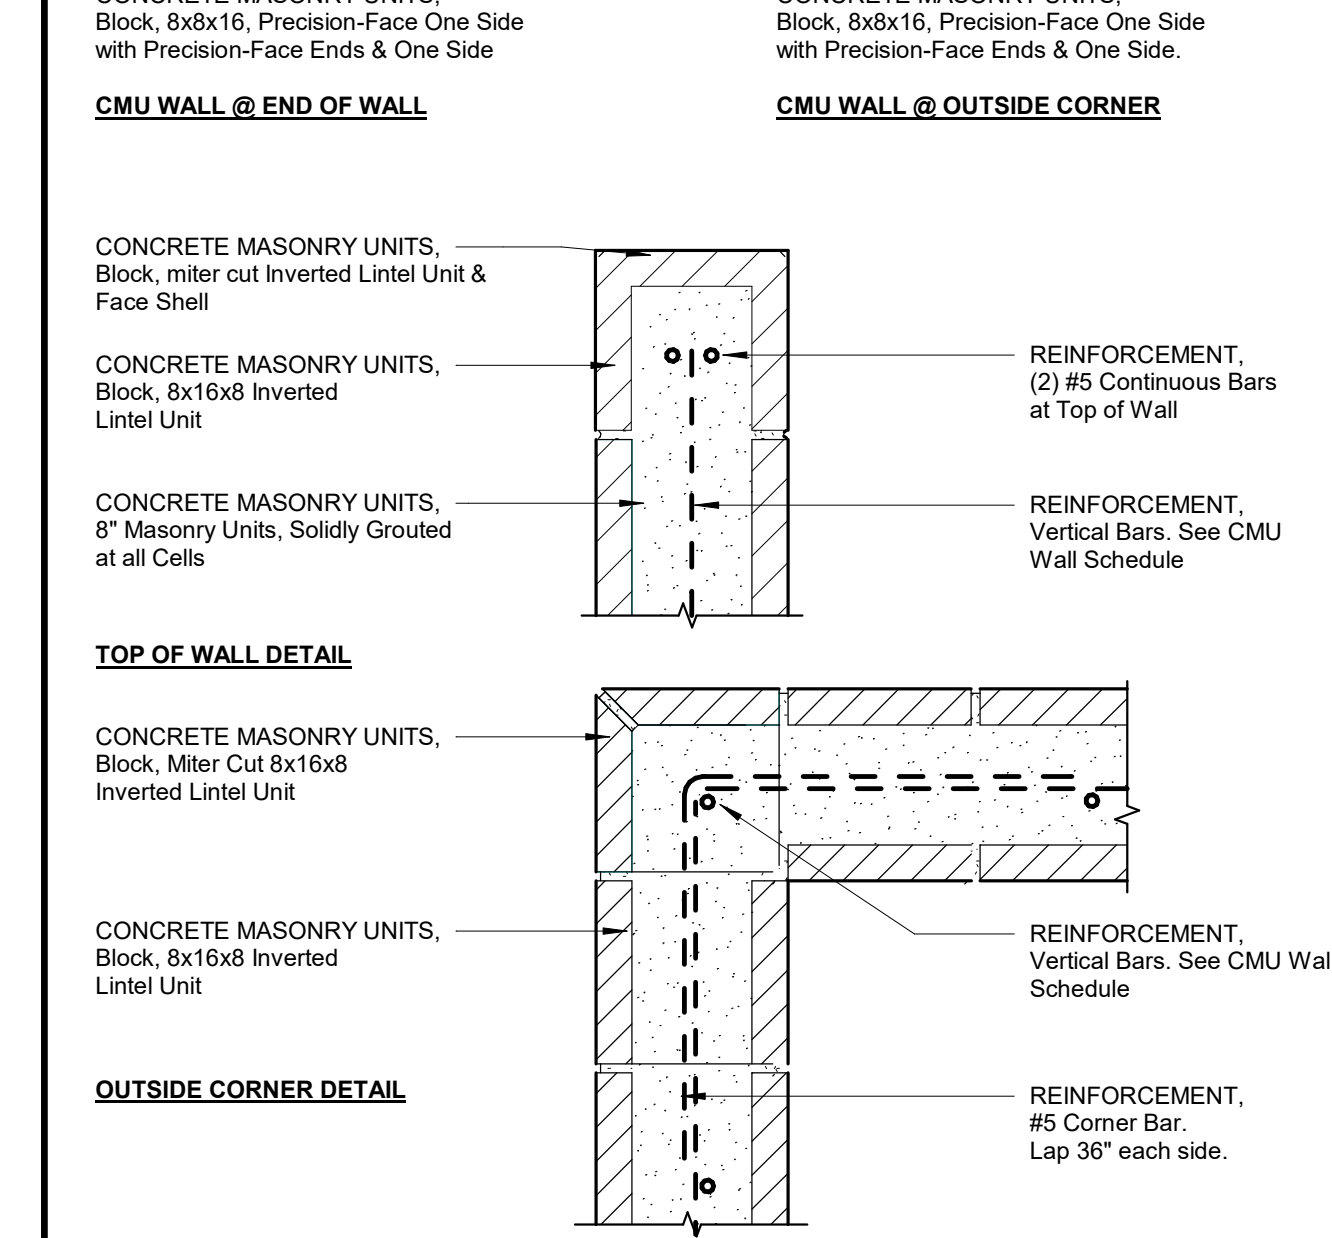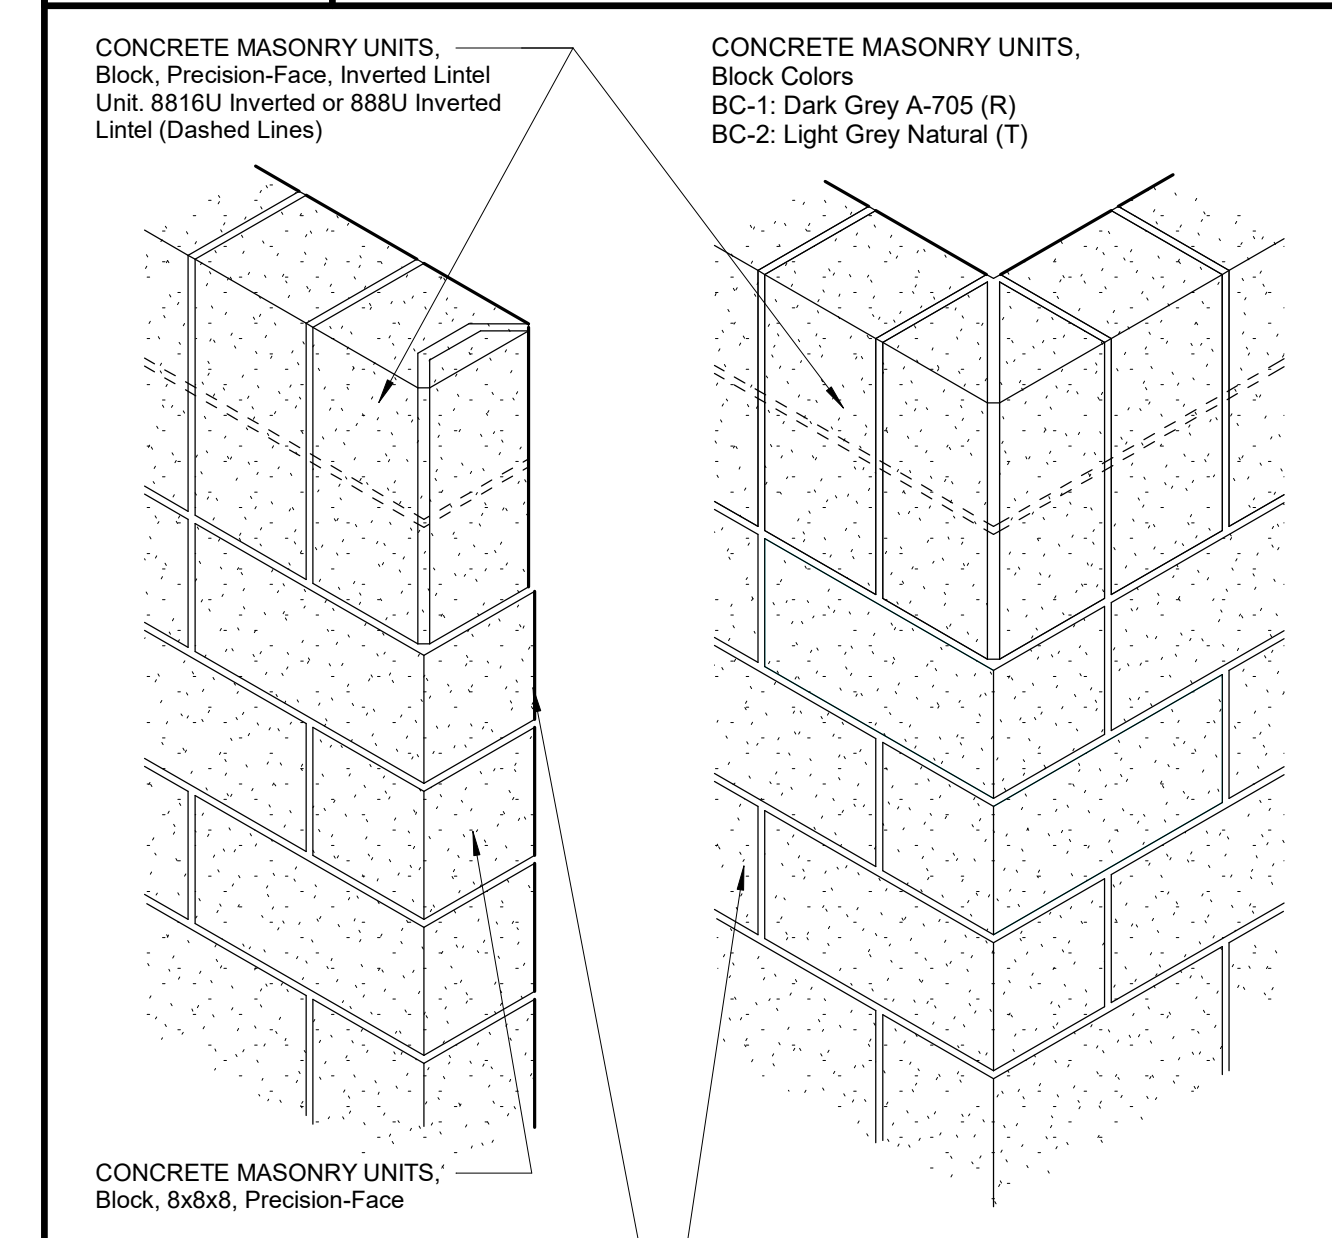

Mission Oak HS Aquatic Complex
Tulare Joint Union High School District
Tulare, CA 93274

SITE DEVELOPMENT
DETAILS - ENCLOSURE DETAILS


ARCHITECTURE PLANNING INTERIORS
www.dardenarchitects.com
6790 N. West Ave. • Fresno, CA 93211 • T. 559.448.8051

Architect

No.	Revision/Submission	Date
1	REVISION_01	05/31/2023

Scale: As indicated
Designed By: MF
Drawn By: FM
Project Number: 2180
Checked By: -
Date: 03/28/2023
Reviewed By: MF

A14
CONCRETE MASONRY UNITS, CMU Details
1 1/2" = 1'-0"

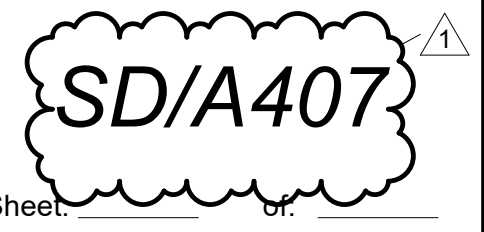

Signage Schedule Site												
Building	Sign Mark	Sign Type	Sign Material	Sign Copy Line 1	Sign Copy Line 2	Sign Copy Line 3	Sign Copy Line 4	Sign Copy Line 5	Mtg Height	Mtg Cond	Remarks	
R	SITE	SG01c	3b	EM	THE NUMBER OF PEOPLE	PERMITTED ON THE POOL DECK	SHALL NOT EXCEED	2814 BY ORDER OF THE	STATE FIRE MARSHALL	6' - 0"	3	See Exterior Elevation A1-P/A402
Q	SITE	SG01e	3b	EM	THE NUMBER OF PEOPLE	PERMITTED IN THE COMPETITION POOL	SHALL NOT EXCEED	256 BY ORDER OF THE	STATE FIRE MARSHALL	5' - 4"	3	See Exterior Elevation A1-P/A402
Q	SITE	SG01f	3b	EM	THE NUMBER OF PEOPLE	PERMITTED IN THE WARM UP POOL	SHALL NOT EXCEED	51 BY ORDER OF THE	STATE FIRE MARSHALL	4' - 8"	3	See Exterior Elevation A1-P/A402
P	SITE	SG01b	6a	EM	EXIT	N/A	N/A	-	5' - 0"	6	-	
P	SITE	SG02b	6a	EM	EXIT	N/A	N/A	-	5' - 0"	6	-	
P	SITE	SG04b	6a	EM	EXIT	N/A	N/A	-	5' - 0"	6	-	
P	SITE	SG05b	6a	EM	EXIT	N/A	N/A	-	5' - 0"	6	-	
P	SITE	SG06b	6a	EM	EXIT	N/A	N/A	-	5' - 0"	6	-	
P	SITE	SG01a	21	EM	NOTICE	N/A	-	-	6' - 0"	6	-	
P	SITE	SG04a	21	EM	NOTICE	N/A	-	-	6' - 0"	6	-	
P	SITE	SG05a	21	EM	NOTICE	N/A	-	-	6' - 0"	6	-	
P	SITE	SG06a	21	EM	NOTICE	N/A	-	-	6' - 0"	6	-	
N	SITE	SG01c	22a	EM	EXIT	N/A	N/A	N/A	7' - 9"	6	-	
N	SITE	SG02a	22a	EM	EXIT	N/A	N/A	N/A	7' - 9"	6	-	
N	SITE	SG04c	22a	EM	EXIT	N/A	N/A	N/A	7' - 9"	6	-	
N	SITE	SG04d	22a	EM	KEEP	CLOSED	N/A	N/A	7' - 9"	6	-	
N	SITE	SG05c	22a	EM	EXIT	N/A	N/A	N/A	7' - 9"	6	-	
N	SITE	SG06c	22a	EM	EXIT	N/A	N/A	N/A	7' - 9"	6	-	
N	SITE	SG01d	23a	EM	KEEP	CLOSED	N/A	N/A	7' - 9"	6	-	
N	SITE	SG01e	23a	EM	KEEP	CLOSED	N/A	N/A	7' - 9"	6	-	
N	SITE	SG05d	23a	EM	KEEP	CLOSED	N/A	N/A	7' - 9"	6	-	
N	SITE	SG05e	23a	EM	KEEP	CLOSED	N/A	N/A	7' - 9"	6	-	
M	SITE	SG06d	23a	EM	KEEP	CLOSED	N/A	N/A	7' - 9"	6	-	

L1 Signage Schedule	
No Scale	Refer to L18 for Schedule Legend

Sign Type 3 - Occupancy Load

Sign Type 23 - Site Gate Sign

Sign Type 20 - Site Gate Sign


Sign Type 22 - Site Gate Sign

Sign Type 21 - Pool Notice Sign

NOTES:

- Mounting Locations and Heights are typical, UON.
- Mount Signs such that the baseline of the highest raised character is 59" Max above finish floor, verify the baseline of the lowest line of braille is a Min of 48" above finish floor.
- Refer Specification Section IDENTIFYING DEVICES and Signage Schedule for the Sign Copy



A1	IDENTIFYING DEVICES, Signage Locations and Dimensions	A7	Signage Site Plan
----	-------------------------------------------------------	----	-------------------

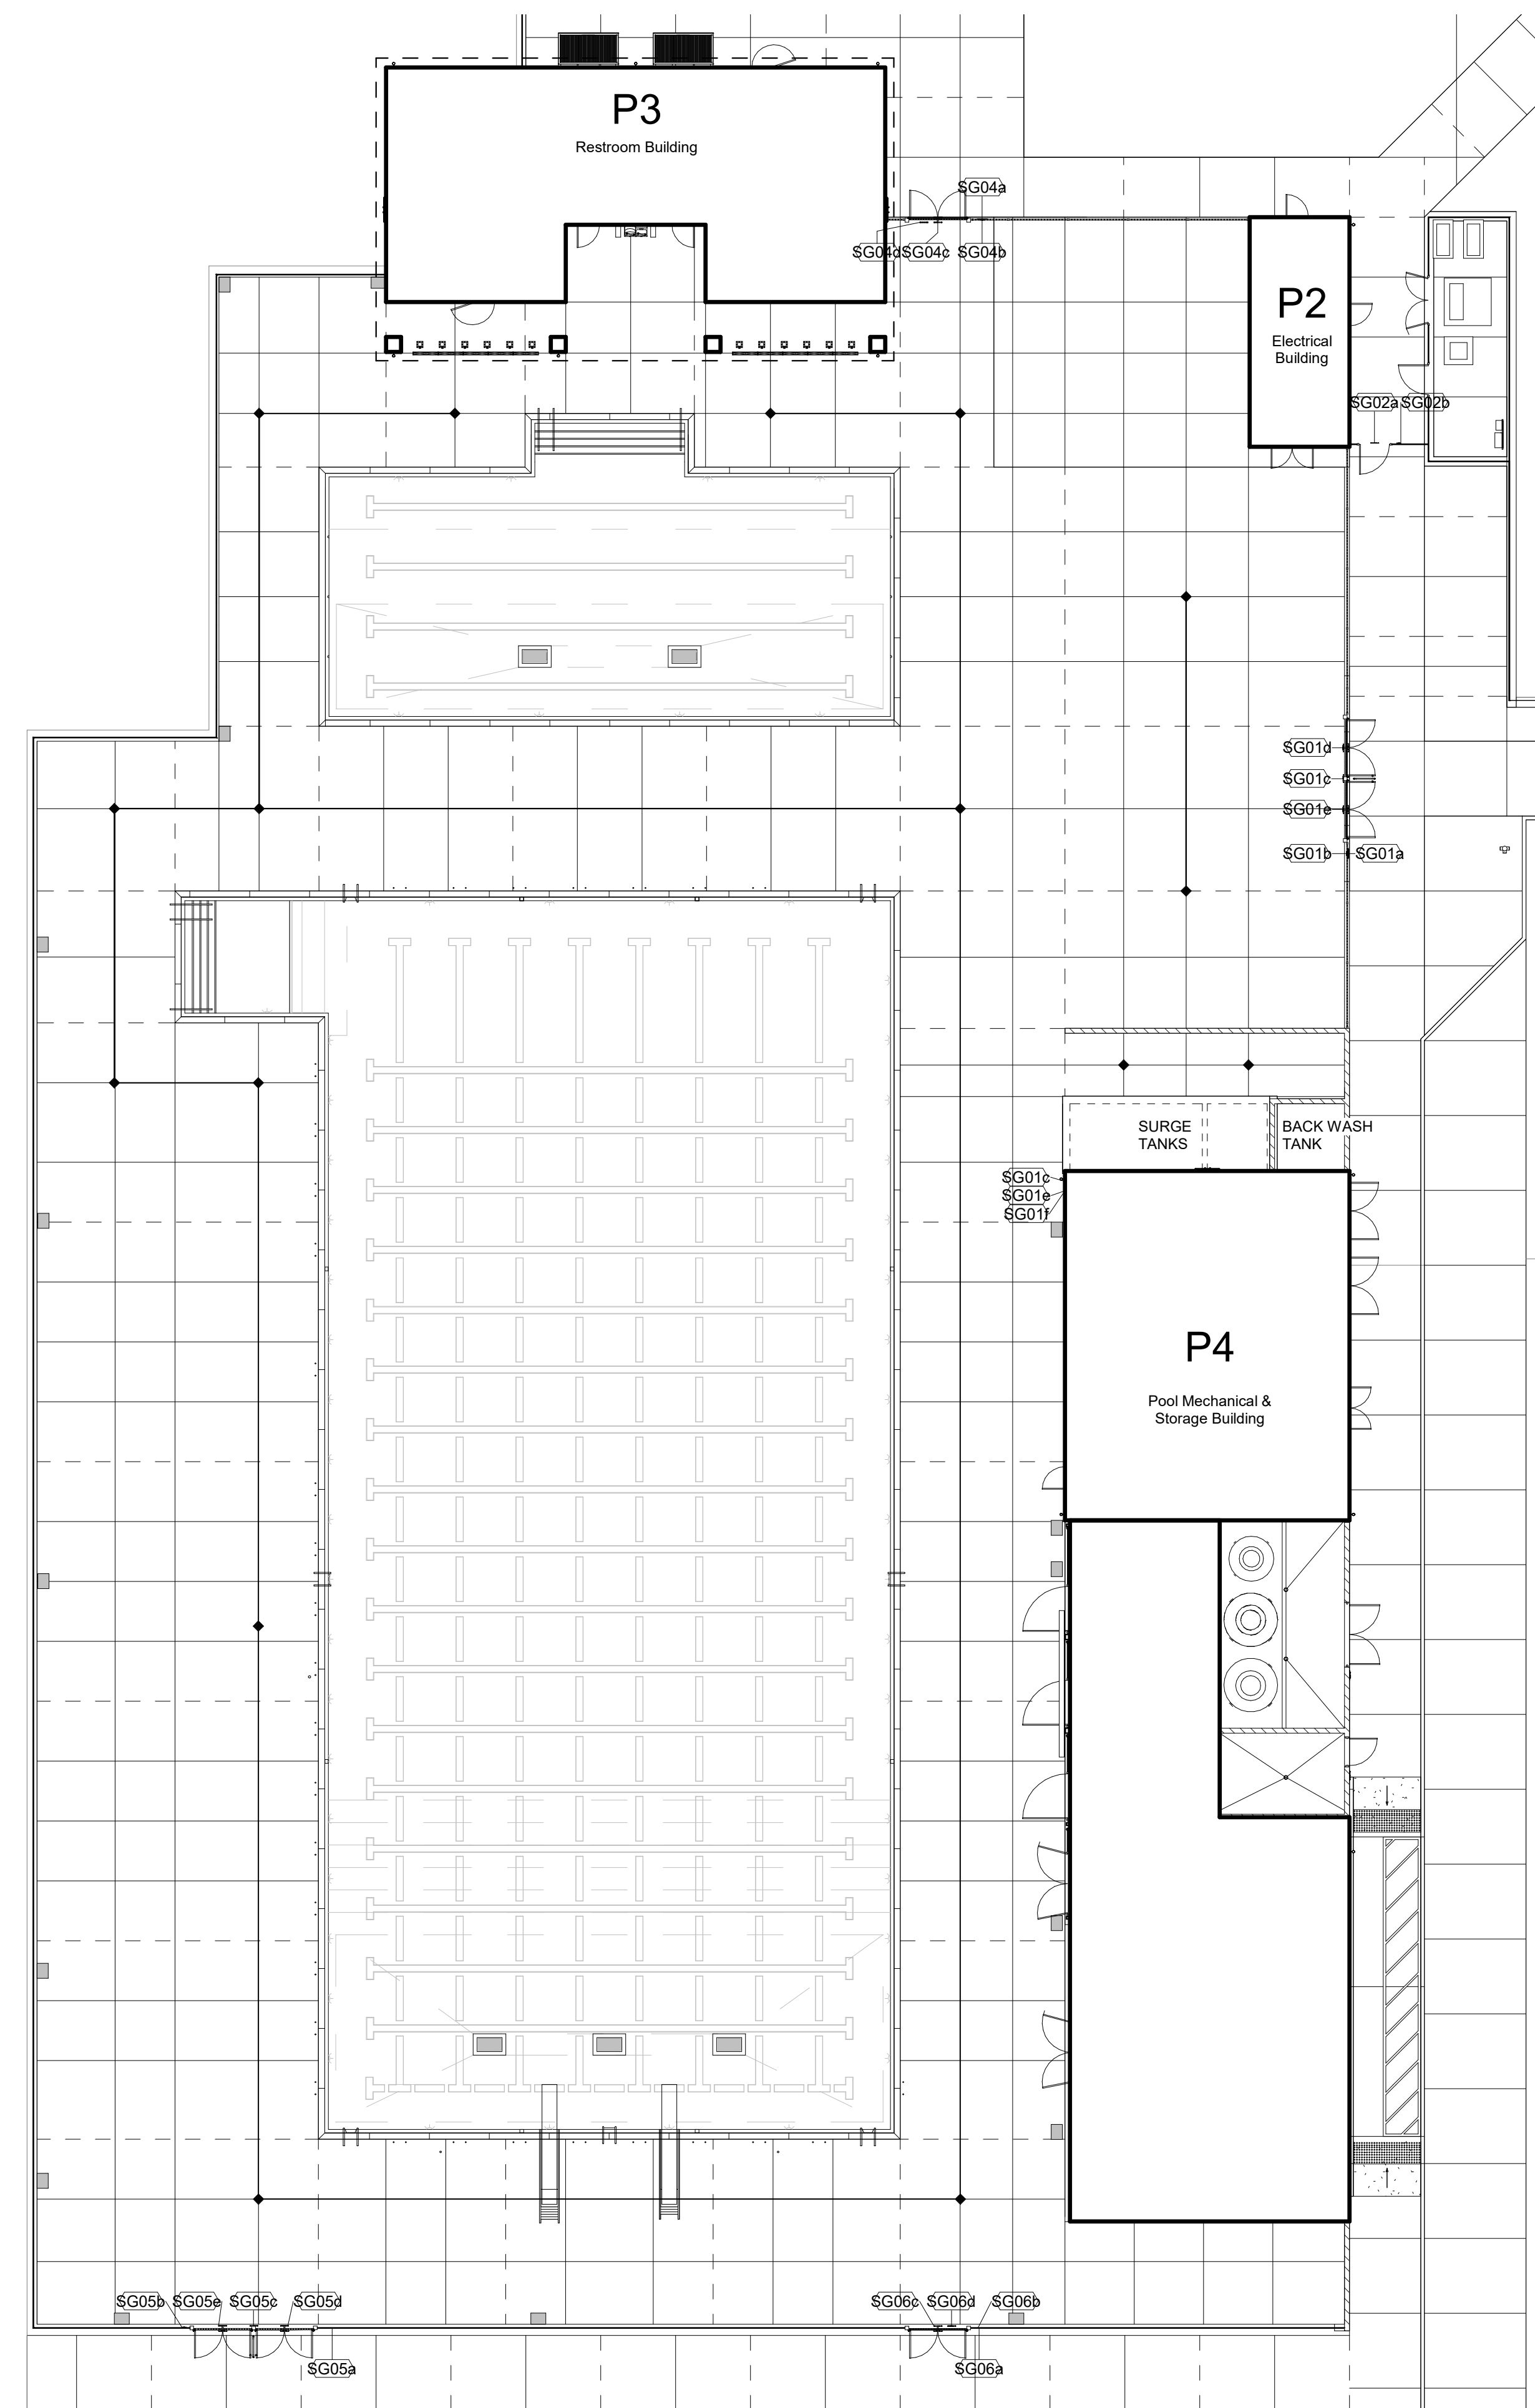

DSA File No.: 54-H11

DSA Application No.: 02-120251

Agency Approval	
MOUNTING CONDITION	SIGN MATERIAL
1. Metal Stud Framed Wall	A = Acrylic
2. Wood Stud Framed Wall	EM = Exterior Metal
3. Concrete and Concrete Masonry	IM = Interior Metal
4. Glass	EP = Exterior Plastic
5. Door	IP = Interior Plastic
6. See Plan	D = Decal

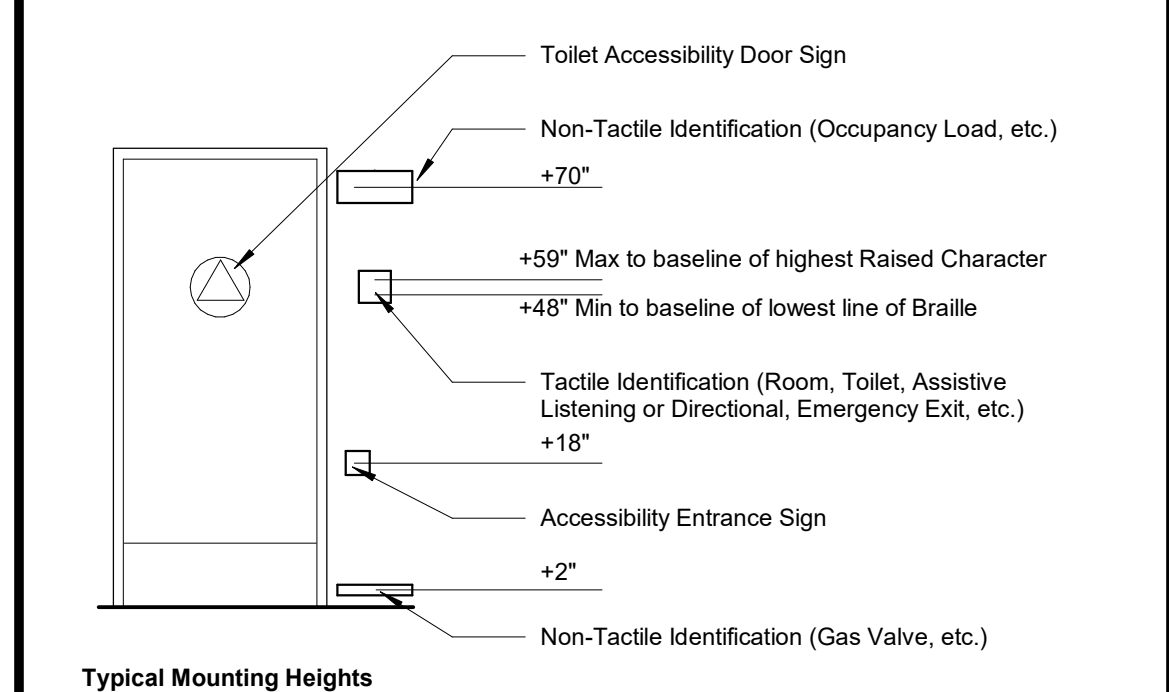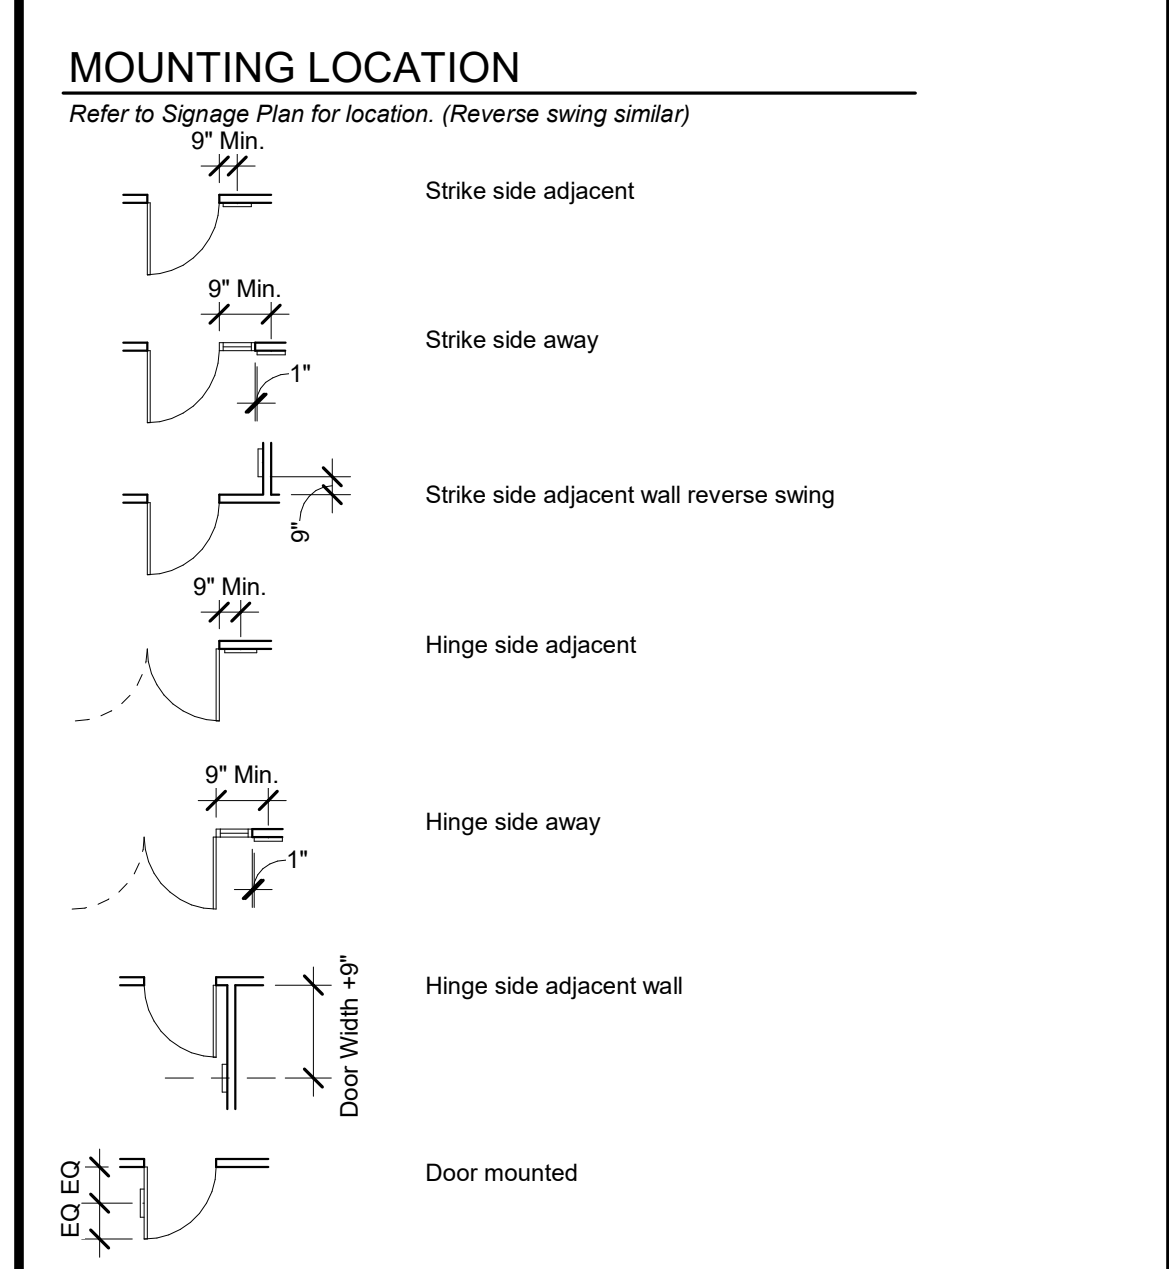

Scale: N.T.S.

- NOTES**
- Refer to Specification Section IDENTIFYING DEVICES.
 - Refer to Plan for Mounting Location.
 - Verify Sign Copy with Owner prior to fabrication, "--" indicates a blank space.
 - For IDENTIFYING DEVICES, Signage Dimensions, refer to detail A1 SD/A701.

G18 Signage Schedule Legend	
No Scale	

Mission Oak HS Aquatic Complex
Tulare Joint Union High School District
Tulare, CA 93274


SITE DEVELOPMENT
SIGNAGE PLAN AND SCHEDULE

ARCHITECTURE PLANNING INTERIORS
www.dardenarchitects.com
6790 N. West Ave. • Fresno, CA 93711 • T. 559.448.8051

No.	Revision/Submission	Date
1	REVISION_01	05/31/2023

Designed By: MF
Copyright 2022 Darden Architects
Scale: As indicated
Drawn By: FM
Project Number: 2180
Checked By: -
Date: 03/28/2023
Reviewed By: MF

8/18/2023 4:29:25 PM e:\Users\alvin\Documents\180 Mission Oak HS Aquatic Complex_RD01_VZ2_A\Invtv.nt

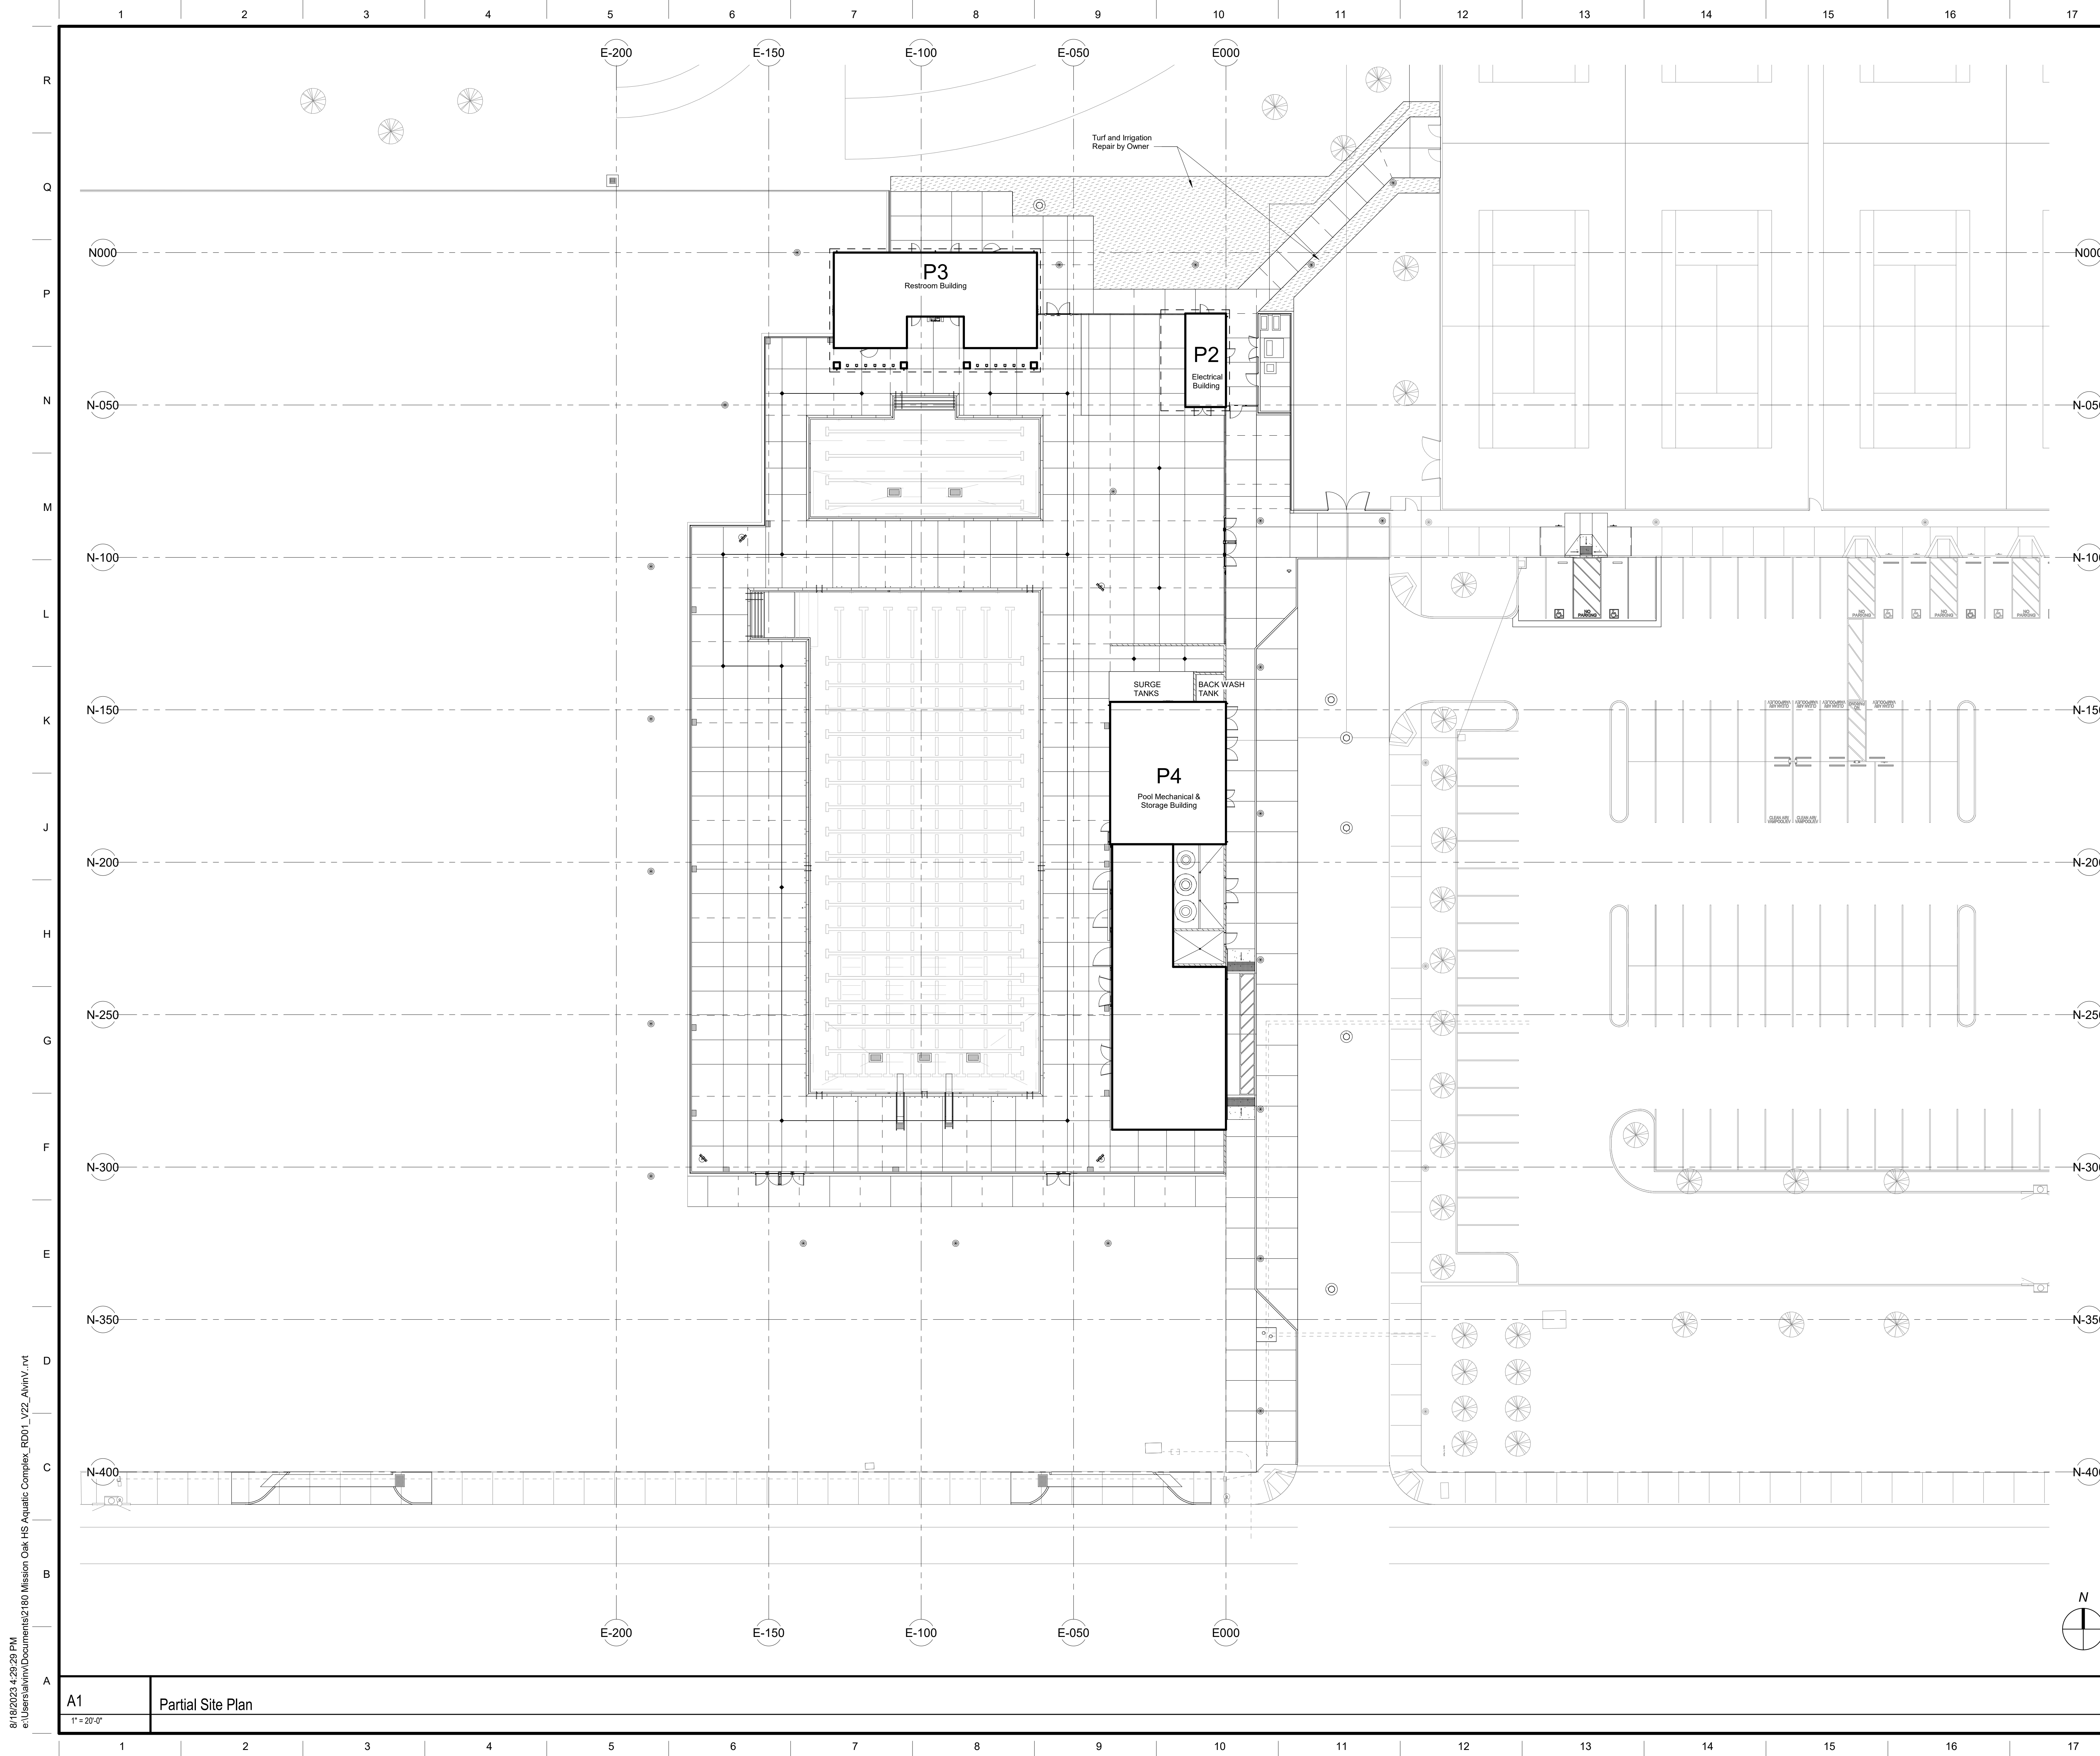

DSA File No.:
54-H11

DSA Application No.:
02-120251

Agency Approval


NOTES

No Turf & Irrigation work in the scope of project.
Level and grade earth according to civil drawings in preparation for turf in area to the north.
All landscaping repair work performed by the School District.

Mission Oak HS Aquatic Complex
Tulare Joint Union High School District
Tulare, CA 93274

SITE DEVELOPMENT
LANDSCAPING PLAN

darden ARCHITECTURE
PLANNING
INTERIORS
architects www.dardenarchitects.com
6790 N. West Ave. • Fresno, CA 93711 • T. 559.448.8051

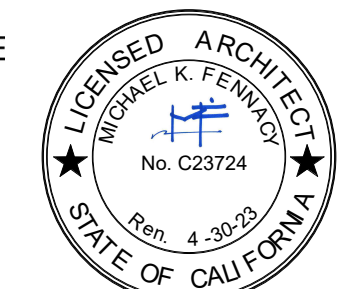

No.	Revision/Submission	Date
1	REVISION_01	05/31/2023

Revision	
Designed By: MF	Copyright 2022 Darden Architects
Scale: 1" = 20'-0"	Drawn By: FM
Project Number: 2180	Checked By: -
Date: 03/28/2023	Reviewed By: MF

SD/L101

8/18/2023 4:29:29 PM e:\Users\alvin\Documents\180 Mission Oak HS Aquatic Complex_RD01_VZ2_A\invt_vt

A1 Partial Site Plan
1" = 20'-0"

Building P		Room Number	Room Name	Interior Finish Schedule										Remarks					
				Floor Finishes			Base Finishes			Wall Finishes			Ceiling Finishes			Miscellaneous Finishes			
P2	P201a	Storage																	
P2	P203	Elect.	CFS																
P2	P202	Fire Riser	CFS																
P3	P301	Boys Shower		X-21															
P3	P302	Boys		X-21															
P3	P304	Girls		X-21															
P3	P305	Girls Shower		X-21															
P3	P306	Cust.	CFS																
P3	P303	Fire Riser	CFS																
P4	P401	Pool Equipment				CB-1		CB-1	FF										
P4	P402	Acid		X-20															
P4	P403	Chlorine		X-20															
P4	P404a	Storage				CB-1		CB-1	FF										
P4	P404b	Storage				CB-1		CB-1	FF										
P4	P404c	Storage				CB-1		CB-1	FF										
P4	P404d	Storage				CB-1		CB-1	FF										
P4	P404e	Storage				CB-1		CB-1	FF										

Building P		Room Number	Room Name	Interior Finish Schedule Alternate										Remarks						
P2	P205	Staff		X-21																
P2	P204	Snack Bar		X-21																
P2	P201a	Storage				GL3-GGLII														
P2	P205a	Cust.	CFS																	
P2	P203	Elect.	CFS																	
P2	P202	Fire Riser	CFS																	

DSA File No.: 54-H11

DSA Application No.: 02-120251

Agency Approval

ABBREVIATIONS

CFS = Clear Floor Sealer
FF = Factory Finish
GL = Gloss Level
GGL = Grand Grade Level
* = Refer To Remarks

Interior Paint Finishes:
Refer To Specification Section - PAINTING
CB# = Concrete or Concrete Masonry Units
PW = Cement Plaster, Veneer Plaster or Gypsum Plaster Finish
M# = Metal Finish
X# = Special Finishes

NOTES

- Refer to appropriate Specification Sections for Materials, Systems and Types.
- All Details, Materials and Finishes shall be considered "Typical" for all similar conditions, Unless Otherwise Noted.
- Do not paint Fire Rated Door and Frame Rating Plates.
- Refer to Interior Elevations for additional information.
- This Schedule is provided for the convenience of the Contractor. Field verify all conditions and dimensions prior to fabrication, installation or application.
- See Interior Color Schedule for Finish / Material Colors.
- VAPOR-ALKALINITY CONTROL: Apply Vapor-Alkalinity Control Membrane System at all concrete slab areas scheduled to receive applied floor covering that are sensitive to and have requirements for limits of vapor transmission and pH levels.

J1	Interior Finish Schedule	J18	Interior Finish Schedule Legend
----	--------------------------	-----	---------------------------------

MATERIAL	FINISH	REMARKS
PAVEMENT		
Asphalt Concrete	See Civil Drawings	
Striping and Markings	See Civil Drawings	
Wheelstops	See Civil Drawings	
CHAIN LINK		
Fences, Gates, Posts, Rails, Pickets, Gates and all Accessories	Galvanized	
CAST-IN-PLACE CONCRETE		
Curbs, Curb and Gutters, Mowstrips, Aprons, Valley Gutter, Housekeeping Pads, Site Light Pole Bases	Natural Cast Concrete	
Walks, Platforms, Steps, Ramps	Broom Finish	
Pool Deck Concrete	Medium Broom Finish	Broom strokes parallel with slope
Precast Benches	Natural Cast Concrete	
Concrete Seat Walls and Fence Walls	Sack and Patch	Tammpatch II
Fire Lane Concrete Curbs	Paint System X-1	Red Paint with 4" White Letters "FIRE LANE"
CONCRETE MASONRY UNITS		
Block, Block Veneer and Mortar	F.F. Ground Face Block	Integral Water-Repellent
STEEL AND FABRICATION		
Steel Gates and Frame, Rails Fencing and Gates, Supports Posts	EM-2 White	Hot Dipped Galvanized after Fabrication
Pipe Guard Rails	Brushed Stainless Steel	
Cane Rail at Bleachers	Hot Dipped Galvanized after Fabrication	
Display Wall Header Assembly (Alt Bid)	Powder Coated	
Display Wall Structure and Trellis (Alt Bid)	EM-2	
FIBERGLASS DOORS AND FRAMES		
Doors, Panels, Frames and Accessories	F.F. Color	
SHEET METAL		
Miscellaneous Flashings, Fence Parapet Caps	EM-2	
HARDWARE		
Steel Gates, Hinges, Hasps, Cane Bolts, etc.	EM-2	
Chain Link Gates, Hinges, Hasps, Cane Bolts, etc.	Galvanize	
Ornamental Gates, Hinges, Hasps, Cane Bolts, etc.	EM-2	
ORNAMENTAL METAL		
Fence, Gates, Accessories	EM-5	
SPORTS LIGHTING (MUSCO)		
Light Poles and Fixtures	F.F. Galvanized	
Pre-Cast Concrete Light Pole Bases	Sack and Patch	Tammpatch II
ALUMINUM BLEACHERS (aka Exterior Grandstands)		
Seats and Risers	F.F.	
SHADE STRUCTURES		
Fabric	F.F.	
Structure	F.F. Powder Coated Color	
TILE		
Ceramic Tile	CT-4	Exterior tile pattern. Refer to exterior elevations.

MATERIAL	FINISH	REMARKS
CAST-IN-PLACE CONCRETE		
Columns, Walls	Sack and Patch	Tammpatch II
CONCRETE MASONRY UNITS		
Block, Block Veneer and Mortar	F.F. Ground Face Block (Exterior Face)	Integral Water-Repellent
Block at Building Grille	ECB-2	
STEEL AND FABRICATION		
Columns, Beams, Lintels, Building Canopies, Sunshades	EM-2	Hot Dipped Galvanized after fabrication
Building Grilles	Powder Coated	Hot Dipped Galvanized after fabrication
Downspouts	EM-2	Hot Dipped Galvanized after fabrication
METAL DECK		
Metal Deck at Pool Storage, exposed to view surfaces.	EM-2	
METAL SHINGLES		
Exterior Roof, Accessories, Gutters, Trim, Flashing, All Misc. Profile Closure + Filler Shapes	F.F.	
SHEET METAL		
Architectural	EM-2	Exposed to all Viewing Angles
Utility	Galvanized	
Snack Bar Counter	Stainless Steel	
GLASS		
Insulated Glazing Panels	F.F.	
FIBERGLASS DOORS AND FRAMES		
Doors, Panels, Frames and Louvers	F.F., Custom Color	
ACCESS DOORS AND FRAMES		
Access Doors, Stainless Steel	F.F.	
CEMENT PLASTER		
Cement Plaster	EP-2	See Remark #2
Metal Accessories	EP-2	
MISCELLANEOUS SPECIALTIES		
Glassfiber Reinforced Cement Facia	EP-2	
PLUMBING		
Drinking Fountains	F.F. Stainless Steel	
MECHANICAL		
Exhaust Fans, Vent Stacks, Mechanical Units, & Misc. Equipment	EM-2	See Remark 1
ELECTRICAL		
Exposed to View Conduits	EM-2	
Switchgear, Transformer, Light Fixtures, Fire Alarm Devices, Speakers.	F.F.	

ABBREVIATIONS:

F.F. = Factory Finish

Exterior Paint Finishes:
Refer to Specification Section - PAINTING
ECB-x = Concrete or Concrete Masonry Units
X-x = Specialty Finish
EM-x = Exterior Metal Finish
EW-x = Exterior Wood Finish
EP-x = Cement Plaster

NOTES:

- Refer to Appropriate Specification Sections for Materials and Systems.
- All Details, Material and Finishes Shall be Considered "Typical" for all Similar Conditions Unless Noted Otherwise.
- Refer to Exterior Elevations for extent of materials and finishes. Includes Backs of Parapets, Typical.

REMARKS

- Do not paint Mechanical Units Condensing Coils and Name Plates.
- The CEMENT PLASTER system includes a Fiber Reinforced Cement Plaster with Embedded Mesh Reinforcing Coat, and Acrylic-Enhanced Cementitious Finish System. Provide mockup panels, and include product manufacture representatives for pre-construction and installation recommendations.

Mission Oak HS Aquatic Complex
Tulare Joint Union High School District
Tulare, CA 93274

Project

TYPICAL INFORMATION
INTERIOR & EXTERIOR FINISH SCHEDULE
Drawing

ARCHITECTURE
PLANNING
INTERIORS
architects www.dardenarchitects.com
6790 N. West Ave. • Fresno, CA 93711 • T. 559.448.8051

Architect

No.	Revision/Submission	Date
1	REVISION_01	05/31/2023

Designed By: MF
Copyright 2022 Darden Architects

Scale: As indicated
Drawn By: PV/KT
Project Number: 2180
Checked By:
Date: 03/28/2023
Reviewed By: MF

X/A201

A1	Exterior Finish Schedule	A14	Ext. Fin. Schedule Legend
----	--------------------------	-----	---------------------------

8/18/2023 4:29:34 PM
e:\Users\alvin\Documents\180 Mission Oak HS Aquatic Complex_RD01_VZ2_A\winV.nt

Opening Schedule Window										
Building	Mark	Frame Type	Size		Material	Head	Jamb	Sill	Glazing Type	Comments
			Width	Height						
P3	P304 c	FG-14	2' - 0"	2' - 0"	FG	J11-X/A402	E11-X/A402	A11-X/A402	-	Louver, 4
P4	P401 c	FG-11	4' - 0"	4' - 0"	FG	J11-X/A402	E11-X/A402	A11-X/A402	-	Louver
P4	P401 d	FG-14	2' - 0"	2' - 0"	FG	J11-X/A402	E11-X/A402	A11-X/A402	-	Louver, 4
P4	P401 e	FG-15	2' - 0"	2' - 0"	FG	J11-X/A402	E11-X/A402	A11-X/A402	-	Louver, 4
P4	P401 f	FG-10	4' - 0"	6' - 0"	FG	J11-X/A402	E11-X/A402	A11-X/A402	-	Louver
P4	P401 g	FG-11	4' - 0"	4' - 0"	FG	J11-X/A402	E11-X/A402	A11-X/A402	-	Louver
P4	P401 h	FG-14	2' - 0"	2' - 0"	FG	J11-X/A402	E11-X/A402	A11-X/A402	-	Louver, 4

Opening Schedule Door														
Building	Door No.	Frame Type	Size			Door Material	Door Type	Louver Type	Head	Jamb	Threshold	Hardware		Comments
			Width	Height	Thickness							Group	Keying Room No	
P2	P201a a	FG-3	5' - 8"	6' - 10"	1 3/4"	FG	PF	-	J7-X/A402	E7-X/A402	-	802	P201	3
P2	P202 a	FG-1	3' - 0"	6' - 10"	1 3/4"	FG	F	-	E14-X/A402	A14-X/A402	E4-X/A402	80E	Exterior	3
P2	P203 a	FG-1	3' - 0"	6' - 10"	1 3/4"	FG	F	-	E14-X/A402	A14-X/A402	E4-X/A402	80E	Exterior	3
P3	P301 a	FG-6	3' - 0"	6' - 10"	1 3/4"	FG	F	-	J11-X/A402	A14-X/A402 & E11-X/A402	E4-X/A402	75E	Exterior	2
P3	P302 a	FG-6	3' - 0"	6' - 10"	1 3/4"	FG	F	-	J11-X/A402	A14-X/A402 & E11-X/A402	E4-X/A402	99E	Exterior	3
P3	P302 b	FG-6	3' - 0"	6' - 10"	1 3/4"	FG	F	-	J11-X/A402	A14-X/A402 & E11-X/A402	E4-X/A402	99E	Exterior	3
P3	P303 a	FG-1	3' - 0"	6' - 10"	1 3/4"	FG	F	-	E14-X/A402	A14-X/A402	E4-X/A402	80E	Exterior	3
P3	P304 a	FG-6	3' - 0"	6' - 10"	1 3/4"	FG	F	-	J11-X/A402	A14-X/A402 & E11-X/A402	E4-X/A402	99E	Exterior	3
P3	P304 b	FG-6	3' - 0"	6' - 10"	1 3/4"	FG	F	-	J11-X/A402	A14-X/A402 & E11-X/A402	E4-X/A402	99E	Exterior	3
P3	P305 a	FG-6	3' - 0"	6' - 10"	1 3/4"	FG	F	-	J11-X/A402	A14-X/A402 & E11-X/A402	E4-X/A402	75E	Exterior	2
P3	P306 a	FG-1	3' - 0"	6' - 10"	1 3/4"	FG	F	-	E14-X/A402	A14-X/A402	E4-X/A402	80E	Exterior	3
P4	P401 a	FG-3	5' - 8"	6' - 10"	1 3/4"	FG	PF	-	E14-X/A402	A14-X/A402	E4-X/A402	802E	Exterior	3
P4	P401 b	FG-1	3' - 0"	6' - 10"	1 3/4"	FG	F	-	E14-X/A402	A14-X/A402	E4-X/A402	75E	Exterior	2
P4	P402 a	FG-5	7' - 8"	6' - 10"	1 3/4"	FG	PL	12" x 12"	E14-X/A402	A14-X/A402	E4-X/A402	802E	Exterior	3
P4	P403 a	FG-5	7' - 8"	6' - 10"	1 3/4"	FG	PL	12" x 12"	E14-X/A402	A14-X/A402	E4-X/A402	802E	Exterior	3
P4	P404a a	CL-1	6' - 0"	8' - 0"	1 3/4"	CL	CL	-	J11-SD/A402	J11-SD/A402	-	-	Site	6. Service Gate with Butterfly Latch and Padlock.
P4	P404c a	CL-1	6' - 0"	8' - 0"	1 3/4"	CL	CL	-	J11-SD/A402	J11-SD/A402	-	-	Site	6. Service Gate with Butterfly Latch and Padlock.
P4	P404d a	CL-1	6' - 0"	8' - 0"	1 3/4"	CL	CL	-	J11-SD/A402	J11-SD/A402	-	-	Site	6. Service Gate with Butterfly Latch and Padlock.
P4	P404e a	CL-2	8' - 0"	8' - 0"	1 3/4"	CL	CL	-	J11-SD/A402	J11-SD/A402	-	-	Site	6. Service Gate with Butterfly Latch and Padlock.
P4	P410 a	CL	8' - 0"	7' - 0"	1 3/4"	CL	CL	-	J4-SD/A402	-	-	-	Site	6. Maintenance Gate with Butterfly Latch and Padlock. Privacy Slats
P4	P420 a	FG-2	3' - 8"	6' - 10"	1 3/4"	FG	F	-	E14-X/A402	A14-X/A402	E4-X/A402	75E	Exterior	2

Opening Schedule Door Add Alternate														
Building	Door No.	Frame Type	Size			Door Material	Door Type	Louver Type	Head	Jamb	Threshold	Hardware		Comments
			Width	Height	Thickness							Group	Keying Room No	
P2	P201a a	FG-4	6' - 0"	6' - 10"	1 3/4"	FG	PF	-	J7-X/A402	E7-X/A402	-	802	P201	3
P2	P202 a	FG-1	3' - 0"	6' - 10"	1 3/4"	FG	F	-	E14-X/A402	A14-X/A402	E4-X/A402	80E	Exterior	3
P2	P203 a	FG-1	3' - 0"	6' - 10"	1 3/4"	FG	F	-	E14-X/A402	A14-X/A402	E4-X/A402	80E	Exterior	3
P2	P204 a	FG-7	3' - 0"	6' - 10"	1 3/4"	FG	F	-	J11-X/A402	A14-X/A402 & E11-X/A402	E4-X/A402	75E	Exterior	2
P2	P204 b	FG-8	8' - 0"	4' - 2"	2"	FG	CD	-	N4-X/A402	J4-X/A402	*	01	Exterior	*Refer to SHEET METAL, Snack Bar Counter detail
P2	P204 c	FG-8	8' - 0"	4' - 2"	2"	FG	CD	-	N4-X/A402	J4-X/A402	*	01	Exterior	*Refer to SHEET METAL, Snack Bar Counter detail
P2	P205 a	FG-7	3' - 0"	6' - 10"	1 3/4"	FG	F	-	J11-X/A402	A14-X/A402 & E11-X/A402	E4-X/A402	85E	Exterior	2
P2	P205a a	FG-1	3' - 0"	6' - 10"	1 3/4"	FG	F	-	J7-X/A402	A7-X/A402	E4-X/A402	80	P205	3

DSA File No.: 54-H11

DSA Application No.: 02-120251

Agency Approval

ABBREVIATIONS

FG - Fiberglass
 SG - Site Gate
 SPF - Steel Post Fence
 CL - Chain Link
 RO - Rough Opening
 T - Tempered Glass


GENERAL NOTES

- This schedule is provided for the convenience of the General Contractor. Dimensions indicated are nominal dimensions.
- The General Contractor is responsible for all coordination and review of drawings and verifying all field conditions and dimensions prior to fabrication. Not all detail references are included in the schedule.
- Provide metal closure plates for FG Frames at concrete curbs. Typical. Refer to Detail A4/A402.
- All details, materials and finishes shall be considered typical for all similar conditions unless noted otherwise.
- Door Types are shown on sheet X/A401.
- Frame Types are shown on sheets X/A401.
- Exit Doors shall be operable from inside without the use of a key or any special knowledge or effort.
- For opening Head, Jamb, and Sill framing conditions, see Structural Drawings.


OPENING SCHEDULE COMMENTS

- HARDWARE, Exit/Panic Devices, section HARDWARE, where occurs.
- HARDWARE, Floor Stop, See detail A1/X/A402.
- Floor Stop and Holder - See detail E1/X/A402.
- Relief Air Louver. Coordinate mechanical drawings.
- CHAIN LINK, Gate - See sheet SD/A402.



J1 Window Schedule
No Scale

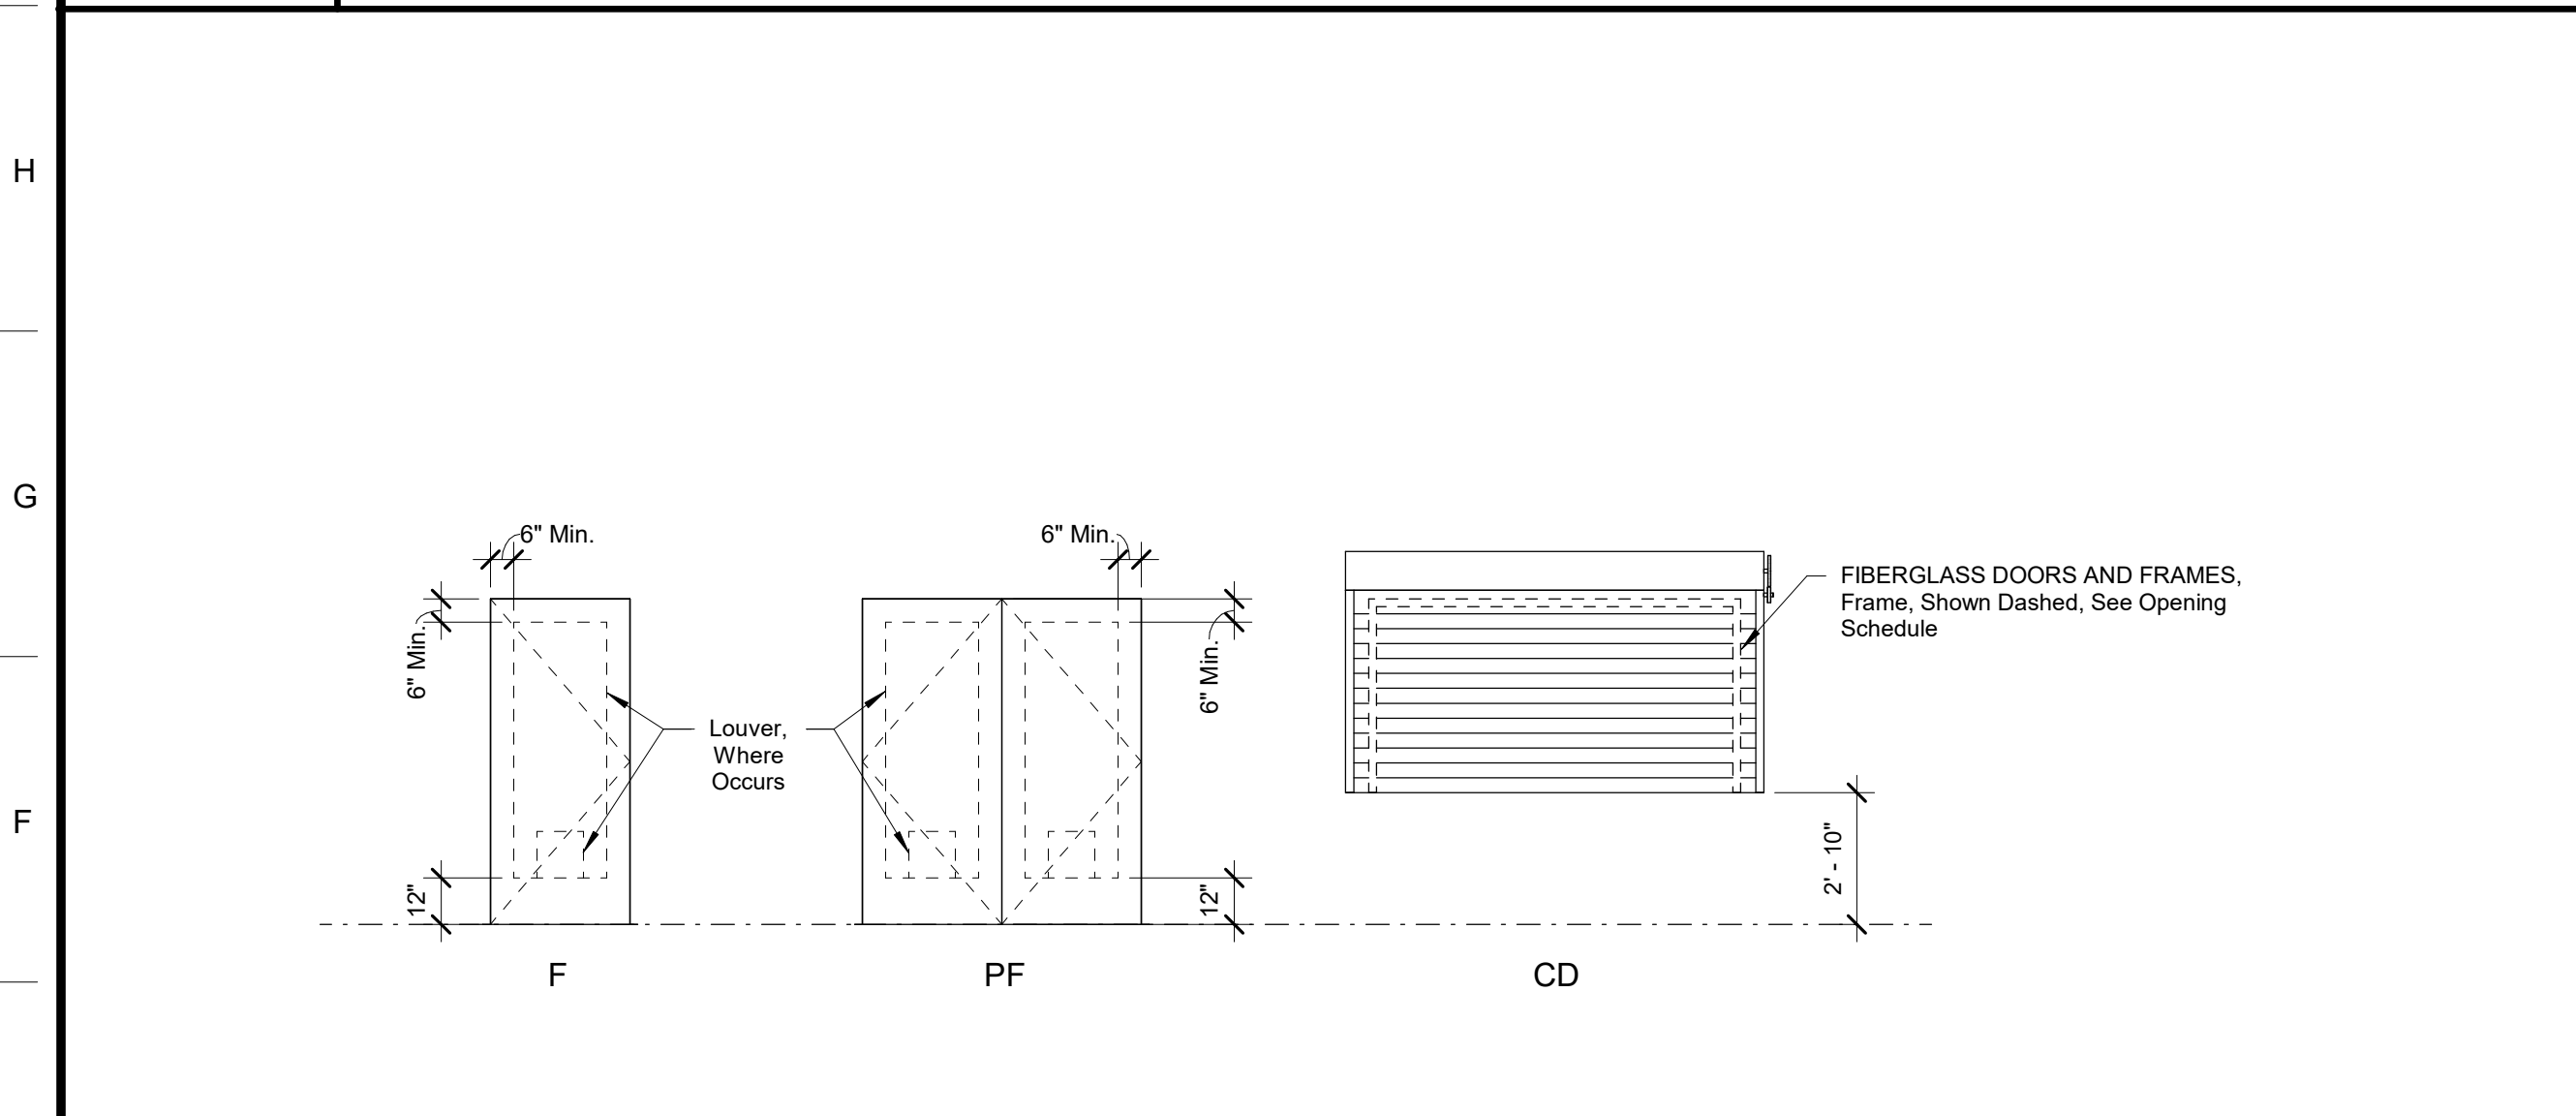

J7 Door Schedule
No Scale

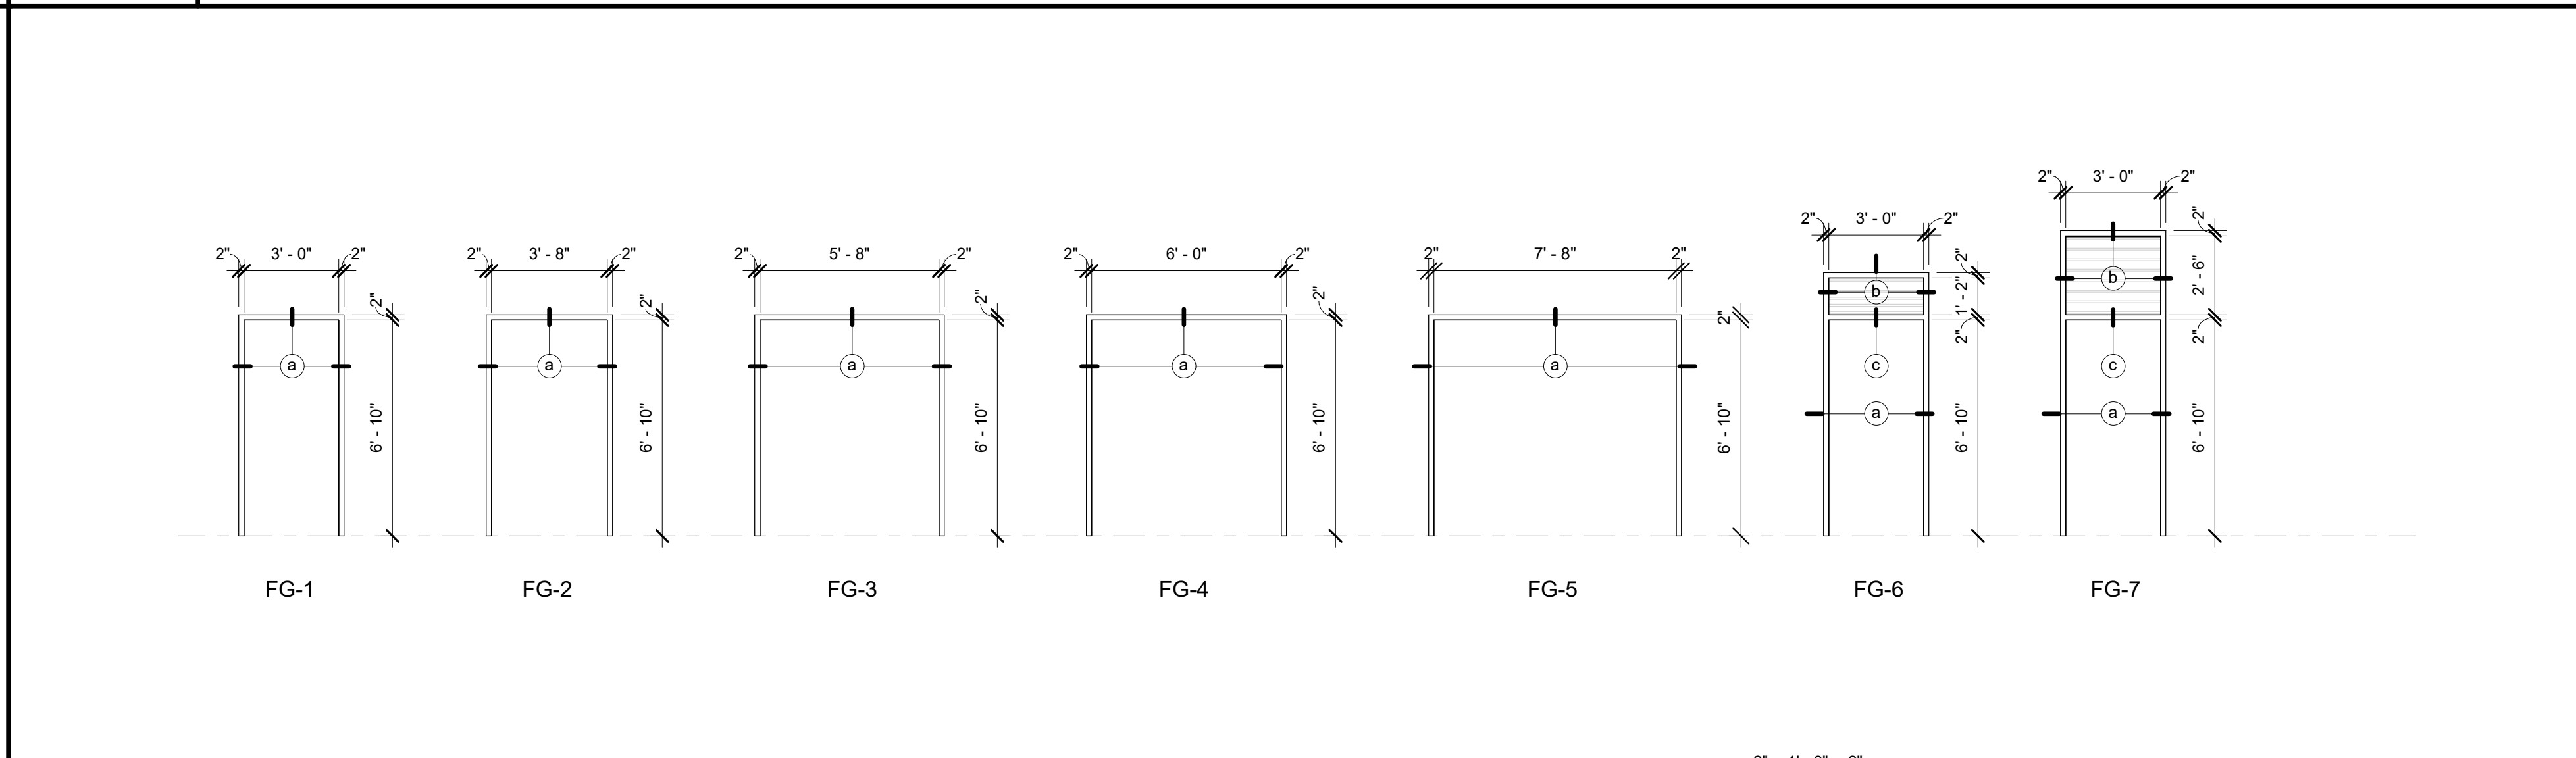

E1 Door Types
No Scale

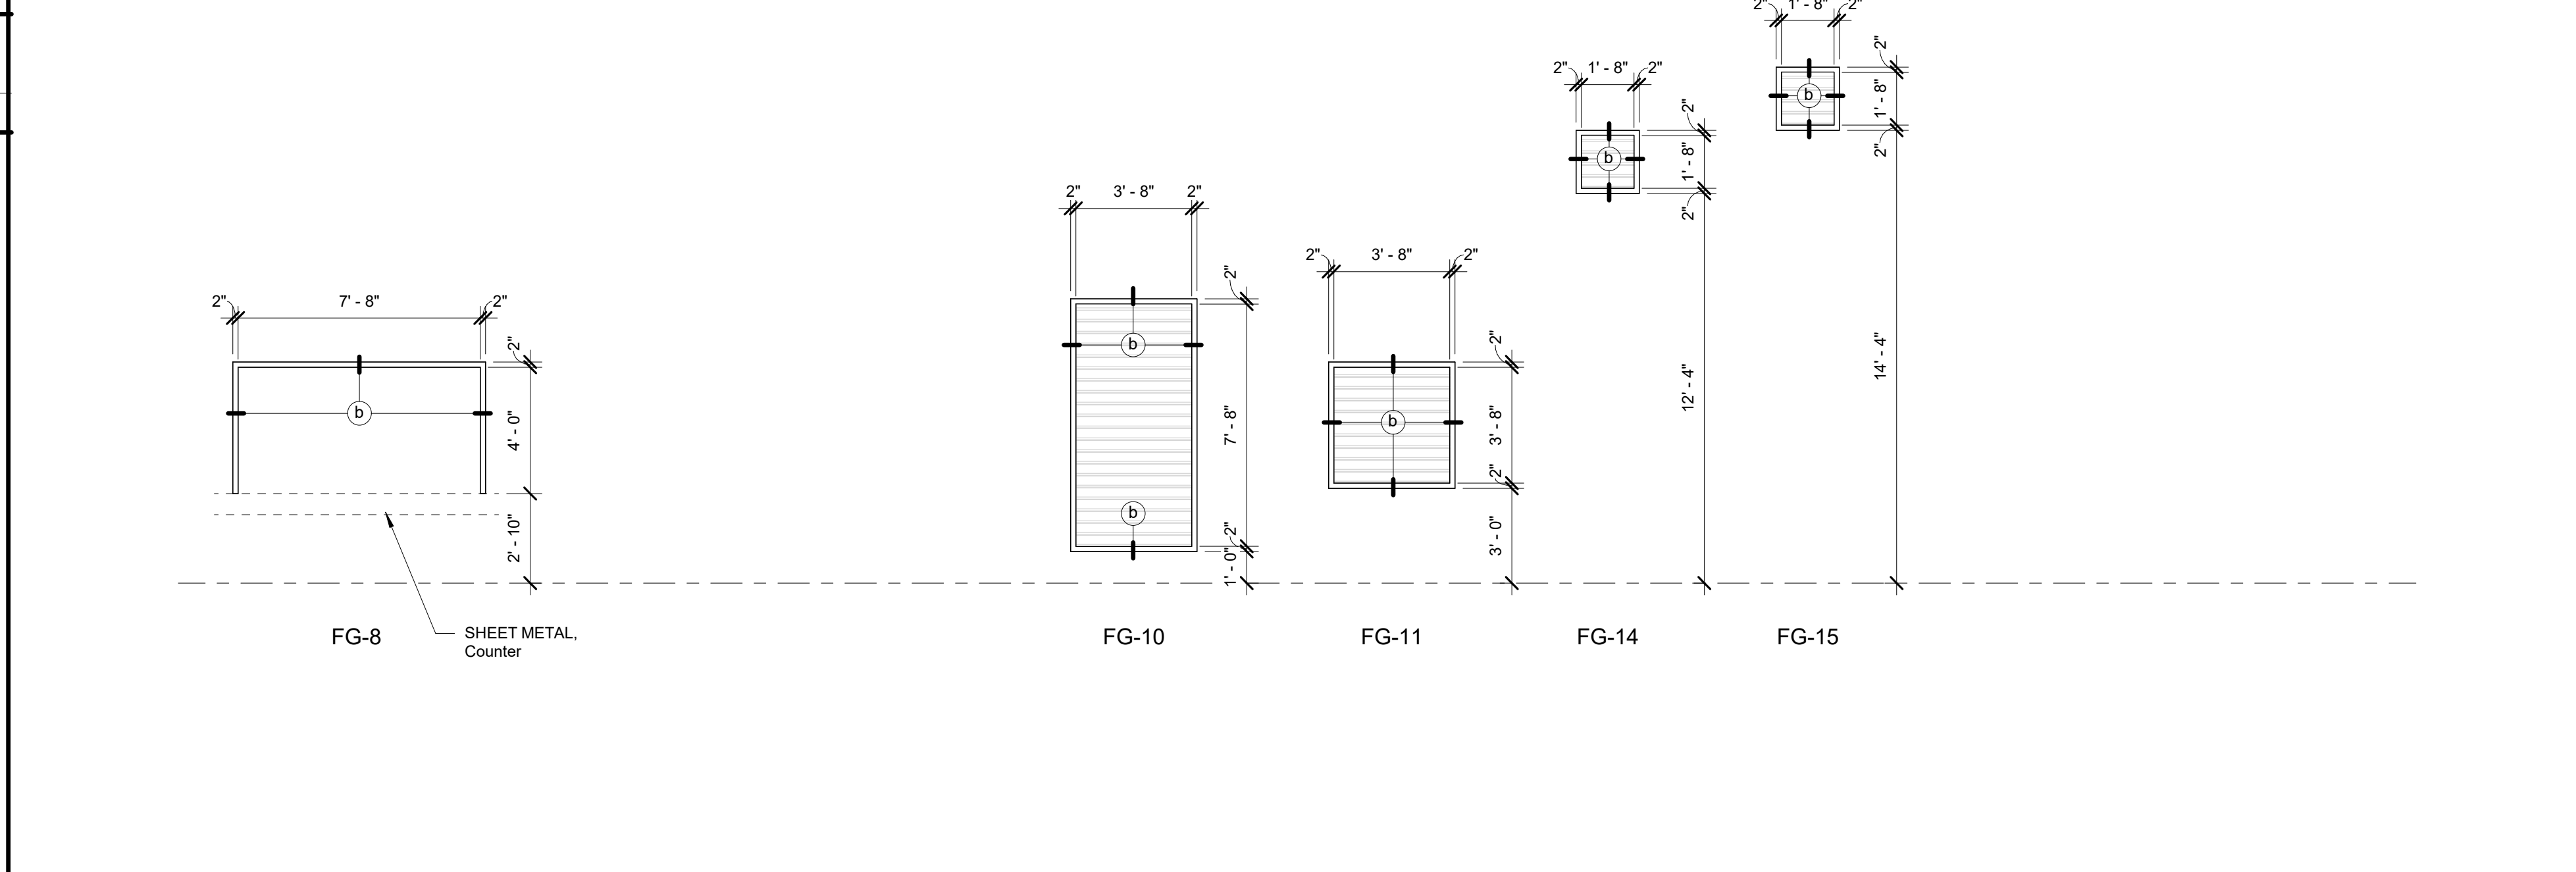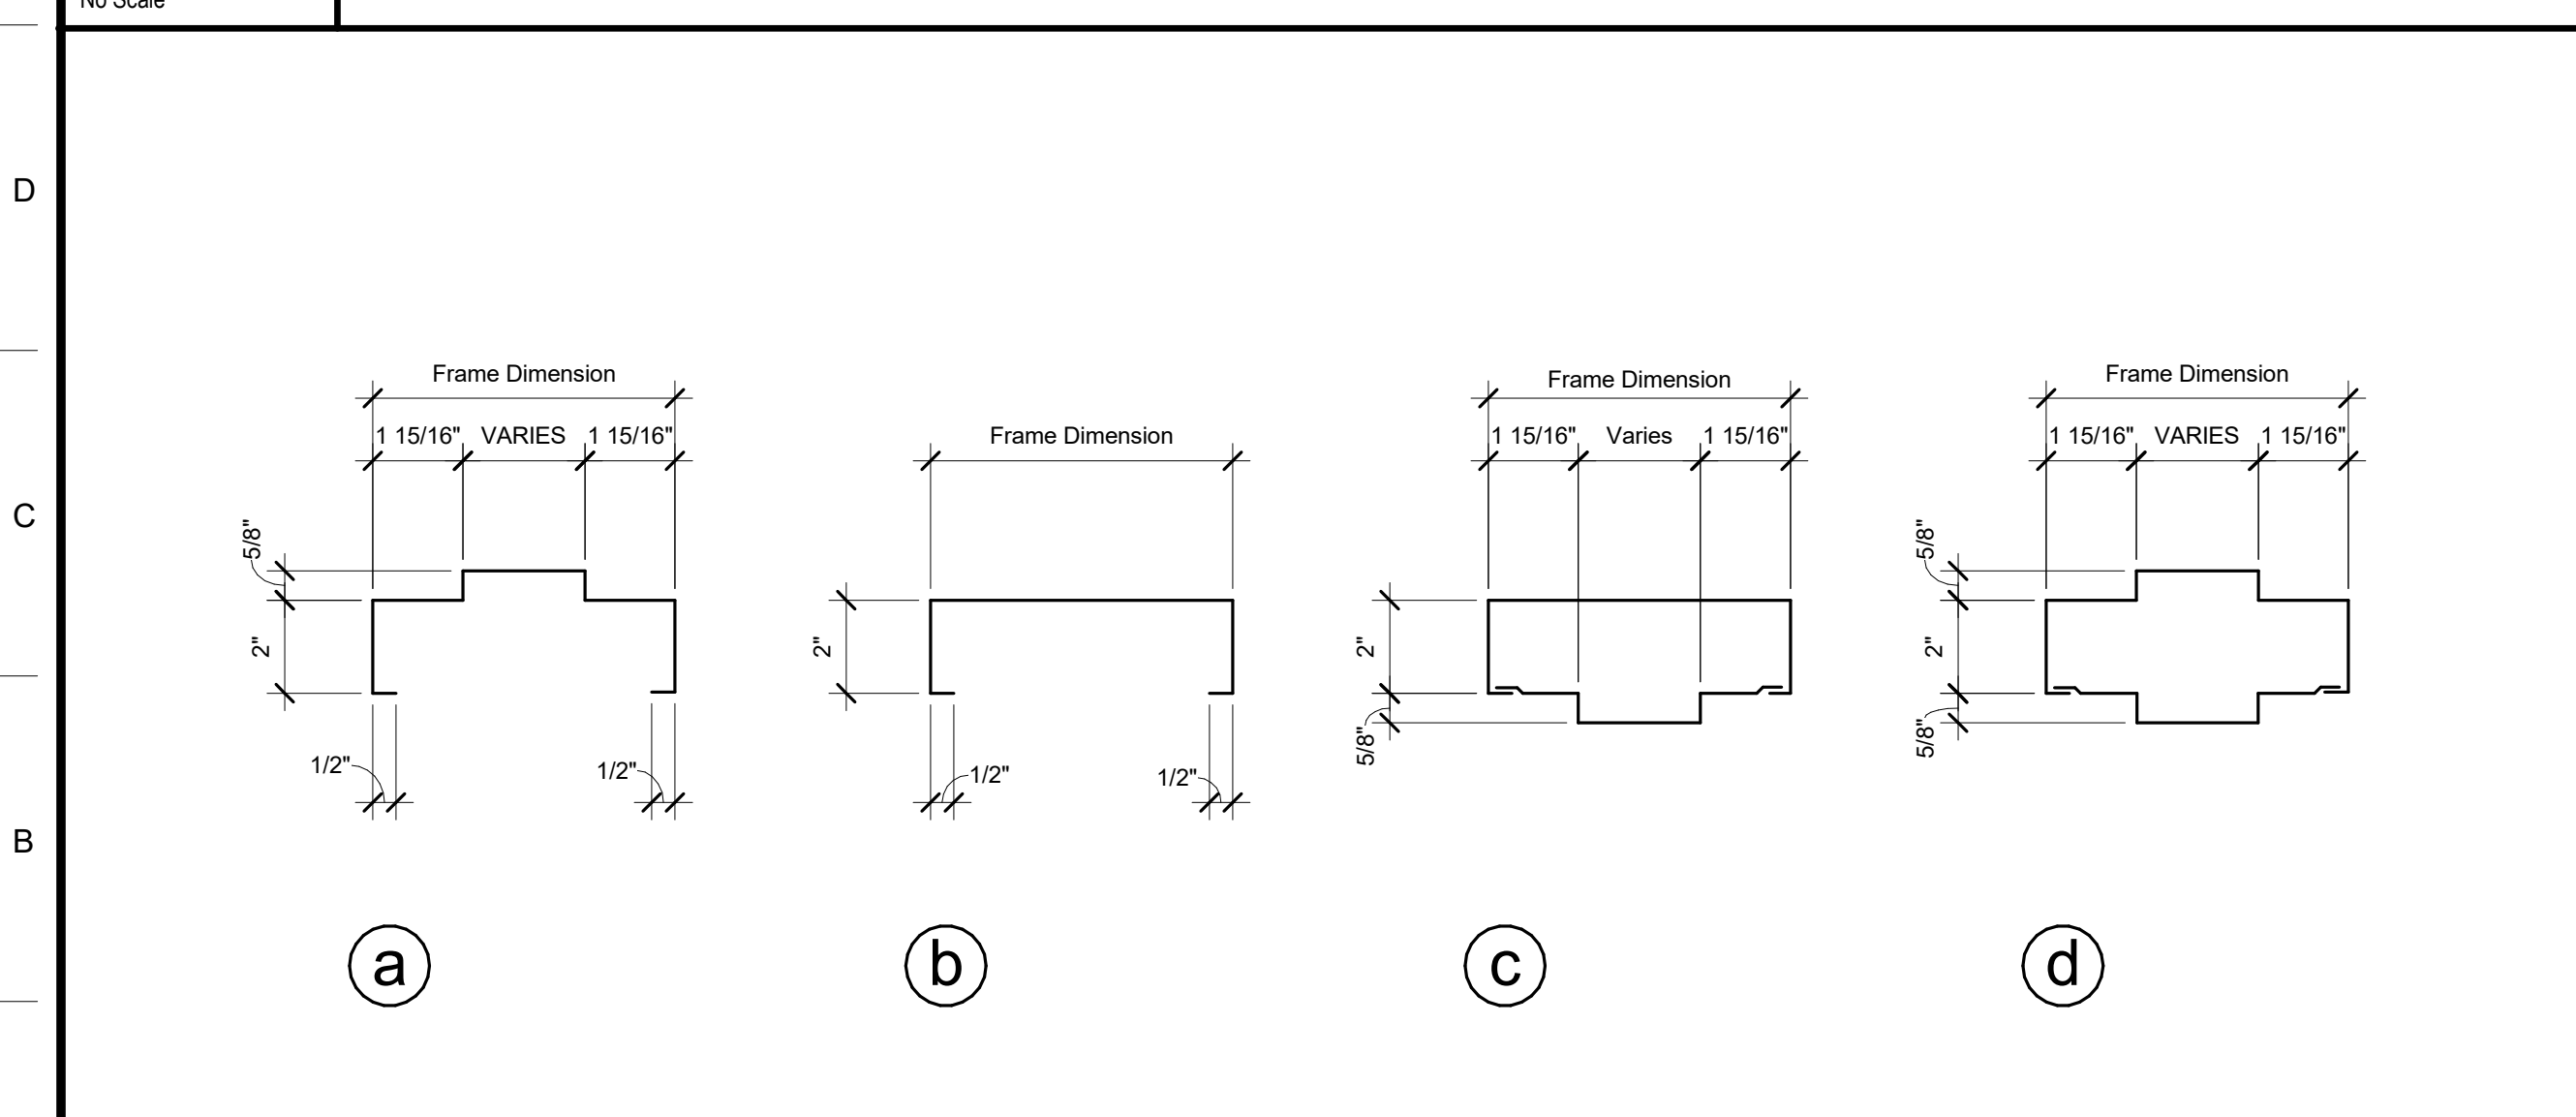

A1 Fiberglass Frame Details
3" = 1'-0"



A7 Frame Types
No Scale



F18 Opening Schedule Legend
No Scale

Mission Oak HS Aquatic Complex
 Tulare Joint Union High School District
 Tulare, CA 93274

Project

TYPICAL INFORMATION
 OPENING SCHEDULES, FRAME ELEVATIONS
 Drawing

ARCHITECTURE
 DARDEN PLANNING INTERIORS
 www.dardenarchitects.com
 6790 N. West Ave. • Fresno, CA 93711 • T. 559.448.8051

Architect


No.	Revision/Submission	Date
1	REVISION_01	05/31/2023

Revision

Designed By: MF Copyright 2022 Darden Architects
 Scale: As indicated Drawn By: KT
 Project Number: 2180 Checked By: -
 Date: 03/28/2023 Reviewed By: MF


X/A401

8/18/2023 4:29:41 PM e:\Users\alvin\Documents\180 Mission Oak HS Aquatic Complex_RD01_VZZ_A\InV.nt

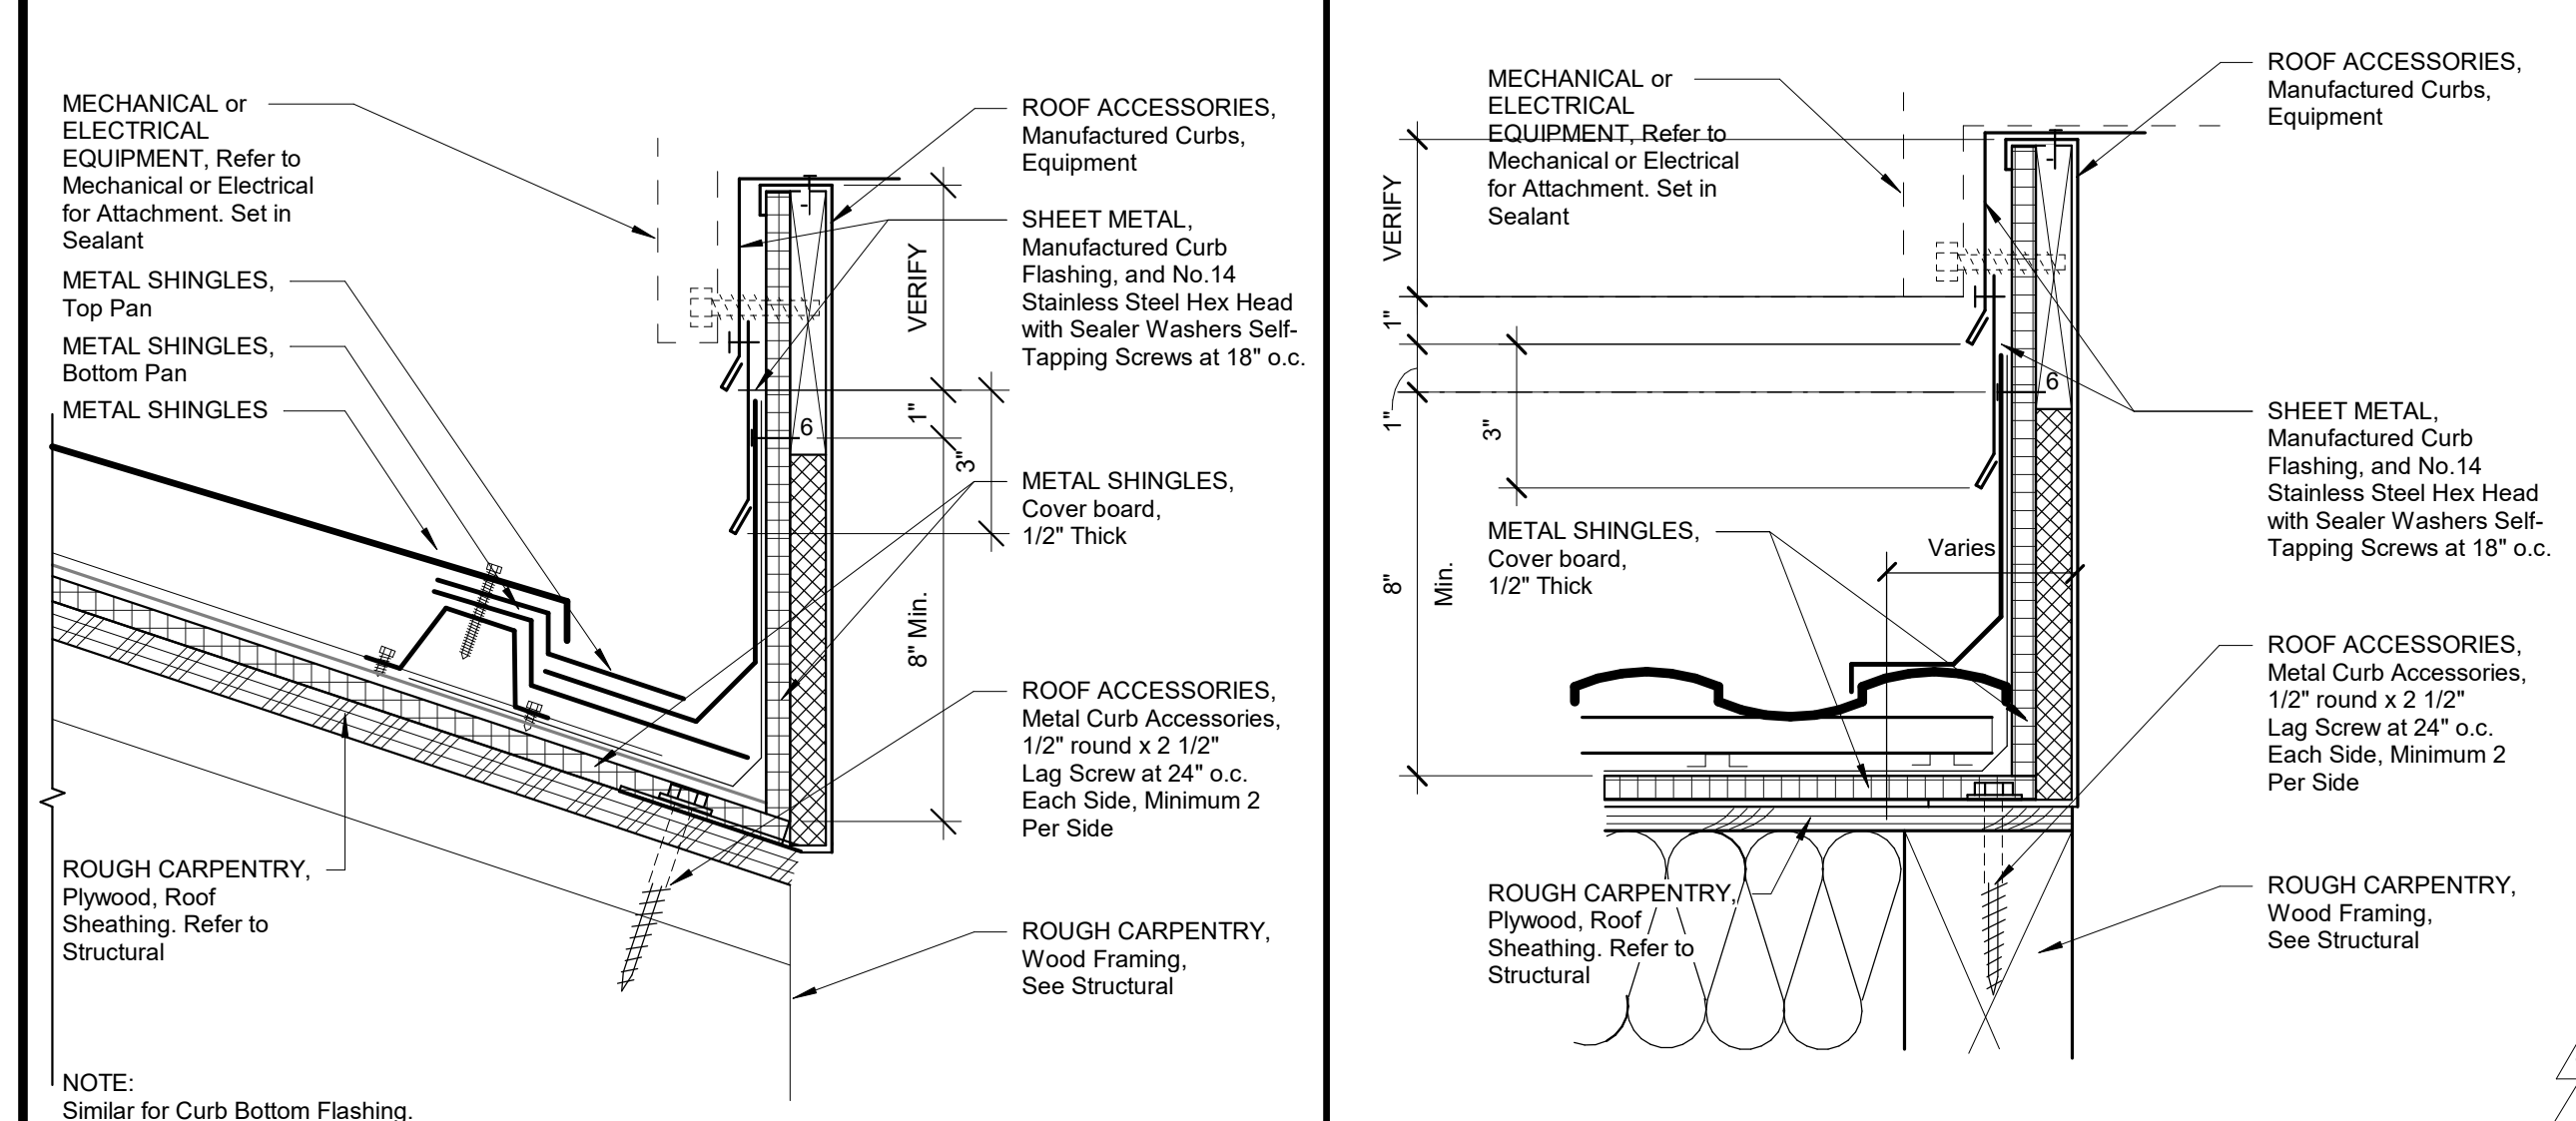


J1 ROOF ACCESSORIES, Equipment Curb Top
 3" = 1'-0"


J4 ROOF ACCESSORIES, Equipment Curb Side
 3" = 1'-0"

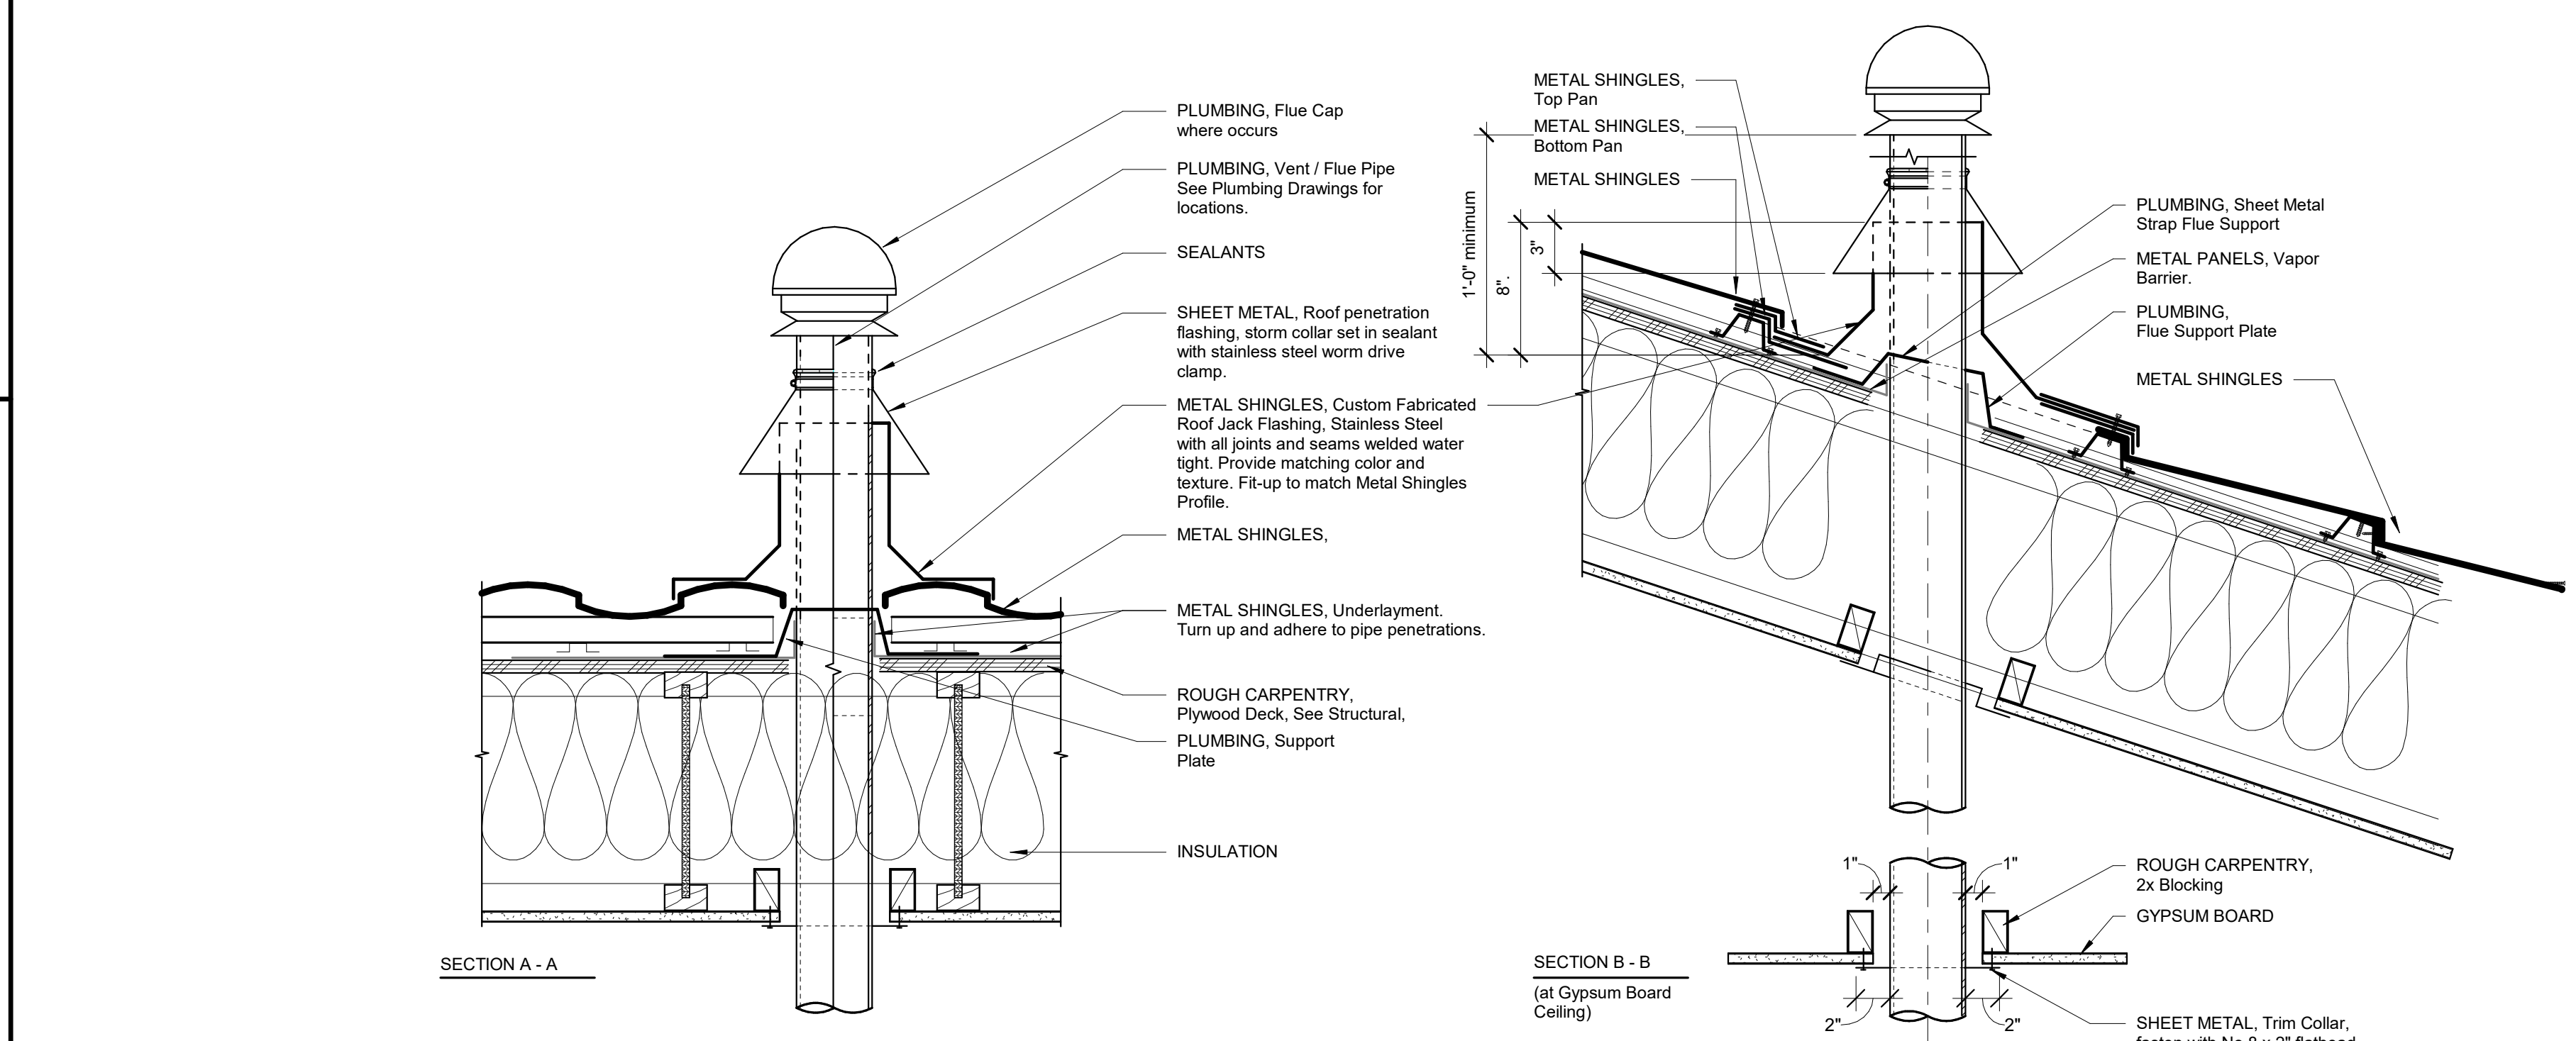

J7 METAL SHINGLES, Roof Penetration Flashing, Flue
 1 1/2" = 1'-0"

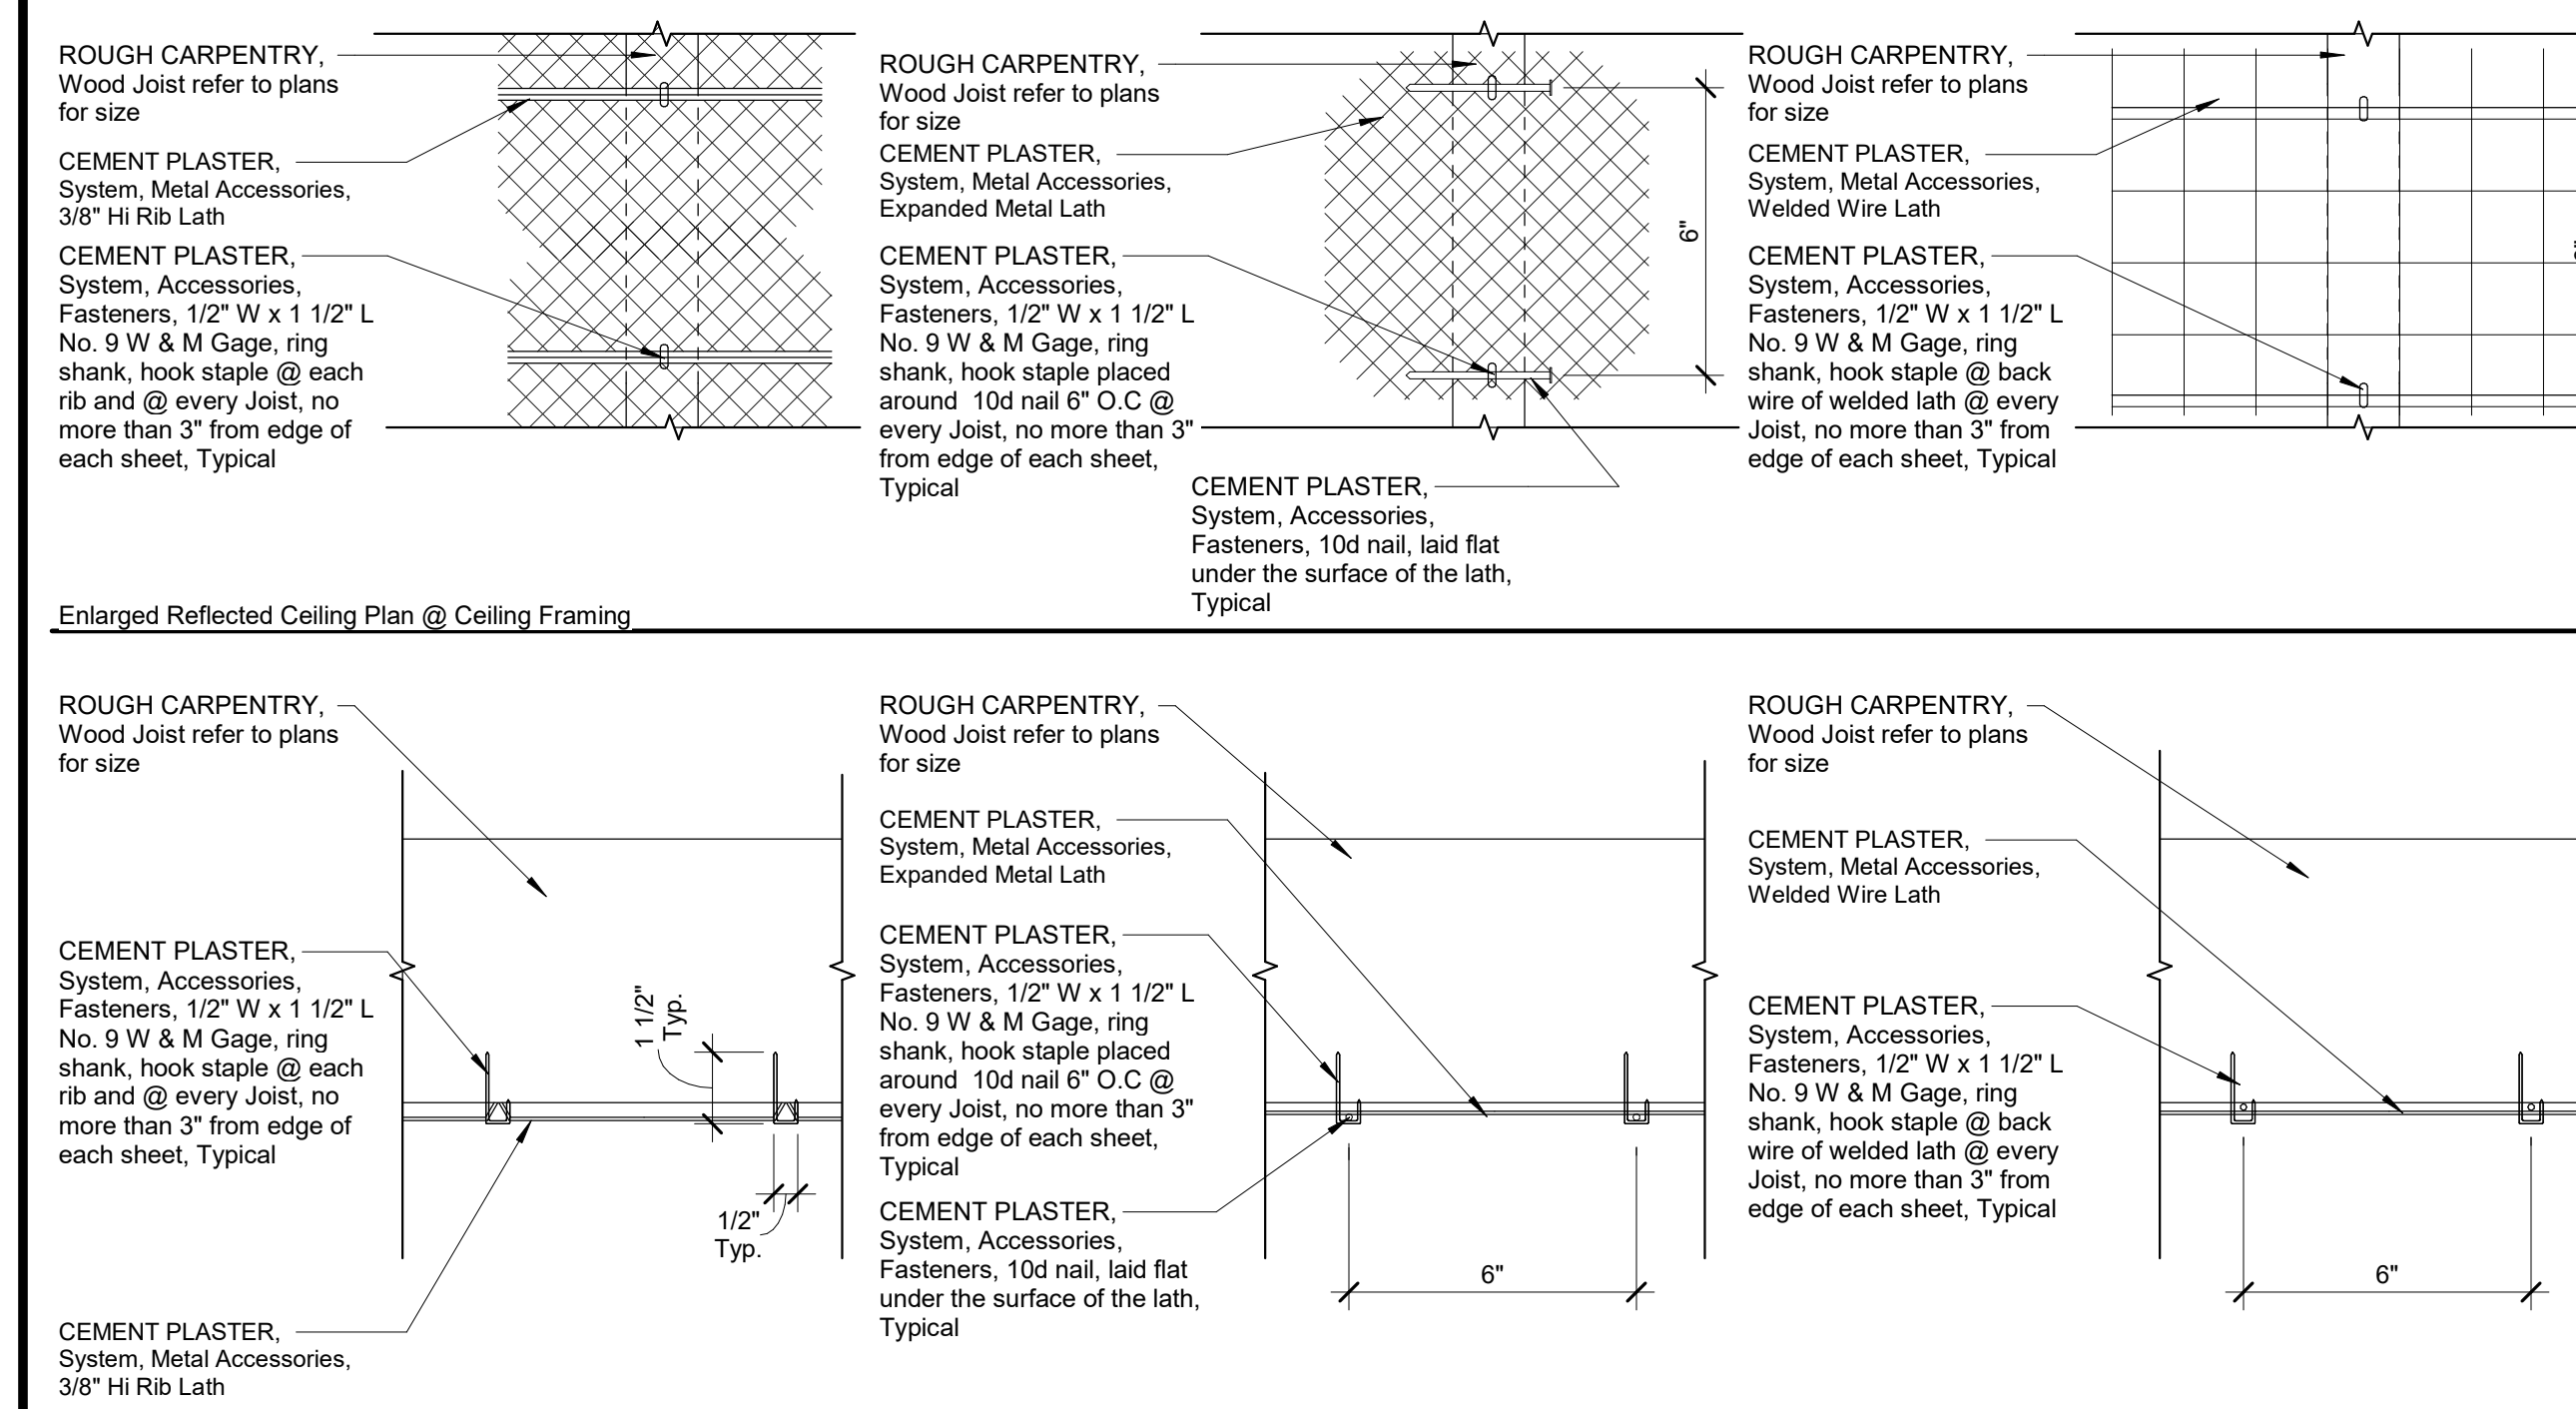

A1 CEMENT PLASTER, Metal Accessories @ Horizontal Wood Framing
 3" = 1'-0"

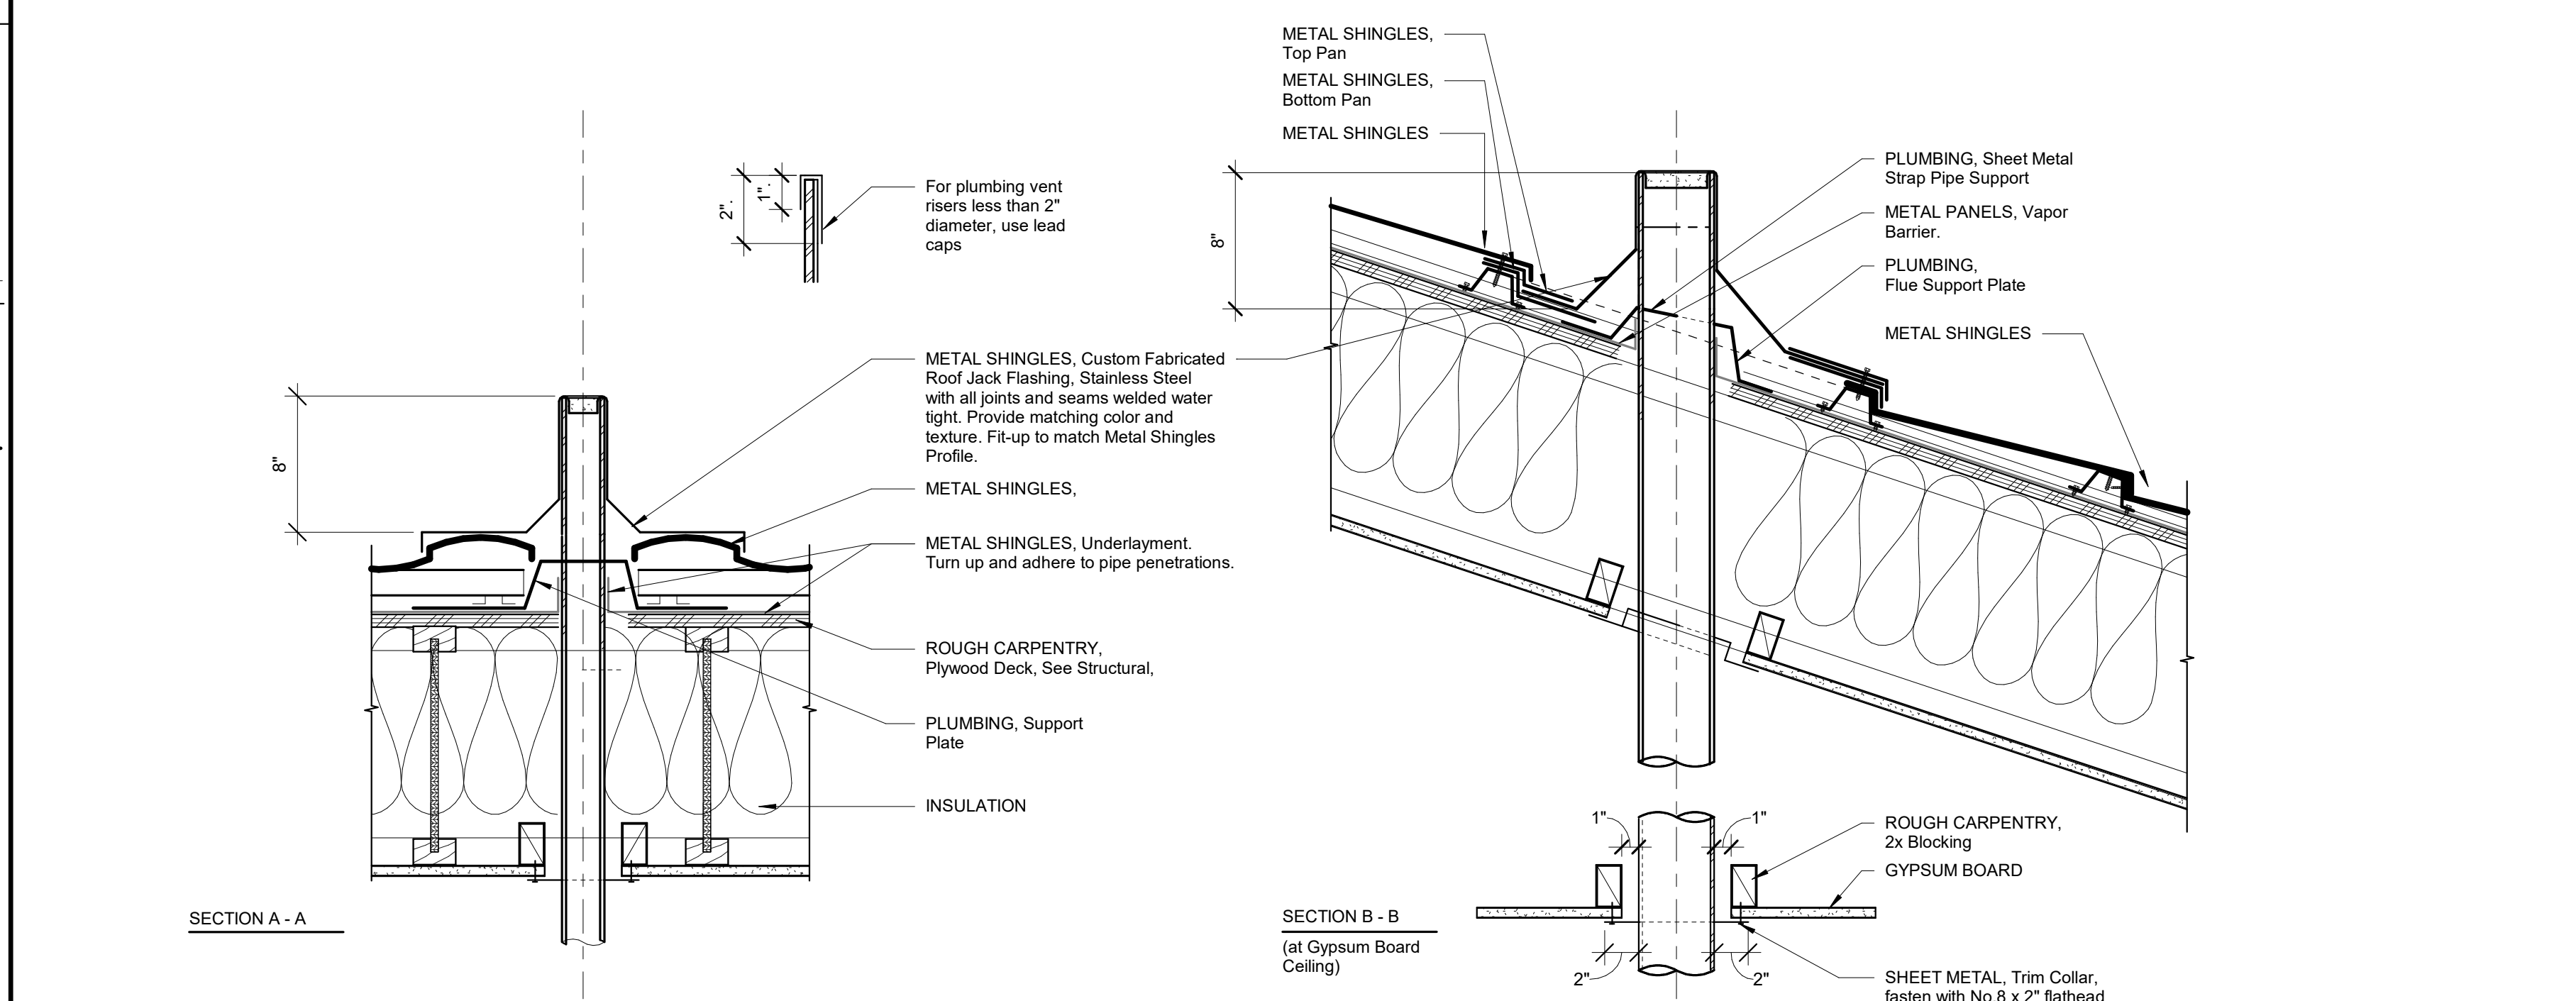

A7 METAL SHINGLES, Roof Penetration Plumbing Vent Riser
 1 1/2" = 1'-0"

Mission Oak HS Aquatic Complex
 Tulare Joint Union High School District
 Tulare, CA 93274

TYPICAL INFORMATION
 EXTERIOR DETAILS
 Drawing

darden ARCHITECTURE
 PLANNING INTERIORS
 architects www.dardenarchitects.com
 6790 N. West Ave. • Fresno, CA 93711 • T. 559.448.8051

Architect


No.	Revision/Submission	Date
1	REVISION_01	05/31/2023

Revision

Designed By: MF Copyright 2022 Darden Architects










Scale: As indicated Drawn By: KT
 Project Number: 2180 Checked By: -
 Date: 03/28/2023 Reviewed By: MF

X/A502

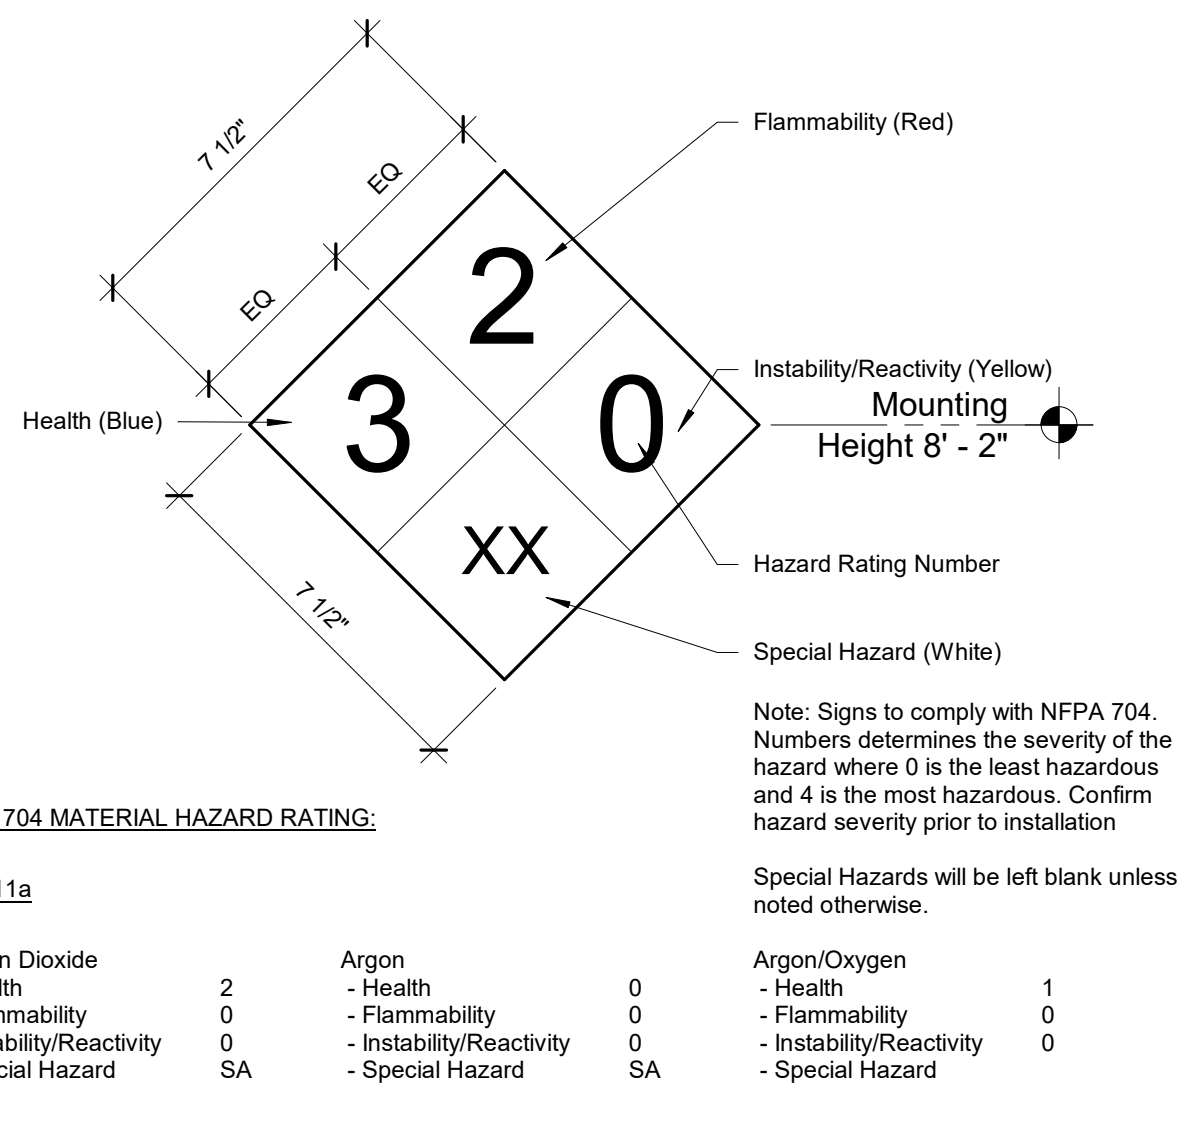


N4
3" = 1'-0"

IDENTIFYING DEVICES, Hazardous Material Signage

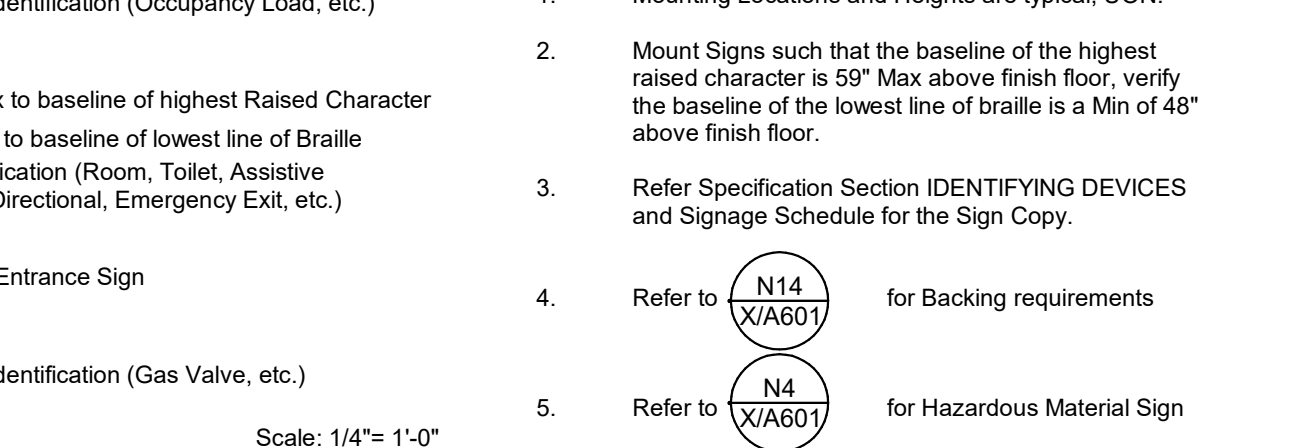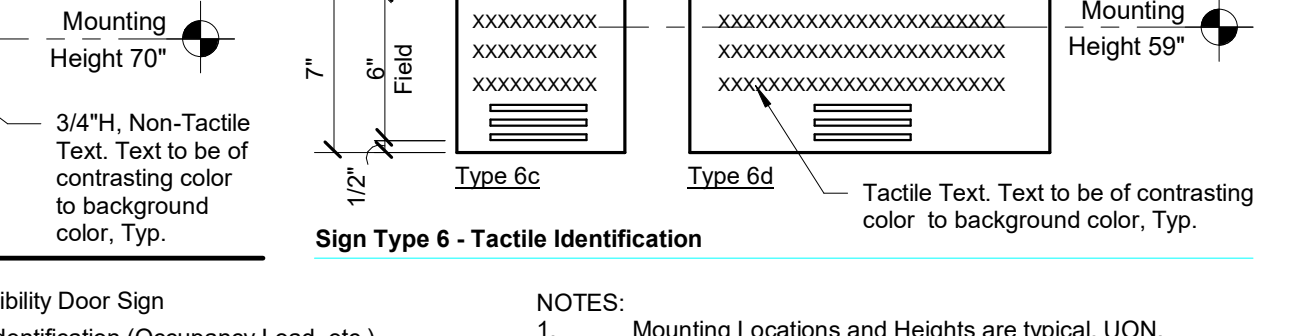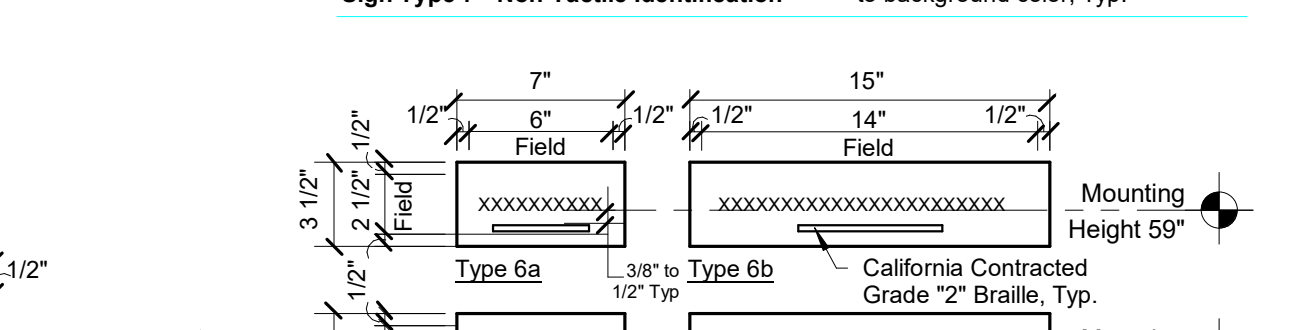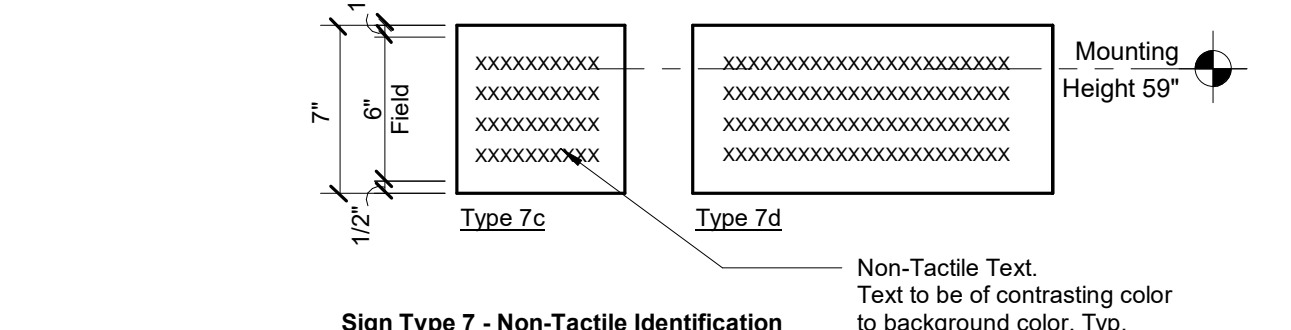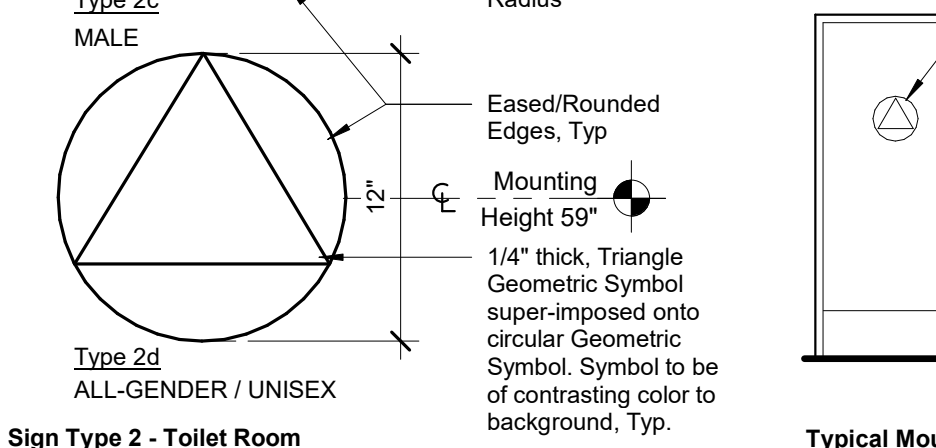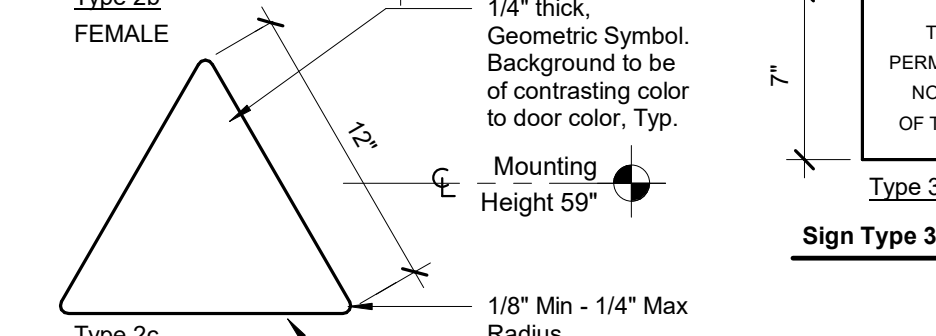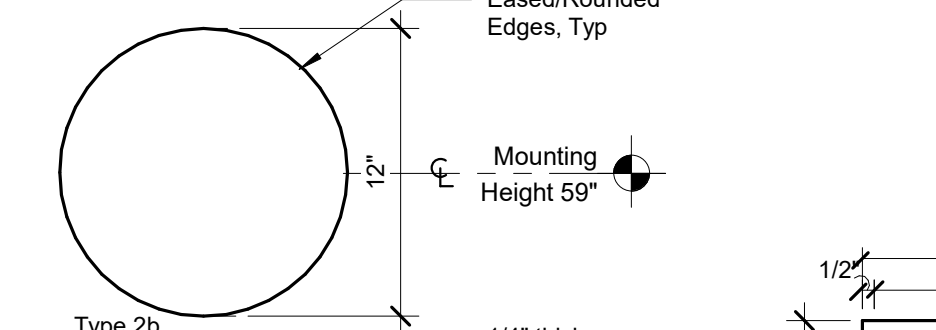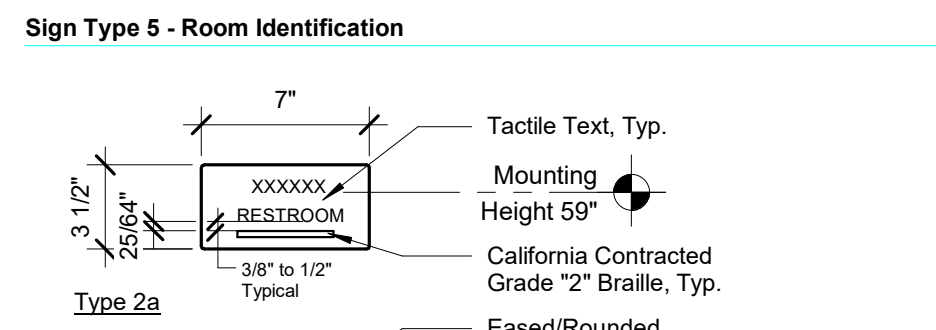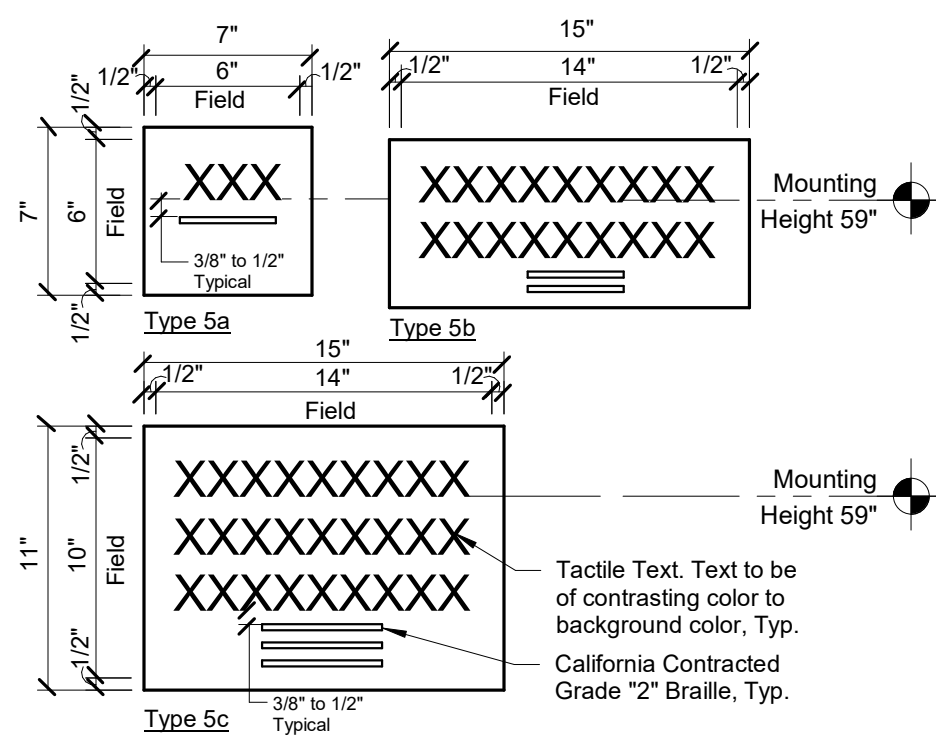

E1
1 1/2" = 1'-0"

IDENTIFYING DEVICES, Signage Locations and Dimensions

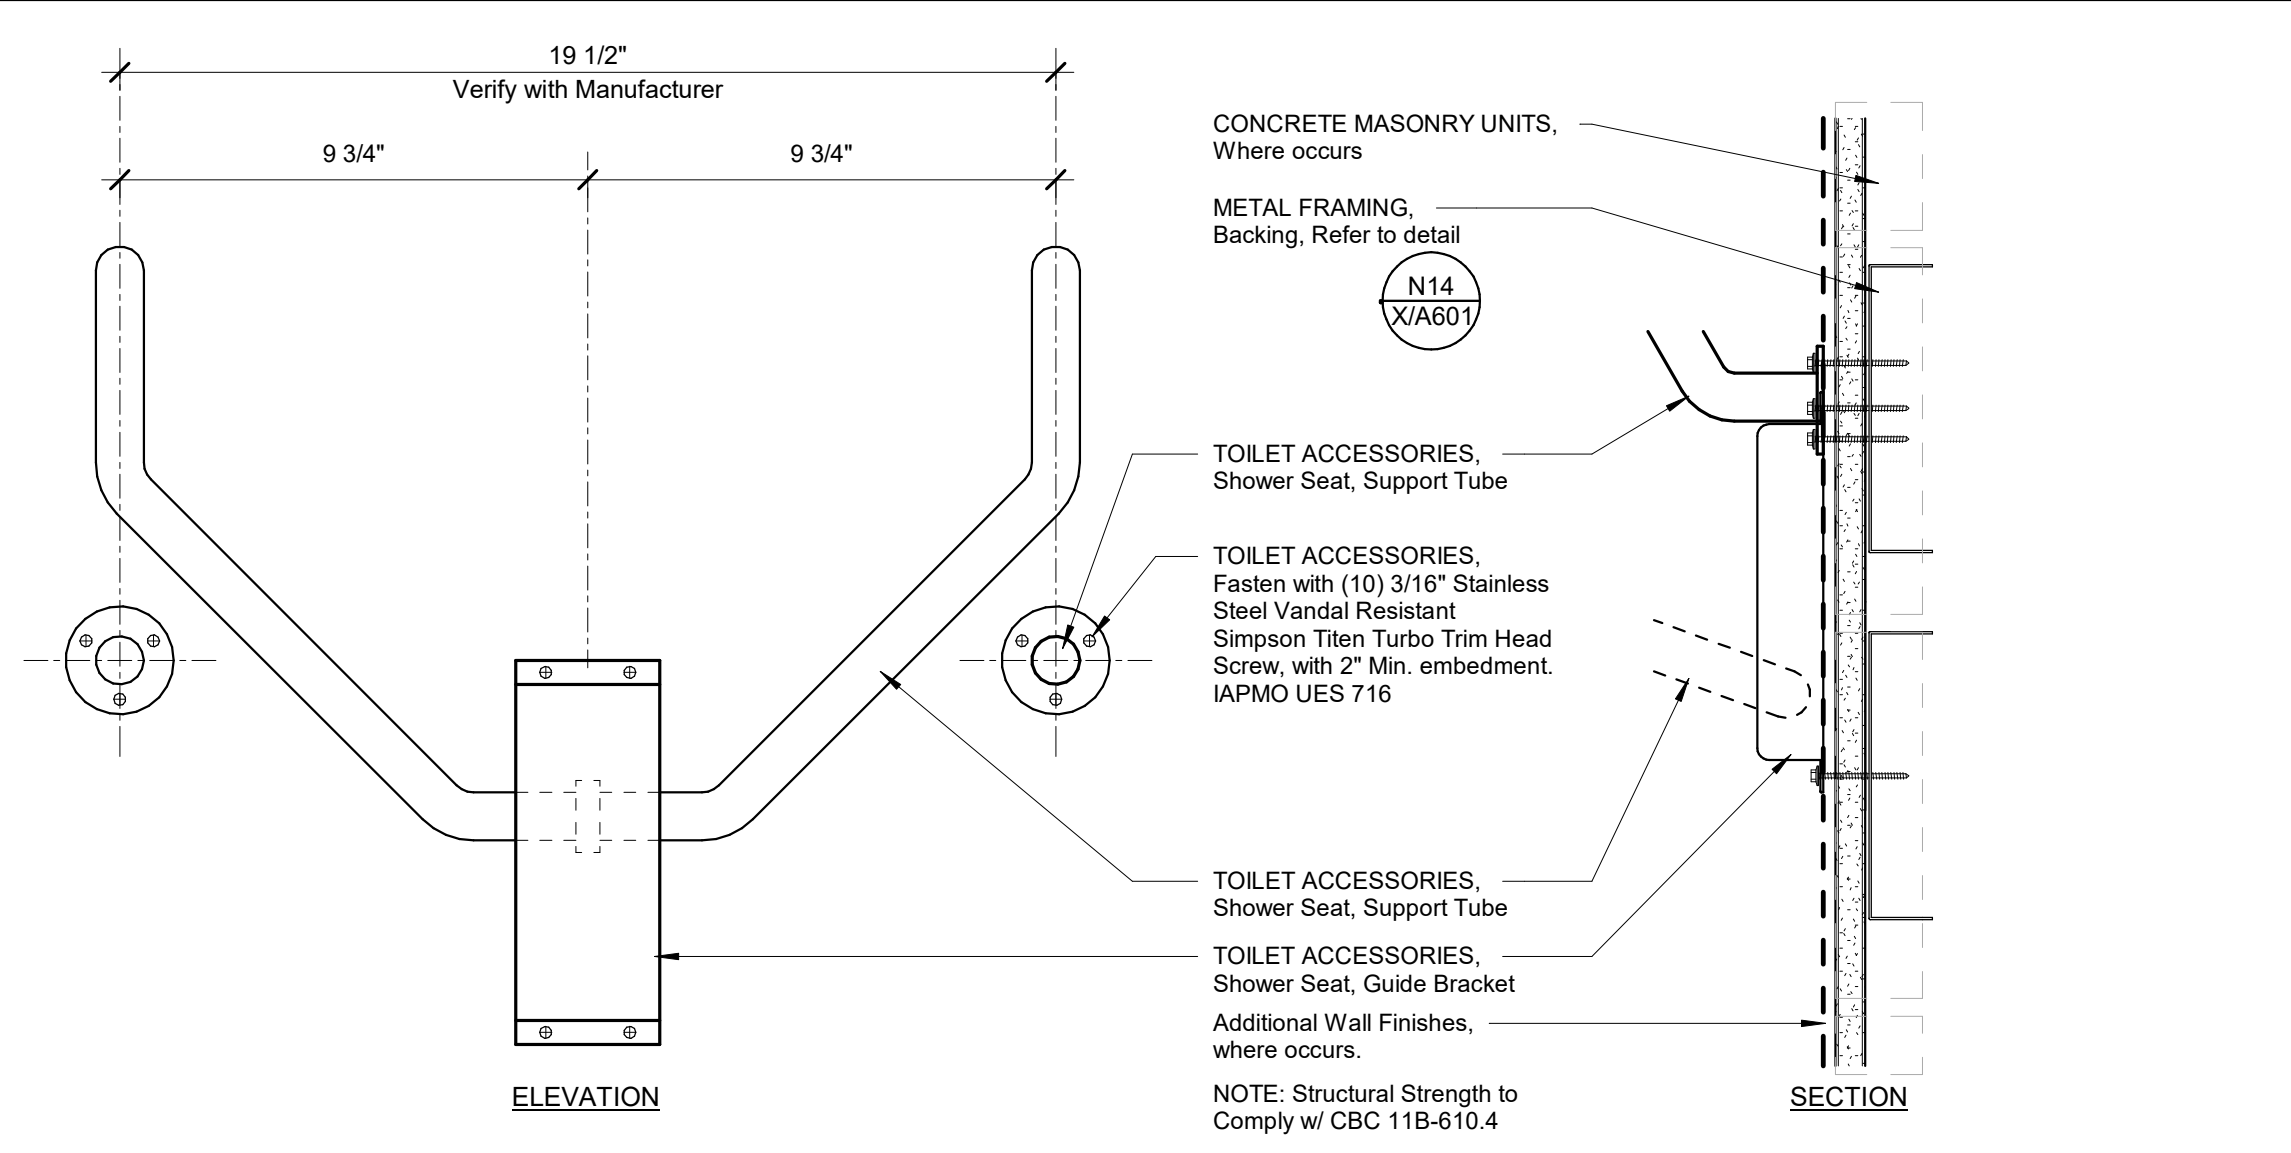


A1
3" = 1'-0"

TOILET ACCESSORIES, L-Shaped Accessible Shower Seat

E7
3/4" = 1'-0"

TOILET ACCESSORIES, Accessible Shower

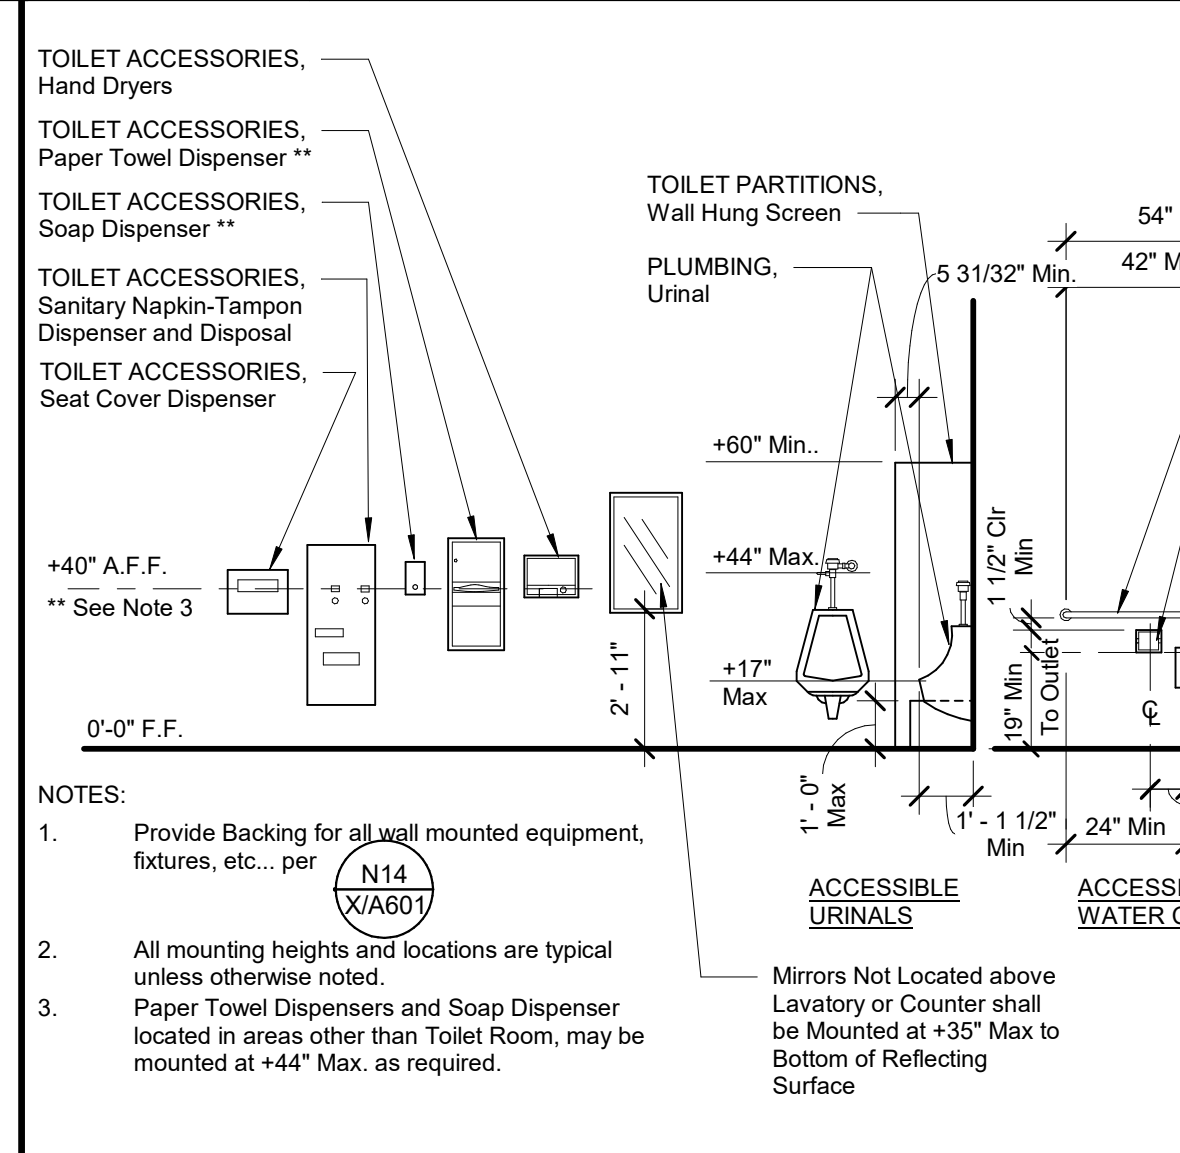


A7
1/4" = 1'-0"

TOILET ACCESSORIES AND PLUMBING FIXTURES,

E11
1" = 1'-0"

MISCELLANEOUS SPECIALTIES, Swimsuit Spinner

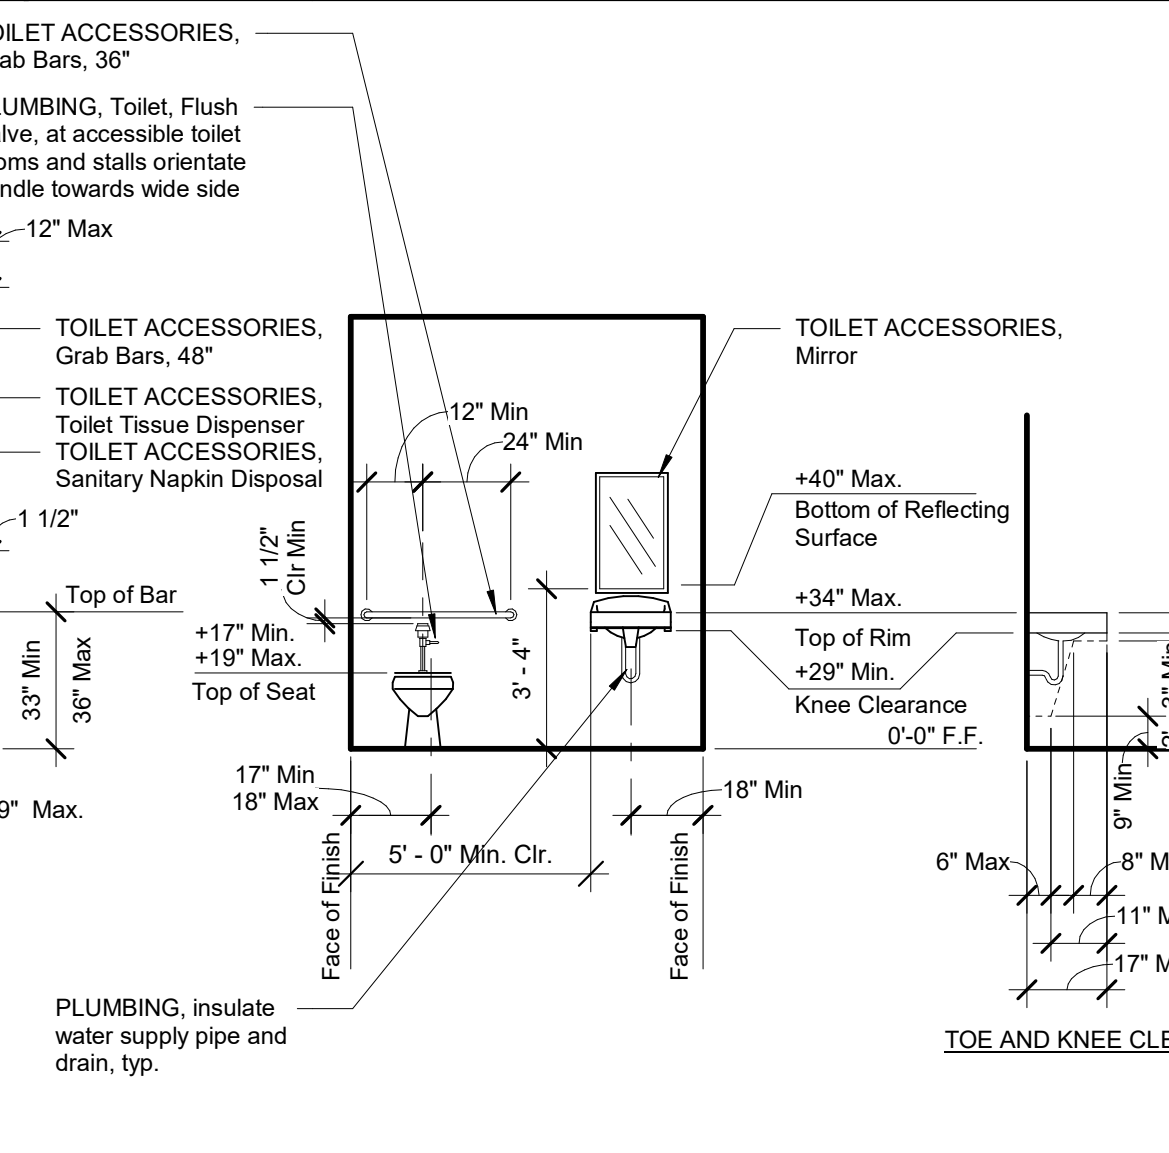


A14
6" = 1'-0"

WALL COVERINGS, Solid Surface

E14
6" = 1'-0"

WALL COVERINGS, FRP Panels

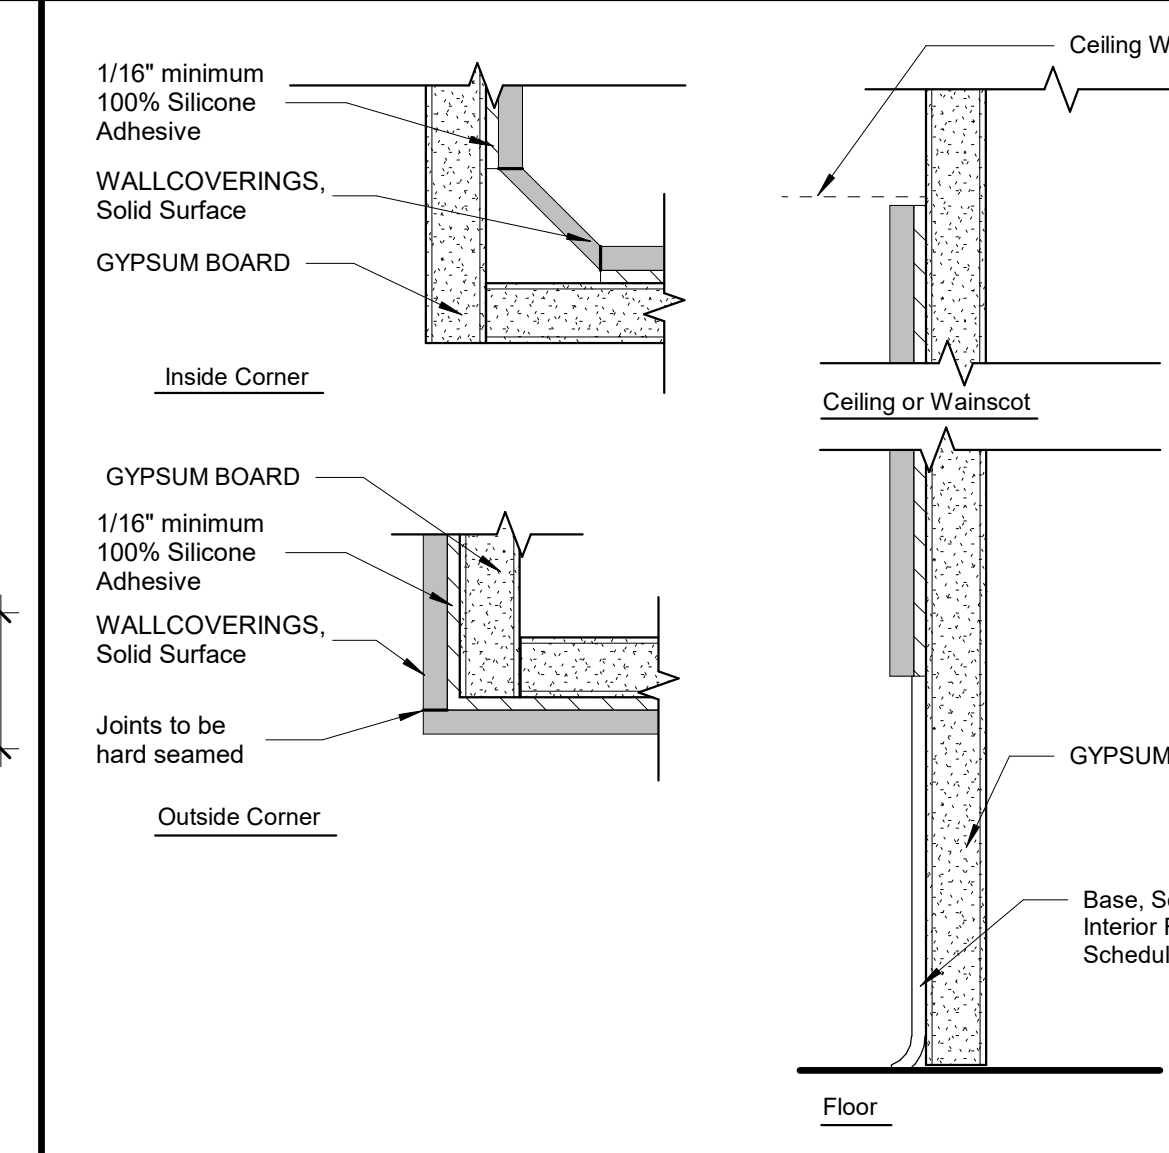


A14
6" = 1'-0"

WALL COVERINGS, Solid Surface


J11
3" = 1'-0"

TOILET ACCESSORIES, Grab Bars

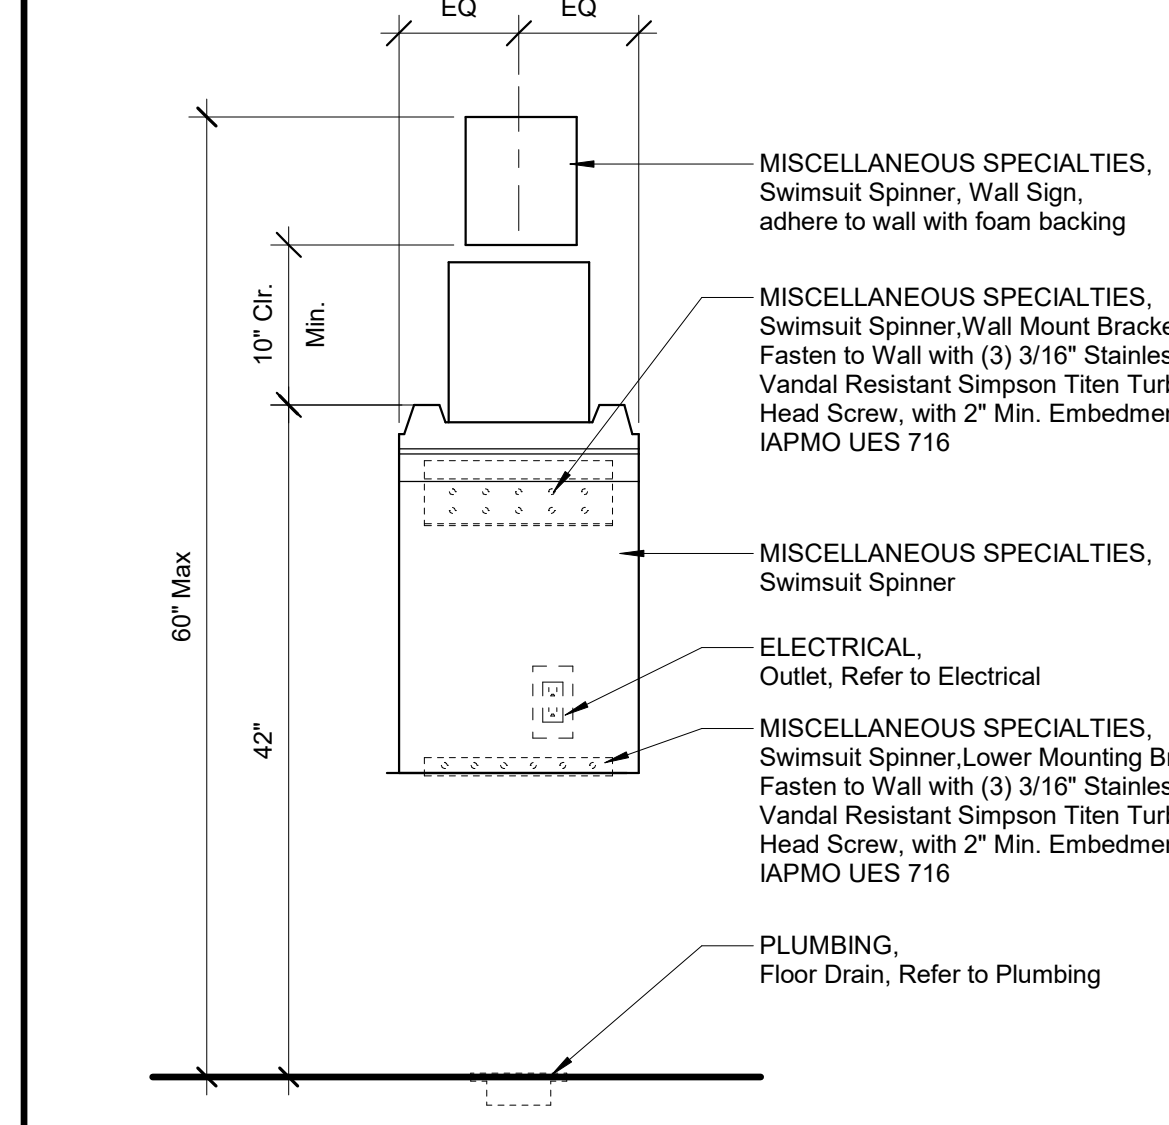


J14
6" = 1'-0"

GYPSUM BOARD, Metal Accessories

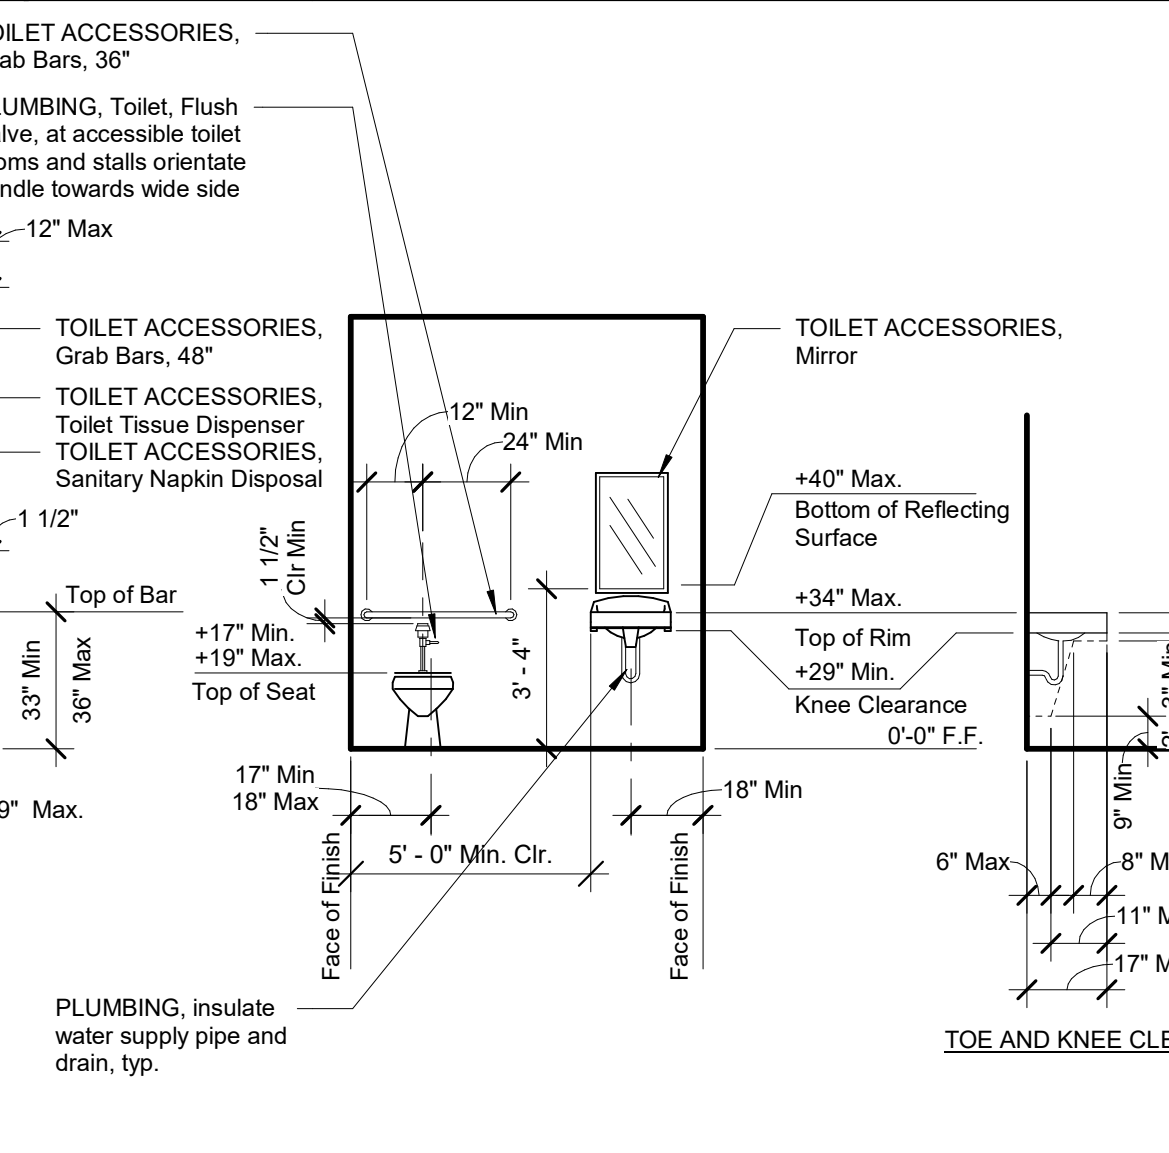


N14
1" = 1'-0"

METAL FRAMING, Backing Detail

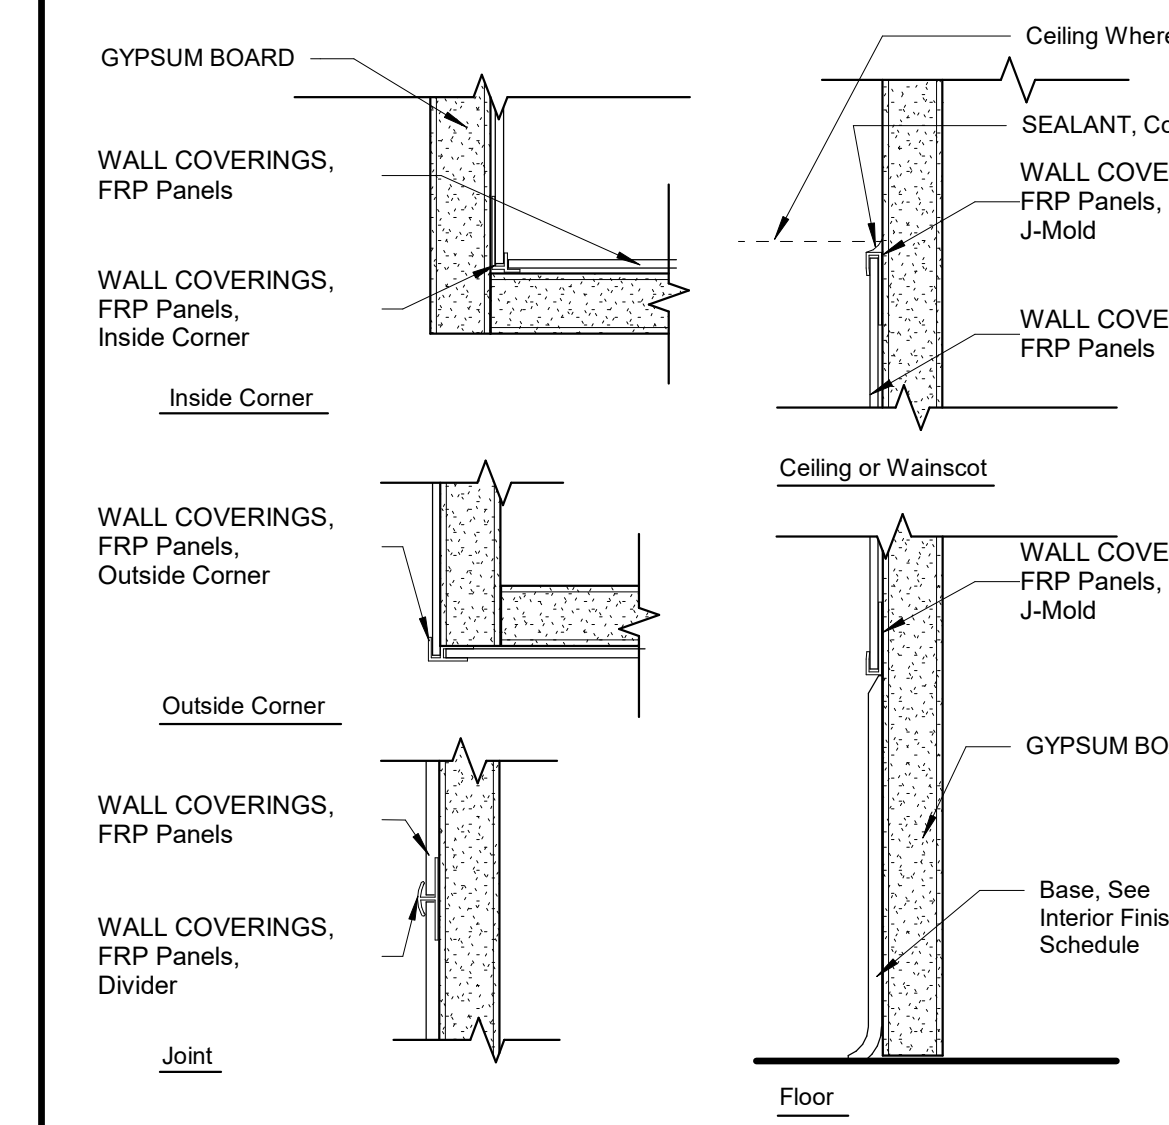

M18
No Scale

Interior Detail Notes

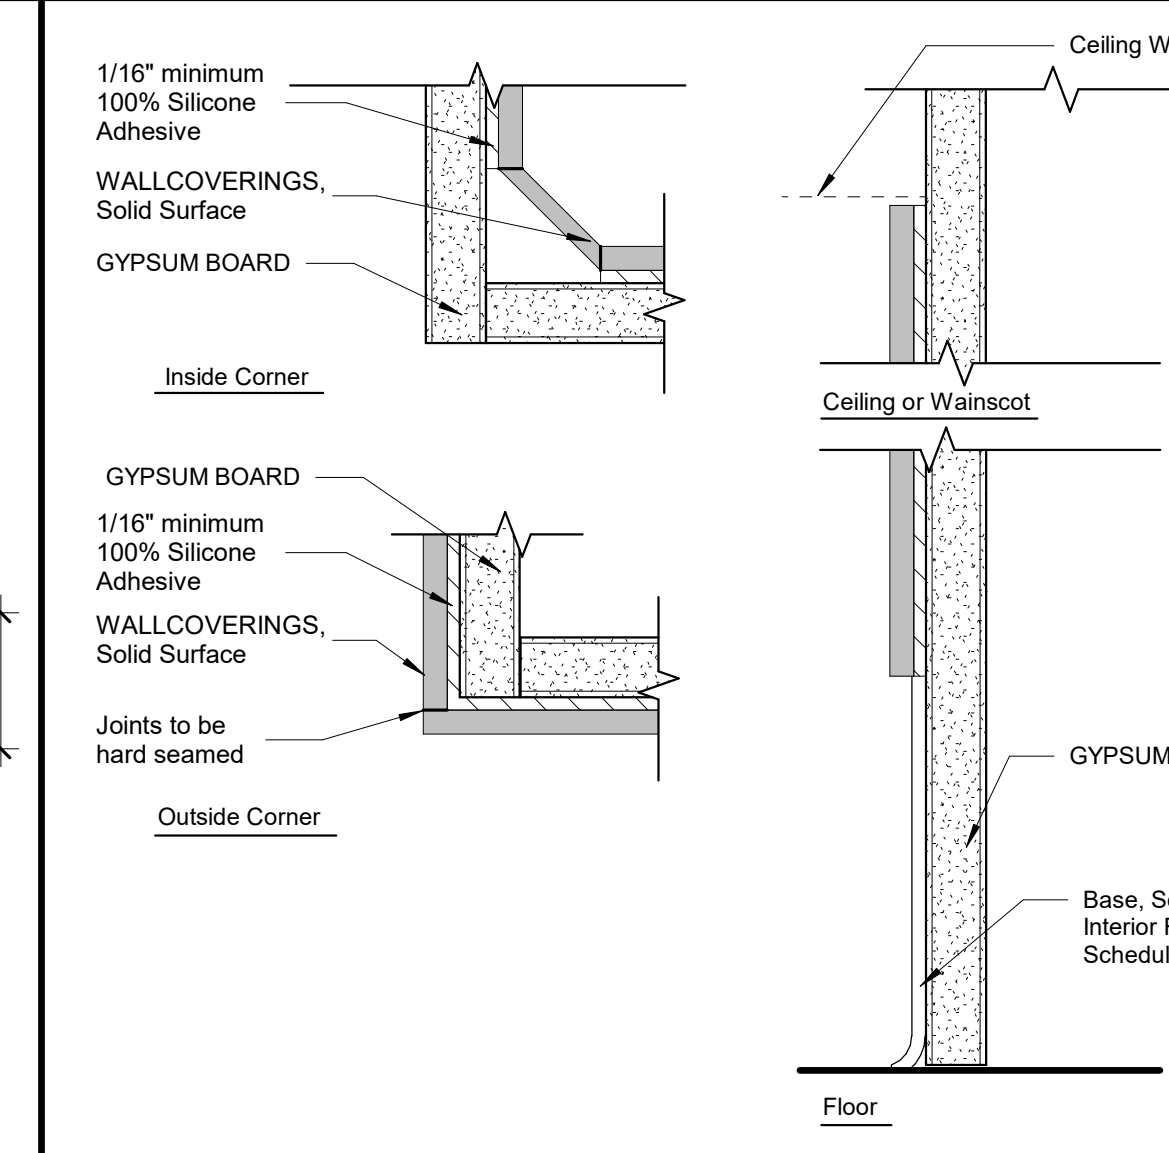

DSA File No.: 54-H11
DSA Application No.: 02-120251
Agency Approval

NOTES

- GYPSUM BOARD, Metal Accessories, Refer to Detail J14 X/A601
- CEMENT PLASTER, ACCESSORIES, Refer to Detail A14 X/A601
- WALL COVERINGS, FRP Panels, Aluminum Trim, Refer to Detail E14 X/A601
- METAL FRAMING, Backing, Refer to Detail N14 X/A601

M18
No Scale
Interior Detail Notes

Mission Oak HS Aquatic Complex
Tulare Joint Union High School District
Tulare, CA 93274
Project


TYPICAL INFORMATION INTERIOR & SIGNAGE DETAILS





No.	Revision/Submission	Date
1	REVISION_01	05/31/2023

Revision


Designed By: MF
Copyright © 2022 Darden Architects
Scale: As indicated
Drawn By: KT
Project Number: 2180
Checked By: -
Date: 03/28/2023
Reviewed By: MF

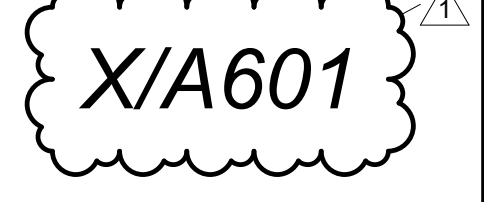

8/18/2023 4:29:46 PM
e:\Users\alvin\Documents\180 Mission Oak HS Aquatic Complex_RD01_VZ2_A\Invt.vnt

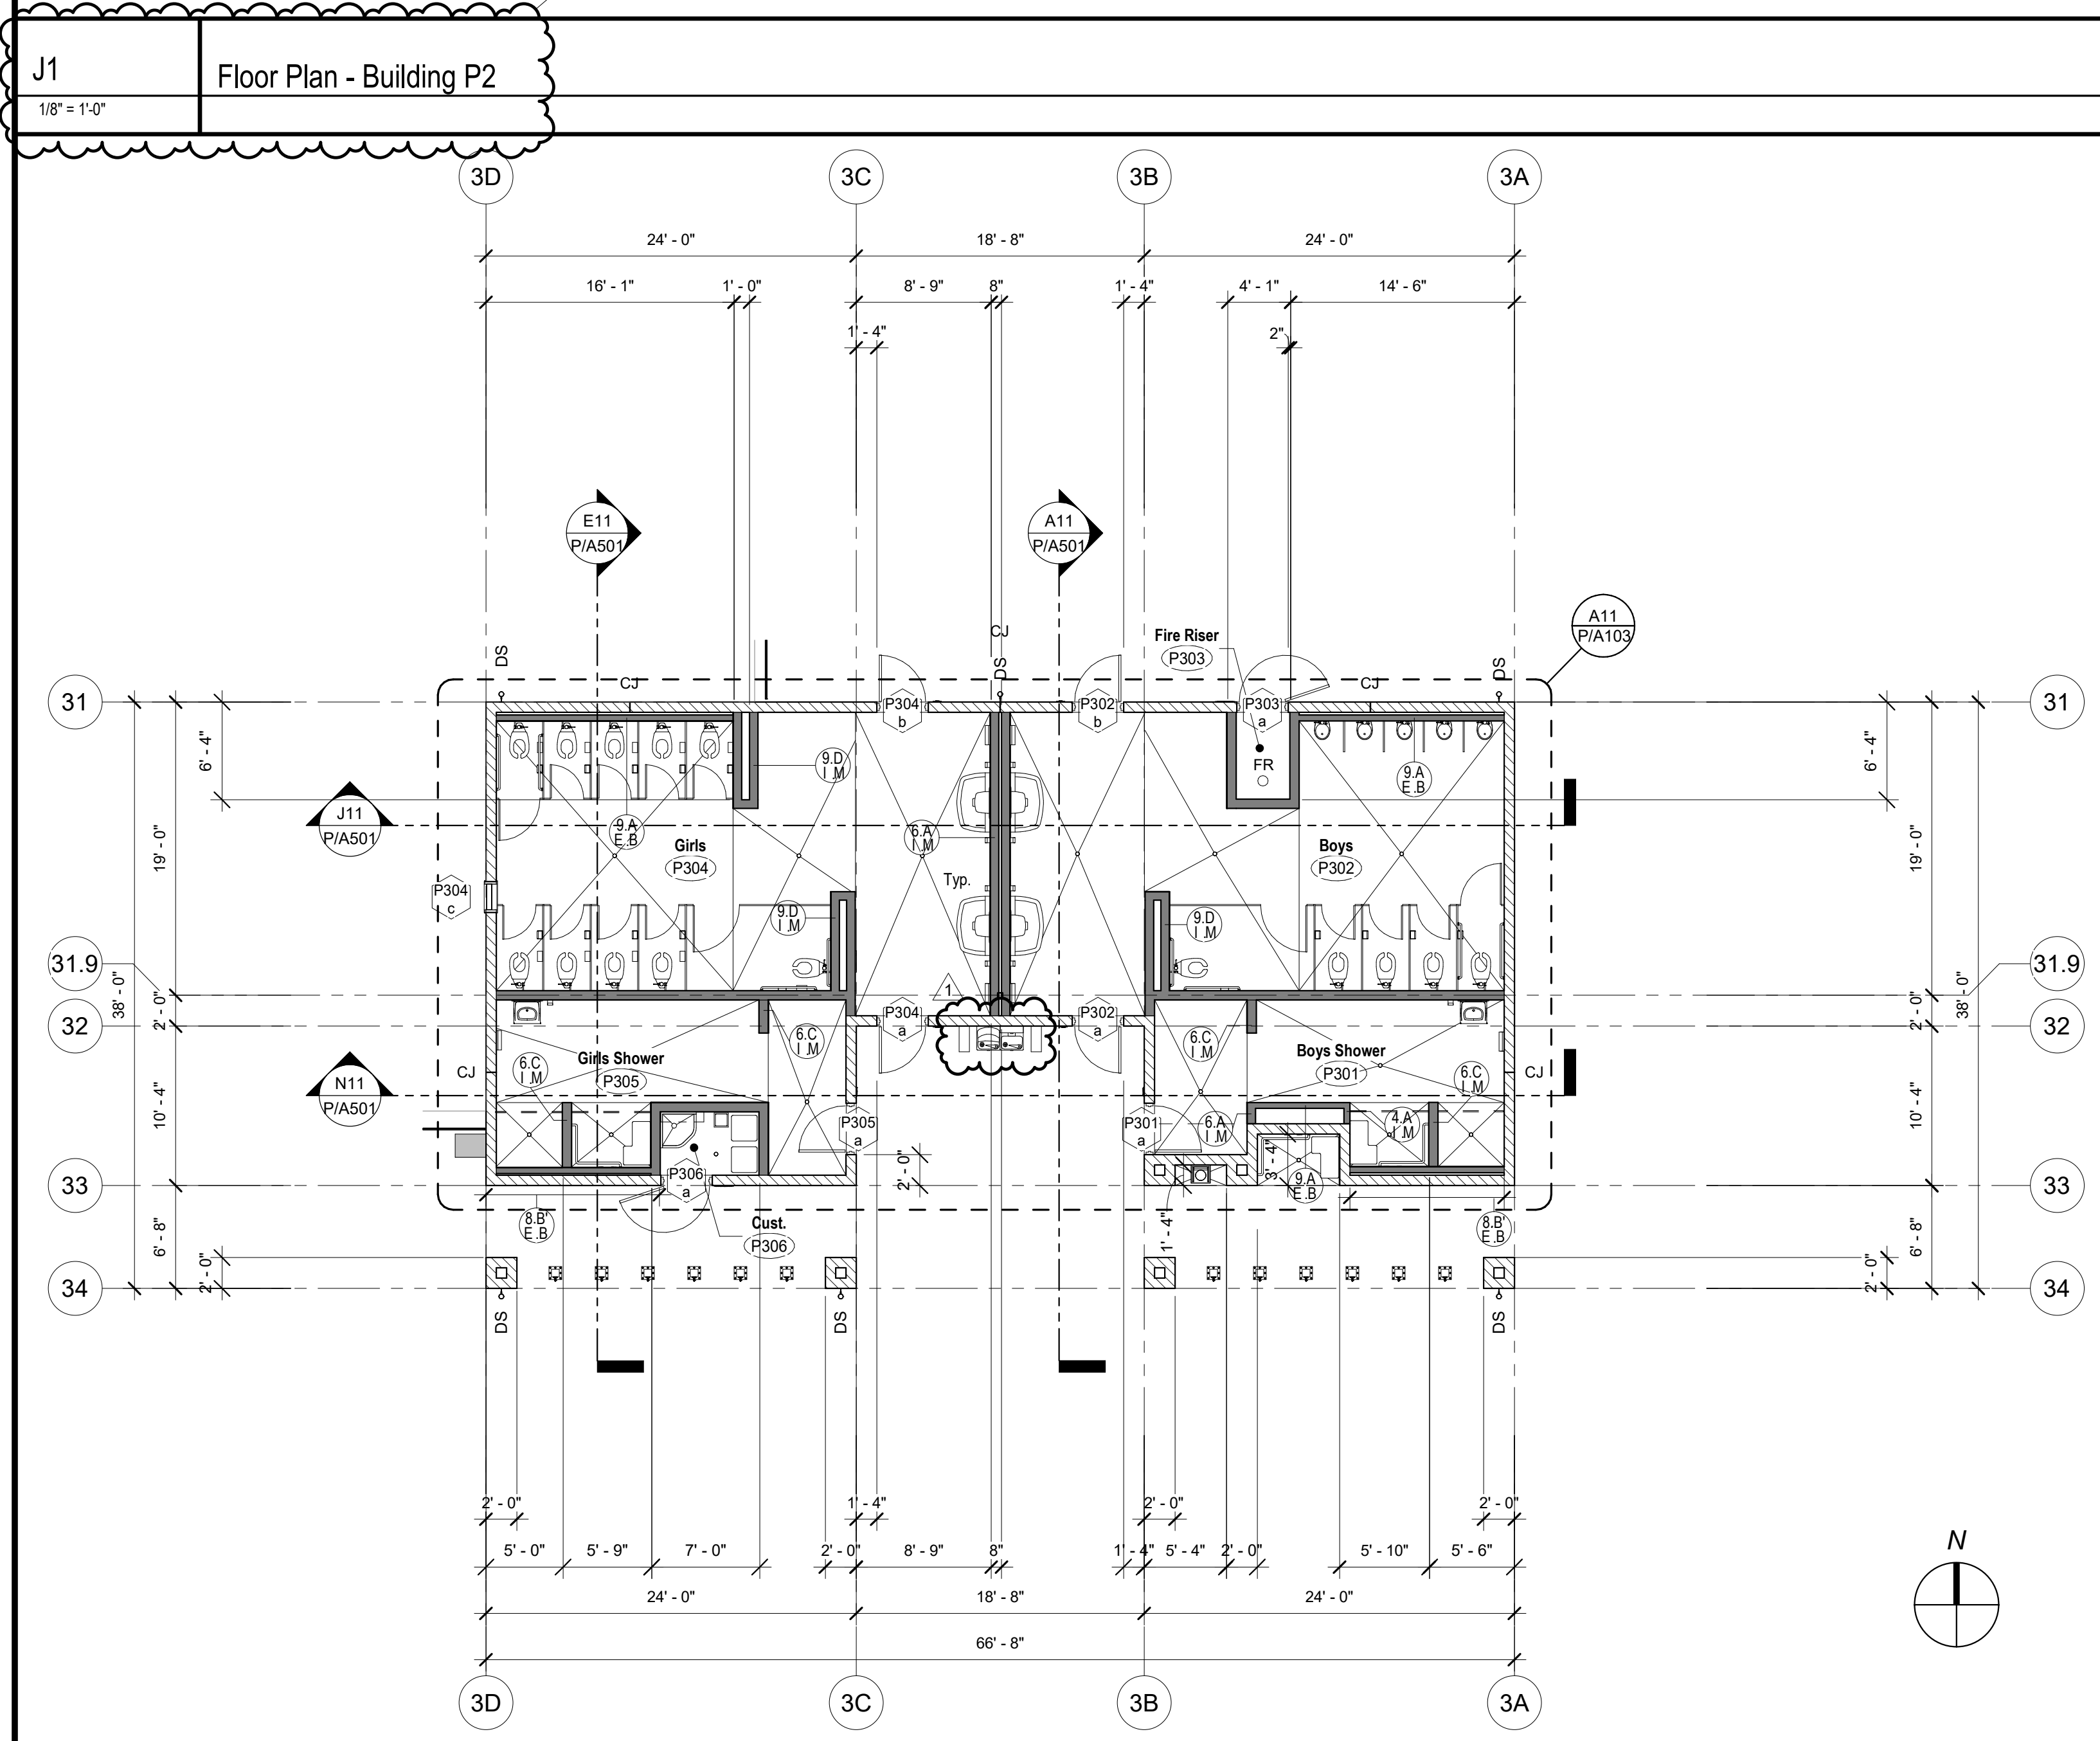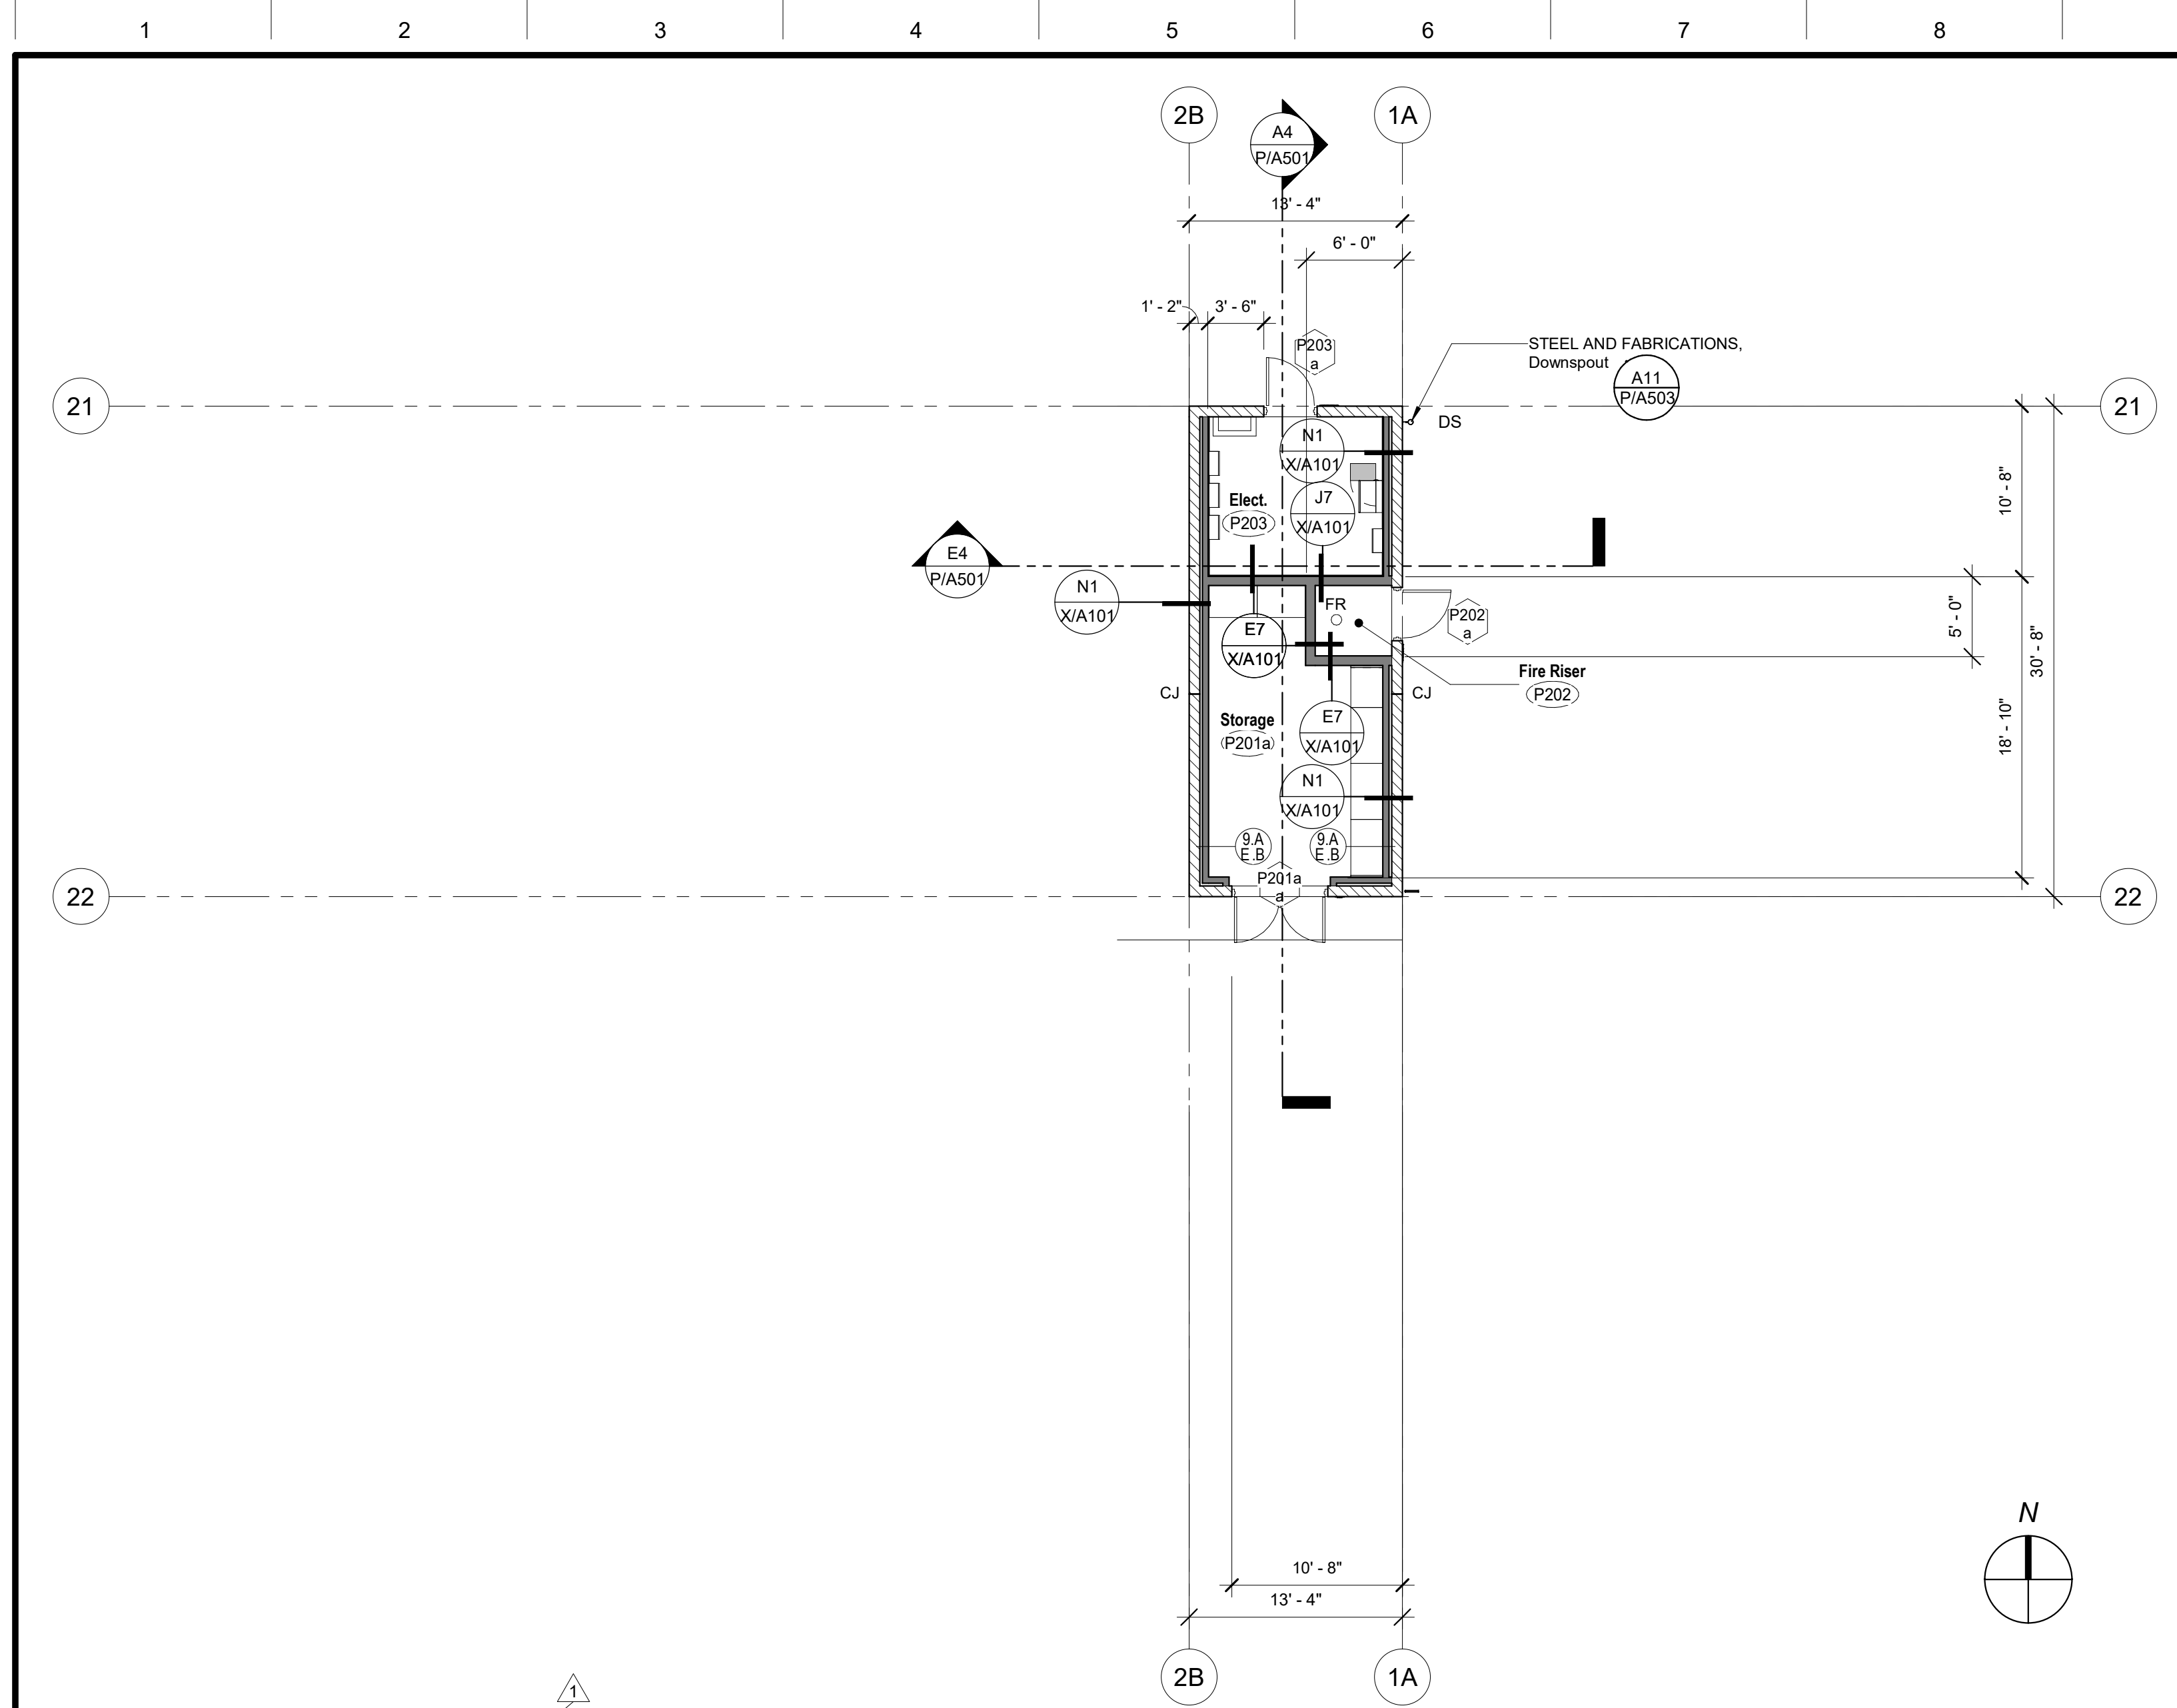

A1 Floor Plan - Building P3
1/8" = 1'-0"

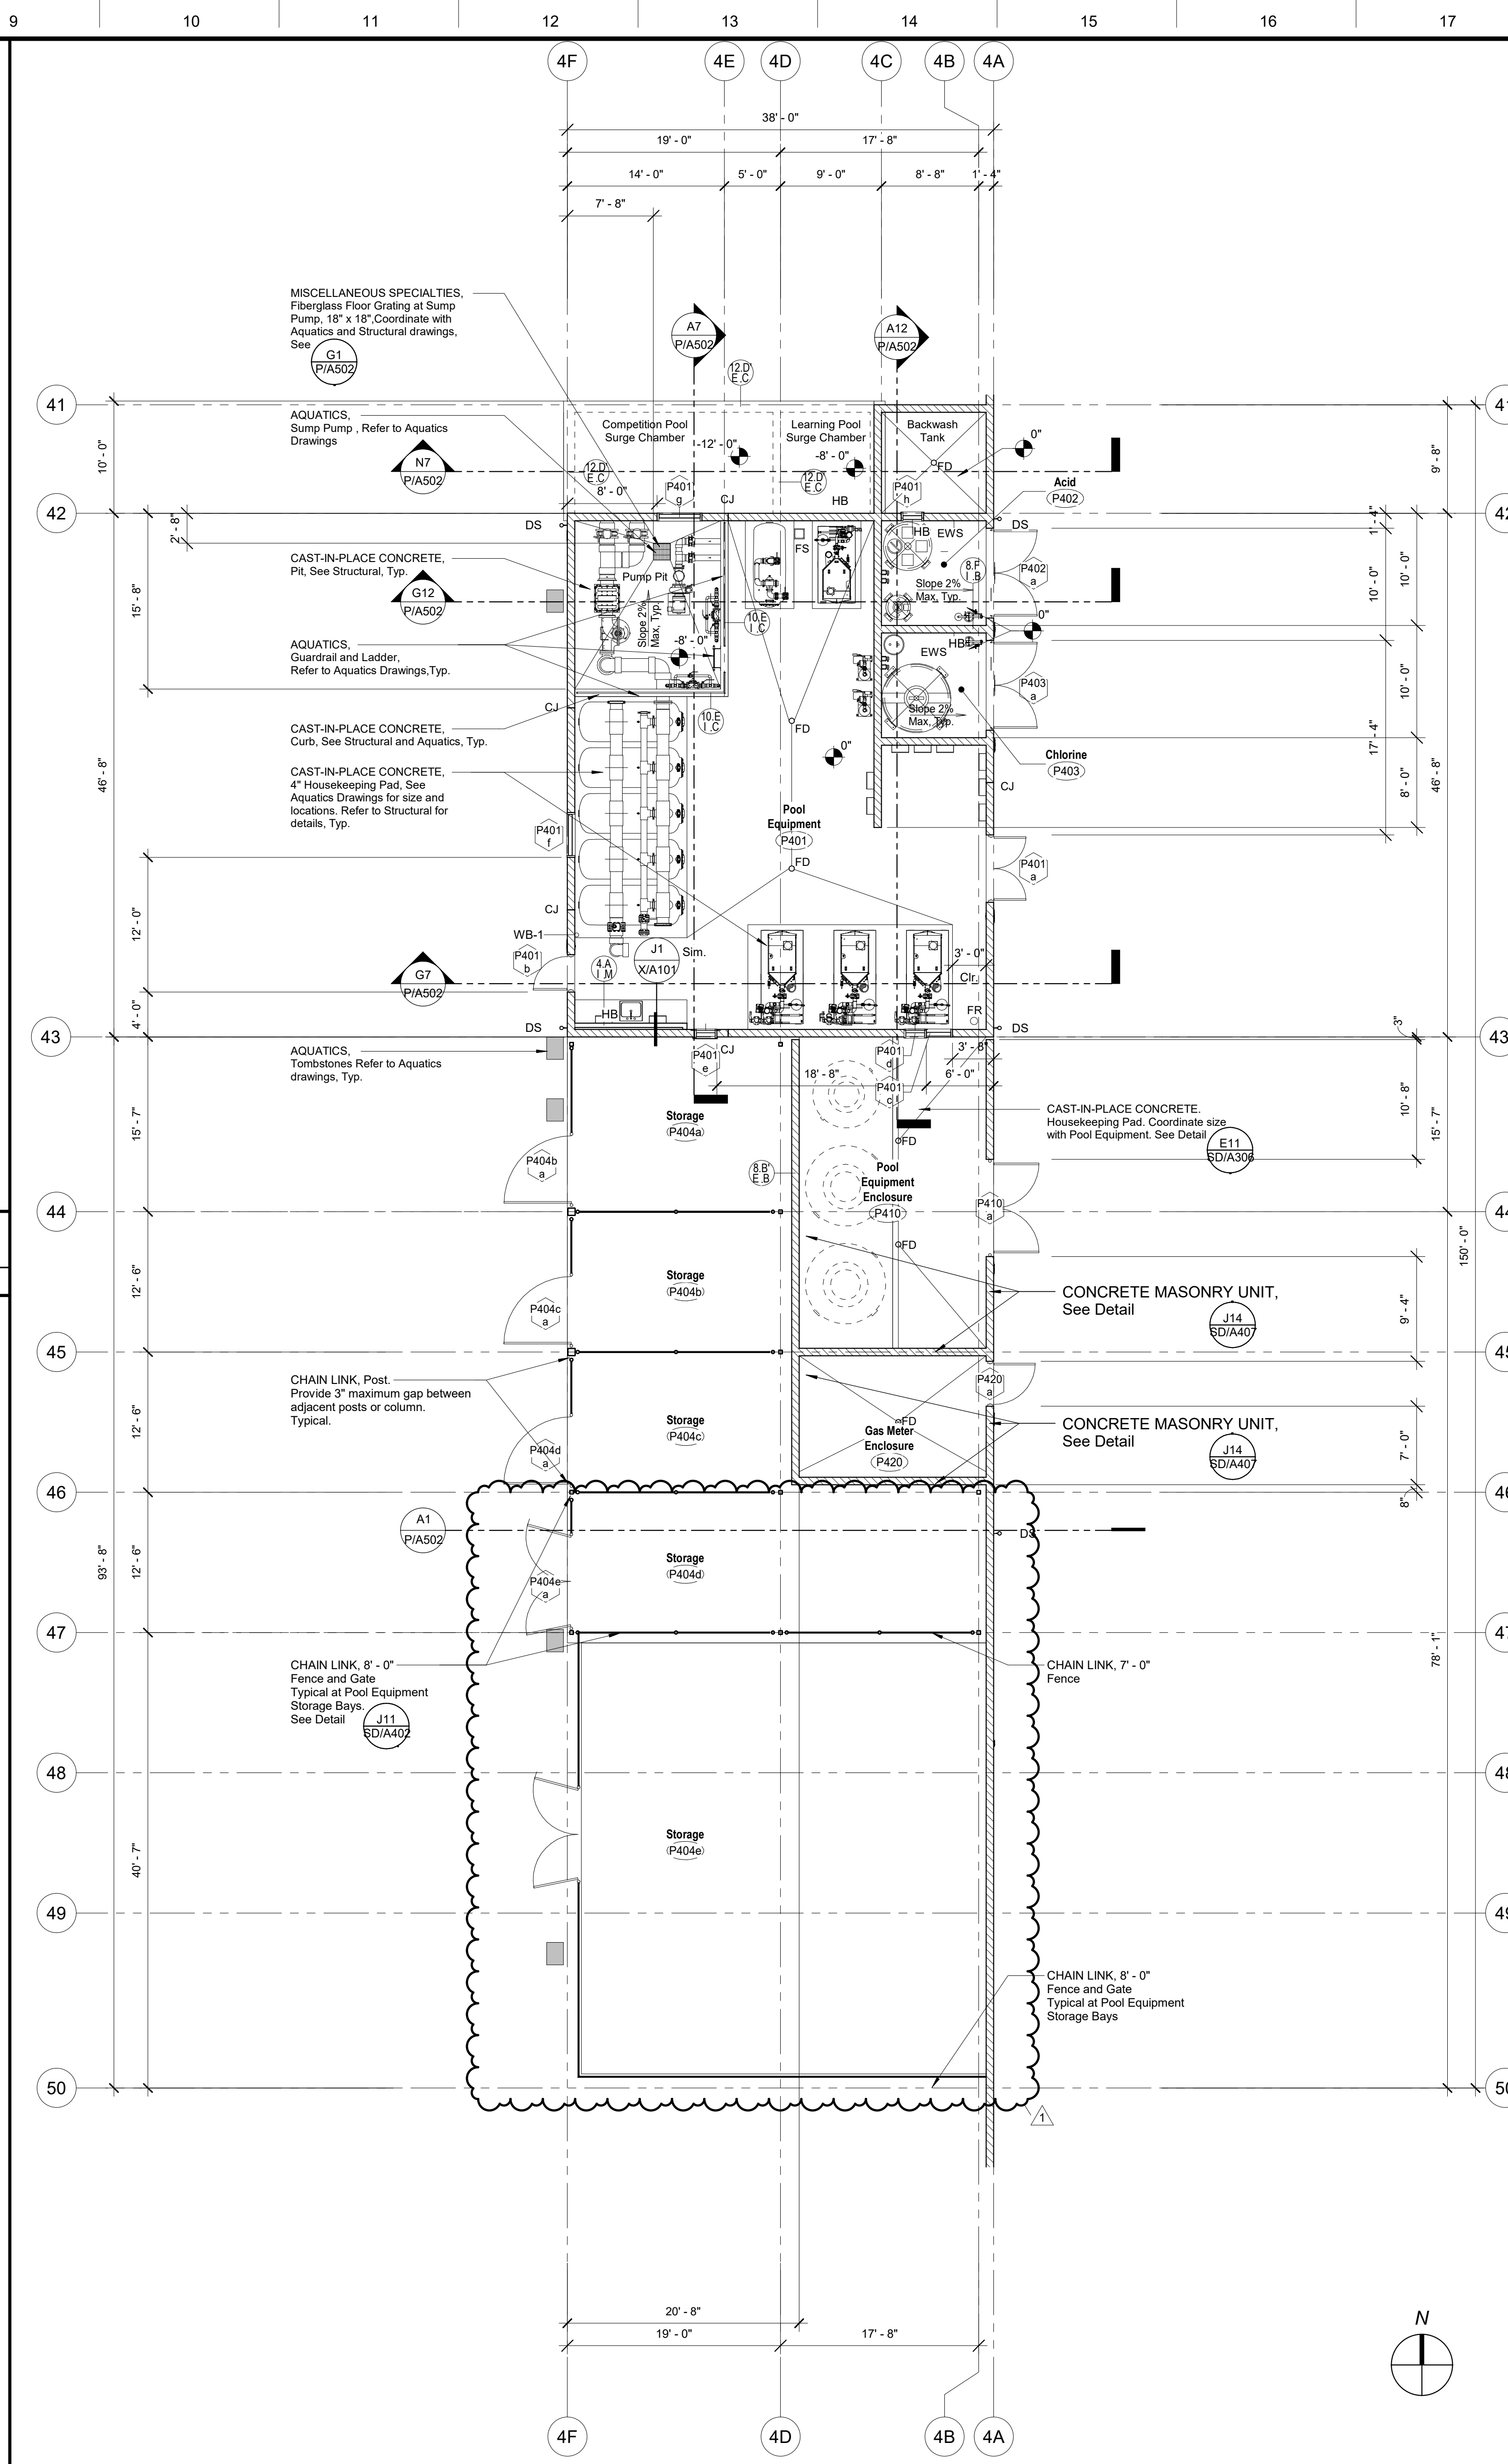

A9 Floor Plan - Building P4
1/8" = 1'-0"

DSA File No.: 54-H11

DSA Application No.: 02-120251

Agency Approval

- SYMBOLS**
- Concrete Masonry Unit Wall, 8" wide unless otherwise noted.
 - Concrete Wall, or Column. Size as indicated.
 - Stud Wall. Studs and Interior Wall materials continuous from floor to underside of floor or roof deck. Studs at 16" o.c. unless otherwise noted. Interior Wall material shall include Batt Insulation, Sound Densifying Board, Plywood Sheathing, Gypsum Board, and Cement Plaster/Ceramic Tile setting bed where occurs.
 - Reference Grid
 - Opening Group No. Refer to Door or Window Opening Schedules
 - Equipment Item No. Refer to Equipment Schedule
 - Room Designation
 - Wall Assembly Symbols. Refer to Sheet X/A101
 - Pool Equipment Building Floor Finish Elevation. See Pool Drawings and Structural Drawings.
 - Indicates Required Accessible Clearance Space

- ABBREVIATIONS**
- DS STEEL AND FABRICATIONS, Rain Water Downspout. See Detail A11 P/A503
 - FE FIRE PROTECTION SPECIALTIES, Fire Extinguisher and Cabinet, Type FEC-1, Unless Noted Otherwise.
 - FF Face of Finish
 - FC Face of Concrete
 - FD Floor Drain
 - FOM Face of Masonry
 - FOS Face of Stud
 - FR FIRE PROTECTION, Fire Riser, See Fire Protection Drawings
 - HB Hose Bib
 - MO Masonry Opening
 - UNO Unless Noted Otherwise
 - RO Rough Opening
 - Typ. Typical
 - Sim. Similar
 - OH Opposite Hand

- NOTES**
1. All Exterior Walls shall be Wall Assembly Type Unless Noted Otherwise.
 2. All Interior Walls shall be Wall Assembly Type Unless Noted Otherwise.
 3. All Exterior Soffit Walls and Arches shall be Wall Assembly Type Unless Noted Otherwise.
 4. All Dimensions are to Face of Stud (FOS) or Center Line, Unless Noted Otherwise.
 5. All Elevation Dimensions are Above Finish Floor at Each Floor Level, Unless Noted Otherwise.
 6. Dimensions Noted as "+1/2" are Nominal.
 7. Floor Drains (FD) and Floor Sinks (FS) shall be Set-3/4" and a Min. of 3'-0" From Nearest wall, 1:48 Max Slope in Any Direction, Unless Noted Otherwise.
 8. IDENTIFYING DEVICES, For Room Signage Refer to and Specifications
 9. Integral Cove Base to be PAINT, Specialty Paint.

F18 Floor Plan Legend

No Scale

Mission Oak HS Aquatic Complex
Tulare Joint Union High School District
Tulare, CA 93274 Project

BUILDING P2, P3 & P4
FLOOR PLANS Drawing

darden architects ARCHITECTURE PLANNING INTERIORS
www.dardenarchitects.com
6790 N. West Ave. • Fresno, CA 93711 • T. 559.448.8051


ARCHITECT

No.	Revision/Submission	Date
1	REVISION_01	05/31/2023


Revision		
Designed By:	MF	Copyright 2022 Darden Architects
Scale:	1/8" = 1'-0"	Drawn By: KT
Project Number:	2180	Checked By: -
Date:	03/28/2023	Reviewed By: MF

P/A101

8/18/2023 4:26:44 PM e:\Users\alwin\Documents\180 Mission Oak HS Aquatic Complex_R001_VZ2_A\winV.nt

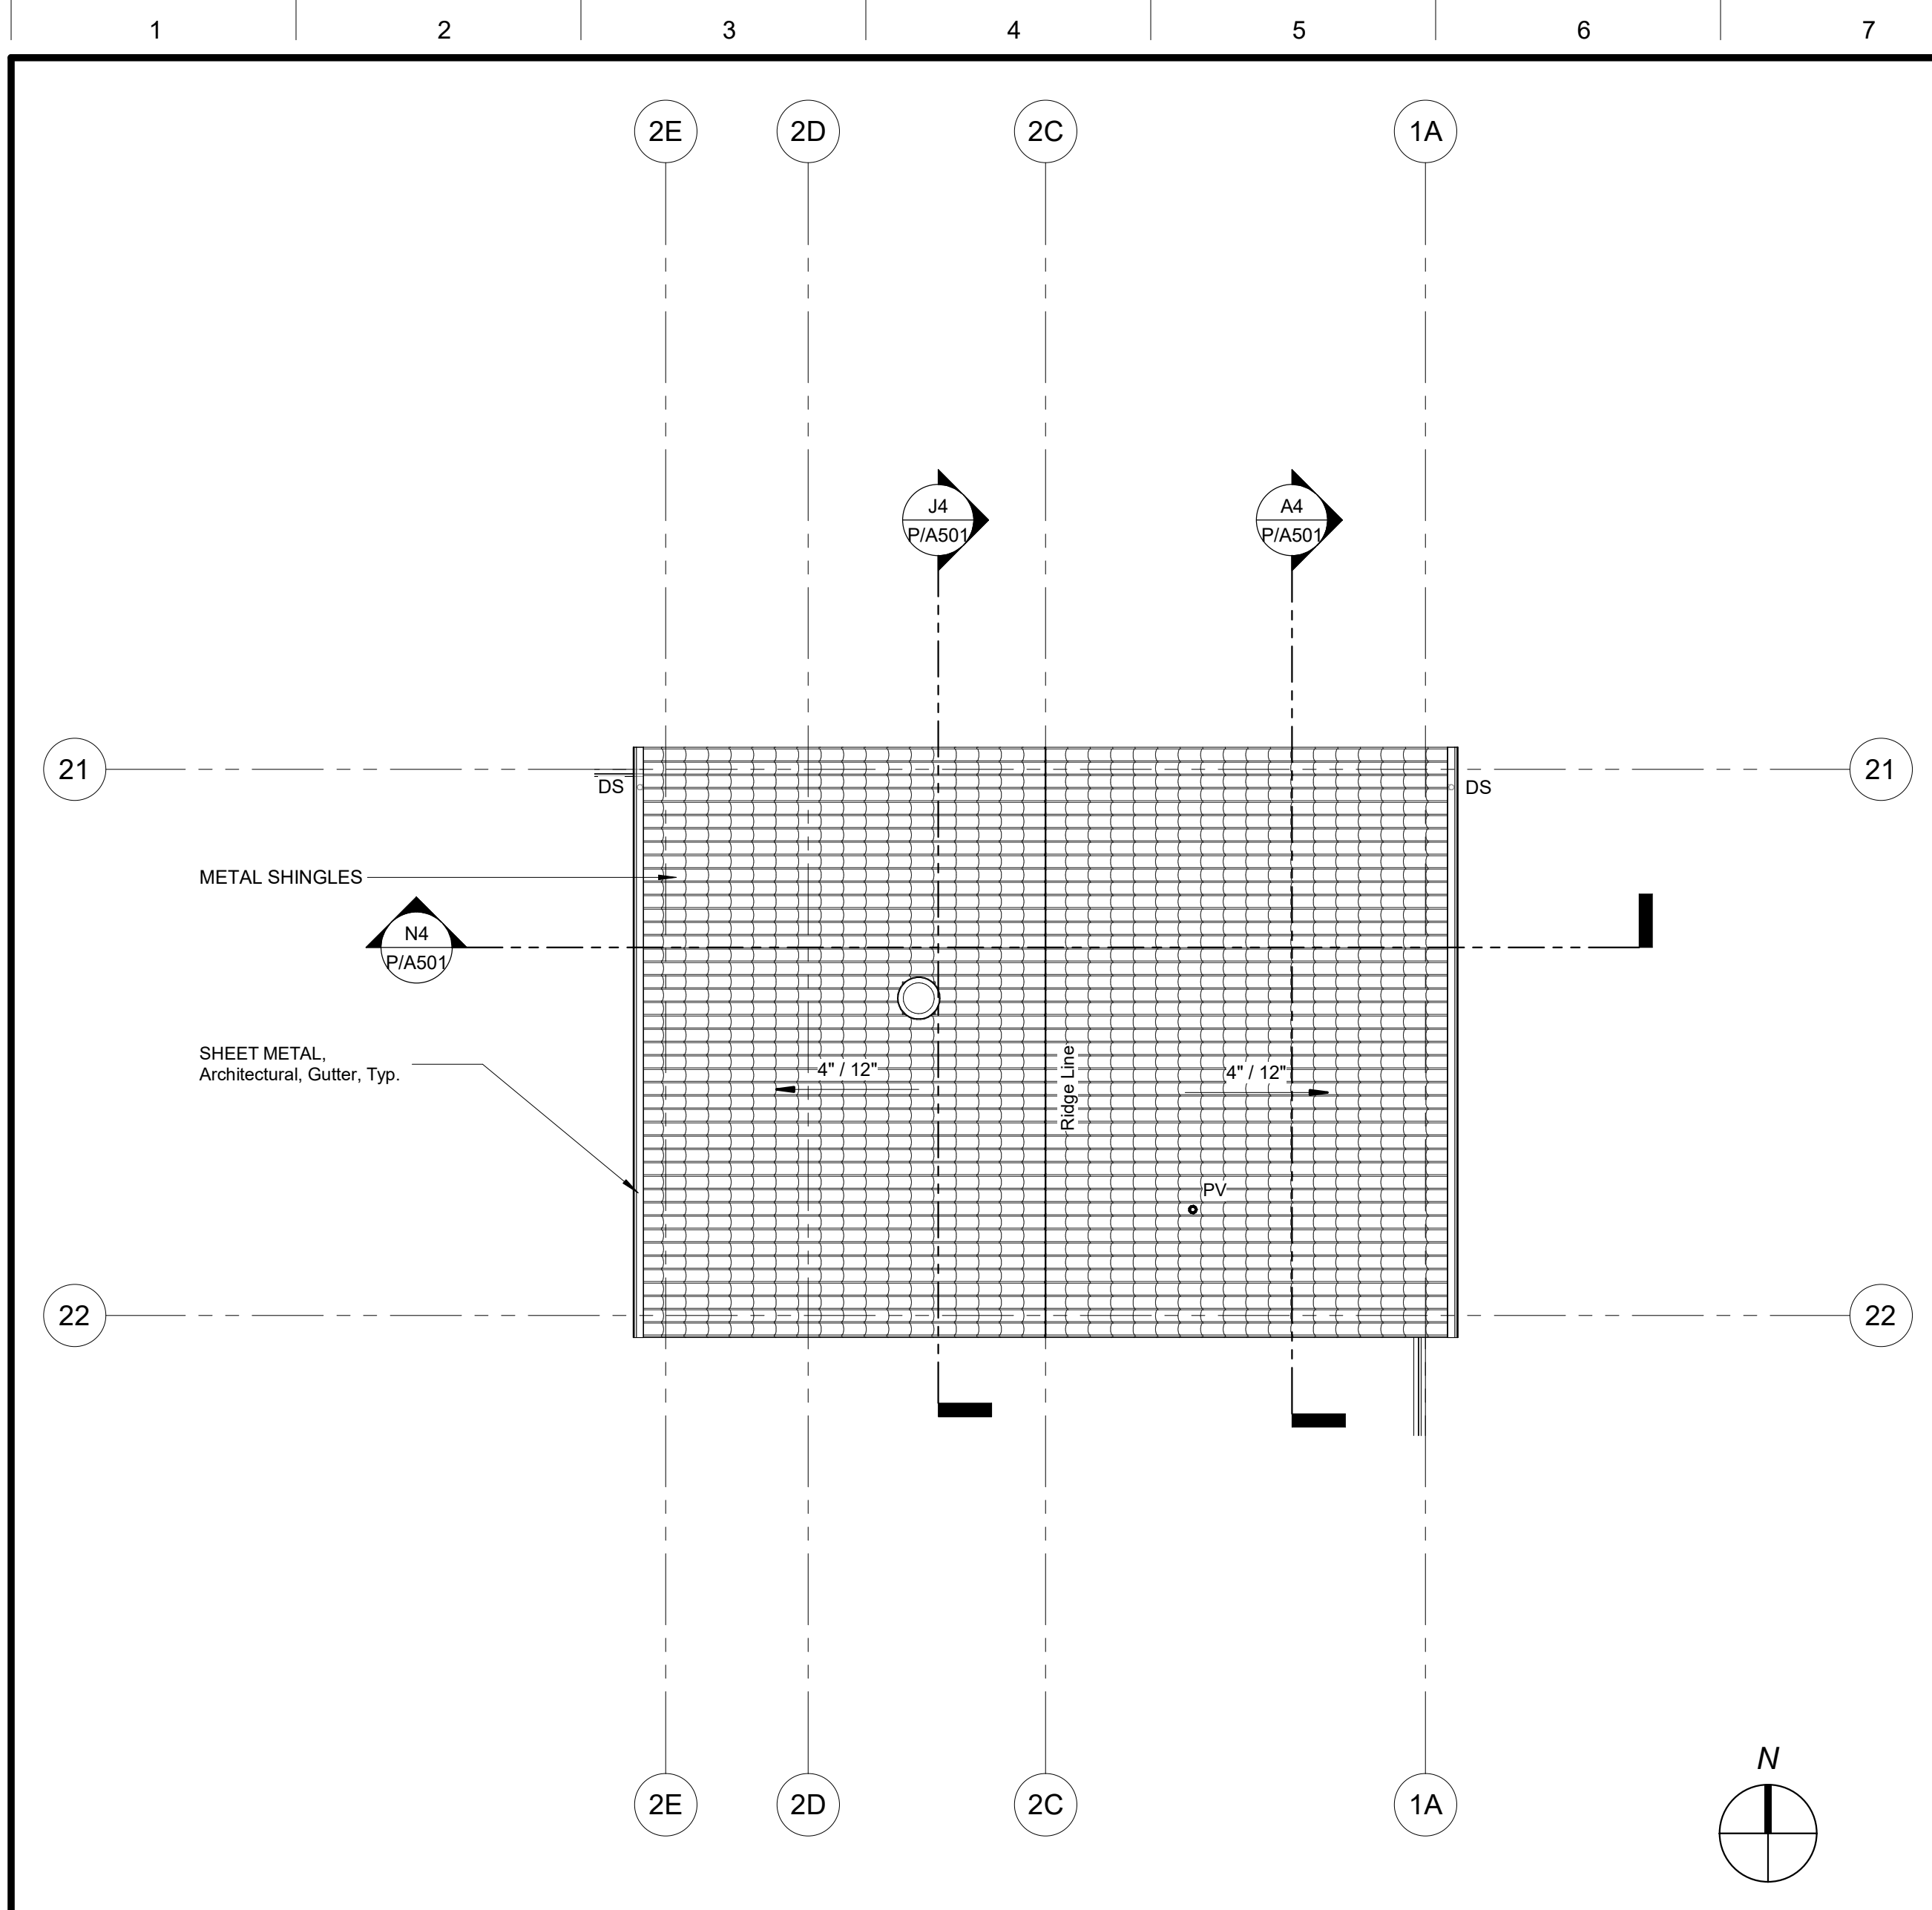

J1 Roof Plan - Building P2
1/8" = 1'-0"

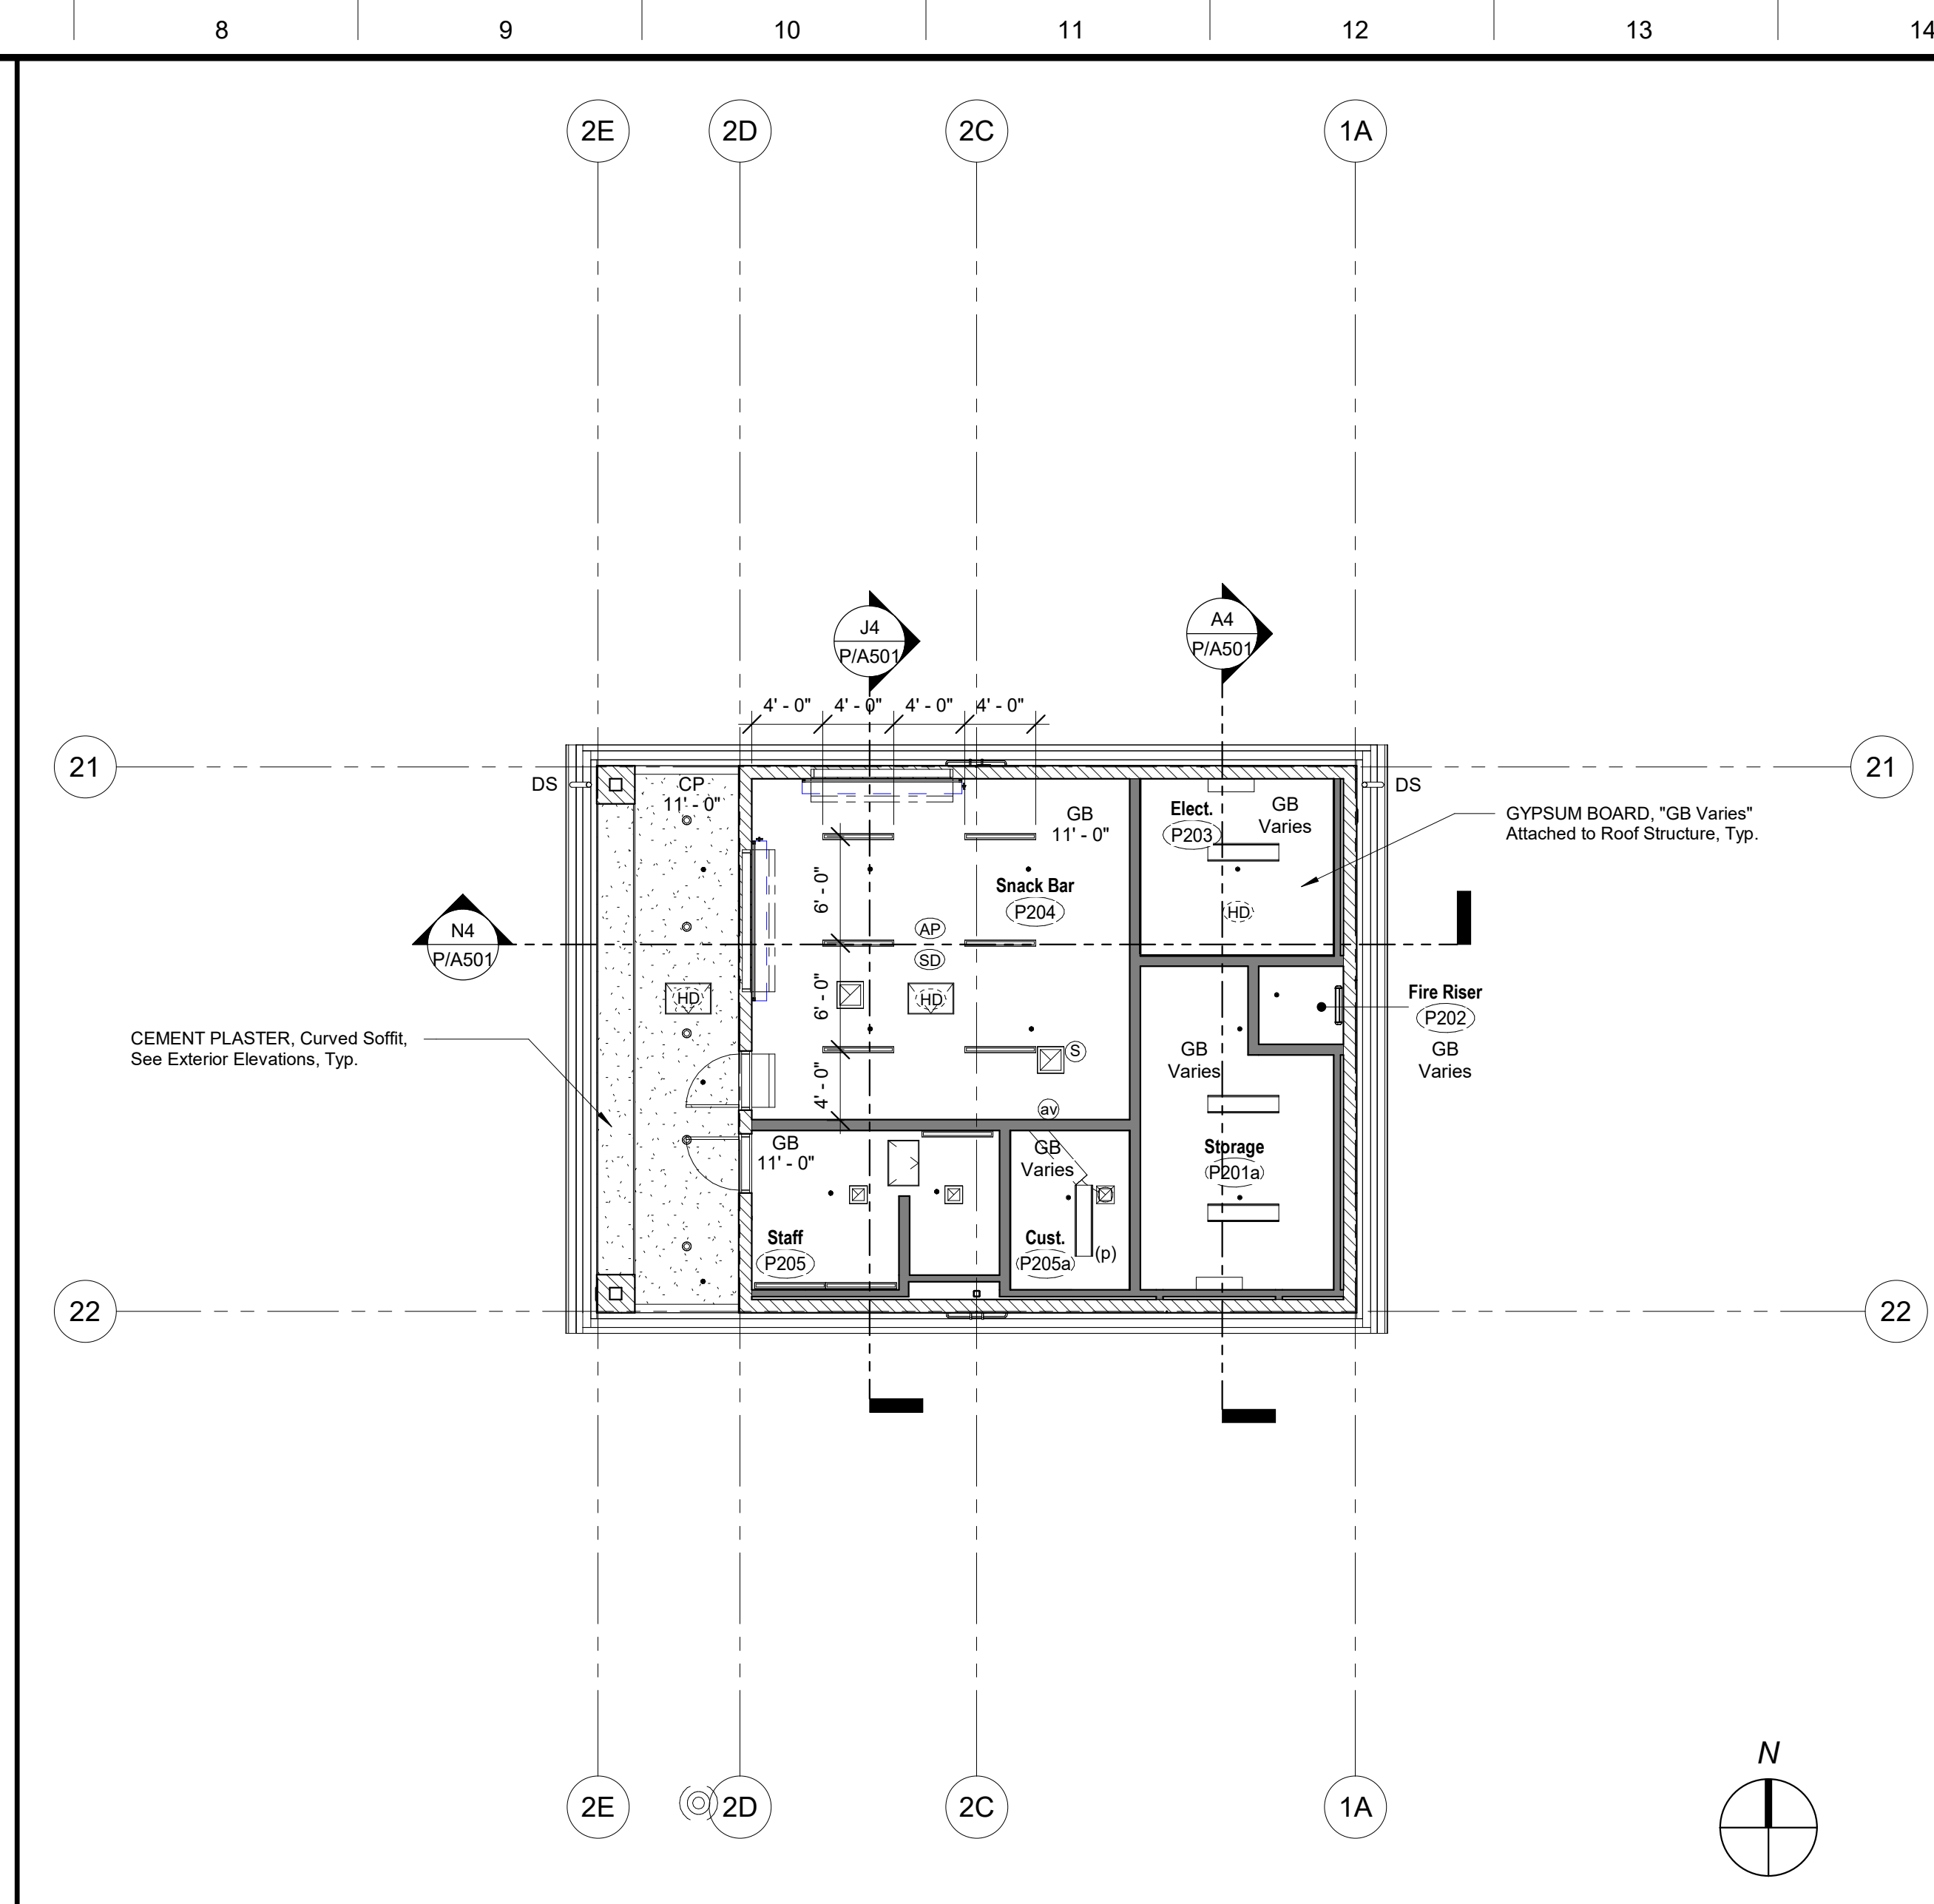

J7 Reflected Ceiling Plan - Building P2
1/8" = 1'-0"

SYMBOLS

- ACUSTICAL CEILING, Suspended Ceiling Compression Strut/ Splay Wire location
- PLUMBING, Overflow Drain
- FIRE PROTECTION, Fire Sprinkler Head
- MECHANICAL, Air Supply Grill
- MECHANICAL, Air Return Grill
- MECHANICAL, Strip Grill
- MECHANICAL, Exhaust Fan
- ELECTRICAL, Light Fixture, Surface Mounted, Unless Noted Otherwise.
- ELECTRICAL, Fire Alarm Device, Heat Detector
- ELECTRICAL, Fire Alarm Device, Smoke Detector
- ELECTRICAL, Fire Alarm Audio Visual Speaker
- ELECTRICAL, Public Address System Speaker
- ELECTRICAL, Wireless Access Point
- CEMENT PLASTER, Cement Plaster System See Structural for Framing Color to be PC-1. Refer to Exterior Color Schedule.
- CEMENT PLASTER, Cement Plaster System See Structural for Framing Color to be PC-2. Refer to Exterior Color Schedule.
- METAL DECK, See Structural Drawings.
- ACCESS DOORS AND FRAMES, Access Doors, Ceiling (20" X 30"), UNO
- Reference Point

ABBREVIATIONS

- DS STEEL AND FABRICATIONS, Rain Water Downspout.
- CLG Ceiling
- CP CEMENT PLASTER, System
- GB GYPSUM BOARD
- GLB GLUE-LAMINATED CONSTRUCTION, Beam
- HT Height
- MD METAL DECK
- TYP Typical
- SM Similar
- OH Opposite hand
- DS Downspout
- OD Overflow Drain
- UNO Unless Noted Otherwise

NOTES

- See Structural for Framing of Soffits and Ceilings
- Single Lights or Single Rows of Lights at Soffit/ Ceilings Shall be Centered, UNO.
- Refer to Interior Color Schedule for color.
- Ceiling Color to Match to Adjacent Surface, Unless Otherwise Noted. Refer to Interior Elevation and Interior Design Plan for Color Location.

J14 Reflected Ceiling Legend
No Scale

DSA File No.: 54-H11
DSA Application No.: 02-120251
Agency Approval

SYMBOLS

- Concrete Masonry Unit Wall, 8" wide unless otherwise noted.
- Concrete Wall, or Column. Size as indicated.
- Stud Wall, Studs and Interior Wall materials continuous from floor to underside of floor or roof deck. Studs at 16" o.c. unless otherwise noted. Interior Wall material shall include Batt Insulation, Sound Densifying Board, Plywood Sheathing, Gypsum Board, and Cement Plaster/Ceramic Tile setting bed where occurs.
- Stud Wall, Studs and finish material continuous from floor to minimum 6" above ceiling. Studs to be braced to underside of roof framing or deck if not required to be continuous to roof framing or deck. Studs at 16" o.c. Unless Otherwise Noted. See Structural for bracing and extent of Structural Sheathing.
- Reference Grid
- Opening Group No. Refer to Door or Window Opening Schedules
- Eq mark Refer to Equipment Schedule
- Room name Refer to Room Designation
- Wall Assembly Symbols. Refer to Sheet X/A101
- Pool Equipment Building Floor Finish Elevation. See Pool Drawings and Structural Drawings.
- Indicates Required Accessible Clearance Space
- Indicates Required Accessible Clearance Space


ABBREVIATIONS

- DS STEEL AND FABRICATIONS, Rain Water Downspout. See Detail A11
- FE FIRE PROTECTION SPECIALTIES, Fire Extinguisher and Cabinet, Type FEC-1, Unless Noted Otherwise.
- FF Face of Finish
- FDC Face of Concrete
- FD Floor Drain
- FOM Face of Masonry
- FOS Face of Stud
- HB Hose Bib
- MO Masonry Opening
- UNO Unless Noted Otherwise
- RO Rough Opening
- TYP Typical
- SM Similar
- OH Opposite Hand


NOTES

- All Exterior Walls shall be Wall Assembly Type (E.A./E.B.) Unless Noted Otherwise.
- All Exterior Soffit Walls and Arches shall be Wall Assembly Type (A.D./E.M.) Unless Noted Otherwise.
- All Dimensions are to Face of Stud (FOS) or Center Line, Unless Noted Otherwise.
- All Elevation Dimensions are above Finish Floor at each floor level, Unless Noted Otherwise.
- Dimensions noted as "+/-" are nominal.
- Floor Drains (FD) and Floor Sinks (FS) shall be set .3/4" and a min. of 3'-0" from nearest wall, Unless Noted Otherwise.
- IDENTIFYING DEVICES, For Room Signage refer to E1 X/A601 and to Specifications
- Integral cove base to be PAINT, Specialty Paint.

F18 Floor Plan Legend
No Scale

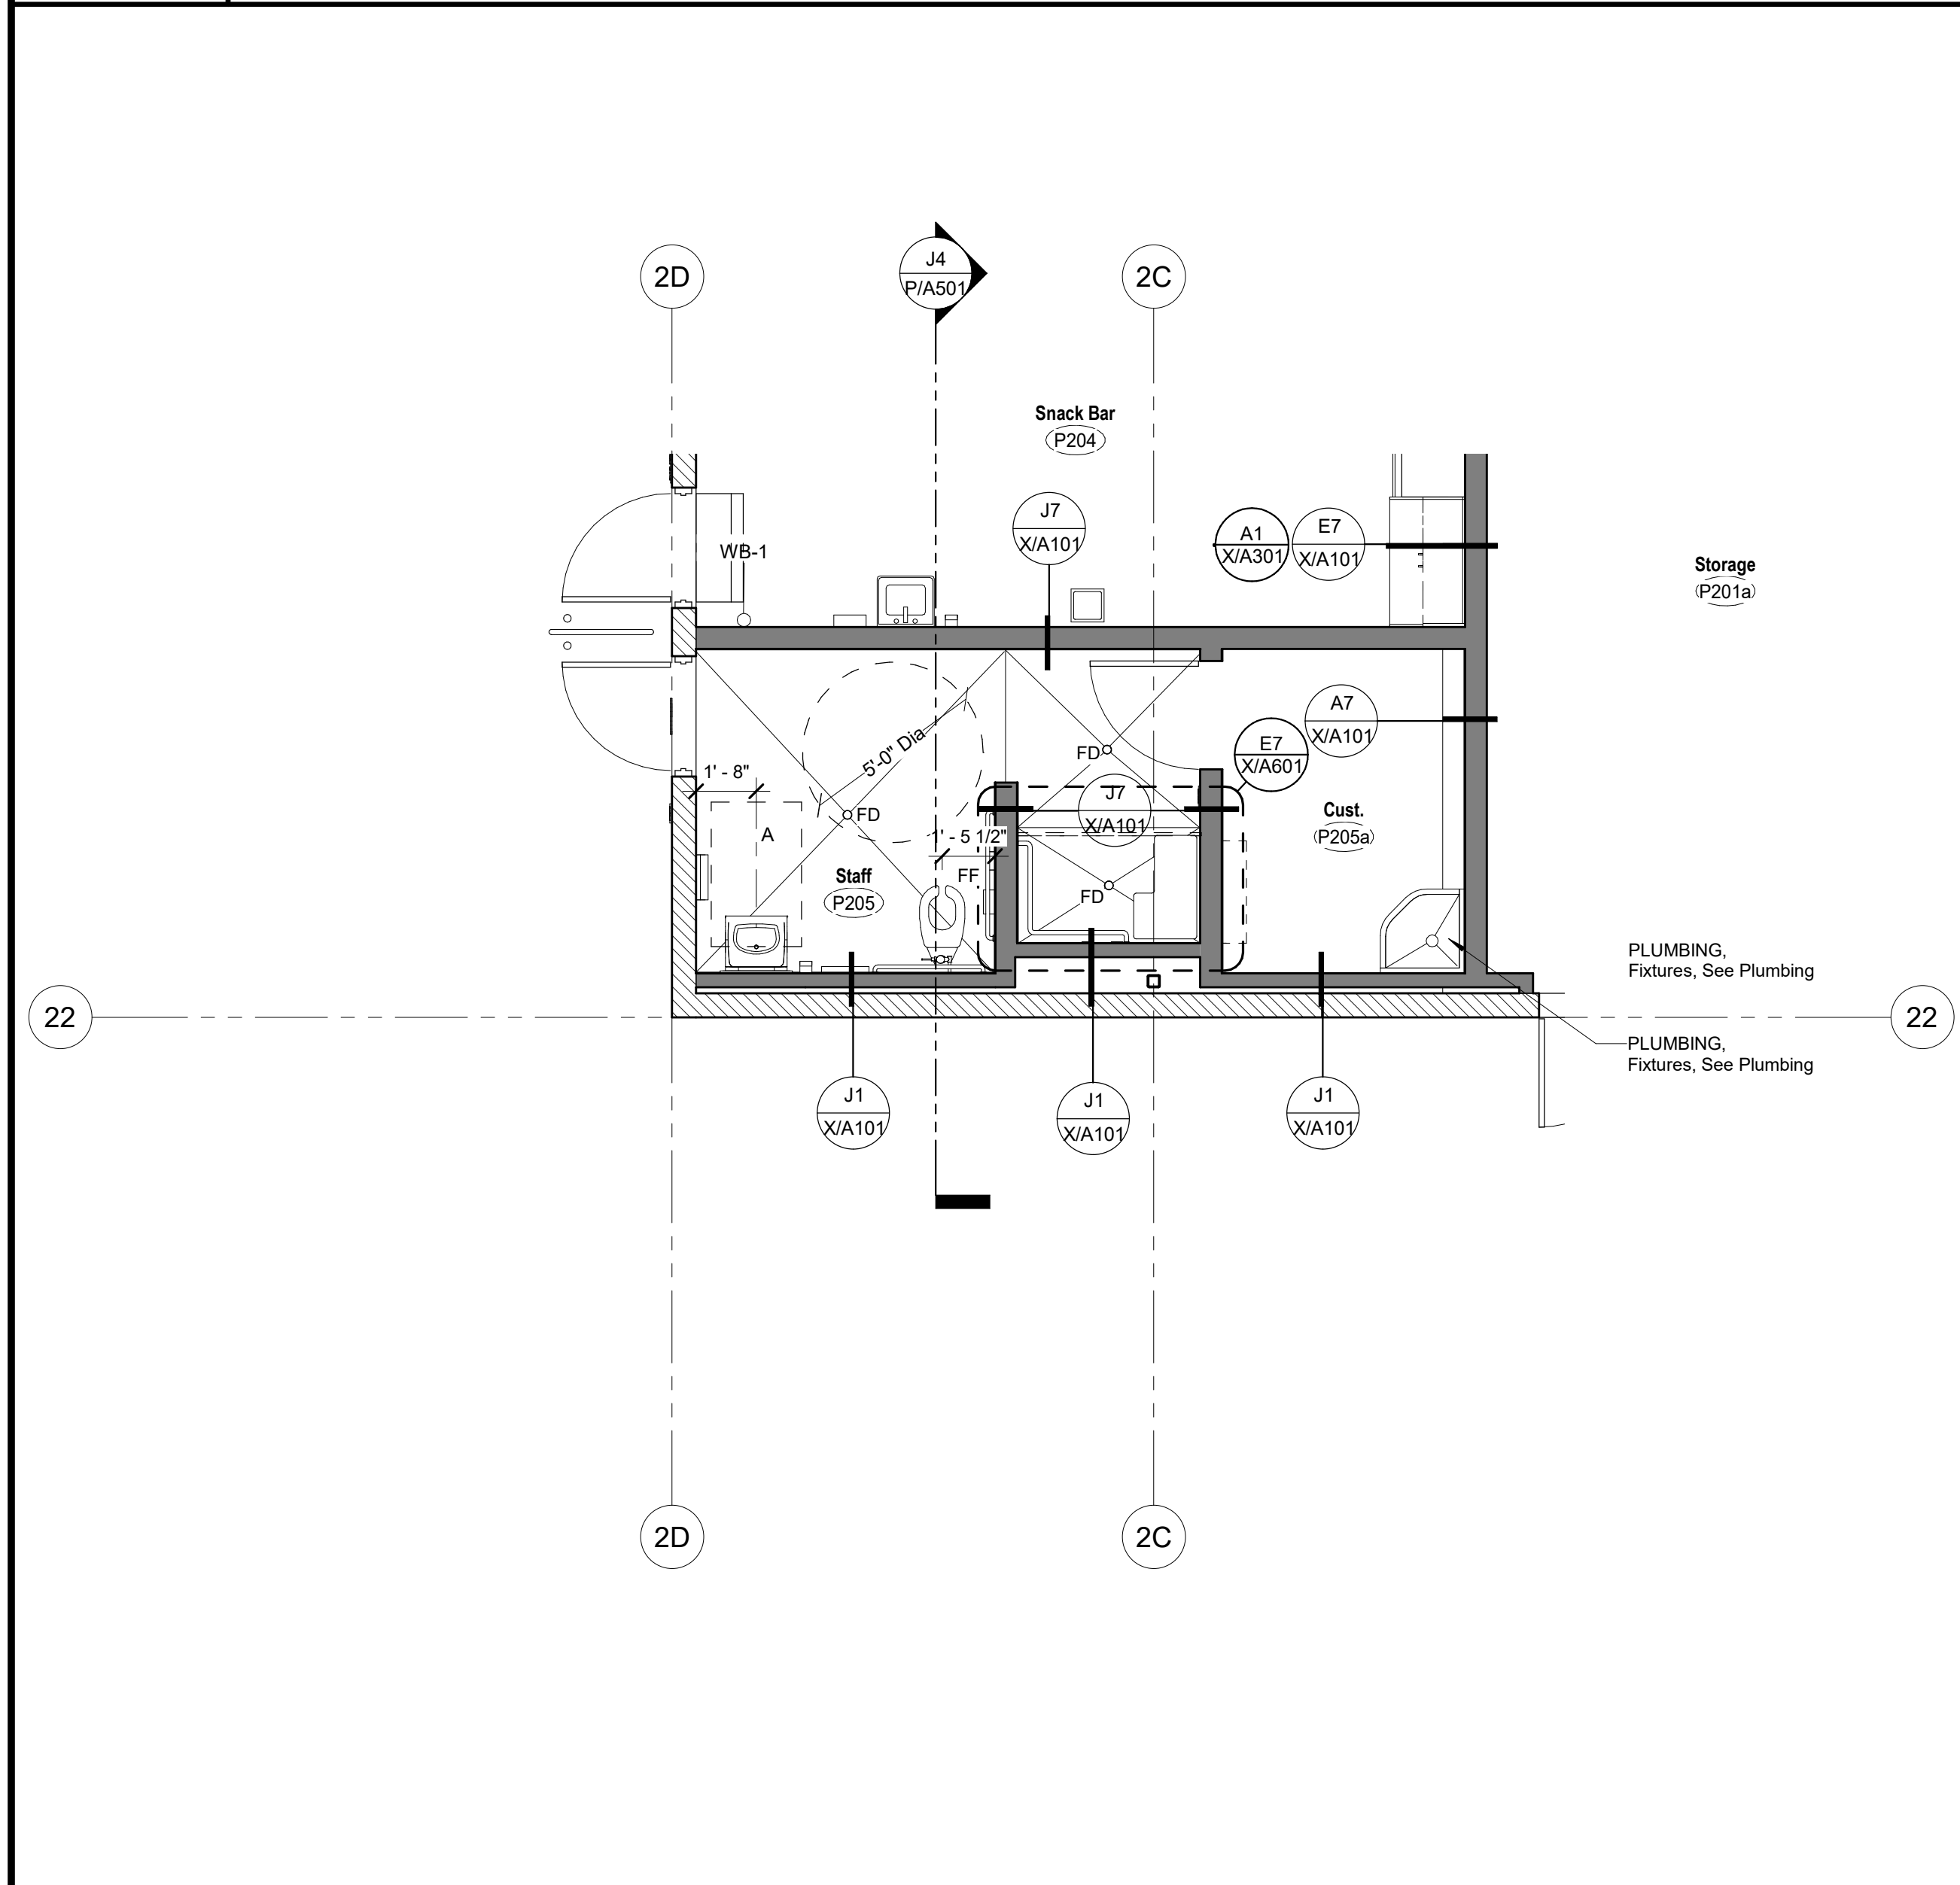

A1 ENLARGED FLOOR PLAN
1/4" = 1'-0"

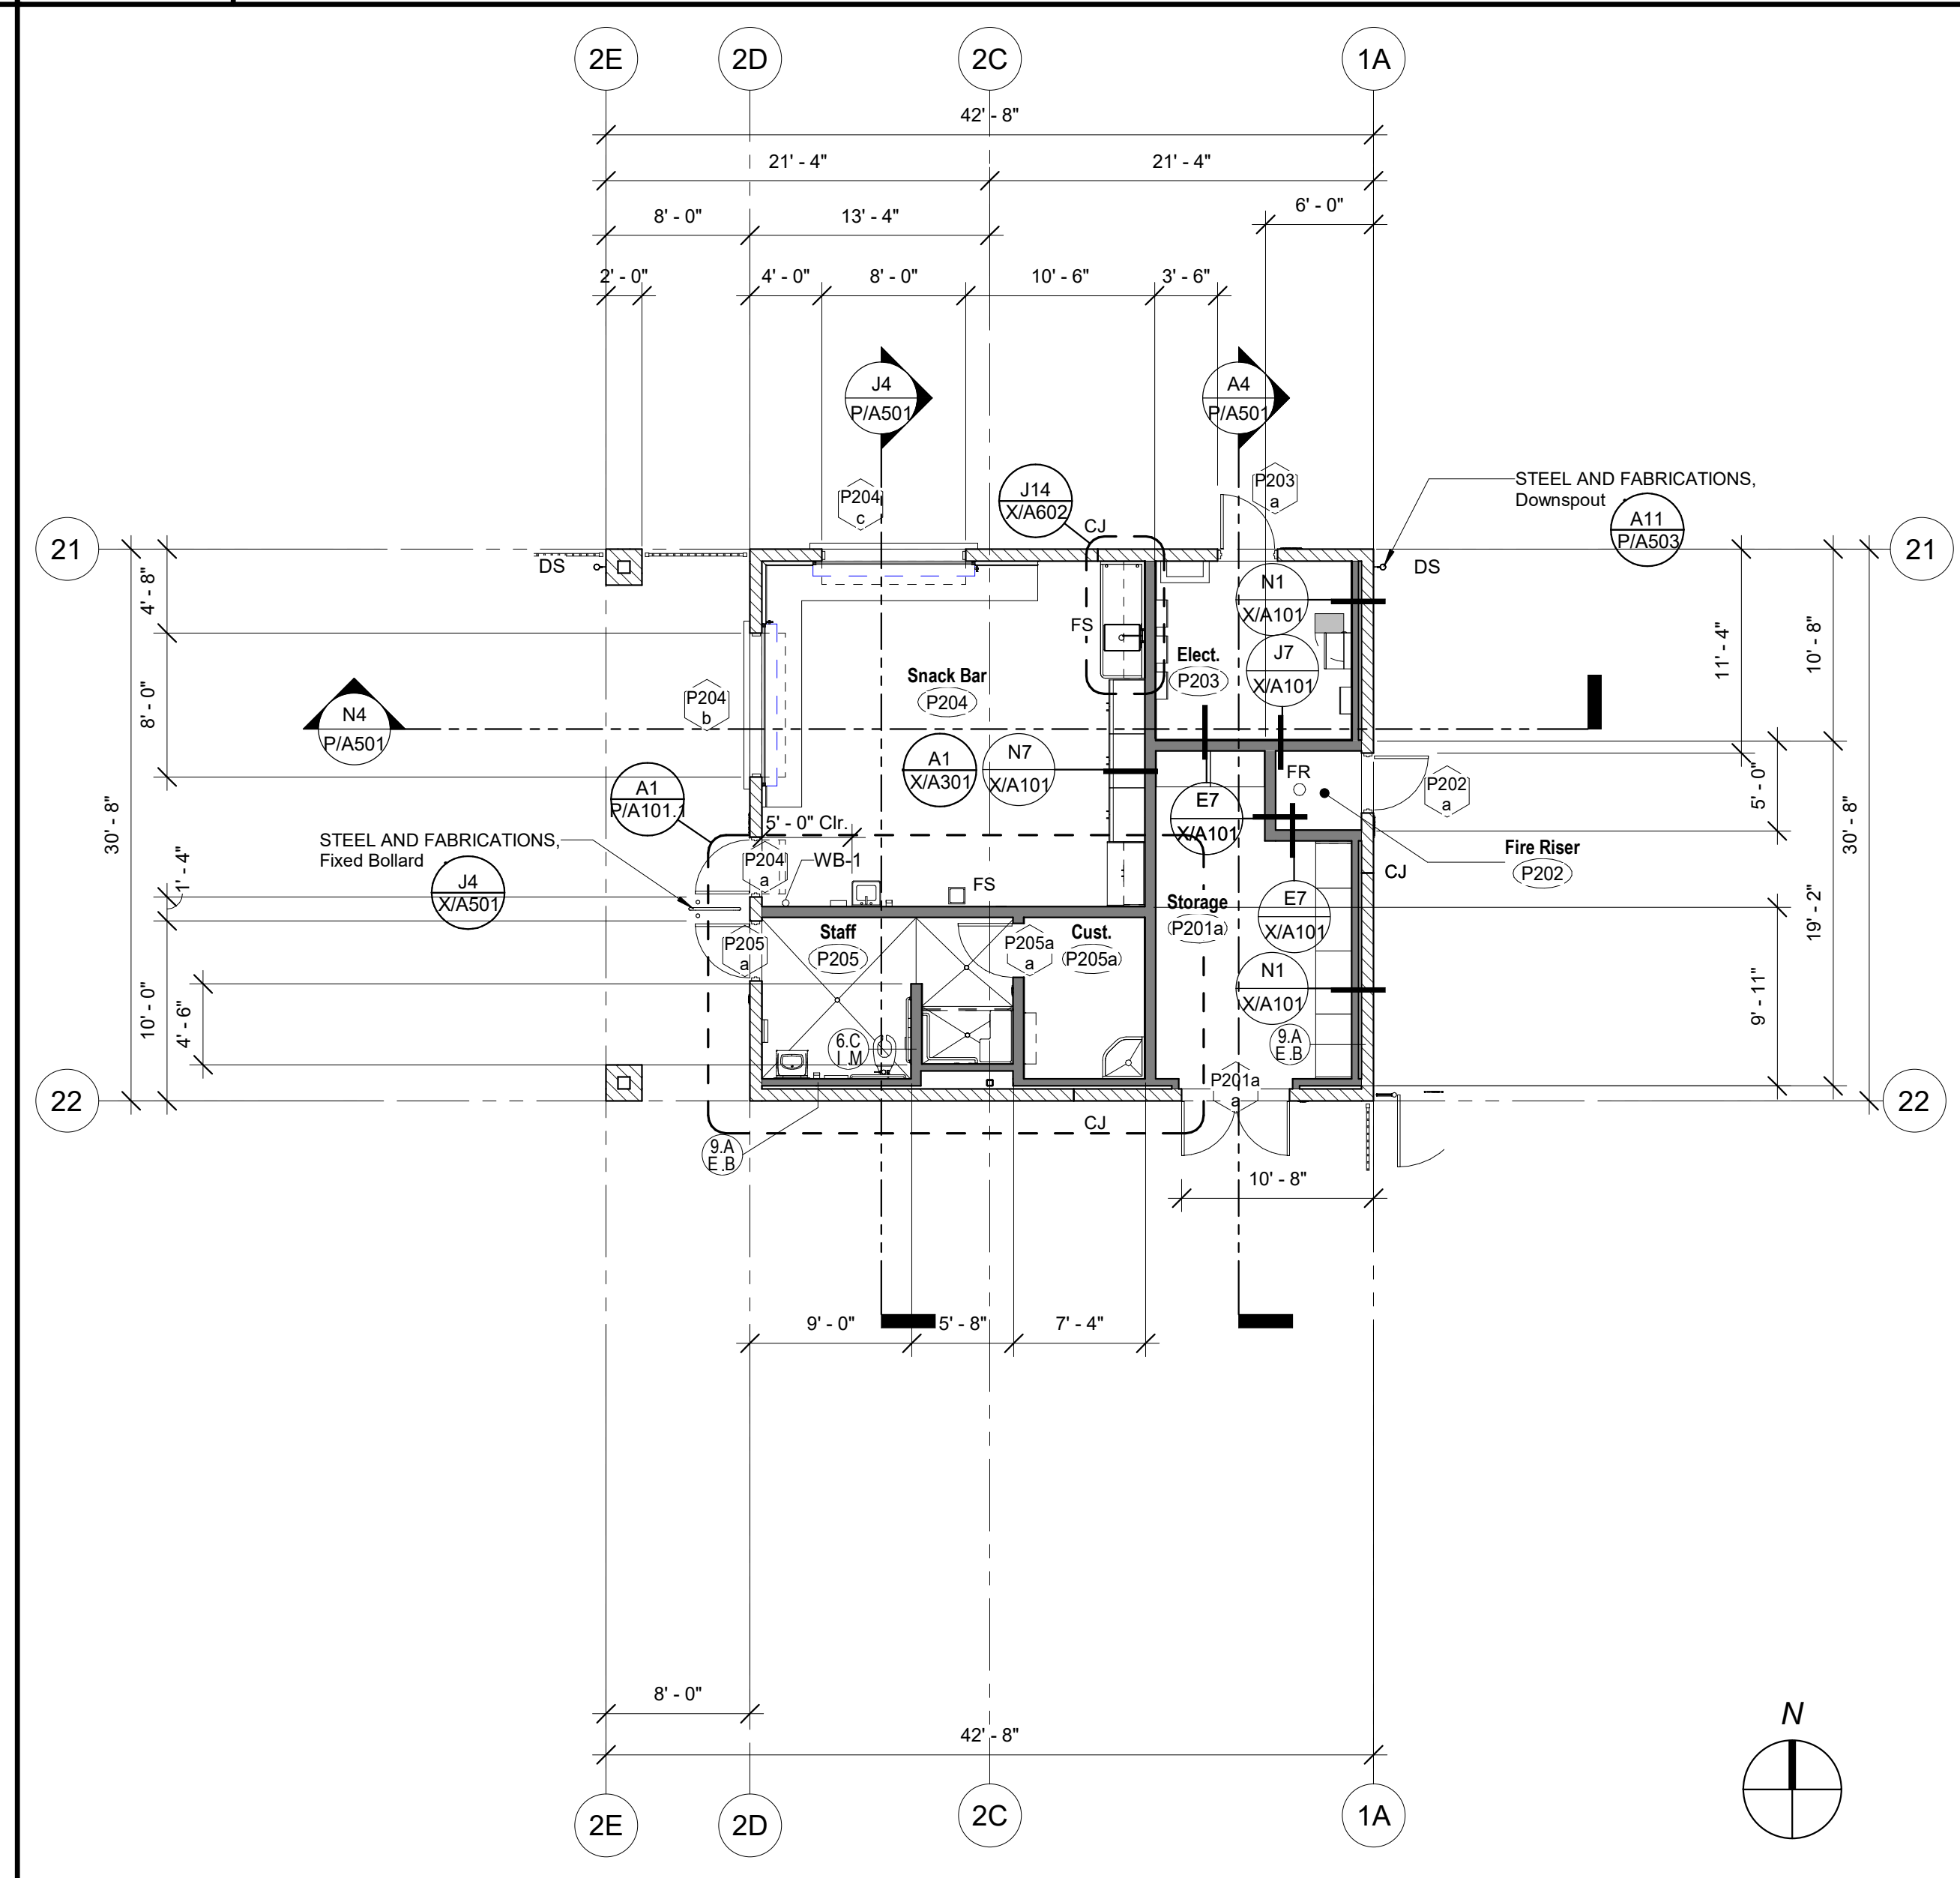

A7 Floor Plan - Building P2
1/8" = 1'-0"

SYMBOLS

- PLUMBING, Vent with METAL SHINGLES Roofing Jack. Powder Coated finish to match the color of the Metal Shingle Room System. Coordinate the locations and sizes between the trades.
- PLUMBING, Flue with METAL SHINGLES Roofing Jack. Powder Coated finish to match the color of the Metal Shingle Room System. Coordinate the locations and sizes between the trades.
- Elevation above finish floor
- Slope (DN) Direction of slope
- Line of Wall below
- Reference Point

ABBREVIATIONS

- DS STEEL AND FABRICATIONS, Rain Water Downspout.
- SEJ SHEET METAL, Architectural Gutters, Expansion Joint
- FD Frng. Face of Framing
- OD PLUMBING, Overflow Drain
- TOP Top of Framing
- PLUMBING, Roof Drain
- TOM Top of Masonry
- OH Opposite Hand
- FOS Face of Stud
- TOS Top of Steel
- SM Similar
- TYP Typical

NOTES

- Refer to Plumbing, Mechanical, and Electrical for all roof penetrations and roof mounted equipment. Coordinate the type of roof penetration with the METAL SHINGLES trade contractor and manufacturer for the flashing and installation of the penetration. Provide shop drawings for locations and shop drawings.

A14 Roof Plan Legend
No Scale

Mission Oak HS Aquatic Complex
Tulare Joint Union High School District
Tulare, CA 93274 Project

BUILDING P1
ALTERNATE BID - BUILDING P2 - SNACK BAR BUILDING
Drawing

ARCHITECTURE
PLANNING
INTERIORS
architects www.dardenarchitects.com
6790 N. West Ave. • Fresno, CA 93711 • T. 559.448.8051
Architect


No.	Revision/Submission	Date
1	REVISION_01	05/31/2023

Scale: As indicated
Project Number: 2180
Date: 03/28/2023

Designed By: MF
Copyright 2022 Darden Architects
Drawn By: FM
Checked By: -
Reviewed By: MF

P/A101.1

 8/18/2023 4:28:49 PM e:\Users\alvin\Documents\180 Mission Oak HS Aquatic Complex_RD01_VZ2_A\Invtv.rvt




DSA File No.: 54-H11
DSA Application No.: 02-120251
Agency Approval

- SYMBOLS**
- Concrete Masonry Unit Wall, 8" wide unless otherwise noted.
 - Concrete Wall, or Column. Size as indicated.
 - Stud Wall. Studs and Interior Wall materials continuous from floor to underside of floor or roof deck. Studs at 16" o.c. unless otherwise noted. Interior Wall material shall include Batt Insulation, Sound Deadening Board, Plywood Sheathing, Gypsum Board, and Cement Plaster/Ceramic Tile setting bed where occurs.
 - Reference Grid
 - Opening Group No. Refer to Door or Window Opening Schedules
 - Eq Mark. Refer to Equipment Schedule
 - Room name. Room Designation
 - Wall Assembly Symbols. Refer to Sheet X/A101
 - Pool Equipment Building Floor Finish Elevation. See Pool Drawings and Structural Drawings.
 - Indicates Required Accessible Clearance Space
 - Indicates Required Accessible Clearance Space

- ABBREVIATIONS**
- DS STEEL AND FABRICATIONS, Rain Water Downspout. See Detail A11/P/A503
 - FE FIRE PROTECTION SPECIALTIES, Fire Extinguisher and Cabinet, Type FE-1, Unless Noted Otherwise.
 - FF Face of Finish
 - FC Face of Concrete
 - FD Floor Drain
 - FOM Face of Masonry
 - FOS Face of Stud
 - FR FIRE PROTECTION, Fire Riser, See Fire Protection Drawings
 - HB Hose Bib
 - MO Masonry Opening
 - UNO Unless Noted Otherwise
 - RO Rough Opening
 - Typ. Typical
 - Sim. Similar
 - OH Opposite Hand

- NOTES**
- All Exterior Walls shall be Wall Assembly Type (S/A/E/B) Unless Noted Otherwise.
 - All Interior Walls shall be Wall Assembly Type (6/D/L/M) Unless Noted Otherwise.
 - All Exterior Soffit Walls and Arches shall be Wall Assembly Type (4/D/E/M) Unless Noted Otherwise.
 - All Dimensions are to Face of Stud (FOS) or Center Line, Unless Noted Otherwise.
 - All Elevation Dimensions are Above Finish Floor at Each Floor Level, Unless Noted Otherwise.
 - Dimensions Noted as "+/-" are Nominal.
 - Floor Drains (FD) and Floor Sinks (FS) shall be Set -3/4" and a Min. of 3'-0" From Nearest wall, 1:48 Max Slope in Any Direction, Unless Noted Otherwise.
 - IDENTIFYING DEVICES, For Room Signage Refer to (E1/A/B/01) and Specifications
 - Integral Cove Base to be PAINT, Specialty Paint.

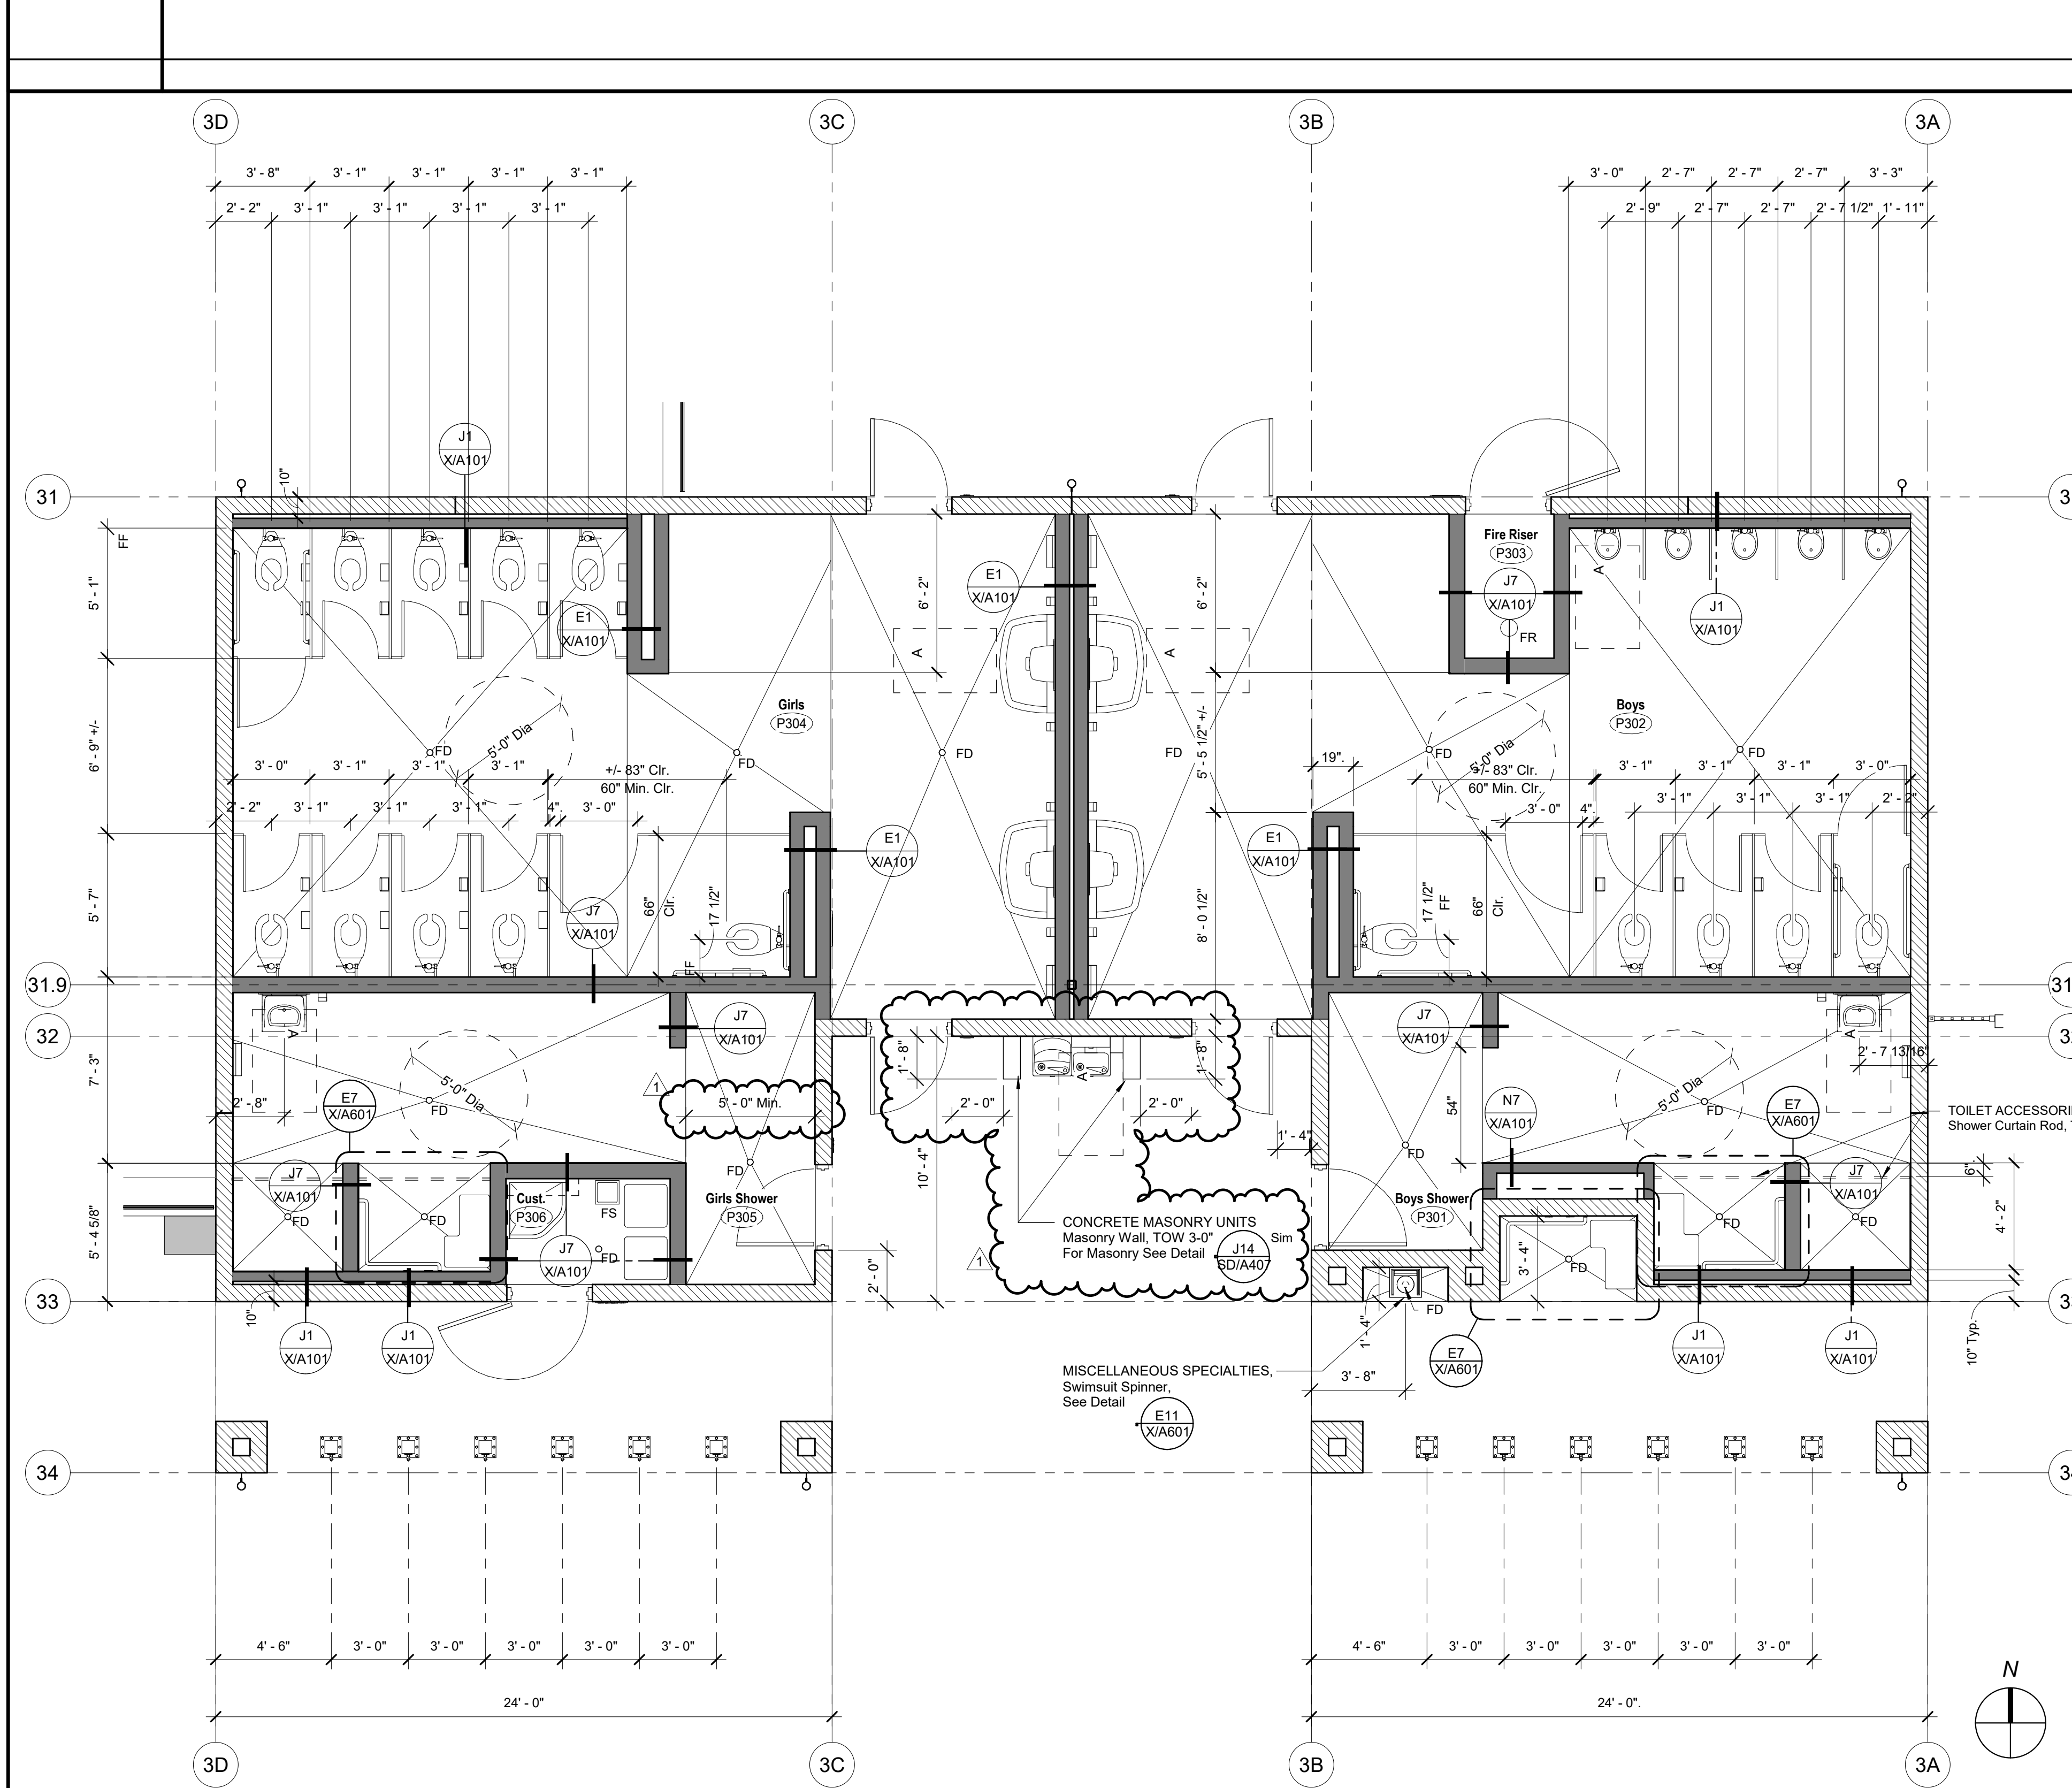

F18	Floor Plan Legend
No Scale	

- NOTES**
- All Exterior Walls shall be Wall Assembly Type (S/A/E/B) Unless Noted Otherwise.
 - All Interior Walls shall be Wall Assembly Type (6/D/L/M) Unless Noted Otherwise.
 - All Exterior Soffit Walls and Arches shall be Wall Assembly Type (4/D/E/M) Unless Noted Otherwise.
 - All Dimensions are to Face of Stud (FOS) or Center Line, Unless Noted Otherwise.
 - All Elevation Dimensions are Above Finish Floor at Each Floor Level, Unless Noted Otherwise.
 - Dimensions Noted as "+/-" are Nominal.
 - Floor Drains (FD) and Floor Sinks (FS) shall be Set -3/4" and a Min. of 3'-0" From Nearest wall, 1:48 Max Slope in Any Direction, Unless Noted Otherwise.
 - IDENTIFYING DEVICES, For Room Signage Refer to (E1/A/B/01) and Specifications
 - Integral Cove Base to be PAINT, Specialty Paint.

Mission Oak HS Aquatic Complex
Tulare Joint Union High School District
Tulare, CA 93274

BUILDING P
ENLARGED FLOOR PLANS

ARCHITECTURE
PLANNING
INTERIORS
architects
www.dardenarchitects.com
6790 N. West Ave. • Fresno, CA 93211 • T. 559.448.8051

No.	Revision/Submission	Date
1	REVISION_01	05/31/2023


Scale: As indicated
Project Number: 2180
Date: 03/28/2023

Designed By: MF
Drawn By: KT
Checked By: -
Reviewed By: MF


Copyright © 2022 Darden Architects
P/A103

8/18/2023 4:26:51 PM
e:\Users\alvin\Documents\180 Mission Oak HS Aquatic Complex_R001_VZ2_A\Invtv.rvt


A11
ENLARGED FLOOR PLAN
1/4" = 1'-0"
Refer to F18-P/A103 for Symbols, Abbreviations, and Notes

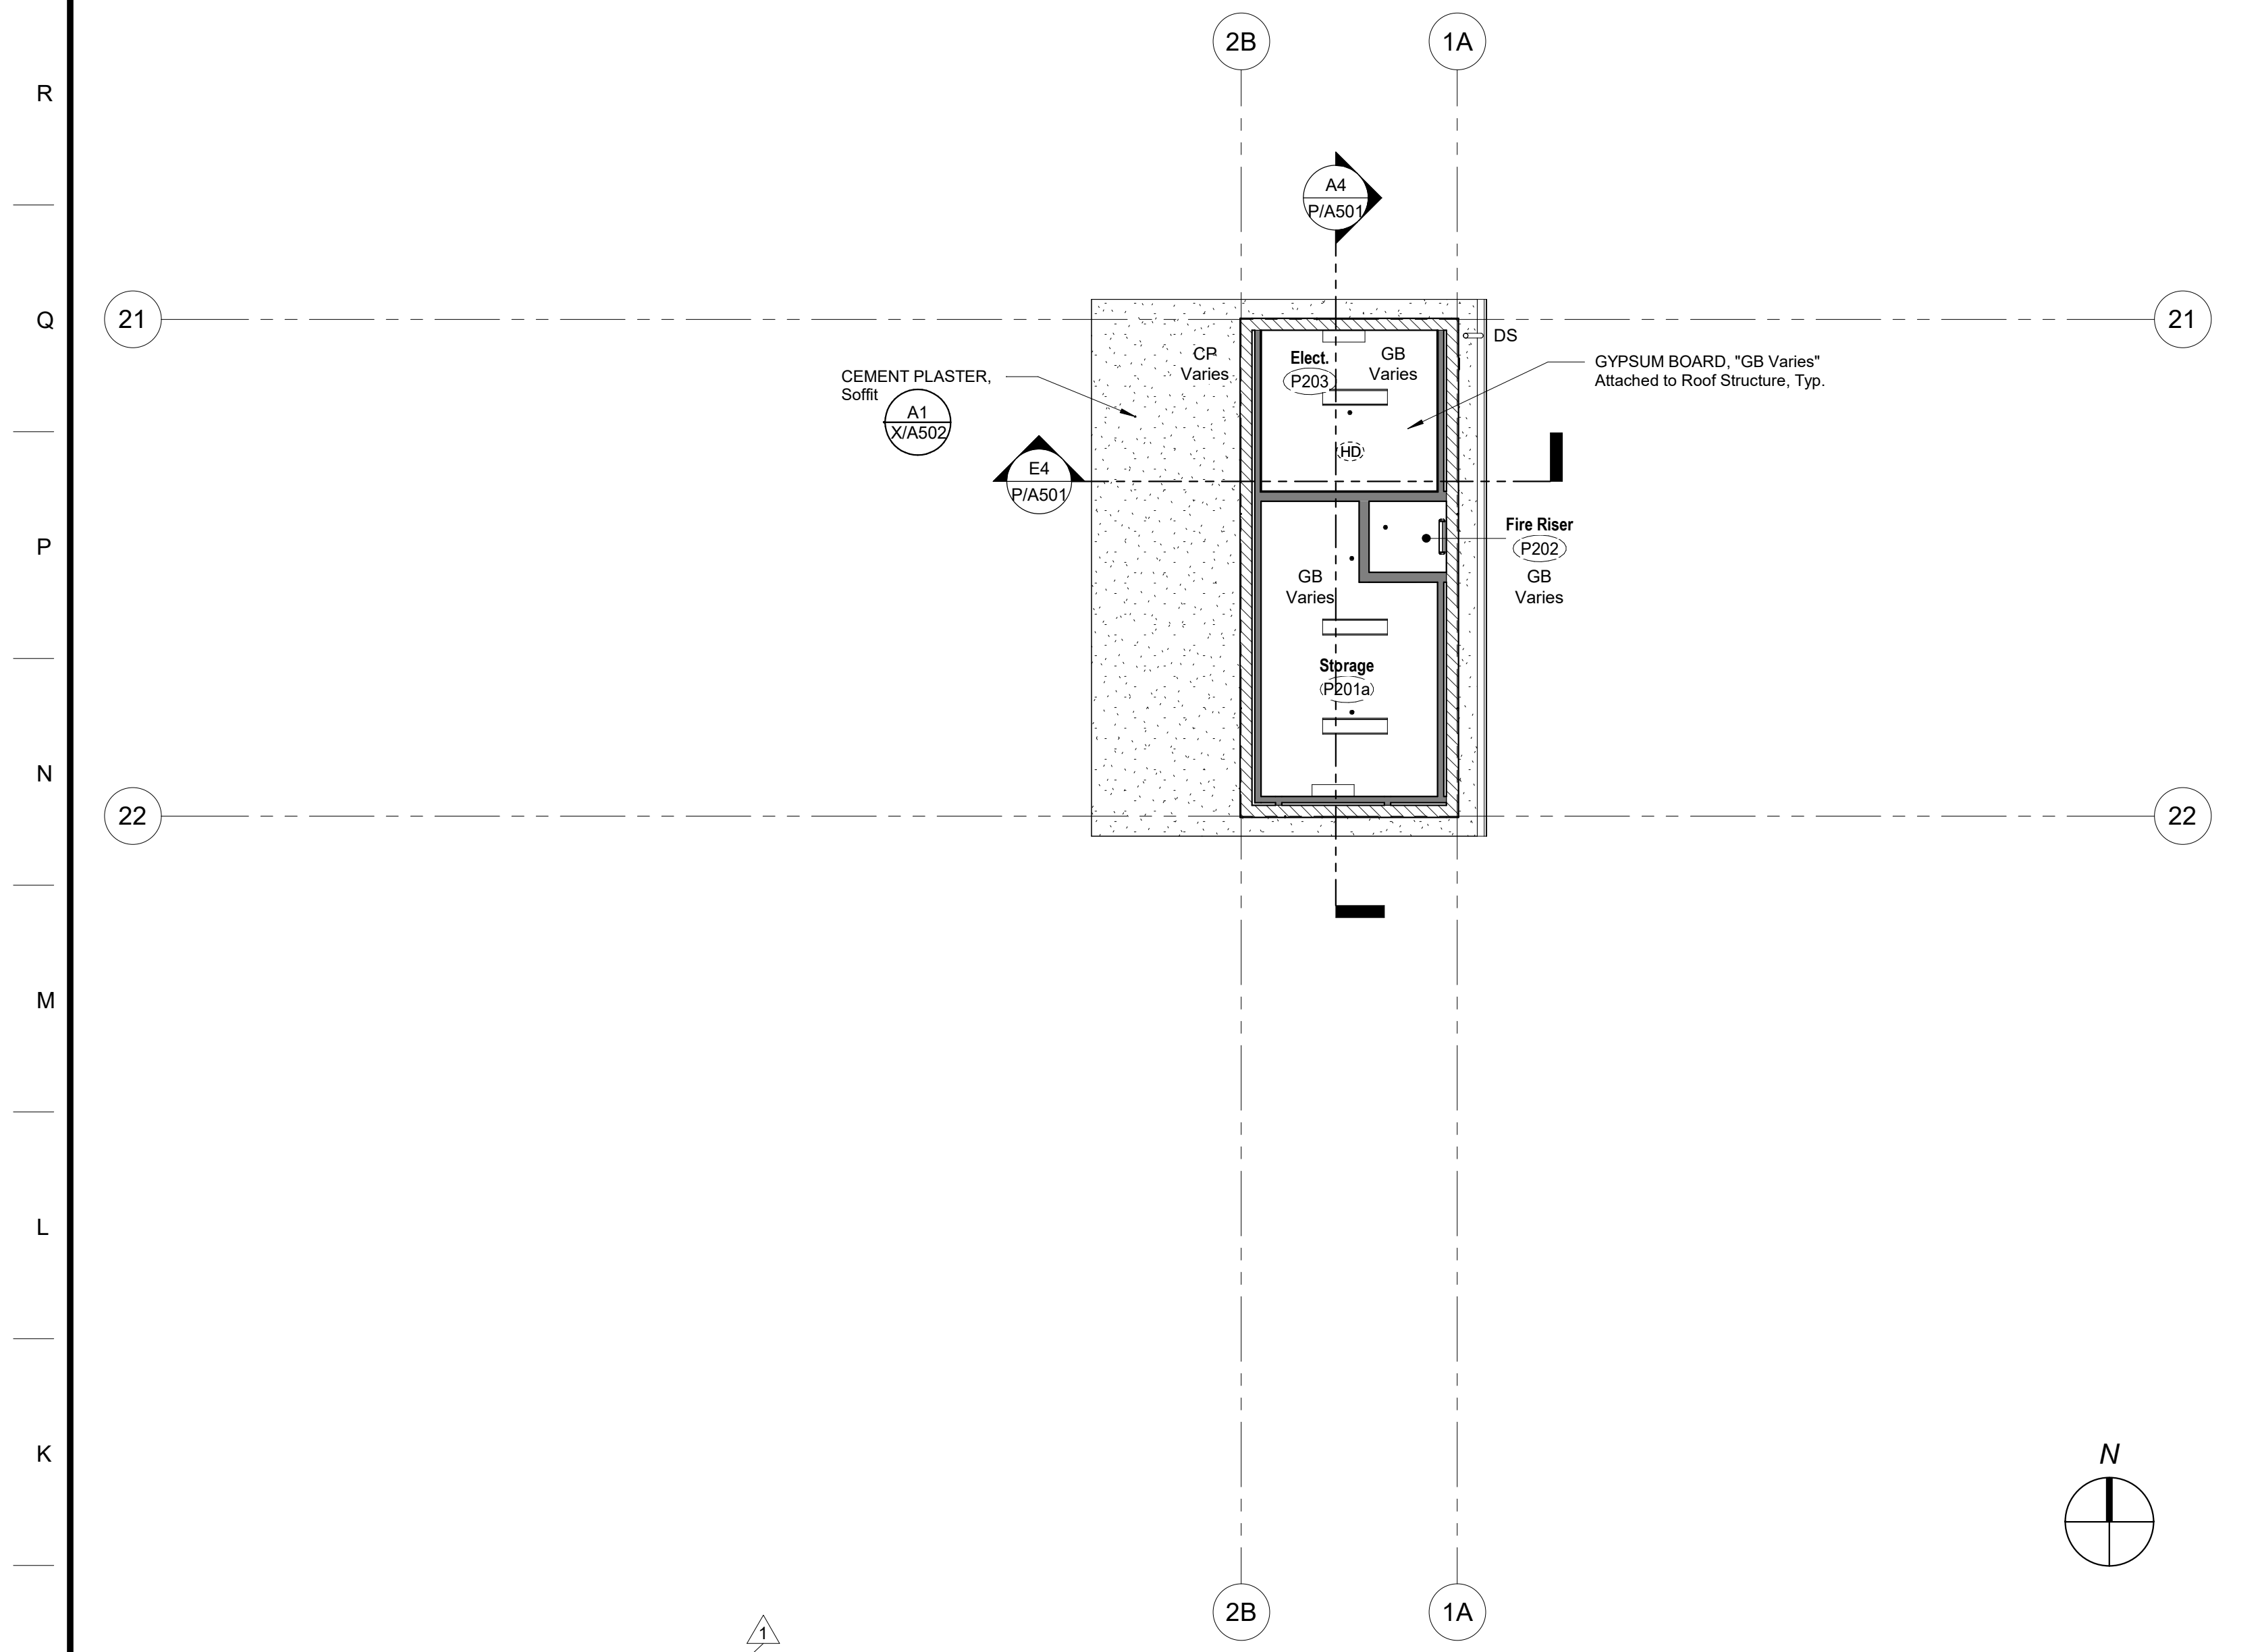

J1 Reflected Ceiling Plan - Building P2
1/8" = 1'-0"

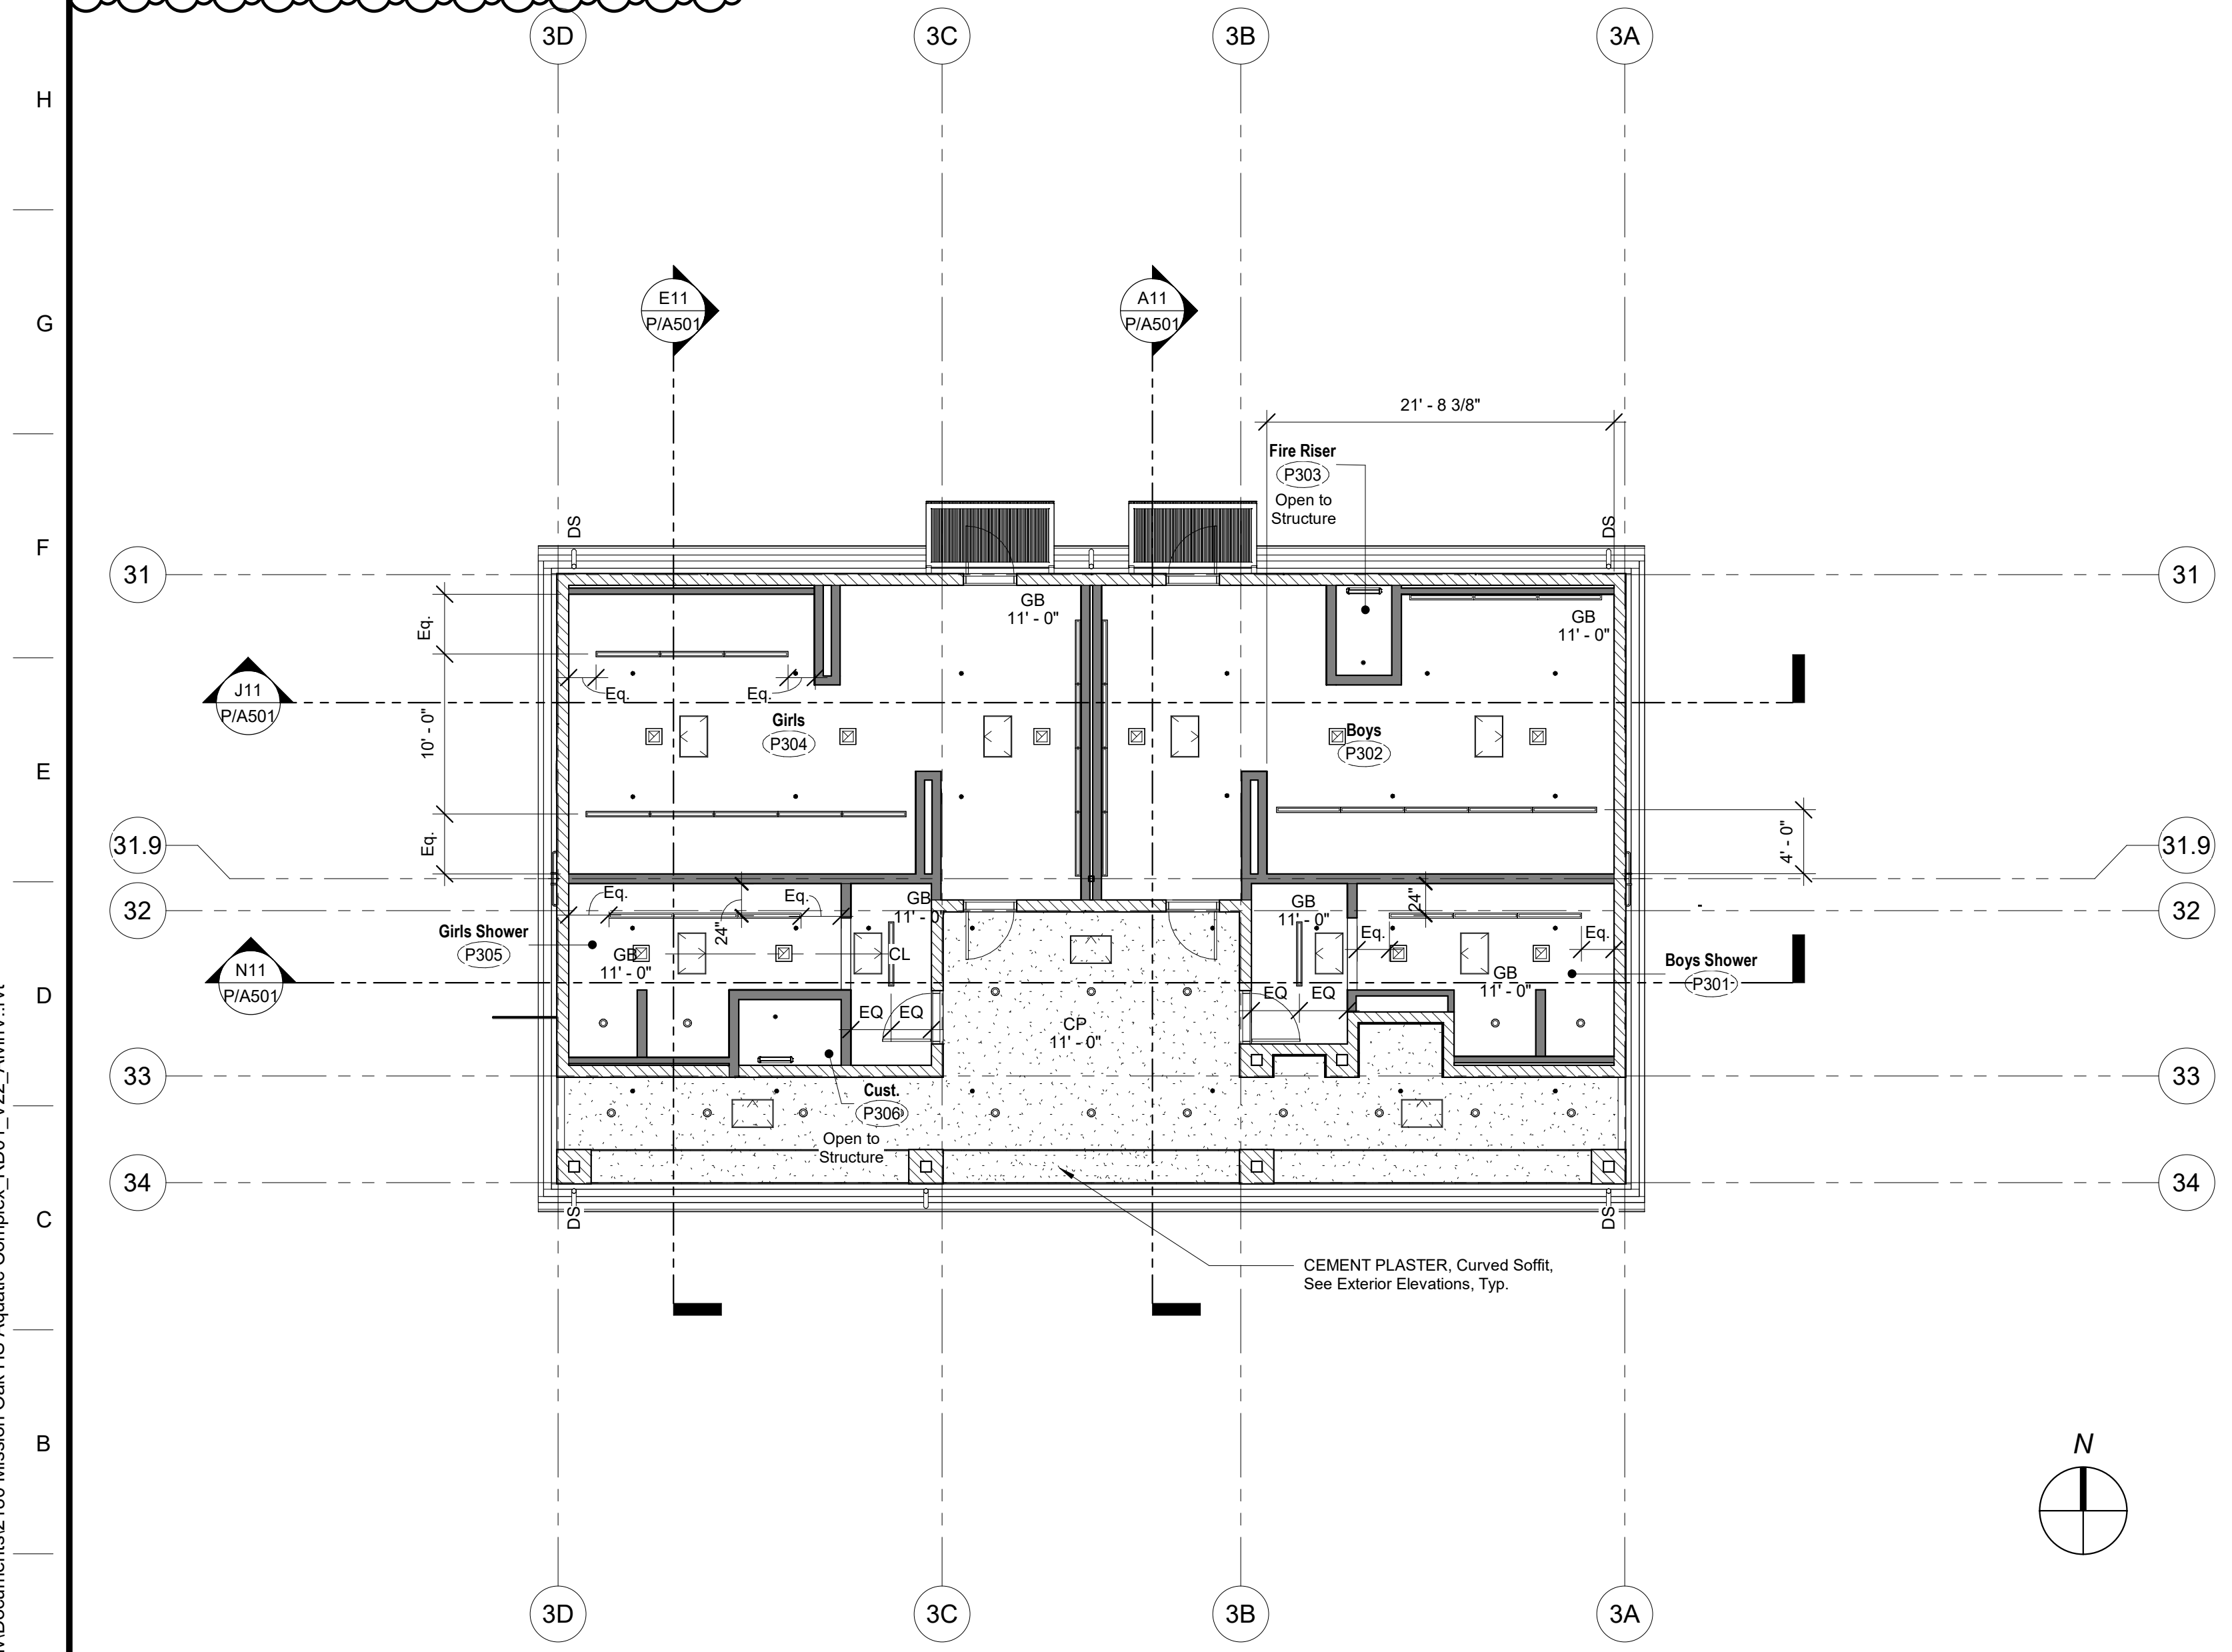

A1 Reflected Ceiling Plan - Building P3
1/8" = 1'-0"

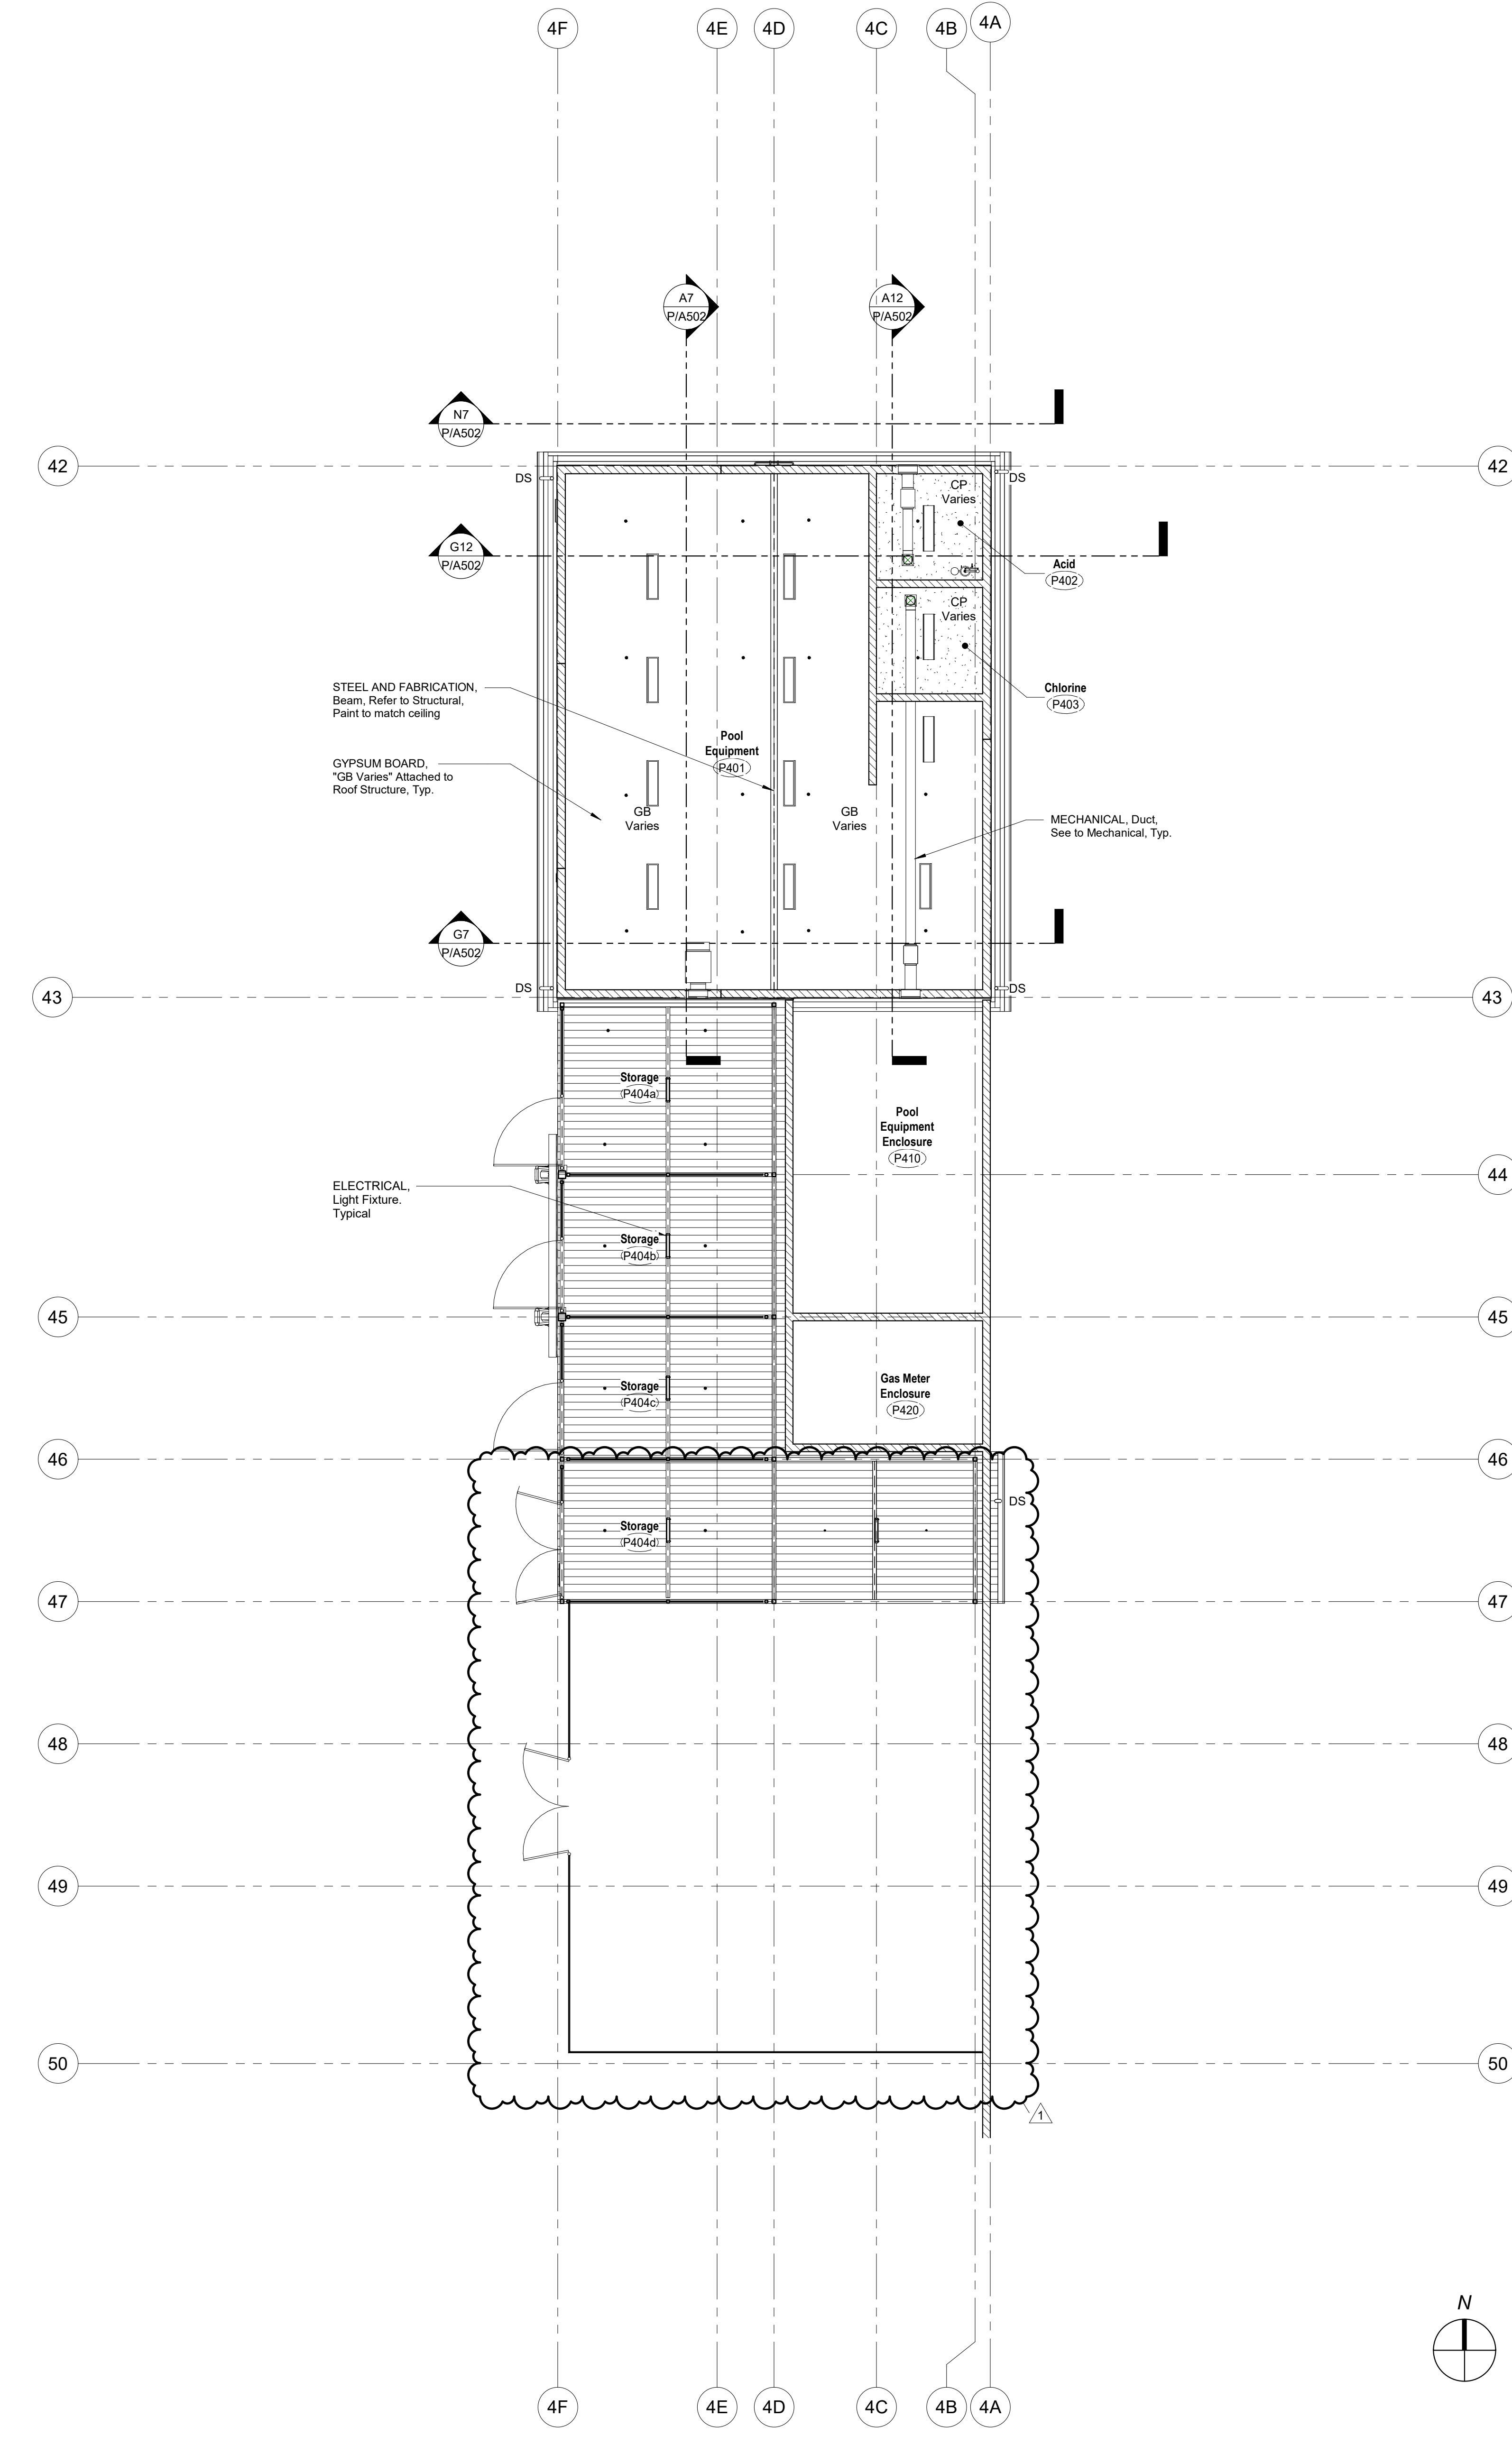

A9 Reflected Ceiling Plan - Building P4
1/8" = 1'-0"

DSA File No.: 54-H11
DSA Application No.: 02-120251
Agency Approval

- SYMBOLS**
- ACOUSTICAL CEILINGS, Suspended Ceiling Compression Strut/ Splay Wire location
 - PLUMBING, Overflow Drain
 - FIRE PROTECTION, Fire Sprinkler Head
 - MECHANICAL, Air Supply Grill
 - MECHANICAL, Air Return Grill
 - MECHANICAL, Strip Grill
 - MECHANICAL, Exhaust Fan
 - ELECTRICAL, Light Fixture, Surface Mounted, Unless Noted Otherwise.
 - ELECTRICAL, Fire Alarm Device, Heat Detector
 - ELECTRICAL, Fire Alarm Device, Smoke Detector
 - ELECTRICAL, Fire Alarm Audio Visual Speaker
 - ELECTRICAL, Public Address System Speaker
 - ELECTRICAL, Wireless Access Point
 - CEMENT PLASTER, Cement Plaster System See Structural for Framing Color to be PC-1. Refer to Exterior Color Schedule.
 - CEMENT PLASTER, Cement Plaster System See Structural for Framing Color to be PC-2. Refer to Exterior Color Schedule.
 - METAL DECK. See Structural Drawings.
 - ACCESS DOORS AND FRAMES, Access Doors, Ceiling (20" X 30"), UNO
 - Reference Point
- ABBREVIATIONS**
- DS STEEL AND FABRICATIONS, Rain Water Downspout.
 - CLG Ceiling
 - CP CEMENT PLASTER, System
 - GB GYPSUM BOARD
 - GLB GLUE-LAMINATED CONSTRUCTION, Beam
 - HT Height
 - MD METAL DECK
 - TYP Typical
 - SIM Similar
 - OH Opposite hand
 - DS Downspout
 - OD Overflow Drain
 - UNO Unless Noted Otherwise

- NOTES**
1. See Structural for Framing of Soffits and Ceilings
 2. Single Lights or Single Rows of Lights at Soffits/ Ceilings Shall be Centered, UNO.
 3. Refer to Interior Color Schedule for color.
 4. Ceiling Color to Match to Adjacent Surface, Unless Otherwise Noted. Refer to Interior Elevation and Interior Design Plan for Color Location.

Mission Oak HS Aquatic Complex
Tulare Joint Union High School District
Tulare, CA 93274 Project

BUILDING P
REFLECTED CEILING PLANS
Drawing


darden architects ARCHITECTURE PLANNING INTERIORS
www.dardenarchitects.com
6790 N. West Ave. • Fresno, CA 93711 • T. 559.448.8051
Architect

No.	Revision/Submission	Date
1	REVISION_01	05/31/2023


Revision

Designed By: MF Copyright 2022 Darden Architects
Scale: 1/8" = 1'-0" Drawn By: KT
Project Number: 2180 Checked By: -
Date: 03/28/2023 Reviewed By: MF


P/A201

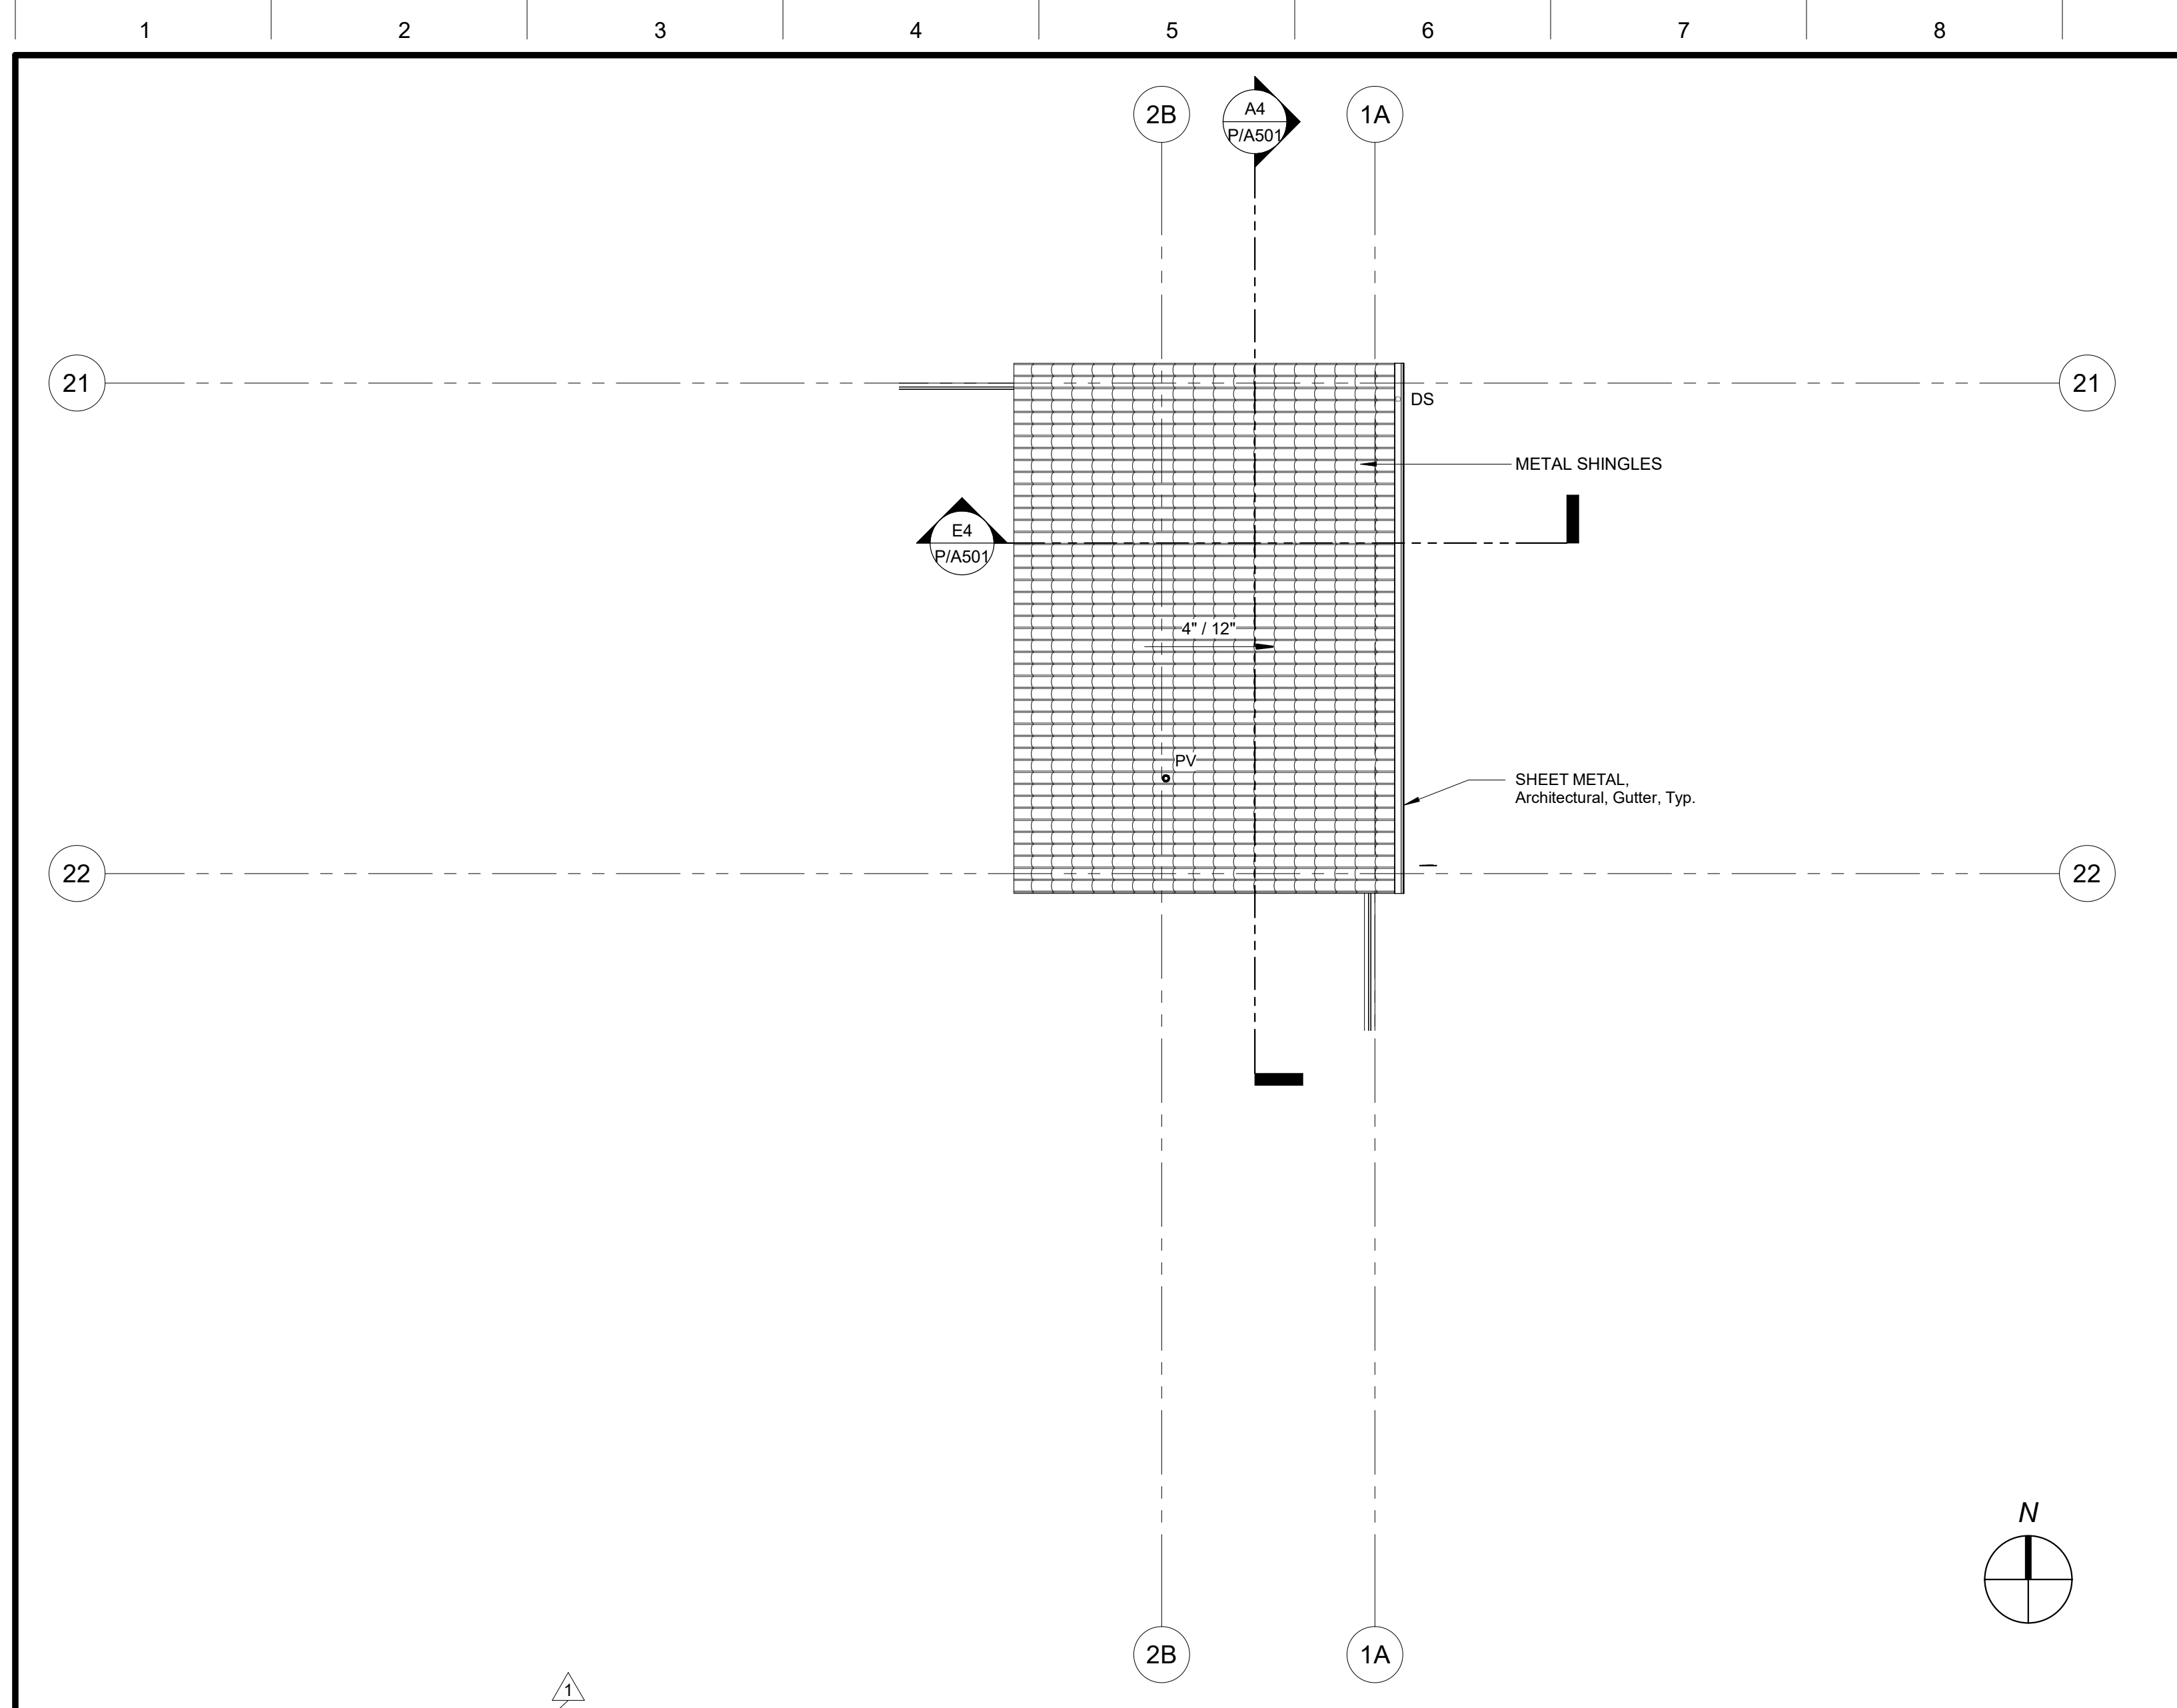

J1 Roof Plan - Building P2
1/8" = 1'-0"

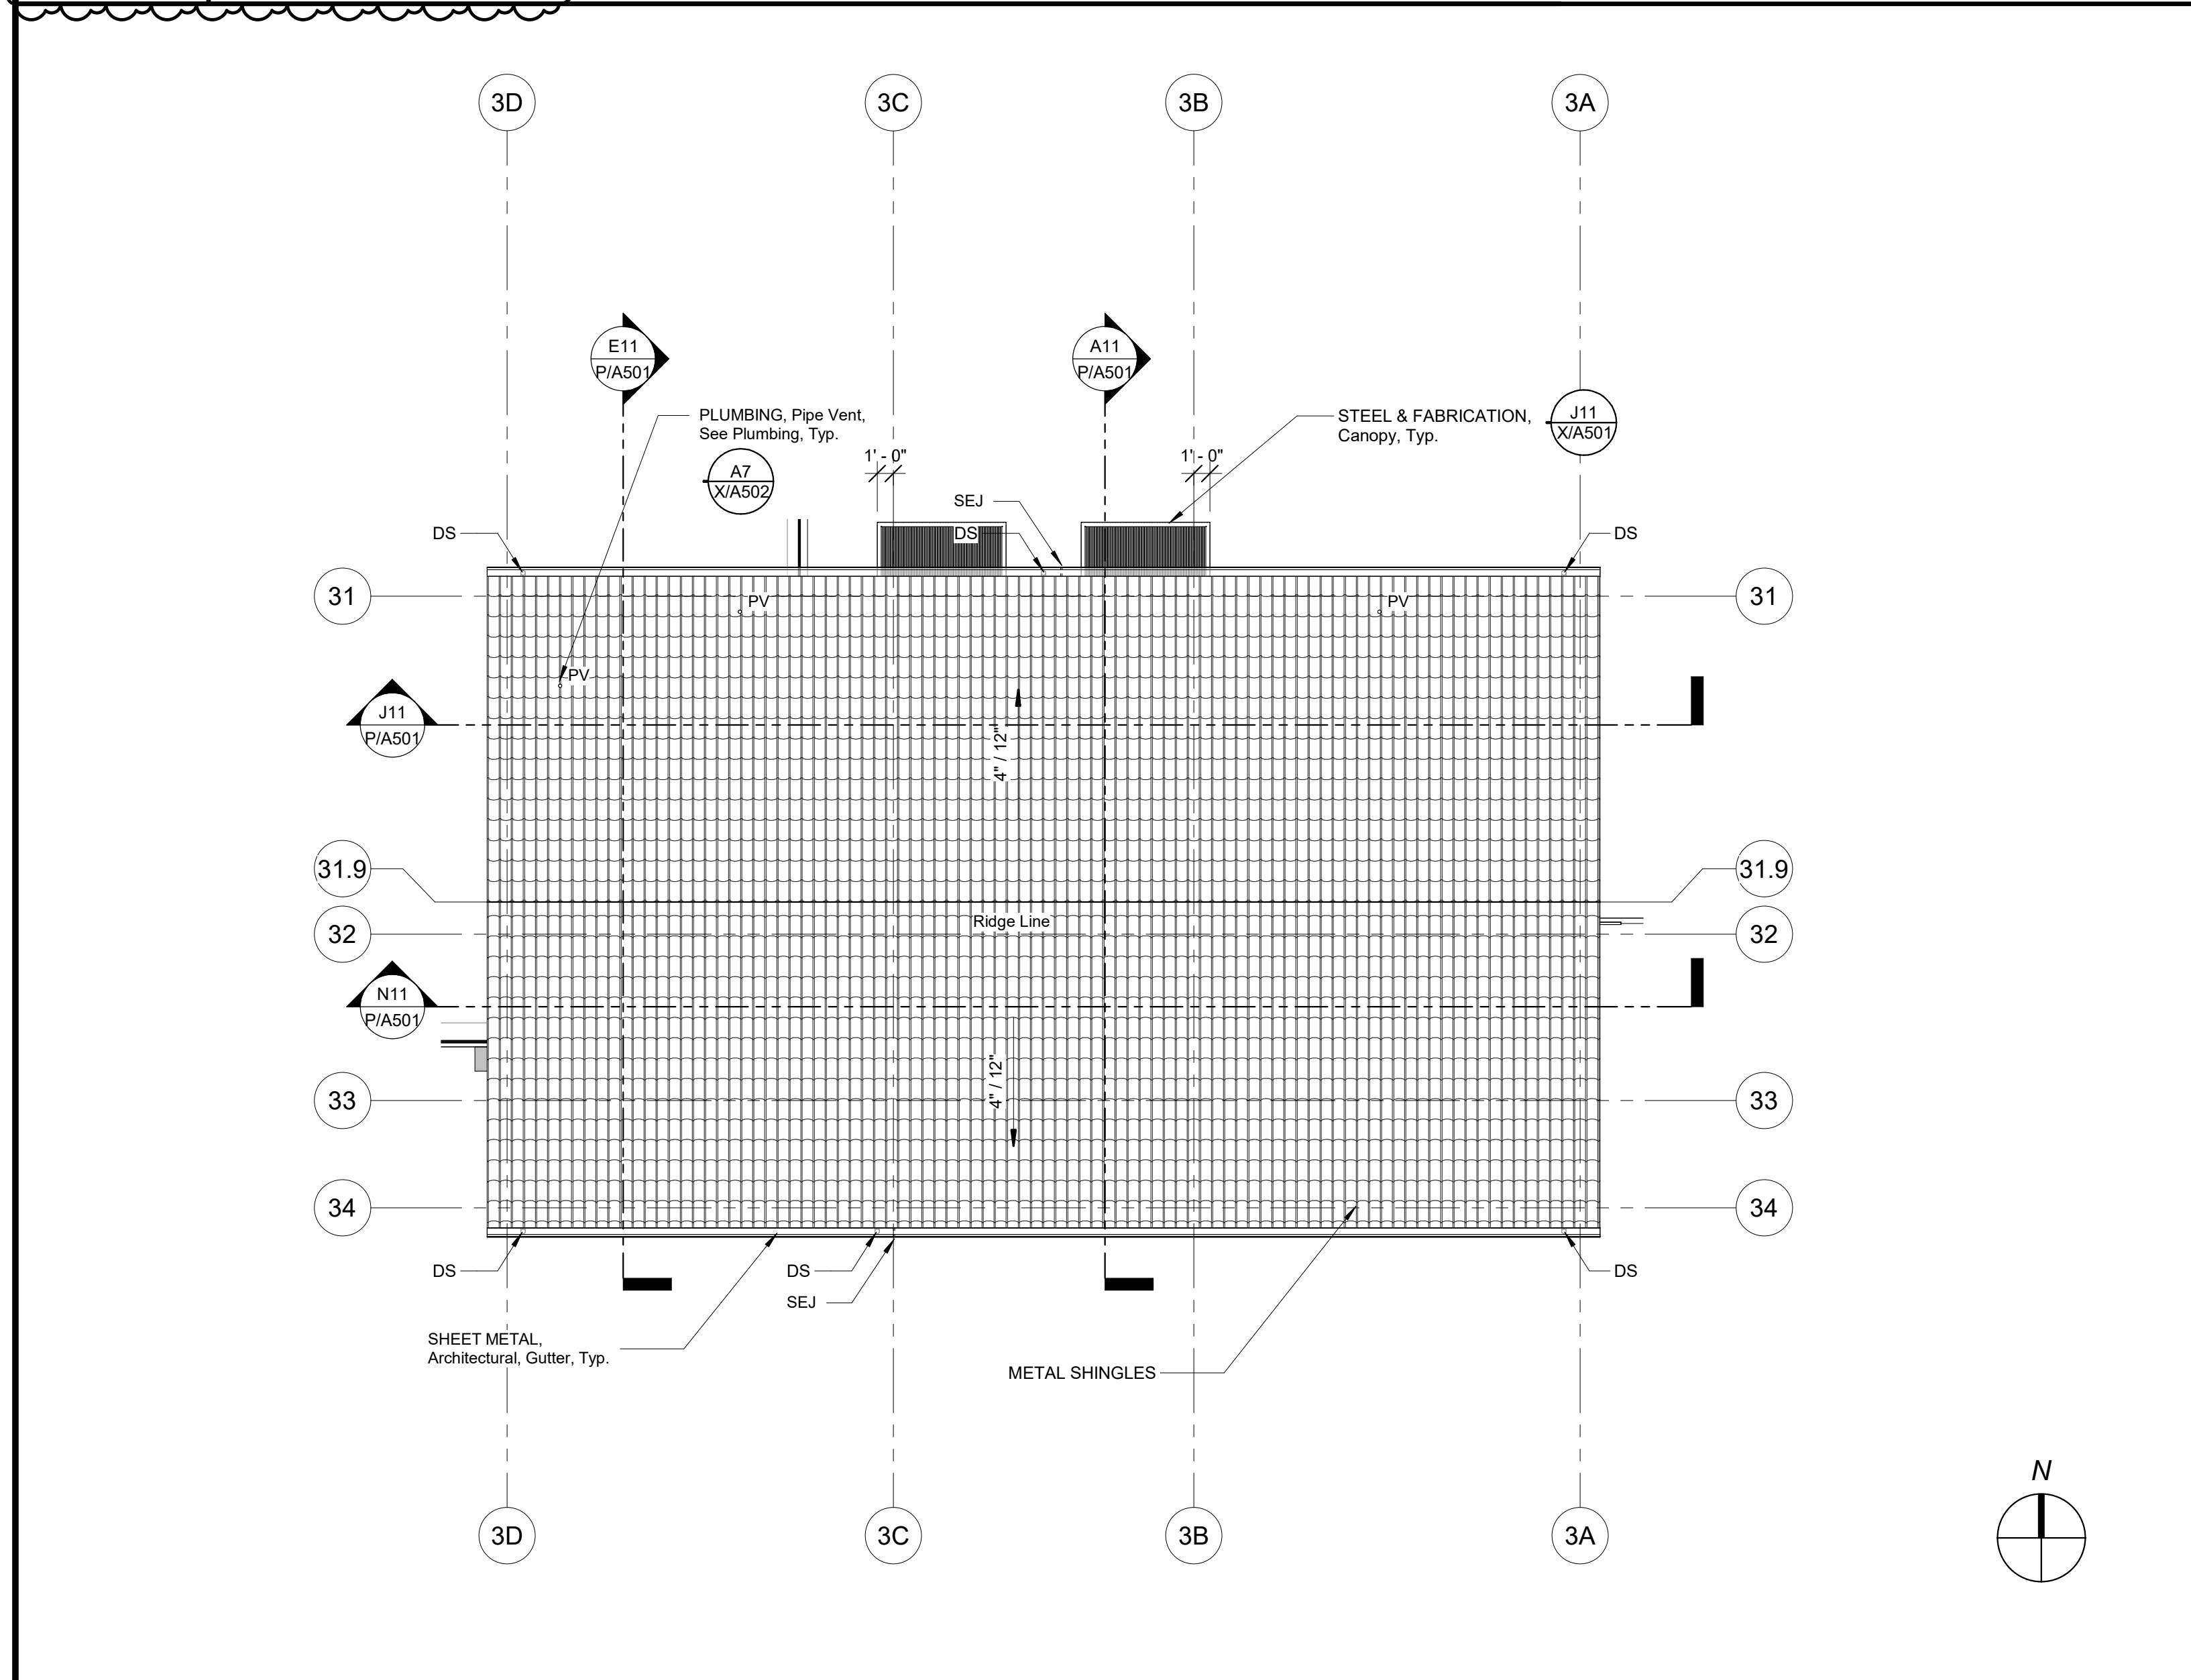

A1 Roof Plan - Building P3
1/8" = 1'-0"

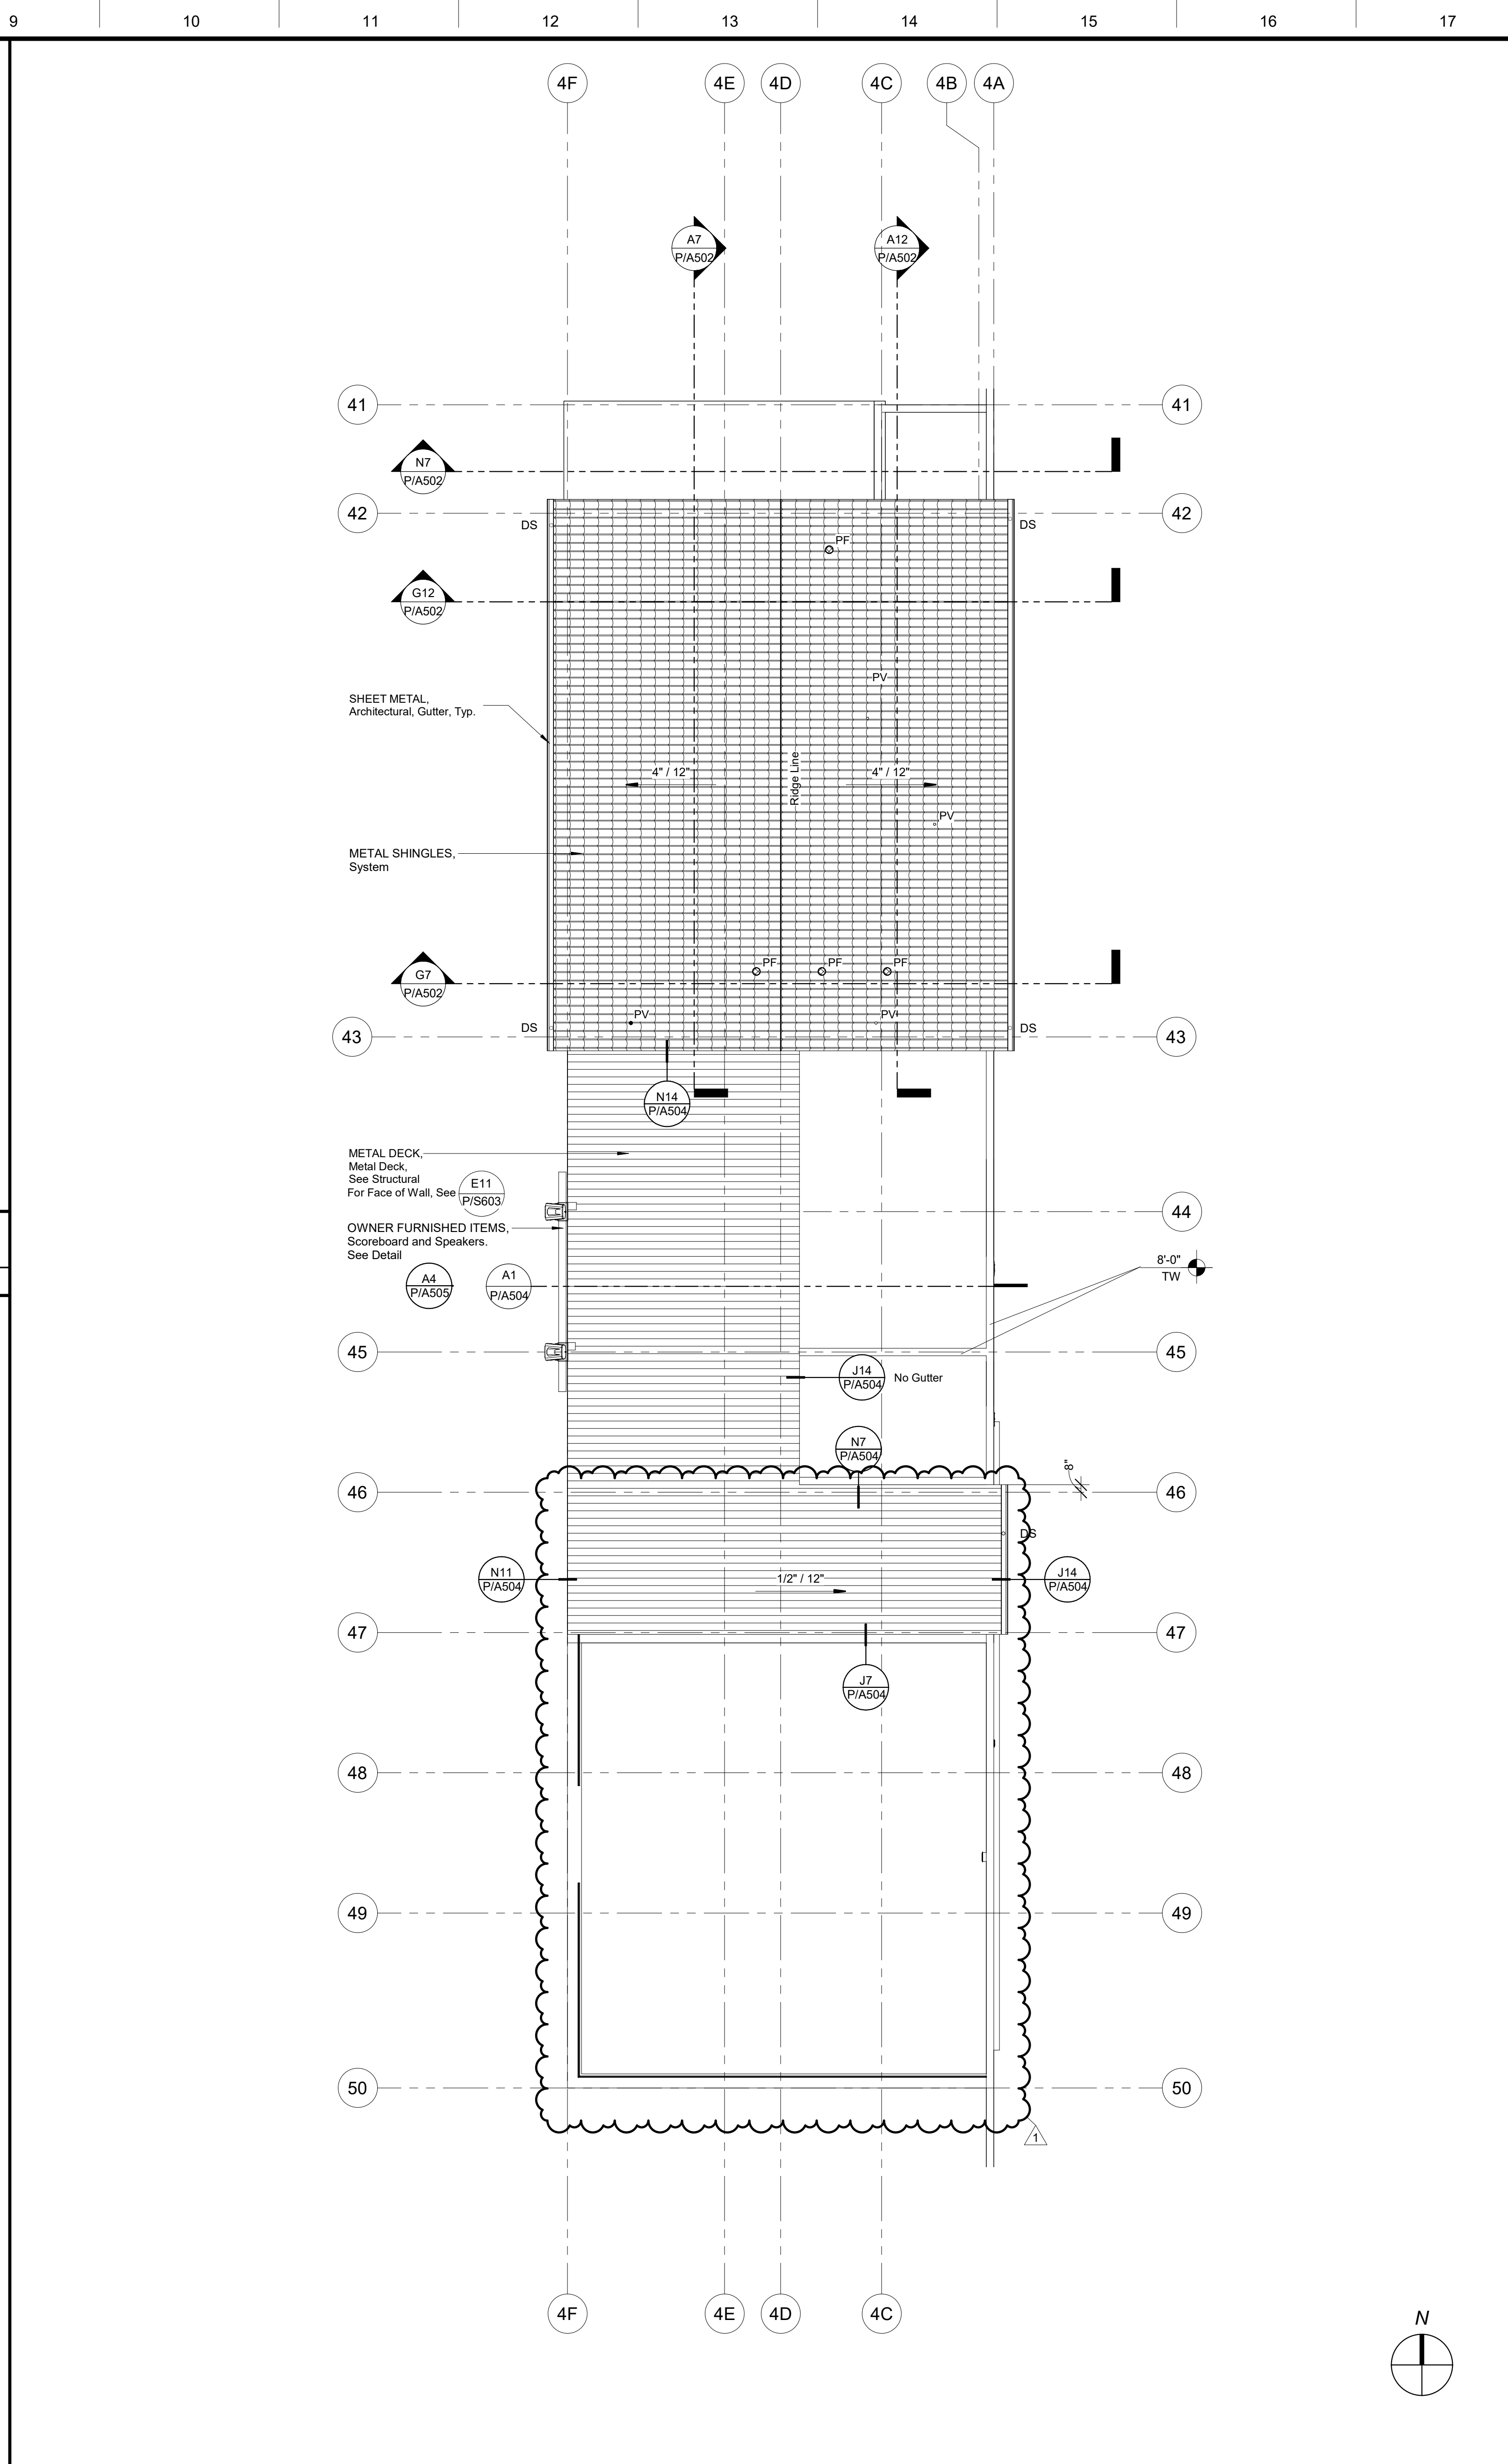

A13 Roof Plan - Building P4
1/8" = 1'-0"

DSA File No.: 54-H11
 DSA Application No.: 02-120251
 Agency Approval

SYMBOLS

- PV: PLUMBING, Vent with METAL SHINGLES Roofing Jack. Powder Coated finish to match the color of the Metal Shingle Room System. Coordinate the locations and sizes between the trades.
- PF: PLUMBING, Flue with METAL SHINGLES Roofing Jack. Powder Coated finish to match the color of the Metal Shingle Room System. Coordinate the locations and sizes between the trades.
- +00'-0" TOP: Elevation above finish floor
- Slope (DN): Direction of slope
- : Line of Wall below
- Reference Point

ABBREVIATIONS

- DS: STEEL AND FABRICATIONS, Rain Water Downspout
- SEJ: SHEET METAL, Architectural Gutters, Expansion Joint
- FD Frm: Face of Framing
- OD: PLUMBING, Overflow Drain
- TOP: Top of Framing
- RO: PLUMBING, Roof Drain
- TOM: Top of Masonry
- OH: Opposite Hand
- FOS: Face of Stud
- TOS: Top of Steel
- Sim: Similar
- Typ: Typical

NOTES

- Refer to Plumbing, Mechanical, and Electrical for all roof penetrations and roof mounted equipment. Coordinate the type of roof penetration with the METAL SHINGLES trade contractor and manufacturer for the flashing and installation of the penetration. Provide shop drawings for locations and shop drawings.

K18 Roof Plan Legend
No Scale

Mission Oak HS Aquatic Complex
 Tulare Joint Union High School District
 Tulare, CA 93274
BUILDING P
 ROOF PLANS

ARCHITECTURE
 PLANNING
 INTERIORS
 darden architects
 www.dardenarchitects.com
 6790 N. West Ave. • Fresno, CA 93711 • T. 559.448.8051

No.	Revision/Submission	Date
1	REVISION_01	05/31/2023


Revision

Designed By: MF
 Drawn By: KT
 Project Number: 2180
 Date: 03/28/2023

Copyright 2022 Darden Architects
 Checked By: -
 Reviewed By: MF

P/A301

8/18/2023 4:26:59 PM e:\Users\alvin\Documents\180 Mission Oak HS Aquatic Complex_RD01_VZ2_A\Invtv.rvt

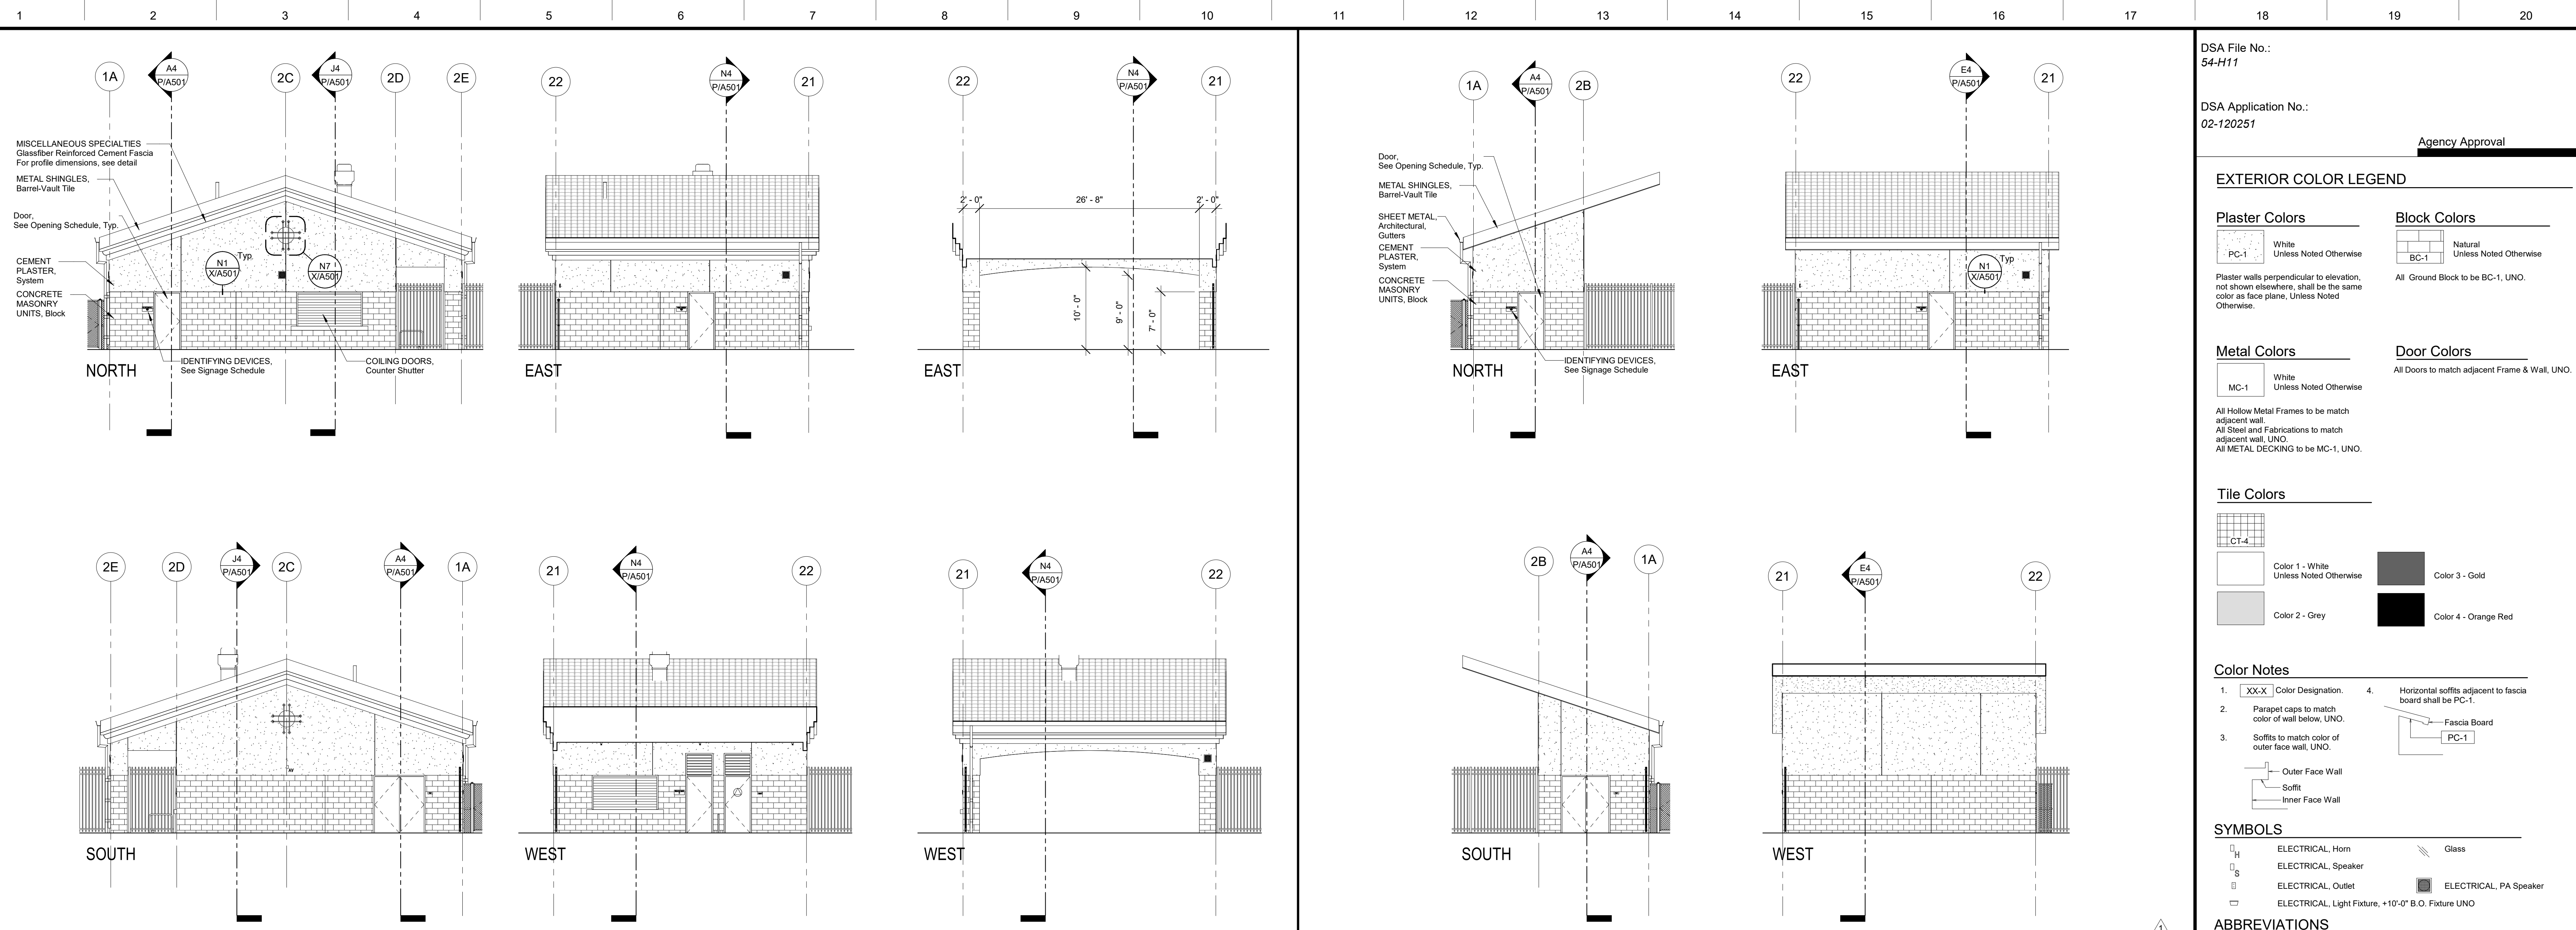

DSA File No.: 54-H11
 DSA Application No.: 02-120251
 Agency Approval

EXTERIOR COLOR LEGEND

Plaster Colors
 PC-1 White Unless Noted Otherwise

Block Colors
 BC-1 Natural Unless Noted Otherwise
 All Ground Block to be BC-1, UNO.

Metal Colors
 MC-1 White Unless Noted Otherwise

Door Colors
 All Doors to match adjacent Frame & Wall, UNO.

Tile Colors
 CT-4

Color Notes

- Color Designation, XXX
- Parapet caps to match color of wall below, UNO.
- Soffits to match color of outer face wall, UNO.
- Horizontal soffits adjacent to fascia board shall be PC-1.

Legend:
 Outer Face Wall
 Soffit
 Inner Face Wall
 Fascia Board
 PC-1

SYMBOLS

H ELECTRICAL, Horn
 S ELECTRICAL, Speaker
 O ELECTRICAL, Outlet
 L ELECTRICAL, Light Fixture, +10'-0" B.O. Fixture UNO


Glass
 ELECTRICAL, PA Speaker

ABBREVIATIONS

AFF Above Finished Floor
 BO Bottom of
 CJ Control Joint
 DS Downspout
 EJ Expansion Joint
 HB PLUMBING, Hose Bibb.
 OH Opposite Hand
 Sim. Similar
 TO Top of
 TOM Top of Masonry
 TOP Top of Parapet Framing
 TOF Top of Framing
 TOR Top of Roof
 TOS Top of Steel
 TPL Top of Plate
 Typ. Typical
 UNO Unless Noted Otherwise

H1 ADD ALTERNATE Exterior Elevations - Building P2
 1/8" = 1'-0"
 Refer to E18 for Legend Symbols, Abbreviations and Notes

H1 Exterior Elevations - Building P2
 1/8" = 1'-0"
 Refer to E18 for Legend Symbols, Abbreviations and Notes

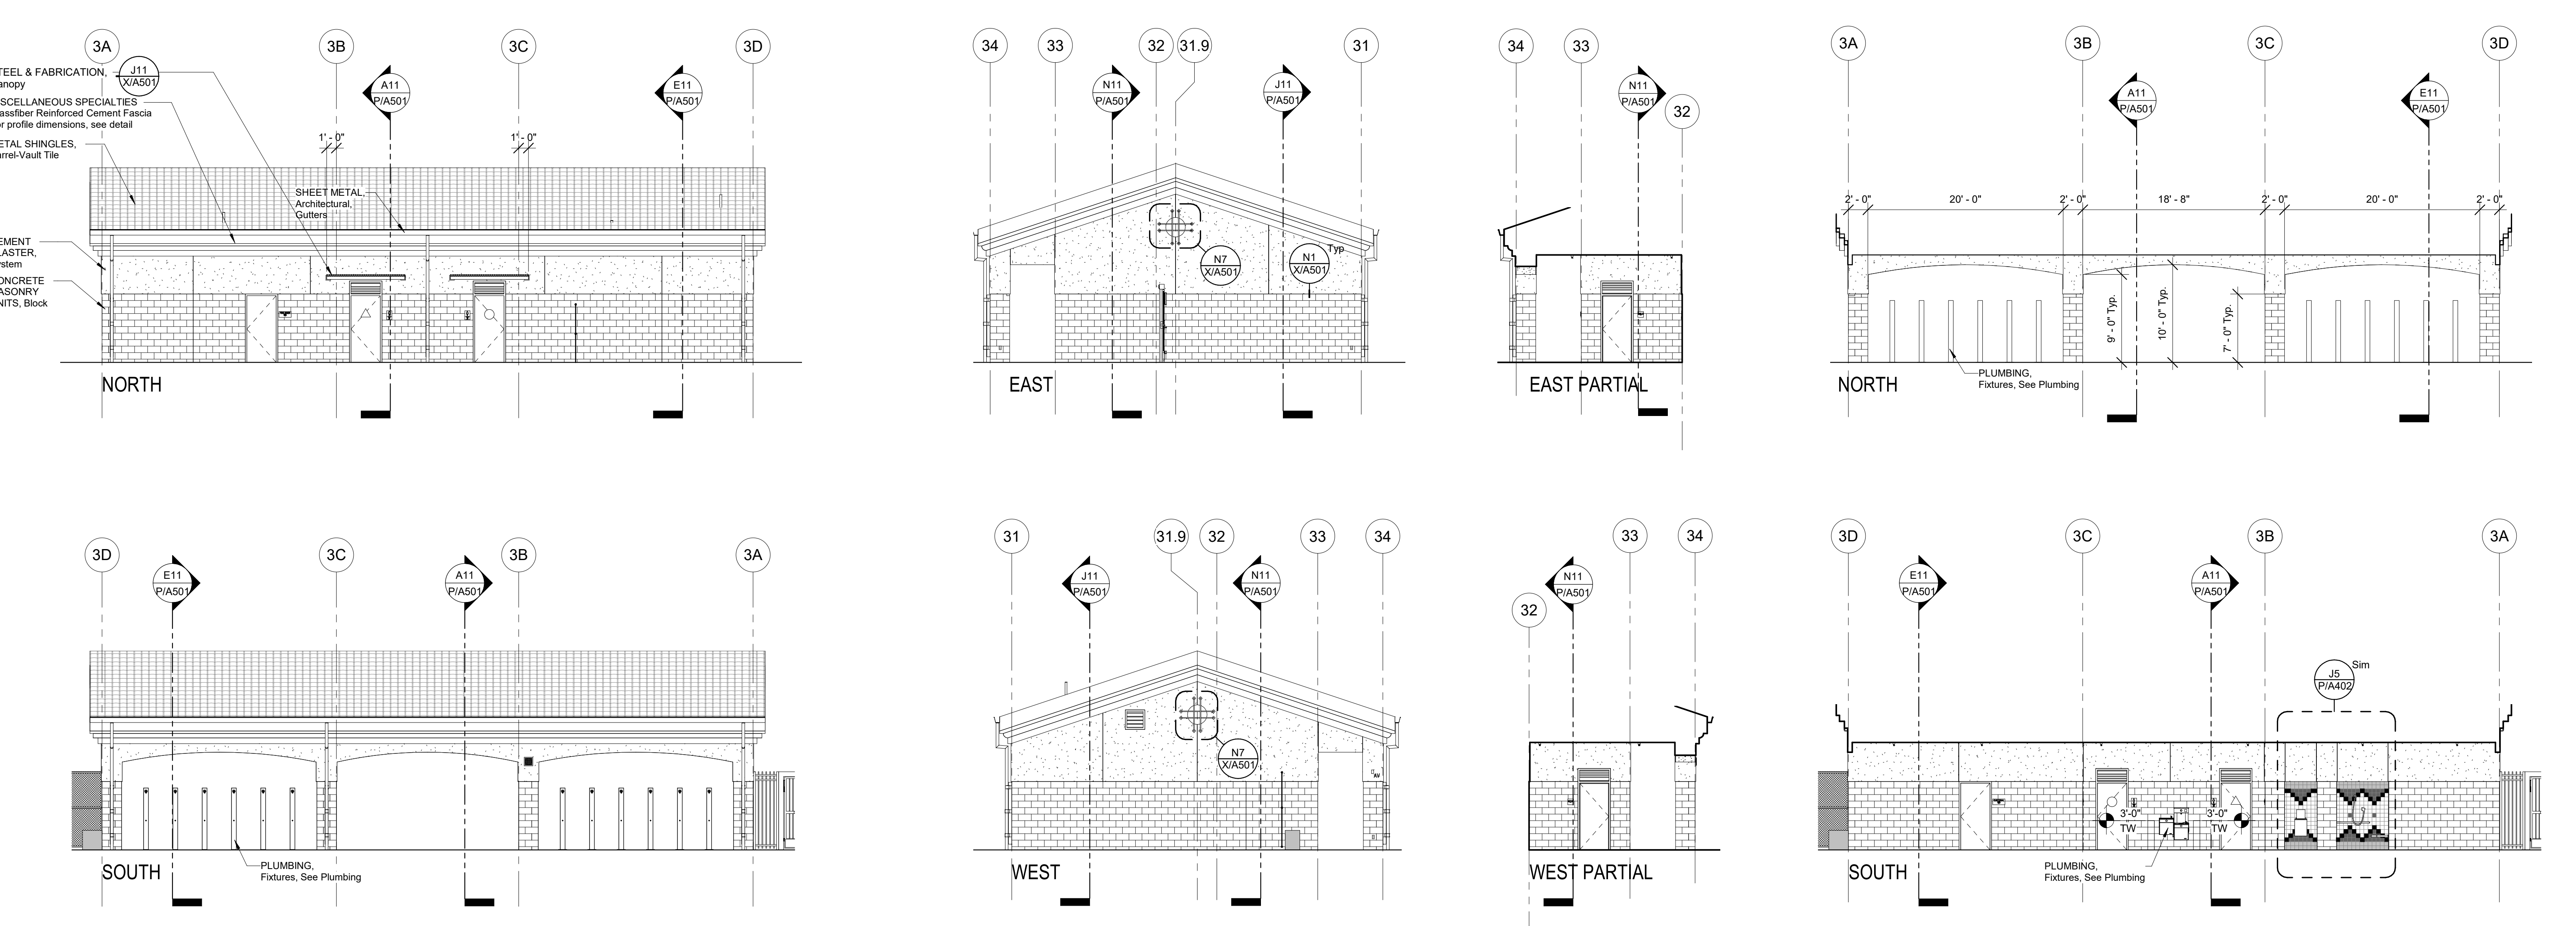

NOTES

- CEMENT PLASTER, Cement Plaster System, Accessories, Refer to Detail A14 X/A501
- STEEL & FABRICATION, Downspout, Refer to Detail A1 X/A501
- Refer to Specifications Section Appendix "C" Exterior Color Schedule.
- Refer to Exterior Finish Schedule on A1 / X/A201
- Refer to Structural for Curved Soffit Framing

E18 Exterior Elevations Legend
 No Scale

Mission Oak HS Aquatic Complex
 Tulare Joint Union High School District
 Tulare, CA 93274
 Project
 BUILDING P1, P2, P3
 EXTERIOR ELEVATIONS - P2 & P3
 Drawing

ARCHITECTURE
PLANNING
INTERIORS
darden architects
 www.dardenarchitects.com
 6790 N. West Ave. • Fresno, CA 93711 • T. 559.448.8051
 Architect

ARCHITECT, FRESNO, CALIFORNIA
 No. C23724
 State of California

No.	Revision/Submission	Date
1	REVISION_01	05/31/2023


Revision

Designed By: MF
 Copyright © 2022 Darden Architects


Scale: As indicated
 Drawn By: FM
 Project Number: 2180
 Checked By: -
 Date: 03/28/2023
 Reviewed By: MF

P/A401


8/18/2023 4:27:09 PM
 e:\Users\alvin\Documents\180 Mission Oak HS Aquatic Complex_RD01_VZ2_A\Inv\...nt

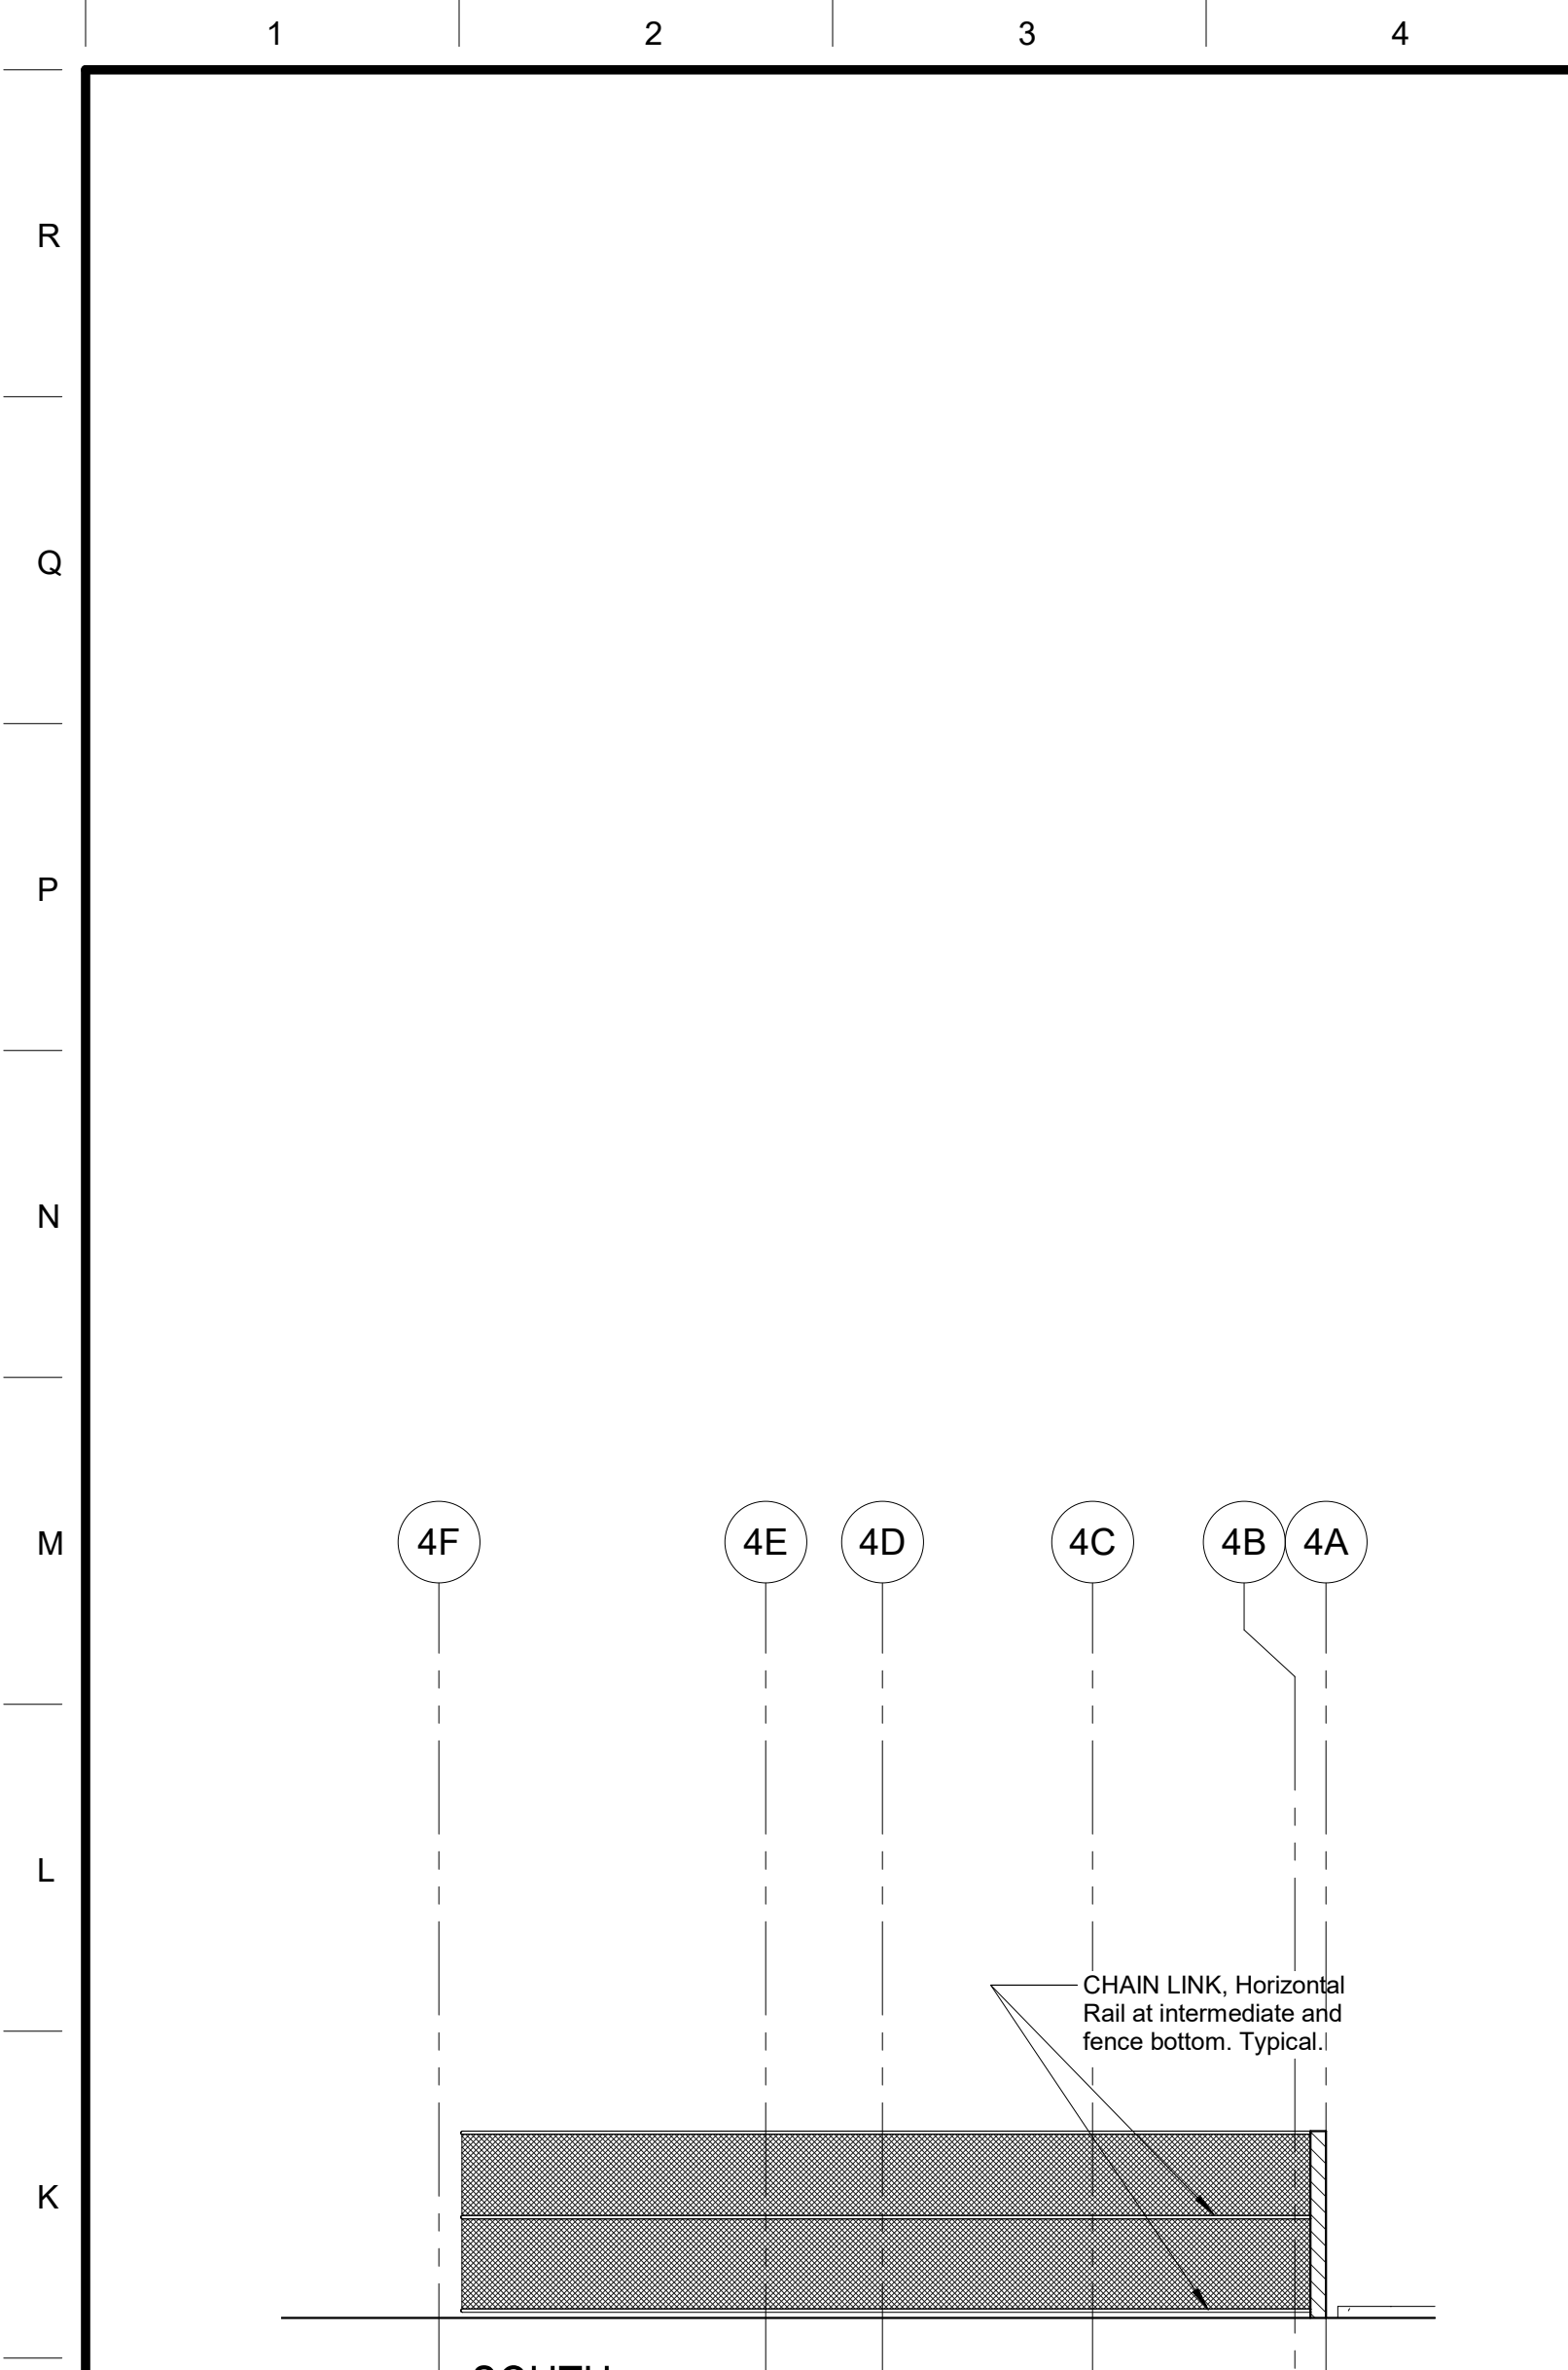


J5 Exterior Elevations - Building P3
1/2" = 1'-0"

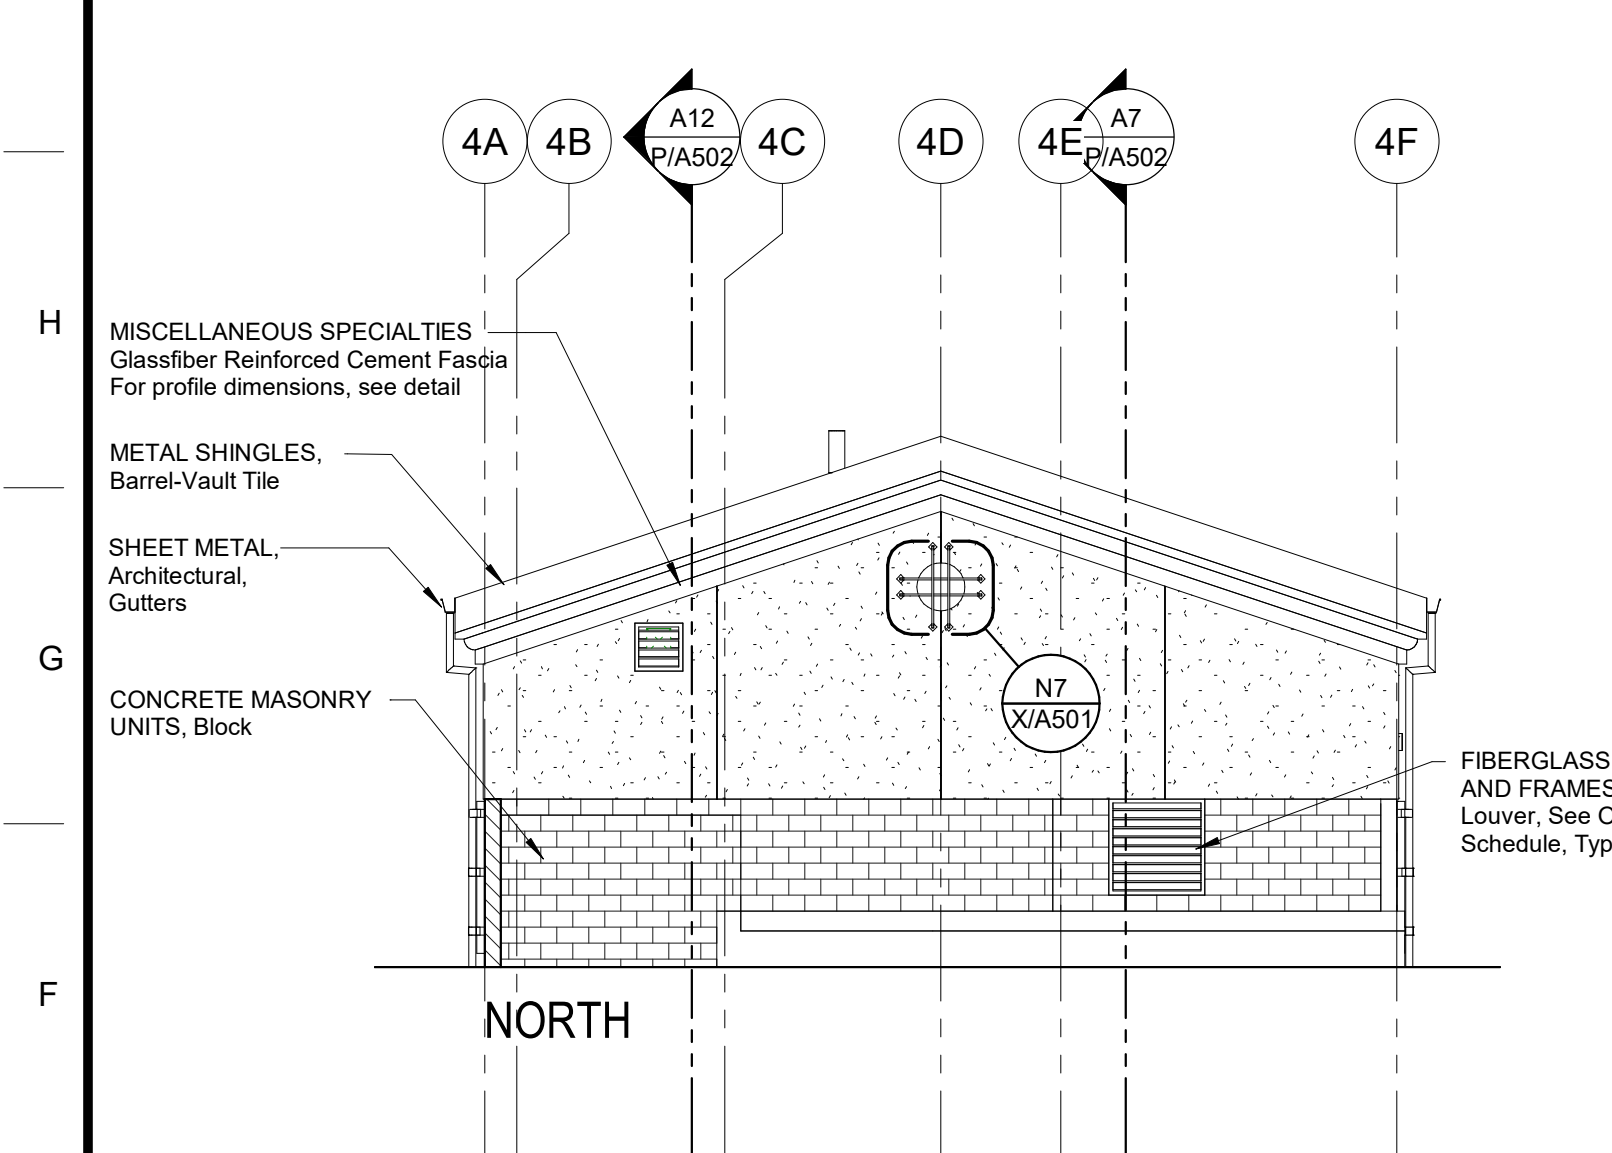


J5 Exterior Elevations - Building P3
1/2" = 1'-0"

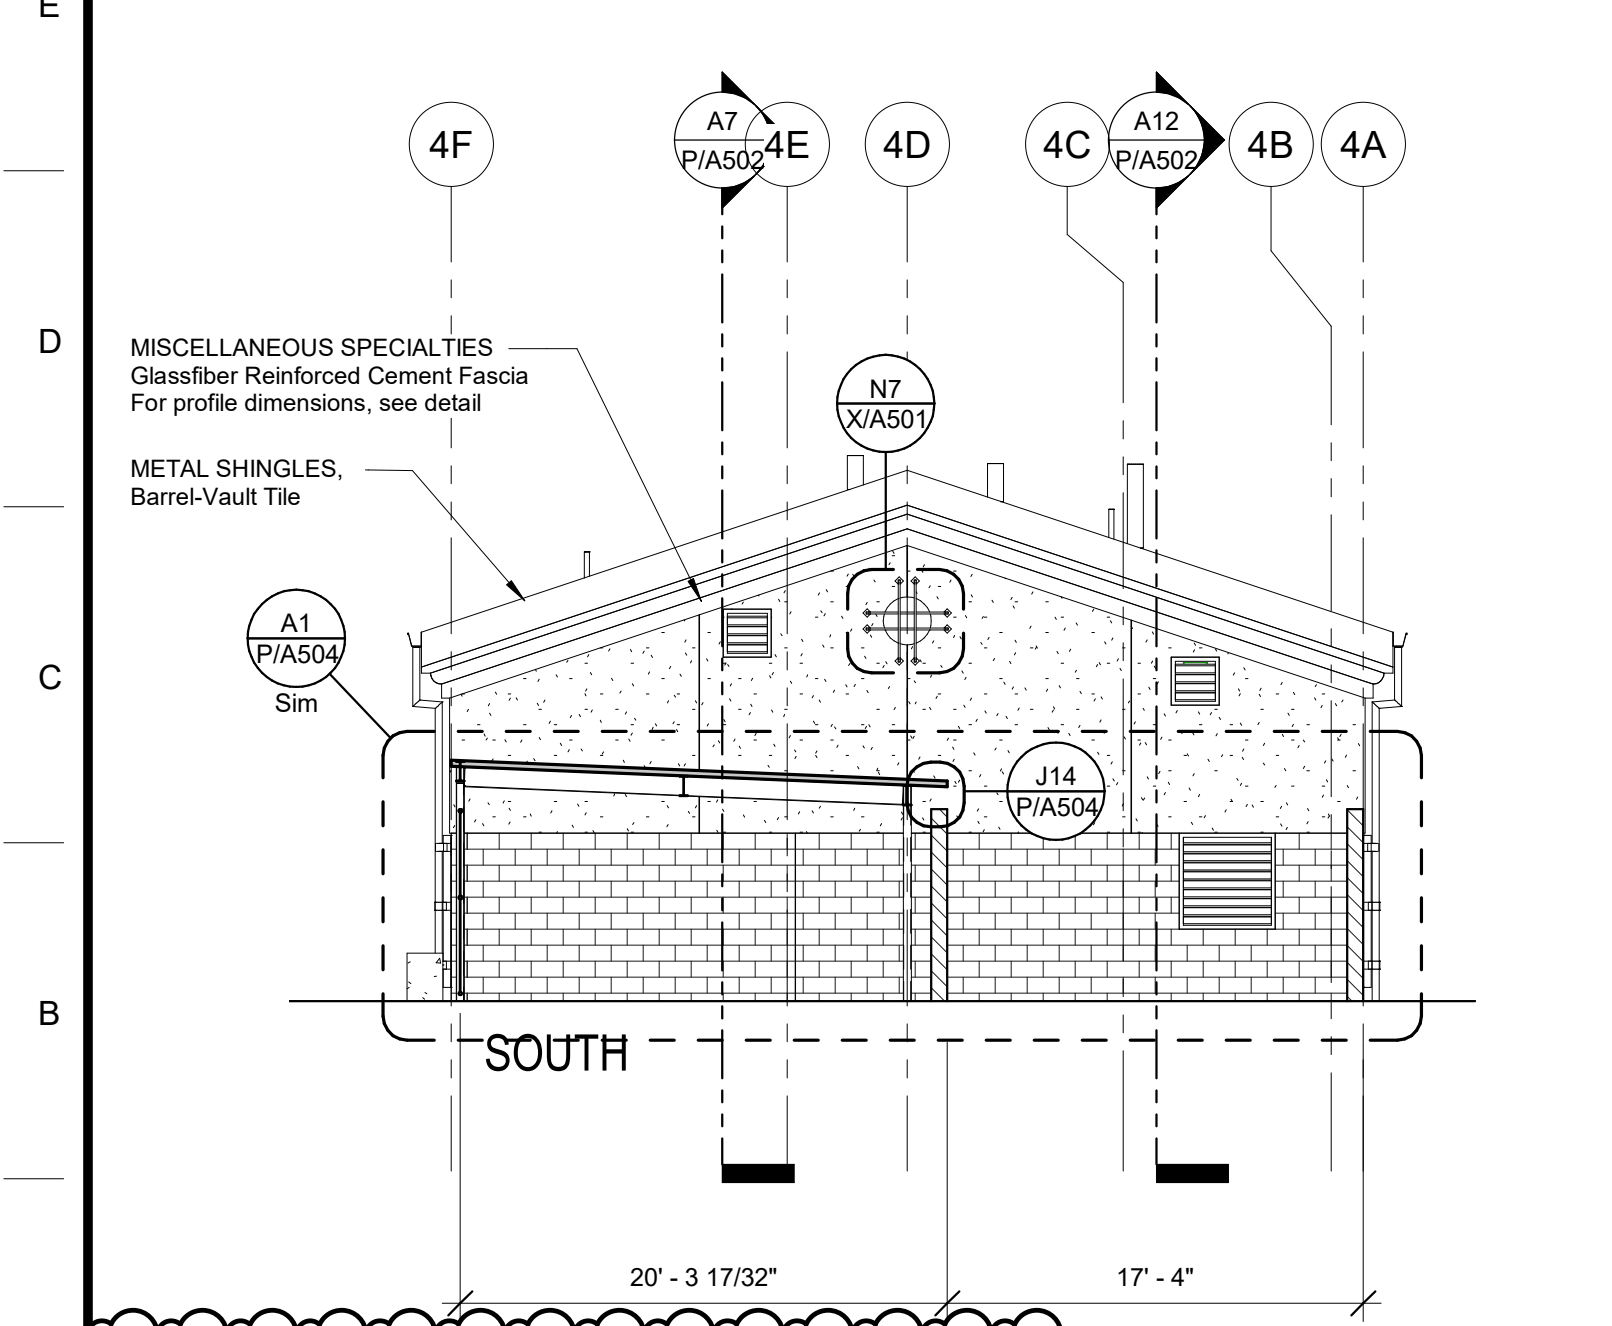


A1 Exterior Elevations
1/8" = 1'-0"

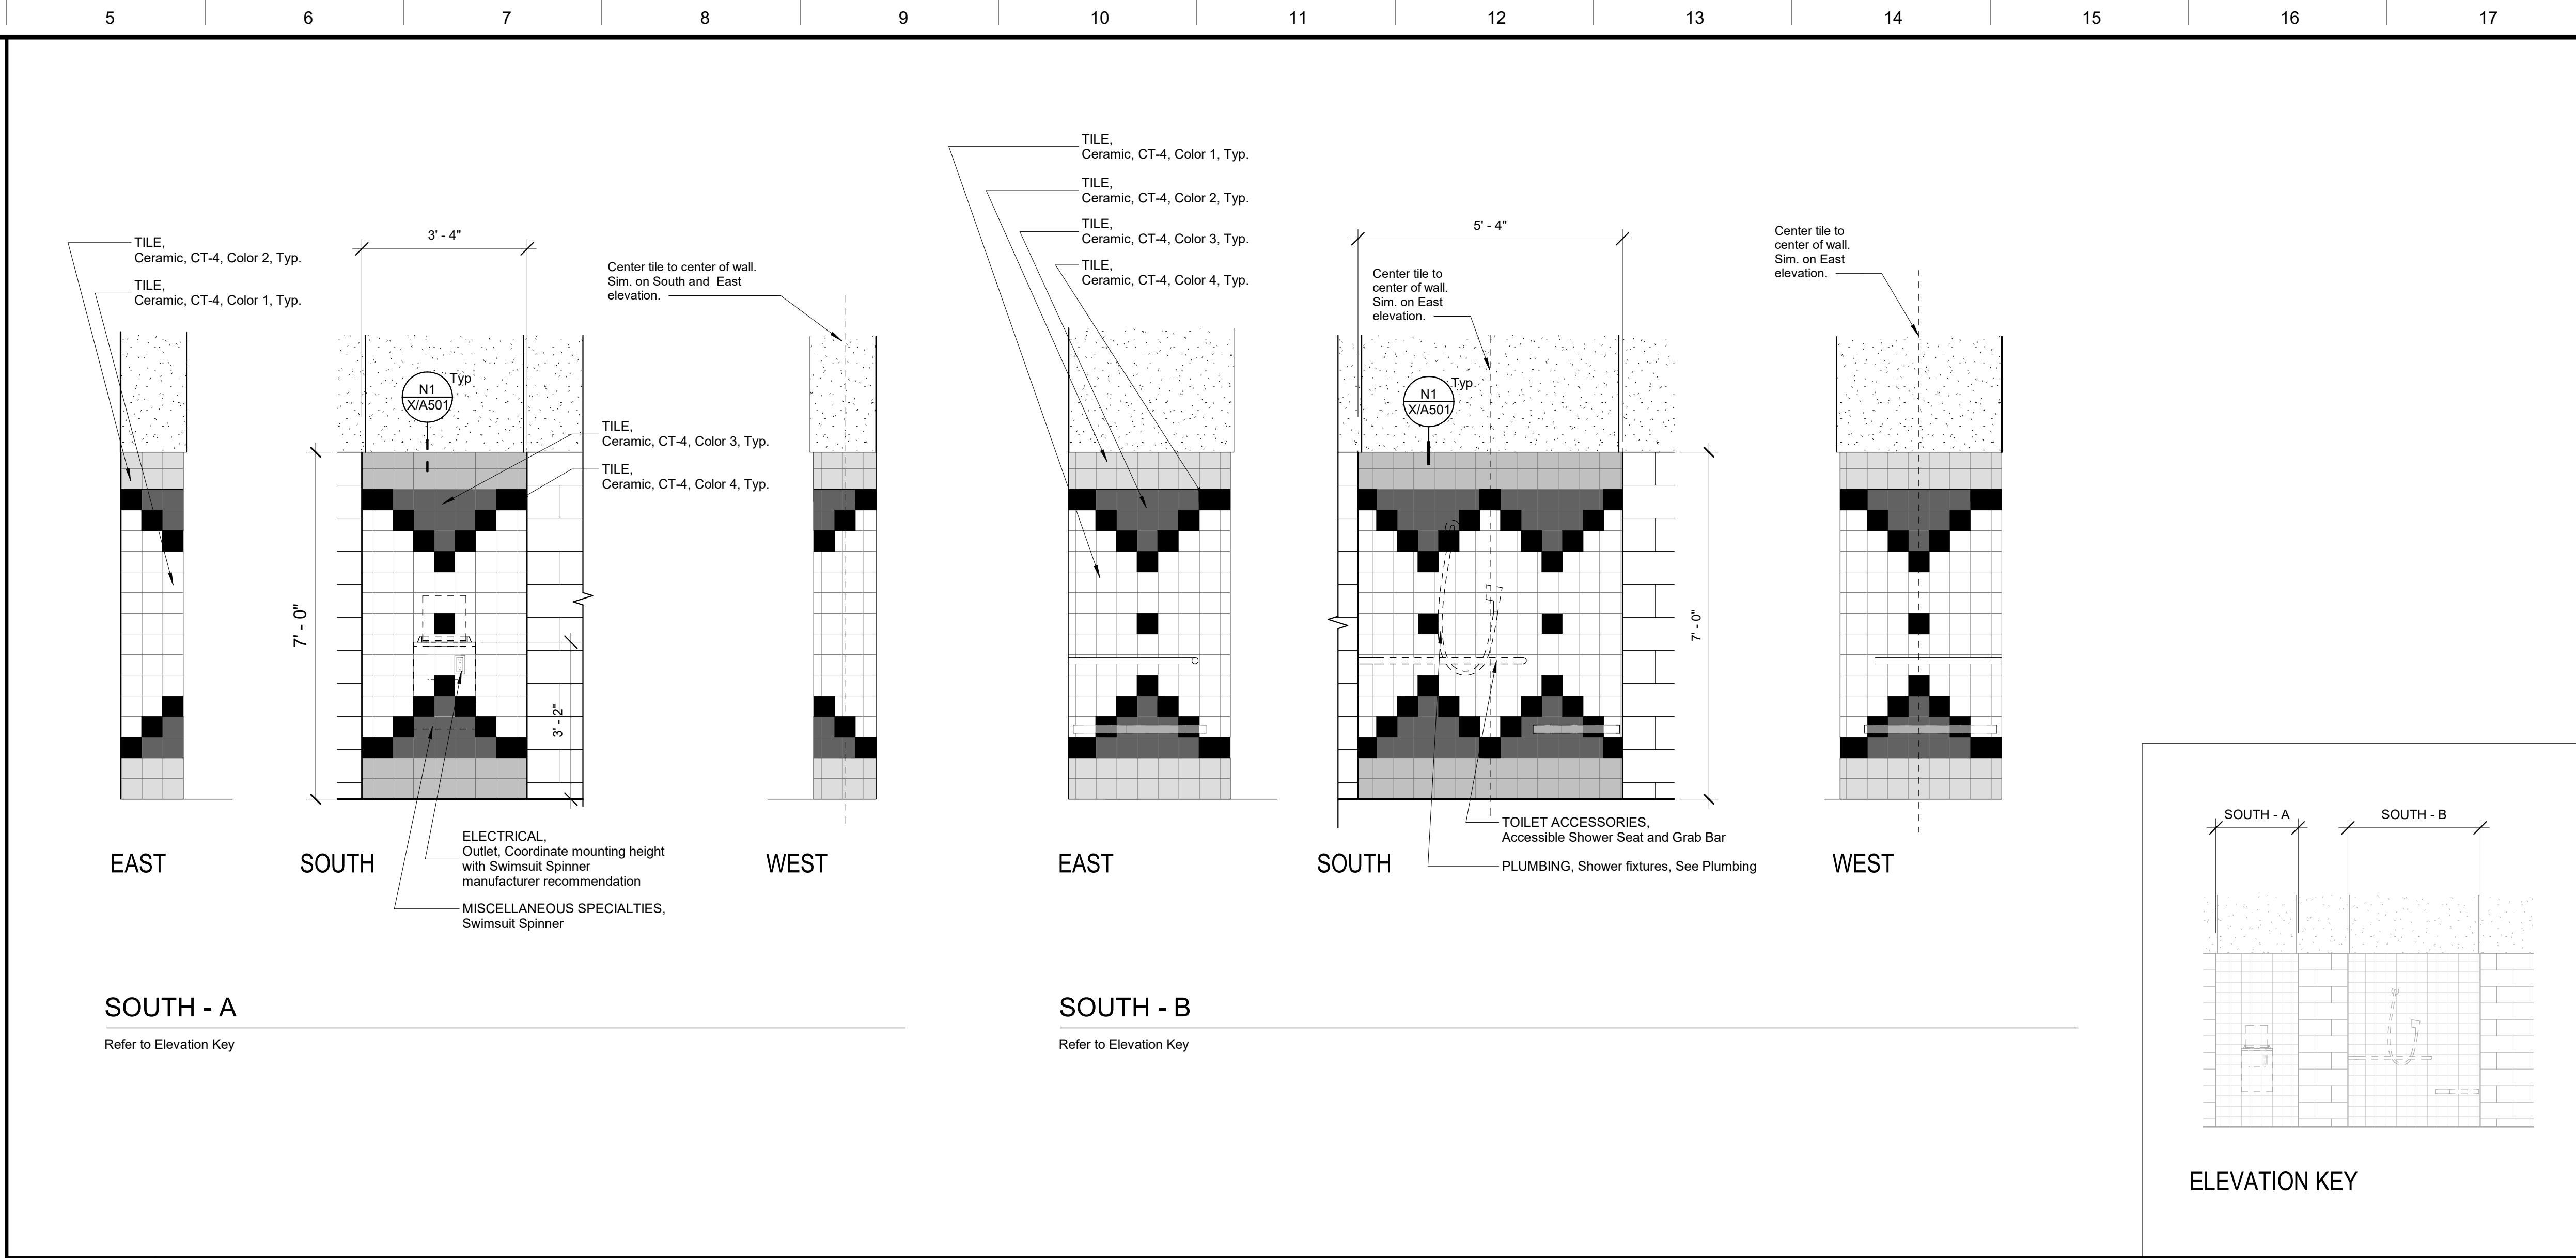

J5 Exterior Elevations - Building P3
1/2" = 1'-0"

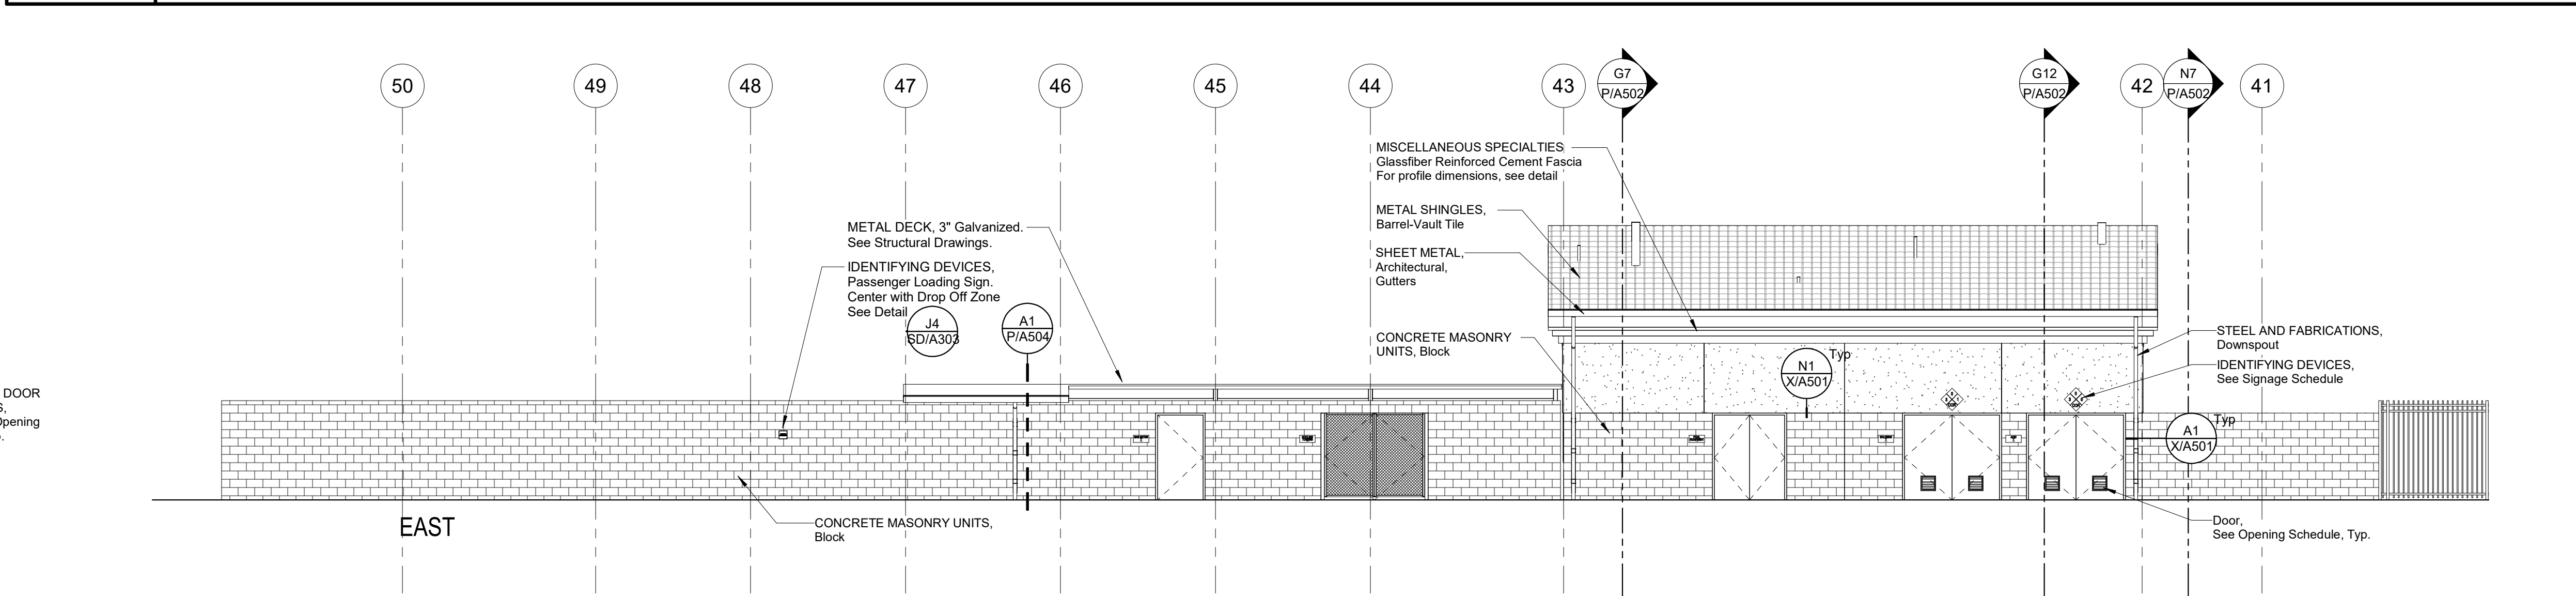

J5 Exterior Elevations - Building P3
1/2" = 1'-0"

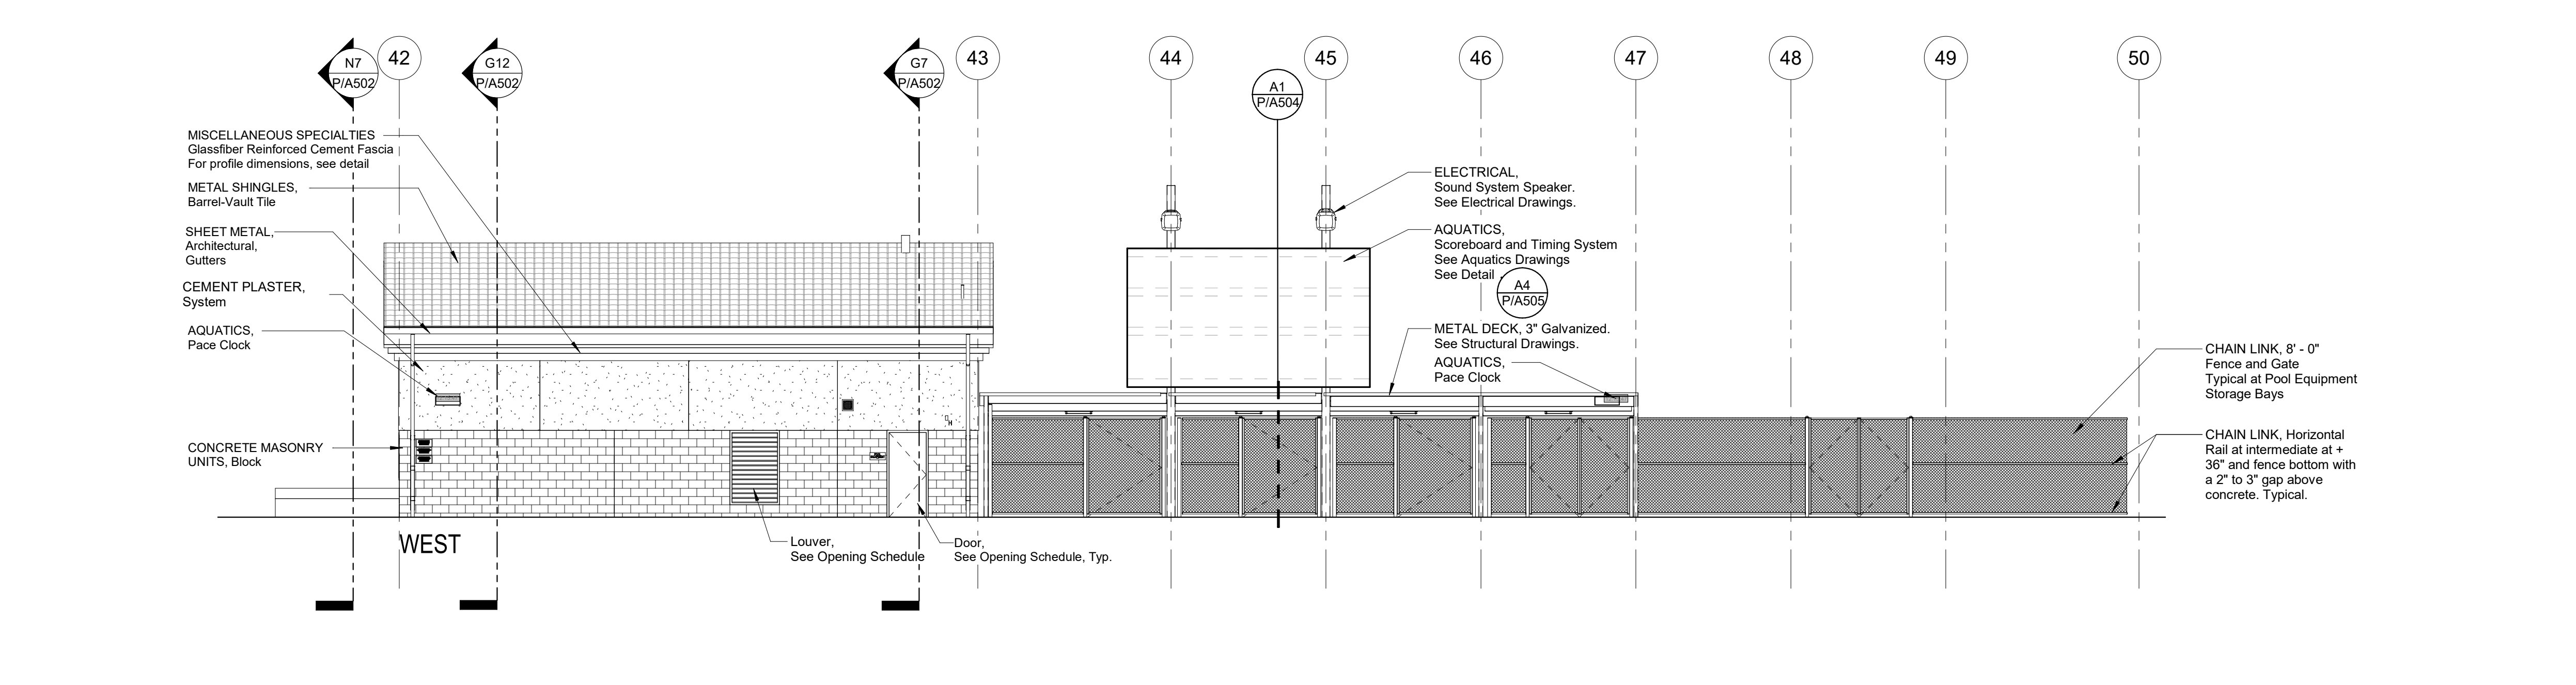

J5 Exterior Elevations - Building P3
1/2" = 1'-0"

DSA File No.: 54-H11
 DSA Application No.: 02-120251
 Agency Approval

EXTERIOR COLOR LEGEND

Plaster Colors
 PC-1 White Unless Noted Otherwise

Block Colors
 BC-1 Natural Unless Noted Otherwise
 All Ground Block to be BC-1, UNO.

Metal Colors
 MC-1 White Unless Noted Otherwise

Door Colors
 All Doors to match adjacent Frame & Wall, UNO.

Tile Colors
 CT-4
 Color 1 - White Unless Noted Otherwise
 Color 2 - Grey
 Color 3 - Gold
 Color 4 - Orange Red

Color Notes

- XX-X Color Designation.
- Parapet caps to match color of wall below, UNO.
- Soffits to match color of outer face wall, UNO.
- Horizontal soffits adjacent to fascia board shall be PC-1.

SYMBOLS

Electrical symbols: Horn, Speaker, Outlet, Light Fixture, PA Speaker, Glass.

ABBREVIATIONS

AFF Above Finished Floor
 BO Bottom of Control Joint
 CJ Control Joint
 DS Downspout
 EJ Expansion Joint
 HB PLUMBING, Hose Bibb.
 OH Opposite Hand
 Sim. Similar
 TO Top of Masonry
 TOM Top of Masonry
 TOP Top of Parapet Framing
 TOE Top of Framing
 TOR Top of Roof
 TOS Top of Steel
 TPL Top of Plate
 Typ. Typical
 UNO Unless Noted Otherwise

NOTES

- CEMENT PLASTER, Cement Plaster System, Accessories, Refer to Detail A14/XA501
- STEEL & FABRICATION, Downspout, Refer to Detail A1/XA501
- Refer to Specifications Section Appendix "C" Exterior Color Schedule.
- Refer to Exterior Finish Schedule on A1 / XIA201
- Refer to Structural for Curved Soffit Framing

E18 Exterior Elevations Legend
No Scale

Mission Oak HS Aquatic Complex
 Tulare Joint Union High School District
 Tulare, CA 93274
 Project

BUILDING P3, P4
 EXTERIOR ELEVATIONS - P3 - P4
 Drawing

ARCHITECTURE
 DARDEN PLANNING INTERIORS
 www.dardenarchitects.com
 6790 N. West Ave. • Fresno, CA 93711 • T. 559.448.8051
 Architect



No.	Revision/Submission	Date
1	REVISION_01	05/31/2023

Designed By: MF
 Copyright 2022 Darden Architects
 Scale: As indicated
 Drawn By: FM
 Project Number: 2180
 Checked By: -
 Date: 03/28/2023
 Reviewed By: MF

P/A402



8/18/2023 4:27:16 PM e:\Users\alwin\Documents\0180 Mission Oak HS Aquatic Complex_R001_VZ2_A\WinV.nt

R
Q
P
N
M
L
K
J
H
G
F
E
D
C
B
A

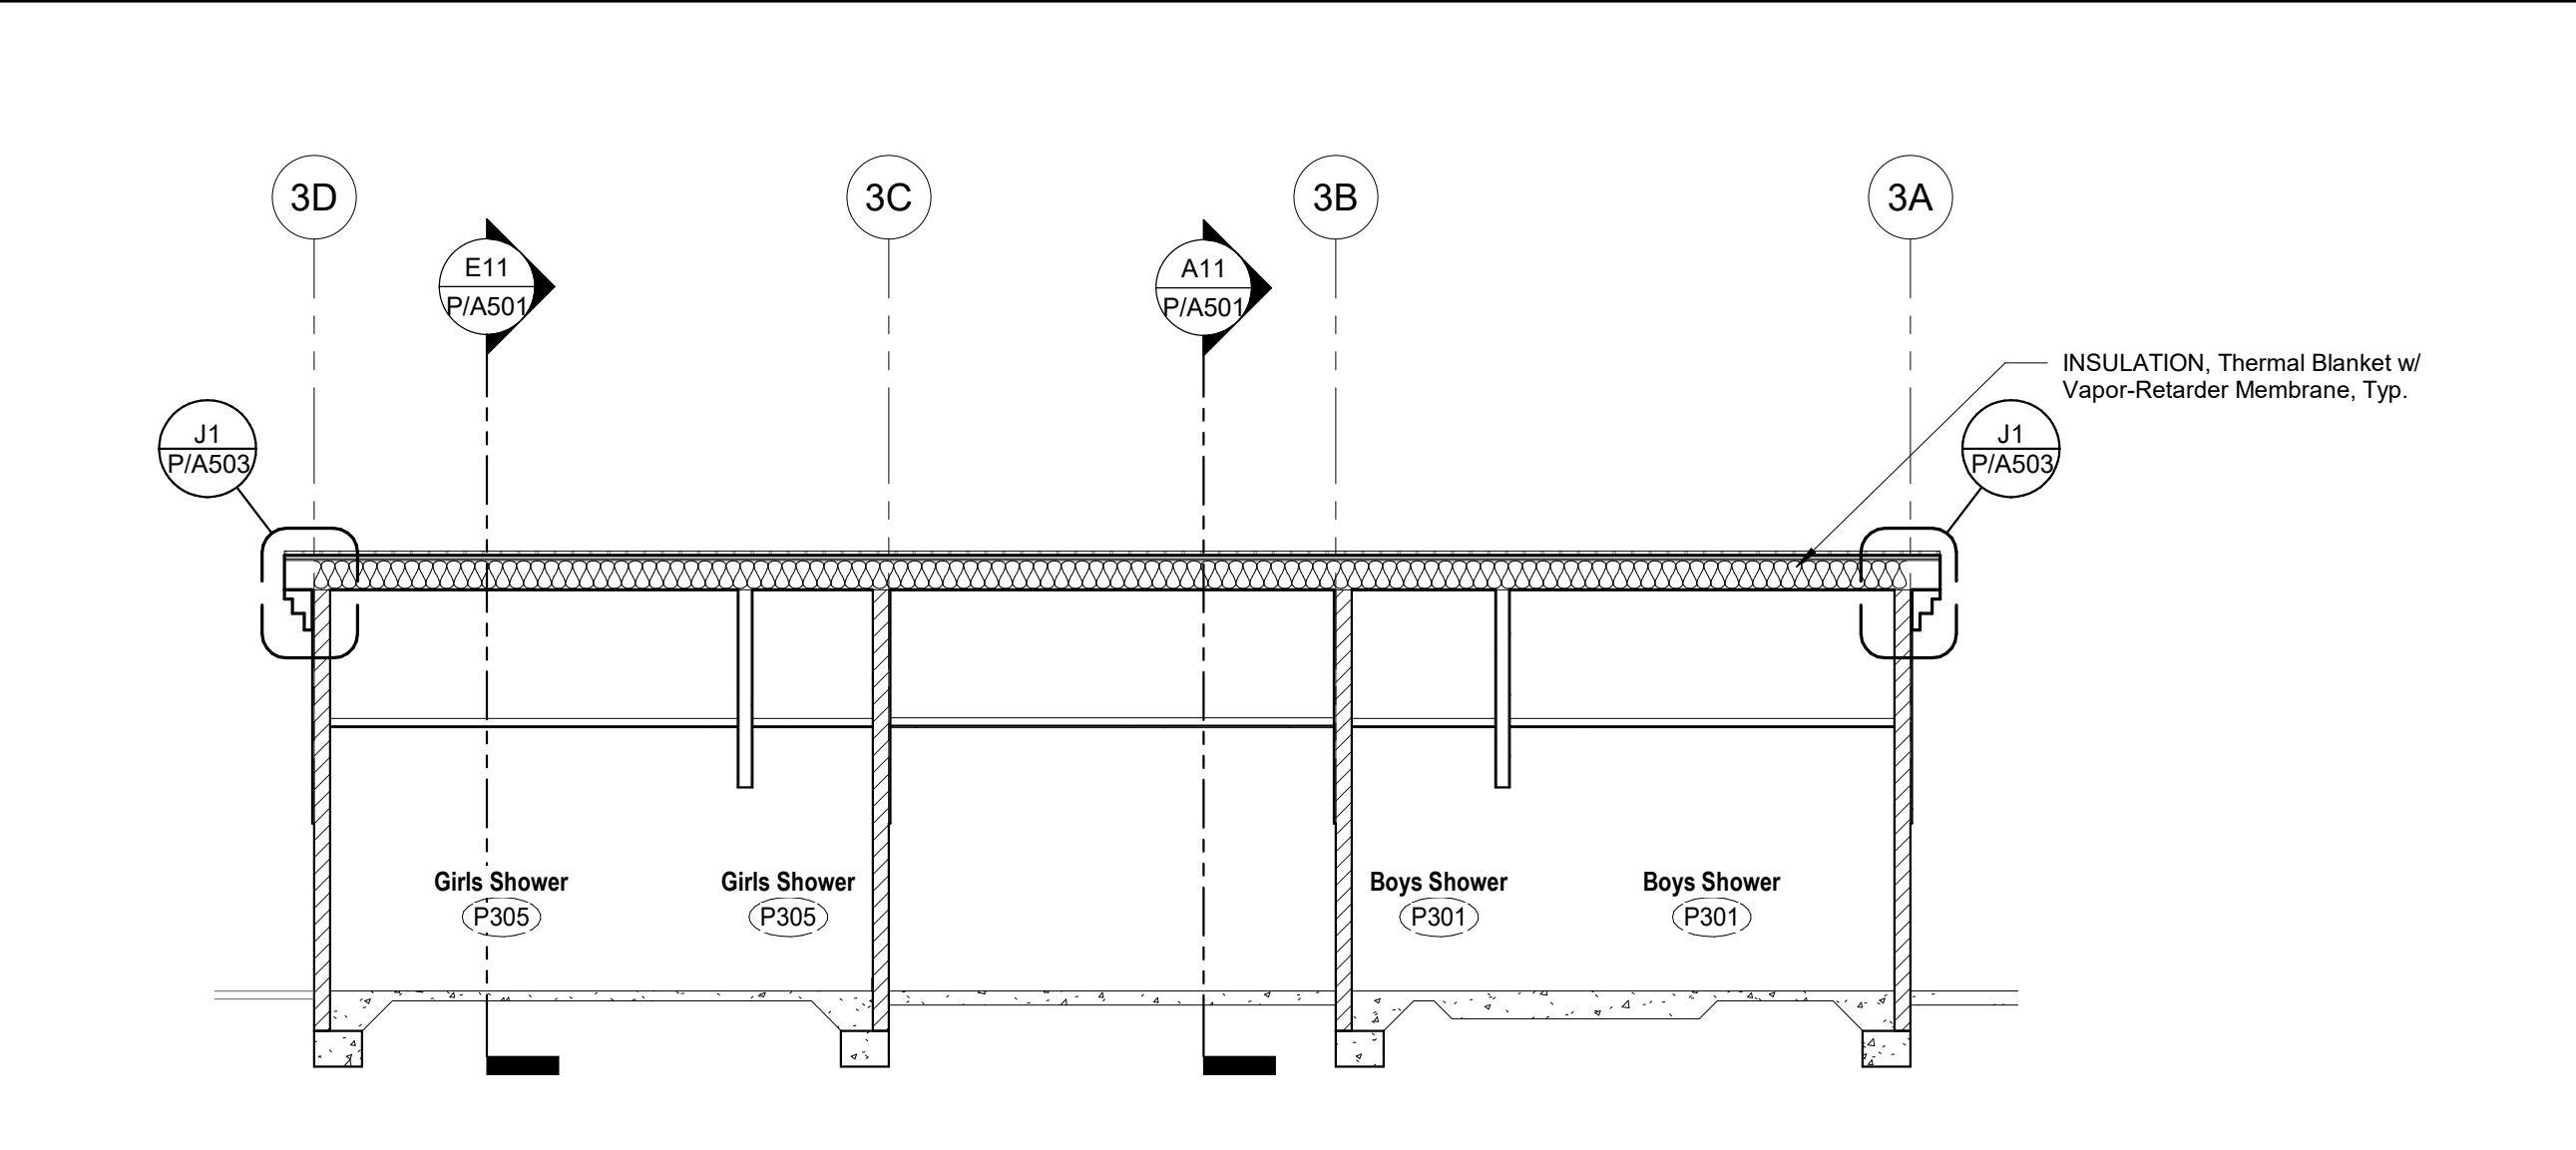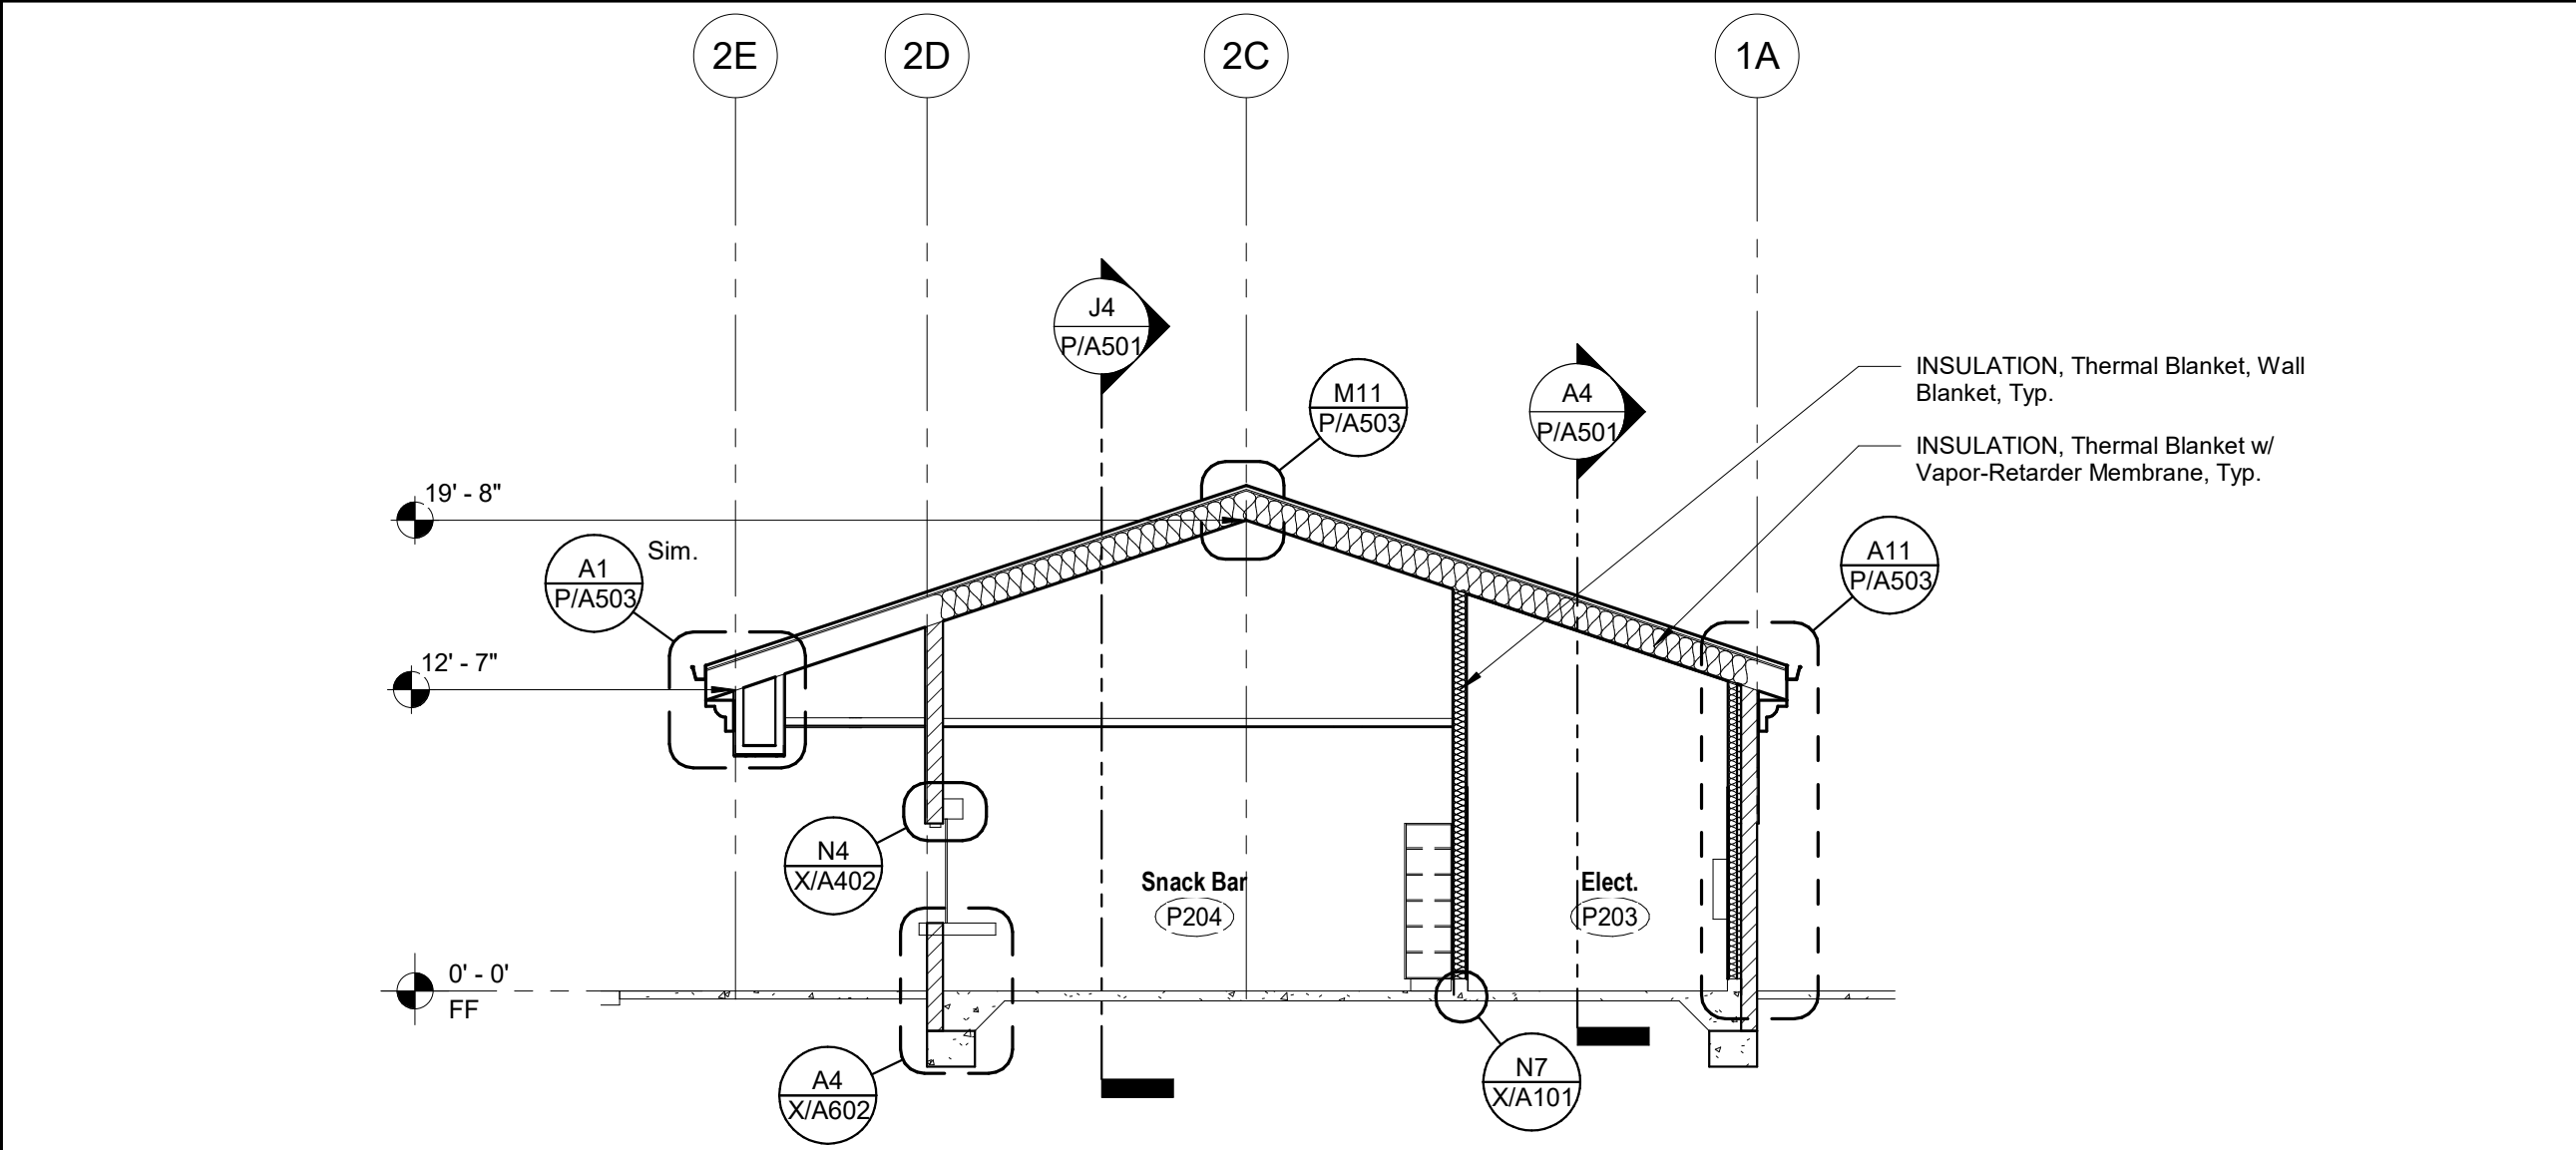




N4 ADD ALTERNATE Building Section - P2
1/8" = 1'-0"

N11 Building Section - P3
1/8" = 1'-0"

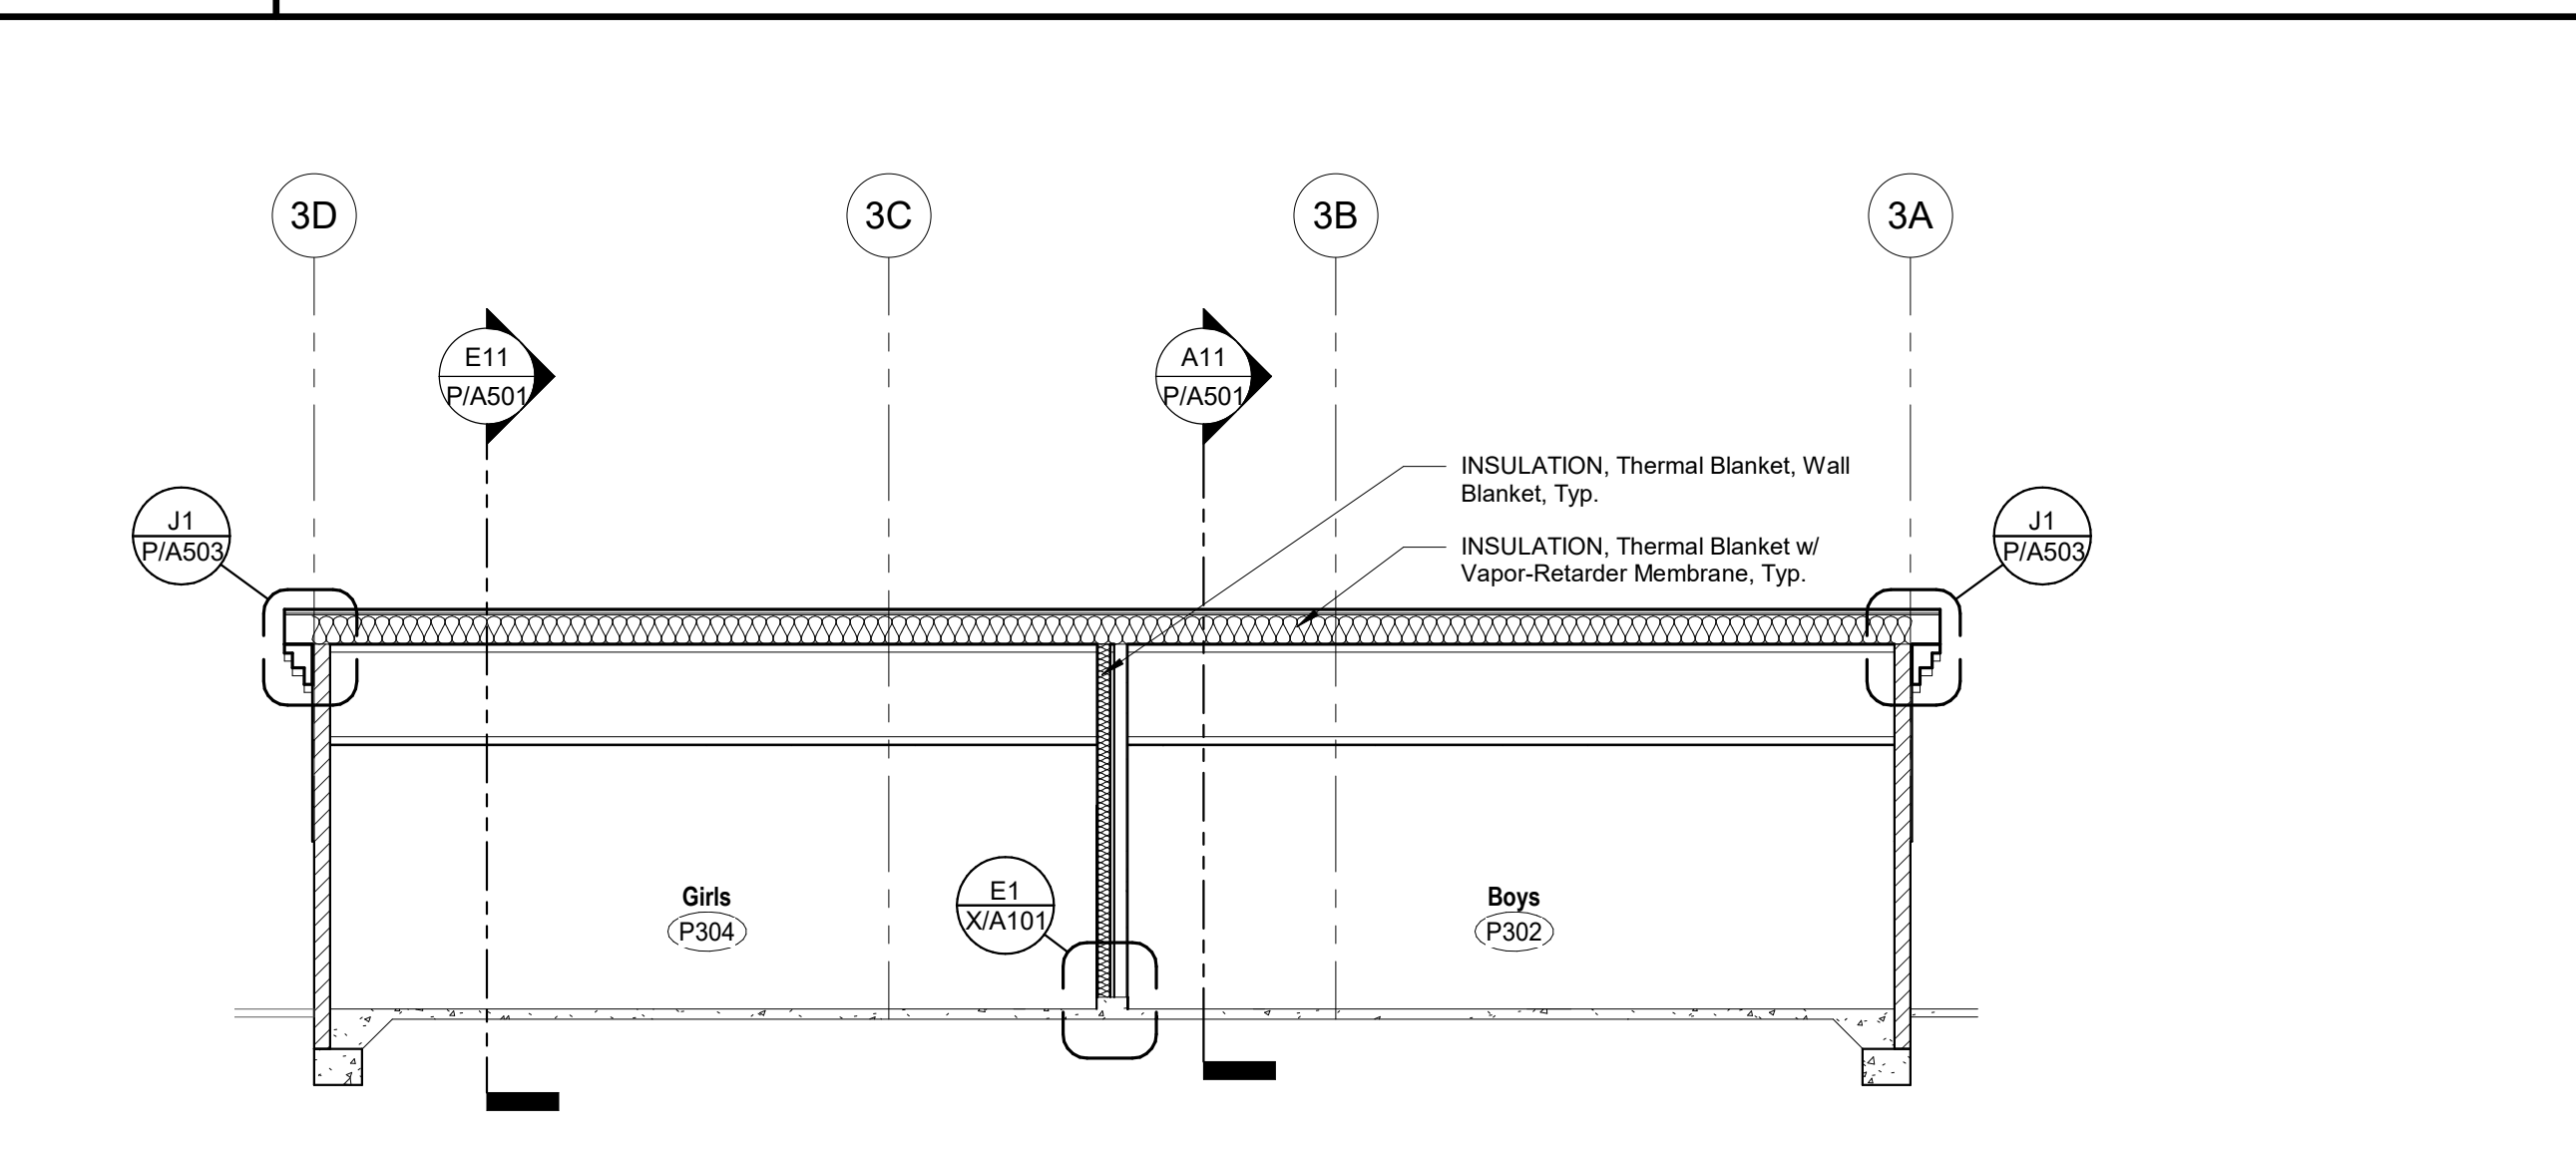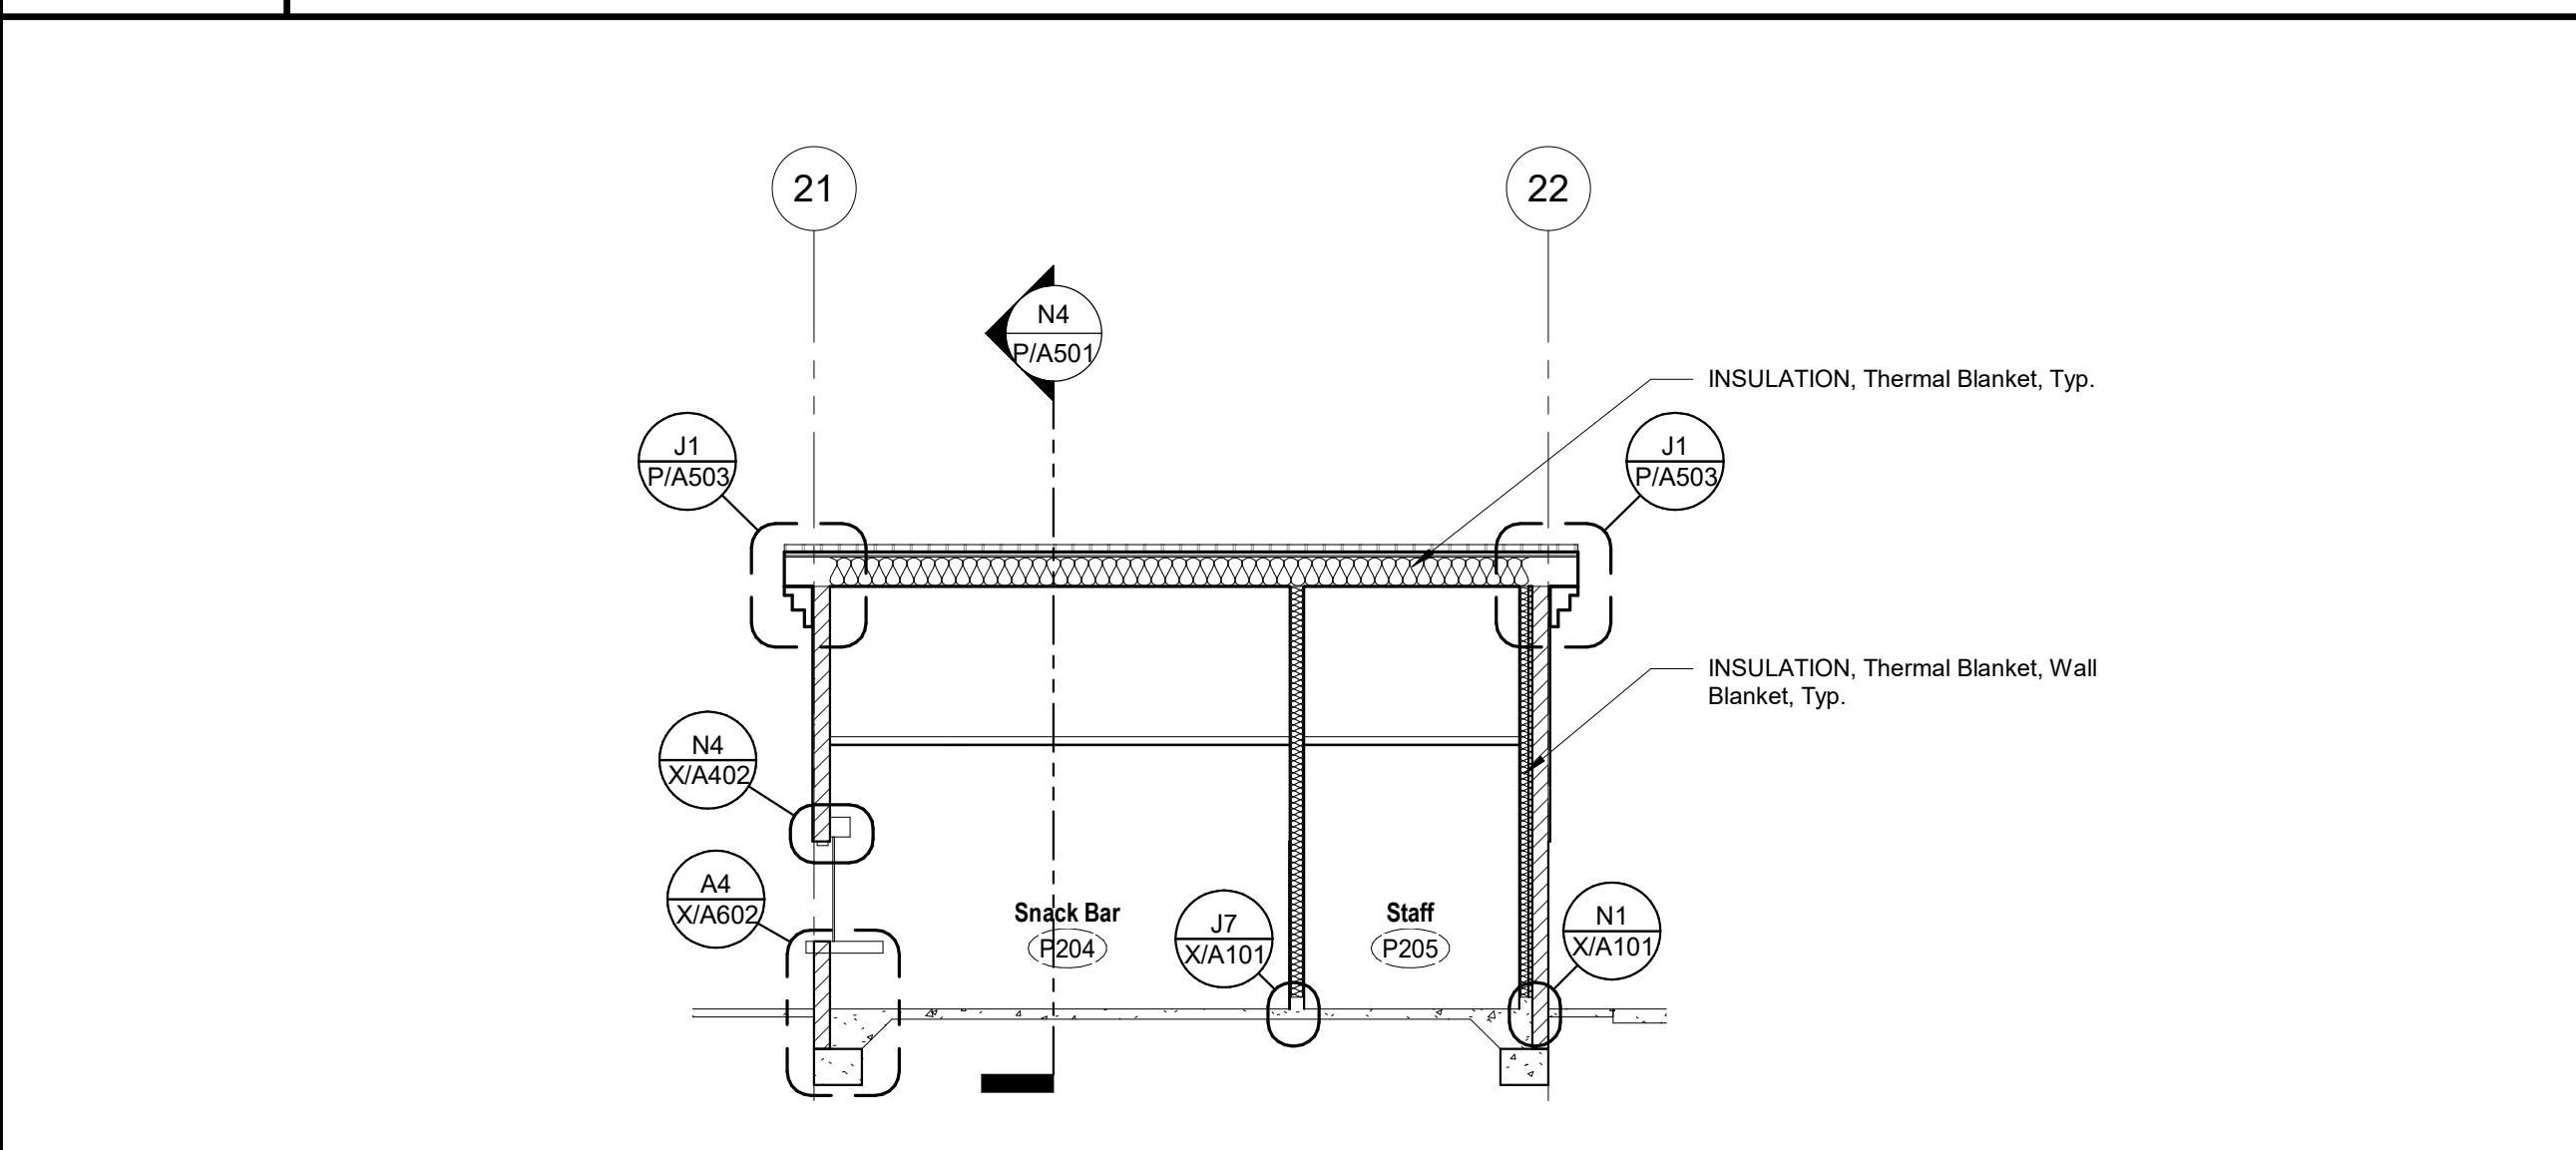

J4 ADD ALTERNATE Building Section - P2
1/8" = 1'-0"




J11 Building Section - P3
1/8" = 1'-0"

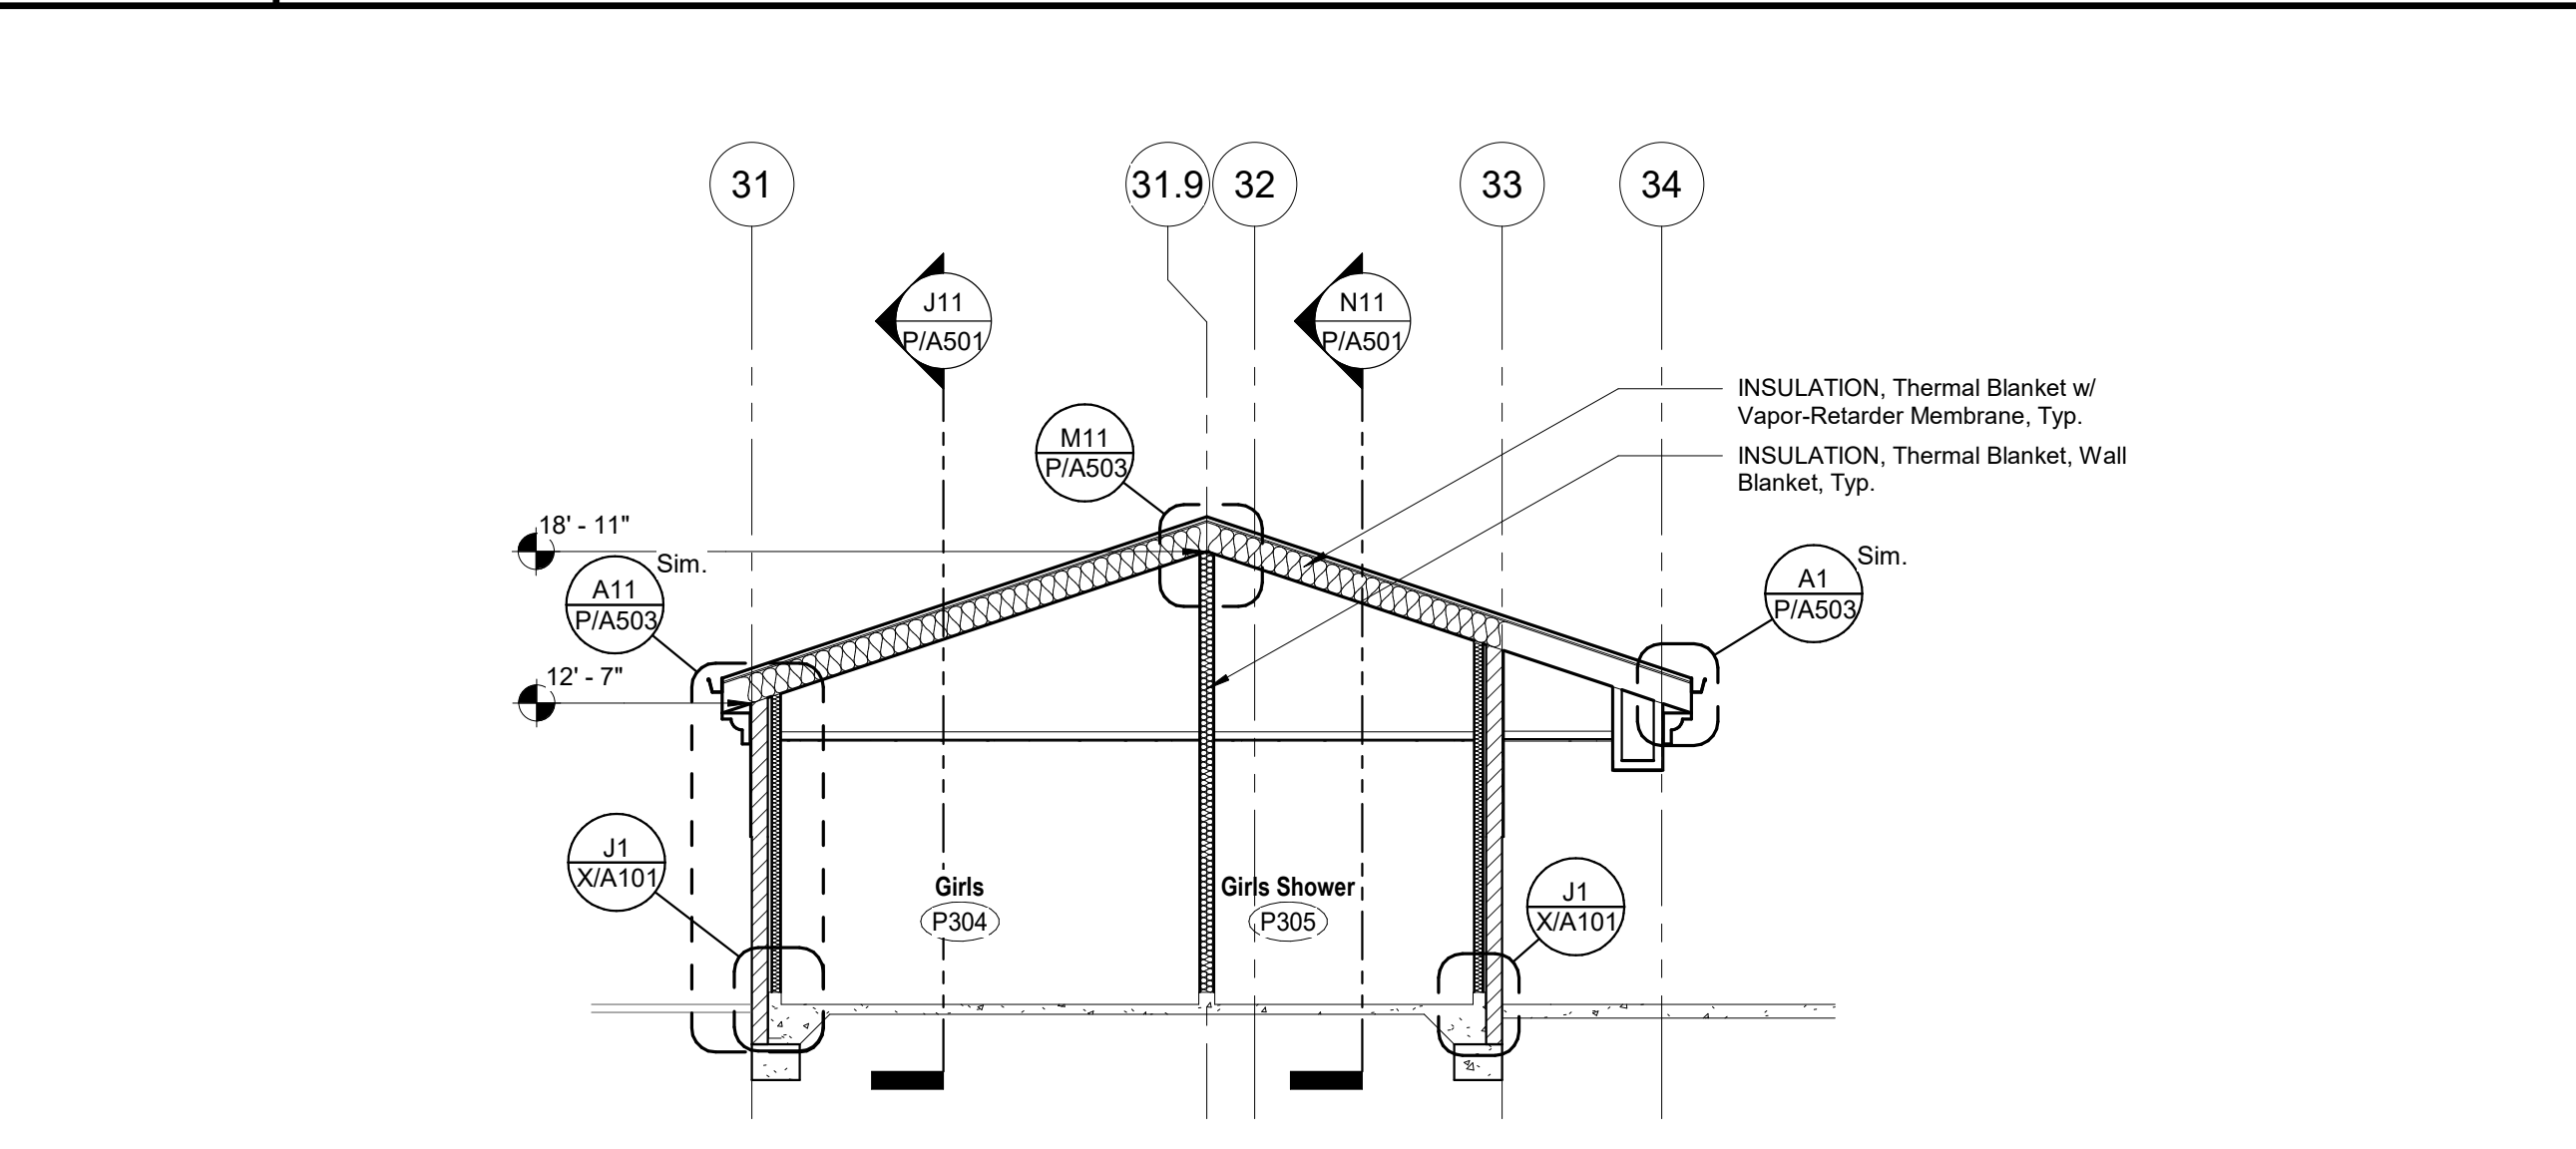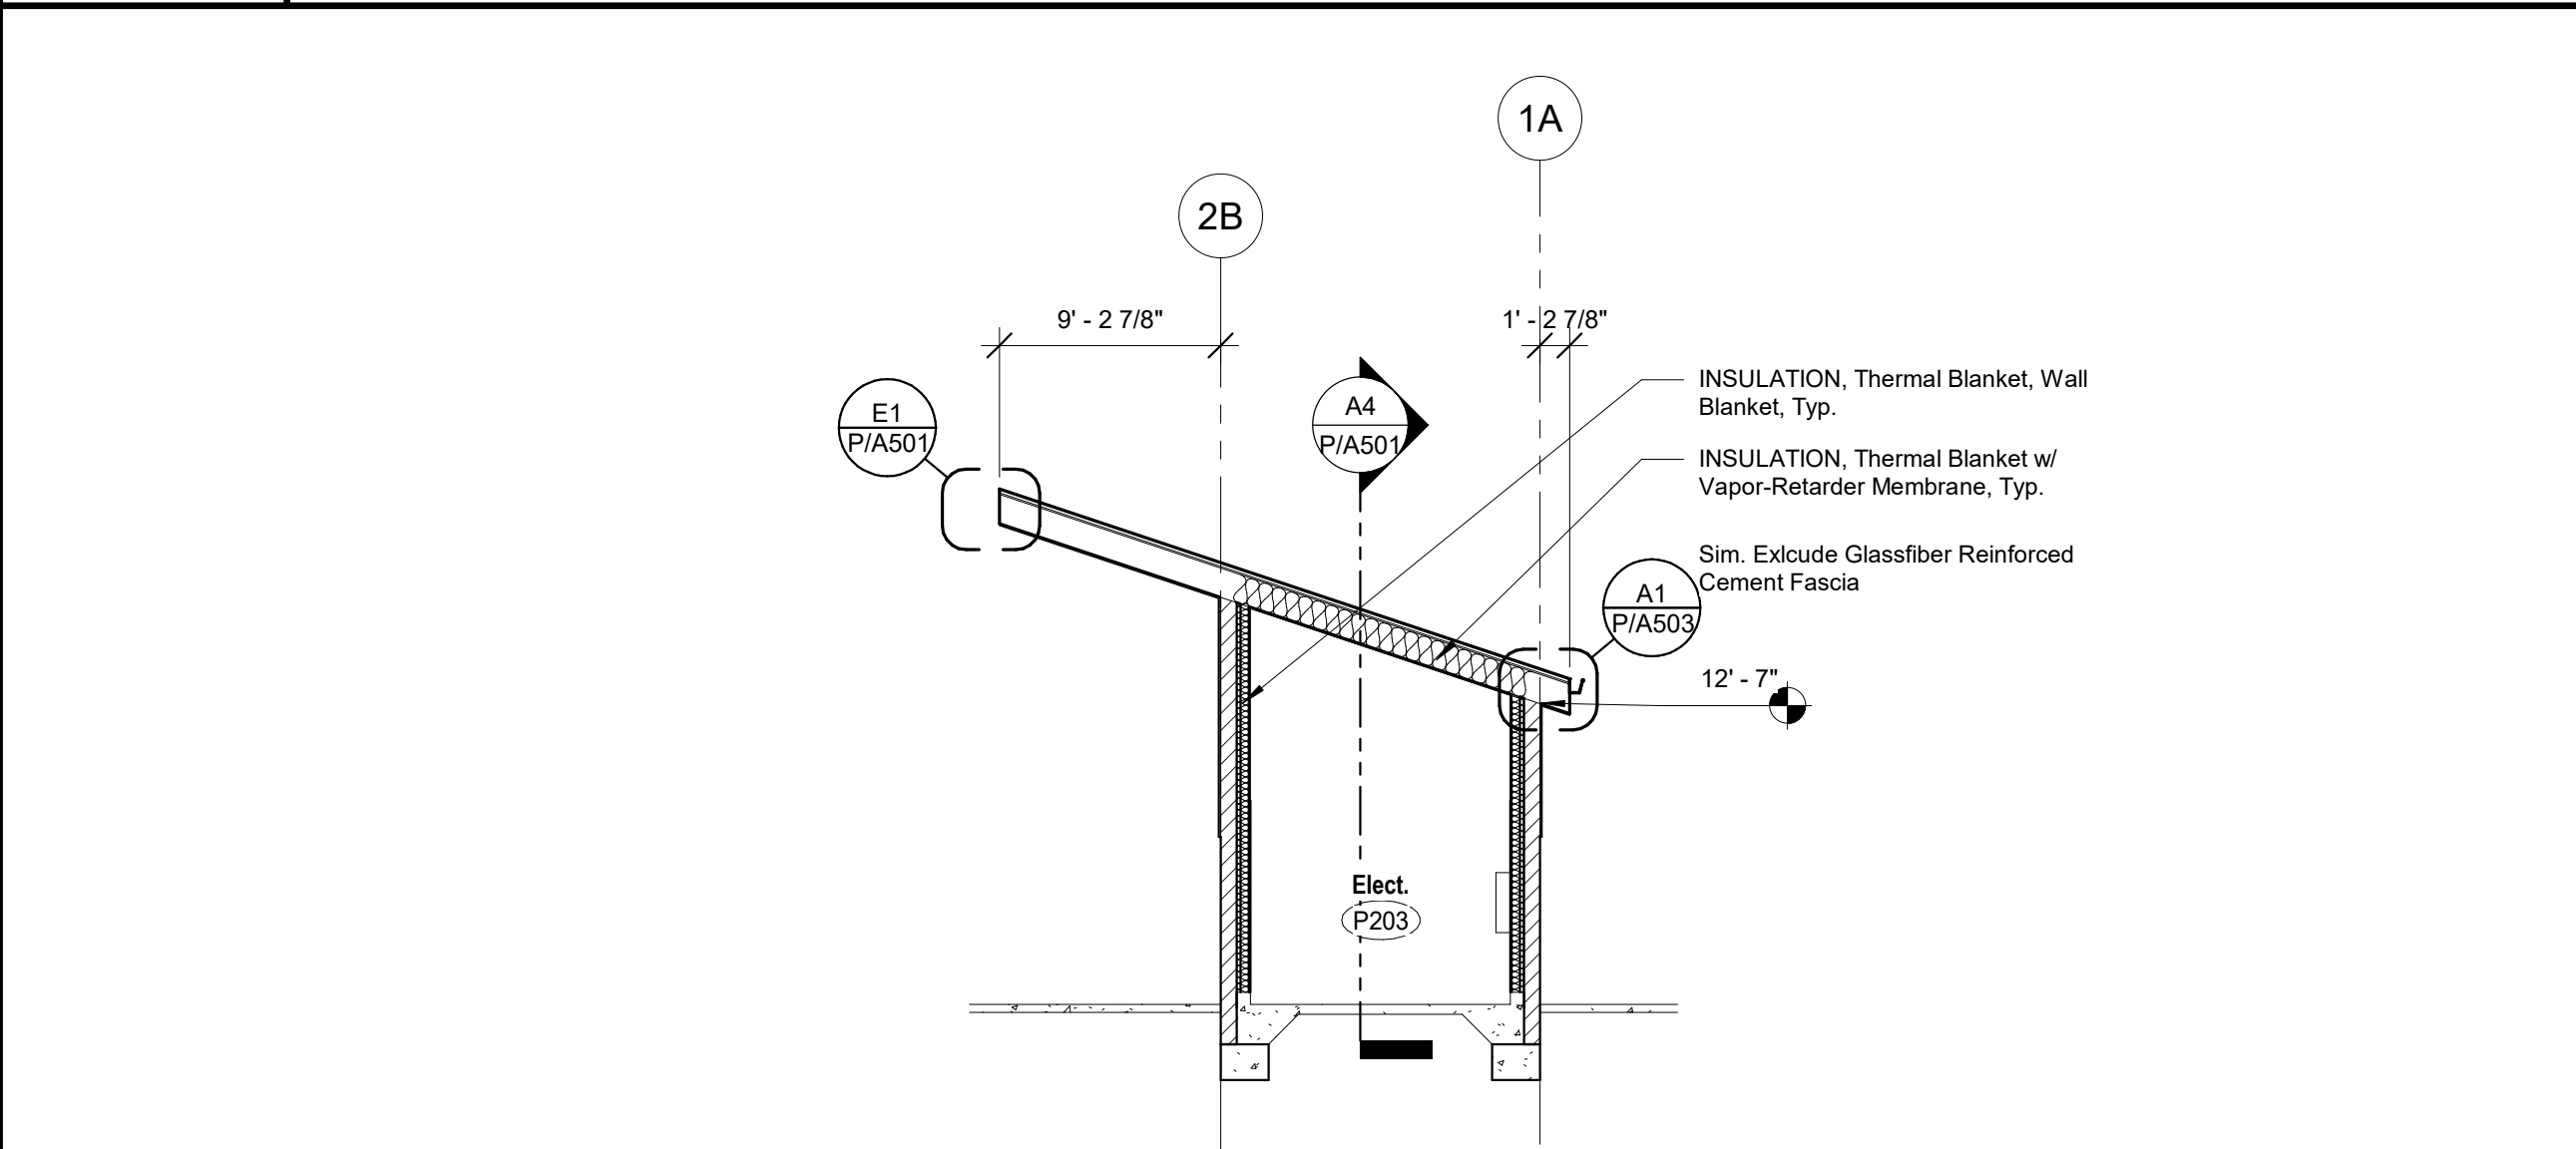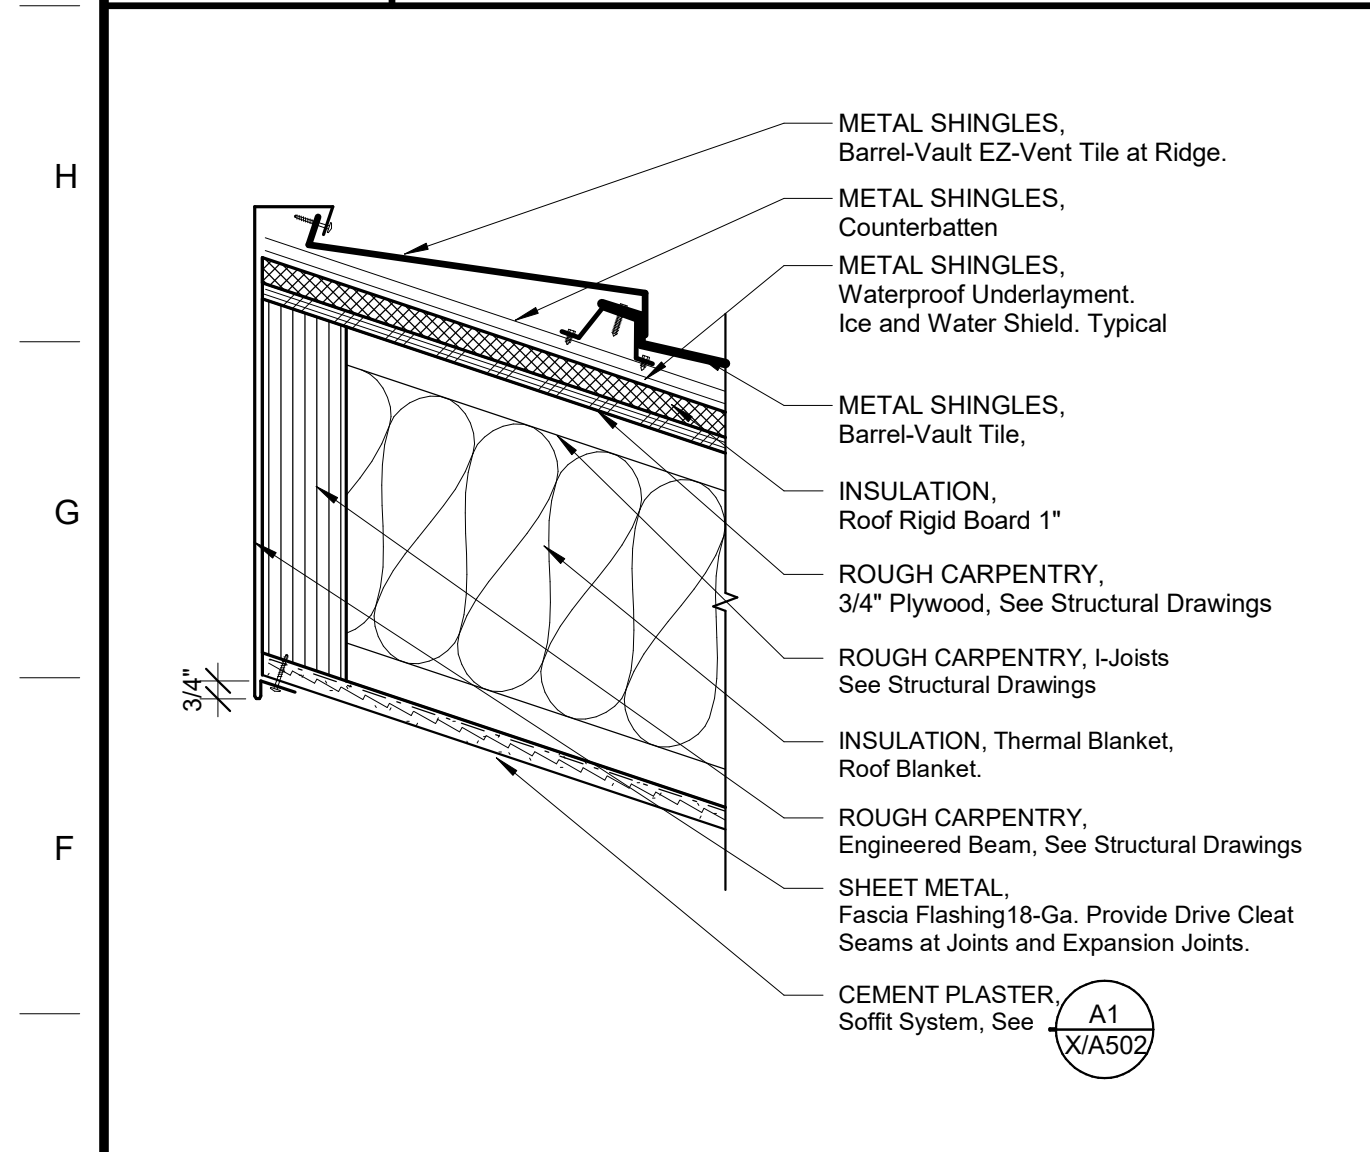

E1 METAL SHINGLES, Ridge Detail
1/12" = 1'-0"

E4 Building Section - P2
1/8" = 1'-0"

E11 Building Section - P3
1/8" = 1'-0"

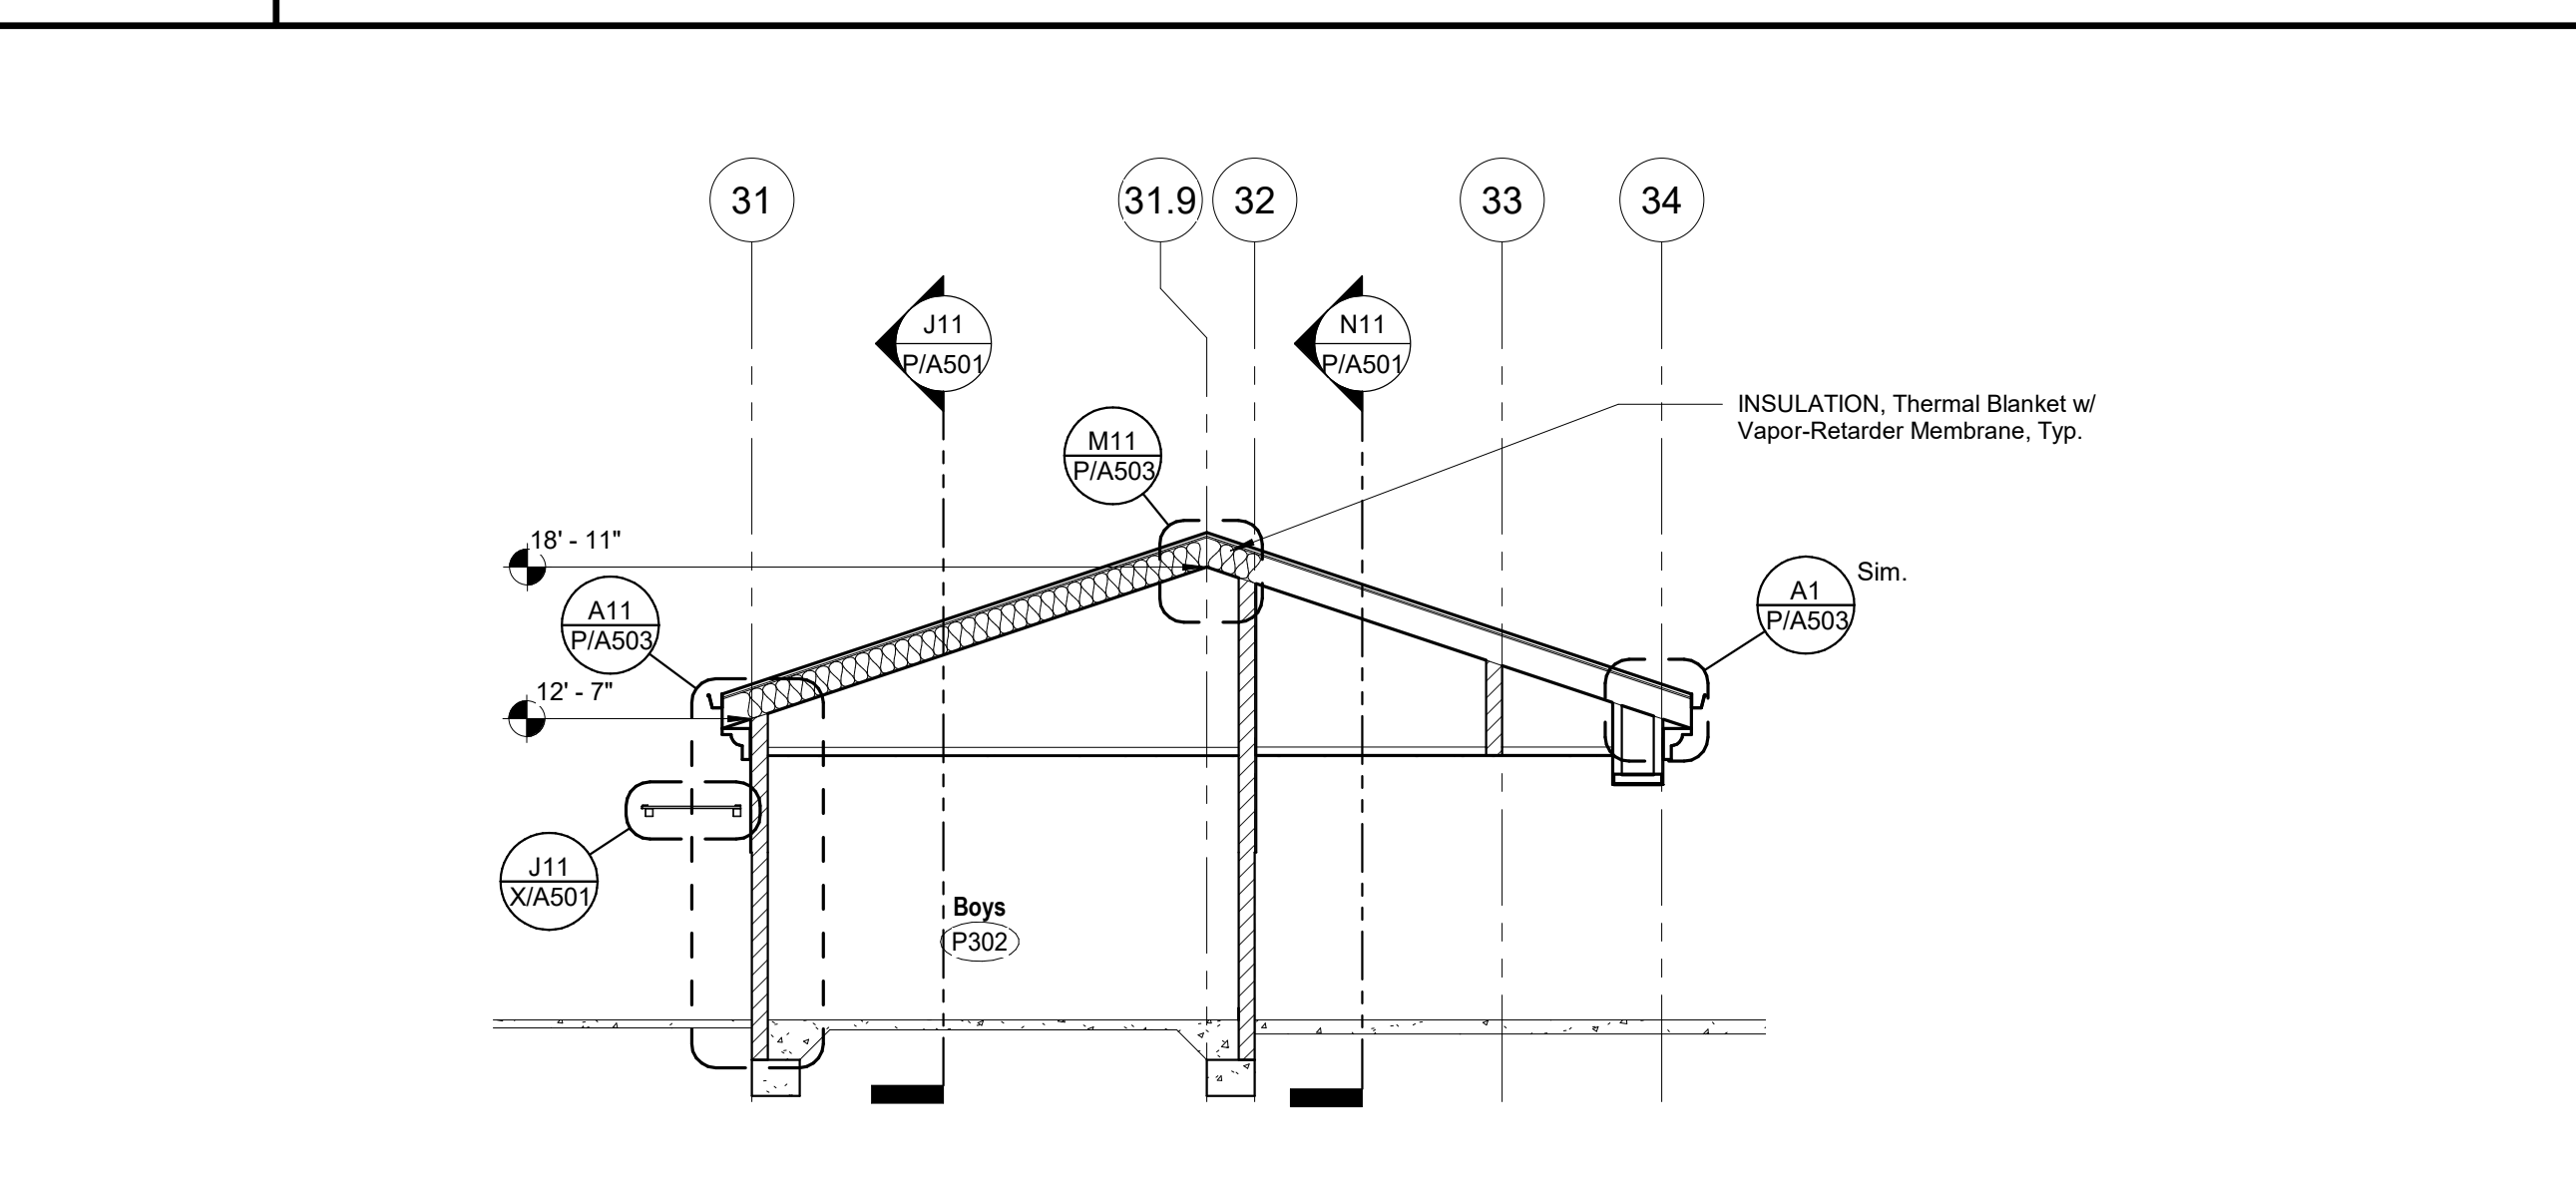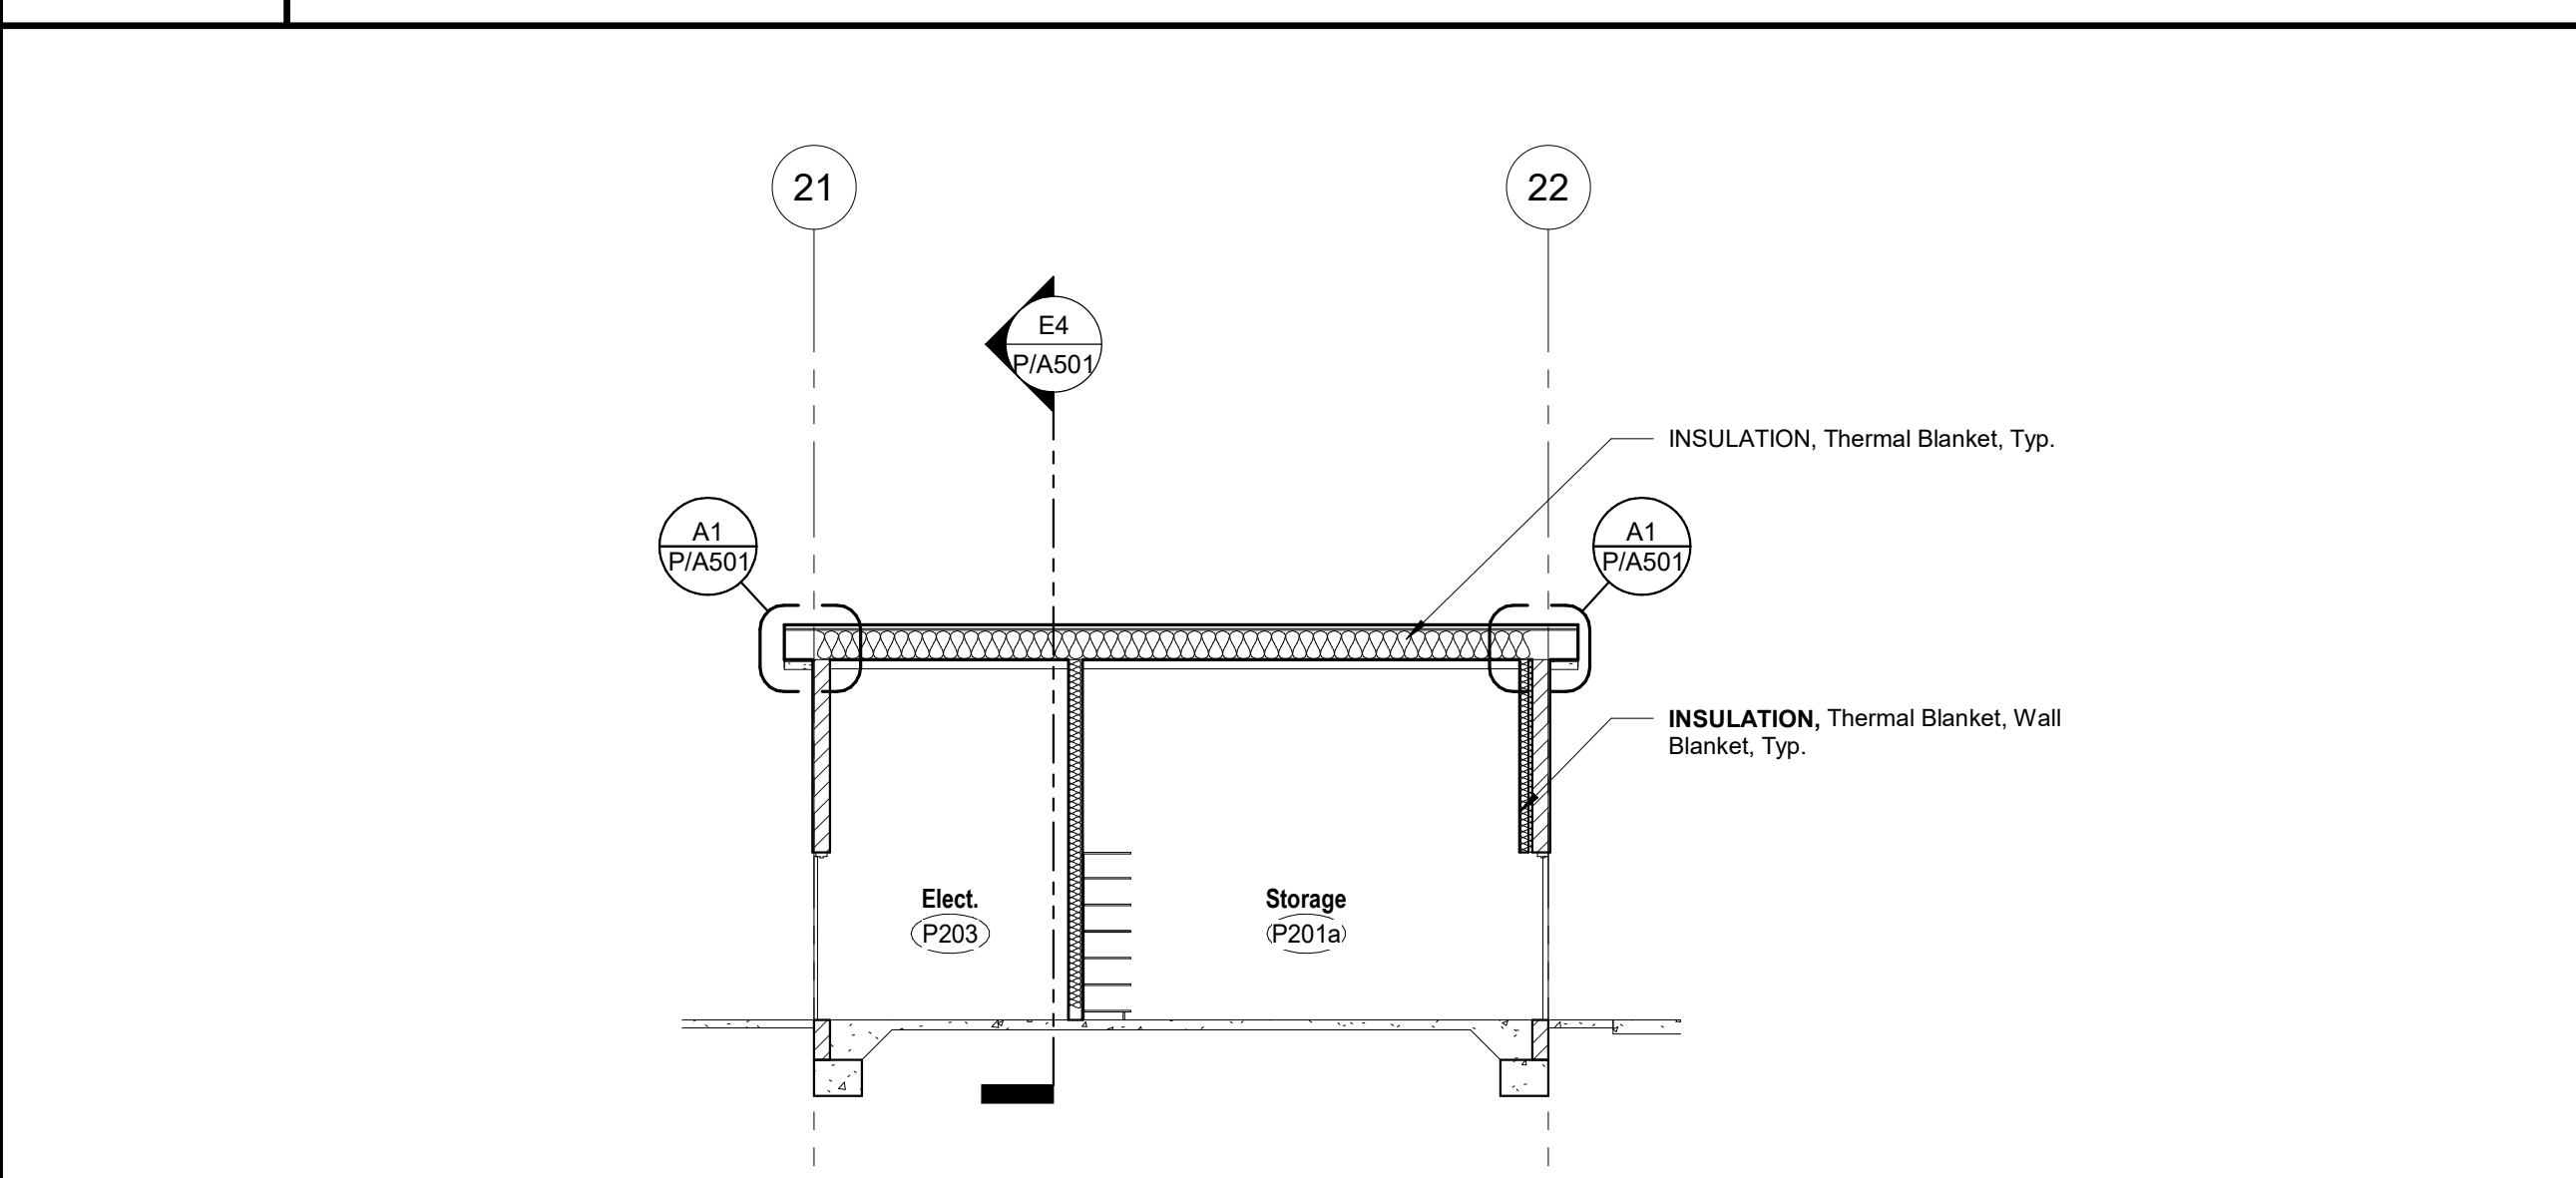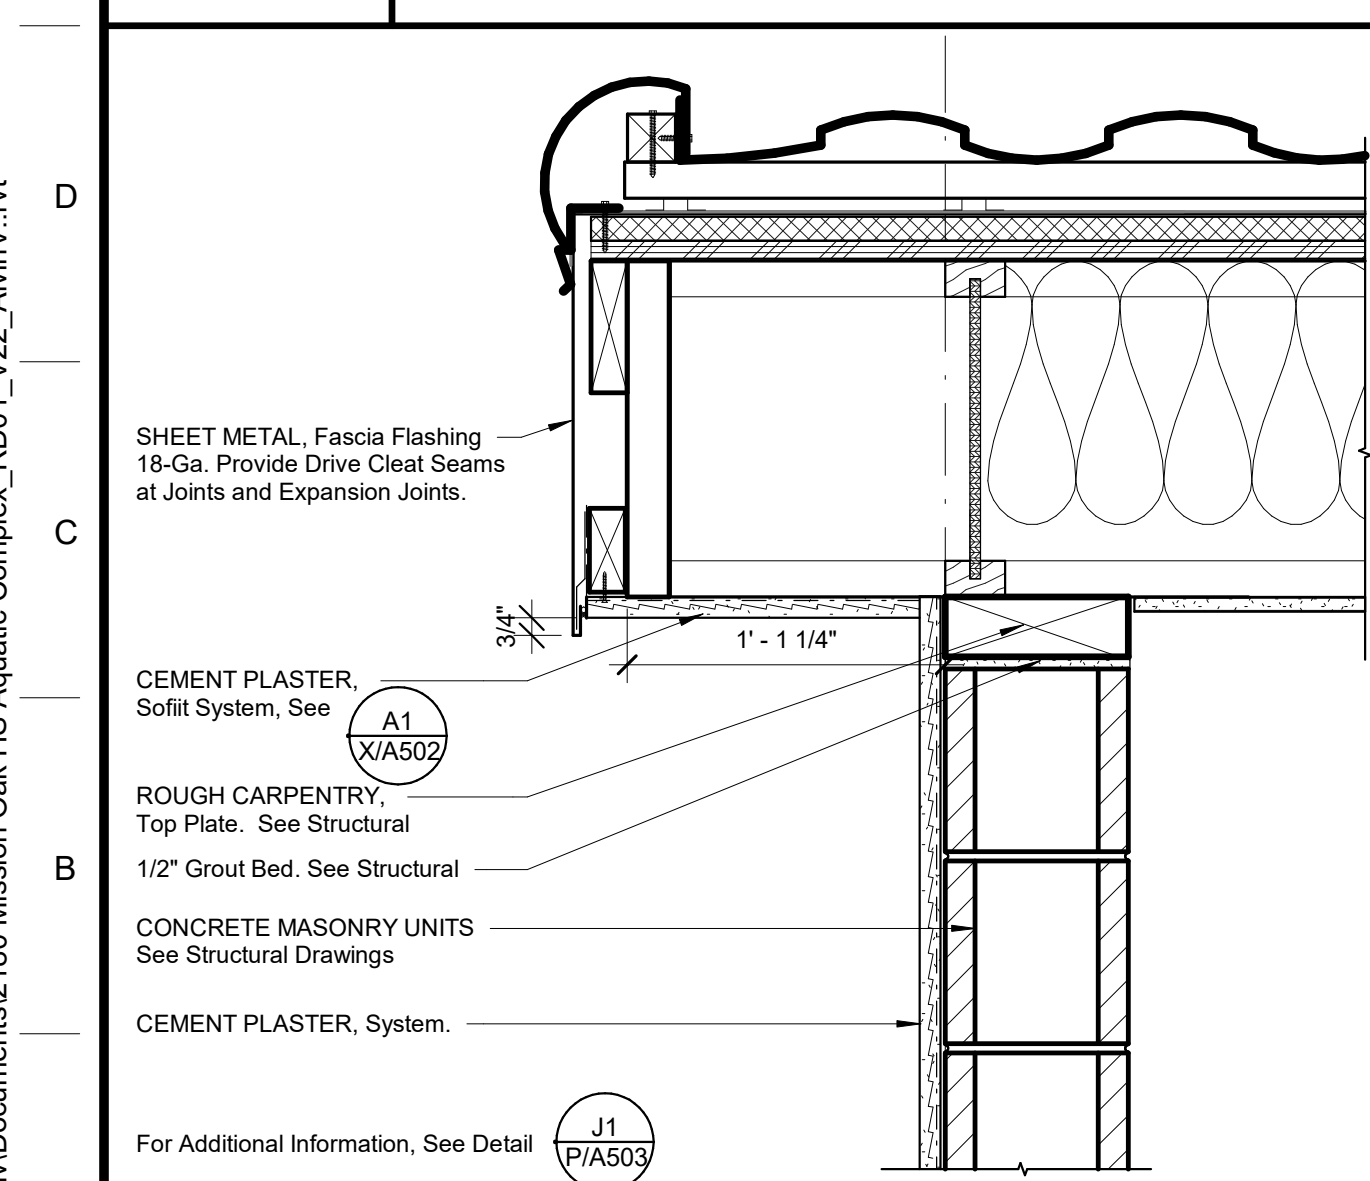

A1 METAL SHINGLES Rake Detail
1/12" = 1'-0"

A4 Building Section - P2
1/8" = 1'-0"

A11 Building Section - P3
1/8" = 1'-0"

DSA File No.: 54-H11
DSA Application No.: 02-120251
Agency Approval

Mission Oak HS Aquatic Complex
Tulare Joint Union High School District
Tulare, CA 93274
Project
BUILDING P2, P3
BUILDING SECTIONS - P2 & P3
Drawing

ARCHITECTURE PLANNING INTERIORS
www.dardenarchitects.com
6790 N. West Ave. • Fresno, CA 93711 • T. 559.448.8051
Architect

LICENSED ARCHITECT
ARCHITECT C. FERRER
No. C23724
Exp. 4-30-25
STATE OF CALIFORNIA

No.	Revision/Submission	Date
1	REVISION_01	05/31/2023

Revision

Designed By: MF Copyright 2022 Darden Architects
Scale: As indicated Drawn By: KT
Project Number: 2180 Checked By: -
Date: 03/28/2023 Reviewed By: MF

P/A501

DSA File No.: 54-H11

DSA Application No.: 02-120251

Agency Approval

SYMBOLS

- Cabinet Group No. Refer to Modular Casework Schedule and Lab Casework Schedule.
- FIRE PROTECTION SPECIALTIES, Fire Extinguisher Cabinet, Top of Cabinet @ +5'-0". Unless Noted Otherwise, Provide Fire Rated Cabinet at Rated Walls. See Detail N14 X/A602
- WALL COVERINGS, FRP Panels E14 X/A601
- WALL COVERINGS, Solid Surfacing A14 X/A601
- ROUGH CARPENTRY, Plywood Sheathing, AC
- PLUMBING, Access Door, See Plumbing Drawings
- ELECTRICAL, AV/Speaker @ +7'-6" to center of device. Unless Noted Otherwise.
- ELECTRICAL, Clock/Speaker @ +8'-6" to center of device. Unless Noted Otherwise.
- ELECTRICAL, Outlet ELECTRICAL, Data Outlet
- ELECTRICAL, Light Switch ELECTRICAL, Microphone Outlet
- ELECTRICAL, Fire Alarm Device ELECTRICAL, Intrusion Sensor
- ELECTRICAL, Volume Control ELECTRICAL, Motion Sensor
- ELECTRICAL, Television Outlet ELECTRICAL, Telephone Outlet
- MECHANICAL, Thermostat ELECTRICAL, HDMI
- PLUMBING, Hose Bib

ABBREVIATIONS

- FEC FIRE PROTECTION SPECIALTIES, Fire Extinguisher and Cabinet.
- GL Type FEC-1, Unless Noted Otherwise.
- KS Knee Space
- OH Opposite Hand
- Typ. Typical
- Sim. Similar
- Dia. Diameter
- UNO Unless Noted Otherwise

NOTES

1. All Details, Materials and Finishes Shall be Considered Typical for All Similar Conditions, Unless Noted Otherwise.
2. Refer to Plumbing, Mechanical, Telecommunications, Food Service, and Electrical for All Wall Mounted Devices and Coordinate Location and Heights with Architectural (i.e. Casework, Equipment, etc.).
3. Locate and Mount TOILET ACCESSORIES and PLUMBING per Detail A7 X/A601 Unless Noted Otherwise.
4. Provide backing at all TOILET ACCESSORIES, TOILET PARTITIONS, and IDENTIFYING DEVICES per Detail N14 X/A601 Unless Noted Otherwise.
5. Provide Backing for TOILET ACCESSORIES, Grab Bars per Detail J11 X/A601
6. Locate and mount IDENTIFYING DEVICES per Detail E1 X/A601 Unless Noted Otherwise.
7. Provide backing at all MODULAR CASEWORK per Detail N14 X/A601
8. WALL COVERINGS, FRP Panels, See Detail E14 X/A601
9. GYPSUM BOARD, Metal Accessories, See Detail J14 X/A601

F18 Interior Elevation legend

Mission Oak HS Aquatic Complex
 Tulare Joint Union High School District
 Tulare, CA 93274 Project

BUILDING P
 INTERIOR ELEVATIONS - ROOMS P201 - P205
 Drawing









ARCHITECTURE PLANNING INTERIORS
 darden architects www.dardenarchitects.com
 6790 N. West Ave. • Fresno, CA 93711 • T. 559.448.8051

Architect

No.	Revision/Submission	Date
1	REVISION_01	05/31/2023

Revision	
Designed Designer	Copyright 2022 Darden Architects
Scale: 1/4" = 1'-0"	Drawn By: Author
Project Number: 2180	Checked I/Checker
Date: 03/28/2023	Reviewed/Approver

P/A601

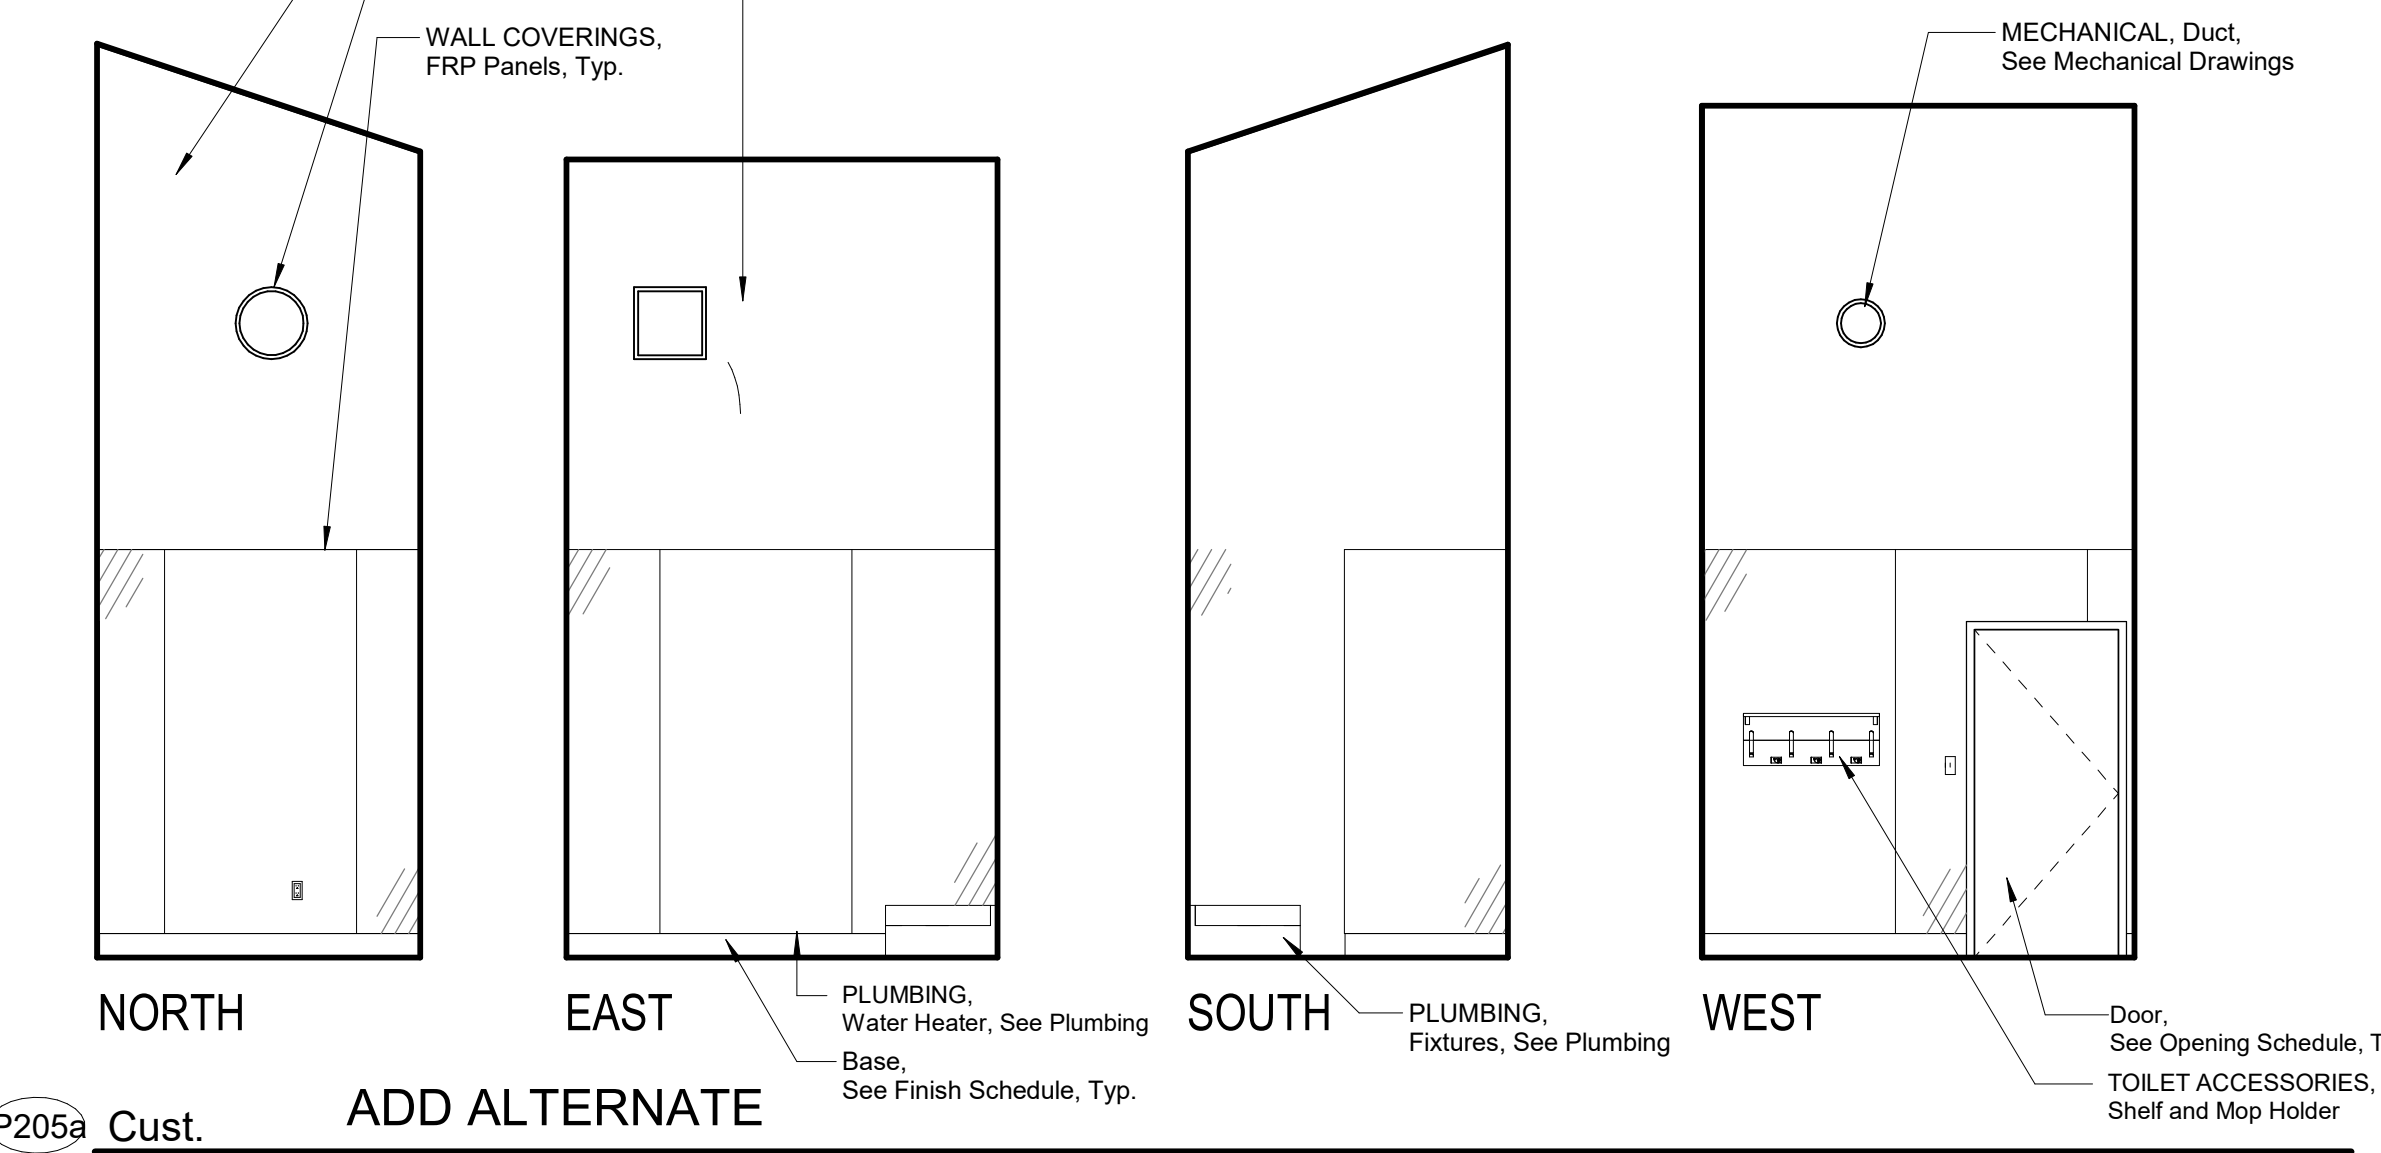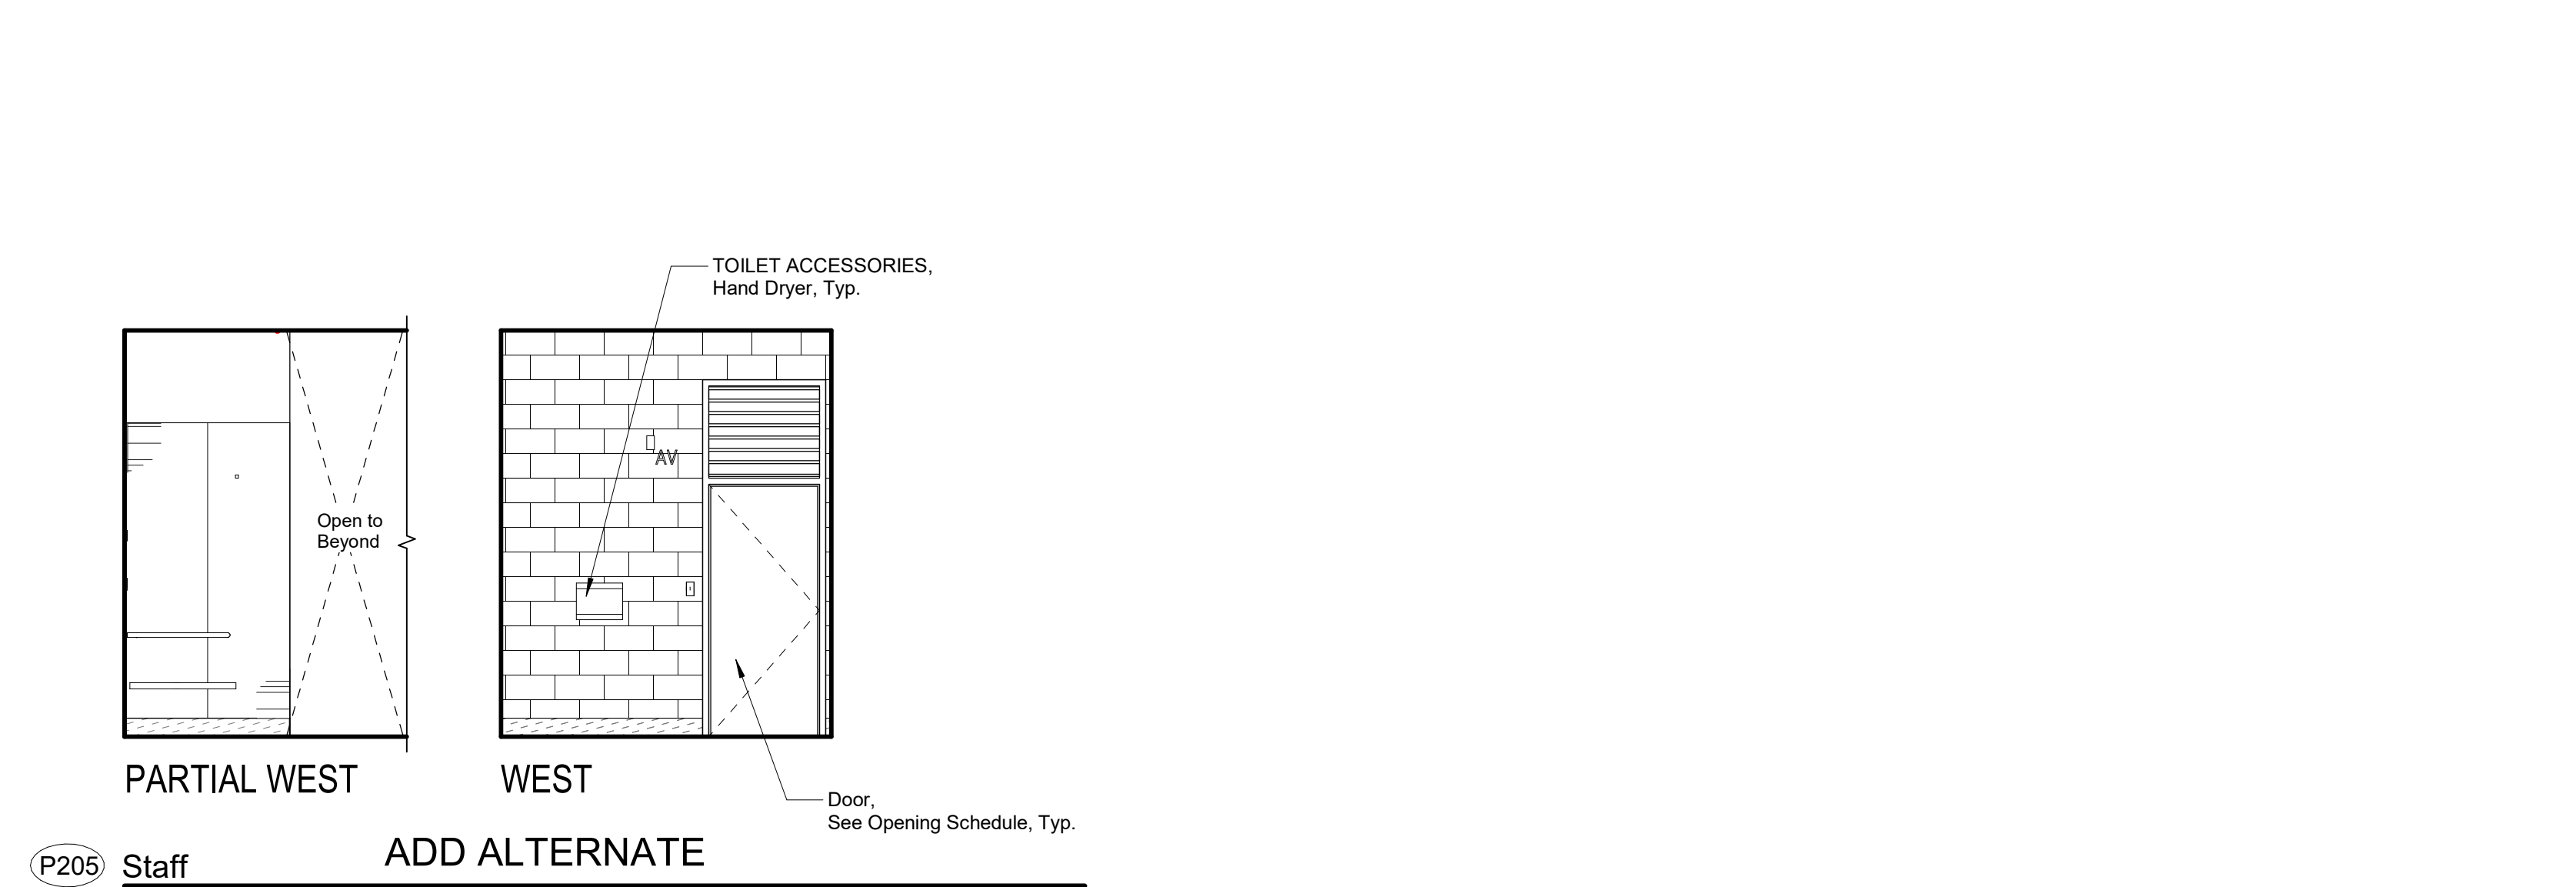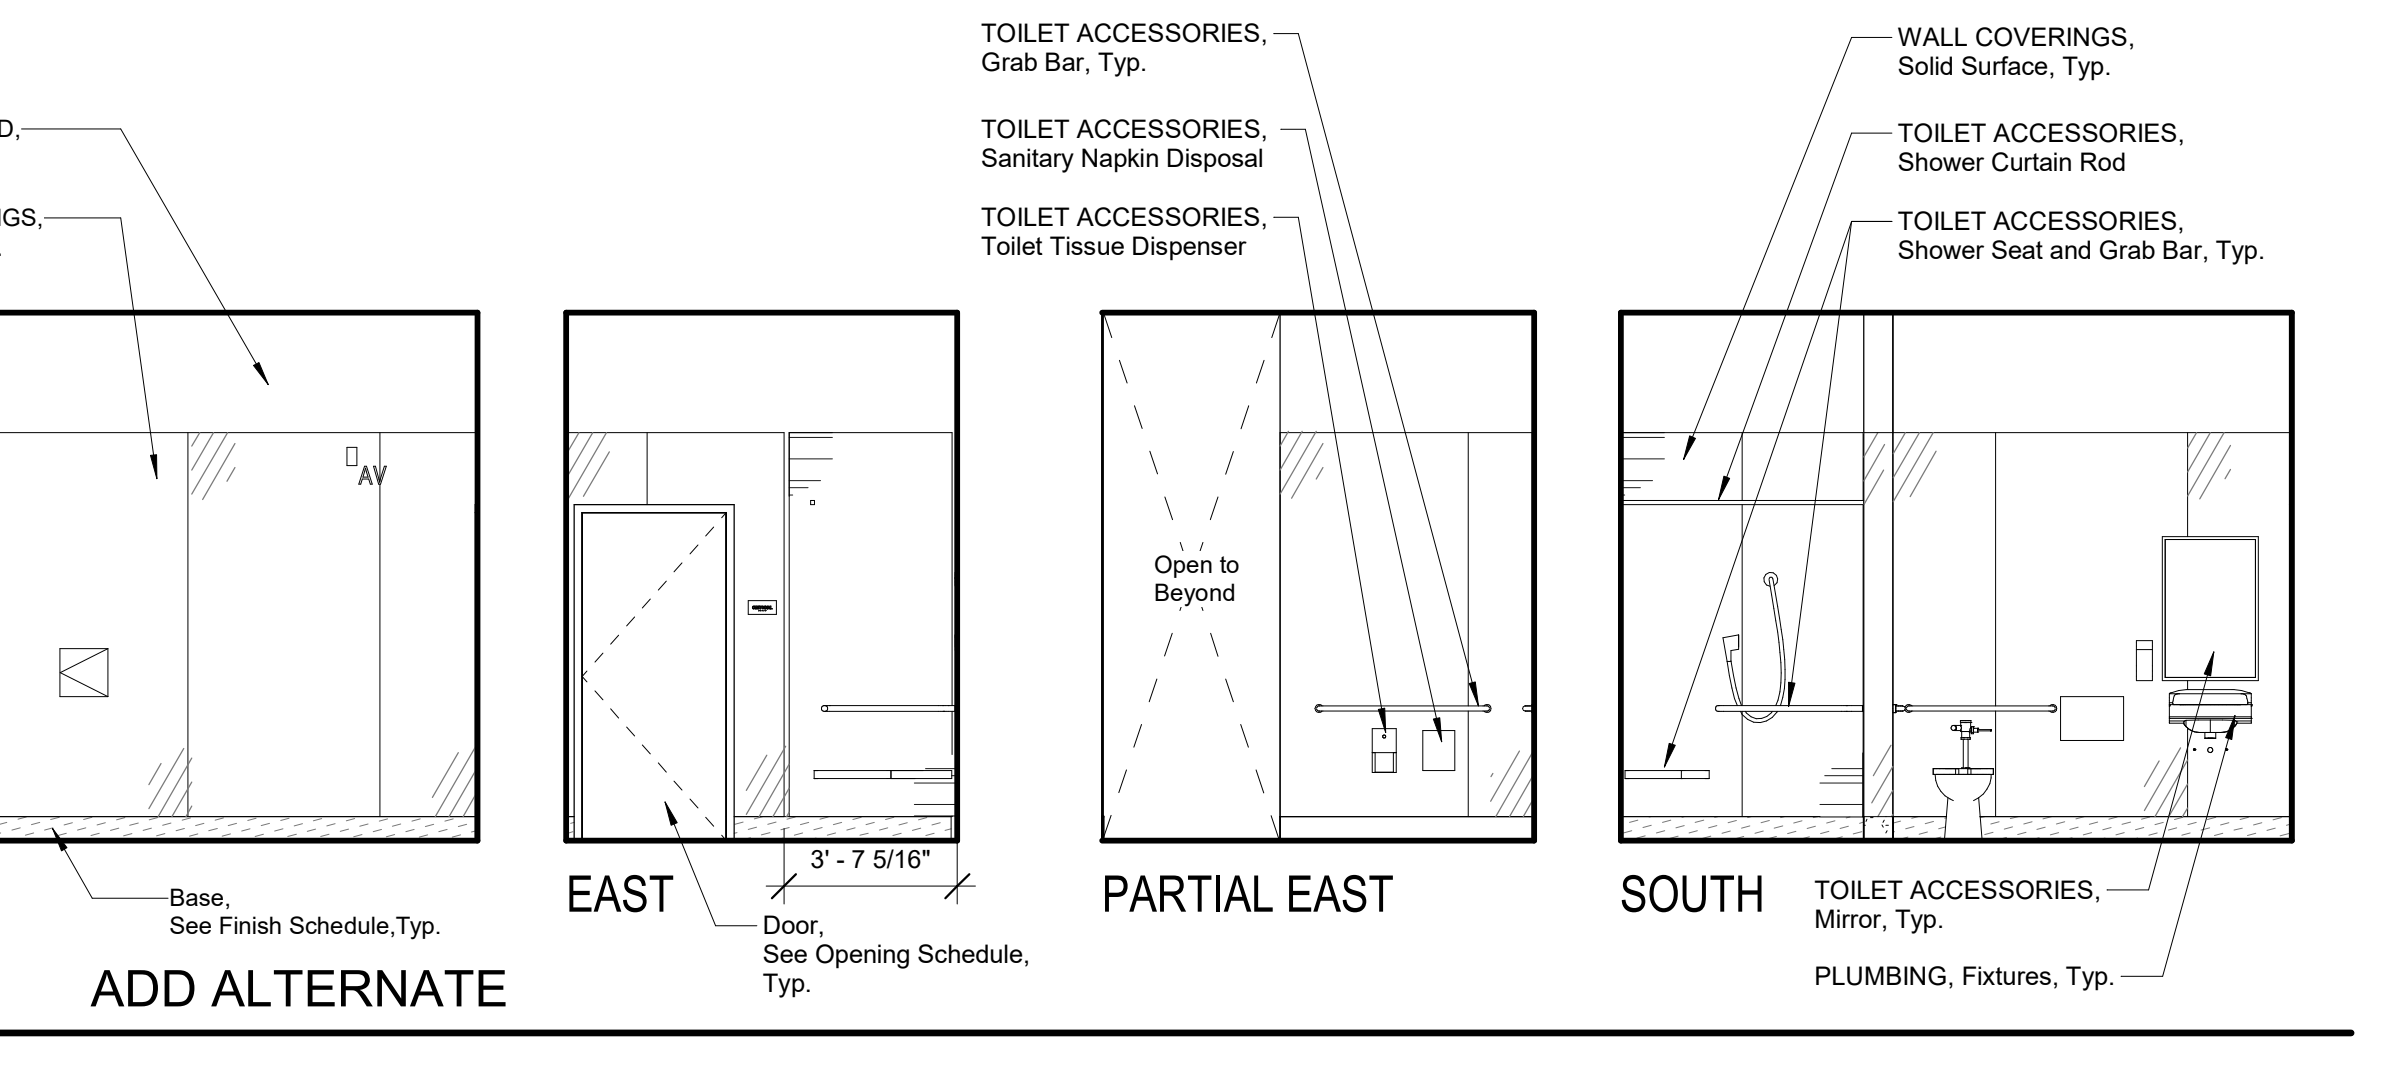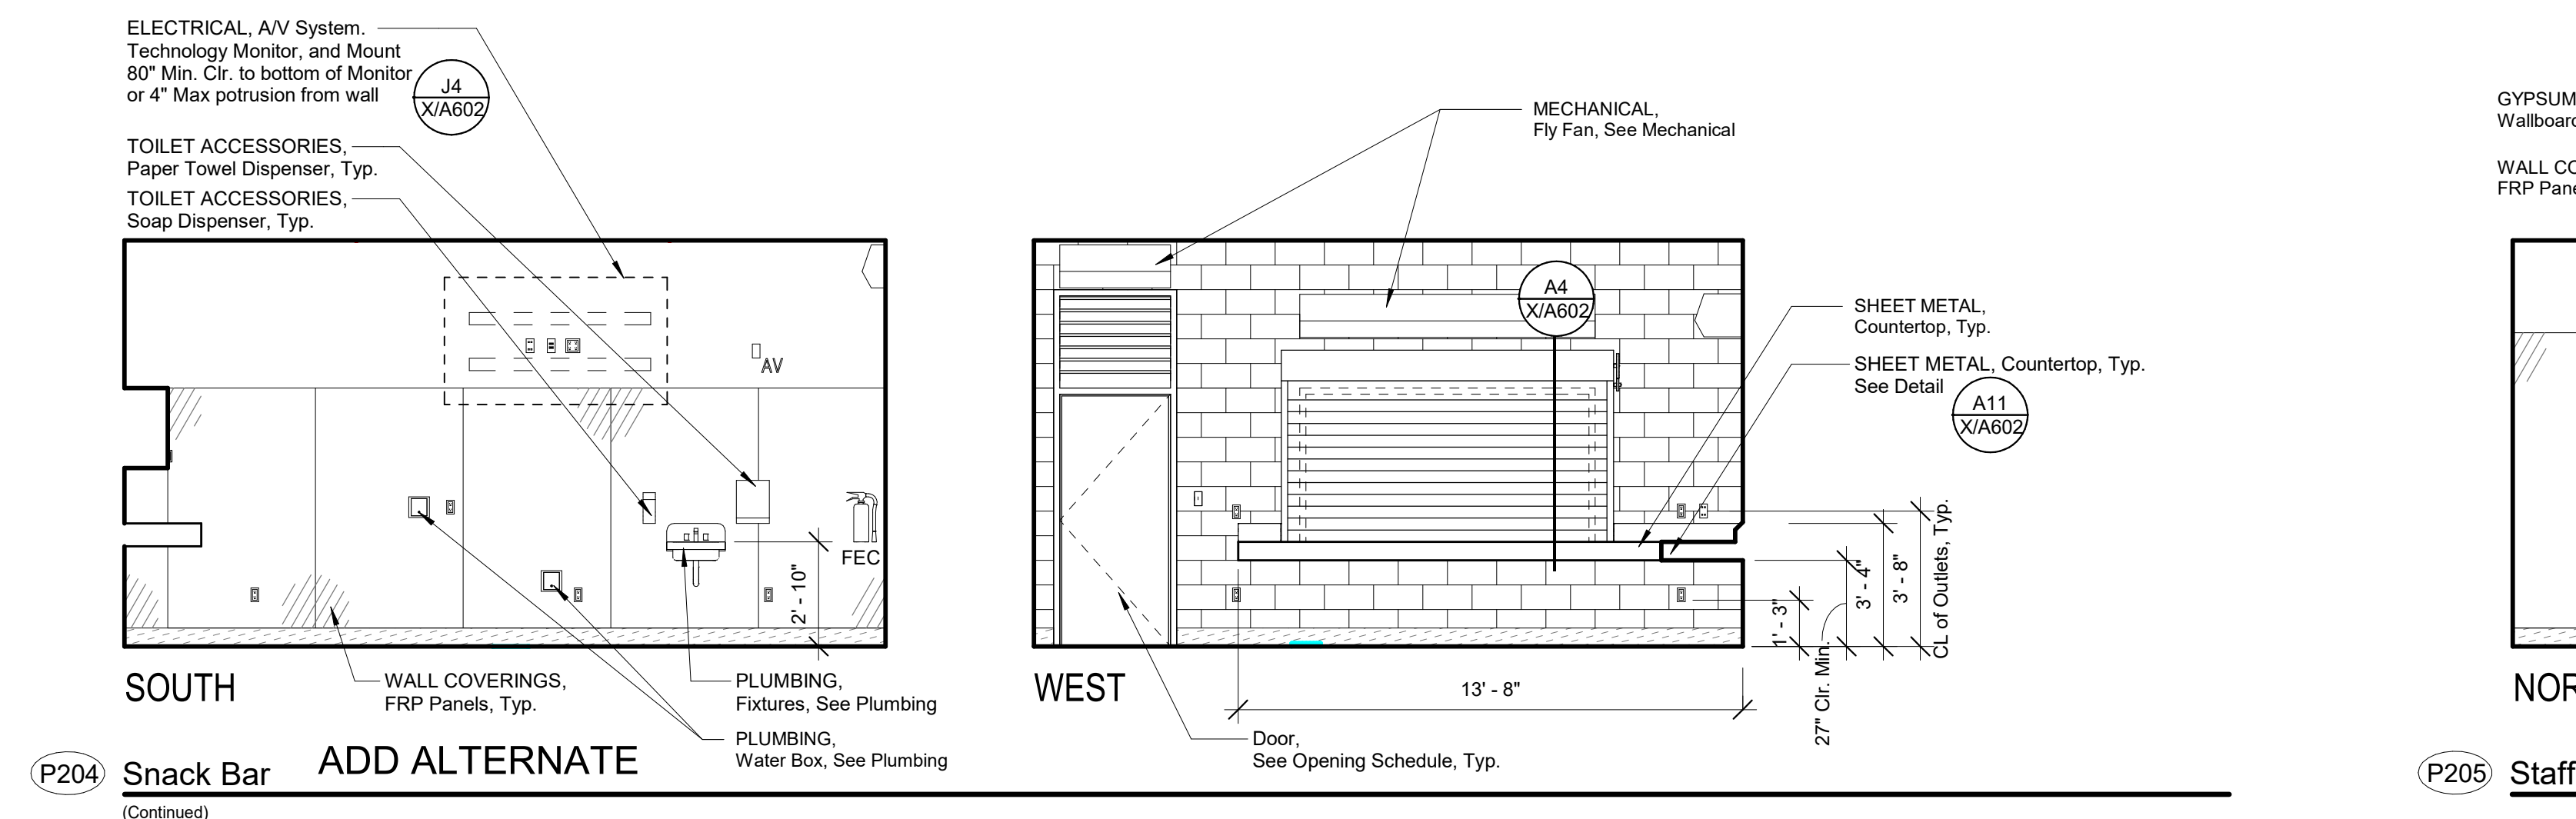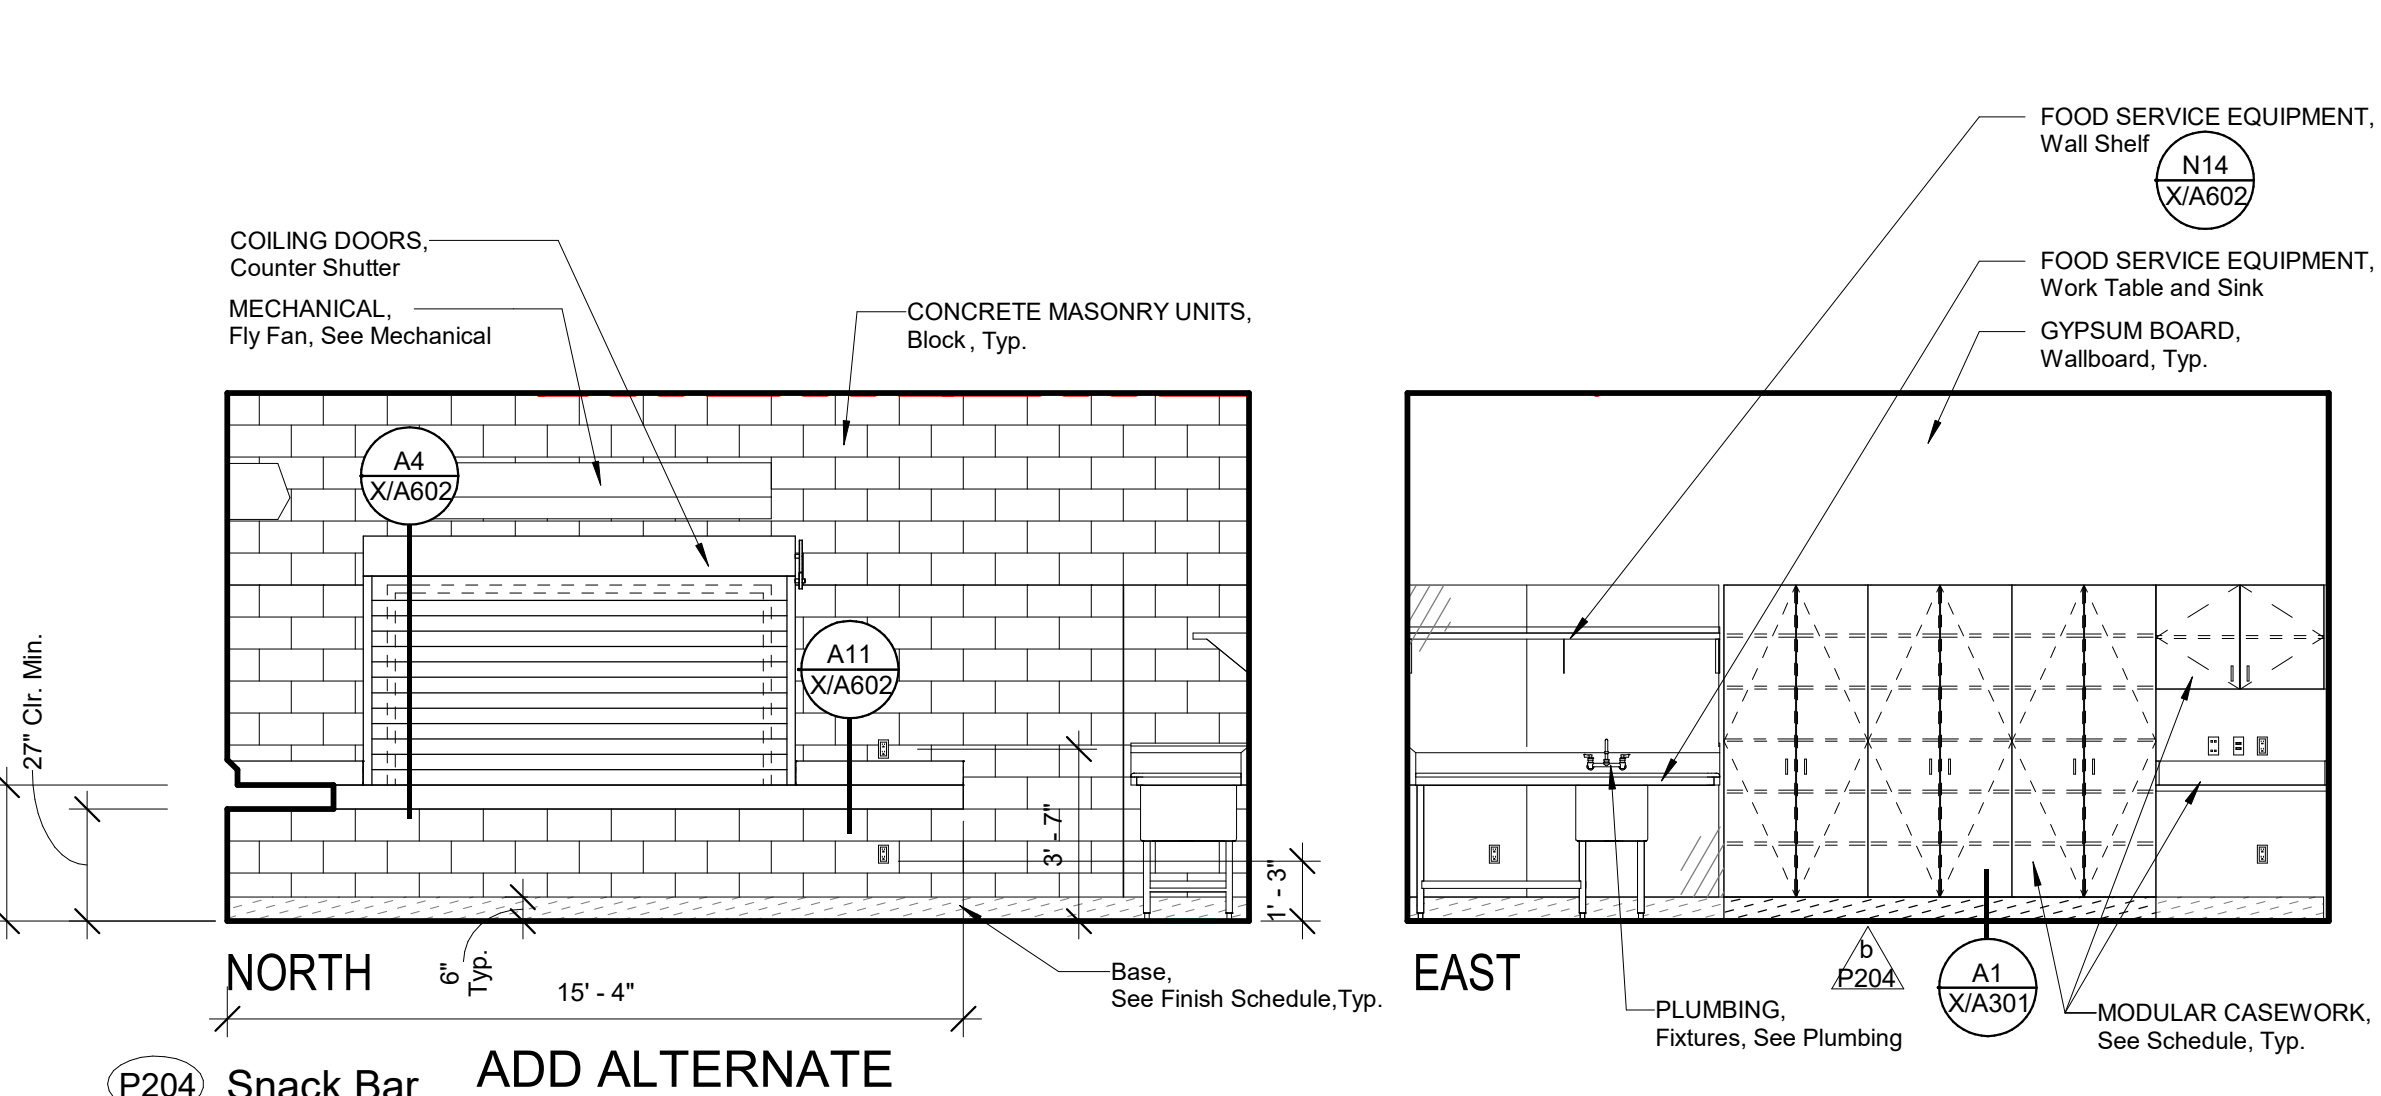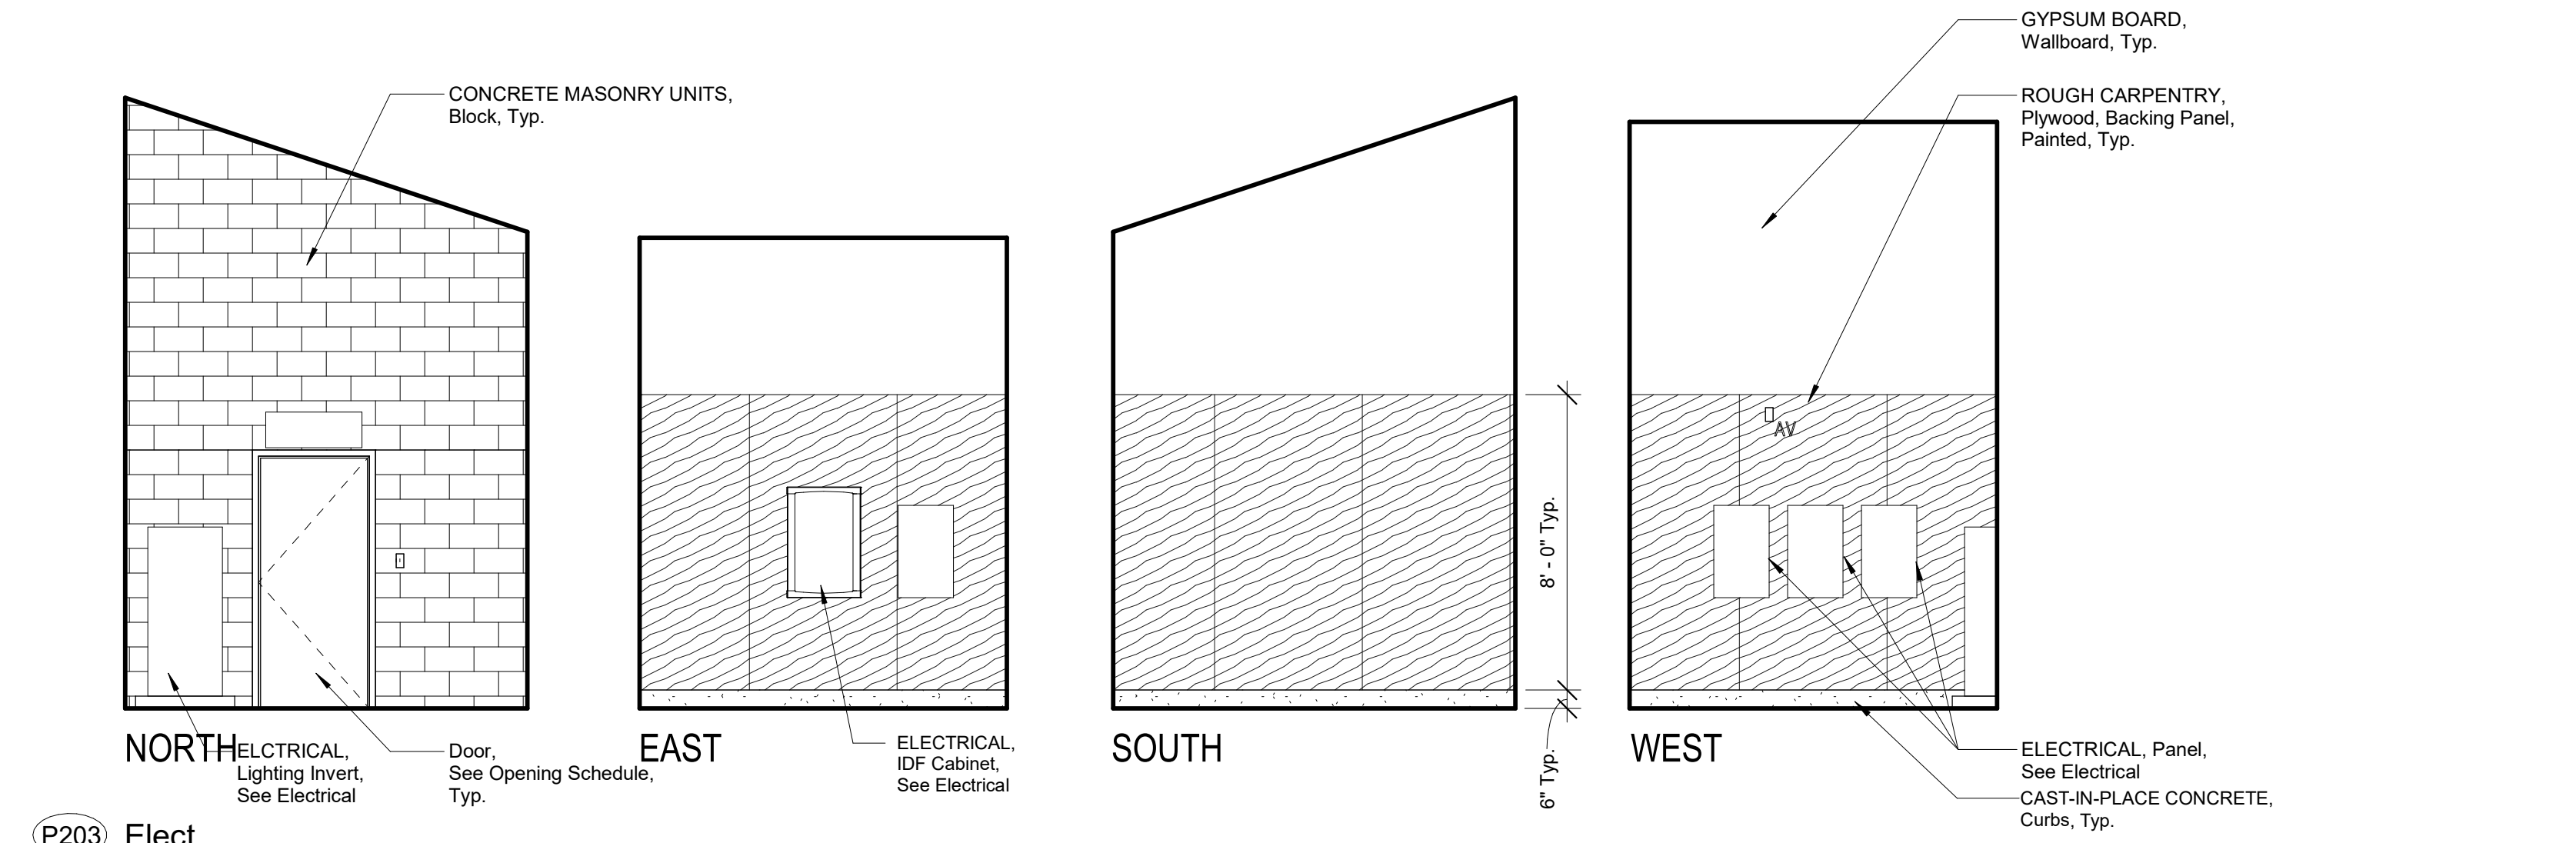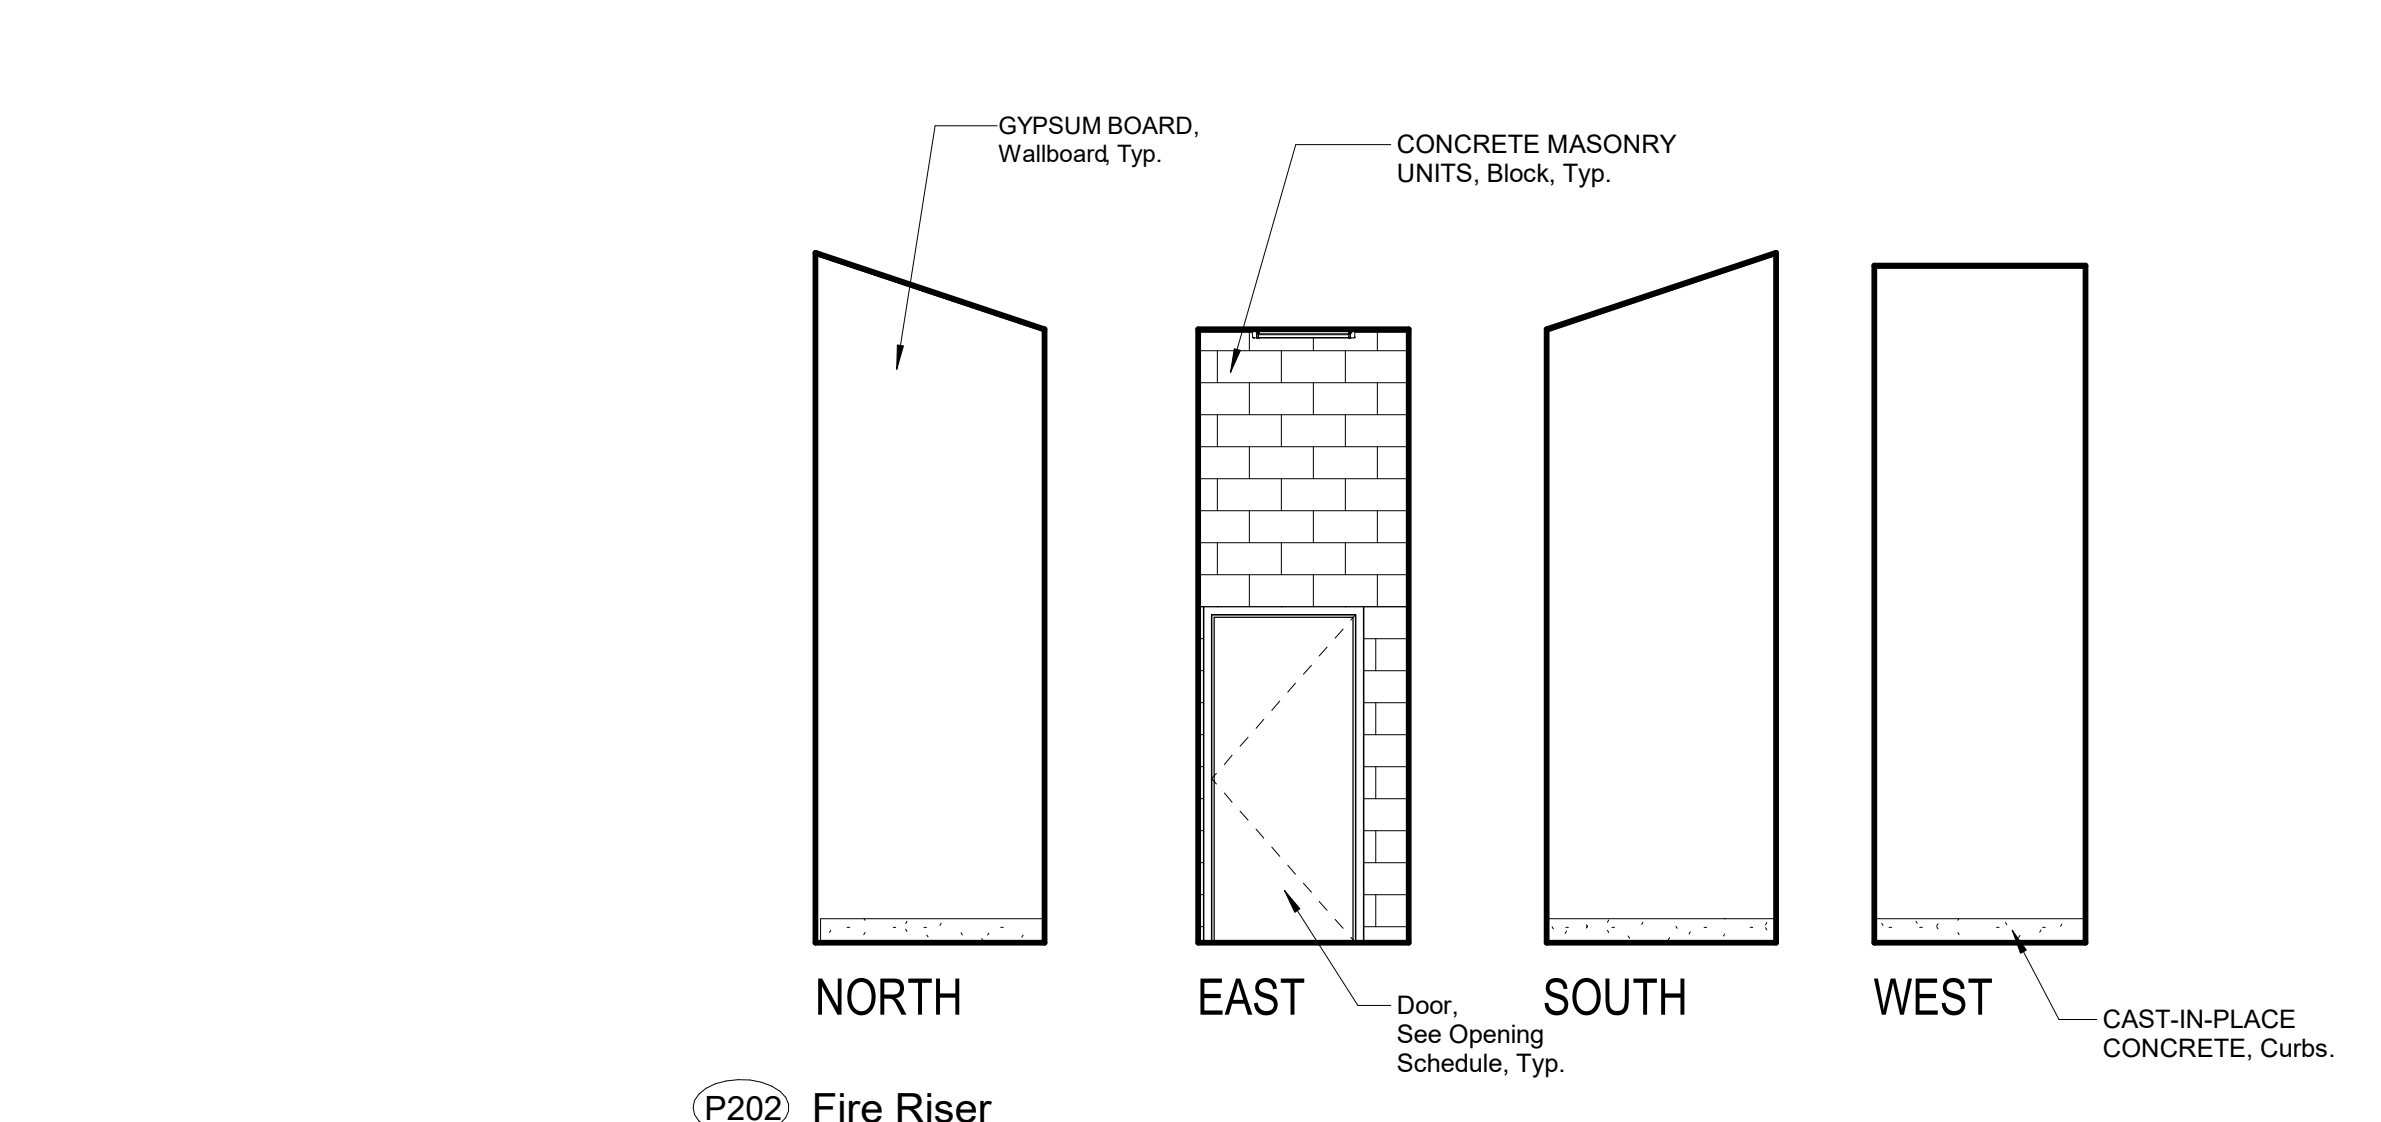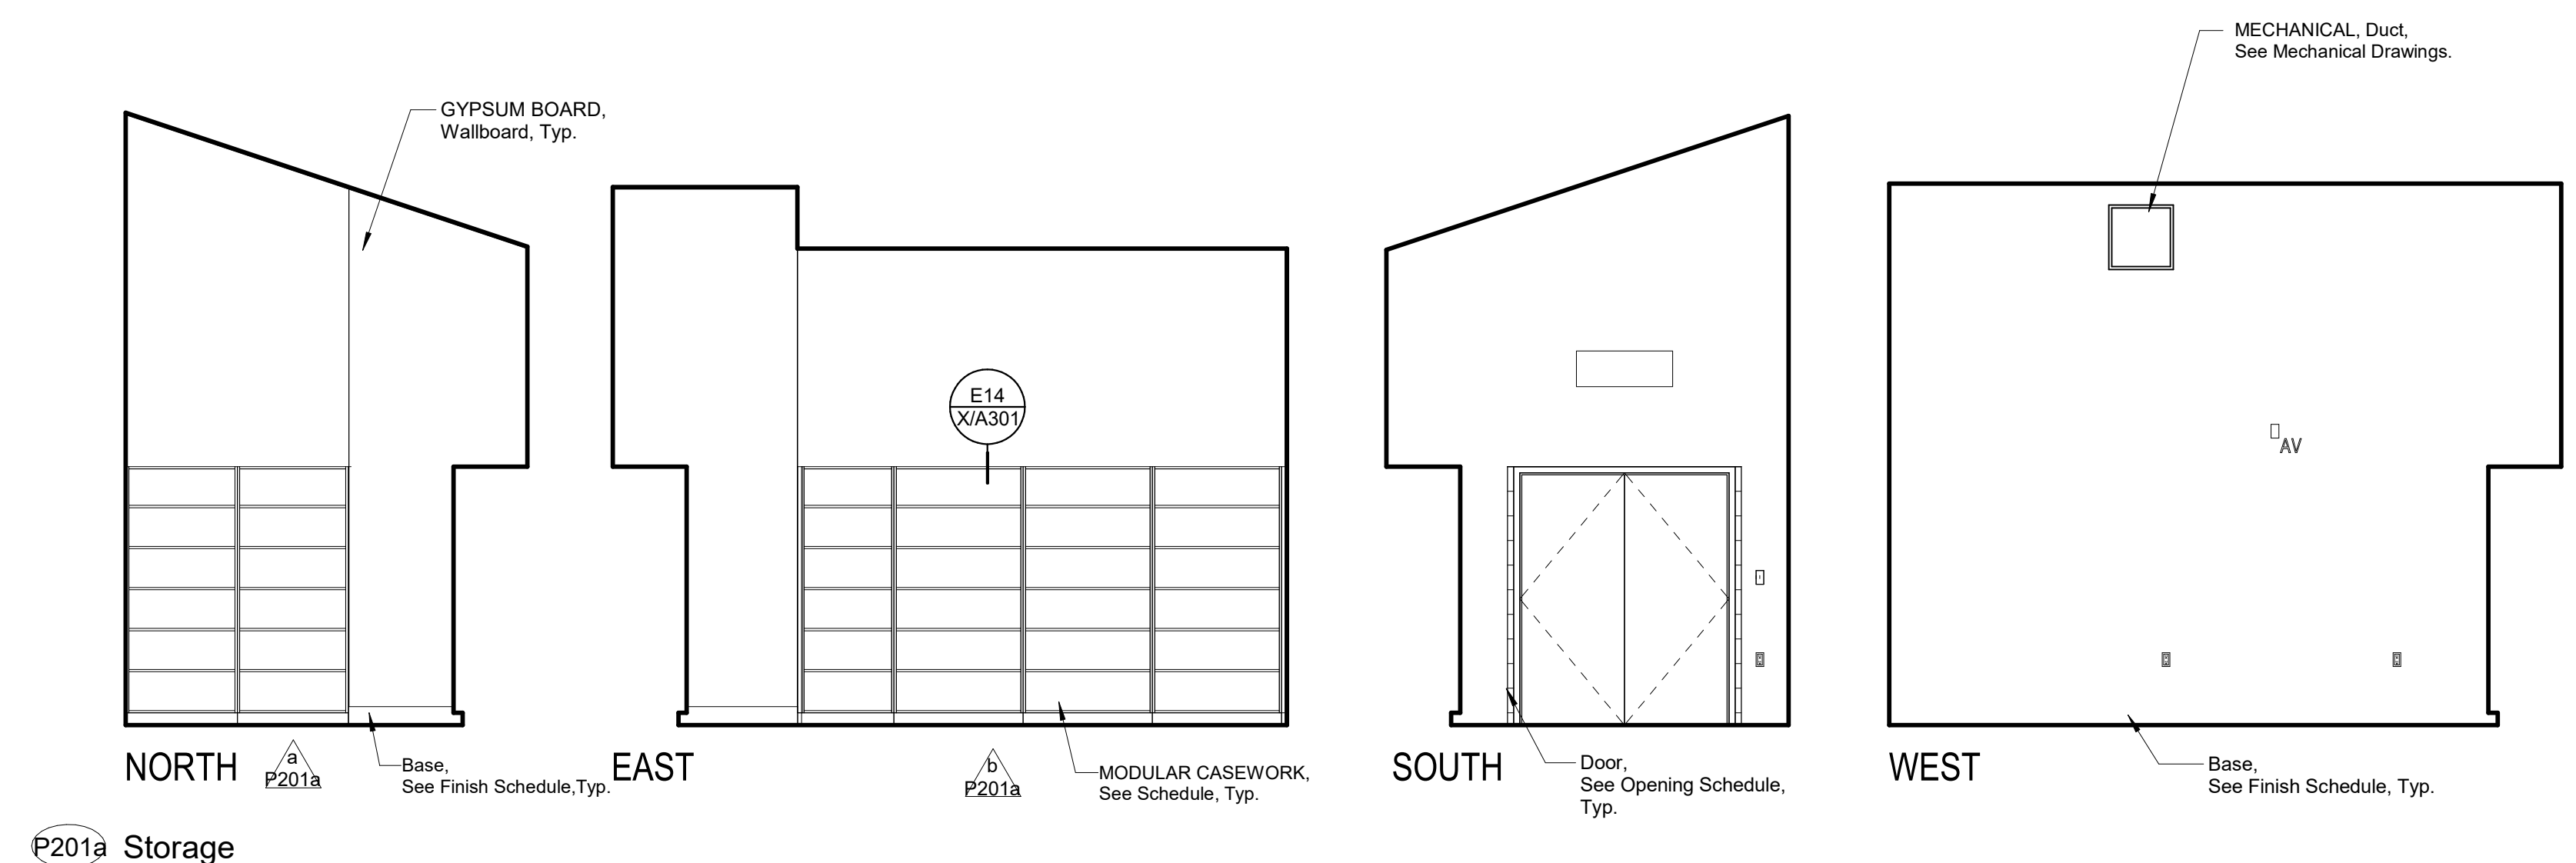

8/18/2023 4:27:33 PM e:\Users\alvin\Documents\180 Mission Oak HS Aquatic Complex_R001_V22_A\InV.nt

DSA File No.: 54-H11

DSA Application No.: 02-120251

Agency Approval










SYMBOLS

	Cabinet Group No. Refer to Modular Casework Schedule and Lab Casework Schedule.
	FIRE PROTECTION SPECIALTIES, Fire Extinguisher Cabinet, Top of Cabinet @ +5'-0". Unless Noted Otherwise, Provide Fire Rated Cabinet at Rated Walls. See Detail N14 X/A607
	WALL COVERINGS, FRP Panels E14 X/A607
	WALL COVERINGS, Solid Surfacing A14 X/A607
	ROUGH CARPENTRY, Plywood Sheathing, AC
	PLUMBING, Access Door, See Plumbing Drawings
	ELECTRICAL, AV/Speaker @ +7'-6" to center of device, Unless Noted Otherwise.
	ELECTRICAL, Clock/Speaker @ +8'-6" to center of device, Unless Noted Otherwise.
	ELECTRICAL, Outlet
	ELECTRICAL, Light Switch
	ELECTRICAL, Fire Alarm Device
	ELECTRICAL, Volume Control
	ELECTRICAL, Television Outlet
	MECHANICAL, Thermostat
	PLUMBING, Hose Bib
	ELECTRICAL, Data Outlet
	ELECTRICAL, Microphone Outlet
	ELECTRICAL, Intrusion Sensor
	ELECTRICAL, Motion Sensor
	ELECTRICAL, Telephone Outlet
	ELECTRICAL, HDMI

ABBREVIATIONS

FEC	FIRE PROTECTION SPECIALTIES, Fire Extinguisher and Cabinet, Type FEC-1, Unless Noted Otherwise.
Gl.	Glass
KS	Knee Space
OH	Opposite Hand
Typ.	Typical
Sim.	Similar
Dis.	Diameter
UNO	Unless Noted Otherwise

- NOTES**
- All Details, Materials and Finishes Shall be Considered Typical for All Similar Conditions, Unless Noted Otherwise.
 - Refer to Plumbing, Mechanical, Telecommunications, Food Service, and Electrical for All Wall Mounted Devices and Coordinate Location and Heights with Architectural (ie. Casework, Equipment, etc.).
 - Locate and Mount TOILET ACCESSORIES and PLUMBING per Detail A7 X/A607 Unless Noted Otherwise.
 - Provide backing at all TOILET ACCESSORIES, TOILET PARTITIONS, and IDENTIFYING DEVICES per Detail N14 X/A607 Unless Noted Otherwise.
 - Provide Backing for TOILET ACCESSORIES, Grab Bars per Detail J11 X/A607
 - Locate and mount IDENTIFYING DEVICES per Detail E1 X/A607 Unless Noted Otherwise.
 - Provide backing at all MODULAR CASEWORK per Detail N14 X/A607
 - WALL COVERINGS, FRP Panels, See Detail E14 X/A607
 - GYPSUM BOARD, Metal Accessories, See Detail J14 X/A607

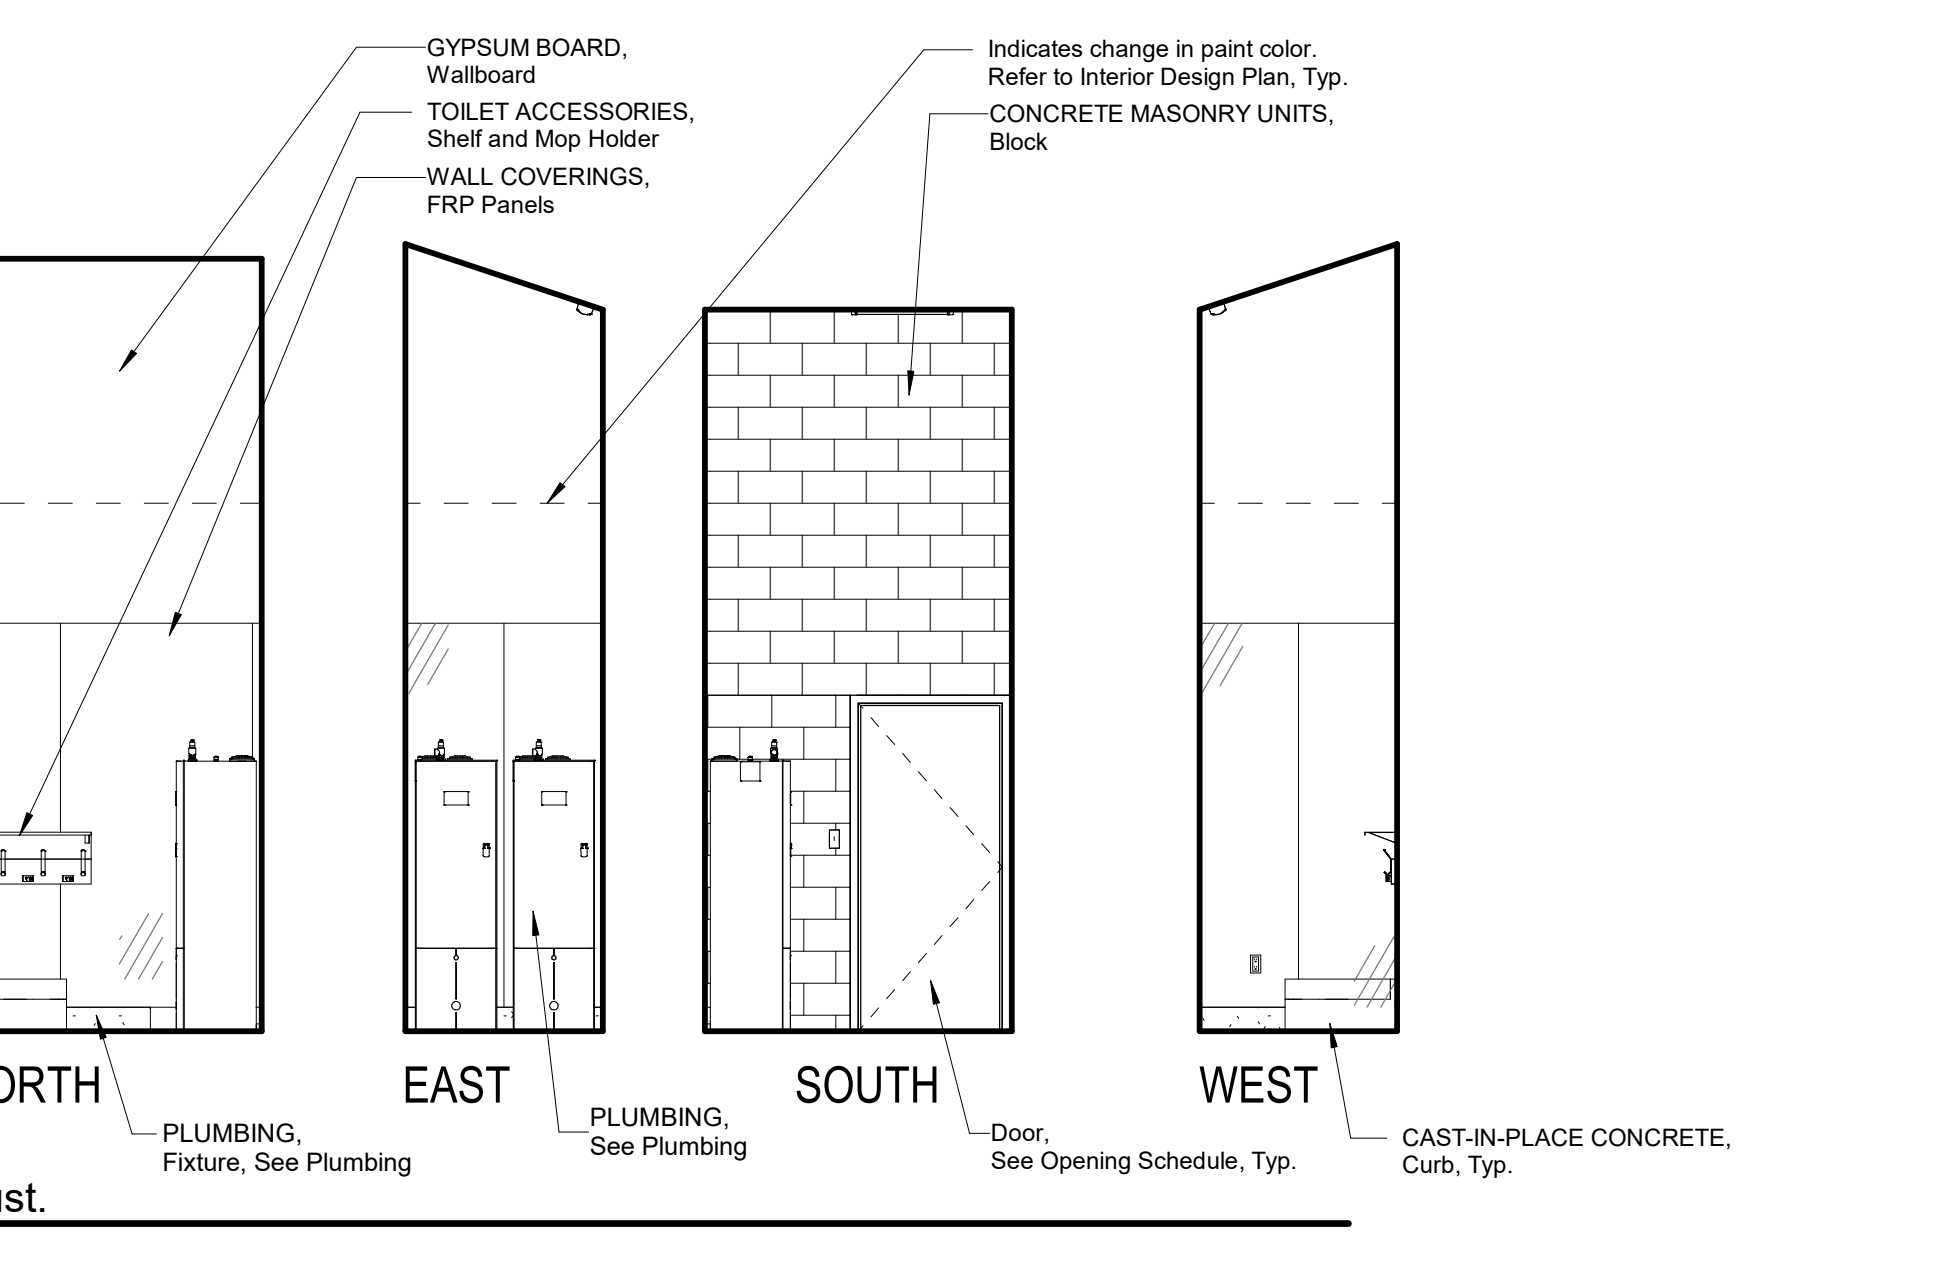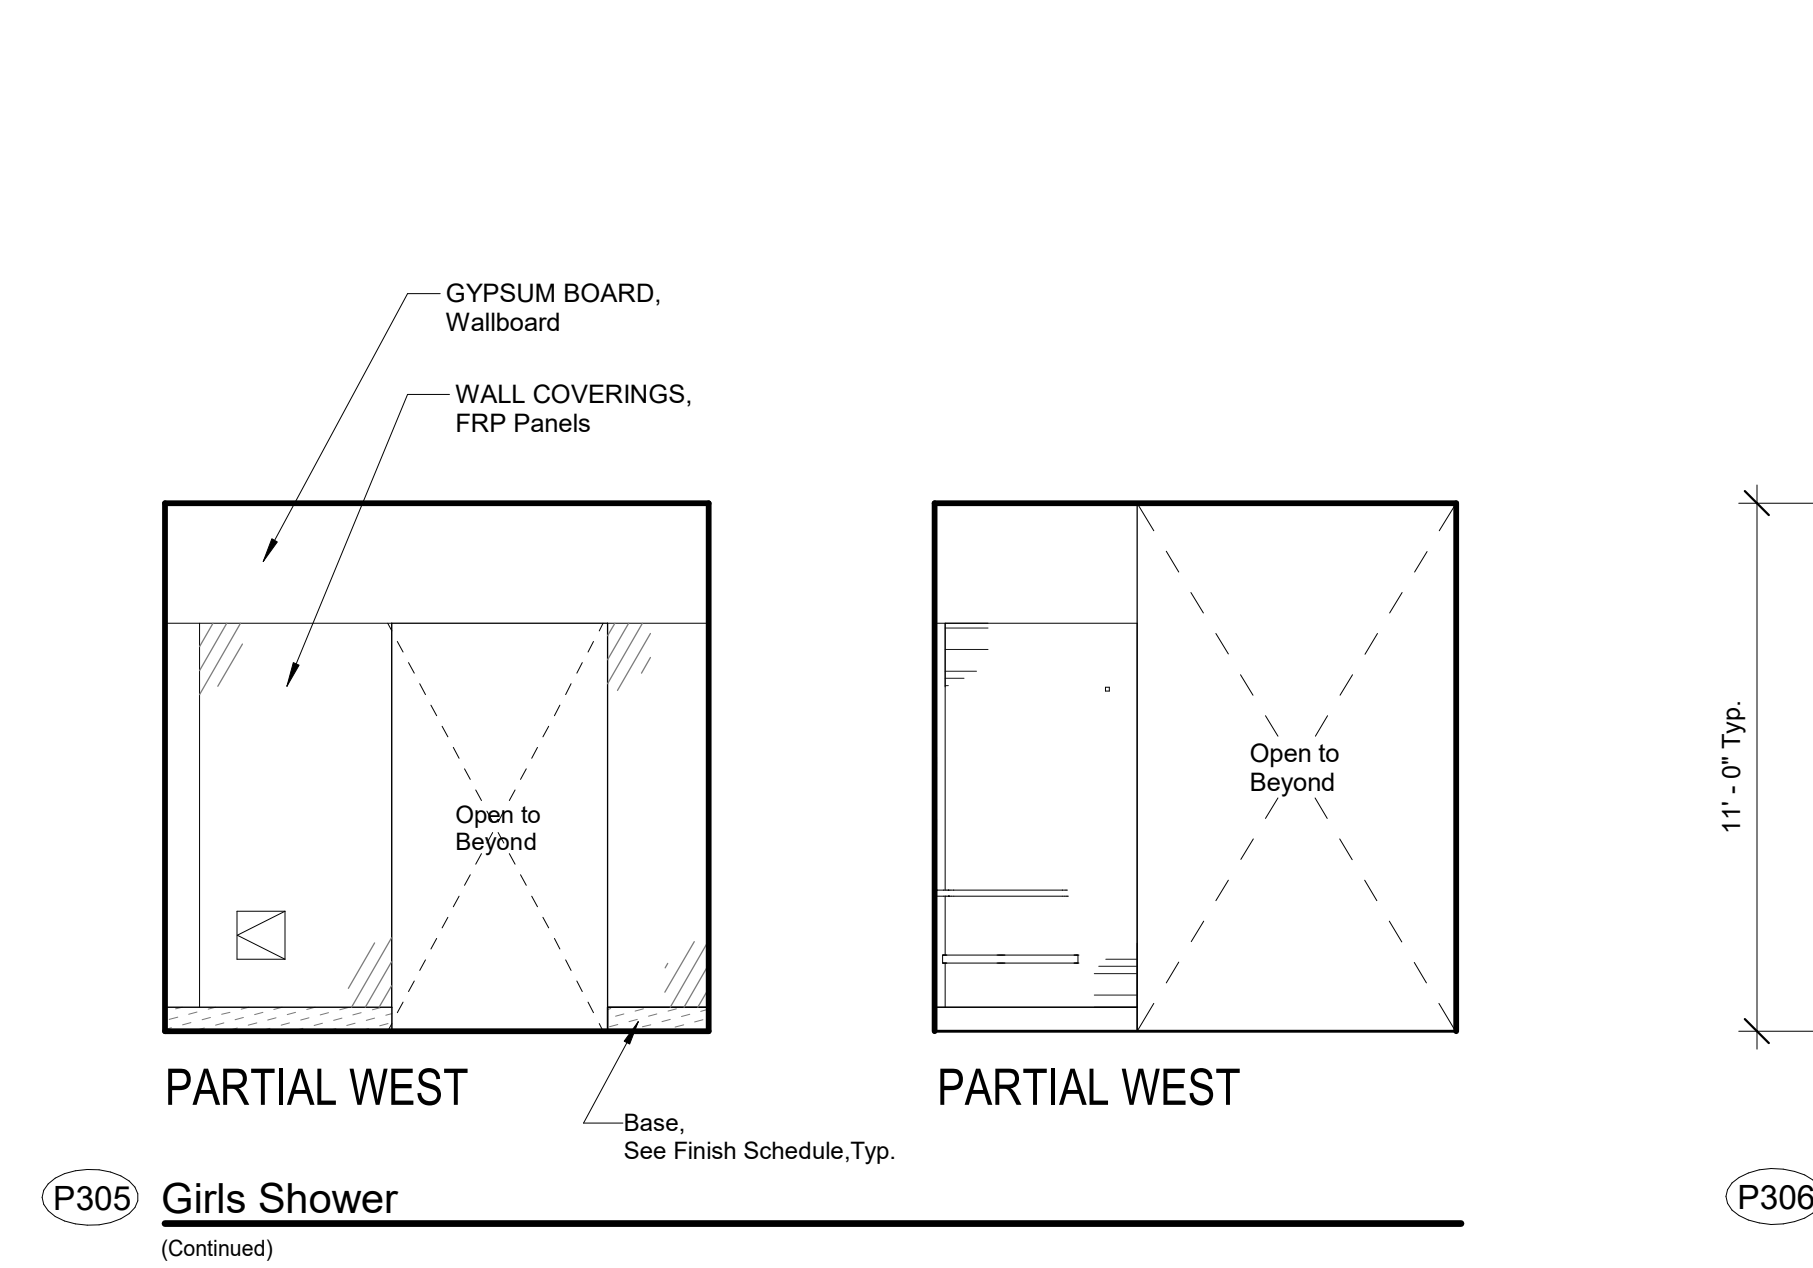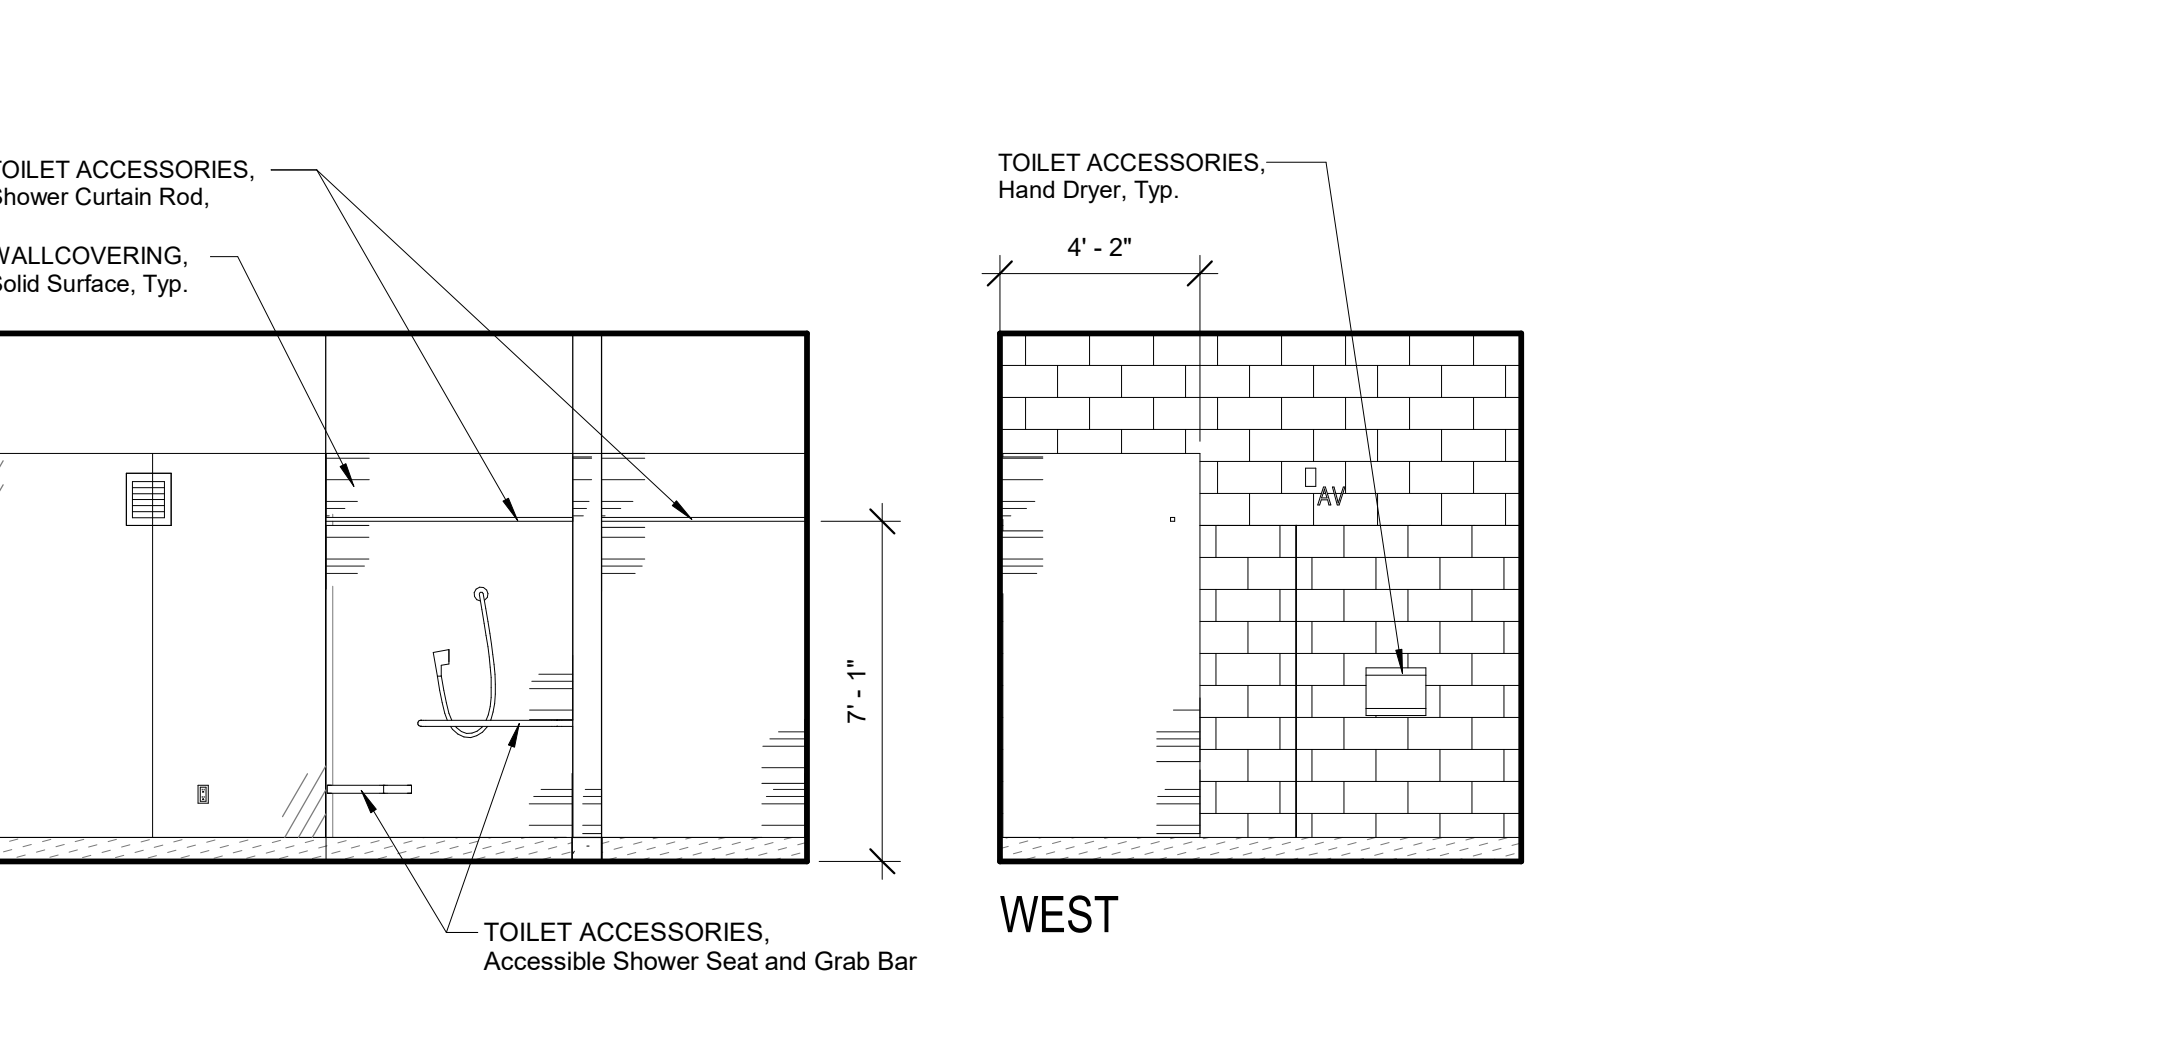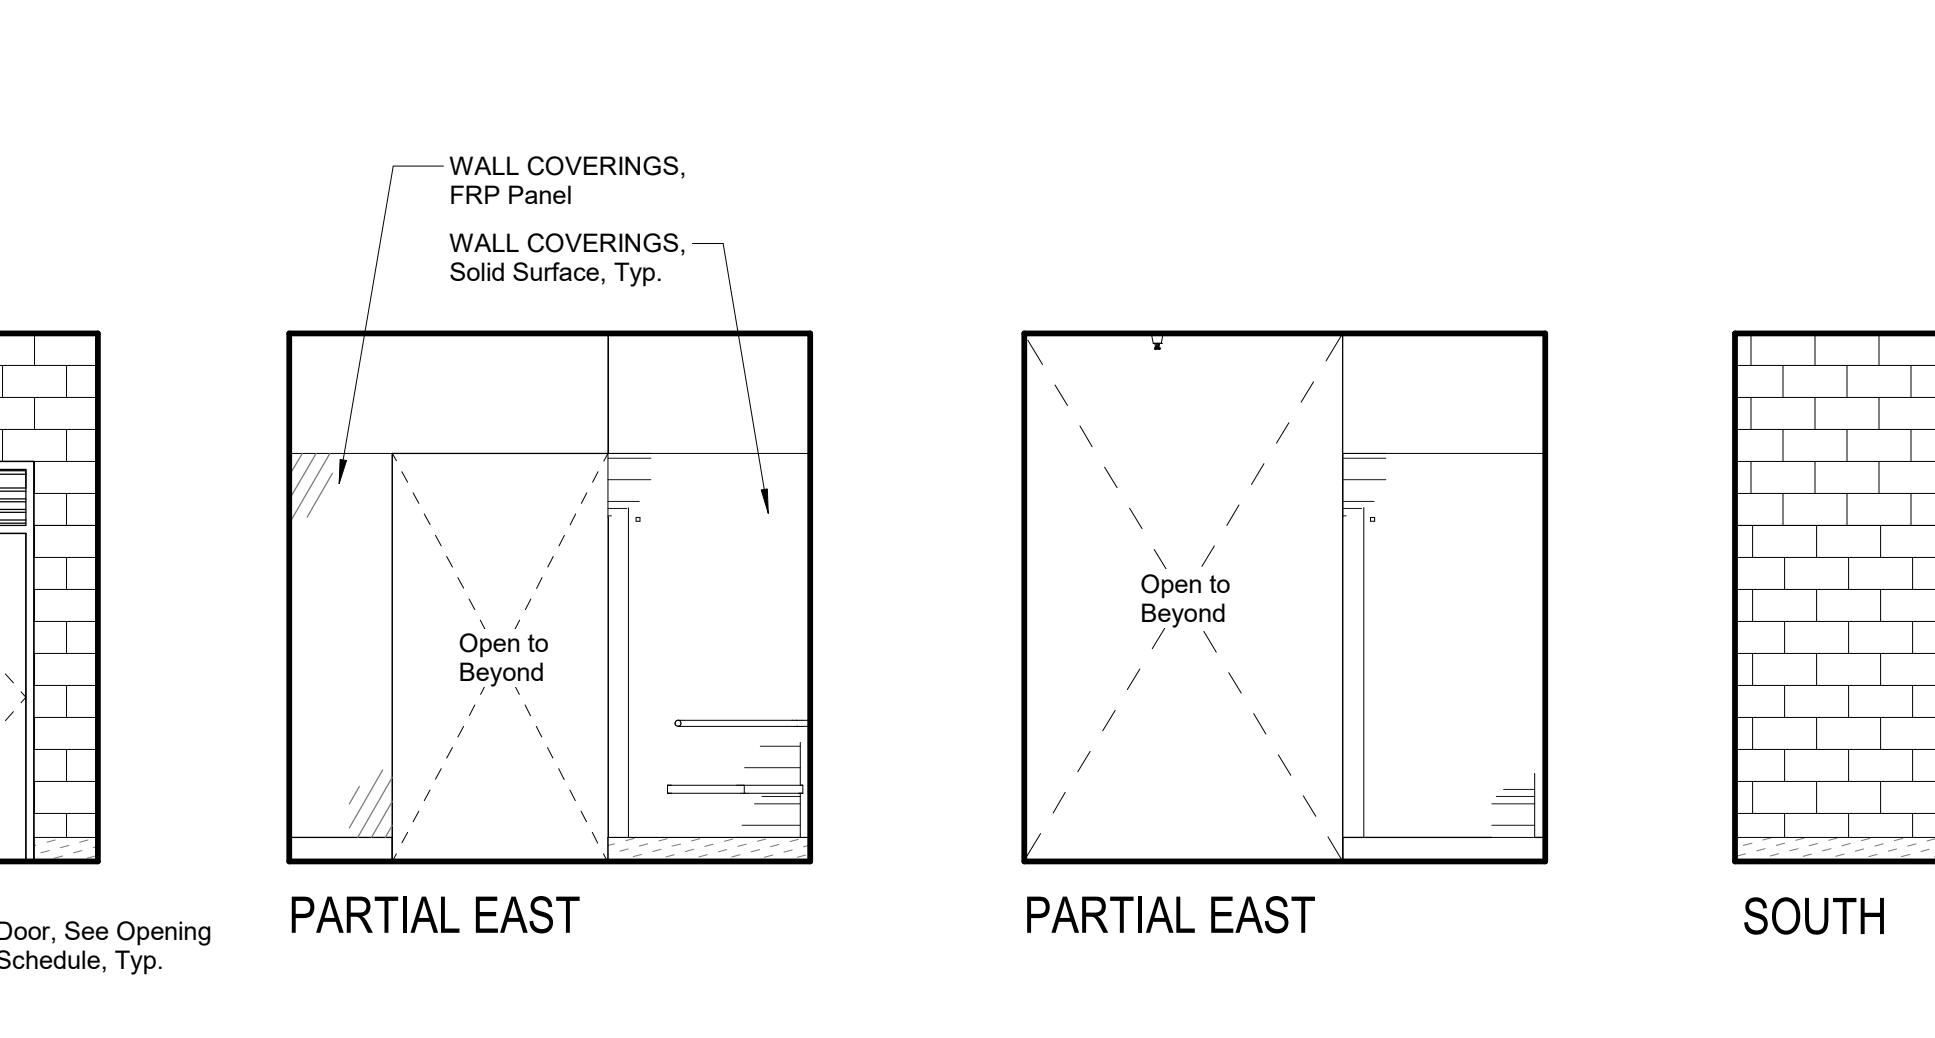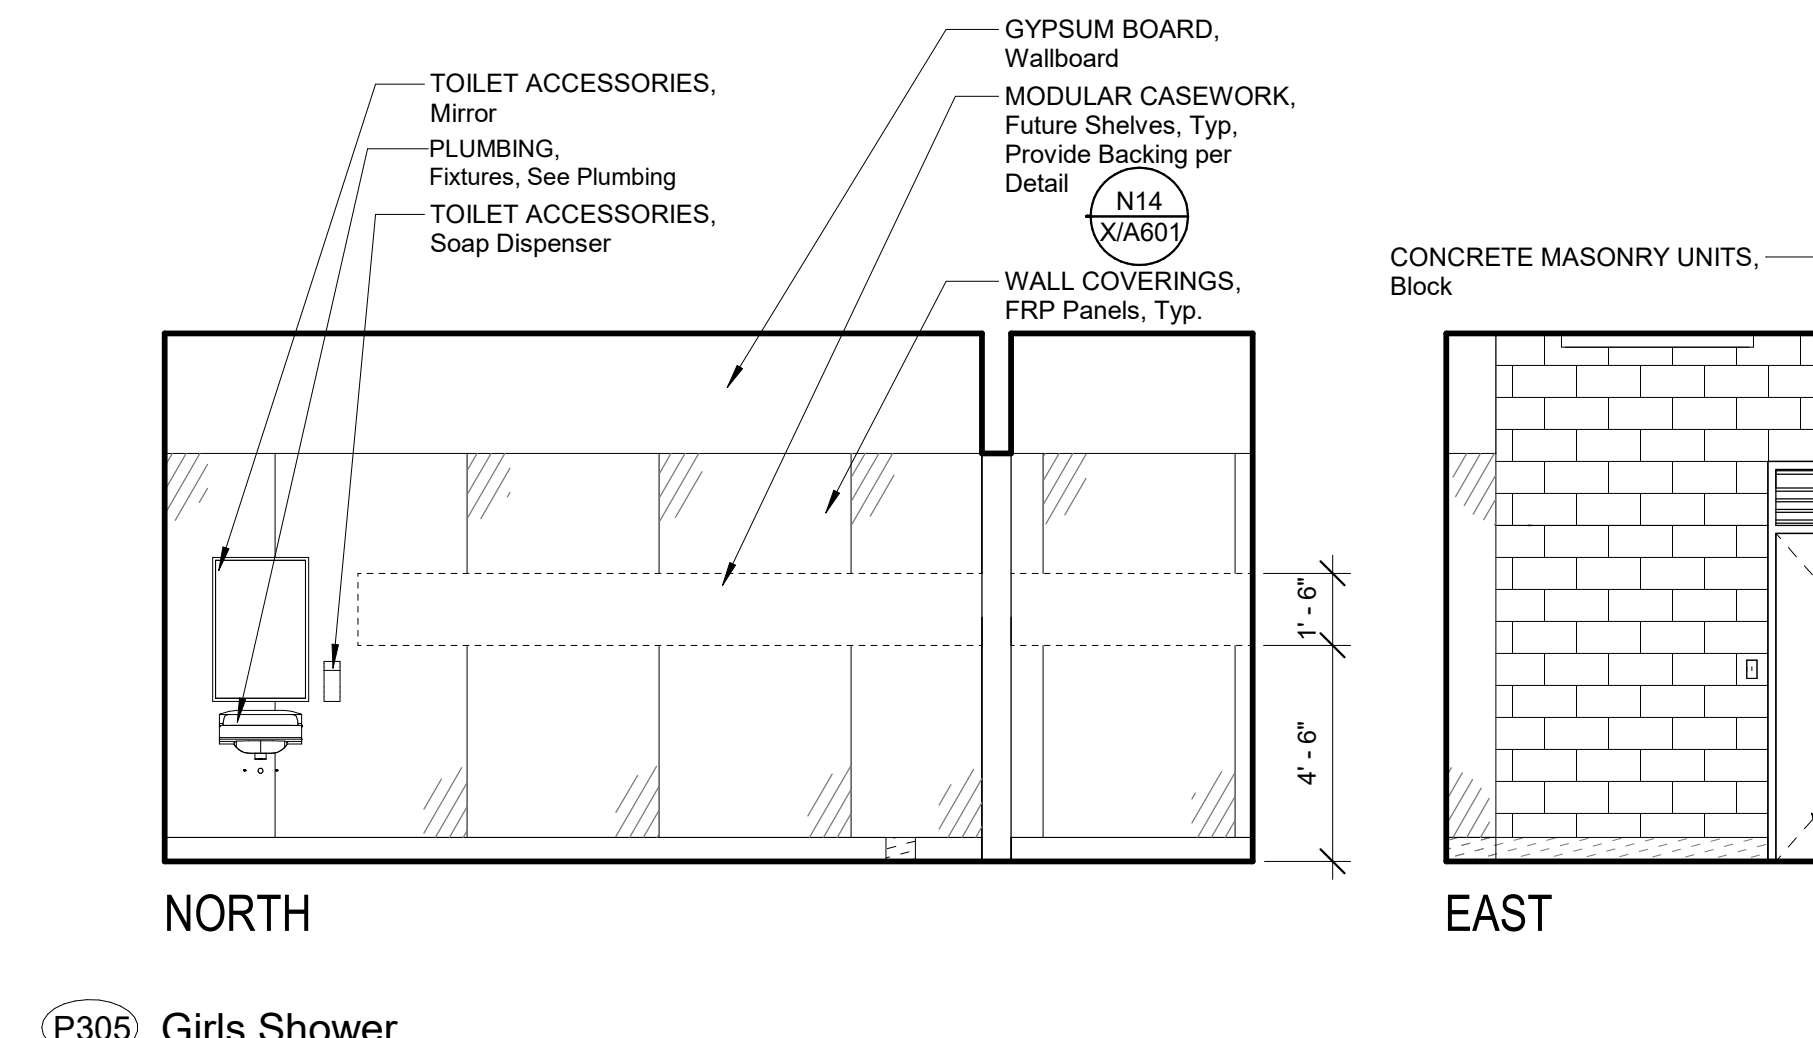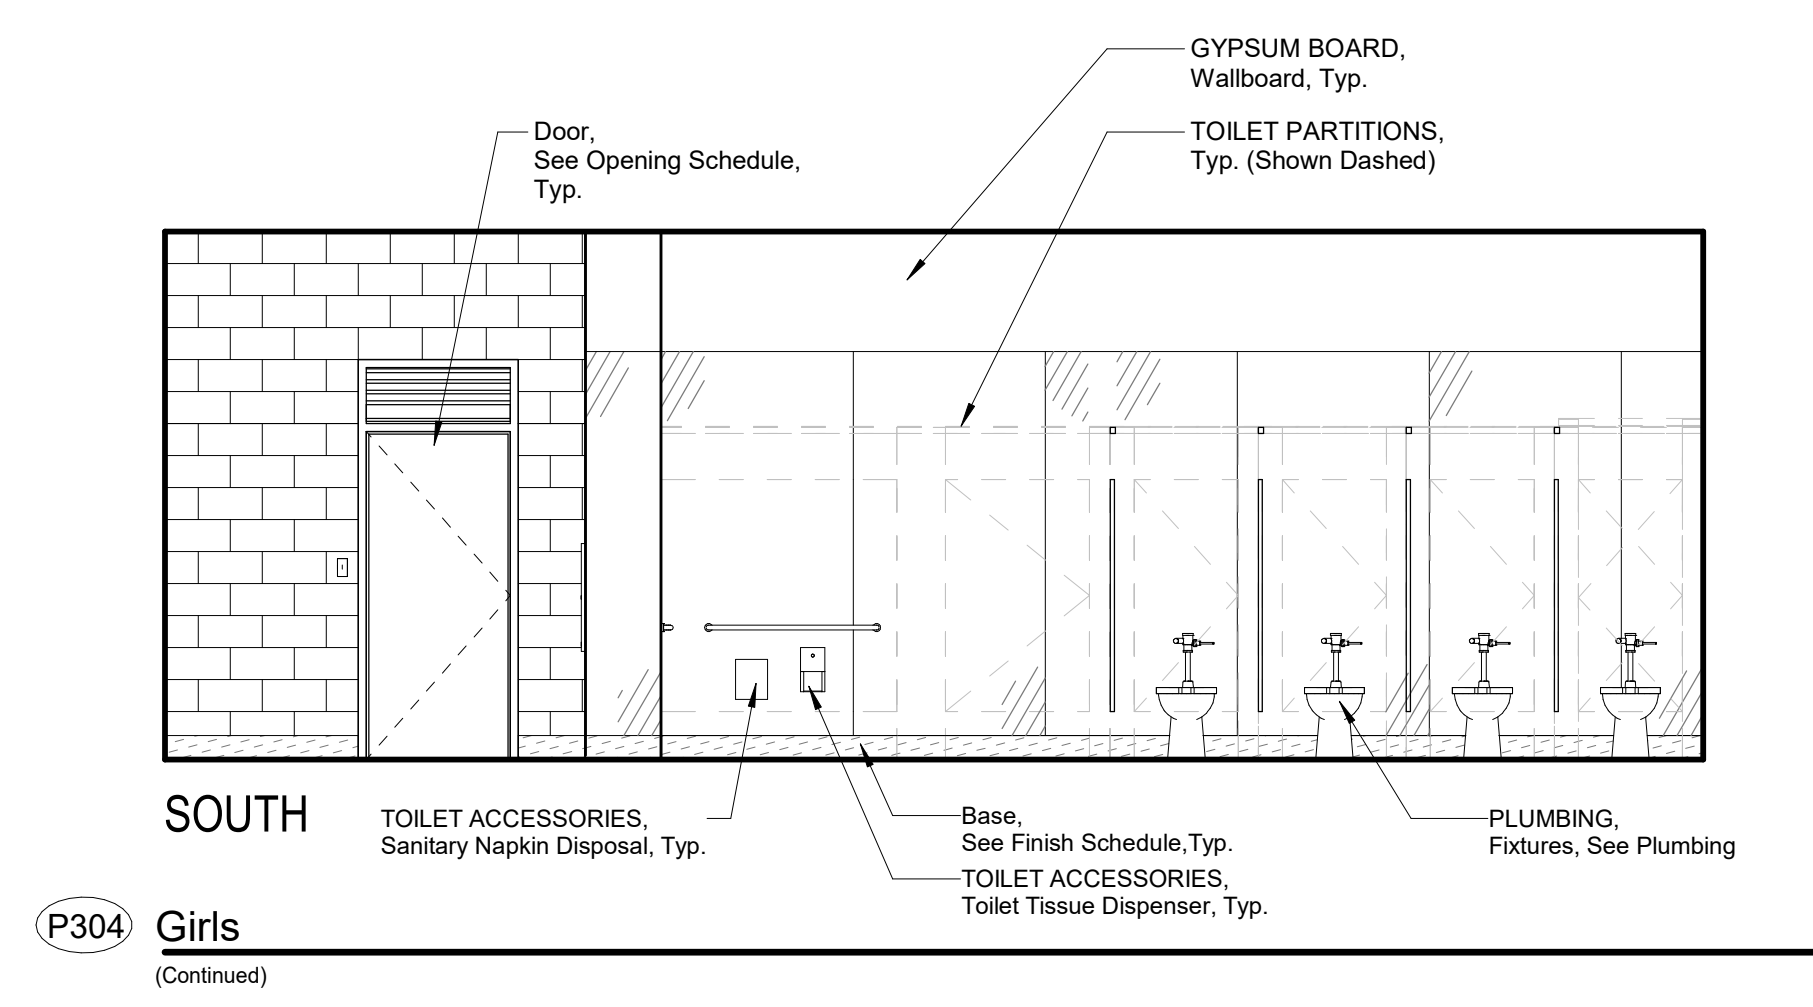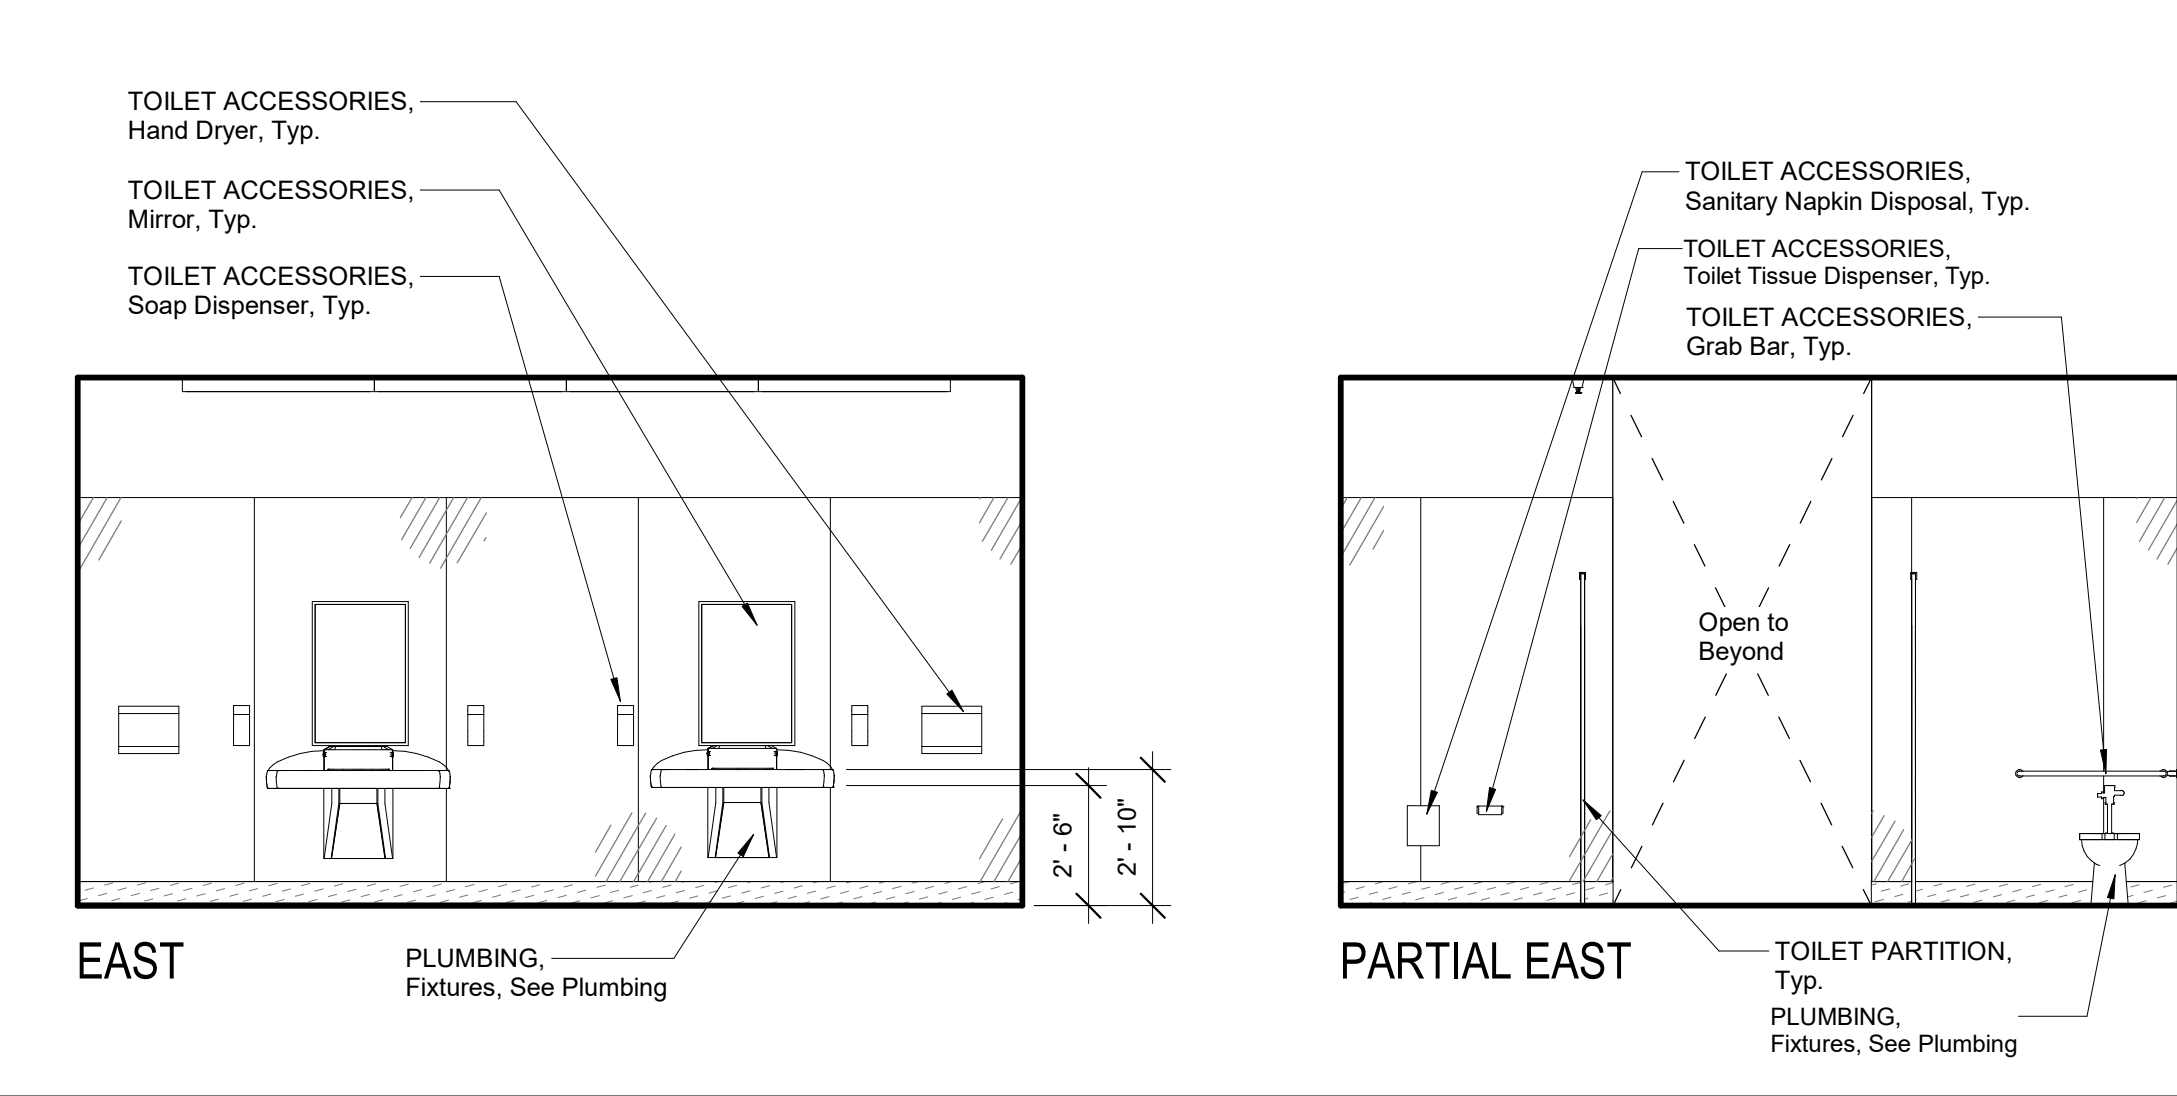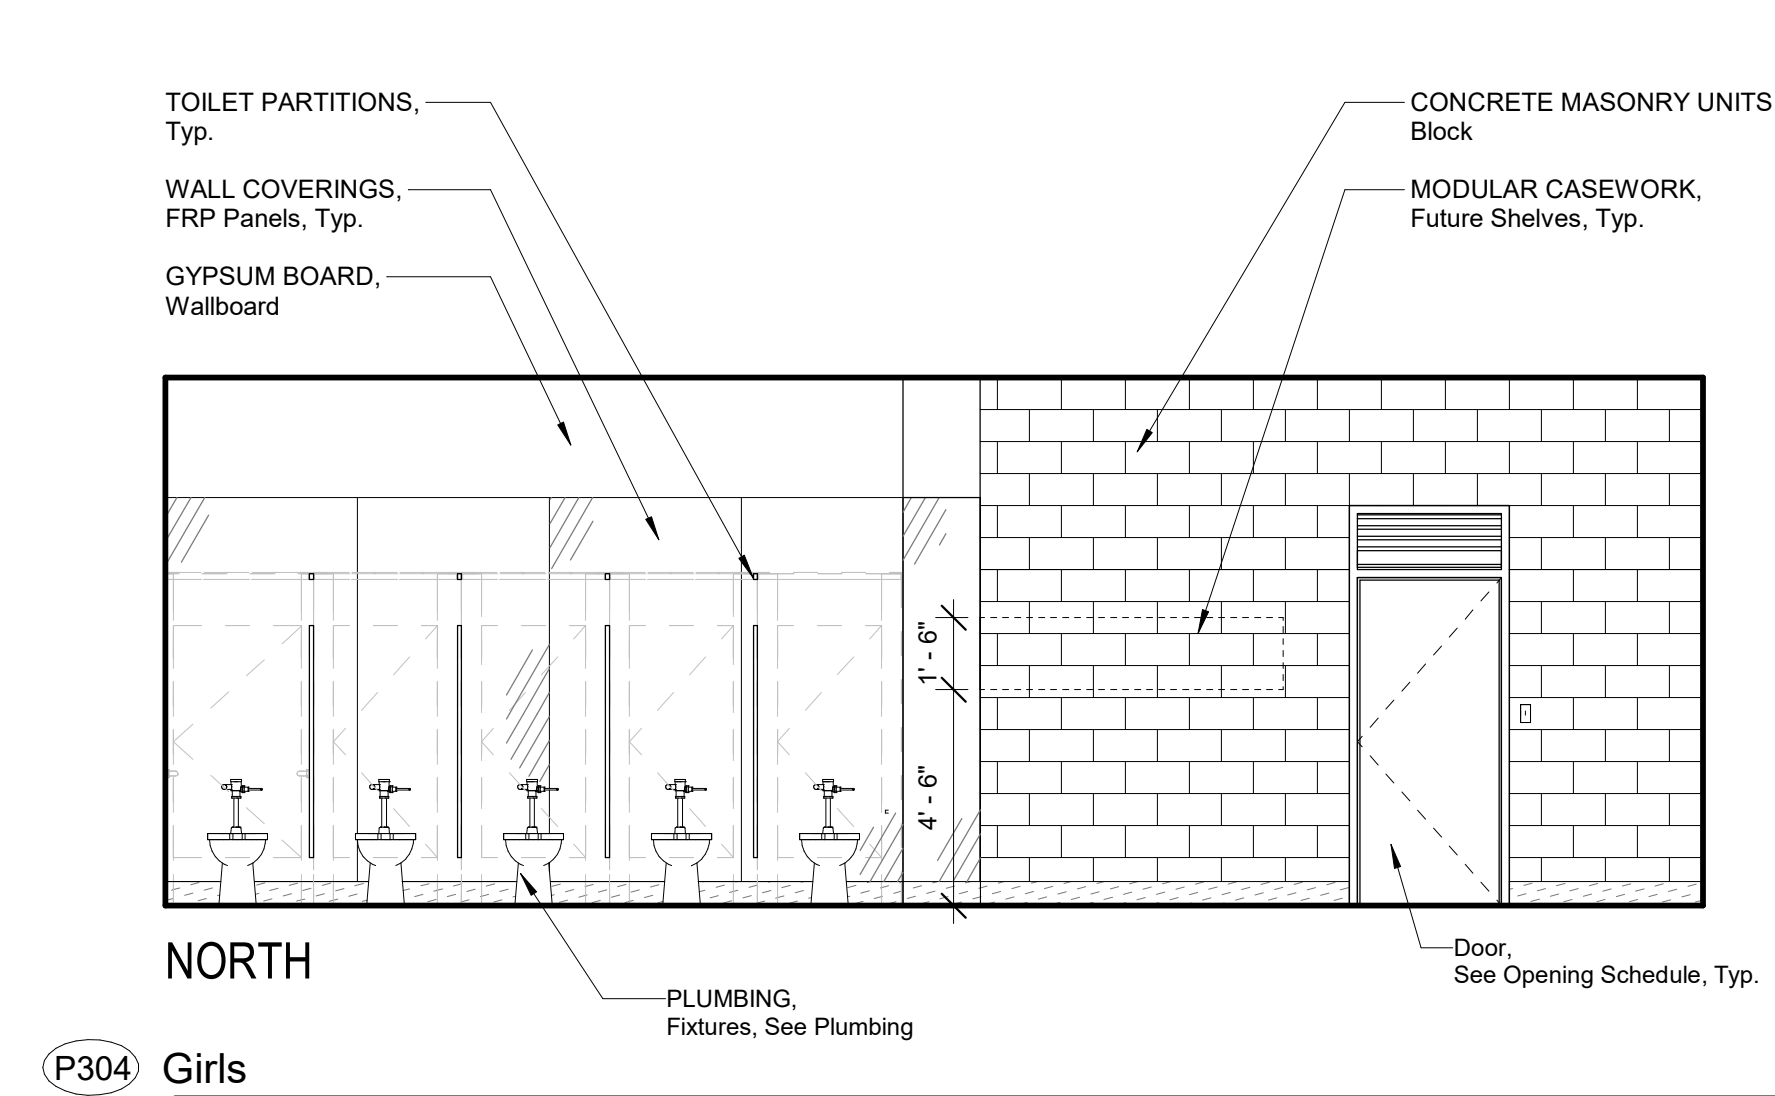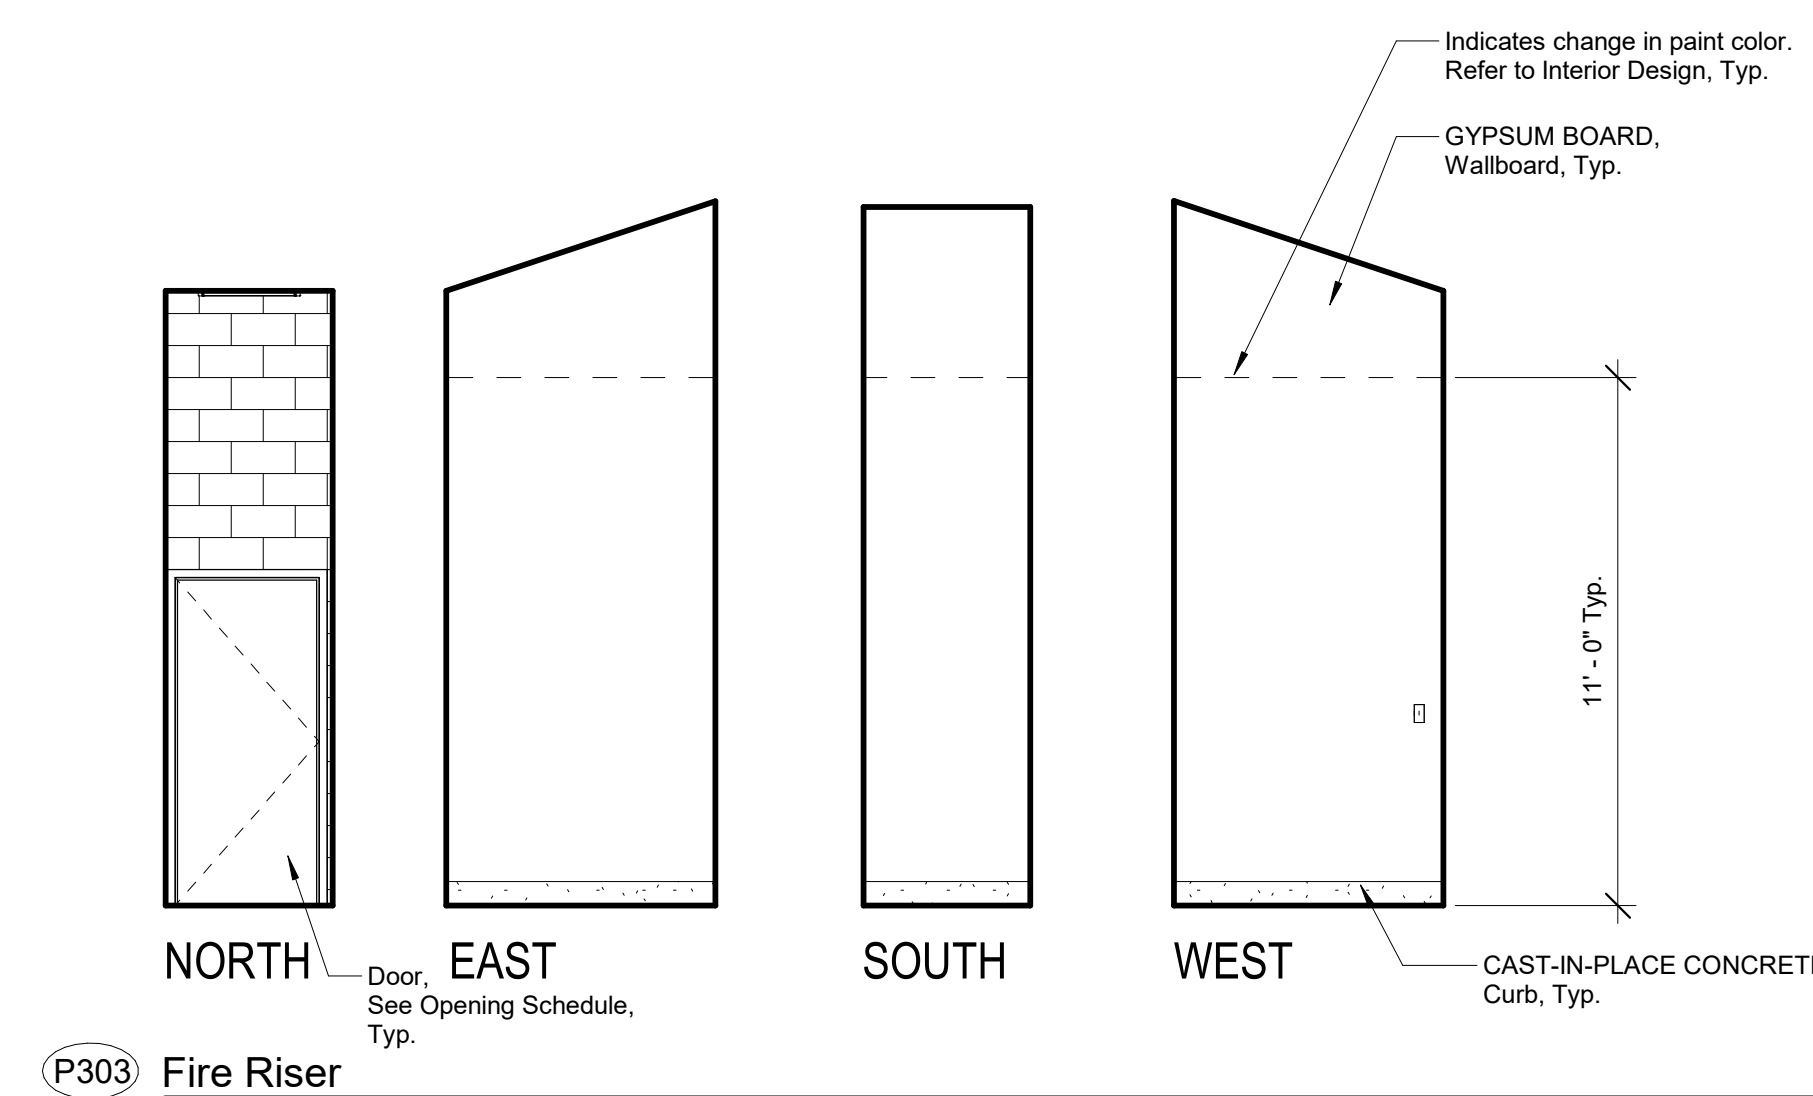

F18	Interior Elevation legend
No Scale	

Mission Oak HS Aquatic Complex
Tulare Joint Union High School District
Tulare, CA 93274 Project

BUILDING P3
INTERIOR ELEVATIONS - ROOMS P303 - P306
Drawing

darden architects ARCHITECTURE PLANNING INTERIORS
www.dardenarchitects.com
6790 N. West Ave. • Fresno, CA 93711 • T. 559.448.8051
Architect

No.	Revision/Submission	Date
1	REVISION_01	05/31/2023

Revision

Designed By: MF Copyright 2022 Darden Architects
Scale: 1/4" = 1'-0" Drawn By: KT
Project Number: 2180 Checked By: -
Date: 03/28/2023 Reviewed By: MF

P/A603

DSA File No.: 54-H11
 DSA Application No.: 02-120251
 Agency Approval


SYMBOLS

	FIRE PROTECTION SPECIALTIES, Fire Extinguisher Cabinet, Top of Cabinet @ +5'-0". Unless Noted Otherwise, Provide Fire Rated Cabinet at Rated Walls. See Detail N11 X/A602
	WALL COVERINGS, FRP Panels E14 X/A601
	WALL COVERINGS, Solid Surfacing A14 X/A601
	ROUGH CARPENTRY, Plywood Sheathing, AC
	PLUMBING, Access Door, See Plumbing Drawings
	ELECTRICAL, AV/Speaker @ +7'-6" to center of device, Unless Noted Otherwise.
	ELECTRICAL, Clock/Speaker @ +8'-6" to center of device, Unless Noted Otherwise.
	ELECTRICAL, Outlet
	ELECTRICAL, Light Switch
	ELECTRICAL, Fire Alarm Device
	ELECTRICAL, Volume Control
	ELECTRICAL, Television Outlet
	MECHANICAL, Thermostat
	PLUMBING, Hose Bib
	ELECTRICAL, Data Outlet
	ELECTRICAL, Microphone Outlet
	ELECTRICAL, Intrusion Sensor
	ELECTRICAL, Motion Sensor
	ELECTRICAL, Telephone Outlet
	ELECTRICAL, HDMI




ABBREVIATIONS

FEC	FIRE PROTECTION SPECIALTIES, Fire Extinguisher and Cabinet, Type FEC-1, Unless Noted Otherwise.
Gl.	Glass
KS	Knee Space
OH	Opposite Hand
Typ.	Typical
Sim.	Similar
Dia.	Diameter
UNO	Unless Noted Otherwise




- NOTES**
- All Details, Materials and Finishes Shall be Considered Typical for All Similar Conditions, Unless Noted Otherwise.
 - Refer to Plumbing, Mechanical, Telecommunications, Food Service, and Electrical for All Wall Mounted Devices and Coordinate Location and Heights with Architectural (ie. Casework, Equipment, etc.).
 - Locate and Mount TOILET ACCESSORIES and PLUMBING per Detail A7 X/A601 Unless Noted Otherwise.
 - Provide backing at all TOILET ACCESSORIES, TOILET PARTITIONS, and IDENTIFYING DEVICES per Detail N14 X/A601 Unless Noted Otherwise.
 - Provide Backing for TOILET ACCESSORIES, Grab Bars per Detail J11 X/A601
 - Locate and mount IDENTIFYING DEVICES per Detail E1 X/A601 Unless Noted Otherwise.
 - Provide backing at all MODULAR CASEWORK per Detail N14 X/A601
 - WALL COVERINGS, FRP Panels, See Detail E14 X/A601
 - GYPSUM BOARD, Metal Accessories, See Detail J14 X/A601

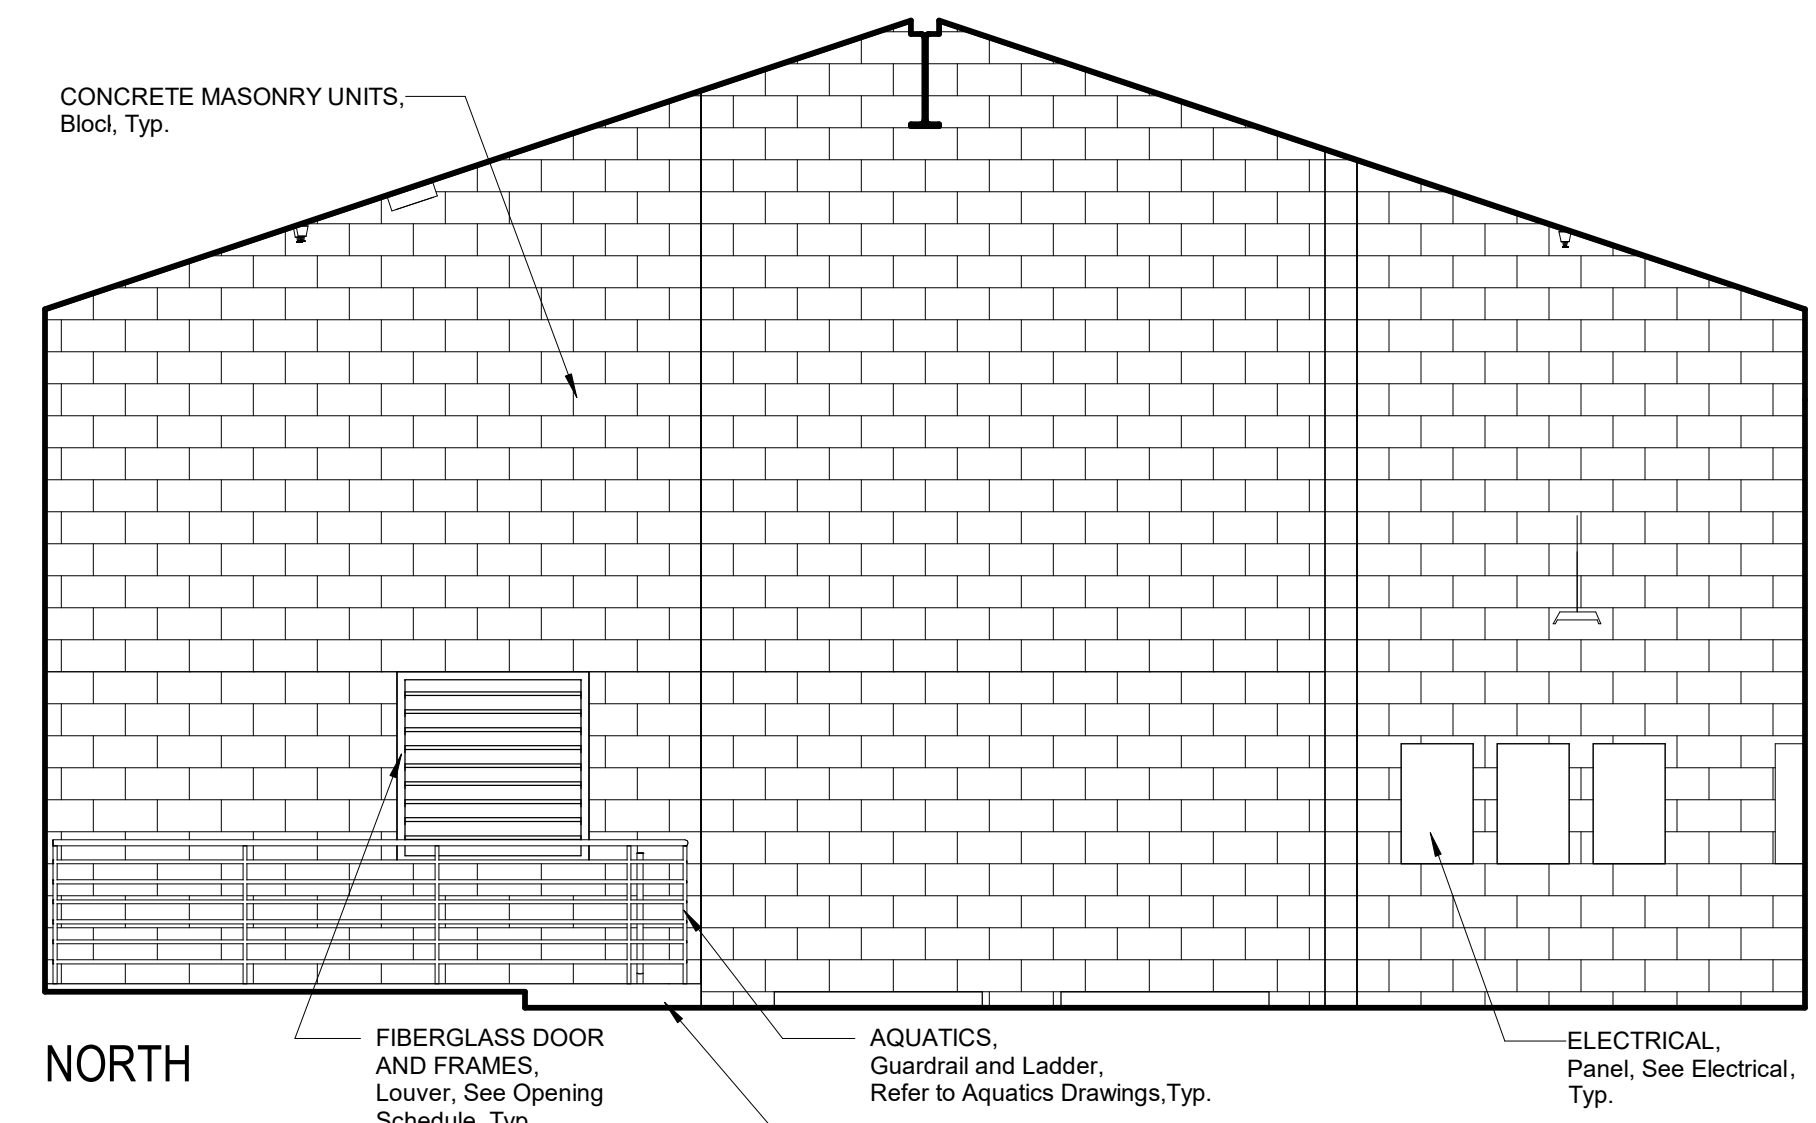


P401 Pool Equipment

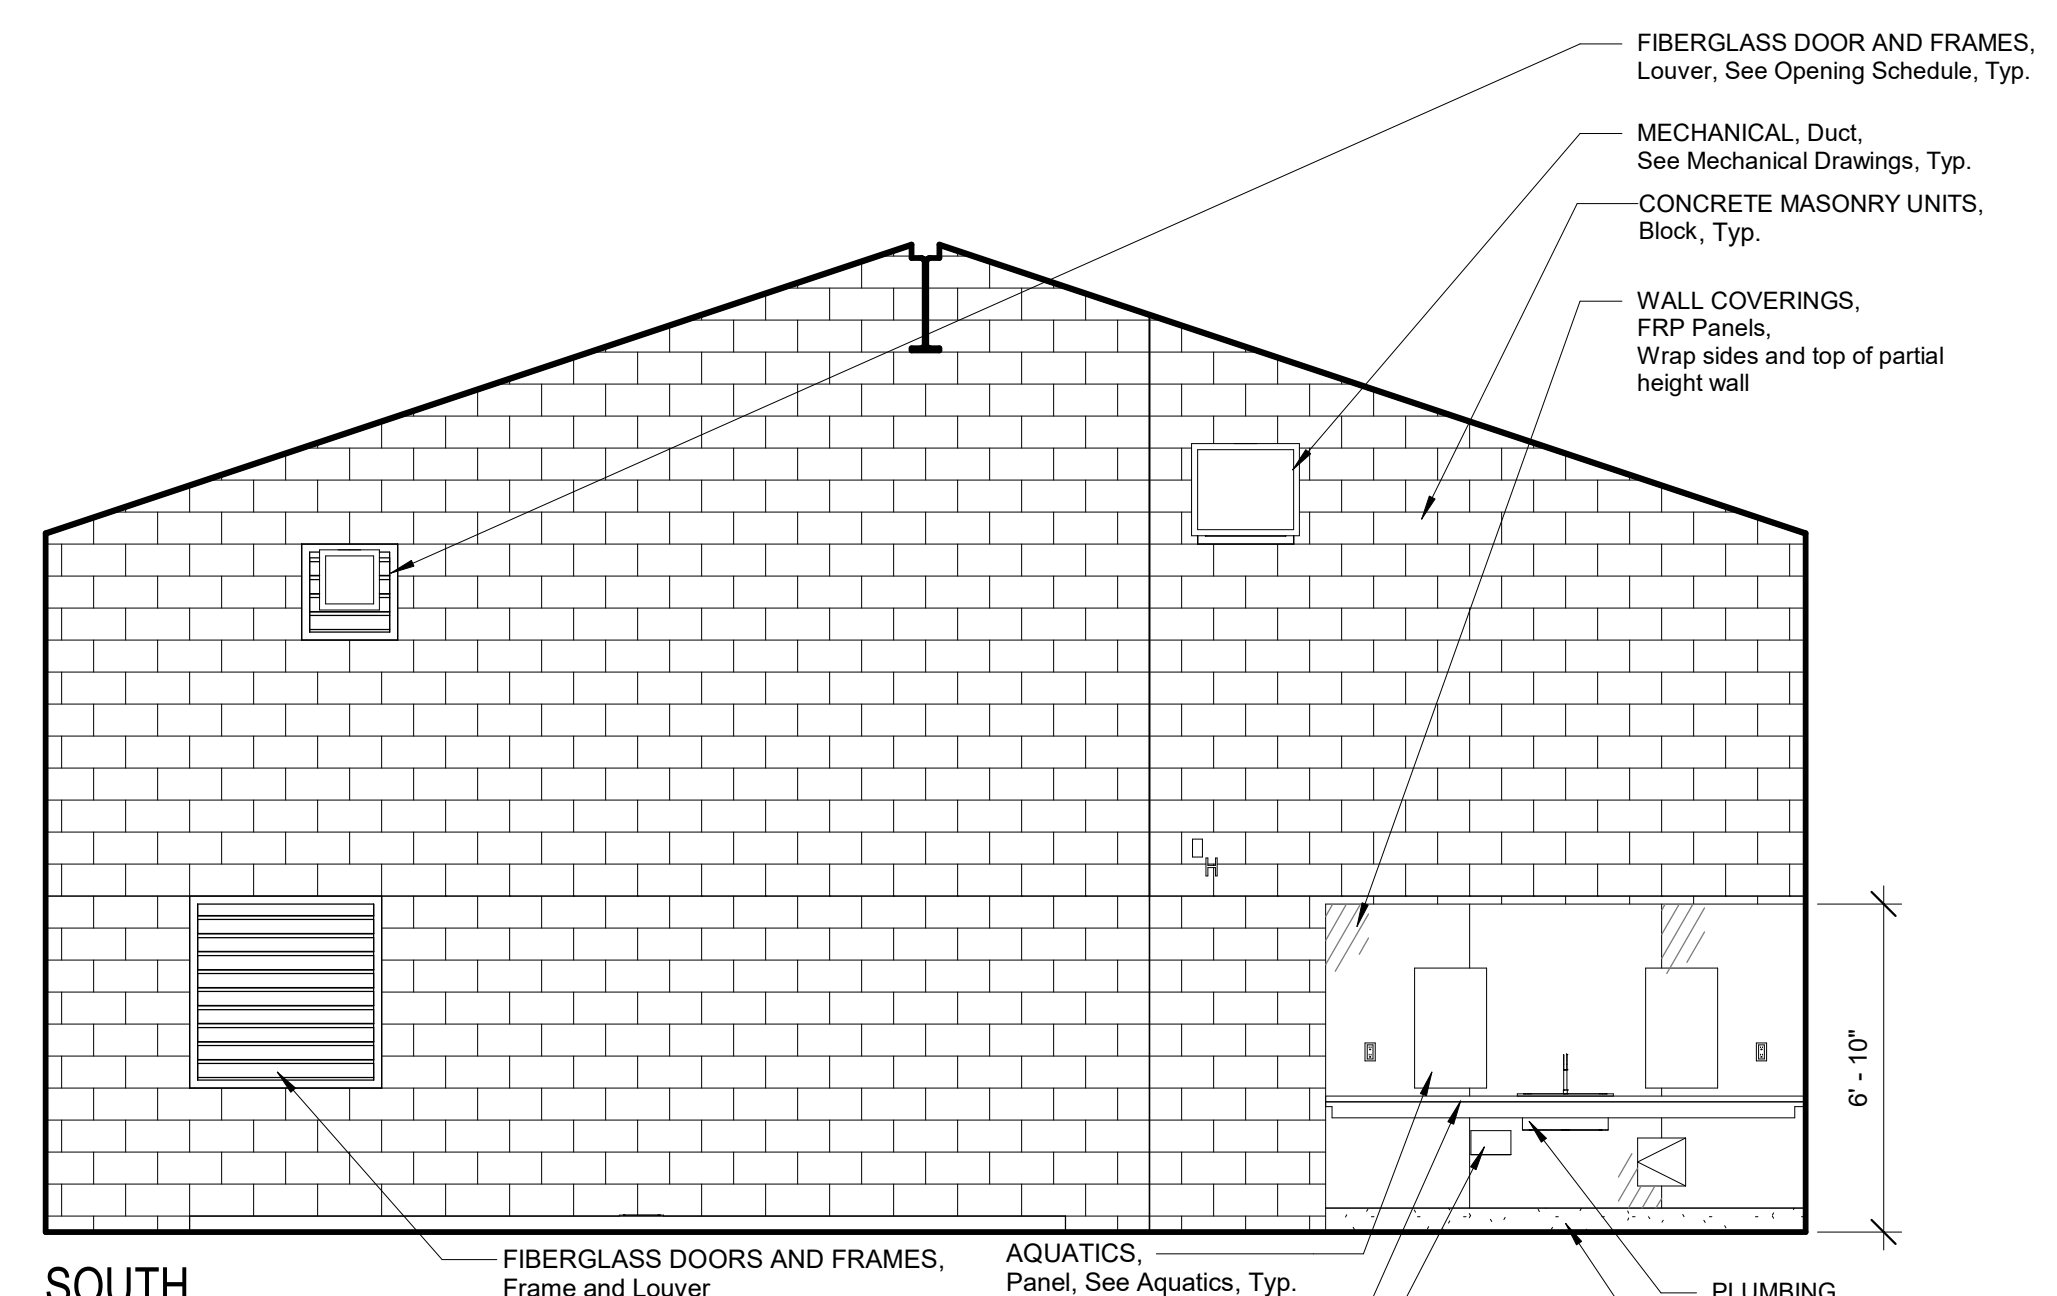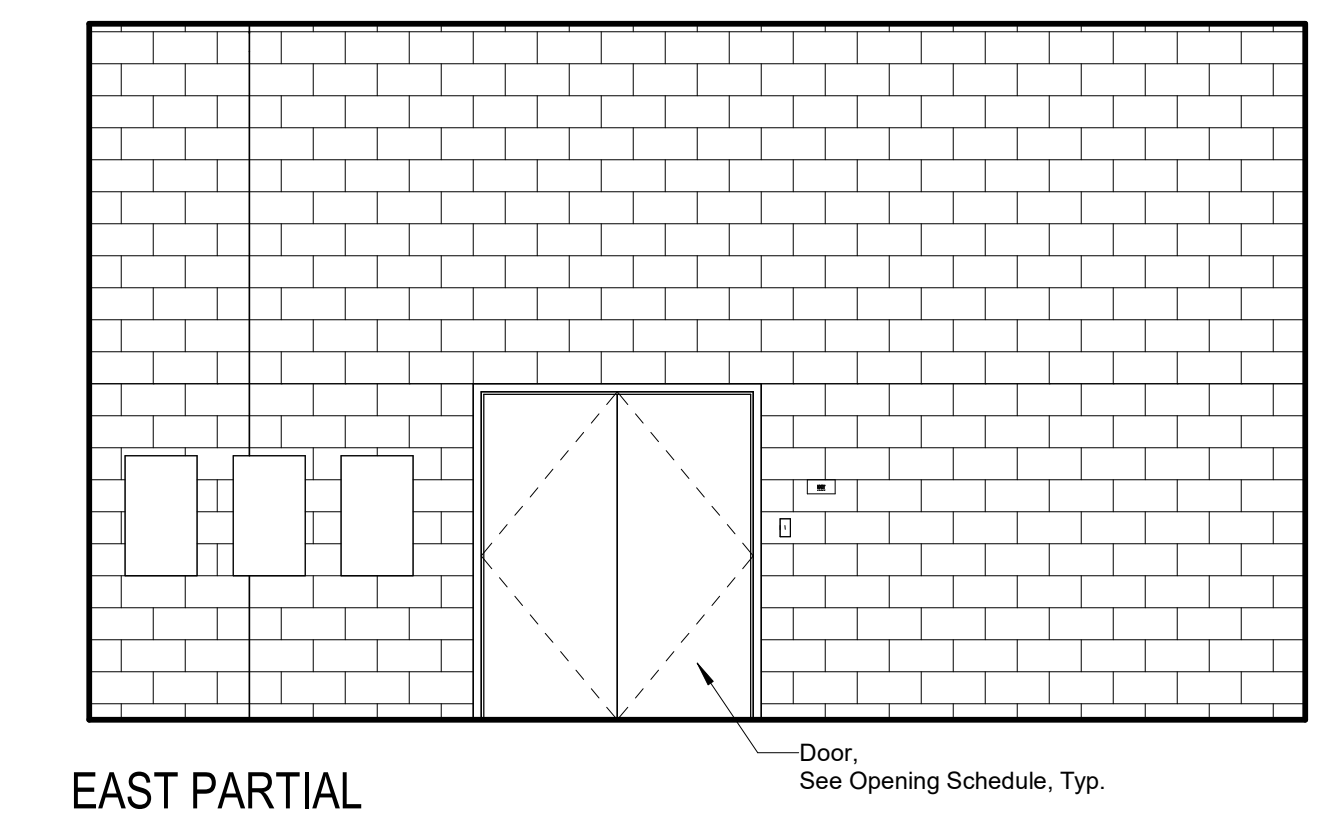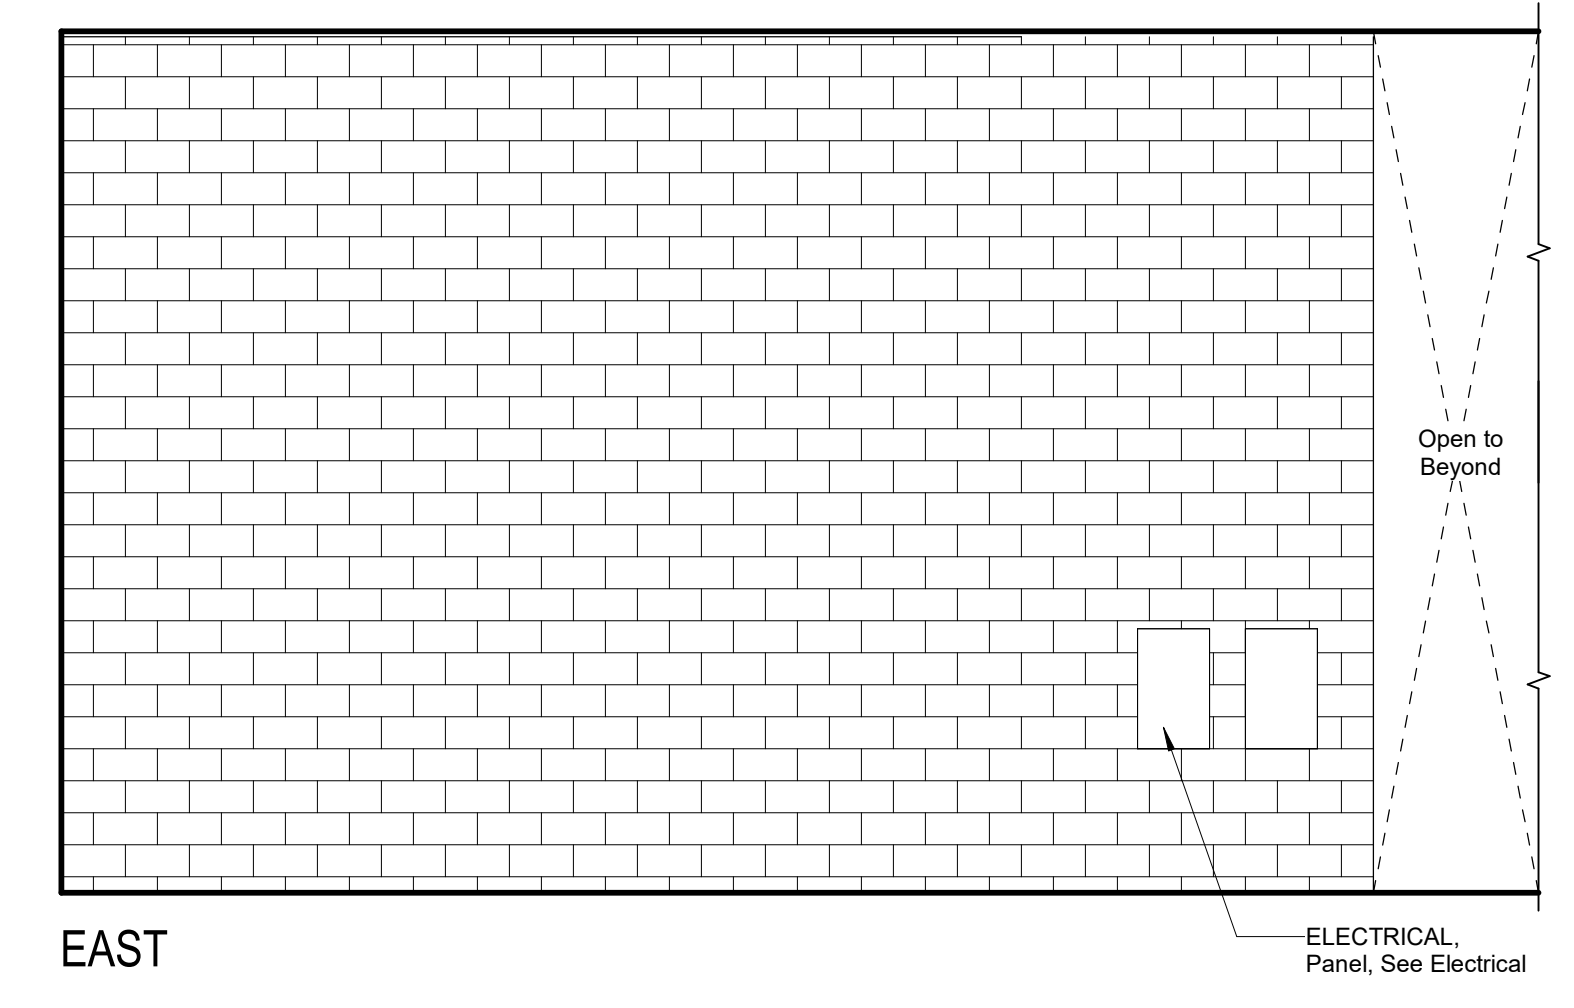

P401 Pool Equipment (Continued)

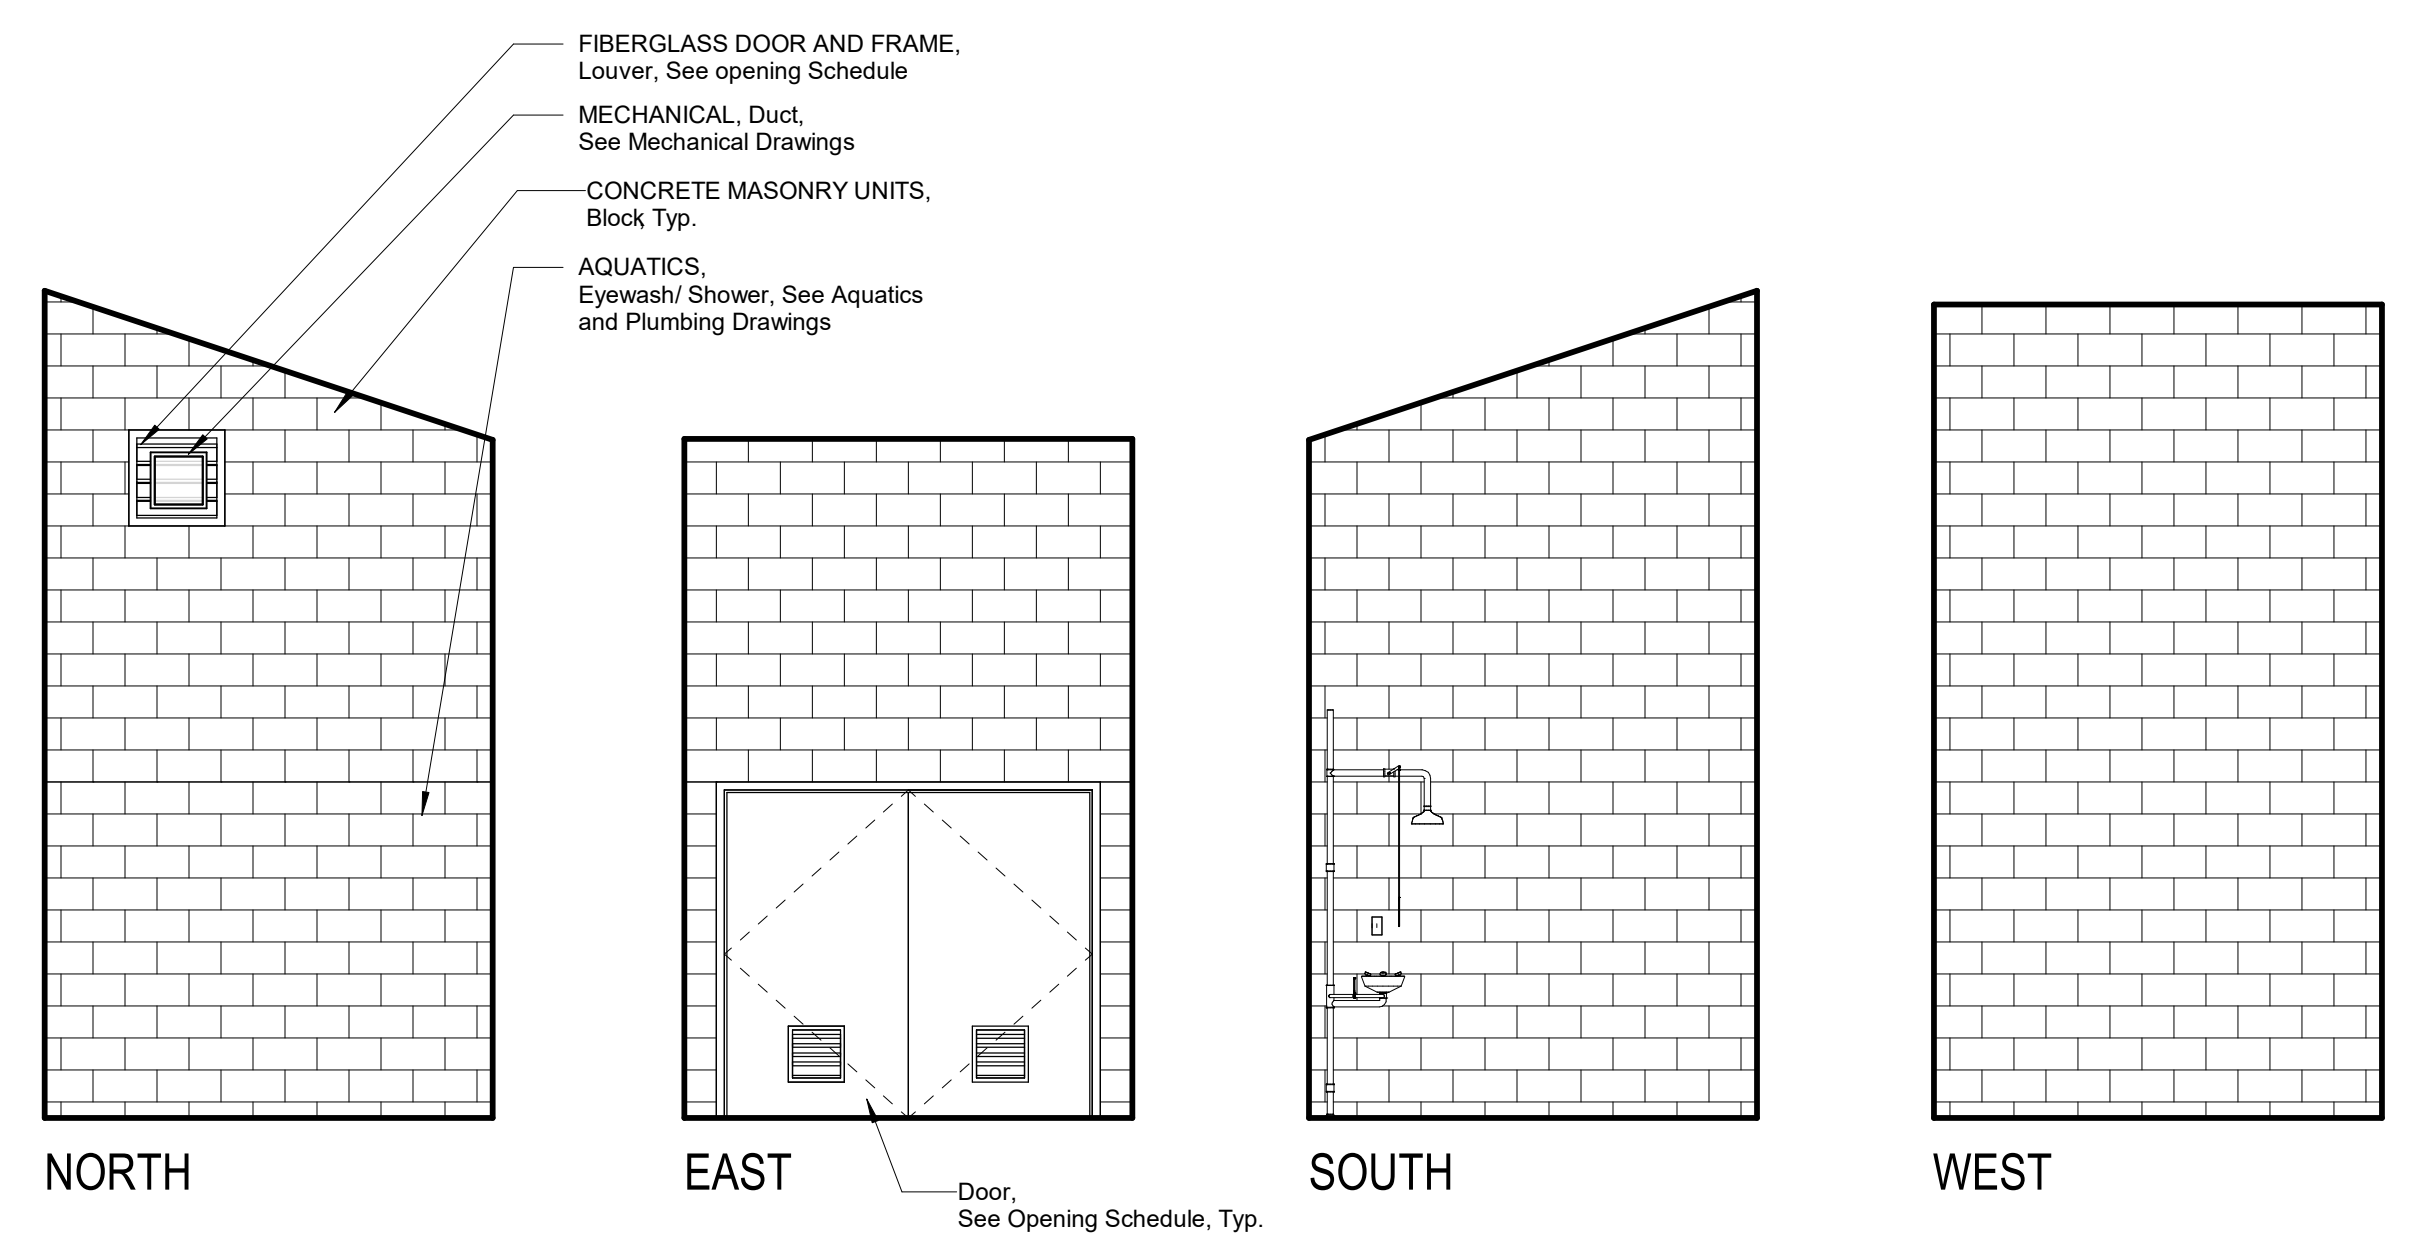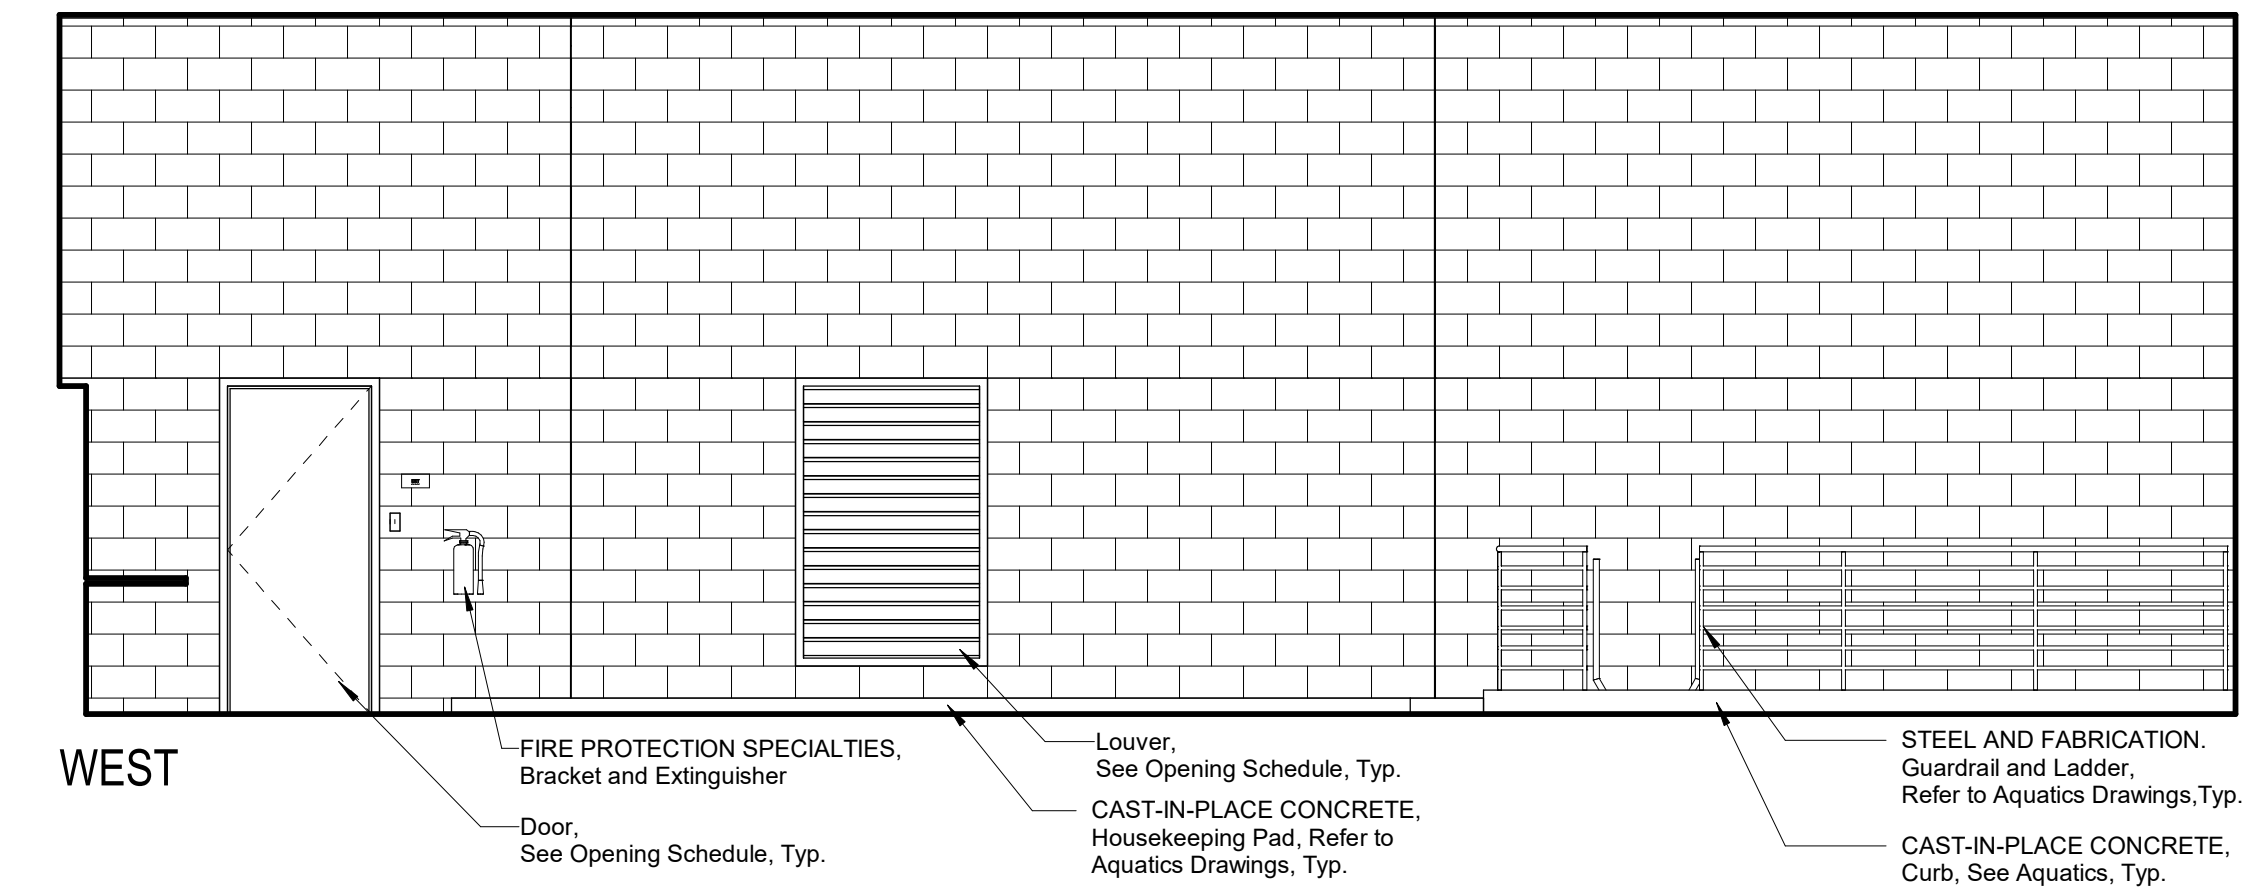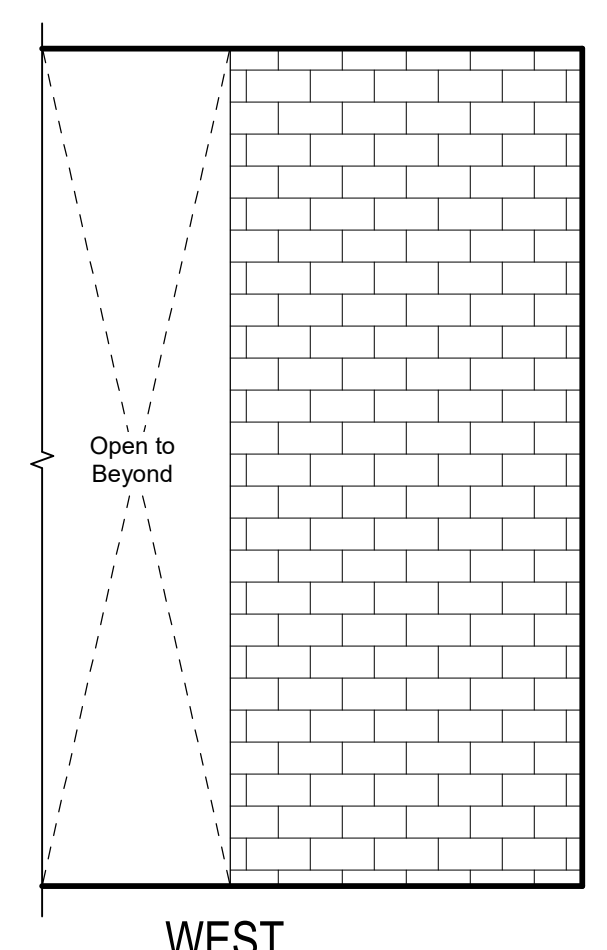

P402 Acid

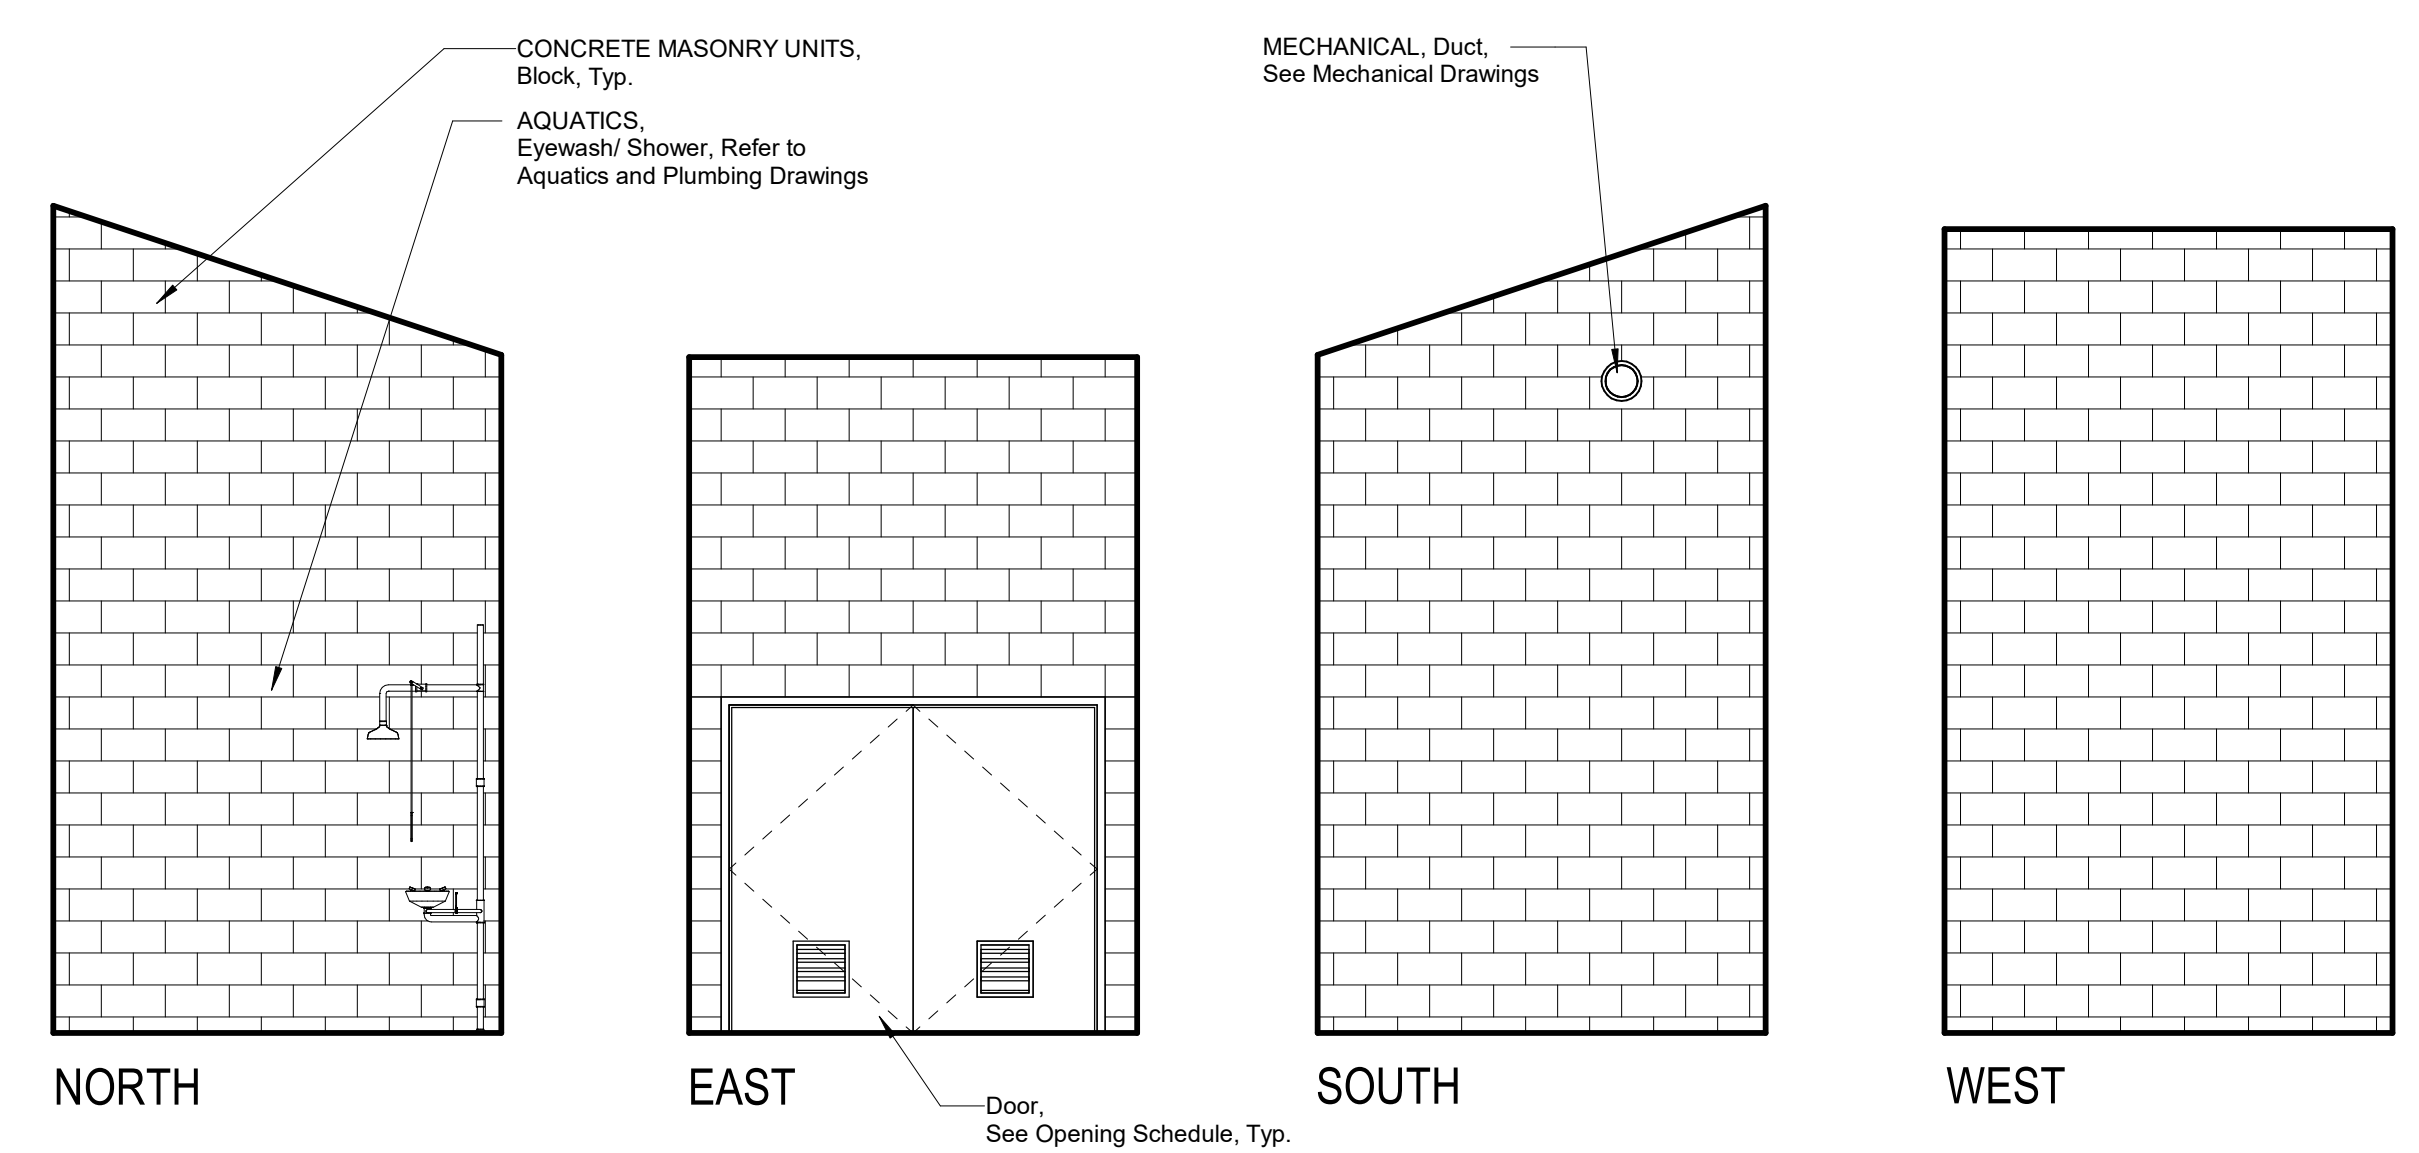

P403 Chlorine

F18 Interior Elevation legend

No Scale

Mission Oak HS Aquatic Complex
 Tulare Joint Union High School District
 Tulare, CA 93274 Project

BUILDING P4
 INTERIOR ELEVATIONS - ROOMS P401 - P403
 Drawing

ARCHITECTURE PLANNING INTERIORS
 darden architects
 www.dardenarchitects.com
 6790 N. West Ave. • Fresno, CA 93711 • T. 559.448.8051


ARCHITECT
 No. C23724
 STATE OF CALIFORNIA

No.	Revision/Submission	Date
1	REVISION_01	05/31/2023


Revision

Designed By: MF	Copyright 2022 Darden Architects
Scale: 1/4" = 1'-0"	Drawn By: KT
Project Number: 2180	Checked By: -
Date: 03/28/2023	Reviewed By: MF


P/A604

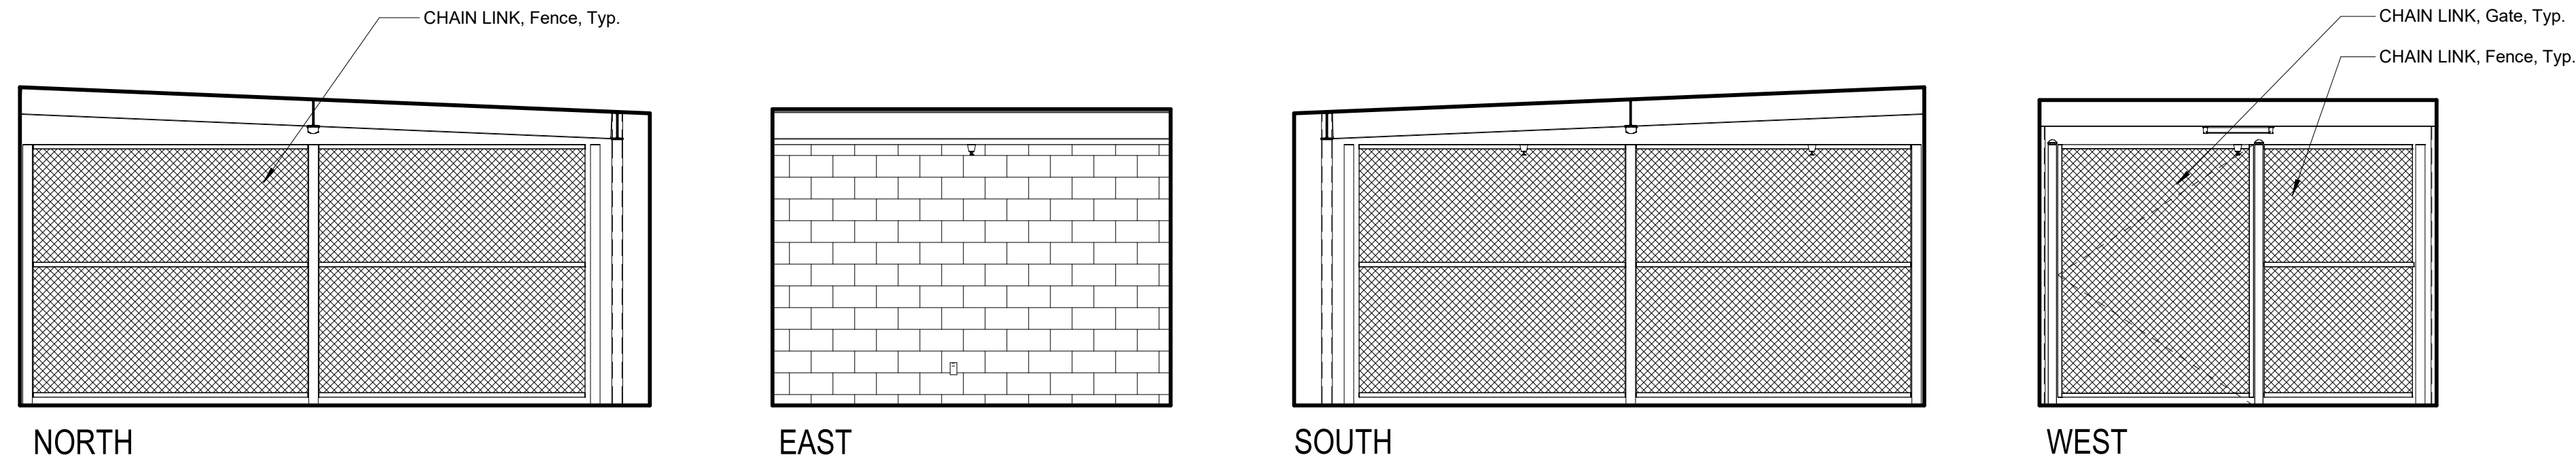


P404b Storage

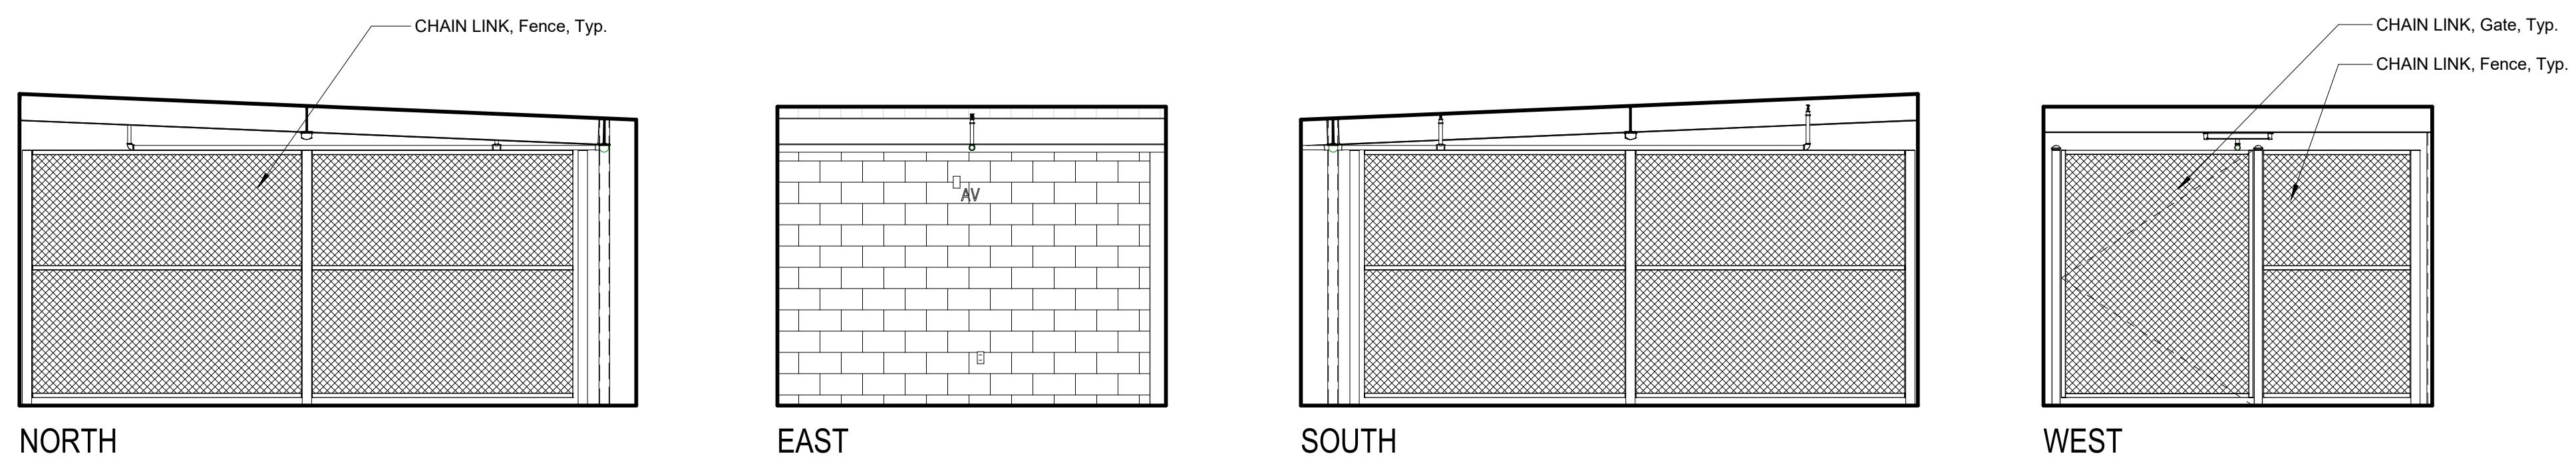

P404c Storage

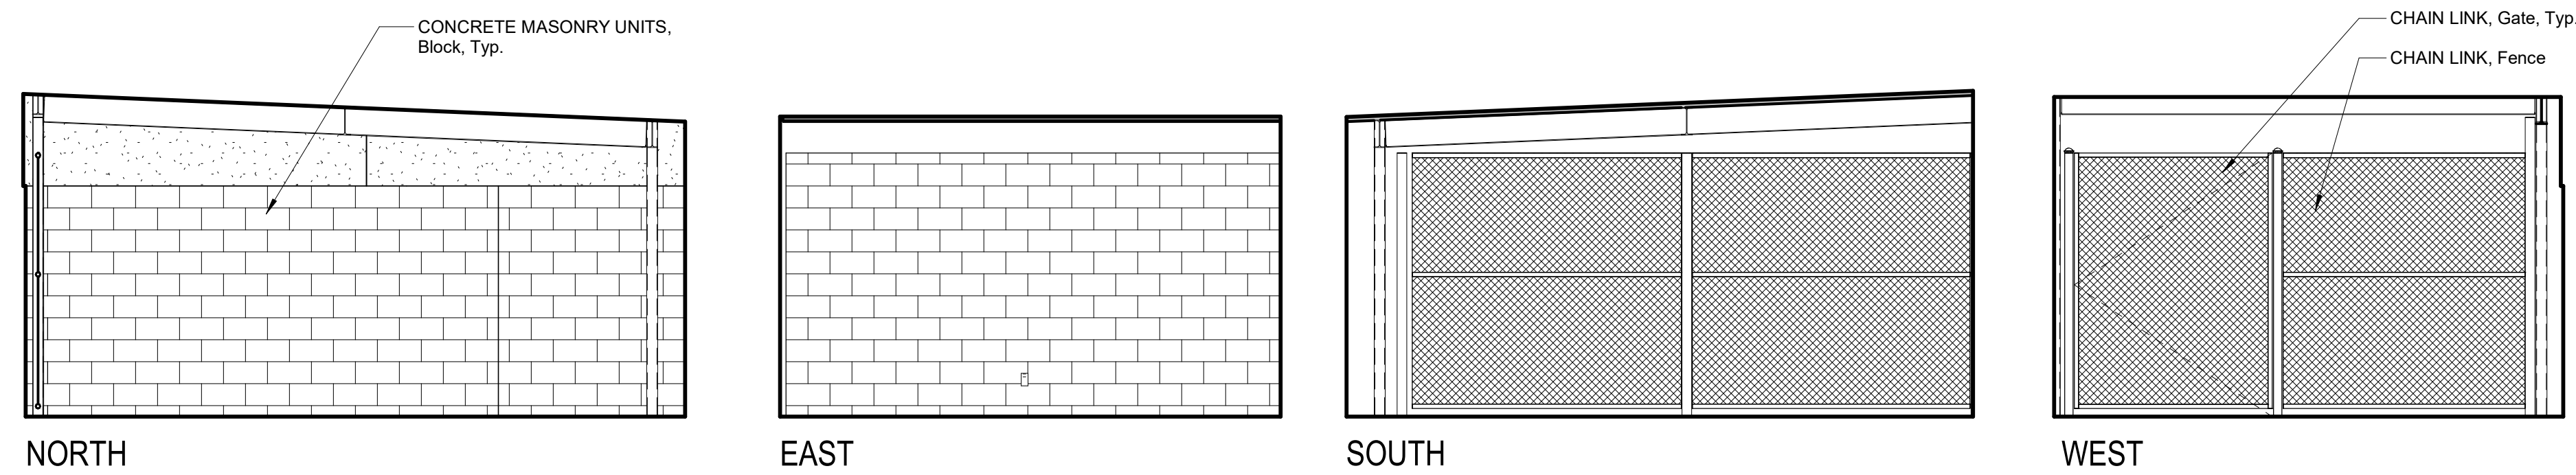

P404a Storage

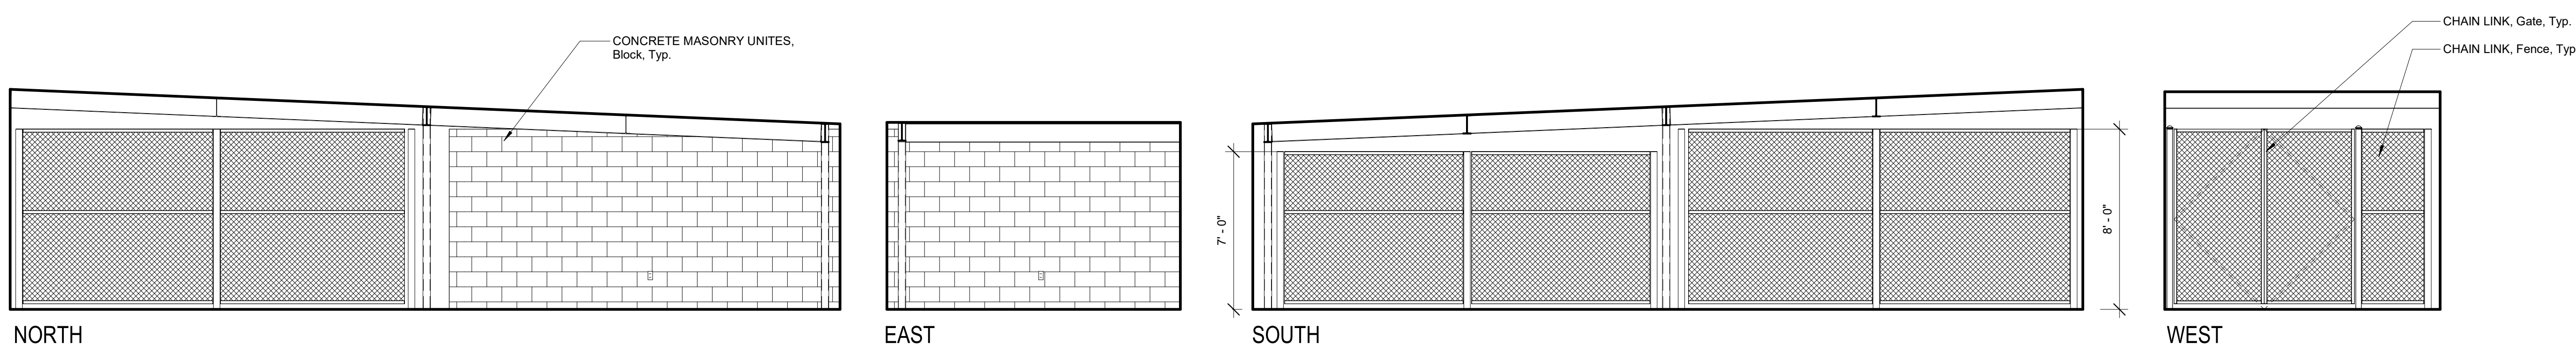

P404d Storage

DSA File No.: 54-H11

DSA Application No.: 02-120251

Agency Approval

SYMBOLS

	Cabinet Group No. Refer to Modular Casework Schedule and Lab Casework Schedule.
	FIRE PROTECTION SPECIALTIES, Fire Extinguisher Cabinet, Top of Cabinet @ +5'-0". Unless Noted Otherwise, Provide Fire Rated Cabinet at Rated Walls. See Detail
	WALL COVERINGS, FRP Panels
	WALL COVERINGS, Solid Surfacing
	ROUGH CARPENTRY, Plywood Sheathing, AC
	PLUMBING, Access Door, See Plumbing Drawings
	ELECTRICAL, AV/Speaker @ +7'-6" to center of device. Unless Noted Otherwise.
	ELECTRICAL, Clock/Speaker @ +8'-6" to center of device. Unless Noted Otherwise.
	ELECTRICAL, Outlet
	ELECTRICAL, Light Switch
	ELECTRICAL, Fire Alarm Device
	ELECTRICAL, Volume Control
	ELECTRICAL, Television Outlet
	MECHANICAL, Thermostat
	PLUMBING, Hose Bib
	ELECTRICAL, Data Outlet
	ELECTRICAL, Microphone Outlet
	ELECTRICAL, Intrusion Sensor
	ELECTRICAL, Motion Sensor
	ELECTRICAL, Telephone Outlet
	ELECTRICAL, HDMI

ABBREVIATIONS

FEC	FIRE PROTECTION SPECIALTIES, Fire Extinguisher and Cabinet, Type FEC-1, Unless Noted Otherwise.
GL	Glass
KS	Knee Space
OH	Opposite Hand
Typ.	Typical
Sim.	Similar
Dia.	Diameter
UNO	Unless Noted Otherwise

- NOTES**
- All Details, Materials and Finishes Shall be Considered Typical for All Similar Conditions, Unless Noted Otherwise.
 - Refer to Plumbing, Mechanical, Telecommunications, Food Service, and Electrical for All Wall Mounted Devices and Coordinate Location and Heights with Architectural (ie. Casework, Equipment, etc.).
 - Locate and Mount TOILET ACCESSORIES and PLUMBING per Detail Unless Noted Otherwise.
 - Provide backing at all TOILET ACCESSORIES, TOILET PARTITIONS, and IDENTIFYING DEVICES per Detail Unless Noted Otherwise.
 - Provide Backing for TOILET ACCESSORIES, Grab Bars per Detail
 - Locate and mount IDENTIFYING DEVICES per Detail Unless Noted Otherwise.
 - Provide backing at all MODULAR CASEWORK per Detail
 - WALL COVERINGS, FRP Panels, See Detail
 - GYPSUM BOARD, Metal Accessories, See Detail

F18 Interior Elevation legend
No Scale


Consultant
Mission Oak HS Aquatic Complex
Tulare Joint Union High School District
Tulare, CA 93274
Project
BUILDING P
INTERIOR ELEVATIONS - ROOMS P404a - P404d
Drawing

darden architects ARCHITECTURE PLANNING INTERIORS
www.dardenarchitects.com
6790 N. West Ave. • Fresno, CA 93711 • T. 559.448.8051
Architect


No.	Revision/Submission	Date
1	REVISION_01	05/31/2023

Revision
Designed By: MF
Copyright 2022 Darden Architects
Scale: 1/4" = 1'-0"
Drawn By: KT
Project Number: 2180
Checked By: -
Date: 03/28/2023
Reviewed By: MF
Sheet: **P/A605**


DSA File No.: 54-H11
 DSA Application No.: 02-120251
 Agency Approval

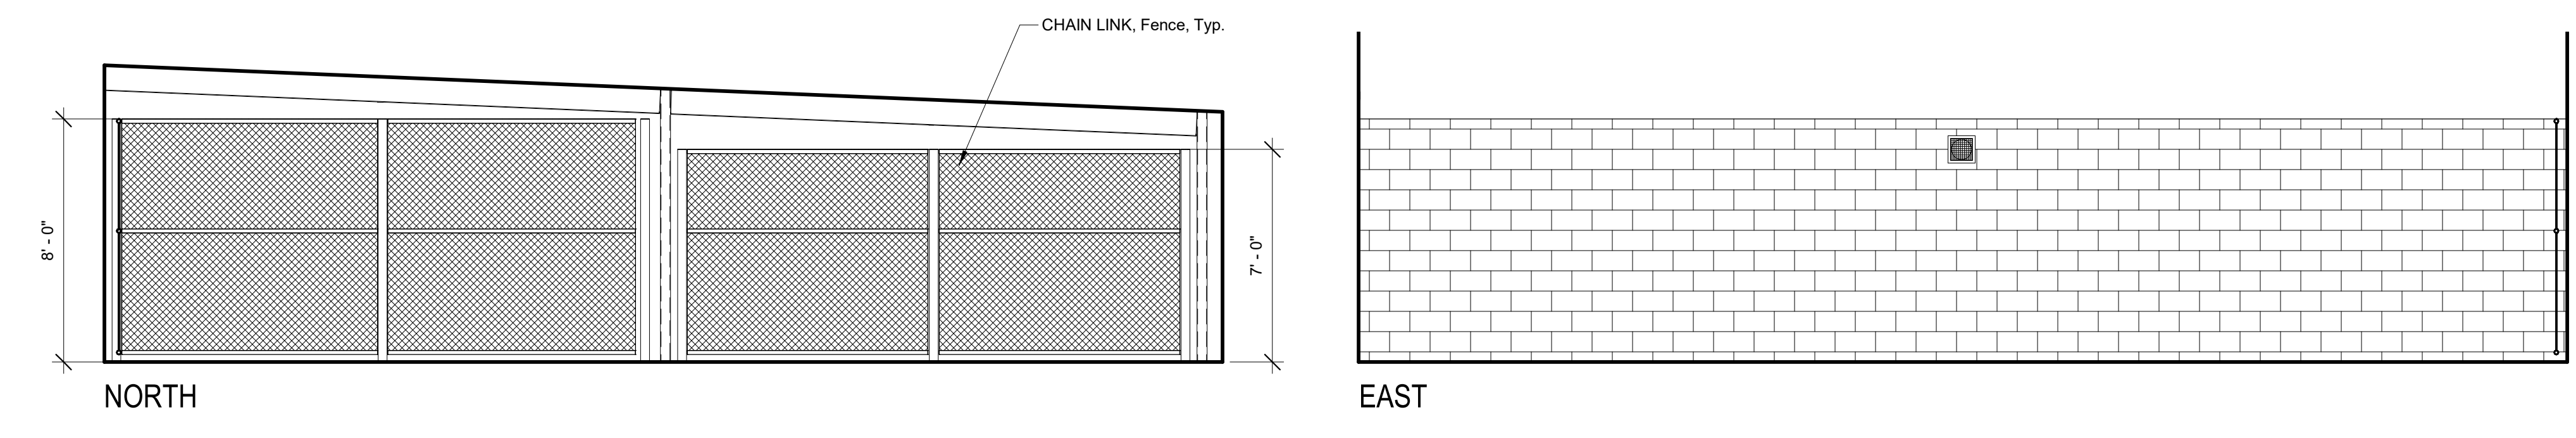


P404a Storage

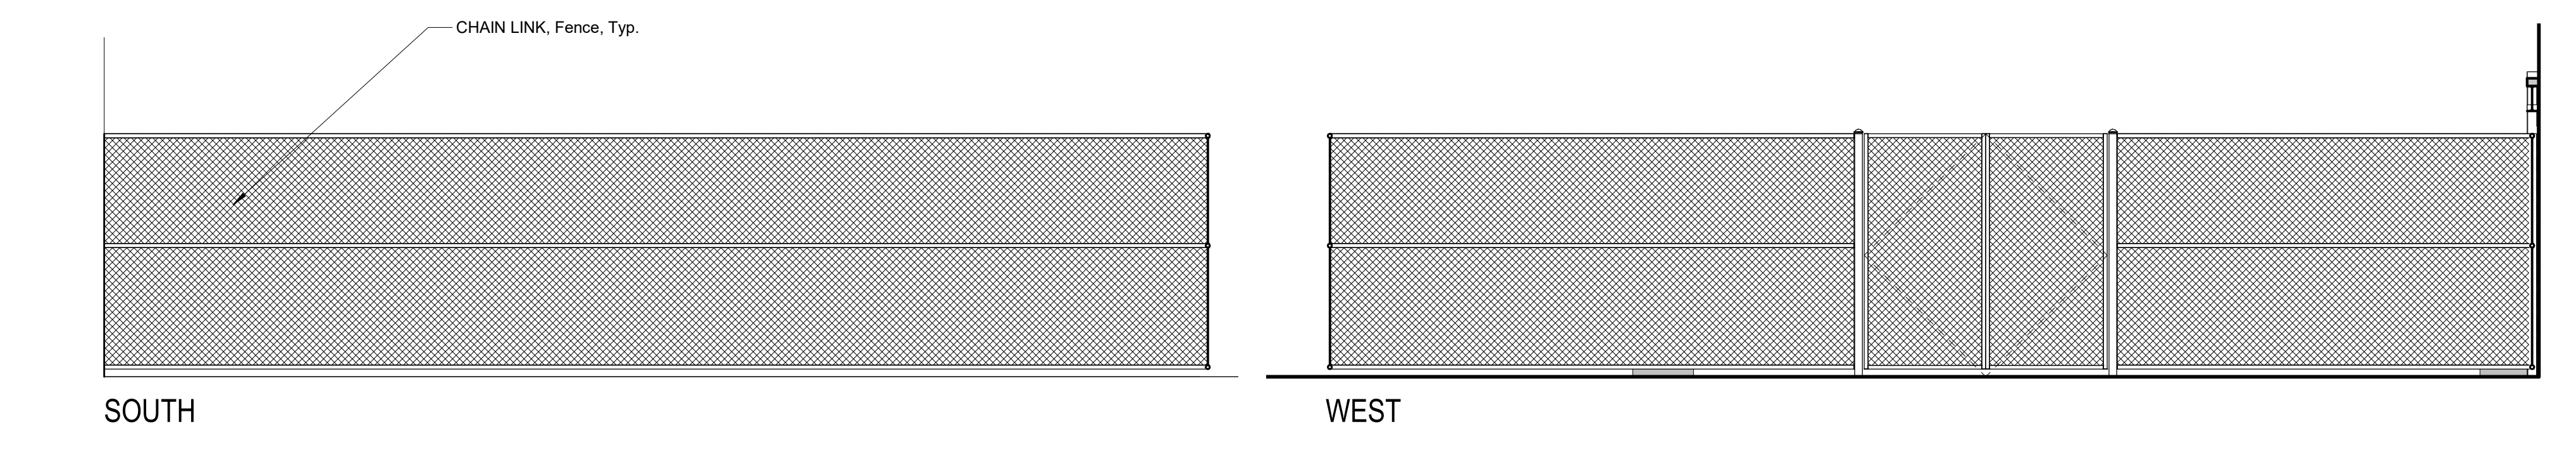

P404a Storage
(Continued)

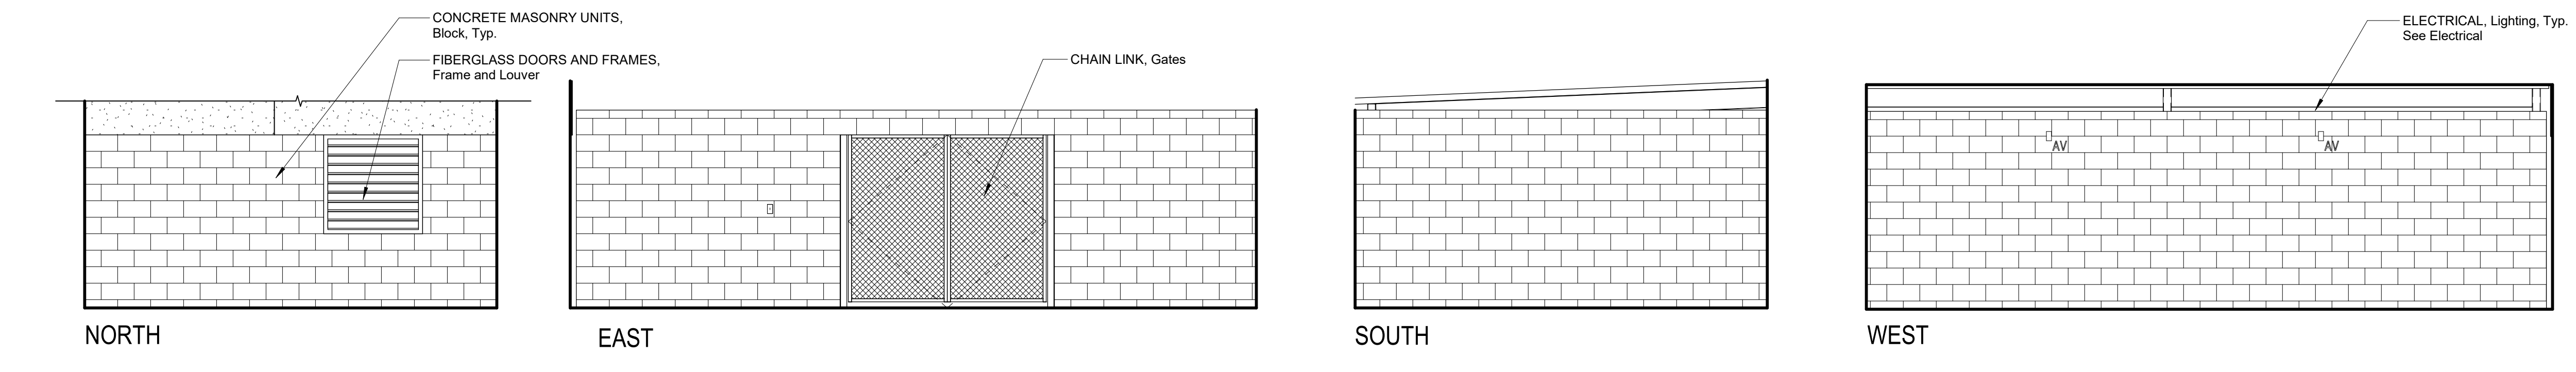

P410 Pool Equipment Enclosure

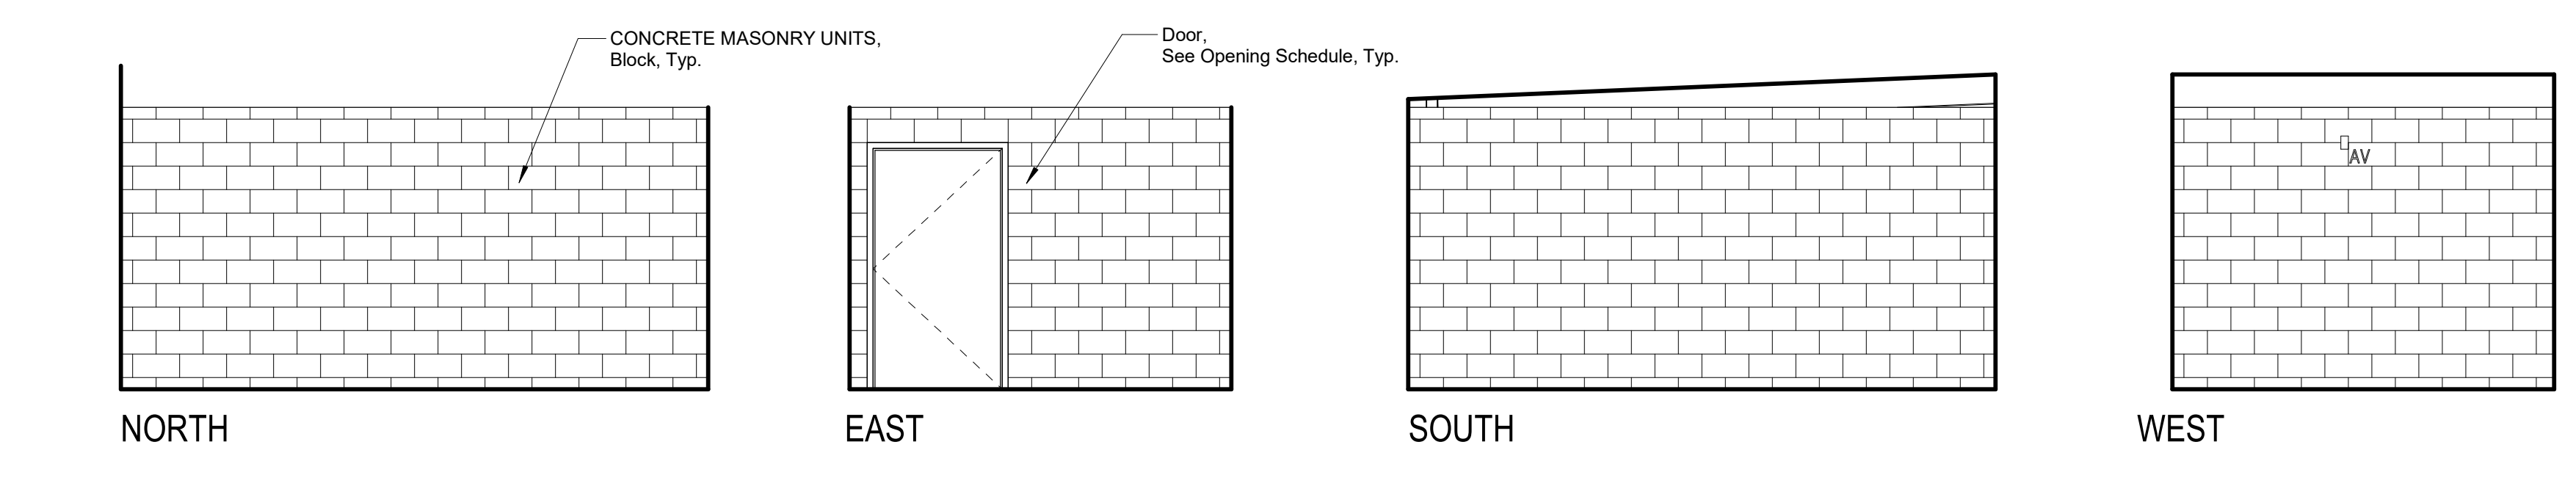

P420 Gas Meter Enclosure

SYMBOLS

	Cabinet Group No. Refer to Modular Casework Schedule and Lab Casework Schedule.
	FIRE PROTECTION SPECIALTIES, Fire Extinguisher Cabinet, Top of Cabinet @ +5'-0". Unless Noted Otherwise, Provide Fire Rated Cabinet at Rated Walls. See Detail N11 X/A602
	WALL COVERINGS, FRP Panels E14 X/A607
	WALL COVERINGS, Solid Surfacing A14 X/A607
	ROUGH CARPENTRY, Plywood Sheathing, AC
	PLUMBING, Access Door, See Plumbing Drawings
	ELECTRICAL, AV/Speaker @ +7'-6" to center of device, Unless Noted Otherwise.
	ELECTRICAL, Clock/Speaker @ +8'-6" to center of device, Unless Noted Otherwise.
	ELECTRICAL, Outlet
	ELECTRICAL, Light Switch
	ELECTRICAL, Fire Alarm Device
	ELECTRICAL, Volume Control
	ELECTRICAL, Television Outlet
	MECHANICAL, Thermostat
	PLUMBING, Hose Bib
	ELECTRICAL, Data Outlet
	ELECTRICAL, Microphone Outlet
	ELECTRICAL, Intrusion Sensor
	ELECTRICAL, Motion Sensor
	ELECTRICAL, Telephone Outlet
	ELECTRICAL, HDMI

ABBREVIATIONS

FEC	FIRE PROTECTION SPECIALTIES, Fire Extinguisher and Cabinet, Type FEC-1, Unless Noted Otherwise.
Gl.	Glass
KS	Knee Space
OH	Opposite Hand
Typ.	Typical
Sim.	Similar
Dia.	Diameter
UNO	Unless Noted Otherwise

- NOTES**
- All Details, Materials and Finishes Shall be Considered Typical for All Similar Conditions, Unless Noted Otherwise.
 - Refer to Plumbing, Mechanical, Telecommunications, Food Service, and Electrical for All Wall Mounted Devices and Coordinate Location and Heights with Architectural (ie. Casework, Equipment, etc.)
 - Locate and Mount TOILET ACCESSORIES and PLUMBING per Detail A7 X/A607 Unless Noted Otherwise.
 - Provide backing at all TOILET ACCESSORIES, TOILET PARTITIONS, and IDENTIFYING DEVICES per Detail N14 X/A607 Unless Noted Otherwise.
 - Provide Backing for TOILET ACCESSORIES, Grab Bars per Detail J11 X/A607
 - Locate and mount IDENTIFYING DEVICES per Detail E1 X/A607 Unless Noted Otherwise.
 - Provide backing at all MODULAR CASEWORK per Detail N14 X/A607
 - WALL COVERINGS, FRP Panels, See Detail E14 X/A607
 - GYPSUM BOARD, Metal Accessories, See Detail J14 X/A607

F18	Interior Elevation legend
No Scale	

Mission Oak HS Aquatic Complex
 Tulare Joint Union High School District
 Tulare, CA 93274 Project

BUILDING P
 INTERIOR ELEVATIONS - ROOMS P404e, P410 & P420
 Drawing

ARCHITECTURE PLANNING INTERIORS
 www.dardenarchitects.com
 6790 N. West Ave. • Fresno, CA 93711 • T. 559.448.8051
 Architect

No.	Revision/Submission	Date
1	REVISION_01	05/31/2023

Revision


Designed By: MF	Copyright 2022 Darden Architects
Scale: 1/4" = 1'-0"	Drawn By: KT
Project Number: 2180	Checked By: -
Date: 03/28/2023	Reviewed By: MF

P/A606



Signage Schedule									
Building	Sign Mark	Sign Type	Sign Material	Sign Copy Line 1	Sign Copy Line 2	Sign Copy Line 3	Mtg Height	Mtg Cond	Remarks
P2	P203a	5b	EM	ELECTRICAL	N/A	N/A	4' - 11"	3	-
P2	P202a	5b	EM	FIRE RISER	N/A	N/A	4' - 11"	3	-
P2	P201aa	6a	EM	STORAGE	-	N/A	5' - 0"	3	-
P3	P302b	2a	EM	BOYS	N/A	-	4' - 11"	3	-
P3	P304a	2a	EM	GIRLS	N/A	-	4' - 11"	3	-
P3	P304d	2a	EM	GIRLS	N/A	-	4' - 11"	3	-
P3	P302c	2a	EM	BOYS	N/A	-	4' - 11"	3	-
P3	P304b	2b	EM	GIRLS	N/A	-	4' - 11"	5	-
P3	P304c	2b	EM	GIRLS	N/A	-	4' - 11"	5	-
P3	P302a	2c	EM	BOYS	N/A	-	4' - 11"	5	-
P3	P302d	2c	EM	BOYS	N/A	-	4' - 11"	5	-
P3	P301a	5a	EM	BOYS SHOWER	N/A	N/A	4' - 11"	3	-
P3	P305a	5a	EM	GIRLS SHOWER	N/A	N/A	4' - 11"	3	-
P3	P306a	5b	EM	CUSTODIAL	N/A	N/A	4' - 11"	3	-
P3	P303a	5b	EM	FIRE RISER	N/A	N/A	4' - 11"	3	-
P4	P402b	5b	EM	ACID	-	-	4' - 11"	3	-
P4	P403b	5b	EM	CHLORINE	-	-	4' - 11"	3	-
P4	P401a	5b	EM	POOL EQUIPMENT	-	-	4' - 11"	3	-
P4	P410a	5b	EM	COOLING TOWERS	-	-	4' - 11"	3	-
P4	P420a	5b	EM	GAS METER	-	-	4' - 11"	3	-
P4	P401c	5b	EM	POOL EQUIPMENT	-	-	4' - 11"	3	-
P4	P401b	6a	EM	EXIT	N/A	N/A	5' - 0"	3	-
P4	P401d	6a	EM	EXIT	N/A	N/A	5' - 0"	3	-
P4	P403a	11a	A	0	COR	3	8' - 2"	3	See A1-X/A602
P4	P402a	11a	A	1	COR	-	8' - 2"	3	See A1-X/A602
P4	P404a	12	A	PASSENGER	LOADING ONLY	N/A	4' - 11"	3	See J4-SD/A303

Signage Schedule Add Alternate									
Building	Sign Mark	Sign Type	Sign Material	Sign Copy Line 1	Sign Copy Line 2	Sign Copy Line 3	Mtg Height	Mtg Cond	Remarks
P2	P205a	2a	EM	RESTROOM	SHOWER	-	4' - 11"	3	-
P2	P205b	2d	EM	UNISEX SYM.	-	-	4' - 11"	5	-
P2	P203a	5b	EM	ELECTRICAL	N/A	N/A	4' - 11"	3	-
P2	P202a	5b	EM	FIRE RISER	N/A	N/A	4' - 11"	3	-
P2	P204a	5b	EM	SNACK BAR	-	-	4' - 11"	3	-
P2	P205aa	6a	EM	CUSTODIAL	-	N/A	5' - 0"	3	-
P2	P201aa	6a	EM	STORAGE	-	N/A	5' - 0"	3	-

J7 Signage Schedule
No Scale Refer to G18 for Schedule Legend

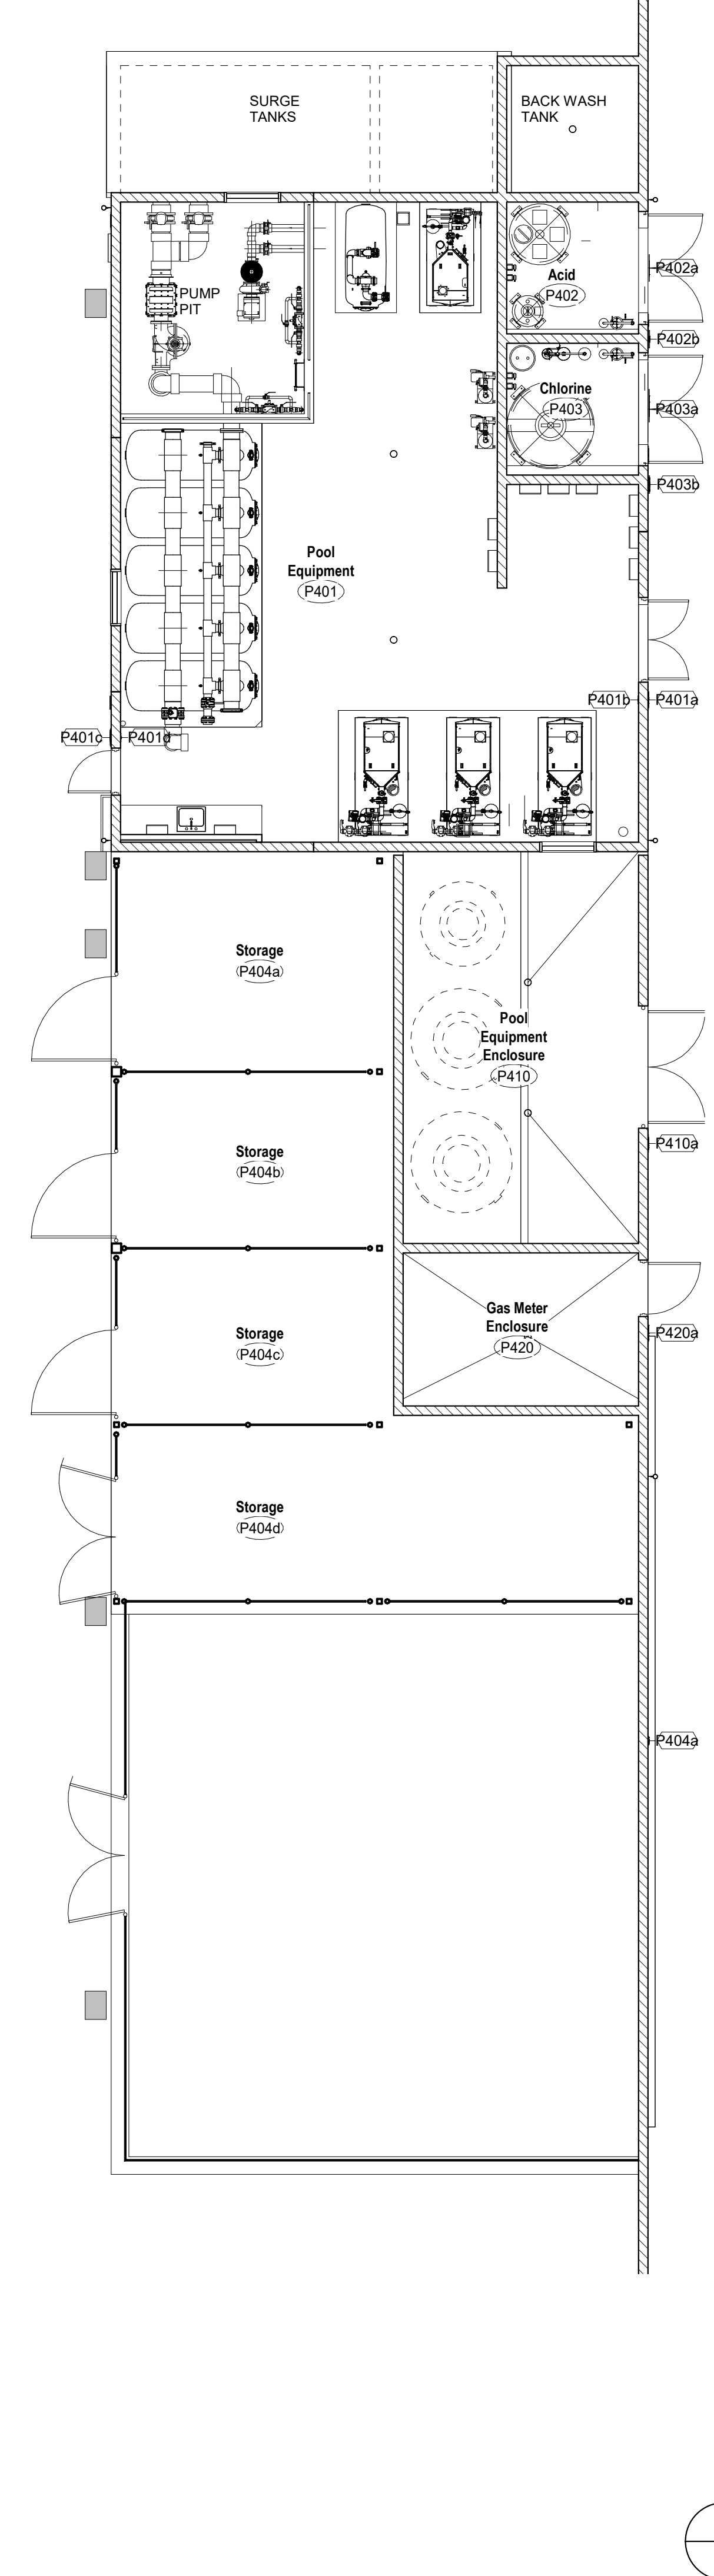




DSA File No.: 54-H11
 DSA Application No.: 02-120251
 Agency Approval
 MOUNTING CONDITION SIGN MATERIAL
 1. Metal Stud Framed Wall A = Acrylic
 2. Wood Stud Framed Wall EM = Exterior Metal
 3. Concrete and Concrete Masonry IM = Interior Metal
 4. Glass EP = Exterior Plastic
 5. Door IP = Interior Plastic
 6. See Plan D = Decal

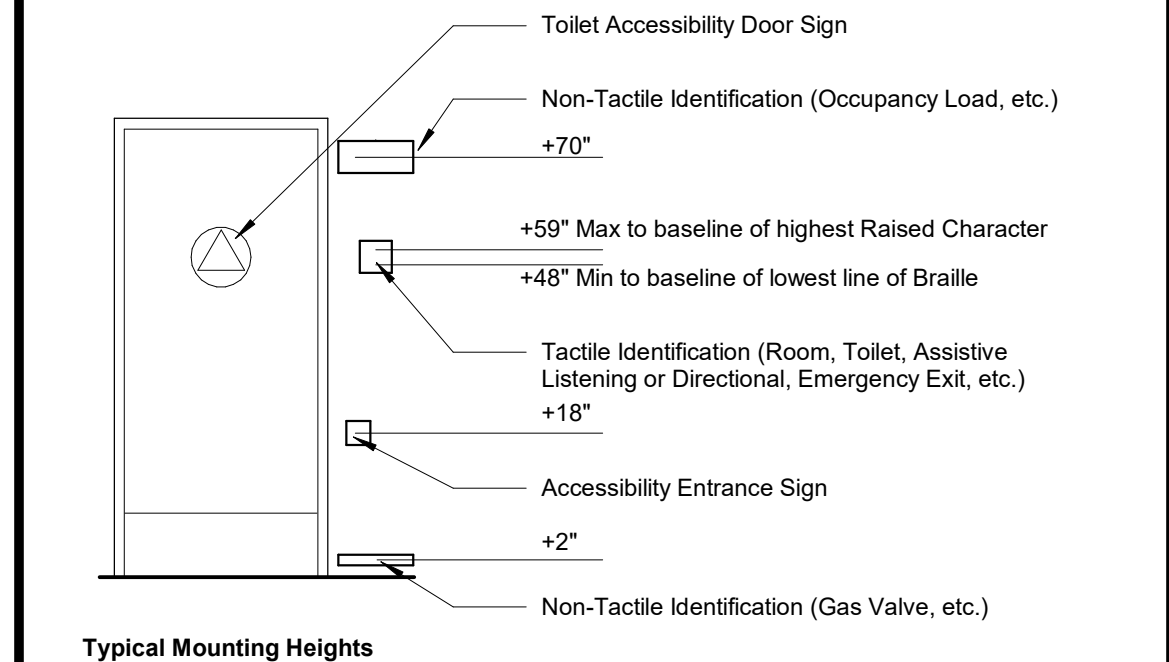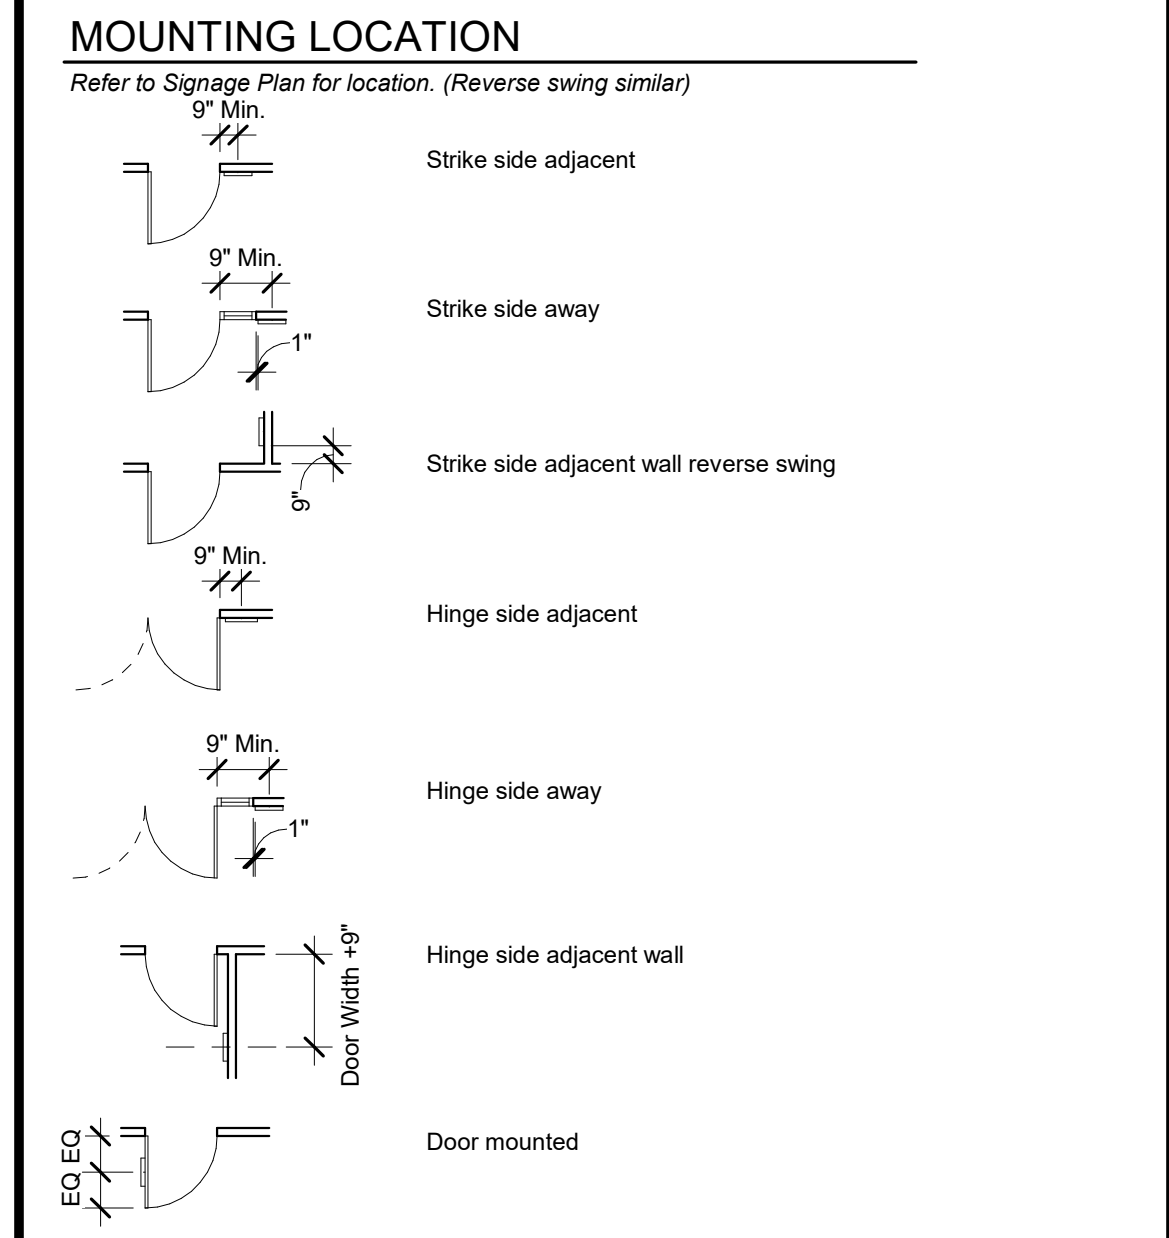

Typical Mounting Heights
Scale: N.T.S.

- NOTES
- Refer to Specification Section IDENTIFYING DEVICES.
 - Refer to Plan for Mounting Location.
 - Verify Sign Copy with Owner prior to fabrication, "-" indicates a blank space.
 - For IDENTIFYING DEVICES, Signage Dimensions, refer to detail E1 X/A601.

G18 Signage Schedule Legend
No Scale

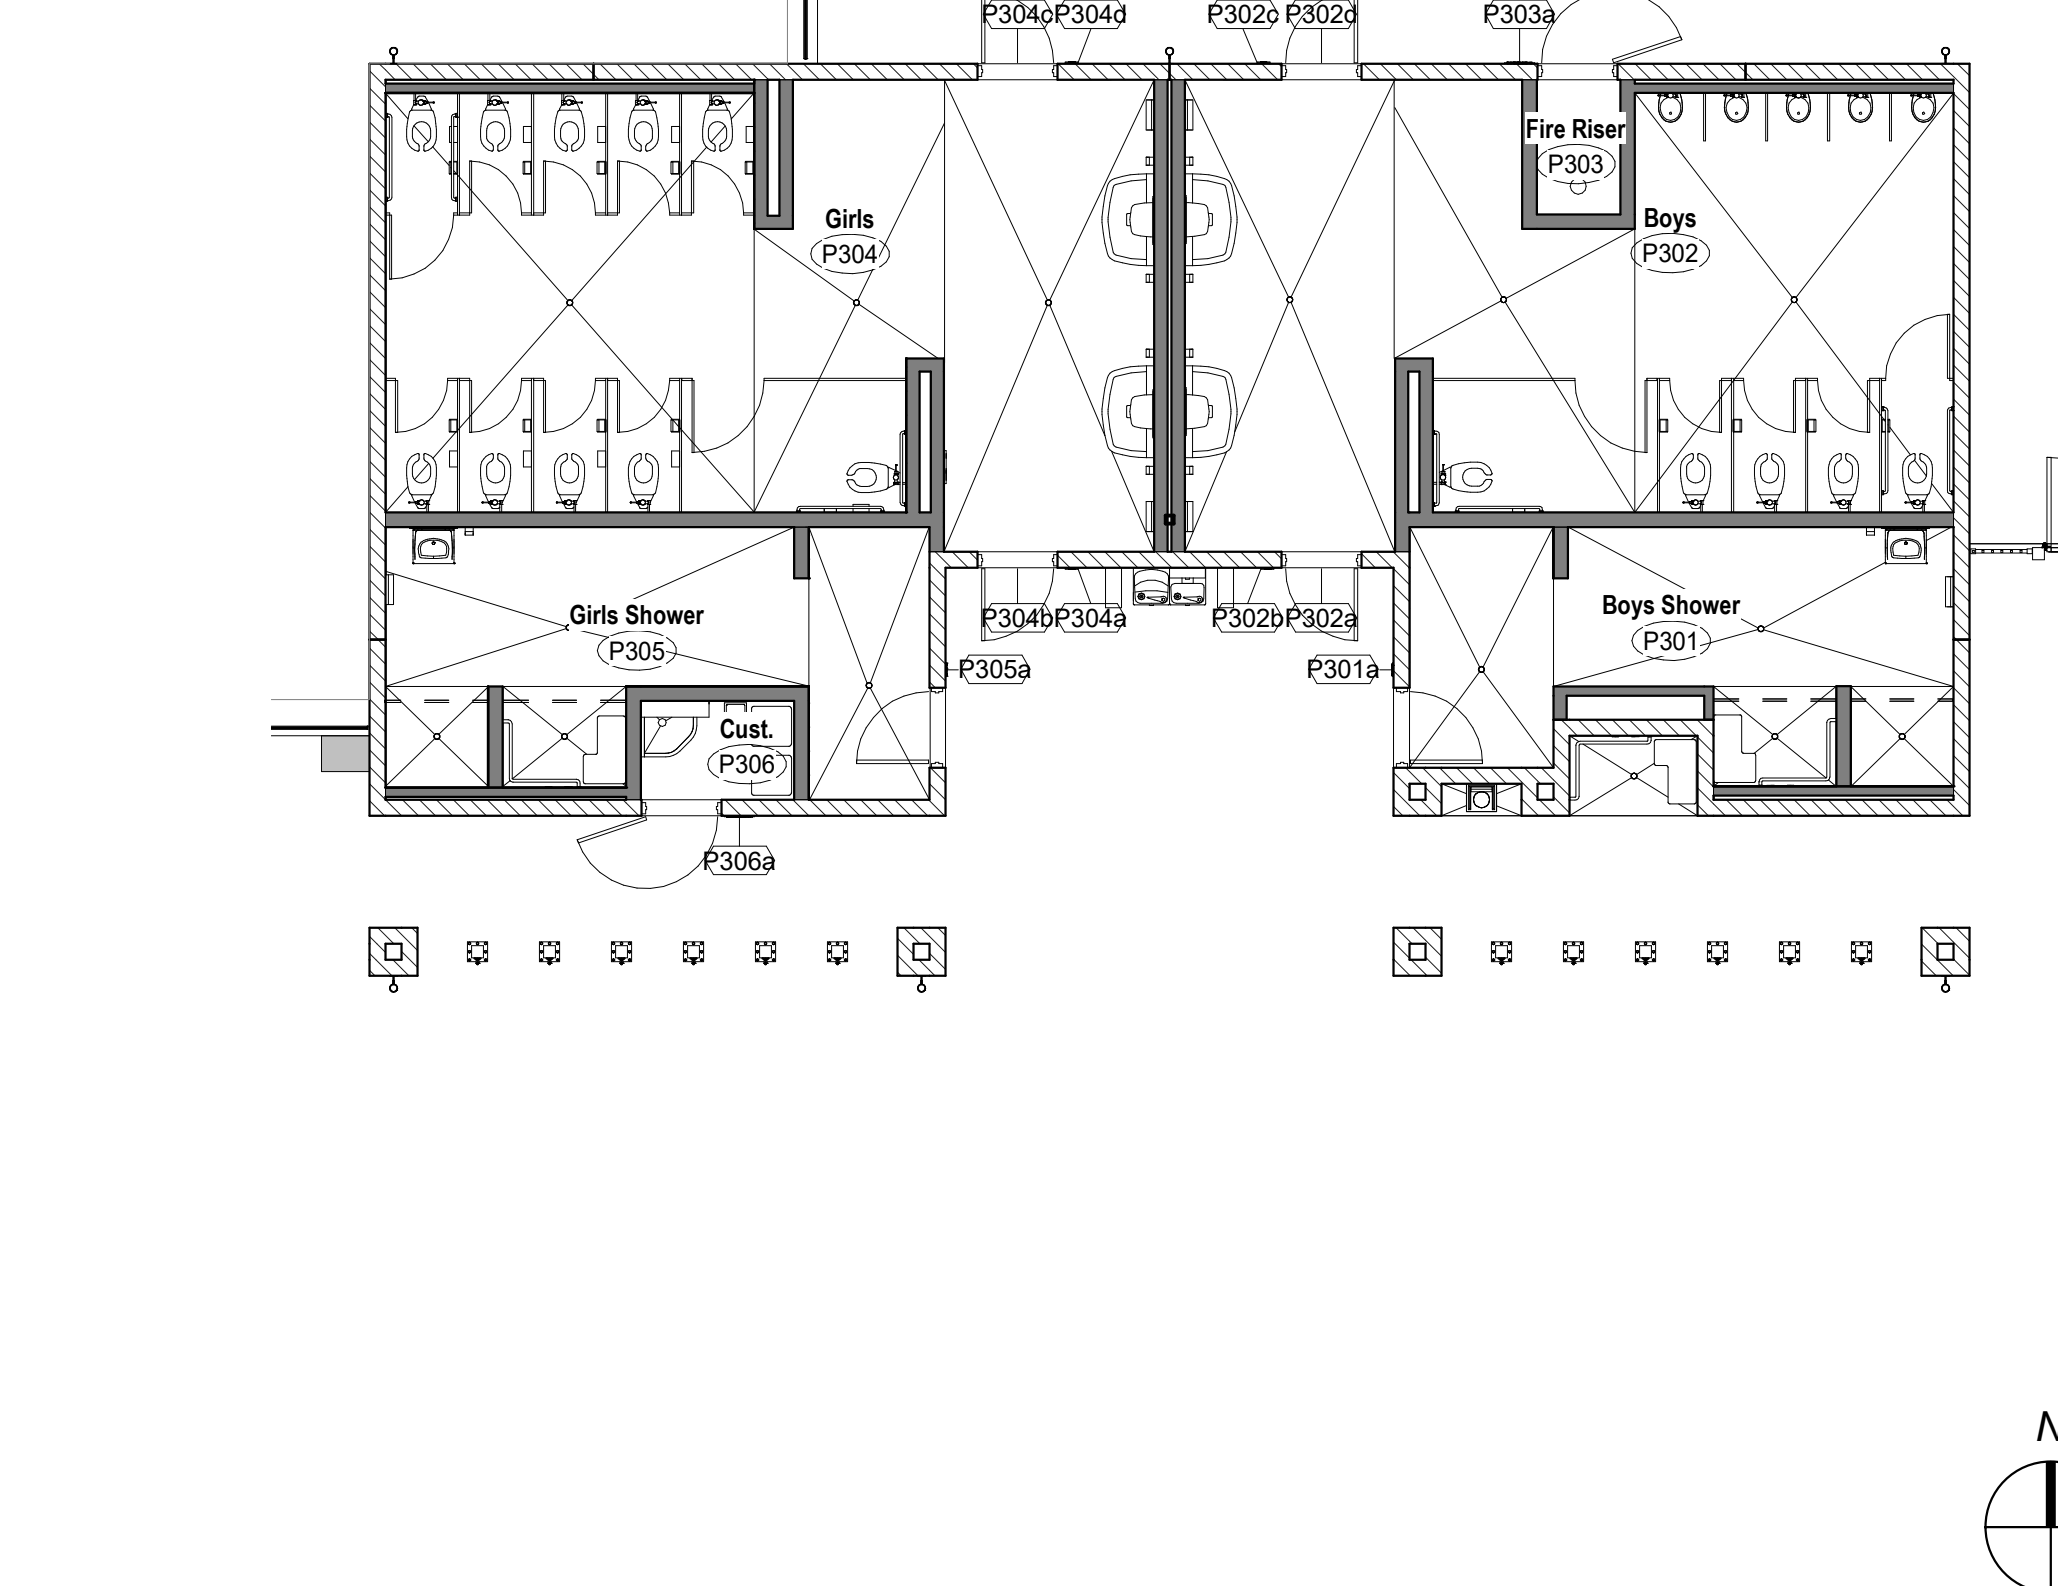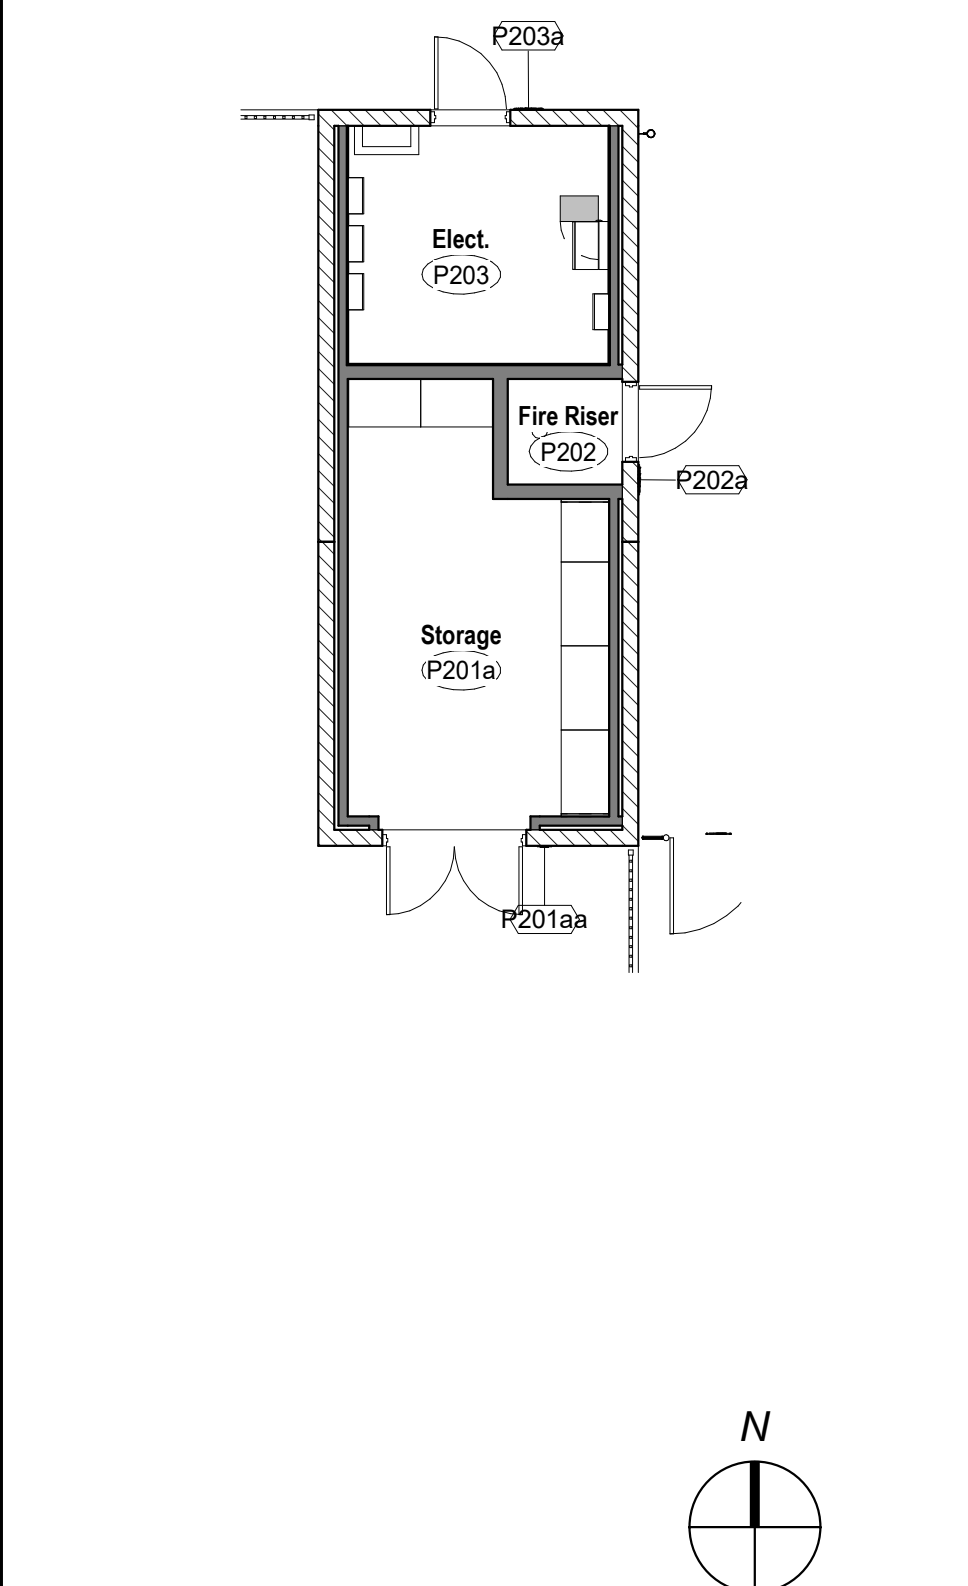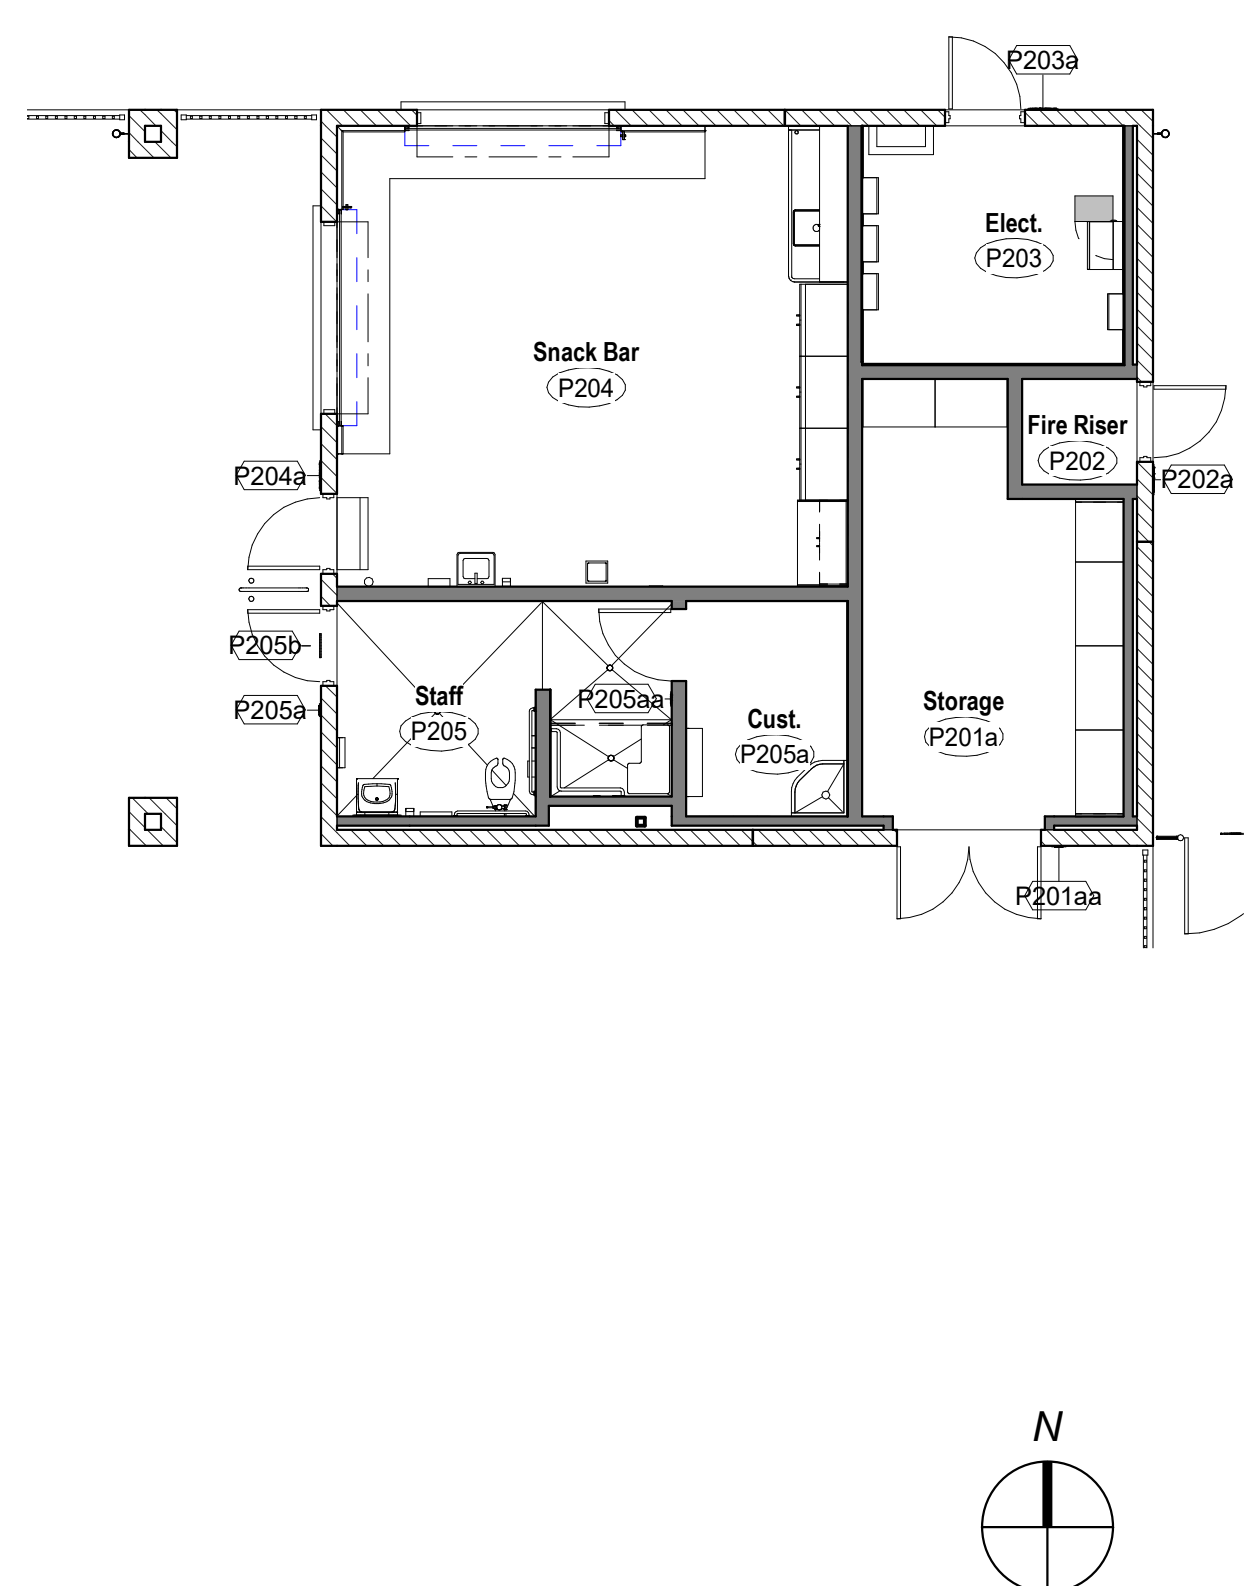

A7 Signage Floor Plan - Building P2
1/8" = 1'-0"

A13 Signage Floor Plan - Building P4
1/8" = 1'-0"

Mission Oak HS Aquatic Complex
 Tulare Joint Union High School District
 Tulare, CA 93274
 BUILDING P2, P3 & P4
 SIGNAGE PLANS AND SCHEDULE
 Project
 Drawing

ARCHITECTURE PLANNING INTERIORS
 darden architects
 www.dardenarchitects.com
 6790 N. West Ave. • Fresno, CA 93711 • T. 559.448.8051
 LICENSED ARCHITECT
 ARCHITECT C. FARRINGTON
 No. C23724
 STATE OF CALIFORNIA
 Architect


No.	Revision/Submission	Date
1	REVISION_01	05/31/2023

Revision



Designed By: MF Copyright 2022 Darden Architects
 Scale: 1/8" = 1'-0" Drawn By: FM
 Project Number: 2180 Checked By: -
 Date: 03/28/2023 Reviewed By: MF

P/A701


8/18/2023 4:28:23 PM e:\Users\alvin\Documents\180 Mission Oak HS Aquatic Complex_RD01_VZ2_A\Inv_V.nt

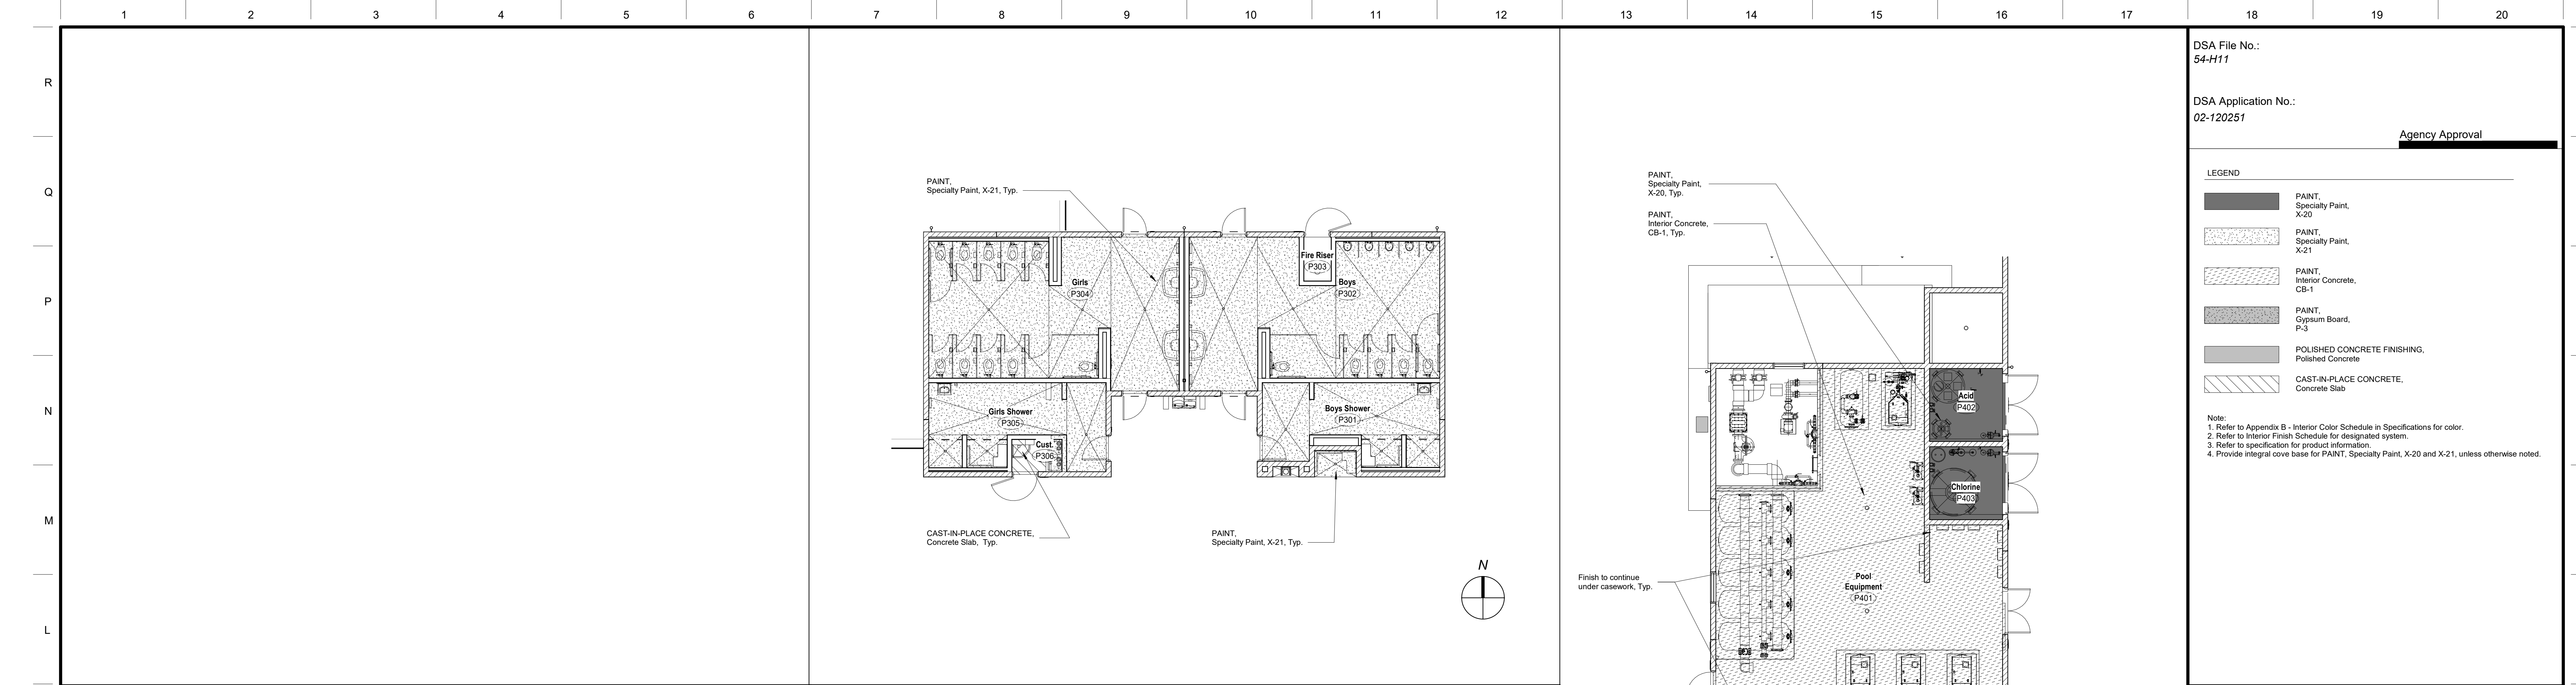

K7 Floor Finish Plan - Building P3
1/8" = 1'-0"

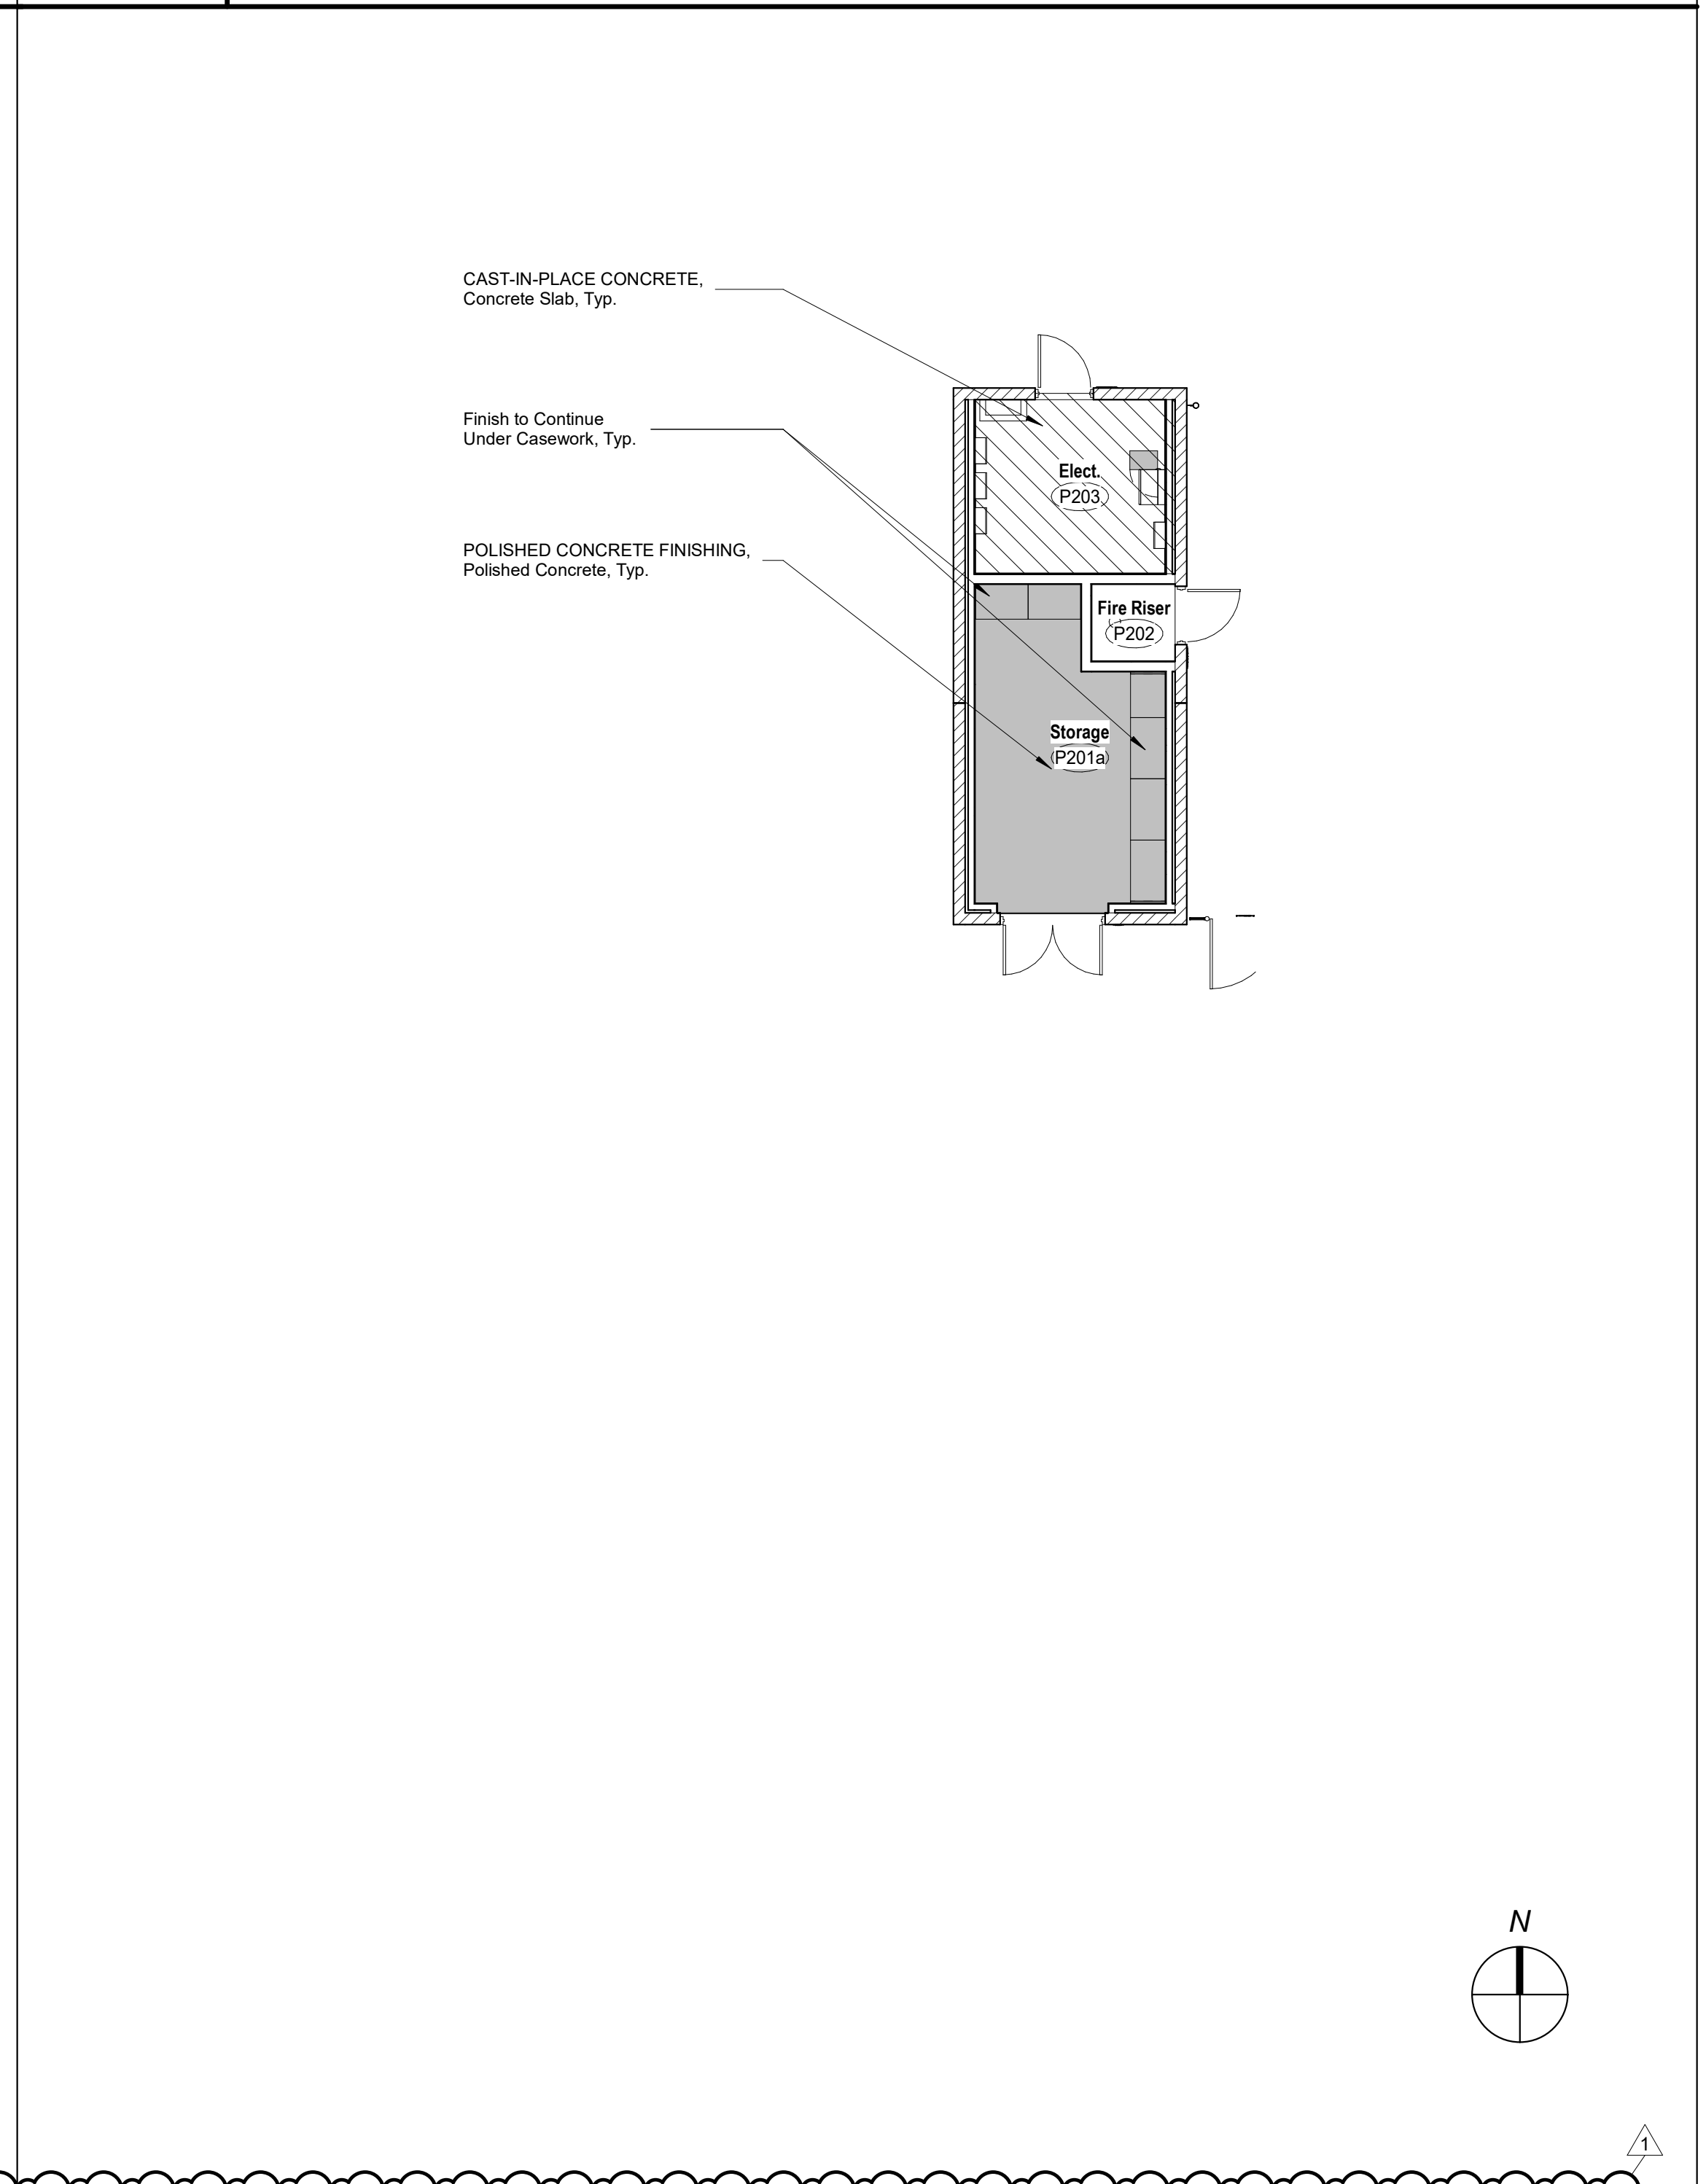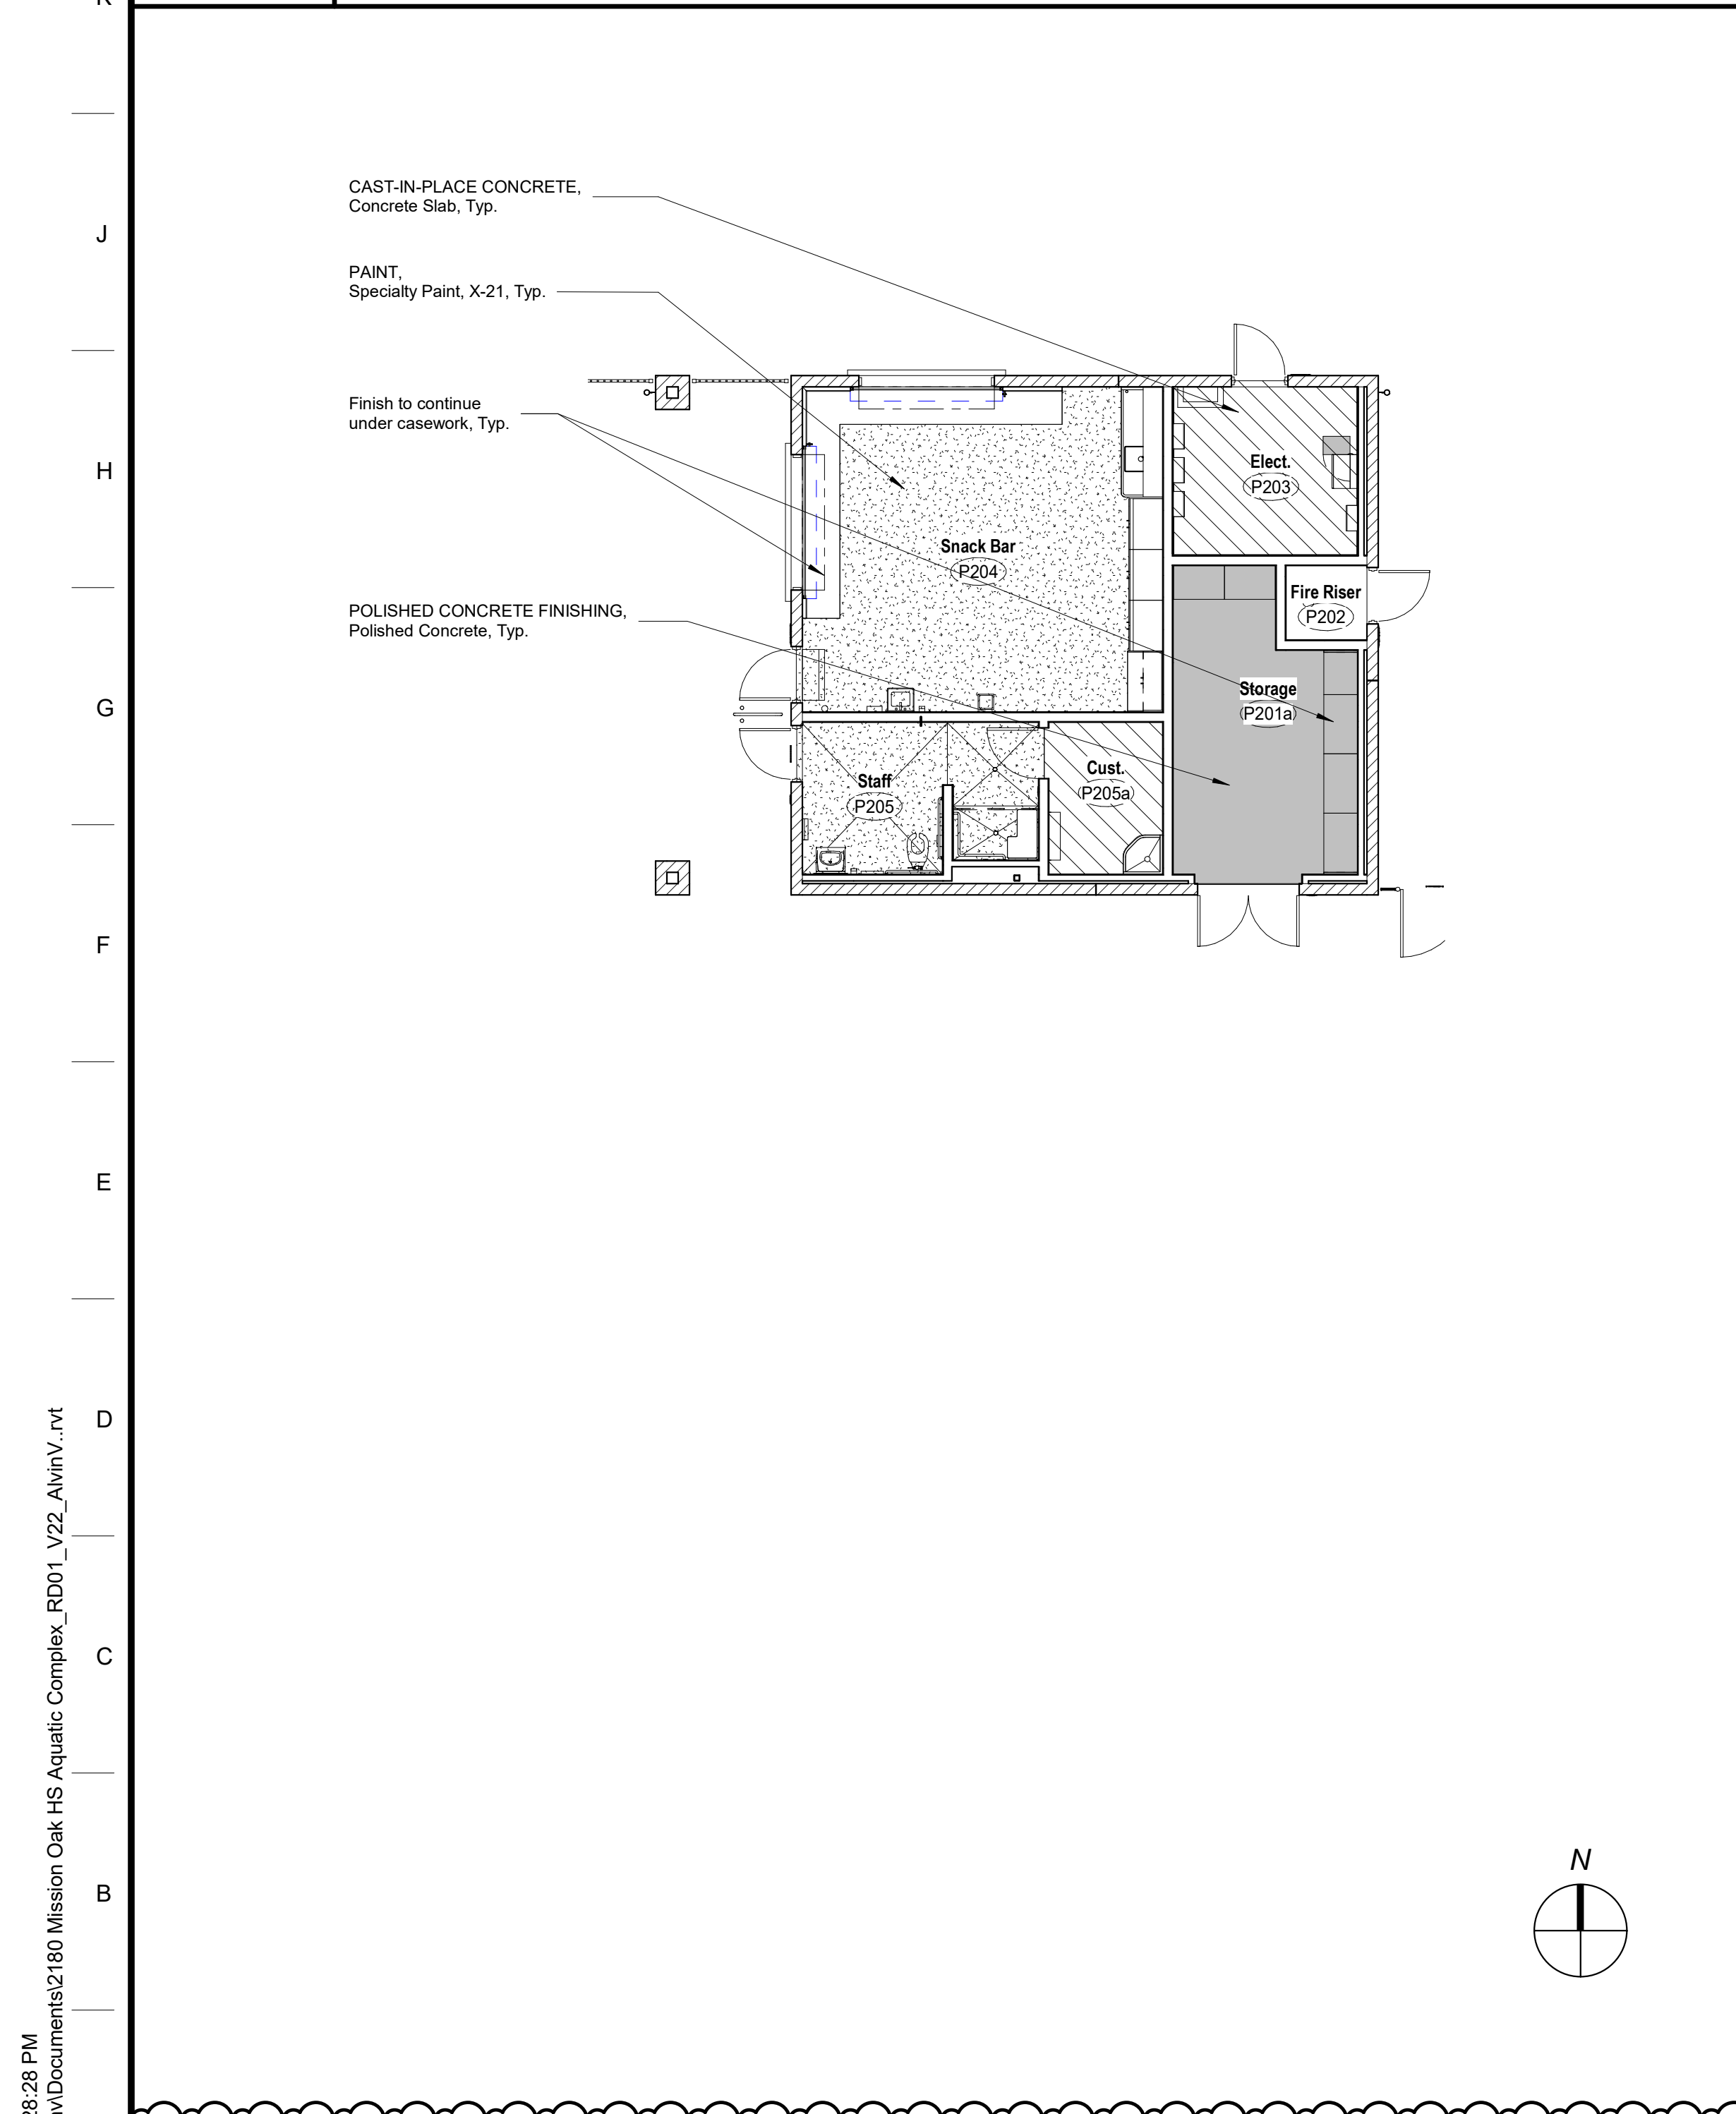

A7 Floor Finish Plan - Building P2
1/8" = 1'-0"

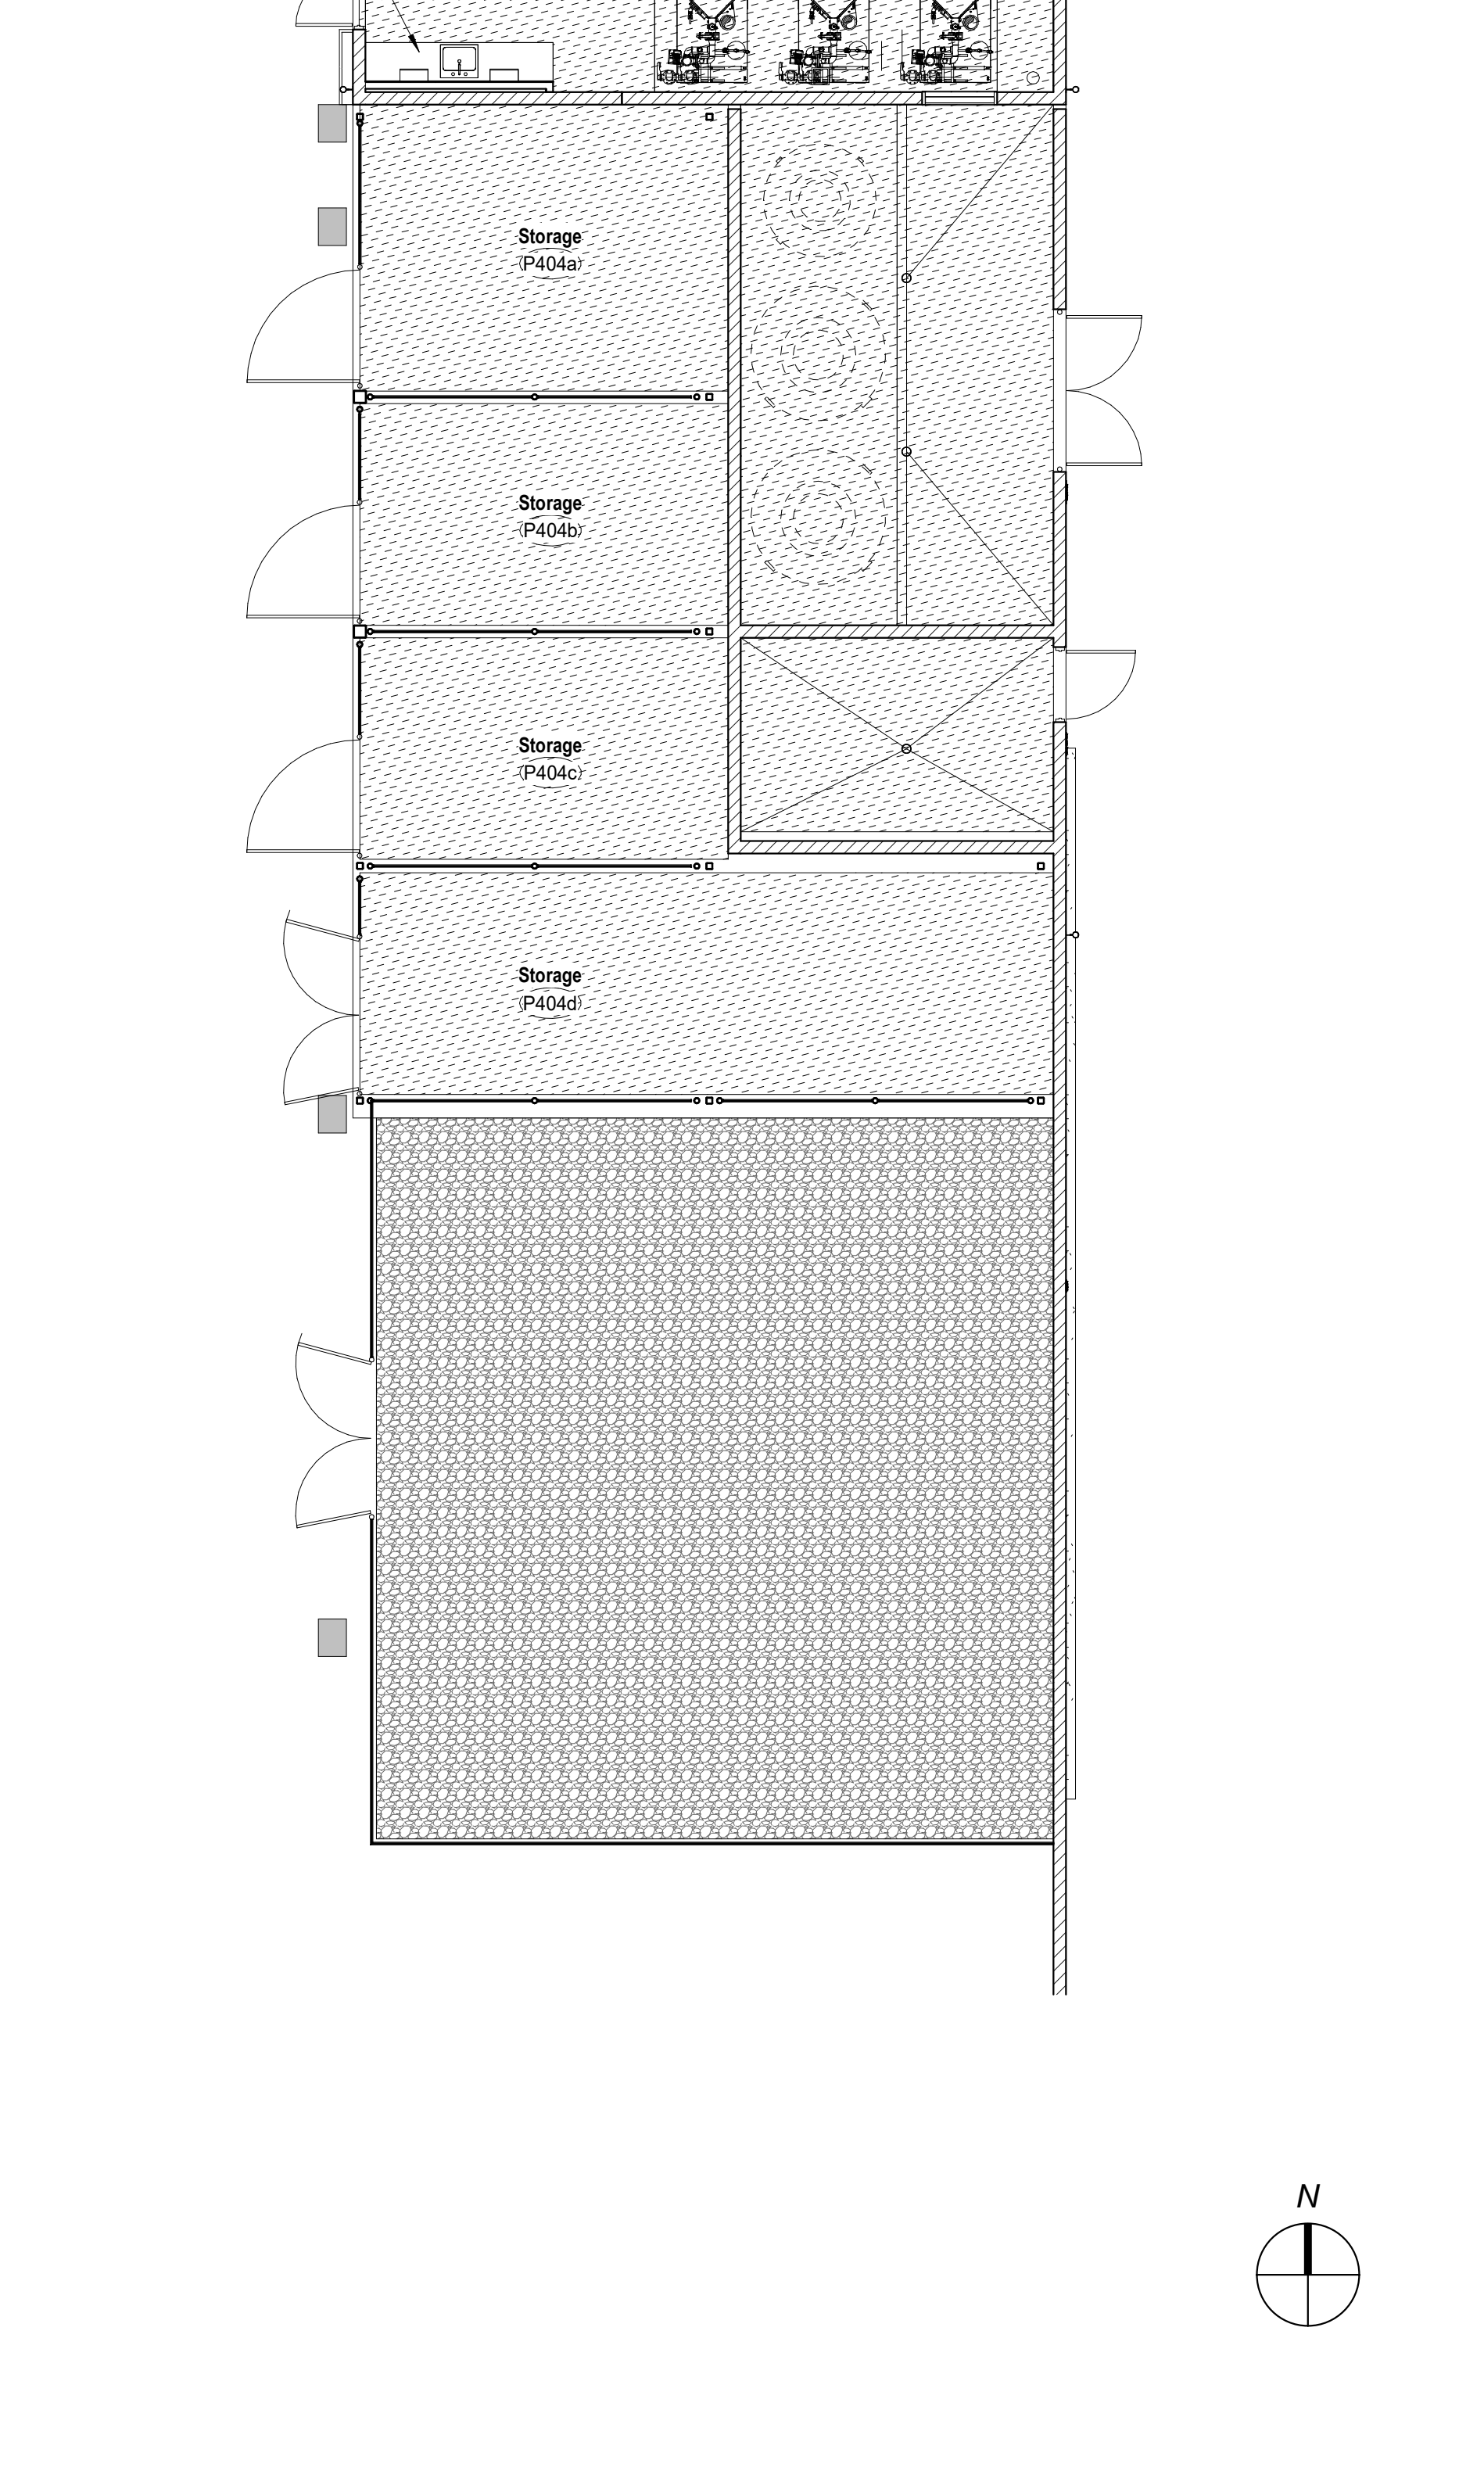

A13 Floor Finish Plan - Building P4
1/8" = 1'-0"

DSA File No.: 54-H11
 DSA Application No.: 02-120251
 Agency Approval

LEGEND
 PAINT, Specialty Paint, X-20
 PAINT, Specialty Paint, X-21
 PAINT, Interior Concrete, CB-1
 PAINT, Gypsum Board, P-3
 POLISHED CONCRETE FINISHING, Polished Concrete
 CAST-IN-PLACE CONCRETE, Concrete Slab

Note:
 1. Refer to Appendix B - Interior Color Schedule in Specifications for color.
 2. Refer to Interior Finish Schedule for designated system.
 3. Refer to specification for product information.
 4. Provide integral cove base for PAINT, Specialty Paint, X-20 and X-21, unless otherwise noted.

K18 Floor Finish Legend

Mission Oak HS Aquatic Complex
 Tulare Joint Union High School District
 Tulare, CA 93274
 Project
BUILDING P2, P3 & P4
 INTERIOR DESIGN PLANS
 Drawing


ARCHITECTURE PLANNING INTERIORS
 www.dardenarchitects.com
 6790 N. West Ave. • Fresno, CA 93711 • T. 559.448.8051
 Architect

LICENSED ARCHITECT
 ARCHITECT C. FERRER
 No. C23724
 STATE OF CALIFORNIA


No.	Revision/Submission	Date
1	REVISION_01	05/31/2023
Revision		
Designed By:	MF	Copyright 2022 Darden Architects
Scale:	1/8" = 1'-0"	Drawn By: PV
Project Number:	2180	Checked By: -
Date:	03/28/2023	Reviewed By: MF

P/A801


8/18/2023 4:28:28 PM
 e:\Users\alvin\Documents\180 Mission Oak HS Aquatic Complex_RD01_VZ2_A\Invtv.rvt

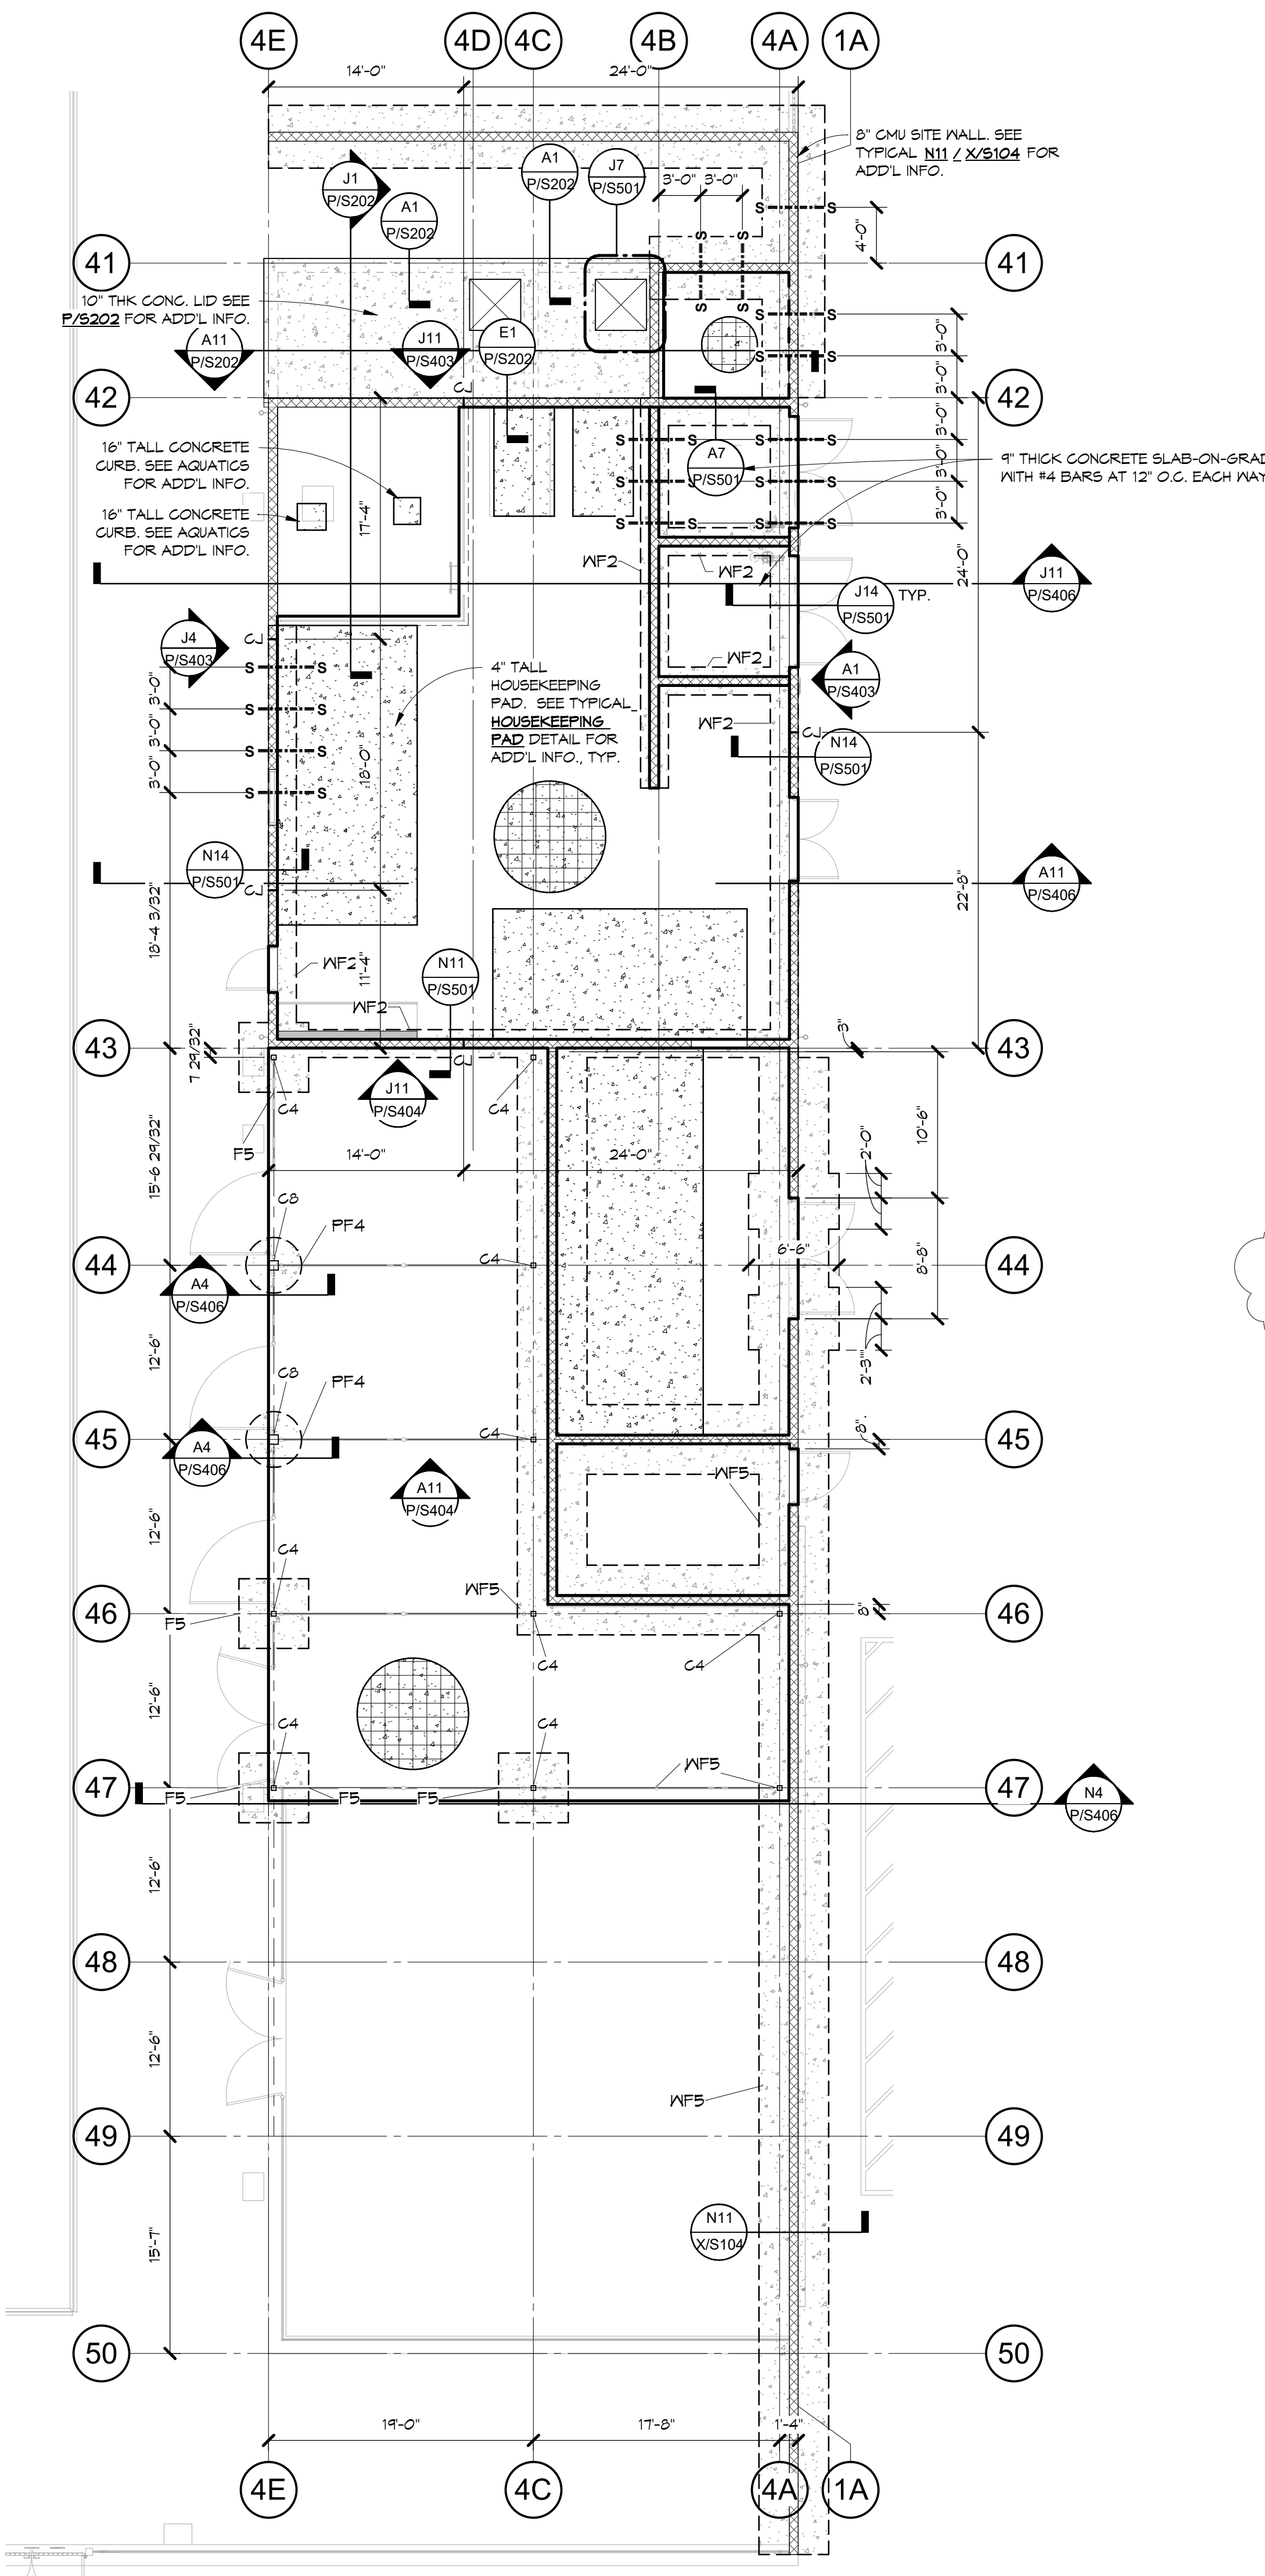

A1 FOUNDATION PLAN - BUILDING P4
P/S202 P/S201 1/8" = 1'-0"

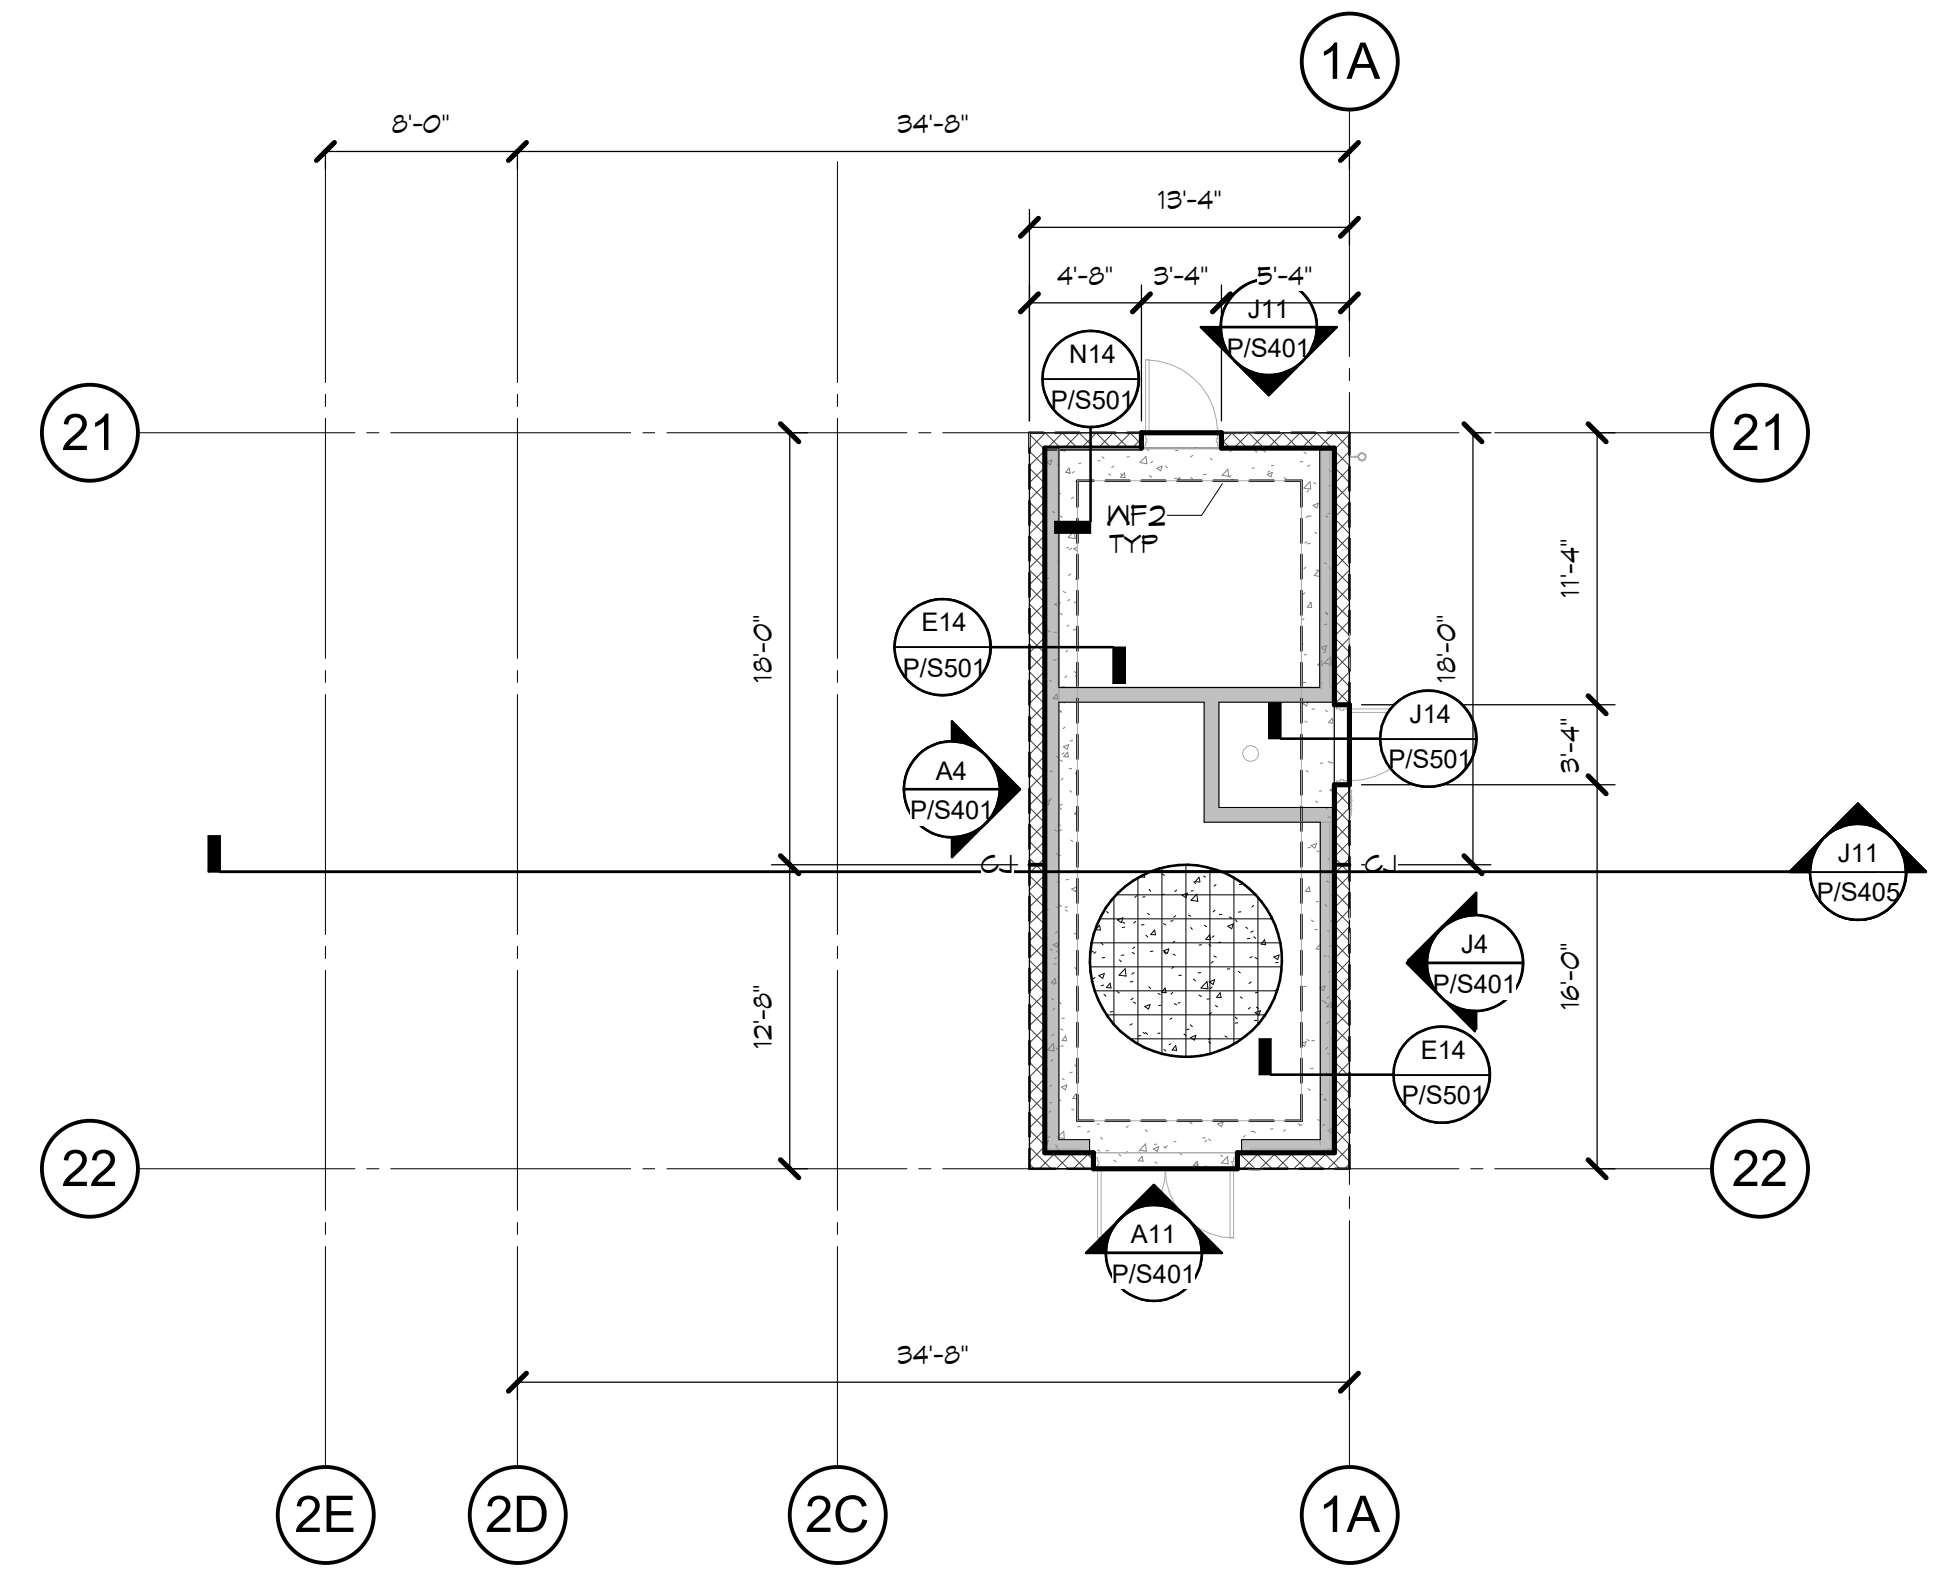

J7 FOUNDATION PLAN - BUILDING P2
P/S202 P/S201 1/8" = 1'-0"

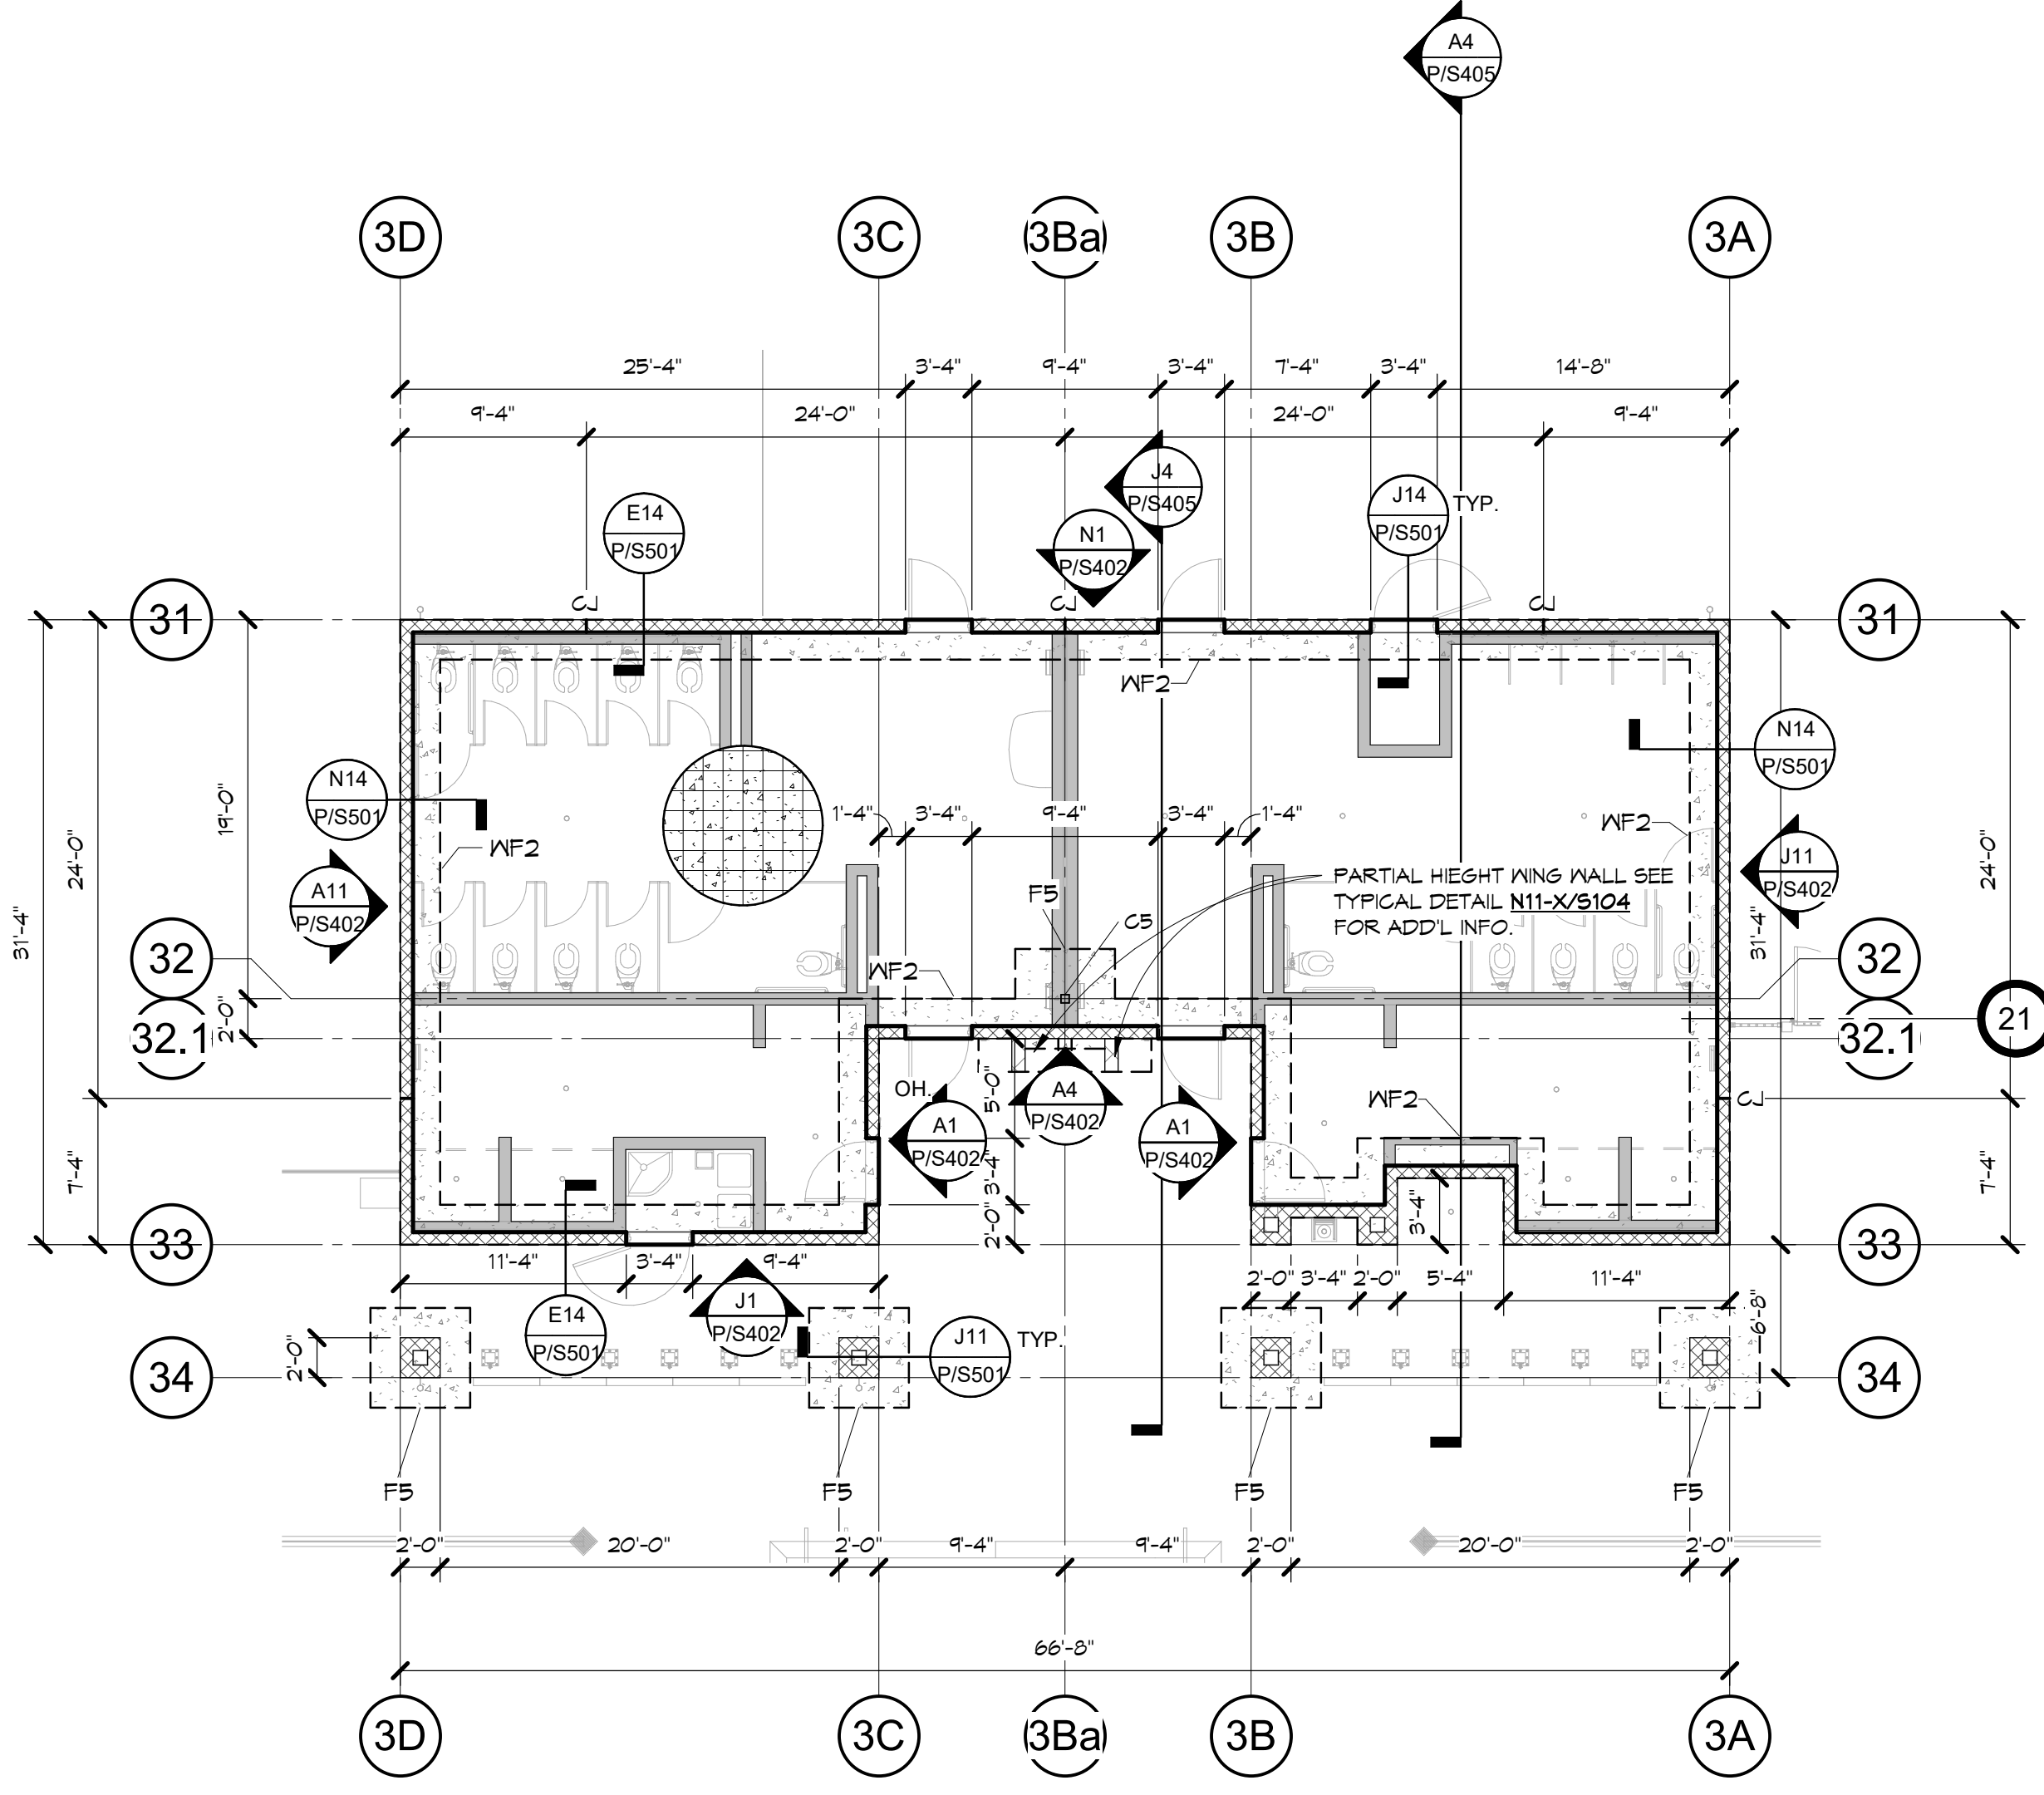

A7 FOUNDATION PLAN - BUILDING P3
P/S202 P/S201 1/8" = 1'-0"

- SEE TYPICAL SHEETS FOR ALL GENERAL AND MATERIAL NOTES, AND ALL TYPICAL SCHEDULES AND DETAILS. THE INFORMATION ON THE TYPICAL SHEETS APPLY TO THE PROJECT AND ARE NOT SPECIFICALLY REFERENCED ON PLAN WORK, UNLESS NOTED OTHERWISE. IF TYPICAL DETAILS ARE SPECIFIED ON PLANS OR NOTES, THEY WILL BE REFERENCED WITH THE WORD 'TYPICAL' FOLLOWED BY **BOLD AND UNDERLINED** TEXT STATING THE TITLE OF THE TYPICAL DETAIL OR NOTE.
- ALL DIMENSIONS SHOWN ARE TO FACE OF EXTERIOR WALLS, CENTER OF COLUMN OR CENTER OF INTERIOR WALLS UNLESS NOTED OTHERWISE. EDGE OF SLAB AT PERIMETER OF BUILDING SHALL BE INDICATED IN SPECIFIC DETAILS AND ARCHITECTURAL. VERIFY ALL BUILDING DIMENSIONS WITH ARCHITECTURAL PLANS PRIOR TO CONSTRUCTION. NOTIFY THE ARCHITECT IMMEDIATELY IF THERE ARE ANY CONFLICTS WITH THE DIMENSIONS SHOWN.
- ALL UNCLEAR AND/OR MISSING DETAILS SHALL BE BROUGHT TO THE STRUCTURAL ENGINEER'S ATTENTION BEFORE PROCEEDING WITH CONSTRUCTION.
- ALL PAD AND CONTINUOUS FOOTINGS ARE TO BE CENTERED ON WALLS AND COLUMNS ABOVE UNLESS NOTED OTHERWISE.
- SEE CIVIL AND/OR ARCHITECTURAL SITE PLAN FOR LOCATION AND DIMENSIONS OF SIDEWALKS, MOY STRIPS, PLANTERS AND OTHER LANDSCAPING FEATURES.
- SEE ARCHITECTURAL AND PLUMBING PLANS FOR LOCATION OF ALL PIPING AND DRAINS. SEE TYPICAL DETAILS FOR STRUCTURAL REQUIREMENTS AT LOCATIONS WHERE PIPES INTERSECT OR ALIGN NEXT TO FOOTINGS AND SLABS.
- ALL EMBEDDED ITEMS SHALL BE IN PLACE AND SECURED PRIOR TO POURING OF CONCRETE.
- ALL SILL PLATE ANCHOR BOLTS SHALL BE SIZED, SPACED, PLACED, AND HAVE THE WASHER AND MATERIAL FINISH AS SPECIFIED IN THE **LIGHT GAUGE STEEL NOTES**.
- CONTRACTOR SHALL SUBMIT CONTROL JOINT PLAN FOR APPROVAL PRIOR TO POURING SLAB. SEE TYPICAL **CONTROL JOINT** DETAIL FOR ADDITIONAL INFORMATION.
- SEE TYPICAL **CMU WALL CONTROL JOINT LAYOUT REQUIREMENTS** DETAIL AND ARCHITECTURAL PLANS FOR LOCATION OF CONTROL JOINTS. NOTIFY THE ARCHITECT IMMEDIATELY IF THERE ARE ANY CONFLICTS WITH THE CONTROL JOINT LAYOUT.
- ALL TOP OF FOOTINGS SHALL BE 1'-8" BELOW FINISH SLAB, UNLESS NOTED OTHERWISE.

N14 FOUNDATION NOTES
P/S201 NOT TO SCALE

- CONCRETE CURB. SEE ARCHITECTURAL DRAWINGS FOR ADDITIONAL INFORMATION.
- 8" CMU WALL WITH #5 BARS AT 24" O.C. VERT. AND HORIZ. UNO. SEE TYPICAL **CONCRETE MASONRY UNIT WALL CONSTRUCTION** DETAIL.
- CONTROL JOINT. SEE TYPICAL **CMU WALL CONTROL JOINT REQUIREMENTS** DETAIL FOR ADDITIONAL INFORMATION.
- 18GA STEEL STUDS (S162 MIN. FLANGE) AT 16" O.C. AT INTERIOR WALL LOCATIONS. SEE ARCHITECTURAL AND TYPICAL **WALL FRAMING AT OPENINGS FOR LIGHT GAUGE STEEL** DETAIL.
- 'XX' AS INDICATED ON PLAN. SEE TYPICAL **SCHEDULES** AS FOLLOWS:
C# - COLUMN SCHEDULE
P# - PLASTER SCHEDULE
W# - WALL SCHEDULE
F# - FOUNDATION SCHEDULE
- T.O.F. - X-X' TOP OF FOOTING (T.O.F.) OR BOTTOM OF FOOTING (B.O.F.). 'X-X' IS THE DISTANCE FROM FINISHED FIRST FLOOR, UNLESS NOTED OTHERWISE.
- STEPPED FOOTING. SEE TYPICAL **STEPPED FOOTING** DETAIL.
- DEPRESSED SLAB. SEE ARCHITECTURAL DRAWINGS FOR ADDITIONAL INFORMATION.
- CONCRETE SLAB. PROVIDE 5" THICK MINIMUM SLAB WITH #4 AT 16" O.C. EACH WAY, UNO. SLAB SHALL BE PLACE OVER 1" TO 2" OF SATURATED SURFACE DRY (SSD) SAND OVER 10 MIL VAPOR RETARDING MEMBRANE. SEE GEOTECHNICAL REPORT FOR ADDITIONAL INFORMATION.

J14 FOUNDATION LEGEND
P/S201 NOT TO SCALE

STRUCTURAL FOUNDATION SCHEDULE		
MARK	TYPE	REINFORCEMENT
F5	5'-0" SQ. X 1'-6" DEEP	(7) #5 BARS EACH WAY TOP AND BOTTOM
F1.5	1'-6" SQ. X 2'-0" DEEP	(13) #5 BARS EACH WAY TOP & BOTTOM
PF4	4'-0" Ø X 1'-0" DEEP	(24) #5 VERTICAL BARS W/ #4 TIES AT 6" O.C.
WF2	2'-0" WIDE X 1'-6" DEEP CONT.	(3) #5 BARS TOP & BOTTOM
WF5	5'-0" WIDE X 1'-6" DEEP CONT.	SEE TYPICAL N11/X/S104

STRUCTURAL COLUMN SCHEDULE		
MARK	TYPE	COMMENTS
C4	H564X4X1/4	SEE TYPICAL A14/X/S105 FOR ADD'L INFO.
C5	H565X5X1/4	SEE TYPICAL A14/X/S105 FOR ADD'L INFO.
C8	H568X8X3/8	SEE TYPICAL A14/X/S105 FOR ADD'L INFO.
C10	H510X10X5/8	SEE DETAIL A11/P/S501 FOR ADD'L INFO.
P4	H564X4X1/4	SEE DETAIL J4/P/S601 FOR ADD'L INFO.

E14 SCHEDULES
NOT TO SCALE

DSA File No.:
DSA Application No.: 02-120251
Agency Approval

BrooksRansom ASSOCIATES
22106
CONSULTANT

Mission Oak HS Aquatic Complex
Tulare Joint Union High School District
Tulare, CA 93274
Project

Building P
FOUNDATION PLANS
Drawing

darden architects ARCHITECTURE PLANNING INTERIORS
www.dardenarchitects.com
6790 N. West Ave. • Fresno, CA 93711 • T. 559.448.8051
ARCHITECT

No.	Revision/Submission	Date
1	REVISION 1	05/31/2023

Revision

Designed By: ESB Copyright Darden Architects


Scale: As indicated Drawn By: ESB

Project Number: 2180 Checked By: ESB

Date: 11/16/2022 Reviewed By: ESB


P/S201
Sheet: _____ of: _____

8/18/2023 10:50:51 AM
 C:\Users\eric\Documents\22106 Mission Oak HS Aquatic VE - R22_EricBain2011.rvt

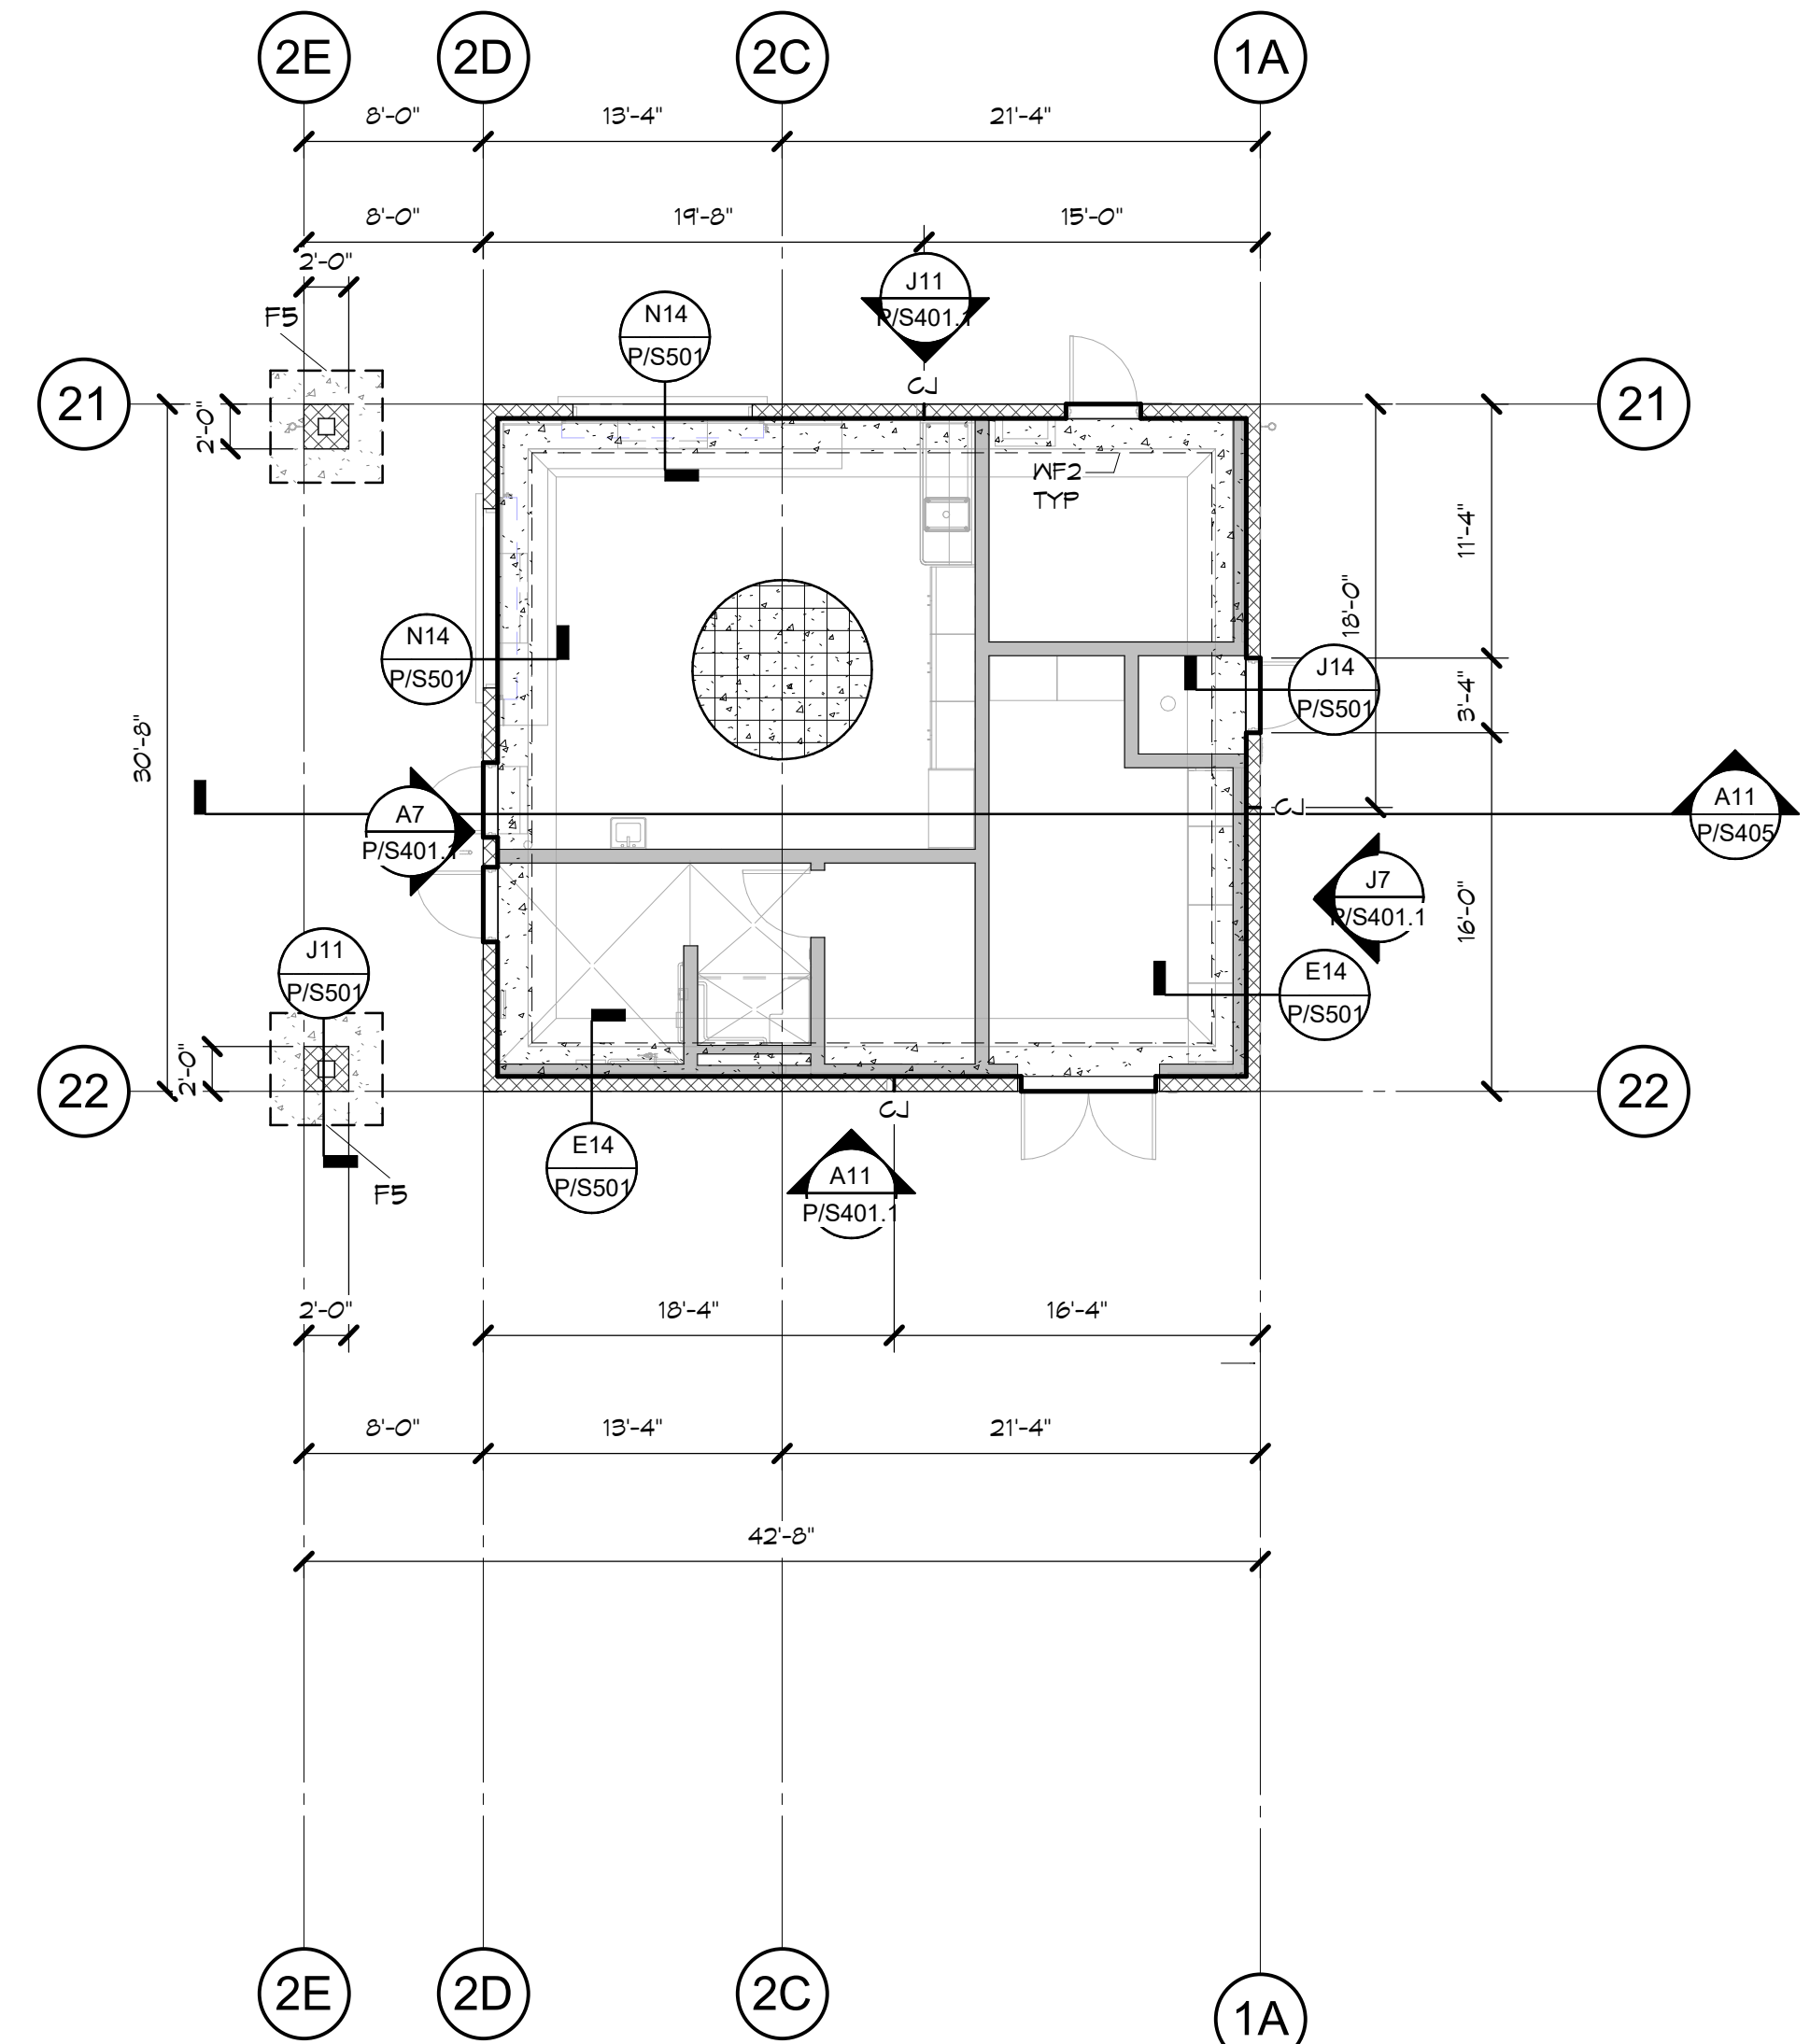

J7 FOUNDATION PLAN - BUILDING P2 ALT BID

P/S202 P/S201.1 1/8" = 1'-0"

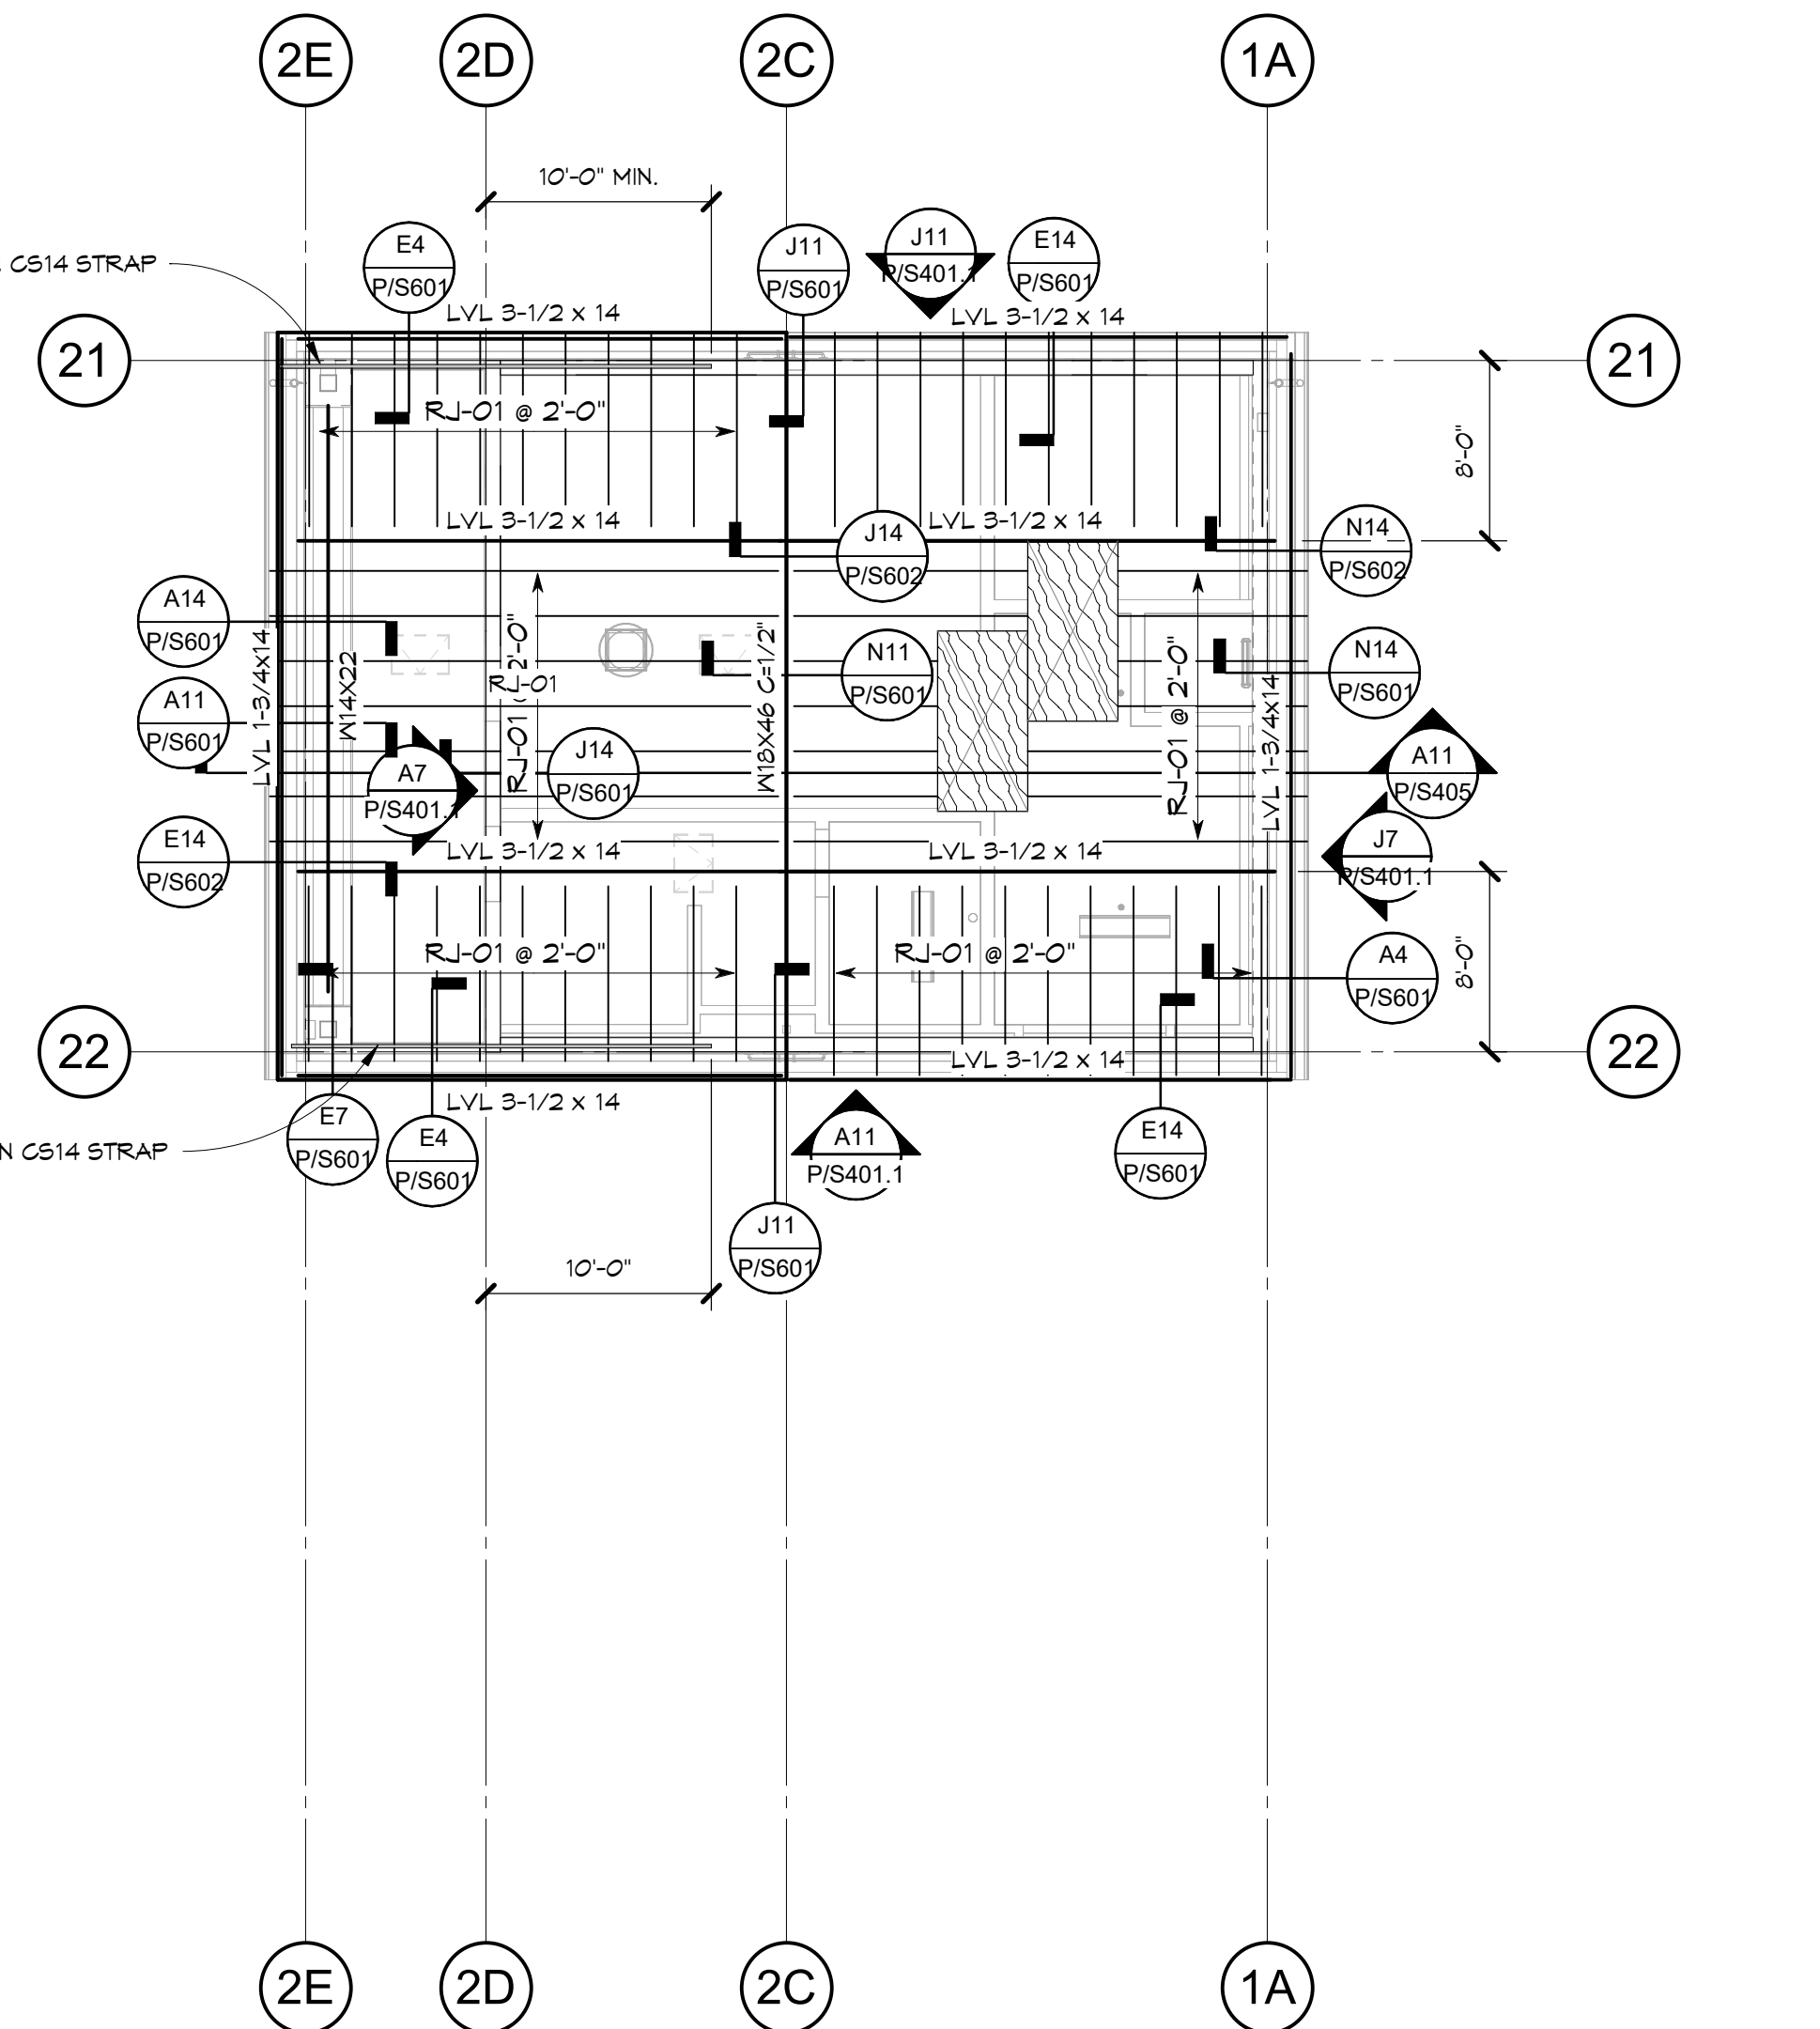

A7 ROOF FRAMING PLAN - BUILDING P2 ALT BID

P/S403 P/S201.1 1/8" = 1'-0"

- SEE TYPICAL SHEETS FOR ALL GENERAL AND MATERIAL NOTES, AND ALL TYPICAL SCHEDULES AND DETAILS. THE INFORMATION ON THE TYPICAL SHEETS APPLY TO THE PROJECT AND ARE NOT SPECIFICALLY REFERENCED ON PLAN WORK, UNLESS NOTED OTHERWISE. IF TYPICAL DETAILS ARE SPECIFIED ON PLANS OR NOTES, THEY WILL BE REFERENCED WITH THE WORD "TYPICAL" FOLLOWED BY **BOLD AND UNDERLINED** TEXT STATING THE TITLE OF THE TYPICAL DETAIL OR NOTE.
- ALL DIMENSIONS SHOWN ARE TO FACE OF EXTERIOR WALLS, CENTER OF COLUMN OR CENTER OF INTERIOR WALLS UNLESS NOTED OTHERWISE. EDGE OF SLAB AT PERIMETER OF BUILDING SHALL BE INDICATED IN SPECIFIC DETAILS AND ARCHITECTURAL. VERIFY ALL BUILDING DIMENSIONS WITH ARCHITECTURAL PLANS PRIOR TO CONSTRUCTION. NOTIFY THE ARCHITECT IMMEDIATELY IF THERE ARE ANY CONFLICTS WITH THE DIMENSIONS SHOWN.
- ALL UNCLEAR AND/OR MISSING DETAILS SHALL BE BROUGHT TO THE STRUCTURAL ENGINEER'S ATTENTION BEFORE PROCEEDING WITH CONSTRUCTION.
- ALL PAD AND CONTINUOUS FOOTINGS ARE TO BE CENTERED ON WALLS AND COLUMNS ABOVE UNLESS NOTED OTHERWISE.
- SEE CIVIL AND/OR ARCHITECTURAL SITE PLAN FOR LOCATION AND DIMENSIONS OF SIDEWALKS, MOW STRIPS, PLANTERS AND OTHER LANDSCAPING FEATURES.
- SEE ARCHITECTURAL AND PLUMBING PLANS FOR LOCATION OF ALL PIPING AND DRAINS. SEE TYPICAL DETAILS FOR STRUCTURAL REQUIREMENTS AT LOCATIONS WHERE PIPES INTERSECT OR ALIGN NEXT TO FOOTINGS AND SLABS.
- ALL EMBEDDED ITEMS SHALL BE IN PLACE AND SECURED PRIOR TO POURING OF CONCRETE.
- ALL SILL PLATE ANCHOR BOLTS SHALL BE SIZED, SPACED, PLACED, AND HAVE THE WASHER AND MATERIAL FINISH AS SPECIFIED IN THE **LIGHT GAUGE STEEL NOTES**.
- CONTRACTOR SHALL SUBMIT CONTROL JOINT PLAN FOR APPROVAL PRIOR TO POURING SLAB. SEE TYPICAL **CONTROL JOINT** DETAIL FOR ADDITIONAL INFORMATION.
- SEE TYPICAL **CMU WALL CONTROL JOINT REQUIREMENTS** DETAIL AND ARCHITECTURAL PLANS FOR LOCATION OF CONTROL JOINTS. NOTIFY THE ARCHITECT IMMEDIATELY IF THERE ARE ANY CONFLICTS WITH THE CONTROL JOINT LAYOUT.
- ALL TOP OF FOOTINGS SHALL BE 1'-8" BELOW FINISH SLAB, UNLESS NOTED OTHERWISE.
- ALL TOP OF FRAMING ABOVE FINISH SLAB VARIES. SEE PLAN FOR INFORMATION.
- VERIFY ROOF SLOPE(S) WITH ARCHITECTURAL PLANS.
- ALL FRAMING SHALL BE D.F. NO. 1 OR BETTER, UNLESS OTHERWISE NOTED. SEE TYPICAL **WOOD NOTES** ADDITIONAL INFORMATION.
- COORDINATE WITH ARCHITECTURAL IF ADDITIONAL FRAMING BLOCKING IS REQUIRED FOR SUSPENDED CEILING, SOFFITS AND FINISHES.
- DAPHRAGM SHEATHING SHALL BE BOUNDARY NAILED TO ALL BLOCKING, BEAM AND RAFTERS THAT ARE IN LINE WITH SHEAR WALLS.
- WHERE HEADERS ARE NOT SPECIFICALLY NOTED ON PLAN, SEE TYPICAL **WALL FRAMING AT OPENINGS** DETAIL FOR HEADER INFORMATION.
- ALL ITEMS ARE NEW UNLESS NOTED OTHERWISE.

L14 PLAN NOTES

P/S201.1 NOT TO SCALE

- CONCRETE CURB. SEE ARCHITECTURAL DRAWINGS FOR ADDITIONAL INFORMATION.
- 8" CMU WALL WITH #5 BARS AT 24" O.C. VERT. AND HORIZ. U.N.O. SEE TYPICAL **CONCRETE MASONRY UNIT WALL CONSTRUCTION** DETAIL.
- CONTROL JOINT. SEE TYPICAL **CMU WALL CONTROL JOINT REQUIREMENTS** DETAIL FOR ADDITIONAL INFORMATION.
- 18GA STEEL STUDS (#163 MIN. FLANGE) AT 16" O.C. AT INTERIOR WALL LOCATIONS. SEE ARCHITECTURAL AND TYPICAL **WALL FRAMING AT OPENINGS FOR LIGHT GAUGE STEEL** DETAIL.
- "XX" AS INDICATED ON PLAN. SEE TYPICAL **SCHEDULES** AS FOLLOWS:
 C# - COLUMN SCHEDULE
 P# - PLASTER SCHEDULE
 W# - WALL SCHEDULE
 F# - FOUNDATION SCHEDULE
- T.O.F. -X-X" TOP OF FOOTING (T.O.F.) OR BOTTOM OF FOOTING (B.O.F.). -X-X" IS THE DISTANCE FROM FINISHED FIRST FLOOR, UNLESS NOTED OTHERWISE.
- STEPPED FOOTING. SEE TYPICAL **STEPPED FOOTING** DETAIL.
- DEPRESSED SLAB. SEE ARCHITECTURAL DRAWINGS FOR ADDITIONAL INFORMATION.
- CONCRETE SLAB. PROVIDE 5" THICK MINIMUM SLAB WITH #4 AT 18" O.C. EACH WAY, U.N.O. SLAB SHALL BE PLACE OVER 1" TO 2" OF SATURATED SURFACE DRY (SSD) SAND OVER 10 ML VAPOR RETARDING MEMBRANE. SEE GEOTECHNICAL REPORT FOR ADDITIONAL INFORMATION.
- WALL BELOW. SEE FRAMING PLAN AT LEVEL BELOW.
- "XX" AS INDICATED ON PLAN. SEE TYPICAL **SCHEDULES** AS FOLLOWS:
 C# - COLUMN SCHEDULE
 P# - PLASTER SCHEDULE
 W# - WALL SCHEDULE
 F# - FOUNDATION SCHEDULE
- T.O.S. -X-X" TOP OF STEEL (T.O.S.) OR BOTTOM OF STEEL (B.O.S.). -X-X" IS THE DISTANCE FROM FINISHED FIRST FLOOR, UNLESS NOTED OTHERWISE.
- SIZE (STUDS) CAMBER. STEEL BEAM.
- ROOF SHEATHING. BLOCKED. PROVIDE 5/8" THICK SHEATHING WITH 10G NAILS @ 6" @ 12" U.N.O. SEE TYPICAL **ROOF SHEATHING** DETAIL.
- FIELD. PANEL EDGE. CONTINUOUS PANEL EDGE & BOUNDARY.

E14 PLAN LEGEND

P/S201.1 NOT TO SCALE

STRUCTURAL FOUNDATION SCHEDULE		
MARK	TYPE	REINFORCEMENT
F5	5'-0" SQ. X 1'-6" DEEP	(7) #5 BARS EACH WAY TOP AND BOTTOM
F1.5	1'-6" SQ. X 2'-0" DEEP	(13) #5 BARS EACH WAY TOP & BOTTOM
PF4	4'-0" Ø X 1'-0" DEEP	(24) #5 VERTICAL BARS W/ #4 TIES AT 6" O.C.
WF2	2'-0" WIDE X 1'-6" DEEP CONT.	(3) #5 BARS TOP & BOTTOM
WF5	5'-0" WIDE X 1'-6" DEEP CONT.	SEE TYPICAL N11/X/S104

STRUCTURAL COLUMN SCHEDULE		
MARK	TYPE	COMMENTS
C4	H564X4X1/4	SEE TYPICAL A14/X/S105 FOR ADD'L INFO.
C5	H565X5X1/4	SEE TYPICAL A14/X/S105 FOR ADD'L INFO.
C8	H568X8X3/8	SEE TYPICAL A14/X/S105 FOR ADD'L INFO.
C10	H5610X10X5/8	SEE DETAIL A11/P/S501 FOR ADD'L INFO.
P4	H564X4X1/4	SEE DETAIL J4/P/S601 FOR ADD'L INFO.

A14 SCHEDULES

NOT TO SCALE

DSA File No.:
 DSA Application No.: 02-120251
 Agency Approval

BrooksRansom ASSOCIATES
 CONSULTANT
 22106
 1600 440-844 OFFICE (1610) 440-840 FAX

Professional Engineer
 ERIC BAIN
 No. 52386
 Exp. 12-31-24
 STATE OF CALIFORNIA

Mission Oak HS Aquatic Complex
 Tulare Joint Union High School District
 Tulare, CA 93274
 Project

Building P
 ALTERNATE BID - BUILDING P2
 Drawing




darden ARCHITECTURE PLANNING INTERIORS
 ARCHITECT
 www.dardenarchitects.com
 6790 N. West Ave. • Fresno, CA 93711 • T. 559.448.8051

Professional Architect
 ERIC BAIN
 No. 023724
 Exp. 4-30-25
 STATE OF CALIFORNIA

No.	Revision/Submission	Date
1	REVISION_1	05/31/2023

Scale: As indicated
 Project Number: 2180
 Date: 11/16/2022

Designed Designer: Copyright Darden Architects
 Drawn By: Author
 Checked/Checker: P/S201.1
 Review/Approver: Sheet of

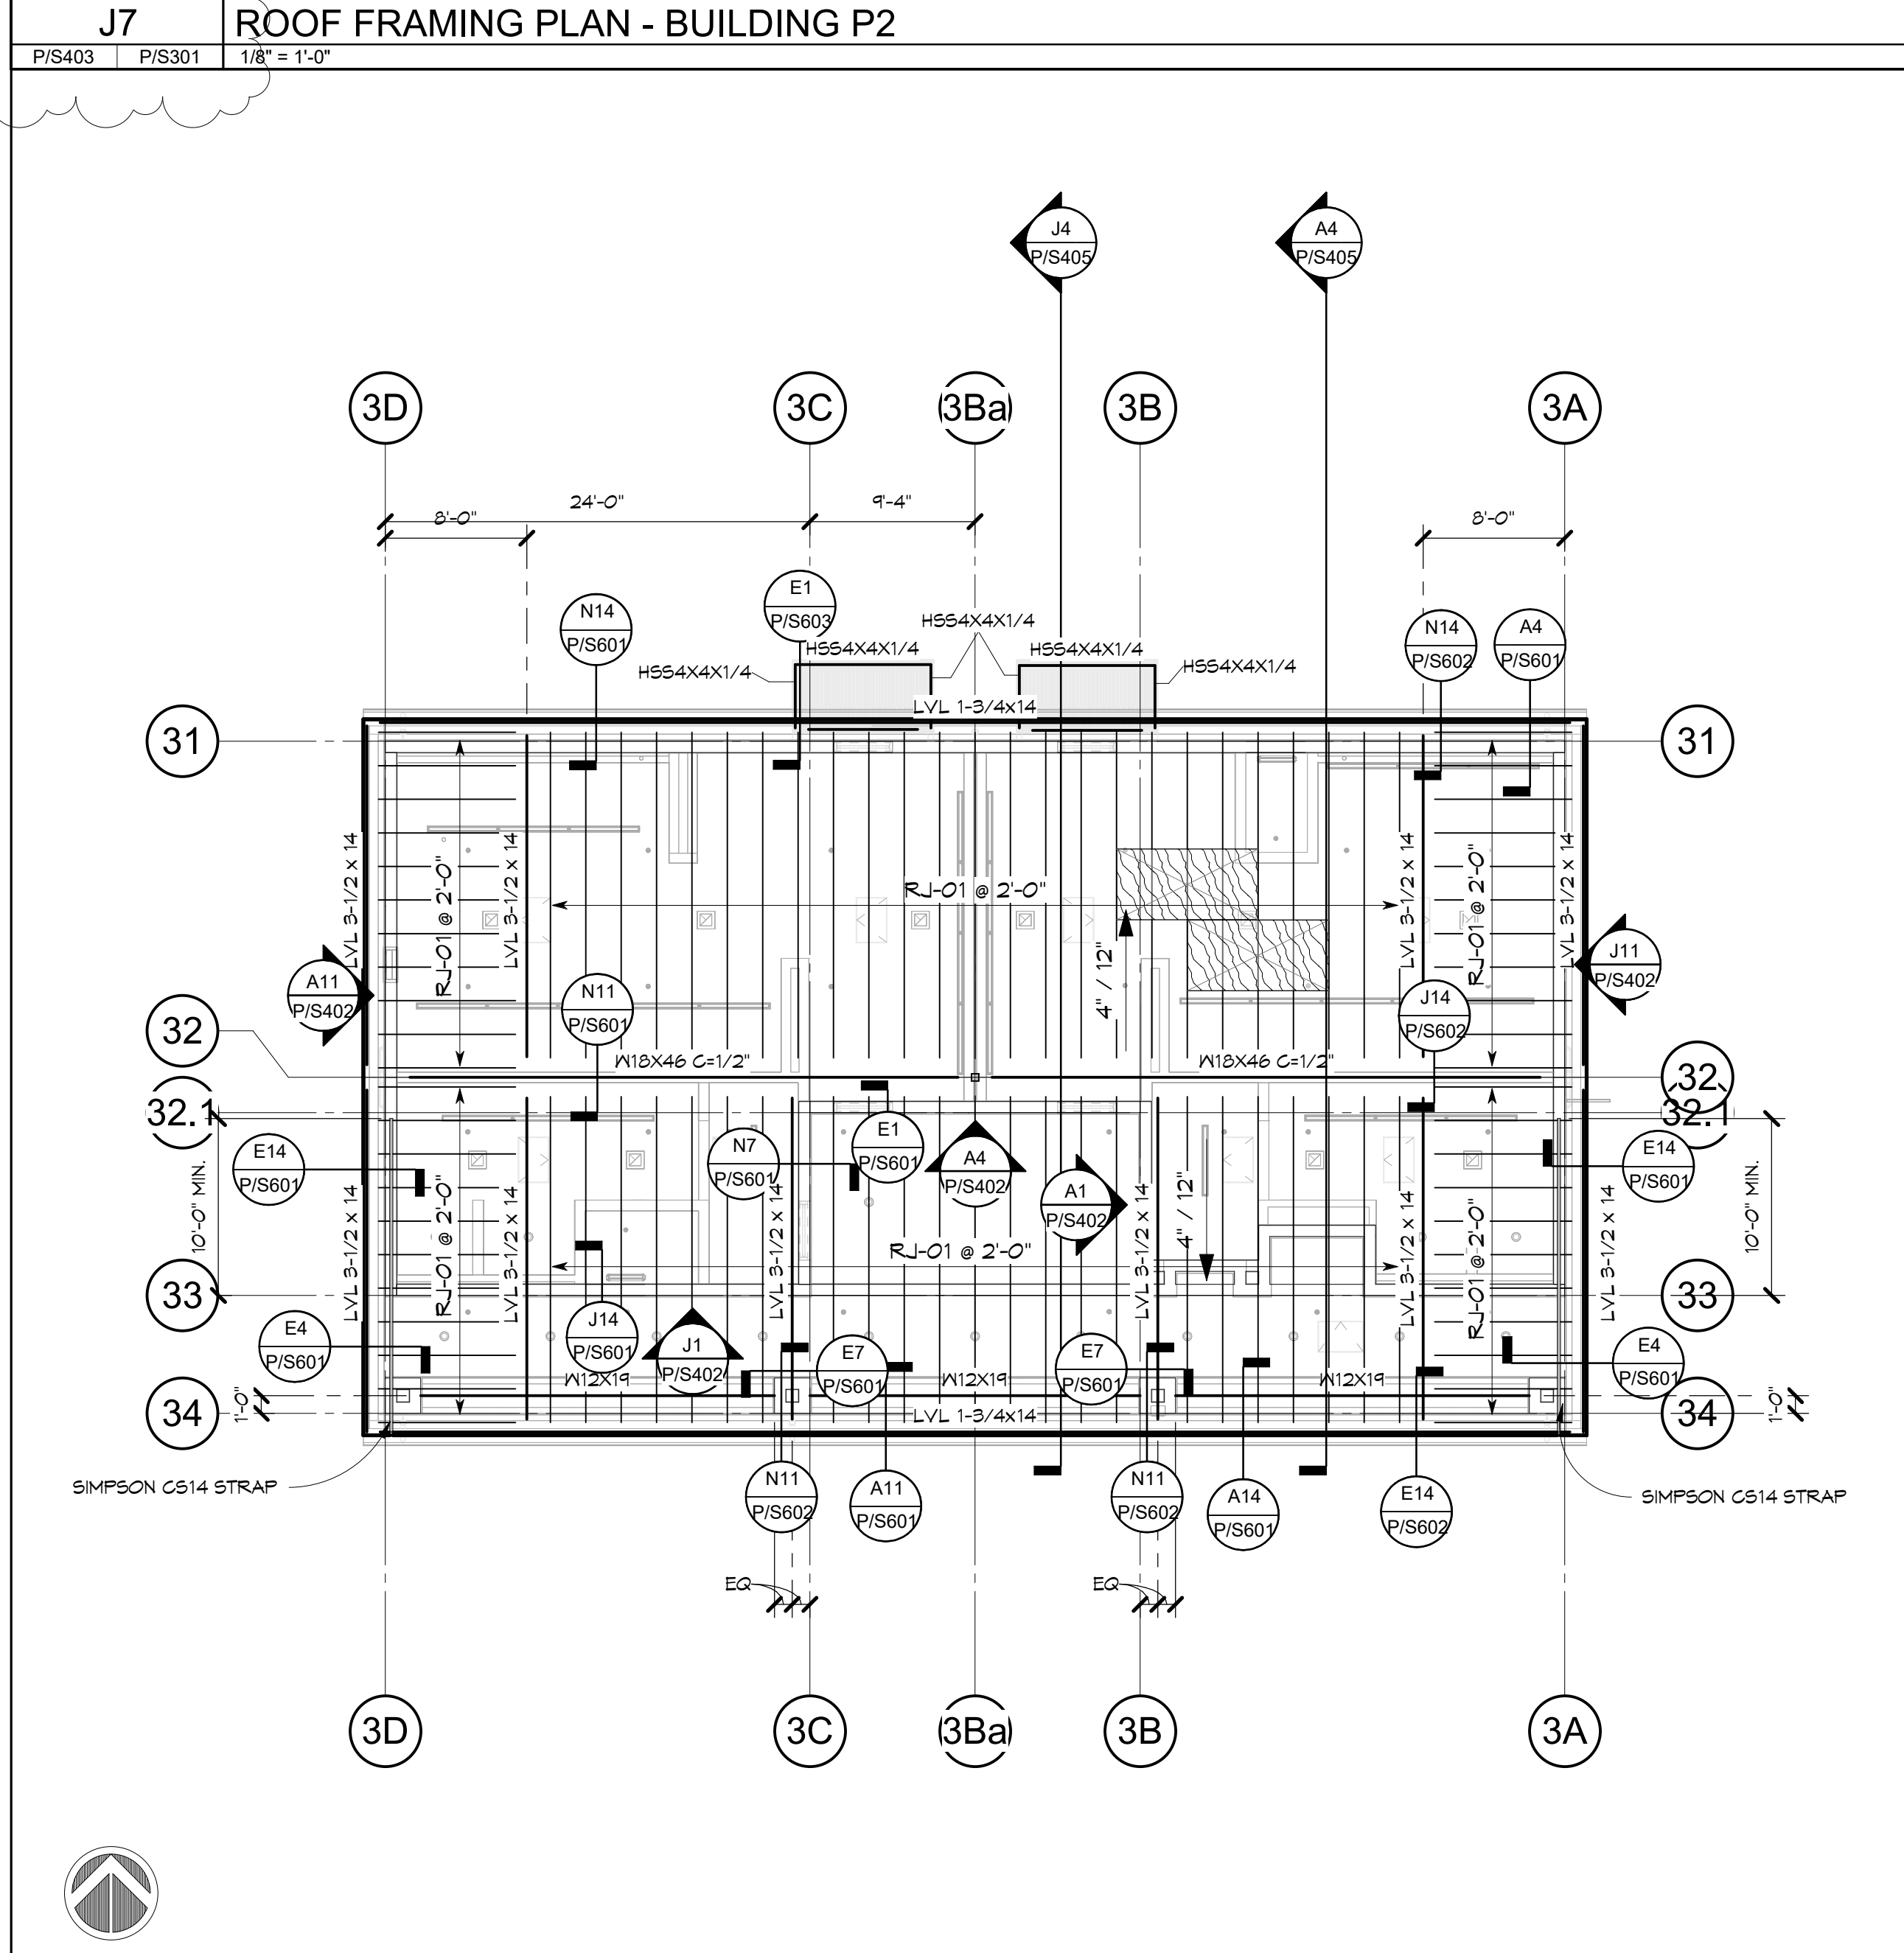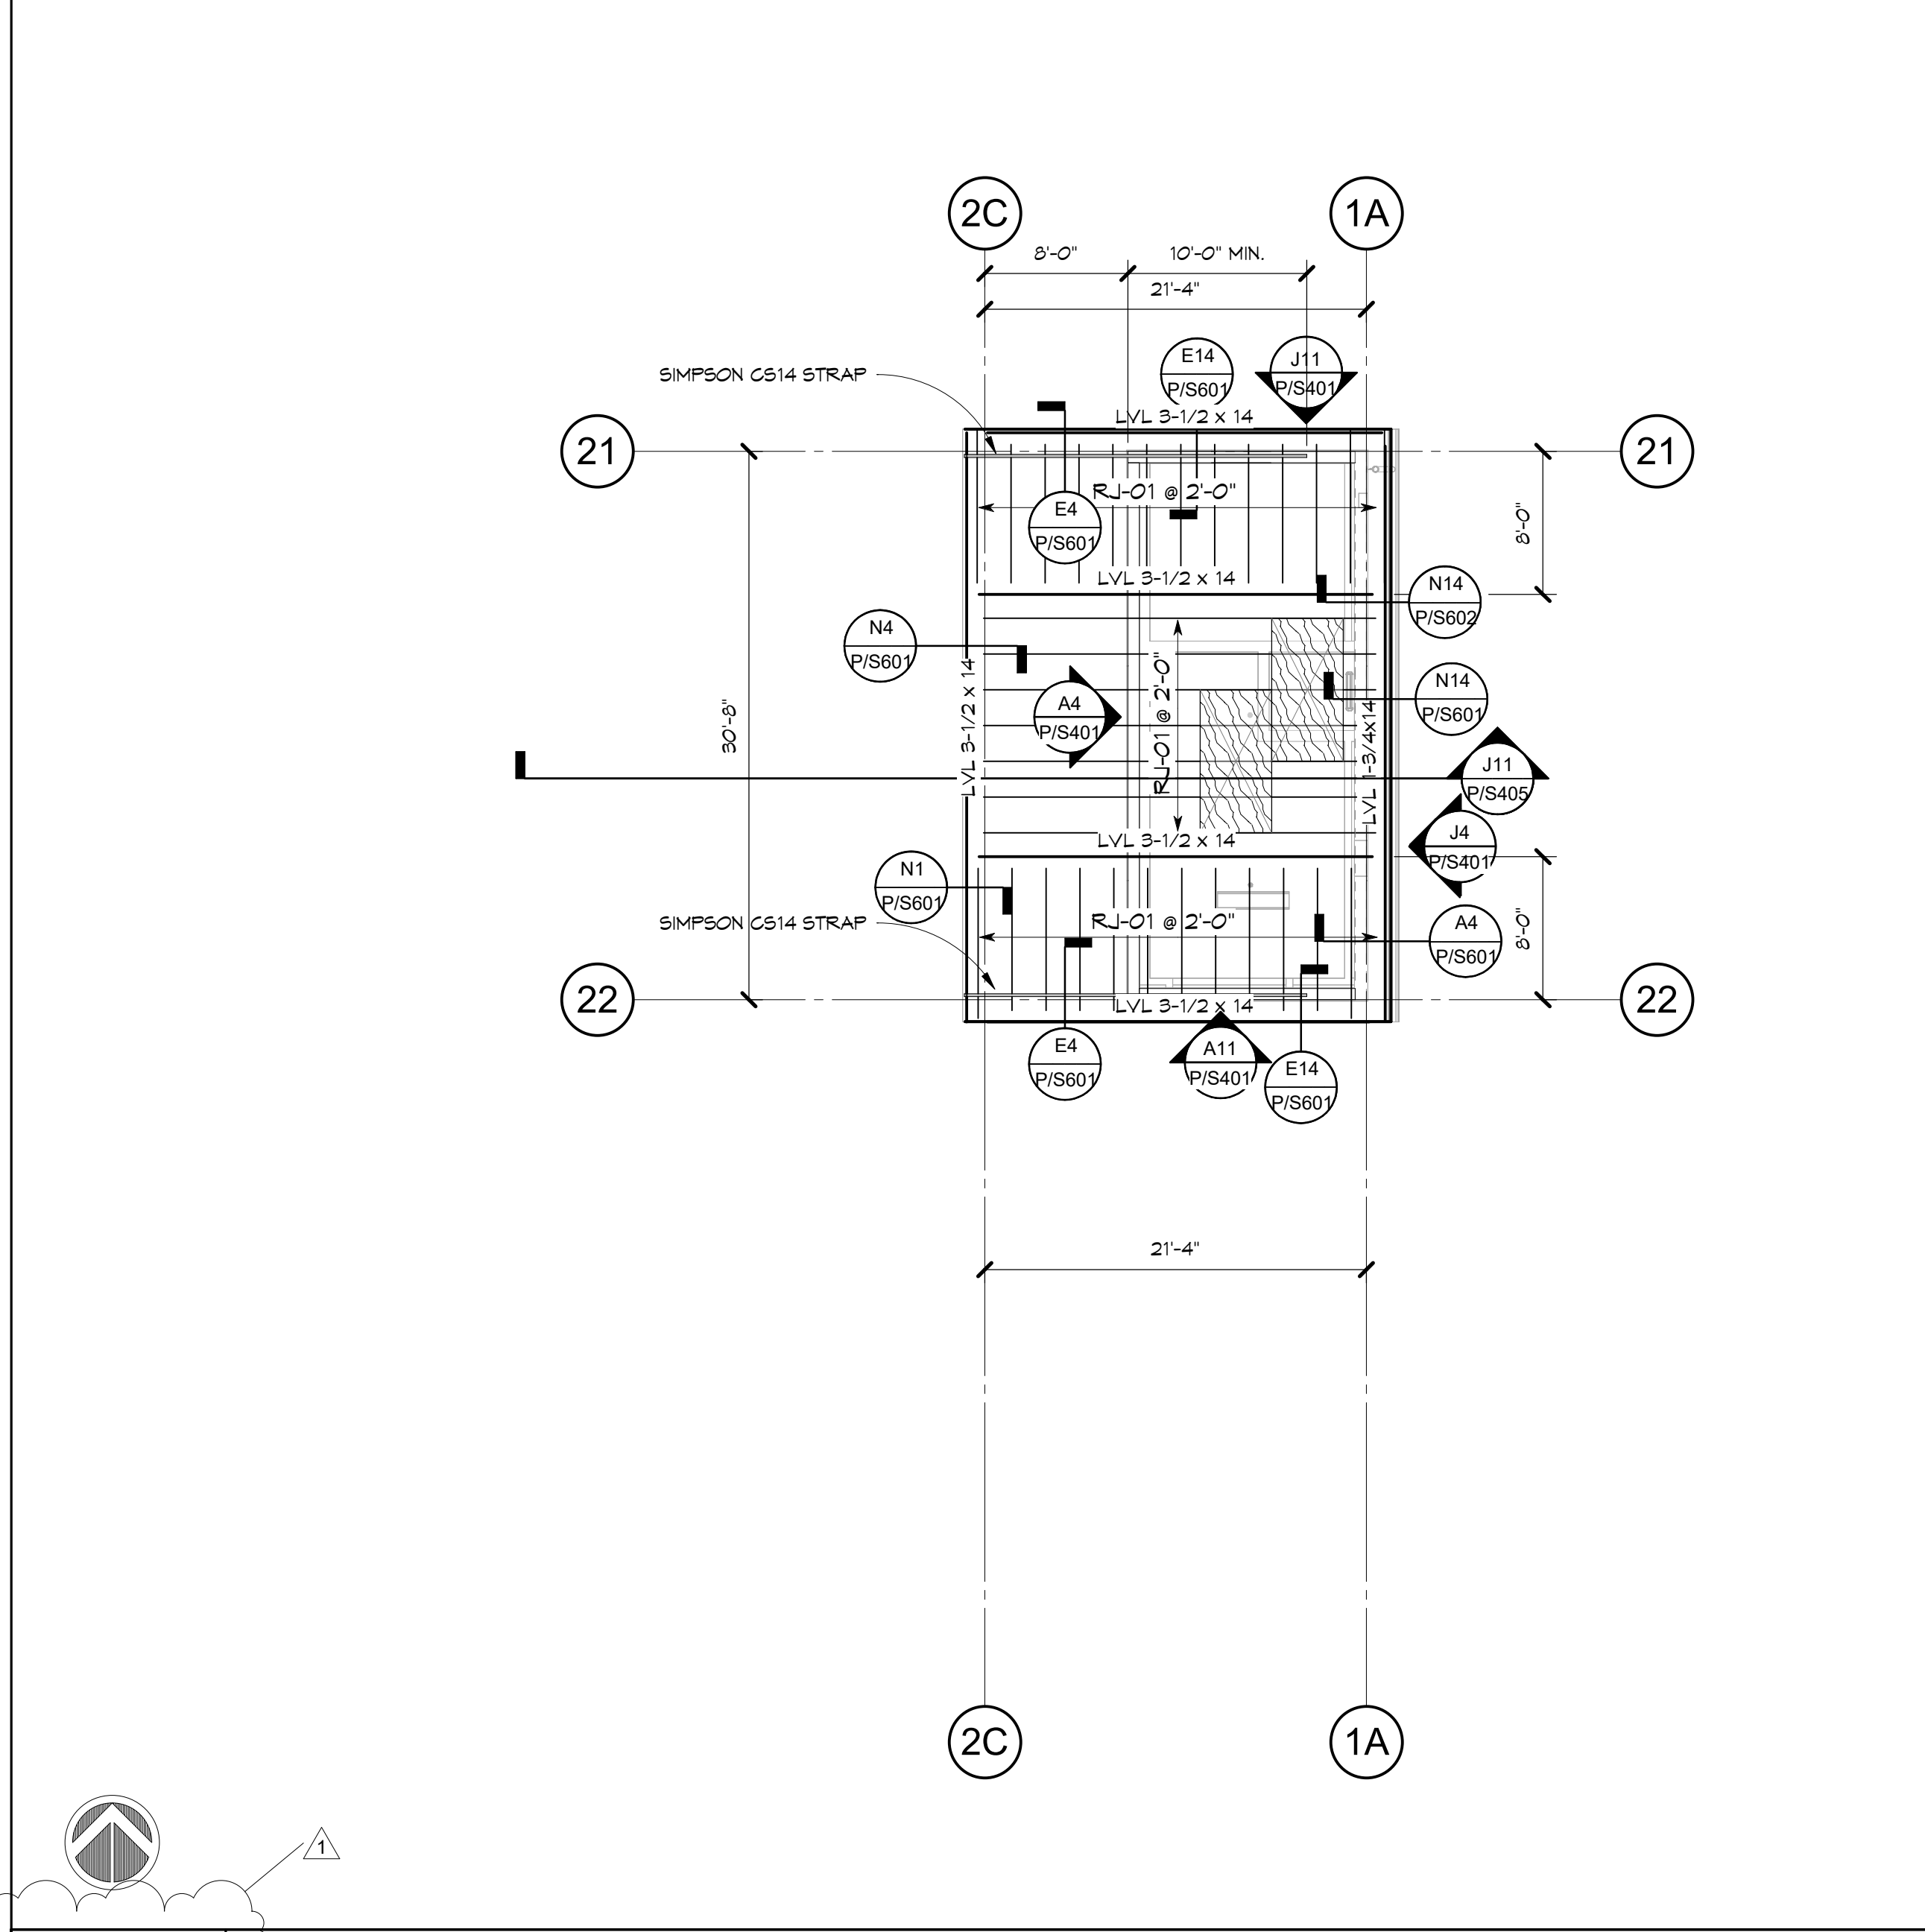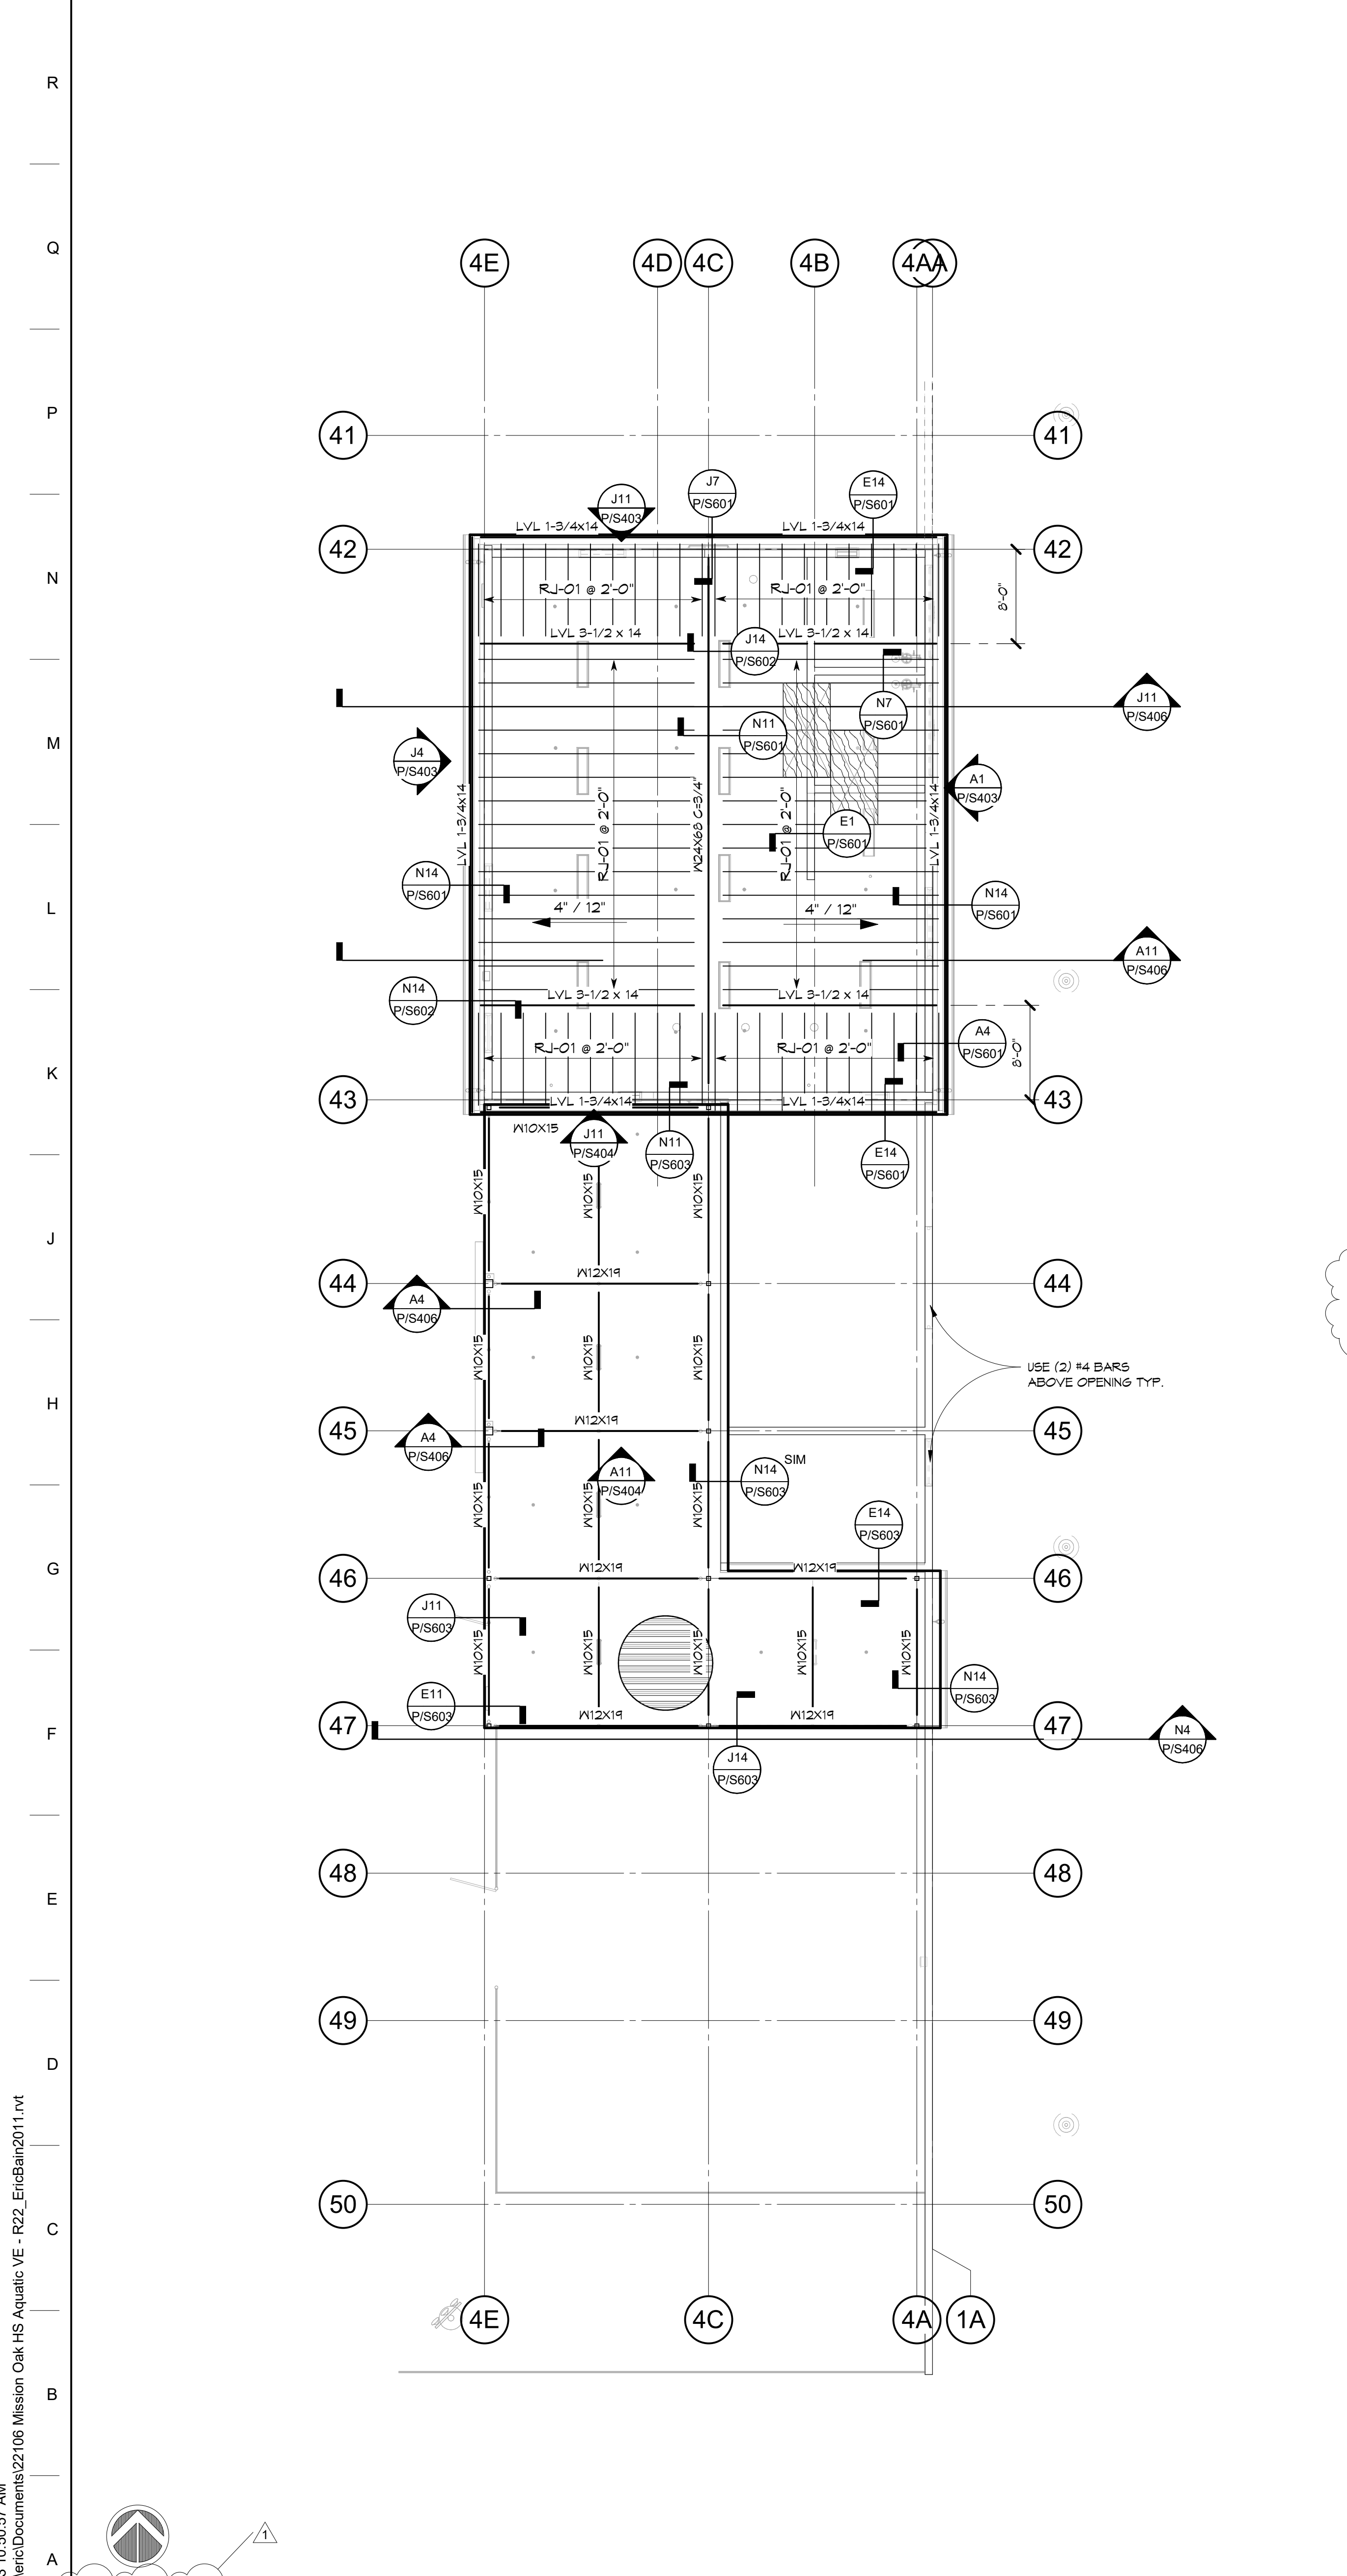

- SEE TYPICAL SHEETS FOR ALL GENERAL AND MATERIAL NOTES, AND ALL TYPICAL SCHEDULES AND DETAILS. THE INFORMATION ON THE TYPICAL SHEETS APPLY TO THE PROJECT AND ARE NOT SPECIFICALLY REFERENCED ON PLAN WORK, UNLESS NOTED OTHERWISE. IF TYPICAL DETAILS ARE SPECIFIED ON PLANS OR NOTES, THEY WILL BE REFERENCED WITH THE WORD "TYPICAL" FOLLOWED BY **BOLD AND UNDERLINED** TEXT STATING THE TITLE OF THE TYPICAL DETAIL OR NOTE.
- ALL UNCLEAR AND/OR MISSING DETAILS SHALL BE BROUGHT TO THE STRUCTURAL ENGINEER'S ATTENTION BEFORE PROCEEDING WITH CONSTRUCTION.
- ALL TOP OF FRAMING ABOVE FINISH SLAB VARIES, SEE PLAN FOR INFORMATION.
- VERIFY ROOF SLOPE(S) WITH ARCHITECTURAL PLANS.
- ALL FRAMING SHALL BE D.F. NO. 1 OR BETTER, UNLESS OTHERWISE NOTED. SEE TYPICAL **WOOD NOTES** ADDITIONAL INFORMATION.
- COORDINATE WITH ARCHITECTURAL IF ADDITIONAL FRAMING BLOCKING IS REQUIRED FOR SUSPENDED CEILING, SOFFITS AND FINISHES.
- DAPHRAGM SHEATHING SHALL BE BOUNDARY NAILED TO ALL BLOCKING, BEAM AND RAFTERS THAT ARE IN LINE WITH SHEAR WALLS.
- WHERE HEADERS ARE NOT SPECIFICALLY NOTED ON PLAN, SEE TYPICAL **WALL FRAMING AT OPENINGS** DETAIL FOR HEADER INFORMATION.
- ALL ITEMS ARE NEW UNLESS NOTED OTHERWISE.

N14 FRAMING NOTES	
P/S301	NOT TO SCALE
	8" CMU WALL WITH #5 BARS AT 24" O.C. VERT. AND HORIZ. U.N.O. SEE TYPICAL CONCRETE MASONRY UNIT WALL CONSTRUCTION DETAIL.
	WALL BELOW. SEE FRAMING PLAN AT LEVEL BELOW.
	"X" AS INDICATED ON PLAN. SEE TYPICAL SCHEDULES AS FOLLOWS: C - COLUMN SCHEDULE PI - PLASTER SCHEDULE W - WALL SCHEDULE F - FOUNDATION SCHEDULE
	T.O.S. "X-X" TOP OF STEEL (T.O.S.) OR BOTTOM OF STEEL (B.O.S.). "X-X" IS THE DISTANCE FROM FINISHED FIRST FLOOR, UNLESS NOTED OTHERWISE.
	STEEL BEAM.
	ROOF SHEATHING, BLOCKED. PROVIDE 5/8" THICK SHEATHING WITH 10d NAILS @ 6" O.C. U.N.O. SEE TYPICAL ROOF SHEATHING DETAIL.
	FIELD
	PANEL EDGE
	CONTINUOUS PANEL EDGE & BOUNDARY
	METAL DECK. INDICATES DIRECTION OF DECKING. SEE TYPICAL METAL ROOF DECK NOTES AND TYPICAL DECK ATTACHMENT LAYOUT DETAILS FOR ADDITIONAL INFORMATION.

J14 FRAMING LEGEND	
P/S301	NOT TO SCALE

STRUCTURAL COLUMN SCHEDULE		
MARK	TYPE	COMMENTS
C4	H554X4X1/4	SEE TYPICAL A14/X/S105 FOR ADD'L INFO.
C5	H558X8X1/4	SEE TYPICAL A14/X/S105 FOR ADD'L INFO.
C6	H558X8X3/8	SEE TYPICAL A14/X/S105 FOR ADD'L INFO.
C10	H5510X10X5/8	SEE DETAIL A11/P/S501 FOR ADD'L INFO.
P4	H554X4X1/4	SEE DETAIL J4/P/S601 FOR ADD'L INFO.

E14 SCHEDULE	
P/S301	NOT TO SCALE

A1 ROOF FRAMING PLAN - BUILDING P4
P/S403 P/S301 1/8" = 1'-0"

A7 ROOF FRAMING PLAN - BUILDING P3
P/S403 P/S301 1/8" = 1'-0"

DSA File No.:
DSA Application No.: 02-120251
Agency Approval

BrooksRansom ASSOCIATES
22106
Consultant

Mission Oak HS Aquatic Complex
Tulare Joint Union High School District
Tulare, CA 93274
Project

Building P
ROOF FRAMING PLANS
Drawing


darden ARCHITECTURE PLANNING INTERIORS
www.dardenarchitects.com
6790 N. West Ave. • Fresno, CA 93711 • T. 559.448.8051
Architect

No.	Revision/Submission	Date
1	REVISION_1	05/31/2023

Revision


Designed By: ESB Copyright Darden Architects
Scale: As indicated Drawn By: ESB
Project Number: 2180 Checked By: ESB
Date: 11/16/2022 Reviewed By: ESB

P/S301
Sheet: _____ of: _____

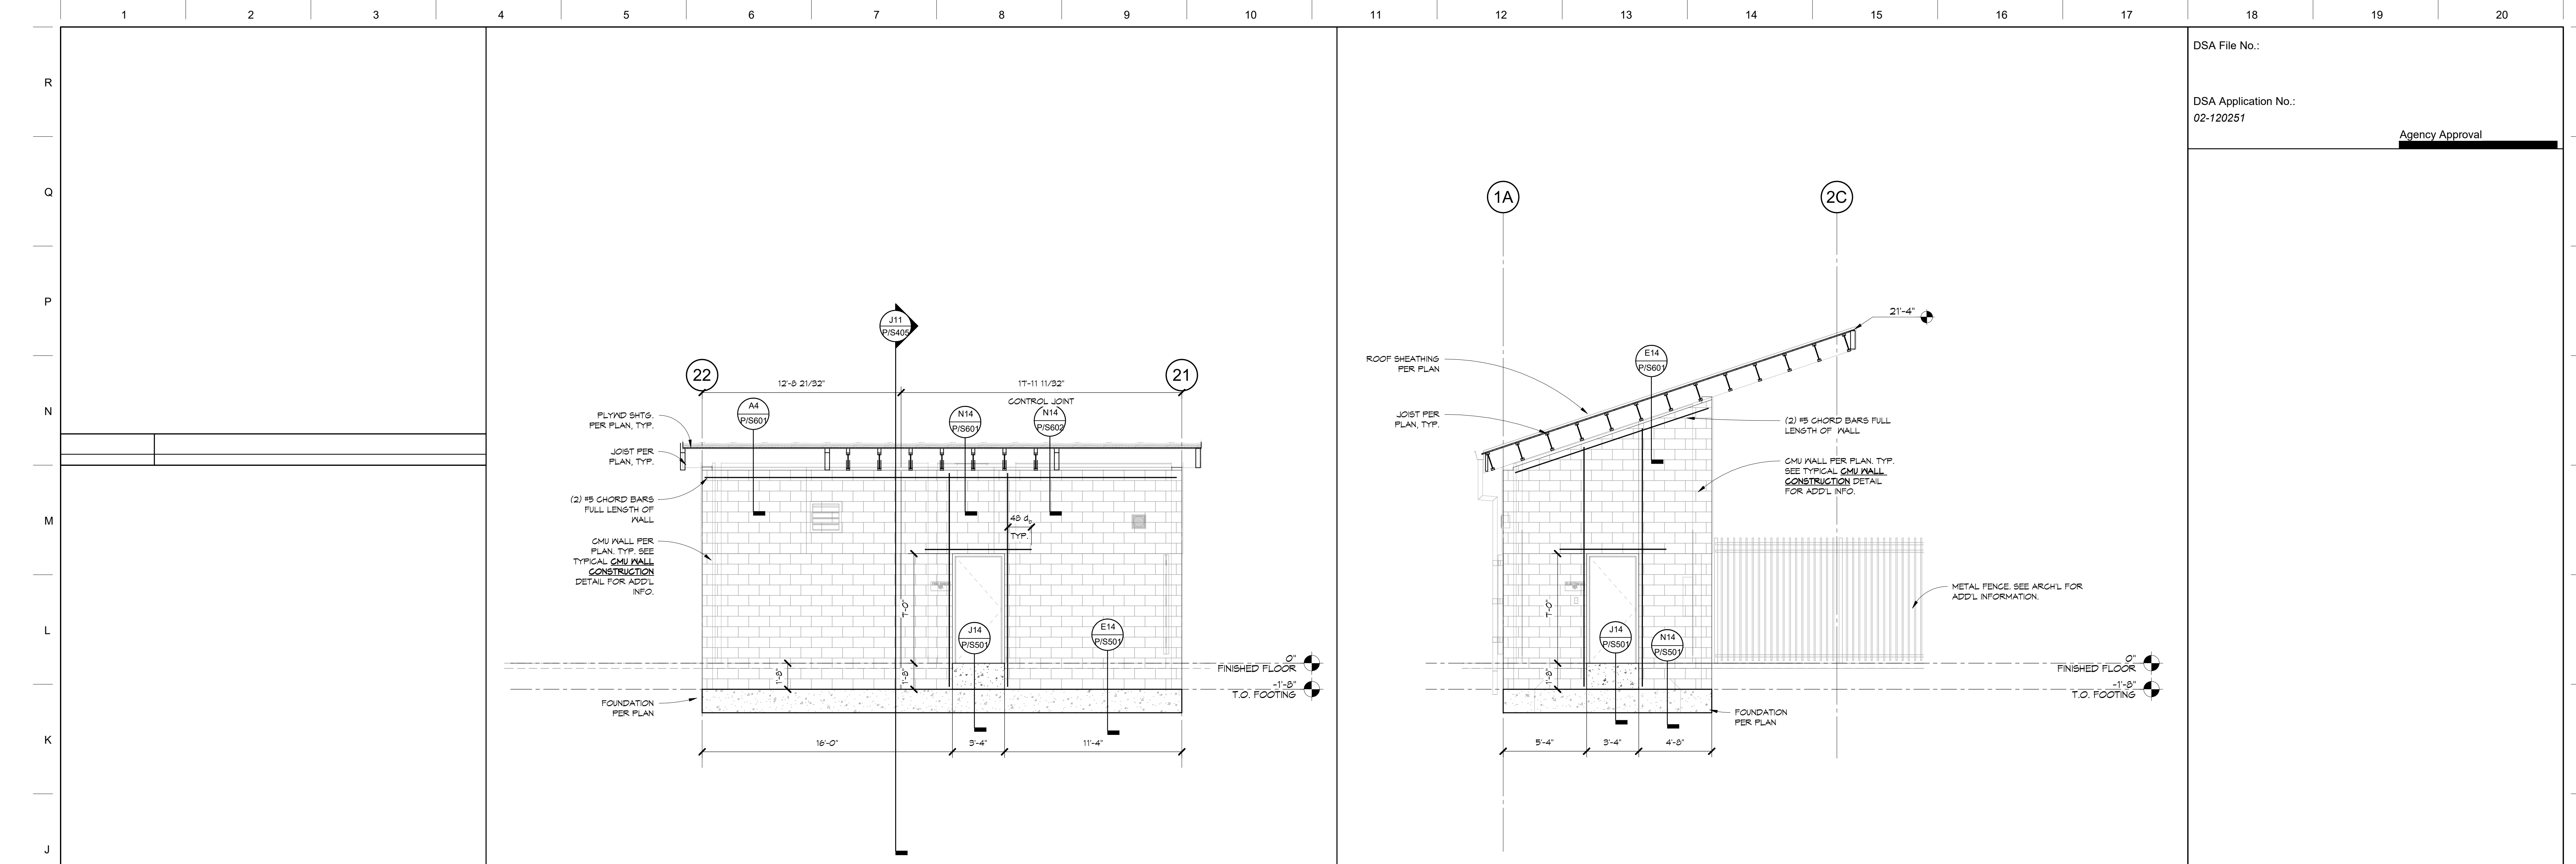

J4 WALL ELEVATION AT GL '1A' - P2
P/S201 P/S401 1/4" = 1'-0"

J11 WALL ELEVATION AT GL '21' - P2
P/S201 P/S401 1/4" = 1'-0"

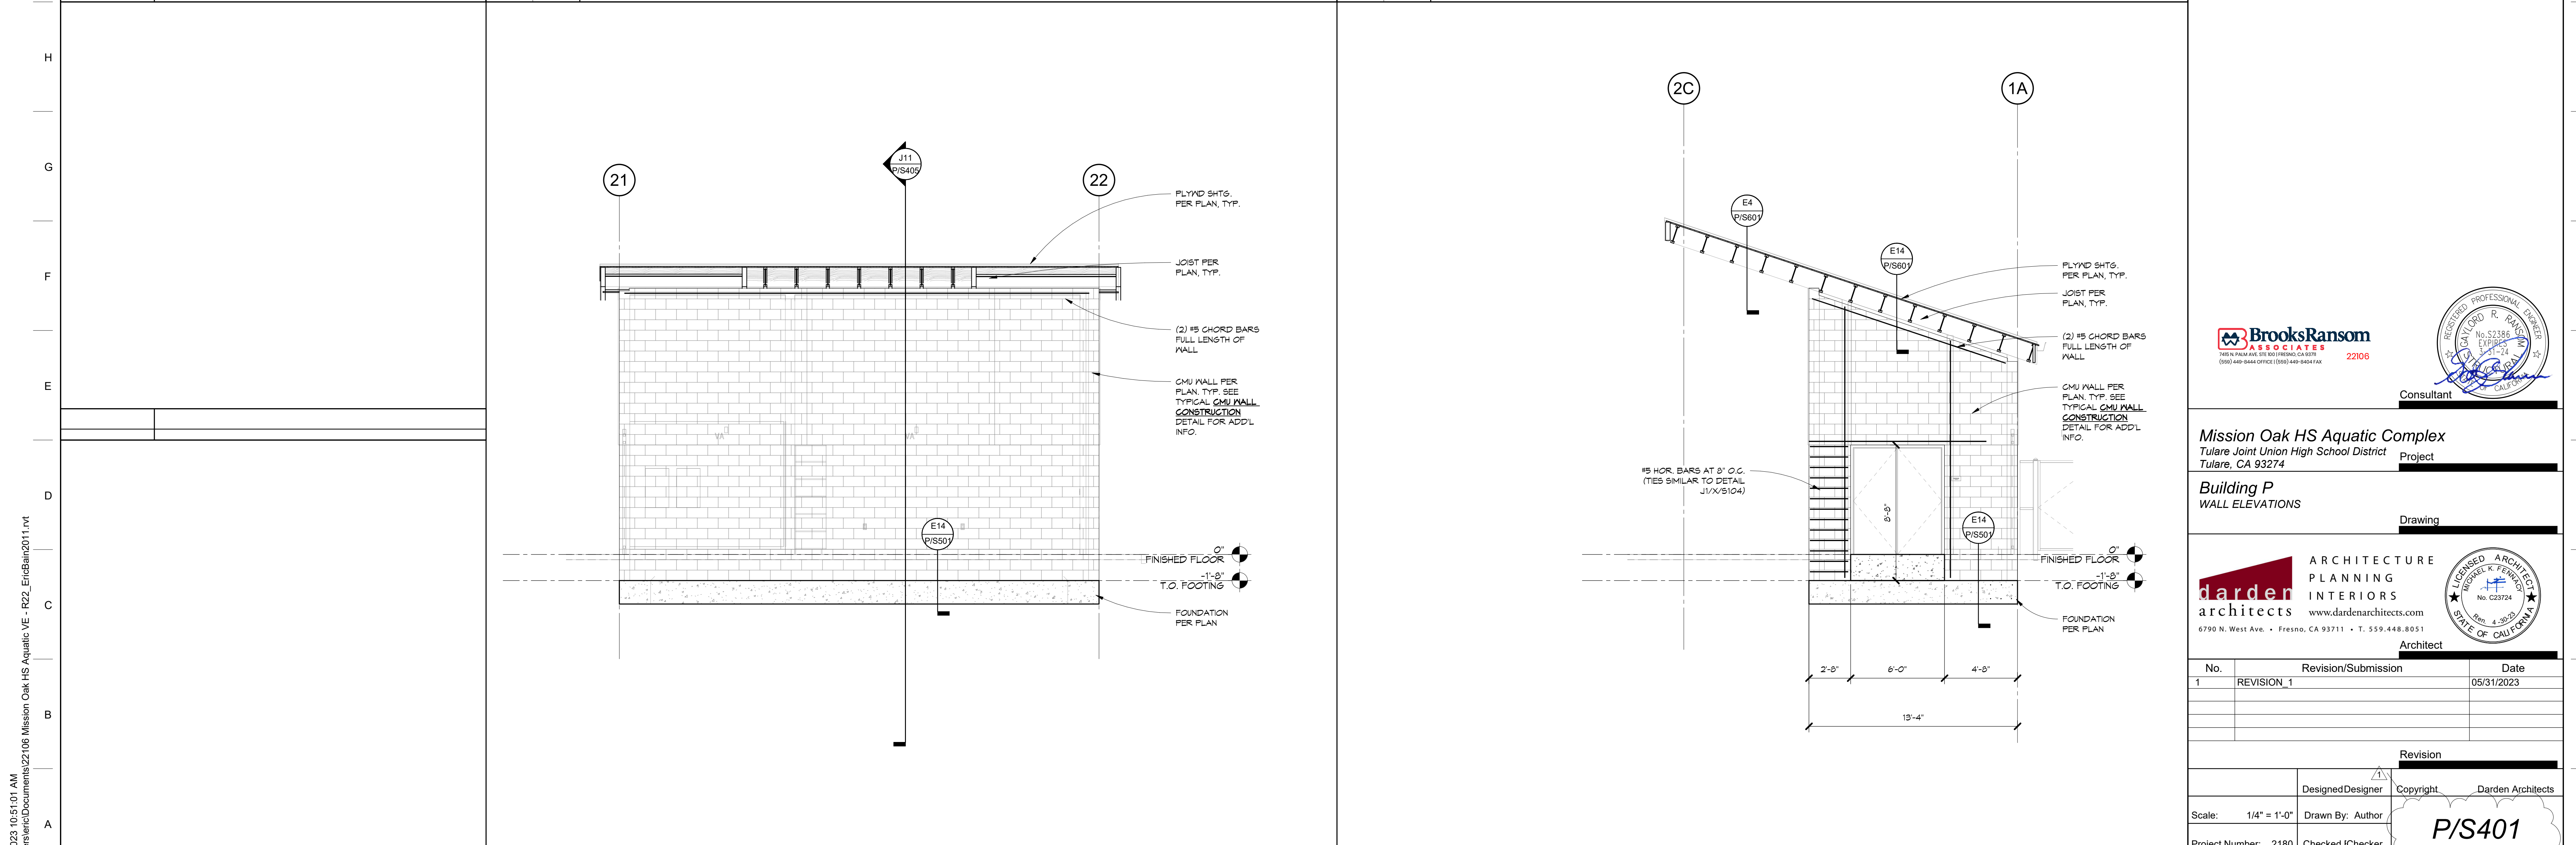

A4 WALL ELEVATION AT GL '2D' - P2
P/S201 P/S401 1/4" = 1'-0"

A11 WALL ELEVATION AT GL '22' - P2
P/S201 P/S401 1/4" = 1'-0"

DSA File No.:
DSA Application No.: 02-120251
Agency Approval

BrooksRansom ASSOCIATES
CONSULTANTS ARCHITECTS ENGINEERS
(660) 448-8444 OFFICE (660) 448-8400 FAX
22106
No. 52386
E121000
02-1-24
CALIFORNIA REGISTERED PROFESSIONAL ENGINEER
No. 52386
02-1-24
CALIFORNIA REGISTERED PROFESSIONAL ARCHITECT
No. C23724
04-30-23
STATE OF CALIFORNIA
Consultant

Mission Oak HS Aquatic Complex
Tulare Joint Union High School District
Tulare, CA 93274
Building P
WALL ELEVATIONS
Project
Drawing




darden architects ARCHITECTURE PLANNING INTERIORS
www.dardenarchitects.com
6790 N. West Ave. • Fresno, CA 93711 • T. 559.448.8051
ARCHITECT
No. C23724
04-30-23
STATE OF CALIFORNIA

No.	Revision/Submission	Date
1	REVISION_1	05/31/2023


Revision

Designed Designer	Copyright	Darden Architects
Scale: 1/4" = 1'-0"	Drawn By: Author	P/S401
Project Number: 2180	Checked IChecker	
Date: 11/16/2022	Review/Approver	Sheet: of

 
8/18/2023 10:51:01 AM C:\Users\eric\Documents\22106 Mission Oak HS Aquatic VE - R22_EricBain2011.rvt

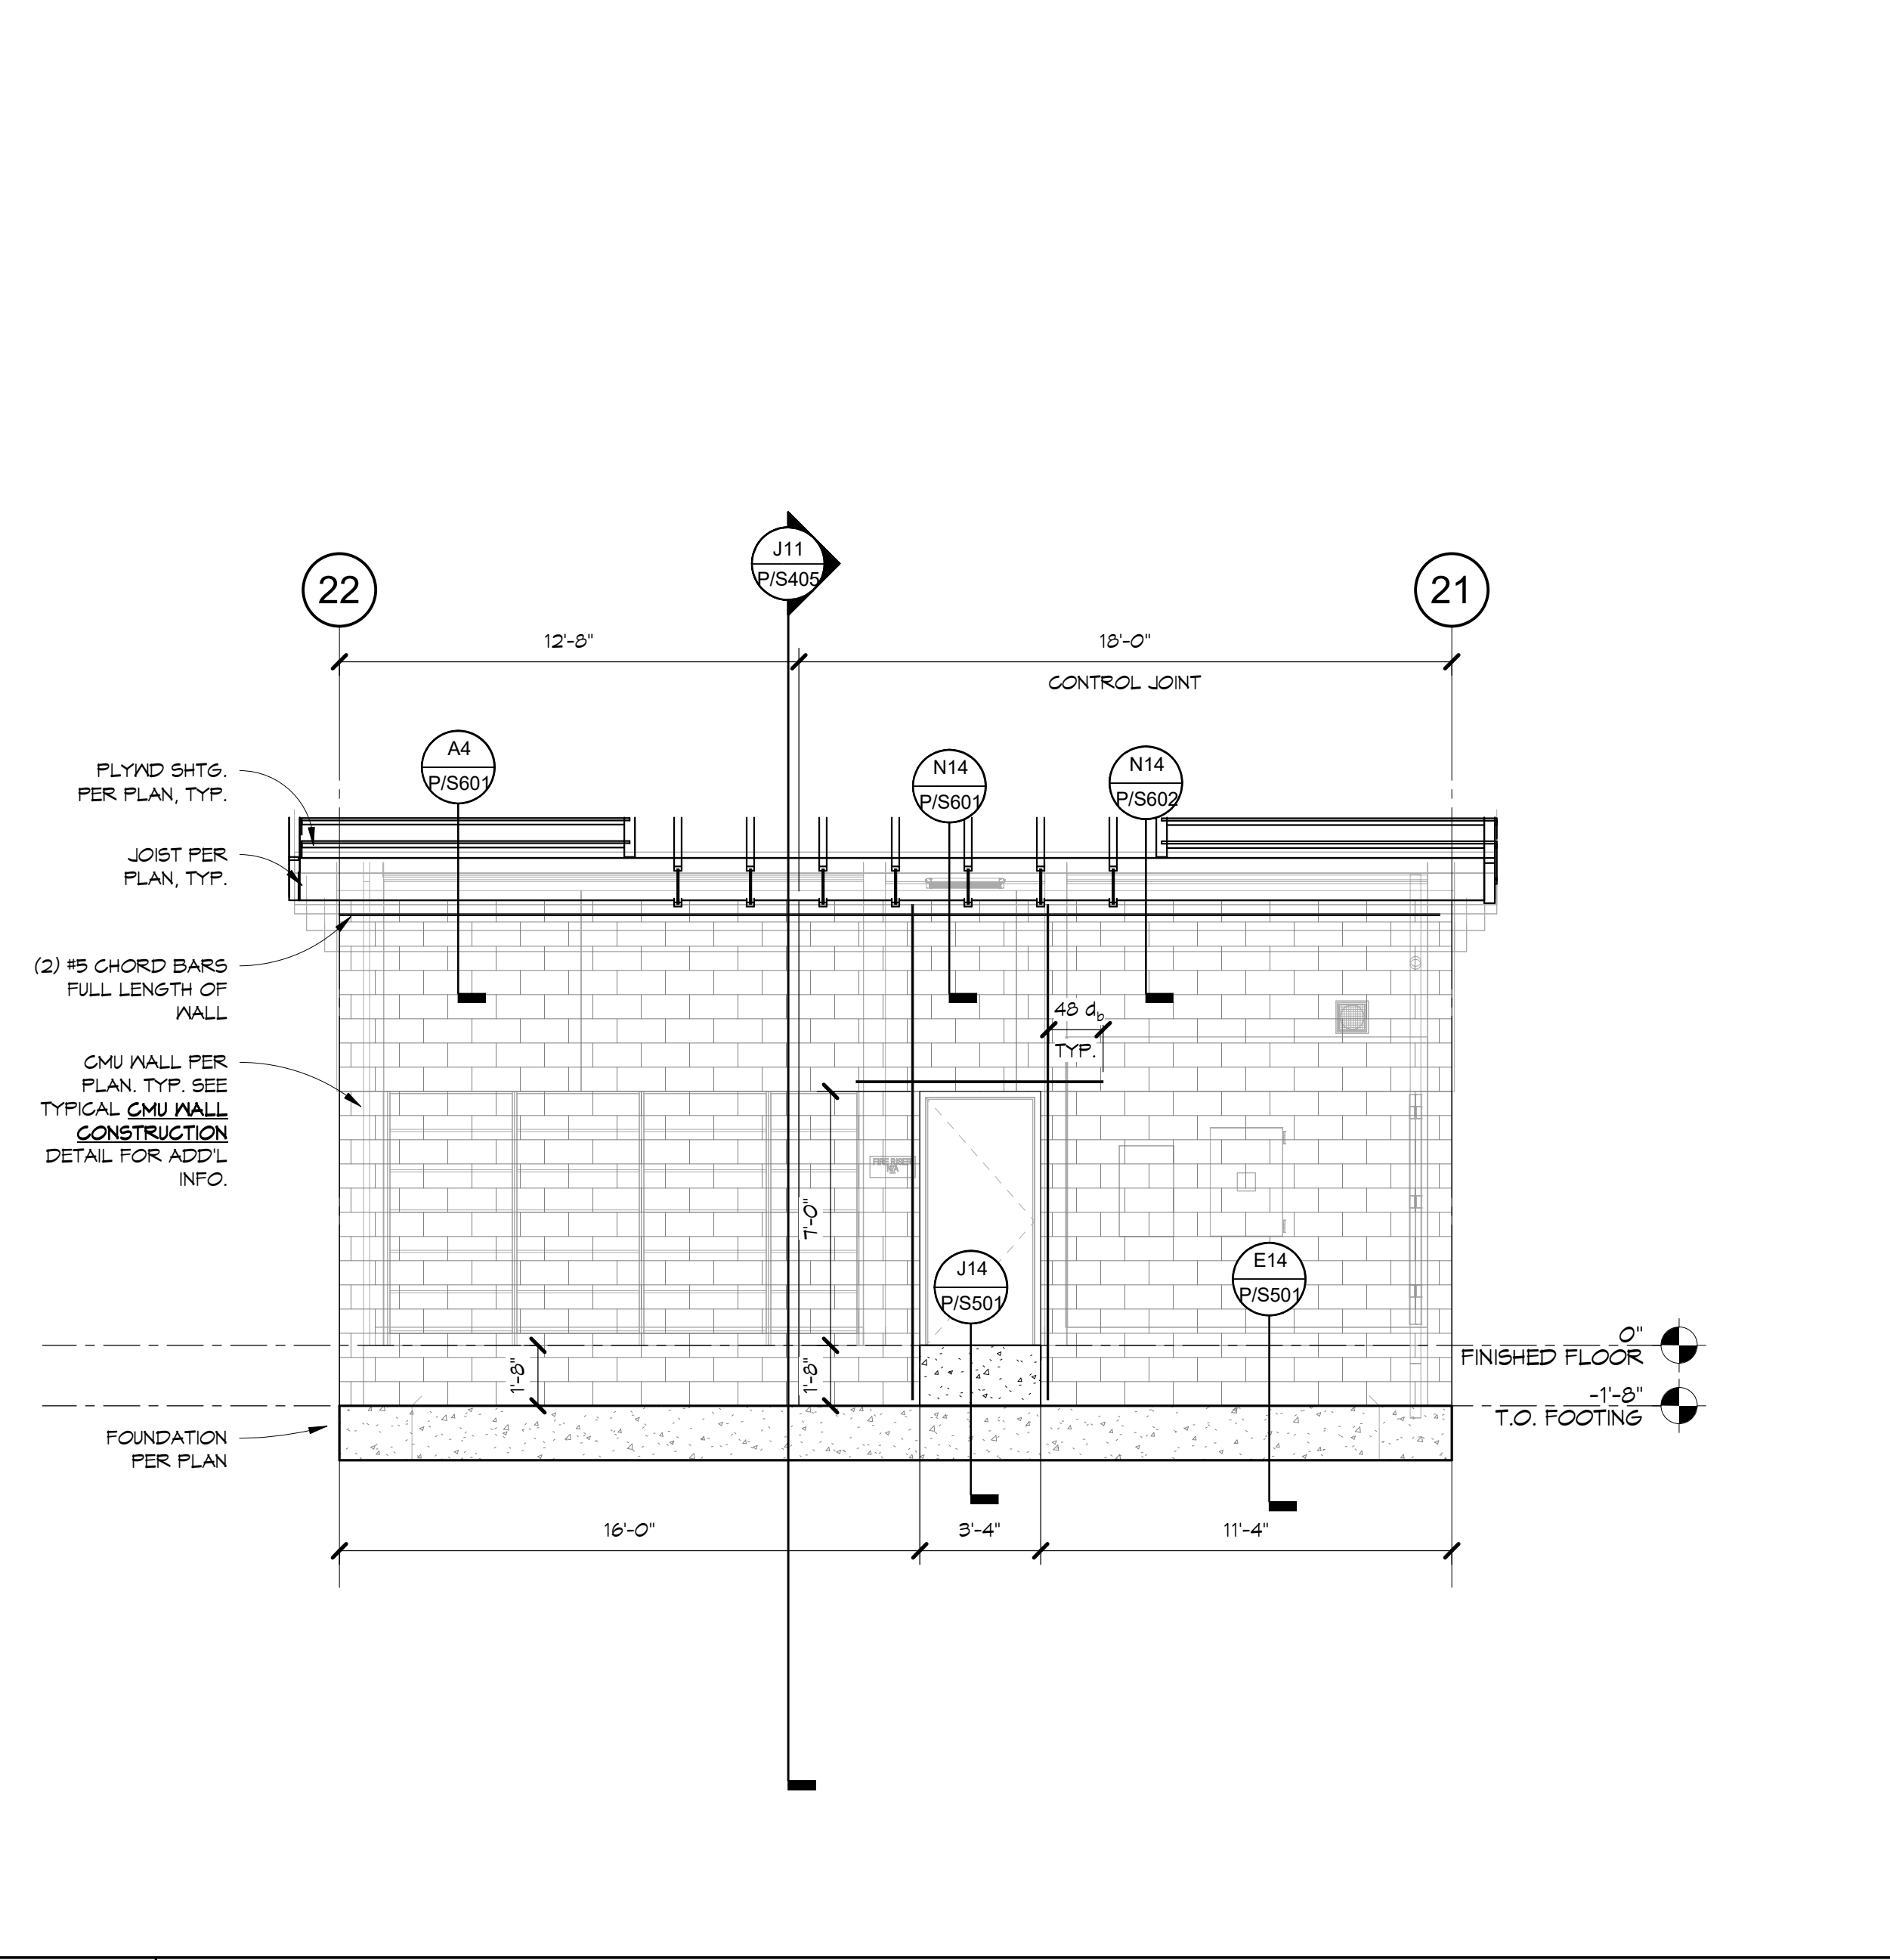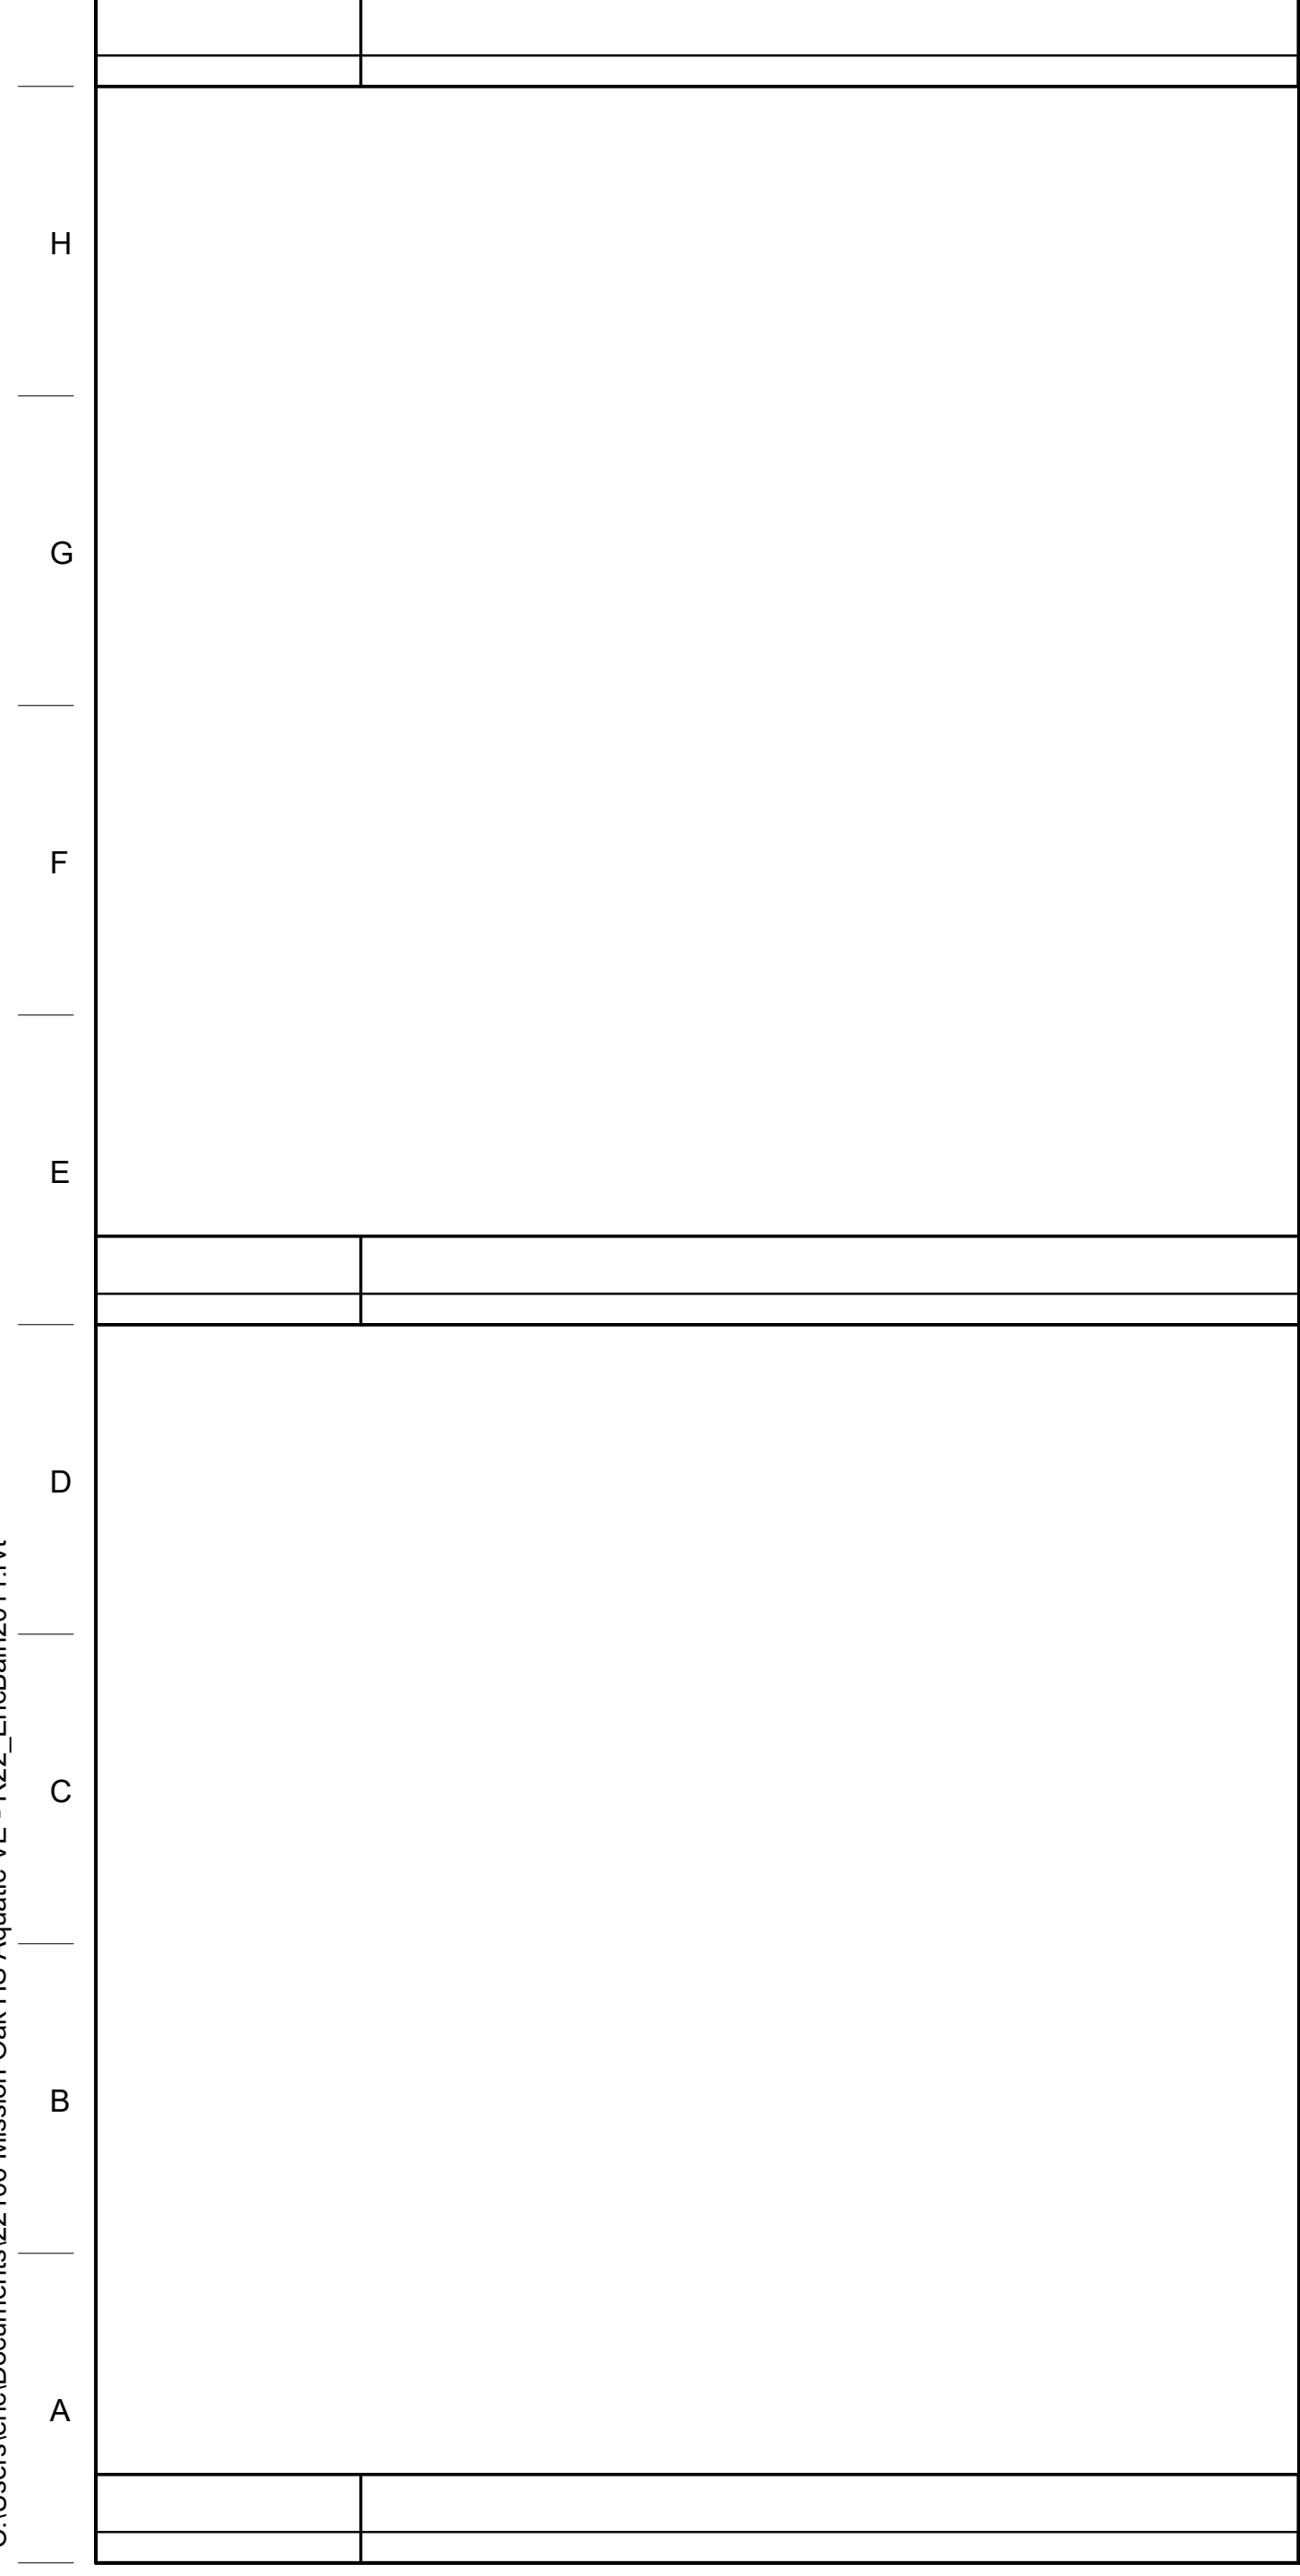


J7 WALL ELEVATION AT GL '1A' - P2 ALT BID
P/S201.1 P/S401.1 1/4" = 1'-0"

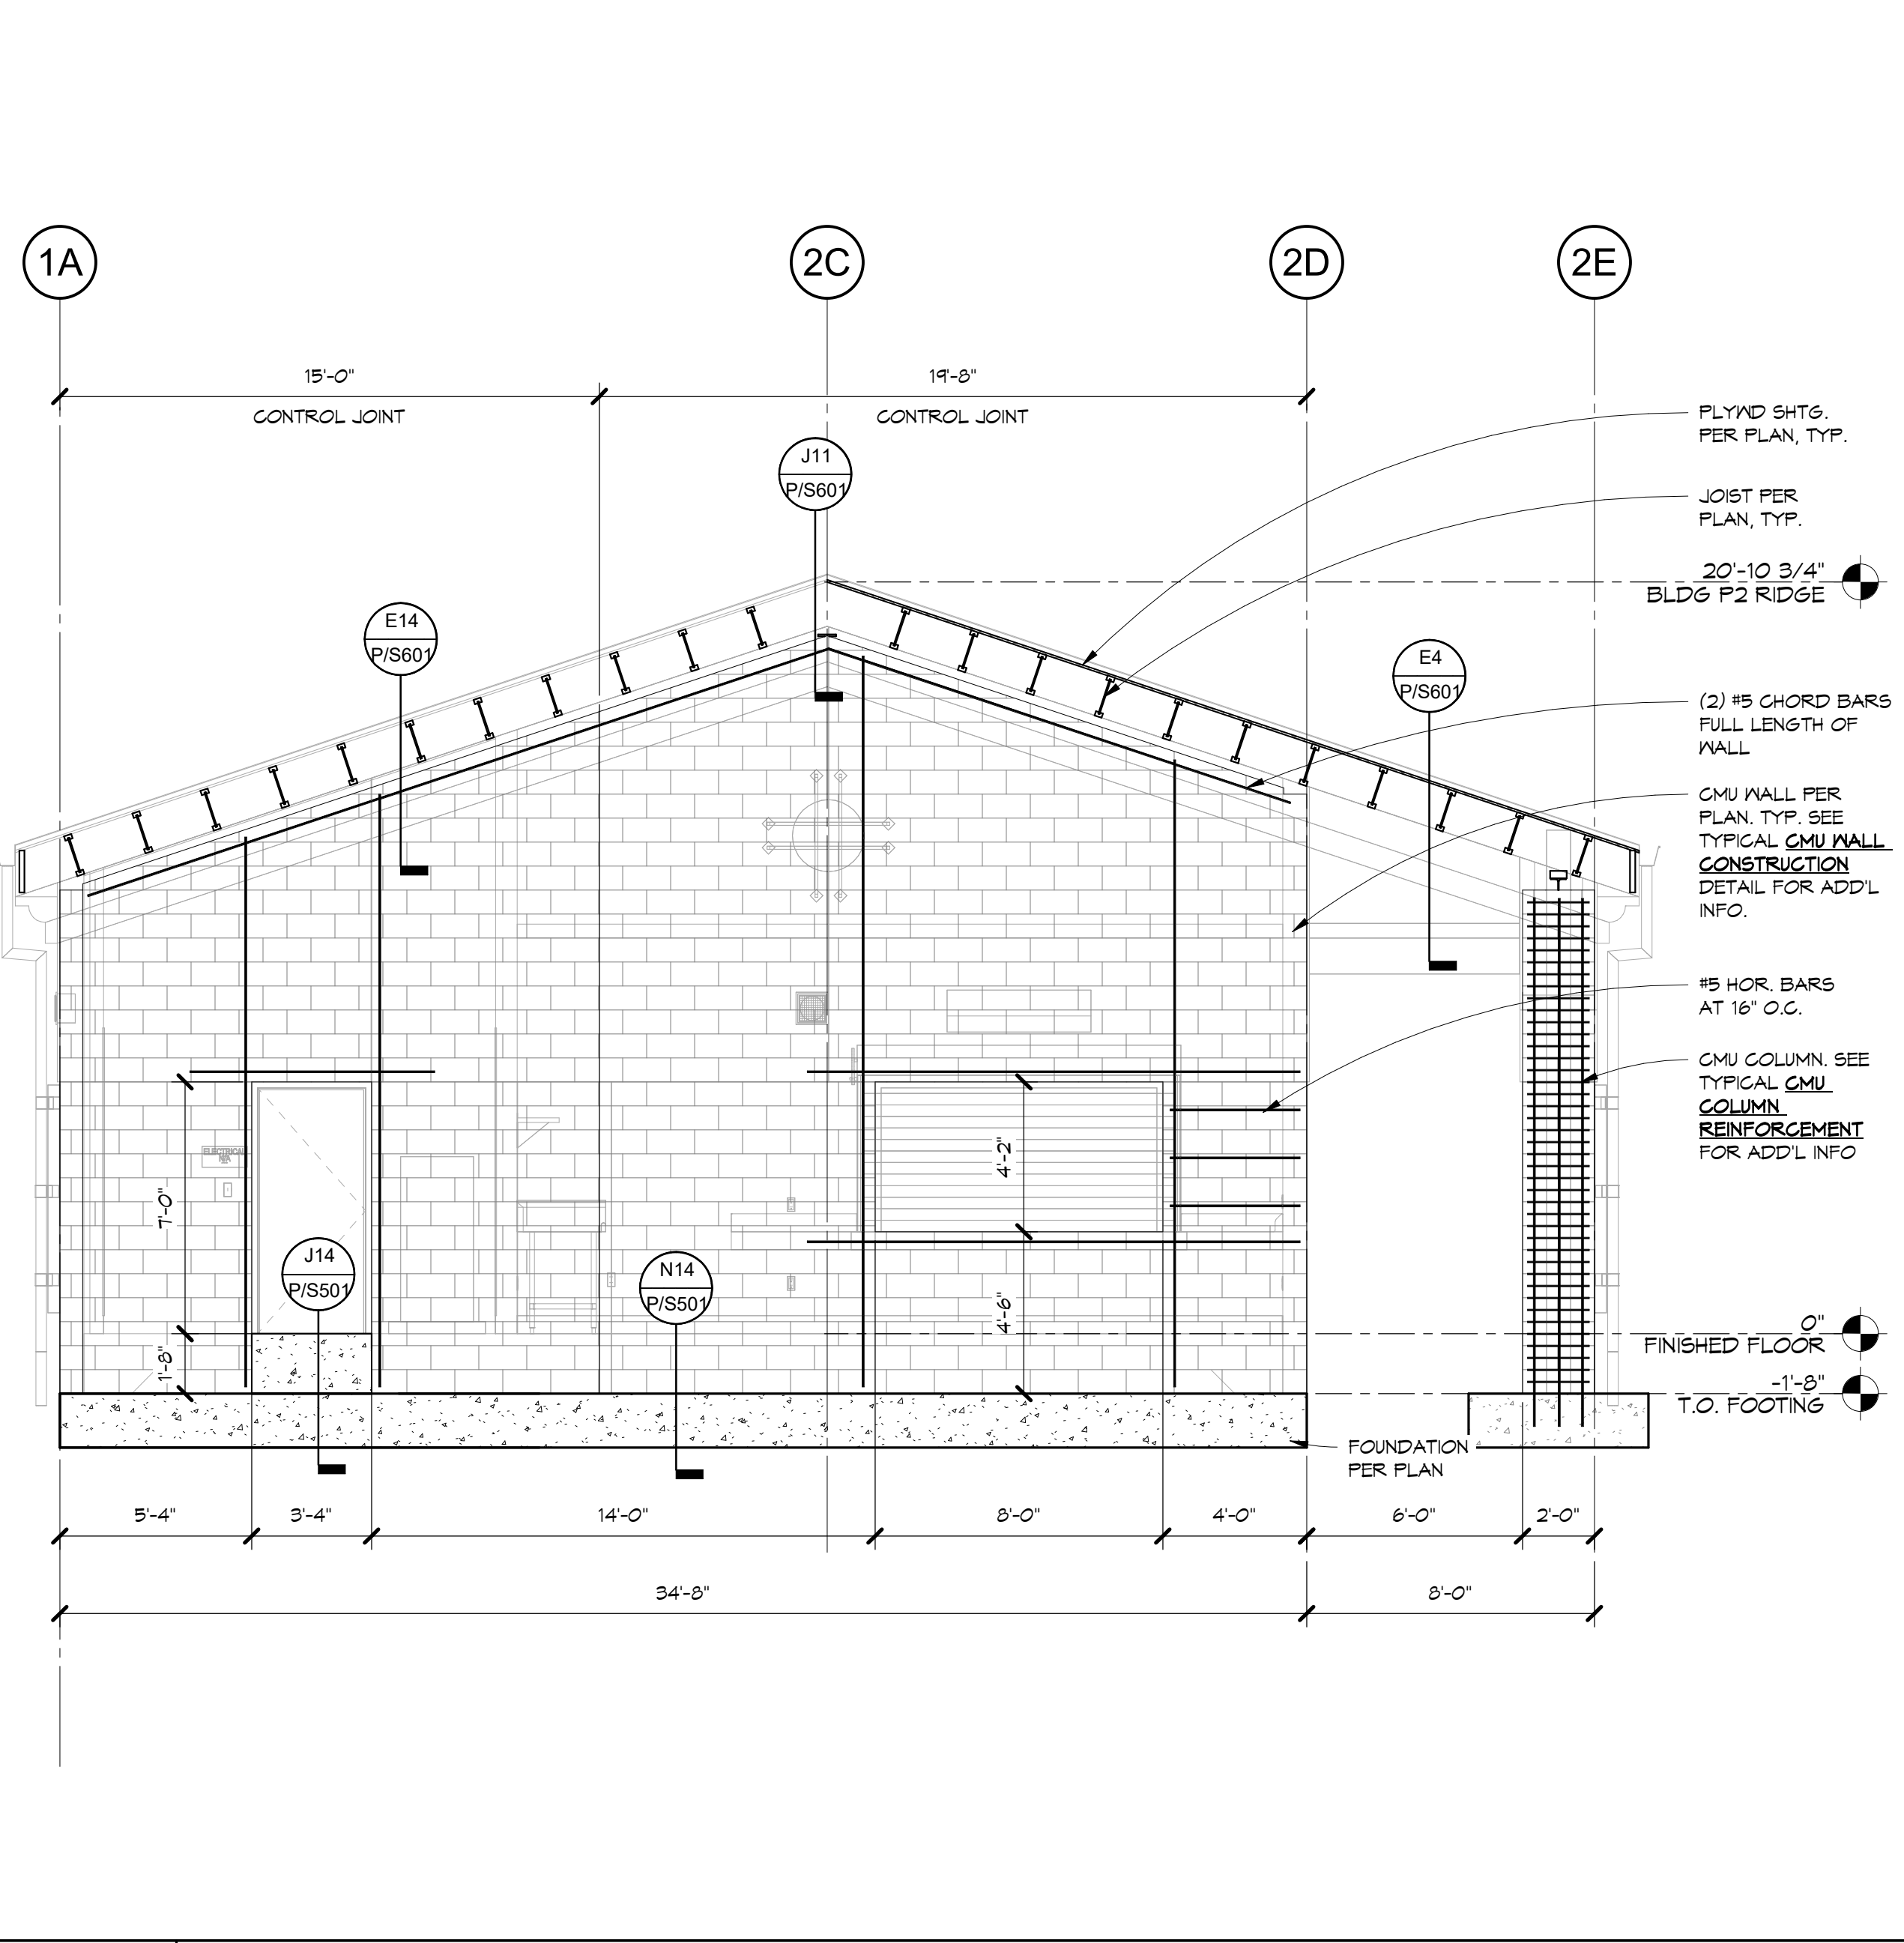

J11 WALL ELEVATION AT GL '21' - P2 ALT BID
P/S201.1 P/S401.1 1/4" = 1'-0"

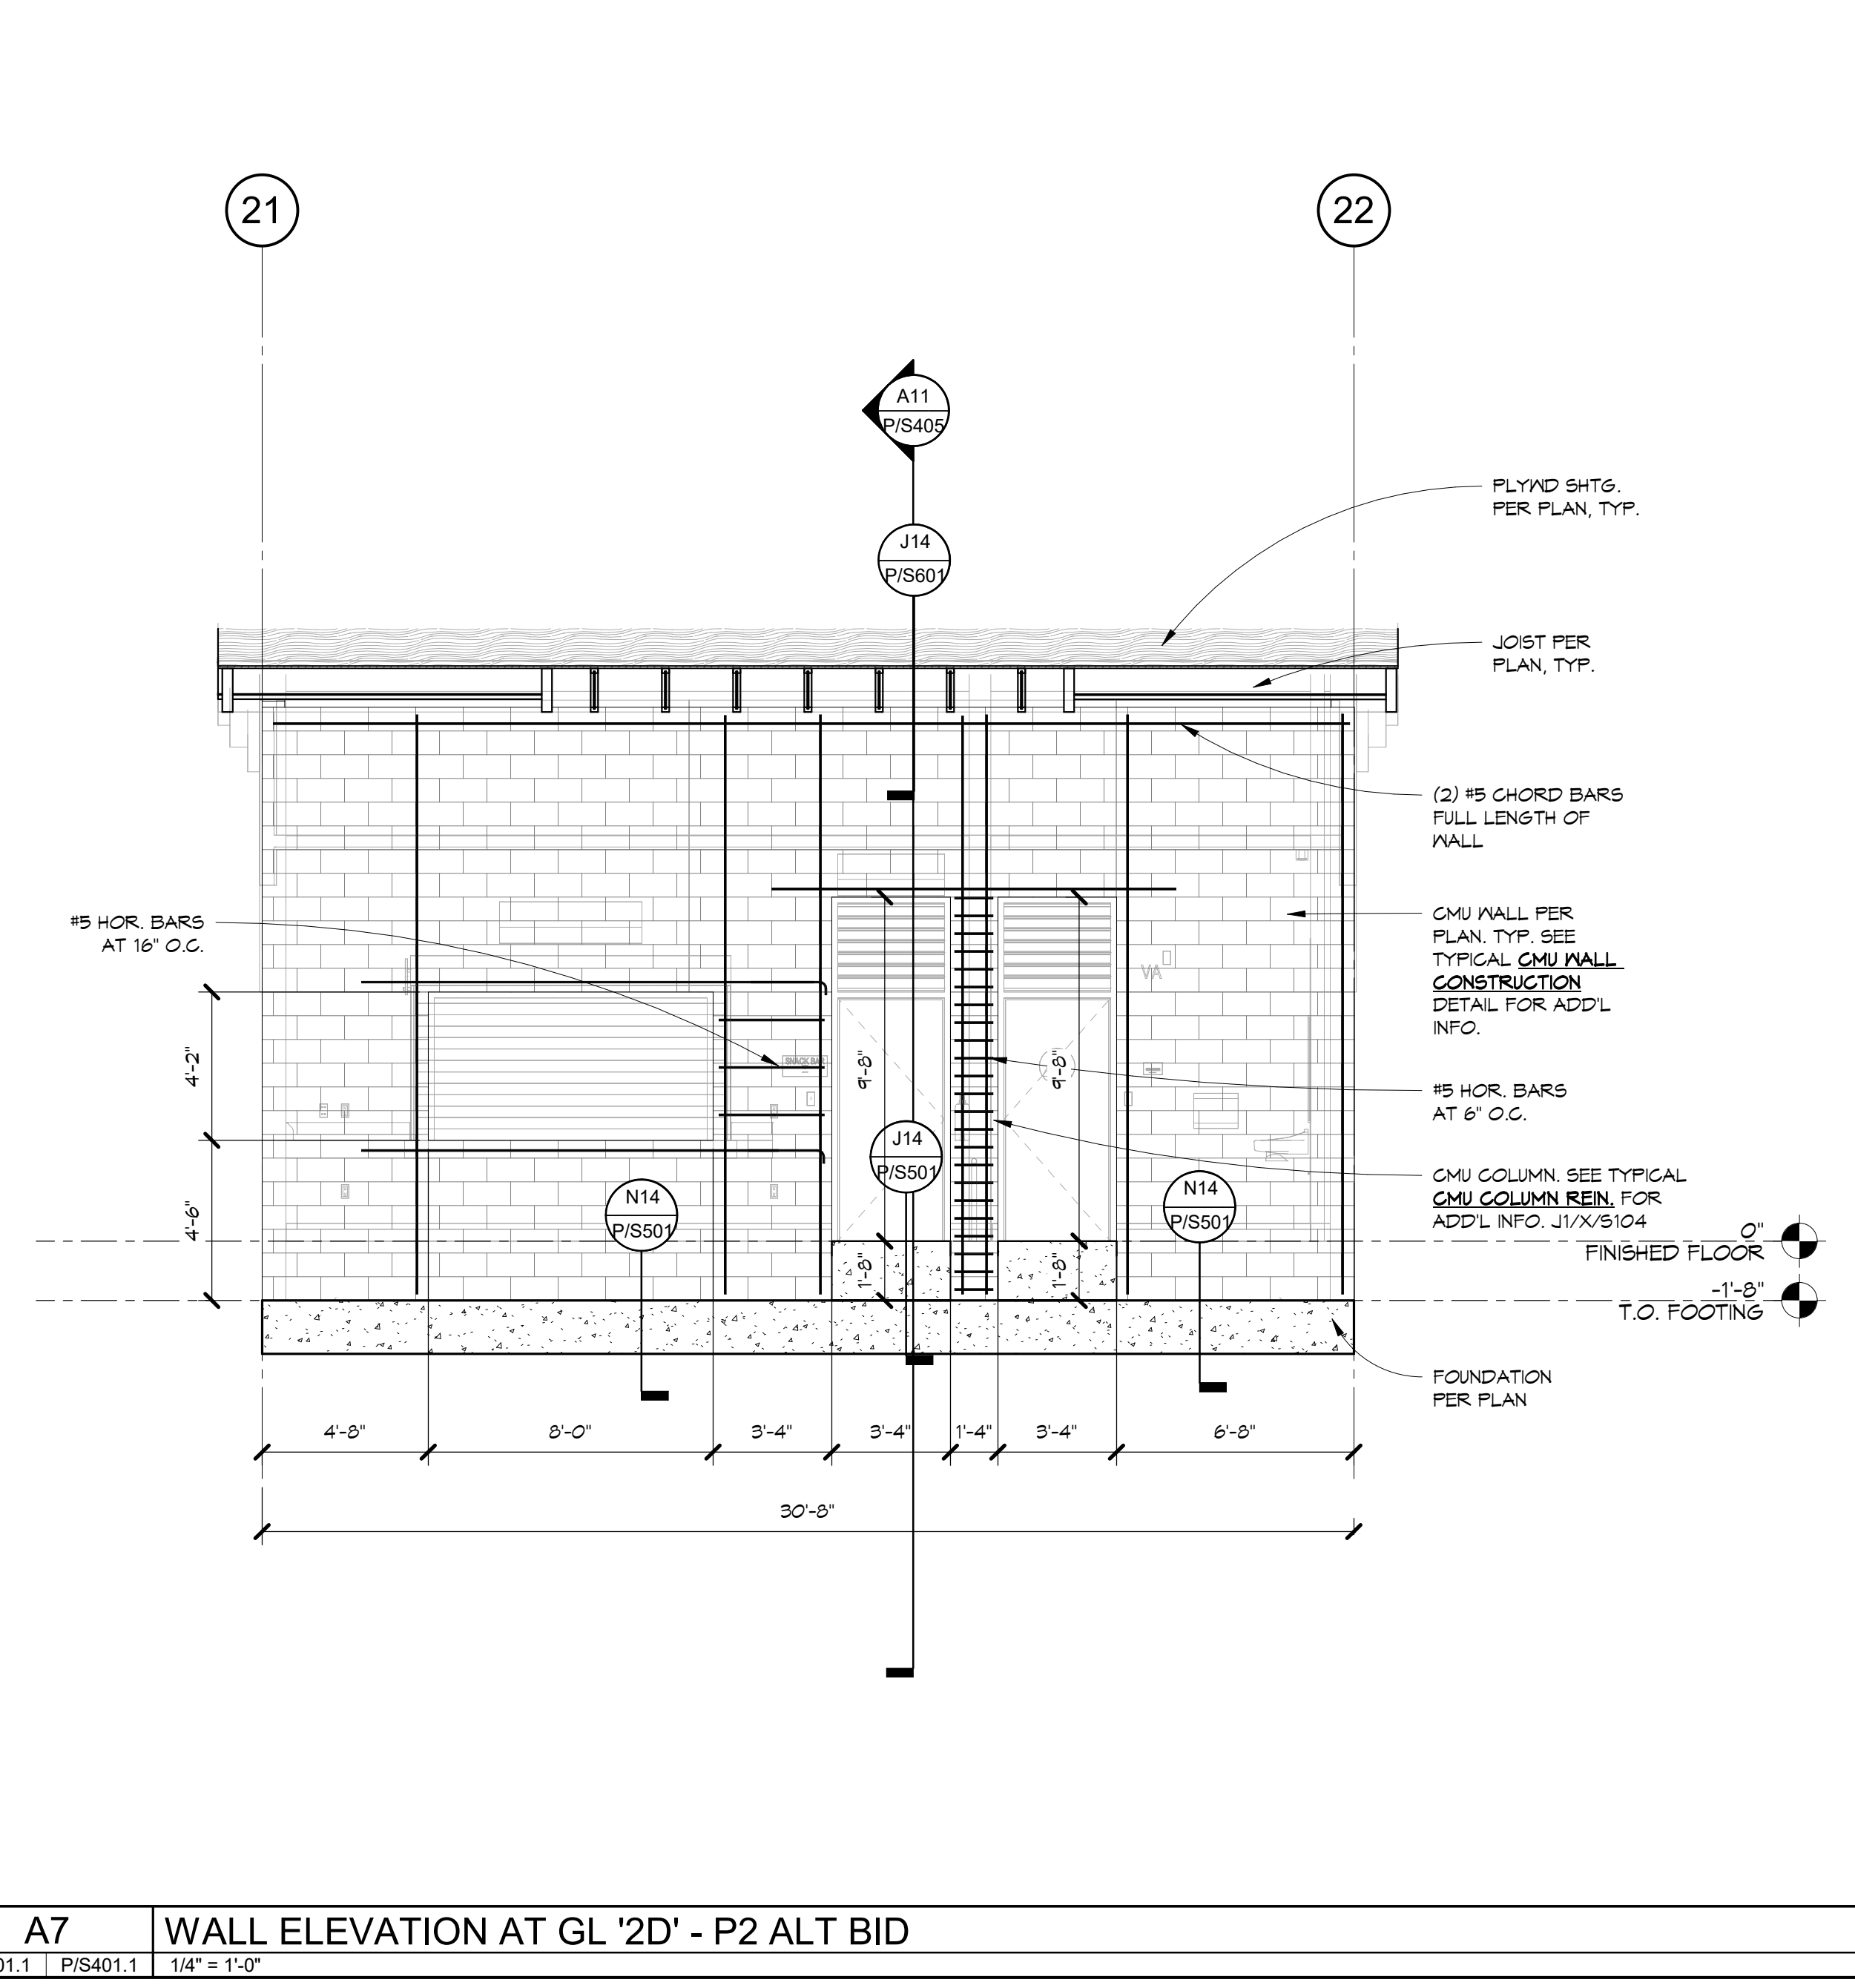

A7 WALL ELEVATION AT GL '2D' - P2 ALT BID
P/S201.1 P/S401.1 1/4" = 1'-0"

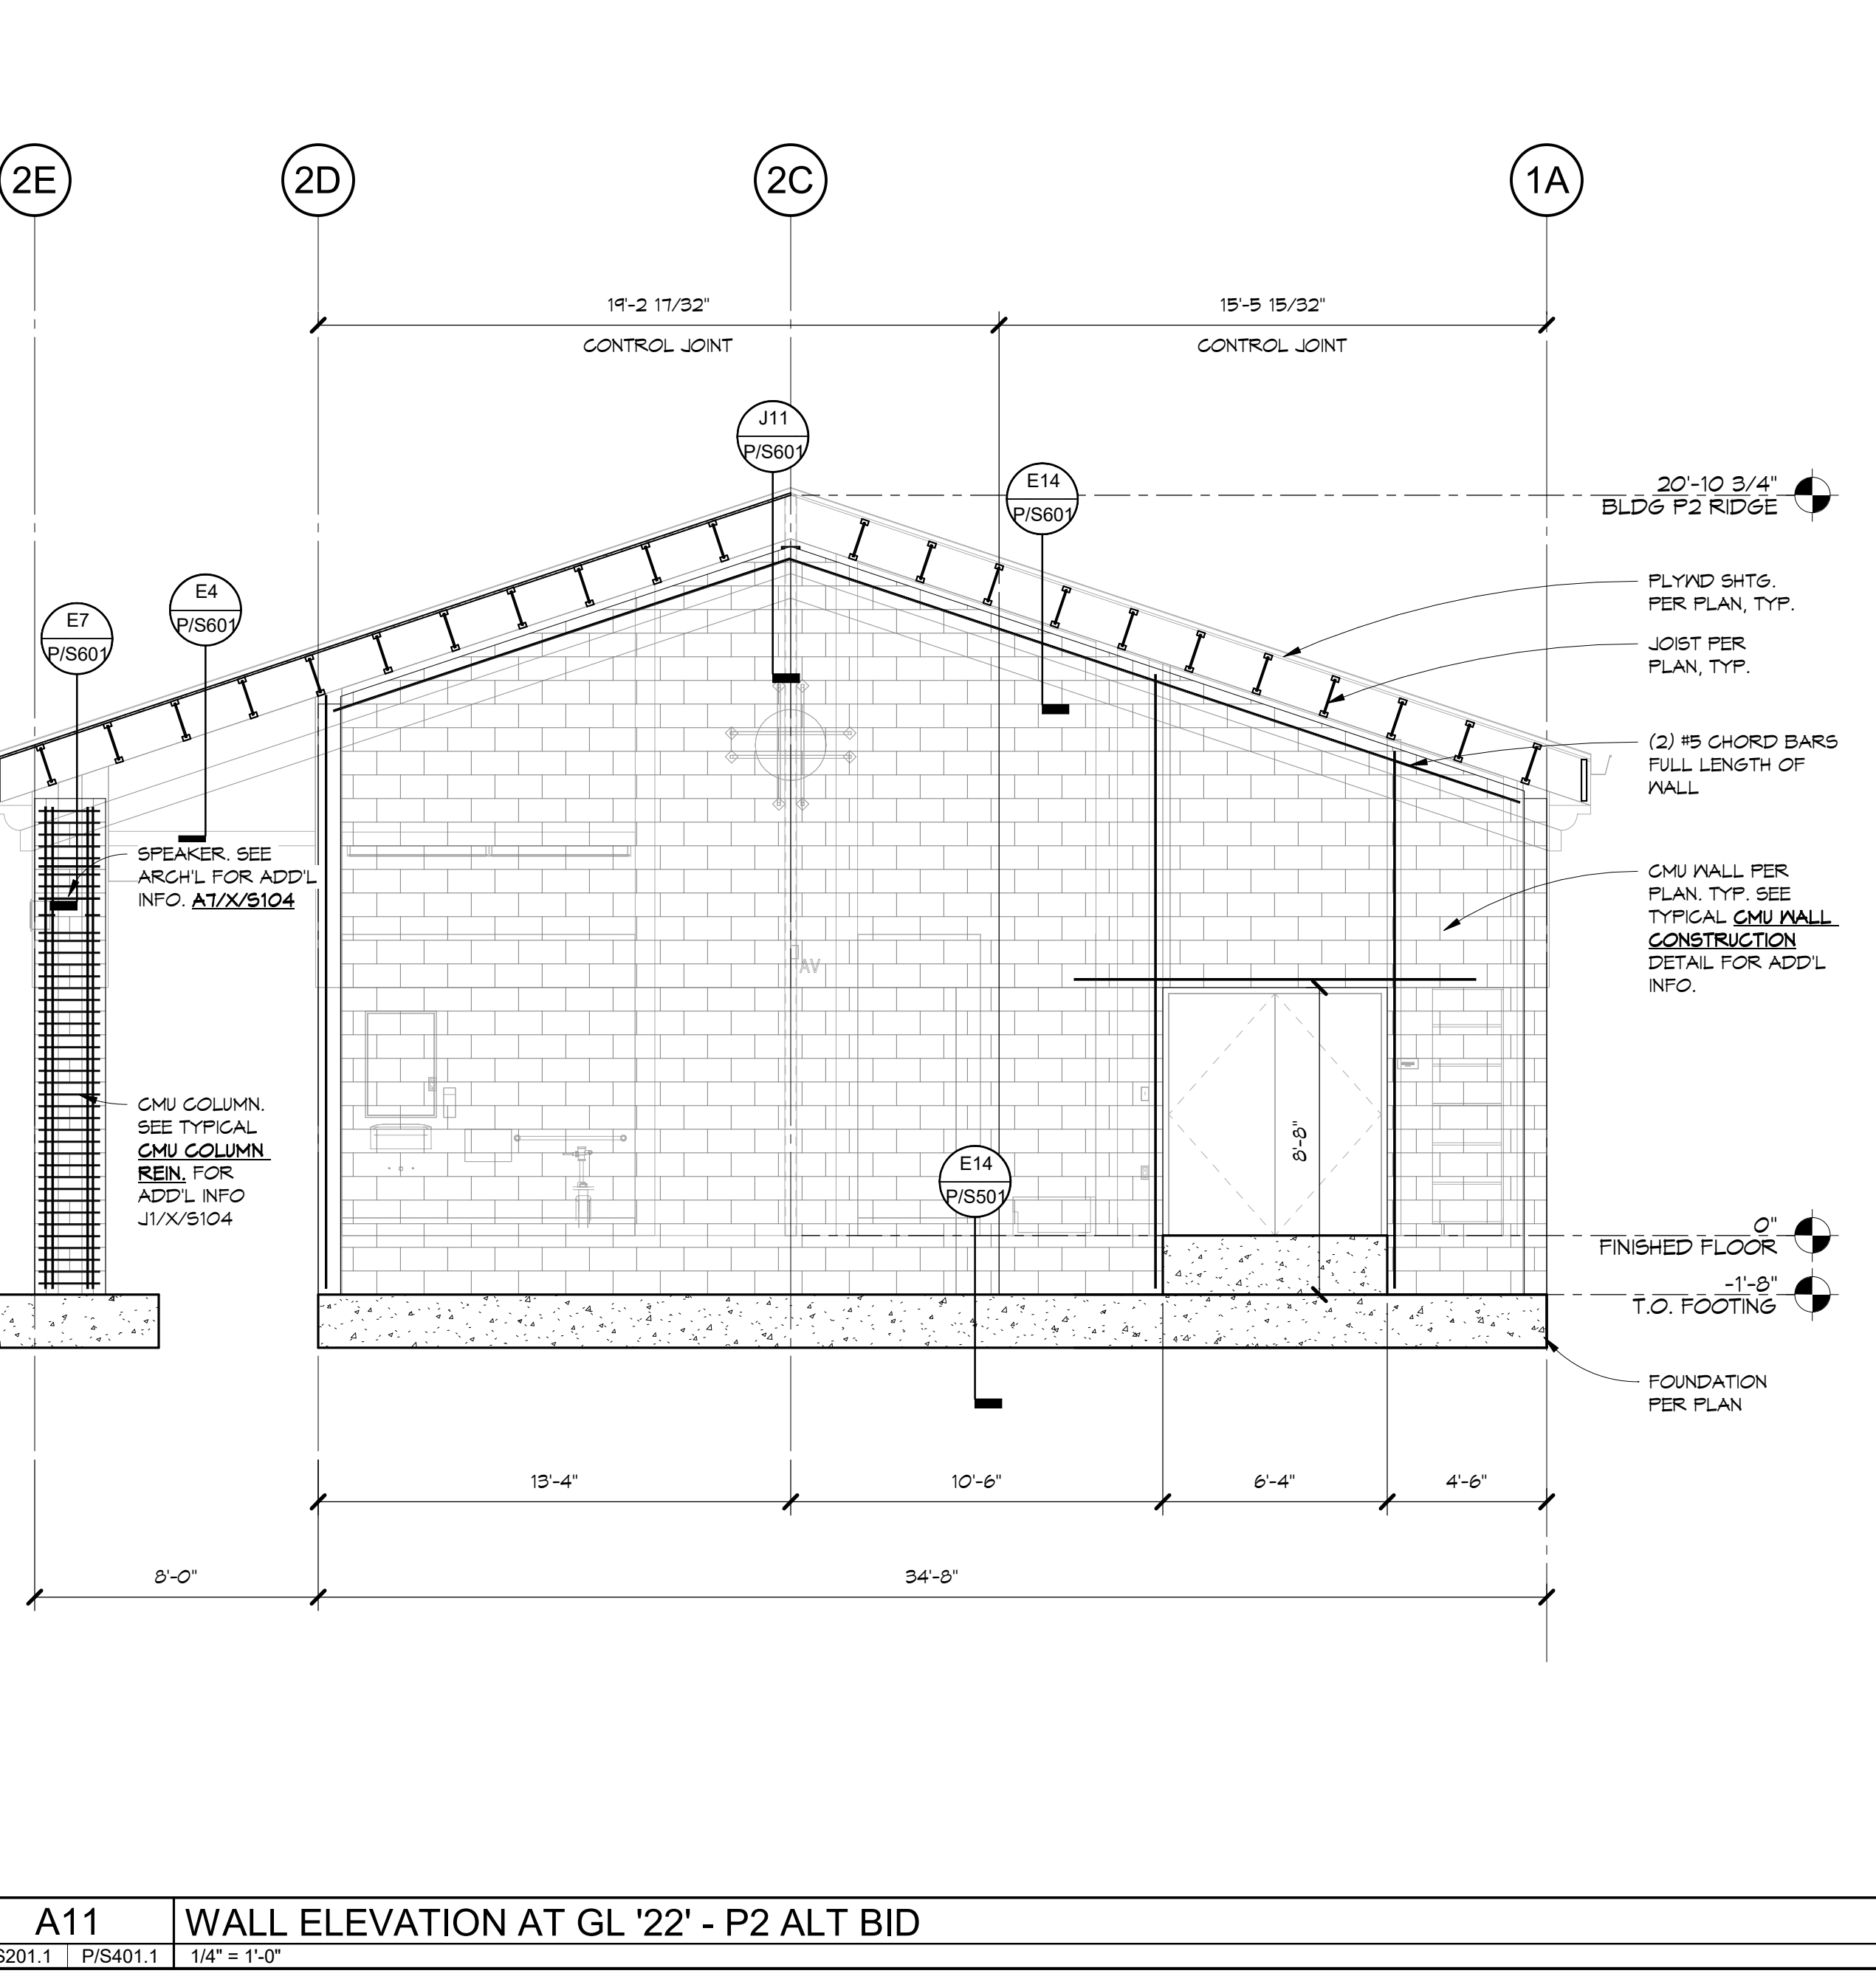

A11 WALL ELEVATION AT GL '22' - P2 ALT BID
P/S201.1 P/S401.1 1/4" = 1'-0"

DSA File No.:
DSA Application No.: 02-120251
Agency Approval

BrooksRansom ASSOCIATES
22108
1660 448-BANK OFFICE (560) 448-9400 FAX

Consultant

Mission Oak HS Aquatic Complex
Tulare Joint Union High School District
Tulare, CA 93274

Project

Building P
ALTERNATE BID - WALL ELEVATIONS
Drawing

ARCHITECTURE PLANNING INTERIORS
darden architects
www.dardenarchitects.com
6790 N. West Ave. • Fresno, CA 93711 • T. 559.448.8051

Architect

No.	Revision/Submission	Date
1	REVISION_1	05/31/2023

Revision

Designed By: ESB
Copyright Darden Architects


Scale: 1/4" = 1'-0"
Drawn By: ESB

Project Number: 2180
Checked By: ESB

Date: 11/16/2022
Reviewed By: ESB


P/S401.1
Sheet: of:

8/18/2023 10:51:05 AM
C:\Users\eric\Documents\22106 Mission Oak HS Aquatic VE - R22_ElevBid\20111.rvt

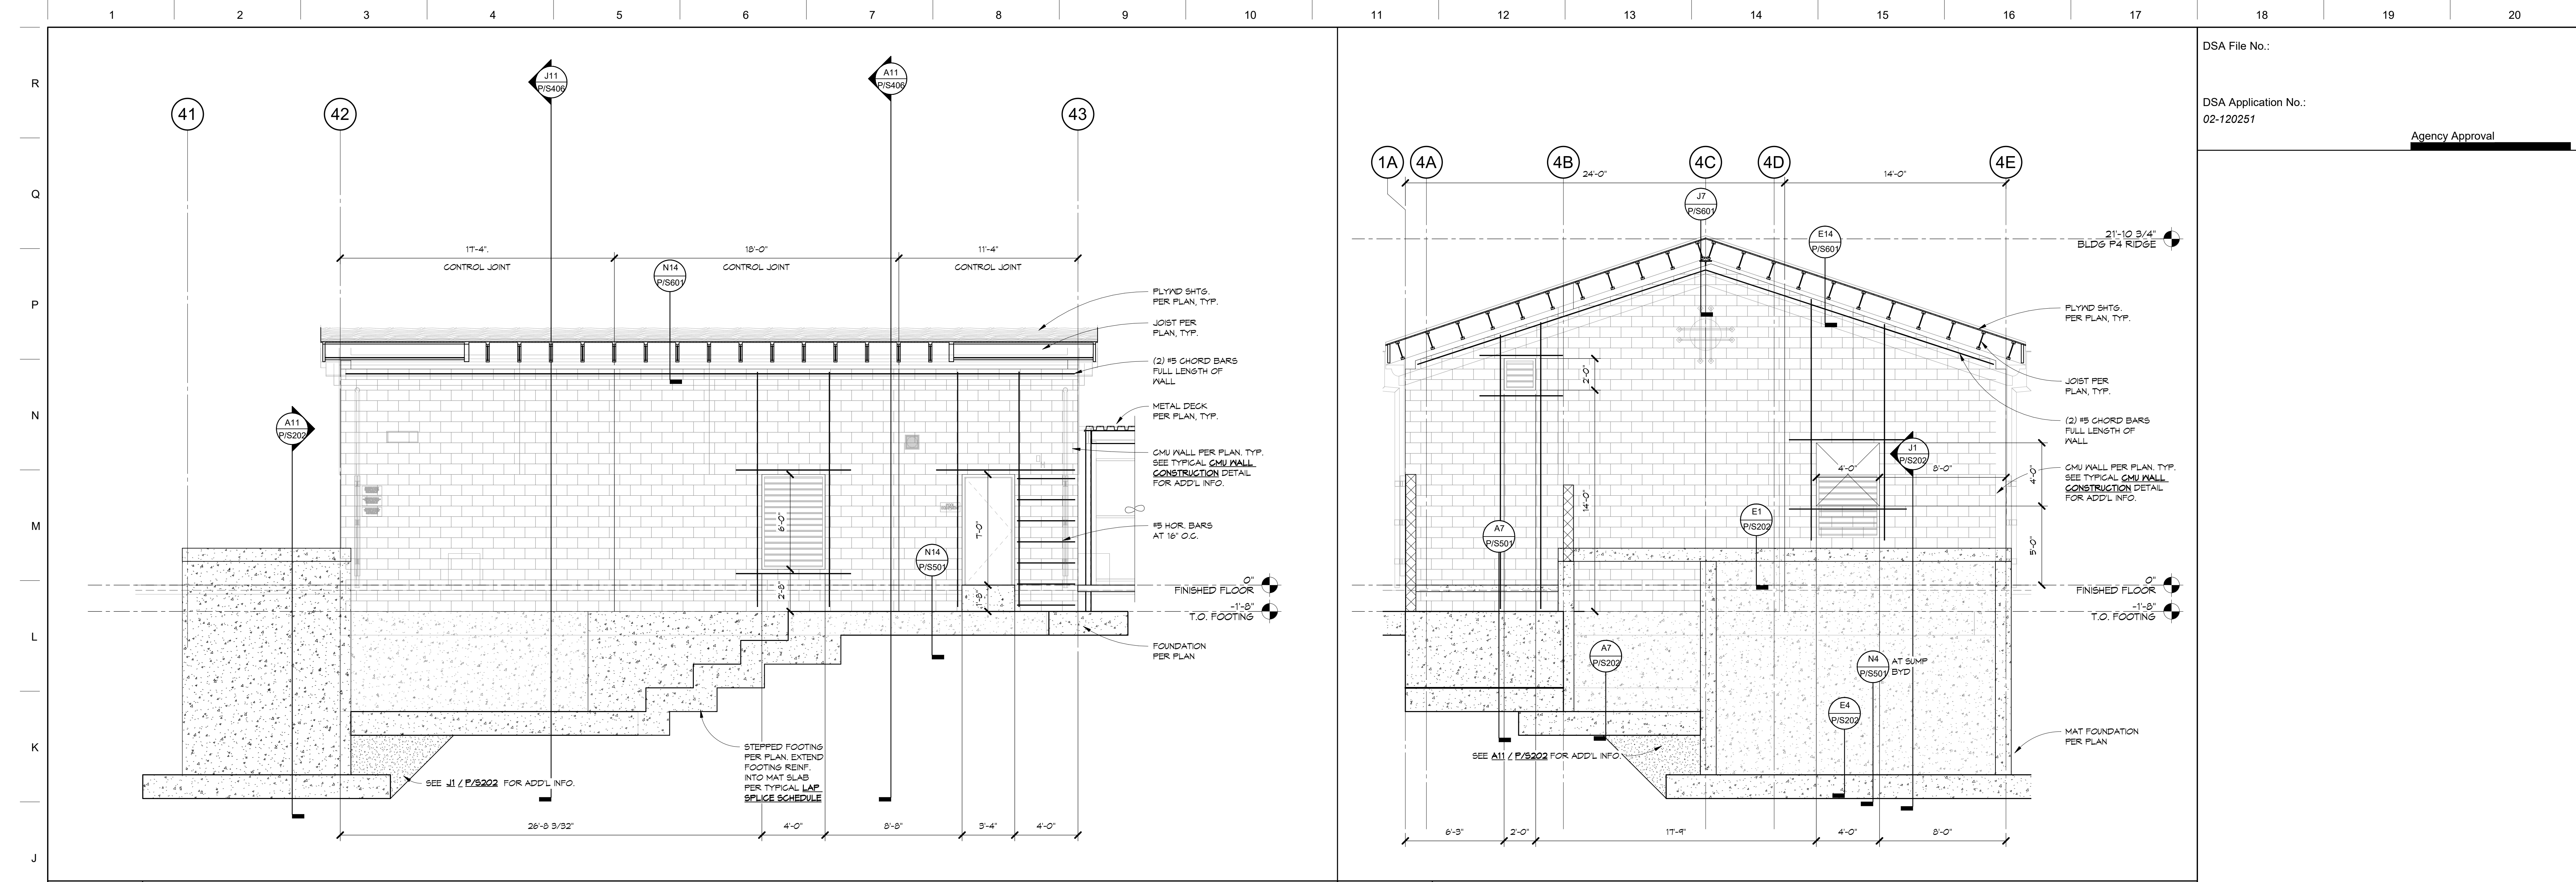

J4 WALL ELEVATION AT GL '4E' - P4
P/S201 P/S403 1/4" = 1'-0"

J11 WALL ELEVATION AT GL '42' - P4
P/S201 P/S403 1/4" = 1'-0"

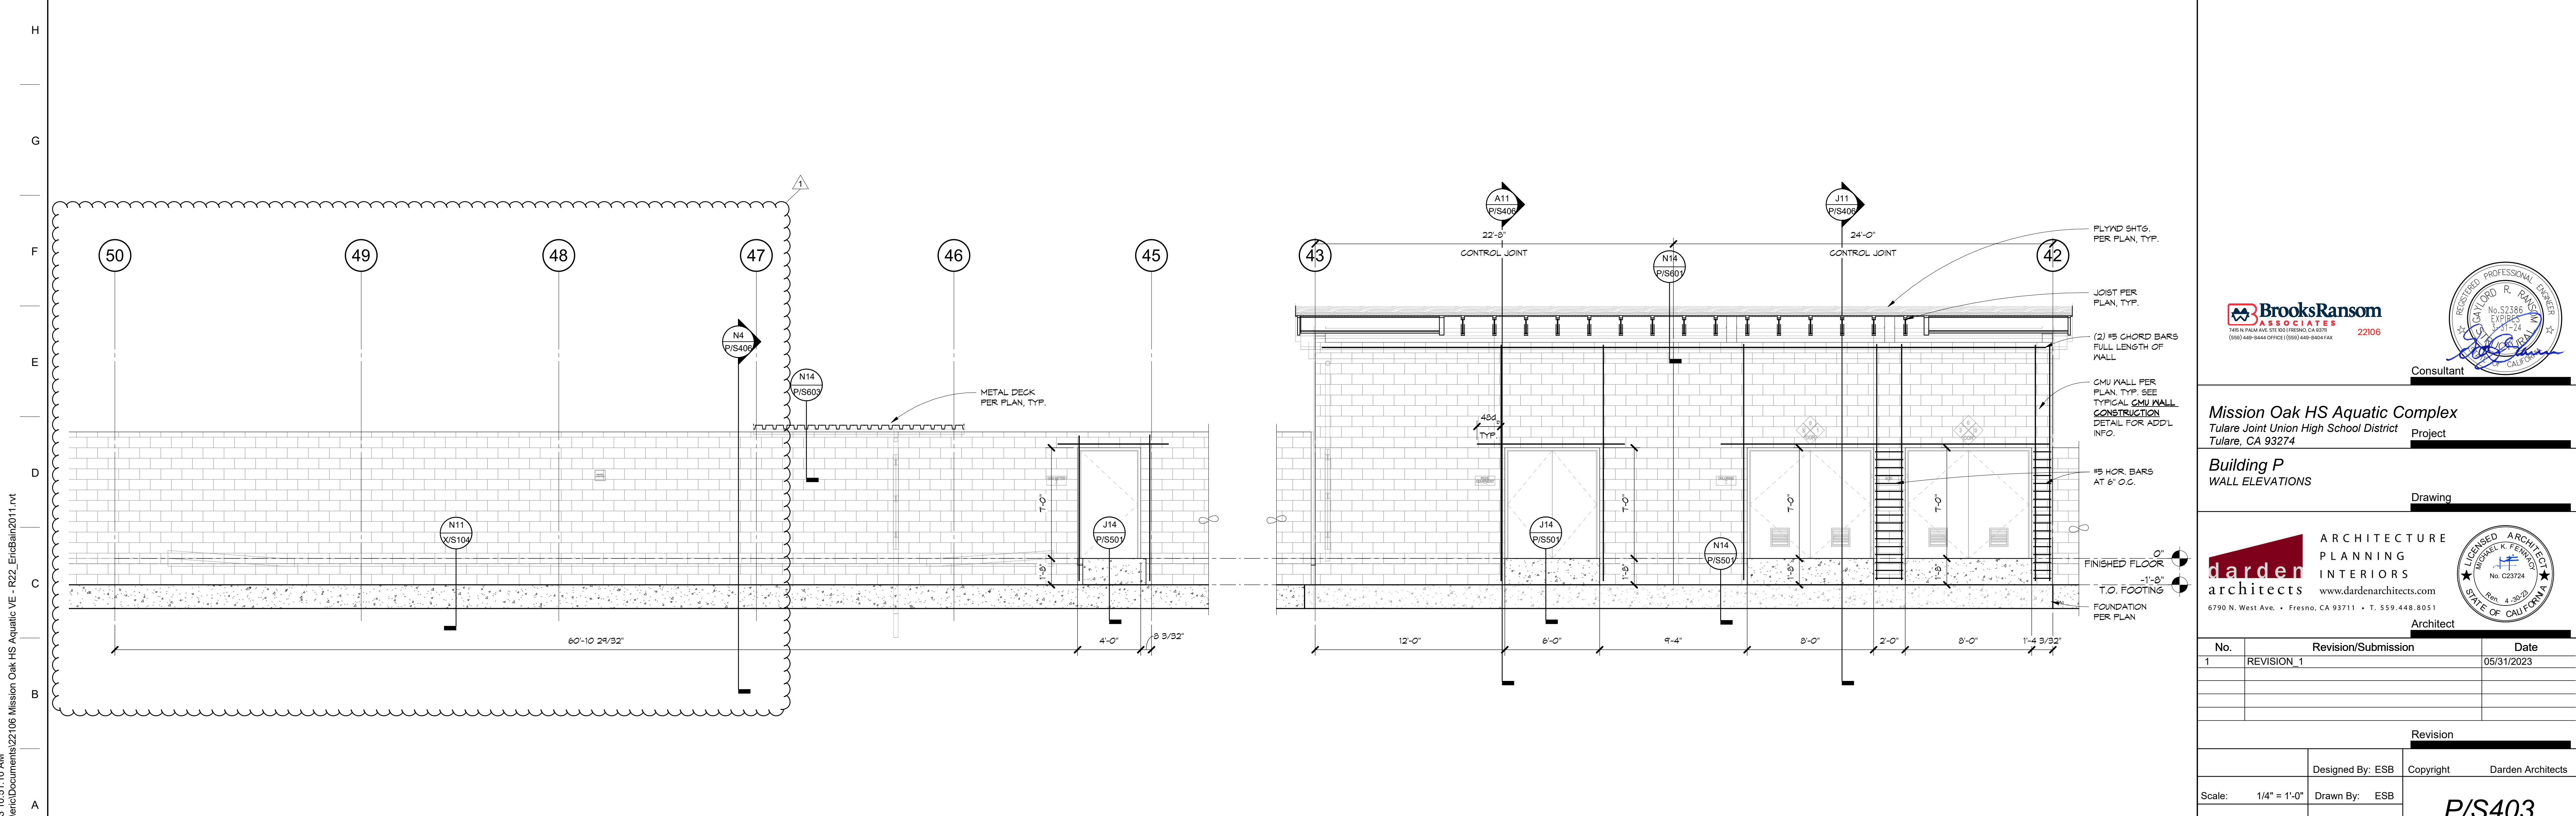

A1 WALL ELEVATION AT GL '1A' - P4
P/S201 P/S403 1/4" = 1'-0"

DSA File No.:
DSA Application No.: 02-120251
Agency Approval



BrooksRansom ASSOCIATES, INC.
Tulare Joint Union High School District
Tulare, CA 93274


Mission Oak HS Aquatic Complex
Tulare Joint Union High School District
Tulare, CA 93274

Building P
WALL ELEVATIONS
ARCHITECTURE PLANNING INTERIORS
www.dardenarchitects.com
6790 N. West Ave. • Fresno, CA 93711 • T. 559.448.8051

No.	Revision/Submission	Date
1	REVISION 1	05/31/2023


Designed By: ESB	Copyright	Darden Architects
Scale: 1/4" = 1'-0"	Drawn By: ESB	P/S403
Project Number: 2180	Checked By: ESB	
Date: 11/16/2022	Reviewed By: ESB	

8/18/2023 10:51:10 AM C:\Users\eric\Documents\22106 Mission Oak HS Aquatic VE - R22_ElevBain2011.rvt

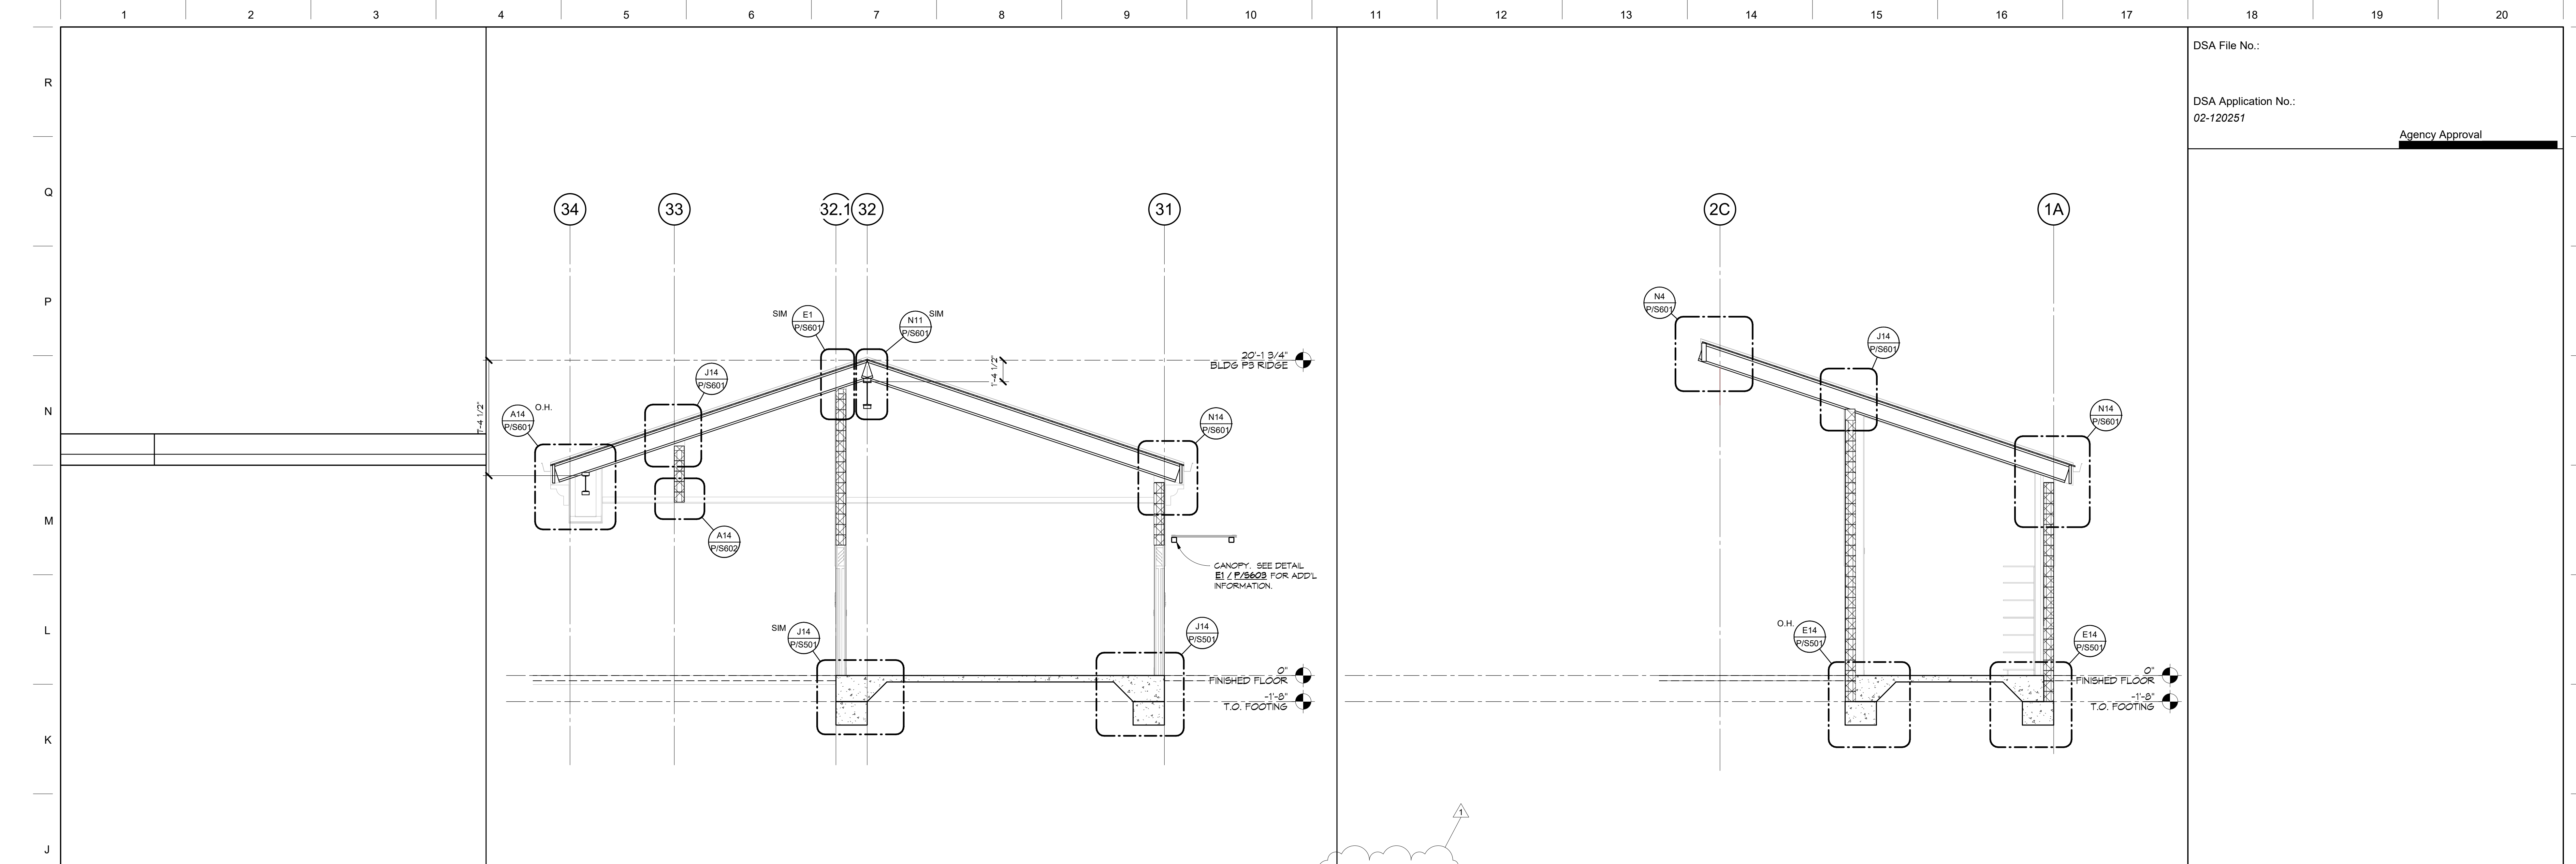

J4 BUILDING SECTION - P3
P/S201 P/S405 1/4" = 1'-0"

J11 BUILDING SECTION - P2
P/S201 P/S405 1/4" = 1'-0"

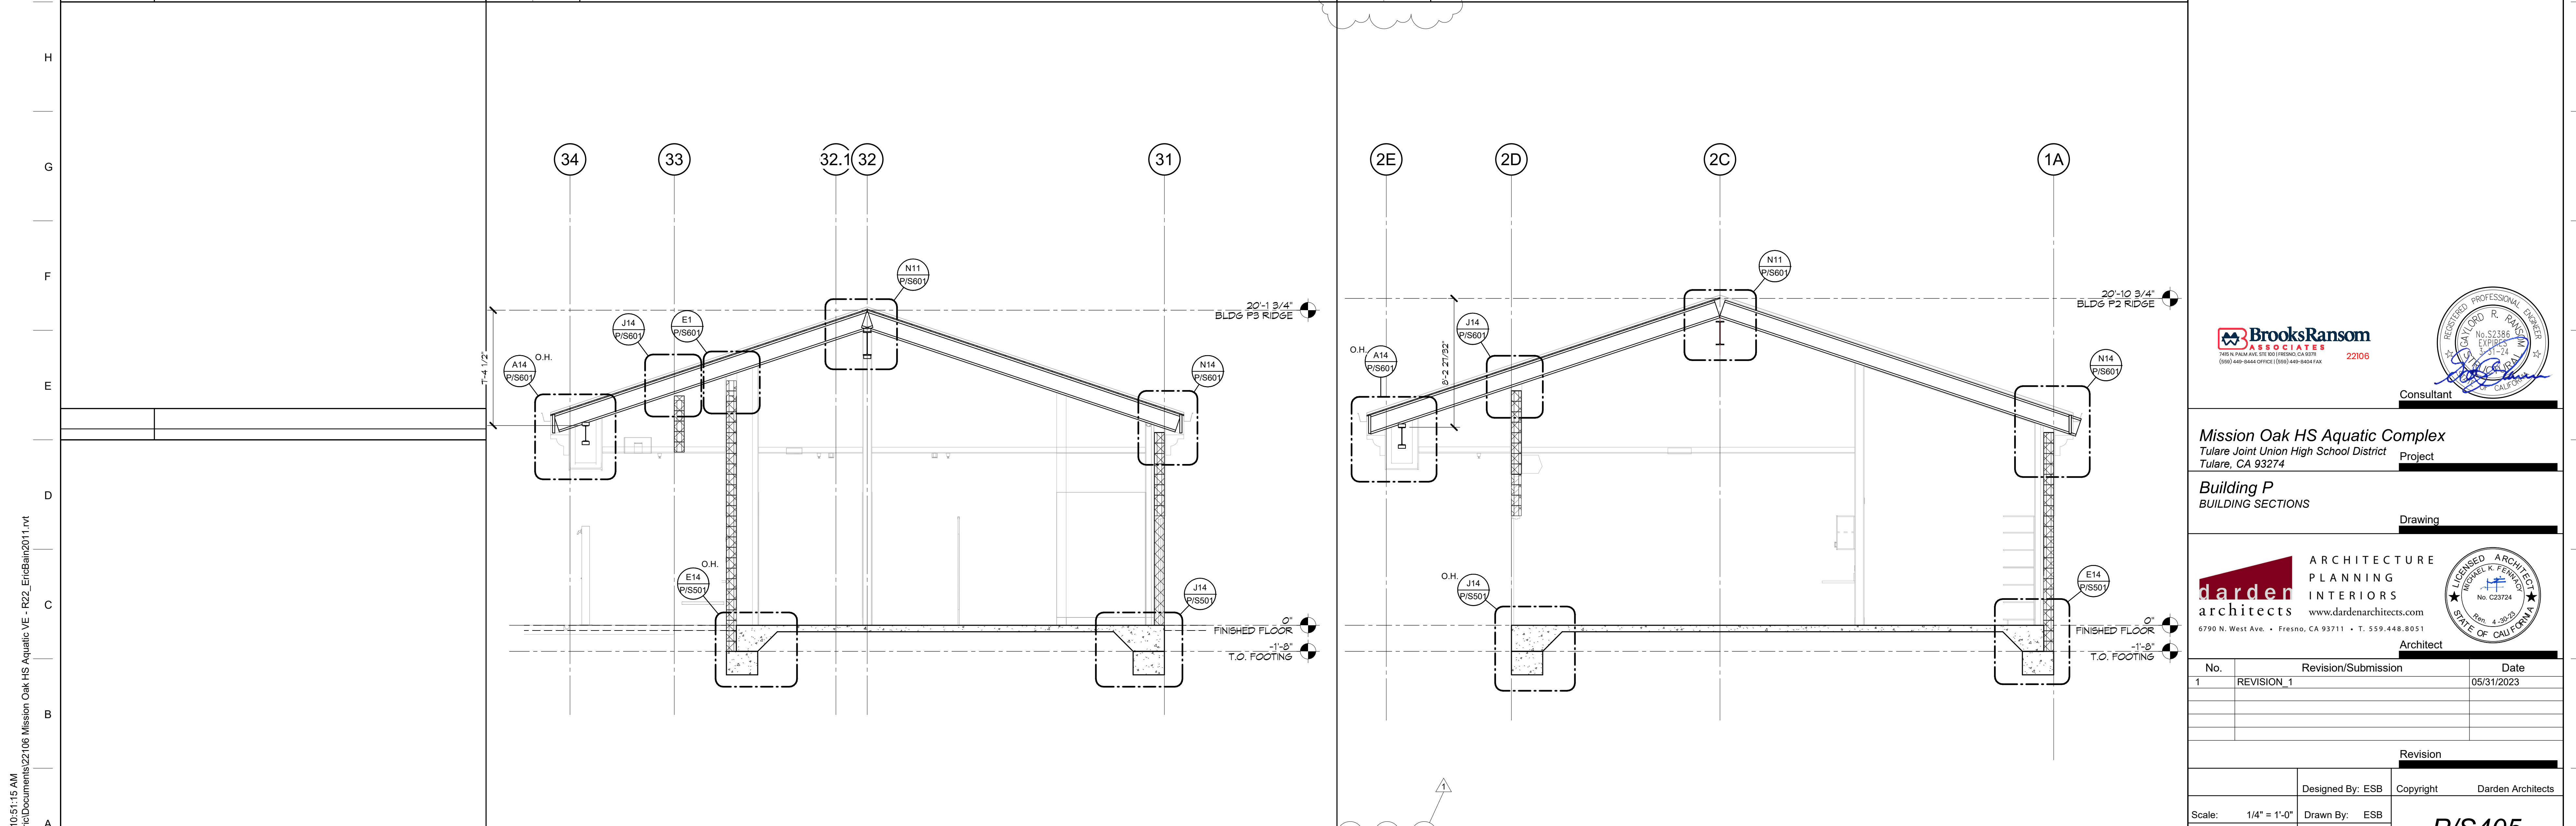

A4 BUILDING SECTION - P3
P/S201 P/S405 1/4" = 1'-0"

A11 BUILDING SECTION - P2 ALT BID
P/S201 P/S405 1/4" = 1'-0"

DSA File No.:
DSA Application No.: 02-120251
Agency Approval



BrooksRansom
ASSOCIATES, INC.
22106
TULARE, CA 93274
CONSULTANT

Mission Oak HS Aquatic Complex
Tulare Joint Union High School District
Tulare, CA 93274
Project



Darden Architects
ARCHITECTURE
PLANNING
INTERIORS
www.dardenarchitects.com
6790 N. West Ave. • Fresno, CA 93711 • T. 559.448.8051
Architect


No.	Revision/Submission	Date
1	REVISION_1	05/31/2023

Revision
Designed By: ESB
Copyright
Darden Architects


Scale: 1/4" = 1'-0"
Project Number: 2180
Date: 11/16/2022
Drawn By: ESB
Checked By: ESB
Reviewed By: ESB
P/S405
Sheet: _____ of: _____

8/18/2023 10:51:15 AM
C:\Users\eric\Documents\22106 Mission Oak HS Aquatic VE - R22_EricBain2011.rvt


DSA File No.:
DSA Application No.: 02-120251
Agency Approval

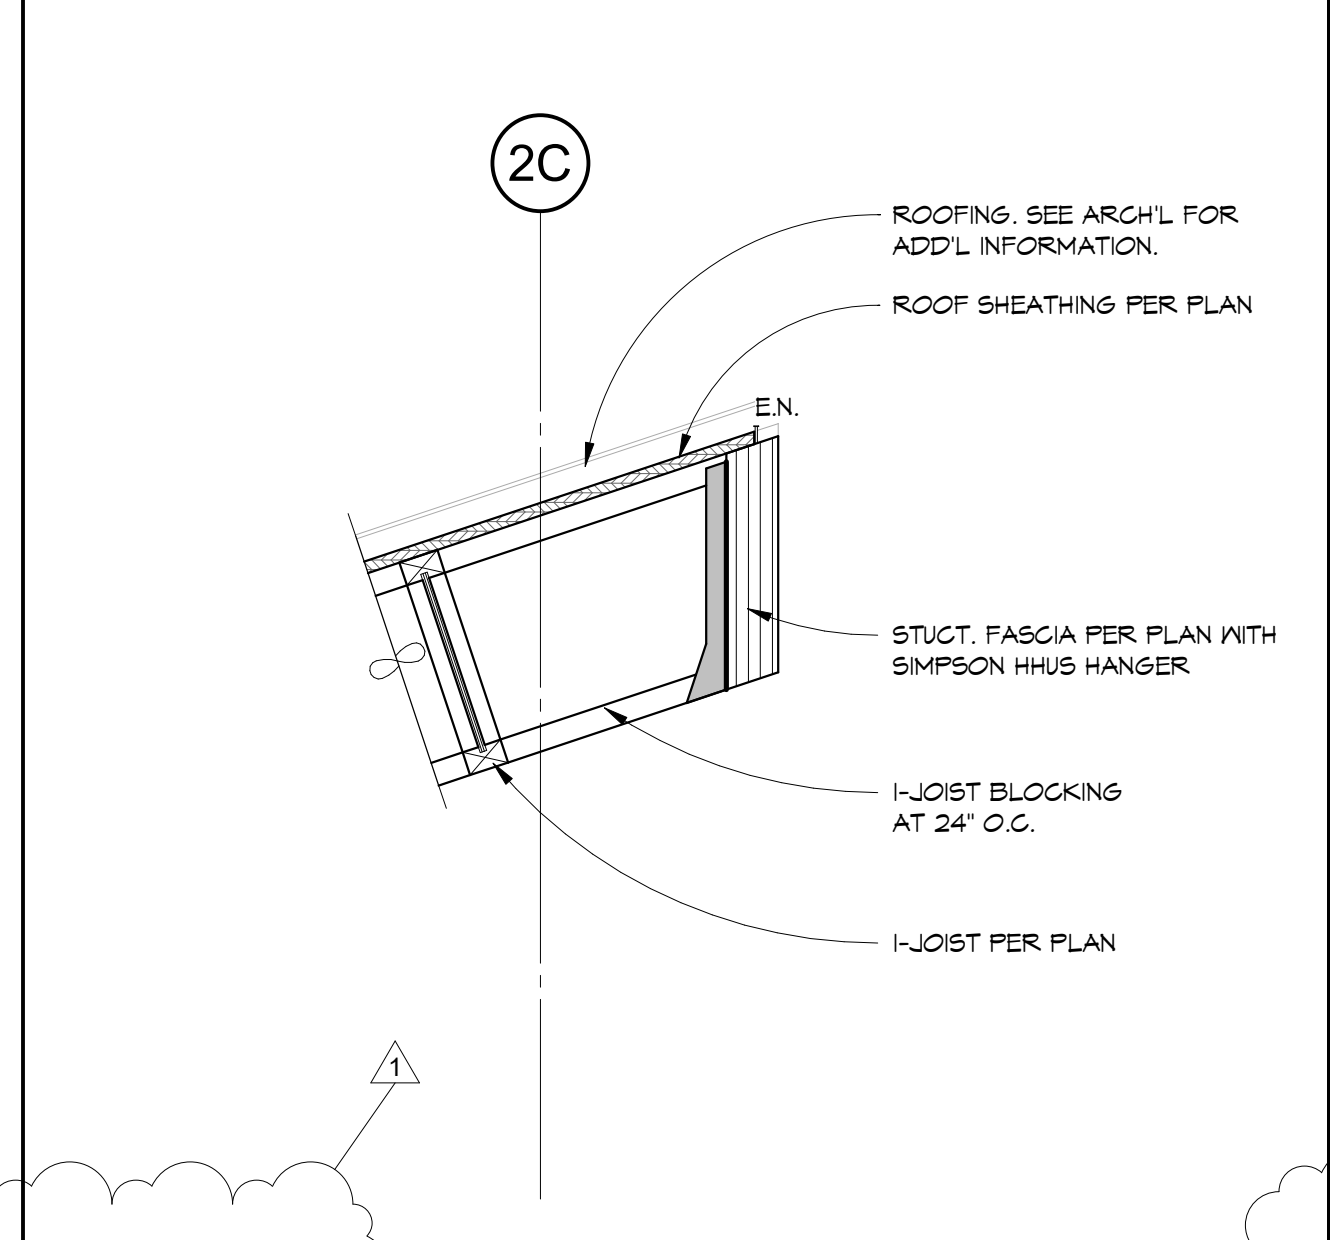


N1 DETAIL
P/S301 P/S601 1" = 1'-0"

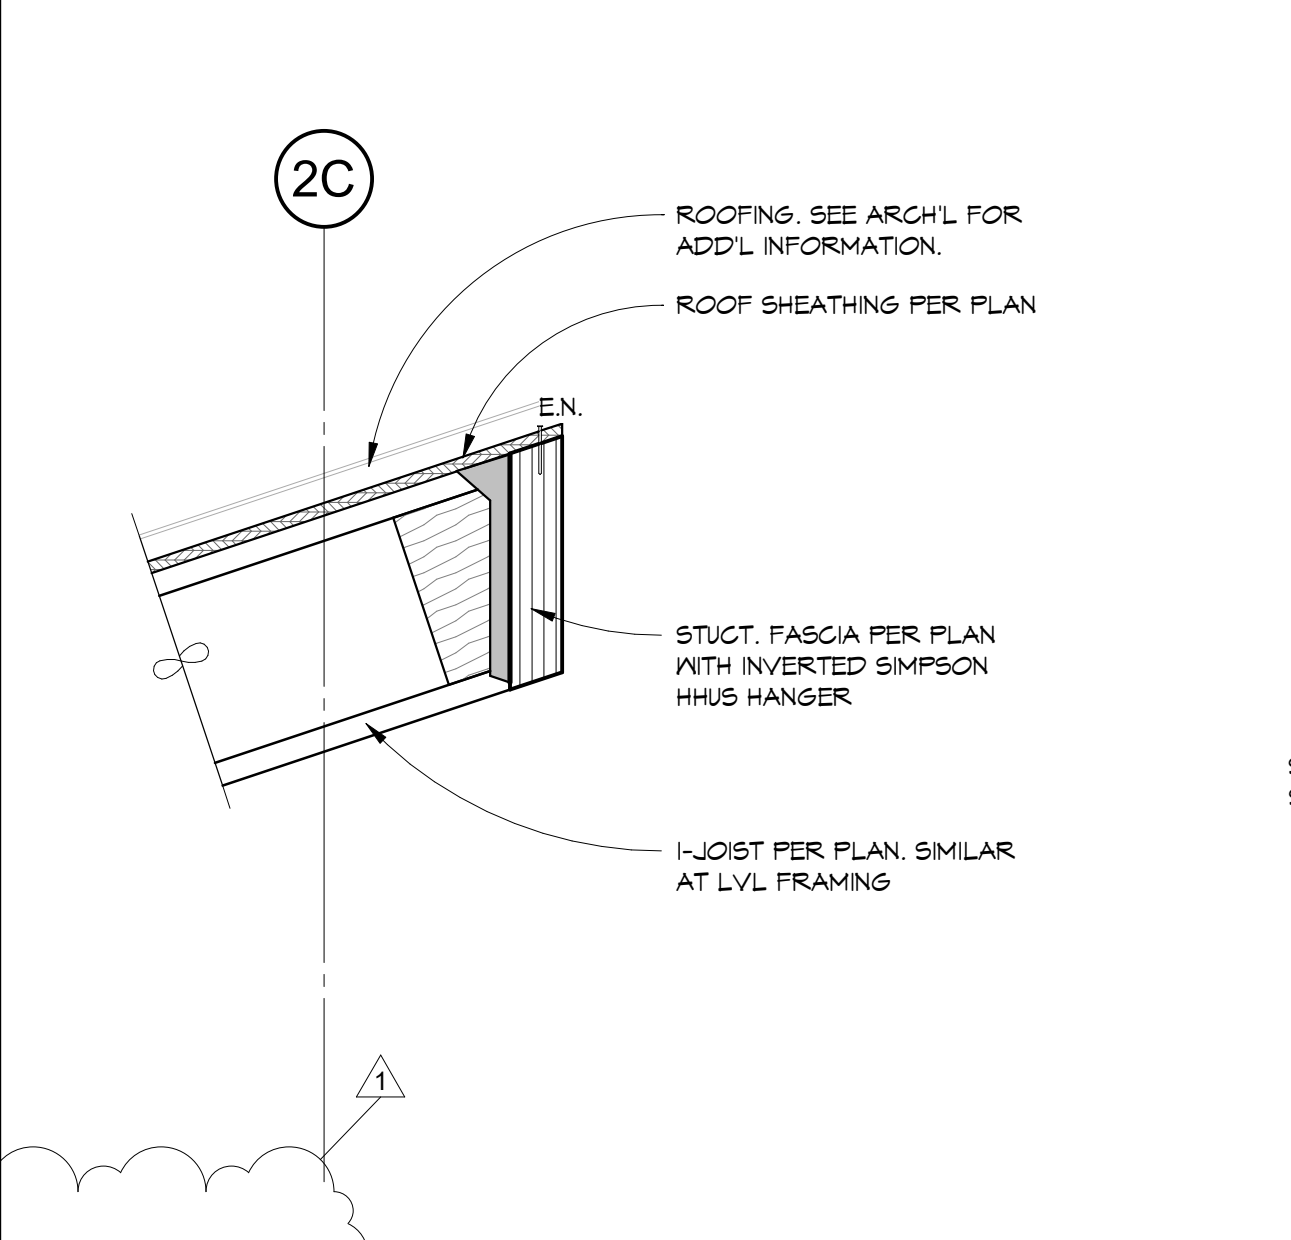


N4 DETAIL
P/S301 P/S601 1" = 1'-0"

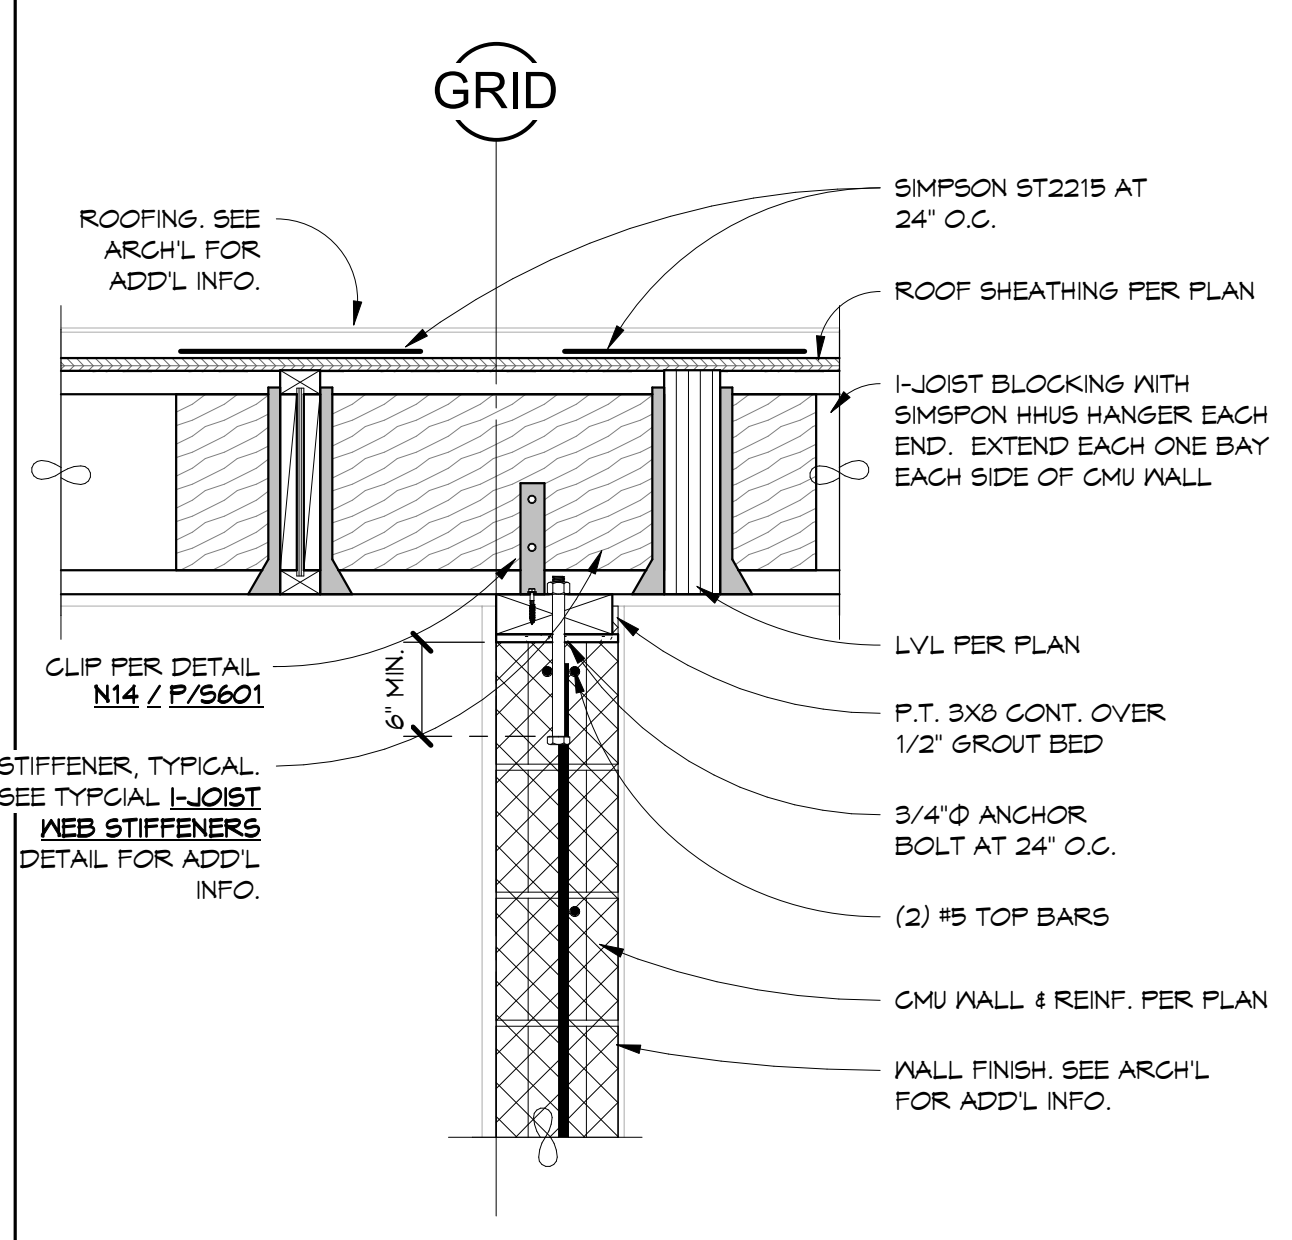


N7 DETAIL
P/S301 P/S601 1" = 1'-0"

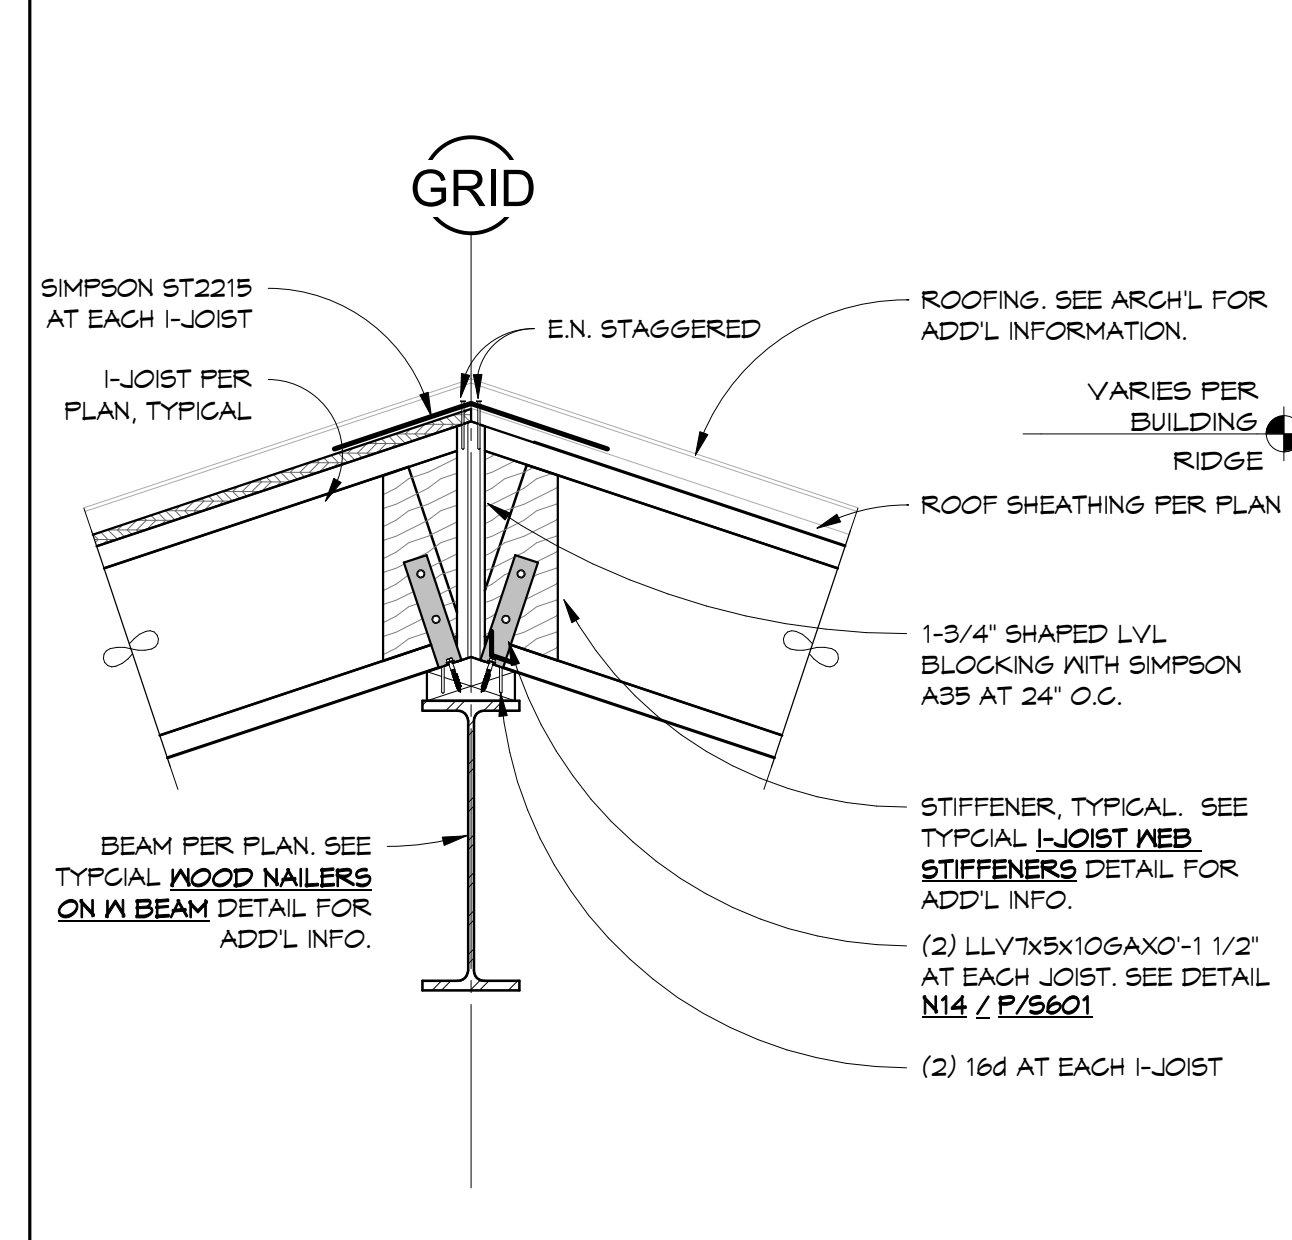

N11 DETAIL
P/S201.1 P/S601 1" = 1'-0"

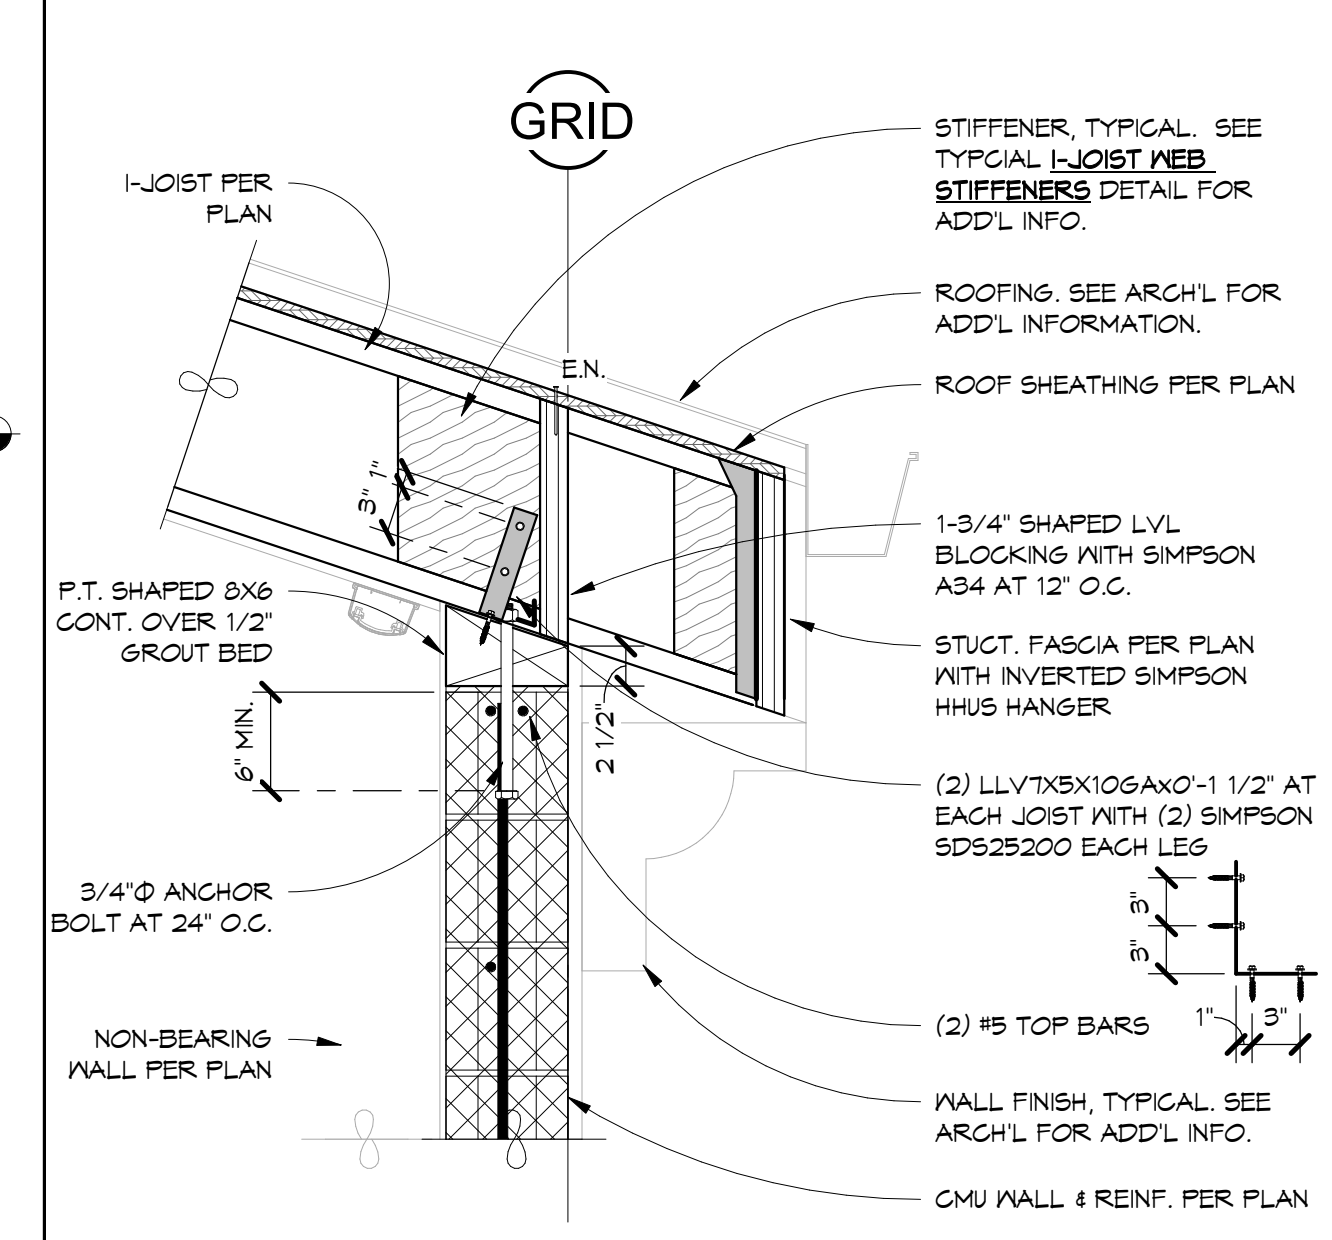


N14 DETAIL
P/S201.1 P/S601 1" = 1'-0"

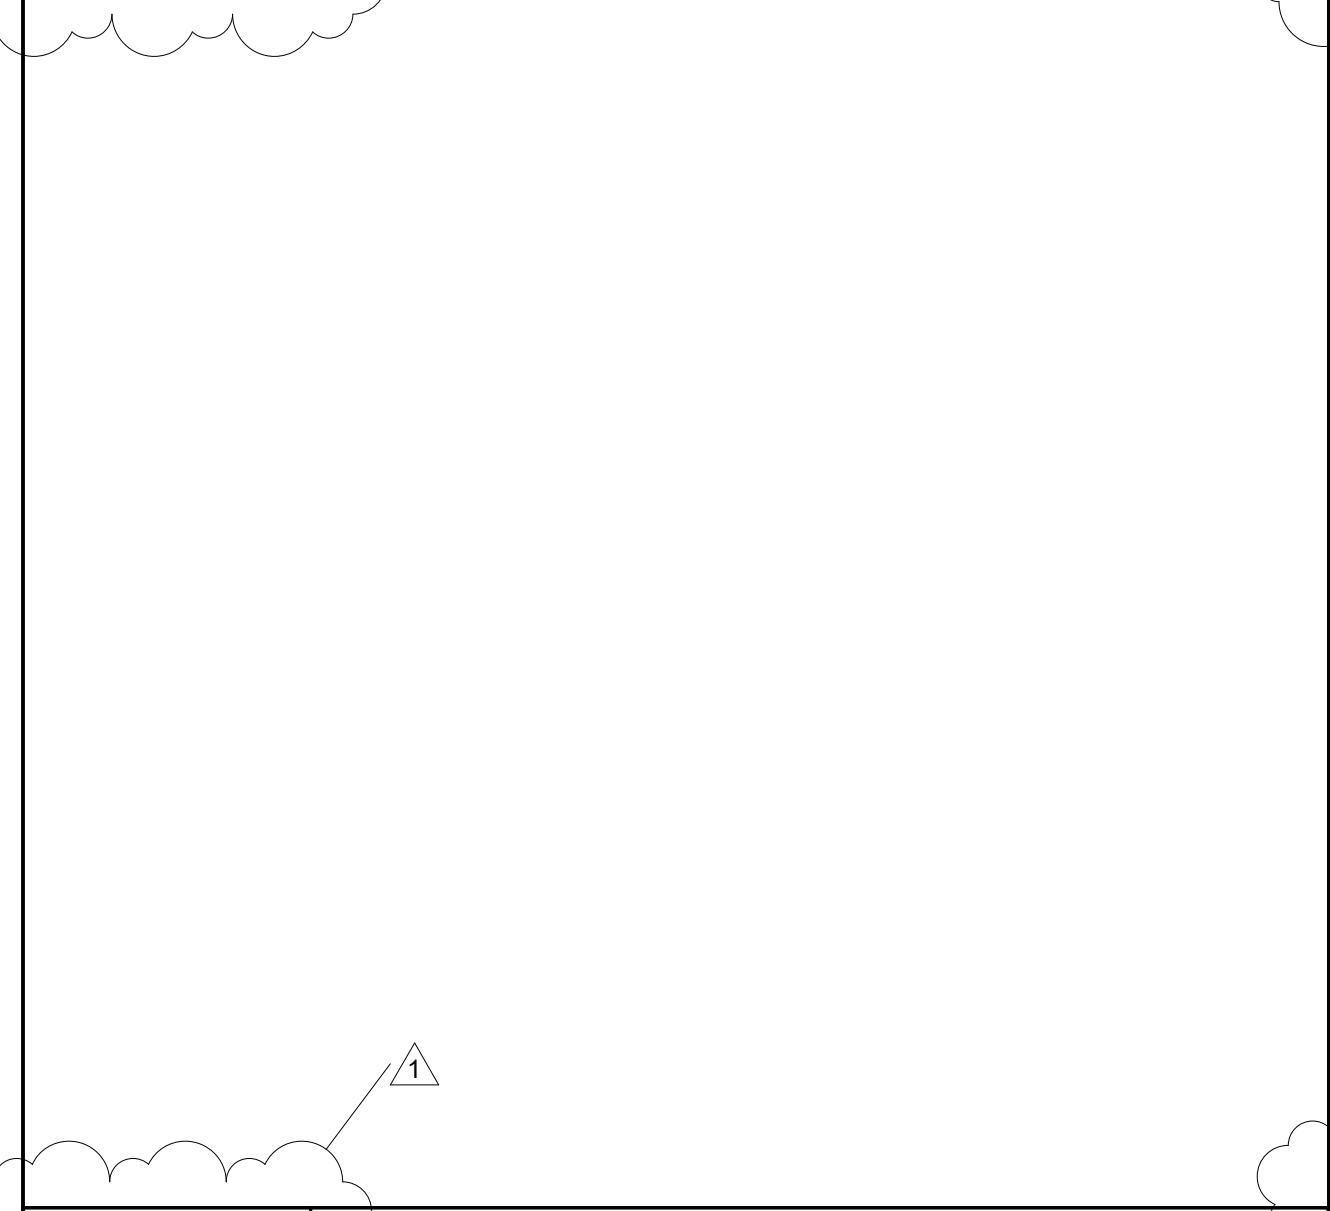


J7 DETAIL
P/S301 P/S601 1" = 1'-0"




J11 DETAIL
P/S201.1 P/S601 1" = 1'-0"

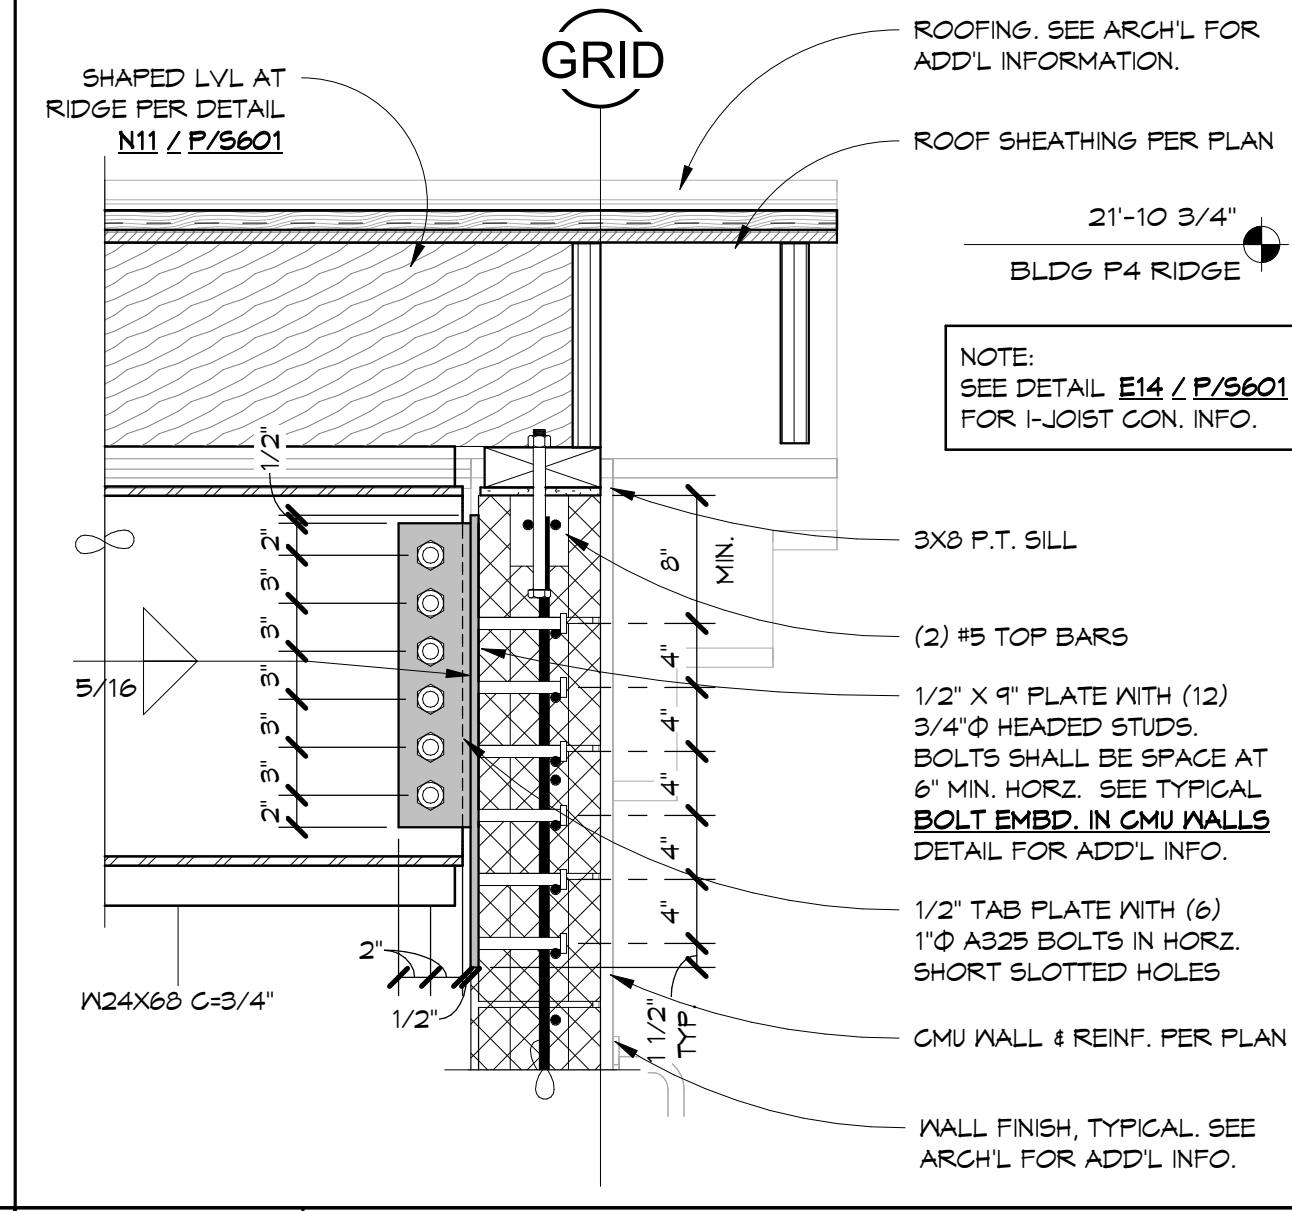


J14 DETAIL
P/S201.1 P/S601 1" = 1'-0"

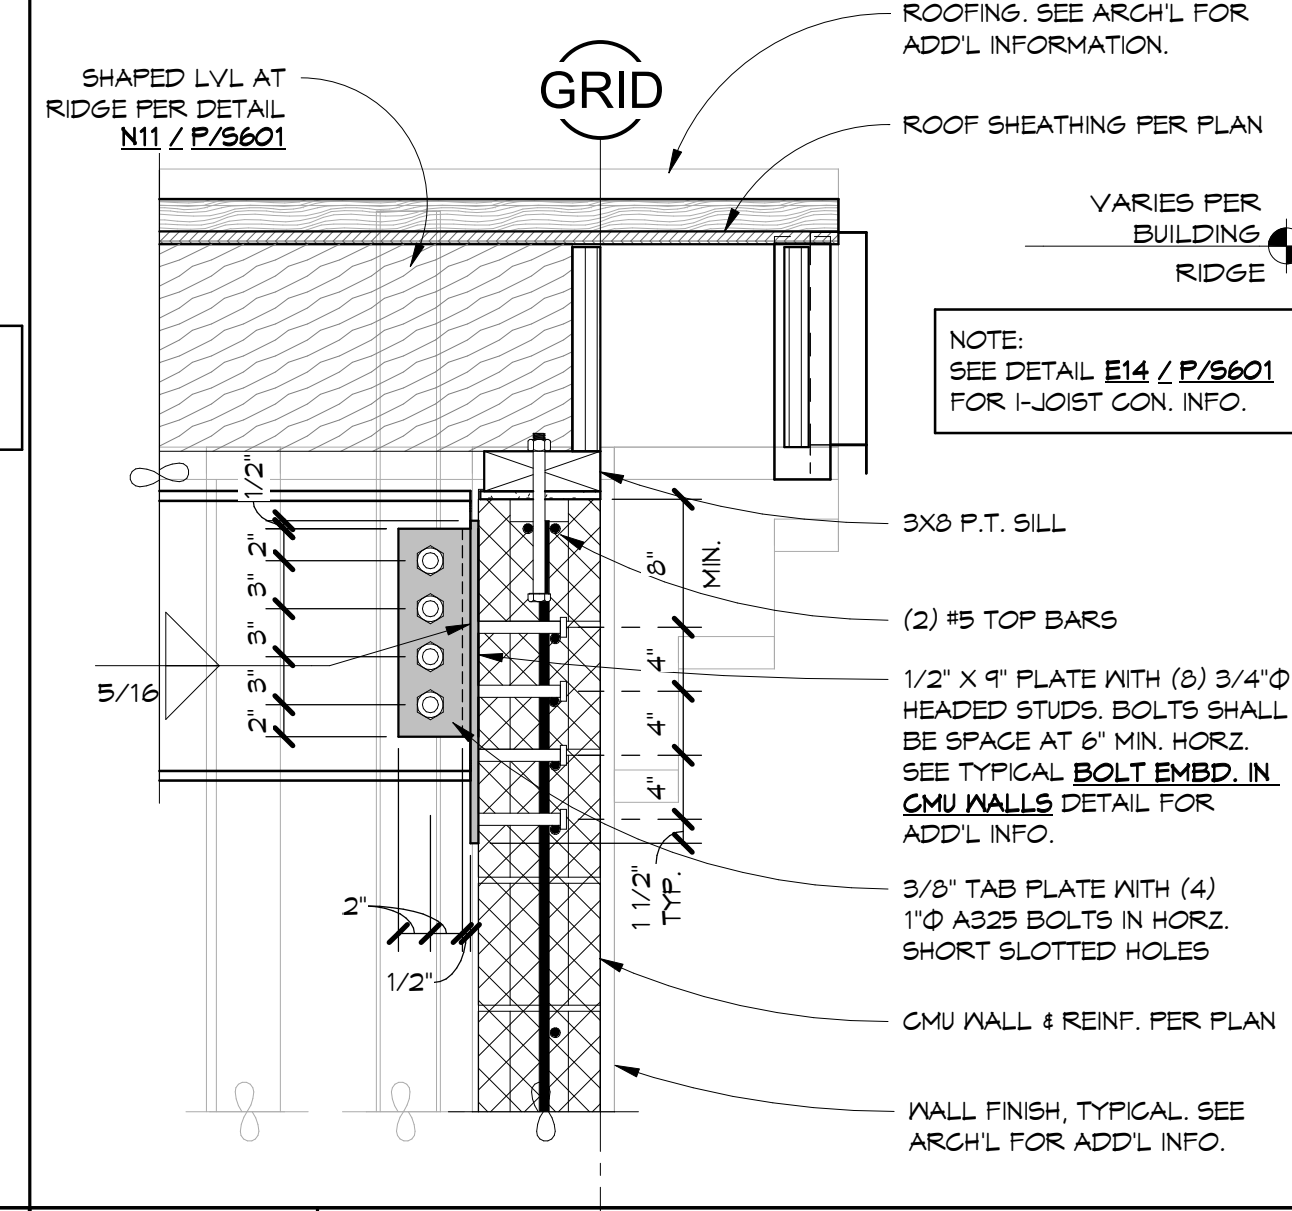


J7 DETAIL
P/S301 P/S601 1" = 1'-0"

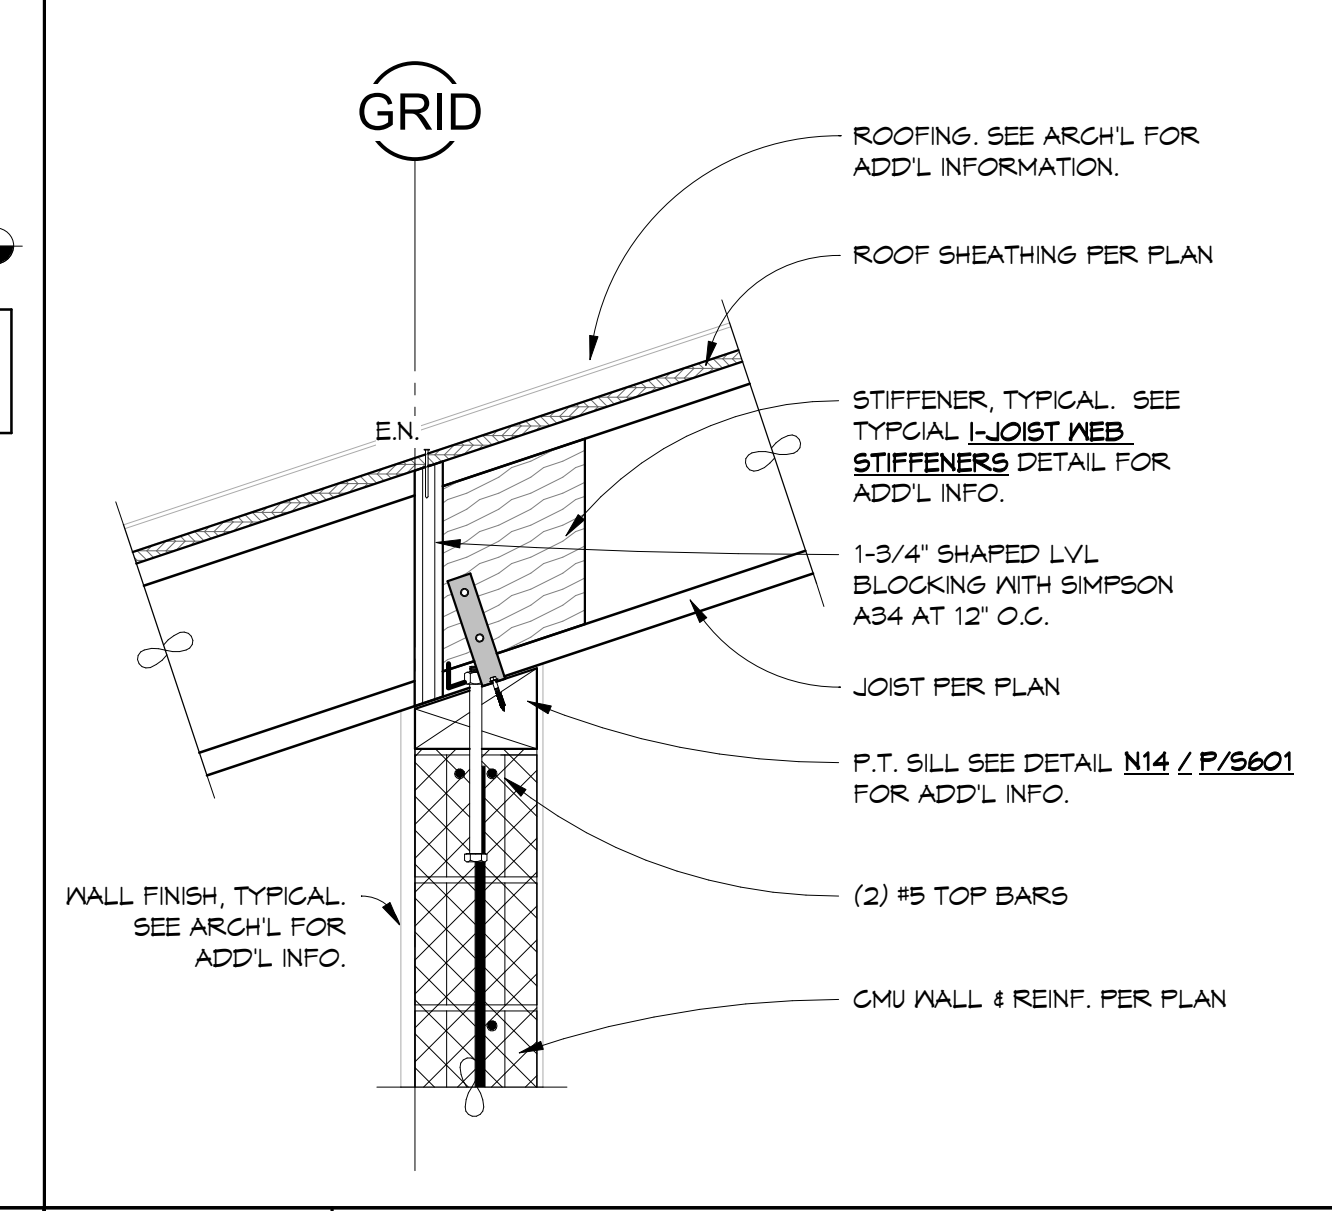


J11 DETAIL
P/S201.1 P/S601 1" = 1'-0"

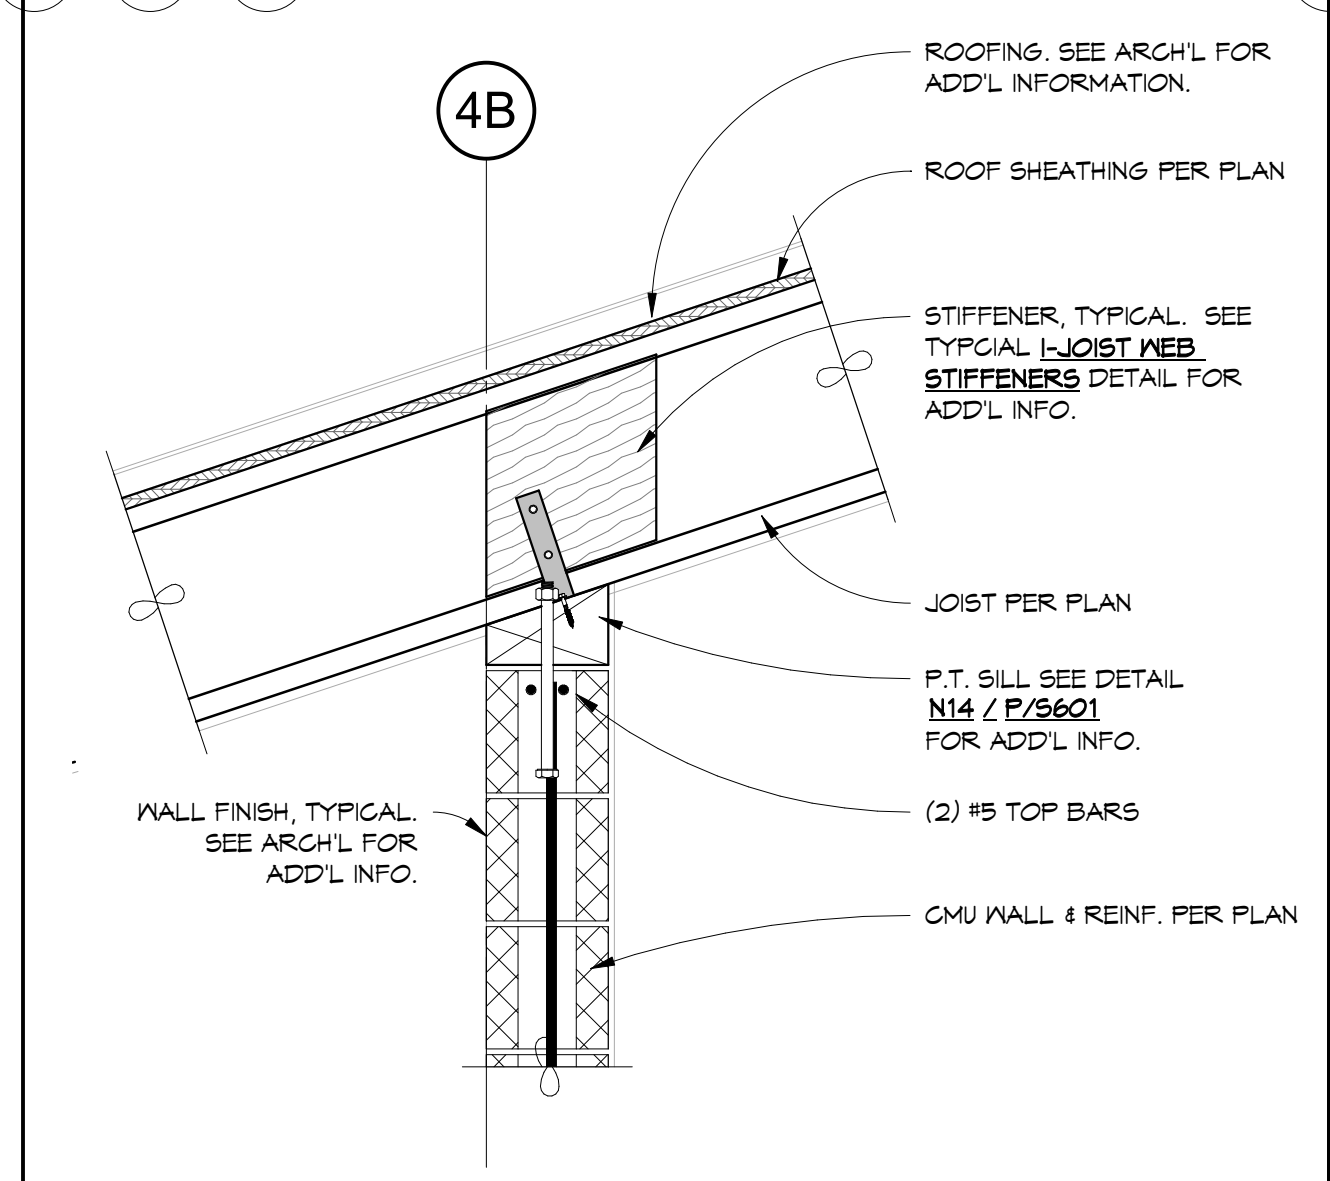


E1 DETAIL
P/S301 P/S601 1" = 1'-0"

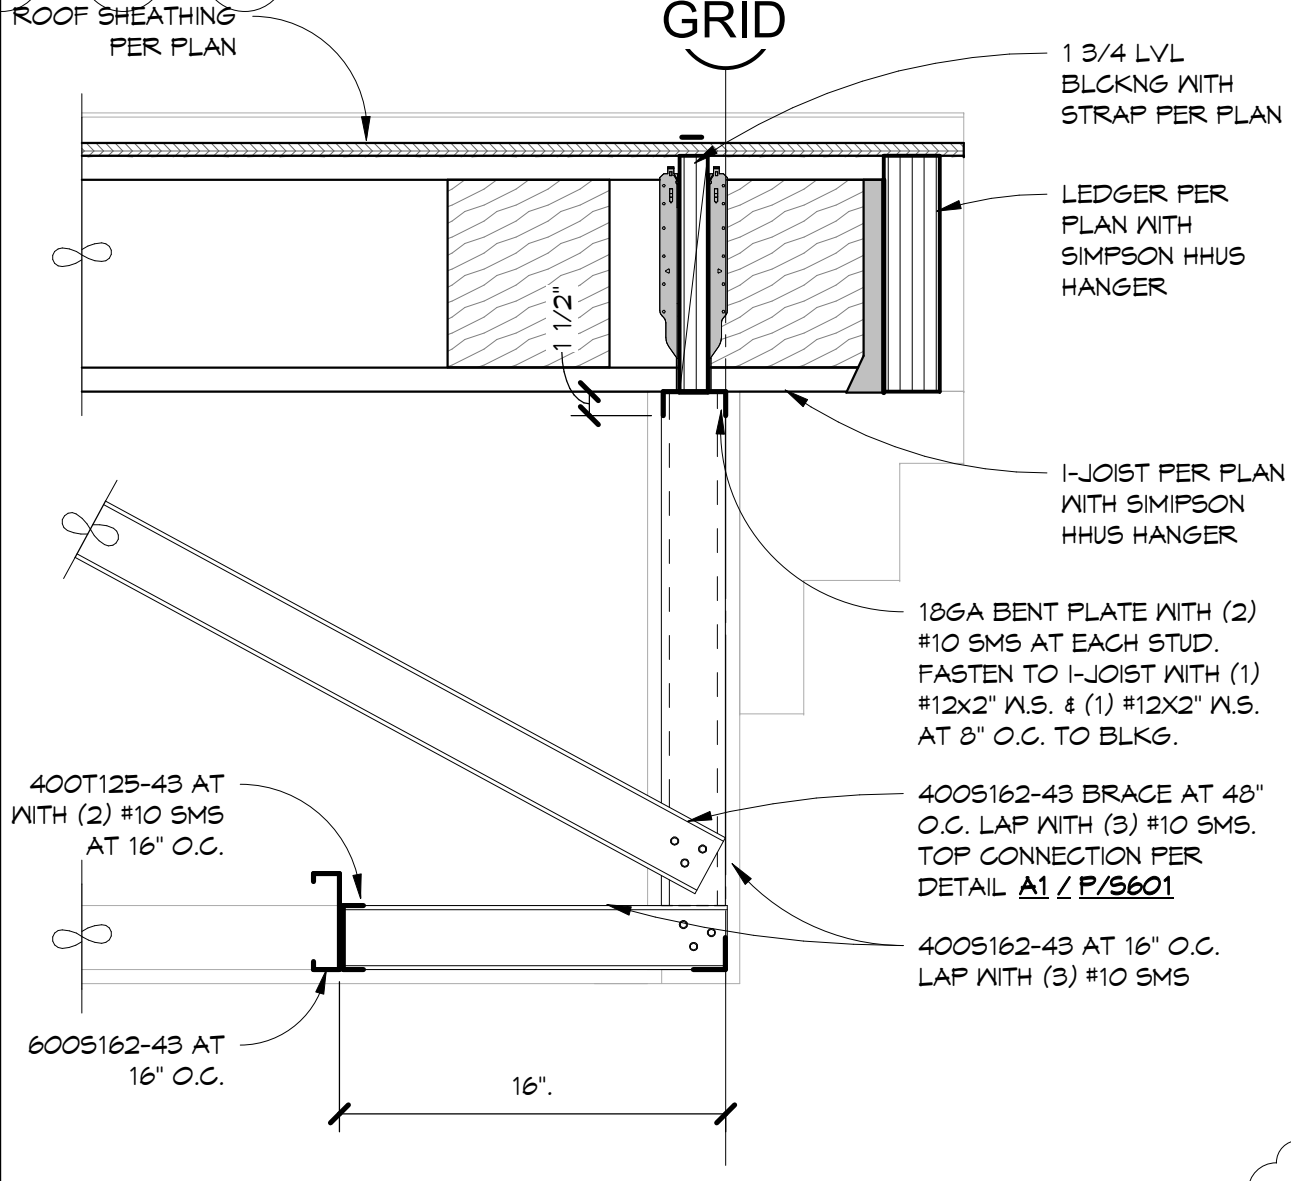


E4 DETAIL
P/S201.1 P/S601 1" = 1'-0"

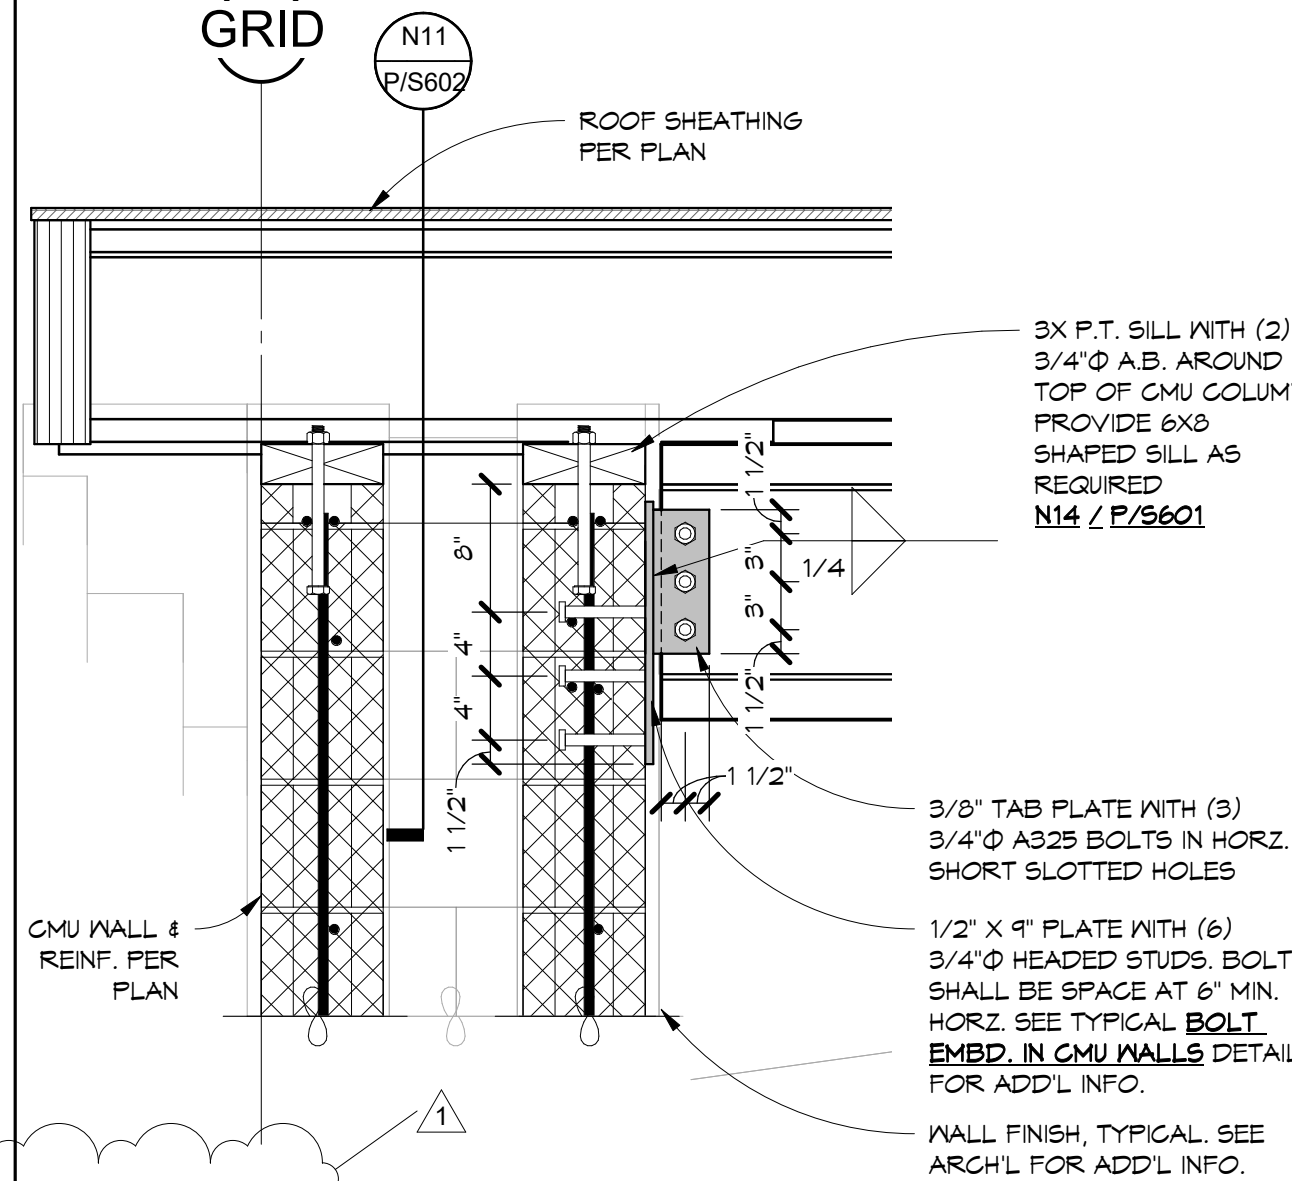


E7 DETAIL
P/S201.1 P/S601 1" = 1'-0"

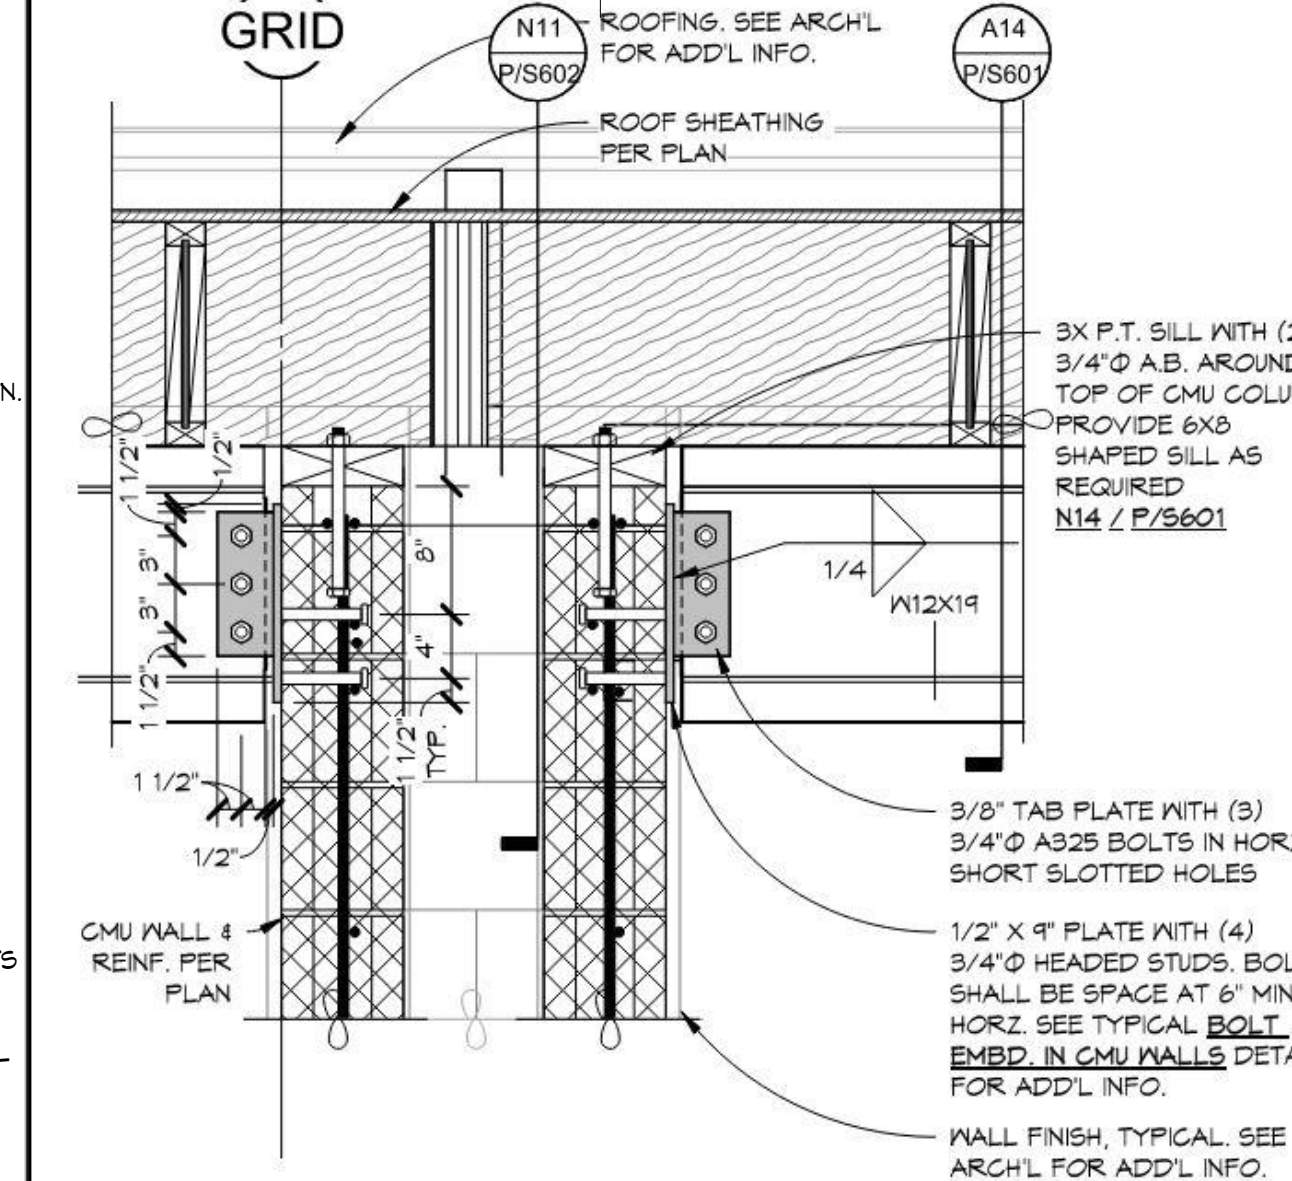


E11 DETAIL
P/S301 P/S601 1" = 1'-0"

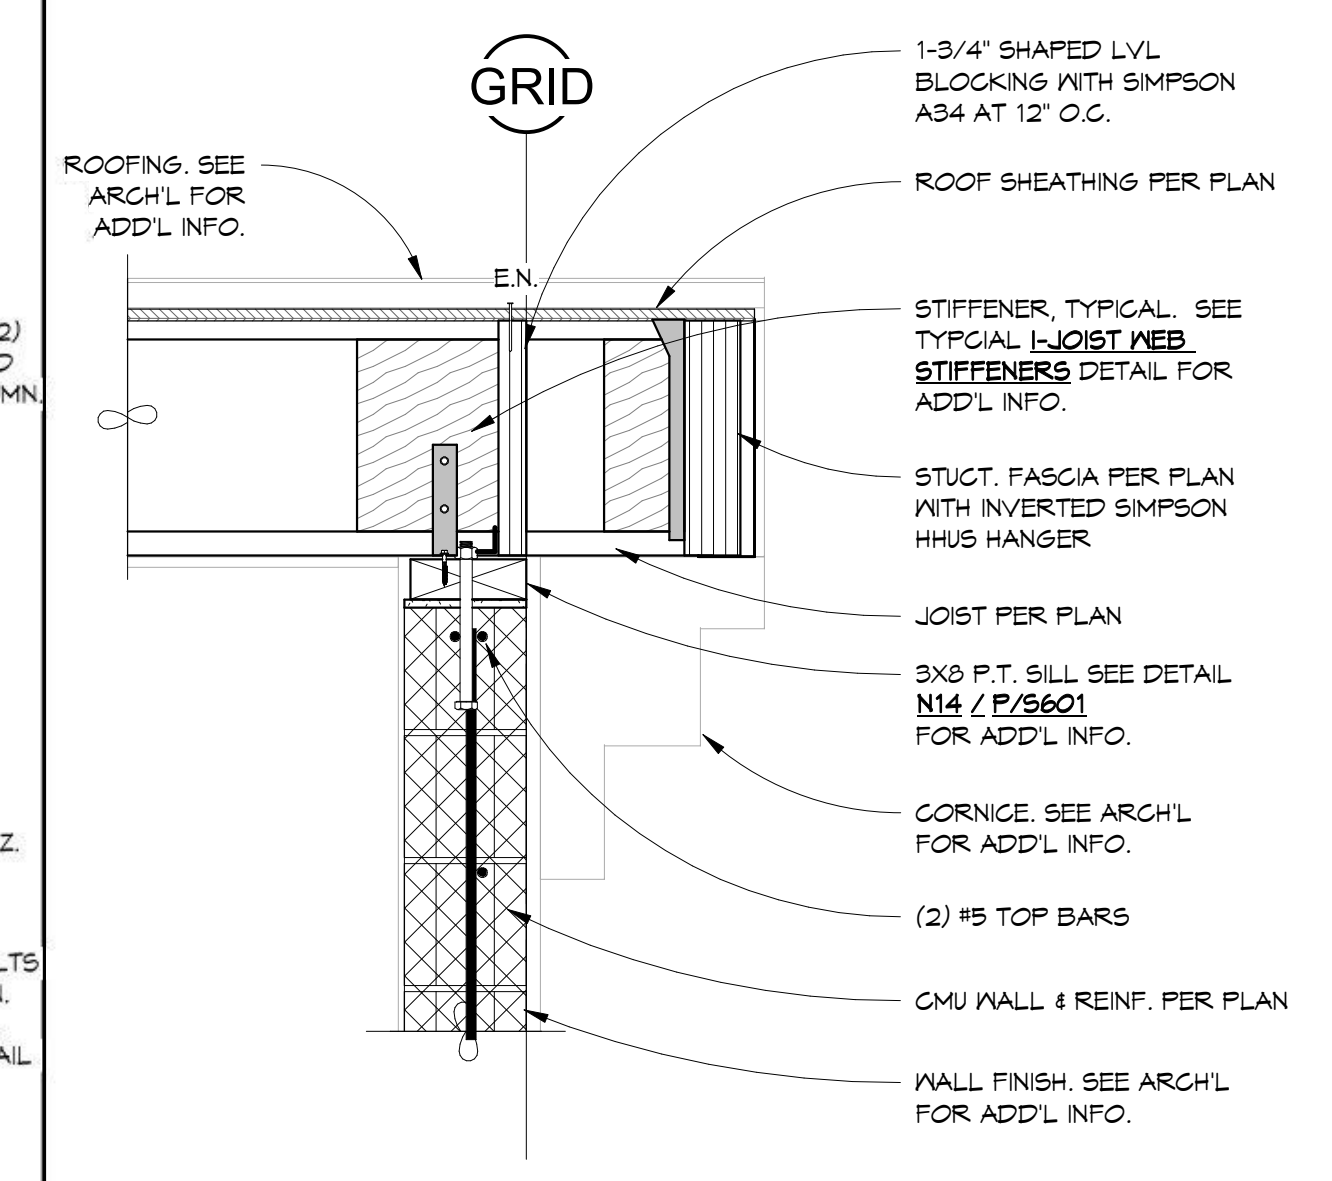

E14 DETAIL
P/S201.1 P/S601 1" = 1'-0"

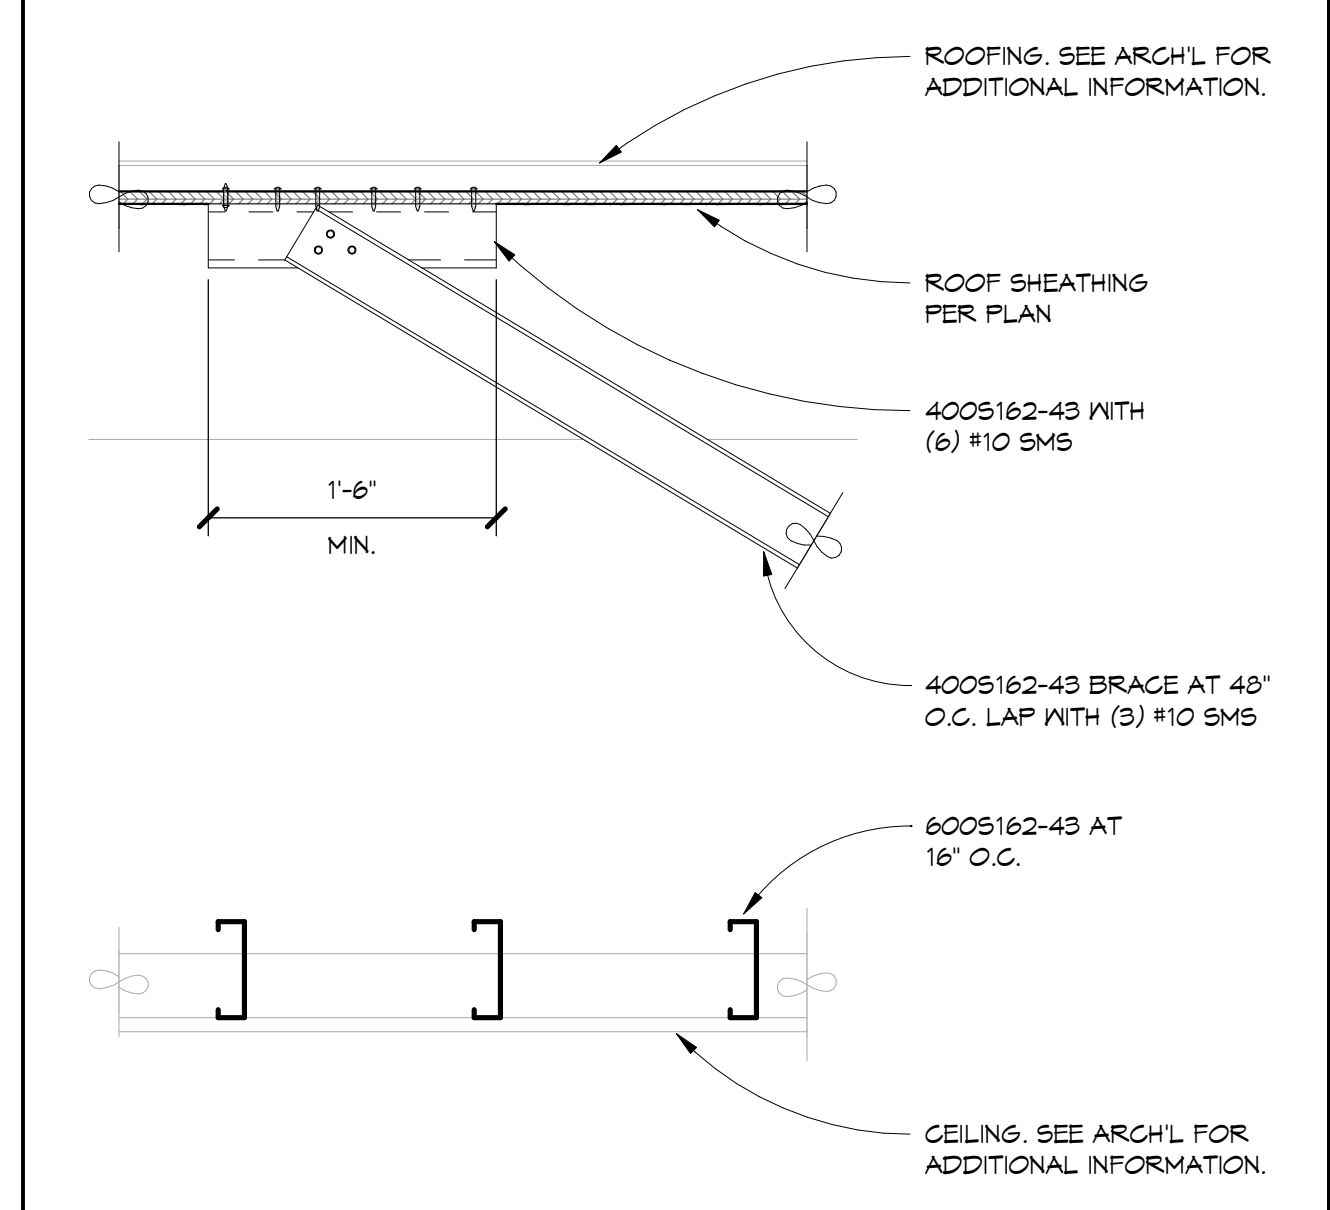


A1 DETAIL
P/S601 1" = 1'-0"

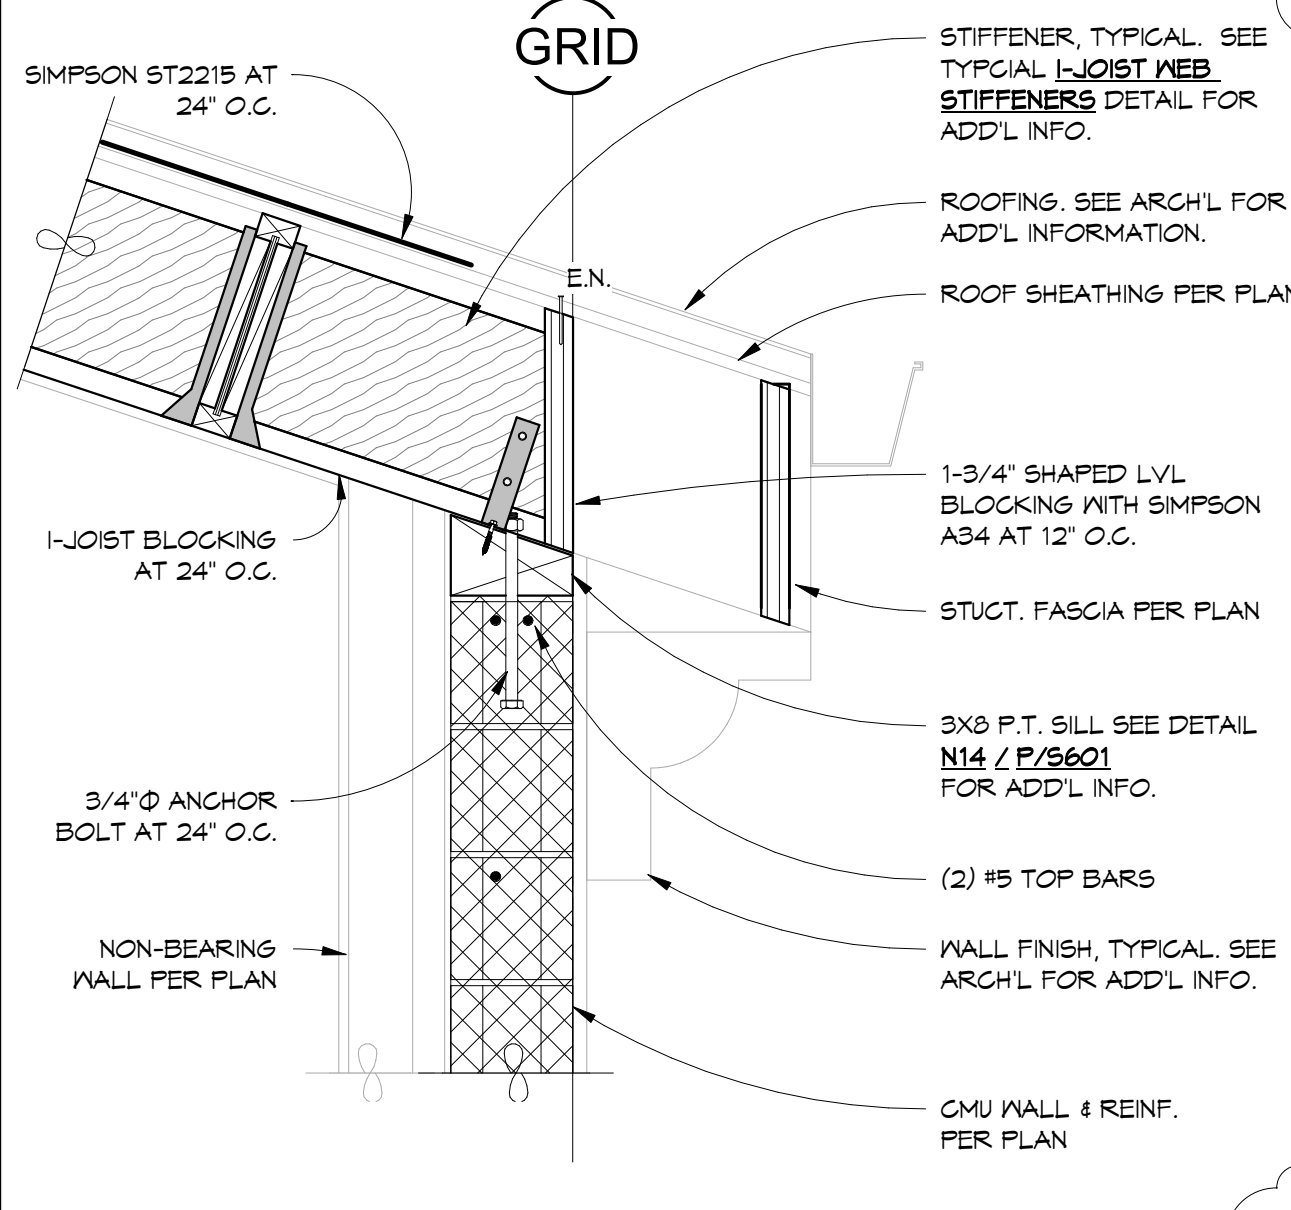


A4 DETAIL
P/S201.1 P/S601 1" = 1'-0"



A11 DETAIL
P/S201.1 P/S601 1" = 1'-0"

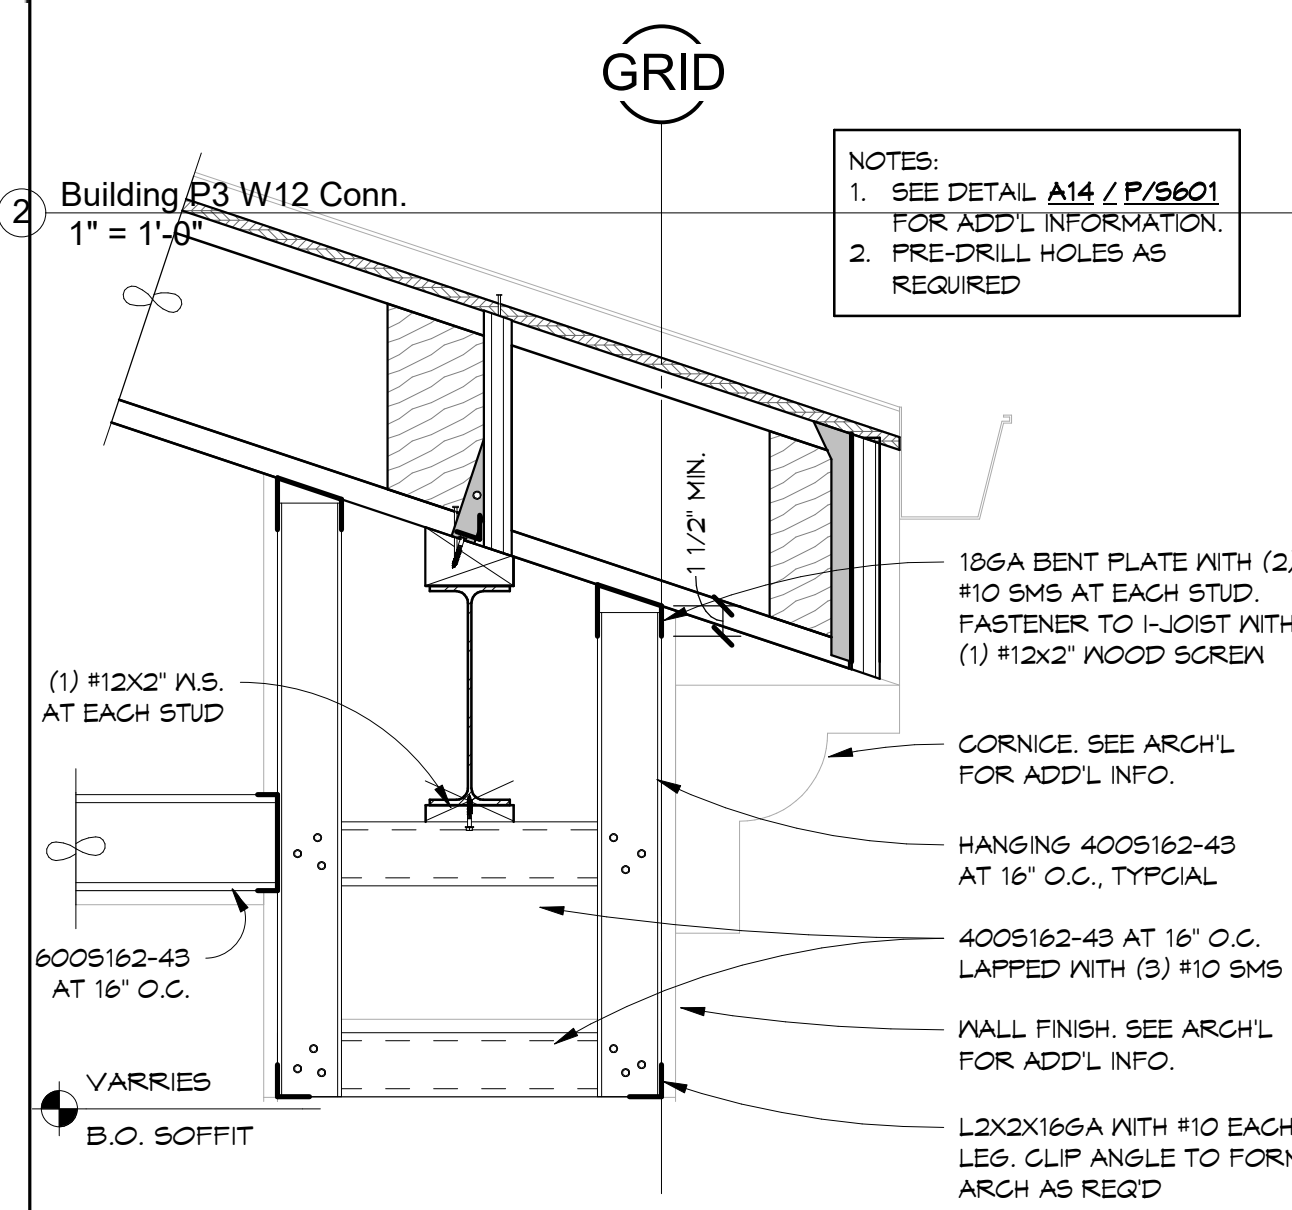

A14 DETAIL
P/S201.1 P/S601 1" = 1'-0"

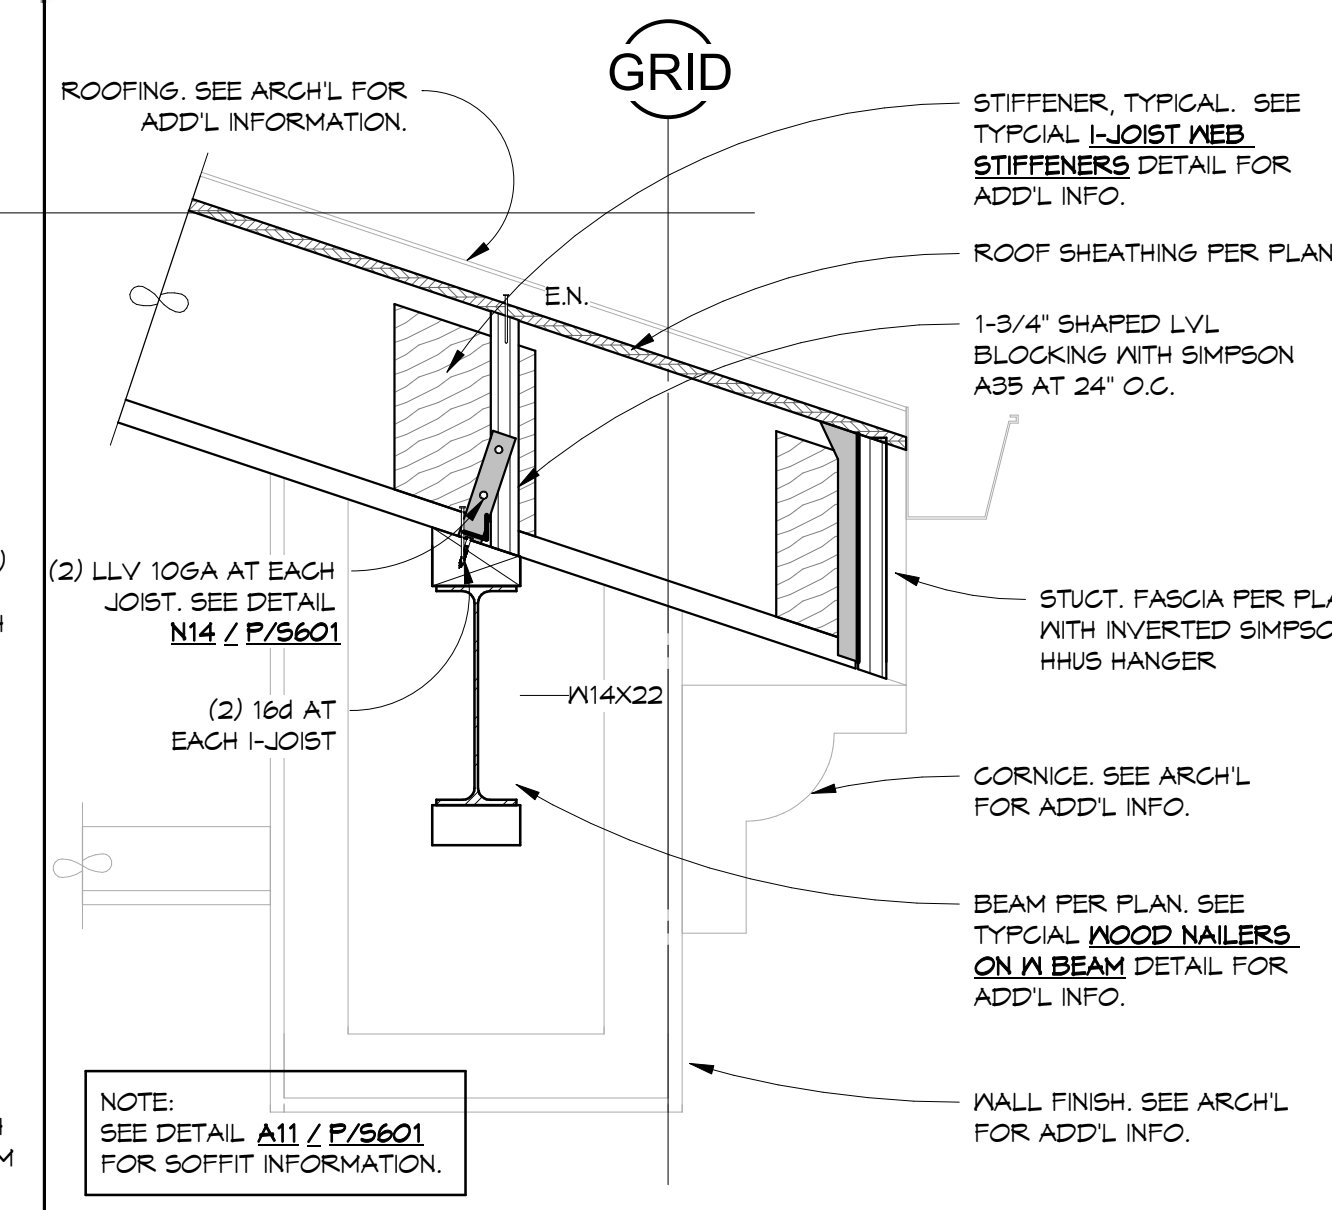

A14 DETAIL
P/S201.1 P/S601 1" = 1'-0"

BrooksRansom ASSOCIATES
CONSULTANT
Professional Engineer Seal: R. Darden, No. 52386, State of California

Mission Oak HS Aquatic Complex
Tulare Joint Union High School District
Tulare, CA 93274


Building P
FRAMING DETAILS
Drawing

darden ARCHITECTURE PLANNING INTERIORS
www.dardenarchitects.com
Architect


No.	Revision/Submission	Date
1	REVISION 1	05/31/2023

Scale: 1" = 1'-0"	Drawn By: ESB	Copyright: Darden Architects
Project Number: 2180	Checked By: ESB	P/S601
Date: 11/16/2022	Reviewed By: ESB	Sheet: _____ of: _____


8/18/2023 10:51:18 AM
 C:\Users\eric\Documents\22106 Mission Oak HS Aquatic VE - R22_EricBain2011.rvt

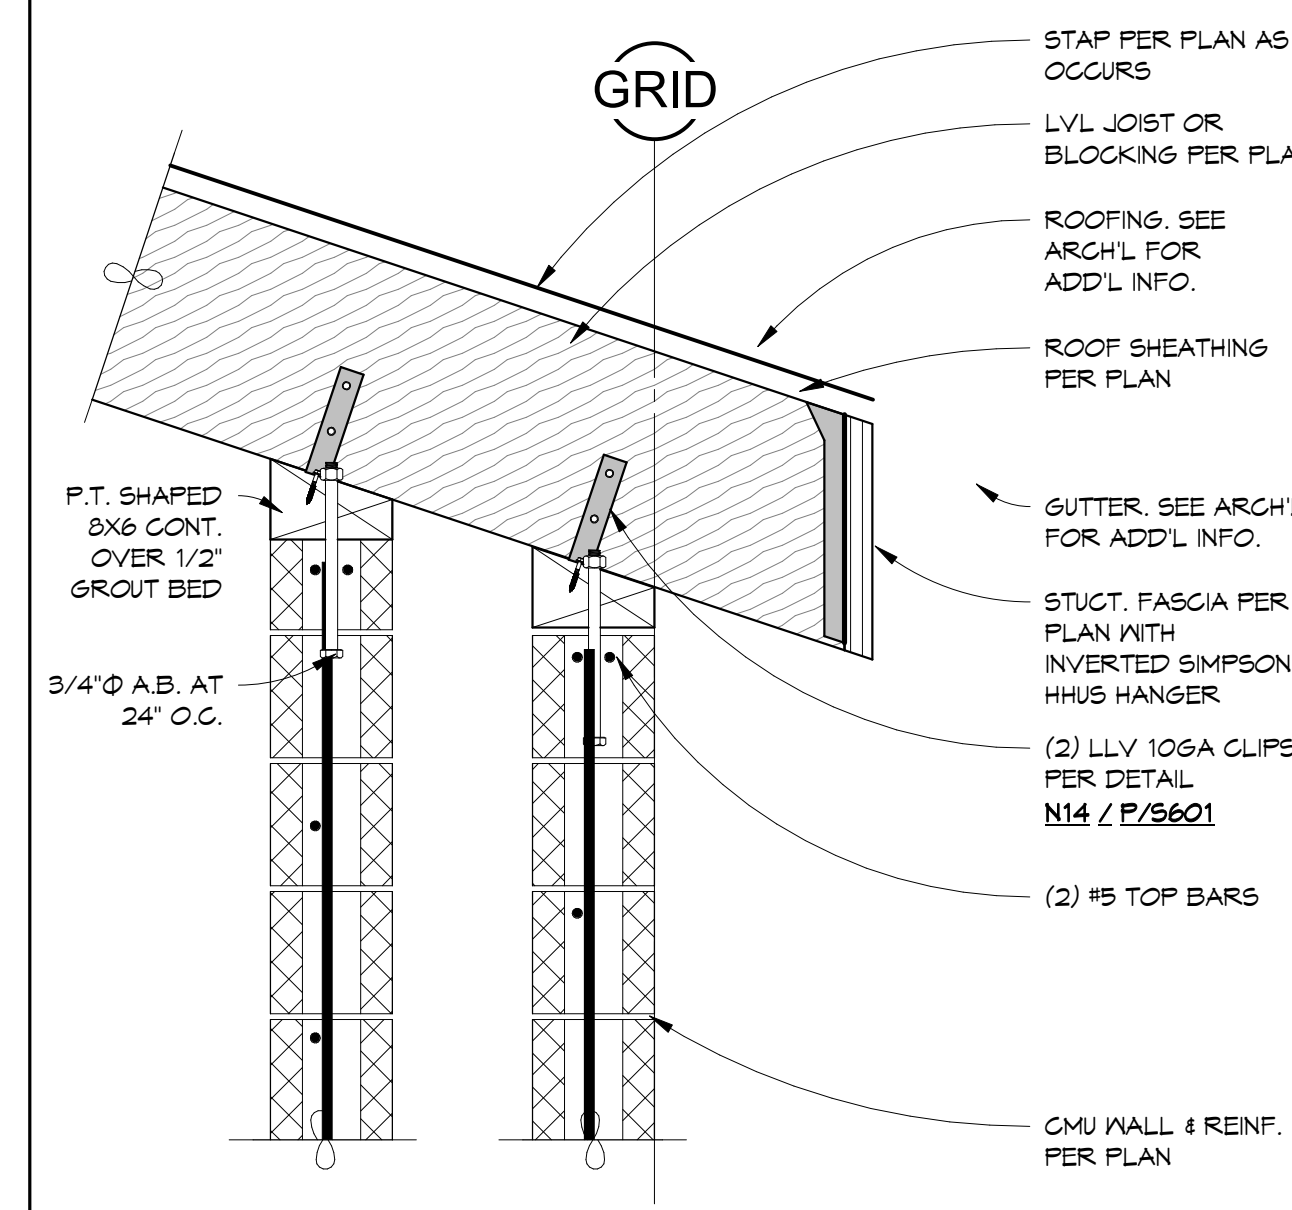


N11 DETAIL
 P/S301 | P/S602 | 1" = 1'-0"

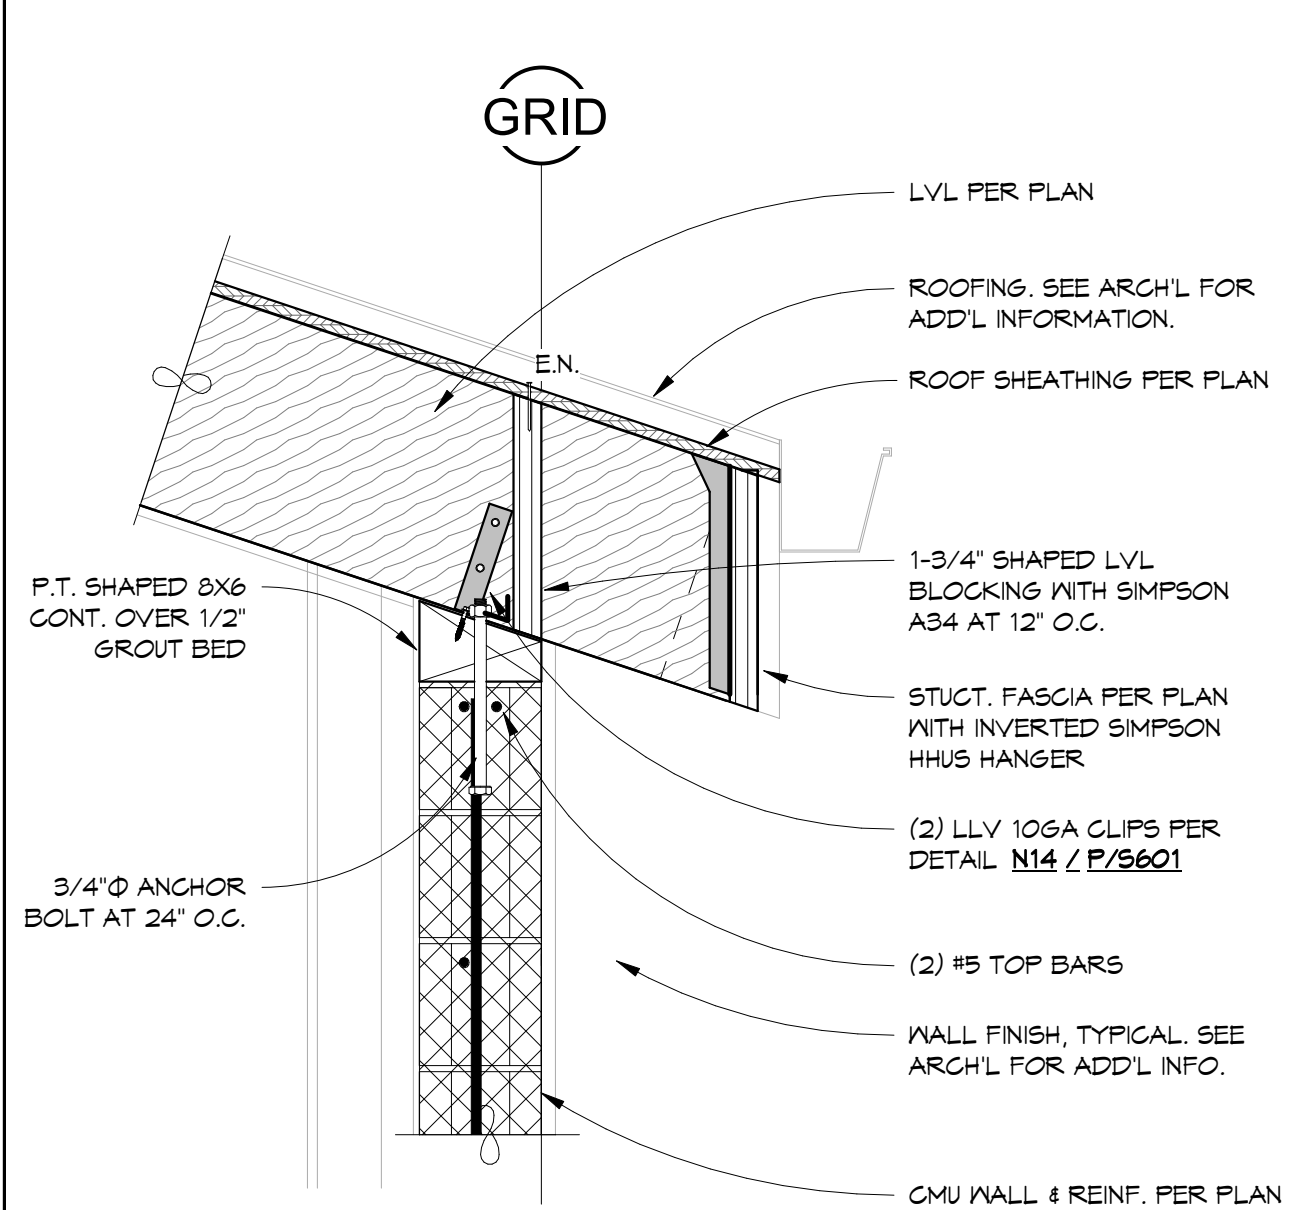


N14 DETAIL
 P/S201.1 | P/S602 | 1" = 1'-0"

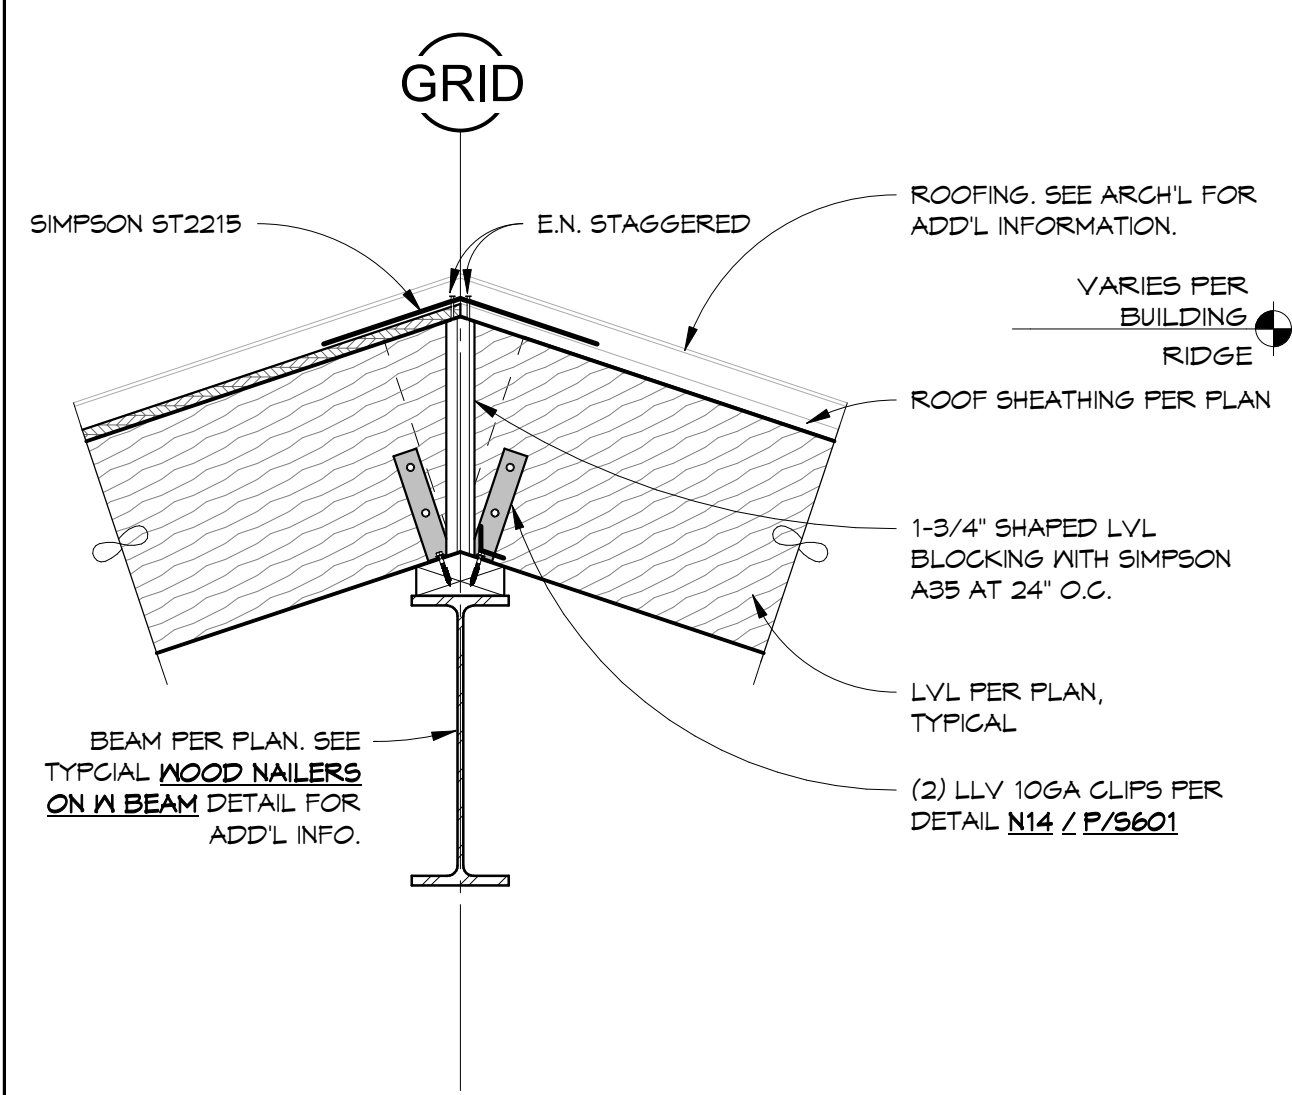

J14 DETAIL
 P/S201.1 | P/S602 | 1" = 1'-0"

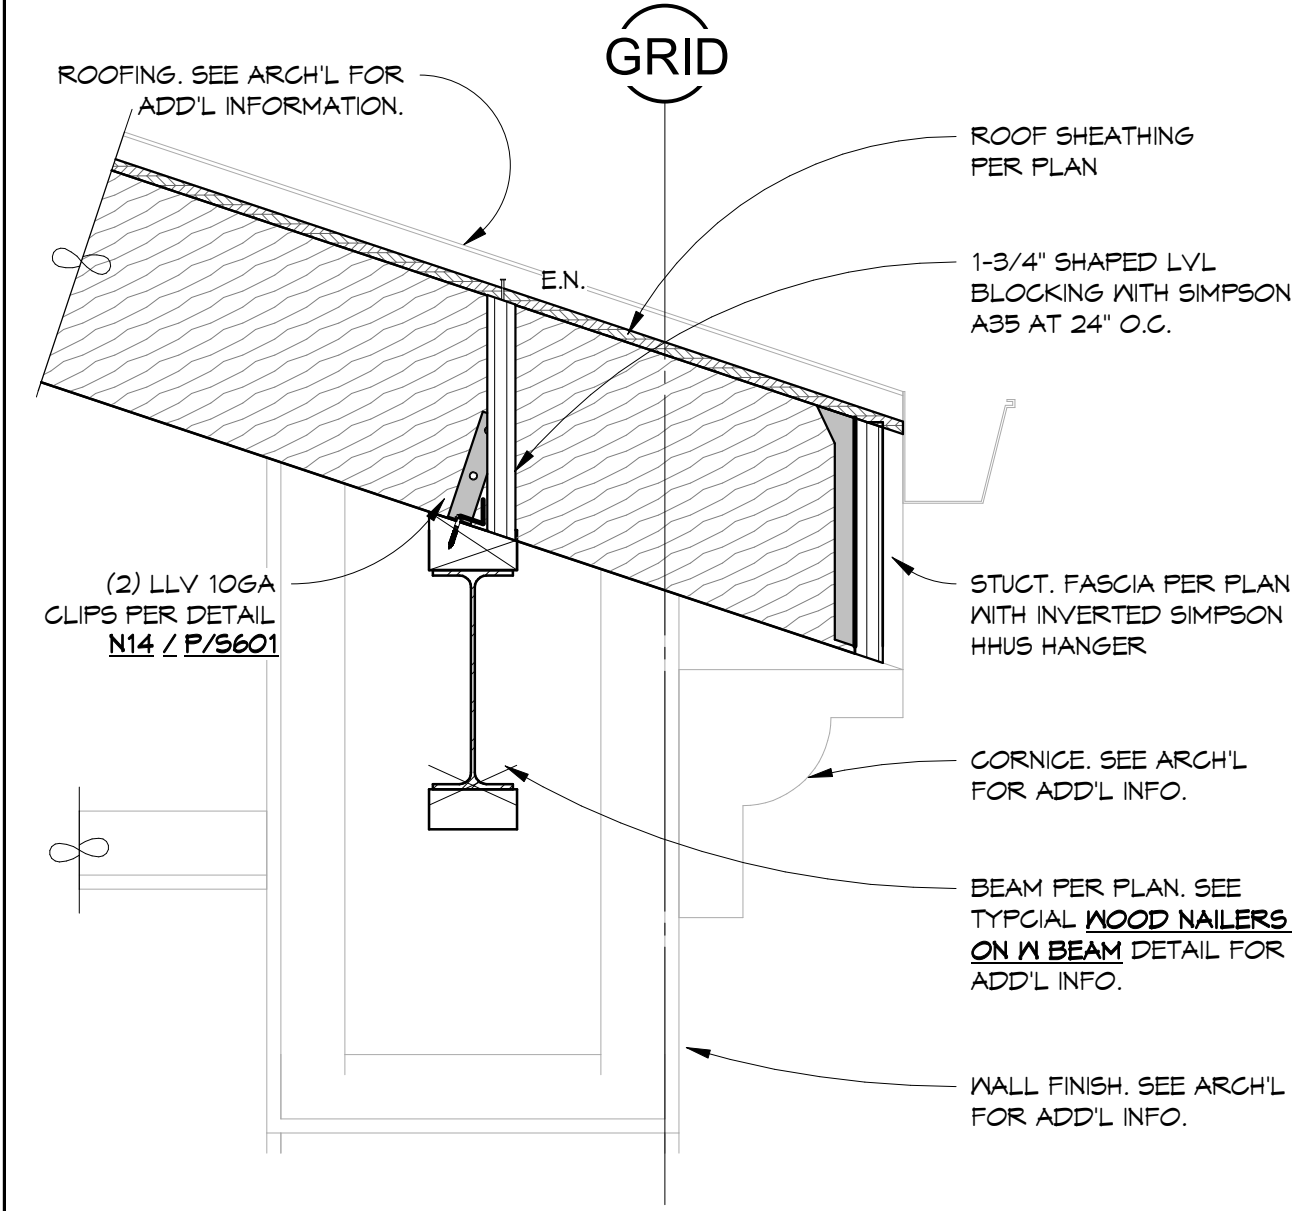

E14 DETAIL
 P/S201.1 | P/S602 | 1" = 1'-0"

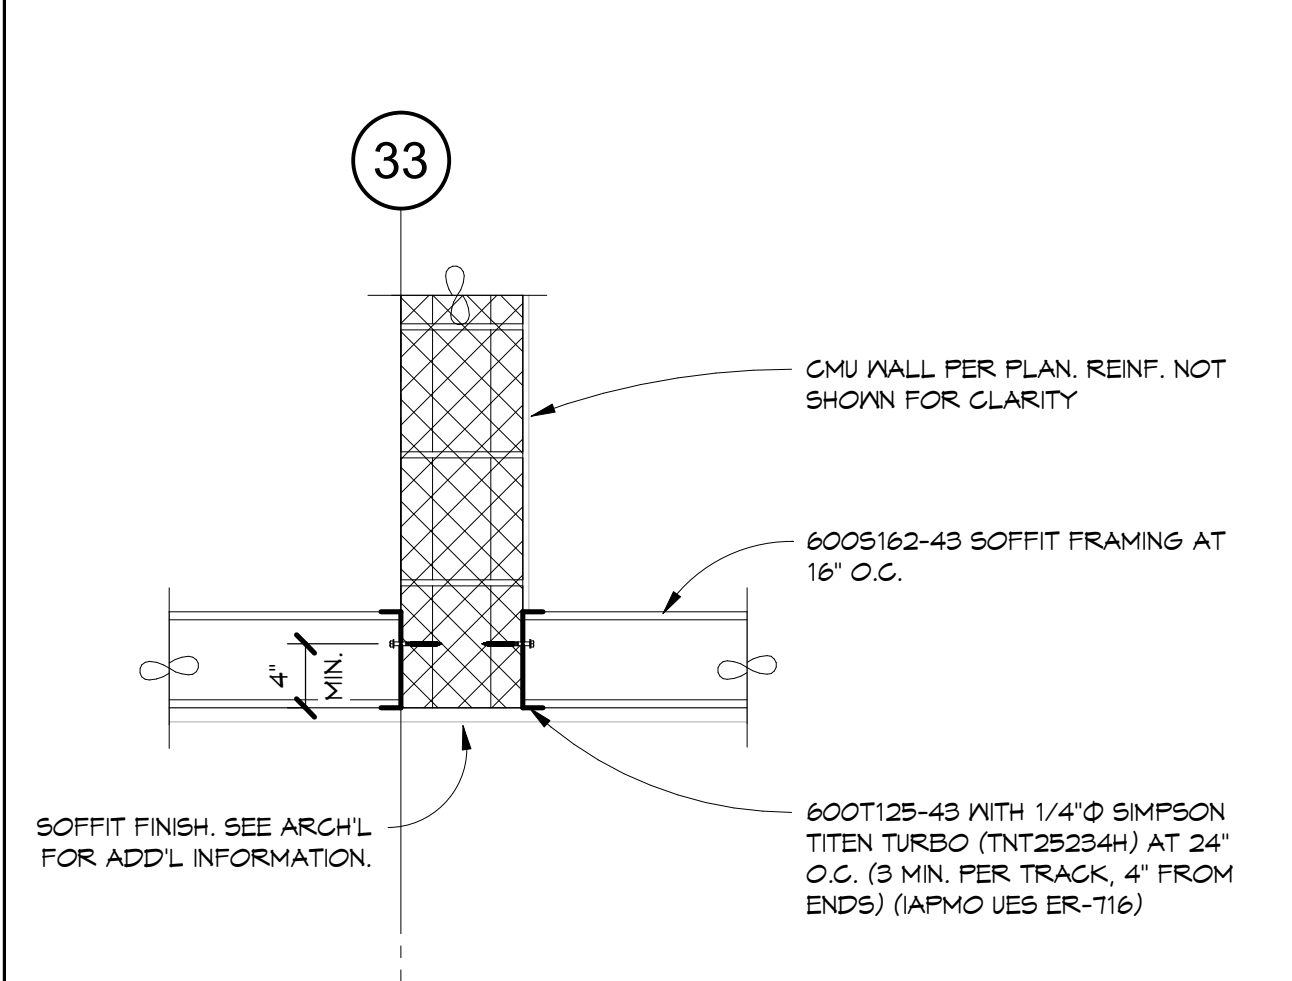

A14 DETAIL
 P/S405 | P/S602 | 1" = 1'-0"

DSA File No.:
 DSA Application No.: 02-120251
 Agency Approval

BrooksRansom ASSOCIATES
 CONSULTANT
 22108

ARCHITECTURE PLANNING INTERIORS
 ARCHITECT
 6790 N. West Ave. • Fresno, CA 93711 • T. 559.448.8051

Mission Oak HS Aquatic Complex
 Tulare Joint Union High School District
 Tulare, CA 93274


Building P
 FRAMING DETAILS

No.	Revision/Submission	Date
1	REVISION_1	05/31/2023

Revision

Designed Designer: Copyright: Darden Architects
 Scale: 1" = 1'-0" Drawn By: Author
 Project Number: 2180 Checked I/Checker
 Date: 11/16/2022 Reviewer/Approver

P/S602

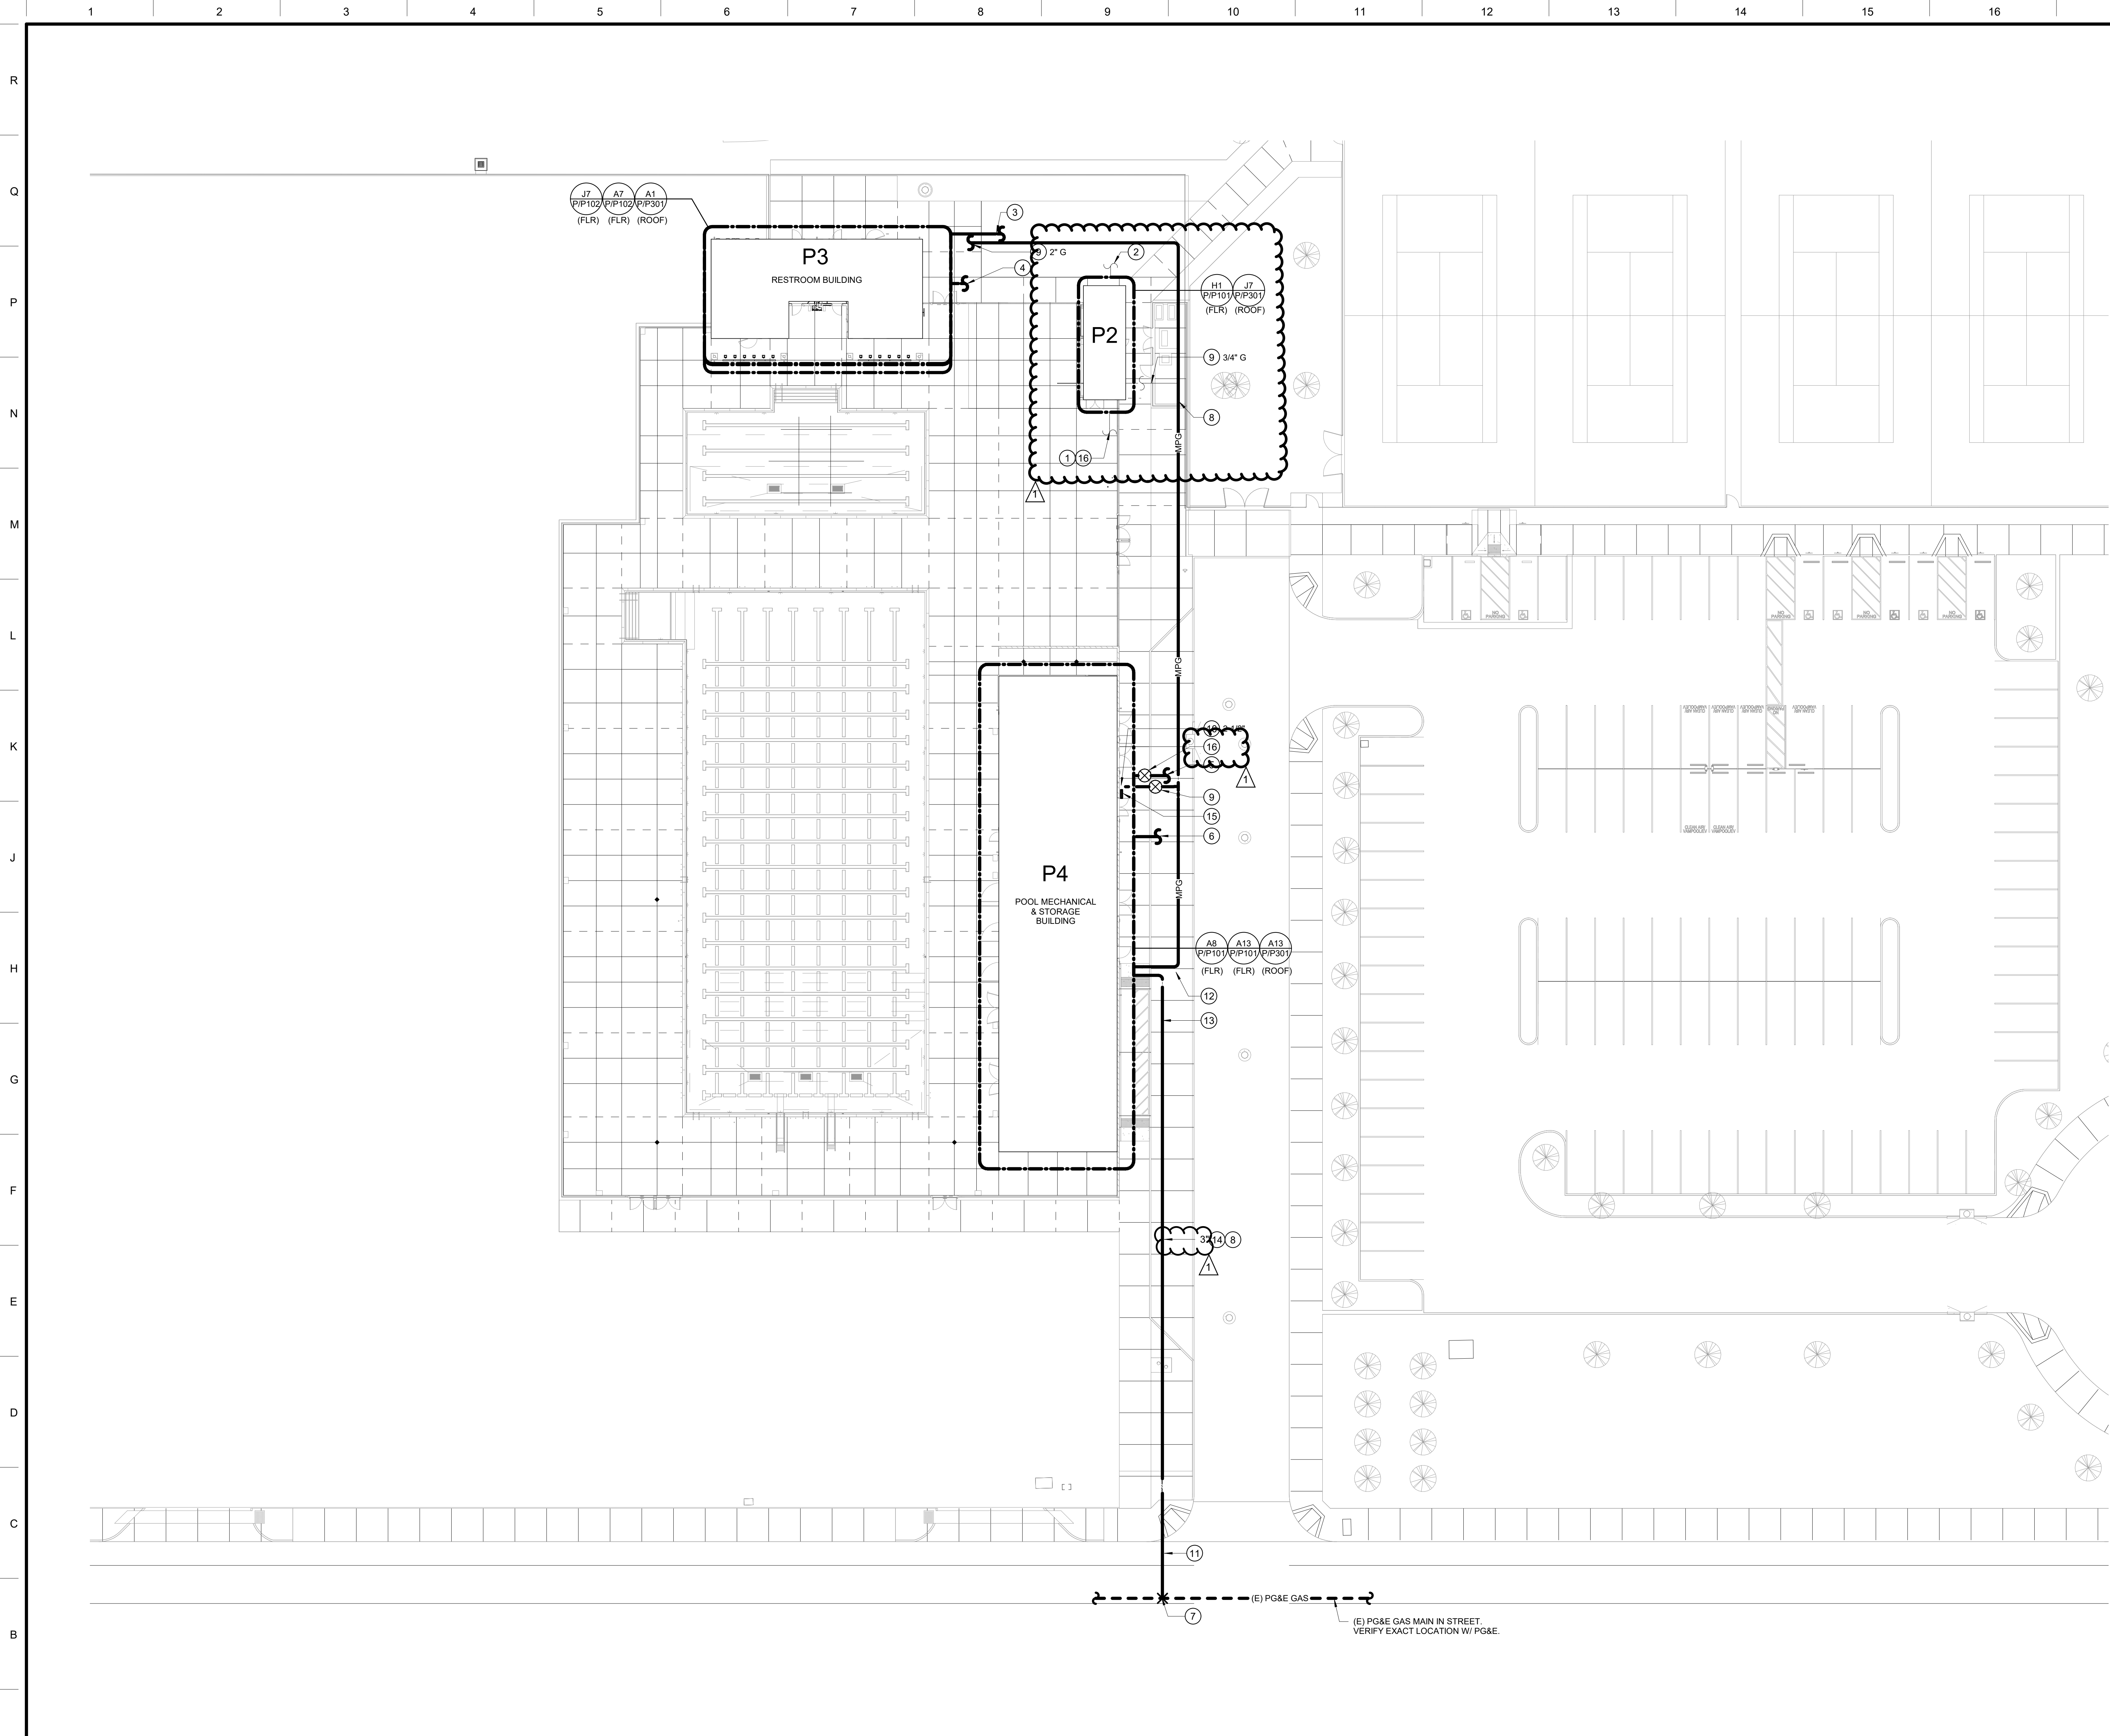

DSA File No.:
DSA File

DSA Application No.:
DSA App

Agency Approval

KEYNOTES #

- 1 2" CW TO BUILDING P2. REFER TO CIVIL PLANS FOR CONTINUATION.
- 2 4" S FROM BUILDING P2. REFER TO CIVIL PLANS FOR CONTINUATION.
- 3 2-1/2" CW TO BUILDING P3. SEE CIVIL PLANS FOR CONTINUATION.
- 4 4" S FROM BUILDING P3. REFER TO CIVIL PLANS FOR CONTINUATION.
- 5 3" CW TO BUILDING P4. REFER TO CIVIL PLANS FOR CONTINUATION.
- 6 6" S FROM BUILDING P4. REFER TO CIVIL PLANS FOR CONTINUATION.
- 7 POC. (N) PG&E GAS SERVICE LINE TO (E) GAS MAIN IN STREET. INSTALLATION OF (N) PG&E GAS SERVICE SHALL BE DONE BY A PG&E CERTIFIED SITE CONTRACTOR. PROVIDE SOVV PER PG&E.
- 8 (N) MEDIUM PRESSURE GAS BELOW GRADE IN UTILITY TRENCH PER DETAIL E4 ON SHEET X/P102.
- 9 MPG TO BUILDING WITH BUILDING GAS SOV IN BOX. SEE DETAILS A14 ON SHEET X/P102.
- 10 2-1/2" MPG TO BUILDING P4 WITH BUILDING GAS SOV IN BOX & GAS PRESSURE REGULATOR ABOVE GRADE IN LOCKABLE CAGE. SEE DETAILS J4 ON SHEET X/P102.
- 11 GAS SERVICE ROUTING TO GAS METER INSTALLATION OF (N) PG&E SERVICE SHALL BE DONE BY A PG&E CERTIFIED SITE CONTRACTOR.
- 12 CUSTOMER SIDE GAS ROUTED INTO GAS METER ENCLOSURE.
- 13 UTILITY SIDE GAS ROUTED INTO GAS METER ENCLOSURE.
- 14 MEDIUM PRESSURE GAS PIPING BELOW GRADE TO BUILDINGS. COORDINATE EXACT LOCATION WITH SITE UTILITIES.
- 15 GAS SHUT-OFF VALVE SIGN MOUNTED ON WALL. SEE DETAIL A8 ON SHEET X/P102.
- 16 CW TO BUILDING WITH BUILDING SOV IN BOX. SEE DETAIL A14 ON SHEET X/P102.

General Notes

NET POSITIVE
consulting
engineers
www.NPCEng.com
project no. 1101

Consultant

Mission Oak HS Aquatic Complex
Tulare Joint Union High School District
Tulare, CA 93274

Project

SITE DEVELOPMENT
PARTIAL PLUMBING SITE PLAN

Drawing

ARCHITECTURE
PLANNING
INTERIORS
architects
www.dardenarchitects.com
6790 N. West Ave. • Fresno, CA 93211 • T. 559.448.8051

Architect

No.	Revision/Submission	Date
1	REVISION_01	05/31/2023

Revision	
Designed By: JCS	Copyright 2022 Darden Architects
Scale: As indicated	Drawn By: AV
Project Number: 2180	Checked By: HB
Date: 07/13/2022	Reviewed By: JCS

SD/P102

8/15/2023 5:45:16 PM

A1 PARTIAL PLUMBING SITE PLAN
1" = 20' 0"

PLUMBING SCHEDULE

PLUMBING FIXTURE SCHEDULE						
MARK	FIXTURE	S OR W	V	CW	HW	DESCRIPTION
WC-1	WATER CLOSET ADA	4"	2"	1"	-	KOHLER "HIGHCLIFF ULTRA" MODEL K-96057-0, FLOOR-MOUNT, ELONGATED BOWL, HIGH EFFICIENCY, ANTI-MICROBIAL GLAZE, ZURN ZER8000PL-HET-CPM SENSOR OPERATED, BATTERY POWERED, 1.28 GPF AUTOMATIC FLUSH VALVE WITH MANUAL OVERRIDE, CHURCH 295SSCT SOLID PLASTIC OPEN FRONT SEAT WITH CHECK STAINLESS STEEL HINGE POSTS, SELF-SUSTAINING HINGES, AND STAT-TITE FASTENING SYSTEM. COLOR: WHITE.
WC-2	WATER CLOSET	4"	2"	1"	-	KOHLER "HIGHCLIFF ULTRA" MODEL K-96057-0, FLOOR-MOUNT, ELONGATED BOWL, HIGH EFFICIENCY, ANTI-MICROBIAL GLAZE, ZURN ZER8000PL-HET-CPM SENSOR OPERATED, BATTERY POWERED, 1.28 GPF AUTOMATIC FLUSH VALVE WITH MANUAL OVERRIDE, CHURCH 295SSCT SOLID PLASTIC OPEN FRONT SEAT WITH CHECK STAINLESS STEEL HINGE POSTS, SELF-SUSTAINING HINGES, AND STAT-TITE FASTENING SYSTEM. COLOR: WHITE.
U-1	URINAL ADA	2"	1-1/2"	3/4"	-	KOHLER K-5452-ET-0 "DEXTER" 0.125 GPF, WALL-HUNG, WASHOUT URINAL WITH STRAINER, ZURN ZER8000AV-ULF-CPM AQUA ADVANTAGE WITH TRIPLE FILTERED DIAPHRAGM, SENSOR OPERATED, BATTERY POWERED, 0.125 GPF AUTOMATIC FLUSH VALVE WITH MANUAL OVERRIDE, AND JAY R. SMITH 637 FLOOR-MOUNTED SUPPORT CARRIER WITH BOTTOM BEARING PLATE. SEE ARCHITECTURAL DRAWINGS FOR MOUNTING HEIGHTS. COLOR: WHITE.
L-1	LAVATORY ADA	2"	1-1/2"	3/4"	3/4"	BRADLEY MODEL MF2949-AST4-NSD WALL-HUNG, QUADRA-FOUNT WASHFOUNTAIN, 46"x26", SOLID SURFACE "TERREON", TYPE 304 STAINLESS STEEL, PEDESTAL FRAME AND ACCESS PANEL, AND (4) MANUAL AIR PUSHBUTTONS. PROVIDE BATTERY-POWERED, INFRARED SENSOR-OPERATED METERING (IBRS) SET FOR 10 SECOND MINIMUM / 30 SECOND MAXIMUM CYCLE TIME WITH 0.5 GPM FLOW. PROVIDE MCOUIRE 155WC OFFSET GRID DRAIN. PROVIDE NAVIGATOR THERMOSTATIC MIXING ASSEMBLY (TMA). SEE ARCHITECTURAL PLANS FOR ACCESSIBLE MOUNTING HEIGHTS. COORDINATE COLOR SELECTION WITH ARCHITECT.
L-2	LAVATORY ADA	2"	1-1/2"	3/4"	3/4"	KOHLER "KINGSTON" MODEL K-2005-0 WALL-HUNG, 20"x18" VITREOUS CHINA WITH BACKSPASH, WALL BRACKET AND 4" CENTER FAUCET HOLES. CHICAGO FAUCET MODEL 3300-ABCP MANUAL METERING FAUCET WITH 0.5 GPM SPRAY OUTLET. SET FAUCET FOR 10 SECOND MINIMUM/30 SECOND MAXIMUM CYCLE TIME. LEONARD 170-LF THERMOSTATIC MIXING VALVE SET AT 100°F. ASSE 1070-2015, MCGUIRE 155WC OFFSET GRID DRAIN AND JAY R. SMITH 700 SERIES SUPPORT CARRIER WITH CONCEALED ARMS. SEE ARCHITECTURAL DRAWINGS FOR ACCESSIBLE MOUNTING HEIGHTS. COLOR: WHITE.
SH-1	SHOWER ADA	-	-	3/4"	3/4"	BRADLEY CORPORATION MODEL HN200-TTPA-S15-ST-RSS-GB-VS, RECESSED MOUNTED CALIFORNIA ADA (CBC T24) COMPLIANT, 14 GAUGE STAINLESS STEEL, PRE-ASSEMBLED SHOWER SYSTEM WITH (1) FIXED SHOWERHEAD AND (1) HAND-HELD SHOWERHEAD, PRESSURE BALANCING SHOWER VALVE WITH LEVER HANDLE W/ THERMOSTATIC MIXING VALVE SET FOR 120°F MAXIMUM ASSE 1016-2017, DIVERTER VALVE WITH LEVER HANDLE, RECESSED SOAP DISH, INTEGRAL STOPS, REVERSIBLE PHENOLIC SHOWER SEAT, L-SHAPED 2-WALL GRAB BAR, AND VANDAL RESISTANT SCREWS W/ 1.5 GPM. SEE DRAWINGS FOR SHOWER LAYOUT.
SH-2	SHOWER VALVE FITTINGS	-	-	3/4"	3/4"	ZURN Z7500-I2-LS-14 "AQUA-PANEL" SHOWER UNIT, PRE-FABRICATED STAINLESS STEEL SHOWER UNIT W/ TEMP-GARD BALANCING SHOWER VALVE WITH SINGLE BRONZE STEM W/ THERMOSTATIC MIXING VALVE SET FOR 120°F MAXIMUM ASSE 1016-2017, STAINLESS STEEL BALANCING PISTON AND BOTTOM ACCESS INTEGRAL SERVICE STOPS, 14 GAGE STAINLESS STEEL SHROUD, CHROME-PLATED BRASS SHOWER HEAD WITH FLOW CONTROL, ON INSTITUTIONAL BRACKET, METAL STEM HANDLE AND VANDAL-PROOF SECURING SCREWS. MAXIMUM FLOW RATE 2.5 GPM AT 80 PSI.
SH-3	FREE-STANDING OUTDOOR SHOWER	-	-	3/4"	3/4"	ACORN "SHOWER-WARE" MODEL 901-6-LVR-P, 14 GAUGE, TYPE 304 STAINLESS STEEL PYLON SHOWER WITH SATIN FINISH STEEL PLATE BASE WITH COATED WALL MOUNT, POLISHED CHROME FAUCET WITH DISCHARGE HEIGHT OF 5'-6", PRE-PIPED AND HYDROSTATICALLY TESTED TO 150 PSI. SUPPLIED WITH TEMPERED WATER FROM SINGLE THERMOSTATIC MIXING VALVE. MV-2, LEVER HANDLE, AND PENAL SHOWER HEAD.
FD-1	FLOOR DRAIN (ACID RESISTANT)	2"	1-1/2"	TP	-	"SPEARS" #LW1600-04096, 5" DIAMETER SS GRATE, CPVC FLOOR DRAIN W/ ROUND GRATE, NO HUB OUTLET AND TRAP PRIMER CONNECTION.
TD-1	TRENCH DRAIN	3"	1-1/2"	TP	-	ZURN Z886 PERMA-TRENCH 6" DRAIN SYSTEM WITH 4" THROAT, LENGTH PER PLAN WITH 0.75% SLOPE BUILT-IN, HOPE TRENCH DRAIN SYSTEM WITH POLYPROPYLENE HEEL-PROOF ADA COMPLIANT 20" LONG SLOTTED GRATE, CLOSED END CAP, AND 4" NO-HUB BOTTOM.
FS-1	FLOOR SINK	2"	1-1/2"	TP	-	JAY R. SMITH 3140Y-12-C, 12"x12"x6" DEEP COATED CAST IRON WITH NICKEL BRONZE RM WITH HALF GRATE, DOME BOTTOM STRAINER, DOUBLE DRAINAGE FLANGE, NO HUB OUTLET, AND TRAP PRIMER CONNECTION FITTING WHERE APPLICABLE.
FS-2	FLOOR SINK (ACID RESISTANT)	3"	2"	TP	-	JAY R. SMITH 3160Y-12-C, 12"x12"x10" ACID RESISTANT COATED FLOOR SINK, DOME BOTTOM STRAINER, DOUBLE DRAINAGE FLANGE, NO HUB OUTLET, AND TRAP PRIMER CONNECTION FITTING WHERE APPLICABLE.
FS-3	FLOOR SINK (ACID RESISTANT)	6"	3"	TP	-	JAY R. SMITH 3251Y-12, 24"x12"x11" ACID RESISTANT COATED FLOOR SINK, DOME BOTTOM STRAINER, DOUBLE DRAINAGE FLANGE, NO HUB OUTLET, AND TRAP PRIMER CONNECTION FITTING WHERE APPLICABLE.
TP-1	TRAP PRIMER	-	-	3/4"	-	PRECISION PLUMBING PRODUCTS MODEL P1-500 PRESSURE DROP ACTIVATED, BRASS CONSTRUCTION, WITH #DU-U DISTRIBUTION UNIT FOR UP TO (4) FLOOR DRAINS. PROVIDE 12"x12" STAINLESS STEEL ACCESS DOOR WITH CYLINDER LOCK. PROVIDE SOV UPSTREAM OF TRAP PRIMER.
MS-1	MOP SINK	3"	2"	3/4"	3/4"	KOHLER "WHITBY" K-6710 CORNER STYLE FLOOR-MOUNTED, 28"x28"x12" DEEP ENAMELED CAST IRON WITH #K-8940 RM QUARD, #K-9148 DRAIN STRAINER, #K-9798 WALL MOUNT, POLISHED CHROME FAUCET WITH HOSE THREAD OUTLET, VACUUM BREAKER, INTEGRAL STOPS, INTEGRAL CHECK VALVES, AND WALL BRACE. FLORESTONE #MR-370 HOSE WITH HOOK AND #MR-372 MOP HANGER.
S-1	HAND WASH SINK	2"	1-1/2"	3/4"	3/4"	JUST MFG. A-3338 WALL-HUNG, 16"x18", 18 GAUGE, TYPE 304 STAINLESS STEEL WITH BACKSPASH AND WALL BRACKET, 4" CENTER FAUCET HOLES, STAINLESS STEEL GRID DRAIN, AND CHICAGO 885-317RGD1ABCP DECK-MOUNTED 2.2 GPM COSINKER FAUCET HANDLE. PROVIDE 2" MINIMUM CLEARANCE FROM POINT OF USE. THERMOSTATIC MIXING VALVE BELOW SINK. PROVIDE A STEEL SUPPORT PLATE FOR MOUNTING FIXTURE PER DETAIL X ON SHEET XPI102. SEE ARCHITECTURAL DRAWINGS FOR ACCESSIBLE MOUNTING HEIGHT.
DF-1	DRINKING FOUNTAIN ADA	2"	1-1/2"	3/4"	-	ELKAY EZH20 BOTTLE FILLING STATION WITH MODEL VRC1L8WSK INTEGRAL HI-LO BARRIER-FREE REFRIGERATED FOUNTAIN, WALL-MOUNTED STAINLESS STEEL WITH DUAL FOUNTAINS, POLISHED CHROME PLATED BRASS BUBBLER HEADS, PUSH BUTTON VALVES, MOUNTING FRAME, CHILLER TO PROVIDE 5.0 GPM FLOW FOR COLD REFRIGERATED WATER. PROVIDE OPTIONAL WATER FILTER KIT FOR BOTTLE FILLER (MODEL EWF3000). ELECTRICAL REQUIRED FOR CHILLER: 120V, 370 WATTS. ELECTRICAL REQUIRED FOR BOTTLE FILLER: 120V, 370 WATTS.
WH-1	WATER HEATER (BUILDING P3)	-	-	1-1/2"	1-1/2"	INTELLIHOT MODEL IN401, MULTIPLE STAINLESS HEAT EXCHANGER, TURNDOWN RATIO OF 13.3:1 PER UNIT, INDOOR FLOOR MOUNTED, ON DEMAND WATER HEATER. WEIGHT: 345, LBS 120V / 60 HZ, MAX 9.5 AMPS, 16 W ON STANDBY.
WH-2	WATER HEATER (BUILDING P4)	-	-	3/8"	3/8"	CHROMOMITE MODEL M-40/208 INSTANT FLOW STANDARD STANDARD FLOW INSTANTANEOUS ELECTRIC WATER HEATER WITH FIELD ADJUSTABLE TEMPERATURE MICROPROCESSOR SET TO DELIVER 120 DEGREE F. HOT WATER OUTLET TEMPERATURE AT 1.0 GPM GLOW RATE, 6.320 WATTS, 40 AMPS, 208V/1 PHASE.
WH-3	WATER HEATER (BUILDING P2 ALT BID)	-	-	1-1/2"	1"	NAVIENT MODEL NPE-180A2, TANKLESS WATER HEATER, ANSI Z21.10.3 - CSA 4.3 LATEST STANDARDS, BUILT IN ADVANCED MULTI-LINES CONTROL PANEL WIT TEMPERATURE OPTIONS AND READY-LINK CASCADE COMPATIBILITY. FLOW RATE OF 8.4 GPM. WEIGHT: 73 LBS, 120V AC, 60 HZ.
TE-1	THERMAL EXPANSION TANK	-	-	12"	-	WILKINS AT-35, 3 GALLON CAPACITY ASME RATED EXPANSION TANK WITH IN-LINE CONNECTIONS, LEAD-FREE, AND FDA-APPROVED BLADDER FOR POTABLE WATER USE. WEIGHT = 15.5 LBS.
CP-1	CIRCULATING PUMP	-	-	-	3/4"	GRUNDFOS MODEL UPS15-555FC STAINLESS STEEL DOMESTIC HOT WATER IN-LINE CIRCULATING PUMP, WITH FLANGED CONNECTIONS, 3-SPEED MOTOR, INTEGRAL CHECK VALVE, 5 GPM AT 13 FT. TDH, 1/12 HP, 120V / 1 PH. CONTROL THRU "HONEYWELL" AQUASTAT AND DIGITAL 365-DAY TIME CLOCK OR EMS CONTACTS. WEIGHT = 5 LBS.
MV-1	MIXING VALVE	-	-	2" IN	1-1/4" IN 1-1/2" OUT	LEONARD PROTON ELECTRONIC VALVE MODEL PNV-150-LF-2PS, 2" INLETS, 3" OUTLET, LEAD-FREE THERMOSTATIC MIXING VALVE WITH INLET CHECK STOPS AND STRAINERS, OUTLET BALL VALVE AND PROGRAMMABLE SET POINT RANGE WITH DIGITAL THERMOMETER, 0.5 GPM MINIMUM FLOW, 50 GPM FLOW AT 20 PSI DROP. LOCKING TEMPERATURE REGULATING HANDLE SET FOR 120°F. ASSE 1017-2009.
SA-1	SHOCK ABSORBER	-	-	1"	-	SIoux CHIEF HYDRA-RESTER MODEL 654-CS SEAMLESS COPPER CHAMBER APPROVED FOR CONCEALED INSTALLATION. PDI SYMBOL "C". INSTALL IN UPWARD POSITION.
HB-1	HOSE BIBB	-	-	3/4"	-	WOODFORD MODEL 24P, 3/4" INLET SIZE, BRASS WALL HOSE FAUCET WITH ROUGH BRASS FINISH, WALL FLANGE, NON-REMOVABLE VACUUM BREAKER, AND OPTIONAL LOOSE TEE KEY HANDLE. PROVIDE POLISHED CHROME FINISH FOR INDOORS, ROUGH BRASS FINISH FOR OUTDOORS.
GPR-1	GAS PRESSURE REGULATOR (BUILDING P4)	-	-	-	-	"ELSTER AMERICAN" SERIES 3000 DIECAST ALUMINUM REGULATOR WITH CAST IRON PIPE SECTION, FULL CAPACITY RELIEF VALVE, 1-1/4" FLANGED INLET AND OUTLET, PROVIDE OPTIONAL INLET AND OUTLET 1/8" PRESSURE TAPS, SPRING NO. 70157035, 5,000 MAXIMUM CAPACITY AT 2PSIG INLET AND 12" W.C. OUTLET GAS PRESSURE.
GPR-2	GAS PRESSURE REGULATOR (BUILDING P3 & P2(ALT BID))	-	-	-	-	"ELSTER AMERICAN" SERIES 1813C DIECAST ALUMINUM REGULATOR WITH CAST IRON PIPE SECTION, FULL CAPACITY RELIEF VALVE, 3/4" SCREWED INLET AND OUTLET, 3/16" ORIFICE SIZE, SPRING NO. 70017P123, 2000 CFH MAXIMUM CAPACITY AT 2PSIG INLET AND 12" W.C. OUTLET GAS PRESSURE.
BD-1	BLOCKING PREVENTOR	-	-	-	-	WILKINS 07XN-U-120-AG, REDUCED PRESSURE BACKFLOW PREVENTER ASSEMBLY, BRONZE BODY, WITH UNION CONNECTIONS, 1/2" NPT INLET AND 1/2" NPT OUTLET, 1/2" NPT AIR GAP DRAIN OUTLET AND DISCHARGE INTO FLOOR SINK.
HD-1	HUB DRAIN	4"	2"	TP	-	HUB DRAIN WITH 6" TOP FUNNEL, NO HUB OUTLET, AND TRAP PRIMER CONNECTION FITTING WHERE APPLICABLE.
IM-1	ICE MAKER BOX	-	-	3/4"	-	SIoux CHIEF 696 SERIES SUPPLY OXBOX WITH 1/4"-TURN VALVE, FRAME, AND ARRESTER, SECURE DIRECTLY TO VERTICAL STUD OR BETWEEN STUDS USING MANUFACTURER'S GALVANIZED BRACKET.
WF-1	WATER FILTER (ICE MACHINE)	-	-	3/8"	-	EVERPURE "INSURE SINGLE 2000" MODEL #EV9324-01 ICE MACHINE WATER FILTER SYSTEM WITH #EV9612-22 0.5 MICRON CARTRIDGE, 1.67 GPM MAXIMUM FLOW RATE, 9,000 GALLONS RATED CAPACITY, WALL MOUNTING BRACKET, PROVIDE (2) ADDITIONAL REPLACEMENT CARTRIDGES, MODEL #EV9612-22. OVERALL DIMENSIONS: 29.64" HIGH x 8.04" WIDE x 5.25" DEEP. WEIGHT = 9 LBS.
KSF-1	KITCHEN SINK FAUCET	-	-	3/4"	3/4"	(1) ZURN Z843G1-XL-19F WALL MOUNT FAUCET WITH 1.5 GPM 8" SWING SPOUT, AND 8" CENTER FAUCET HOLES.

ANCHORAGE & BRACING NOTES

MEP COMPONENT ANCHORAGE NOTE
 ALL MECHANICAL, PLUMBING, AND ELECTRICAL COMPONENTS SHALL BE ANCHORED AND INSTALLED PER THE DETAILS ON THE DSA APPROVED CONSTRUCTION DOCUMENTS. THE FOLLOWING COMPONENTS SHALL BE ANCHORED OR BRACED TO MEET THE FORCE AND DISPLACEMENT REQUIREMENTS PRESCRIBED IN THE 2019 CBC, SECTIONS 1617A.1.18 THROUGH 1617A.1.26 AND ASCE 7-16 CHAPTERS 13, 26, AND 30:

- ALL PERMANENT EQUIPMENT AND COMPONENTS.
- TEMPORARY, MOVABLE OR MOBILE EQUIPMENT THAT IS PERMANENTLY ATTACHED (E.G. HARD WIRED) TO THE BUILDING UTILITY SERVICES SUCH AS ELECTRICITY, GAS OR WATER. "PERMANENTLY ATTACHED" SHALL INCLUDE ALL ELECTRICAL CONNECTIONS EXCEPT PLUGS FOR 110/220 VOLT RECEPTACLES HAVING A FLEXIBLE CABLE.
- TEMPORARY, MOVABLE OR MOBILE EQUIPMENT WHICH IS HEAVIER THAN 400 POUNDS OR HAS A CENTER OF MASS LOCATED 4 FEET OR MORE ABOVE THE ADJACENT FLOOR OR ROOF LEVEL THAT DIRECTLY SUPPORT THE COMPONENT IS REQUIRED TO BE RESTRAINED IN A MANNER APPROVED BY DSA.

THE FOLLOWING MECHANICAL AND ELECTRICAL COMPONENTS SHALL BE POSITIVELY ATTACHED TO THE STRUCTURE BUT NEED NOT DEMONSTRATE DESIGN COMPLIANCE WITH THE REFERENCES NOTED ABOVE. THESE COMPONENTS SHALL HAVE FLEXIBLE CONNECTIONS PROVIDED BETWEEN THE COMPONENT AND ASSOCIATED DUCTWORK, PIPING AND CONDUIT. FLEXIBLE CONNECTIONS MUST ALLOW MOVEMENT IN BOTH TRANSVERSE AND LONGITUDINAL DIRECTIONS:

- COMPONENTS WEIGHING LESS THAN 400 POUNDS AND HAVE A CENTER OF MASS LOCATED 4 FEET OR LESS ABOVE THE ADJACENT FLOOR OR ROOF LEVEL THAT DIRECTLY SUPPORT THE COMPONENT.
- COMPONENTS WEIGHING LESS THAN 20 POUNDS, OR IN THE CASE OF DISTRIBUTED SYSTEMS, LESS THAN 5 POUNDS PER FOOT, WHICH ARE SUSPENDED FROM A ROOF OR FLOOR OR HUNG FROM A WALL.

THE ANCHORAGE OF ALL MECHANICAL, ELECTRICAL AND PLUMBING COMPONENTS SHALL BE SUBJECT TO THE APPROVAL OF THE DESIGN PROFESSIONAL IN GENERAL RESPONSIBLE CHARGE OR STRUCTURAL ENGINEER DELEGATED RESPONSIBILITY AND ACCEPTANCE BY DSA. THE PROJECT INSPECTOR WILL VERIFY THAT ALL COMPONENTS AND EQUIPMENT HAVE BEEN ANCHORED IN ACCORDANCE WITH ABOVE REQUIREMENTS.

PIPING, DUCTWORK, AND ELECTRICAL DISTRIBUTION SYSTEM BRACING NOTE

PIPING, DUCTWORK AND ELECTRICAL DISTRIBUTION SYSTEMS SHALL BE BRACED TO COMPLY WITH THE FORCES AND DISPLACEMENTS PRESCRIBED IN ASCE 7-16 SECTION 13.3 AS DEFINED IN ASCE 7-16 SECTIONS 13.6.5, 13.6.6, 13.6.7, 13.6.8, AND 2019 CBC, SECTIONS 1617A.1.24, 1617A.1.25 AND 1617A.1.26.

THE METHOD OF SHOWING BRACING AND ATTACHMENTS TO THE STRUCTURE FOR THE IDENTIFIED DISTRIBUTION SYSTEM ARE AS NOTED BELOW. WHEN BRACING AND ATTACHMENTS ARE BASED ON A PRE-APPROVED INSTALLATION GUIDE (E.G. OSHPD OPM FOR 2013 CBC OR LATER), COPIES OF THE BRACING SYSTEM INSTALLATION GUIDE OR MANUAL SHALL BE AVAILABLE ON THE JOBSITE PRIOR TO THE START OF AND DURING THE HANGING AND BRACING OF THE DISTRIBUTION SYSTEMS. THE STRUCTURAL ENGINEER OF RECORD SHALL VERIFY THE ADEQUACY OF THE STRUCTURE TO SUPPORT THE HANGER AND BRACE LOADS.

MECHANICAL PIPING (MP), MECHANICAL DUCTS (MD), PLUMBING PIPING (PP), ELECTRICAL DISTRIBUTION SYSTEMS (E):

- MD MP PP E - OPTION 1: DETAILED ON THE APPROVED DRAWINGS WITH PROJECT SPECIFIC NOTES AND DETAILS.
- MD MP PP E - OPTION 2: SHALL COMPLY WITH THE APPLICABLE OSHPD PRE-APPROVAL (OPM #) # 0043-13.

GAS METER DEMAND CALC'S

BUILDING P2 (ALT BID)			
EQUIPMENT	EQUIPMENT DEMAND (MBH)	UNIT #	TOTAL DEMAND (MBH)
WATER HEATER	150	1	150.0
GPR-2 SHEET P/P101 BUILDING TOTAL			150.0
BUILDING P3			
EQUIPMENT	EQUIPMENT DEMAND (MBH)	UNIT #	TOTAL DEMAND (MBH)
WATER HEATER	399.9	2	799.8
GPR-2 SHEET P/P102 BUILDING TOTAL			799.8
BUILDING P4			
EQUIPMENT	EQUIPMENT DEMAND (MBH)	UNIT #	TOTAL DEMAND (MBH)
WARM UP POOL BOILER	1000	1	1000
LAP POOL BOILER	1500	3	4500
GPR-1 SHEET P/P101 BUILDING TOTAL			5500
AQUATIC COMPLEX TOTAL			6449.8
@ 550 FEET, 3" MPG (2 PSI) TO START PER CPC 2019, TABLE 1215.2(4)			

PLUMBING LEGEND

SYMBOL	ITEM	ABBR.
—A—	ABOVE CEILING	ABV
—AF—	ABOVE FINISHED FLOOR	ABV CLG
—ALT—	ALTERNATE	ALT
—AND—	AND	AND
—ARCH—	ARCHITECT / ARCHITECTURAL	ARCH
—AT—	AT	AT
—BEL FLR—	BELOW FLOOR	BEL FLR
—BEL GR—	BELOW GRADE	BEL GR
—CMC—	CALIFORNIA MECHANICAL CODE	CMC
—CPC—	CALIFORNIA PLUMBING CODE	CPC
—CLG—	CEILING	CLG
—CLN—	CENTER LINE	CLN
—CONT—	CONTINUATION	CONT
—CFH—	CUBIC FEET PER HOUR	CFH
—DIA—	DIAMETER	DIA
—DN—	DOWN	DN
—DWG—	DRAWING	DWG
—ELL—	ELBOW	ELL
—ELEC—	ELECTRICAL	ELEC
—(E)—	EXISTING	(E)
—FT—	FEET	FT
—FLR—	FLOOR	FLR
—FL—	FLOW LINE	FL
—GAL—	GALLON	GAL
—GPH—	GALLONS PER HOUR	GPH
—GPM—	GALLONS PER MINUTE	GPM
—GA—	GAUGE	GA
—ID—	INSIDE DIAMETER	ID
—IE—	INVERT ELEVATION	IE
—MAX—	MAXIMUM	MAX
—MIN—	MINIMUM	MIN
—(N)—	NEW	(N)
—NIC—	NOT IN CONTRACT	NIC
—NTS—	NOT TO SCALE	NTS
—NO—	NUMBER	NO
—OD—	OUTSIDE DIAMETER	OD
—LBS—	POUNDS	LBS
—PSI—	POUNDS PER SQUARE INCH	PSI
—PSIA—	POUNDS PER SQUARE INCH ABSOLUTE	PSIA
—PSIG—	POUNDS PER SQUARE INCH GAUGE	PSIG
—PVC—	POLYVINYL CHLORIDE	PVC
—RM—	ROOM	RM
—SPEC—	SPECIFICATION	SPEC
—SQ FT—	SQUARE FEET	SQ FT
—SS—	STAINLESS STEEL	SS
—TEMP—	TEMPERATURE	TEMP
—THRU—	THROUGH	THRU
—(TYP)—	TYPICAL	(TYP)
—UIG—	UNDER GROUND	UIG
—WC—	WATER COLUMN	WC
—W/—	WITH	W/
—W/O—	WITHOUT	W/O
—A—	COMPRESSED AIR	A
—AV—	ACID VENT	AV
—AW—	ACID WASTE	AW
—AVR—	ACID VENT RISER	AVR
—AVTR—	ACID VENT THRU ROOF	AVTR
—CD—	CONDENSATE DRAIN	CD
—CW—	DOMESTIC COLD WATER	CW
—HW—	DOMESTIC HOT WATER	HW
—HWR—	DOMESTIC HOT WATER RETURN	HWR
—G—	LOW PRESSURE NATURAL GAS	G
—HPG—	HIGH PRESSURE GAS	HPG
—ICW—	INDUSTRIAL COLD WATER	ICW
—LPG—	LIQUIFIED PETROLEUM GAS	LPG
—F—	FIRE PROTECTION LINE	F
—RWL—	RAIN WATER LEADER	RWL
—OD—	OVERFLOW DRAIN	OD
—SD—	STORM DRAIN	SD
—S or W—	SOIL or WASTE	S or W
—TW—	TEMPERED WATER	TW
—V—	VENT	V
—VR—	VENT RISER	VR
—VTR—	VENT THRU ROOF	VTR
—COTG—	CLEANOUT TO GRADE	COTG
—DEMO—	DEMOLITION	DEMO
—FCO—	FLOOR CLEANOUT	FCO
—HOSE BIBB—	HOSE BIBB	HOSE BIBB
—PIPING TURN UP—	PIPING TURN UP	PIPING TURN UP
—PIPING TURN DOWN—	PIPING TURN DOWN	PIPING TURN DOWN
—PIPING CAP—	PIPING CAP	PIPING CAP
—POC—	POINT OF CONNECTION TO EXISTING	POC
—ANGLE VALVE—	ANGLE VALVE	ANGLE VALVE
—BALANCE VALVE—	BALANCE VALVE	BALANCE VALVE
—BALL VALVE—	BALL VALVE	BALL VALVE
—CHECK VALVE—	CHECK VALVE	CHECK VALVE

SYMBOL	ITEM	ABBR.
—CONC—	CONCENTRIC REDUCER	CONC
—TWO-WAY—	TWO-WAY CONTROL VALVE	TWO-WAY
—PLUG—	PLUG VALVE	PLUG
—PRESS—	PRESSURE REDUCING VALVE	PRESS
—SHUT-OFF—	SHUT-OFF VALVE IN BOX	SHUT-OFF
—SOV—	SHUT-OFF VALVE	SOV
—THERM—	THERMOSTATIC MIXING VALVE	THERM
—TEMP/PRESS—	TEMPERATURE / PRESSURE RELIEF VALVE	TEMP/PRESS
—UNION—	UNION	UNION
—WALL CLEANOUT—	WALL CLEANOUT	WCO
—Y—	"Y" TYPE STRAINER	Y
—PRESSURE GAUGE—	PRESSURE GAUGE	PRESSURE GAUGE
—TEMPERATURE GAUGE—	TEMPERATURE GAUGE	TEMPERATURE GAUGE
—KEYNOTE—	KEYNOTE	KEYNOTE
—2 P207—	DETAIL REFERENCE EXAMPLE: DETAIL 2, SHEET P207	2 P207
—3 P400—	SECTION REFERENCE EXAMPLE: SECTION 3, SHEET P400	3 P400

GENERAL NOTES

- COORDINATION OF WORK: LAYOUT OF MATERIALS, EQUIPMENT AND SYSTEMS IS GENERALLY DIAGRAMMATIC UNLESS SPECIFICALLY DIMENSIONED. SOME WORK MAY BE SHOWN OFFSET FOR CLARITY.
- THE ACTUAL LOCATION OF ALL MATERIALS, PIPING, DUCTWORK, FIXTURES, EQUIPMENT, SUPPORTS, ETC. SHALL BE CAREFULLY PLANNED, PRIOR TO INSTALLATION OF ANY WORK TO AVOID ALL INTERFERENCES WITH EACH OTHER, OR WITH STRUCTURAL, ELECTRICAL, ARCHITECTURAL OR OTHER ELEMENTS.
- VERIFY THE PROPER VOLTAGE AND PHASE OF ALL EQUIPMENT WITH THE ELECTRICAL PLANS. ALL CONFLICTS SHALL BE CALLED TO THE ATTENTION OF THE ARCHITECT AND THE ENGINEER PRIOR TO THE INSTALLATION OF ANY WORK OR THE ORDERING OF ANY EQUIPMENT.
- ALL DRAWINGS AND SPECIFICATIONS ARE TO BE CONSIDERED PART OF THE CONTRACT DOCUMENTS. THE CONTRACTOR SHALL BE RESPONSIBLE FOR THE REVIEW AND COORDINATION OF ALL DRAWINGS PRIOR TO ANY CONSTRUCTION, INCLUDING ARCHITECTURAL, STRUCTURAL, MECHANICAL, PLUMBING, AND ELECTRICAL. ANY WORK PERFORMED IN CONFLICT WITH THE CONTRACT DOCUMENTS OR ANY CODE REQUIREMENT SHALL BE CORRECTED BY THE CONTRACTOR AT HIS OWN EXPENSE AND AT NO EXPENSE TO THE OWNER OR THE OWNER REPRESENTATIVE.
- MINIMUM SLOPE FOR SEWER IS 1/4" PER FT, UNLESS OTHERWISE NOTED.
- ALL ROOF PENETRATIONS SHALL BE COMPATIBLE WITH ROOF SYSTEM WITH AS FEW PENETRATIONS AS POSSIBLE.
- MINIMUM DOMESTIC WATER PIPE SIZE TO BE 3/4" UNLESS OTHERWISE NOTED. USE A REDUCING ELL AT FIXTURE, IF NECESSARY.
- ALL PLUMBING FIXTURES, VALVES, FAUCETS, FIXTURE STOPS, ETC. WHICH PROVIDE WATER FOR HUMAN CONSUMPTION MUST MEET THE "LEAD FREE" REQUIREMENT FOR THE STATE OF CALIFORNIA.
- MAXIMUM ALLOWABLE DISTANCE FOR HOT WATER LATERALS TO FIXTURES OFF OF THE CIRCULATING MAIN SHALL BE 10'-0" FOR HAND WASH SINKS AND LAVS, AND 15'-0" FOR OTHER SINKS.
- LEAN CONCRETE SHALL BE USED AS BACK FILL WHERE UTILITY TRENCHES EXTEND FROM THE EXTERIOR TO THE INTERIOR LIMITS OF THE BUILDING. LEAN CONCRETE SHALL EXTEND A MINIMUM DISTANCE OF TWO (2) FEET LATERALLY ON EACH SIDE OF THE EXTERIOR BUILDING LINE AND A MINIMUM OF SIX (6) INCHES ABOVE FOOTING PENETRATION.

DSA File No.: DSA File

DSA Application No.: DSA App

Agency Approval


General Notes

NET POSITIVE consulting engineers
 www.NPceng.com
 project no. 1101
 CONSULTANT

Mission Oak HS Aquatic Complex
 Tulare Joint Union High School District
 Tulare, CA 93274
 PROJECT


TYPICAL INFORMATION
 PLUMBING SCHEDULE, LEGENDS, AND NOTES
 Drawing

darden architects ARCHITECTURE PLANNING INTERIORS
 www.dardenarchitects.com
 6790 N. West Ave. • Fresno, CA 93711 • T. 559.448.8051
 ARCHITECT

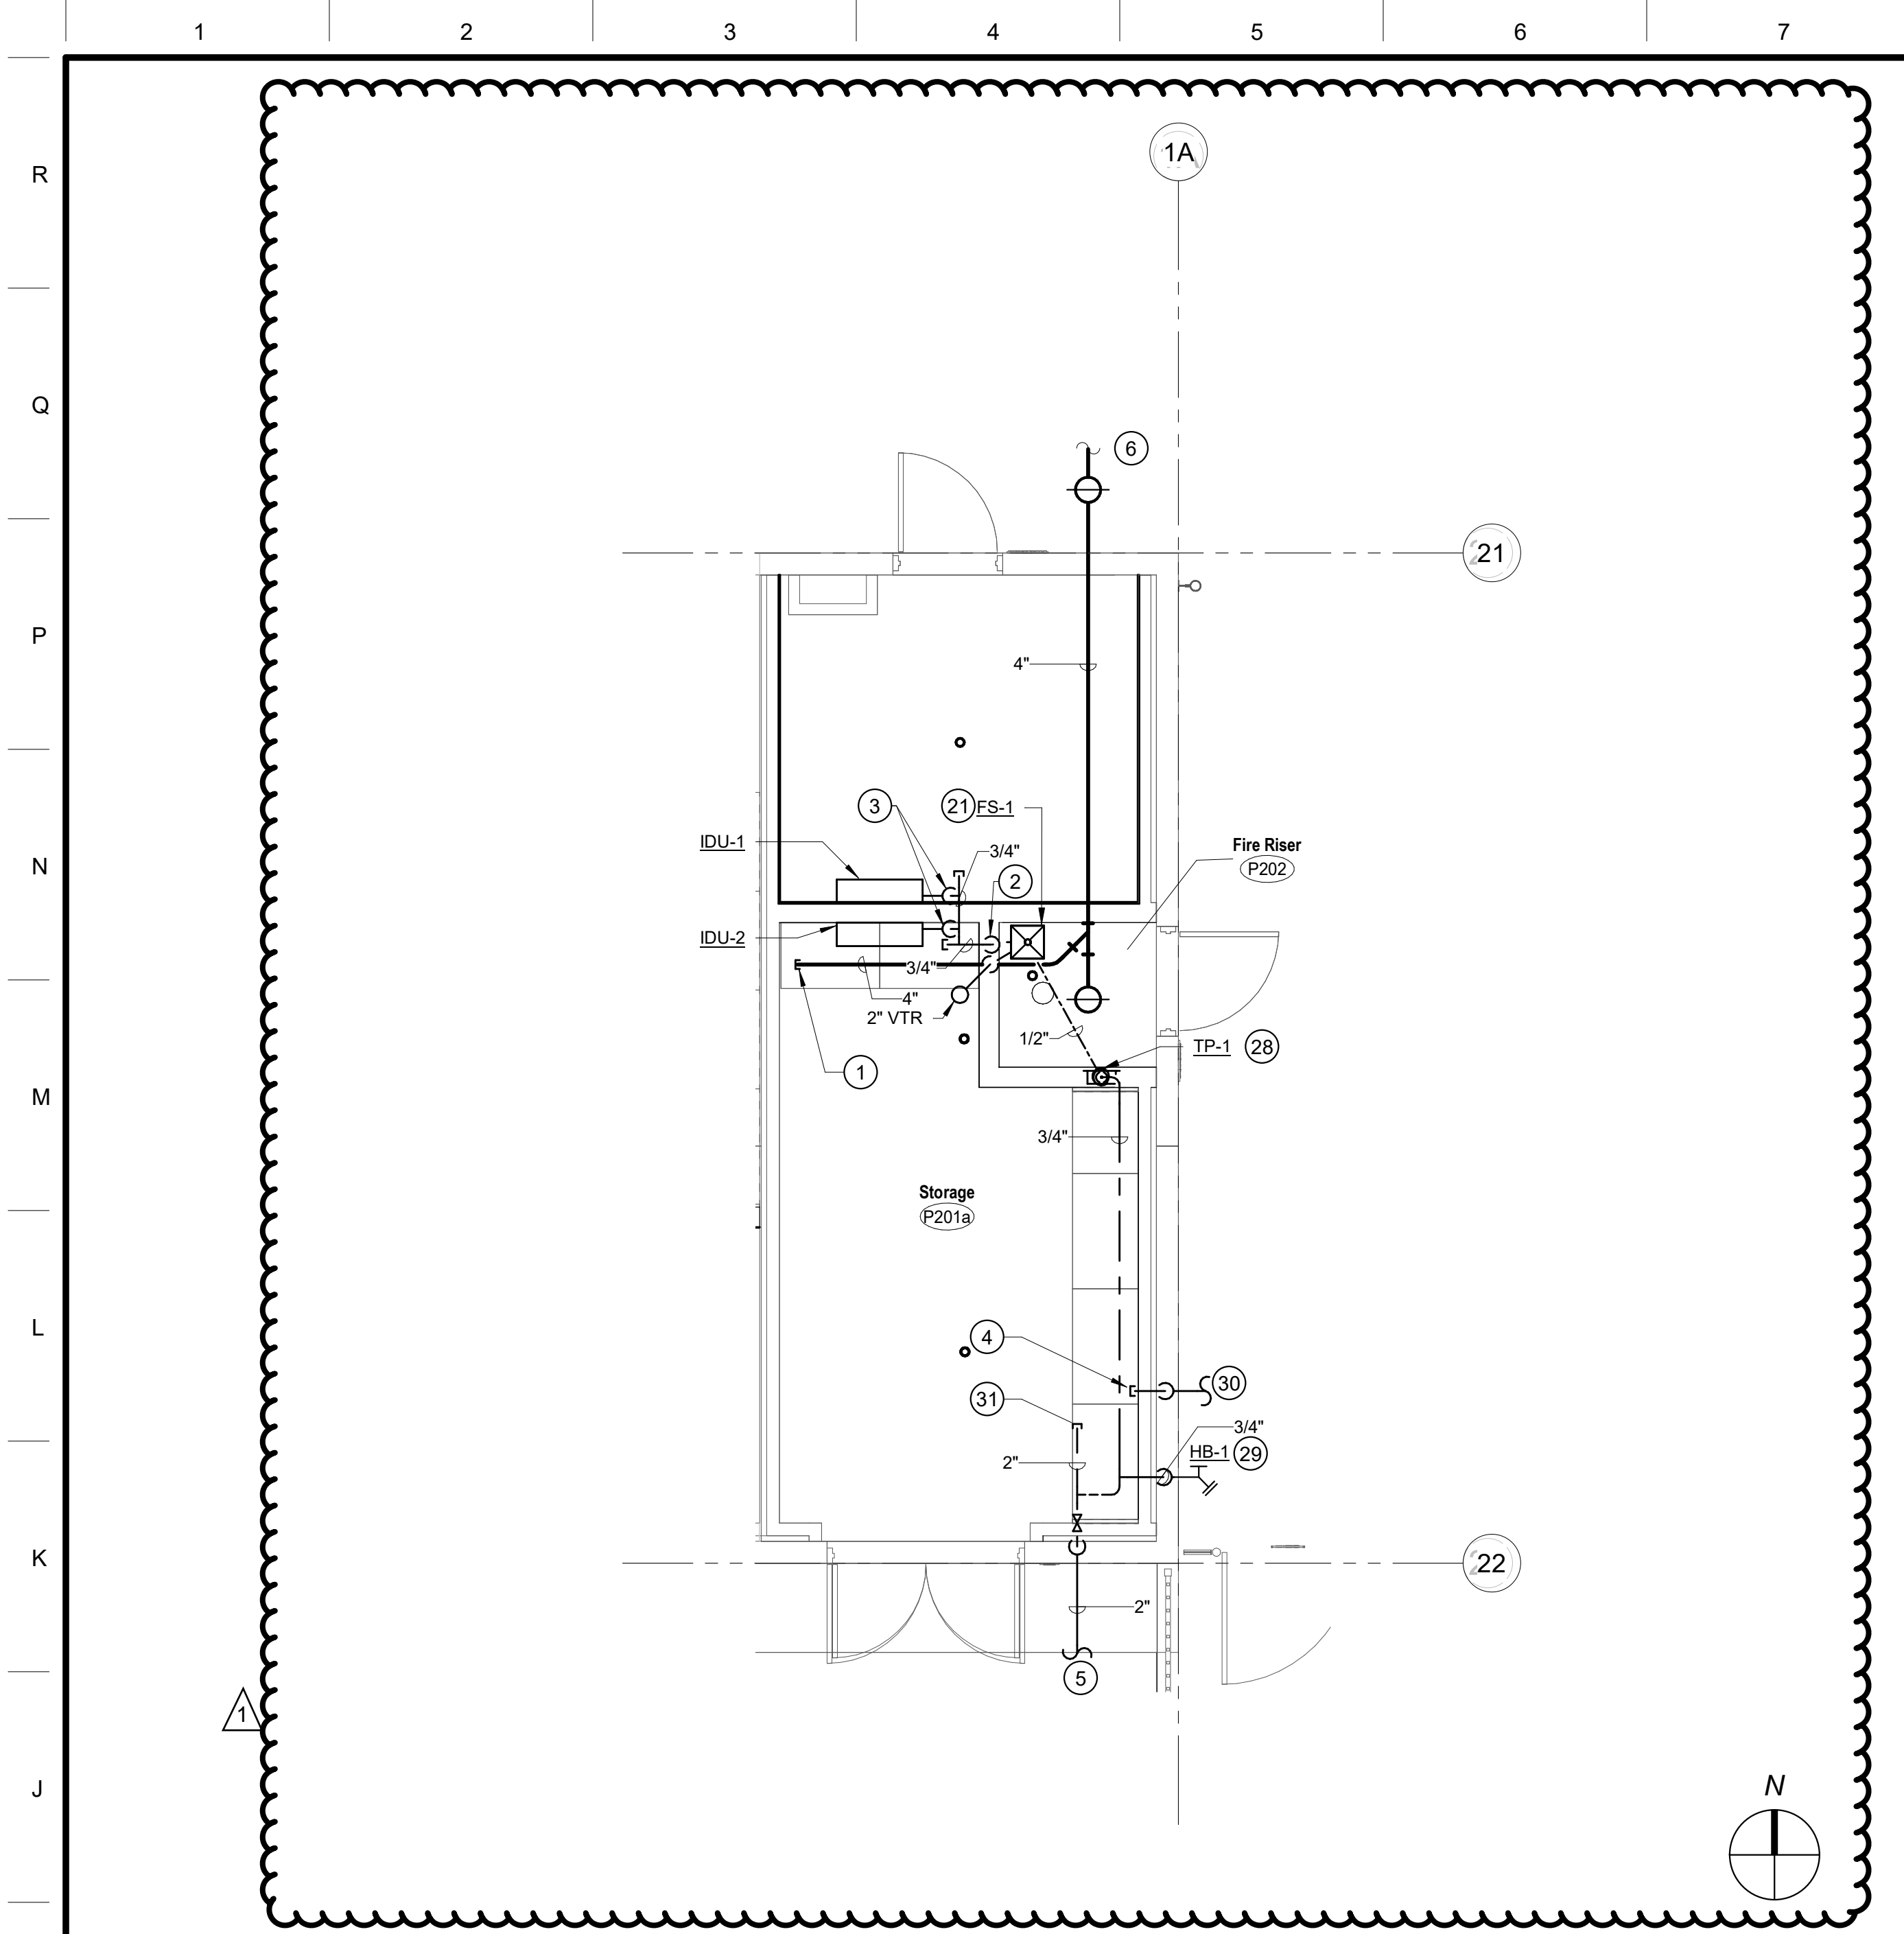


H1 PLUMBING PLAN - BASE BID - BUILDING 2

1/4" = 1'-0"

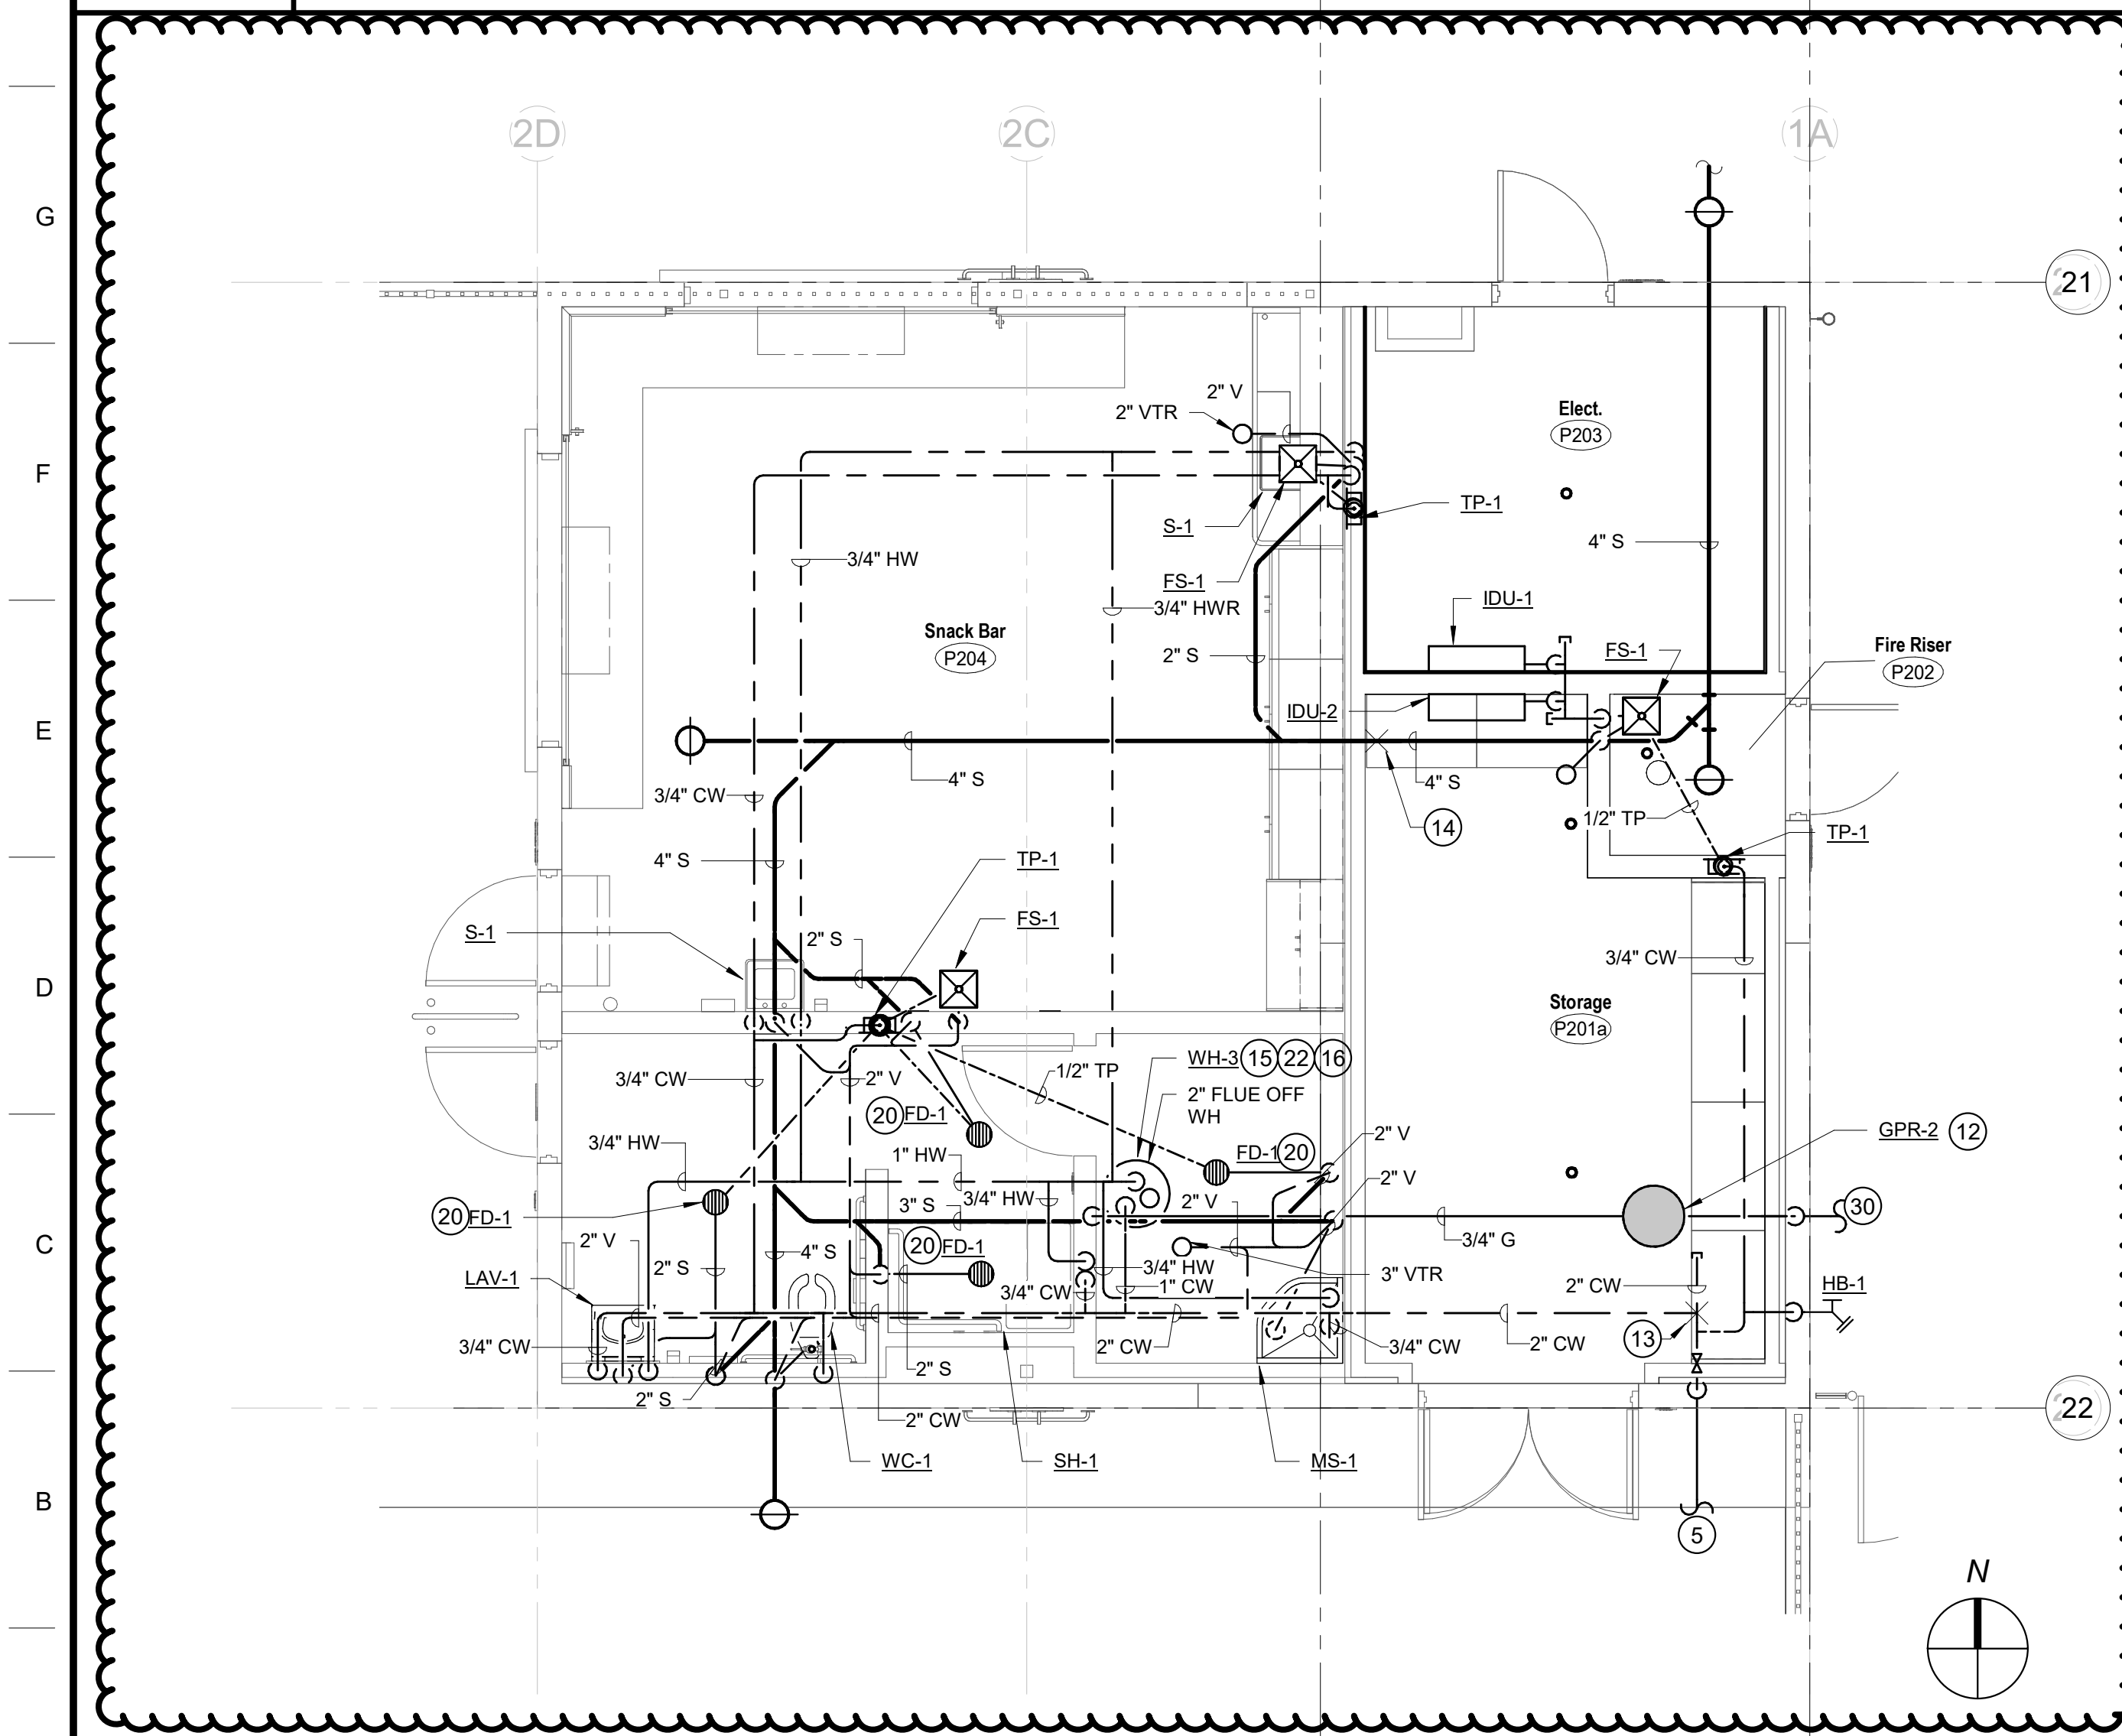


A1 PLUMBING PLAN - ALT BID BUILDING P2

1/4" = 1'-0"

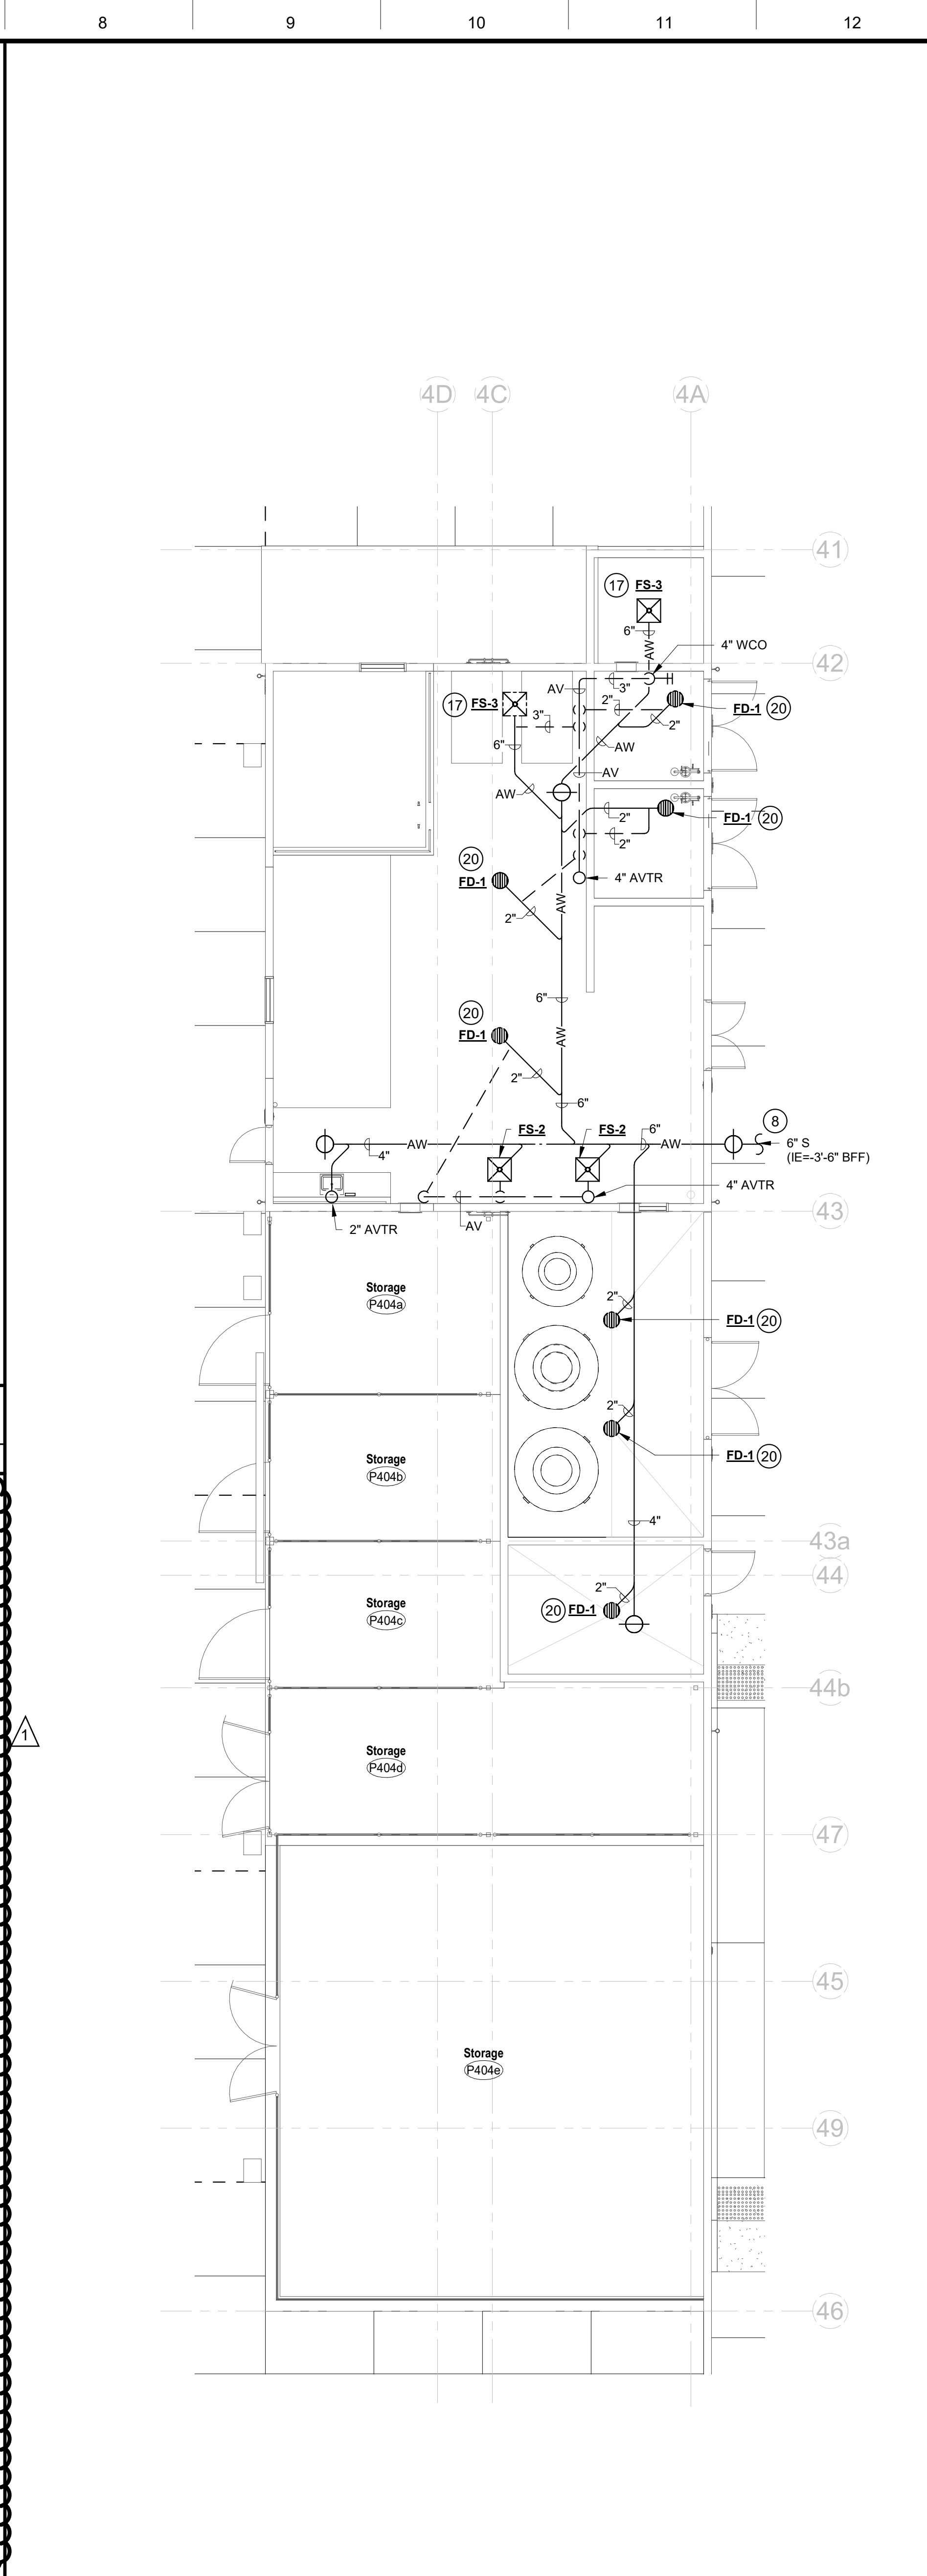

A8 PLUMBING PLAN - BUILDING P4 - S & V

1/8" = 1'-0"

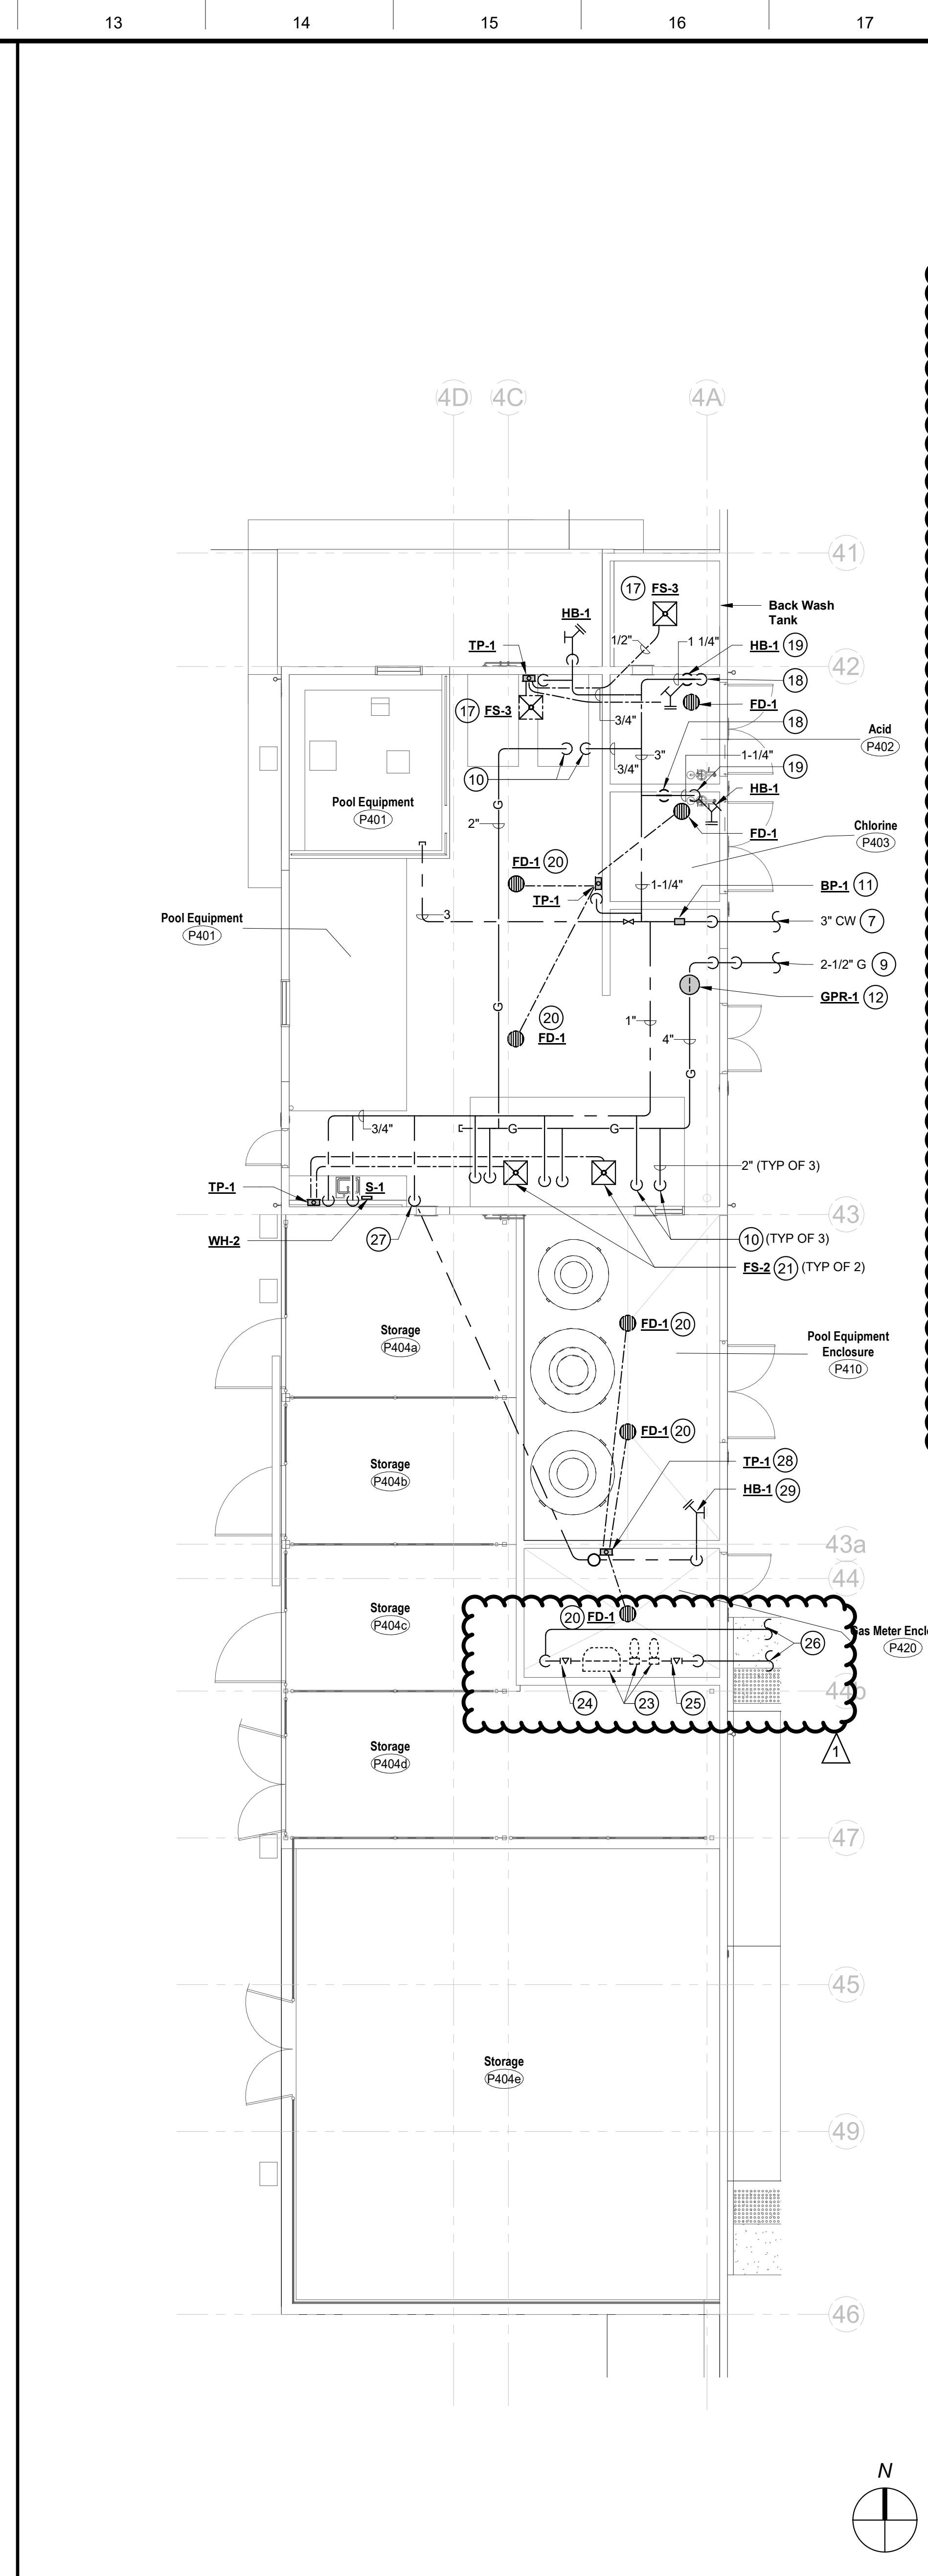

A13 PLUMBING PLAN - BUILDING P4 - CW & G

1/8" = 1'-0"

DSA File No.:
DSA File

DSA Application No.:
DSA App

Agency Approval

- KEYNOTES #**
- 4" S, CAP FOR FUTURE INVERT 2'-8" BELOW FF.
 - CONDENSATE DRAIN DN IN WALL. TERMINATE IN FLOOR SINK.
 - 3/4" CD CONNECTION TO INDOOR UNIT W/ TRAP PER DETAIL E1 ON SHEET X/P102.
 - 3/4" G ABOVE GRADE, CAP FOR FUTURE CONNECTION TO STAFF / SNACK BAR.
 - 2" CW TO BUILDING P2. SEE CIVIL PLANS FOR CONTINUATION.
 - 4" S FROM BUILDING P2. SEE CIVIL PLANS FOR CONTINUATION.
 - 3" CW TO BUILDING P4. SEE CIVIL PLANS FOR CONTINUATION.
 - 6" S FROM POOL EQUIPMENT BUILDING P4. SEE CIVIL PLANS FOR CONTINUATION.
 - 2-1/2" MPG TO BUILDING P4. SEE SHEET SD/P102 FOR CONTINUATION.
 - 3/4" CW AND 2" GAS DROP DN TO POOL BOILER.
 - BP-1 BACKFLOW PREVENTER OVERHEAD. PROVIDE 1" SCHEDULE 40 GALVANIZED STEEL DRAIN PIPE FROM BP-1 SLOPED AT 1/4" TO NEAREST FLOOR SINK.
 - 2" VENT PIPE FROM GAS PRESSURE REGULATOR ROUTED UP THRU ROOF PER DETAIL N4 ON X/P102.
 - 2" CW POC FROM BASE BID 4" S.
 - 4" S POC FROM BASE BID 4" S.
 - 3/4" G DN TO WATER HEATER W/ GAS DIRT LEG. REFER TO DETAIL N8 ON SHEET X/P102.
 - WATER HEATER MOUNTED TO WALL AND FLOOR PER DETAIL E8 ON SHEET X/P102.
 - 6" S w/ TRAP, 3" V & 1/2" TRAP PRIMER CONNECTION FOR FLOOR SINK.
 - 1-1/4" CW DN FOR EMERGENCY SHOWER AND EYE WASH STATION (FIXTURE BY OTHERS).
 - 3/4" CW DN TO HOSE BIBB.
 - 2" S w/ TRAP, 1-1/2" V & 1/2" TRAP PRIMER CONNECTION FOR FLOOR DRAIN.
 - 3" S w/ TRAP, 2" V & 1/2" TRAP PRIMER CONNECTION FOR FLOOR DRAIN/SINK.
 - GPR MOUNTED ABOVE GRADE WITH VENT ROUTED ABOVE ROOF LINE PER DETAIL N4 ON SHEET X/P102.
 - GAS METER LOCATION WITHIN ENCLOSURE. GAS METER ASSEMBLY BY PG&E WITH 2 PSI OUTLET PRESSURE. SITE GAS PIPE SIZING DOWNSTREAM OF METER BASED ON 2019 CPC TABLE 1215.2(4) USING 400 FT ROW AND MAXIMUM LOAD OF 5,800 MBH. CONTRACTOR SHALL COORDINATE WITH PG&E.
 - CONNECT 2-1/2" MPG (2 PSIG) TO CUSTOMER SIDE OF GAS METER ASSEMBLY WITH PLUG VALVE.
 - 3" MPG STUBBED INTO GAS METER ENCLOSURE WITH PLUG VALVE.
 - 3" MPG FROM SITE. REFER TO SHEET SD/P102 FOR CONTINUATION.
 - 3/4" CW DN TO BELOW FLOOR, TO BE ROUTED TO FIXTURES IN GAS METER ENCLOSURE.
 - 1/2" CW UP TO TRAP PRIMER.
 - 3/4" CW UP TO HOSE BIBB.
 - 3/4" MPG TO BUILDING P3. SEE SHEET SD/P102 FOR CONTINUATION.
 - 2" CW CAP FOR FUTURE.

GENERAL NOTES

- ALL SUPPORTS WITHIN BUILDING P4 SHALL BE STAINLESS STEEL OR FRP OF EQUIVALENT STRENGTH. REFER TO MASON WEST OPM 0043-13 FOR STRENGTH AND SPACING REQUIREMENTS.

NET POSITIVE consulting engineers
www.NPCEng.com
project no. 1101

Consultant

Mission Oak HS Aquatic Complex
Tulare Joint Union High School District
Tulare, CA 93274

Project

BUILDING P2 & P4 PLUMBING PLANS

Drawing

ARDEN ARCHITECTS
ARCHITECTURE PLANNING INTERIORS
www.ardenarchitects.com
6790 N. West Ave. • Fresno, CA 93211 • T. 559.448.8051

Architect


No.	Revision/Submission	Date
1	REVISION_01	05/31/2023

Revision


Designed By: JCS Copyright 2022 Darden Architects
Scale: As indicated Drawn By: AV
Project Number: 2180 Checked By: HB
Date: 07/13/2022 Reviewed By: JCS

P/P101

8/15/2023 5:45:05 PM

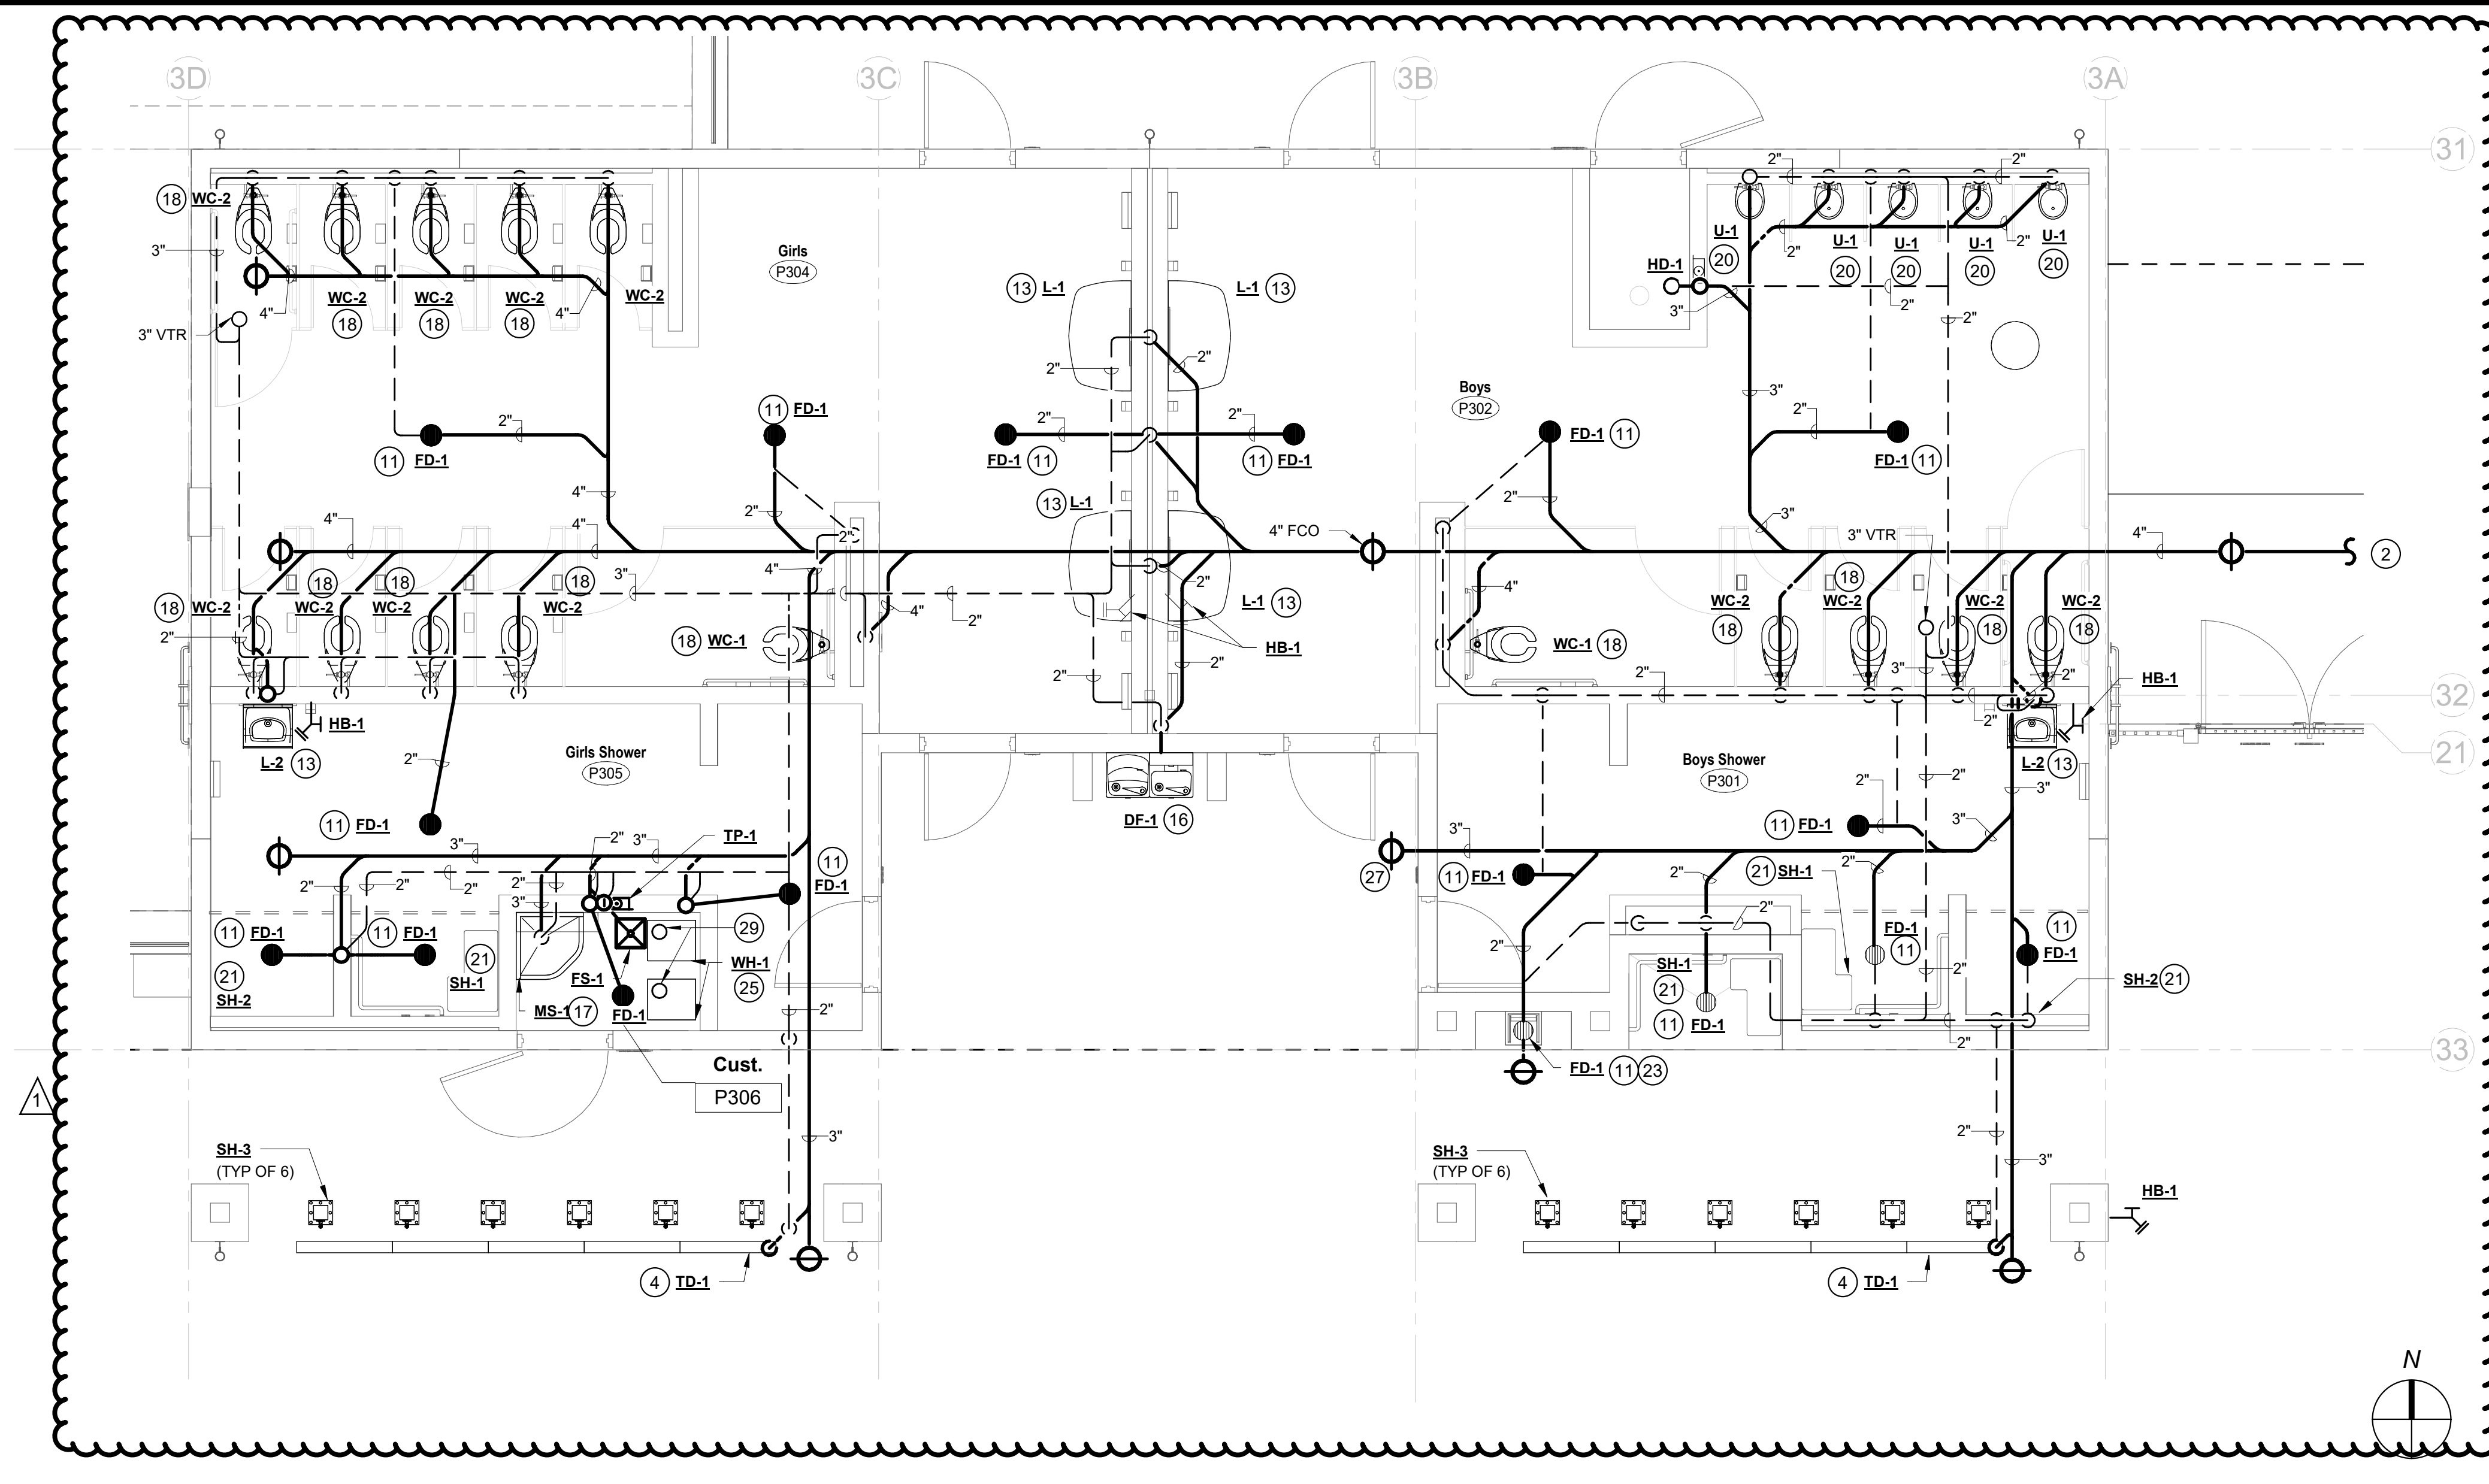

J7
1/4" = 1'-0"
ENLARGED PLUMBING PLAN - BUILDING P3, S & V

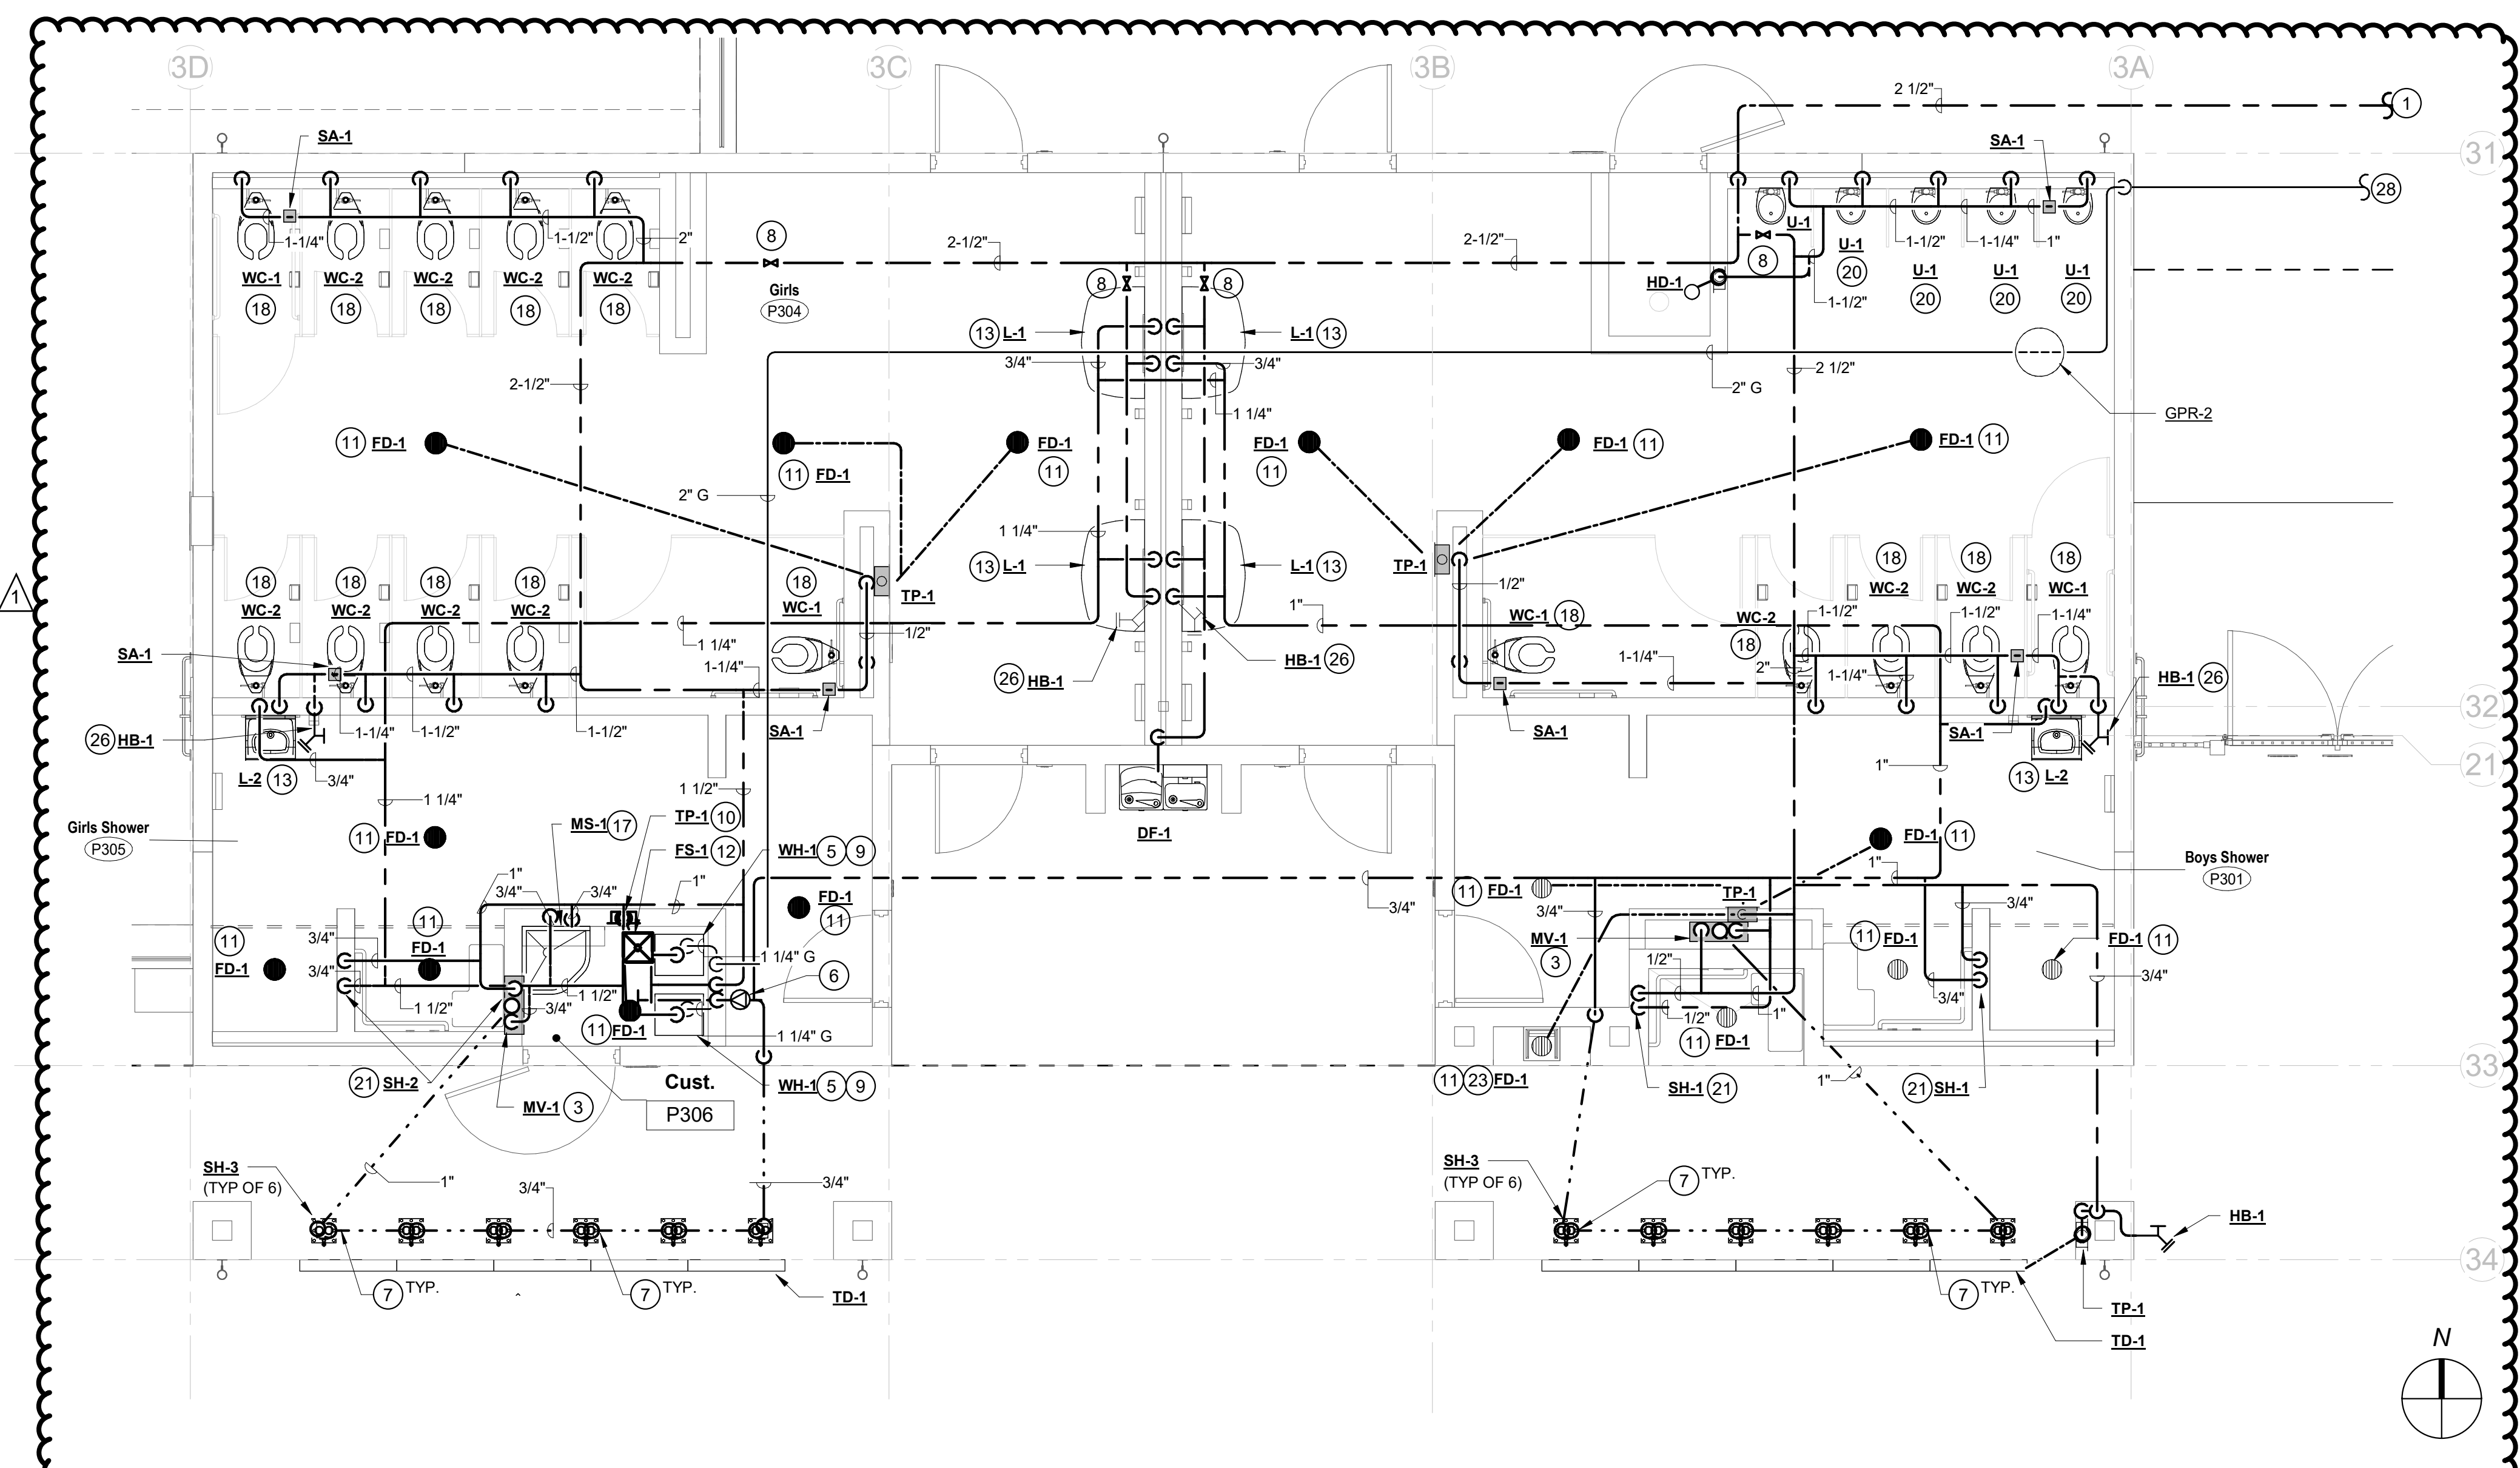

A7
1/4" = 1'-0"
ENLARGED PLUMBING PLAN - BUILDING P3, G, CW, & HW

DSA File No.:
DSA File

DSA Application No.:
DSA App

Agency Approval

KEYNOTES #

- 1 2-1/2" CW FOR RESTROOM BUILDING. SEE CIVIL PLANS FOR CONTINUATION.
- 2 4" S FOR RESTROOM BUILDING. SEE CIVIL PLANS FOR CONTINUATION.
- 3 MIXING VALVE ON WALL. CONNECT 3/4" CW & 3/4" HW TO INLET CONNECTIONS AND PROVIDE 1" TEMPERED WATER (TW) CONNECTION AT OUTLET.
- 4 3" S FOR TRENCH DRAINS WITH CW FROM TRAP PRIMER.
- 5 VERTICAL WATER HEATER TO BE FLOOR MOUNTED PER DETAIL E8/X/P102 WITH 1/2" HILTI TZ2 PER ICC-ES ESR-4266 (TYP OF 4).
- 6 HOT WATER RETURN CIRCULATING PUMP CP-1 MOUNTED OVER WATER HEATERS, SHOWN OFF SET FOR CLARITY.
- 7 NO PIPE JOINTS BELOW GRADE.
- 8 CW ISOLATION VALVE. FIELD VERIFY AND COORDINATE LOCATION WITH NEW CEILING ACCESS PANEL.
- 9 4" CONCENTRIC VENT ASSEMBLY. REFER TO DETAILS A4 AND J11 ON SHEET X/P102.
- 10 1/2" CW DN TO TRAP PRIMER IN WALL WITH ACCESS PANEL.
- 11 2" S w/ TRAP. 1-1/2" V & 1/2" TRAP PRIMER CONNECTION FOR FLOOR DRAIN/FLOOR SINK. FIELD COORDINATED FS TO BE EXPOSED AND ACCESSIBLE FOR HEALTH DEPT INSPECTION.
- 12 3" S w/ TRAP. 1-1/2" V & 1/2" TRAP PRIMER CONNECTION FOR FLOOR SINK. FIELD COORDINATED FS TO BE EXPOSED AND ACCESSIBLE FOR HEALTH DEPT INSPECTION.
- 13 2" S, 1-1/2" V, 3/4" CW/HW, DN TO HANDSINK/LAV. NOT USED.
- 14 NOT USED.
- 15 NOT USED.
- 16 2" S, 1-1/2" V & 3/4" CW DN FOR DRINKING FOUNTAIN.
- 17 3" S w/ TRAP, 1-1/2" V, 3/4" CW/HW DN FOR MOP SINK.
- 18 4" S, 2" V & 1" CW DN TO WATER CLOSET.
- 19 3/4" CW/HW TO KITCHEN SINK FAUCET.
- 20 2" S, 1-1/2" V, 3/4" CW FOR URINALS.
- 21 3/4" CW/HW DN FOR SHOWERS. NOT USED.
- 22 NOT USED.
- 23 FLOOR DRAIN FOR SPIN DRYER DISCHARGE. NOT USED.
- 24 WATER HEATER MOUNTED TO WALL AND FLOOR PER DETAIL E8 ON SHEET X/P102.
- 25 3/4" CW DOWN TO HOSE BIBB. TYP.
- 26 4" FCG REFER TO DETAIL A4 ON SHEET X/P102.
- 27 2" MPG TO BUILDING P3. SEE SHEET SD/P102 FOR CONTINUATION.
- 28 4" AIR INTAKE & 4" VENT, 8" CONCENTRIC RISER THRU ROOF PER DETAIL A1/X/P102, SEE SHEET P3/01 FOR CONTINUATION.
- 29 4" AIR INTAKE & 4" VENT, 8" CONCENTRIC RISER THRU ROOF PER DETAIL A1/X/P102, SEE SHEET P3/01 FOR CONTINUATION.

General Notes

NET POSITIVE
consulting
engineers

www.NPComp.com
project no. 1101

Consultant

Mission Oak HS Aquatic Complex
Tulare Joint Union High School District
Tulare, CA 93274

Project

BUILDING P2 & P3
ENLARGED PLUMBING PLANS

Drawing

darden ARCHITECTURE
PLANNING
INTERIORS
architects

www.dardenarchitects.com
6790 N. West Ave. • Fresno, CA 93711 • T. 559.448.8051

Architect

No.	Revision/Submission	Date
1	REVISION_01	05/31/2023

Revision

Designed By: JCS Copyright 2022 Darden Architects

Scale: As indicated Drawn By: AV


 
Project Number: 2180 Checked By: HB

Date: 07/13/2022 Reviewed By: JCS



P/P102

8/15/2023 5:45:08 PM


8/15/2023 5:45:12 PM

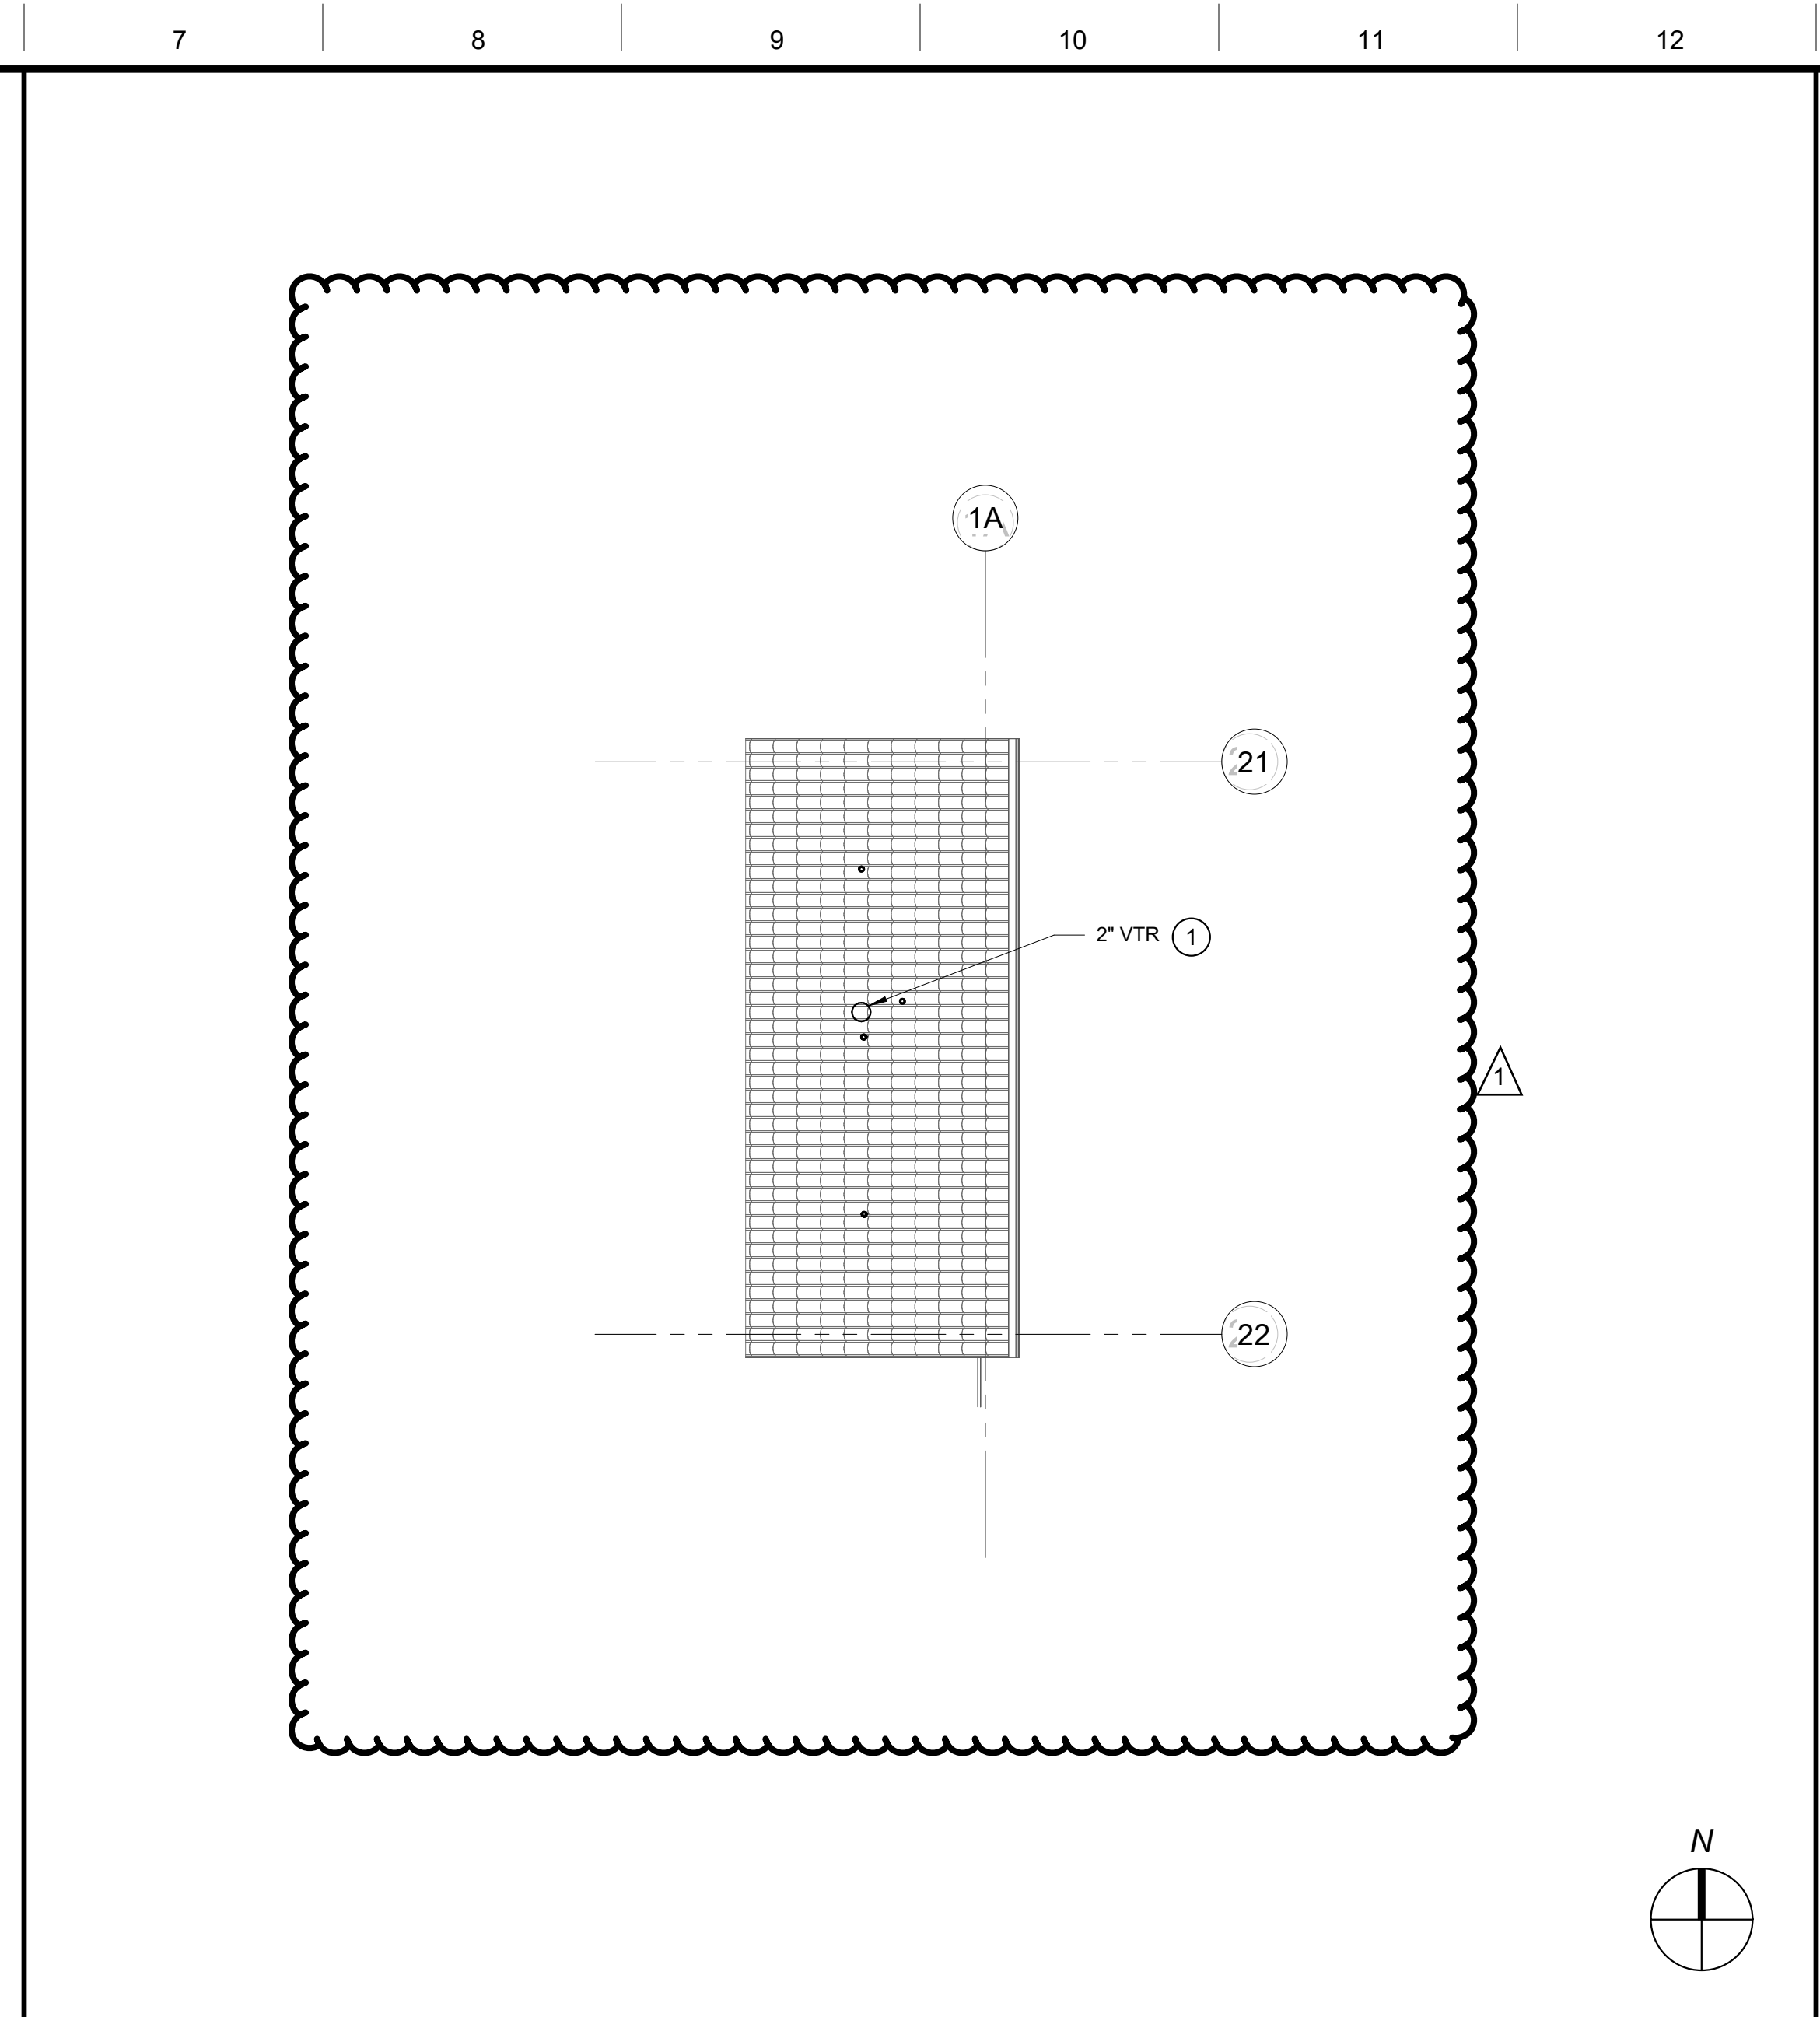

J7
1/8" = 1'-0"
PLUMBING ROOF PLAN - BASE BID - BUILDING P2

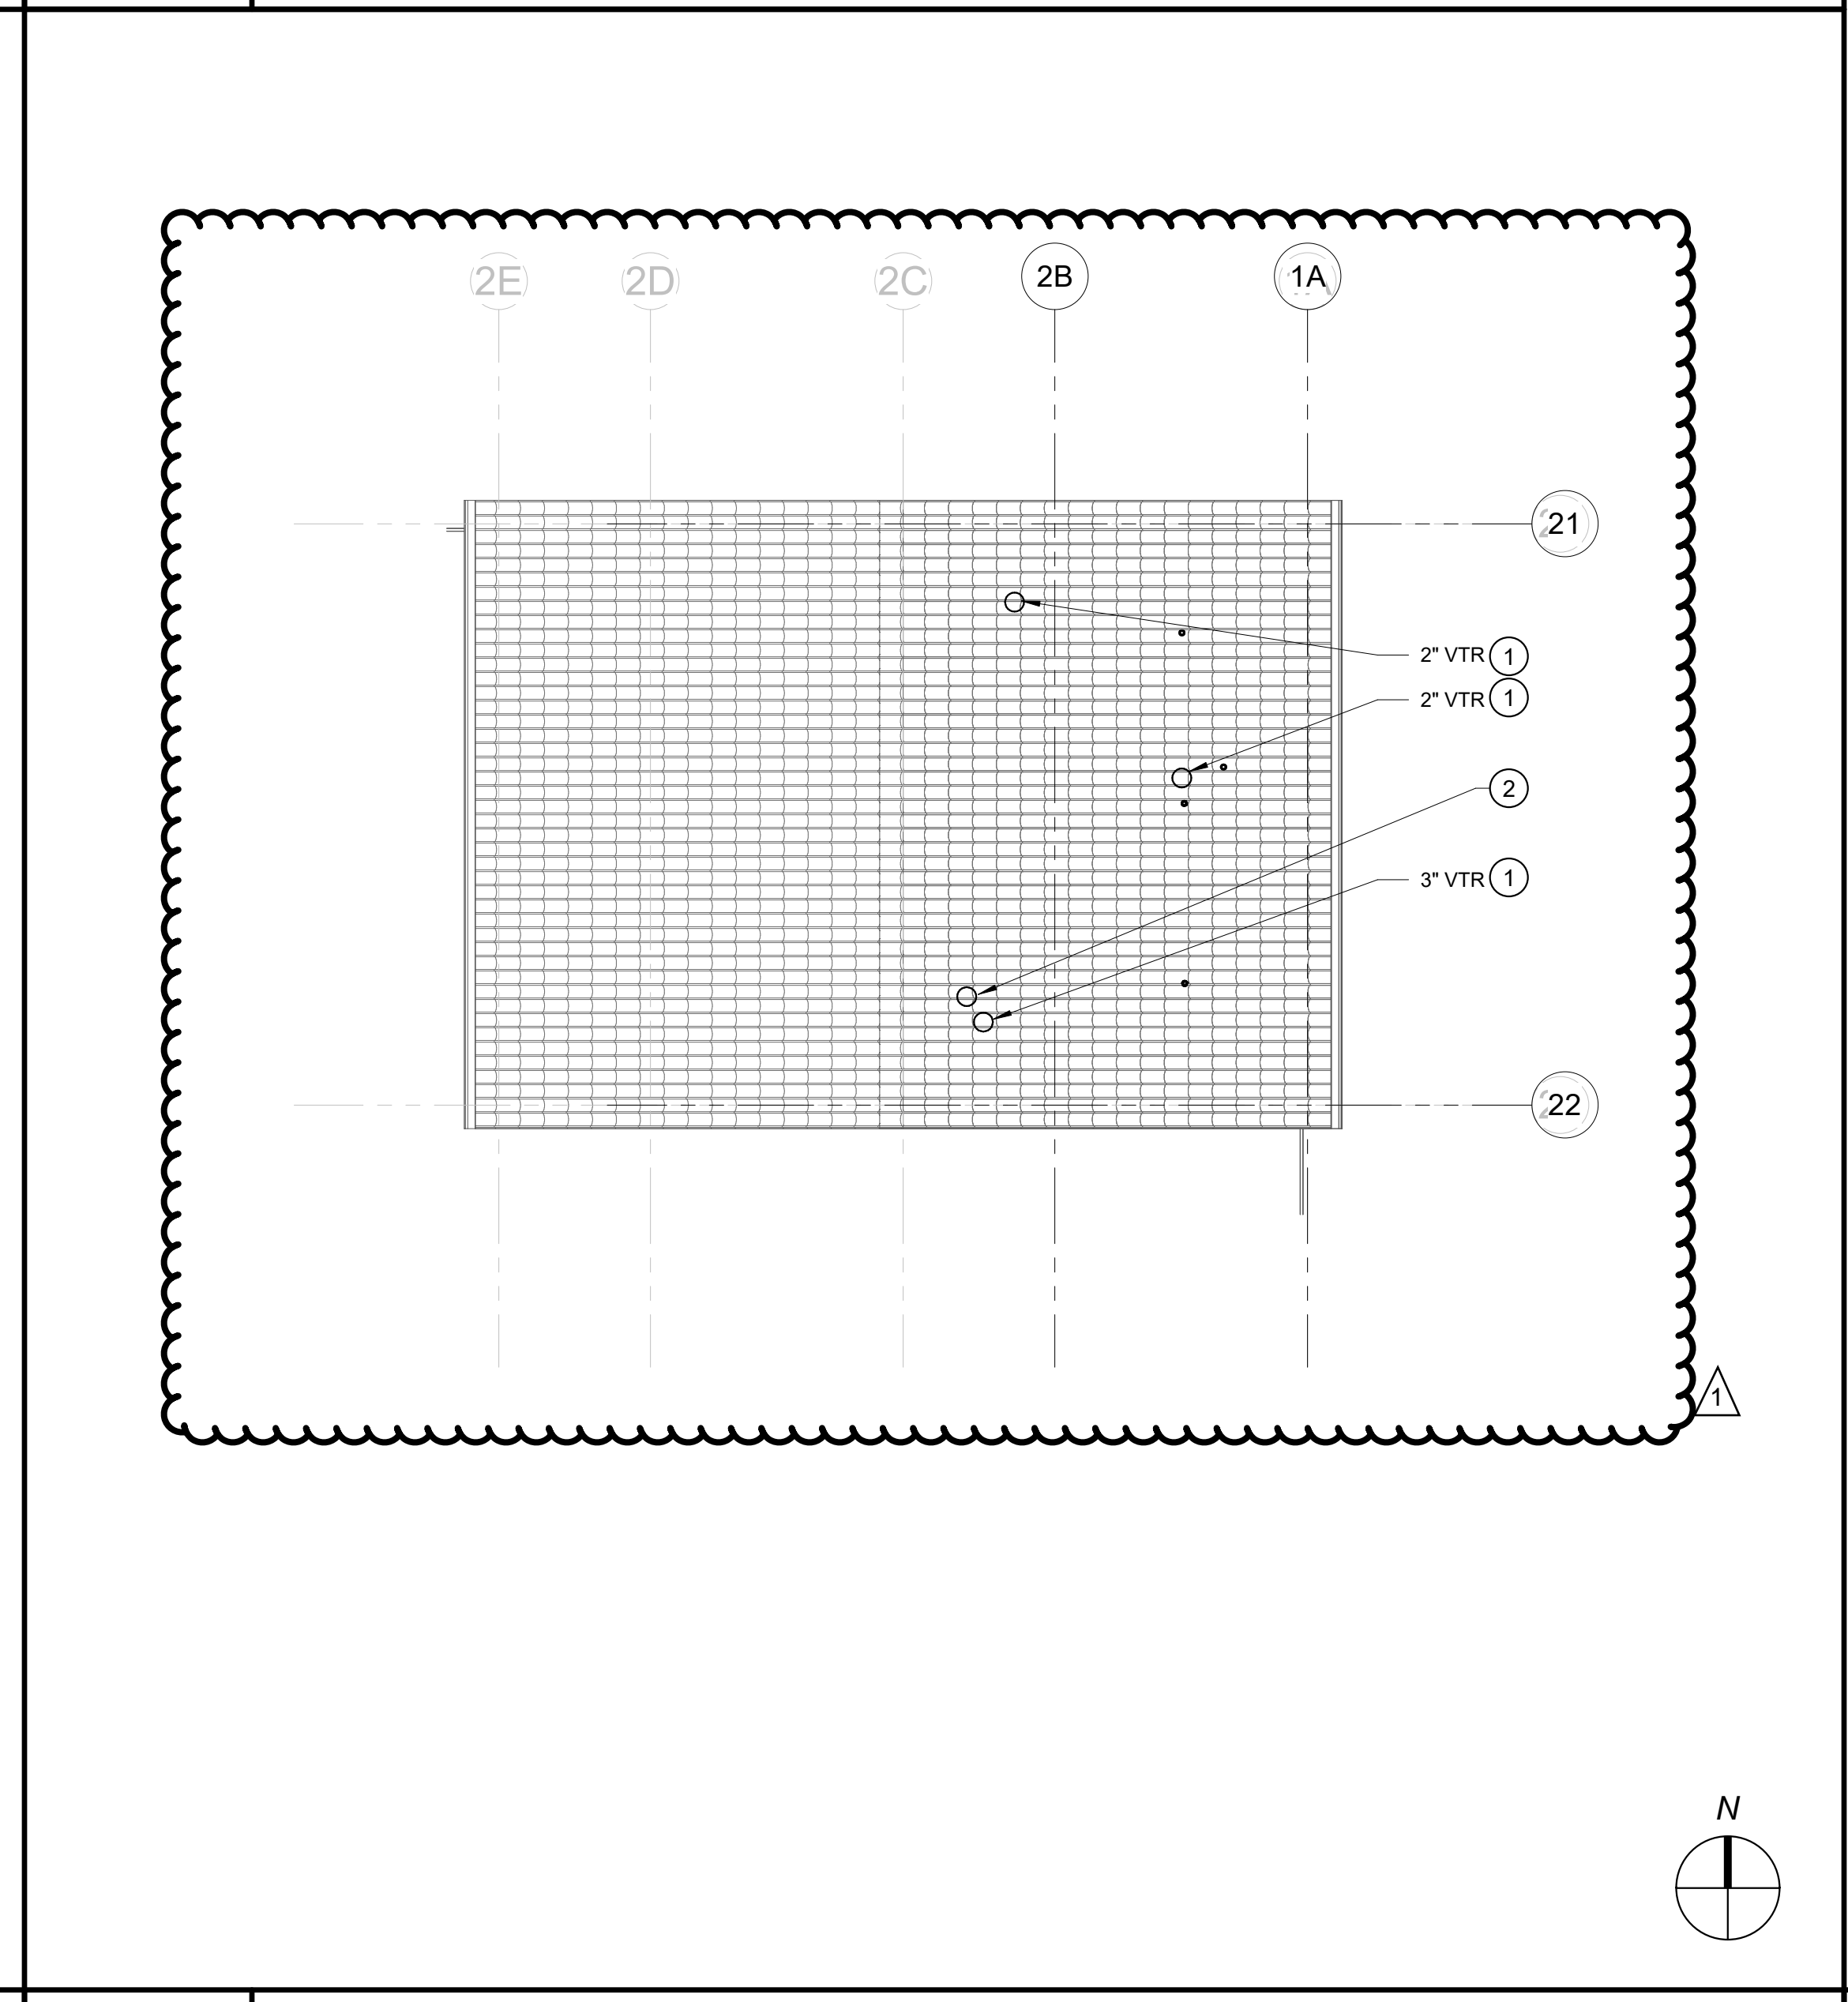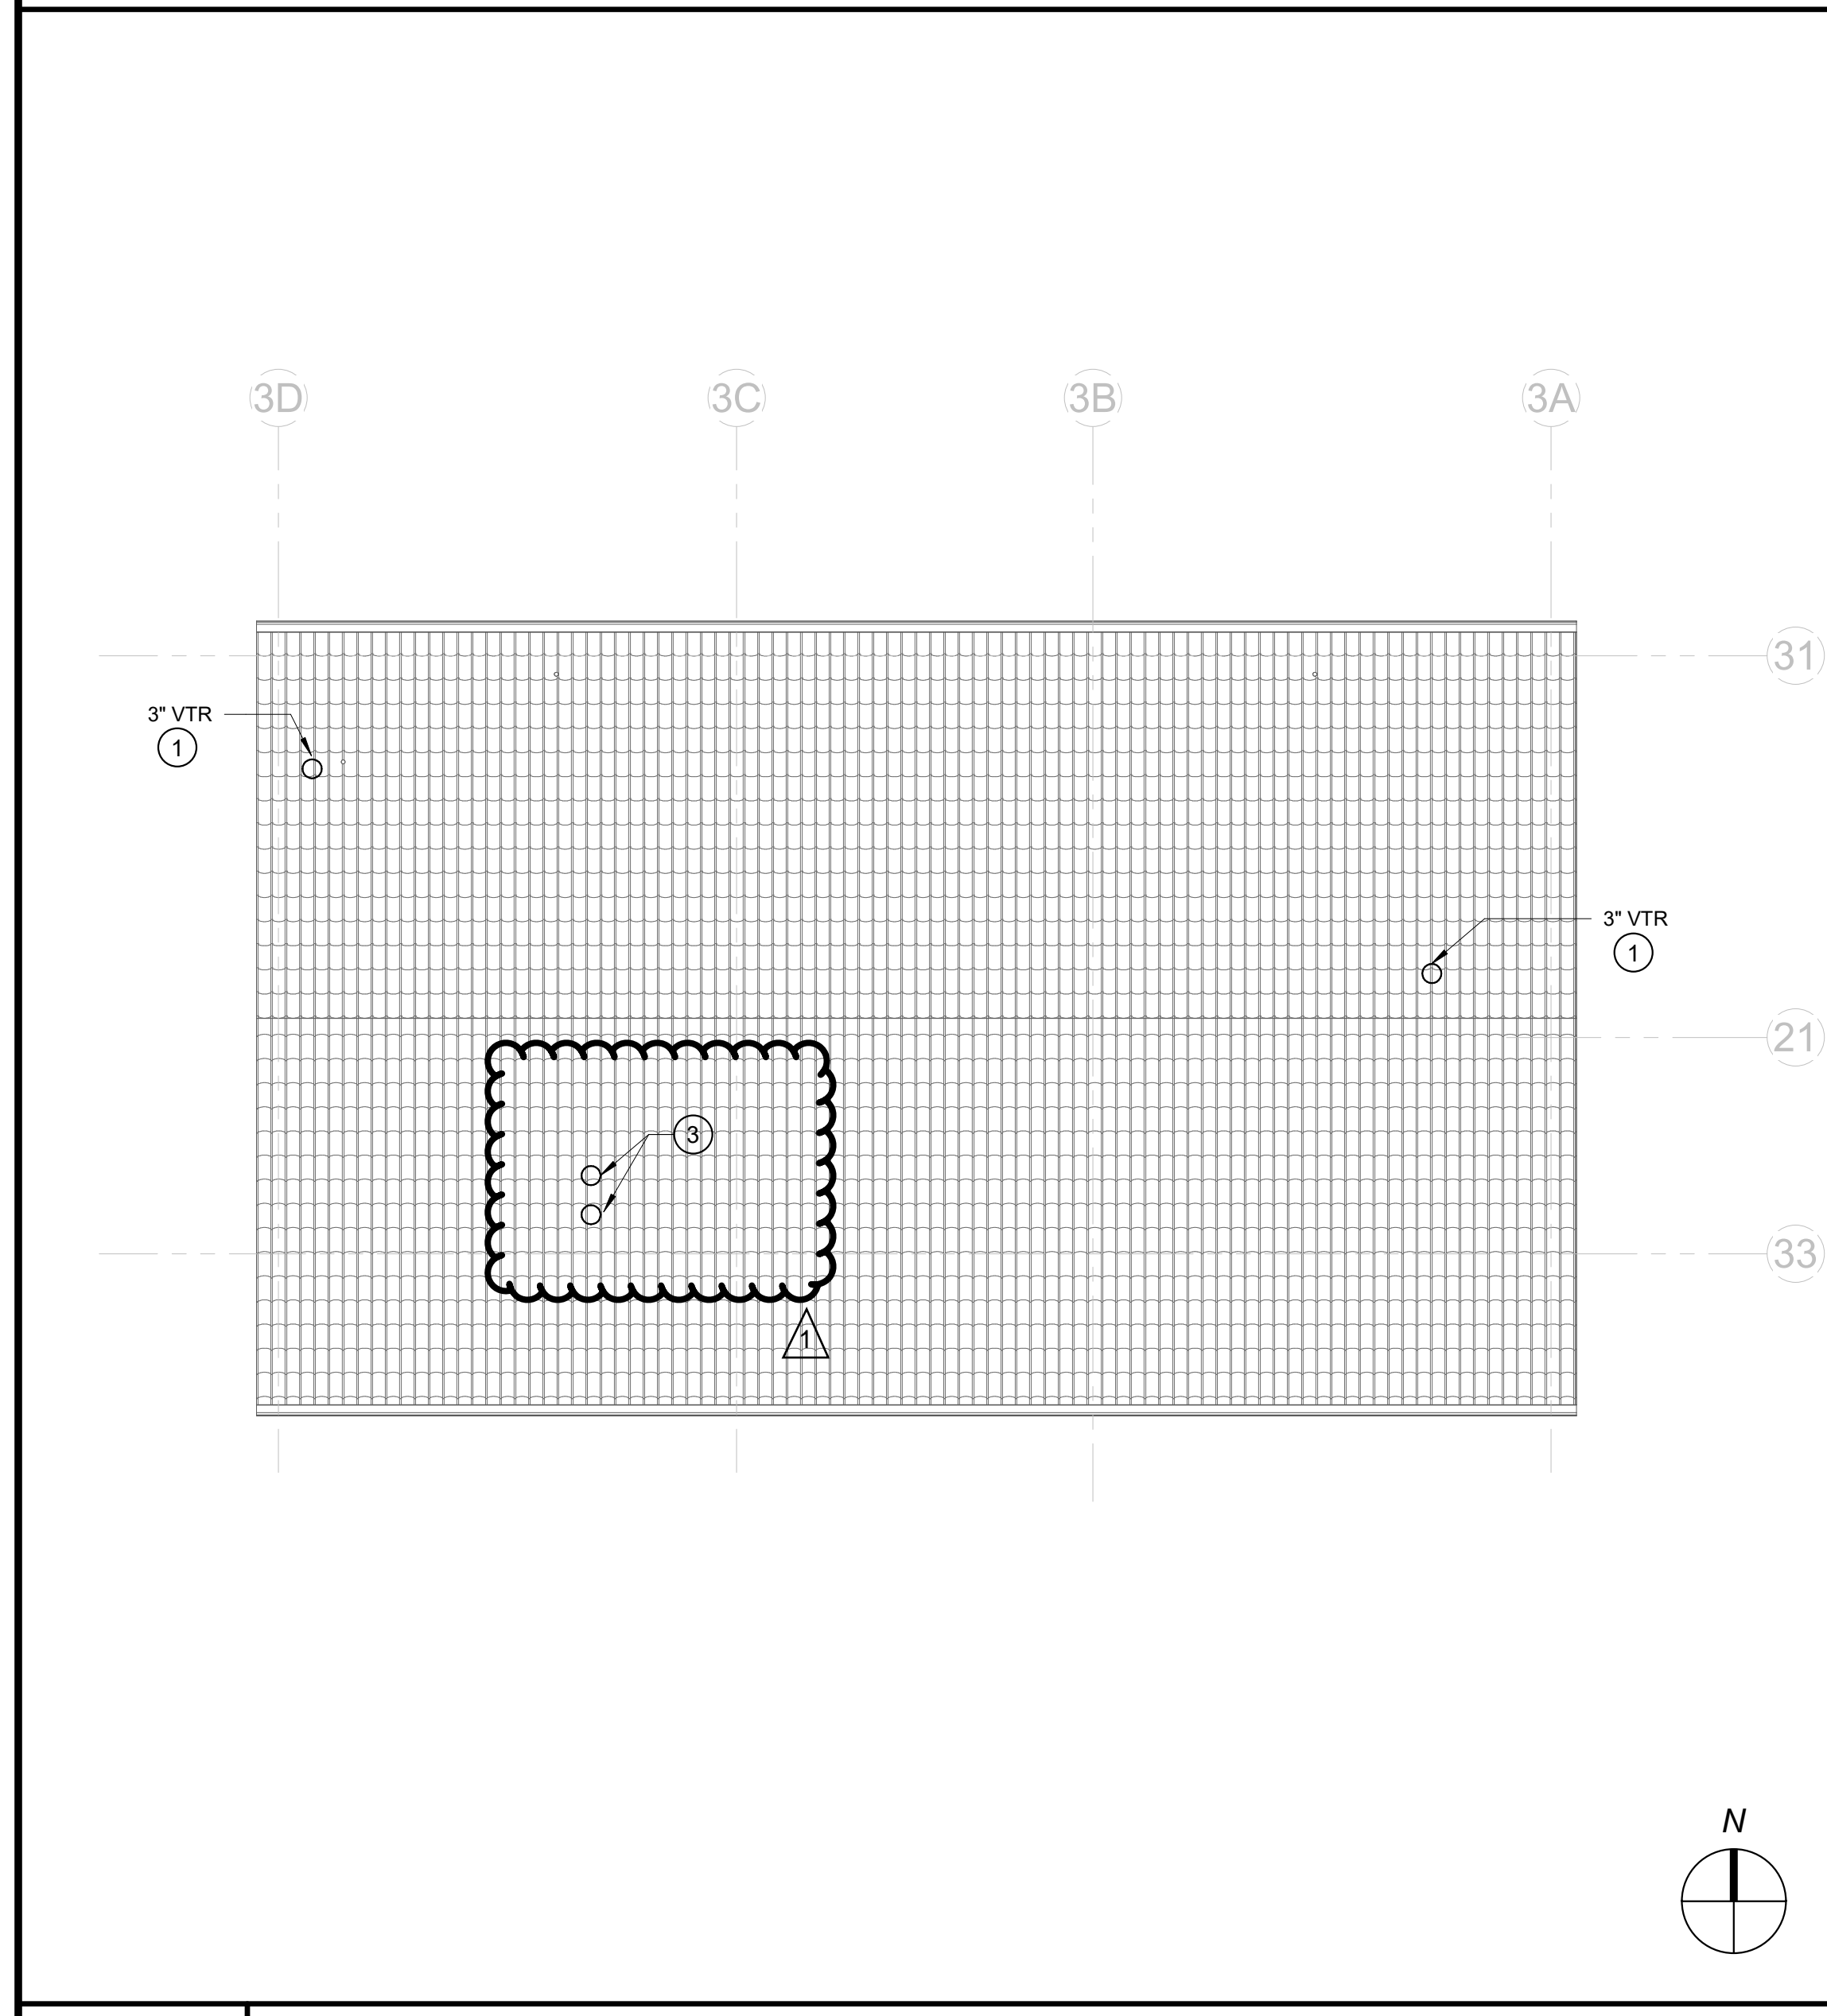

A7
1/8" = 1'-0"
PLUMBING ROOF PLAN - ALT BID BUILDING P2

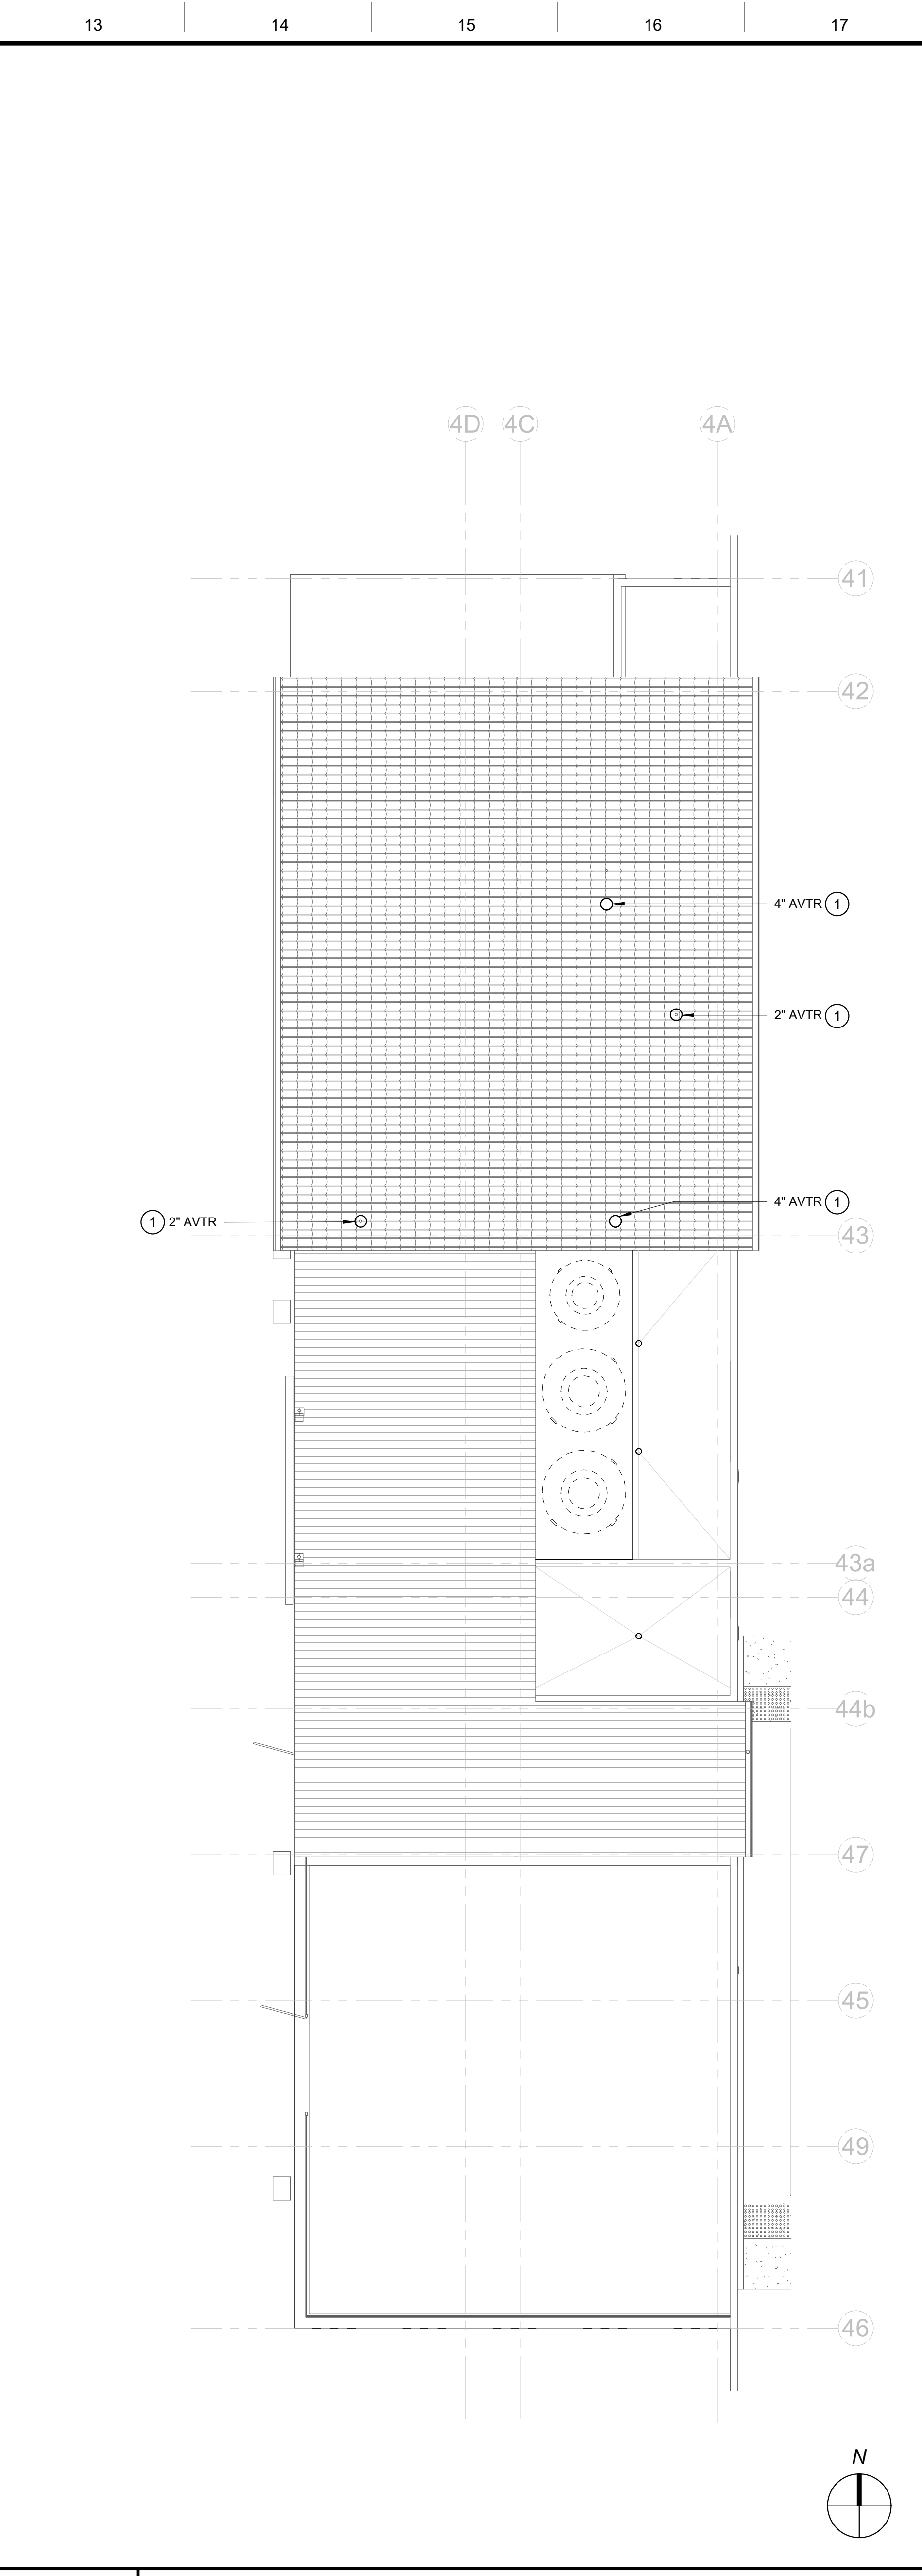


A13
1/8" = 1'-0"
PLUMBING ROOF PLAN - BUILDING P4

DSA File No.:
DSA File
DSA Application No.:
DSA App

Agency Approval

KEYNOTES #

- 1 VENT THRU ROOF. SEE ARCHITECTURAL DETAIL J7/X/A502 & DRAWINGS FOR ROOF PENETRATION AND FLASHING DETAILS.
- 2 VENT THRU ROOF. SEE ARCHITECTURAL DETAIL J7/X/A502 & DRAWINGS FOR ROOF PENETRATION AND FLASHING DETAILS.
- 3 8" WATER HEATER CONCENTRIC AIR INTAKE AND VENT PER DETAIL A1/X/P102.

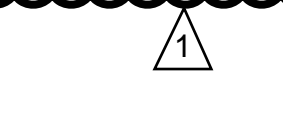

General Notes

NET POSITIVE consulting engineers
www.NPCEng.com
project no. 1101

Consultant

Mission Oak HS Aquatic Complex
Tulare Joint Union High School District
Tulare, CA 93274

Project

BUILDING P2, P3 & P4
PLUMBING ROOF PLANS

Drawing

ARCHITECTURE PLANNING INTERIORS
www.dardenarchitects.com
6790 N. West Ave. • Fresno, CA 93211 • T. 559.448.8051

Architect

No.	Revision/Submission	Date
1	REVISION_01	05/31/2023

Revision


Designed By: JCS
Copyright 2022 Darden Architects

Scale: As Indicated
Drawn By: AV

Project Number: 2180
Checked By: HB

Date: 07/13/2022
Reviewed By: JCS

P/P301

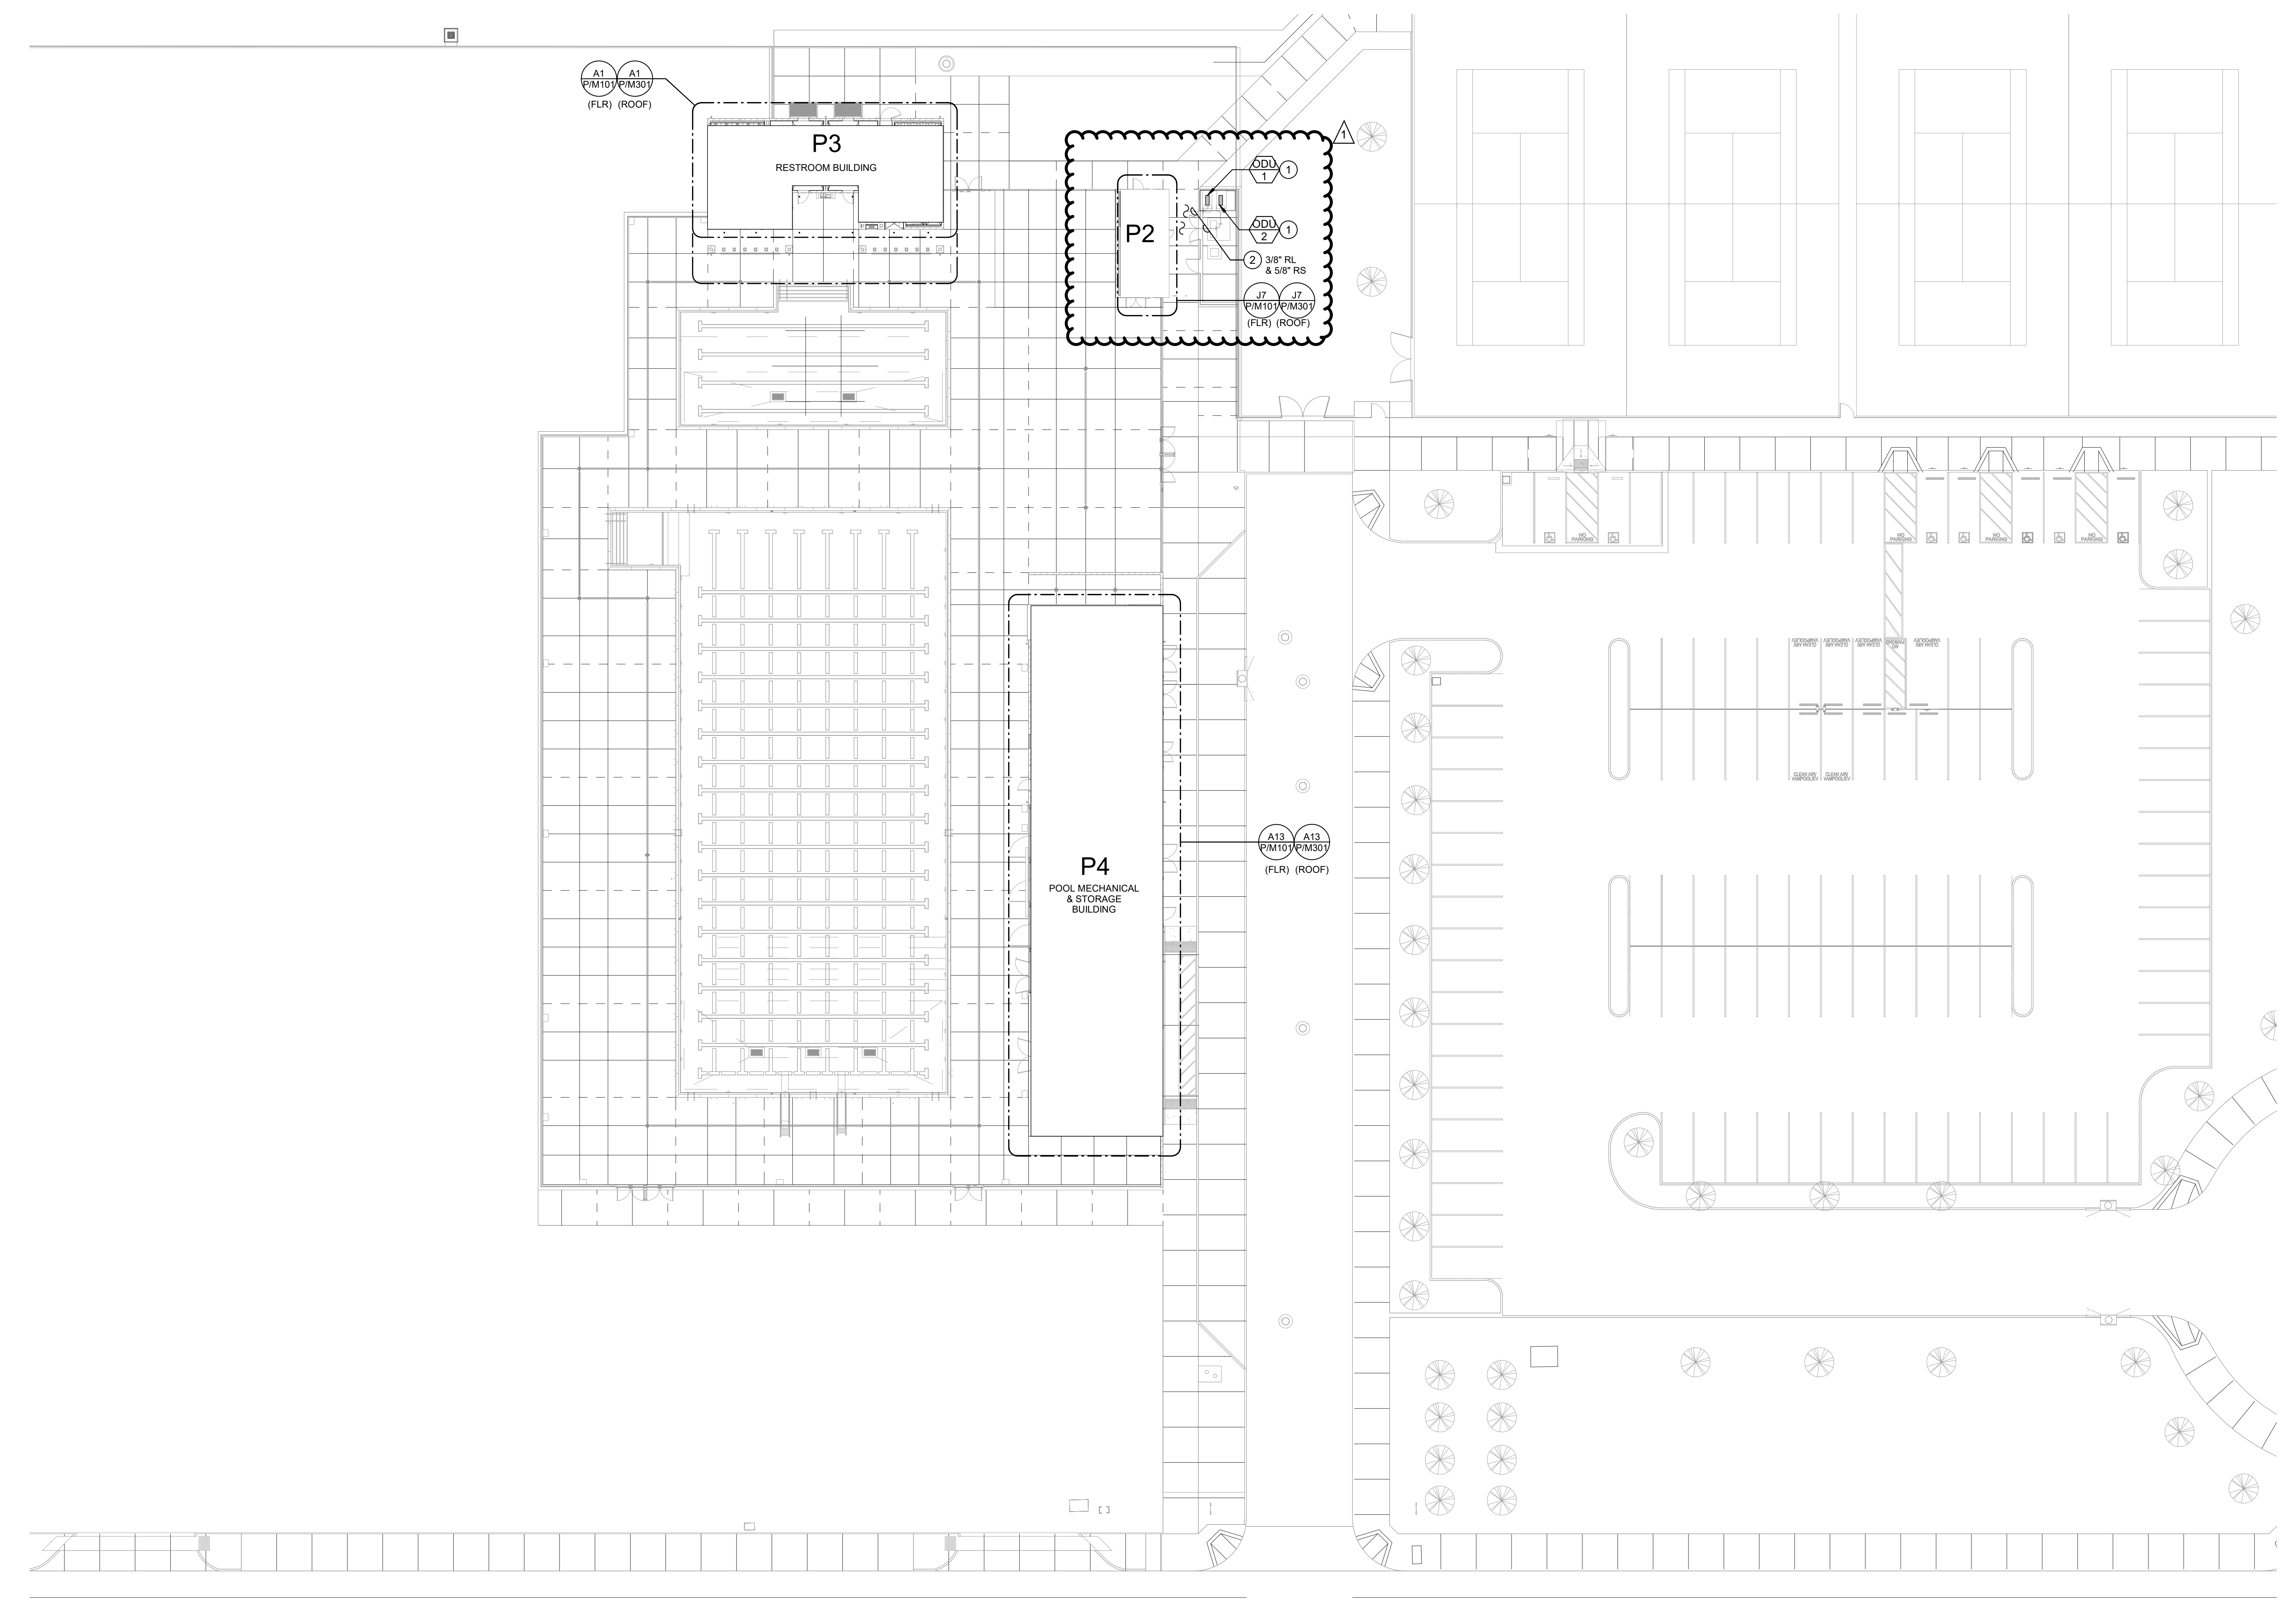

DSA File No.:
DSA File

DSA Application No.:
02-120251

Agency Approval

KEYNOTES #

- 1 OUTDOOR UNIT ON CONCRETE HOUSEKEEPING PAD PER DETAIL J11 ON X/M102.
- 2 PRE-INSULATED REFRIGERANT PIPES ROUTED BELOW GRADE WITHIN 4" Ø PVC SLEEVE. (TWO PIPES SHOWN SINGLE LINE FOR CLARITY)

GENERAL NOTES

- A. REFRIGERANT PIPING SHOWN AS SINGLE LINE CLARITY. SINGLE LINE REPRESENTS RS & RL PIPING.
- B. SEE DETAIL A7 ON X/M102 FOR TYPICAL UTILITY TRENCH DETAIL. LEAN CONCRETE SHALL BE USED AS BACKFILL WHERE UTILITY TRENCHES EXTEND FROM THE EXTERIOR TO THE INTERIOR LIMITS OF THE BUILDING. LEAN CONCRETE SHALL EXTEND A MINIMUM DISTANCE OF TWO (2) FEET Laterally ON EACH SIDE OF THE EXTERIOR BUILDING LINE AND A MINIMUM OF SIX (6) INCHES ABOVE FOOTING PENETRATION.
- C.

General Notes

NET POSITIVE consulting engineers
www.NPCEng.com
project no. 1101

Consultant

Mission Oak HS Aquatic Complex
Tulare Joint Union High School District
Tulare, CA 93274

Project

SITE DEVELOPMENT
PARTIAL MECHANICAL SITE PLAN

Drawing

darden architects
ARCHITECTURE PLANNING INTERIORS
www.dardenarchitects.com
6790 N. West Ave. • Fresno, CA 93211 • T. 559.448.8051

Architect

No.	Revision/Submission	Date
1	REVISION_01	05/31/2023

Scale: As indicated Drawn By: HB
Project Number: 2180 Checked By: JCS
Date: 07/13/2022 Reviewed By: JCS

SD/M102

MECHANICAL SCHEDULES

EXHAUST FAN SCHEDULE					
DESIGNATION	EF-1	EF-2	EF-3	EF-4	EF-5
CFM	5,020	1,285	175	175	3,000
EXT. SP (IN, WC)	0.61	0.50	0.52	0.52	0.50
HP / BHP	1-1/2 / 1.31	1/4 / 0.25	1/12 / 0.05	1/12 / 0.05	1 / 0.89
VOLTS / PHASE	115 / 1	115 / 1	115 / 1	115 / 1	115 / 1
RPM	1,750	1024	1,550	1,550	714
TIP SPEED / SONES	- / 19.1	- / 8.8	- / 7.3	- / 7.3	- / 11.2
DRIVE	DIRECT	DIRECT	DIRECT	DIRECT	BELT
MOUNTING	INLINE	ROOFTOP	INLINE	INLINE	INLINE
MANUFACTURER	GREENHECK	GREENHECK	GREENHECK	GREENHECK	GREENHECK
TYPE	CENTRIFUGAL	CENTRIFUGAL	CENTRIFUGAL	CENTRIFUGAL	CENTRIFUGAL
MODEL NUMBER	SQ-16-M2	CUBE-140	SQ-80	SQ-80	BDF-120
CONTROL	NOTE 2	NOTE 3	NOTE 4	NOTE 4	NOTE 4
SERVICE	BUILDING P3, RESTROOMS & SHOWERS	BUILDING P2, RESTROOM	BUILDING P4, ACID ROOM	BUILDING P4, CHLORINE ROOM	BUILDING P4, POOL EQUIPMENT
OPER. WT. (LBS)	112	29	49	49	141
ACCESSORIES	1,2	1,3,8	1,4,5,6,7	1,4,5,6,7	1,4,5,7

- PROVIDE WITH HANDERS AND ACCESS PER THE 2019 CMC.
- INTERLOCK OPERATION WITH EMS SCHEDULE.
- INTERLOCK OPERATION WITH LIGHTSWITCH IN RESTROOM/SHOWERS.
- CONTINUOUS OPERATION.
- STAINLESS STEEL HOUSING AND FAN COMPONENTS.
- MAINTAIN MINIMUM 10'-0" CLEARANCE BETWEEN EXHAUST FANS, EF-3 & EF-4.
- PROVIDE MANUFACTURER'S INDUSTRIAL EPOXY COATING FOR CHEMICAL RESISTANCE AND CORROSION PROTECTION.
- ALTERNATE BID EQUIPMENT.

GRILLE SCHEDULE		
MARK	DUTY	DESCRIPTION
A	SURFACE MOUNTED DIFFUSER (SUPPLY)	TITUS MODEL PMC (TYPE 1) PERFORATED MODULAR CORE STEEL LOUVER DIFFUSER FOR SURFACE MOUNTING, SQUARE NECK, FLAT BLACK INTERIOR, AND NO. 26 WHITE FINISH.
B	SURFACE MOUNTED DIFFUSER (RETURN / EXHAUST)	TITUS MODEL 25RL (TYPE 1) STEEL GRILLE FOR SURFACE MOUNTING, 30" FIXED DEFLECTION, 1/2" BLADE SPACING, AND NO. 26 WHITE FINISH.
C	LINEAR DIFFUSER (SUPPLY)	TITUS MODEL FL-15 LINEAR SLOT DIFFUSER WITH 1-1/2" SLOT SPACING, 1-SLOT CONFIGURATION, BORDER TYPE 11 FOR LAY. IN CEILING, HIGH-THROW PATTERN CONTROLLER, FLAT BLACK INTERIOR AND NO. 26 WHITE FINISH. PROVIDE FBP-15 SUPPLY PLENUM.
D	LINEAR DIFFUSER (BLANK-OFF)	TITUS MODEL FL-15 LINEAR SLOT DIFFUSER WITH 1-1/2" SLOT SPACING, 1-SLOT CONFIGURATION, BORDER TYPE 11 FOR LAY. IN CEILING, FLAT BLACK INTERIOR AND FBP-15 BLANK-OFF PANEL.

FLY FAN SCHEDULE		
DESIGNATION	FF-1	FF-2
CFM	1,379	1,442
FPM (AT NOZZLE)	2,200	2,200
HP	1/2	1/2
VOLTS / PHASE	115 / 1	115 / 1
FLA	5.1	5.1
DRIVE	DIRECT	DIRECT
MOUNTING	WALL	WALL
MANUFACTURER	MARS	MARS
TYPE	CENTRIFUGAL	CENTRIFUGAL
MODEL NUMBER	STD236-1UA-OB	STD248-1UA-OB
CONTROL	DOOR SWITCH	DOOR SWITCH
SERVICE	BUILDING P2, MAN DOOR	BUILDING P2, CONCESSION WINDOW
OPER. WT. (LBS)	60	70
ACCESSORIES	1	1

INDOOR UNIT SCHEDULE		
DESIGNATION	IDU-1	IDU-2
BLOWER		
SUPPLY AIR (CFM)	335	335
EXT. SP (IN, WC)	0	0
MIN. O.S.A. (CFM)	-	-
VOLTS / PHASE	208-230 / 1	208-230 / 1
MCA / MOCP	NOTE 3	NOTE 3
DRIVE	DIRECT	DIRECT
COOLING		
SENSIBLE (MBH)	9.6	9.7
TOTAL (MBH)	14.4	13.5
EADB / EAWB (°F)	80 / 67	80 / 67
REFRIGERANT TYPE	R-410A	R-410A
FILTERS		
QUANTITY / SIZE	1 / -	1 / -
TYPE	FACTORY	FACTORY
MANUFACTURER	CARRIER	CARRIER
TYPE	HIGH WALL	HIGH WALL
MODEL NUMBER	40MAHQ12XA3	40MAHQ09XA3
LOCATION	BUILDING P2, ELECTRICAL	BUILDING P2, STORAGE
OPER. WT (LBS)	22.93	22.71
ACCESSORIES	1,2,3	1,2,3

OUTDOOR UNIT SCHEDULE		
DESIGNATION	ODU-1	ODU-2
VOLTS / PHASE	208-230 / 1	208-230 / 1
MCA / MOCP	15 / 15	15 / 15
EER2 / SEER2	14 / 25.5	16.2 / 28.1
COOLING CAP. (MBH)	12.0	9.0
REFRIGERANT TYPE	R-410A	R-410A
AMBIENT (°F)	105	105
MANUFACTURER	CARRIER	CARRIER
TYPE	COOLING ONLY	HEAT PUMP
MODEL NUMBER	38MARBQ12AA3	38MARBQ09AA3
LOCATION	YARD	YARD
OPER. WT. (LBS)	73.6	74.1
ACCESSORIES	-	-

- WIRED WALL MOUNTED THERMOSTAT.
- REFRIGERANT LINE SET COVERS FOR EXPOSED PIPING IN ROOM. (AC COVER GUARD)
- POWERED THRU THE OUTDOOR UNIT.

GENERAL NOTES

- COORDINATION OF WORK: LAYOUT OF MATERIALS, EQUIPMENT AND SYSTEMS IS GENERALLY DIAGRAMMATIC UNLESS SPECIFICALLY DIMENSIONED. SOME WORK MAY BE SHOWN OFFSET FOR CLARITY. THE ACTUAL LOCATION OF ALL MATERIALS, PIPING, DUCTWORK, FIXTURES, EQUIPMENT, SUPPORTS, ETC. SHALL BE CAREFULLY PLANNED PRIOR TO INSTALLATION OF ANY WORK TO AVOID ALL INTERFERENCES WITH EACH OTHER, OR WITH STRUCTURAL, ELECTRICAL, ARCHITECTURAL OR OTHER ELEMENTS.
- VERIFY THE PROPER VOLTAGE AND PHASE OF ALL EQUIPMENT WITH THE ELECTRICAL PLANS. ALL CONFLICTS SHALL BE CALLED TO THE ATTENTION OF THE ARCHITECT AND THE ENGINEER PRIOR TO THE INSTALLATION OF ANY WORK OR THE ORDERING OF ANY EQUIPMENT. PROVIDE ALL DUCT TRANSITION PIECES AND FITTINGS REQUIRED TO ACCOMMODATE MECHANICAL EQUIPMENT CONNECTIONS, STRUCTURE, ARCHITECTURAL ELEMENTS, AND CHANGES IN DUCT SIZES.
- ALL DUCTWORK SHALL BE CONSTRUCTED, ERECTED AND TESTED IN ACCORDANCE WITH THE STANDARDS ADOPTED BY SMACNA AND CHAPTER 6 OF THE 2019 CMC.
- ALL DUCTWORK AND PIPING SHALL BE INSULATED CONSISTENT WITH THE REQUIREMENTS OF 2019 CMC. INSULATION MATERIALS SHALL MEET THE CALIFORNIA QUALITY STANDARD PER SECTION 110.8, 120.3, AND 120.4 OF THE 2019 CALIFORNIA ENERGY CODE.
- ALL DUCT SIZES SHOWN ARE NET INSIDE DIMENSIONS. DUCTWORK SHALL BE SHEET METAL CONSTRUCTED IN COMPLETE CONFORMANCE WITH CMC LATEST EDITION, CHAPTER 6 AND THE LATEST SMACNA HVAC DUCT CONSTRUCTION STANDARDS.
- ALL DRAWINGS AND SPECIFICATIONS ARE TO BE CONSIDERED PART OF THE CONTRACT DOCUMENTS. THE CONTRACTOR SHALL BE RESPONSIBLE FOR THE REVIEW AND COORDINATION OF ALL DRAWINGS PRIOR TO ANY CONSTRUCTION, INCLUDING ARCHITECTURAL, STRUCTURAL, MECHANICAL, PLUMBING, AND ELECTRICAL. ANY WORK PERFORMED IN CONFLICT WITH THE CONTRACT DOCUMENTS OR ANY CODE REQUIREMENT SHALL BE CORRECTED BY THE CONTRACTOR AT HIS OWN EXPENSE AND AT NO EXPENSE TO THE OWNER OR THE OWNER REPRESENTATIVE.
- PROVIDE VOLUME DAMPERS IN ALL BRANCH DUCTS (SUPPLY, RETURN, O.S.A. AND EXHAUST) FOR SYSTEM BALANCING.
- HANDLE, STORE AND INSTALL ALL EQUIPMENT PER MANUFACTURER'S INSTRUCTIONS AND AS DIRECTED IN THE PROJECT MANUAL.
- ALL AIR SYSTEMS SHALL BE TESTED, ADJUSTED AND BALANCED TO MEET THE REQUIRED FLOW. TAB METHODOLOGY SHALL BE SUBMITTED TO OWNER REPRESENTATIVE PRIOR TO IMPLEMENTATION AND IN ACCORDANCE WITH PROJECT SEQUENCING.

ANCHORAGE & BRACING NOTES

MEP COMPONENT ANCHORAGE NOTE

ALL MECHANICAL, PLUMBING, AND ELECTRICAL COMPONENTS SHALL BE ANCHORED AND INSTALLED PER THE DETAILS ON THE DSA APPROVED CONSTRUCTION DOCUMENTS. THE FOLLOWING COMPONENTS SHALL BE ANCHORED OR BRACED TO MEET THE FORCE AND DISPLACEMENT REQUIREMENTS PRESCRIBED IN THE 2019 CBC, SECTIONS 1617A.1.18 THROUGH 1617A.1.26 AND ASCE 7-16 CHAPTERS 13, 26, AND 30:

- ALL PERMANENT EQUIPMENT AND COMPONENTS.
- TEMPORARY, MOVABLE OR MOBILE EQUIPMENT THAT IS PERMANENTLY ATTACHED (E.G. HARD WIRED) TO THE BUILDING UTILITY SERVICES SUCH AS ELECTRICITY, GAS OR WATER. "PERMANENTLY ATTACHED" SHALL INCLUDE ALL ELECTRICAL CONNECTIONS EXCEPT PLUGS FOR 110/220 VOLT RECEPTACLES HAVING A FLEXIBLE CABLE.
- TEMPORARY, MOVABLE OR MOBILE EQUIPMENT WHICH IS HEAVIER THAN 400 POUNDS OR HAS A CENTER OF MASS LOCATED 4 FEET OR MORE ABOVE THE ADJACENT FLOOR OR ROOF LEVEL THAT DIRECTLY SUPPORT THE COMPONENT IS REQUIRED TO BE RESTRAINED IN A MANNER APPROVED BY DSA.

THE FOLLOWING MECHANICAL AND ELECTRICAL COMPONENTS SHALL BE POSITIVELY ATTACHED TO THE STRUCTURE BUT NEED NOT DEMONSTRATE DESIGN COMPLIANCE WITH THE REFERENCES NOTED ABOVE. THESE COMPONENTS SHALL HAVE FLEXIBLE CONNECTIONS PROVIDED BETWEEN THE COMPONENT AND ASSOCIATED DUCTWORK, PIPING AND CONDUIT. FLEXIBLE CONNECTIONS MUST ALLOW MOVEMENT IN BOTH TRANSVERSE AND LONGITUDINAL DIRECTIONS:

- COMPONENTS WEIGHING LESS THAN 400 POUNDS AND HAVING A CENTER OF MASS LOCATED 4 FEET OR LESS ABOVE THE ADJACENT FLOOR OR ROOF LEVEL THAT DIRECTLY SUPPORT THE COMPONENT.
- COMPONENTS WEIGHING LESS THAN 20 POUNDS, OR IN THE CASE OF DISTRIBUTED SYSTEMS, LESS THAN 5 POUNDS PER FOOT, WHICH ARE SUSPENDED FROM A ROOF OR FLOOR OR HUNG FROM A WALL.

THE ANCHORAGE OF ALL MECHANICAL, ELECTRICAL AND PLUMBING COMPONENTS SHALL BE SUBJECT TO THE APPROVAL OF THE DESIGN PROFESSIONAL IN GENERAL RESPONSIBLE CHARGE OR STRUCTURAL ENGINEER DELEGATED RESPONSIBILITY AND ACCEPTANCE BY DSA. THE PROJECT INSPECTOR WILL VERIFY THAT ALL COMPONENTS AND EQUIPMENT HAVE BEEN ANCHORED IN ACCORDANCE WITH THE ABOVE REQUIREMENTS.

PIPING, DUCTWORK, AND ELECTRICAL DISTRIBUTION SYSTEM BRACING NOTE

PIPING, DUCTWORK AND ELECTRICAL DISTRIBUTION SYSTEMS SHALL BE BRACED TO COMPLY WITH THE FORCES AND DISPLACEMENTS PRESCRIBED IN ASCE 7-16 SECTION 13.3 AS DEFINED IN ASCE 7-16 SECTIONS 13.6.5, 13.6.6, 13.6.7, 13.6.8; AND 2019 CBC, SECTIONS 1617A.1.24, 1617A.1.25 AND 1617A.1.26.

THE METHOD OF SHOWING BRACING AND ATTACHMENTS TO THE STRUCTURE FOR THE IDENTIFIED DISTRIBUTION SYSTEM ARE AS NOTED BELOW. WHEN BRACING AND ATTACHMENTS ARE BASED ON A PRE-APPROVED INSTALLATION GUIDE (E.G., OSHPD OPM FOR 2013 CBC OR LATER), COPIES OF THE BRACING SYSTEM INSTALLATION GUIDE OR MANUAL SHALL BE AVAILABLE ON THE JOBSITE PRIOR TO THE START OF AND DURING THE HANGING AND BRACING OF THE DISTRIBUTION SYSTEMS. THE STRUCTURAL ENGINEER OF RECORD SHALL VERIFY THE ADEQUACY OF THE STRUCTURE TO SUPPORT THE HANGER AND BRACE LOADS.

MECHANICAL PIPING (MP), MECHANICAL DUCTS (MD), PLUMBING PIPING (PP), ELECTRICAL DISTRIBUTION SYSTEMS (E):

- MD MP PP E
 - MD MP PP E
- OPTION 1: DETAILED ON THE APPROVED DRAWINGS WITH PROJECT SPECIFIC NOTES AND DETAILS.
- OPTION 2: SHALL COMPLY WITH THE APPLICABLE OSHPD PRE-APPROVAL (OPM #) # 0043-13.

LEGEND

SYMBOL	ITEM	ABBR.
—	ABOVE	ABV
—	ABOVE CEILING	ABV CLG
—	ABOVE FINISHED FLOOR	AFF
—	ALTERNATE	ALT
—	AIR CONDITIONING	AC
—	AIR FLOW STATION	AFS
—	AIR HANDLER UNIT	AHU
—	ANALOG INPUT	AI
—	ANALOG OUTPUT	AO
&	AND	
—	ARCHITECT / ARCHITECTURAL	ARCH
@	AT	
—	BACKDRAFT DAMPER	BDD
—	BELOW FINISH CEILING	BFC
—	BELOW FLOOR	BEL FLR
—	BELOW GRADE	BEL GR
—	BLIND FLANGE	BLF
—	BRITISH THERMAL UNIT	BTU
—	BRITISH THERMAL UNIT PER HOUR	BTUH
—	CALIFORNIA MECHANICAL CODE	CMC
—	CALIFORNIA PLUMBING CODE	CPC
—	CEILING	CLG
—	CENTER LINE	
—	CONTINUATION	CONT
—	CUBIC FEET OF AIR PER MINUTE	CFM
—	CURRENT SENSOR	CS
∅	DIAMETER	DIA
—	DIFFERENTIAL PRESSURE SWITCH	DPS
—	DIGITAL INPUT	DI
—	DIGITAL OUTPUT	DO
—	DOWN	DN
—	DRAWING	DWG
—	ELECTRICAL	ELEC
—	ELBOW	ELL
—	EXHAUST	EXH
—	EXHAUST AIR	EA
—	EXHAUST FAN	EF
—	EXISTING	(E)
—	FEET	FT
—	FLOOR	FLR
—	FLOW LINE	FL
—	FLOW SWITCH	FS
—	GAUGE	GA
—	GALLON	GAL
—	GALLONS PER HOUR	GPH
—	GALLONS PER MINUTE	GPM
—	INSIDE DIAMETER	ID
—	MAKE-UP AIR UNIT	MAU
—	MAXIMUM	MAX
—	MINIMUM	MIN
—	NEW	(N)
—	NOT IN CONTRACT	NIC
—	NOT TO SCALE	NTS
#	NUMBER	NO.
—	OUTSIDE AIR	OSA
—	OUTSIDE DIAMETER	OD
—	POUNDS	LBS
—	POUNDS PER SQUARE INCH	PSI
—	POUNDS PER SQUARE INCH ABSOLUTE	PSIA
—	POUNDS PER SQUARE INCH GAUGE	PSIG
—	POLYVINYL CHLORIDE	PVC
—	PRESSURE STATION	PS
—	RETURN AIR	RA
—	ROOM	RM
—	SUPPLY AIR	SA
—	SPECIFICATION	SPEC
—	SQUARE FEET	SQ FT
—	STAINLESS STEEL	SS
—	TEMPERATURE	TEMP
—	TEMPERATURE SENSOR	TS
—	THROUGH	THRU
—	TYPICAL	(TYP)
—	UNDER GROUND	UIG
—	VARIABLE AIR VOLUME UNIT	VAV
—	WITH	W/
—	WITHOUT	W/O
—	BOILER BLOWDOWN	
—	BOILER FEED	
—	CHEMICAL FEED	
—	COMPRESSED AIR	A
—	CHILLED WATER SUPPLY	CHWS
—	CHILLED WATER RETURN	CHWR
—	CONDENSER WATER SUPPLY	CWS
—	CONDENSER WATER RETURN	CWR
—	DOMESTIC COLD WATER	
—	HEATING HOT WATER SUPPLY	HWS
—	HEATING HOT WATER RETURN	HWR
—	REFRIGERANT DISCHARGE	RD
—	REFRIGERANT LIQUID	RL
—	REFRIGERANT SUCTION	RS
—	SOFT COLD WATER	
—	STEAM SUPPLY	S

SYMBOL	ITEM	ABBR.
—	STEAM CONDENSATE RETURN	CR
—	SURFACE BLOWDOWN	
—	DRAIN	D
—	PIPING CAP	
—	EXISTING (DESIGNATED)	(E)
—	REMOVE / DEMO EXISTING (DESIGNATED)	
—	DIRECTION OF FLOW	
—	SUPPLY AIR	SA
—	RETURN AIR	RA
—	EXHAUST AIR	EA
—	PIPE/DUCT TURN DOWN	
—	PIPE/DUCT TURN UP	
—	ROUND DUCT (SMALLER THAN 100")	
—	ROUND FLEXIBLE DUCT	
—	RECTANGULAR OR ROUND DUCT (100" AND LARGER)	
—	EXISTING DUCT (DESIGNATED)	
—	REMOVE / DEMO EXISTING DUCT (DESIGNATED)	
—	DUCT WITH ACOUSTIC LINING	
—	SUPPLY AIR DUCT DROP	
—	SUPPLY AIR DUCT RISE	
—	RETURN AIR DUCT DROP	
—	RETURN AIR DUCT RISE	
—	EXHAUST AIR DUCT DROP	
—	EXHAUST AIR DUCT RISE	
—	OUTSIDE AIR DUCT DROP	
—	OUTSIDE AIR DUCT RISE	
—	TURNING VANES	TV
—	EXTRACTOR	
—	CO ₂ SENSOR	
—	DUCT DETECTOR	DD
—	HEAT DETECTOR	HD
—	SMOKE DETECTOR	SD
—	MOTORIZED DAMPER	
—	FIRE DAMPER W/MOTORIZED RESET AND ACCESS DOOR	
—	FIRE DAMPER WITH ACCESS PANEL OR SECURITY BARS	
—	FIRE DAMPER WITH ACCESS PANEL	FD
—	FIRE/SMOKE DAMPER WITH ACCESS PANEL	F/S/D
—	VOLUME CONTROL DAMPER WITH LOCKING QUADRANT	VCD
—	REMOTE T'STAT WITH SENSOR IN DUCT	
—	THERMOSTAT; THERMOSTAT LABEL MOUNT @ +48" AFF TO TOP OF BOX EXAMPLE: THERMOSTAT FOR AC-1	T'STAT
—	POINT OF CONNECTION TO EXISTING	POC
—	BYPASS TIMER	BPT
—	THERMOMETER	
—	PRESSURE GAGE	
—	SECURITY BARS	
—	PETE'S PLUG	
—	BALANCING COCK	
—	BALL VALVE	
—	BUTTERFLY VALVE	
—	CHECK VALVE	
—	CONCENTRIC REDUCER	
—	TWO-WAY CONTROL VALVE	
—	FLOW SWITCH	FS
—	FLEXIBLE CONNECTION	FLEX
—	GATE VALVE	
—	GLOBE VALVE	
—	INSTRUMENT WELL	
—	PLUG VALVE	
—	PRESSURE RELIEF VALVE	PRV
—	"Y" TYPE STRAINER	
—	UNION	
—	KEYNOTE	
—	GRILLE TAG	
—	NEW EQUIPMENT TAG EXAMPLE: DESCRIPTION EF, MARK NUMBER 8	
—	DETAIL REFERENCE EXAMPLE: DETAIL 2, SHEET M202	
—	SECTION REFERENCE EXAMPLE: SECTION 3, SHEET M400	

DSA File No.: DSA File

DSA Application No.: 02-120251

Agency Approval

General Notes

NET POSITIVE consulting engineers




Consultant

Mission Oak HS Aquatic Complex
Tulare Joint Union High School District
Tulare, CA 93274

Project

TYPICAL INFORMATION
MECHANICAL SCHEDULES, LEGENDS, AND NOTES
Drawing

ARCHITECTURE PLANNING INTERIORS
www.dardenarchitects.com

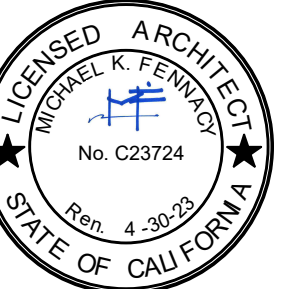



Architect

No.	Revision/Submission	Date
1	REVISION_01	05/31/2023

Revision




Designed By: JCS Copyright 2022 Darden Architects
Scale: 12" = 1'-0" Drawn By: HB
Project Number: 2180 Checked By: JCS
Date: 07/13/2022 Reviewed By: JCS

X/M101

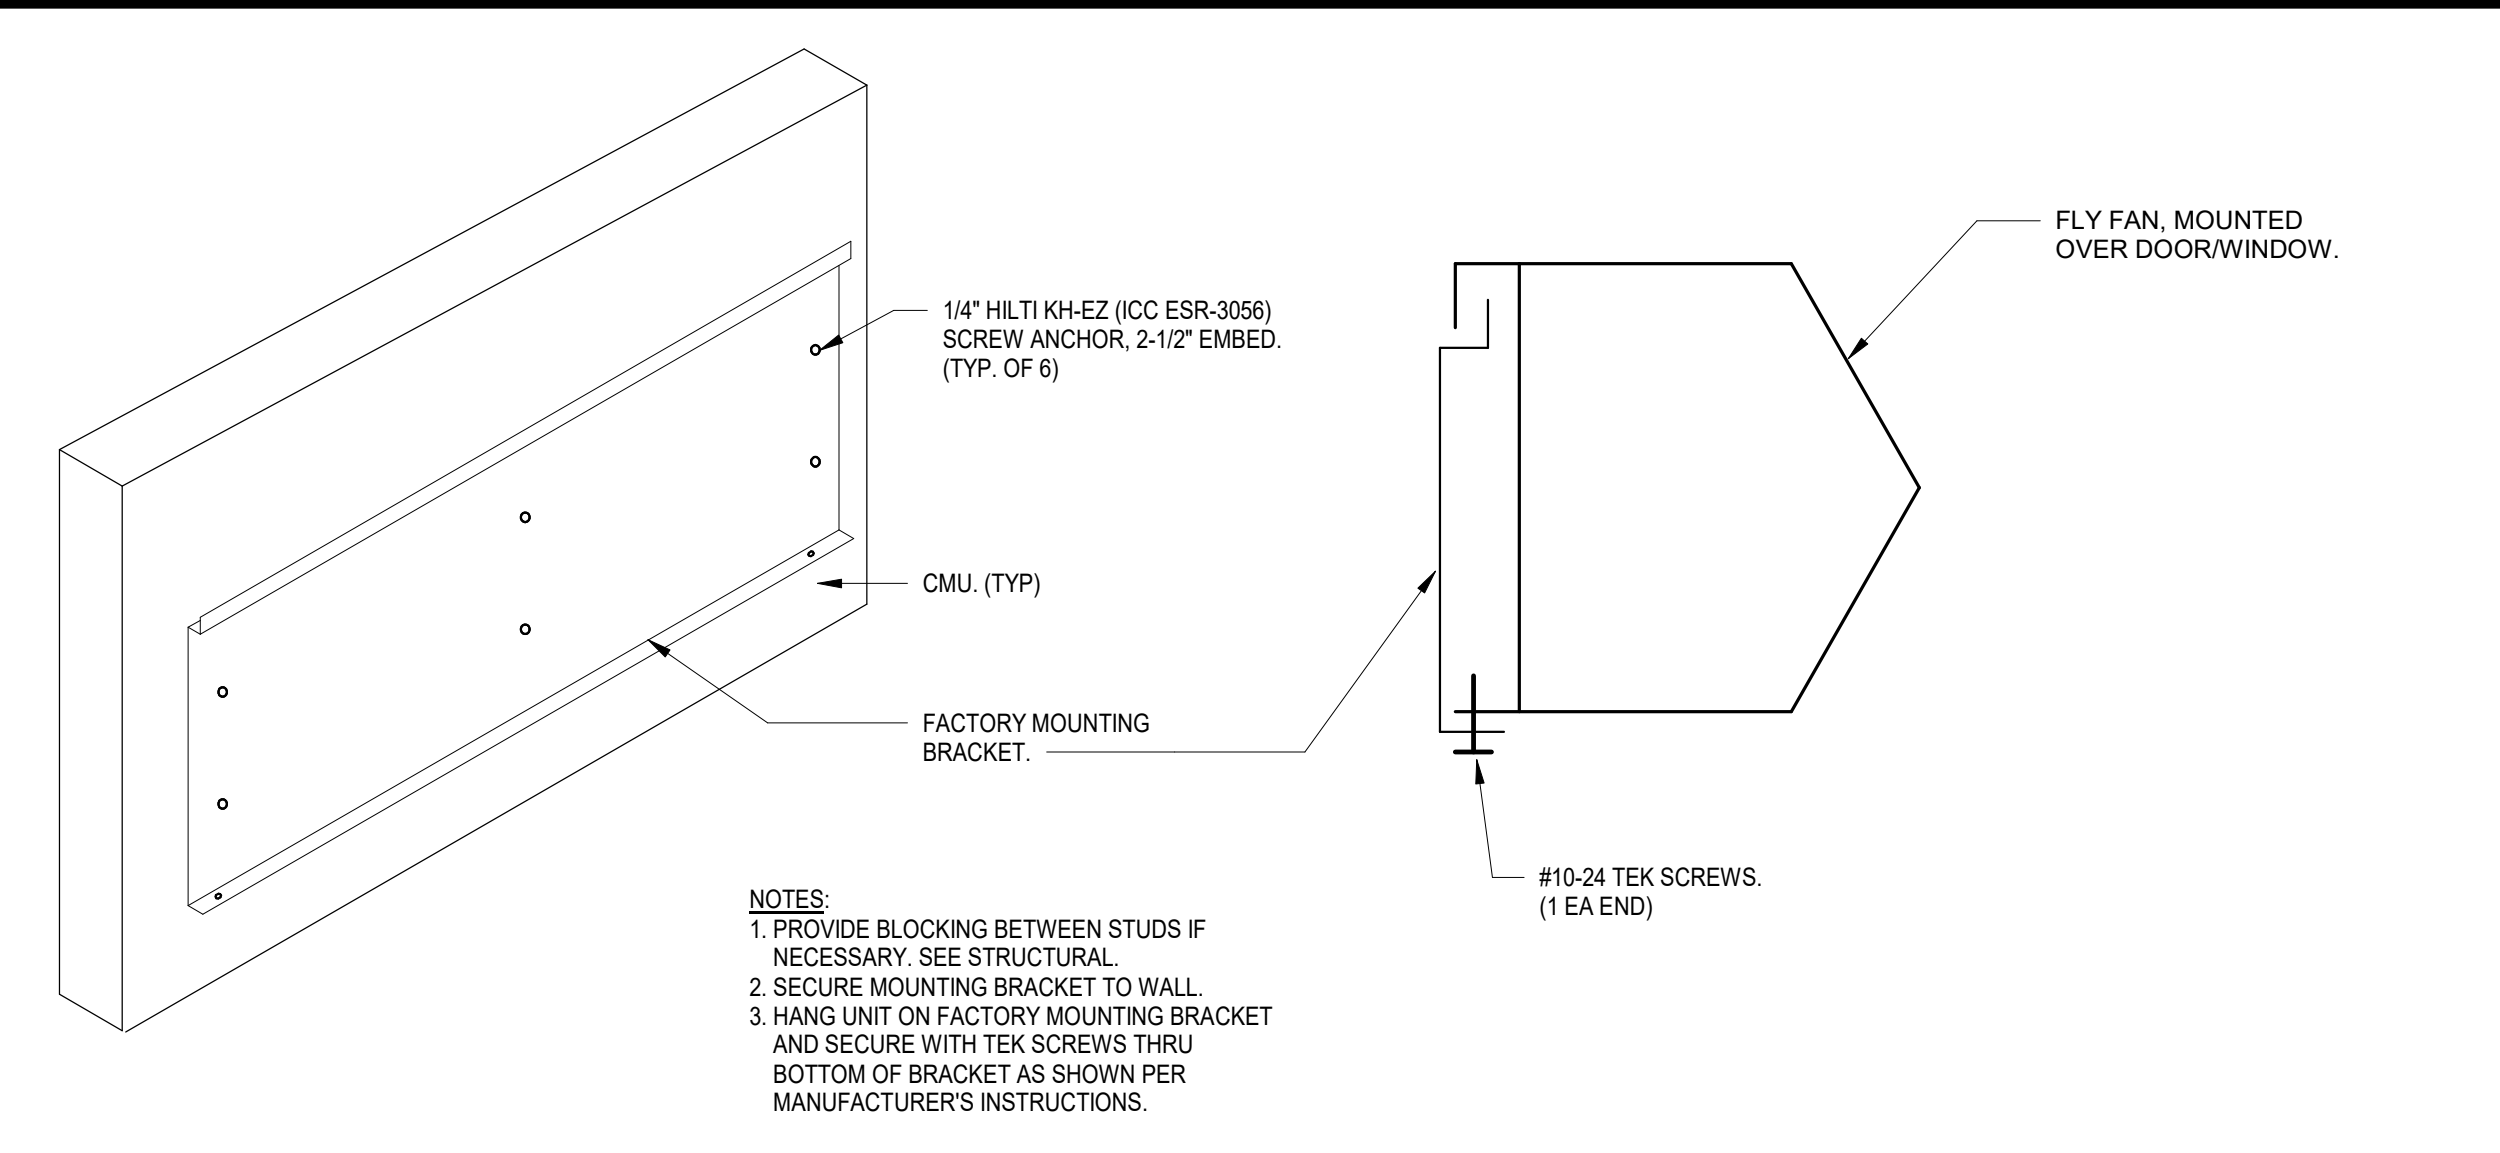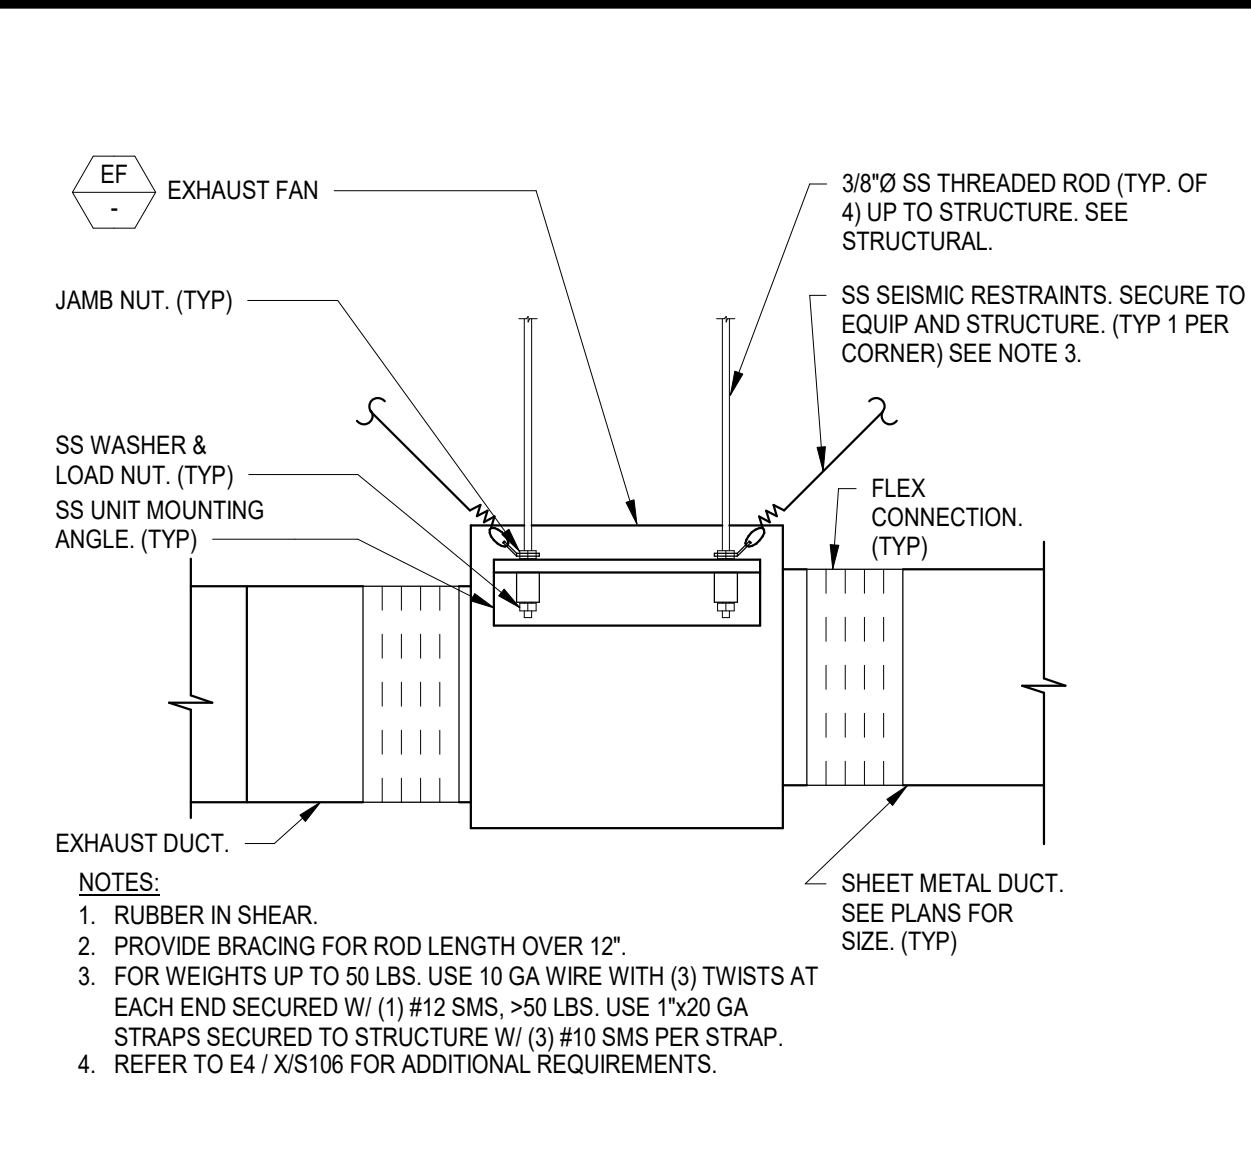

N7 INLINE EXHAUST FAN
 N.T.S.





N11 FLY FAN MOUNTING
 N.T.S.

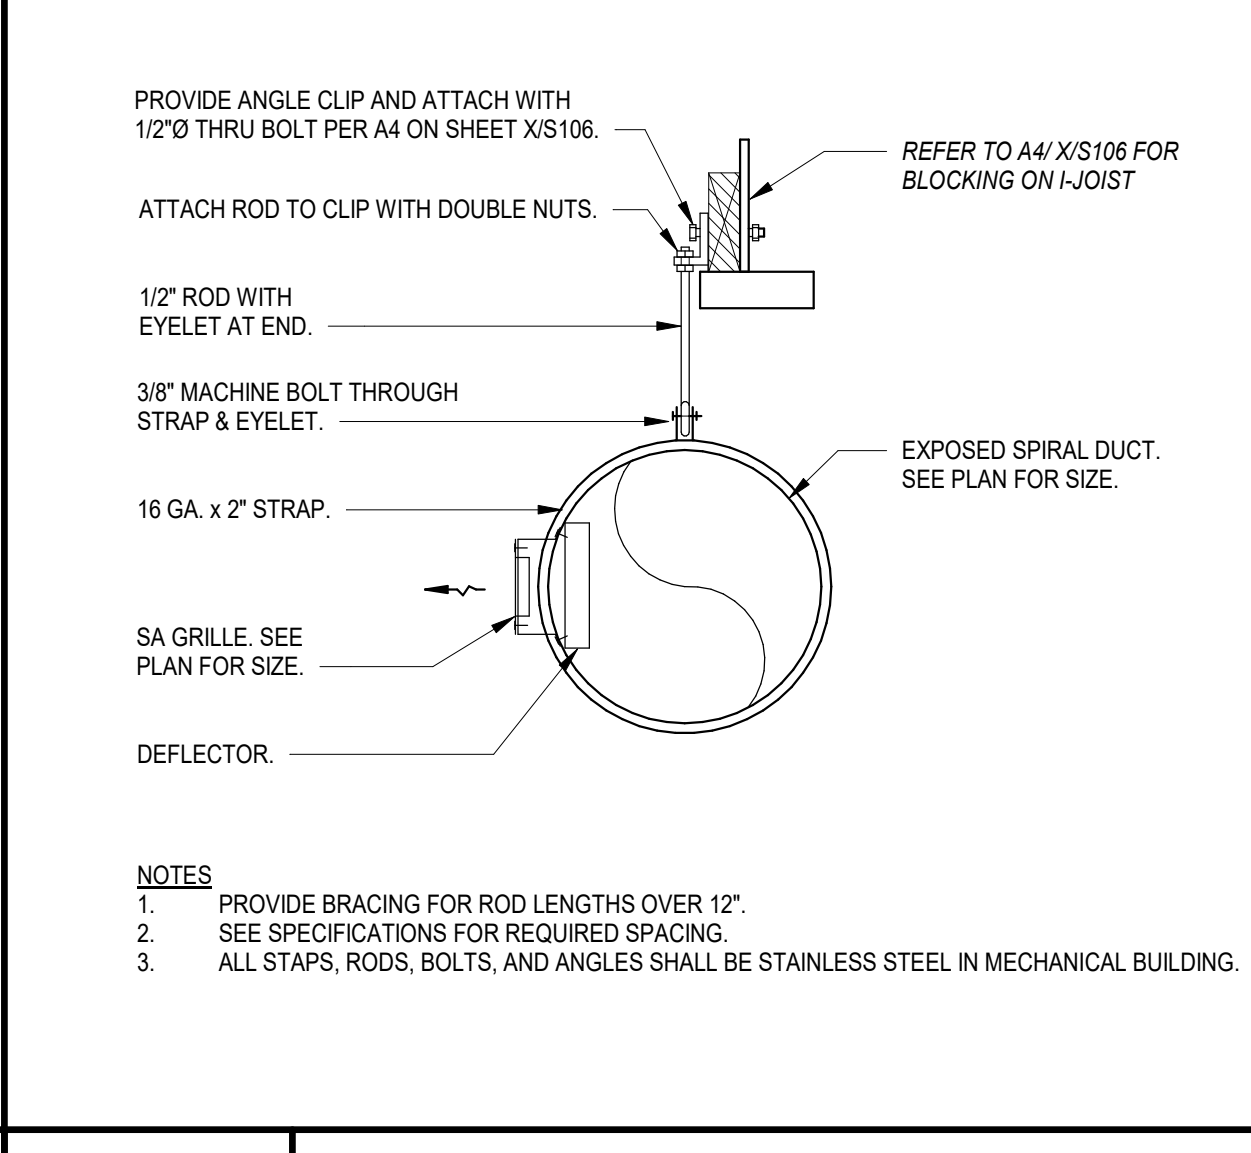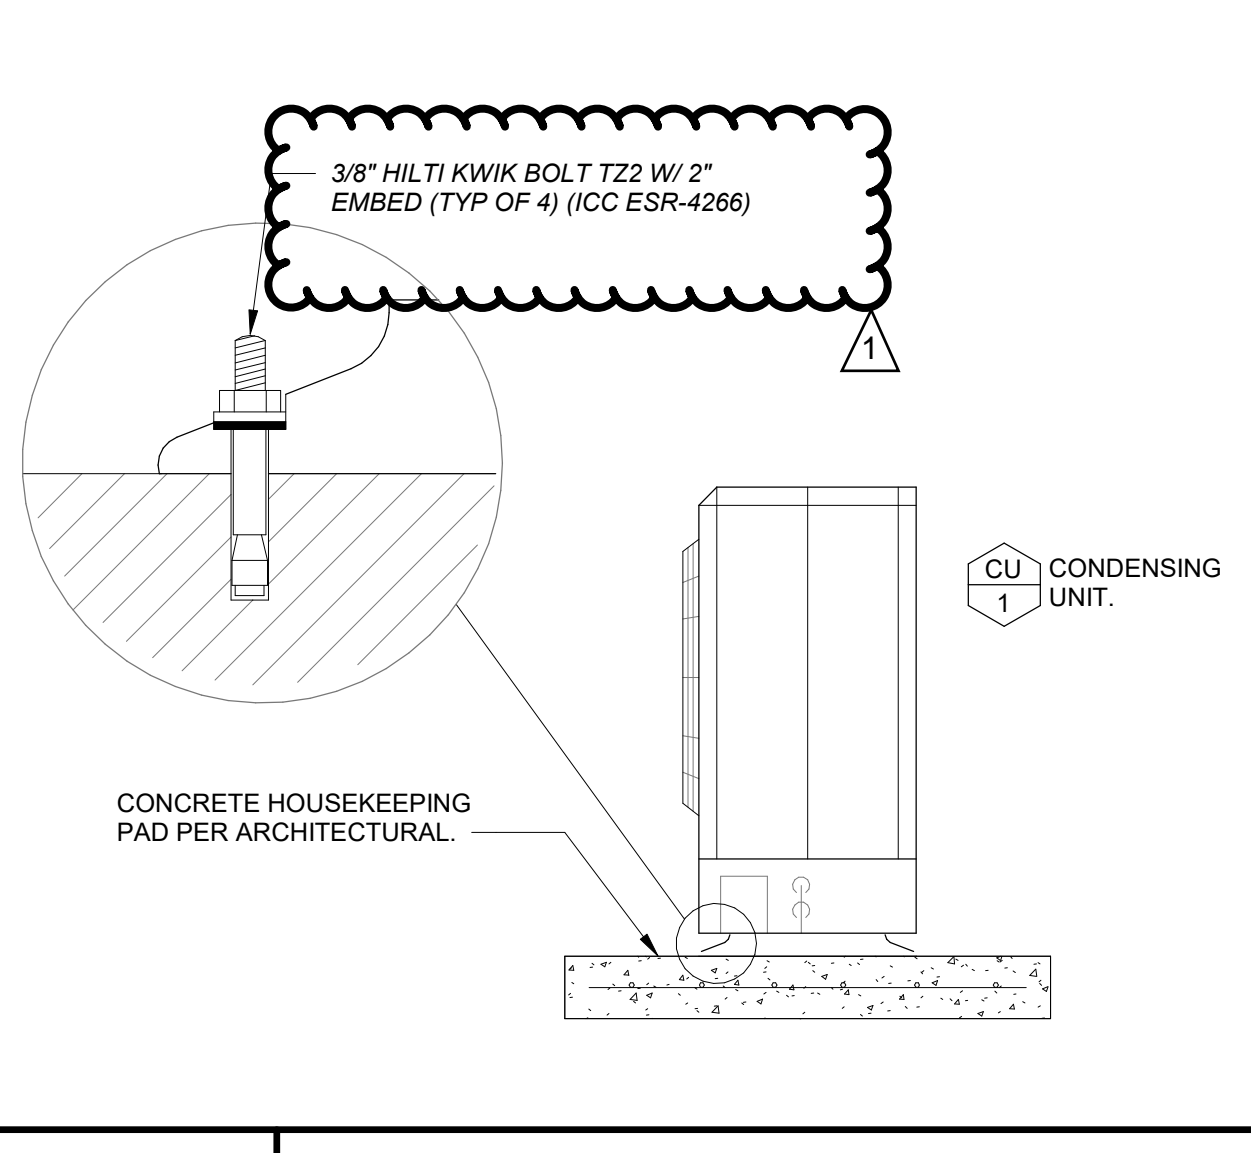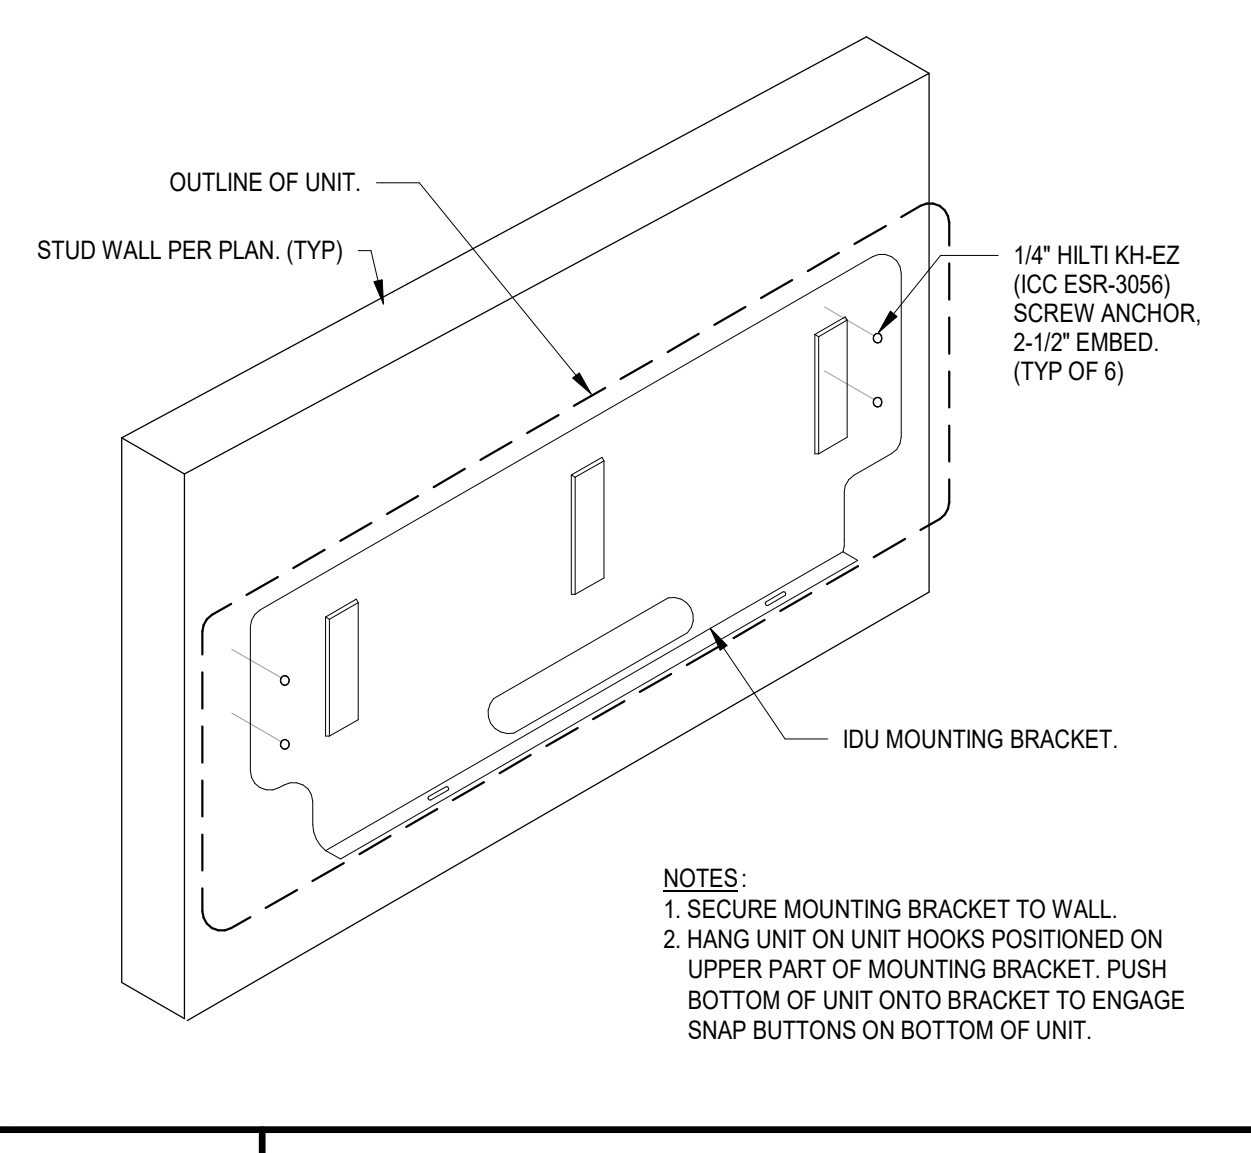

J7 HIGH WALL UNIT ON CMU WALL
 N.T.S.

J11 CONDENSING UNIT ON CONCRETE PAD
 N.T.S.



J14 DUCT-MOUNTED GRILLE
 N.T.S.

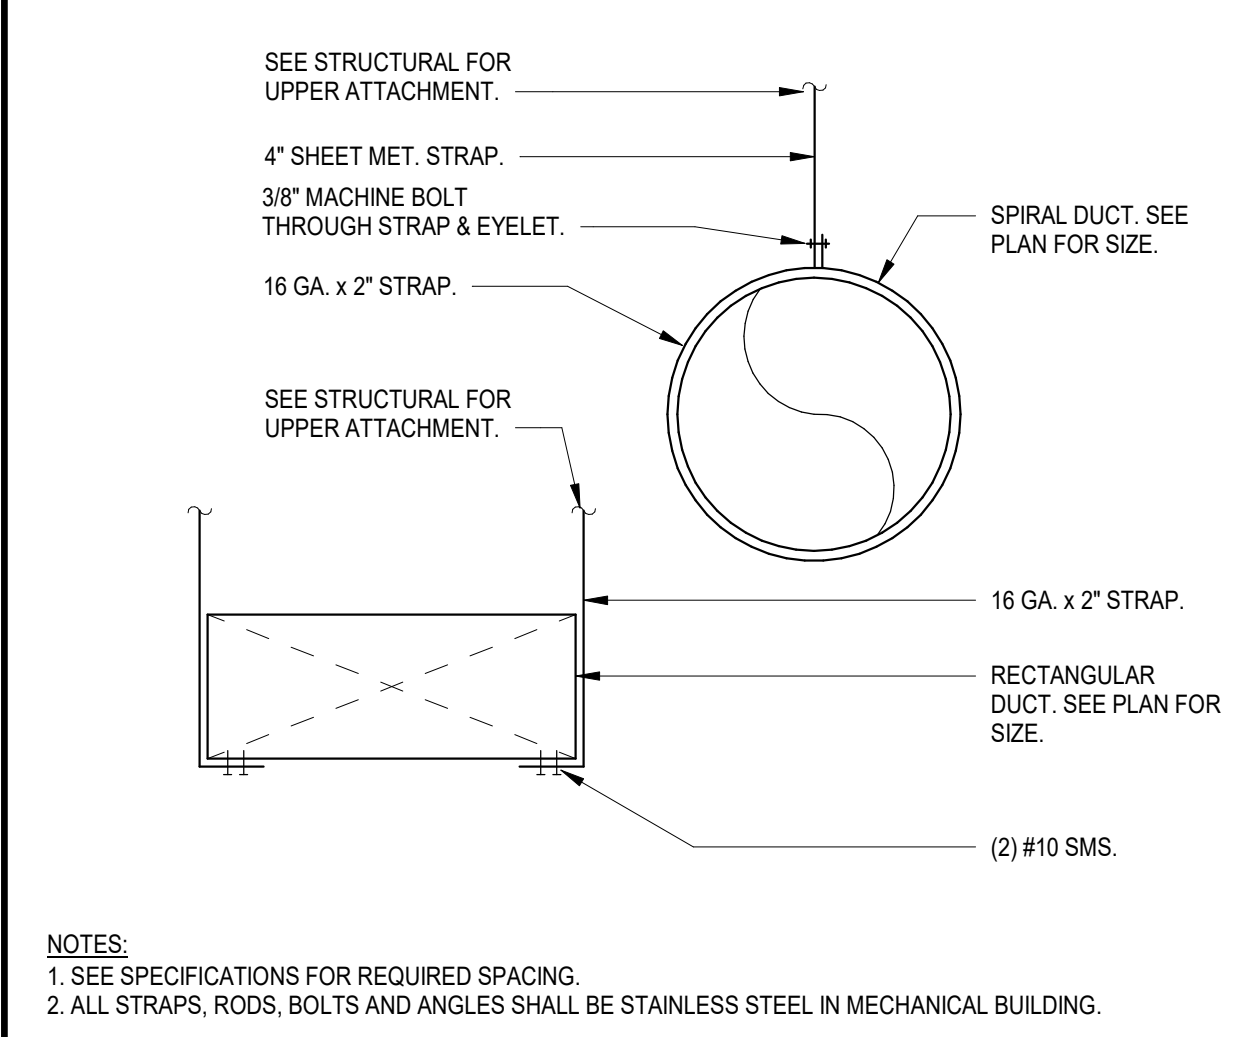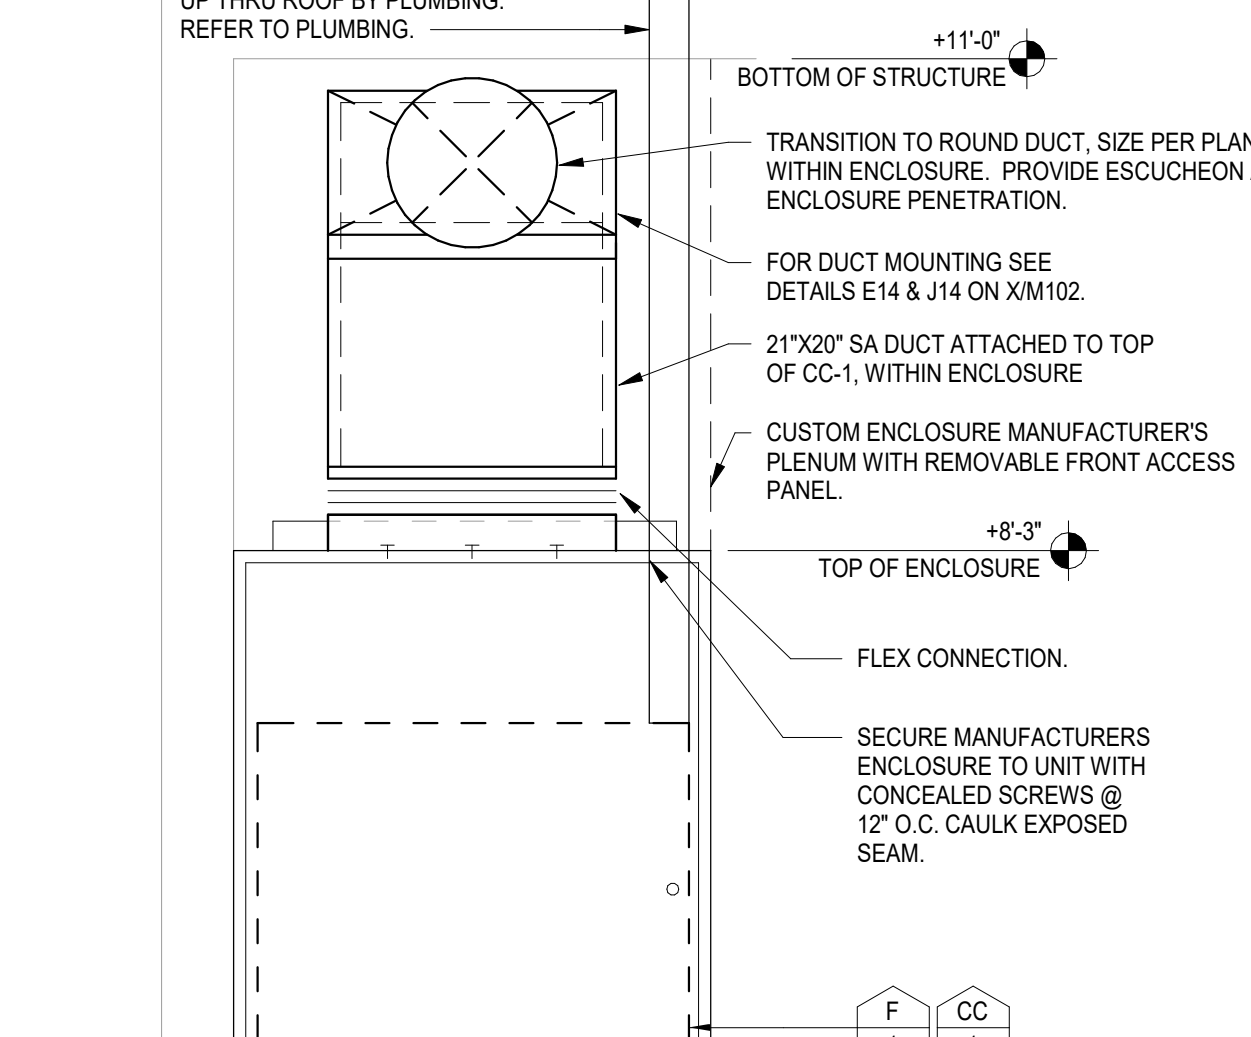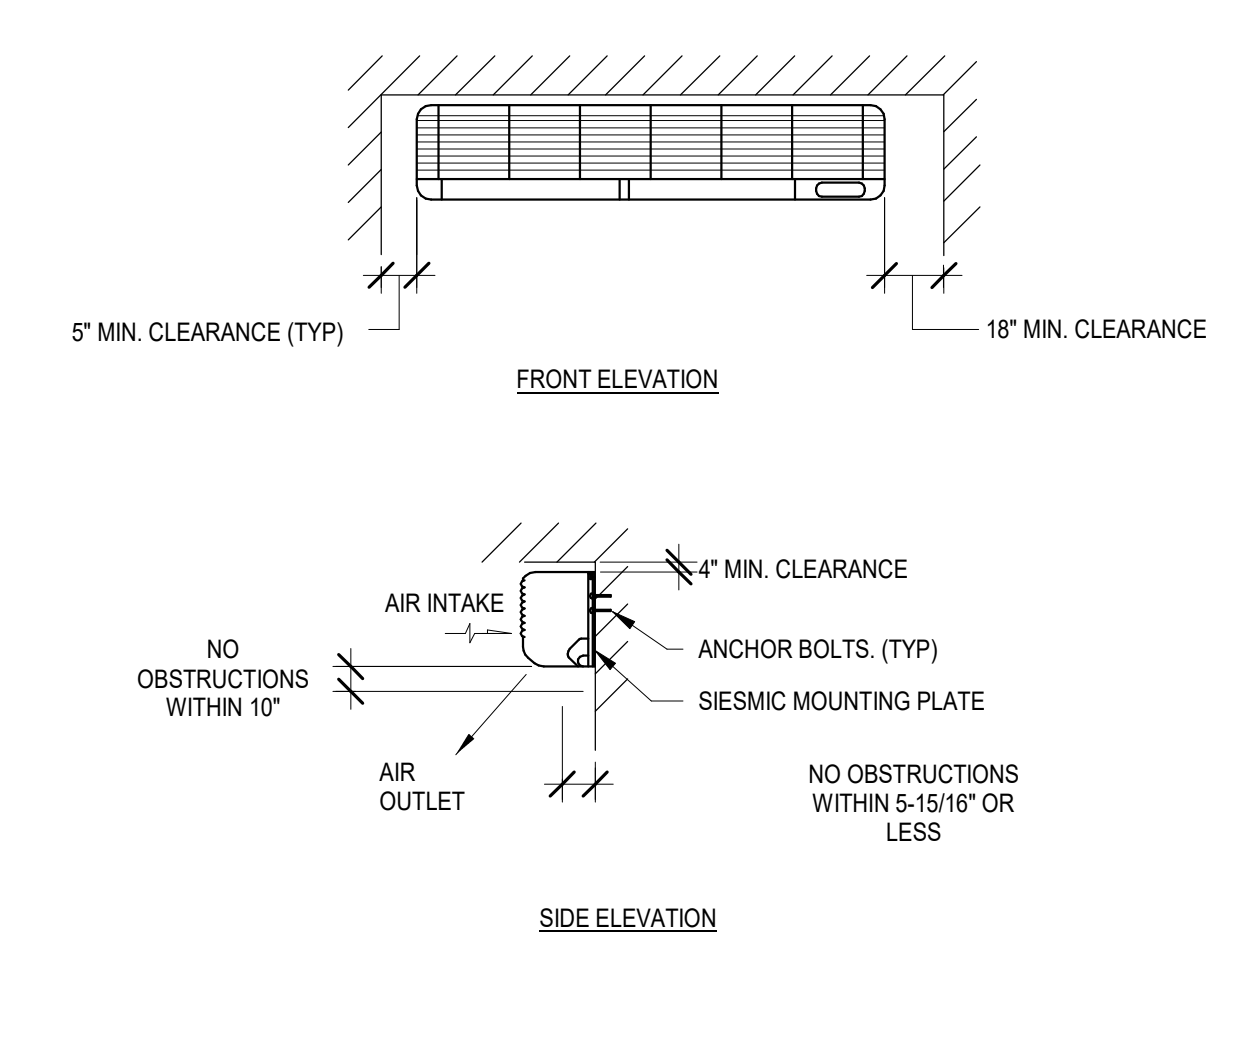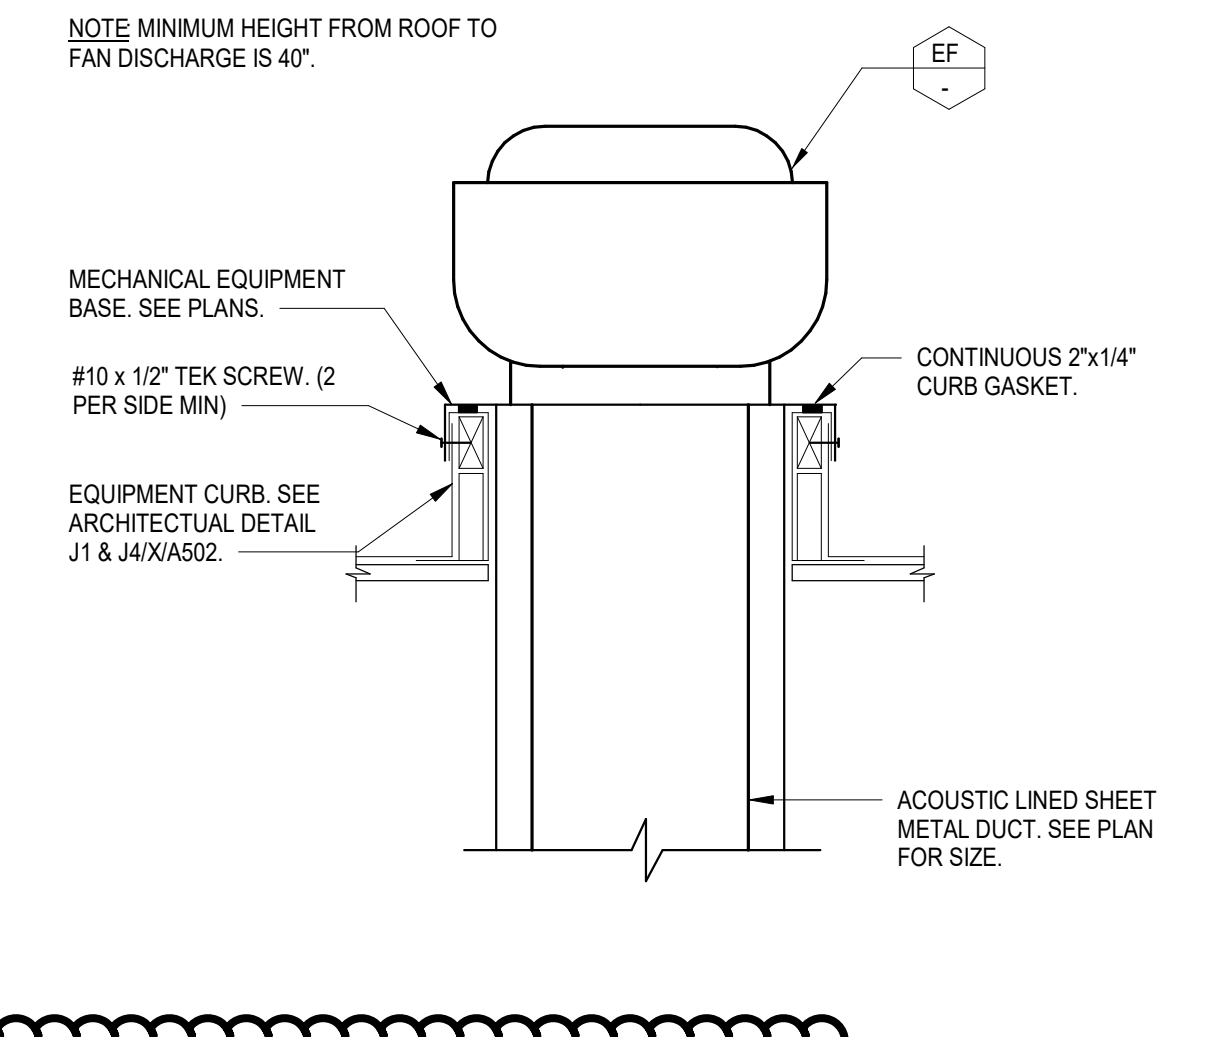

E4 ROOF TOP EXHAUST FAN
 N.T.S.

E7 HIGH WALL CLEARANCES
 N.T.S.

E14 DUCT SUPPORT
 N.T.S.

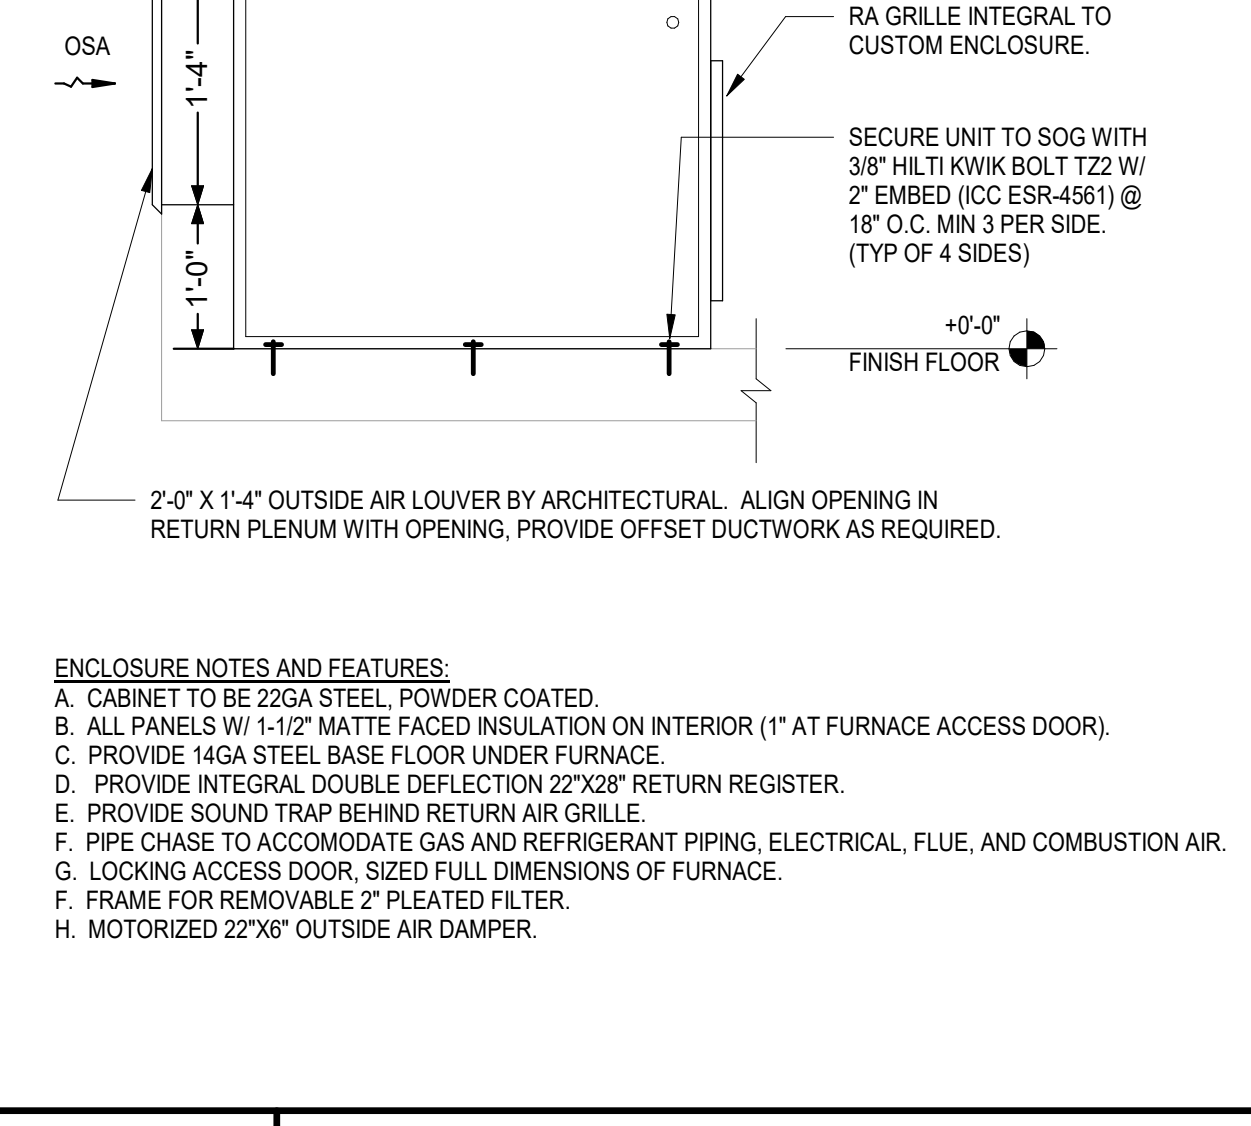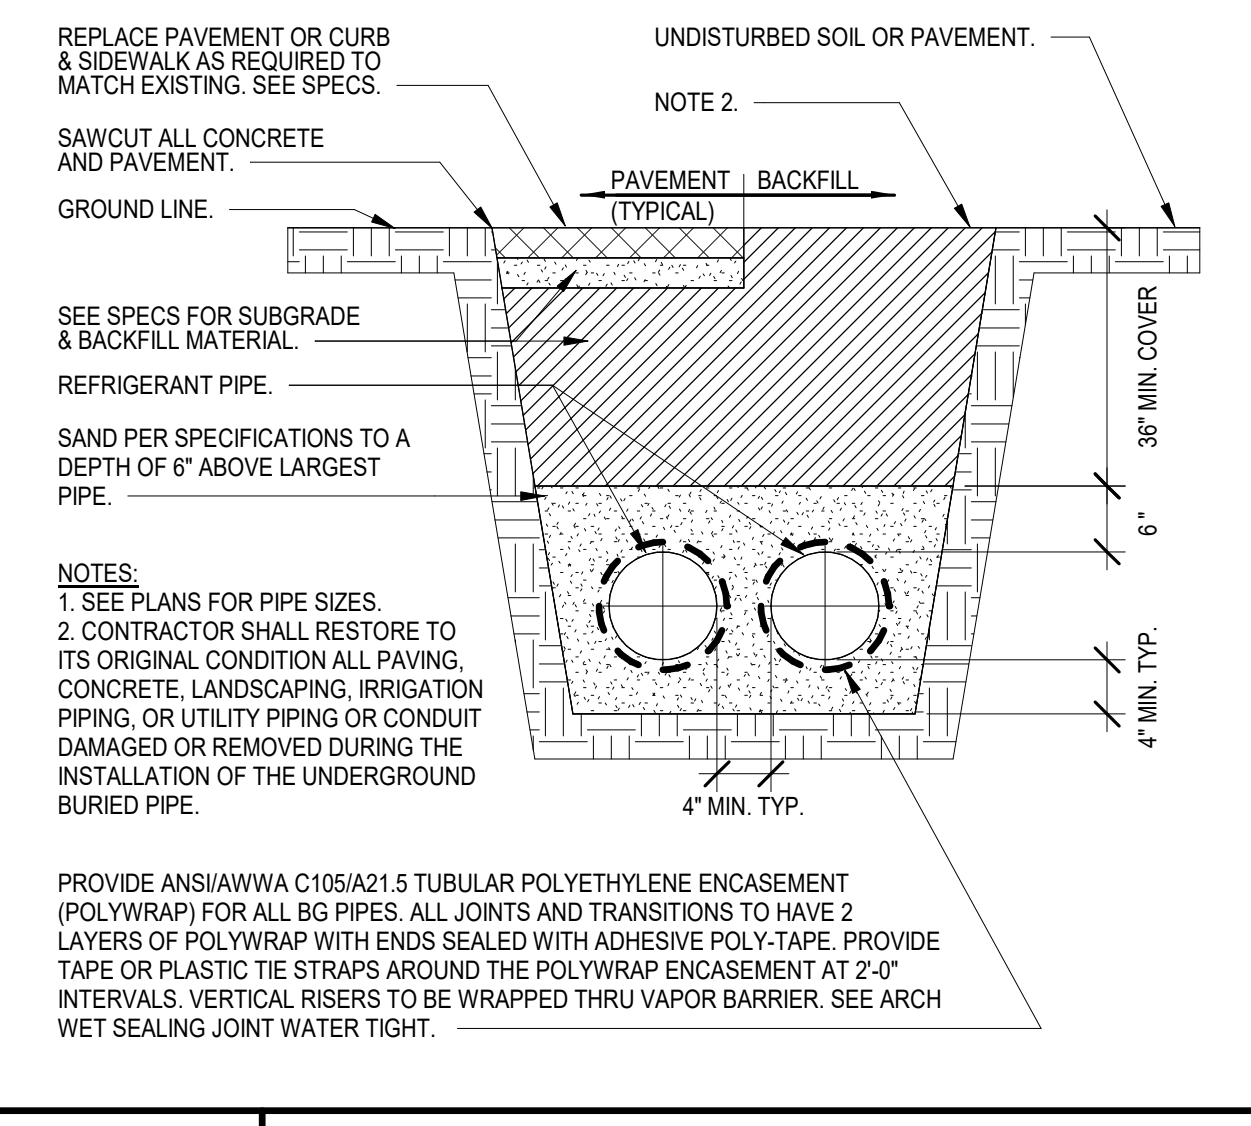

A7 TYPICAL UTILITY TRENCH
 N.T.S.

A11 CLASSROOM UNIT IN CUSTOM ENCLOSURE
 N.T.S.

A14 PIPE PENETRATION COVER
 N.T.S.

DSA File No.:
 DSA File
 DSA Application No.:
 02-120251
 Agency Approval

NET POSITIVE
 consulting
 engineers
 www.NPComp.com
 project no. 1101
 CONSULTANT

Mission Oak HS Aquatic Complex
 Tulare Joint Union High School District
 Tulare, CA 93274
 PROJECT

TYPICAL INFORMATION
 MECHANICAL DETAILS
 DRAWING

darden ARCHITECTURE
 PLANNING
 INTERIORS
 www.dardenarchitects.com
 6790 N. West Ave. • Fresno, CA 93711 • T. 559.448.8051
 ARCHITECT

No.	Revision/Submission	Date
1	REVISION_01	05/31/2023

Revision

Designed By: JCS
 Copyright 2022 Darden Architects
 Scale: As indicated
 Drawn By: HB
 Project Number: 2180
 Checked By: JCS
 Date: 07/13/2022
 Reviewed By: JCS

X/M102

STATE OF CALIFORNIA CALIFORNIA ENERGY COMMISSION
Mechanical Systems
CERTIFICATE OF COMPLIANCE
Project Name: Mission Oak HS Aquatic Complex
Report Page: (Page 14 of 14)
Date Prepared: 2023-05-25T18:22:05-04:00

D. DECLARATION OF REQUIRED CERTIFICATES OF ACCEPTANCE
Selections have been made based on information provided in previous tables of this document. If any selection needs to be changed, please explain why in Table E, Additional Remarks.

Table with 2 columns: Mandatory Measure, Compliance with Mandatory Measures documented through MCH. Rows include Heating Equipment Efficiency, Control Equipment Efficiency, Furnace Standby Loss Control, Heat Pump with Supplemental Electric Resistance Heater Controls, and Kitchen range hoods.

CA Building Energy Efficiency Standards - 2022 Nonresidential Compliance
Report Version: 2022.0.000
Compliance ID: 110361-0523-0004
Report Generated: 2023-05-25 13:33:03

STATE OF CALIFORNIA CALIFORNIA ENERGY COMMISSION
Domestic Water Heating System
CERTIFICATE OF COMPLIANCE
Project Name: Mission Oak HS Aquatic Complex
Report Page: (Page 3 of 8)
Date Prepared: 2023-05-25T18:22:05-04:00

F. DOMESTIC HOT WATER EQUIPMENT
Table with columns: System Name, Equipment Type, Volume, Capacity, Max GPM, First Hour Rating, Rated Efficiency, Minimum Efficiency Required, Efficiency Unit, Designated Standby Loss, Maximum Standby Loss.

CA Building Energy Efficiency Standards - 2022 Nonresidential Compliance
Report Version: 2022.0.000
Compliance ID: 110361-0523-0004
Report Generated: 2023-05-25 15:22:06

STATE OF CALIFORNIA CALIFORNIA ENERGY COMMISSION
Domestic Water Heating System
CERTIFICATE OF COMPLIANCE
Project Name: Mission Oak HS Aquatic Complex
Report Page: (Page 7 of 8)
Date Prepared: 2023-05-25T18:22:05-04:00

I. DECLARATION OF REQUIRED CERTIFICATES OF INSTALLATION
Selections have been made based on information provided in this document. If any selection has been changed by permit applicant, an explanation should be included in Table E, Additional Remarks.

L. DECLARATION OF REQUIRED CERTIFICATES OF VERIFICATION
There are no forms required for this project.

CA Building Energy Efficiency Standards - 2022 Nonresidential Compliance
Report Version: 2022.0.000
Compliance ID: 110361-0523-0004
Report Generated: 2023-05-25 15:22:06

STATE OF CALIFORNIA CALIFORNIA ENERGY COMMISSION
Mechanical Systems
CERTIFICATE OF COMPLIANCE
Project Name: Mission Oak HS Aquatic Complex
Report Page: (Page 14 of 14)
Date Prepared: 2023-05-25T18:22:05-04:00

DOCUMENTATION AUTHOR'S DECLARATION STATEMENT
I certify that this Certificate of Compliance documentation is accurate and complete.

RESPONSIBLE PERSON'S DECLARATION STATEMENT
I certify the following under penalty of perjury, under the laws of the State of California:

CA Building Energy Efficiency Standards - 2022 Nonresidential Compliance
Report Version: 2022.0.000
Compliance ID: 110361-0523-0003
Report Generated: 2023-05-25 13:33:03

STATE OF CALIFORNIA CALIFORNIA ENERGY COMMISSION
Domestic Water Heating System
CERTIFICATE OF COMPLIANCE
Project Name: Mission Oak HS Aquatic Complex
Report Page: (Page 4 of 8)
Date Prepared: 2023-05-25T18:22:05-04:00

F. DOMESTIC HOT WATER EQUIPMENT
Table with columns: System Name, Equipment Type, Volume, Capacity, Max GPM, First Hour Rating, Rated Efficiency, Minimum Efficiency Required, Efficiency Unit, Designated Standby Loss, Maximum Standby Loss.

CA Building Energy Efficiency Standards - 2022 Nonresidential Compliance
Report Version: 2022.0.000
Compliance ID: 110361-0523-0004
Report Generated: 2023-05-25 15:22:06

STATE OF CALIFORNIA CALIFORNIA ENERGY COMMISSION
Domestic Water Heating System
CERTIFICATE OF COMPLIANCE
Project Name: Mission Oak HS Aquatic Complex
Report Page: (Page 7 of 8)
Date Prepared: 2023-05-25T18:22:05-04:00

I. DECLARATION OF REQUIRED CERTIFICATES OF INSTALLATION
Selections have been made based on information provided in this document. If any selection has been changed by permit applicant, an explanation should be included in Table E, Additional Remarks.

L. DECLARATION OF REQUIRED CERTIFICATES OF VERIFICATION
There are no forms required for this project.

CA Building Energy Efficiency Standards - 2022 Nonresidential Compliance
Report Version: 2022.0.000
Compliance ID: 110361-0523-0004
Report Generated: 2023-05-25 15:22:06

STATE OF CALIFORNIA CALIFORNIA ENERGY COMMISSION
Domestic Water Heating System
CERTIFICATE OF COMPLIANCE
Project Name: Mission Oak HS Aquatic Complex
Report Page: (Page 1 of 8)
Date Prepared: 2023-05-25T18:22:05-04:00

A. GENERAL INFORMATION
01 Project Location (City): Tulare
02 Climate Zone: 13
03 Occupancy Types Within Project (select all that apply):
School or Classroom

B. PROJECT SCOPE
This table includes domestic water heating systems that are within the scope of the permit application and are demonstrating compliance using the prescriptive paths outlined in 140.1/170.2(a) and 141.6(a)/180.1, or 141.0(a)(2)/180.2 for additions or alterations. Solar water heating systems are documented on the NRC-CES compliance document. Combined hydronic water heating systems are documented on the NRC-MCH compliance document.

C. COMPLIANCE RESULTS
Table with columns: Table G, Table H, Table I, Compliance Results. Rows for Domestic Hot Water Equipment, Distribution Systems, Controls.

D. EXCEPTIONAL CONDITIONS
This table is used to document any conditions that are not covered by the prescriptive paths.

CA Building Energy Efficiency Standards - 2022 Nonresidential Compliance
Report Version: 2022.0.000
Compliance ID: 110361-0523-0004
Report Generated: 2023-05-25 15:13:36

STATE OF CALIFORNIA CALIFORNIA ENERGY COMMISSION
Domestic Water Heating System
CERTIFICATE OF COMPLIANCE
Project Name: Mission Oak HS Aquatic Complex
Report Page: (Page 5 of 8)
Date Prepared: 2023-05-25T18:22:05-04:00

G. DOMESTIC HOT WATER DISTRIBUTION SYSTEM
This table is used to demonstrate compliance for nonresidential occupancies with distribution requirements in 120.3 and 140.5. For multifamily and hotel/motel occupancies, compliance is demonstrated with requirements in 120.3(a), 160.4, and 170.2(b).

Table with columns: Fluid Temperature Range, Insulation Mean Rating Temp, Nominal Pipe Diameter, Minimum Insulation Required. Rows for 105-140, 100, 1.0 in or 7.7, 1.5 in or 12.5, 1.5 in or 8.11, 2.0 in or 8.16.

CA Building Energy Efficiency Standards - 2022 Nonresidential Compliance
Report Version: 2022.0.000
Compliance ID: 110361-0523-0004
Report Generated: 2023-05-25 15:22:06

STATE OF CALIFORNIA CALIFORNIA ENERGY COMMISSION
Domestic Water Heating System
CERTIFICATE OF COMPLIANCE
Project Name: Mission Oak HS Aquatic Complex
Report Page: (Page 6 of 8)
Date Prepared: 2023-05-25T18:22:05-04:00

I. DECLARATION OF REQUIRED CERTIFICATES OF INSTALLATION
Selections have been made based on information provided in this document. If any selection has been changed by permit applicant, an explanation should be included in Table E, Additional Remarks.

L. DECLARATION OF REQUIRED CERTIFICATES OF VERIFICATION
There are no forms required for this project.

CA Building Energy Efficiency Standards - 2022 Nonresidential Compliance
Report Version: 2022.0.000
Compliance ID: 110361-0523-0004
Report Generated: 2023-05-25 15:22:06

STATE OF CALIFORNIA CALIFORNIA ENERGY COMMISSION
Domestic Water Heating System
CERTIFICATE OF COMPLIANCE
Project Name: Mission Oak HS Aquatic Complex
Report Page: (Page 2 of 8)
Date Prepared: 2023-05-25T18:22:05-04:00

E. ADDITIONAL REMARKS
This table includes remarks made by the permit applicant to the Authority Having Jurisdiction.

CA Building Energy Efficiency Standards - 2022 Nonresidential Compliance
Report Version: 2022.0.000
Compliance ID: 110361-0523-0004
Report Generated: 2023-05-25 15:13:36

STATE OF CALIFORNIA CALIFORNIA ENERGY COMMISSION
Domestic Water Heating System
CERTIFICATE OF COMPLIANCE
Project Name: Mission Oak HS Aquatic Complex
Report Page: (Page 4 of 8)
Date Prepared: 2023-05-25T18:22:05-04:00

H. DOMESTIC HOT WATER CONTROLS
Table with columns: System Name, Equipment Type, Volume, Capacity, Max GPM, First Hour Rating, Rated Efficiency, Minimum Efficiency Required, Efficiency Unit, Designated Standby Loss, Maximum Standby Loss.

CA Building Energy Efficiency Standards - 2022 Nonresidential Compliance
Report Version: 2022.0.000
Compliance ID: 110361-0523-0004
Report Generated: 2023-05-25 15:22:06

STATE OF CALIFORNIA CALIFORNIA ENERGY COMMISSION
Domestic Water Heating System
CERTIFICATE OF COMPLIANCE
Project Name: Mission Oak HS Aquatic Complex
Report Page: (Page 7 of 8)
Date Prepared: 2023-05-25T18:22:05-04:00

I. DECLARATION OF REQUIRED CERTIFICATES OF INSTALLATION
Selections have been made based on information provided in this document. If any selection has been changed by permit applicant, an explanation should be included in Table E, Additional Remarks.

L. DECLARATION OF REQUIRED CERTIFICATES OF VERIFICATION
There are no forms required for this project.

CA Building Energy Efficiency Standards - 2022 Nonresidential Compliance
Report Version: 2022.0.000
Compliance ID: 110361-0523-0004
Report Generated: 2023-05-25 15:22:06

General Notes



Mission Oak HS Aquatic Complex
Tulare Joint Union High School District
Tulare, CA 93274

TYPICAL INFORMATION
TITLE 24 DOCUMENTATION




Table with columns: No., Revision/Submission, Date. Row 1: REVISION_01, 05/31/2023.

Revision
Designed By: JCS
Copyright 2022 Darden Architects
Scale:
Drawn By: HB
Project Number: 2180
Checked By: JCS
Date: 07/13/2022
Reviewed By: JCS

X/M104


J7
N.T.S.

MECHANICAL ROOF PLAN - BASE BID - BUILDING 2

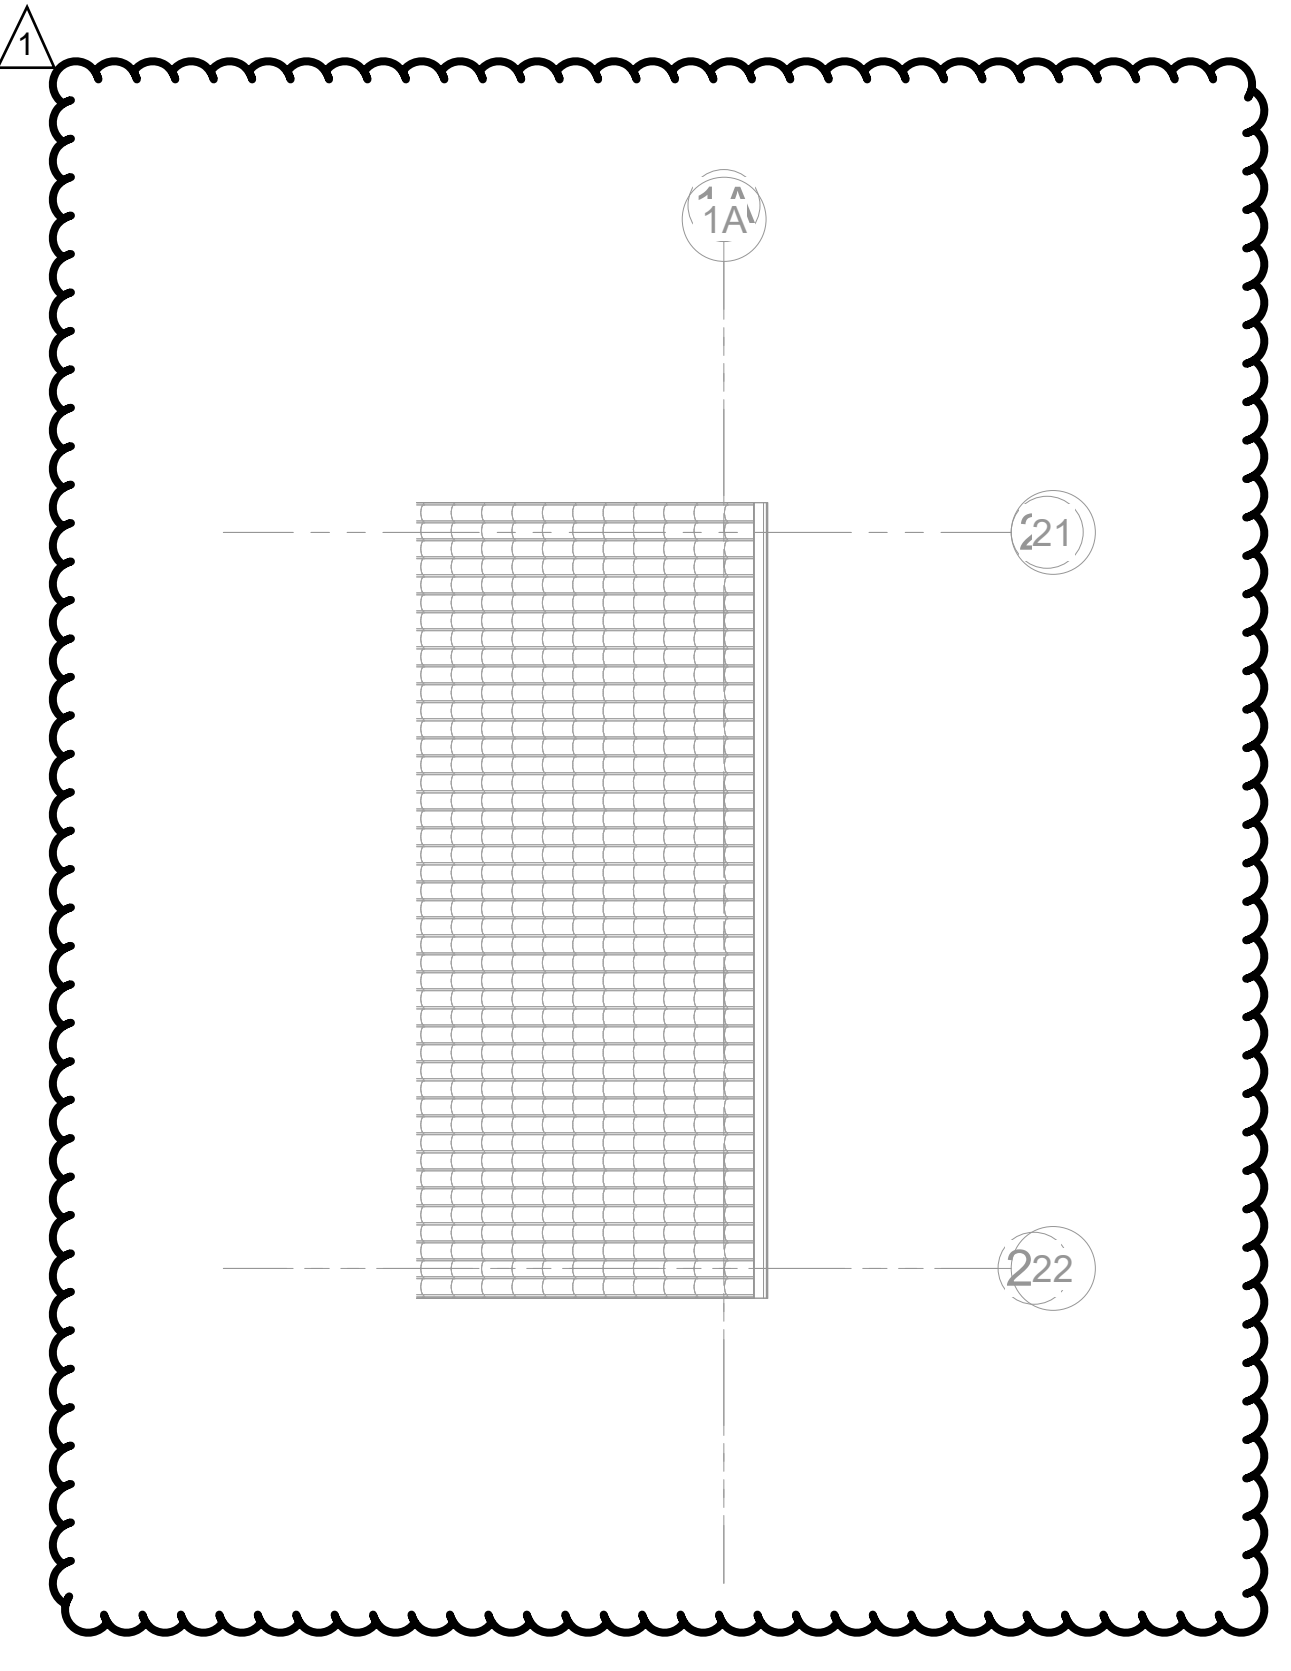



A7
1/8" = 1/4"

MECHANICAL ROOF PLAN - ALT BID - BUILDING P2

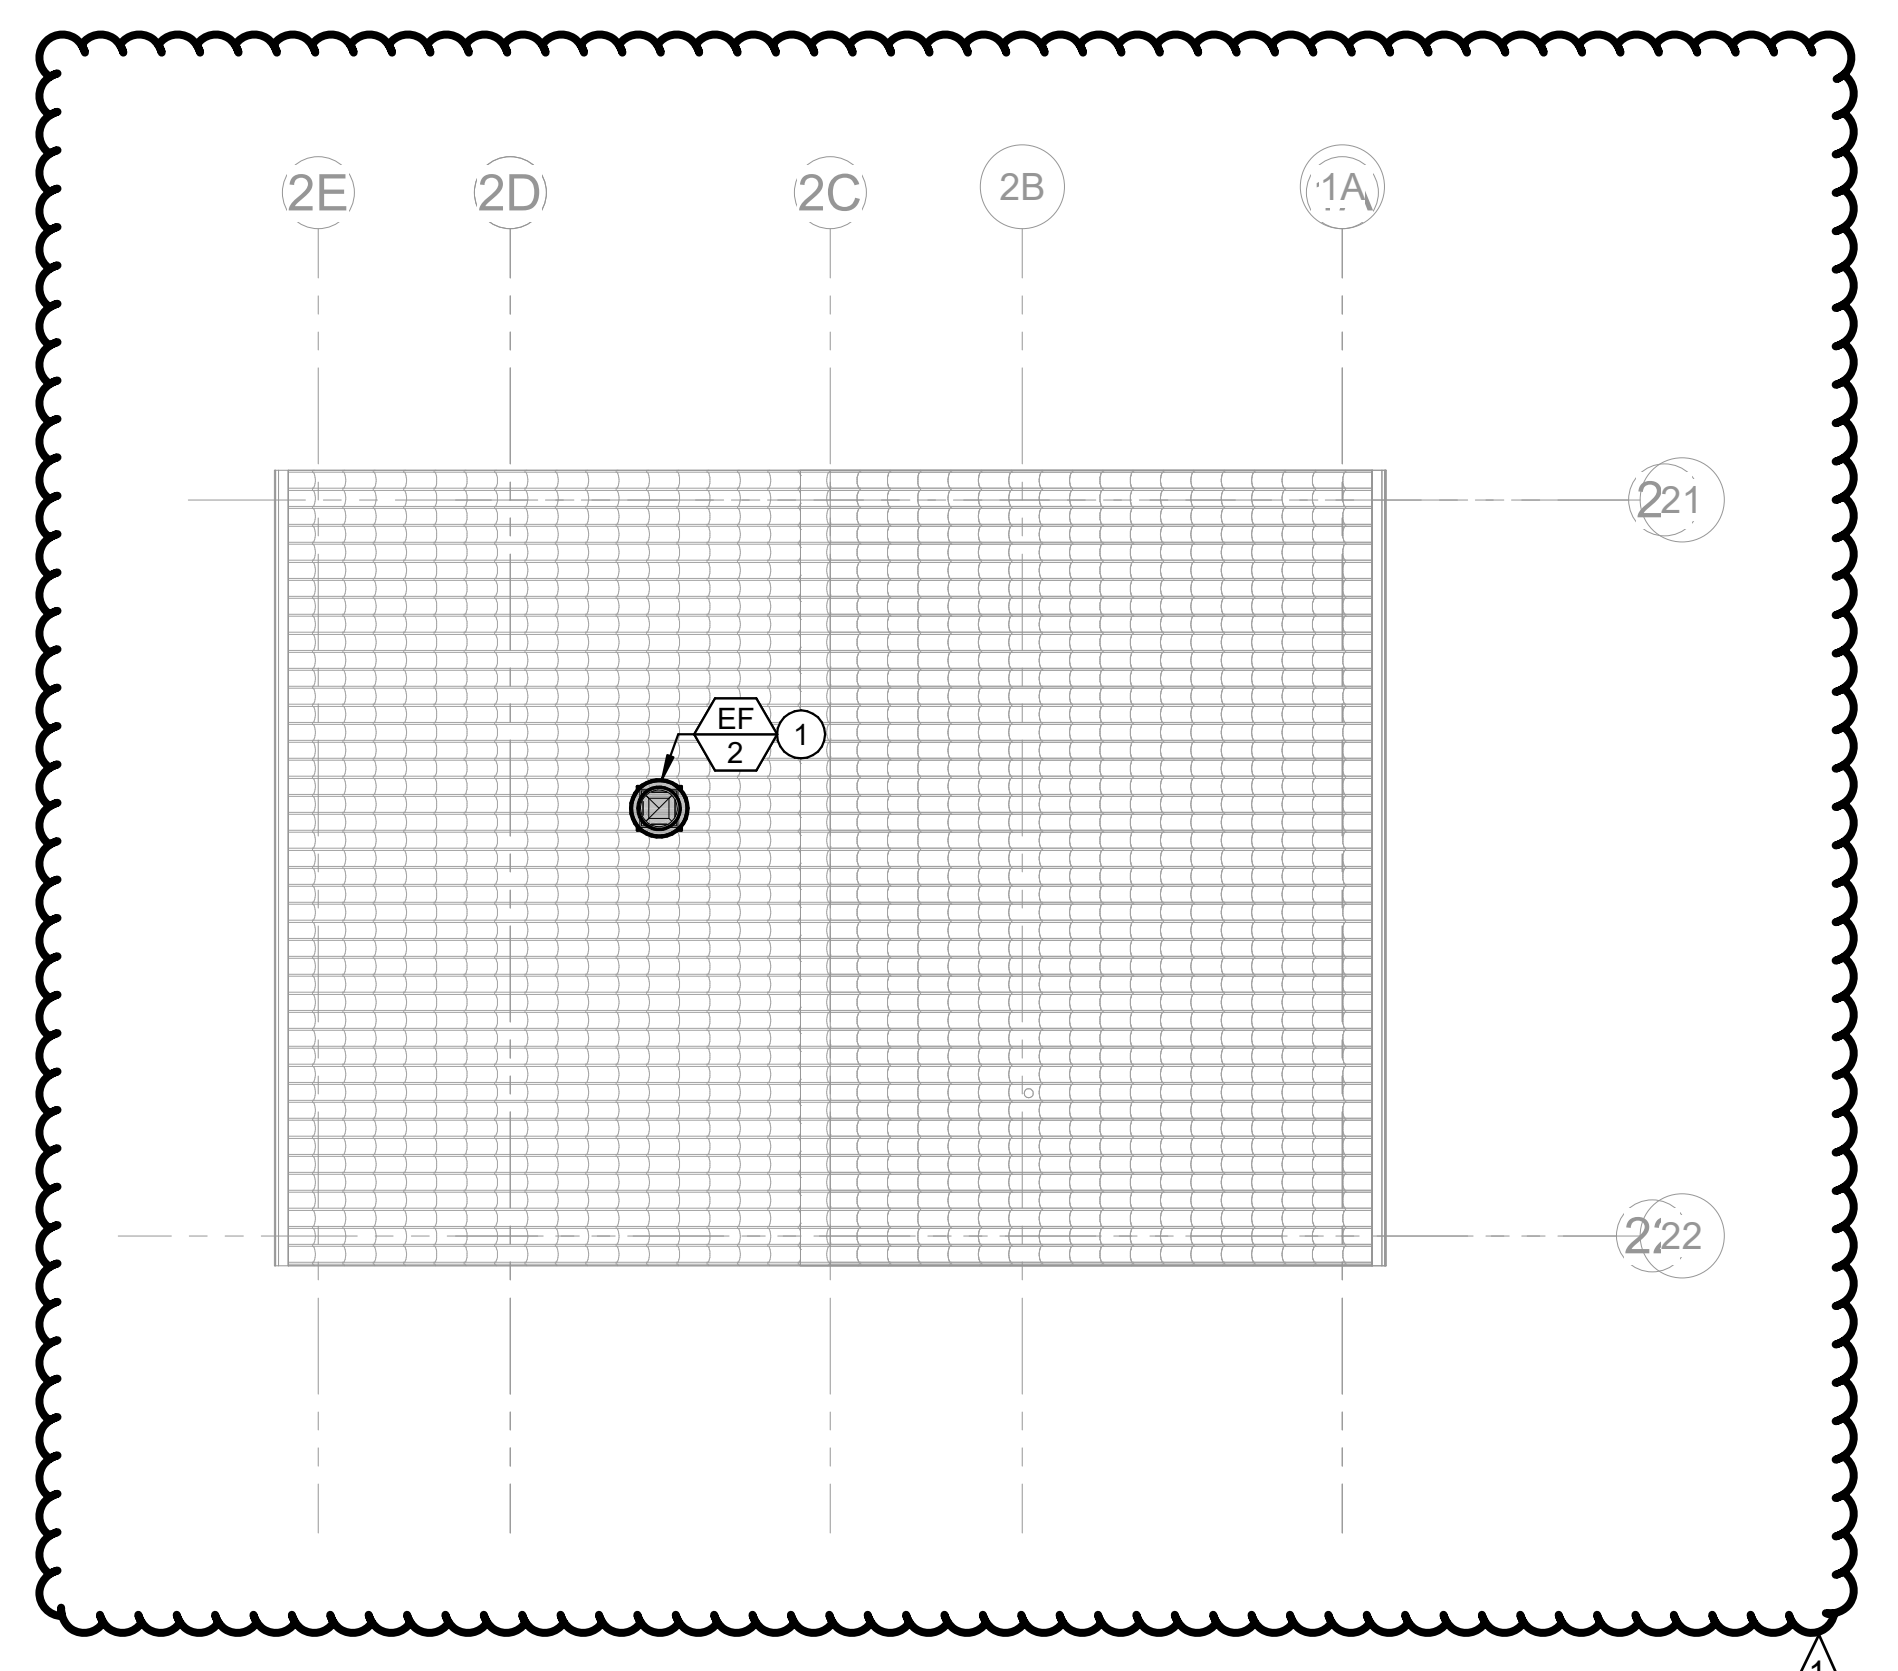

A13
1/8" = 1/4"

MECHANICAL ROOF PLAN - BUILDING P4

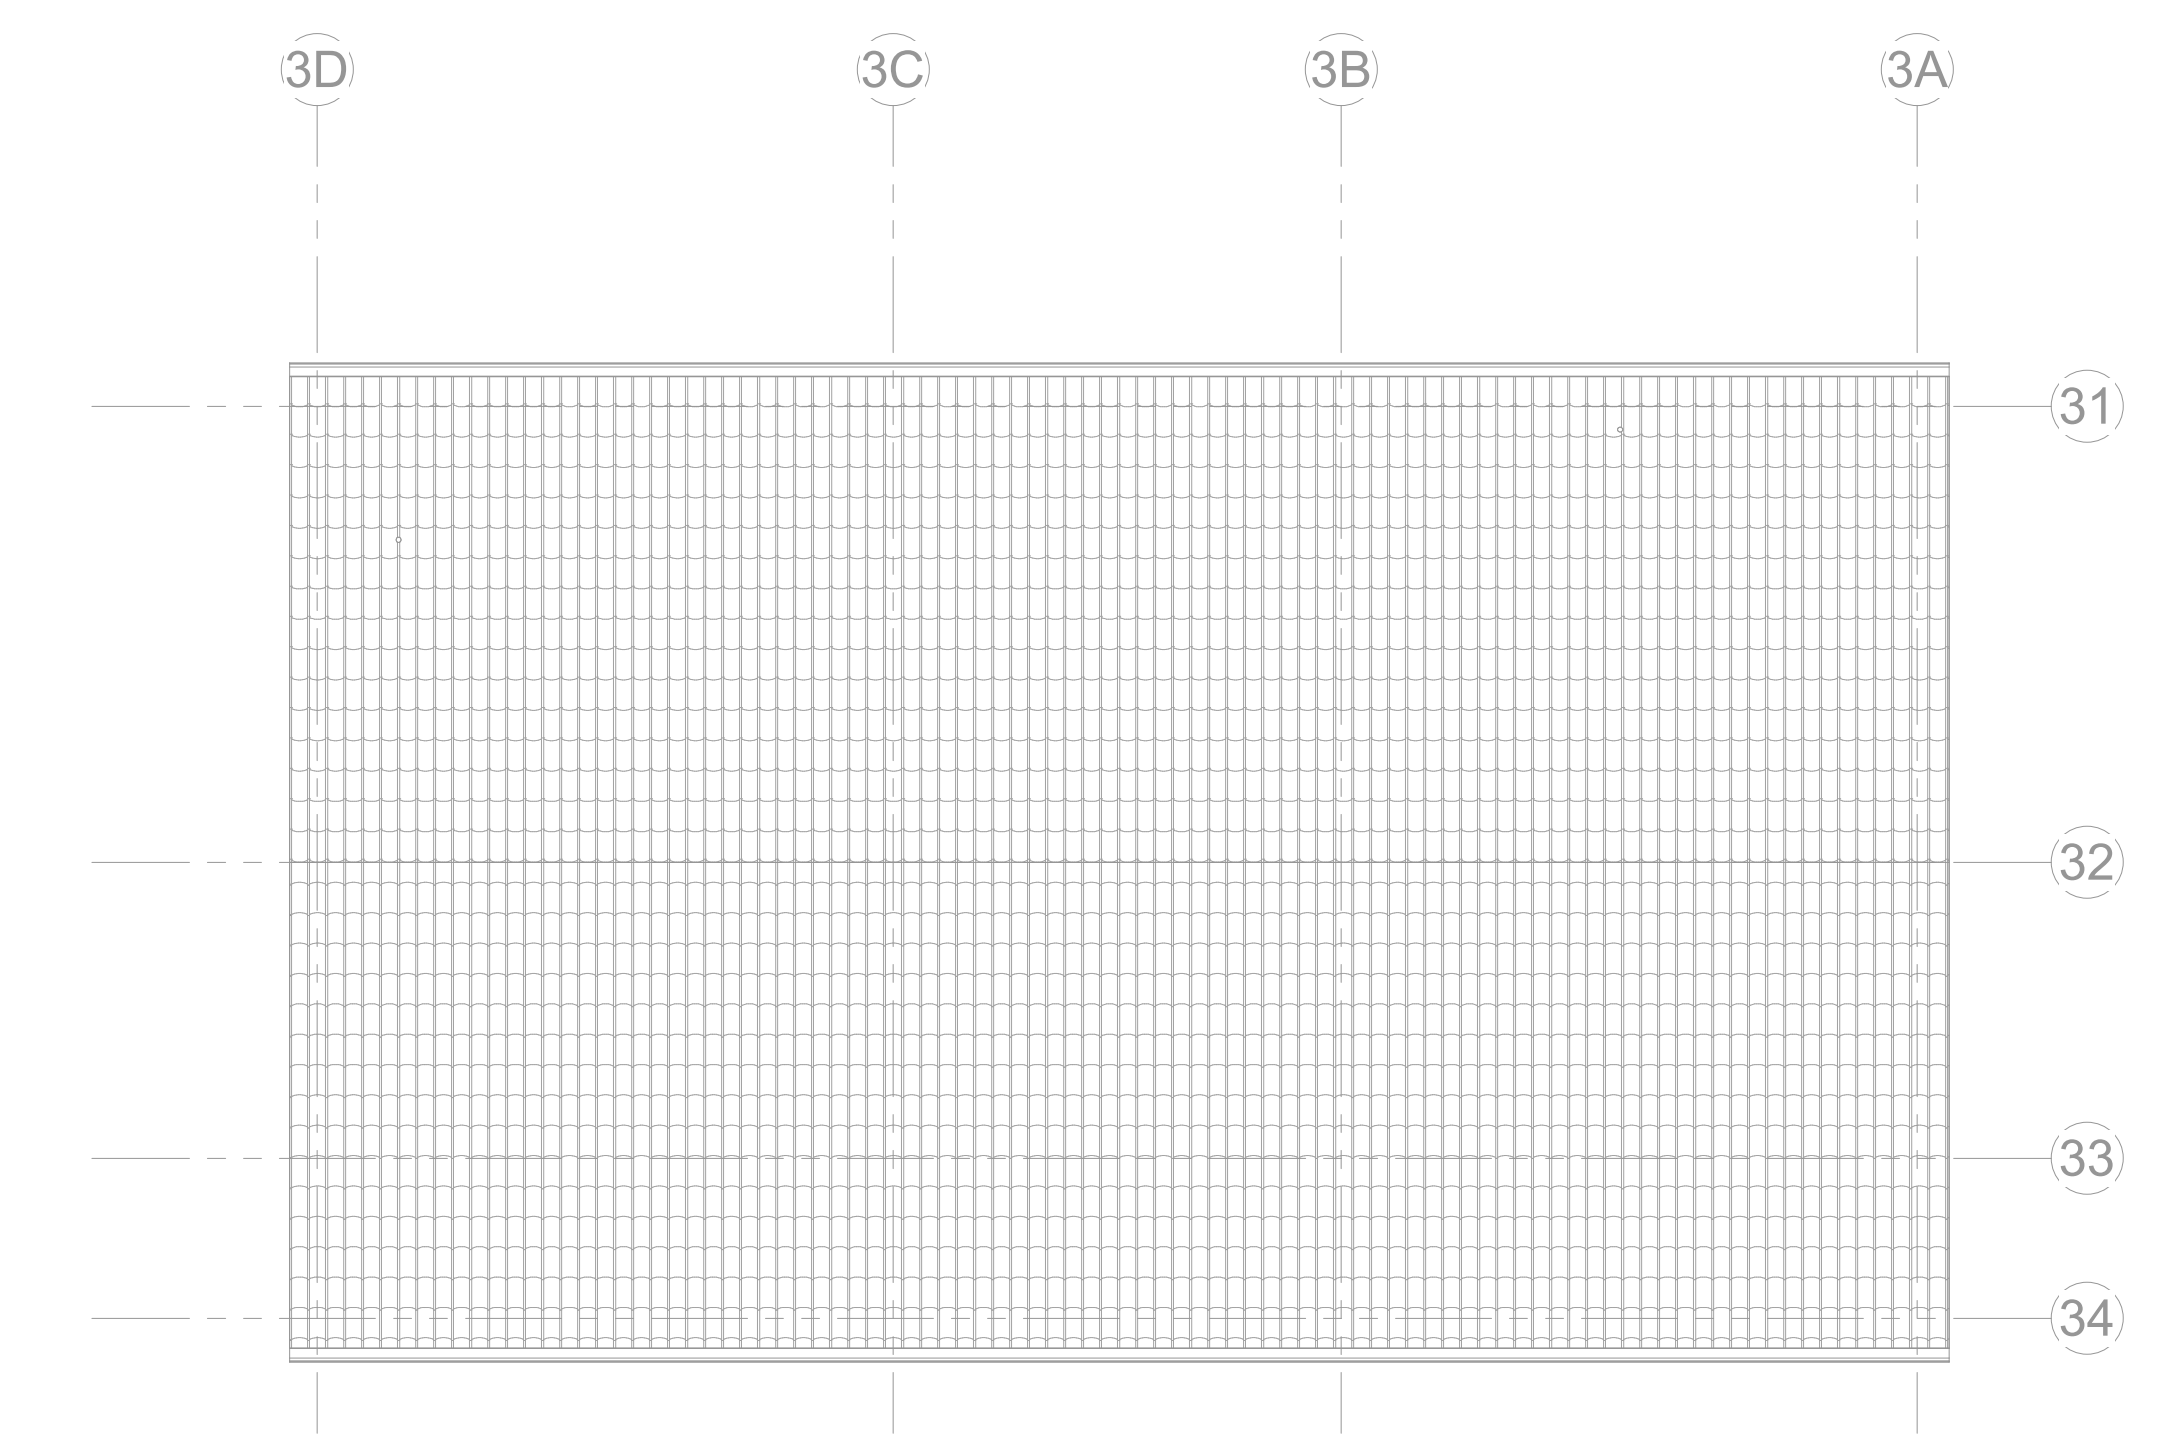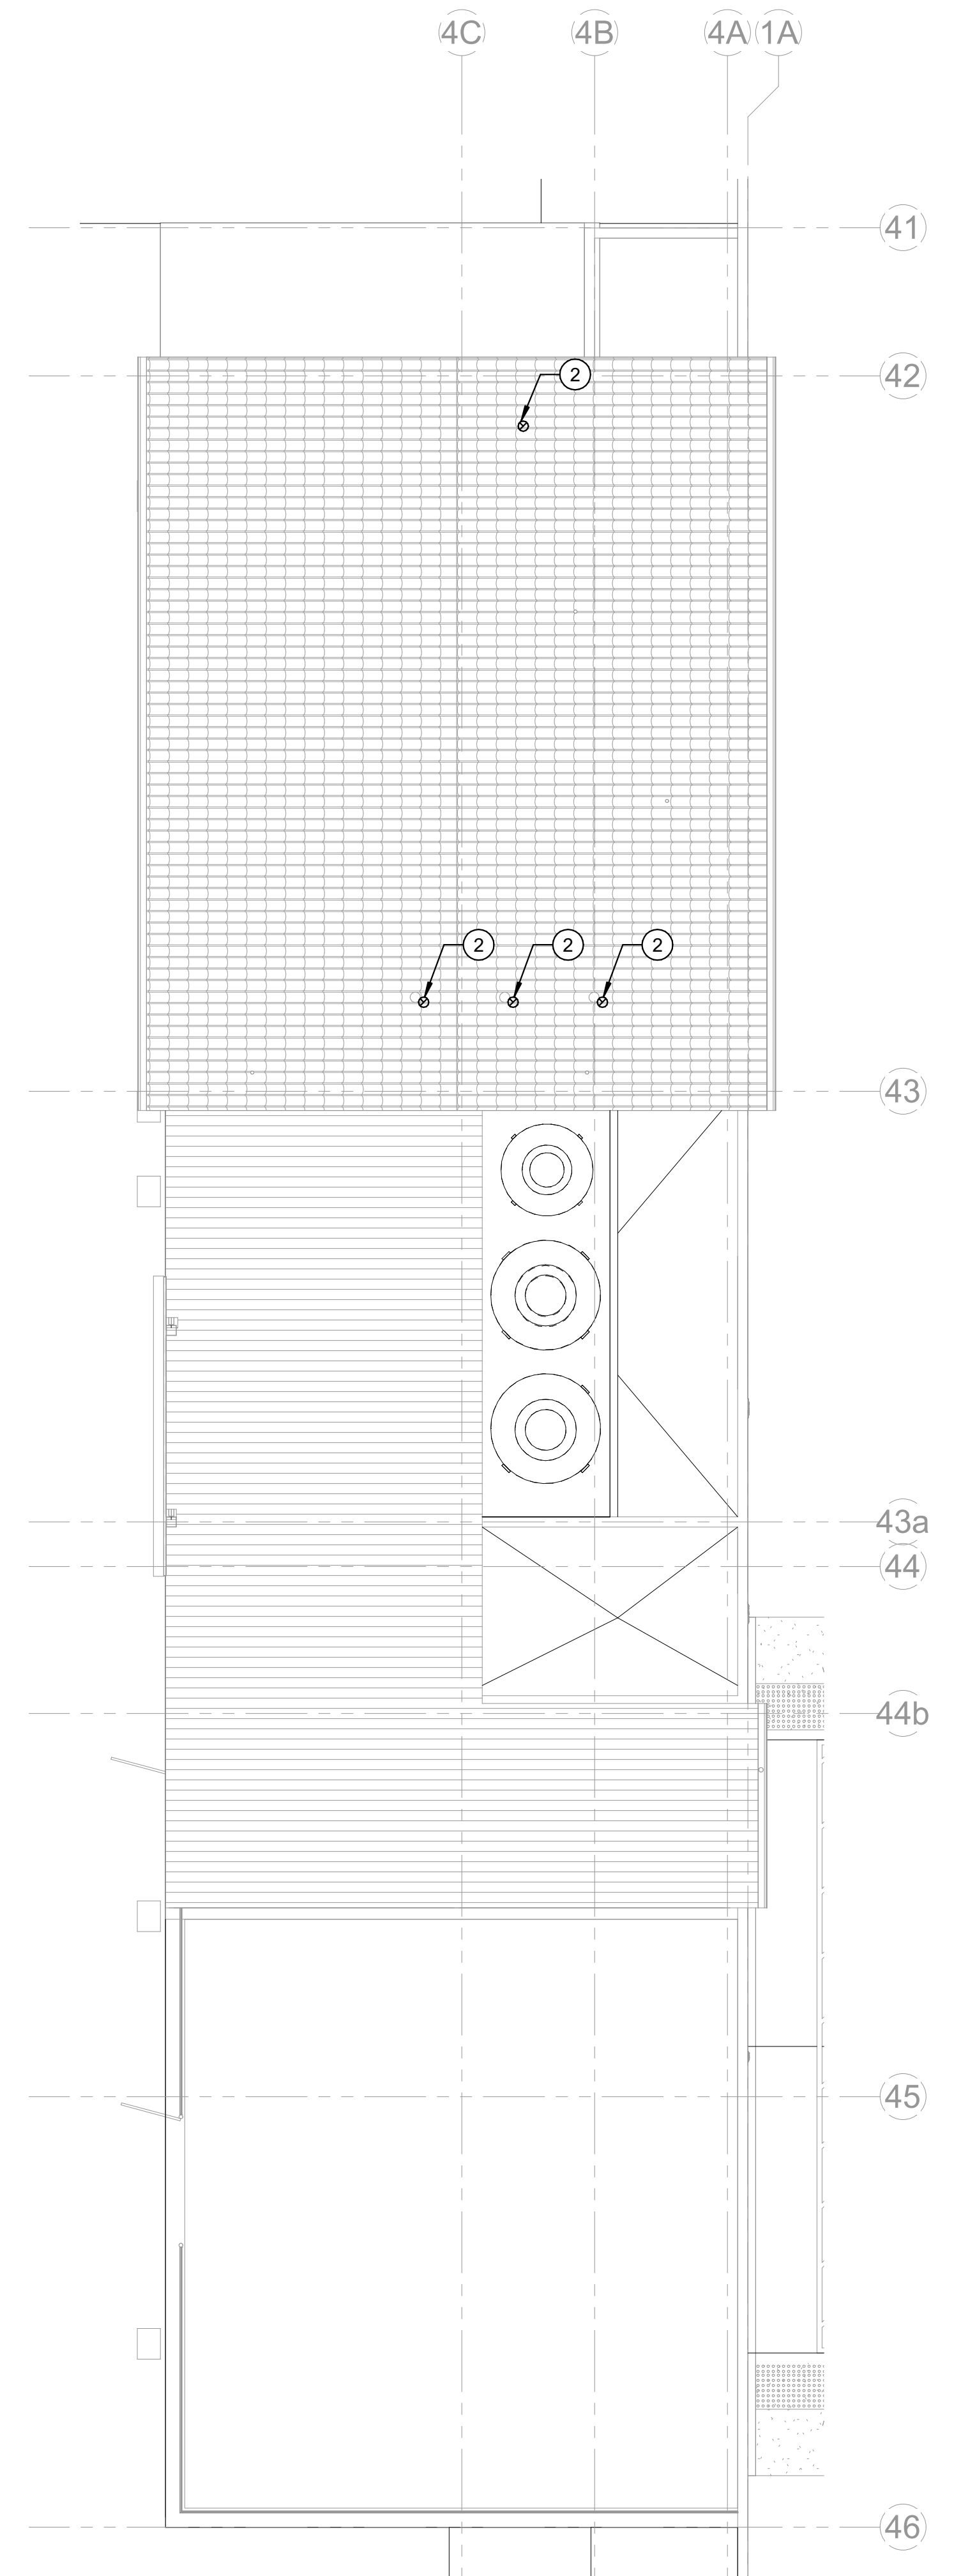

A1
1/8" = 1/4"

MECHANICAL ROOF PLAN - BUILDING P3

DSA File No.:
DSA File

DSA Application No.:
02-120251


Agency Approval

KEYNOTES #

- 1 ROOF MOUNTED EXHAUST FAN MOUNTED ON CURB PER DETAILS E4/X/M102 - J1/X/A502 & J4/X/A502
- 2 8" FLUE WITH CONCENTRIC INTAKE

General Notes

NET POSITIVE
consulting
engineers
www.NPCEng.com
project no. 1101

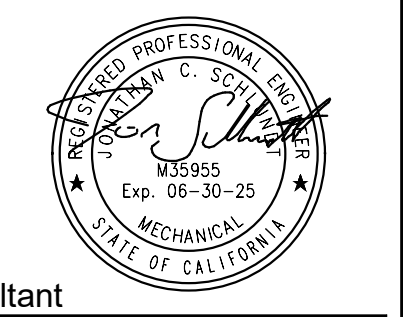

Consultant


Mission Oak HS Aquatic Complex
Tulare Joint Union High School District
Tulare, CA 93274

Project

BUILDING P2, P3, & P4
MECHANICAL ROOF PLANS

Drawing

darden ARCHITECTURE
PLANNING
INTERIORS
architects www.dardenarchitects.com
6790 N. West Ave. • Fresno, CA 93711 • T. 559.448.8051

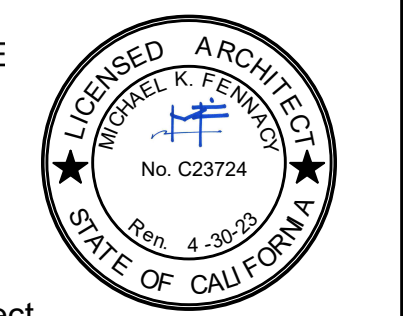

Architect

No.	Revision/Submission	Date
1	REVISION_01	05/31/2023

Revision

Designed By: JCS Copyright 2022 Darden Architects

Scale: As Indicated Drawn By: HB

Project Number: 2180 Checked By: JCS

Date: 07/13/2022 Reviewed By: JCS

P/M301

FIRE PROTECTION SHEET INDEX	
SHEET NUMBER	SHEET NAME
FP001	FIRE PROTECTION - PROJECT INFORMATION
FP002	FIRE PROTECTION - SITE PLAN
FP100	FIRE PROTECTION - PIPING PLANS
FP200	FIRE PROTECTION - REFLECTED CEILING PLANS
FP400	FIRE PROTECTION - BLDG. P2 & P3 SECTION VIEWS
FP401	FIRE PROTECTION - BLDG. P4 SECTION VIEWS
FP500	FIRE PROTECTION - DETAILS

PIPING SYSTEM SCHEDULE			
PRODUCT	MANUFACTURER	SCHEDULE	MATERIAL TYPE
MAINS	WHEATLAND OR EQUAL	SCH 10	STEEL
BRANCHLINES > 1"	WHEATLAND OR EQUAL	SCH 10	STEEL
BRANCHLINES 1" & LESS	WHEATLAND OR EQUAL	SCH 40	STEEL
GROOVED FITTINGS	VICTAULIC OR EQUAL	175 PSI	DUCTILE IRON
THREADED FITTINGS	ANVIL OR EQUAL	175 PSI	DUCTILE IRON

FIRE PROTECTION ABBREVIATIONS

A.D.	ACCESS DOOR
A.F.F.	ABOVE FINISHED FLOOR
ALP.	ALARM PANEL
A.P.	ACCESS PANEL
B.F.F.	BELOW FINISHED FLOOR
B.F.P.	BACKFLOW PREVENTOR
C.P.	CONTROL PANEL
DCDA	DOUBLE CHECK DETECTOR ASSEMBLY
ELEV	ELEVATION
FD	FLOOR DRAIN
FDC	FIRE DEPARTMENT CONNECTION
FHC	FIRE HOSE VALVE CONNECTION (2-1/2")
FHV	FIRE HOSE VALVE
FLR	FLOOR
FS	FLOW SWITCH NORMALLY CLOSED N.C.
N.I.C	NOT TO SCALE
N.T.S.	NOT IN CONTRACT
OS&Y	OUTSIDE STEM AND YOKE GATE VALVE
PSIG	POUNDS PER SQUARE INCH GAUGE
TS	TAMPER SWITCH
TYP.	TYPICAL THROUGHOUT
PIV	POST INDICATOR VALVE

PROJECT TOTAL SPRINKLER SCHEDULE									
Sprinkler Symbol	Count	Manufacturer	Model	Orifice Size	K-Factor	Temperature Rating	Sprinkler Orientation	Finish	
⊙	71	VICTAULIC Inc.	V2704	1/2"	5.6	200 °F	Upright	Brass	
●	30	VICTAULIC Inc.	V3802	1/2"	5.6	155 °F	Pendent	White	

HYDRAULIC CALCULATION CRITERIA

- ALL SPRINKLER SYSTEMS THROUGHOUT THE BUILDING SHALL BE HYDRAULICALLY CALCULATED BASED ON COORDINATED SHOP DRAWINGS.
- SPRINKLER SYSTEM LAYOUT AND CALCULATIONS SHALL COMPLY WITH THE CALIFORNIA BUILDING CODE, NFPA 13, OWNER'S INSURANCE COMPANY REQUIREMENTS AND GOOD ENGINEERING PRACTICE.
- OCCUPANCY CLASSIFICATION:
 - LIGHT HAZARD OCCUPANCY: CLASSROOMS, CORRIDORS, COMMON AREAS.
 - ORDINARY HAZARD GROUP-1 OCCUPANCY: STORAGE, MECHANICAL, ELECTRICAL ROOMS
 - ORDINARY HAZARD GROUP-2 OCCUPANCY: POOL STORAGE
- SPRINKLERS PROTECTING LIGHT HAZARD OCCUPANCY SHALL PROVIDE A MINIMUM DENSITY DISCHARGE OF .10 GPM/SQ.FT. OVER MOST HYDRAULICALLY REMOTE 1,500 SQ.FT., MAXIMUM COVERAGE PER SPRINKLER HEAD- 225 SQ.FT.
- SPRINKLERS PROTECTING ORDINARY HAZARD GROUP-1 OCCUPANCY SHALL PROVIDE A MINIMUM DENSITY DISCHARGE OF .15 GPM/SQ.FT. OVER MOST HYDRAULICALLY REMOTE 1,500 SQ.FT., MAXIMUM COVERAGE PER SPRINKLER HEAD- 130 SQ.FT.
- SPRINKLERS PROTECTING ORDINARY HAZARD GROUP-2 OCCUPANCY SHALL PROVIDE A MINIMUM DENSITY DISCHARGE OF .20 GPM/SQ.FT. OVER MOST HYDRAULICALLY REMOTE 1,500 SQ.FT., MAXIMUM COVERAGE PER SPRINKLER HEAD- 130 SQ.FT.
- MINIMUM PRESSURE AT ANY SPRINKLER HEAD SHALL BE AS REQUIRED BY HYDRAULIC CALCULATIONS BUT IN NO CASE LESS THEN 7-PSI.

GENERAL NOTES

- IT IS THE INTENT OF THESE DRAWINGS AND SPECIFICATIONS FOR THE CONTRACTOR TO FURNISH AND INSTALL A COMPLETE NEW WET FIRE SPRINKLER PROTECTION SYSTEM FOR THE BUILDING IN FULL COMPLIANCE WITH THE STATE OF CALIFORNIA AND BUILDING CODES INCLUDING: VALVES, RISERS, AND ALARMS AS REQUIRED. THIS CONTRACTOR SHALL BE RESPONSIBLE FOR THE FULL INSTALLATION ASPECT OF THE FIRE PROTECTION SYSTEM IN ACCORDANCE WITH APPLICABLE CODES.
- THE ENTIRE INSTALLATION SHALL BE IN ACCORDANCE WITH THE LATEST RULES AND REGULATIONS OF THE AUTHORITIES HAVING JURISDICTION INCLUDING BUT NOT LIMITED TO, STATE BUILDING AND FIRE CODES AND ALL APPENDICES, THE NATIONAL FIRE PROTECTION ASSOCIATION STANDARD NO. 13, 14 & 20 AS ADOPTED BY THE STATE OF CALIFORNIA, AND THE OWNER'S INSURANCE UNDERWRITERS.
- IF THERE ARE ANY QUESTIONS CONCERNING WHAT THE INSURANCE UNDERWRITER WILL REQUIRE IN ORDER TO APPROVE THE COMPLETED INSTALLATION (PIPING SIZING, LOCATION OF RISERS, TEST STATIONS, HYDRANTS, ALARMS, ETC.) THE BIDDER SHALL CONSULT WITH THE INSURANCE UNDERWRITER BEFORE SUBMITTING HIS BID. FAILURE TO CONSULT WITH THE INSURANCE UNDERWRITER DOES NOT RELIEVE THIS CONTRACTOR FROM HIS RESPONSIBILITY BY THE COMPLETION OF ANY AND ALL WORK REQUIRED WITH NO EXTRA CHARGES TO THE OWNER.
- FURNISH ALL MATERIALS, LABOR, TOOLS, EQUIPMENT AND SUPERVISION REQUIRED FOR THE INSTALLATION OF COMPLETE SYSTEMS AND ALL NECESSARY PIPING, SPRINKLER HEADS, TEST CONNECTIONS, VALVES, DRAINS AND SPRINKLER ALARMS, FLOW SWITCHES, HORNS OR GONGS, DETECTOR CHECK VALVES, SIAMESE FIRE DEPARTMENT CONNECTIONS, PRESSURE GAUGES, AND OTHER REQUIRED COMPONENTS.
- ALL MATERIALS EXPOSED WITHIN PLENUMS SHALL BE NONCOMBUSTIBLE OR SHALL HAVE A FLAME SPREAD INDEX OF NOT MORE THAN 25 AND A SMOKE DEVELOPED INDEX OF NOT MORE THAN 50 WHEN TESTED IN ACCORDANCE WITH ASTM E 84. CONTRACTOR SHALL PROVIDE PROOF OF COMPLIANCE WITH THIS REQUIREMENT UPON REQUEST.
- ALL SPRINKLER PIPING SHALL BE CONCEALED IN ALL FINISHED AREAS, AVOIDING INTERFERENCE WITH LIGHTS, DUCTS, PIPES, ETC. AND A SMOKE DEVELOPED INDEX OF NOT MORE THAN 50 WHEN TESTED IN ACCORDANCE WITH ASTM E 84. CONTRACTOR SHALL PROVIDE PROOF OF COMPLIANCE WITH THIS REQUIREMENT UPON REQUEST.
- SPRINKLER HEADS SHALL NOT INTERFERE WITH LIGHTING FIXTURES, SPEAKERS, AIR CONDITIONING DIFFUSERS AND GRILLES, ETC. COORDINATE WITH ARCHITECT'S REFLECTED CEILING PRIOR TO SUBMITTING SHOP DRAWING.
- EXACT LOCATION OF SPRINKLER HEADS AND PIPING SHALL BE COORDINATED WITH OTHER TRADES AND THE ARCHITECT'S REFLECTED CEILING PLAN BEFORE INSTALLATION.
- CUTTING AND NOTCHING OF JOISTS IS NOT ACCEPTABLE AND WILL NOT BE PERMITTED. ANY DAMAGE CAUSED TO THE BUILDING STRUCTURE DURING INSTALLATION SHALL BE REPAIRED AT THIS CONTRACTORS EXPENSE.
- ALL ELECTRICAL REQUIREMENTS FOR FIRE PROTECTION AND SPRINKLER SYSTEM ARE TO BE INCLUDED AS PART OF THIS CONTRACTOR'S RESPONSIBILITY. THIS CONTRACTOR SHALL SUB-CONTRACT FOR ALL WIRING AND RELATED COMPONENT REQUIREMENTS WITH SEPARATE ELECTRICAL CONTRACTOR. ALARM WIRING REQUIREMENTS FOR THE FIRE PROTECTION AND ALARM SYSTEM ARE TO BE INCLUDED IN THIS WORK.
- WHEN COMPLETED, THE ENTIRE SPRINKLER SYSTEM SHALL BE TESTED IN ACCORDANCE WITH CHAPTER 25 OF NFPA 13 AND AS REQUIRED BY THE RULES AND REGULATIONS OF THE AUTHORITIES HAVING JURISDICTION. ALL SYSTEMS MUST BE FREE OF LEAKS AND ANY OTHER DEFECTS.
- ALL EQUIPMENT AND WORKMANSHIP SHALL BE GUARANTEED FOR A PERIOD OF ONE(1) YEAR AFTER ACCEPTANCE BY THE OWNER AND ARCHITECT, AGAINST DEFECTIVE MATERIALS AND LABOR AND IMPROPER DESIGN.
- CONTRACTOR SHALL MAKE AN ALLOWANCE FOR A MINIMUM OF 5% ADDITIONAL SPRINKLER HEADS TO BE INSTALLED AS TO PROVIDE ADEQUATE COVERAGE DUE TO ANY OBSTRUCTIONS, DUCTWORK, PIPING, ETC. INSTALLED DURING CONSTRUCTION WHICH MAY ALTER THE ORIGINAL SPRINKLER DESIGN.
- FURNISH SPRINKLER CABINETS OF FINISHED STEEL AND HINGED COVER SIMILAR TO POTTER-ROEMER FIG. 6162 WITH SPACE FOR A MINIMUM OF 6 SPARE SPRINKLER HEADS PLUS SPRINKLER WRENCH FOR EACH TYPE. SUITABLE FOR WALL MOUNTING. FURNISH SIX (6) EXTRA SPRINKLER HEADS, WITH A MINIMUM OF (2) OF EACH TYPE. THIS SHALL ALSO INCLUDE ESCUTCHEONS.
- INSTALL SPRINKLER PIPING TO PROVIDE FOR SYSTEM DRAINAGE IN ACCORDANCE WITH NFPA 13.
- INSTALL SPRINKLER PIPING ACCORDING TO NFPA 13 VIBRATION ISOLATION AND SEISMIC RESTRAINTS.
- CONTRACTOR TO PAY FOR AND SUPPLY ALL DUMPSTERS FOR DEBRIS REMOVAL, COORDINATE AND OBTAIN APPROVAL FOR DUMPSTER LOCATIONS ON SITE AND DEBRIS REMOVAL ROUTES WITH THE CONSTRUCTION MANAGER.
- INSTALL NON-COMBUSTIBLE HOODS OR SHIELDS ABOVE IMPORTANT ELECTRICAL EQUIPMENT FOR PROTECTION FROM SPRINKLER DISCHARGE PER NFPA 13, 8.14.10.2.
- WHERE WORK BETWEEN THESE DRAWINGS AND ARCHITECTURAL PLANS ARE IN CONFLICT, ADVISE ARCHITECT AND ENGINEER PRIOR TO INSTALLATION OF SPRINKLER WORK.
- ALL SPRINKLER DRAINS SHALL RUN TO SAFE LOCATIONS TO PREVENT OVERFLOW OF DRAINS.
- PORTABLE FIRE EXTINGUISHERS, IF REQUIRED (OF REQUIRED CLASS AND CAPACITY) ARE NOT PART OF THIS CONTRACT.
- ALL PIPING SYSTEMS SHOWN ON THESE DRAWINGS ARE DIAGRAMMATIC AND EVERY ATTEMPT HAS BEEN MADE TO INDICATE OFFSETS AND PIPING ARRANGEMENTS TO SUIT ACTUAL INSTALLATION REQUIREMENTS. HOWEVER, SPRINKLER CONTRACTOR SHALL COORDINATE WITH THE G.C. AND ALL OTHER TRADES WHEN LAYING OUT HIS WORK TO ENSURE CONFLICT AVOIDANCE.
- AS THE ACTUAL LIFE SPAN OF THE SPRINKLER SYSTEM IS DEPENDENT ON MANY VARIABLES, INCLUDING BUT NOT LIMITED TO WATER QUALITY AND ATMOSPHERIC CONDITIONS, THE ENGINEER ASSUMES NO LIABILITY OR RESPONSIBILITY OF THE LIFE SPAN OF THE SPRINKLER SYSTEM DUE TO MICRO-BIOLOGICALLY INFLUENCED CORROSION (MIC). THE SPRINKLER CONTRACTOR AND/OR THE GENERAL CONTRACTOR SHALL HAVE THE SPRINKLER SYSTEM TESTED AND TREATED (IF NECESSARY) FOR PROTECTION AGAINST MICRO-BIOLOGICALLY INFLUENCED CORROSION (MIC).
- INSTALLATION OF THE SPRINKLER SYSTEM SHALL NOT BE STARTED UNTIL DRAWINGS, SPECIFICATIONS, CALCULATIONS, ETC. HAVE BEEN APPROVED BY DSA.
- STORAGE AREAS CONTAINING CORROSSIVE CHEMICALS SHALL HAVE CORROSSION RESTISTANT SPRINKLERS OF THE SAME ORIENTATION, TEMPERATURE, AND K-FACTOR INSTALLED.
- THE INSTALLATING CONTRACT SHALL SUBMIT SHOP DRAWINGS, CALCULATIONS, AND TECHINCAL SUBMITALS FOR REVIEW PRIOR TO INSTALLATION.

NOTES:

- ALARM CHECK VALVE VICTAULIC MODEL 751 OR APPROVED EQUAL.
- BACKFLOW PREVENTER LF757DCDA SERIES WATTS - 6" DCDA OR APPROVED EQUAL.
- THE BACKFLOW PREVENTER VALVES SHALL BE ELECTRICALLY SUPERVISED BY A TAMPER SWITCH INSTALLED IN ACCORDANCE WITH NFPA 72 AND SEPERATED ANNUNCIATED.
- ALL VALVES CONTROLLING THE WATER SUPPLY FOR AUTOMATIC SPRINKLER SYSTEMS, PUMPS, WATER FLOW SWITCHES ON ALL SPRINKLER SYSTEMS SHALL BE ELCTRICALLY SUPERVISED BY THE FIRE ALARM SYSTEM.
- 4" DOUBLE DETECTOR CHECK ASSEMBLY (DCDA). DEVICE MUST BE INSTALLED AS PER AHJ APPROVED DOCUMENTS INCLUDING BUT NOT LIMITED TO THE STATE OF CALIFORNIA DSA.

DSA File No.:

DSA Application No.:

Agency Approval

General Notes

NET POSITIVE
consulting
engineers
www.npceing.com
project no. 1101



Consultant

Mission Oaks HS Aquatic Complex
Tulare Joint Union High School District
Tulare, CA 93274

Project

FIRE PROTECTION - PROJECT INFORMATION
Drawing

darden ARCHITECTURE
PLANNING
INTERIORS
www.dardenarchitects.com
6790 N. West Ave. • Fresno, CA 93711 • T. 559-448-8051



Architect

No.	Revision/Submission	Date
1	REVISION_01	05/31/2023

Revision

Designed Designer Copyright 2022 Darden Architects

Scale: Drawn By: Author

Project Number: 2180 Checked IChecker

Date: 01/20/2023 Reviewer Approver

FP001




- SYMBOLS LEGEND**
- PIPE DIAMETER, CUT LENGTH, AND SECTION LENGTHS
 - PIPE DIAMETER AND CUT LENGTH
 - PIPE HANGER
 - PIPE CHANGE IN ELEVATION
 - LATERAL SWAY BRACE
 - LONGITUDINAL SWAY BRACE
 - 4-WAY SWAY BRACE
 - FLEX DROP
 - HYDRAULIC NODE
 - ALARM BELL
 - BRANCHLINE RESTRAINT
 - BUILDING SEISMIC SEPARATION
 - PIPE HANGER - STEEL

DSA File No.:

DSA Application No.:

Agency Approval

• SPRINKLERS IN POOL EQUIPMENT, CHLORINE, AND ACID SPACES SHALL ALL BE CORROSION RESISTANT

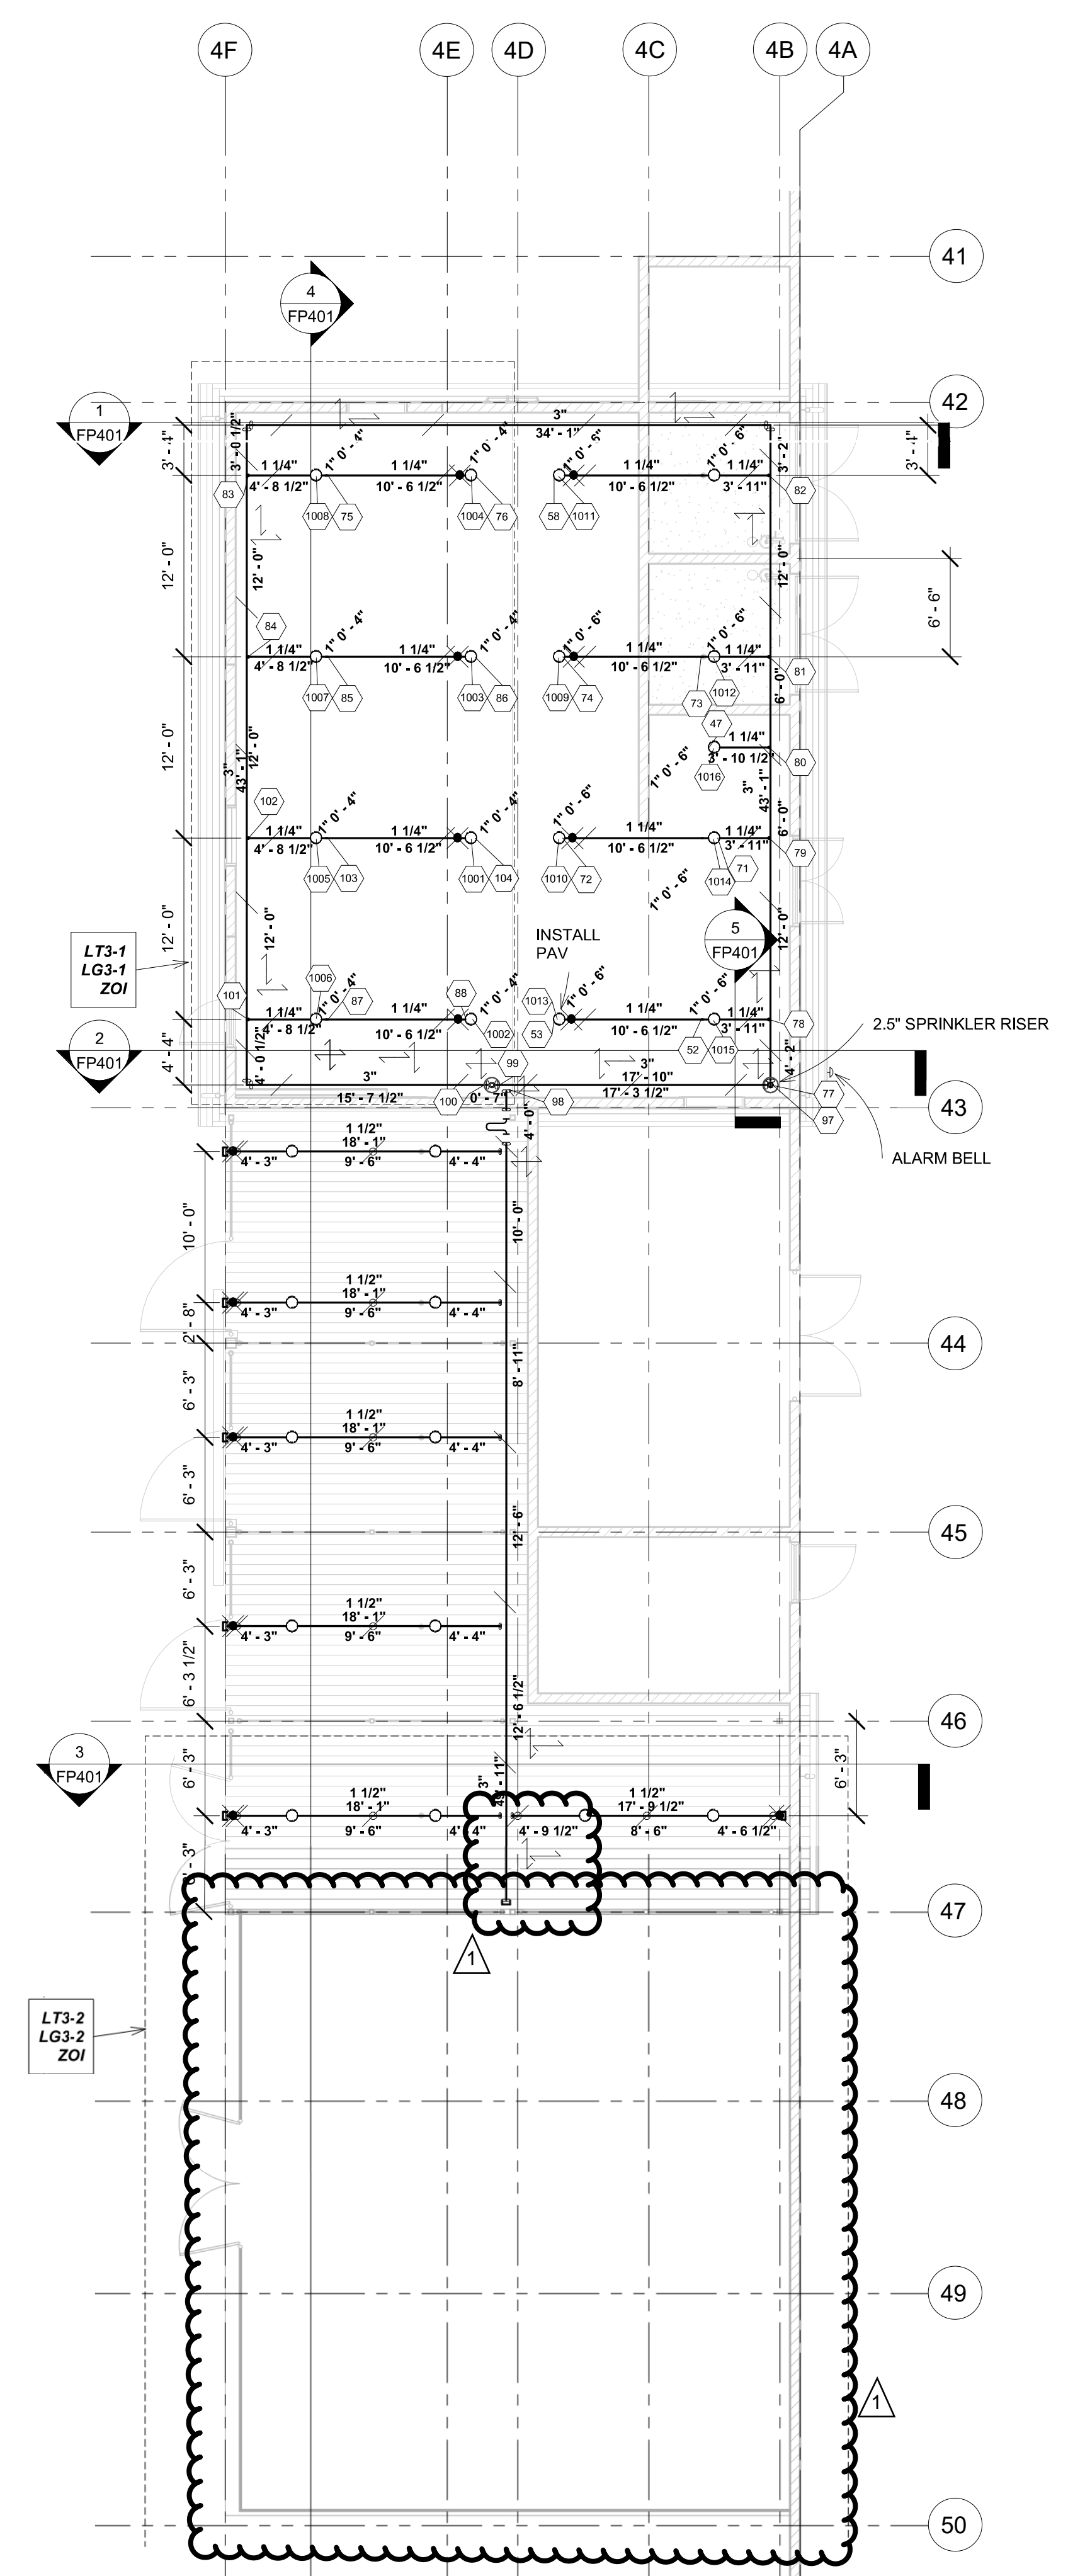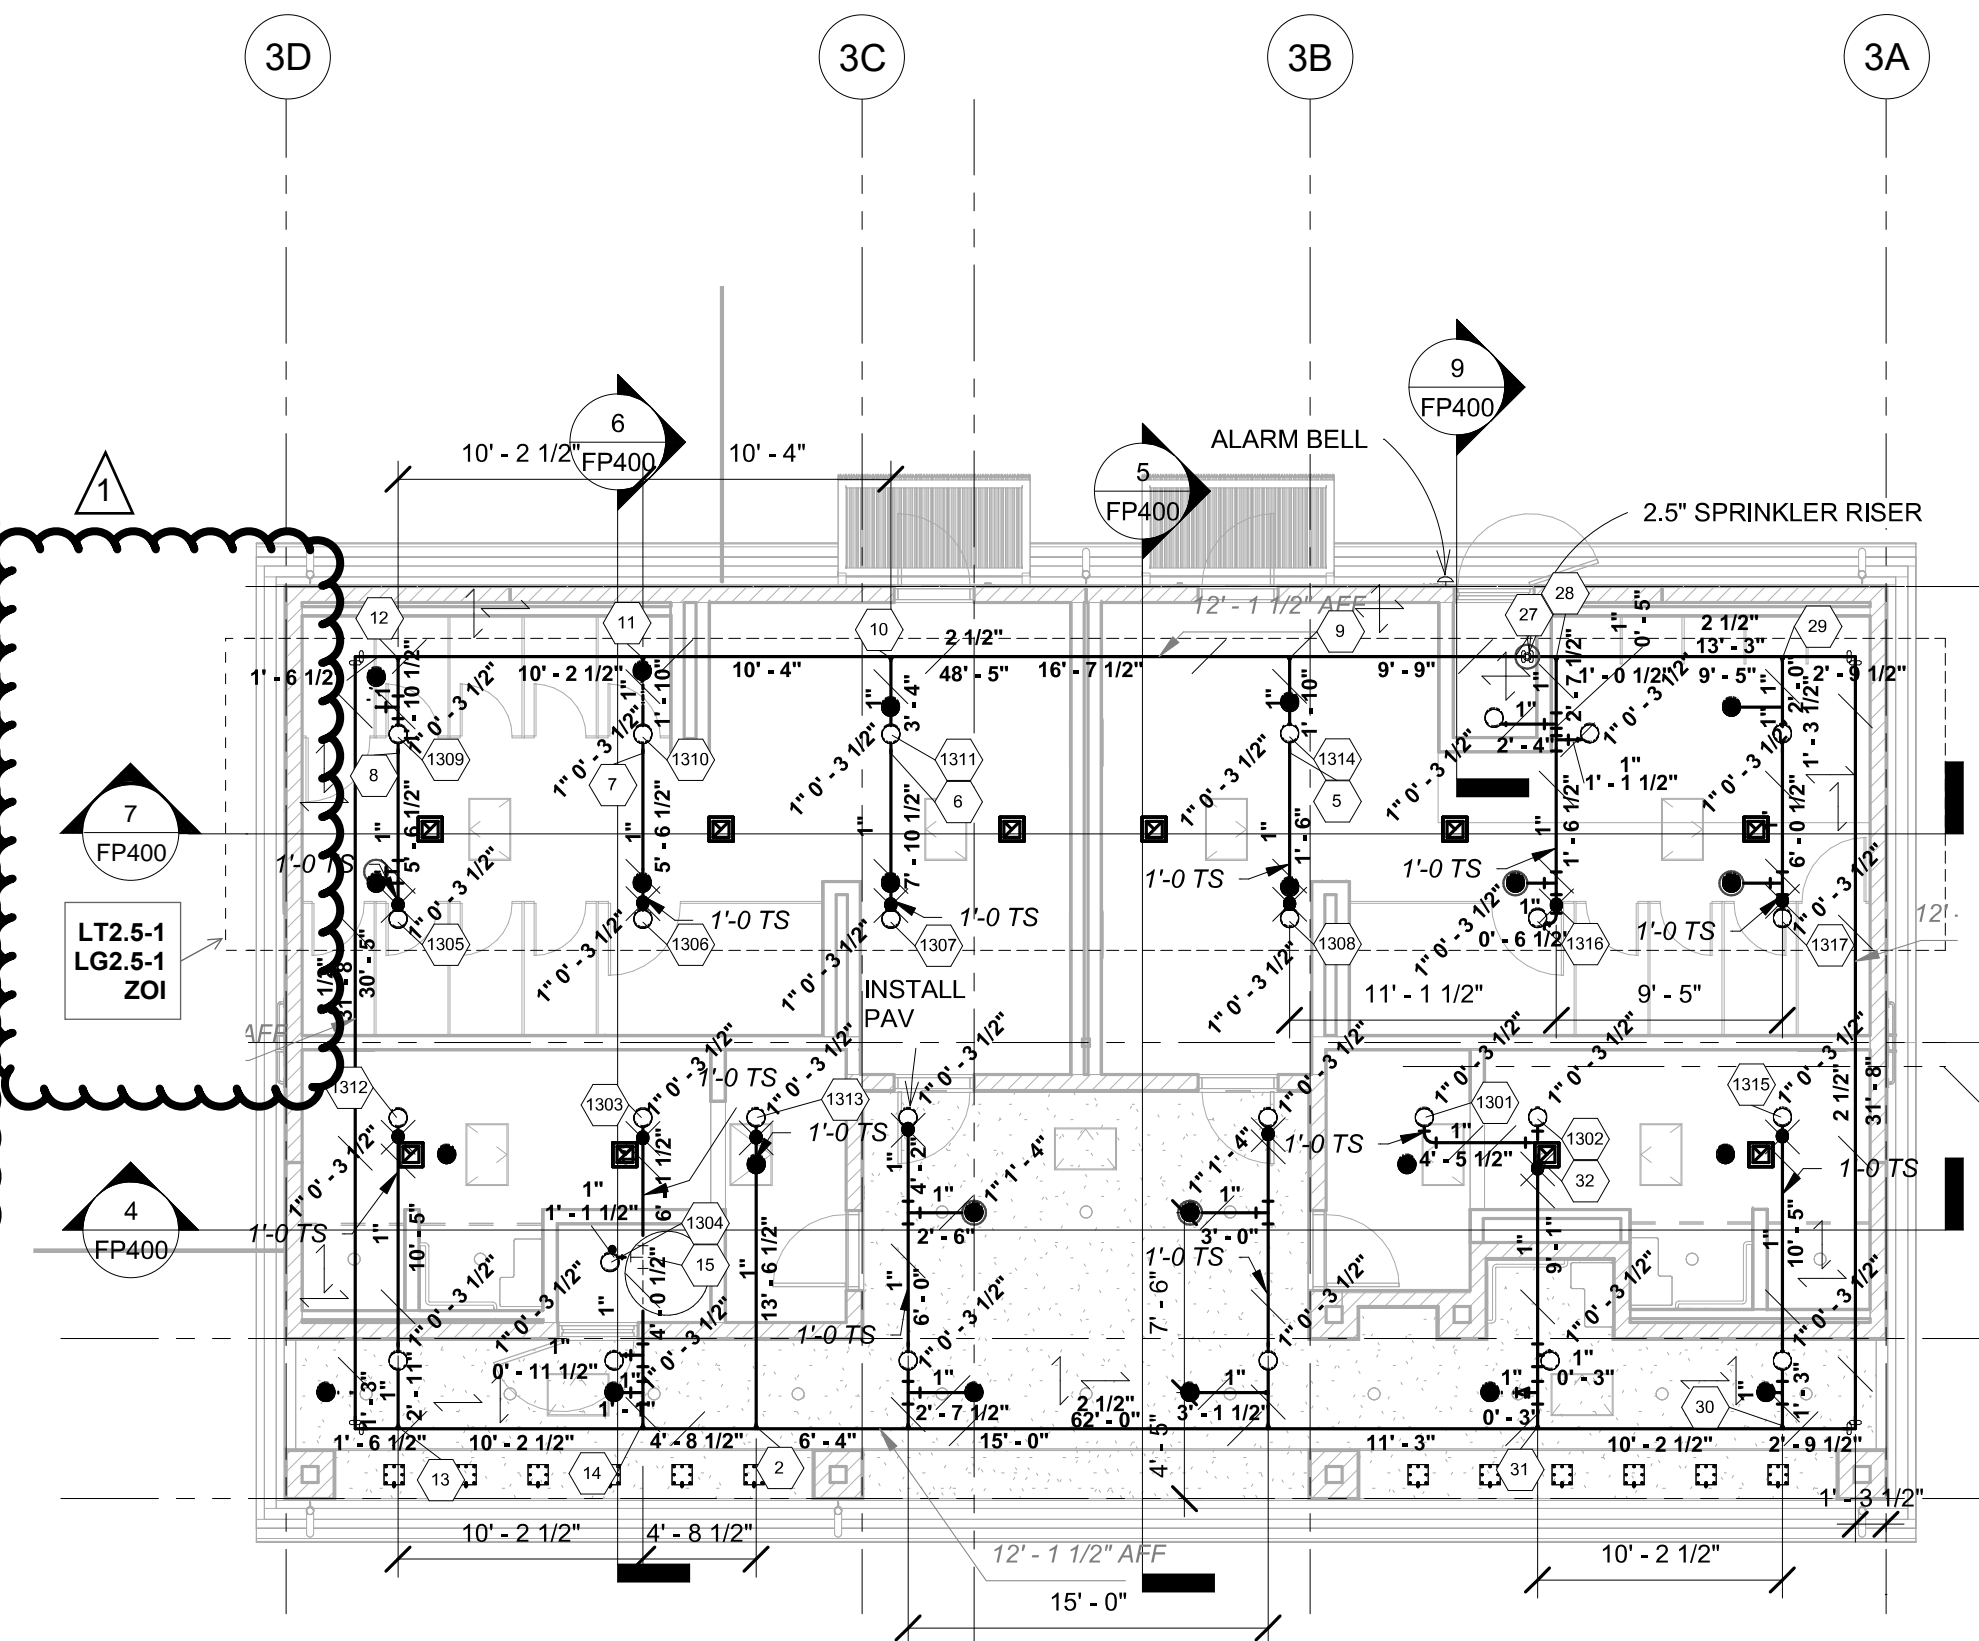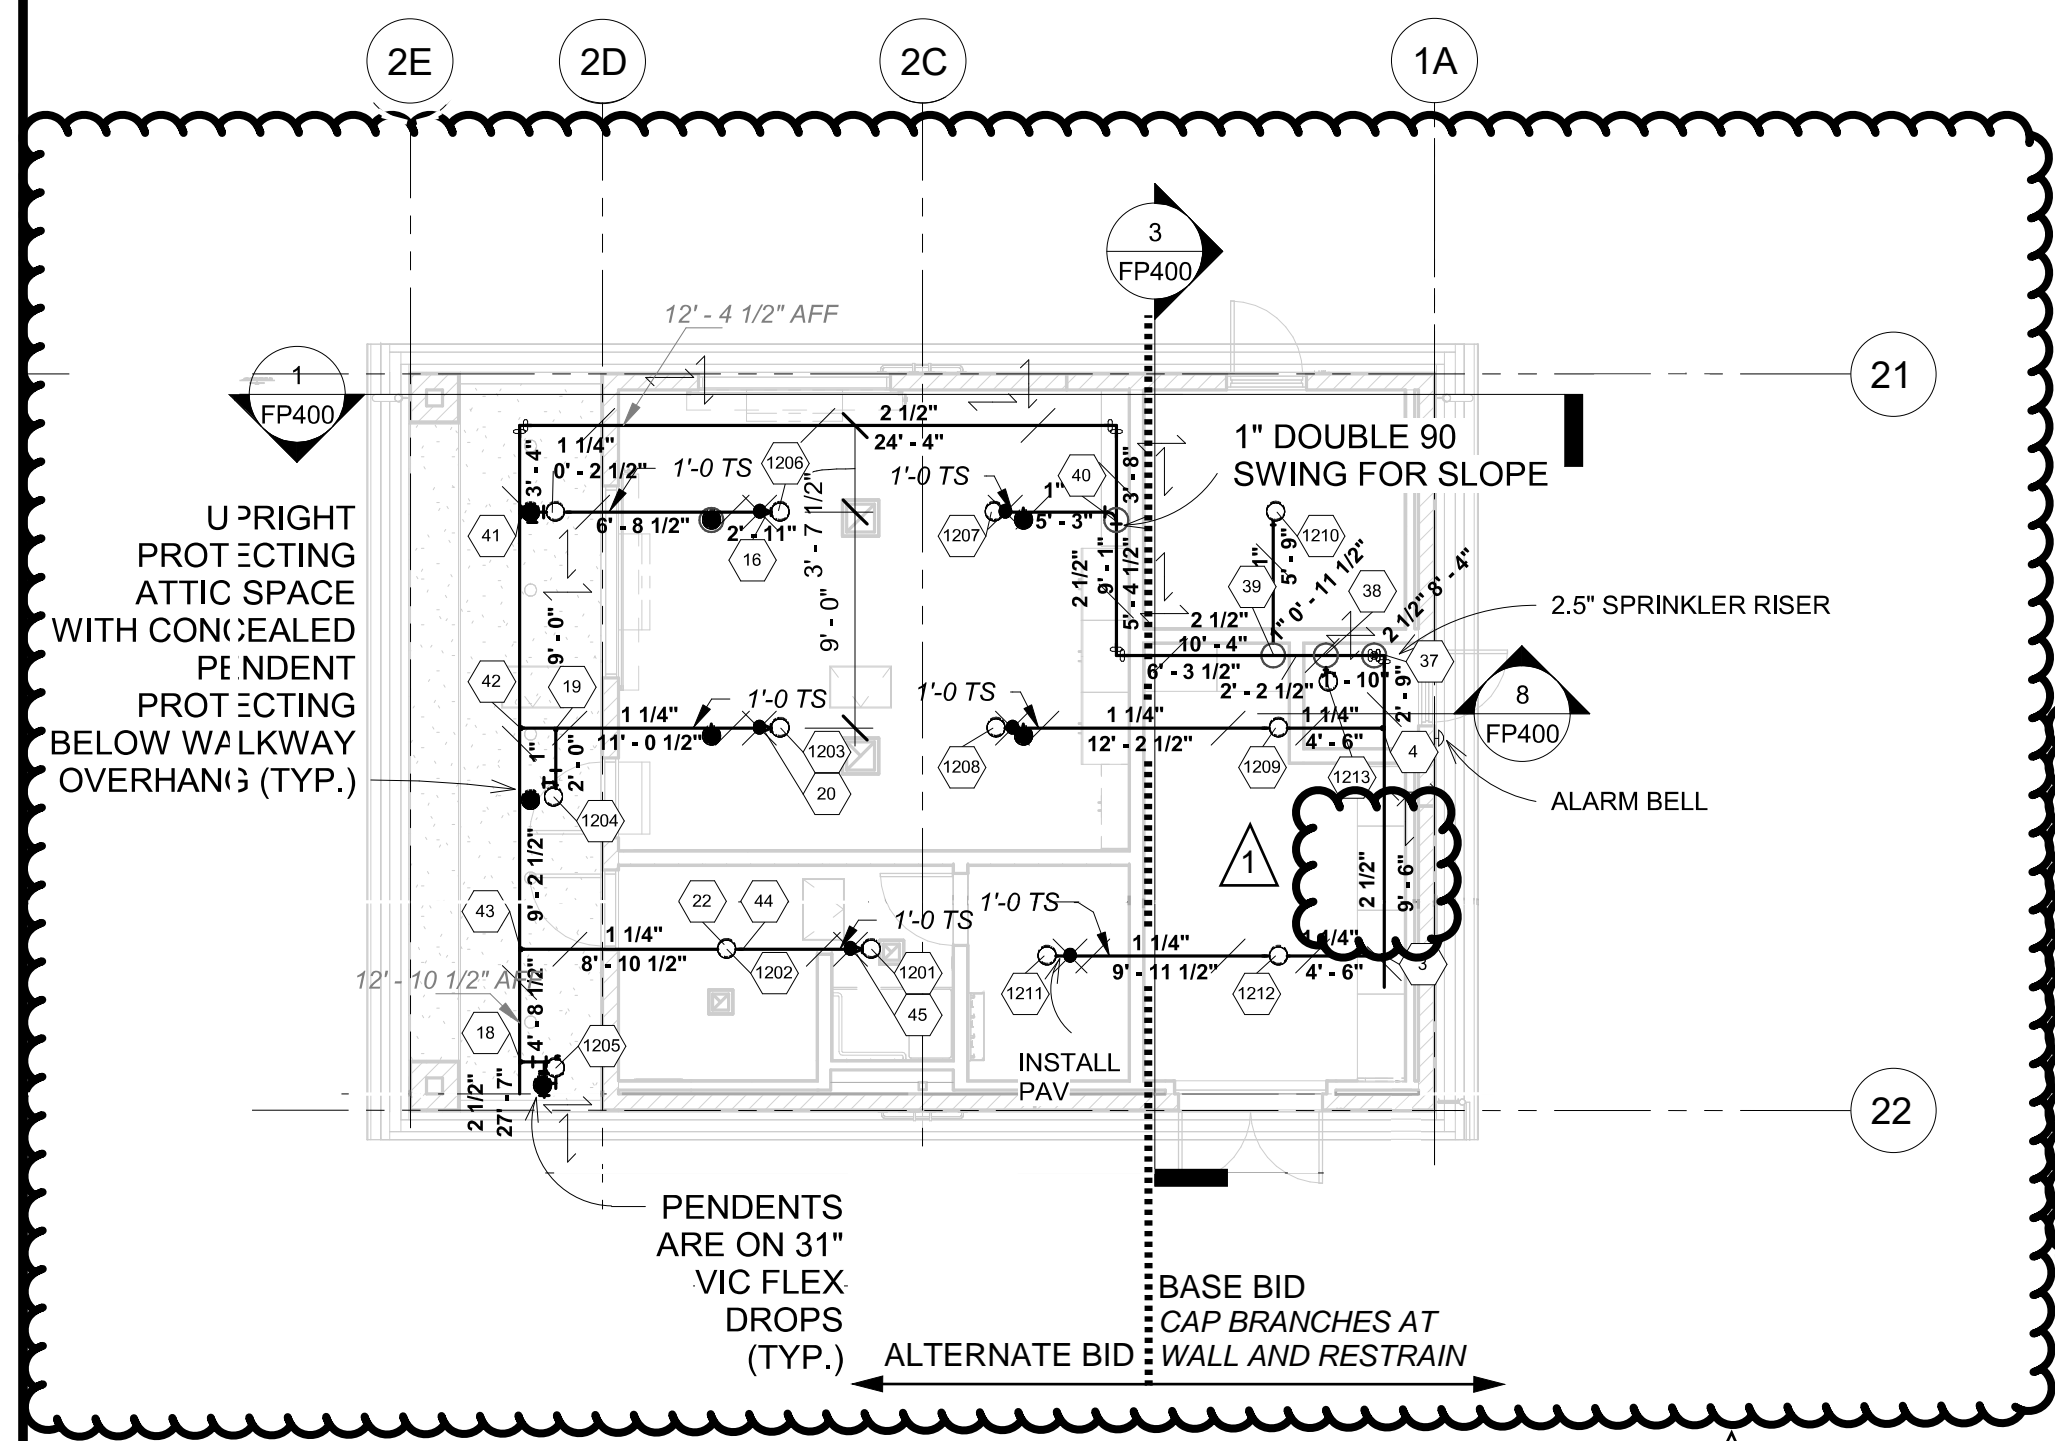

GENERAL NOTES


1. All Unistruts shall have the Unistrut Defender Finish.
2. All Rods, Nuts and Screws shall be stainless steel

General Notes



Mission Oaks HS Aquatic Complex
Tulare Joint Union High School District
Tulare, CA 93274

FIRE PROTECTION - PIPING PLANS
Drawing

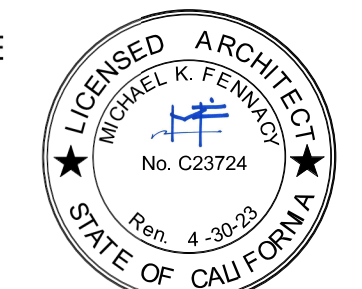

No.	Revision/Submission	Date
1	REVISION_01	05/31/2023
Revision		
Designed By:	WC	Copyright 2022 Darden Architects
Scale:	1/8" = 1'-0"	Drawn By: CC
Project Number:	2180	Checked/Checker
Date:	01/20/2023	Reviewed By/DSA

FP100

5/30/2023 10:44:40 PM C:\Users\waco\Box\Projects\2022\22-014 - NPCEng - Mission Oaks Aquatic Center\22-014 - NPCEng - R1.rvt Mission Oaks Aquatic Center2_Submittals\Drawings\22-014 - Mission Oaks Aquatic Ctr - FP - R1.rvt

SYMBOLS LEGEND

	PIPE DIAMETER, CUT LENGTH, AND SECTION LENGTHS
	PIPE DIAMETER AND CUT LENGTH
	PIPE HANGER
	PIPE CHANGE IN ELEVATION
	LATERAL SWAY BRACE
	LONGITUDINAL SWAY BRACE
	4-WAY SWAY BRACE
	FLEX DROP
	HYDRAULIC NODE
	ALARM BELL
	BRANCHLINE RESTRAINT
	BUILDING SEISMIC SEPARATION
	PIPE HANGER - STEEL

SPRINKLER SCHEDULE




Sprinkler Symbol	Count	Manufacturer	Model	Orifice Size	K-Factor	Temperature Rating	Sprinkler Orientation	Finish
○	14	VICTAULIC Inc.	V2704	1/2"	5.6	200 °F	Upright	Brass
●	7	VICTAULIC Inc.	V3802	1/2"	5.6	155 °F	Pendent	White

SPRINKLER SCHEDULE

Sprinkler Symbol	Count	Manufacturer	Model	Orifice Size	K-Factor	Temperature Rating	Sprinkler Orientation	Finish
○	28	VICTAULIC Inc.	V2704	1/2"	5.6	200 °F	Upright	Brass
●	23	VICTAULIC Inc.	V3802	1/2"	5.6	155 °F	Pendent	White

SPRINKLER SCHEDULE

Sprinkler Symbol	Count	Manufacturer	Model	Orifice Size	K-Factor	Temperature Rating	Sprinkler Orientation	Finish
○	29	VICTAULIC Inc.	V2704	1/2"	5.6	200 °F	Upright	Brass

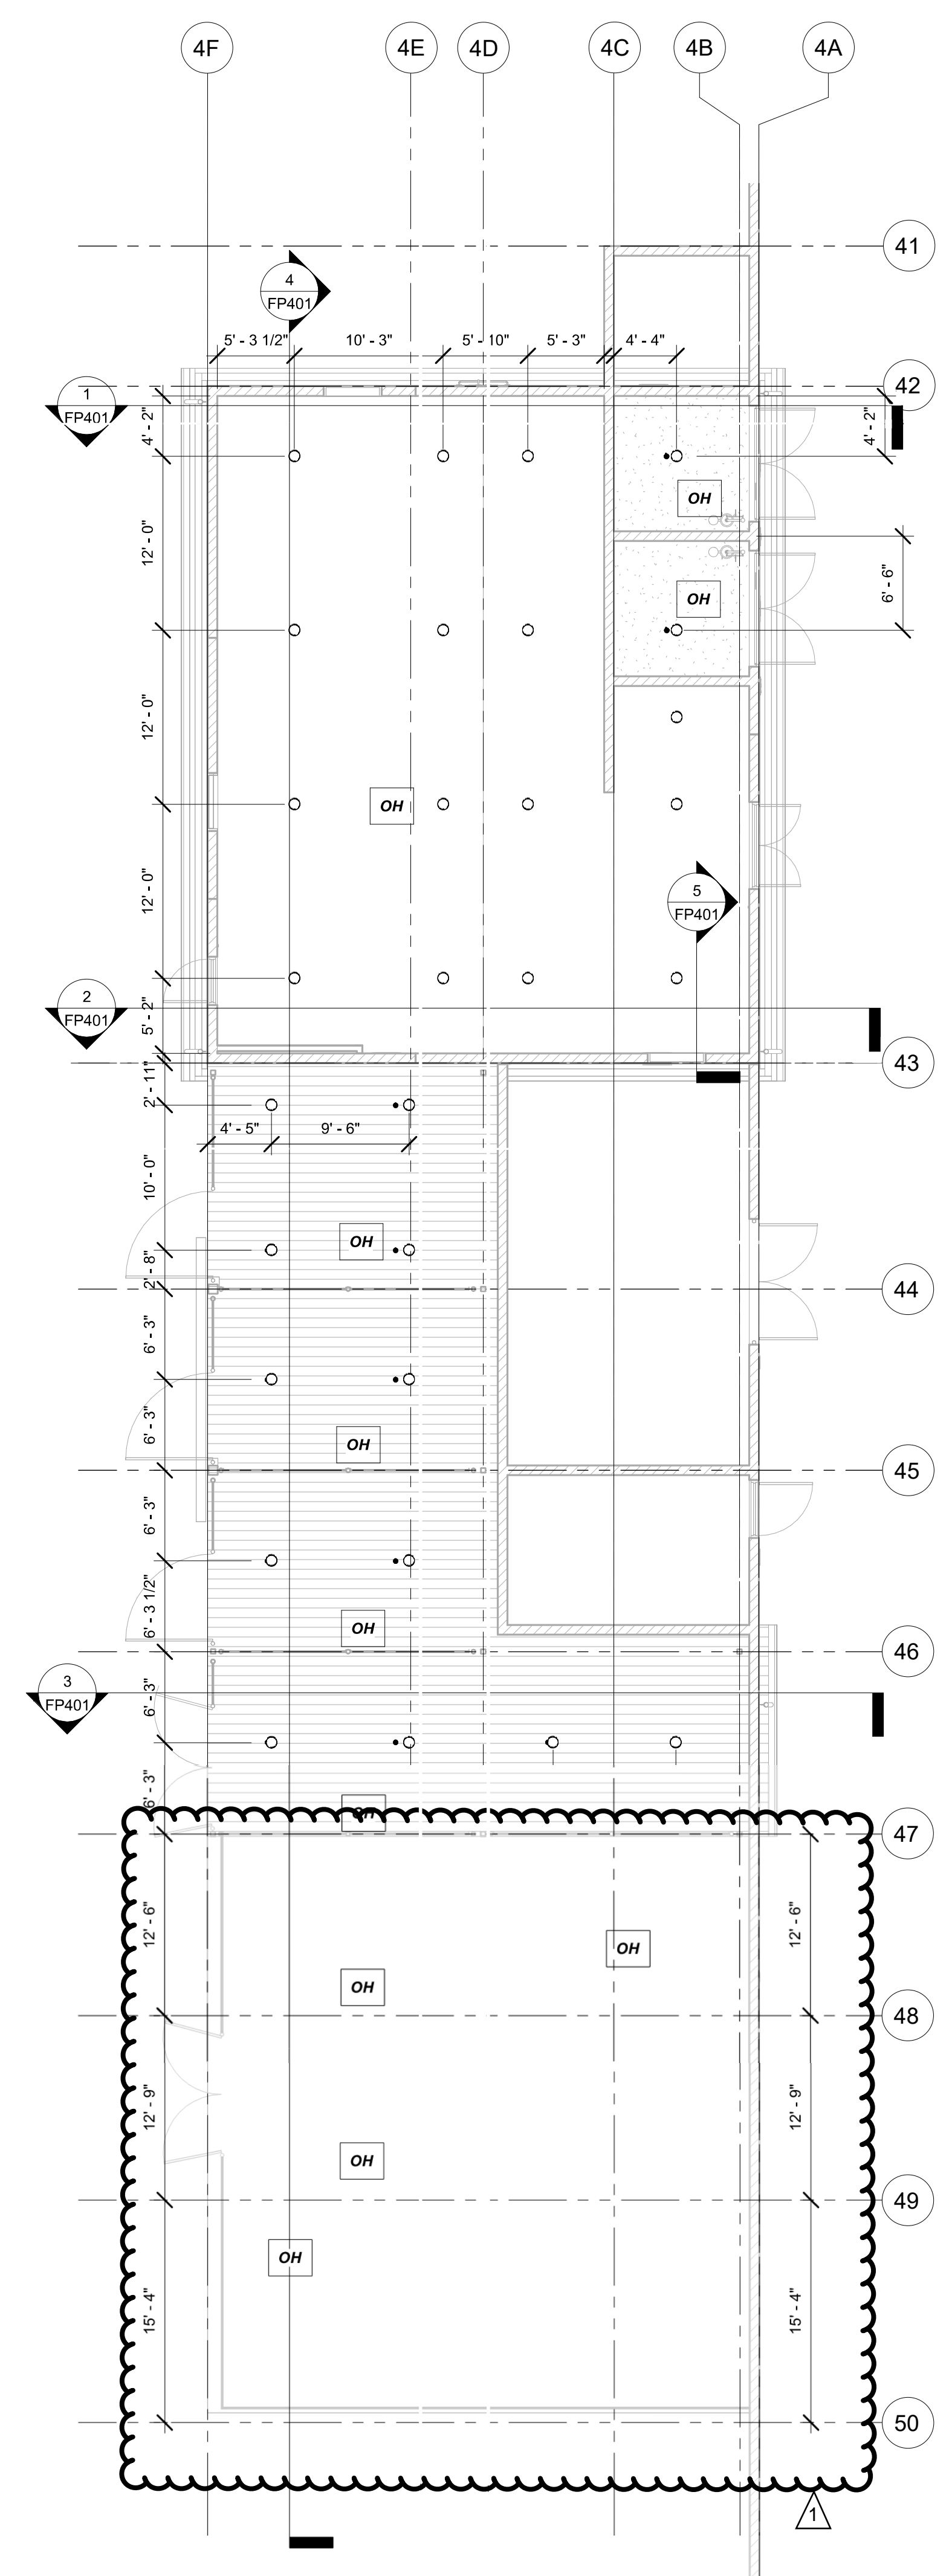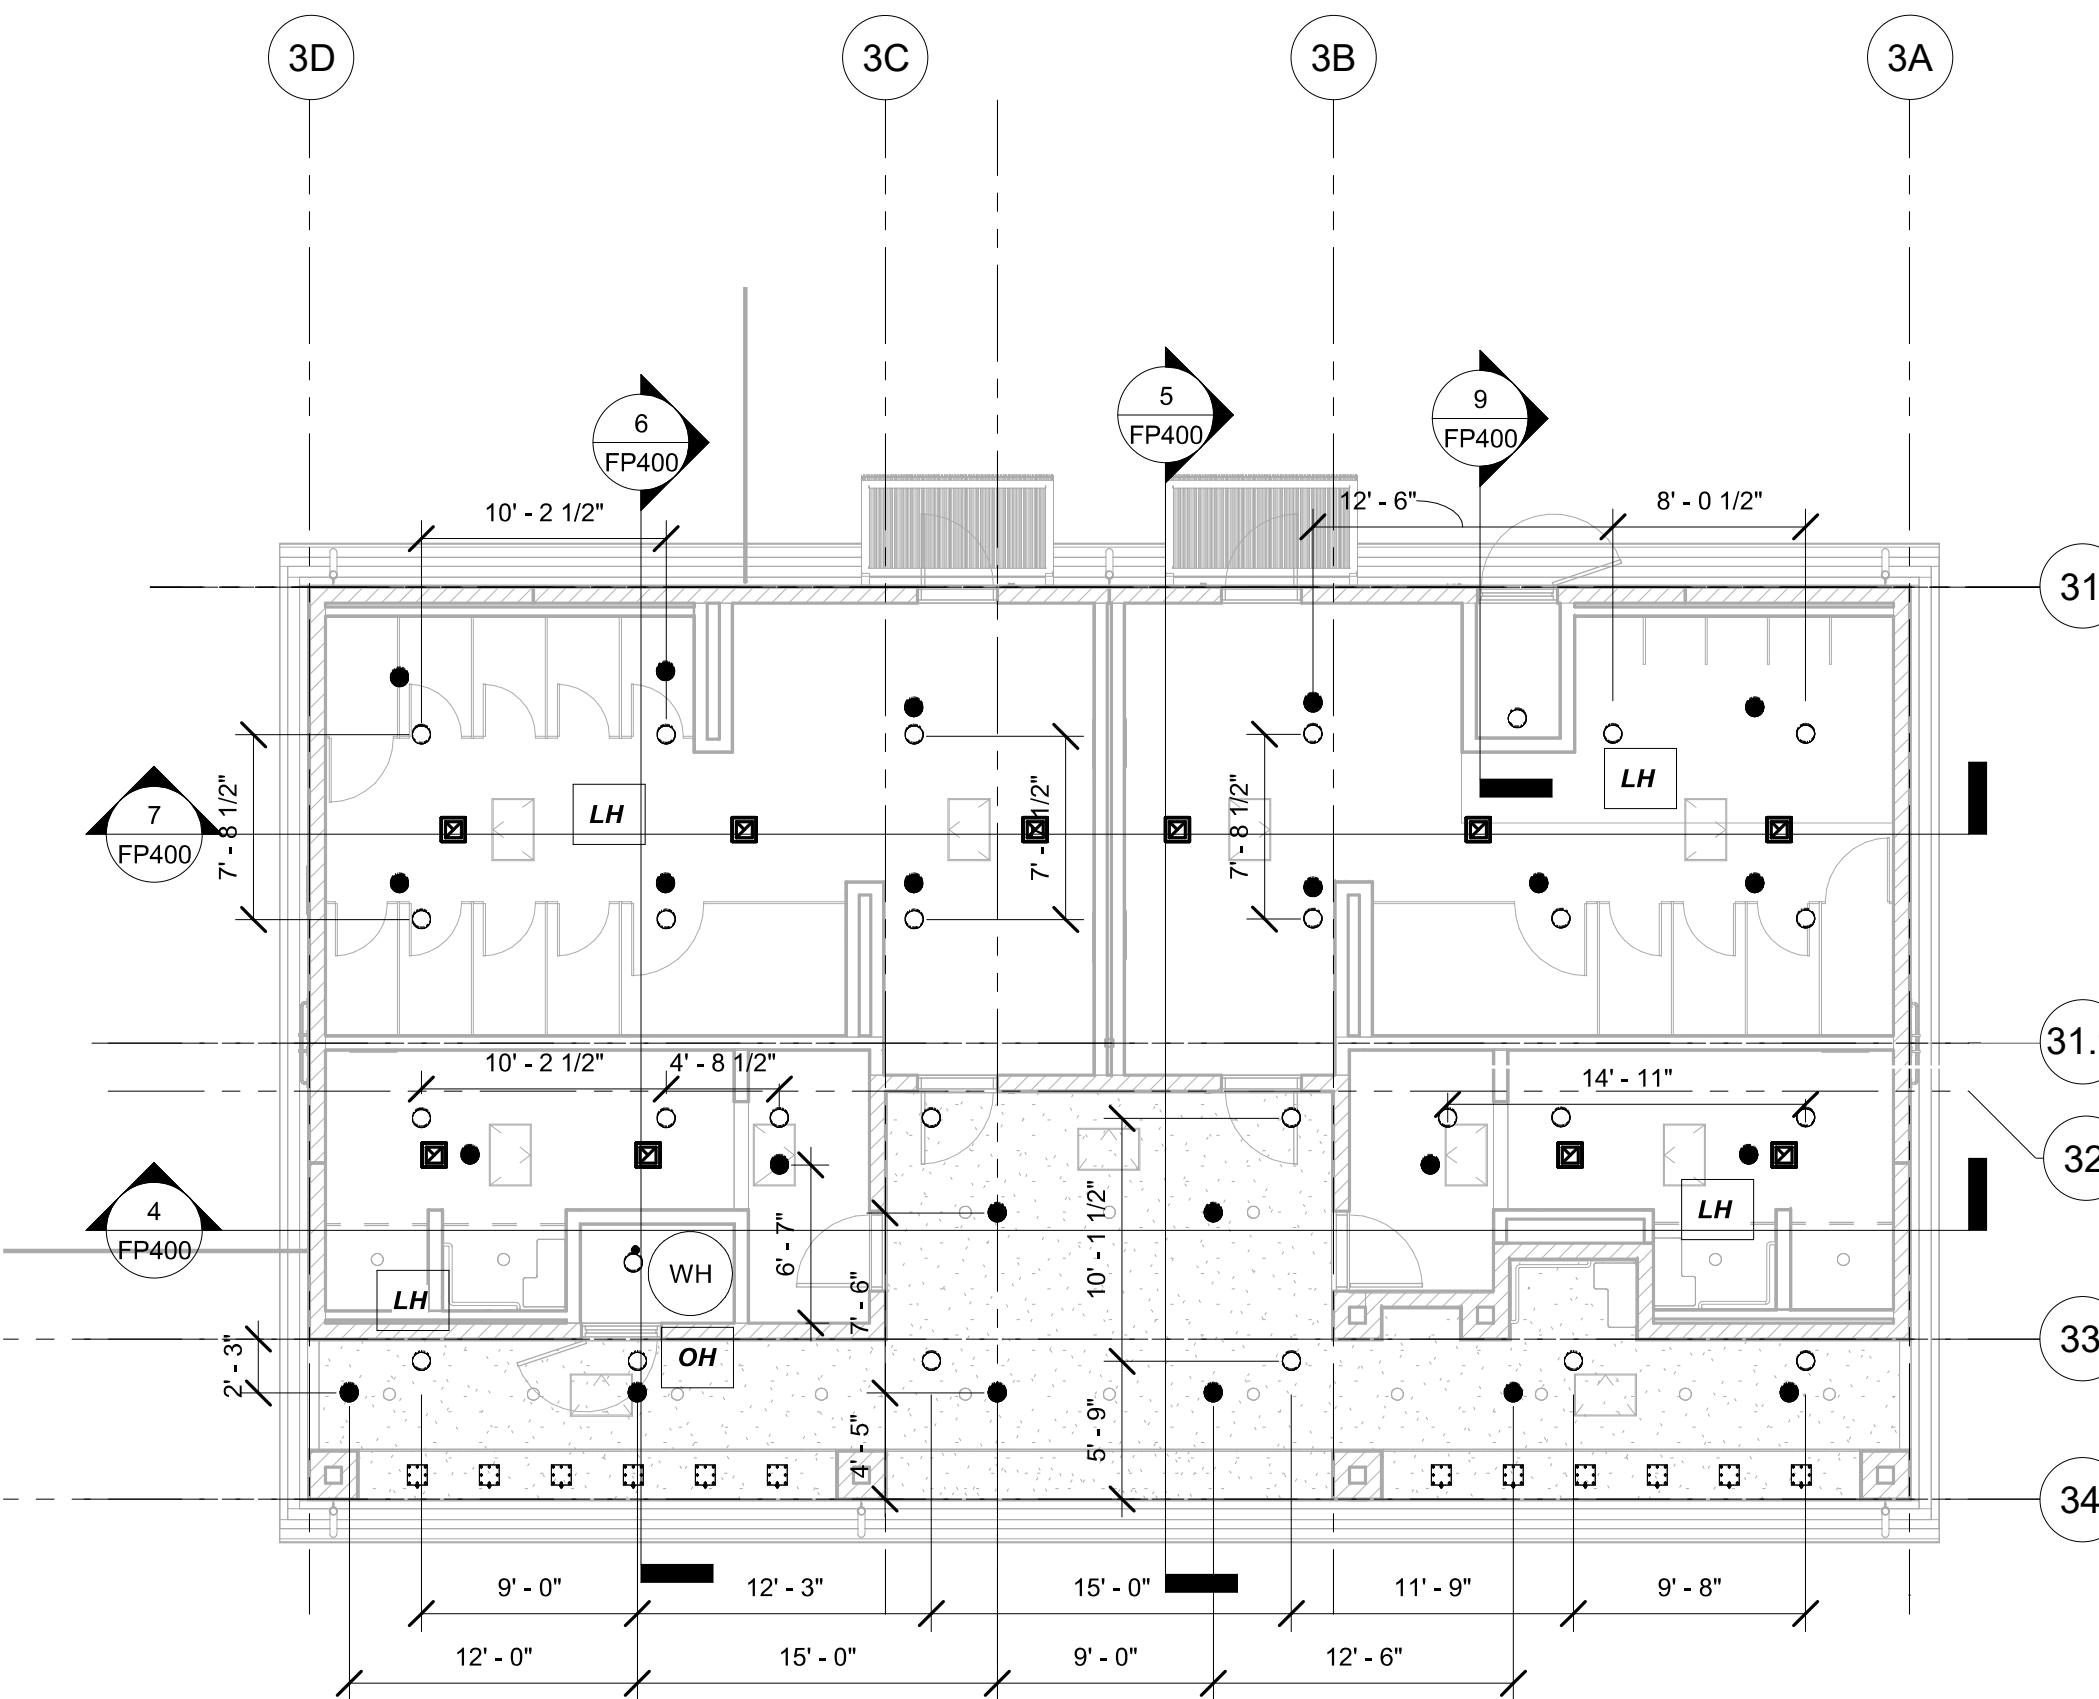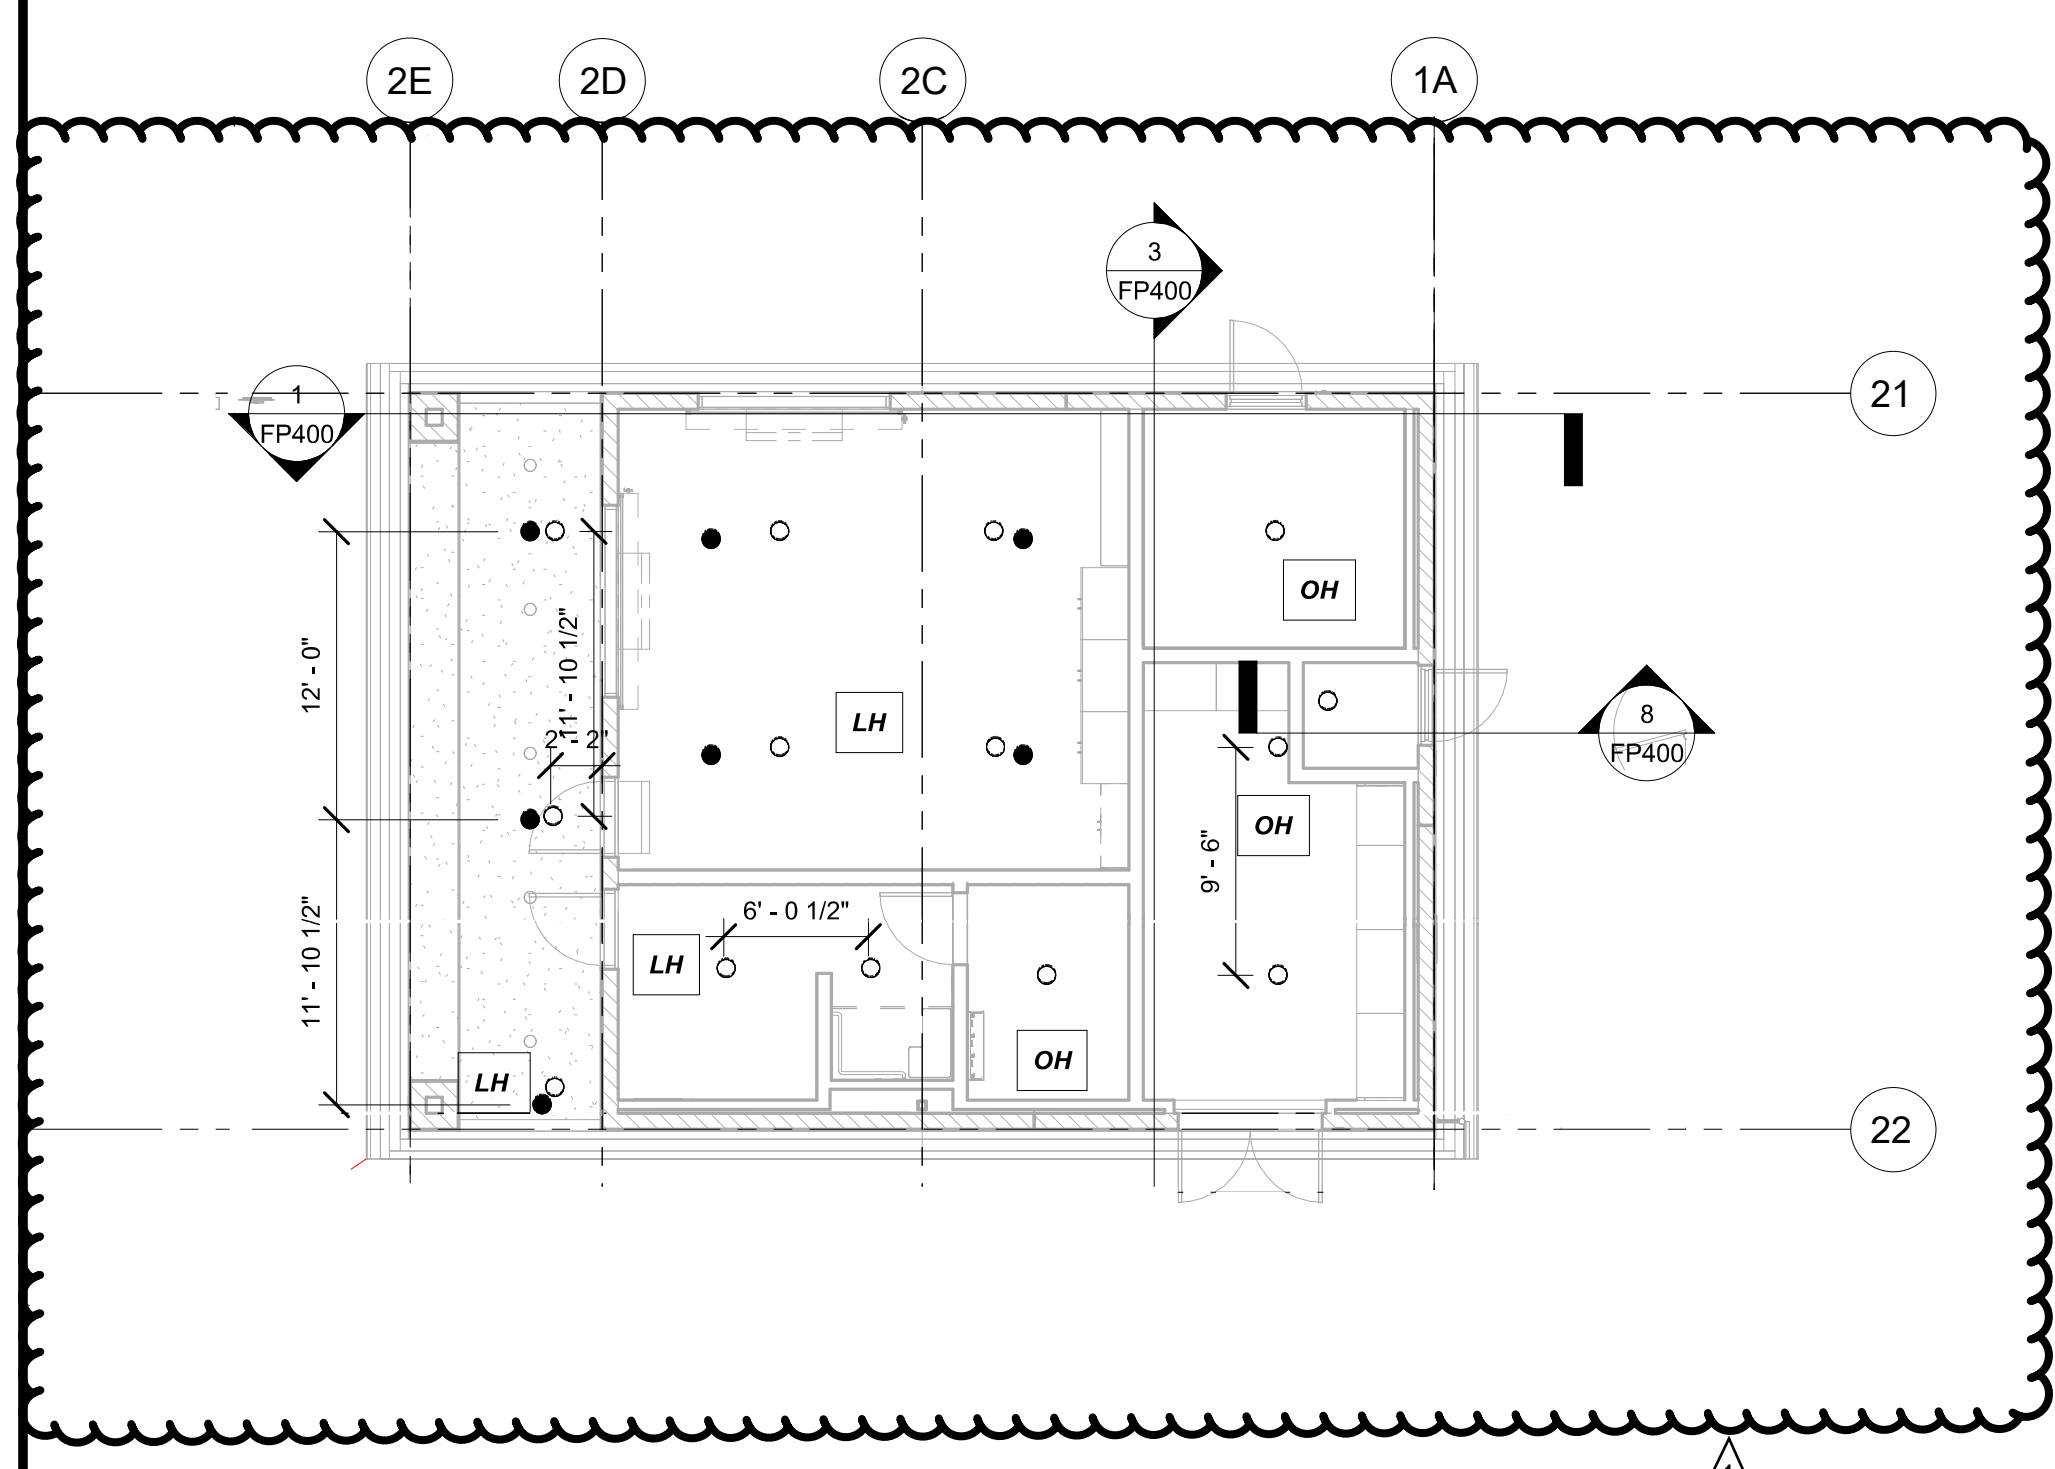

DSA File No.:
 DSA Application No.:
 Agency Approval

GENERAL NOTES

- All Unistruts shall have the Unistrut Defender Finish.
- All Rods, Nuts and Screws shall be stainless steel.

NET POSITIVE consulting engineers
 www.NPCEng.com
 project no. 1101
 Consultant

Mission Oaks HS Aquatic Complex
 Tulare Joint Union High School District
 Tulare, CA 93274
 Project

FIRE PROTECTION - REFLECTED CEILING PLANS
 Drawing

darden ARCHITECTURE PLANNING INTERIORS architects
 www.dardenarchitects.com
 6790 N. West Ave. • Fresno, CA 93711 • T. 559.448.8051
 Architect

No.	Revision/Submission	Date
REVISION_01		05/31/2023

Revision


Designed By: WC
 Copyright 2022 Darden Architects

Scale: 1/8" = 1'-0"
 Project Number: 2180
 Date: 01/20/2023


Drawn By: CC
 Checked By: NP
 Reviewed By: DSA

FP200


5/30/2023 10:44:41 PM
 C:\Users\wacov\Box\FProjects\2022\22-014 - NPCEng - Mission Oaks Aquatic Center\22-014 - NPCEng - Mission Oaks Aquatic Center\Fire Protection - R1.rvt
 Mission Oaks Aquatic Center2_Submittals\Drawings\22-014 - Mission Oaks Aquatic Center - Fire Protection - R1.rvt

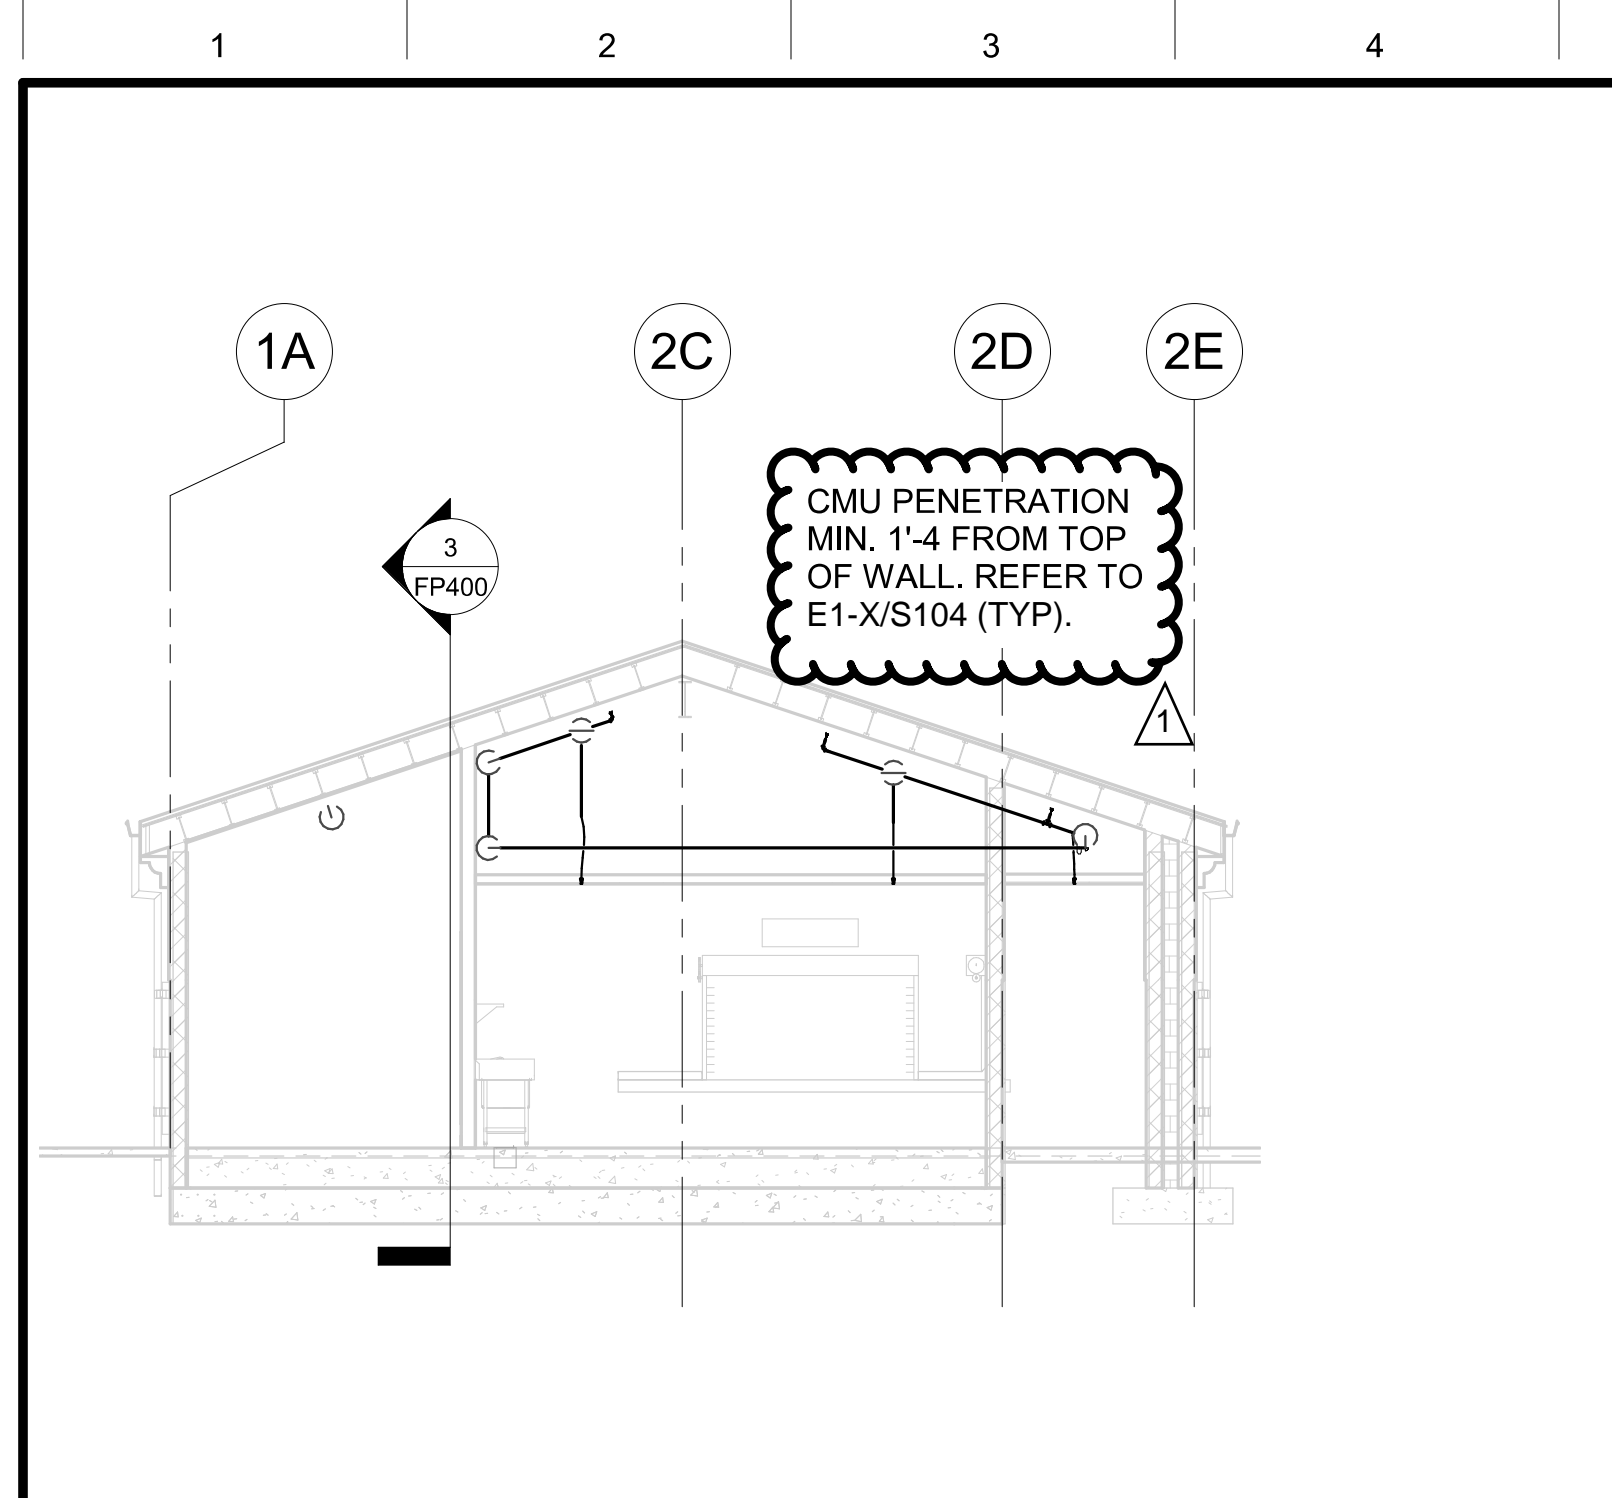



1 BUILDING P2 NORTH SNACK BAR
1/8" = 1'-0"

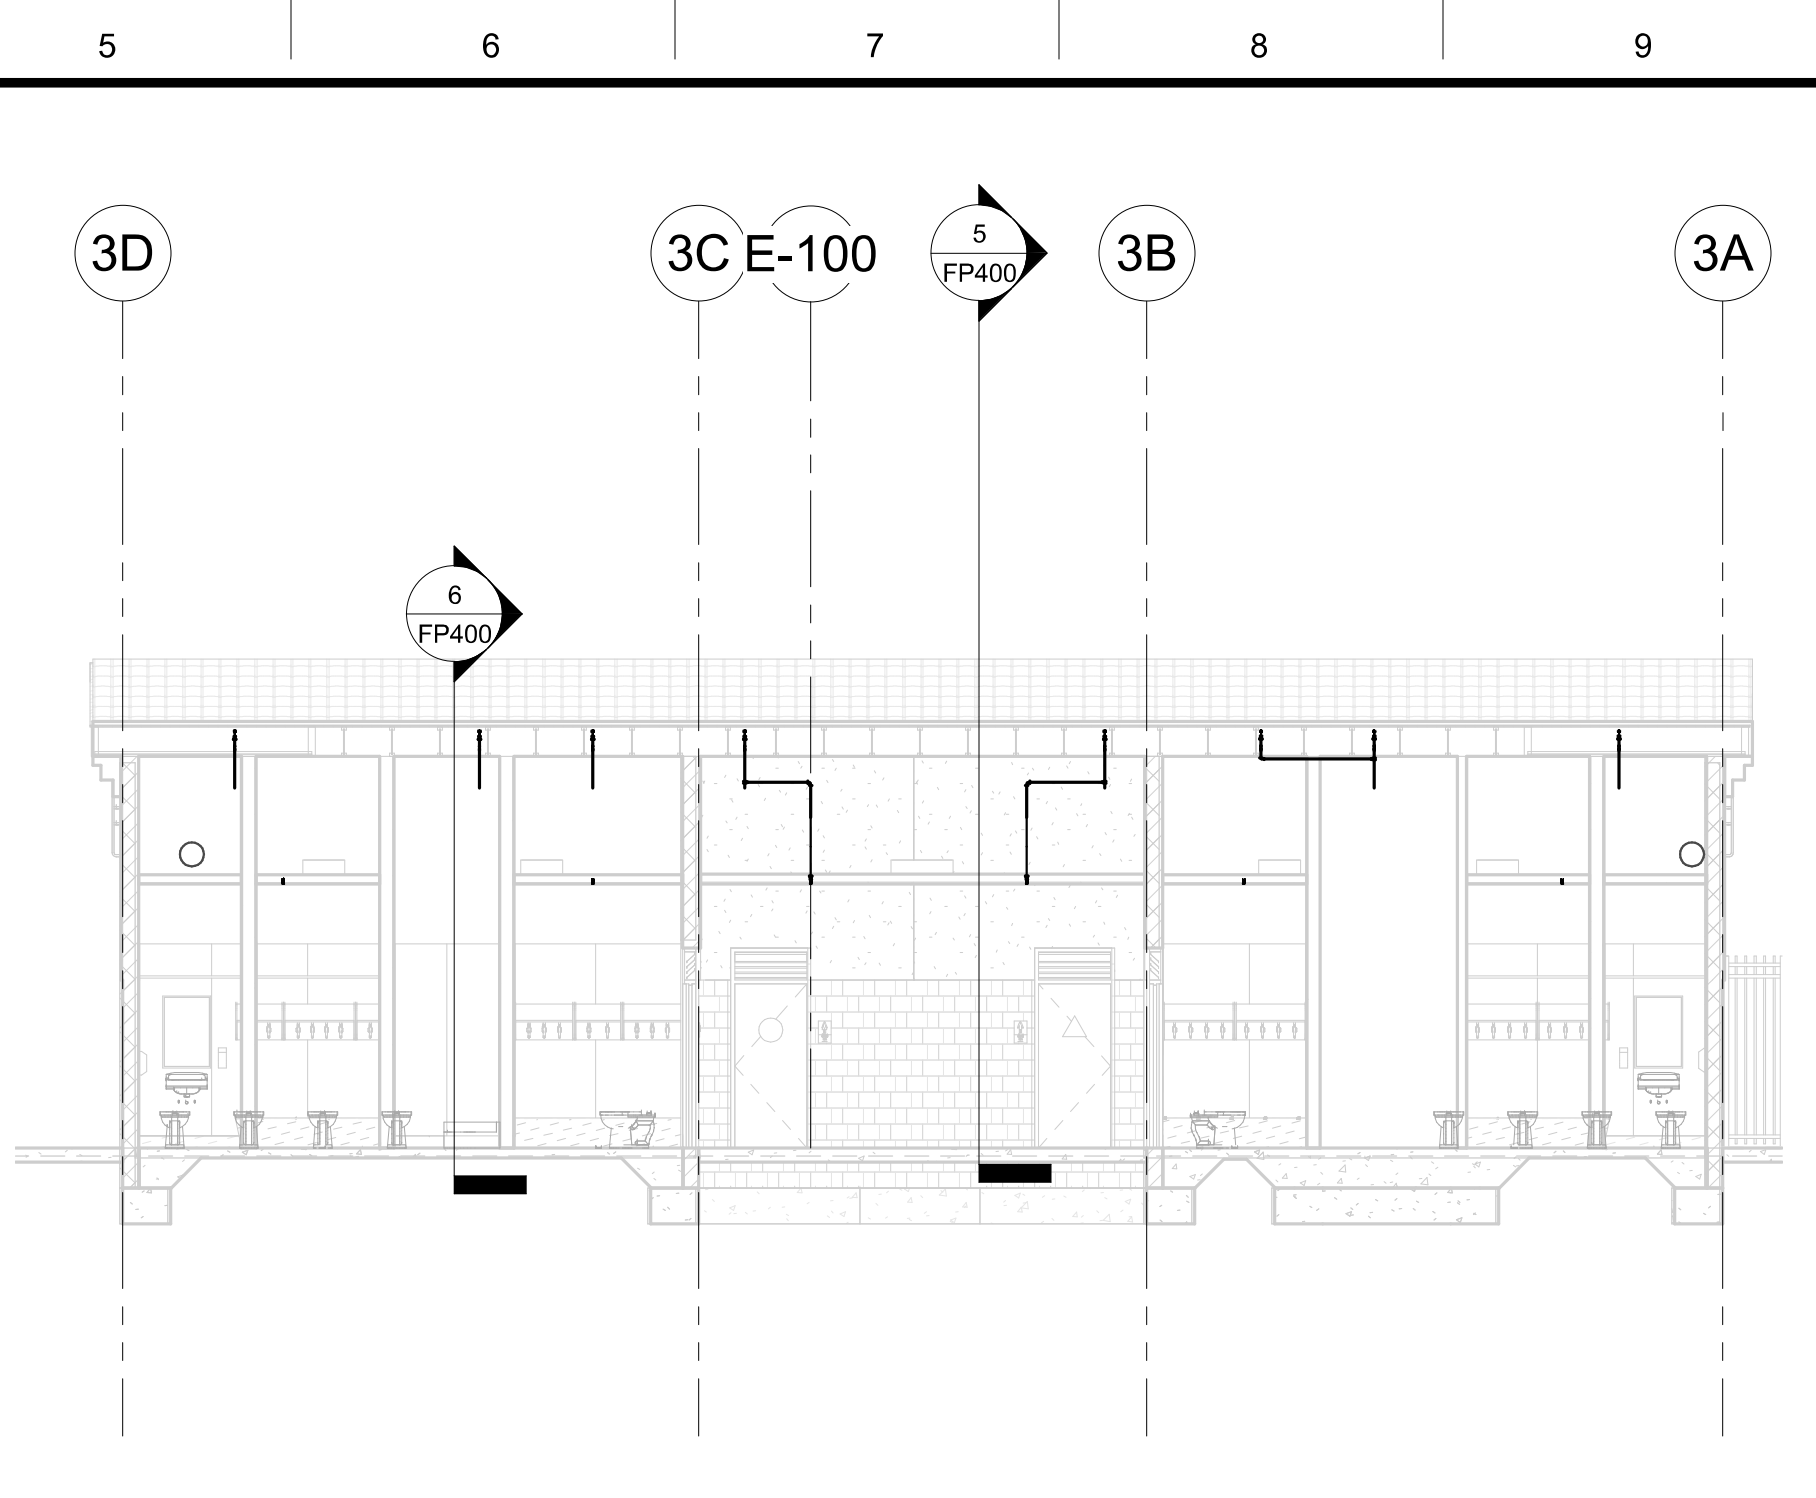



4 BUILDING P3 SOUTH SHOWERS
1/8" = 1'-0"

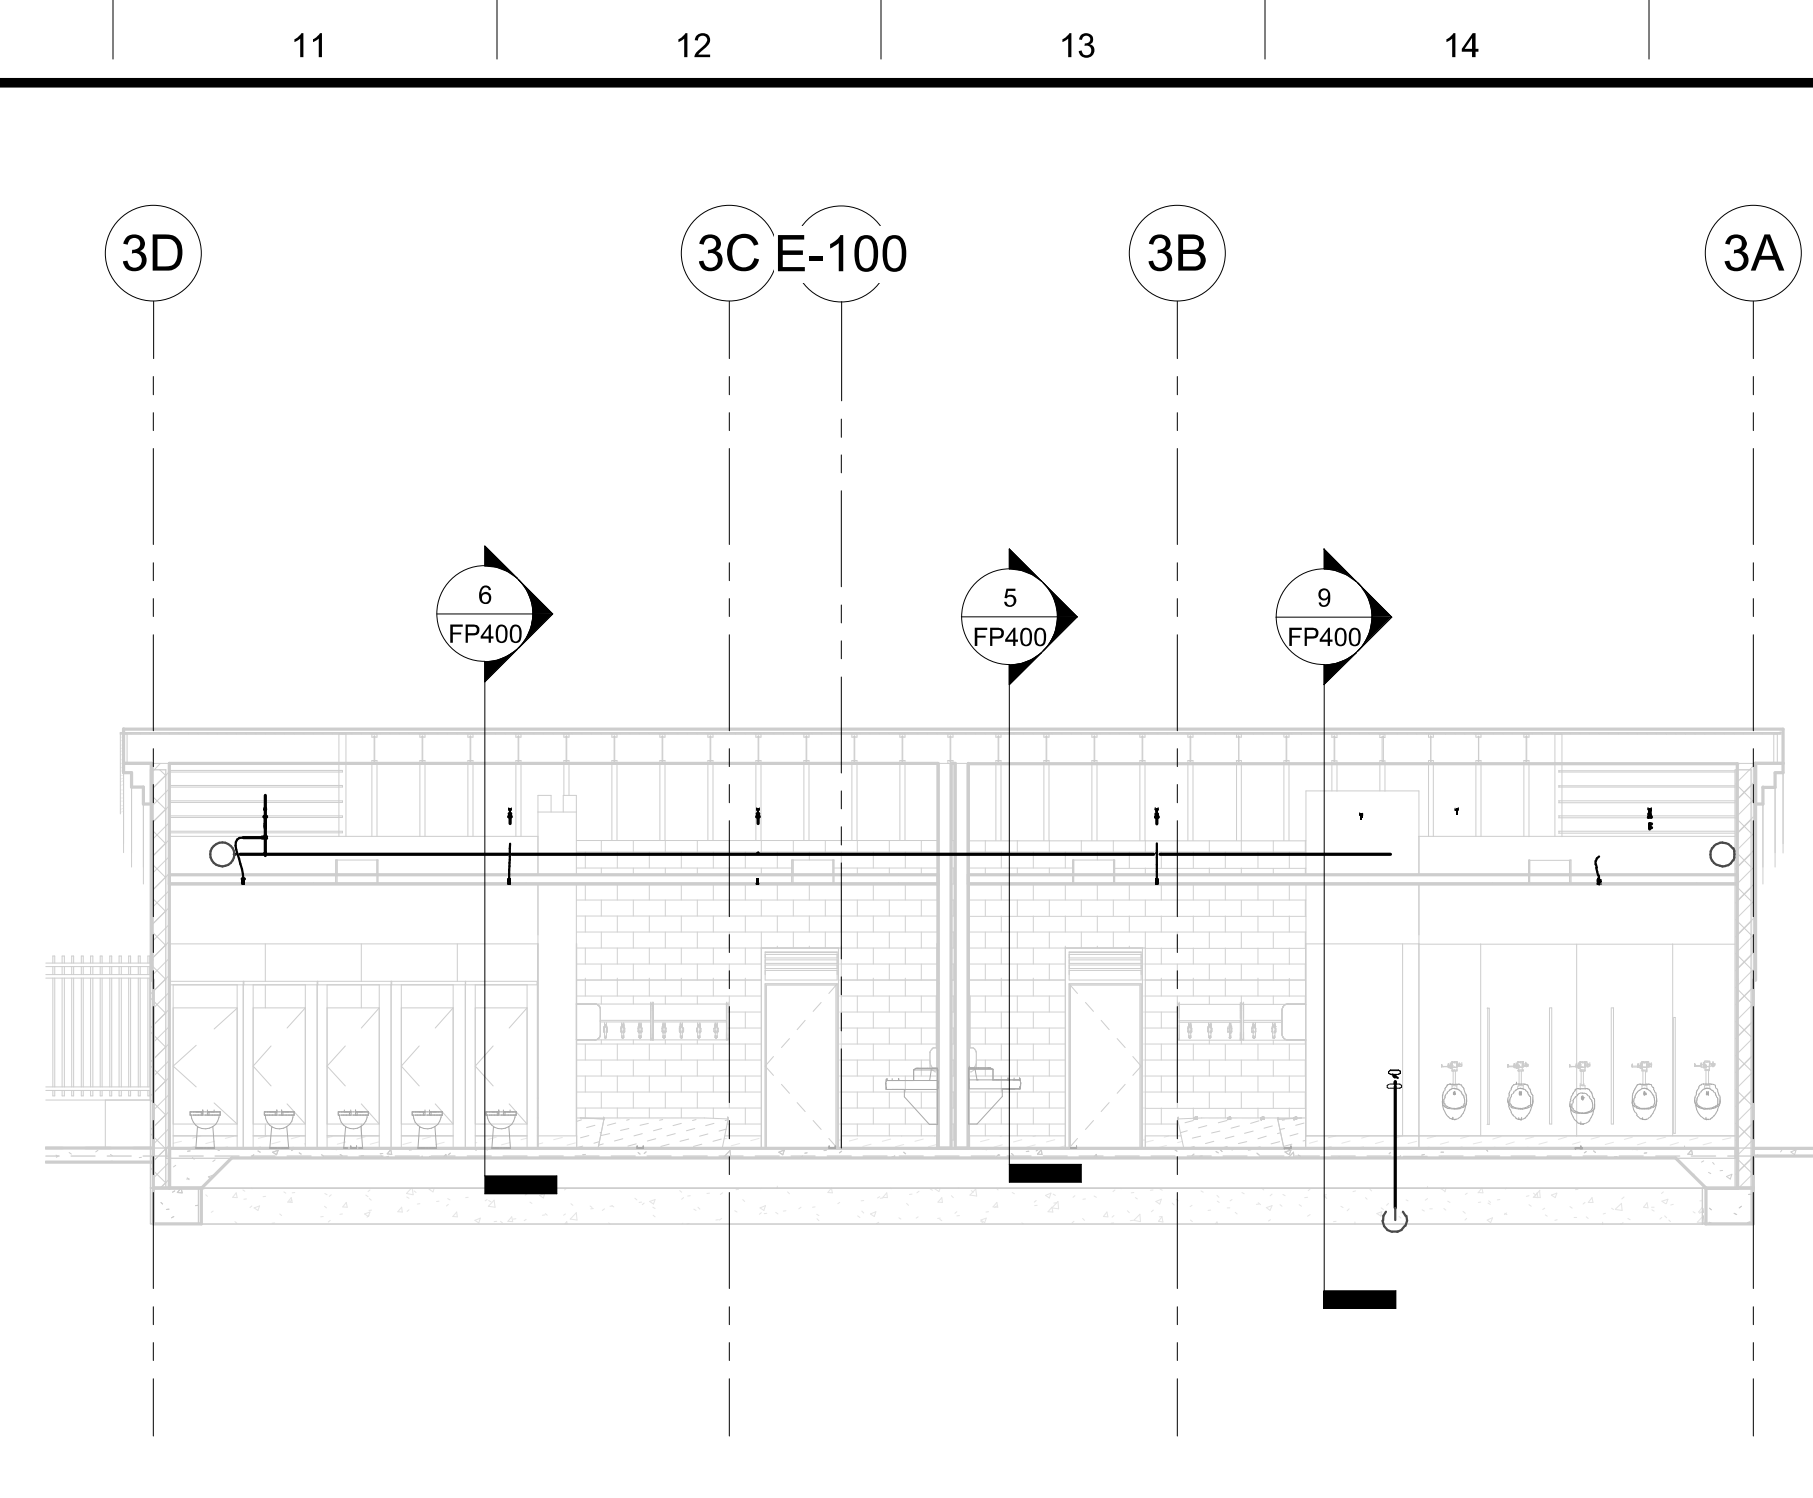



7 BUILDING P3 SOUTH RESTROOMS
1/8" = 1'-0"

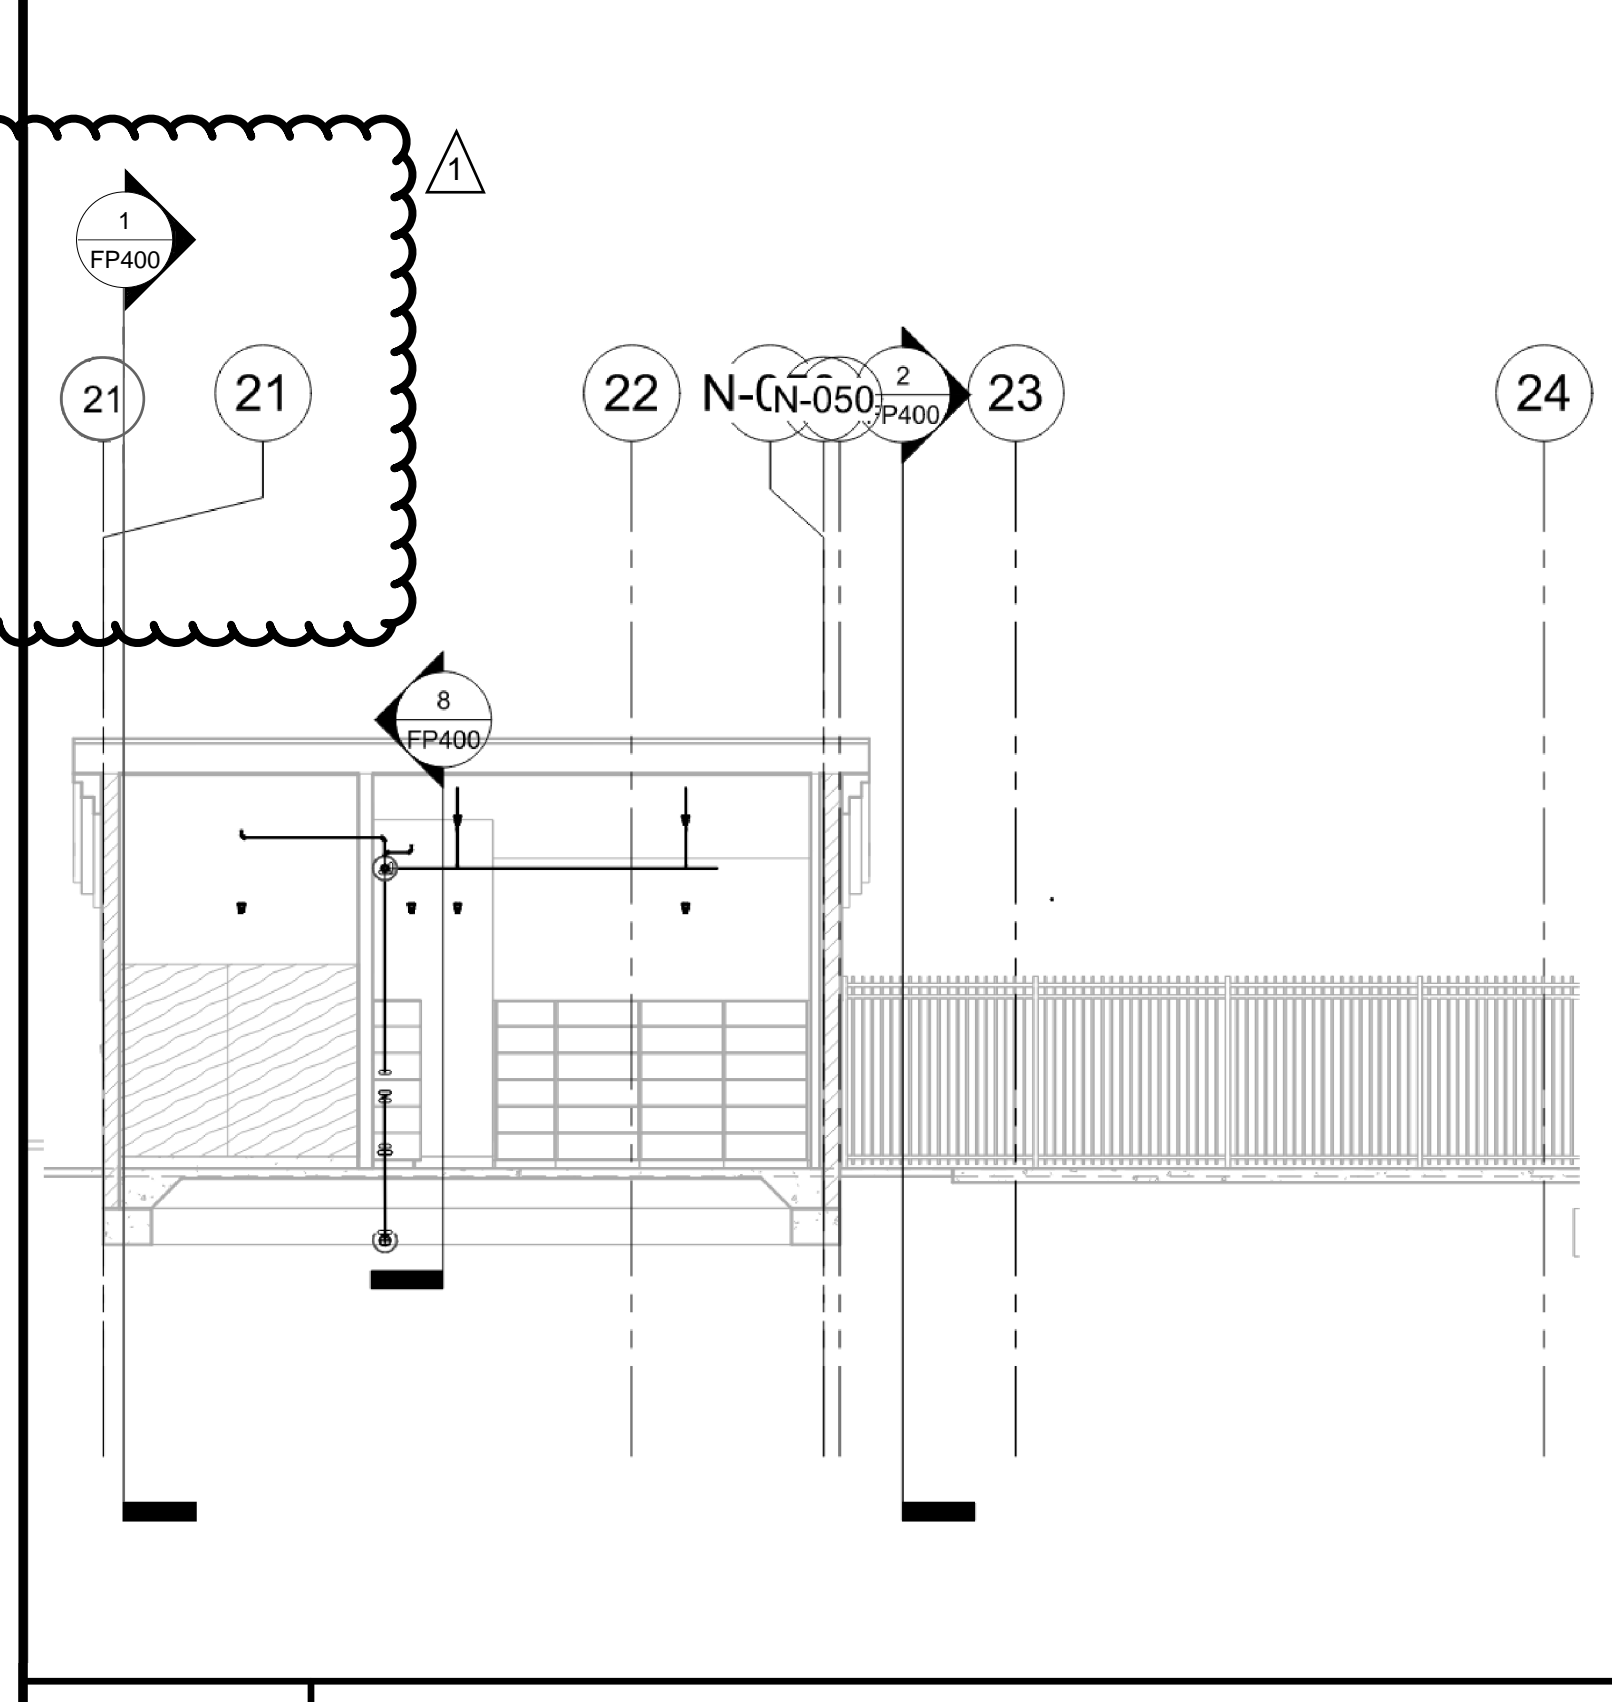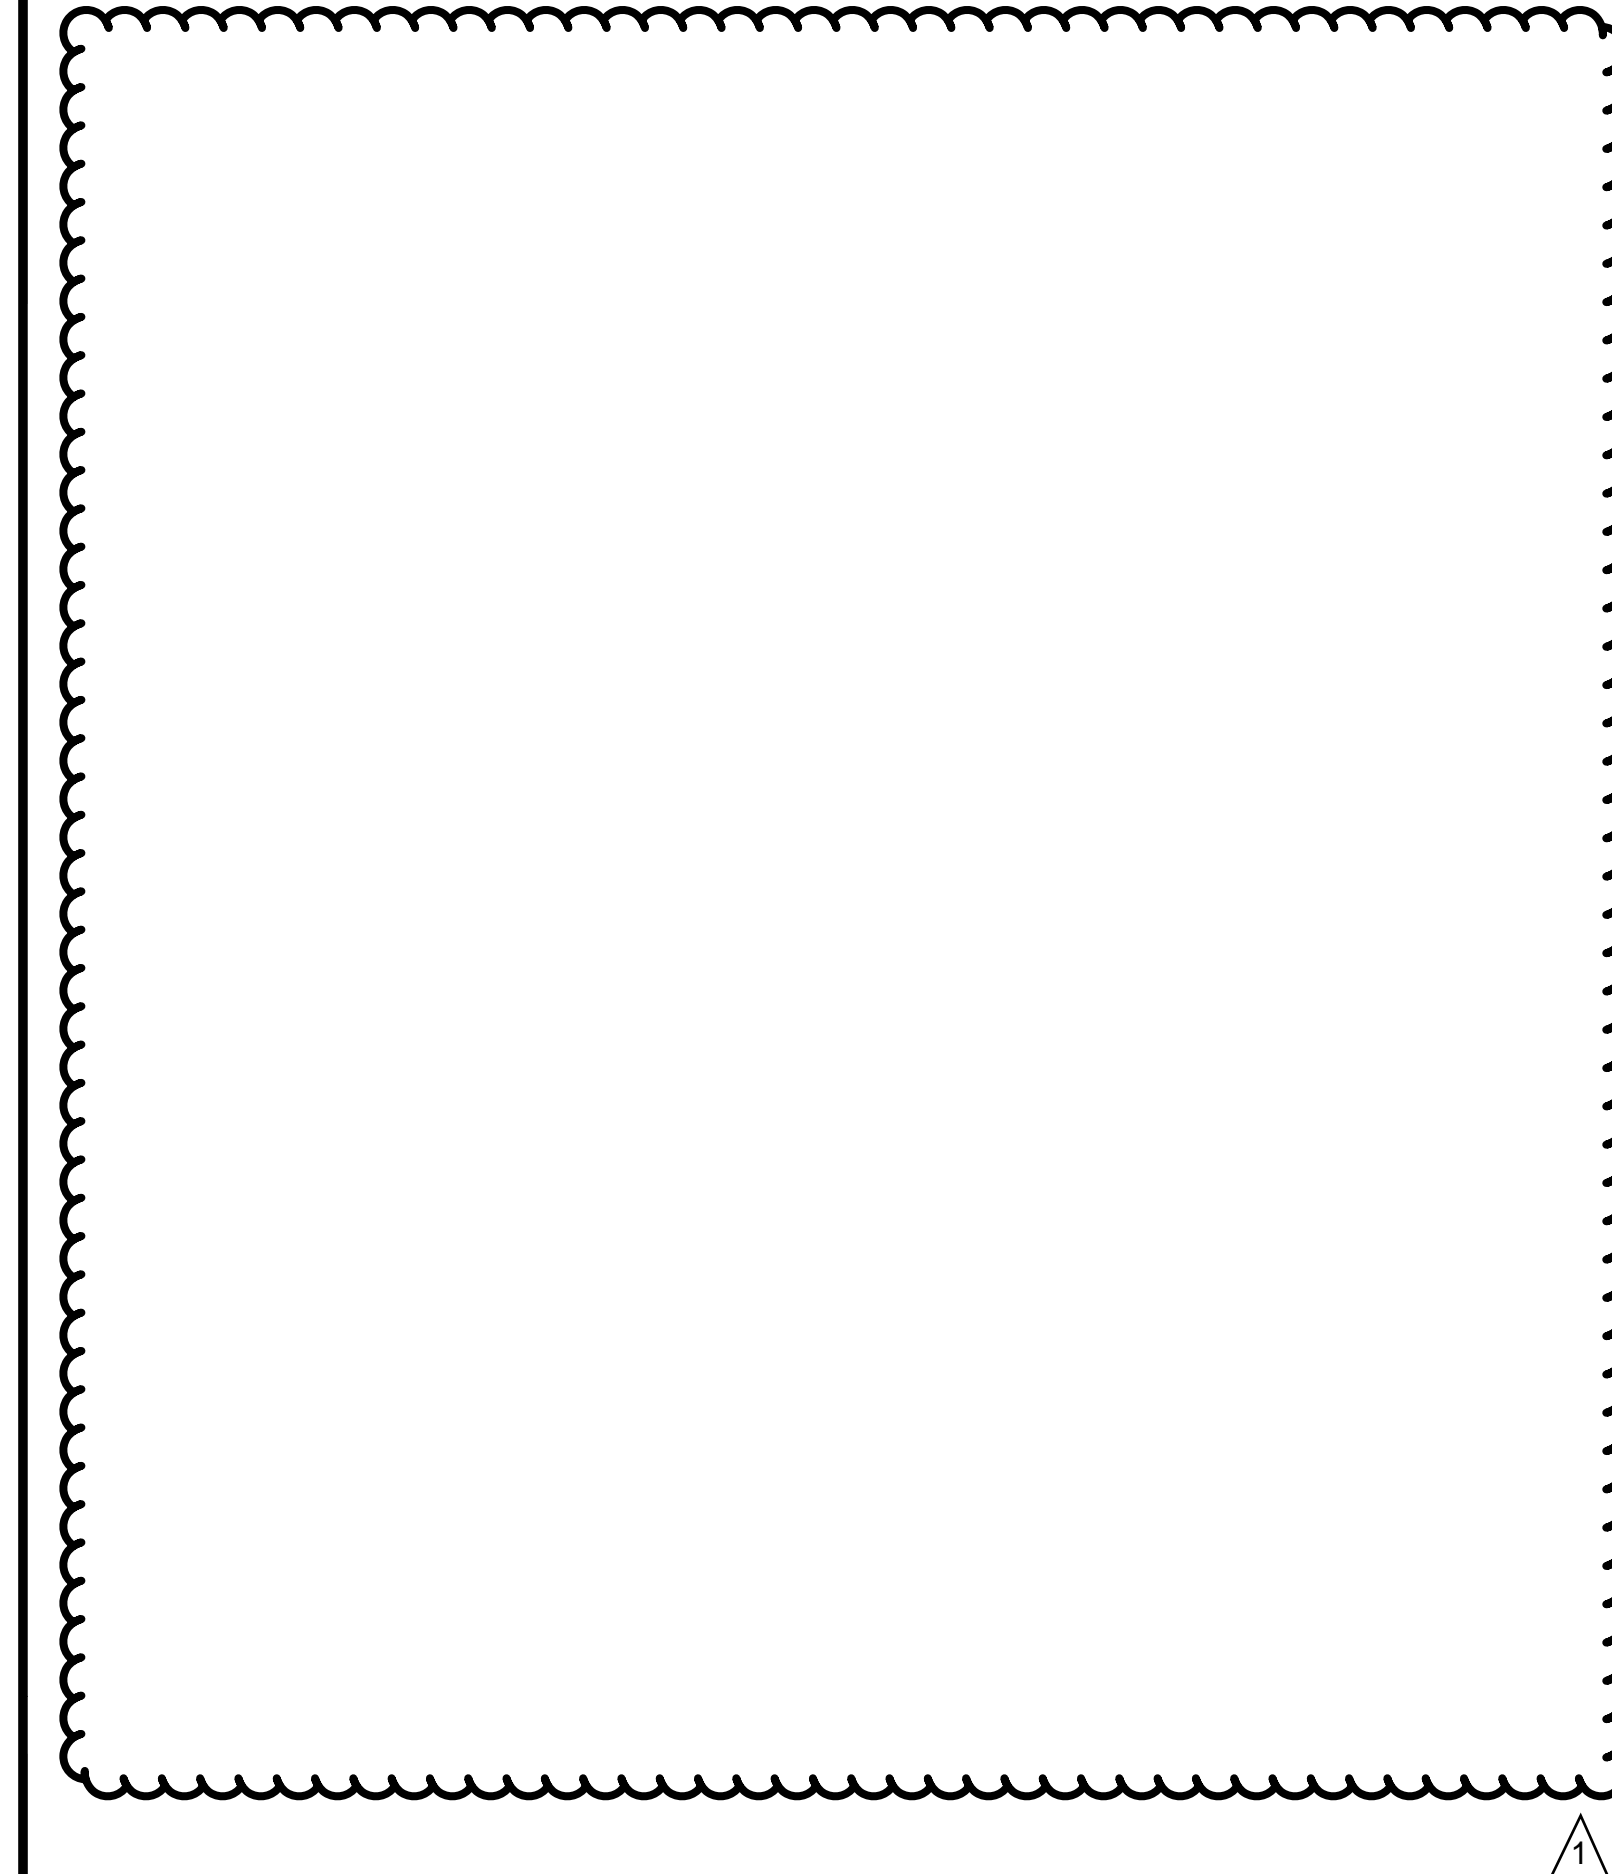

3 BUILDING P2 WEST STORAGE
1/8" = 1'-0"

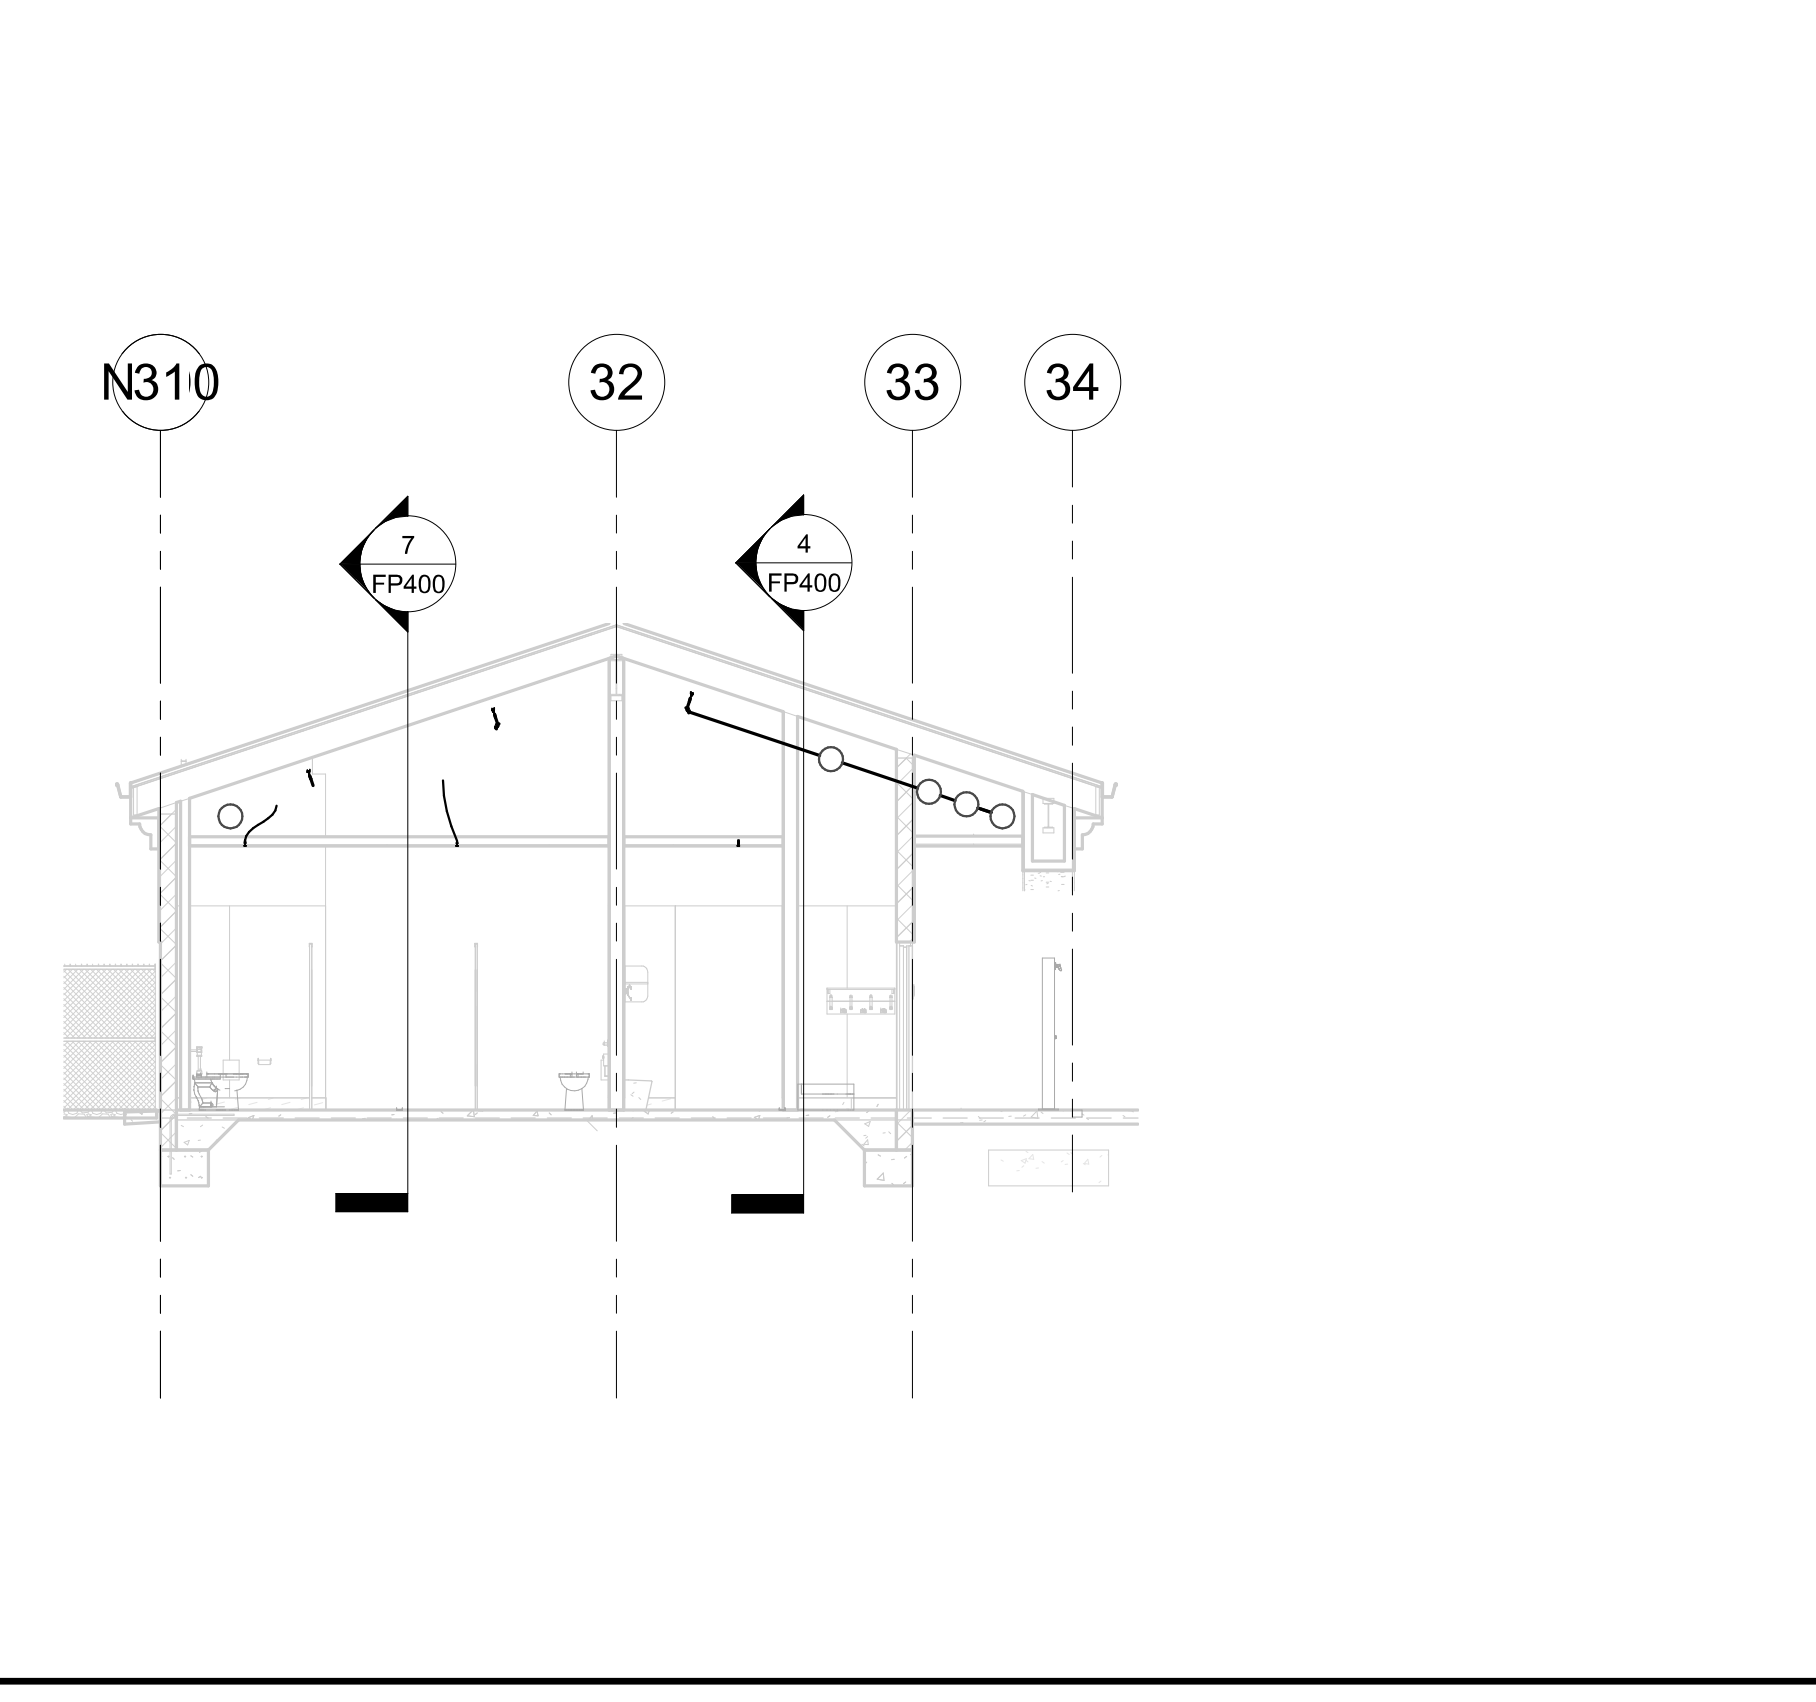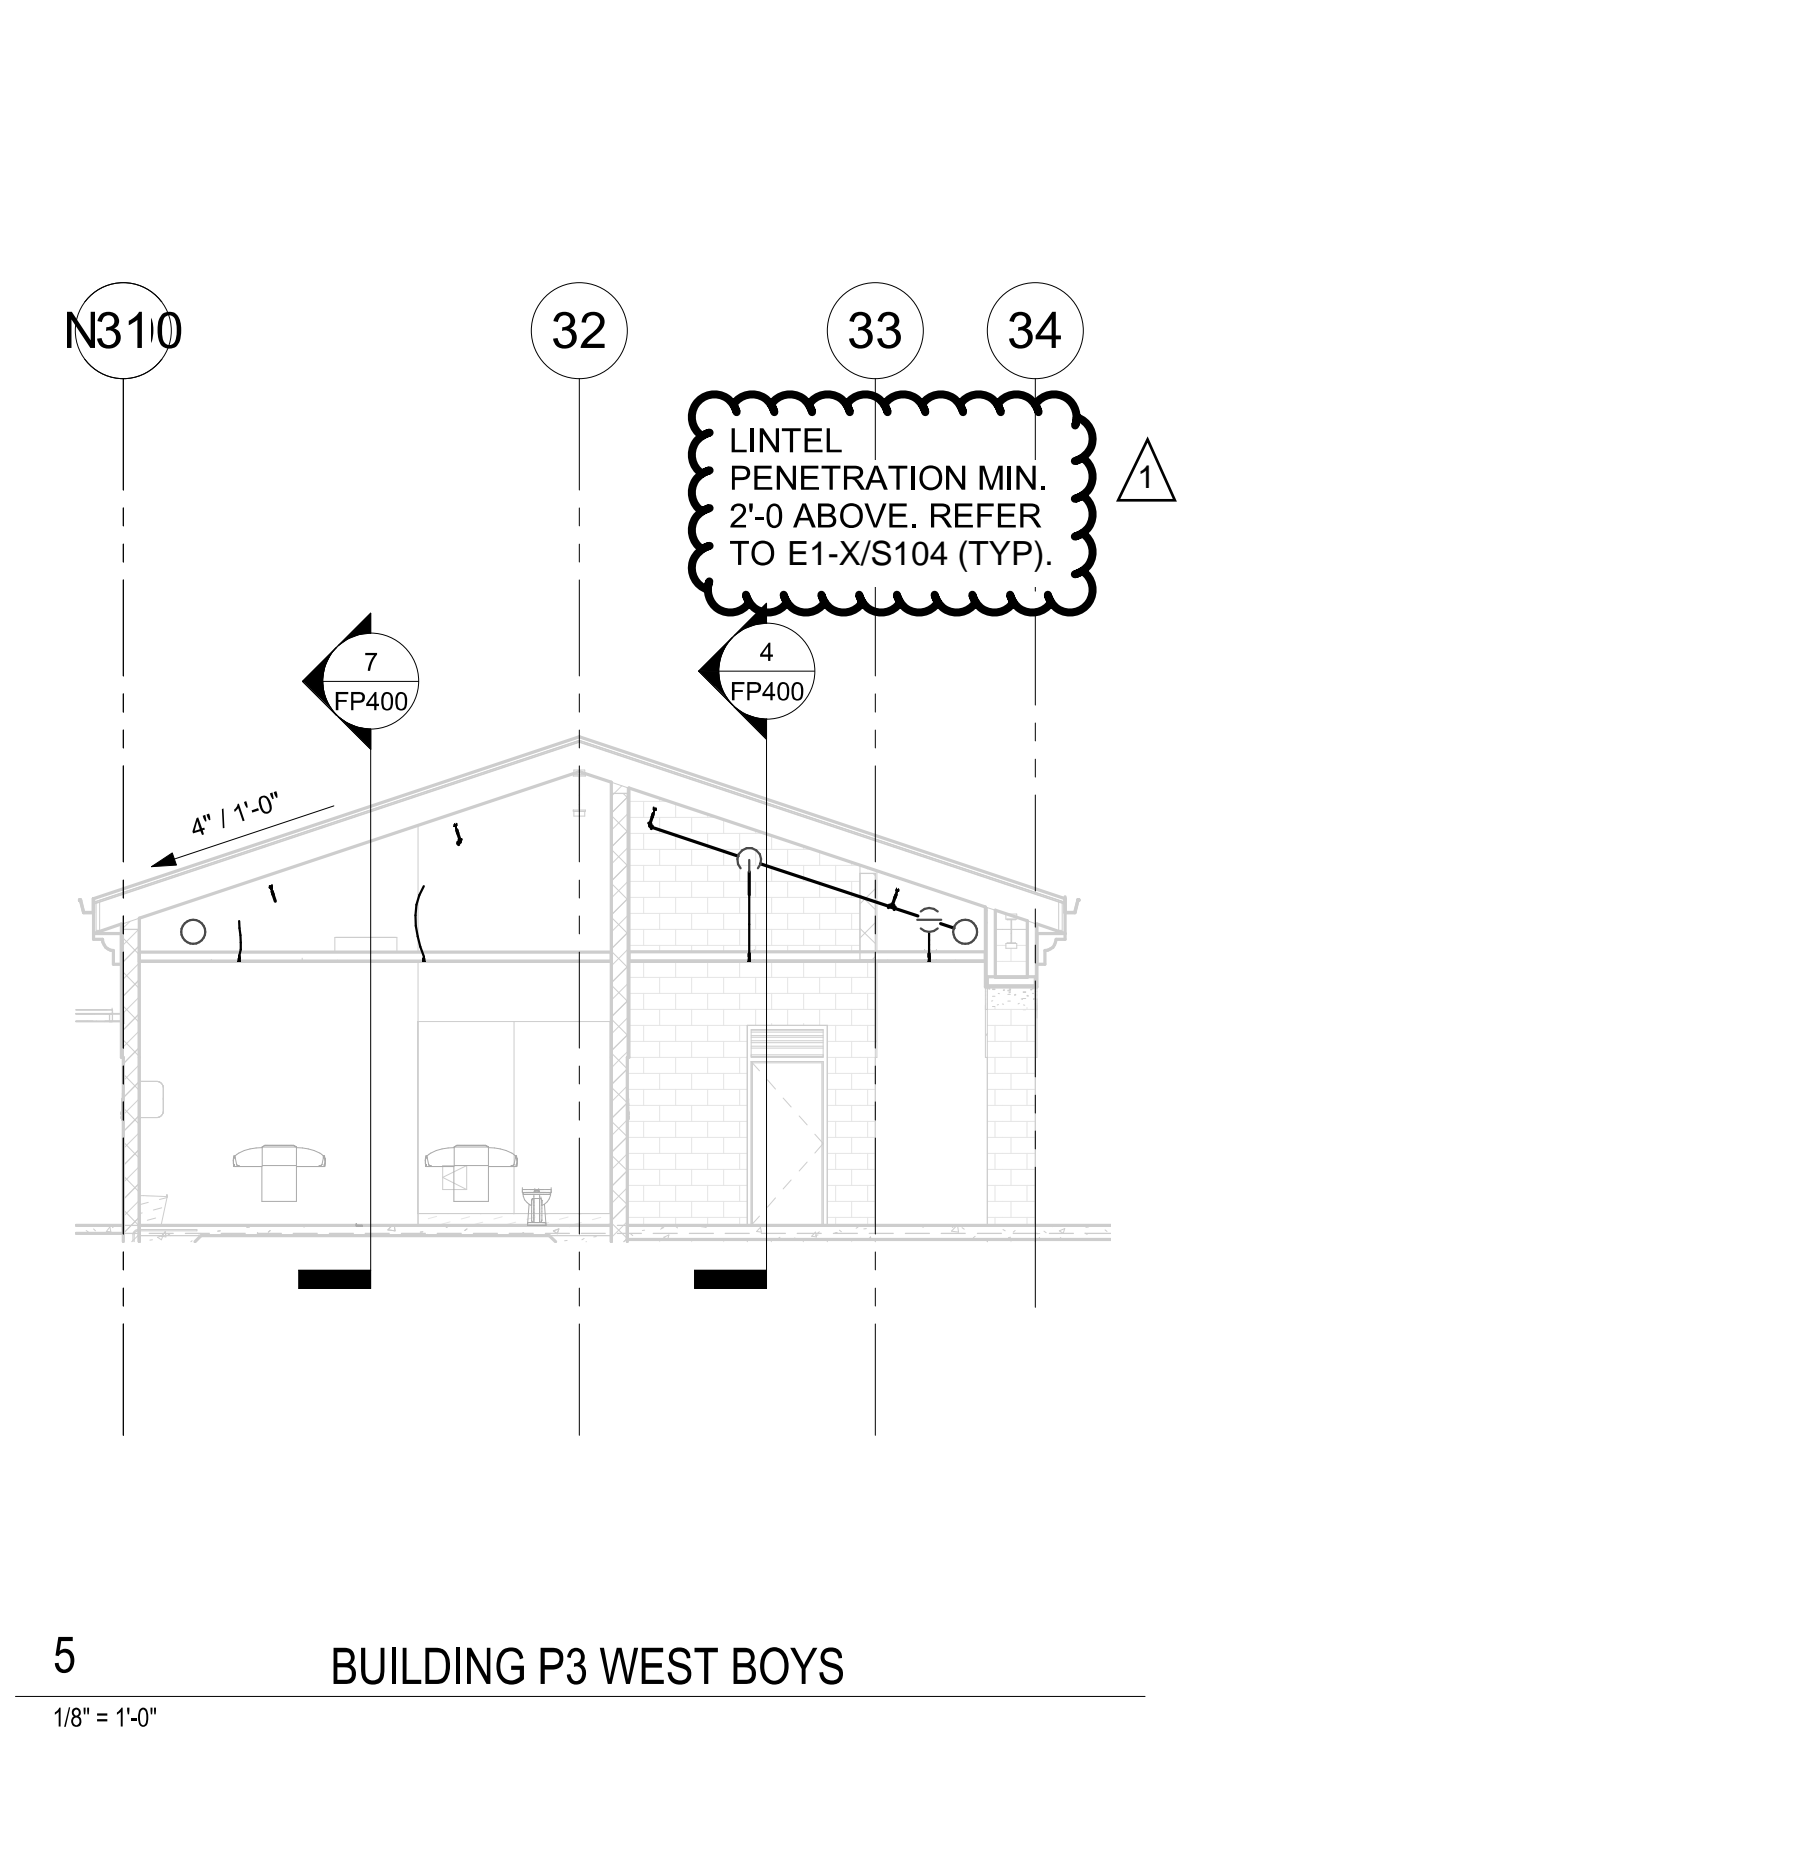

6 BUILDING P3 WEST GIRLS
1/8" = 1'-0"

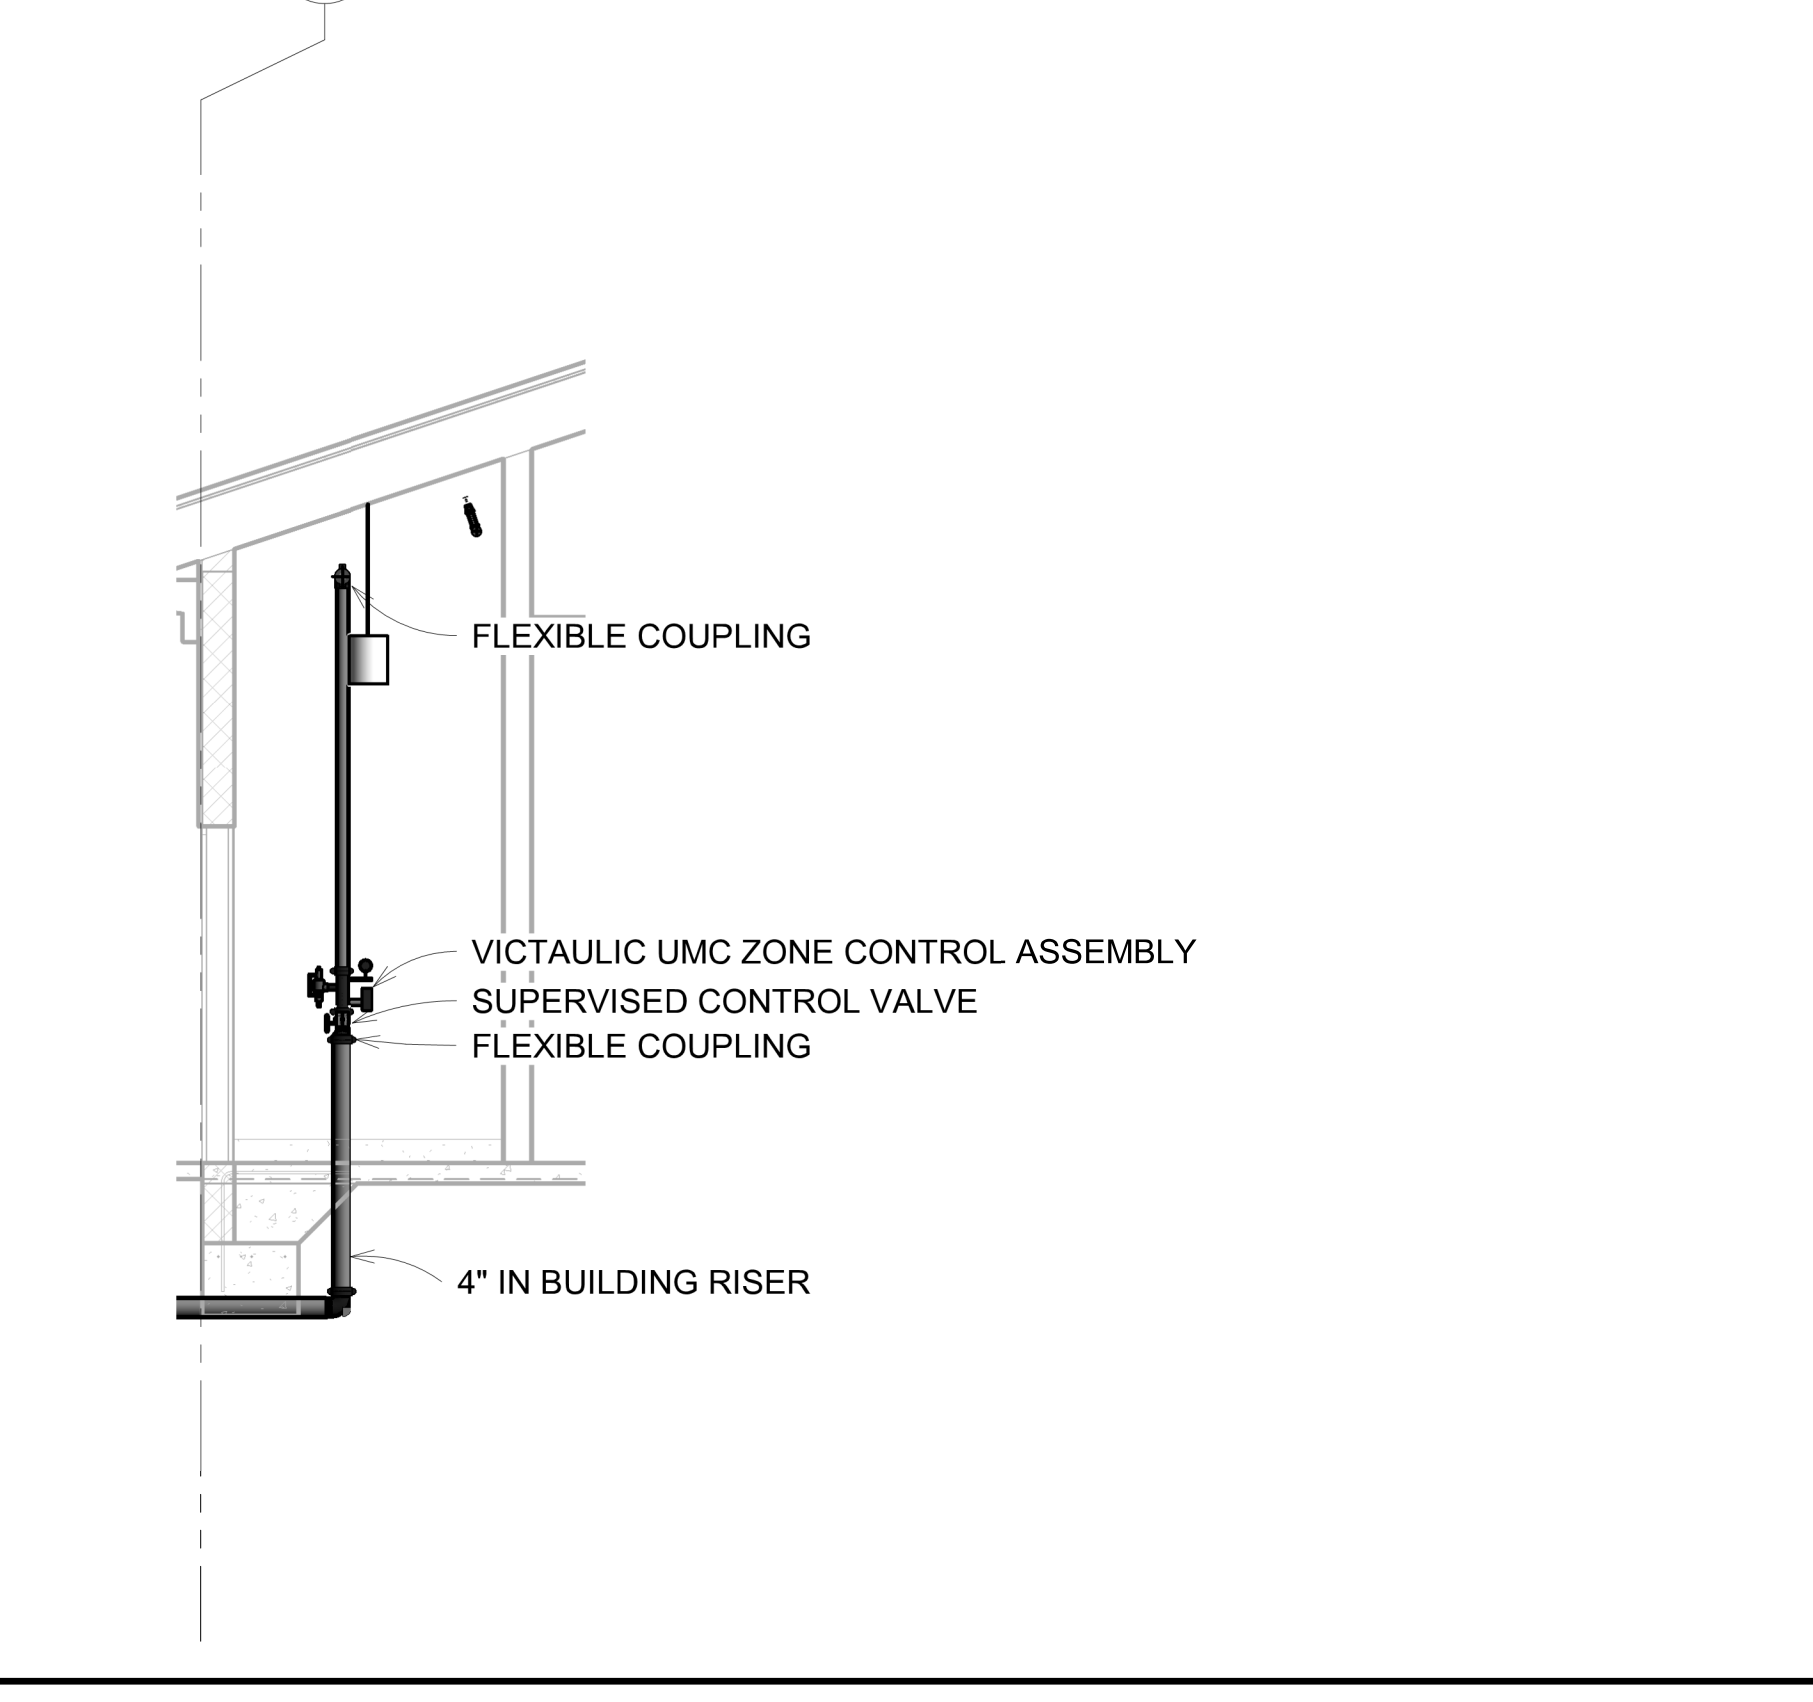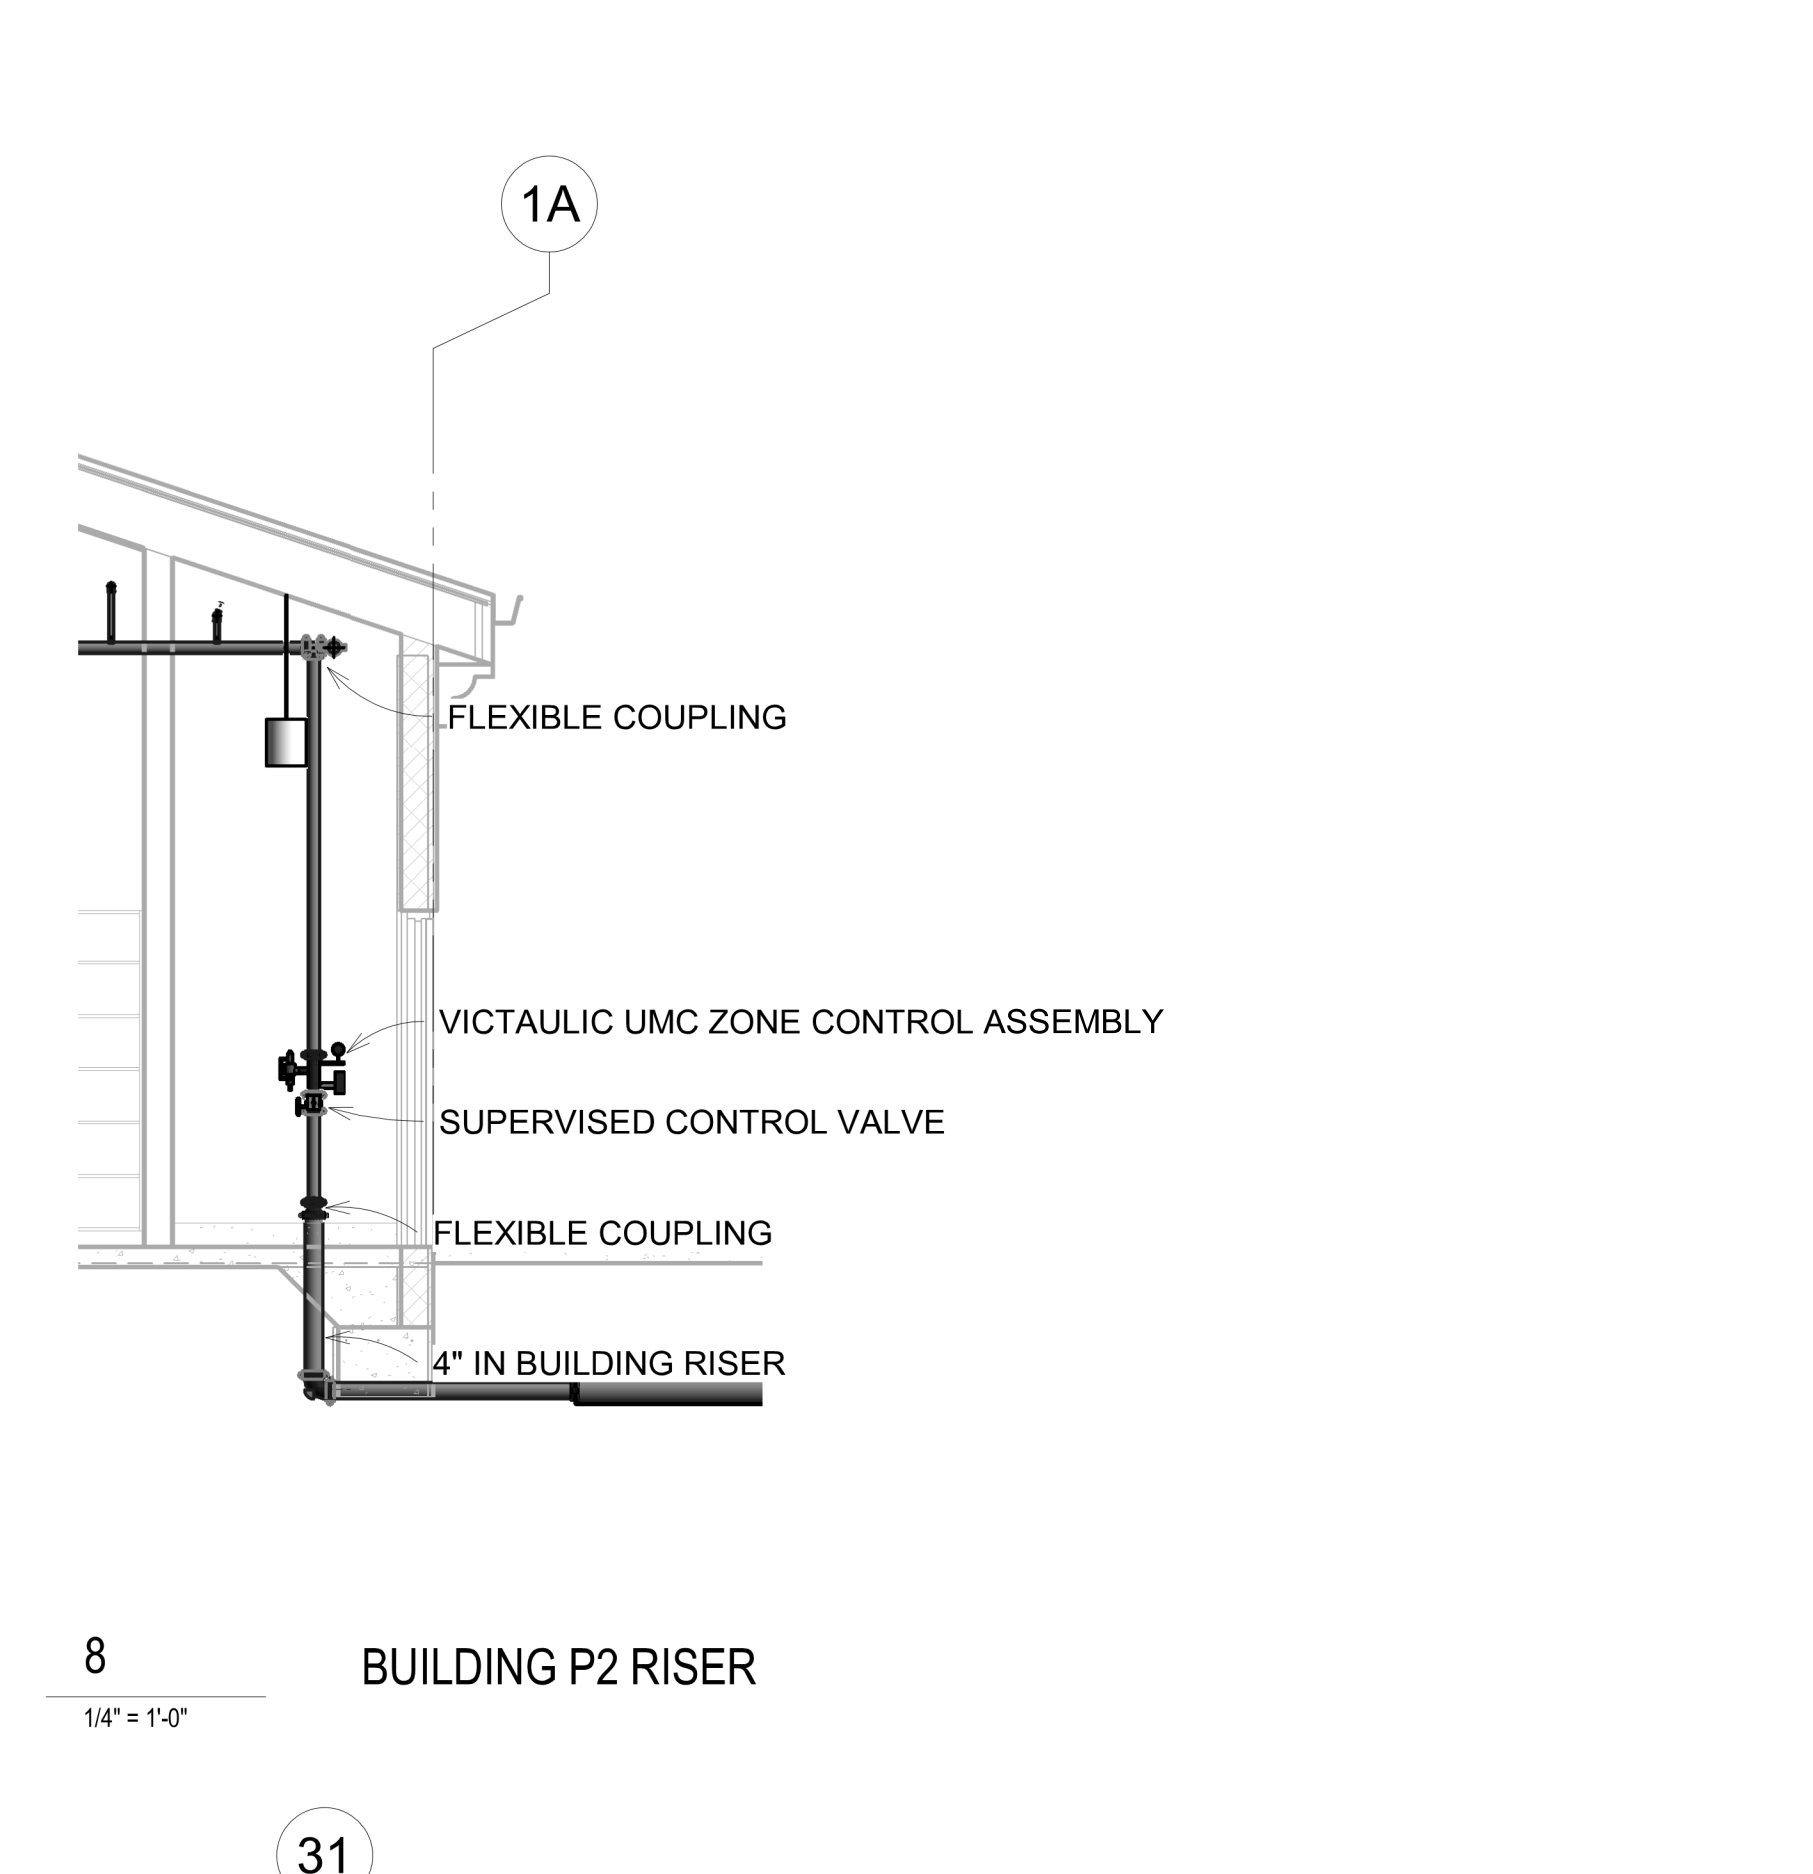

9 BUILDING P3 RISER
1/4" = 1'-0"

DSA File No.:
DSA Application No.:
Agency Approval

GENERAL NOTES
1. All Unistruts shall have the Unistrut Defender Finish.
2. All Rods, Nuts and Screws shall be stainless steel

NET POSITIVE
consulting
engineers
www.NPCEng.com
project no. 1101
Consultant

Mission Oaks HS Aquatic Complex
Tulare Joint Union High School District
Tulare, CA 93274
Project


BUILDING P
FIRE PROTECTION - BLDG. P2 & P3 SECTION VIEWS
Drawing

darden ARCHITECTURE
PLANNING
INTERIORS
architects
www.dardenarchitects.com
6790 N. West Ave. • Fresno, CA 93711 • T. 559.448.8051
Architect


No.	Revision/Submission	Date
1	REVISION_01	05/31/2023
Revision		
Designed By:	WC	Copyright 2022 Darden Architects
Scale:	As indicated	Drawn By: CC
Project Number:	2180	Checked By: NP
Date:	01/20/2023	Reviewed By: DSA

FP400


1/23/2023 7:46:37 PM C:\Users\waco\Box\Projects\2022\22-014 - NPCEng - Mission Oaks Aquatic Center\22-014 - NPCEng - Mission Oaks Aquatic Center\2 - Submittals\Drawings\22-014 - Mission Oaks Aquatic Ctr - FP - R01.rvt

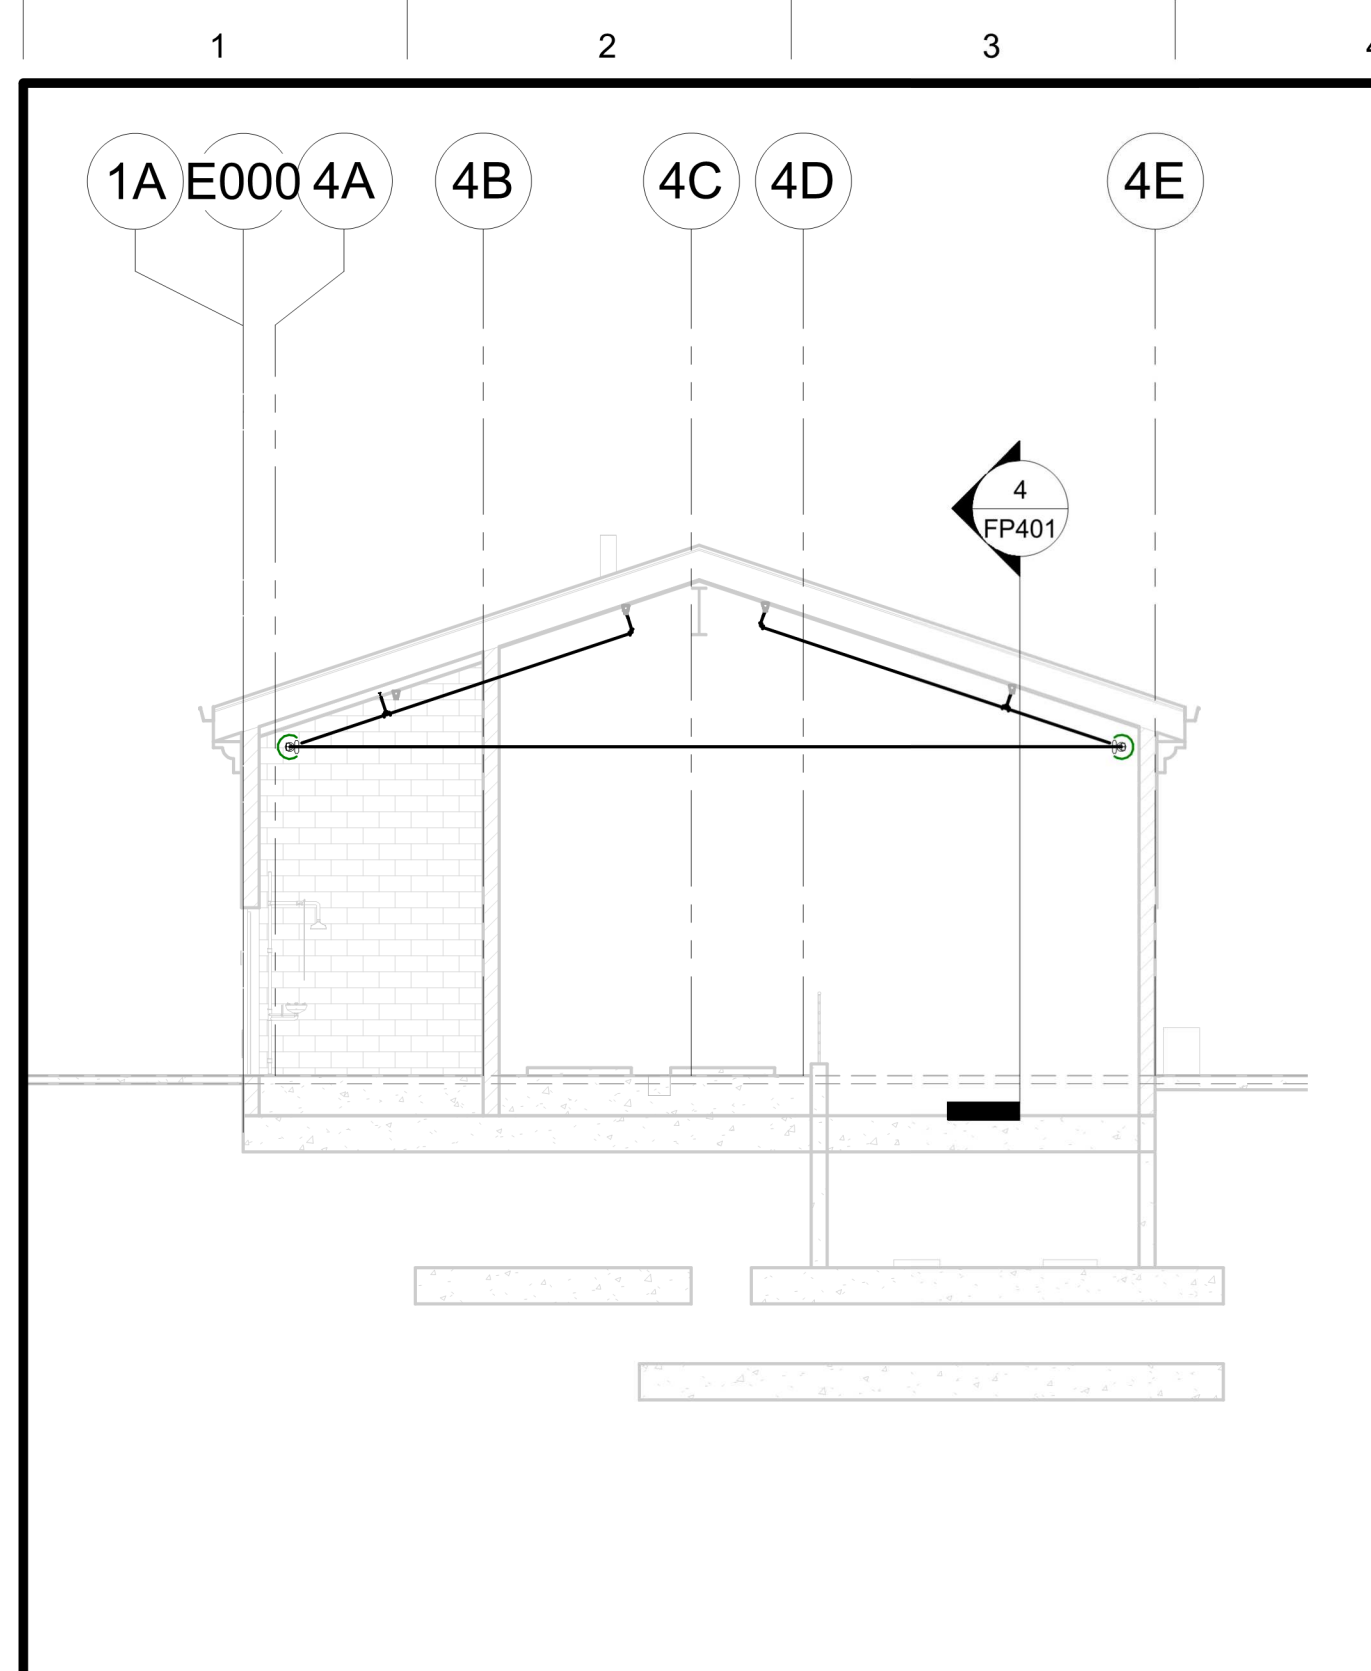


1 BUILDING P4 NORTH POOL EQUIPMENT
1/8" = 1'-0"

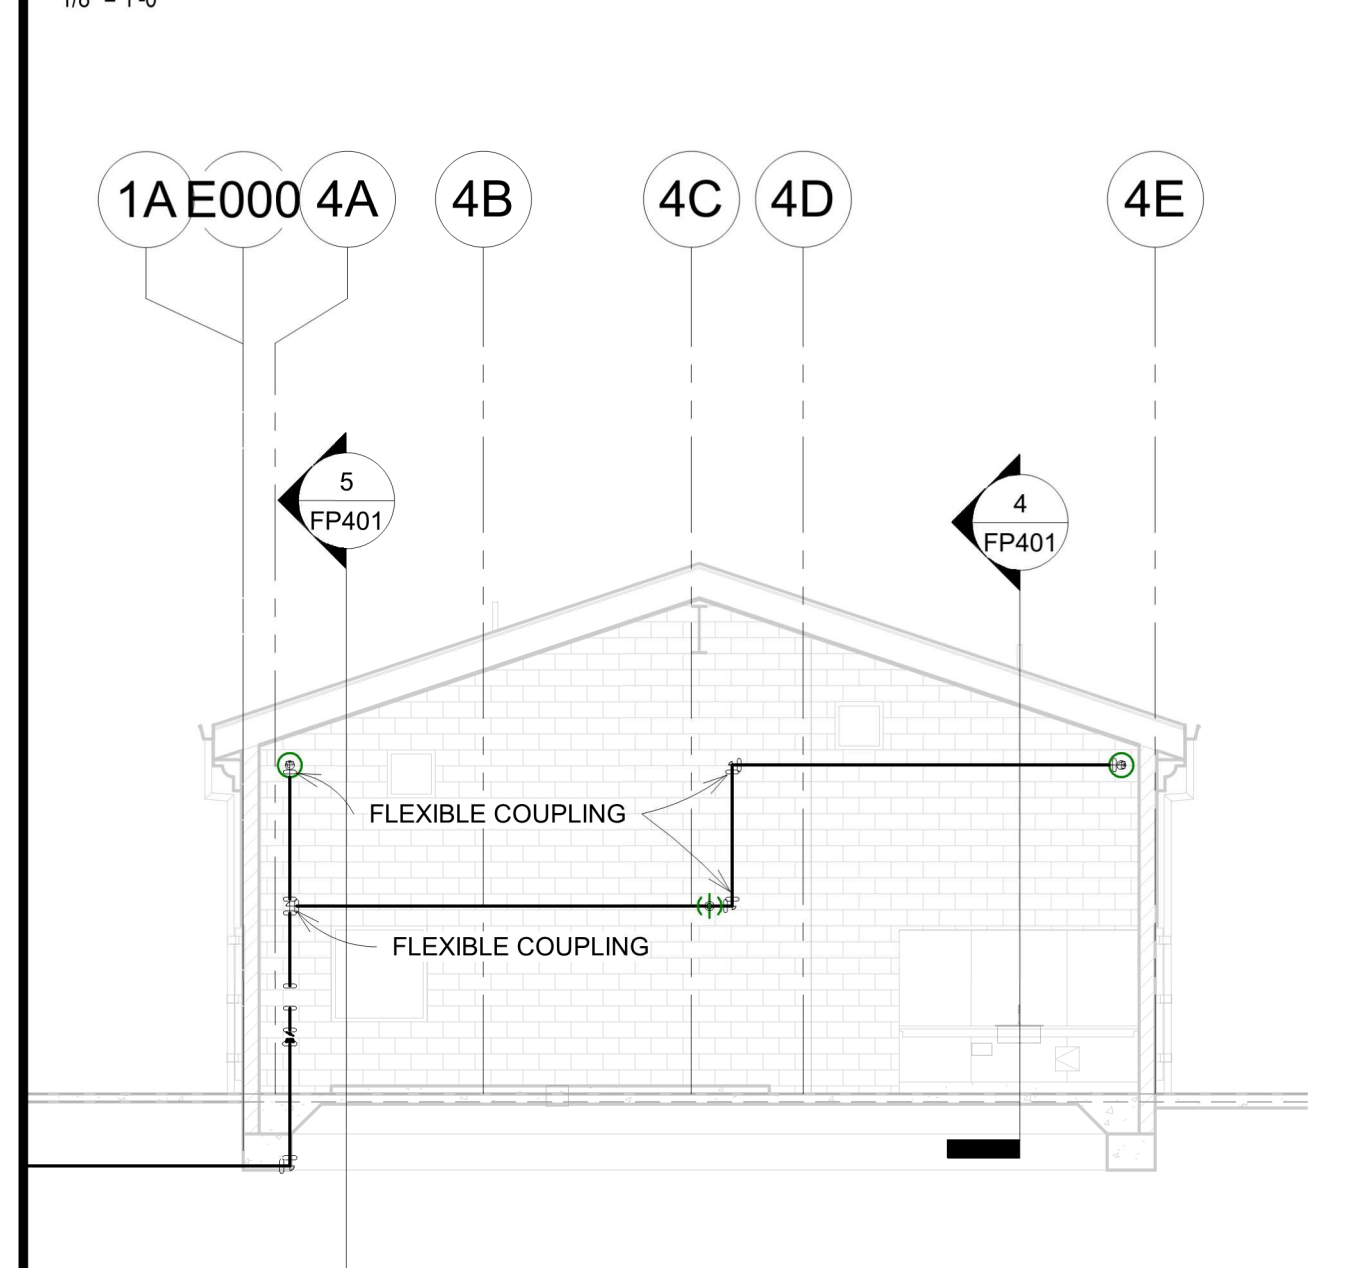


2 BUILDING P4 POOL EQUIP TO STORAGE
1/8" = 1'-0"

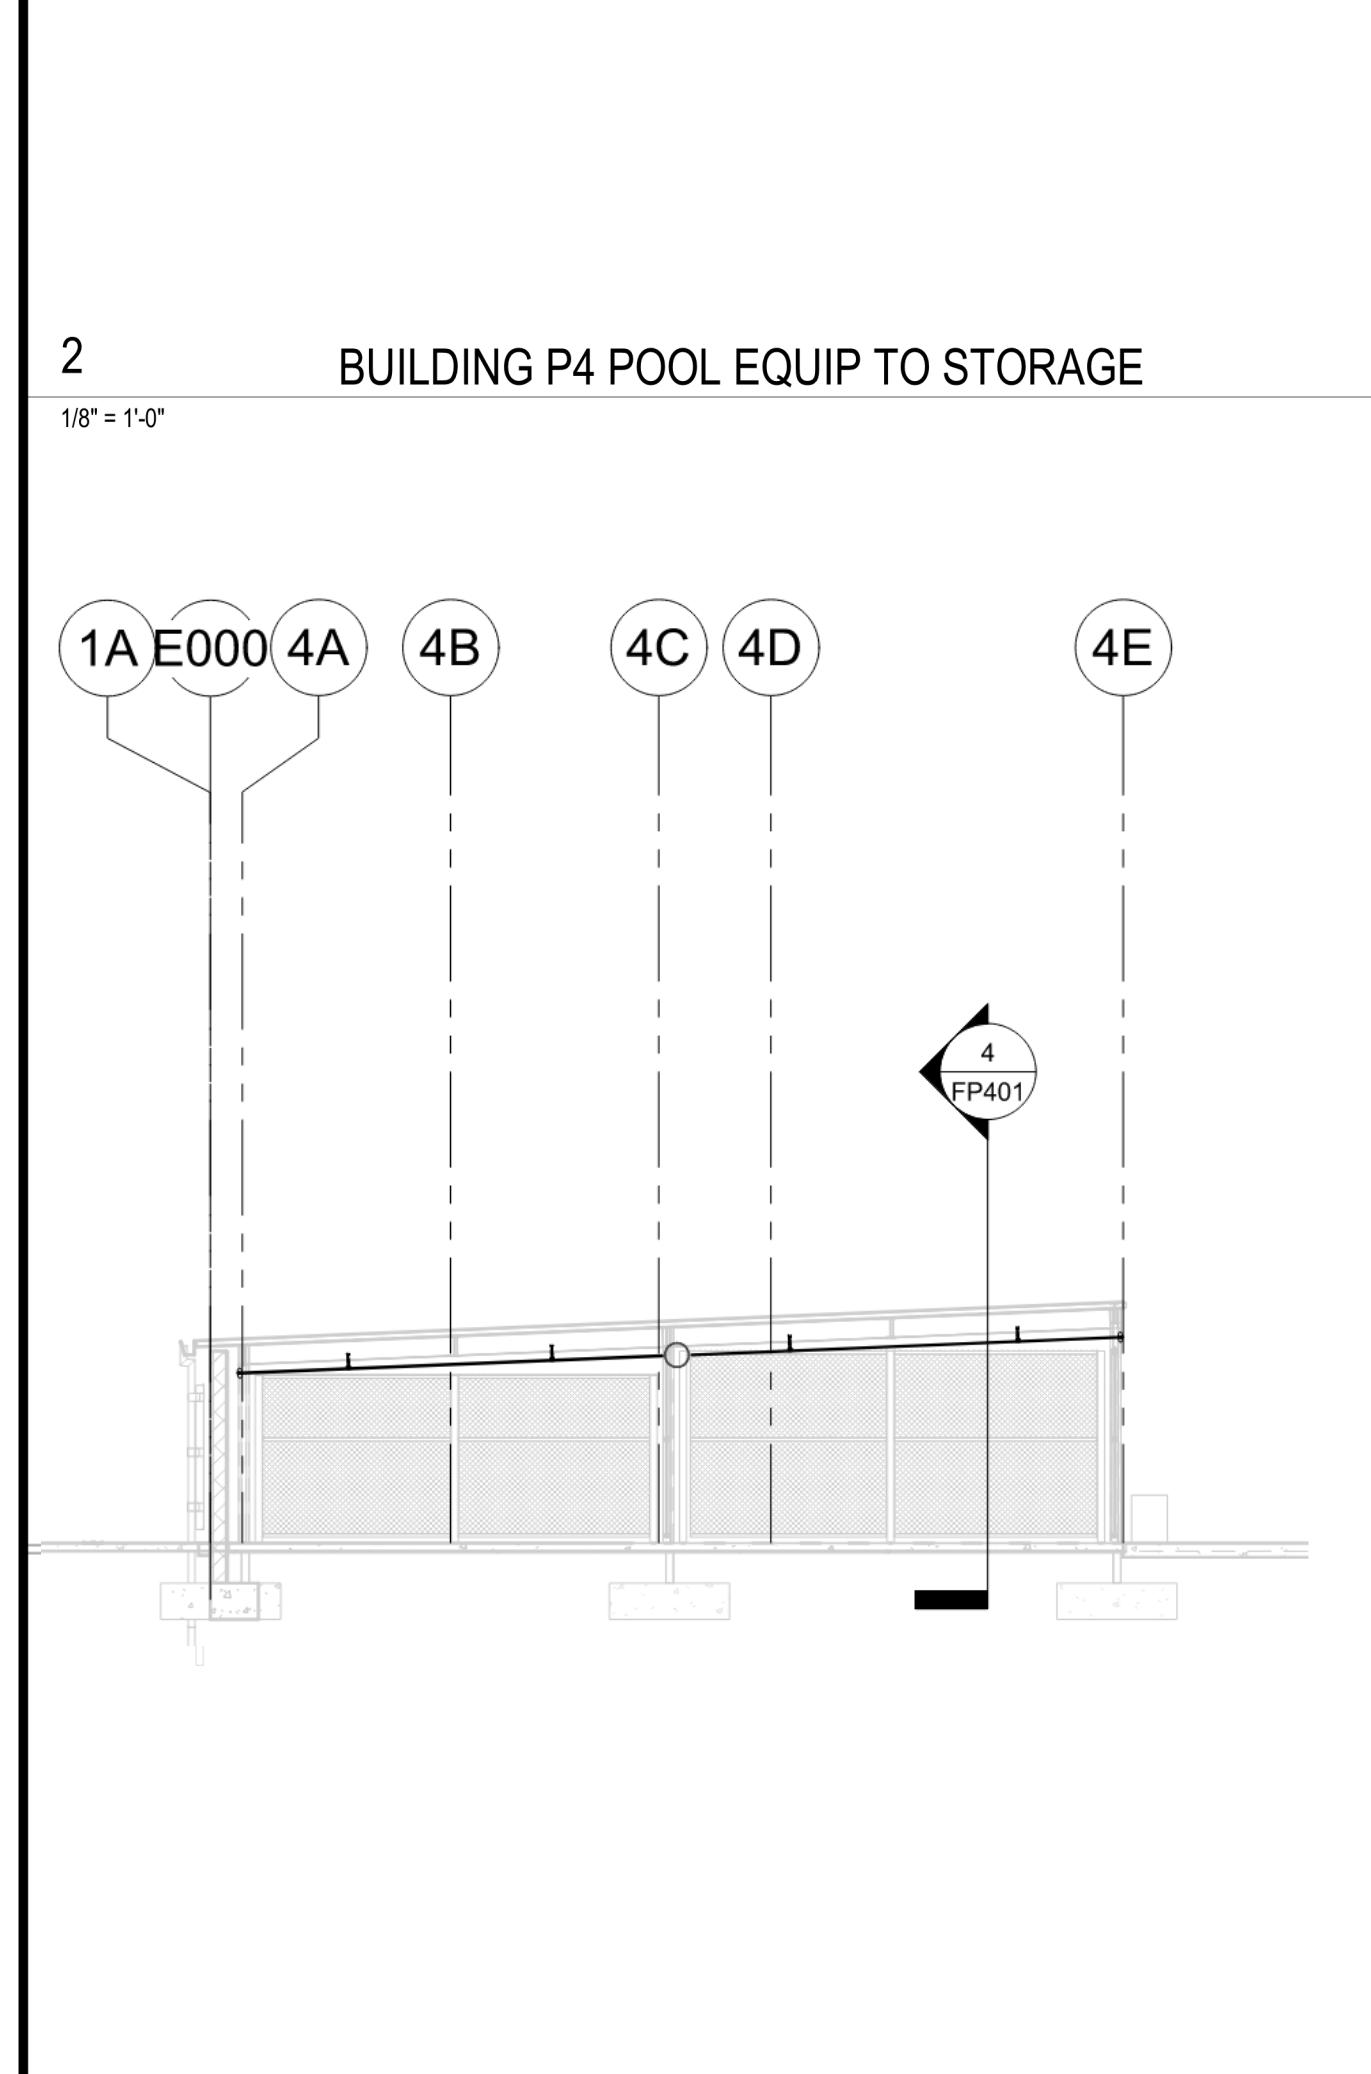

3 BUILDING P4 STORAGE
1/8" = 1'-0"

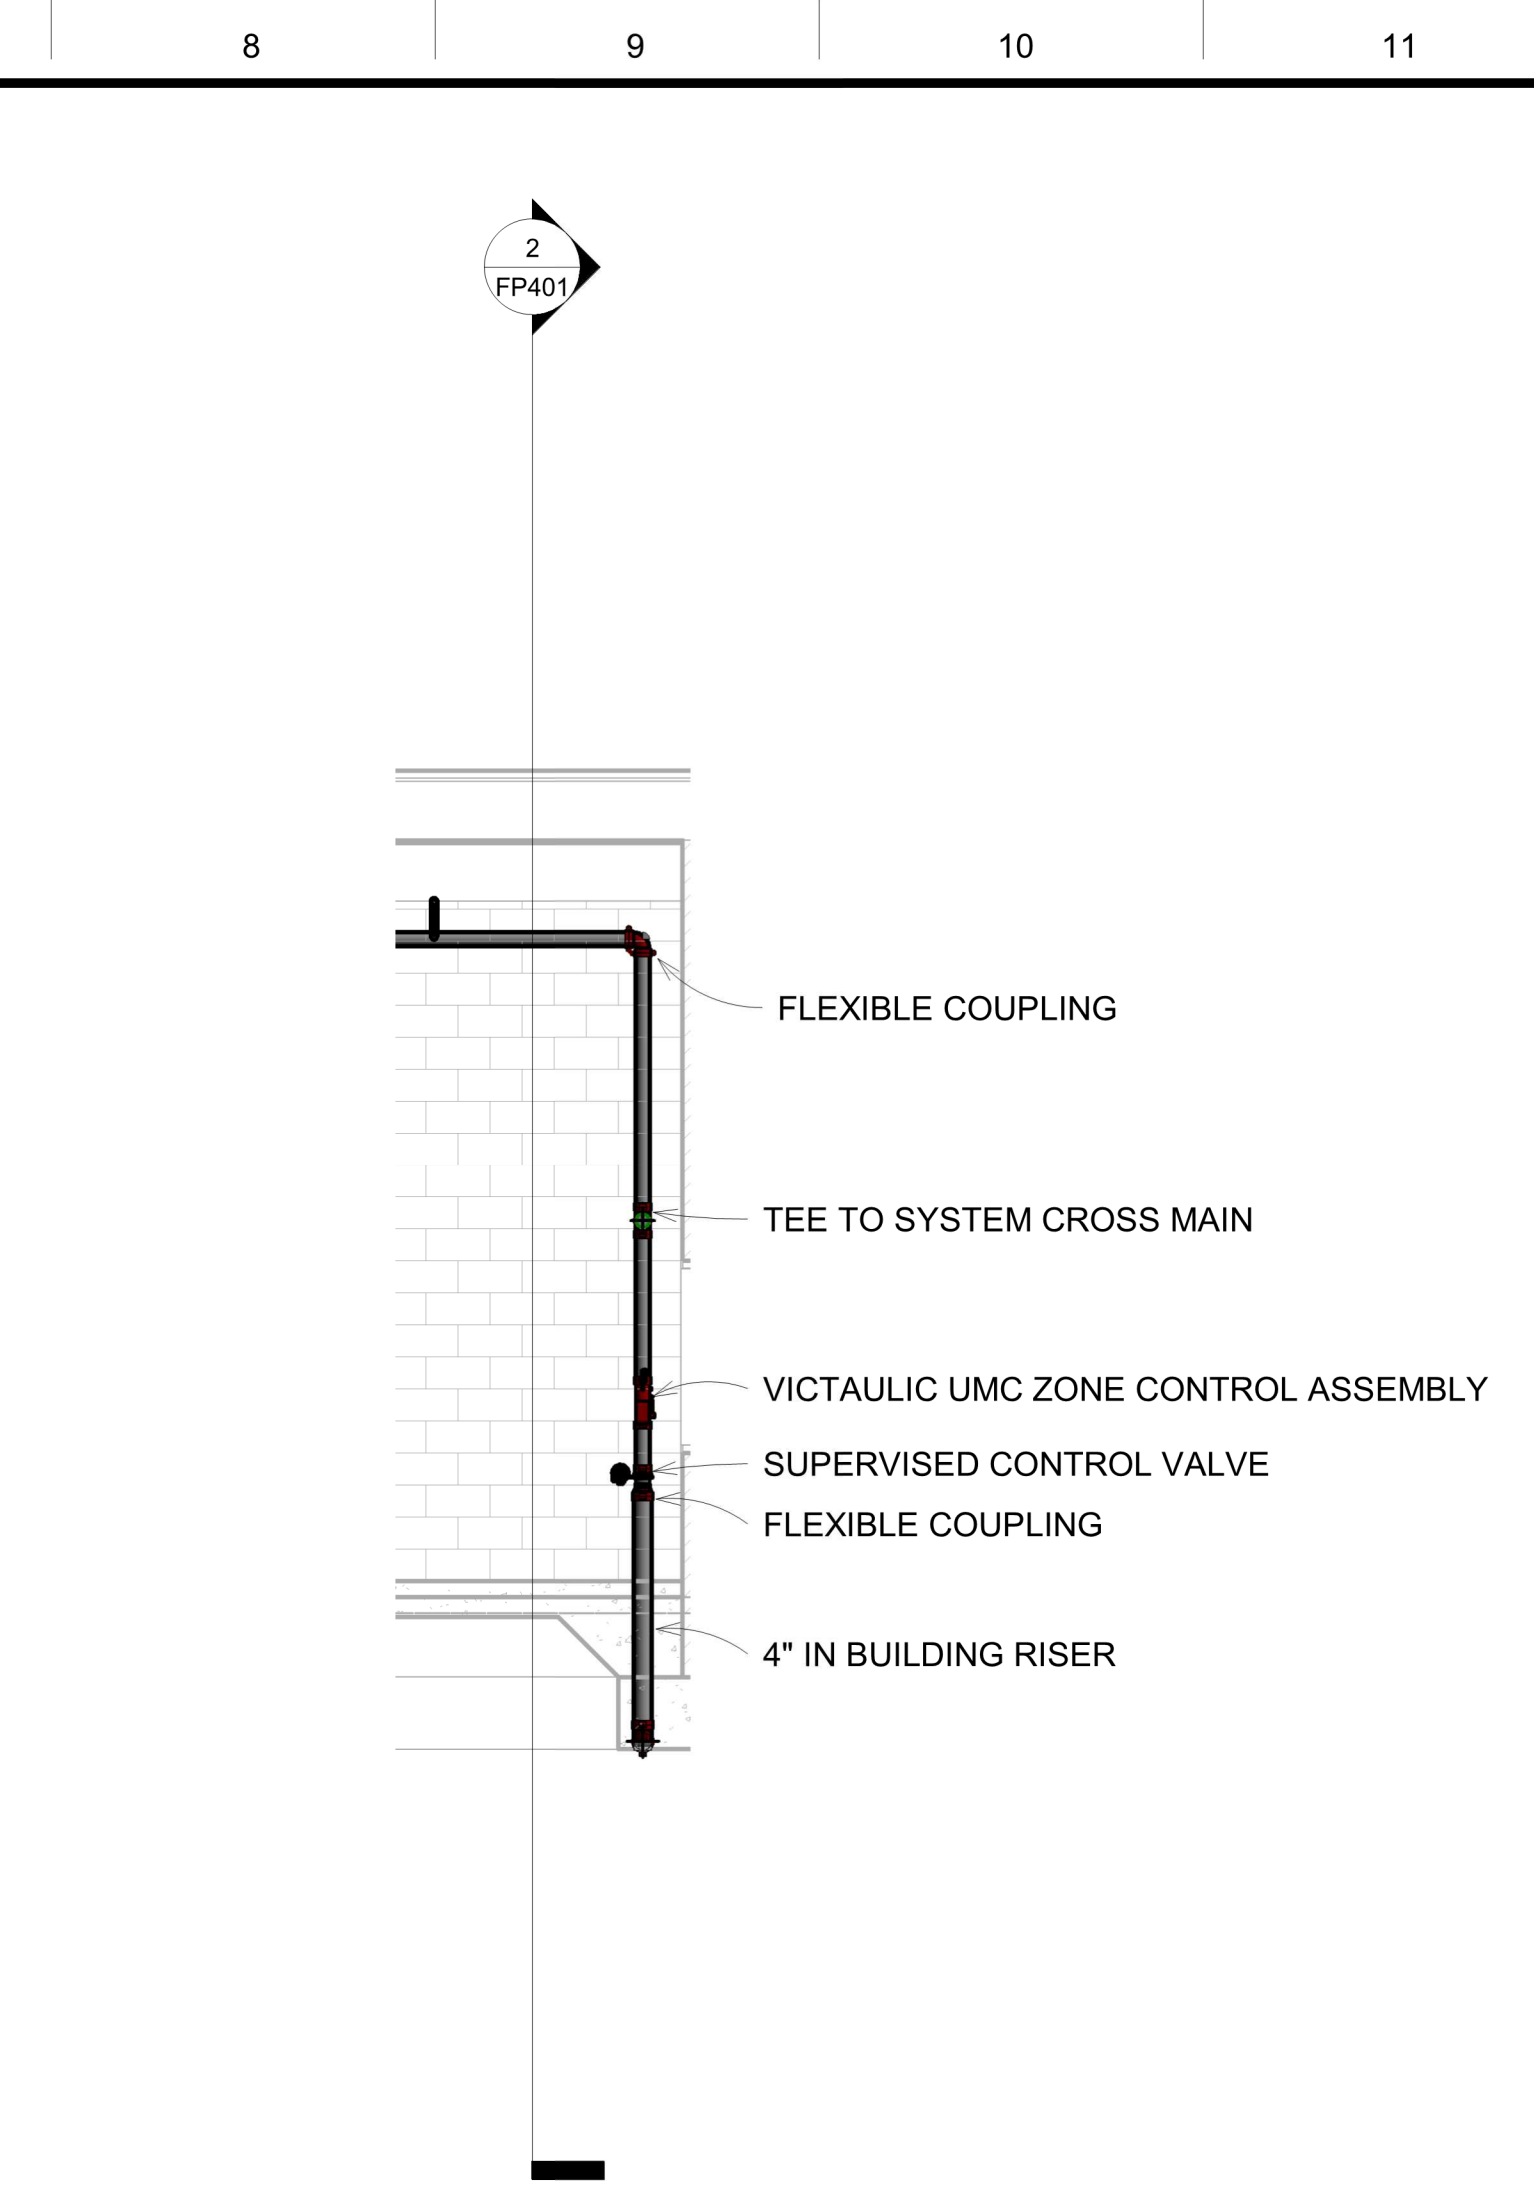

5 BUILDING P4 RISER
1/4" = 1'-0"

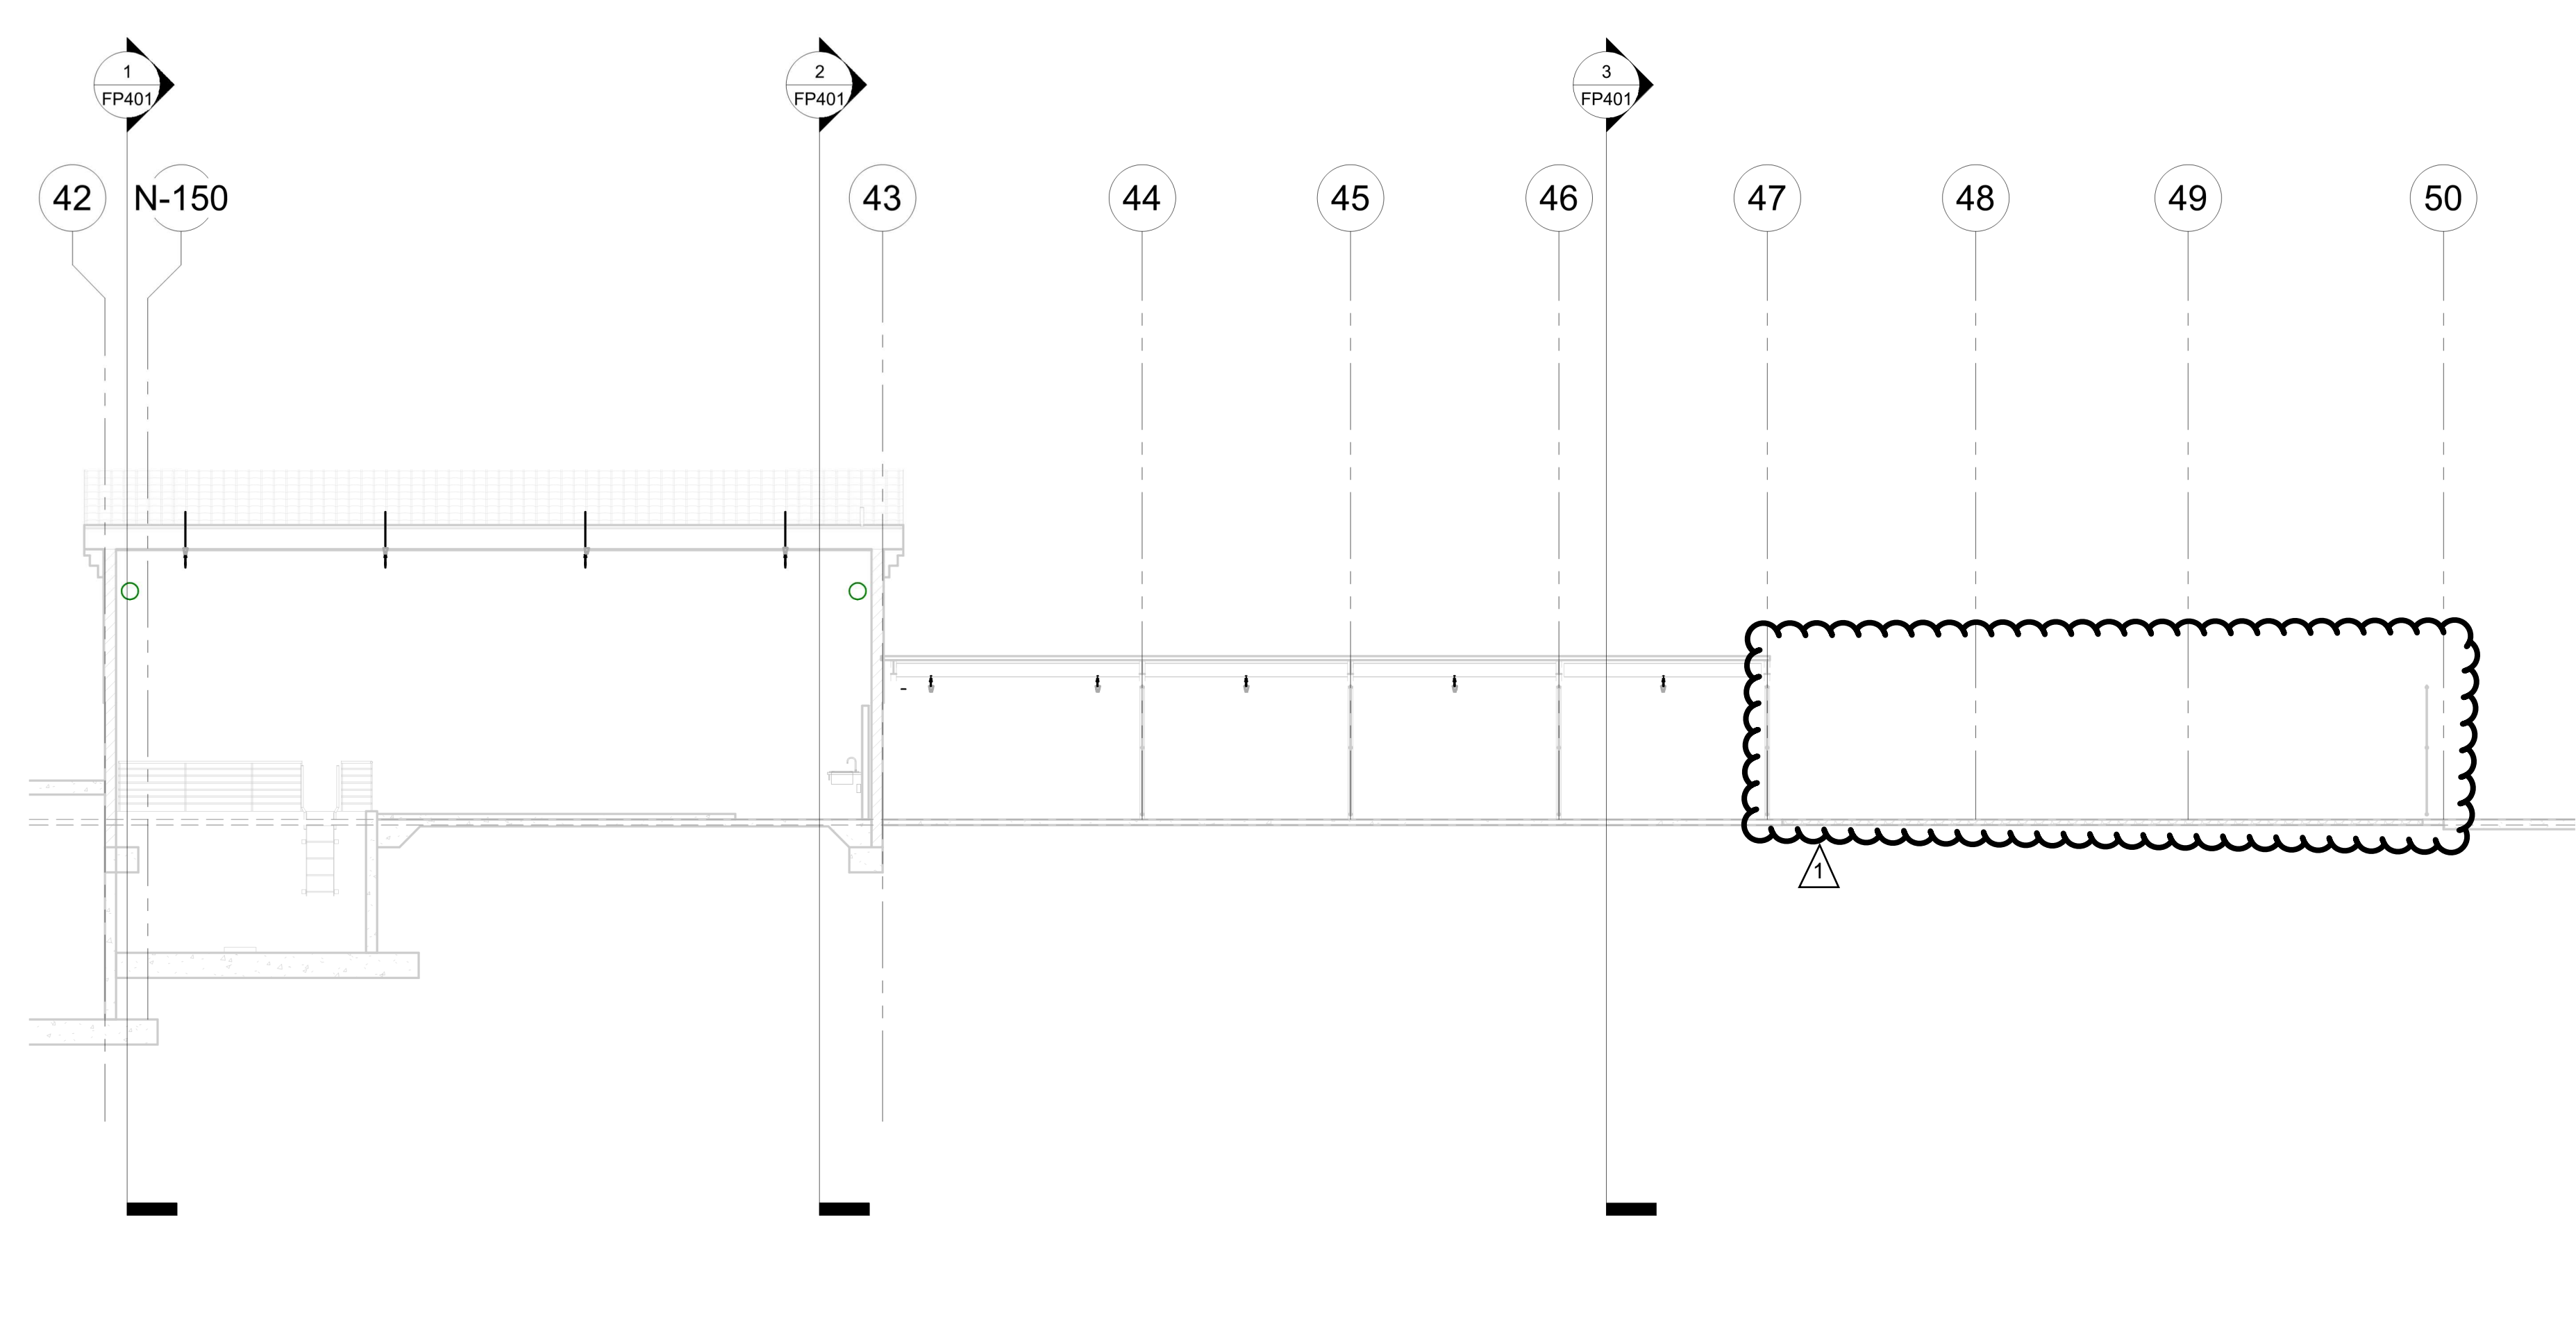

4 BUILDING P4 WEST STORAGE
1/8" = 1'-0"

DSA File No.:
DSA Application No.:
Agency Approval

GENERAL NOTES
1. All Unistruts shall have the Unistrut Defender Finish.
2. All Rods, Nuts and Screws shall be stainless steel

NET POSITIVE
consulting
engineers
www.NPCEng.com
project no. 1101

Consultant

Mission Oaks HS Aquatic Complex
Tulare Joint Union High School District
Tulare, CA 93274

Project

FIRE PROTECTION - BLDG. P4 SECTION VIEWS
Drawing

darden ARCHITECTURE
PLANNING
INTERIORS
architects
www.dardenarchitects.com
6790 N. West Ave. • Fresno, CA 93711 • T. 559.448.8051

Architect

No.	Revision/Submission	Date

Revision

Scale: As indicated
Project Number: 2180
Date: 01/20/2023

Designed By: WC
Drawn By: CC
Checked By: NP
Reviewed By: DSA

Copyright 2022 Darden Architects


FP401

6/5/2023 3:42:51 PM
 C:\Users\YasserAhmad\Net Positive\NPCEng\Documents\1 - Projects\1100\1101 -
 Darden - Mission Oaks High School Aquatics Center\07 - INBOX\2023-06-02 - Fire Sprinkler
 Revision\22-014 - Mission Oaks Aquatic Ctr. - FP - RI.rvt

DSA File No.:

DSA Application No.:

Agency Approval

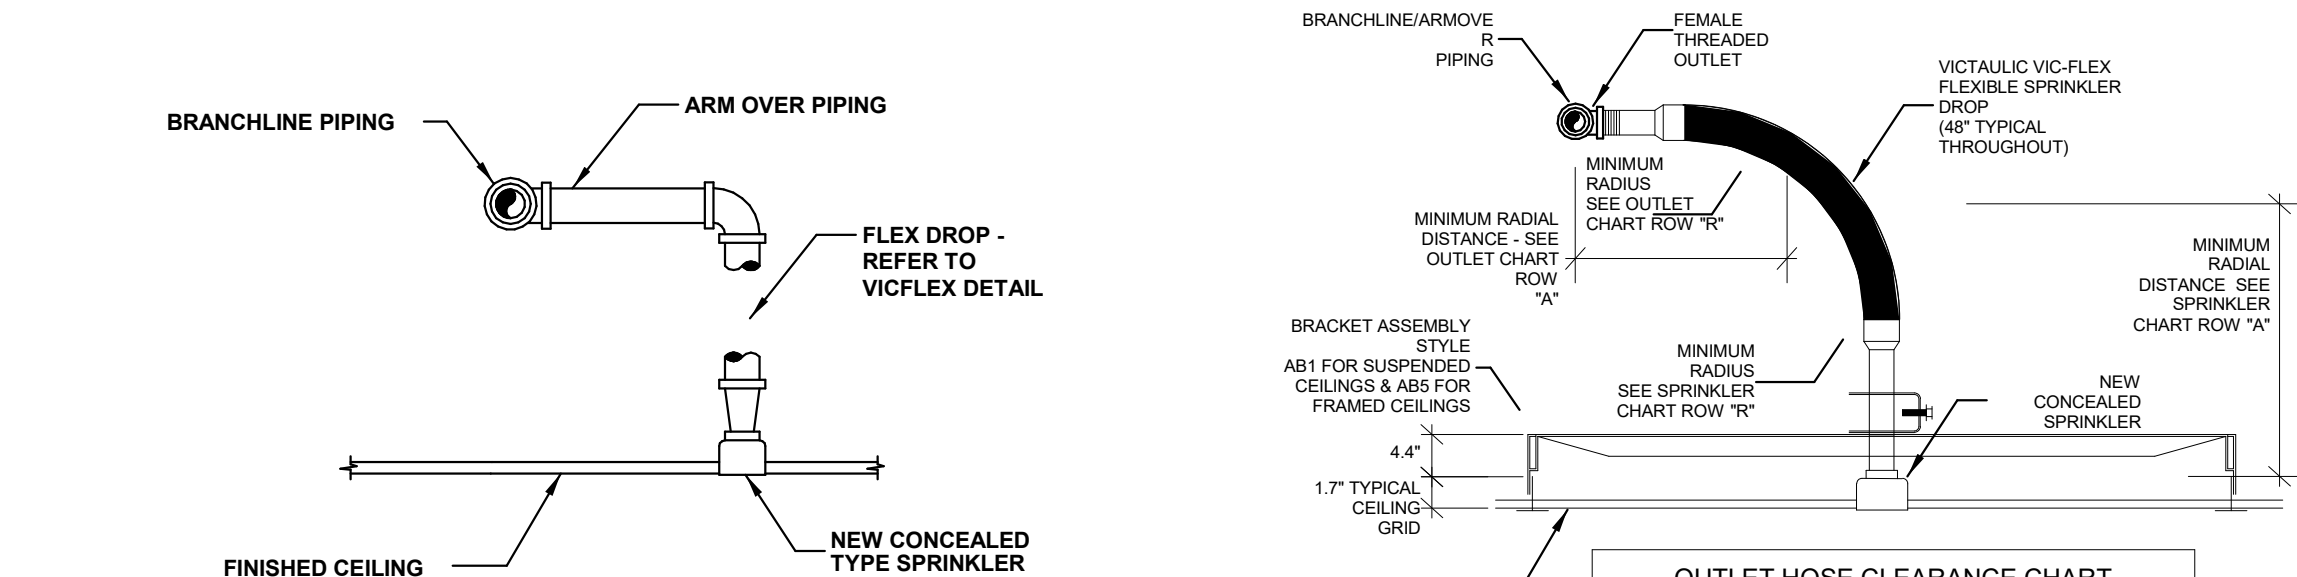

ALL PENDENT AND CONCEALED PENDENTS ON PROJECT SHALL BE INSTALLED USING 31" VIC FLEX FLEXIBLE SPRINKLER DROPS.





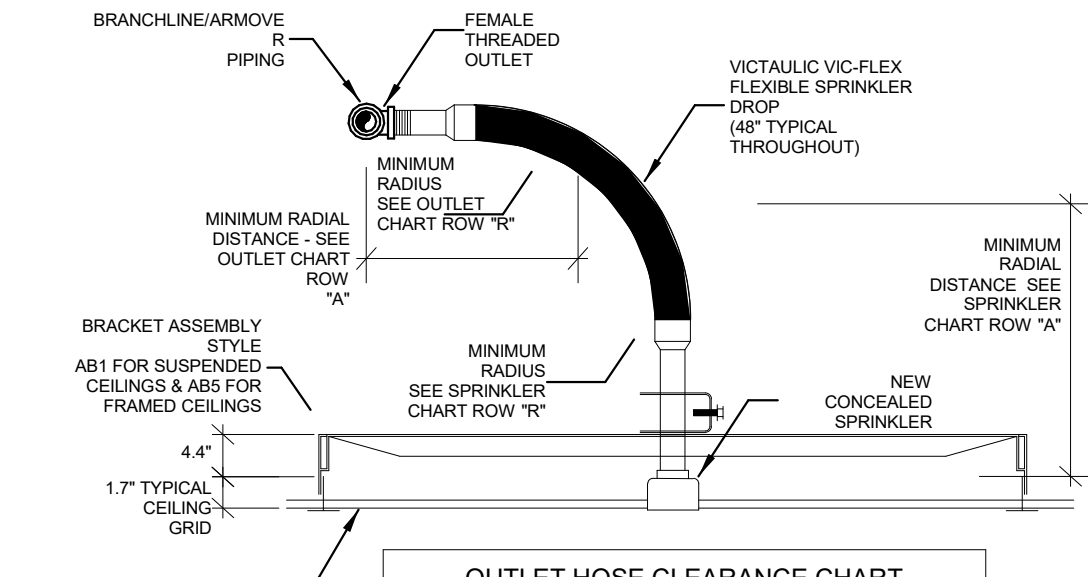


Table with 2 columns: DIMENSIONS, INCHES. Rows include R MINIMUM BEND RADIUS, A MINIMUM, and SPRINKLER HOSE CLEARANCE CHART.


CAUTION RELOCATION OF THIS DEVICE SHOULD ONLY BE PERFORMED BY QUALIFIED AND/OR LICENSED INDIVIDUALS THAT ARE AWARE OF THE ORIGINAL SYSTEM DESIGN CRITERIA.

TO BE INSTALLED ON ALL FLEX DROP ANCHORS. SIMILAR VERBIAGE FROM MANUFACTURER, NFPA OR OTHER SOURCE IS ACCEPTABLE.


VIC-FLEX LABEL DETAIL

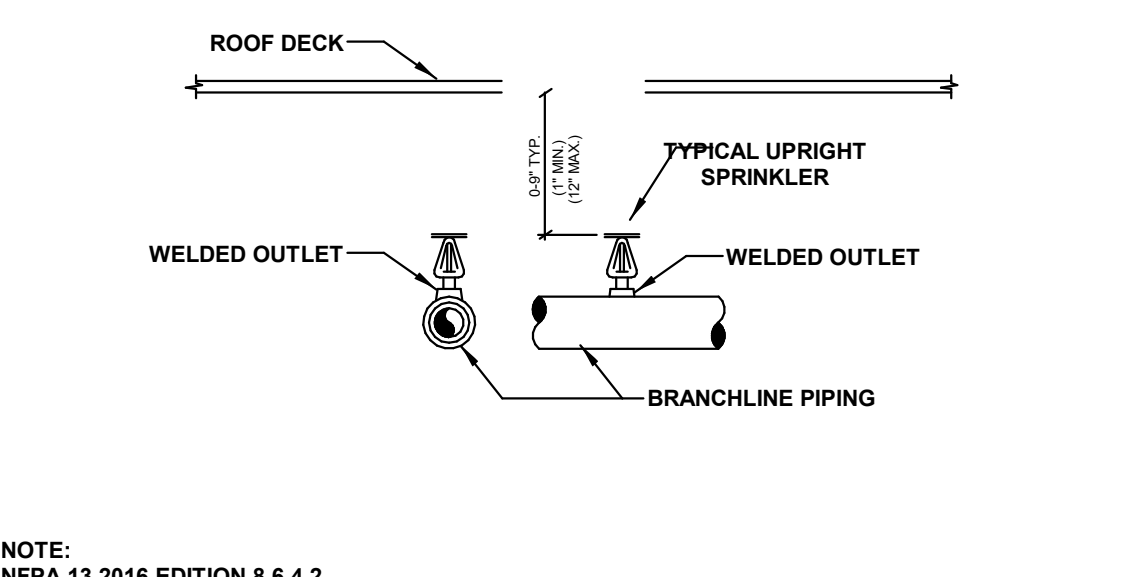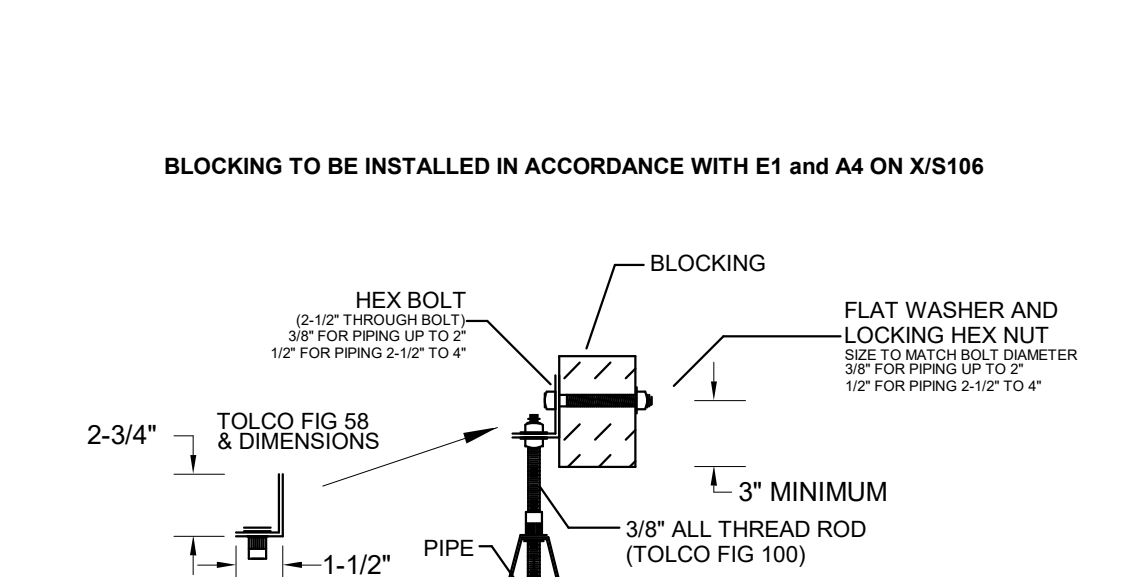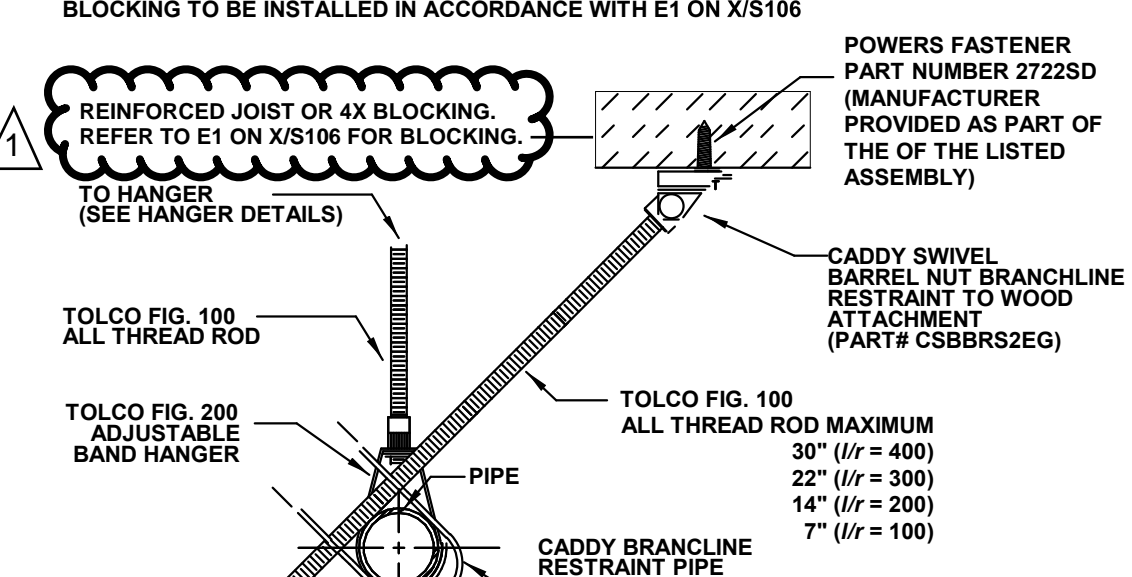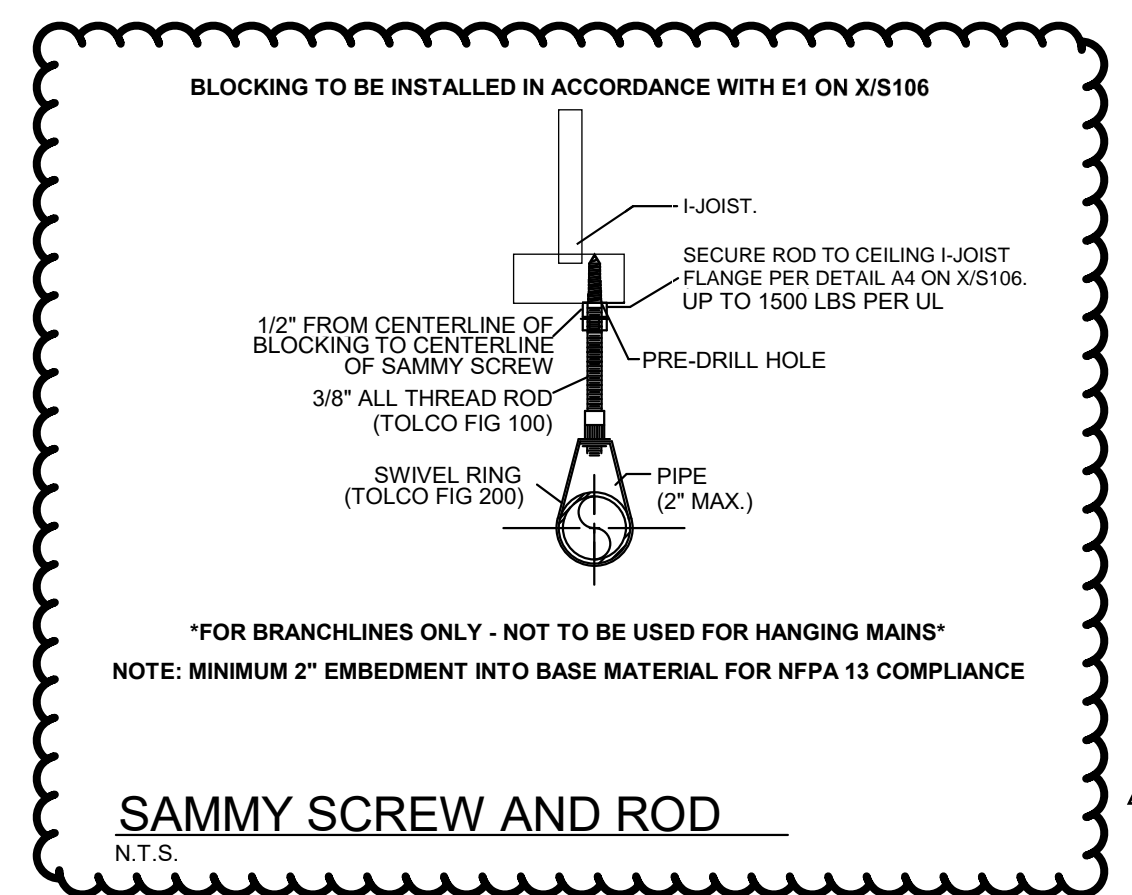


NOTE: NFPA 13 2016 EDITION 8.6.4.2 8.6.4.2.1 UNLESS THE REQUIREMENTS OF 8.6.4.2.2 OR 8.6.4.2.3 ARE MET, DEFLECTORS OF SPRINKLERS SHALL BE ALIGNED PARALLEL TO CEILINGS, ROOFS, HIPS, OR THE INCLINE OF STAIRS.

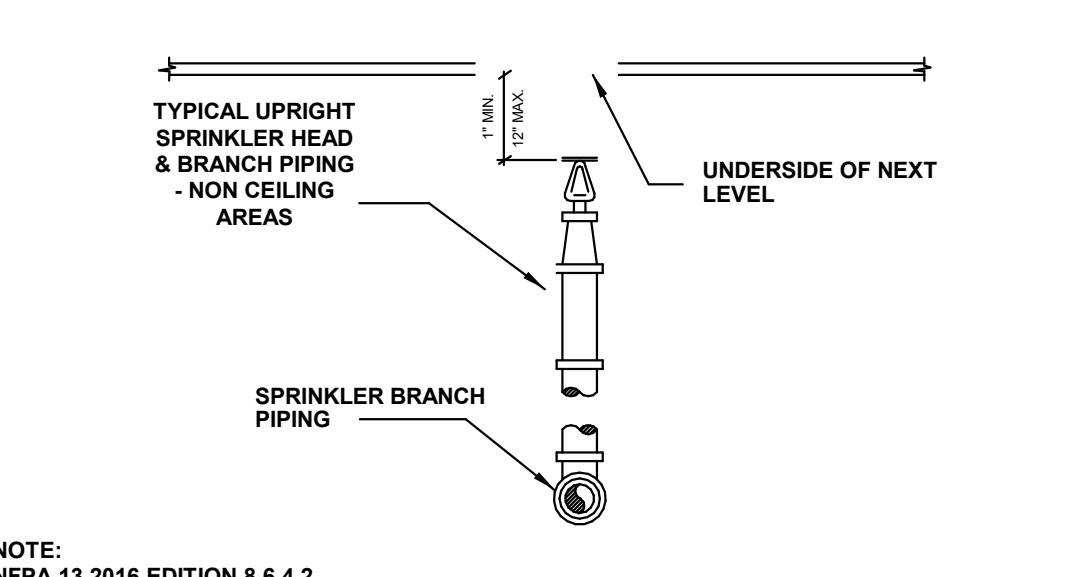

NOTE: NFPA 13 2016 EDITION 8.6.4.2 8.6.4.2.1 UNLESS THE REQUIREMENTS OF 8.6.4.2.2 OR 8.6.4.2.3 ARE MET, DEFLECTORS OF SPRINKLERS SHALL BE ALIGNED PARALLEL TO CEILINGS, ROOFS, HIPS, OR THE INCLINE OF STAIRS.

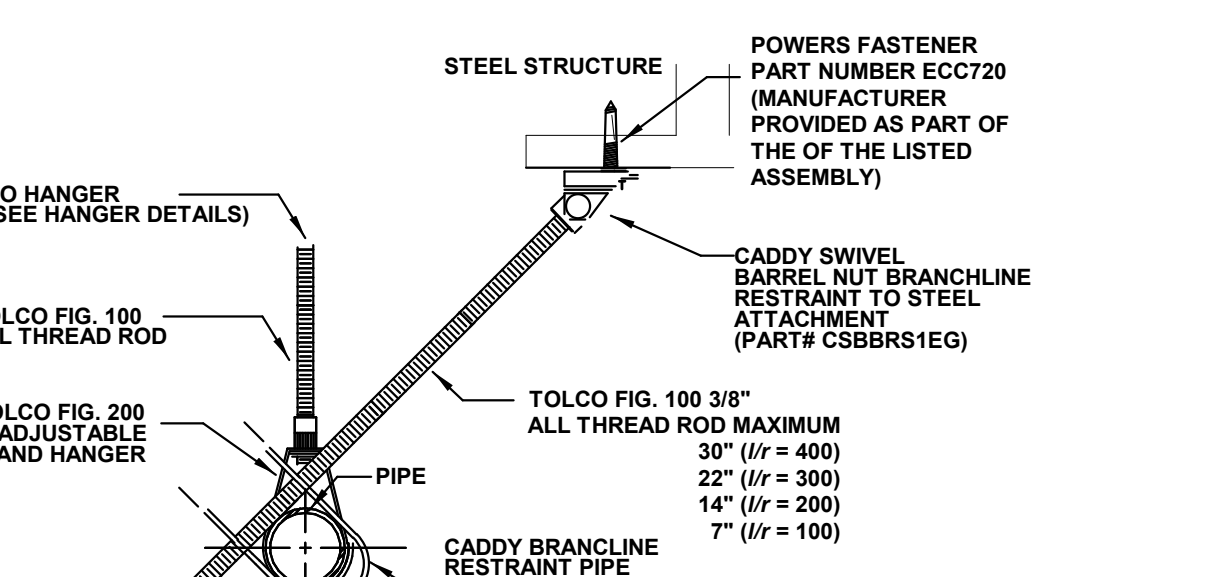

BUILDING SEISMIC SEPARATION ZONE ANCHORS NOT TO BE WITHIN ZONE. END CONNECTIONS MAY BE FINISHED FLANGED, OR GROOVED TO SUIT SYSTEM PIPING.

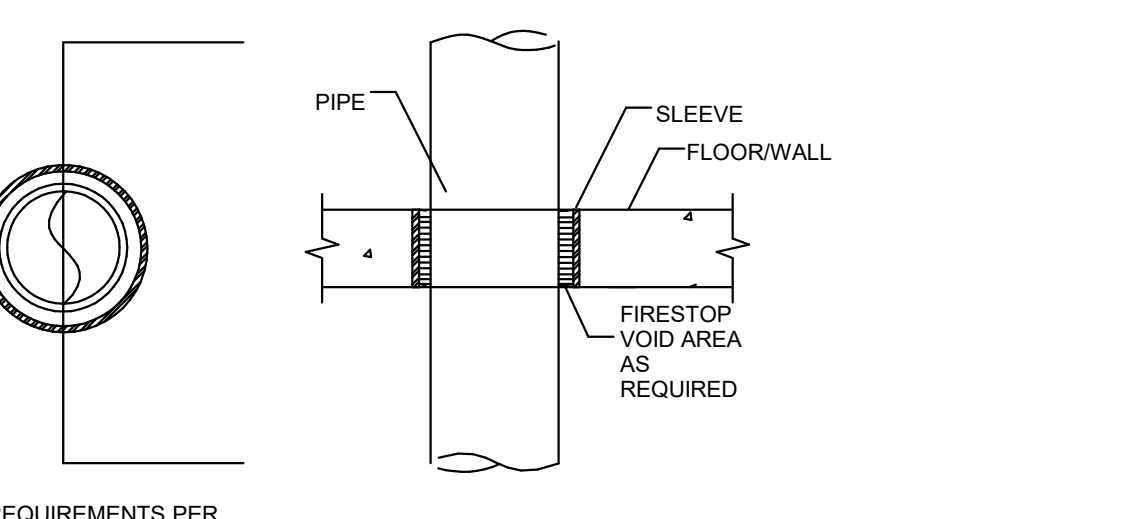

SLEEVE REQUIREMENTS PER NFPA 13 2016 9.3.4.3 WHERE CLEARANCE IS PROVIDED BY A PIPE SLEEVE, A NOMINAL DIAMETER 2 IN. (50 MM) LARGER THAN THE NOMINAL DIAMETER OF THE PIPE SHALL BE ACCEPTABLE FOR PIPE SIZES 1 IN. (25 MM) THROUGH 3/2 IN. (90 MM).



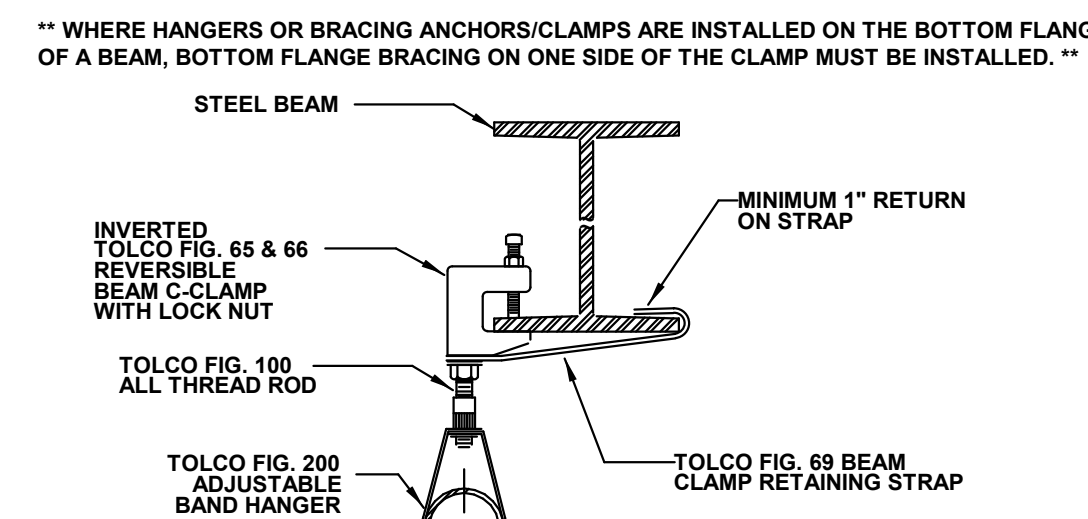


Table with 2 columns: DIMENSIONS, INCHES. Rows include 1", 1-1/2", 2", and 4" for TOLCO FIG 200.

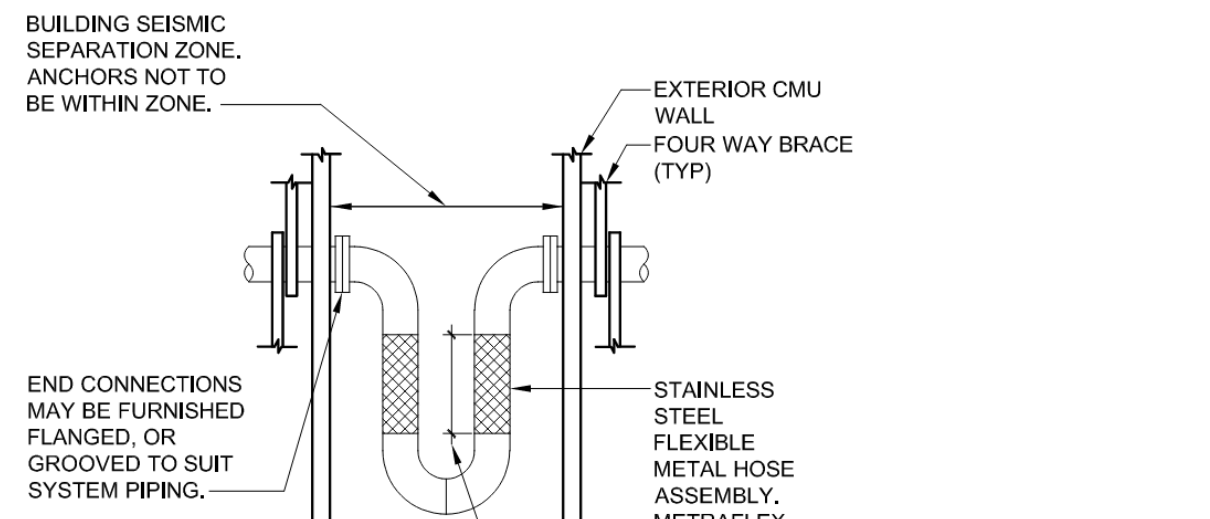


ATTACHMENT TO STRUCTURE VIA THROUGH BOLTS "REFER TO SWAY BRACE CALCULATION REPORTS".

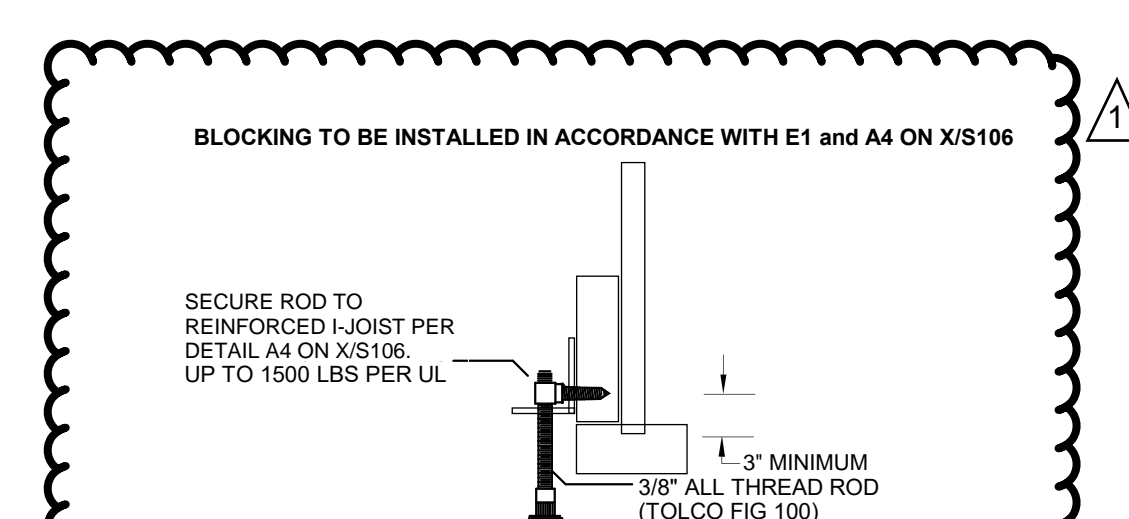


NOTE: ROD SHALL BE RUN DOWN TO TOP OF PIPE "MAY BE USED FOR UP TO AND INCLUDING 3" PIPING".


WET SYSTEM RISER SHALL BE A VICTAULIC UMC RISER CONTROL ASSEMBLY WITH 705W SUPERVISED CONTROL VALVE. FDC IS A REMOTE FREE STANDING FDC CONNECTED TO UNDERGROUND FIRE SERVICE.

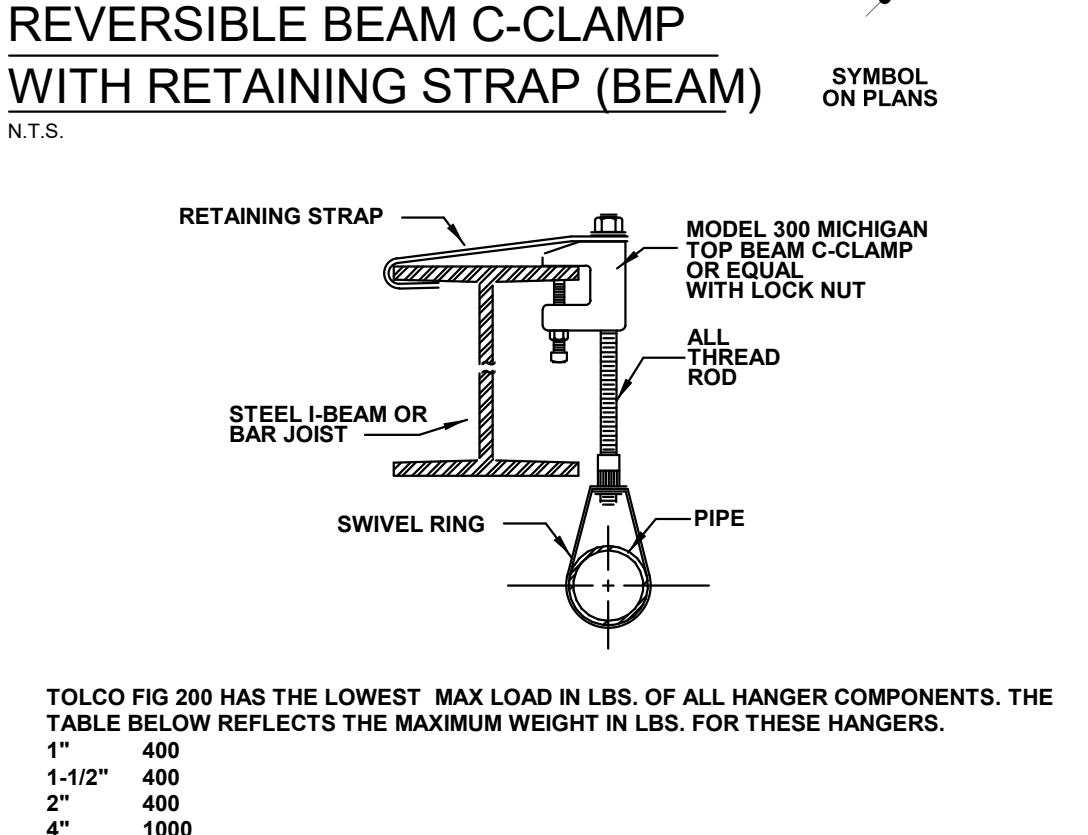

TOLCO FIG 200 HAS THE LOWEST MAX LOAD IN LBS. OF ALL HANGER COMPONENTS. THE TABLE BELOW REFLECTS THE MAXIMUM WEIGHT IN LBS. FOR THESE HANGERS.

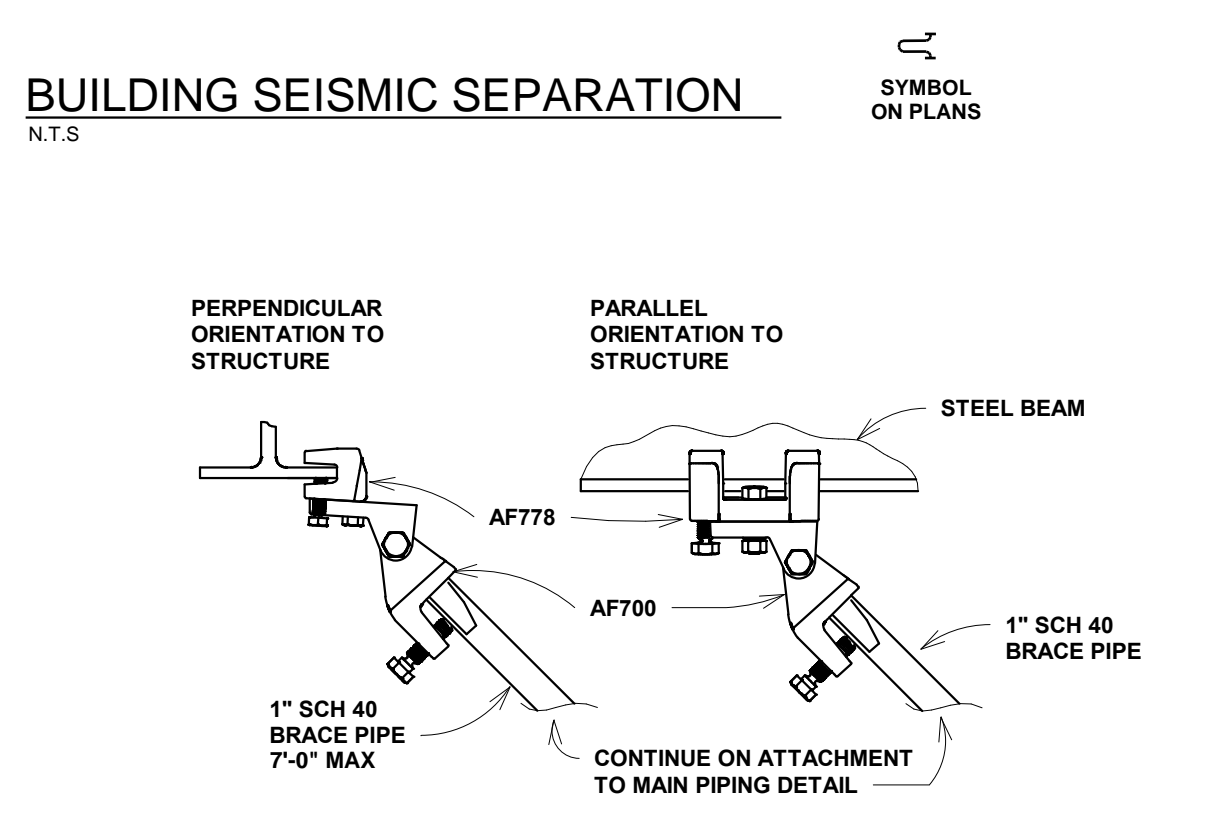


AFCON FIG 700 / 778 ATTACHMENT TO STEEL BAR JOIST. ALL BRACE ANGLES ARE 30-44 DEGREES.

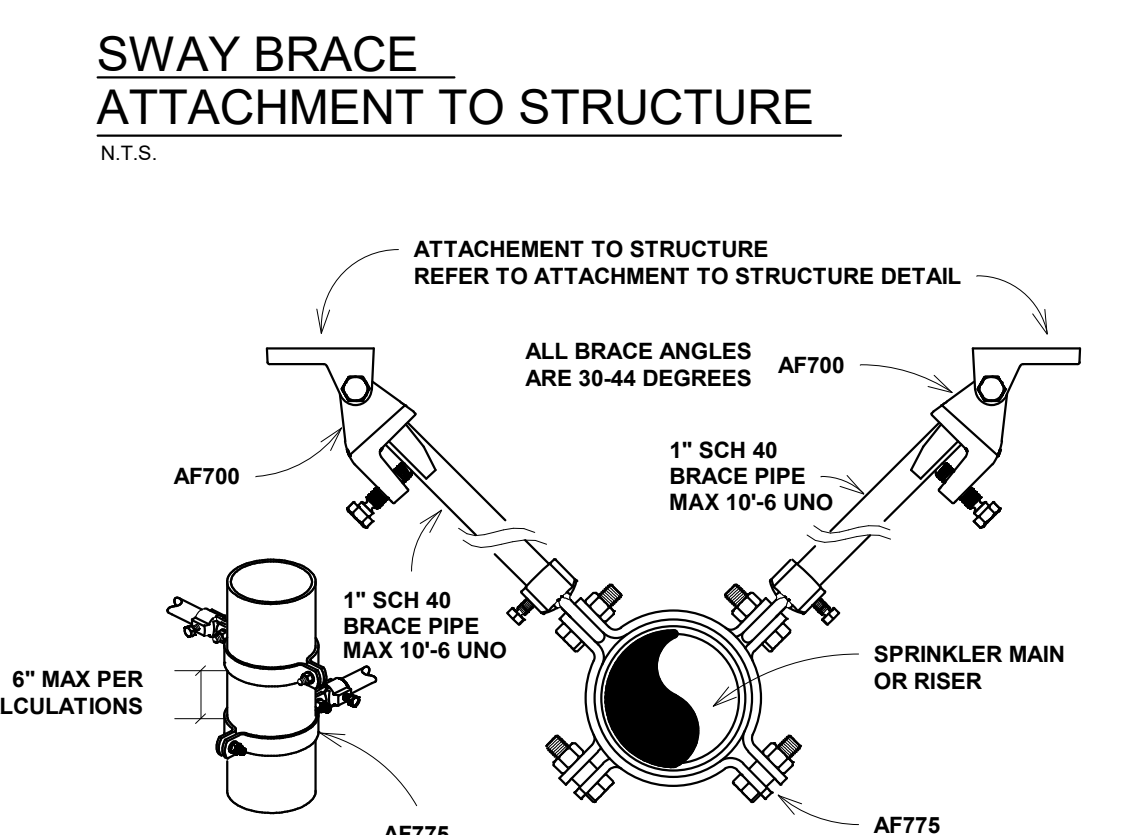


AFCON FIG 700 / 775 4-WAY SWAY BRACE ATTACHMENT. ALL BRACE ANGLES ARE 30-44 DEGREES.

Table 9.2.2.1(a) MAXIMUM DISTANCE BETWEEN HANGERS (FT.-IN.) and Table 9.1.2.1 HANGER ROD SIZE.


PROJECT HANGER SPACING TABLE (EXCEEDING NFPA). CONTINUE ON ATTACHMENT TO STRUCTURE DETAIL.

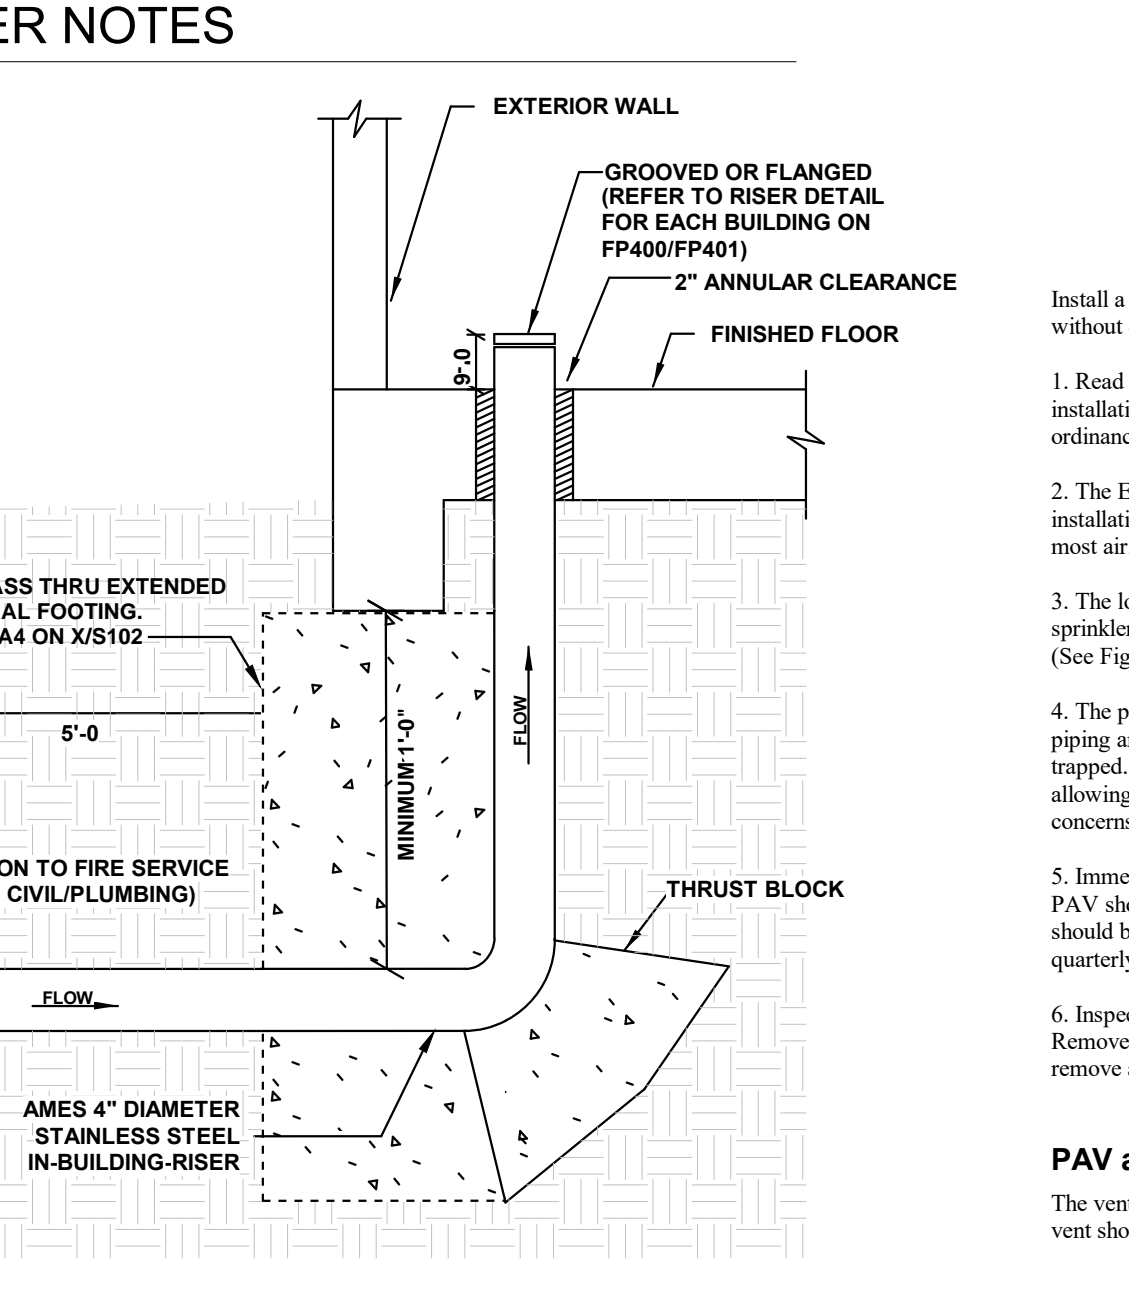


PAV Outline Drawing Fig 1. REFER TO SHEET FP100 FOR LOCATION OF PAV. Install a ball valve in line with the PAV to assist in servicing the strainer without disabling the sprinkler system.

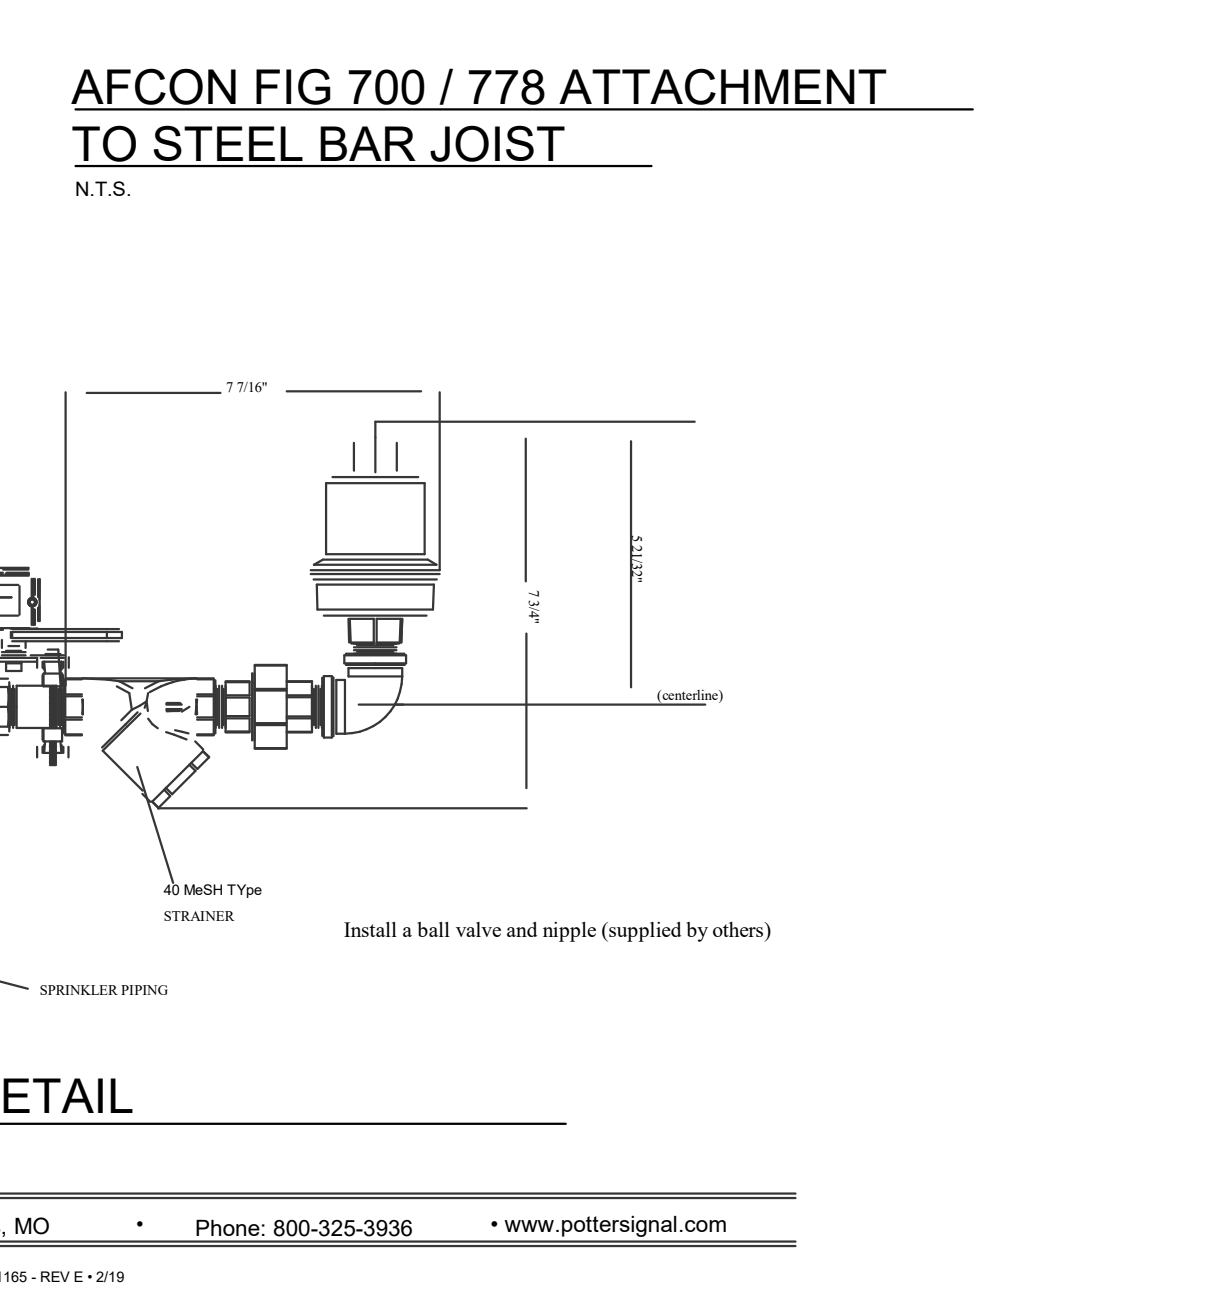

AIR VENT DETAIL. The vent used in the PAV is not field replaceable. If the vent should fail, the entire unit must be replaced.

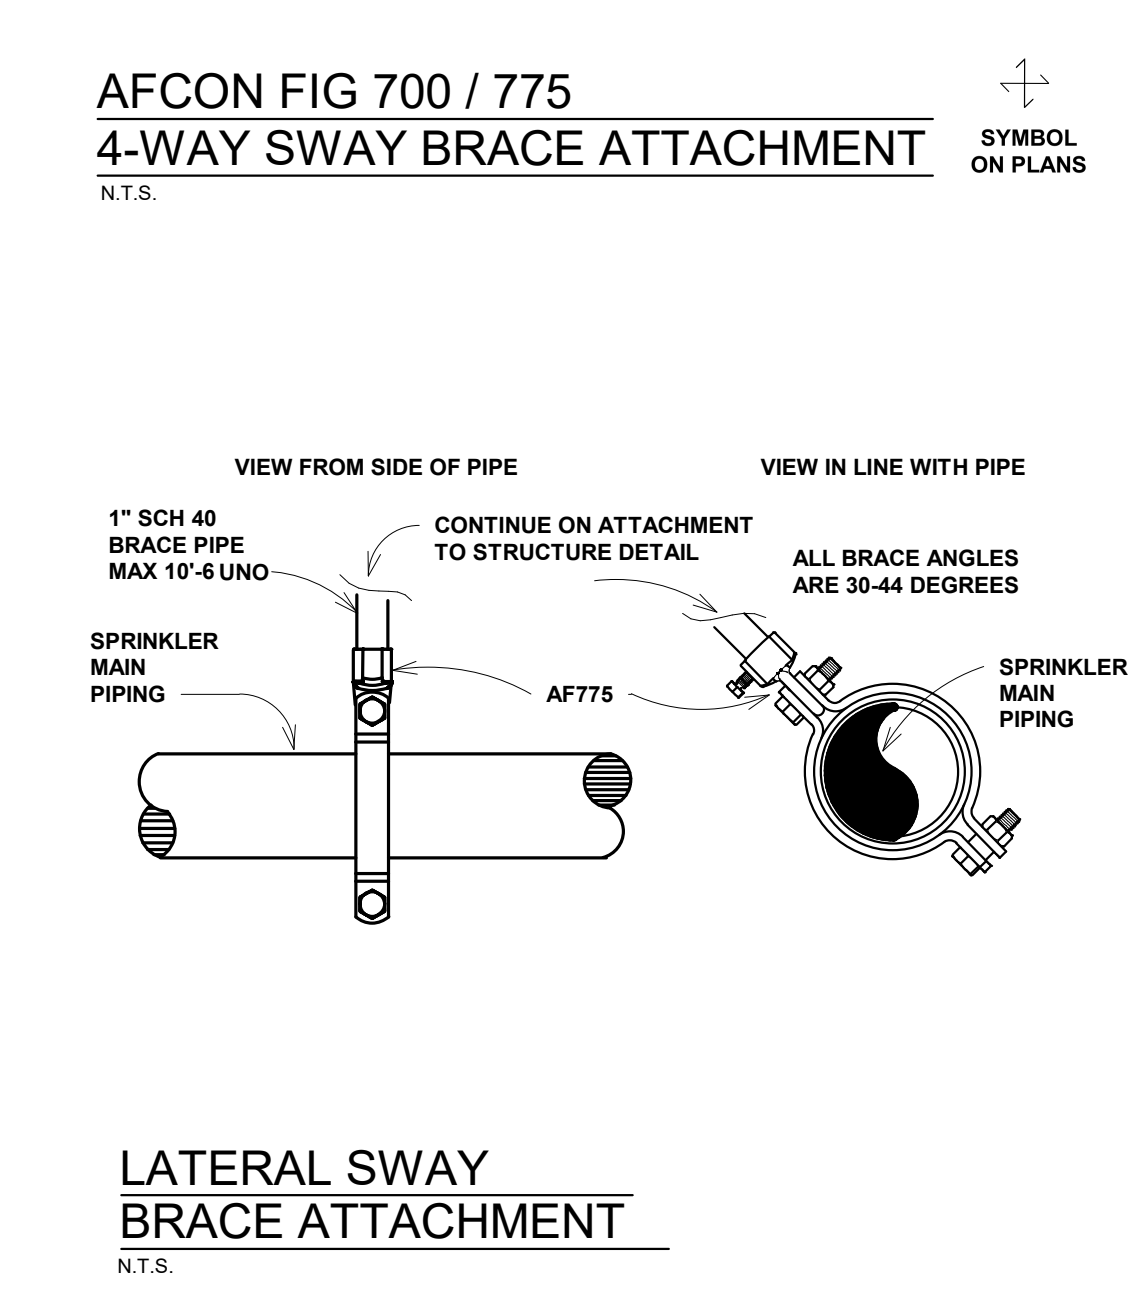

LATERAL SWAY BRACE ATTACHMENT. ALL BRACE ANGLES ARE 30-44 DEGREES.

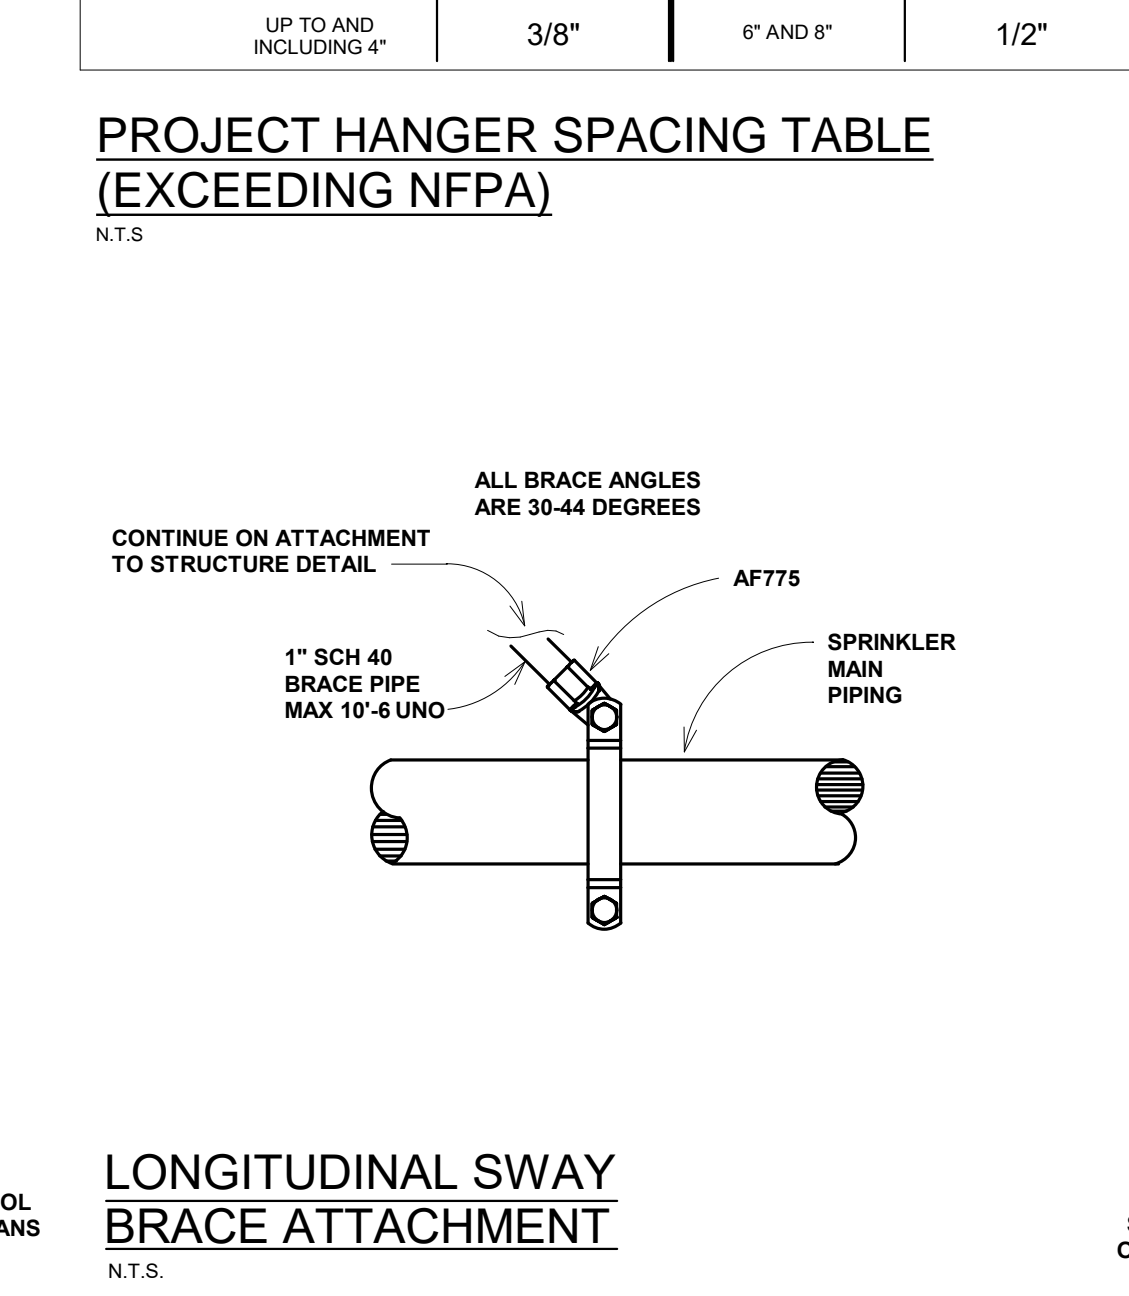

LONGITUDINAL SWAY BRACE ATTACHMENT. ALL BRACE ANGLES ARE 30-44 DEGREES.

GENERAL NOTES. 1. All Unistruts shall have the Unistrut Defender Finish. 2. All Rods, Nuts and Screws shall be stainless steel.

NET POSITIVE consulting engineers logo and contact information.

Mission Oaks HS Aquatic Complex, Tulare Joint Union High School District, Tulare, CA 93274.


FIRE PROTECTION - DETAILS. Drawing.

Darden Architects logo and contact information.

Revision table with columns: No., Revision/Submission, Date.

1/23/2023 7:46:42 PM C:\Users\waco\Box\Projects\2022\22-014 - NPOcong - Mission Oaks Aquatic Center\22-014 - NPOcong - Mission Oaks Aquatic Center\2 - Submittal Drawings\22-014 - Mission Oaks Aquatic Ctr - FP - RO.DWG

8/16/2023 4:24:02 PM
Z:\Clients\Darden Architects\22068 - Tulare USD Mission Oak HS Aquatic Complex\CAD Files\22068 - 4 Elec_rebld.dwg

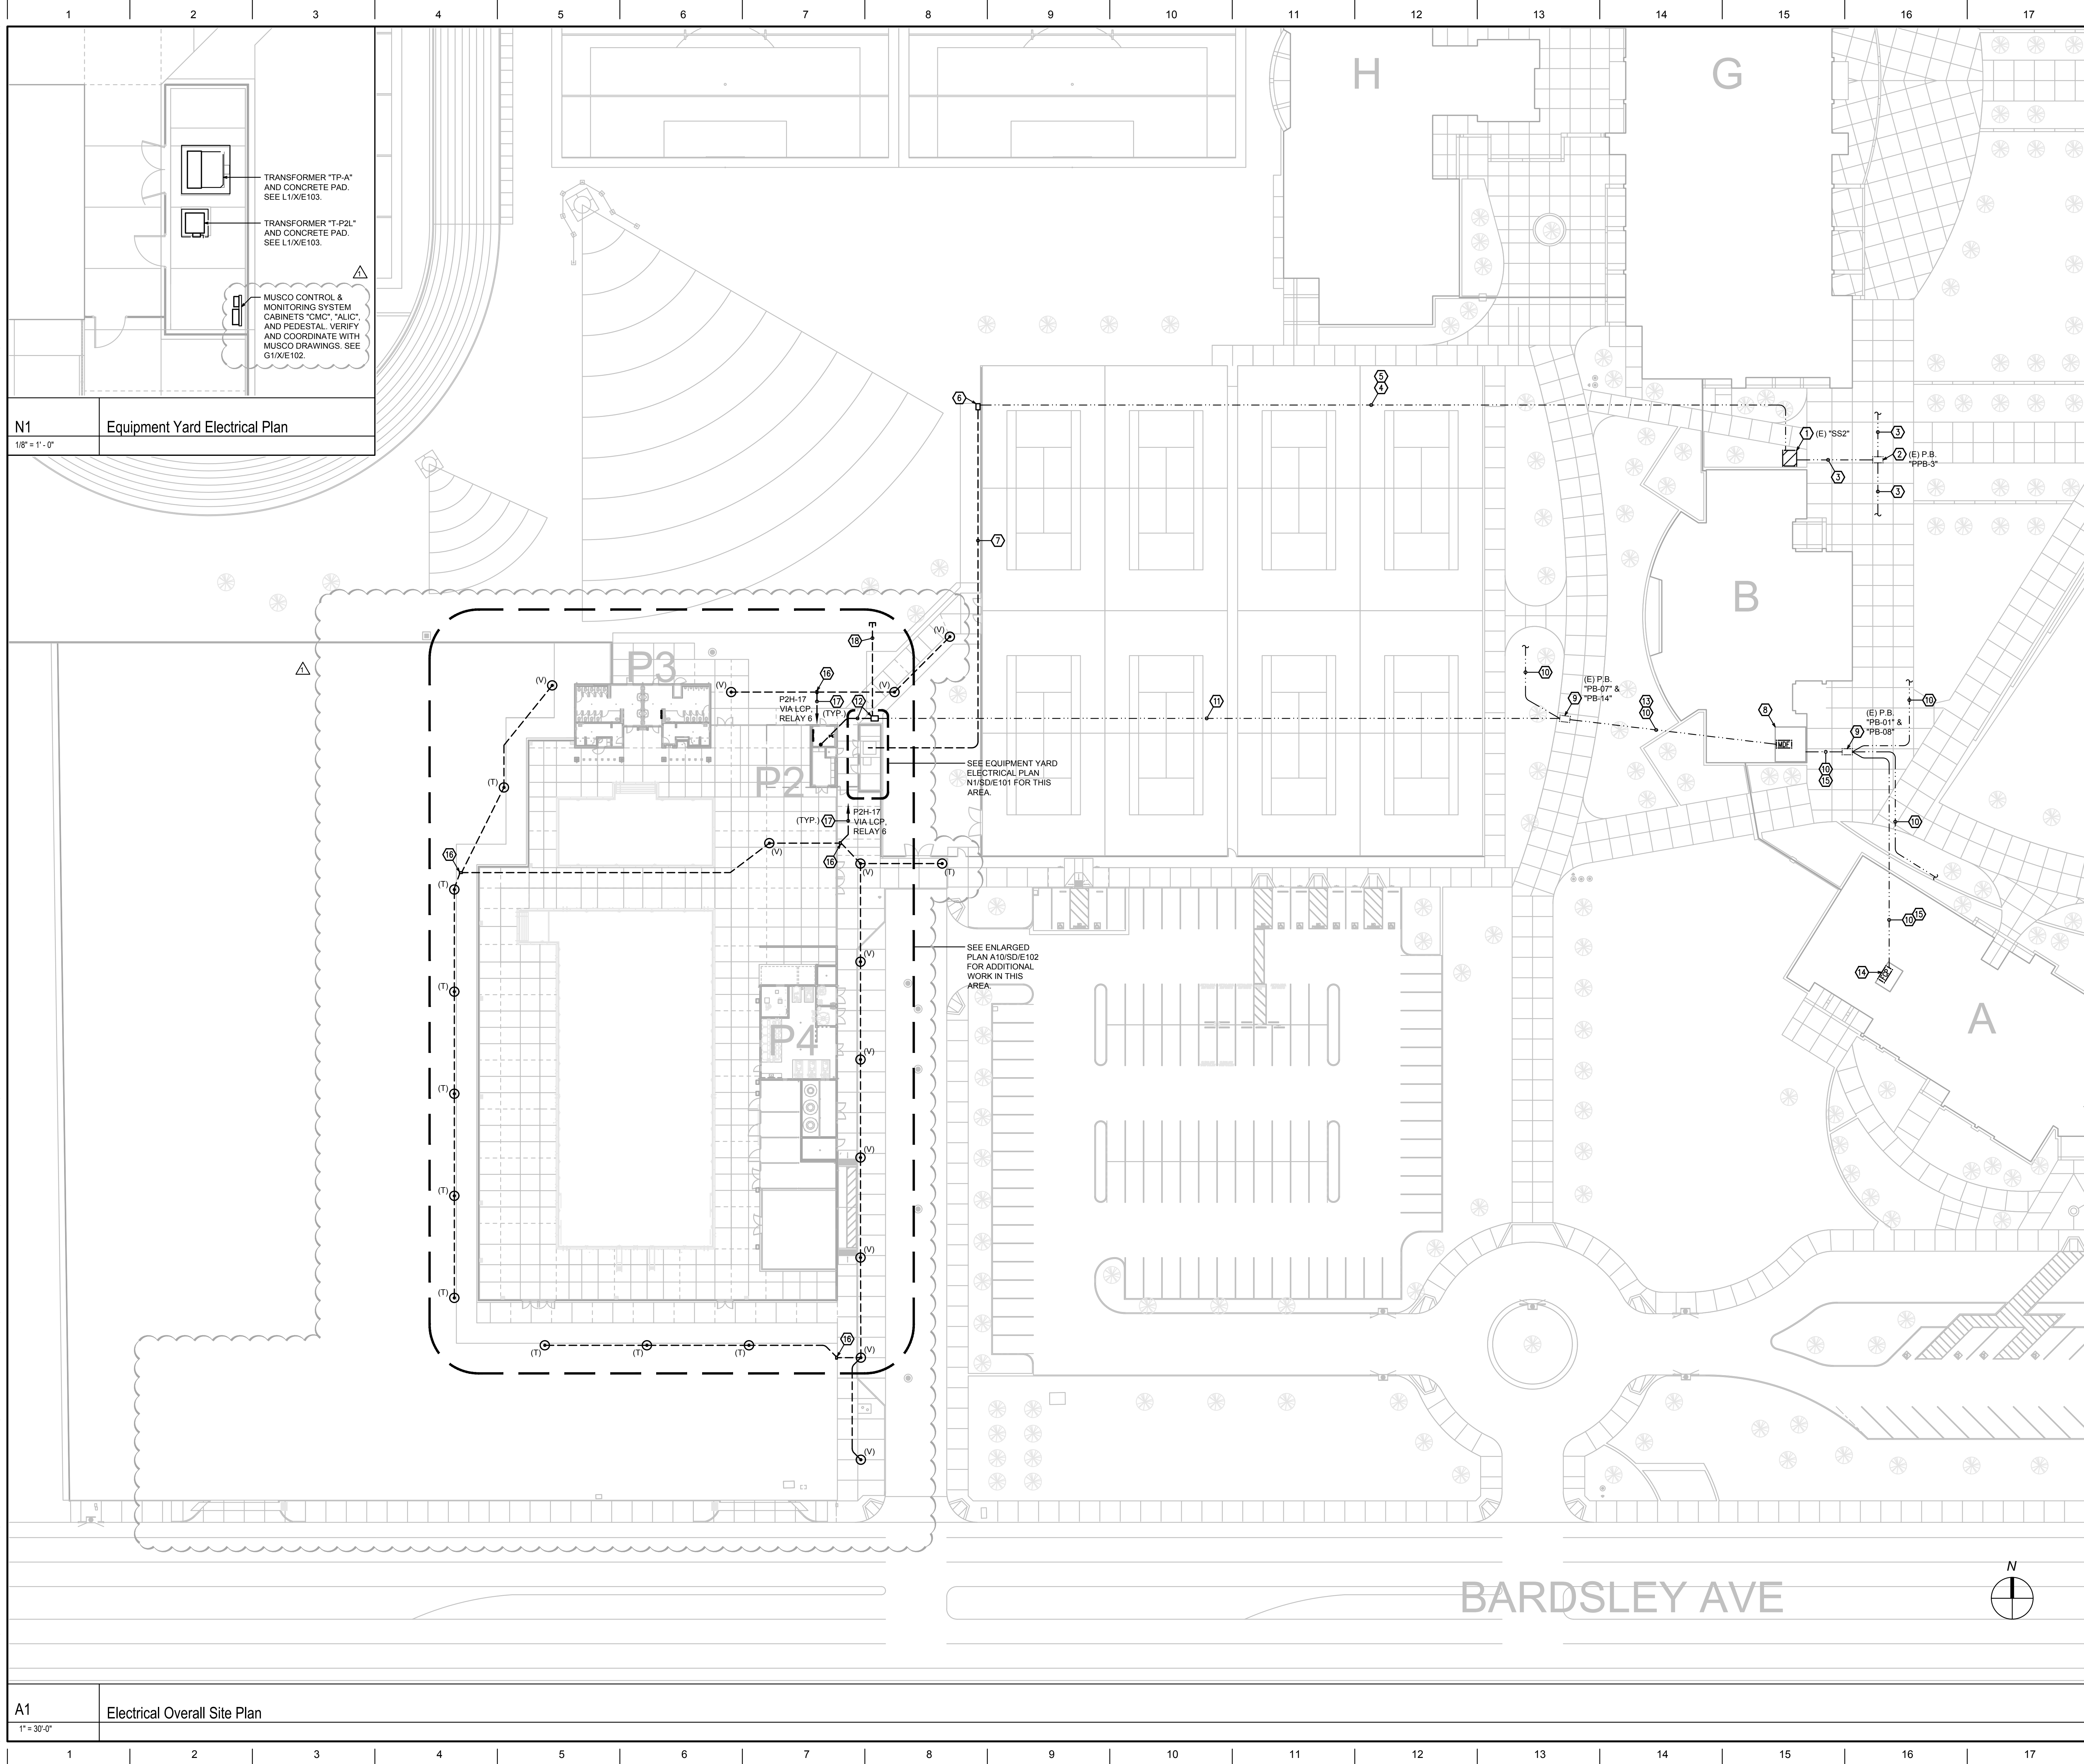

N1 Equipment Yard Electrical Plan
1/8" = 1'-0"

A1 Electrical Overall Site Plan
1" = 3/8" = 0"

DSA File No.: 54-H11
DSA Application No.: 02-120251
Agency Approval

- KEYNOTES**
- EXISTING PAD MOUNTED MEDIUM VOLTAGE SECTIONALIZING SWITCH, 600A 15KV.
 - EXISTING POWER PULL BOX.
 - EXISTING POWER FEEDERS.
 - EXISTING SPARE 4" POWER CONDUIT STUB WITH PULL ROPE.
 - PROVIDE MV CONDUCTORS PER POWER SINGLE LINE DIAGRAM L11X/E103.
 - 3 FT. x 5 FT. VAULT WITH SPRING-ASSIST BOLT-DOWN STEEL LIDS WITH "HIGH VOLTAGE" MARKING. SEE DETAIL M10X/E106.
 - POWER MV FEEDER AND SPARE 4". PER POWER SINGLE LINE DIAGRAM L11X/E103.
 - EXISTING DATA MDF AND LOW VOLTAGE SYSTEMS HEAD END EQUIPMENT AT EXISTING BUILDING DATA/ELECTRICAL ROOM. CONNECT DATA AND LOW VOLTAGE SYSTEMS. SEE LOW VOLTAGE SINGLE LINE DIAGRAM A11X/E105.
 - EXISTING LOW VOLTAGE SYSTEMS PULL BOX(ES).
 - EXISTING LOW VOLTAGE SYSTEMS CONDUITS AND CABLING.
 - EXISTING (2) 4" SPARE CONDUITS STUB FROM EXISTING PULL BOX "PB-07".
 - EXISTING (3) 2" & (1) 1 1/2" SPARE CONDUITS STUB FROM EXISTING PULL BOX "PB-14".
 - INTERCEPT EXISTING CONDUITS AND RISE INTO B3042 VAULT. RUN (1) 4"C., (2) 2"C., AND (1) 1 1/2"C. TO NEW BUILDING "P2" ELECTRICAL ROOM. PULL NEW FIBER OPTIC AND COMMISIGNAL CABLES PER LOW VOLTAGE SINGLE LINE DIAGRAM A11X/E105.
 - PULL NEW FIBER OPTIC AND COMMISIGNAL CABLES THROUGH EXISTING CONDUITS. CABLING PER LOW VOLTAGE SINGLE LINE DIAGRAM A11X/E105.
 - EXISTING FIRE ALARM CONTROL PANEL AT EXISTING BUILDING DATA/ELECTRICAL ROOM. CONNECT FIRE ALARM. SEE FIRE ALARM PLANS.
 - PULL FIRE ALARM CABLES THROUGH EXISTING CONDUIT.
 - B1017 H-20 RATED PULL BOX WITH BOLT-DOWN STEEL LID LABELLED "LIGHTING" PER DETAIL M14X/E106.
 - 1"C. 2#8, #10G.
 - STUB (1) 4"C., (2) 2"C., (1) 1 1/2"C. AS SHOWN.

- POWER & SYSTEMS NOTES**
- ALL WORK AT THE POOLS AND RELATED POOL EQUIPMENT SHALL CONFORM WITH CEC ARTICLE 680. REFER TO AQUATIC DESIGN GROUP DRAWINGS AND SPECIFICATIONS FOR ADDITIONAL ELECTRICAL WORK (E.G. POOL LIGHTING, TIMING EQUIPMENT, GROUNDING, ETC.) AT THE POOLS AND RELATED EQUIPMENT ROOMS.
 - ALL RACEWAYS, COUPLINGS, STRAPS, ANCHORS, AND WIRING IN POOL EQUIPMENT ROOM, ACID, CHLORINE, AND POOL EQUIPMENT ENCLOSURE SHALL CONFORM TO CEC ARTICLE 680.14 AND SHALL BE UL LISTED AND ETL VERIFIED FOR SUCH USE. THE EXPOSED ELECTRICAL INSTALLATION SHALL BE FINISHED WITH PVC ANTI-CORROSIVE COATINGS. ALL UNISTRUTS SHALL HAVE A DEFENDER FINISH.
 - ALL CONDUIT PENETRATIONS THROUGH CMU WALLS SHALL BE PER DETAIL E11X/S104.

HD
Hardin-Davidson Engineering
356 Pollasky Ave., Suite 200, Clovis, CA 93612
559.323.4995 tel • 559.323.4928 fax
www.hardin-davidson.com
Consultant

Mission Oak HS Aquatic Complex
Tulare Joint Union High School District
Tulare, CA 93274
Project


SITE DEVELOPMENT
ELECTRICAL OVERALL SITE PLAN
Drawing

darden architects ARCHITECTURE PLANNING INTERIORS
www.dardenarchitects.com
8790 N. West Ave. • Fresno, CA 93711 • T. 559.448.8051
Architect

No.	Revision/Submission	Date
1	REVISION_01	05/31/2023

Revision	
Designed By:	SD
Copyright	2022 Darden Architects
Scale:	As indicated
Drawn By:	HDE
Project Number:	2180
Checked By:	SD
Date:	08/02/2022
Reviewed By:	SD

Sheet: **SD/E101** of: _____

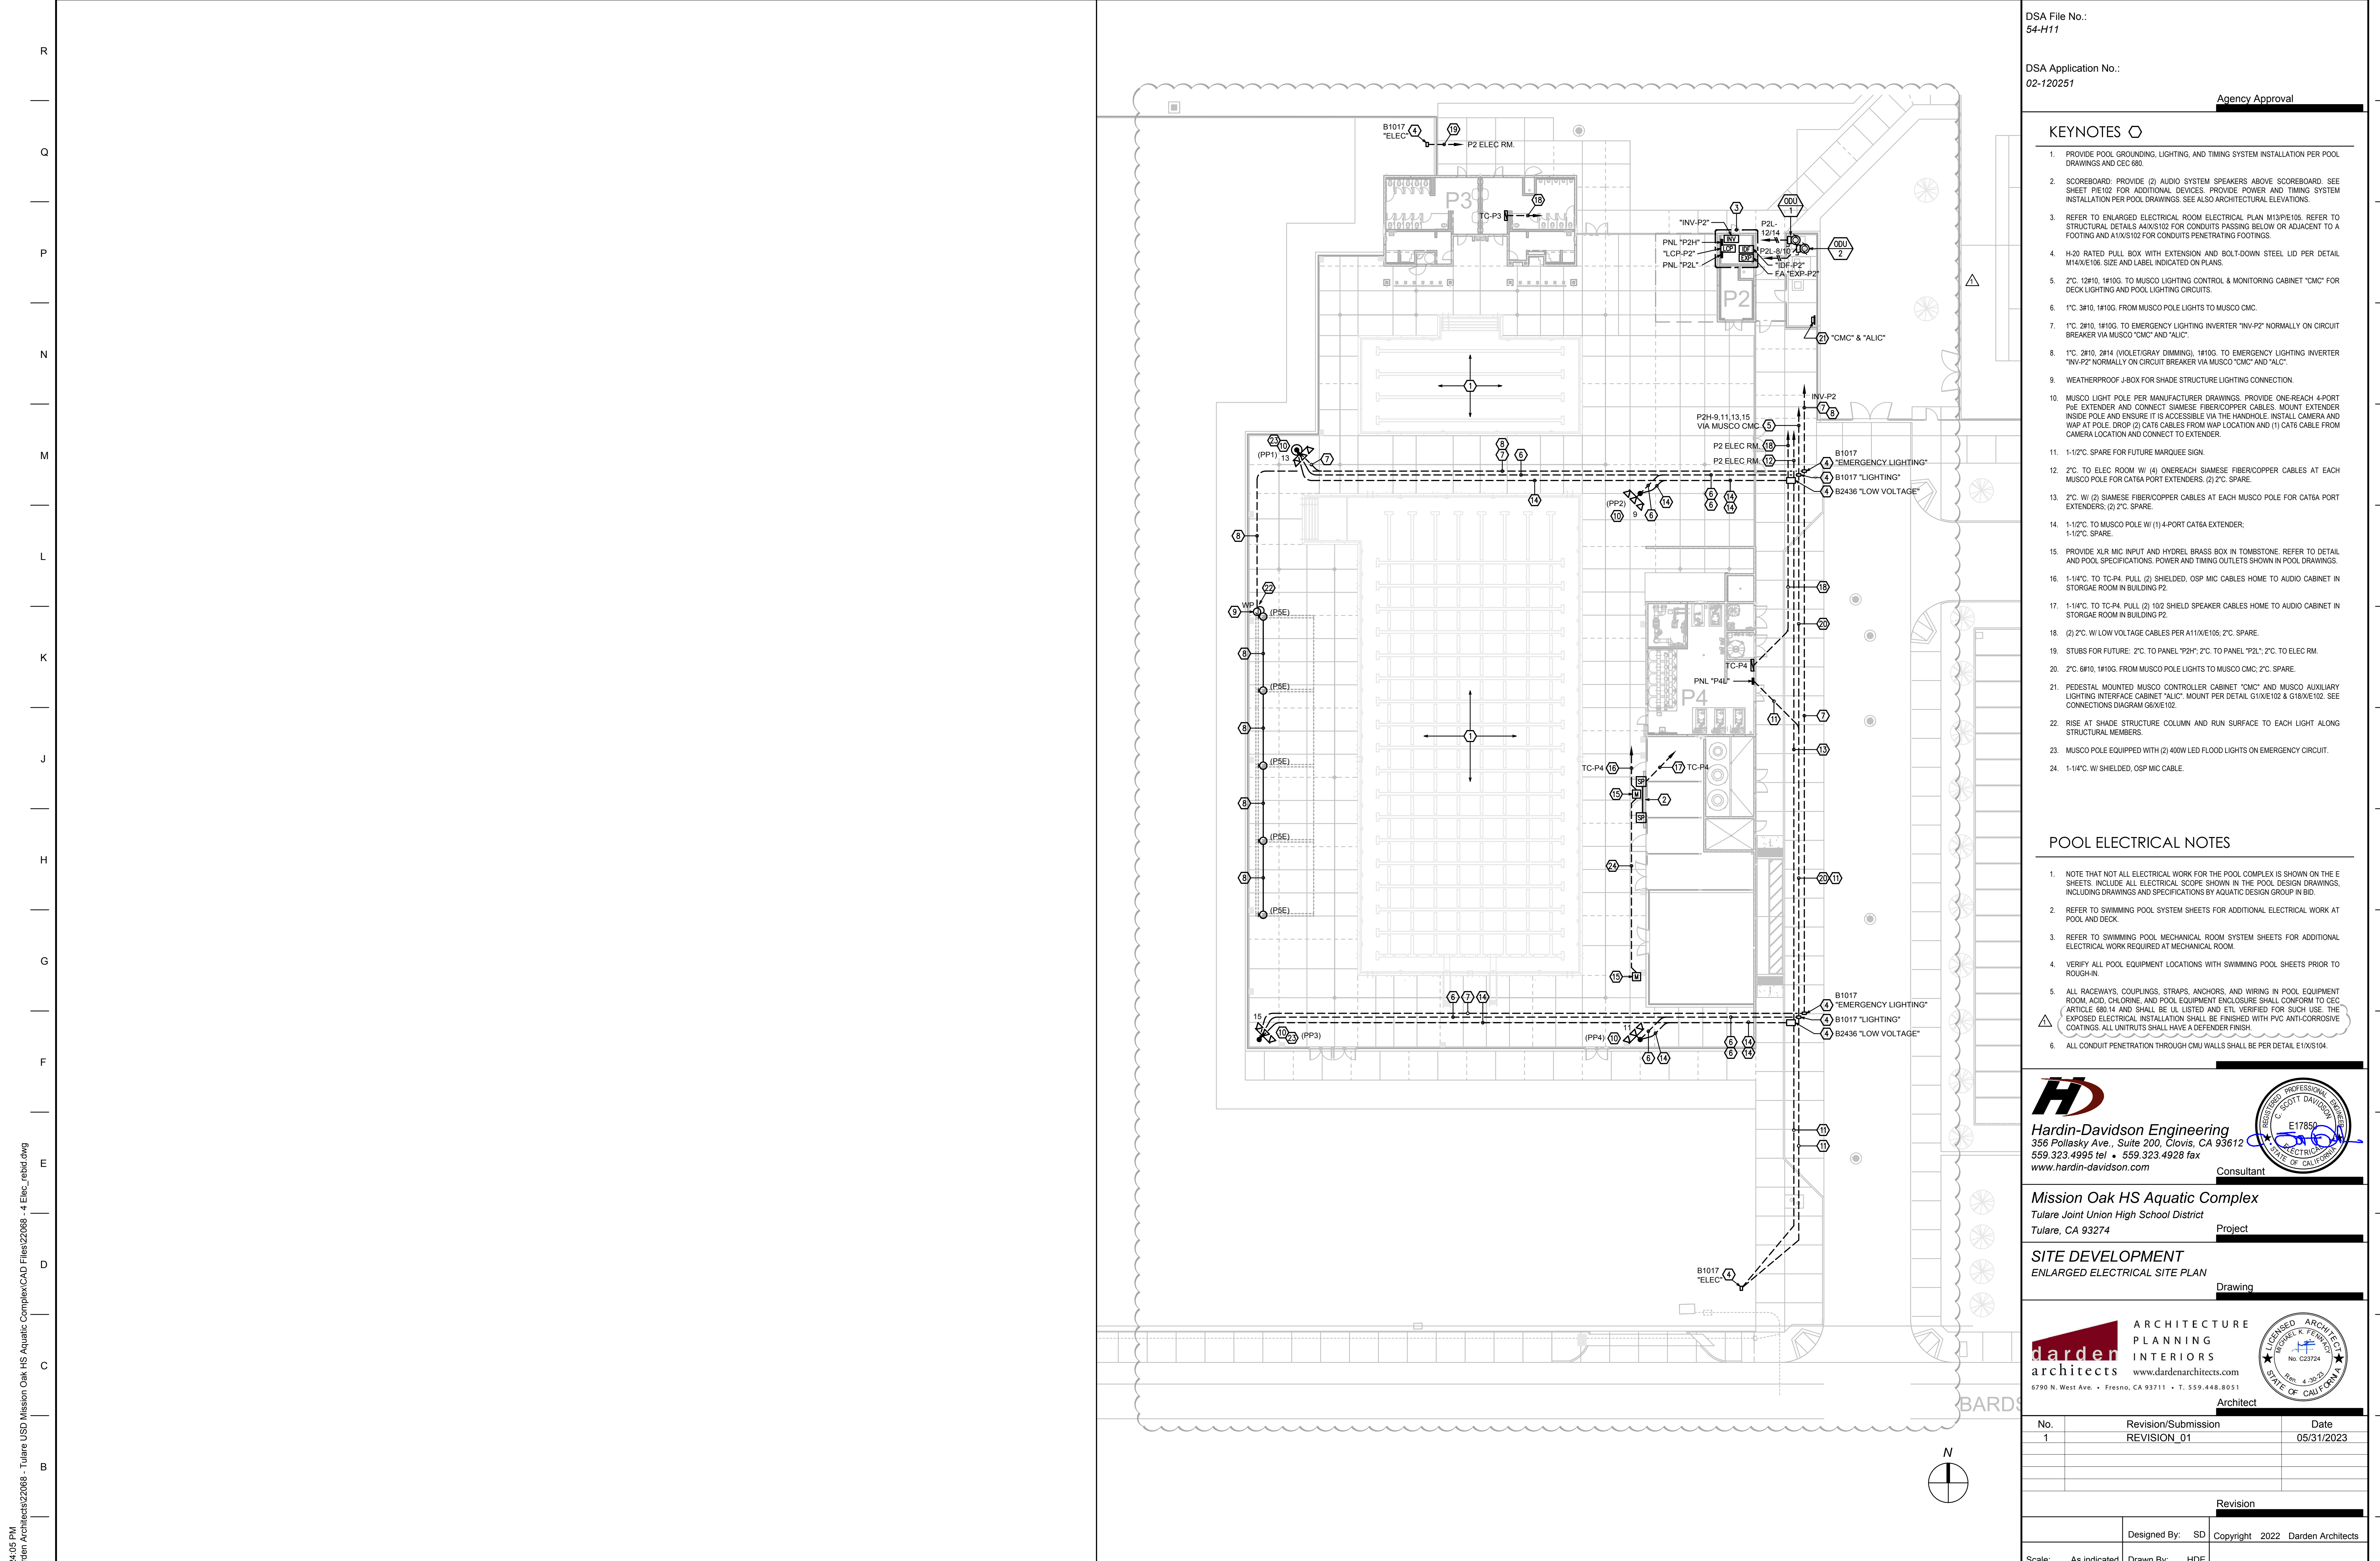

DSA File No.: 54-H11
 DSA Application No.: 02-120251
 Agency Approval

- ### KEYNOTES
1. PROVIDE POOL GROUNDING, LIGHTING, AND TIMING SYSTEM INSTALLATION PER POOL DRAWINGS AND CEC 880.
 2. SCOREBOARD: PROVIDE (2) AUDIO SYSTEM SPEAKERS ABOVE SCOREBOARD. SEE SHEET P2102 FOR ADDITIONAL DEVICES. PROVIDE POWER AND TIMING SYSTEM INSTALLATION PER POOL DRAWINGS. SEE ALSO ARCHITECTURAL ELEVATIONS.
 3. REFER TO ENLARGED ELECTRICAL ROOM ELECTRICAL PLAN M10P/E105. REFER TO STRUCTURAL DETAILS 41X/5102 FOR CONDUITS PASSING BELOW OR ADJACENT TO A FOOTING AND 41X/5102 FOR CONDUITS PENETRATING FOOTINGS.
 4. H-20 RATED PULL BOX WITH EXTENSION AND BOLT-DOWN STEEL LID PER DETAIL M14X/E106. SIZE AND LABEL INDICATED ON PLANS.
 5. 2" 12#10, 1#10G. TO MUSCO LIGHTING CONTROL & MONITORING CABINET "CMC" FOR DECK LIGHTING AND POOL LIGHTING CIRCUITS.
 6. 1" 3#10, 1#10G. FROM MUSCO POLE LIGHTS TO MUSCO CMC.
 7. 1" 2#10, 1#10G. TO EMERGENCY LIGHTING INVERTER "INV-P2" NORMALLY ON CIRCUIT BREAKER VIA MUSCO "CMC" AND "ALIC".
 8. 1" 2#10, 2#14 (VIOLET/GRAY DIMMING), 1#10G. TO EMERGENCY LIGHTING INVERTER "INV-P2" NORMALLY ON CIRCUIT BREAKER VIA MUSCO "CMC" AND "ALIC".
 9. WEATHERPROOF J-BOX FOR SHADE STRUCTURE LIGHTING CONNECTION.
 10. MUSCO LIGHT POLE PER MANUFACTURER DRAWINGS. PROVIDE ONE-REACH 4-PORT P&E EXTENDER AND CONNECT SIEMENS FIBER/COPPER CABLES. MOUNT EXTENDER INSIDE POLE AND ENSURE IT IS ACCESSIBLE VIA THE HANDHOLE. INSTALL CAMERA AND WAP AT POLE. DROP (2) CAT6 CABLES FROM WAP LOCATION AND (1) CAT6 CABLE FROM CAMERA LOCATION AND CONNECT TO EXTENDER.
 11. 1-1/2" C. SPARE FOR FUTURE MARQUEE SIGN.
 12. 2" C. TO ELEC ROOM W/ (4) ONE-REACH SIEMENS FIBER/COPPER CABLES AT EACH MUSCO POLE FOR CAT6A PORT EXTENDERS. (2) 2" C. SPARE.
 13. 2" W/ (2) SIEMENS FIBER/COPPER CABLES AT EACH MUSCO POLE FOR CAT6A PORT EXTENDERS. (2) 2" C. SPARE.
 14. 1-1/2" C. TO MUSCO POLE W/ (1) 4-PORT CAT6A EXTENDER. 1-1/2" C. SPARE.
 15. PROVIDE XLR MIC INPUT AND HYDREL BRASS BOX IN TOMBSTONE. REFER TO DETAIL AND POOL SPECIFICATIONS. POWER AND TIMING OUTLETS SHOWN IN POOL DRAWINGS.
 16. 1-1/4" C. TO TC-P4. PULL (2) SHIELDED, OSP MIC CABLES HOME TO AUDIO CABINET IN STORAGE ROOM IN BUILDING P2.
 17. 1-1/4" C. TO TC-P4. PULL (2) 102 SHIELD SPEAKER CABLES HOME TO AUDIO CABINET IN STORAGE ROOM IN BUILDING P2.
 18. (2) 2" C. W/ LOW VOLTAGE CABLES PER A11X/E105. 2" C. SPARE.
 19. STUBS FOR FUTURE: 2" C. TO PANEL "P2H"; 2" C. TO PANEL "P2L"; 2" C. TO ELEC RM.
 20. 2" C. #10, 1#10G. FROM MUSCO POLE LIGHTS TO MUSCO CMC. 2" C. SPARE.
 21. PEDESTAL MOUNTED MUSCO CONTROLLER CABINET "CMC" AND MUSCO AUXILIARY LIGHTING INTERFACE CABINET "ALIC" MOUNT PER DETAIL G11X/E102 & G18X/E102. SEE CONNECTIONS DIAGRAM G6X/E102.
 22. RISE AT SHADE STRUCTURE COLUMN AND RUN SURFACE TO EACH LIGHT ALONG STRUCTURAL MEMBERS.
 23. MUSCO POLE EQUIPPED WITH (2) 400W LED FLOOD LIGHTS ON EMERGENCY CIRCUIT.
 24. 1-1/4" C. W/ SHIELDED, OSP MIC CABLE.

- ### POOL ELECTRICAL NOTES
1. NOTE THAT NOT ALL ELECTRICAL WORK FOR THE POOL COMPLEX IS SHOWN ON THE E SHEETS. INCLUDE ALL ELECTRICAL SCOPE SHOWN IN THE POOL DESIGN DRAWINGS, INCLUDING DRAWINGS AND SPECIFICATIONS BY AQUATIC DESIGN GROUP IN BID.
 2. REFER TO SWIMMING POOL SYSTEM SHEETS FOR ADDITIONAL ELECTRICAL WORK AT POOL AND DECK.
 3. REFER TO SWIMMING POOL MECHANICAL ROOM SYSTEM SHEETS FOR ADDITIONAL ELECTRICAL WORK REQUIRED AT MECHANICAL ROOM.
 4. VERIFY ALL POOL EQUIPMENT LOCATIONS WITH SWIMMING POOL SHEETS PRIOR TO ROUGH-IN.
 5. ALL RACEWAYS, COUPLINGS, STRAPS, ANCHORS, AND WIRING IN POOL EQUIPMENT ROOM, ACID, CHLORINE, AND POOL EQUIPMENT ENCLOSURE SHALL CONFORM TO CEC ARTICLE 680.14 AND SHALL BE UL LISTED AND ETL VERIFIED FOR SUCH USE. THE EXPOSED ELECTRICAL INSTALLATION SHALL BE FINISHED WITH PVC ANTI-CORROSIVE COATINGS. ALL UNITS SHALL HAVE A DEFENDER FINISH.
 6. ALL CONDUIT PENETRATION THROUGH CMU WALLS SHALL BE PER DETAIL E11X/5104.

HD
Hardin-Davidson Engineering
 356 Pollasky Ave., Suite 200, Clovis, CA 93612
 559.323.4955 tel • 559.323.4928 fax
 www.hardin-davidson.com
 Consultant

Mission Oak HS Aquatic Complex
 Tulare Joint Union High School District
 Tulare, CA 93274
 Project

SITE DEVELOPMENT
 ENLARGED ELECTRICAL SITE PLAN
 Drawing

darden architects
 ARCHITECTURE
 PLANNING
 INTERIORS
 www.dardenarchitects.com
 6790 N. West Ave. • Fresno, CA 93711 • T. 559.448.8051
 Architect


No.	Revision/Submission	Date
1	REVISION_01	05/31/2023
Revision		
Scale:	As indicated	Drawn By: HDE
Project Number:	2180	Checked By: SD
Date:	08/02/2022	Reviewed By: SD
Designed By: SD		Copyright © 2022 Darden Architects
Scale: 1" = 20'-0"		Sheet: SD/E102 of: _____

8/16/2023 4:24:05 PM
 Z:\Clients\Hardin Architects\22068 - Tulare USD Mission Oak HS Aquatic Complex\CAD Files\22068 - 4 Elec_rebid.dwg

A10
 1" = 20'-0"
 Enlarged Electrical Site Plan

System No. W-1-1003

February 14, 2008
F Rating - 1 and 2 Hr (See Item 1)
T Rating - 0 Hr

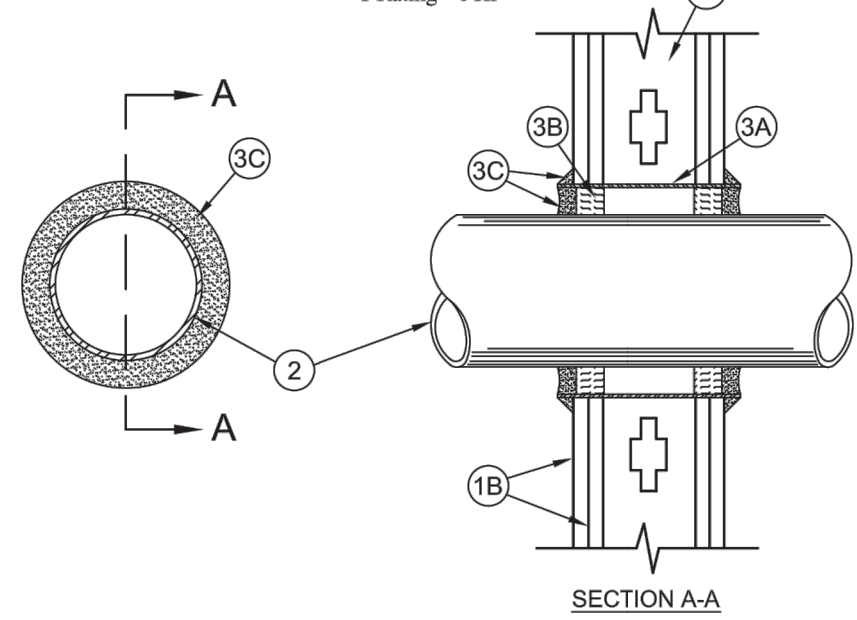


SECTION A-A

- 1. Wall Assembly - The 1 or 2 hr fire-rated gypsum board/wall assembly shall be constructed of the materials and in the manner described in the individual U300, U400 or V400 Series Wall and Partition Design in the UL Fire Resistance Directory and shall include the following construction features:
A. Studs - Wall framing may consist of either wood studs or steel channel studs. Wood studs to consist of nom 2 by 4 in. (51 by 102 mm) lumber spaced 16 in. (406 mm) OC with nom 2 by 4 in. (51 by 102 mm) lumber end plates and cross braces. Steel studs to be min 3-1/2 in. (89 mm) wide by 1.38 in. (35 mm) deep channels spaced max 24 in. (610 mm) OC.
B. Gypsum Board - Nom 5/8 in. (16 mm) thick, 4 ft. (1.2 m) wide with square or tapered edges. The gypsum board type, thickness, number of layers, fastener type and sheet orientation shall be as specified in the individual U300, U400 or V400 Series Design in the UL Fire Resistance Directory. Max diam of opening is 15 in. (381 mm).
The hourly F Rating of the firestop system is equal to the hourly fire rating of the wall assembly in which it is installed.
Through Penetrant - One metallic pipe, conduit or tubing to be installed either concentrically or eccentrically within the firestop system. The space between pipes, conduits or tubing and the steel sleeve (Item 3A) shall be min 0.1 in. (spit contact) to max 2-3/8 in. (60 mm). Pipe, conduit or tubing to be rigidly supported on both sides of wall assembly. The following types and sizes of metallic pipes, conduits or tubing may be used:
A. Steel Pipe - Nom 12 in. (305 mm) diam (or smaller) Schedule 10 (or heavier) steel pipe.
B. Iron Pipe - Nom 12 in. (305 mm) diam (or smaller) service weight (or heavier) cast iron soil pipe, nom 12 in. (305 mm) diam (or smaller) or Class 50 (or heavier) ductile iron pressure pipe.
C. Conduit - Nom 6 in. (152 mm) diam (or smaller) steel conduit or nom 4 in. (102 mm) diam (or smaller) steel electrical metallic tubing.
D. Copper Tubing - Nom 6 in. (152 mm) diam (or smaller) Type L (or heavier) copper tubing.
E. Copper Pipe - Nom 6 in. (152 mm) diam (or smaller) Regular (or heavier) copper pipe.
Firestop System - Installed symmetrically on both sides of wall assembly. The details of the firestop system shall be as follows:
A. Steel Sleeve - Cylindrical sleeve fabricated from min 0.019 in. thick (0.48 mm) galv sheet steel and having a min 2 in. (51 mm) lap along the longitudinal seam. Length of steel sleeve to be equal to thickness of wall plus 1 to 4 in. (25 to 102 mm) such that, when installed, the ends of the sleeve will project approx 1/2 to 2 in. (13 to 51 mm) beyond the surface of the wall on both sides of the wall assembly. Sleeve installed by coiling the sheet steel to a diam smaller than the through opening, inserting the coil through the openings and releasing the coil to lie snugly against the circular cavity in the gypsum board/wall assembly.
B. Packing Material - Min 1 in. (25 mm) thickness of mineral wool batt insulation firmly packed into steel sleeve on both sides of the wall assembly as permanent foam. Packing material to be recessed min 1/2 in. (13 mm) from end of steel sleeve (flush with or recessed into gypsum board surface) on both sides of wall assembly.
C. Backer Rod - (Not shown) - As an alternate to Item B, nom 1 in. (25 mm) thick polyisocyanurate backer rod may be used. The backer rod is to be recessed within the steel sleeve a min of 1 in. (25 mm) from each surface of wall.
D. Fill Void or Cavity Materials - Caulk or Sealant - When mineral wool batt insulation is used, caulk or sealant applied to fill the steel sleeve to a min depth of 1/2 in. (13 mm) on both sides of wall assembly. When backer rod is used, a min thickness of 1 in. (25 mm) of caulk or sealant is required flush with both sides of wall. A nom 1/4 in. (6 mm) diam continuous bead of caulk or sealant shall be applied around the circumference of the sleeve at its edges from the gypsum board surface on both sides of the wall assembly.
JM COMPANY - CP 25WB-1, IC 15WB or FB-3000 WT
*Bearing the UL Classification Mark

System No. C-AJ-1366

December 04, 2008
F Rating - 2 Hr
T Rating - 0 Hr

L Rating At Ambient Temp - Less Than 1 CFM/50 ft
L Rating At 400 F - 2 CFM/50 ft

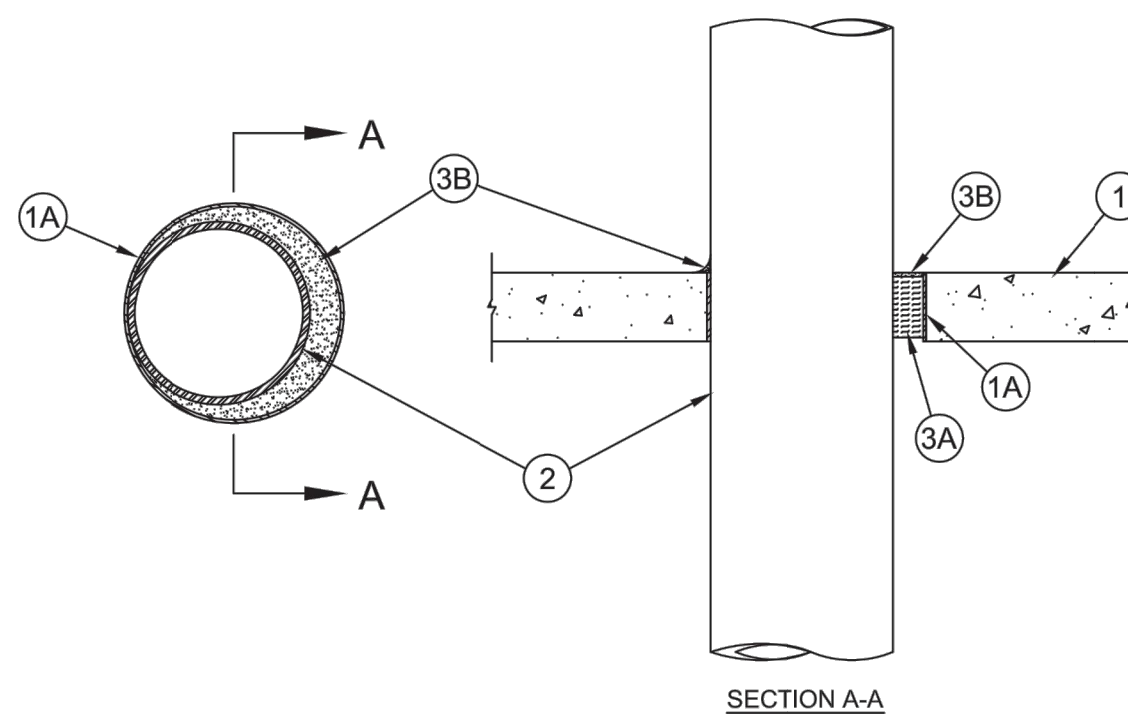

SECTION A-A

- 1. Floor or Wall Assembly - Min 2-1/2 in. (64 mm) thick reinforced lightweight or normal weight (100-150 pcf or 1600-2400 kg/m³) concrete floor or min 3 in. (76 mm) thick, reinforced lightweight or normal weight (100-150 pcf or 1600-2400 kg/m³) concrete wall. Wall may also be constructed of any UL Classified Concrete Blocks*. Max diam of opening is 10 in. (254 mm).
See Concrete Blocks (CAZT) category in the Fire Resistance Directory for names of manufacturers.
1A. Steel Sleeve (Optional) - Nom 10 in. (254 mm) diam (or smaller) Schedule 10 (or heavier) steel pipe sleeve cast into concrete floor or wall. Sleeve to be flush with top and bottom surfaces of floor or both surfaces of wall.
2. Through Penetrants - One metallic pipe, tubing or conduit to be installed either concentrically or eccentrically within the firestop system. The smallest space between tube and periphery of sleeve shall be min 0.1 in. to max 7/8 in. (22 mm). Penetrants to be rigidly supported on both sides of floor assembly. The following types and sizes of metallic pipes, tubing or conduit may be used:
A. Steel Pipe - Nom 8 in. (203 mm) diam (or smaller) Schedule 10 (or heavier) steel pipe.
B. Iron Pipe - Nom 8 in. (203 mm) diam (or smaller) cast iron or ductile iron pipe.
C. Conduit - Nom 6 in. (152 mm) diam (or smaller) rigid steel conduit.
D. Conduit - Nom 4 in. (102 mm) diam (or smaller) steel electrical metallic tubing.
E. Copper Tubing - Nom 4 in. (102 mm) diam (or smaller) Type L (or heavier) copper tube.
F. Copper Pipe - Nom 4 in. (102 mm) diam (or smaller) Regular (or heavier) copper pipe.
Firestop System - The details of the firestop system shall be as follows:
A. Packing Material - Min 2 in. (51 mm) thickness of min 4 pcf (64 kg/m³) mineral wool batt insulation firmly packed into opening as a permanent foam. Packing material to be recessed from top surface of floor or both surfaces of wall to accommodate the required thickness of fill material.
B. Fill Void or Cavity Materials - Caulk - Min 1/2 in. (13 mm) thickness of caulk applied within the annulus, flush with top surface of floor or both surfaces of wall. Min 1/2 in. (13 mm) diam bead of caulk applied to the penetrant/concrete interface at the point contact location on the top surface of floor or both surfaces of wall.
JM COMPANY - FireDam 150
*Bearing the UL Classification Mark

ELECTRICAL GENERAL NOTES:

- 1. ALL WORK SHALL MEET THE LATEST ADOPTED ADDITIONS OF THE CALIFORNIA CODE OF REGULATIONS, TITLE 24 AND ALL OTHER APPLICABLE REGULATIONS, WHICH INCLUDE:
CALIFORNIA BUILDING CODE 2019
CALIFORNIA ELECTRICAL CODE 2019
NON RESIDENTIAL CEC ENERGY STANDARDS 2019
2. NOTHING IN THE PLANS OR SPECIFICATIONS IS TO BE CONSTRUED TO PERMIT WORK NOT CONFORMING TO THESE CODES.
3. IT IS THE INTENTION OF THESE PLANS AND SPECIFICATIONS TO COVER EVERYTHING REQUIRED TO PROVIDE FOR COMPLETE AND OPERATIVE SYSTEMS. THE CONTRACTOR IS TO FURNISH LABOR, MATERIAL, TRANSPORTATION, EQUIPMENT, MISCELLANEOUS SERVICES, ETC. REQUIRED TO ACCOMPLISH THIS RESULT. ANYTHING WHICH MAY BE REASONABLY CONSTRUED AS A NECESSARY PART OF THE INSTALLATION IS TO BE INCLUDED, WHETHER OR NOT SPECIFICALLY SHOWN OR MENTIONED.
4. THE CONTRACTOR SHALL EXAMINE THE SITE AND EXISTING CONDITIONS AND MAKE ALLOWANCES IN THE BID FOR ANY CONDITIONS NOT SHOWN ON THE ELECTRICAL DOCUMENTS.
5. THE PLANS AND SPECIFICATIONS ARE INTENDED TO BE USED AS CONSTRUCTION GUIDELINES AND ARE NOT THE TOTAL INSTRUMENT OF CONTRACT DOCUMENTS. IT IS NOT THE INTENTION OF ANY CONSTRUCTION PLANS TO DIVIDE WORK AMONG DIFFERENT TRADES. VERIFY THE SCOPE OF WORK WITH THE ARCHITECT AND THE GENERAL CONTRACTOR.
6. ELECTRICAL ROUTING IS DIAGRAMMATIC ONLY. ACTUAL ROUTING & PHYSICAL CONDITIONS MAY VARY. THE CONTRACTOR IS RESPONSIBLE FOR DETERMINING THE ACTUAL ROUTING, CONNECTIONS & PROVISION OF ALL APPURTENANCES NECESSARY FOR A COMPLETE & OPERATING SYSTEM.
7. ELECTRICAL EQUIPMENT SHALL HAVE AN APPROVED TESTING LABORATORY LABEL ATTACHED (UL, CSA ETC) PER CEC 110.2.
8. PROVIDE LABELING AND DIRECTORIES FOR ALL SWITCHBOARDS AND PANELBOARDS PER CEC 408.4.
9. ELECTRICAL EQUIPMENT SHALL HAVE A SHORT CIRCUIT CURRENT RATING CAPABLE OF WITHSTANDING THE AVAILABLE SHORT CIRCUIT CURRENT PER CEC 110.9.
10. PROVIDE MINIMUM 30" WIDE x 78" HIGH x 36" DEEP WORK CLEARANCES IN FRONT OF PANELS, SERVICE OR EQUIPMENT RATED AT 120/208/240 V/4 W PER CEC 110.26.
11. PROVIDE MINIMUM 30" WIDE x 78" HIGH x 42" DEEP WORK CLEARANCES IN FRONT OF PANELS, SERVICE OR EQUIPMENT RATED AT 277/480 V/3Ø 4W PER CEC 110.26.
12. ELECTRICAL RECEPTACLE OUTLETS ON BRANCH CIRCUIT OF 30 AMPERES OR LESS AND COMMUNICATION SYSTEM RECEPTACLES SHALL BE MOUNTED BETWEEN 15" AFF AND 48" AFF AND SHALL COMPLY WITH CBC SECTION 11B-308. THE LOW REACH SHALL BE MEASURED TO THE BOTTOM OF THE OUTLET BOX AND THE HIGH REACH SHALL BE MEASURED TO THE TOP OF THE OUTLET BOX. IF THE REACH IS OBSTRUCTED (E.G. BY CASEWORK, COUNTERS, ETC.), RECEPTACLES SHALL BE LOCATED WITHIN THE REACH RANGES SPECIFIED IN CBC 11B-308.2.2 AND 11B-308.3.2.
13. CONTROLS AND SWITCHES INTENDED TO BE USED BY THE OCCUPANT OF A ROOM OR AREA TO CONTROL LIGHTING AND RECEPTACLE OUTLETS, APPLIANCES, OR COOLING, HEATING AND VENTILATING EQUIPMENT SHALL BE MOUNTED BETWEEN 15" AFF AND 48" AFF AND SHALL COMPLY WITH CBC SECTION 11B-308. THE LOW REACH SHALL BE MEASURED TO THE BOTTOM OF THE OUTLET BOX AND THE HIGH REACH SHALL BE MEASURED TO THE TOP OF THE OUTLET BOX. IF THE REACH IS OBSTRUCTED (E.G. BY CASEWORK, COUNTERS, ETC.), SWITCHES AND CONTROLS SHALL BE LOCATED WITHIN THE REACH RANGES SPECIFIED IN CBC 11B-308.2.2 AND 11B-308.3.2.
14. ALL WALL AND SURFACE MOUNTED FIXTURES PROTRUDING IN THE PATH OF TRAFFIC (PO) OR COMMON PEDESTRIANWAYS SHALL COMPLY WITH CBC 11B-307.2, OR SHALL BE MOUNTED LESS THAN 27" AFF OR GREATER THAN 80" AFF, OR SHALL BE PROVIDED WITH A BARRIER CONFORMING TO CBC 11B-307.4.
15. EMERGENCY EGRESS LIGHTING SHALL PROVIDE A MINIMUM LUMINANCE OF 1 FOOTCANDLE AT THE WALKING SURFACE FOR A MINIMUM OF 90 MINUTES.
16. FIRE ALARM EQUIPMENT SHALL BE SERVED BY DEDICATED FIRE ALARM BRANCH CIRCUITS PER NFPA 72 10.6.5.1.2. THE CIRCUIT NUMBER SHALL BE PERMANENTLY IDENTIFIED AT THE FIRE ALARM EQUIPMENT PER NFPA 72 10.6.5.2.1. THE CIRCUIT BREAKER SHALL BE EQUIPPED WITH RED HANDLE AND LOCK-ON DEVICE, AND PERMANENTLY IDENTIFIED AS "FIRE ALARM CIRCUIT" PER NFPA 72 10.6.5.2.2, 10.6.5.2.3, 10.6.5.2.4, AND 10.6.5.4.
17. WIRING FOR 120/208V AND 277/480V SYSTEMS SHALL BE MIN. #12 AWG THHN/THWN-2 COPPER.
18. FEEDERS SIZE #4 AND LARGER SHALL BE MEGGER TESTED. TEST RESULTS SHALL BE SUBMITTED TO THE ENGINEER.
19. COLOR/FINISHES/MATERIALS FOR ALL ELECTRICAL DEVICES, PLATES, LIGHT FIXTURES, ETC. SHALL BE CHOSEN BY THE ARCHITECT.
20. PROVIDE PERMANENT LOCK-OPEN DEVICES ON CIRCUIT BREAKERS SERVING ELECTRIC WATER HEATERS TO MEET THE REQUIREMENTS OF CEC 422.31.
21. CONTRACTOR SHALL EXTEND ALL SIGNAL AND FIRE ALARM SYSTEMS AS REQUIRED. MODIFY HEAD-IN EQUIPMENT TO ACCOMMODATE NEW DEVICES AS REQUIRED. VERIFY THE CONDITION AND EXPANDABILITY OF ALL HEAD-IN EQUIPMENT PRIOR TO BID AND MODIFY ACCORDINGLY.
22. CALL USR UNDERGROUND ALERT AND VERIFY WITH DISTRICT THE DESIRED ROUTING AND LOCATIONS OF UNDERGROUND CONDUITS AND STRUCTURES PRIOR TO TRENCHING.
23. EXISTING EQUIPMENT TO BE REMOVED AND/OR REPLACED SHALL BE DELIVERED TO THE DISTRICT MAINTENANCE DEPARTMENT OR DISPOSED OF, AT THE DISCRETION OF THE DISTRICT.
24. ALL CONDUITS UNDER CONCRETE OR ASPHALT WILL HAVE 3/4" MINIMUM COVER OF ROCK FREE NATIVE SOIL, METALLIC WARNING TAPE AT 12" AND NO ENCASMENT REQUIRED. ALL CONDUITS THAT HAVE CONDUCTORS WITH A POTENTIAL OF 250 VOLT TO GROUND OR GREATER, THAT ARE NOT UNDER ASPHALT AND/OR CONCRETE SHALL REQUIRE 1,500 PSI CONCRETE ENCASMENT, METALLIC WARNING TAPE AT 12" AND A MINIMUM COVER OF 24". ALL CONDUITS THAT HAVE CONDUCTORS WITH A POTENTIAL OF 250 VOLTS TO GROUND, THAT ARE NOT UNDER ASPHALT AND/OR CONCRETE WILL HAVE 3/4" MINIMUM COVER OF NATIVE SOIL, METALLIC WARNING TAPE AT 12" AND NO ENCASMENT REQUIRED.
25. INSTALL GALVANIZED RIGID STEEL RISERS & ELBOWS WHERE THEY OCCUR. WRAP GALVANIZED RIGID STEEL BELOW GRADE. PVC SHALL NOT BE INSTALLED ABOVE GRADE.
26. CONDUIT INSTALLED ABOVE GRADE SHALL BE MIN. 3/4" TRADE SIZE. CONDUIT BELOW GRADE SHALL BE MIN. 1" TRADE SIZE.
27. PROVIDE (4) 1" CONDUIT STUBS FROM NEW ELECTRICAL PANEL TO ACCESSIBLE ATTIC SPACE FOR FUTURE USE.
28. CIRCUIT BREAKERS SERVING FIRE ALARM EQUIPMENT SHALL HAVE A RED HANDLE AND LOCK-ON DEVICE.
29. HOLES ARE NOT ALLOWED THROUGH TOP PLATES OF BEARING WALLS AND SHEAR WALLS.
30. INCLUDE FIRE STOP SYSTEMS REQUIRED FOR ALL WORK AFFECTED BY FIRE RATED ASSEMBLIES.
31. INCLUDE ALL WORK REQUIRED TO INVESTIGATE, DEMOLISH, & RECONNECT EXISTING ITEMS.
32. ALL LOW VOLTAGE EQUIPMENT SHALL BE DEENERGIZED PRIOR TO DEMO WORK. CONTRACTOR IS RESPONSIBLE FOR ANY DAMAGE TO LIFE EQUIPMENT.
33. LEAN CONCRETE SHALL BE USED AS BACK FILL WHERE UTILITY TRENCHES EXTEND FROM THE EXTERIOR TO THE INTERIOR LIMITS OF THE BUILDING. LEAN CONCRETE SHALL HAVE A MINIMUM DISTANCE OF 2 FEET LATERALLY ON EACH SIDE OF THE EXTERIOR BUILDING LINE AND A MINIMUM OF 6 INCHES ABOVE FOOTING PENETRATION.

LIGHTING GENERAL NOTES:

- 1. THE CONTRACTOR SHALL PROVIDE A COMPLETE SYSTEM OF LIGHT FIXTURES AND CONTROLS THAT COMPLY WITH THE REQUIREMENTS OF CALIFORNIA ENERGY COMMISSION TITLE 24.
2. PROVIDE A COMPLETE AND OPERATIONAL CONTROLS PACKAGE IN LIGHTING AREAS. PROVIDE WALL SWITCHES, SENSORS, POWER PACKS, MISCELLANEOUS APPURTENANCES, FACTORY CABLING, AND FACTORY COMMISSIONING.
3. AN EQUAL SUBSTITUTE PACKAGE BY ANOTHER MANUFACTURER MAY BE ACCEPTABLE. CONTRACTOR SHALL BE RESPONSIBLE TO PROVIDE ALL REQUIRED COMPONENTS. ADDITIONAL WIRING FOR DIMMING OPERATION OF LIGHT FIXTURES, AND ANYTHING ELSE NEEDED FOR A COMPLETE AND OPERATIONAL SYSTEM, SUBMIT SUBSTITUTE PACKAGE, INCLUDING SHOP DRAWINGS, TO ENGINEER FOR REVIEW AND APPROVAL. FAILURE TO COMPLY WITH THIS REQUIREMENT MAY RESULT IN REJECTION OF SUBSTITUTE COMPONENTS.
4. THE PLANS GENERALLY SHOW THE LOCATION OF SWITCHES, SENSORS, CONTROL MODULES ETC. ACTUAL LOCATIONS AND INSTALLATION REQUIREMENTS SHALL BE DETERMINED BY THE MANUFACTURER. SUBMIT SHOP DRAWINGS TO ENGINEER FOR APPROVAL.
5. PROVIDE FACTORY COMMISSIONING, TO INCLUDE COMPLETE CONTROL WIRING/ CALIBRATION/ PROGRAMMING OF LIGHTING CONTROL COMPONENTS.
6. LIGHTING SYSTEM ACCEPTANCE TESTING IS REQUIRED AS PER TITLE 24. THE CONTRACTOR SHALL INCLUDE ACCEPTANCE TESTING COSTS IN BID. THE CONTRACTOR IS RESPONSIBLE TO MAKE ANY ADJUSTMENTS NECESSARY TO ACHIEVE ACCEPTANCE.
7. LIGHTING FIXTURE COLORS, WHEN NOT SPECIFIED, SHALL BE SELECTED BY THE ARCHITECT'S OFFICE. DO NOT SUBMIT COLORS THAT HAVE NOT BEEN APPROVED BY THE ARCHITECT.

LOW VOLTAGE GENERAL NOTES:

- 1. THE ELECTRICAL CONTRACTOR SHALL CONTACT EACH ELECTRONICS SYSTEM VENDOR AND THOROUGHLY INVESTIGATE THE EXPANDABILITY OF ALL EXISTING SYSTEMS. THE CONTRACTORS BID SHALL INCLUDE ALL REQUIRED COMPONENTS, PROGRAMMING, CABLING, UPGRADES, AND RELATED LABOR AND MATERIALS TO INTEGRATE THE WORK SHOWN IN DIVISIONS 26, 27, 28 DRAWINGS AND SPECIFICATIONS AND PROVIDE FOR FULLY FUNCTIONAL LOW VOLTAGE SYSTEMS.
2. EXISTING PULL BOX LOCATIONS ARE DIAGRAMMATIC. FIELD VERIFY EXACT LOCATIONS. ADD CONDUITS TO EXISTING PULL BOXES WHERE INDICATED. REPAIR ANY DAMAGE INCURRED.
3. DISCONNECT, REMOVE, RE-PULL, AND RE-TERMINATE EXISTING CABLING AS REQUIRED TO INSTALL NEW CABLING IN EXISTING CONDUITS.
4. ELECTRONICS SYSTEMS CABLING SHALL BE RUN IN CONDUIT WHERE ATTIC SPACES ARE INACCESSIBLE AND WHERE OPEN CEILINGS OCCUR. CABLING INSTALLED IN ACCESSIBLE ATTIC SPACES SHALL BE RUN ON J-HOOKS.
5. TERMINAL CABINETS SHALL BE WEGMANN RMC SERIES, OR EQUAL, W/ MOUNTING PANELS / PLYWOOD BACK BOARD. INSTALL ALL REQUIRED TERMINAL STRIPS, PUNCH DOWN BLOCKS, ETC.
6. INSTALL NYLON PULL LINE WITH ALL CABLE RUNS IN UNDERGROUND CONDUITS.

ELECTRICAL SYMBOLS SCHEDULE:

Table with columns: SYMBOL, DESCRIPTION, NOTES. Lists various electrical symbols and their corresponding descriptions and notes, including items like POLE WITH POST TOP AREA LUMINAIRE, SWITCHBOARD, DIMMING POWER PACK, and INTRUSION SYSTEM MAIN PANEL.

Table with columns: SYMBOL, DESCRIPTION, NOTES. Lists various electrical symbols and their corresponding descriptions and notes, including items like SWITCHBOARD, POWER PANEL, JUNCTION BOX, DISCONNECT SWITCH, FUSEBLE, COMBINATION STARTER/DISCONNECT SWITCH, MOTOR, EXHAUST FAN, CEILING MOUNTED, SINGLE CONVENIENCE OUTLET, and HOME RUN (TO PANEL 'A', CIRCUIT '15').

DSA File No.: 54-H11

DSA Application No.: 02-120251

Agency Approval

ELECTRICAL COMPONENT ANCHORAGE NOTES:

- ALL ELECTRICAL COMPONENTS SHALL BE ANCHORED AND INSTALLED PER THE DETAILS ON THE DSA APPROVED CONSTRUCTION DOCUMENTS. THE FOLLOWING COMPONENTS SHALL BE ANCHORED OR BRACED TO MEET THE FORCE AND DISPLACEMENT REQUIREMENTS PRESCRIBED IN THE 2019 CBC, SECTIONS 1617A.1.18 THROUGH 1617A.1.26 AND ASCE 7-16, CHAPTERS 13, 26 AND 30:
1. ALL PERMANENT EQUIPMENT AND COMPONENTS.
2. TEMPORARY MOVABLE OR MOBILE EQUIPMENT THAT IS PERMANENTLY ATTACHED (E.G. HARD WIRE) TO THE BUILDING ELECTRICAL UTILITY SERVICE. "PERMANENTLY ATTACHED" SHALL INCLUDE ALL ELECTRICAL CONNECTIONS EXCEPT PLUGS FOR 110/220 VOLT RECEPTACLES HAVING A FLEXIBLE CABLE.
3. TEMPORARY MOVABLE OR MOBILE EQUIPMENT WHICH IS HEAVIER THAN 400 POUNDS OR HAS A CENTER OF MASS LOCATED 4 FEET OR MORE ABOVE THE ADJACENT FLOOR OR ROOF LEVEL THAT DIRECTLY SUPPORT THE COMPONENT IS REQUIRED TO BE RESTRAINED IN A MANNER APPROVED BY DSA.

- THE FOLLOWING ELECTRICAL COMPONENTS SHALL BE POSITIVELY ATTACHED TO THE STRUCTURE BUT NEED NOT DEMONSTRATE DESIGN COMPLIANCE WITH THE REFERENCES NOTED ABOVE. THESE COMPONENTS SHALL HAVE FLEXIBLE CONNECTIONS PROVIDED BETWEEN THE COMPONENT AND ASSOCIATED CONDUIT. FLEXIBLE CONNECTIONS MUST ALLOW MOVEMENT IN BOTH TRANSVERSE AND LONGITUDINAL DIRECTIONS:
A. COMPONENTS WEIGHING LESS THAN 400 POUNDS AND HAVE A CENTER OF MASS LOCATED 4 FEET OR LESS ABOVE THE ADJACENT FLOOR OR ROOF LEVEL THAT DIRECTLY SUPPORT THE COMPONENT.
B. COMPONENTS WEIGHING LESS THAN 20 POUNDS, OR IN THE CASE OF DISTRIBUTED SYSTEMS, LESS THAN 5 POUNDS PER FOOT, WHICH ARE SUSPENDED FROM A ROOF OR FLOOR OR HUNG FROM A WALL.

THE ANCHORAGE OF ALL ELECTRICAL COMPONENTS SHALL BE SUBJECT TO THE APPROVAL OF THE DESIGN PROFESSIONAL IN GENERAL, RESPONSIBLE CHAIR OR STRUCTURAL ENGINEER DELEGATED RESPONSIBILITY AND ACCEPTANCE BY DSA. THE PROJECT INSPECTOR WILL VERIFY THAT ALL COMPONENTS AND EQUIPMENT HAVE BEEN ANCHORED IN ACCORDANCE WITH THE ABOVE REQUIREMENTS.

ELECTRICAL DISTRIBUTION SYSTEM BRACING NOTES:


THE ELECTRICAL DISTRIBUTION SYSTEM SHALL BE BRACED TO COMPLY WITH THE FORCES AND DISPLACEMENTS PRESCRIBED IN ASCE 7-16 SECTION 13.3 AS DEFINED IN ASCE 7-16, SECTIONS 13.6.5, 13.6.6, 13.6.7, 13.6.8, AND 2019 CBC, SECTIONS 1617A.1.24, 1617A.1.25, AND 1617A.1.26.

THE METHOD OF SHOWING BRACING AND ATTACHMENTS TO THE STRUCTURE FOR THE IDENTIFIED DISTRIBUTION SYSTEM ARE AS NOTED BELOW. WHEN BRACING AND ATTACHMENTS ARE BASED ON A PREAPPROVED INSTALLATION GUIDE (E.G., OSHPD 09M FOR 2013 CBC OR LATER), COPIES OF THE BRACING SYSTEM INSTALLATION GUIDE OR MANUAL, SHALL BE AVAILABLE ON THE JOBSITE PRIOR TO THE START OF AND DURING THE HANGING AND BRACING OF THE DISTRIBUTION SYSTEMS. THE STRUCTURAL ENGINEER OF RECORD SHALL VERIFY THE ADEQUACY OF THE STRUCTURE TO SUPPORT THE HANGER AND BRACE LOADS.

THE ELECTRICAL DISTRIBUTION SYSTEM IS DETAILED ON THE APPROVED DRAWINGS WITH SPECIFIC NOTES AND DETAILS. WHEN A DETAIL IS NOT PROVIDED ON THE PLANS, THE ELECTRICAL DISTRIBUTION SYSTEM SHALL COMPLY WITH OSHPD PRE-APPROVAL #09M-0922-13 (9-16).

E1 Conduit Penetration Fire Stop Detail

No Scale

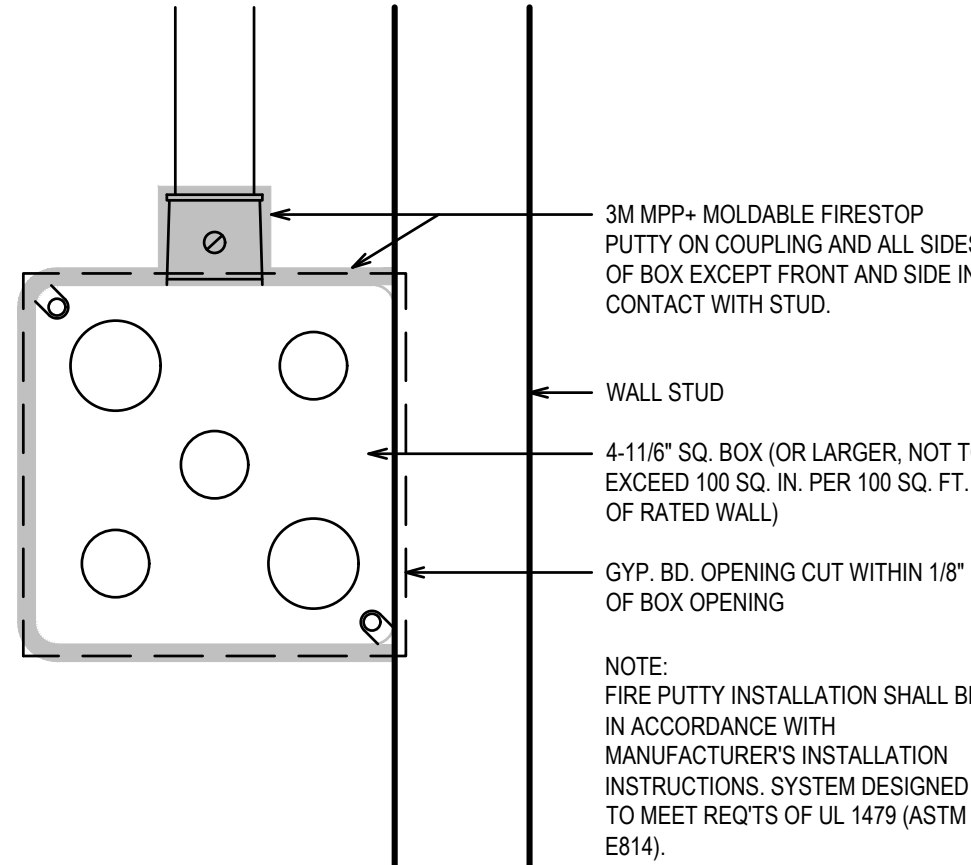

A1 Electrical Box in Fire Rated Wall Detail

No Scale

Hardin-Davidson Engineering logo and contact information: 356 Polasky Ave., Suite 200, Clovis, CA 93612. 559.323.4995 tel • 559.323.4928 fax www.hardin-davidson.com

Mission Oak HS Aquatic Complex, Tulare Joint Union High School District, Tulare, CA 93274. Project


TYPICAL INFORMATION, ELECTRICAL SYSTEMS - SYMBOLS, NOTES, AND DETAILS. Drawing

Darden Architects logo and contact information: 6790 N. West Ave., Fresno, CA 93711 • T. 559.448.8051

Revision table with columns: No., Revision/Submission, Date. Shows revision 01 on 05/31/2023.


Scale, Project Number, Date, and other project details table.

8/16/2023 4:24:06 PM Z:\Clients\Darden Architects\22068 - Tulare USD Mission Oak HS Aquatic Complex\CAD Files\22068 - 4 Elec_rdbd.dwg

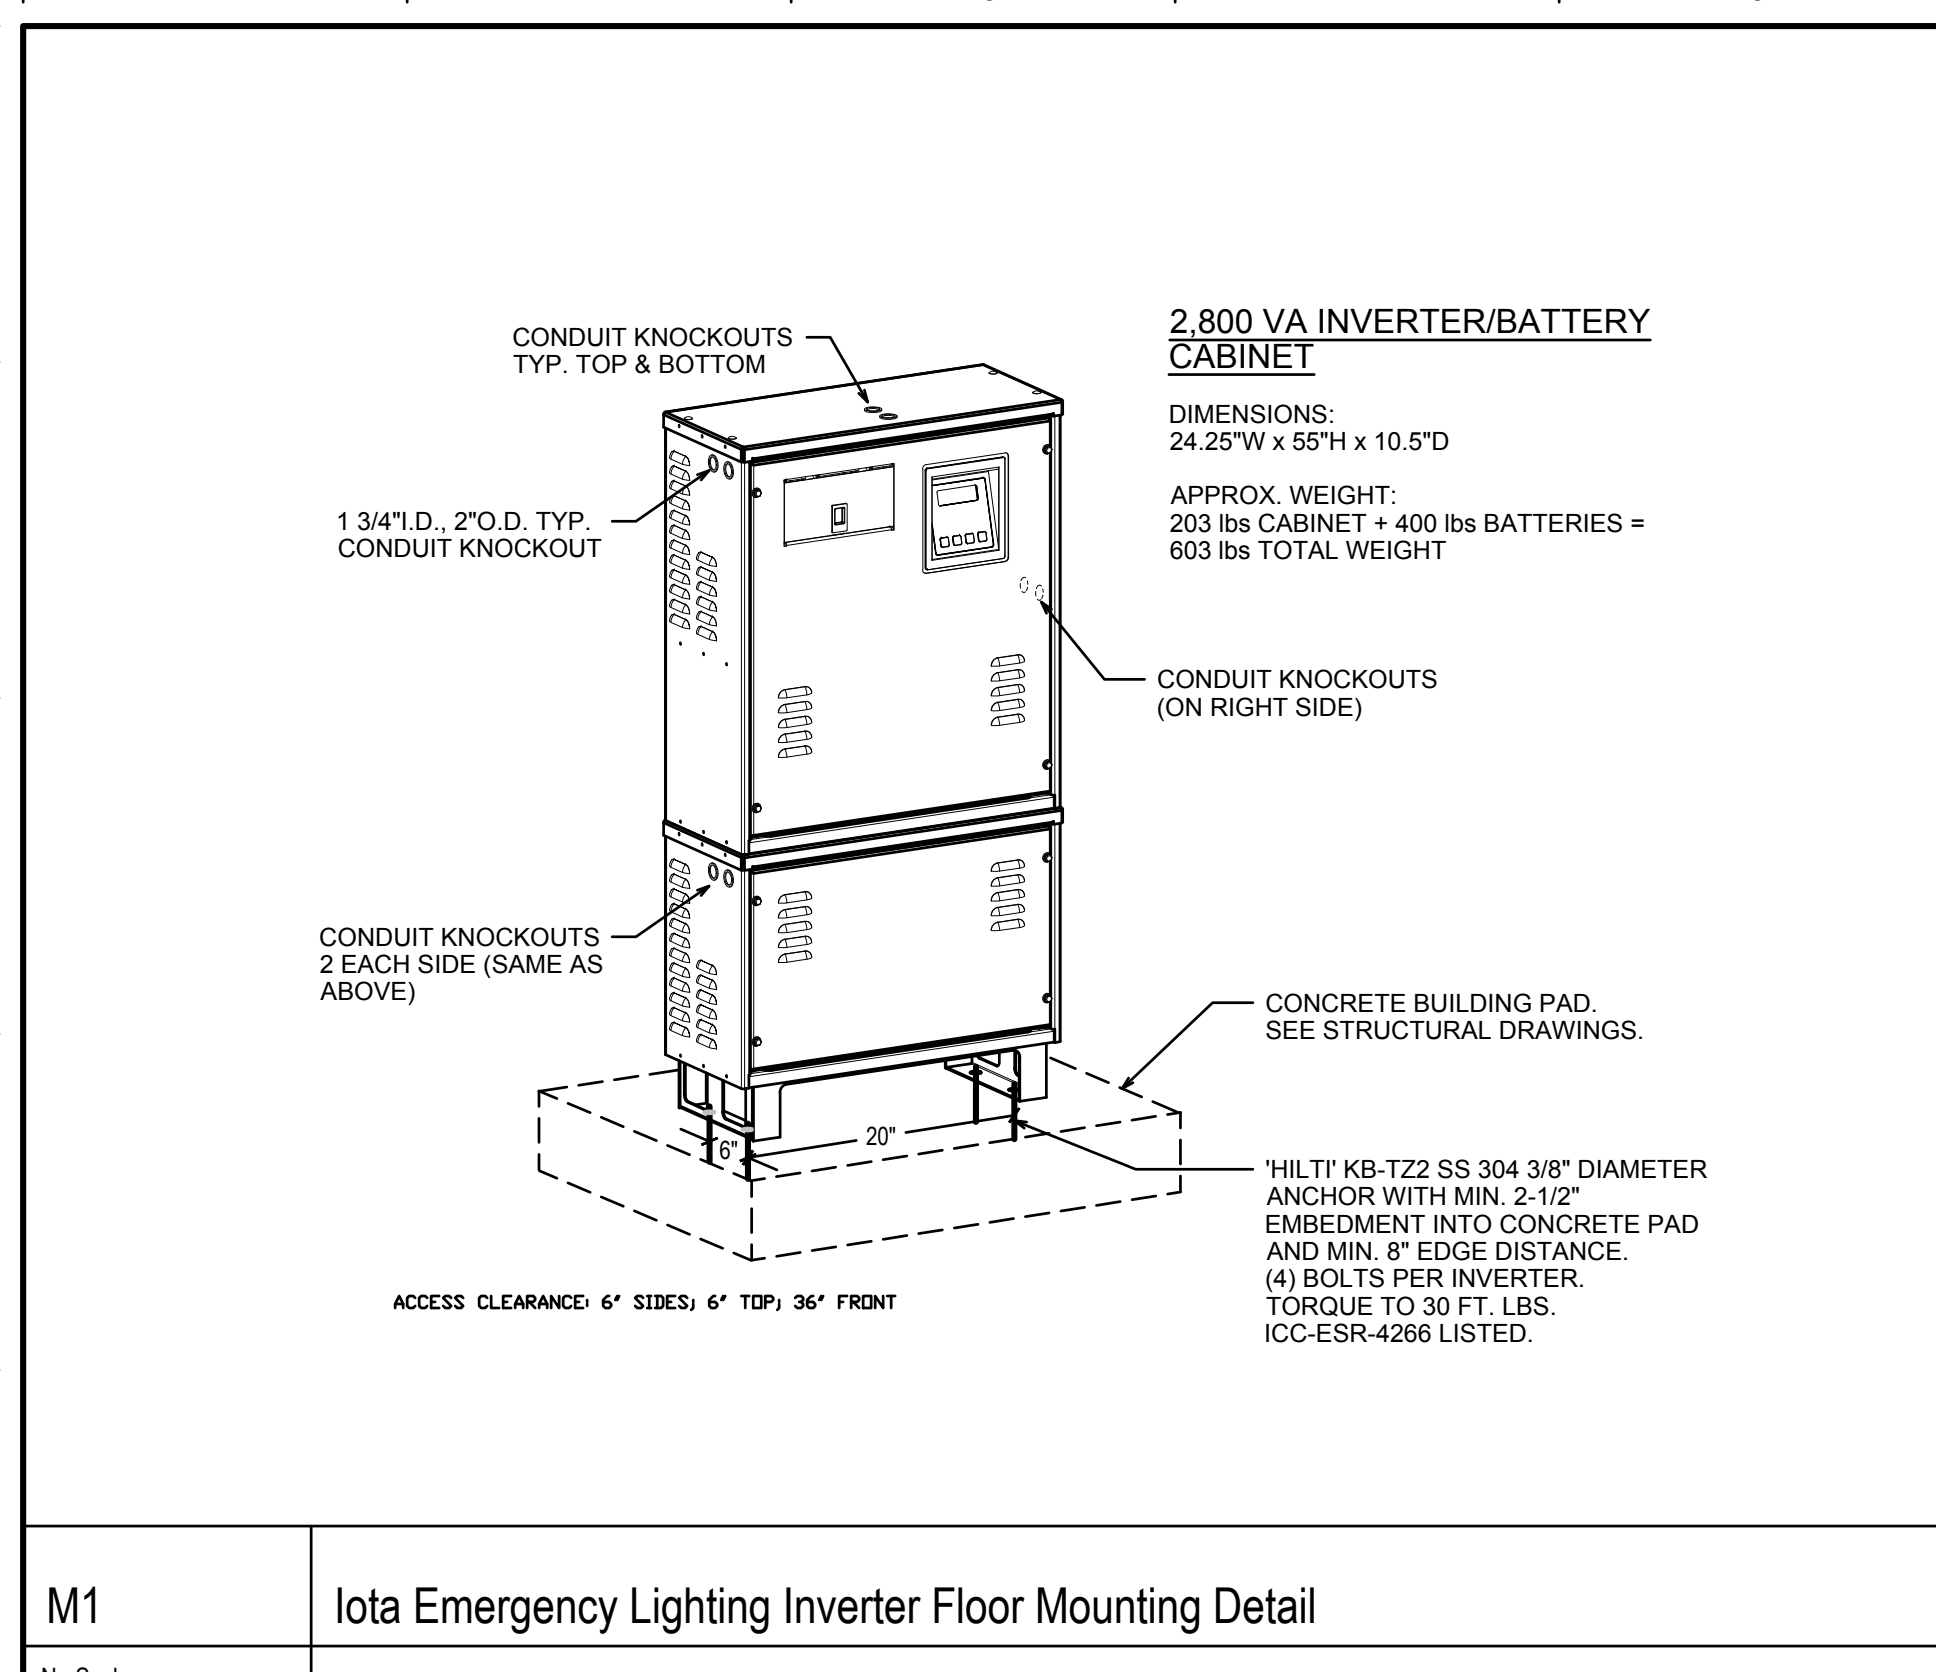


M1 Iota Emergency Lighting Inverter Floor Mounting Detail

No Scale

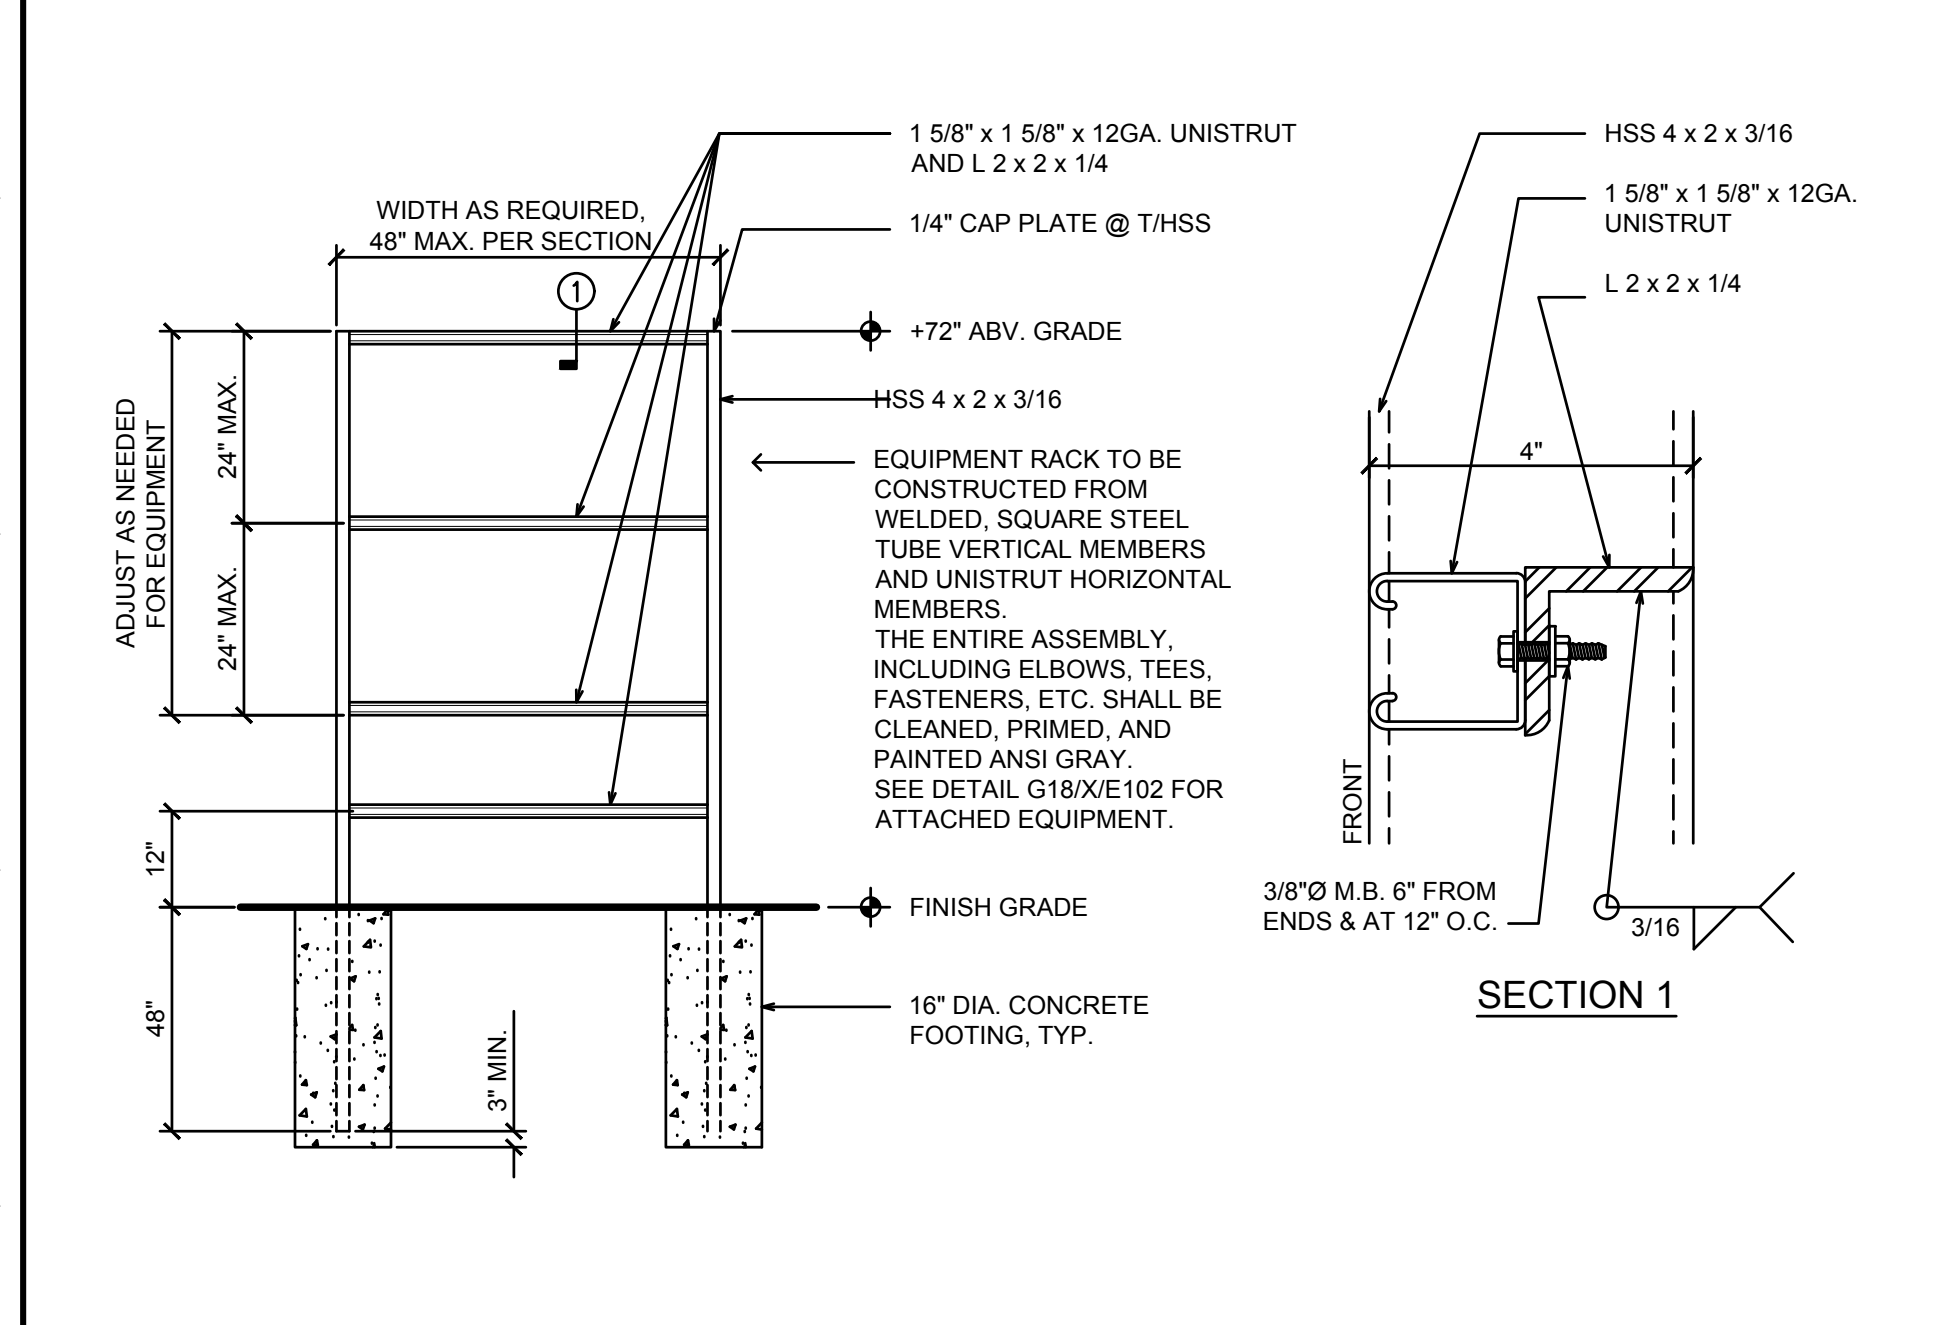

G1 Free Standing Equipment Pedestal Detail

No Scale

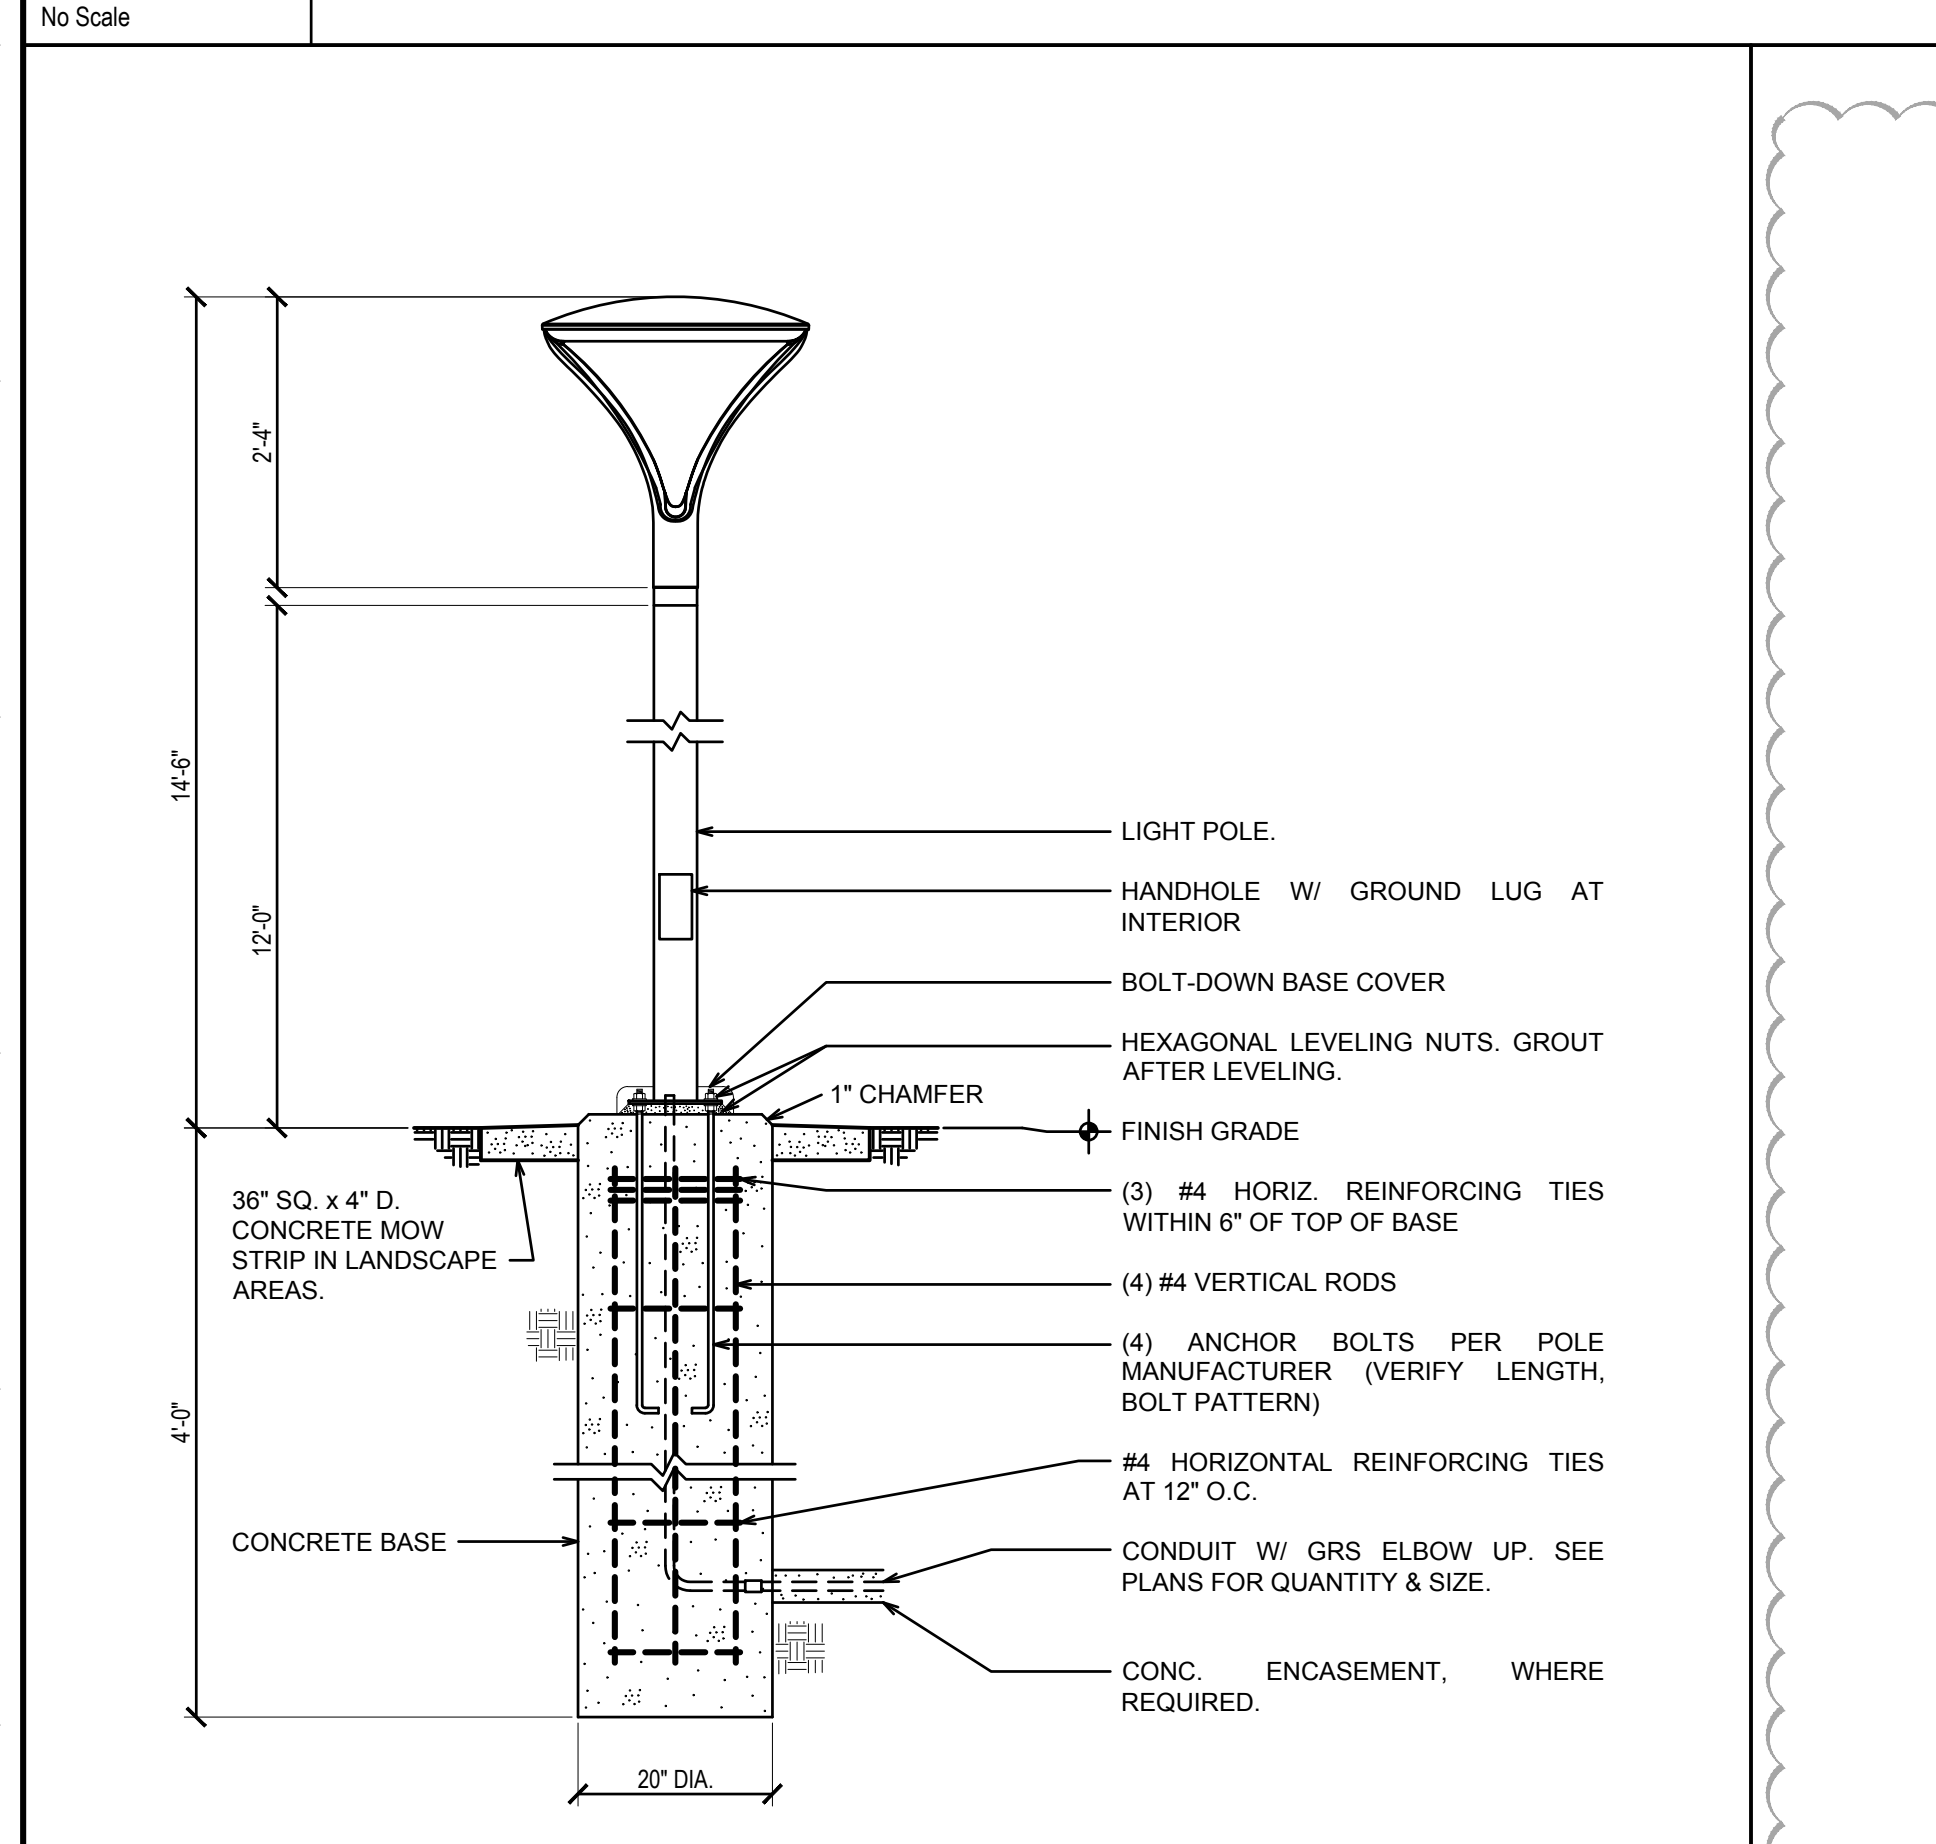

A1 Pedestrian Area Pole Light Concrete Base Detail


(NOT PART OF THIS APPROVAL PER IR A-22 SECTION 2)

No Scale

TYPE OF SPACE	MANUAL ON/OFF SWITCH	AUTOMATIC DAYLIGHT DIMMING WHEN AVAILABLE	OCCUPANCY SENSOR ON 10/70%	OCCUPANCY SENSOR SENSITIVE TO 10MIN. AFTER 10MIN. OCCUPANCY	GATEWAY OPEN HOURS SCHEDULE ON	GATEWAY CLOSED & HOLIDAY HOURS SCHEDULE OFF	GATEWAY SHADOWING SWITCHES DURING OPEN HOURS	COLOR TOUCHSCREEN WITH AT LEAST 4 SCENES	REMOTE CONTROL TOUCHSCREEN WITH AT LEAST 4 SCENES	LEGEND RESPONSE CAPABLE	ASTRONOMIC TIMECLOCK ON/OFF	ASTRONOMIC TIMECLOCK DIMMING	ASTRONOMIC TIMECLOCK AIR RELAYS
ENTRY / LOBBY	X	X	X	X	X	X	X	X	X	X	X	X	X
CORRIDOR	X	X	X	X	X	X	X	X	X	X	X	X	X
OFFICE	X	X	X	X	X	X	X	X	X	X	X	X	X
CLASSROOM	X	X	X	X	X	X	X	X	X	X	X	X	X
CONFERENCE ROOM	X	X	X	X	X	X	X	X	X	X	X	X	X
MULTI-PURPOSE	X	X	X	X	X	X	X	X	X	X	X	X	X
GYMNASIUM	X	X	X	X	X	X	X	X	X	X	X	X	X
CAFETERIA	X	X	X	X	X	X	X	X	X	X	X	X	X
KITCHEN	X	X	X	X	X	X	X	X	X	X	X	X	X
KITCHENETTES IN OFFICES	X	X	X	X	X	X	X	X	X	X	X	X	X
COPY ROOMS	X	X	X	X	X	X	X	X	X	X	X	X	X
LARGE RESTROOM	X	X	X	X	X	X	X	X	X	X	X	X	X
STAIRWELLS	X	X	X	X	X	X	X	X	X	X	X	X	X
STORAGE <100 S.F.	X	X	X	X	X	X	X	X	X	X	X	X	X
ELECTRICAL ROOM	X	X	X	X	X	X	X	X	X	X	X	X	X
OTHER	X	X	X	X	X	X	X	X	X	X	X	X	X
BUILDING >10,000 S.F.	X	X	X	X	X	X	X	X	X	X	X	X	X
BUILDING EXTERIOR	X	X	X	X	X	X	X	X	X	X	X	X	X
PEDESTRIAN WALKS	X	X	X	X	X	X	X	X	X	X	X	X	X
PARKING LOT	X	X	X	X	X	X	X	X	X	X	X	X	X

L6 Lighting Control Matrix

No Scale

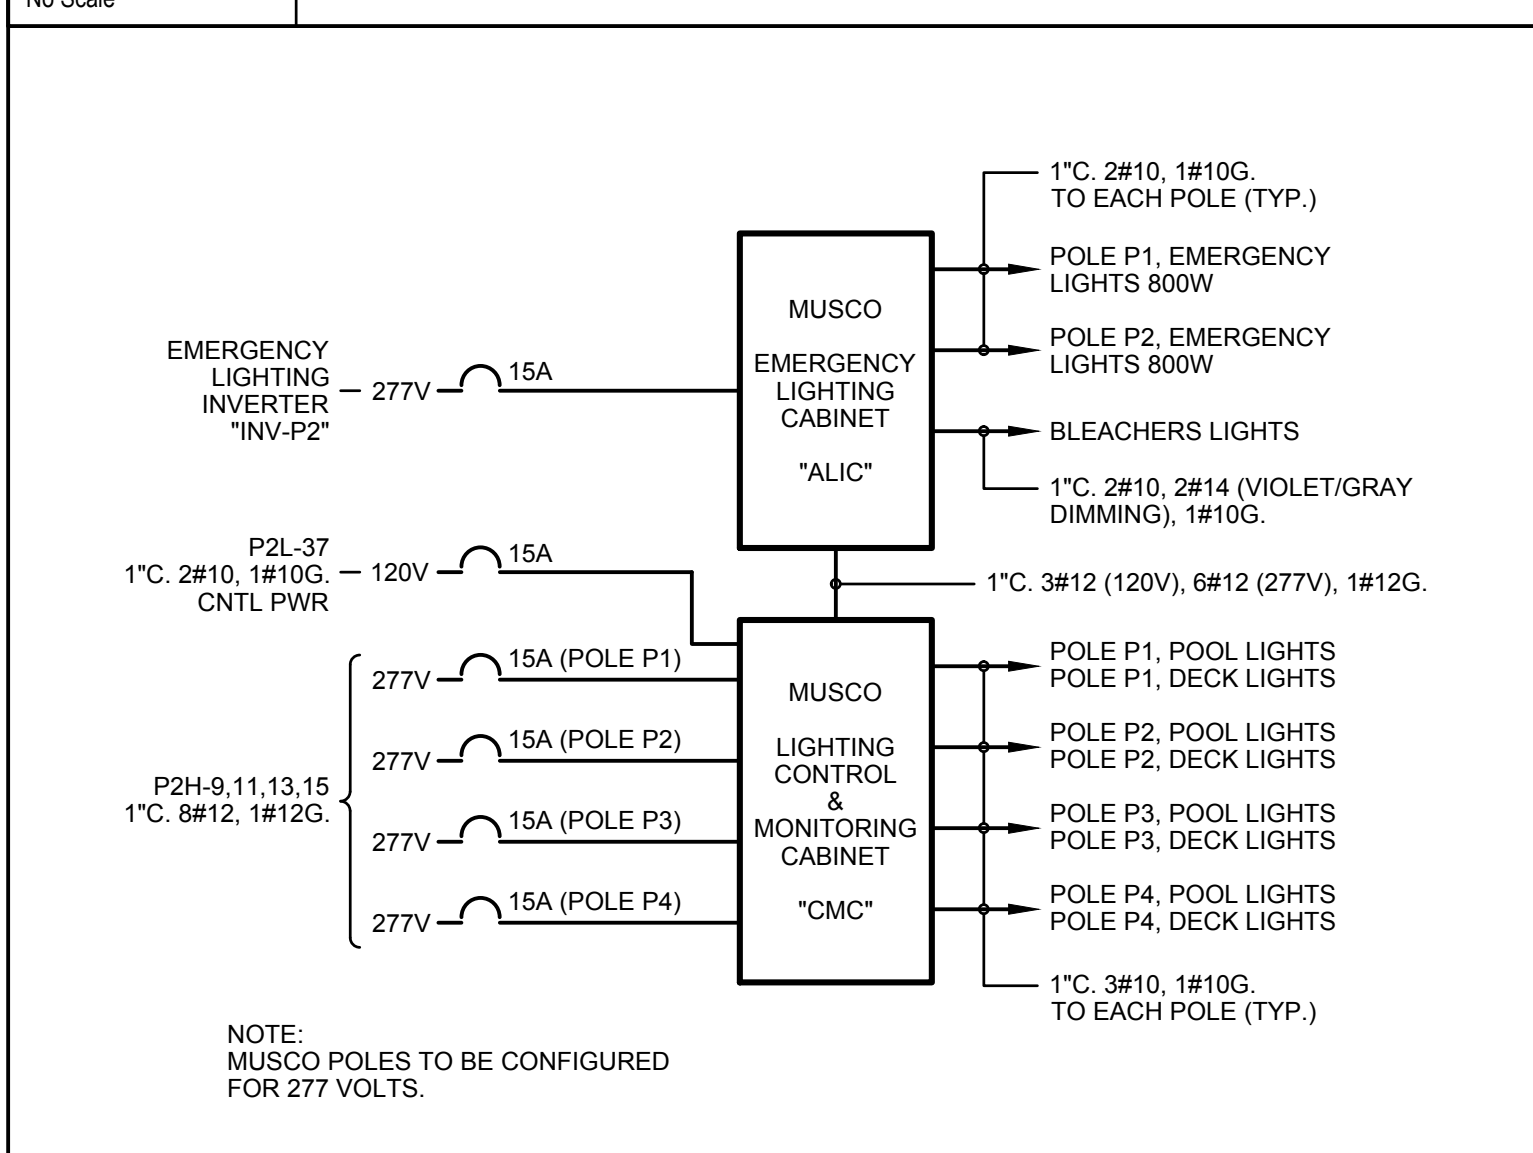


G6 MUSCO Control & Monitoring Cabinet Connections Diagram

No Scale

TYPE	MANUFACTURER	CATALOG NO.	LAMPING	WATTS	VOLTS	MOUNTING	DETAIL	REMARK
A4	PRUDENTIAL	BPR03 REC FLSH LED35-90 SO 4' TMW SAL LP SC UNV X3 DM01	LED	31.2	120-277V	FLUSH	MFG'R	
A12	PRUDENTIAL	BPR03 REC FLSH LED35-90 SO 12' TMW SAL LP SC UNV X3 DM01	LED	93.6	120-277V	FLUSH	MFG'R	
A12E	PRUDENTIAL	BPR03 REC FLSH LED35-90 SO 12' TMW SAL LP SC UNV X3 DM01 EMC	LED	93.6	120-277V	FLUSH	MFG'R	SECTION SHOWN ON PLANS CONNECTED TO EM INVERTER
A20E	PRUDENTIAL	BPR03 REC FLSH LED35-90 SO 20' TMW SAL LP SC UNV X3 DM01 EMC	LED	156.0	120-277V	FLUSH	MFG'R	SECTION SHOWN ON PLANS CONNECTED TO EM INVERTER
AP4	PRUDENTIAL	BPR03 REC FLSH LED35-90 SO 4' TMW WWF LP SC UNV X3 DM01	LED	31.2	120-277V	FLUSH	MFG'R	
AP8	PRUDENTIAL	BPR03 REC FLSH LED35-90 SO 8' TMW WWF LP SC UNV X3 DM01	LED	62.4	120-277V	FLUSH	MFG'R	
AP12	PRUDENTIAL	BPR03 REC FLSH LED35-90 SO 12' TMW WWF LP SC UNV X3 DM01	LED	93.6	120-277V	FLUSH	MFG'R	
AP16E	PRUDENTIAL	BPR03 REC FLSH LED35-90 SO 16' TMW WWF LP SC UNV X3 DM01 EMC	LED	125.6	120-277V	FLUSH	MFG'R	SECTION SHOWN ON PLANS CONNECTED TO EM INVERTER
C	LUMINAIRE	VPF8 4FT MIN10 50W 35K MVOLT OP WHT	LED	50.0	120-277V	SURFACE	E14/X/E102	
CE	LUMINAIRE	VPF8 4FT MIN10 50W 35K MVOLT OP WHT	LED	50.0	120-277V	SURFACE	E14/X/E102	SAME AS ABOVE BUT CONNECTED TO EM INVERTER
CEB	LUMINAIRE	VPF8 4FT MIN10 50W 35K MVOLT OP WHT EMB310	LED	50.0	120-277V	SURFACE	E14/X/E102	WITH 90 MINUTE EMERGENCY BATTERY PACK
CS	LUMINAIRE	VPF8 4FT MIN10 50W 35K MVOLT OP WHT OCC	LED	50.0	120-277V	SURFACE	E14/X/E102	INTEGRAL OCC SENSOR
C2	LUMINAIRE	VPF8 2FT MIN10 15W 35K MVOLT OP WHT	LED	15.0	120-277V	SURFACE	N/A	(15 LBS.)
D	GOTHAM	EV06SH 35/25 DFRAMF 5MO MVOLT EX10 90CRI	LED	24.7	120-277V	RECESSED	A14/X/E102	
P1	GOTHAM	EV06VR 40/25 AR LSS MD PCL MVOLT EZ10 90CRI SNKL	LED	24.7	120-277V	RECESSED	A14/X/E102	
P1E	GOTHAM	EV06VR 40/25 AR LSS MD PCL MVOLT EZ10 90CRI SNKL	LED	24.7	120-277V	RECESSED	A14/X/E102	SAME AS ABOVE BUT CONNECTED TO EM INVERTER
P2	LUMINAIRE	FFW1212 MIN10 25W 40K MVOLT OP [COLOR]	LED	25.0	120-277V	WALL	A10/X/E102	(12 LBS.)
P2E	LUMINAIRE	FFW1212 MIN10 25W 40K MVOLT OP [COLOR]	LED	25.0	120-277V	WALL	A10/X/E102	SAME AS ABOVE BUT CONNECTED TO EM INVERTER
P3	LUMINAIRE	VPF8 2FT MIN10 15W 35K MVOLT OP [COLOR]	LED	15.0	120-277V	SURFACE	N/A	(15 LBS.)
P4	LUMENPULSE	(2) LOG RO 277 48 27K WWLFP UMP SJ DIM CRC ETC & DRIVER	LED	68.0	277	SIGN	N/A	(14 LBS.) INSTALL (2) LUMINAIRES PER SIGN IN CHANNEL. INSTALL (1) DRIVER AT INTERIOR OF EACH SIGN BOX.
P5E	LUMINAIRE	SPC4 N8 12 MIN1 10W 40K MVOLT OP [COLOR]	LED	10.0	120-277V	COLUMN	N/A	(9 LBS.) CONNECTED TO EM INVERTER
T	LITHONIA	RADPT LED P5 40K PATH MVOLT PT4 PIR [COLOR] w/ 12 FT POLE	LED	123.0	120-277V	POLE	A1/X/E102	PEDESTRIAN POLE LIGHT
V	LITHONIA	RADPT LED P5 40K SYM MVOLT PT4 PIR [COLOR] w/ 12 FT POLE	LED	123.0	120-277V	POLE	A1/X/E102	


J10 Light Fixture Schedule

No Scale

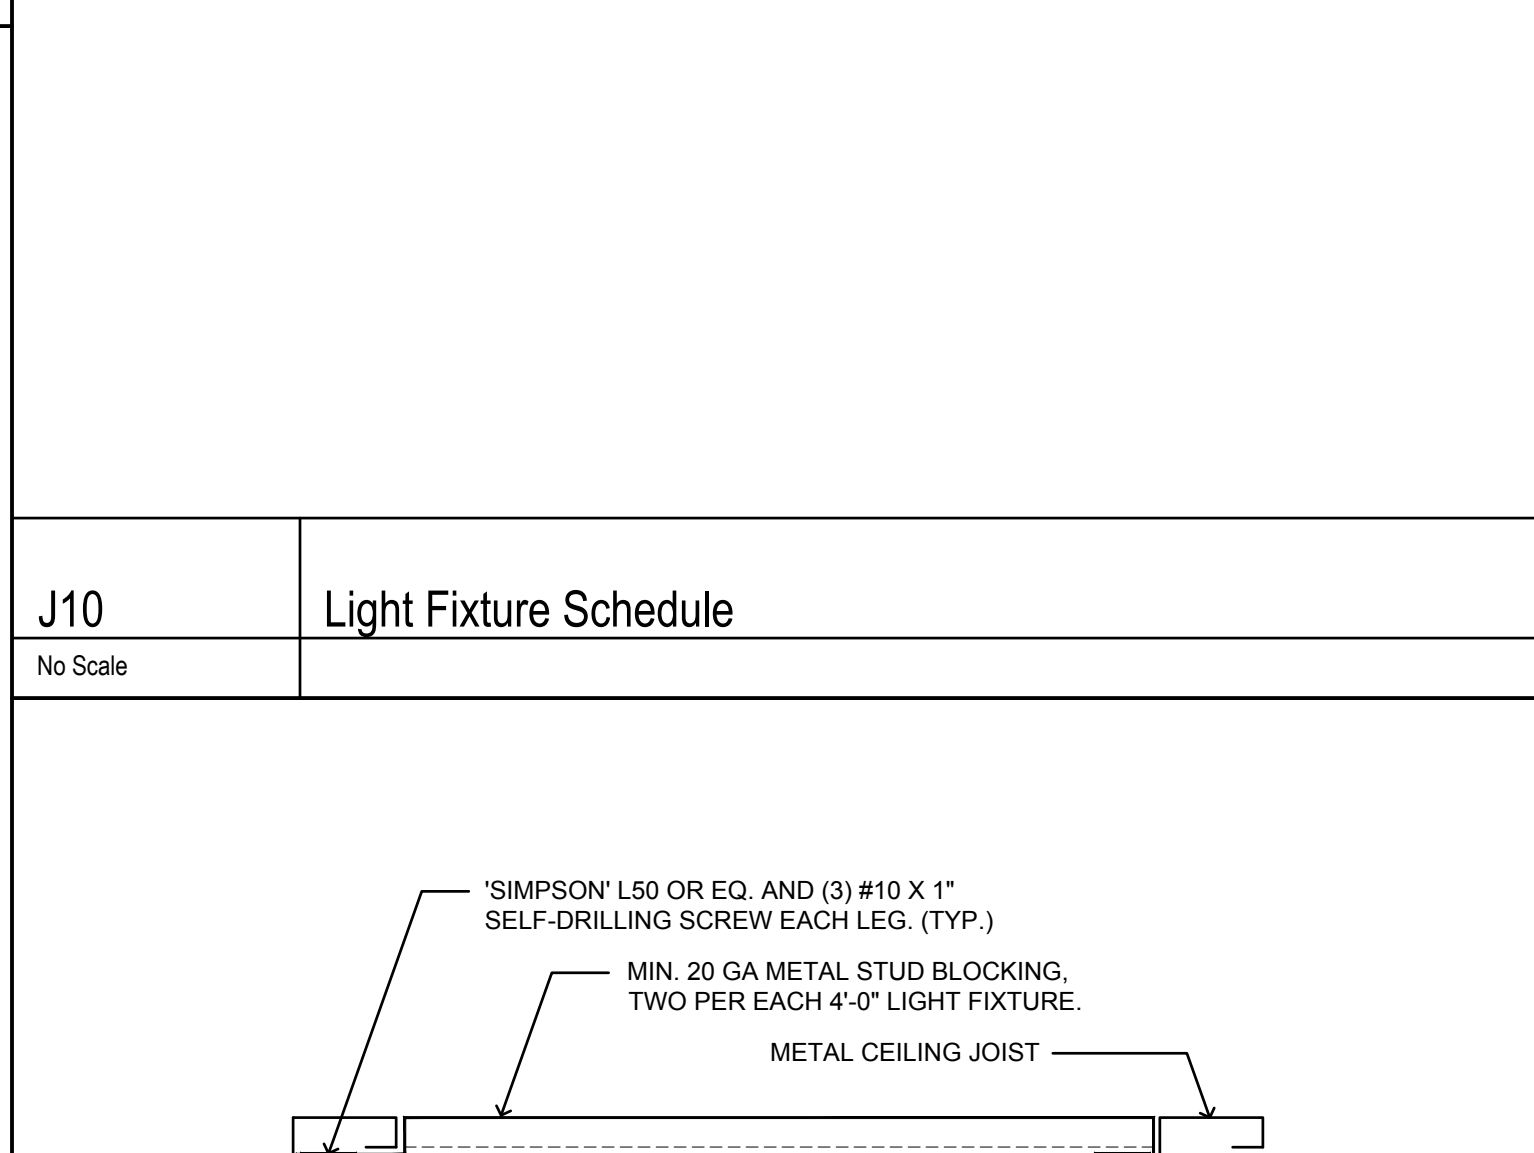


E10 Surface Fixture Surface Mounting Detail

No Scale

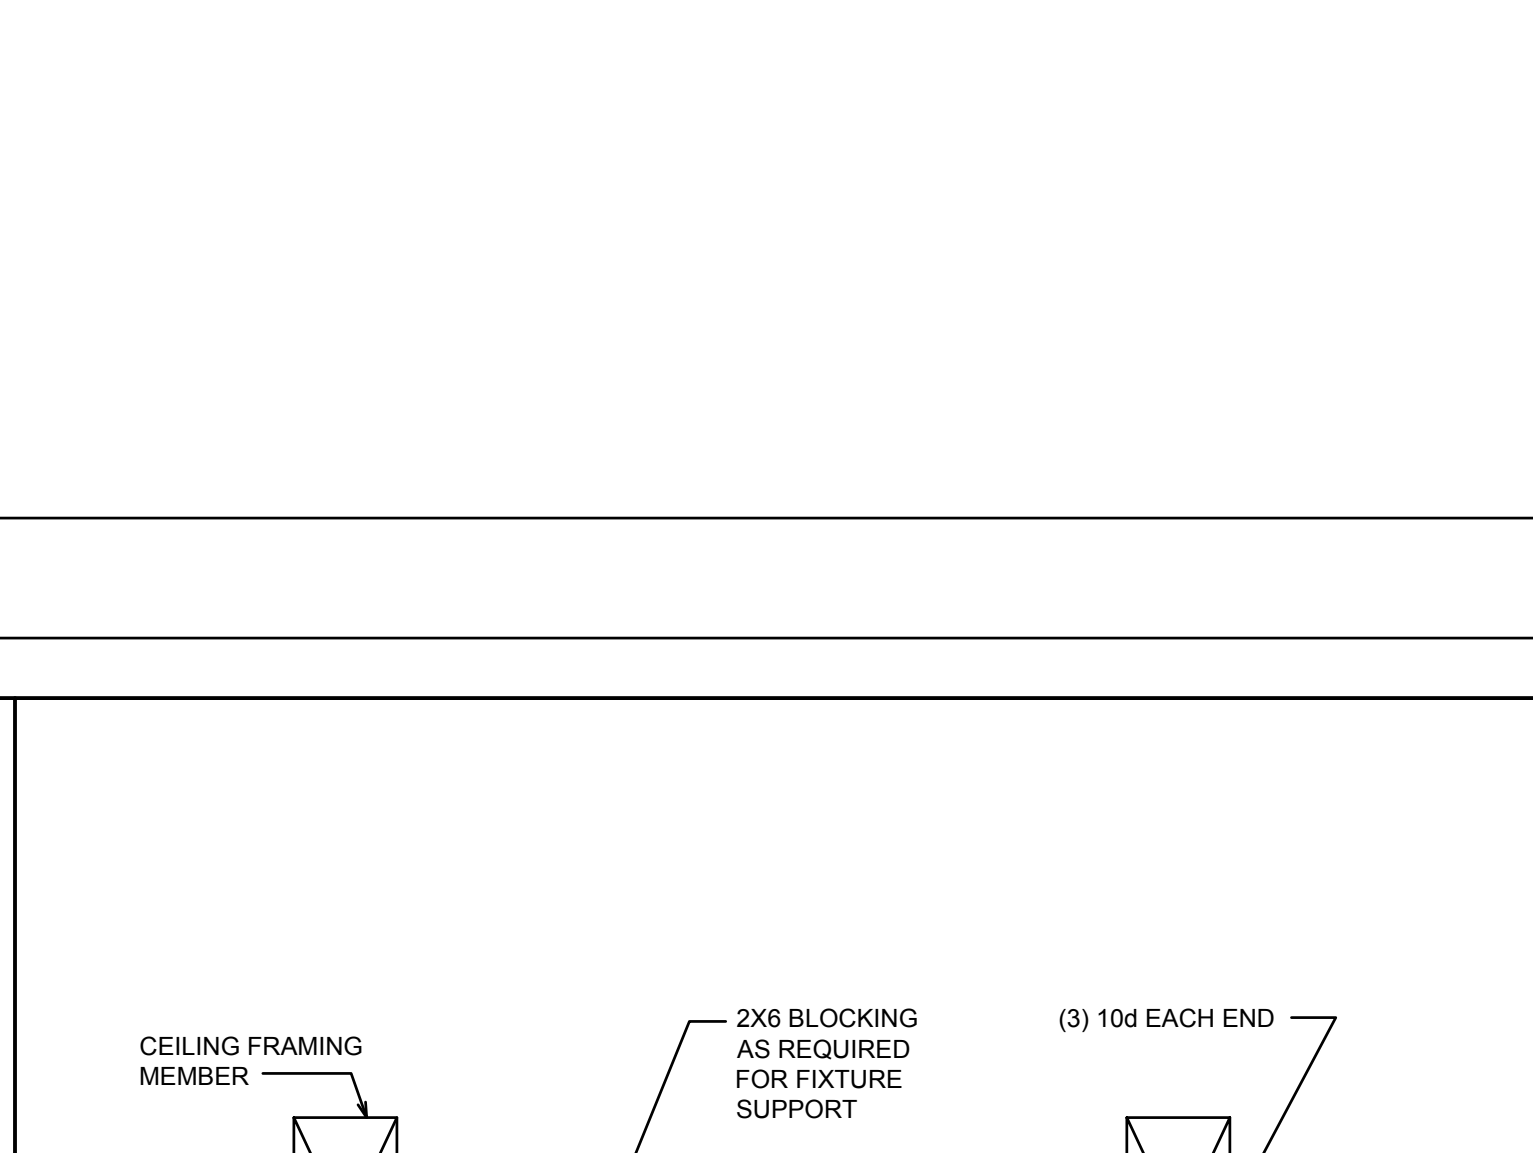


E14 Surface Fixture Surface Mounting Detail

No Scale

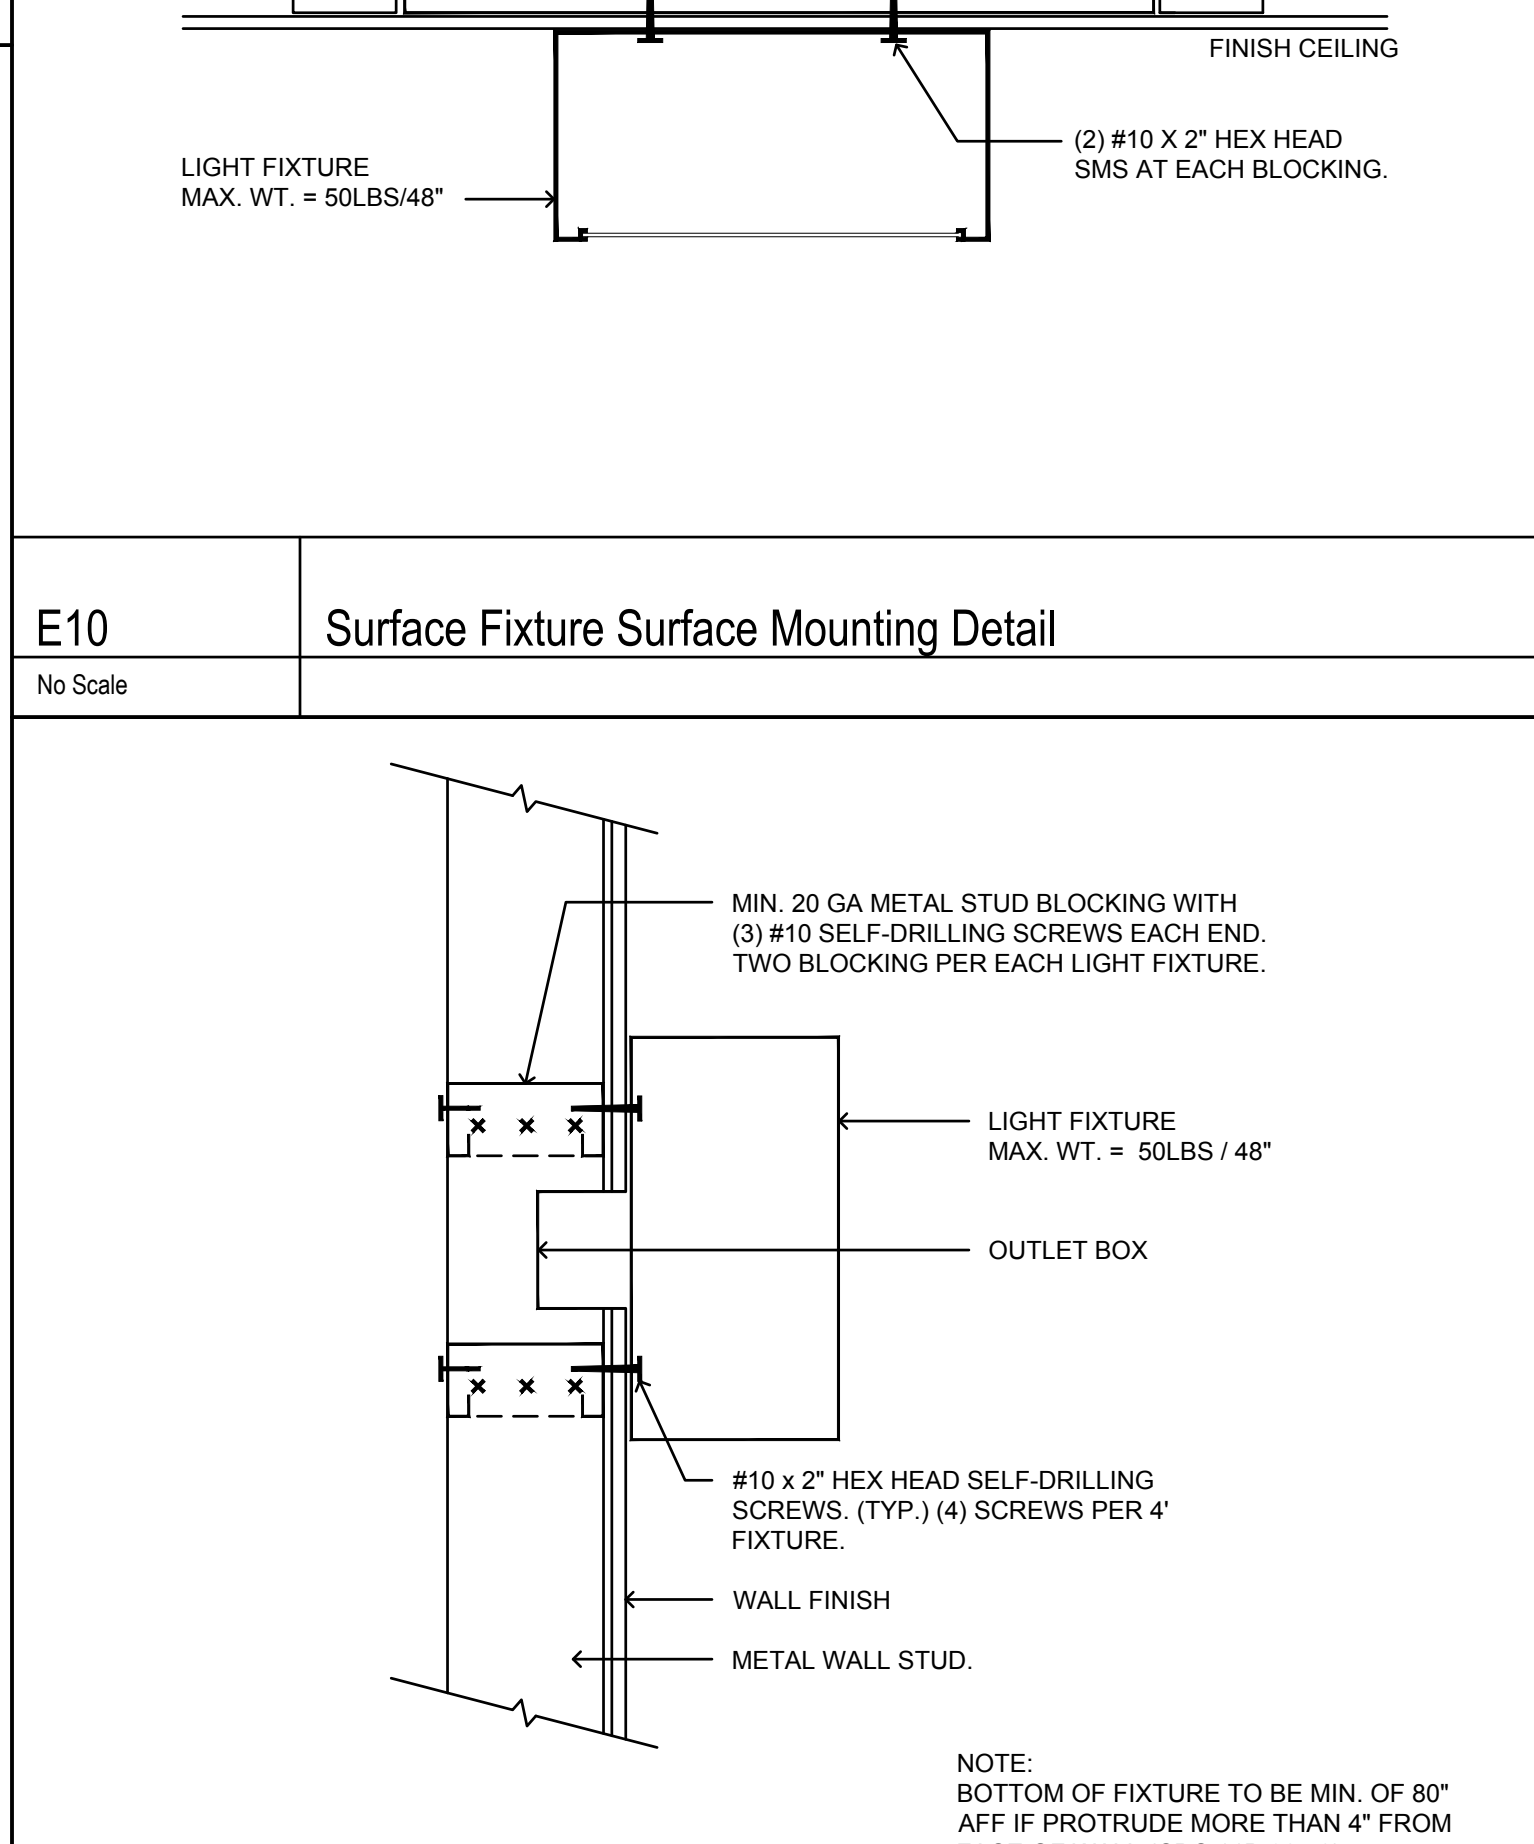

A10 Wall Fixture Surface Mounting Detail

No Scale

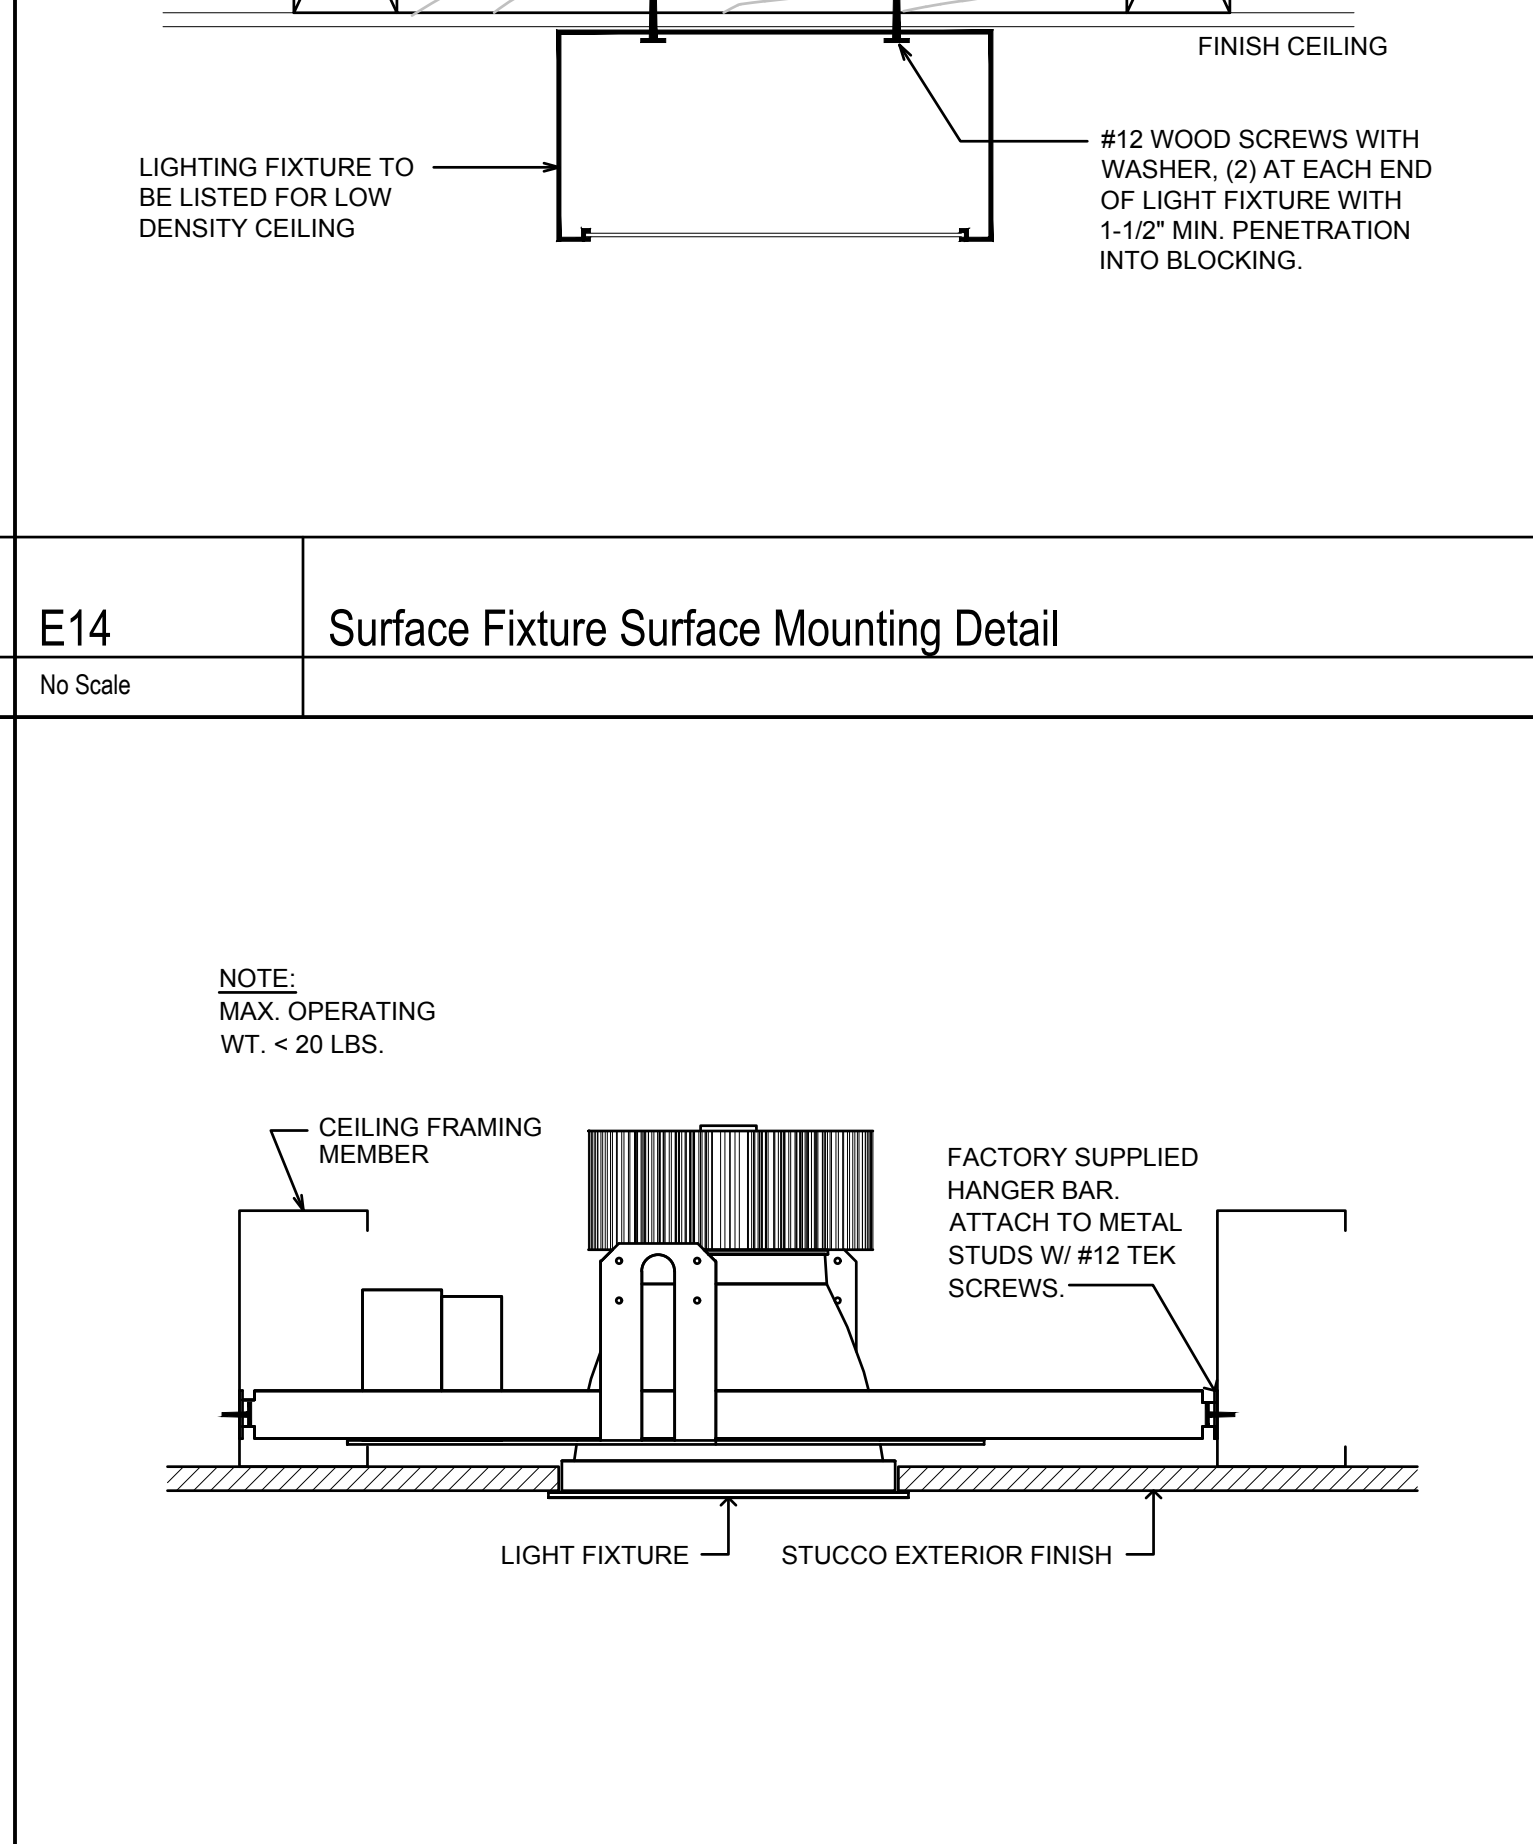

A14 Downlight Fixture Recessed Mounting Detail

No Scale


DSA File No.: 54-H11

DSA Application No.: 02-120251

Agency Approval

G18 Equipment Attachment Detail

No Scale

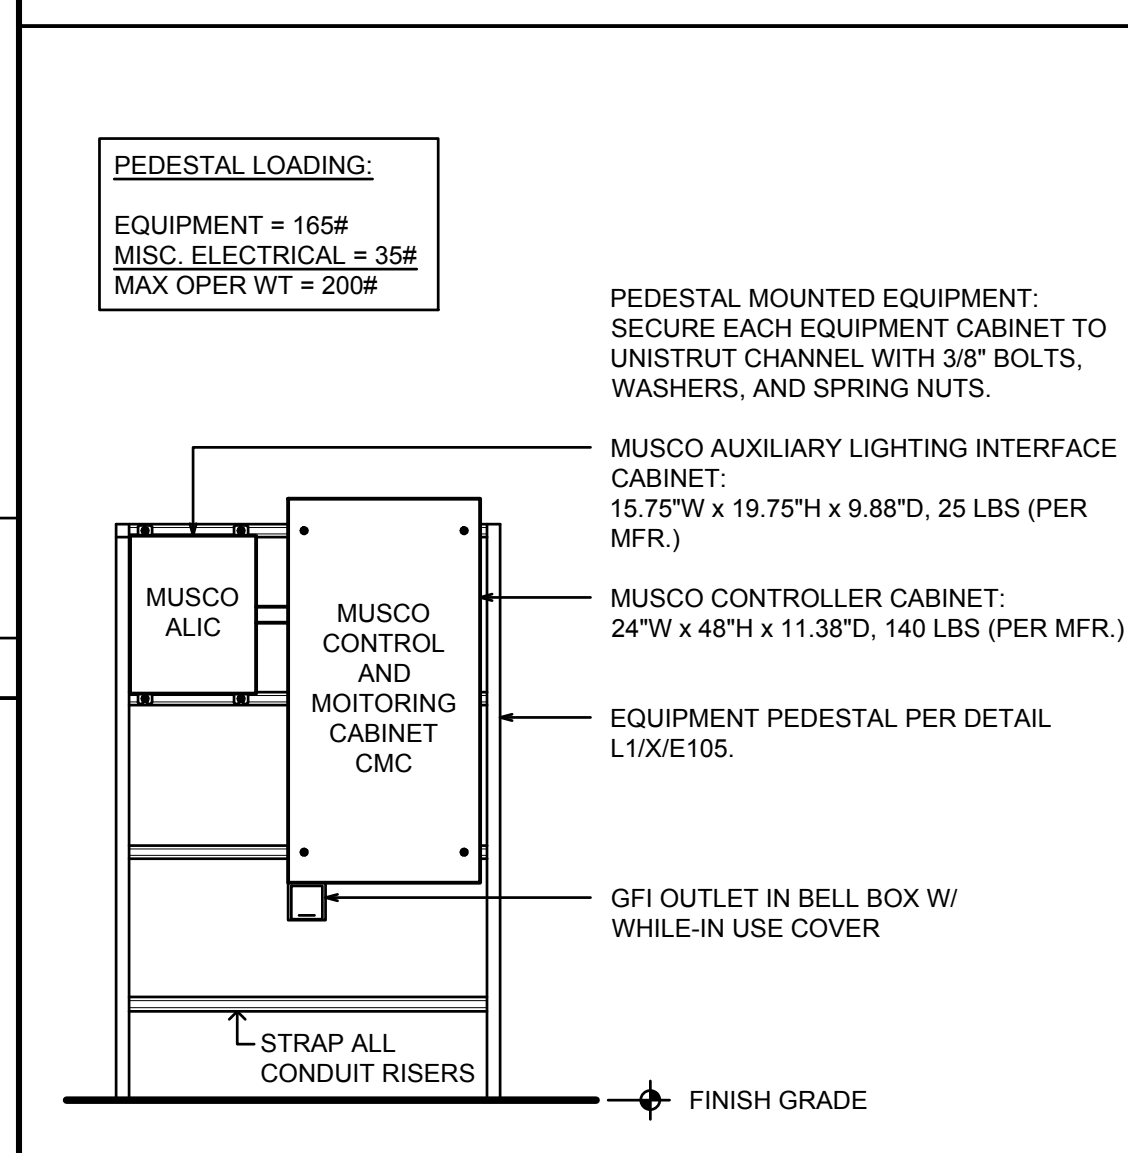

E18 Equipment Attachment Detail

No Scale

Hardin-Davidson Engineering
356 Pollasky Ave., Suite 200, Clovis, CA 93612
559.323.4995 tel • 559.323.4928 fax
www.hardin-davidson.com

Mission Oak HS Aquatic Complex
Tulare Joint Union High School District
Tulare, CA 93274

TYPICAL INFORMATION
LIGHTING SYSTEMS - FIXTURE SCHEDULE AND DETAILS

darden architects
www.dardenarchitects.com
6790 N. West Ave. • Fresno, CA 93711 • T. 559.448.8051

No.	Revision/Submission	Date
1	REVISION_01	05/31/2023

Designed By: SD
Copyright 2022 Darden Architects

Scale: As indicated
Drawn By: HDE
Project Number: 2180
Checked By: SD
Date: 08/02/2022
Reviewed By: SD

X/E102

Sheet: _____ of: _____


8/16/2023 4:24:07 PM Z:\Clients\Hardin Architects\22068 - Tulare USD Mission Oak HS Aquatic Complex\CAD Files\22068 - 4 Elec_rebld.dwg

8/16/2023 4:24:09 PM Z:\Clients\Darden Architects\22068 - Tulare USD Mission Oak HS Aquatic Complex\CAD Files\22068 - 4 Elec_rebld.dwg







DSA File No.: 54-H11
 DSA Application No.: 02-120251
 Agency Approval

- KEYNOTES**
- MEDIUM VOLTAGE TRANSFORMER AND CONCRETE PAD PER ASX/E103. 63.0"W x 67.0"D x 72.0"H; OPERATING WEIGHT = 5,174 LBS.
 - PANELBOARD, MOUNT PER DETAIL E13X/E103 AT METAL FRAMED WALLS. MOUNT PER G5X/E103 AT CMU WALLS.
 - GROUND PANELBOARD PER G9X/E103. GEC SIZE NOTED ON PLANS.
 - GROUND TRANSFORMER PER A9X/E103. GEC SIZE NOTED ON PLANS.
 - 3x5 CONCRETE VAULT WITH SPRING-ASSIST, BOLT-DOWN STEEL LIDS.
 - 5/8" x 10 FT. CU. CLAD GROUND ROD. BOND ALL STEEL COMPONENTS AT VAULT, INCLUDING THE LIDS, WITH #2 CU.

NOTE:
 ALL PANELBOARDS SHALL BE FULLY RATED FOR THE SHORT CIRCUIT CURRENT RATING LISTED. SERIES RATINGS ARE NOT PERMITTED.

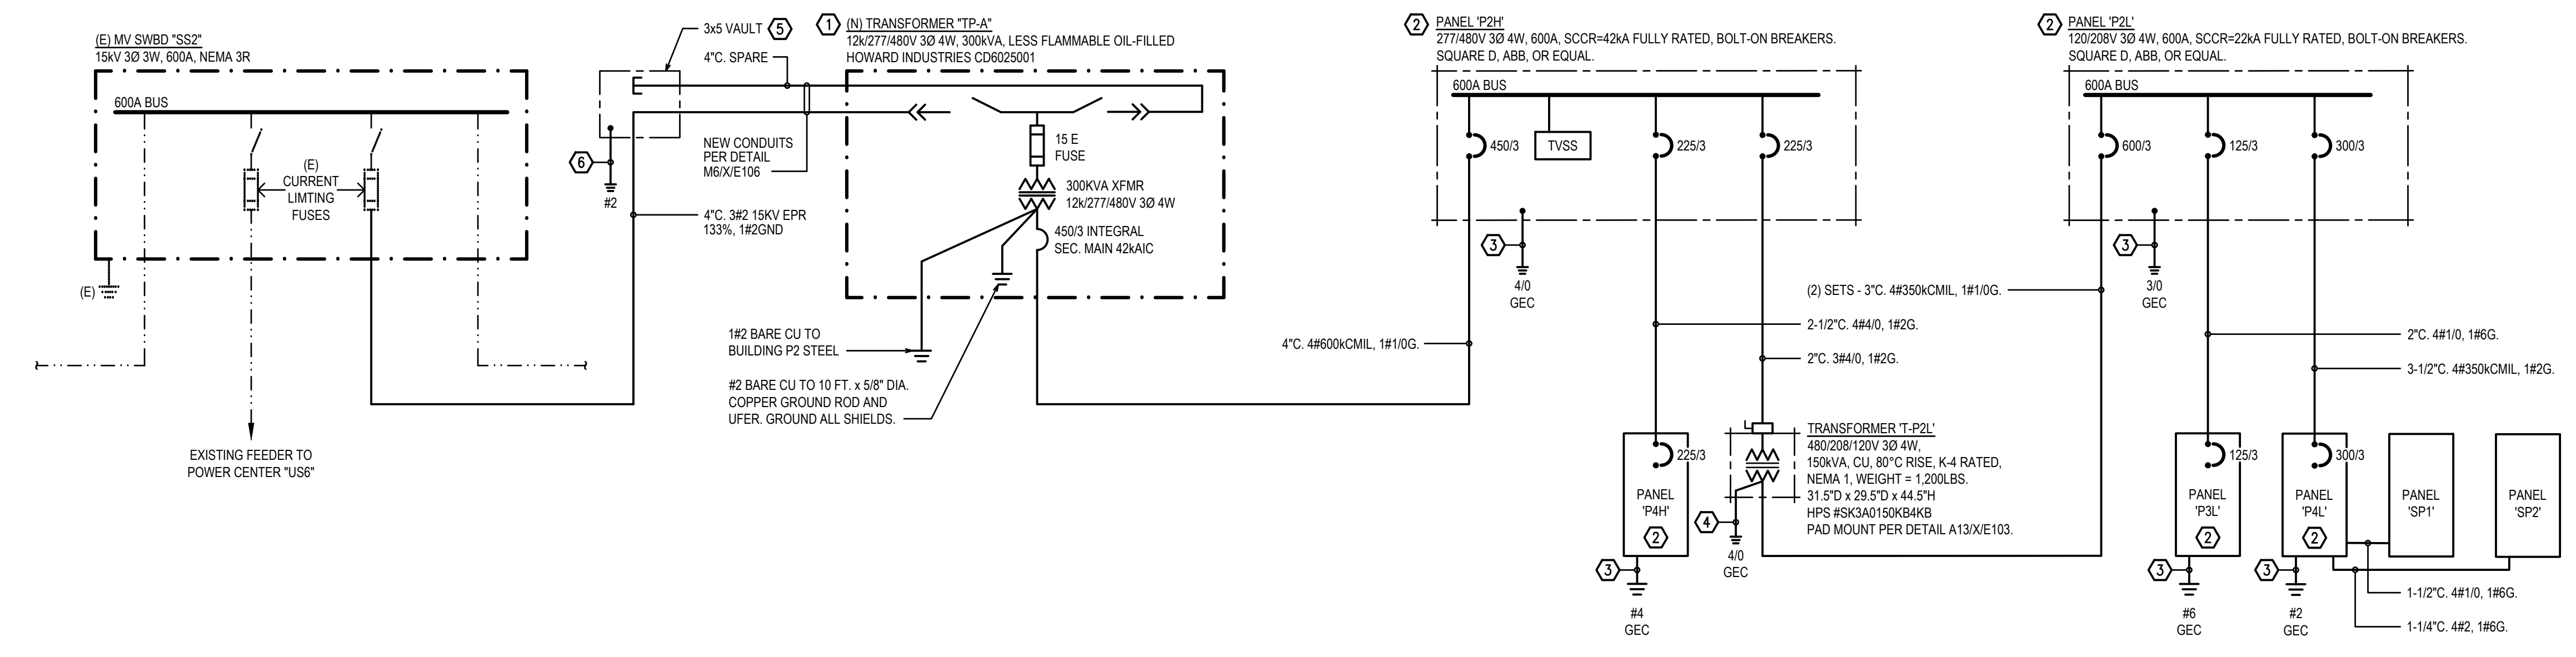

L1 Power Single Line Diagram
 No Scale

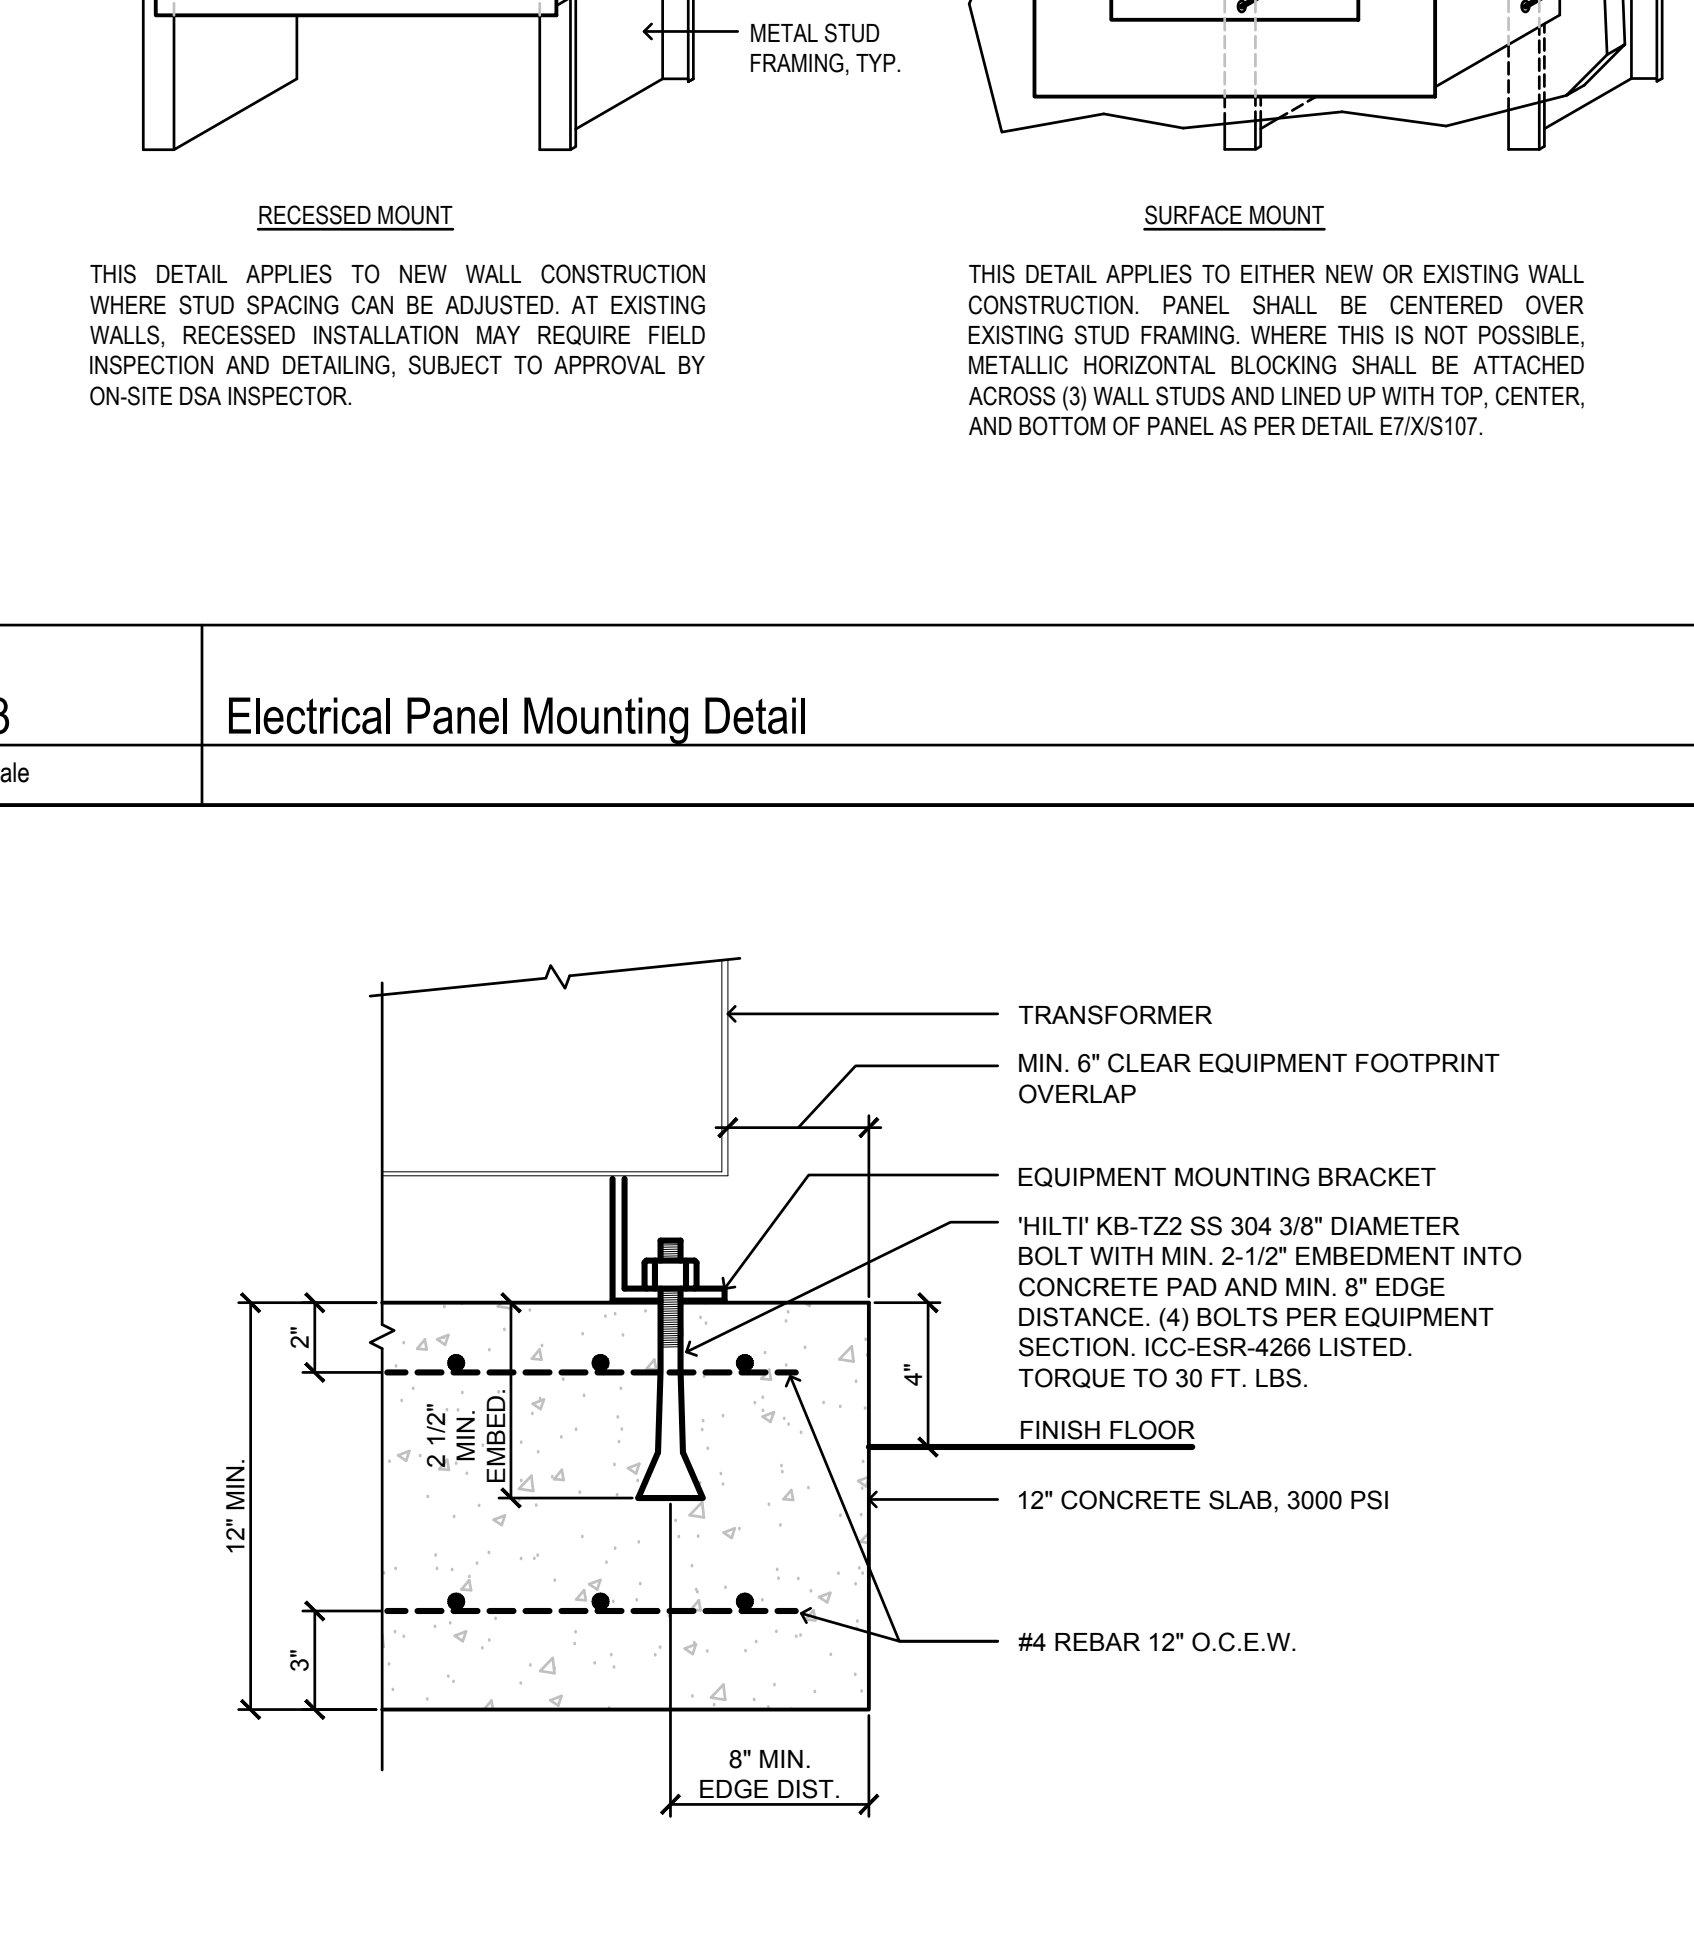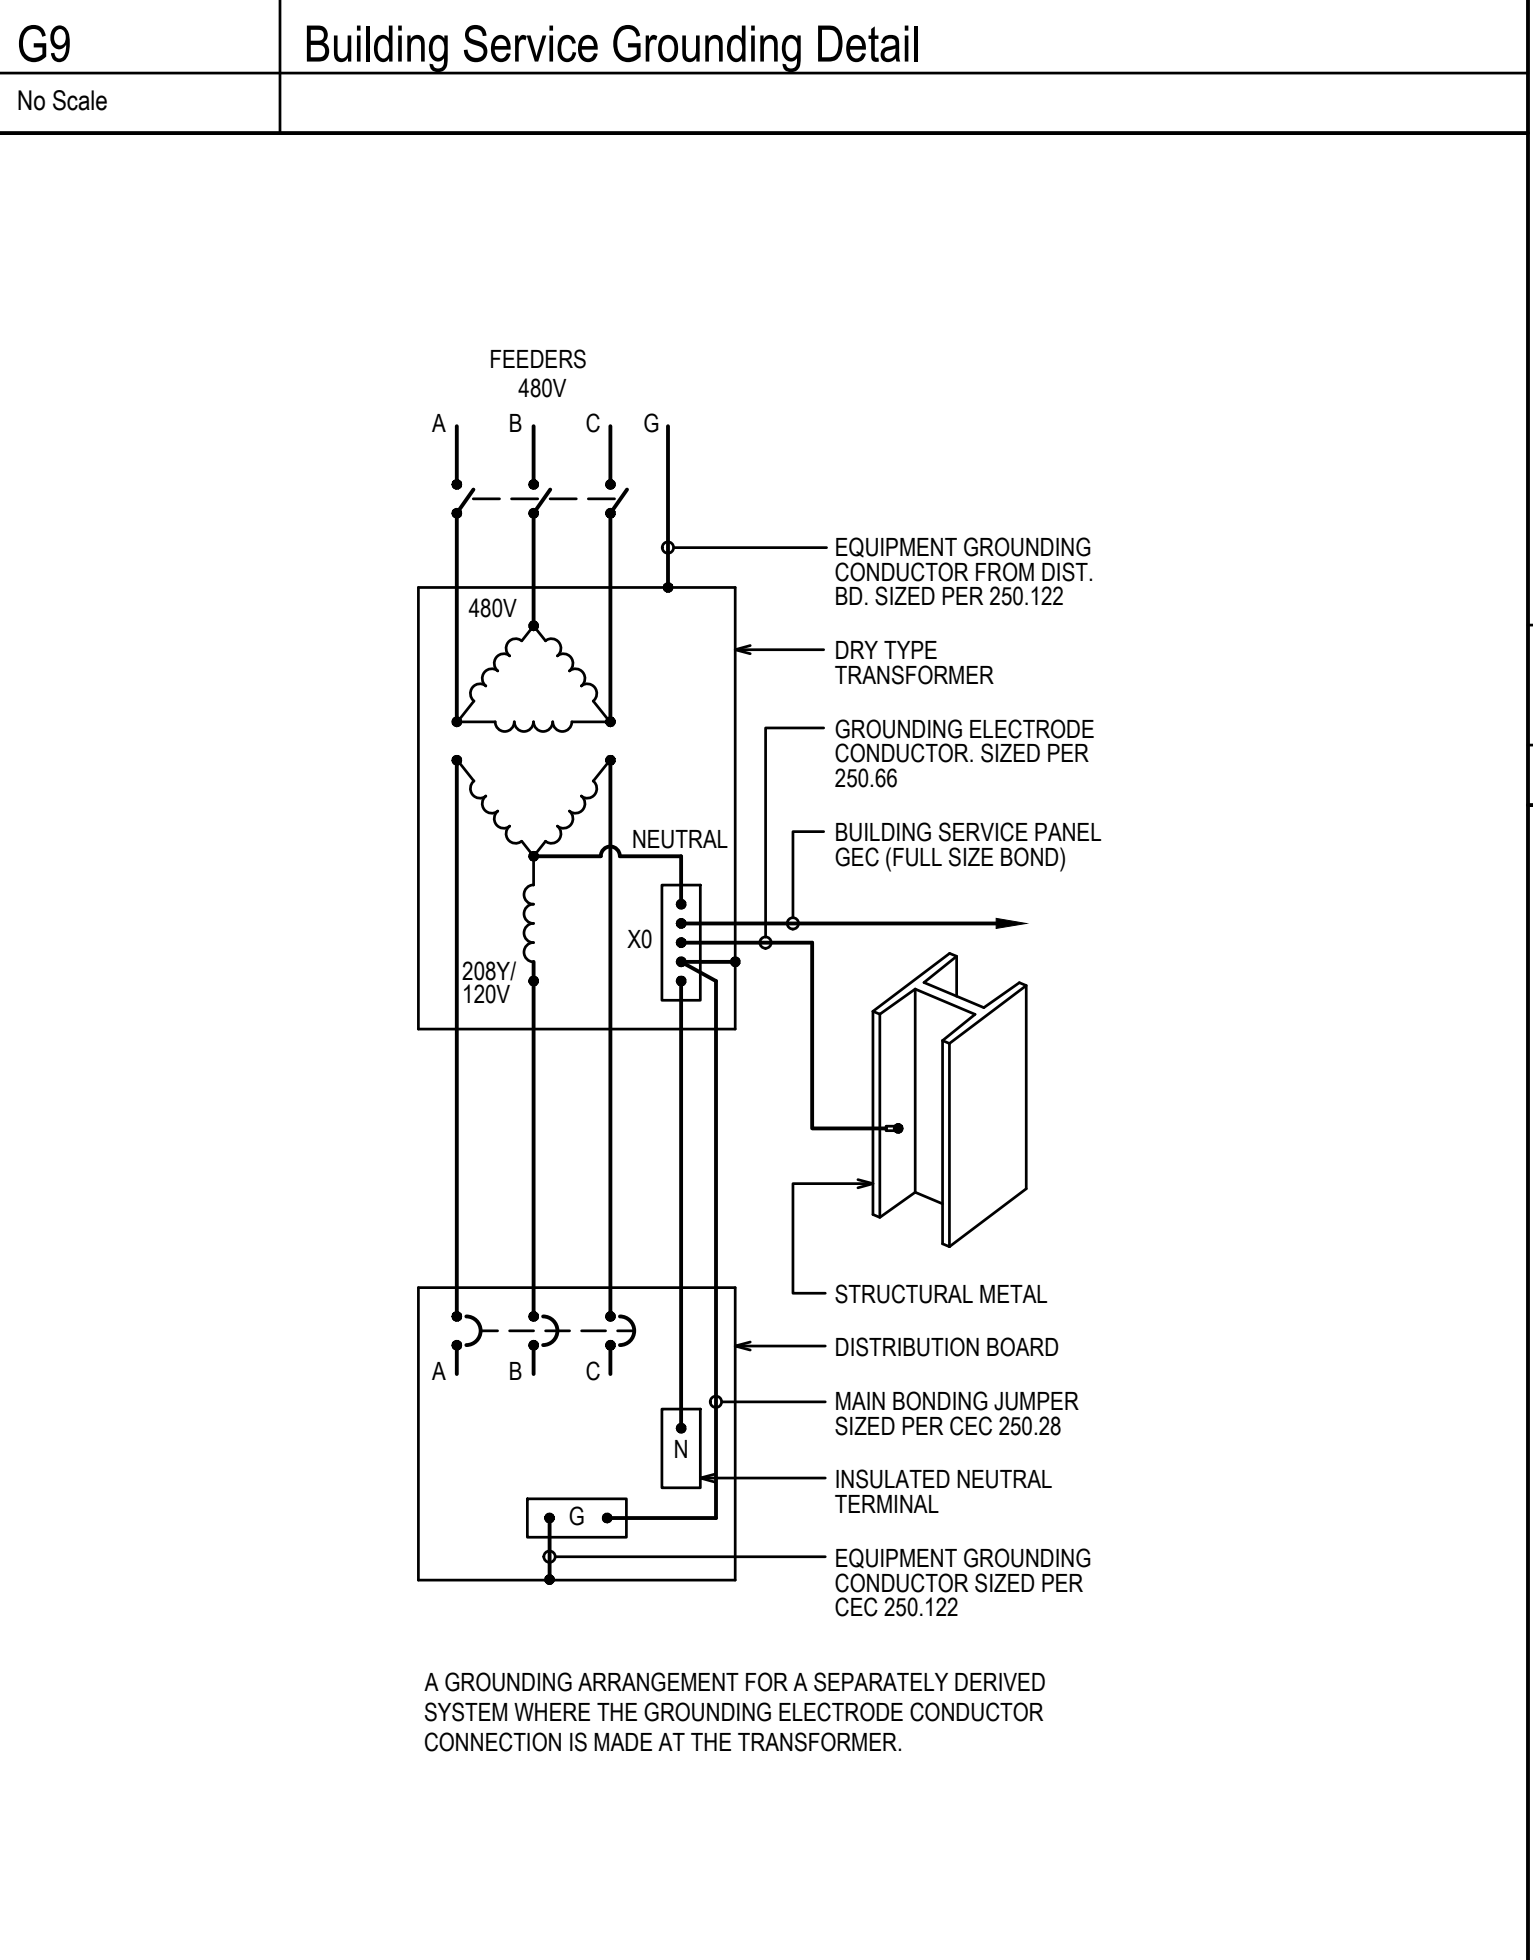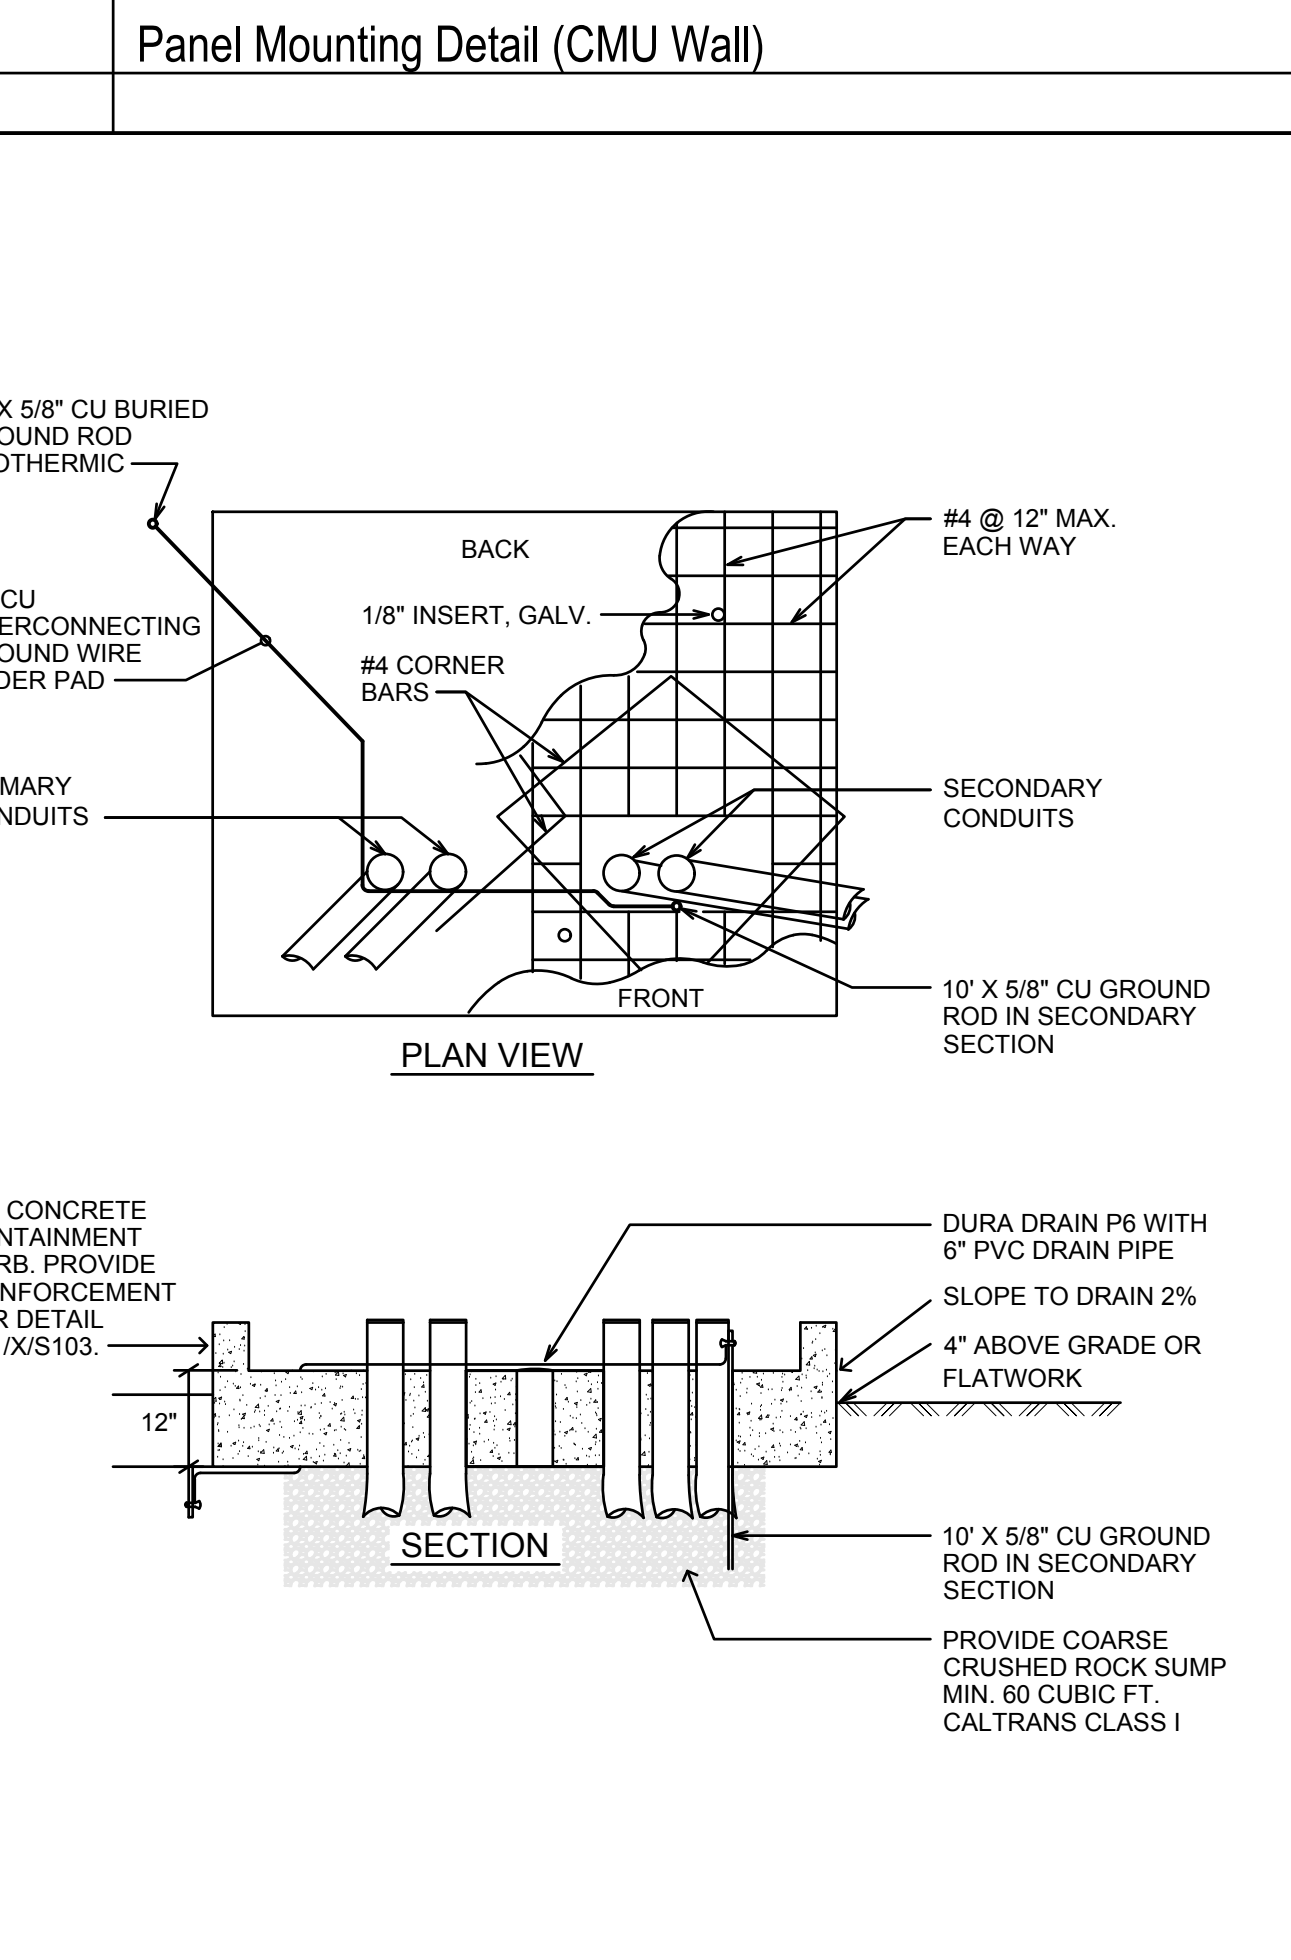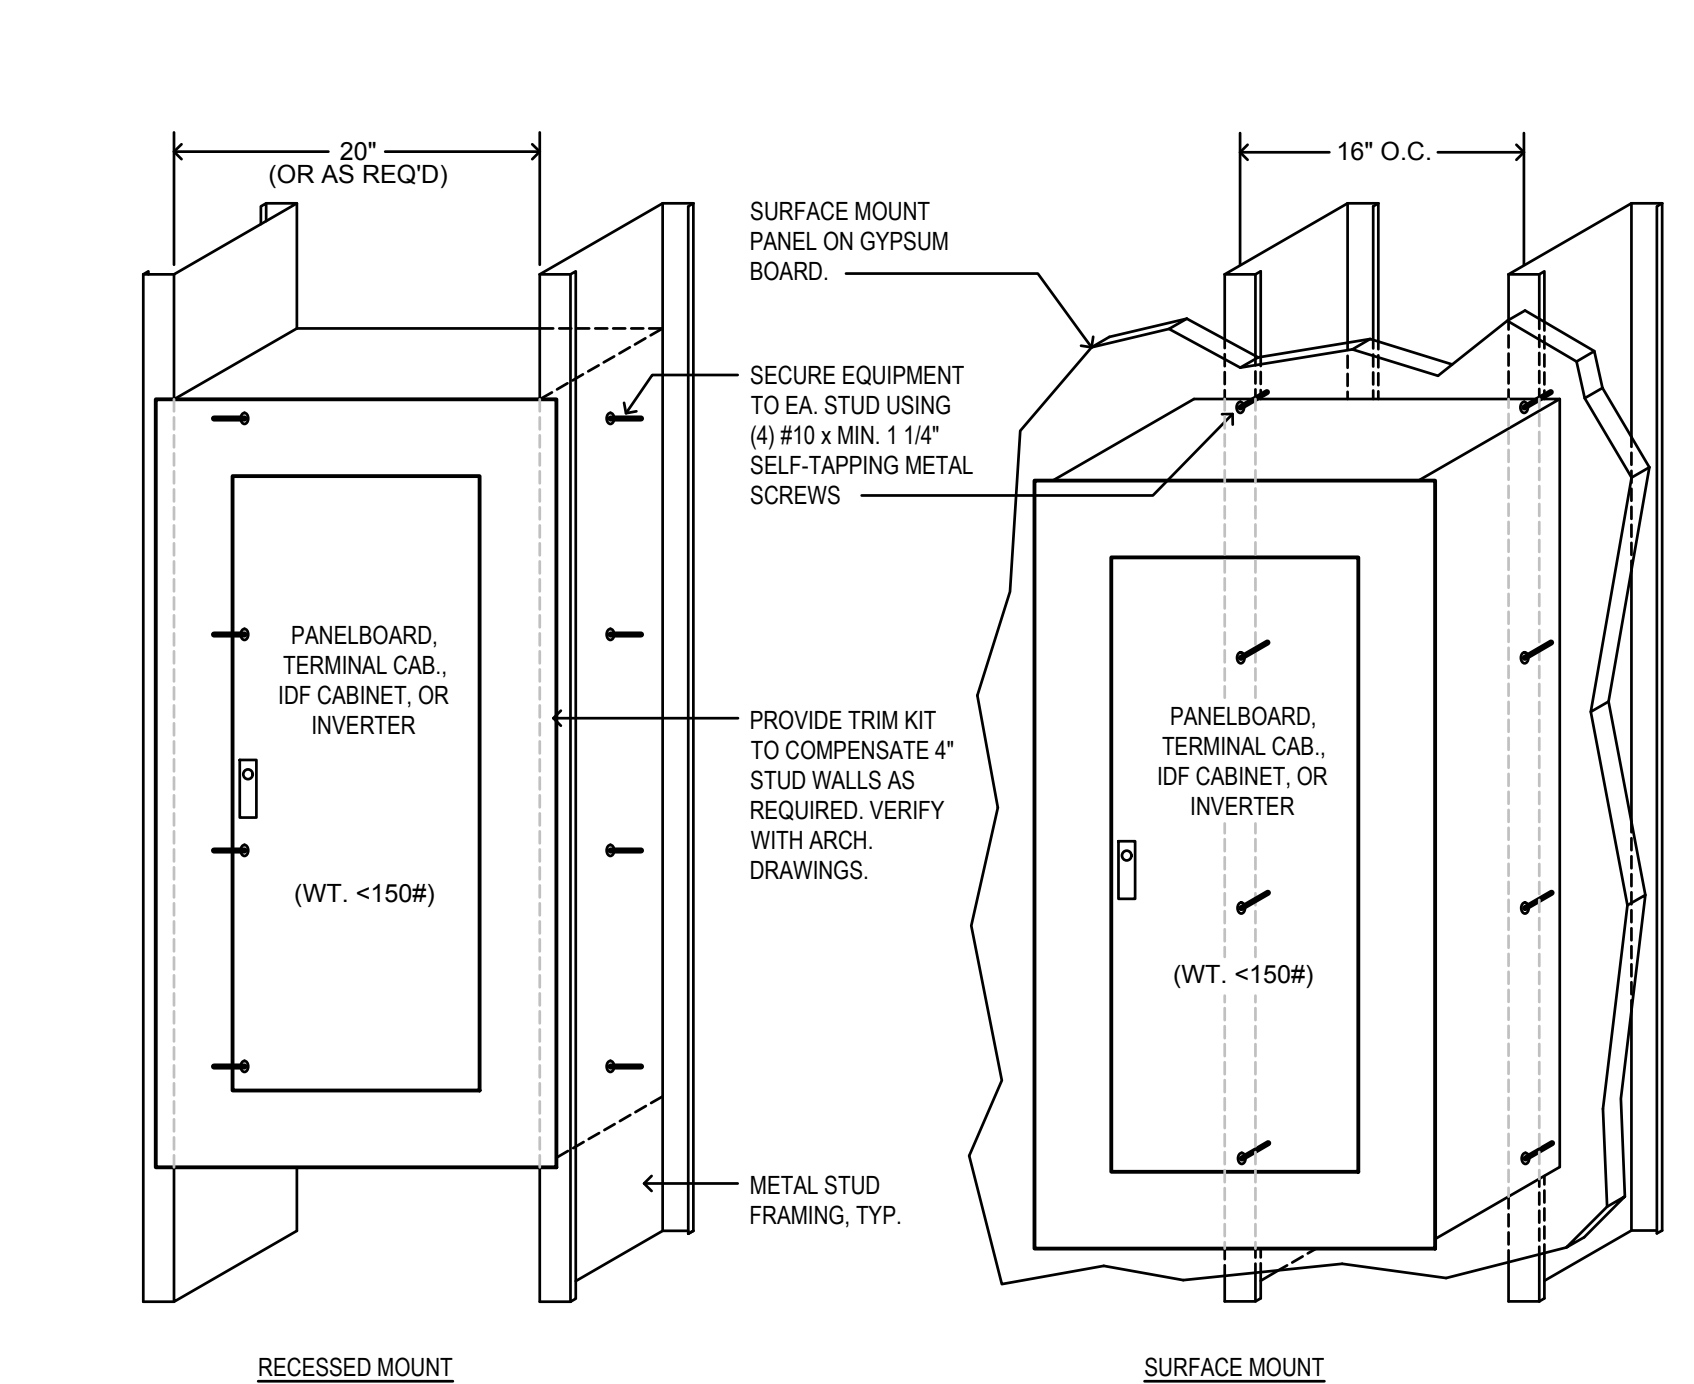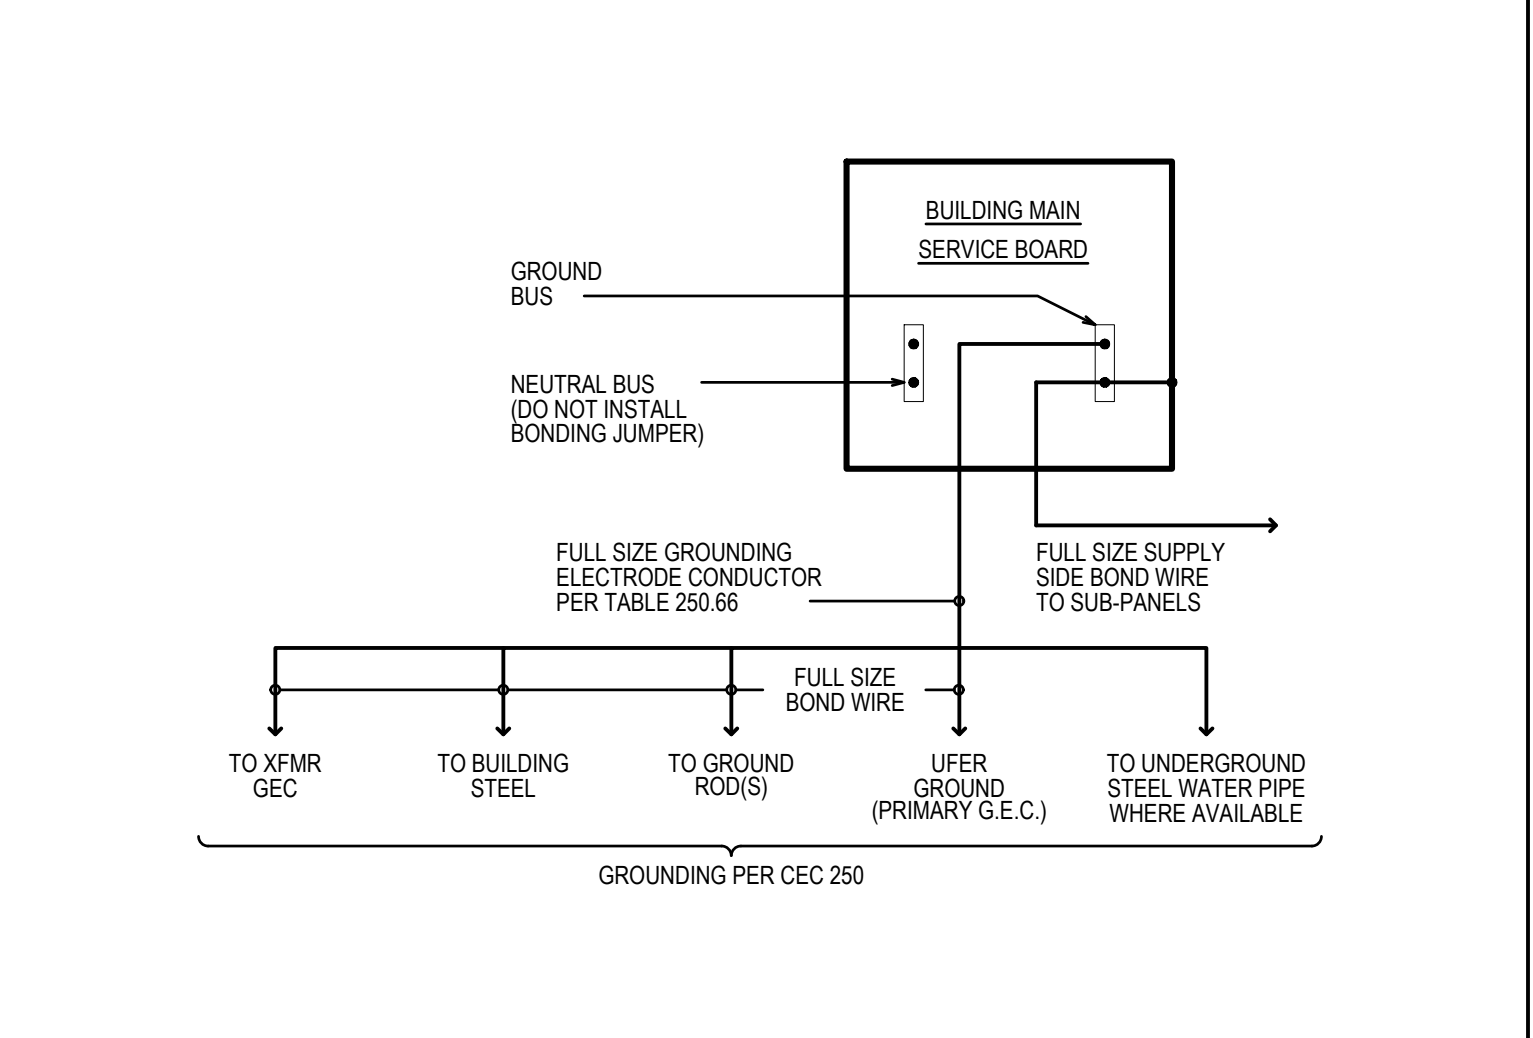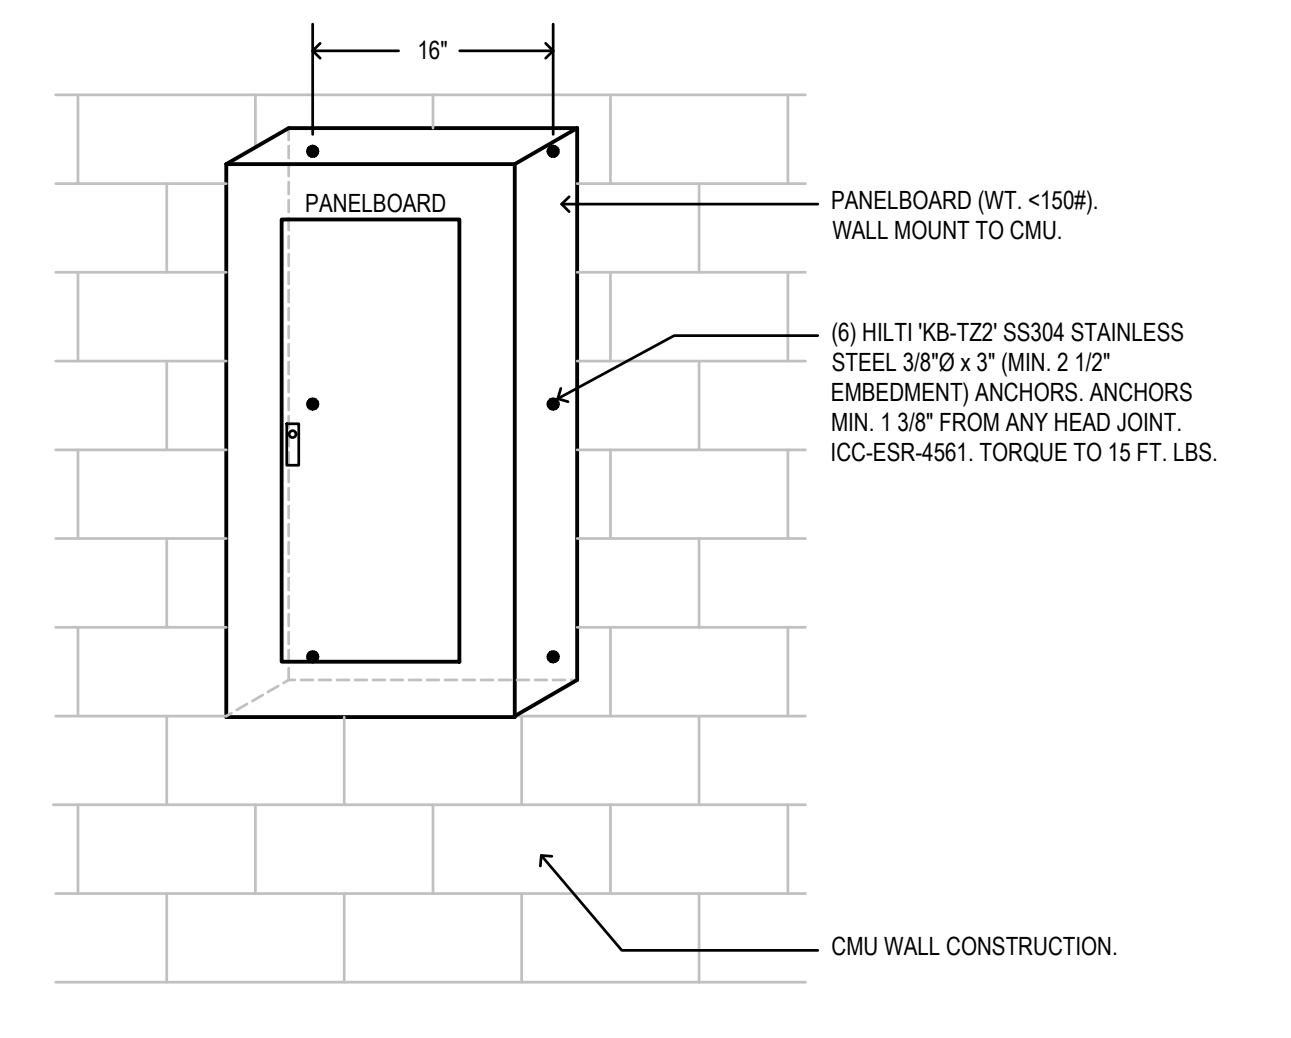

HD
 Hardin-Davidson Engineering
 356 Pollasky Ave., Suite 200, Clovis, CA 93612
 559.323.4995 tel • 559.323.4928 fax
 www.hardin-davidson.com
 Consultant

E1785
 REGISTERED PROFESSIONAL ENGINEER
 C. SCOTT DAVIDSON
 ELECTRICAL
 STATE OF CALIFORNIA

Mission Oak HS Aquatic Complex
 Tulare Joint Union High School District
 Tulare, CA 93274
 Project

TYPICAL INFORMATION
 POWER SYSTEMS - SINGLE LINE DIAGRAM AND DETAILS
 Drawing

darden architects ARCHITECTURE PLANNING INTERIORS
 www.dardenarchitects.com
 6790 N. West Ave. • Fresno, CA 93711 • T. 559.448.8051
 Architect

LICENCED ARCHITECT
 ARCHITECT C. F. DARDEN
 No. C23724
 STATE OF CALIFORNIA

No.	Revision/Submission	Date
1	REVISION_01	05/31/2023

Revision		
Designed By:	SD	Copyright 2022 Darden Architects
Scale:	As indicated	Drawn By: HDE
Project Number:	2180	Checked By: SD
Date:	08/02/2022	Reviewed By: SD

X/E103

Sheet: _____ of: _____

PANEL "P2H" SCHEDULE									
277/480V 3Ø 4W 42KAIC INDOOR / SURFACE									
CKT. NO.	DESCRIPTION	BREAKER AMPS POLES	VA	Φ	VA	BREAKER AMPS POLES	DESCRIPTION	CKT. NO.	
1	EM LIGHTING INVERTER AND EM LIGHTS	15 1	1913	A		15 3	SPARE	2	
3	LIGHTS - INTERIOR	15 1	115	B				4	
5	LIGHTS - EXTERIOR (BLDG. P2 & P3)	15 1	571	C				6	
7	LIGHTS - EXTERIOR (BLDG. P4)	15 1	536	A		20 1	SPARE	8	
9	LIGHTS - POOL POLE (NORTHEAST)	15 1	2670	B		20 1	SPARE	10	
11	LIGHTS - POOL POLE (SOUTHEAST)	15 1	2670	C		20 1	SPARE	12	
13	LIGHTS - POOL POLE (NORTHWEST)	15 1	2670	A			SPACE ONLY	14	
15	LIGHTS - POOL POLE (SOUTHWEST)	15 1	2670	B			SPACE ONLY	16	
17	LIGHTS - SITE AND PARKING LOT	15 1	2706	C			SPACE ONLY	18	
19	SPACE ONLY			A			SPACE ONLY	20	
21	SPACE ONLY			B			SPACE ONLY	22	
23	SPACE ONLY			C			SPACE ONLY	24	
25	SPACE ONLY			A			SPACE ONLY	26	
27	SPACE ONLY			B			SPACE ONLY	28	
29	SPACE ONLY			C			SPACE ONLY	30	
31	SPACE ONLY			A			SPACE ONLY	32	
33	SPACE ONLY			B			SPACE ONLY	34	
35	SPACE ONLY			C			SPACE ONLY	36	
37	TRANSFORMER "T-P2L"	175 3	33485	A	21652	250 3	PANEL "P4H"	38	
39	----	-- --	34511	B	21052	-- --	----	40	
41	----	-- --	29228	C	21052	-- --	----	42	
LOAD SUMMARY:			Φ A 60256 VA		BUSING: 600A				
			Φ B 61018 VA		MAIN: 450A				
			Φ C 56227 VA						
CONNECTED LOAD:			177.5 KVA						
MAX CURRENT:			220 A						

PANEL "P3L" SCHEDULE									
120/208V 3Ø 4W 22KAIC INDOOR / SURFACE									
CKT. NO.	DESCRIPTION	BREAKER AMPS POLES	VA	Φ	VA	BREAKER AMPS POLES	DESCRIPTION	CKT. NO.	
1	OUTLETS - GIRLS & GIRLS SHOWER	20 1	540	A	564	20 1	LIGHTS - BOYS, BOYS SHOWER, FIRE RISER	2	
3	OUTLETS - EXTERIOR	20 1	360	B	564	20 1	LIGHTS - GIRLES, GIRLS SHOWER, CUST.	4	
5	HAND DRYER - GIRLS SHOWER	20 1	2000	C		20 1	SPARE	6	
7	HAND DRYER - GIRLS	20 1	2000	A		20 1	SPARE	8	
9	HAND DRYER - GIRLS	20 1	2000	B		20 1	SPARE	10	
11	OUTLETS - BOYS & BOYS SHOWER	20 1	540	C		20 1	SPARE	12	
13	OUTLETS - EXTERIOR	20 1	360	A			SPACE ONLY	14	
15	HAND DRYER - BOYS SHOWER	20 1	2000	B			SPACE ONLY	16	
17	HAND DRYER - BOYS	20 1	2000	C			SPACE ONLY	18	
19	HAND DRYER - BOYS	20 1	2000	A			SPACE ONLY	20	
21	SWIMSUIT SPINNER	20 1	500	B			SPACE ONLY	22	
23	SPARE	20 1		C			SPACE ONLY	24	
25	SPARE	20 1		A			SPACE ONLY	26	
27	SPARE	20 1		B			SPACE ONLY	28	
29	SPARE	20 1		C			SPACE ONLY	30	
31	WATER HEATER & CIRC. PUMP	20 1	1217	A			SPACE ONLY	32	
33	WATER HEATER & CIRC. PUMP	20 1	1217	B			SPACE ONLY	34	
35	SPACE ONLY			C			SPACE ONLY	36	
37	SPACE ONLY			A			SPACE ONLY	38	
39	SPACE ONLY			B			SPACE ONLY	40	
41	* FIRE SPRINKLER BELL	20 1	180	C	2400	40 1	EXHAUST FAN EF-1	42	
LOAD SUMMARY:			Φ A 6681 VA		BUSING: 125A				
			Φ B 6641 VA		MAIN: 125A				
			Φ C 7120 VA						
CONNECTED LOAD:			20.4 KVA						
MAX CURRENT:			59 A						

PANEL "P4H" SCHEDULE									
277/480V 3Ø 4W 42KAIC INDOOR / SURFACE / STAINLESS STEEL, NEMA 4X									
CKT. NO.	DESCRIPTION	BREAKER AMPS POLES	VA	Φ	VA	BREAKER AMPS POLES	DESCRIPTION	CKT. NO.	
1	LIGHTS - INTERIOR	15 1	600	A	18005	100 3	COMPETITION POOL CIRC. PUMP	2	
3	SPARE	20 1		B	18005	-- --	----	4	
5	SPARE	20 1		C	18005	-- --	----	6	
7	SPACE ONLY			A	3047	20 3	LEARNING POOL CIRC. PUMP	8	
9	SPACE ONLY			B	3047	-- --	----	10	
11	SPACE ONLY			C	3047	-- --	----	12	
13	SPACE ONLY			A			SPACE ONLY	14	
15	SPACE ONLY			B			SPACE ONLY	16	
17	SPACE ONLY			C			SPACE ONLY	18	
19	SPACE ONLY			A			SPACE ONLY	20	
21	SPACE ONLY			B			SPACE ONLY	22	
23	SPACE ONLY			C			SPACE ONLY	24	
25	SPACE ONLY			A			SPACE ONLY	26	
27	SPACE ONLY			B			SPACE ONLY	28	
29	SPACE ONLY			C			SPACE ONLY	30	
31	SPACE ONLY			A			SPACE ONLY	32	
33	SPACE ONLY			B			SPACE ONLY	34	
35	SPACE ONLY			C			SPACE ONLY	36	
37	SPACE ONLY			A			SPACE ONLY	38	
39	SPACE ONLY			B			SPACE ONLY	40	
41	SPACE ONLY			C			SPACE ONLY	42	
LOAD SUMMARY:			Φ A 21652 VA		BUSING: 225A				
			Φ B 21052 VA		MAIN: 225A				
			Φ C 21052 VA						
CONNECTED LOAD:			63.8 KVA						
MAX CURRENT:			78 A						

PANEL "P2L" SCHEDULE									
120/208V 3Ø 4W 22KAIC INDOOR / SURFACE									
CKT. NO.	DESCRIPTION	BREAKER AMPS POLES	VA	Φ	VA	BREAKER AMPS POLES	DESCRIPTION	CKT. NO.	
1	SPARE	20 1		A	720	20 1	SPARE	2	
3	SPARE	20 1		B	720	20 1	SPARE	4	
5	SPARE	20 1		C	720	20 1	SPARE	6	
7	SPARE	20 1		A	1098	15 2	IDU/ODU-2	8	
9	SPARE	20 1		B	1098	-- --	----	10	
11	OUTLETS - STORAGE	20 1	720	C	798	15 2	IDU/ODU-1	12	
13	SPARE	20 1		A	798	-- --	----	14	
15	SPARE	20 1		B	798	-- --	----	16	
17	SPARE	20 1		C	798	-- --	----	18	
19	SPARE	20 1		A	360	20 1	OUTLETS - EXTERIOR	20	
21	SPARE	20 1		B	360	20 1	OUTLETS - ELECT.	22	
23	SPARE	20 1		C	360	20 1	OUTLETS - ELECT.	24	
25	SPARE	20 1		A	360	20 1	OUTLETS - ELECT.	26	
27	SPARE	20 1		B	360	20 1	OUTLETS - ELECT.	28	
29	SPARE	20 1		C	360	20 1	OUTLETS - ELECT.	30	
31	SPARE	20 1		A	360	20 1	OUTLETS - ELECT.	32	
33	SPARE	20 1		B	720	20 1	OUTLETS - ELECT.	34	
35	SPARE	20 1		C	720	20 1	OUTLETS - ELECT.	36	
37	MUSCO CAB. CONTROL POWER - ELEC YARD	15 1	250	A	360	20 1	IDF-P2	38	
39	POOL AREA AUDIO SYSTEM CAB. - TEAM RM	20 1	500	B	500	20 2	IDF-P2 208V OUTLET	40	
41	SPARE	20 1		C	500	-- --	----	42	
43	SPARE	20 1		A	6681	125 3	PANEL "P3L"	44	
45	SPARE	20 1		B	6641	-- --	----	46	
47	SPARE	20 1		C	7120	-- --	----	48	
49	SPARE	20 1		A	23218	300 3	PANEL "P4L"	50	
51	SPARE	20 1		B	24332	-- --	----	52	
53	* FIRE ALARM PANEL & SPRINKLER BELL	20 1	360	C	18290	-- --	----	54	
LOAD SUMMARY:			Φ A 33485 VA		BUSING: 600A				
			Φ B 34511 VA		MAIN: 600A				
			Φ C 29228 VA						
CONNECTED LOAD:			97.2 KVA						
MAX CURRENT:			288 A						

PANEL "P4L" SCHEDULE									
120/208V 3Ø 4W 22KAIC INDOOR / SURFACE / STAINLESS STEEL, NEMA 4X									
CKT. NO.	DESCRIPTION	BREAKER AMPS POLES	VA	Φ	VA	BREAKER AMPS POLES	DESCRIPTION	CKT. NO.	
1	OUTLETS - STORAGES & EXTERIOR	20 1	540	A	76.8	20 1	EXHAUST FAN EF-4	2	
3	OUTLETS - STORAGES	20 1	540	B	1920	30 1	EXHAUST FAN EF-5	4	
5	OUTLETS - STORAGES	20 1	540	C	76.8	20 1	EXHAUST FAN EF-3	6	
7	OUTLET - POOL EQUIPMENT	20 1	180	A	4160	40 2	WATER HEATER WH-2	8	
9	OUTLET - POOL EQUIPMENT	20 1	180	B	4160	-- --	----	10	
11	OUTLETS - EXTERIOR	20 1	720	C		20 1	SPARE	12	
13	SPARE	20 1		A	20	20 1	SPARE	14	
15	SPARE	20 1		B	20	20 1	SPARE	16	
17	SPARE	20 1		C	20	20 1	SPARE	18	
19	SPARE	20 1		A			SPACE ONLY	20	
21	SPARE	20 1		B			SPACE ONLY	22	
23	SPARE	20 1		C			SPACE ONLY	24	
25	SPACE ONLY			A			SPACE ONLY	26	
27	SPACE ONLY			B			SPACE ONLY	28	
29	SPACE ONLY			C			SPACE ONLY	30	
31	SPACE ONLY			A	12633	150 3	PANEL "SP1"	32	
33	SPACE ONLY			B	11904	-- --	----	34	
35	SPACE ONLY			C	11145	-- --	----	36	
37	SPARE (FUTURE MARQUEE SIGN)	20 2		A	5628	125 3	PANEL "SP2"	38	
39	----	-- --		B	5628	-- --	----	40	
41	* FIRE SPRINKLER BELL	20 1	180	C	5628	-- --	----	42	
LOAD SUMMARY:			Φ A 23218 VA		BUSING: 400A				
			Φ B 24332 VA		MAIN: 300A				
			Φ C 18290 VA						
CONNECTED LOAD:			65.8 KVA						
MAX CURRENT:			203 A						

H1 Panel Schedules

PANEL "P2H" SCHEDULE									
277/480V 3Ø 4W 42KAIC INDOOR / SURFACE									
CKT. NO.	DESCRIPTION	BREAKER AMPS POLES	VA	Φ	VA	BREAKER AMPS POLES	DESCRIPTION	CKT. NO.	
1	EM LIGHTING INVERTER AND EM LIGHTS	15 1	1912	A		15 3	SPARE	2	
3	LIGHTS - INTERIOR	15 1	446	B				4	
5	LIGHTS - EXTERIOR (BLDG. P2 & P3)	15 1	695	C				6	
7	LIGHTS - EXTERIOR (BLDG. P4)	15 1	536	A		20 1	SPARE	8	
9	LIGHTS - POOL POLE (NORTHEAST)	15 1	2670	B		20 1	SPARE	10	
11	LIGHTS - POOL POLE (SOUTHEAST)	15 1	2670	C		20 1	SPARE	12	
13	LIGHTS - POOL POLE (NORTHWEST)	15 1	2670	A			SPACE ONLY	14	
15	LIGHTS - POOL POLE (SOUTHWEST)	15 1	2670	B			SPACE ONLY	16	
17	LIGHTS - SITE AND PARKING LOT	15 1	2706	C			SPACE ONLY	18	
19	SPACE ONLY			A			SPACE ONLY	20	
21	SPACE ONLY			B			SPACE ONLY	22	
23	SPACE ONLY			C			SPACE ONLY	24	
25	SPACE ONLY			A			SPACE ONLY	26	
27	SPACE ONLY			B			SPACE ONLY	28	
29	SPACE ONLY			C			SPACE ONLY	30	
31	SPACE ONLY			A			SPACE ONLY	32	
33	SPACE ONLY			B			SPACE ONLY	34	
35	SPACE ONLY			C			SPACE ONLY	36	
37	TRANSFORMER "T-P2L"	175 3	33485	A	21652	250 3	PANEL "P4H"	38	
39	----	-- --	34511	B	21052	-- --	----	40	
41	----	-- --	29228	C	21052	-- --	----	42	
LOAD SUMMARY:			Φ A 60255 VA		BUSING: 600A				
			Φ B 61349 VA		MAIN: 450A				
			Φ C 56350 VA						
CONNECTED LOAD:			178.0 KVA						
MAX CURRENT:			221 A						

PANEL "P2L" SCHEDULE									
120/208V 3Ø 4W 22									

PLYWOOD INSTALLATION NOTES:


1. INSTALL 3/4" FIRE RESISTANT PAINTED PLYWOOD BACKBOARD AT INTERIOR OF ROOM WHERE SHOWN.
2. SECURE PLYWOOD TO METAL WALL STUDS WITH FLUSH #10 x 3" FLAT HEAD WOOD SMS AT 8" CENTERS.

LADDER RACK NOTES:



1. THE MAXIMUM CABLE WEIGHT FOR THIS SYSTEM SHALL NOT EXCEED 50 POUNDS PER LINEAR FOOT.
2. THE COMBINED WEIGHT OF THE CABLE AND LADDER RACK SYSTEM SHALL NOT EXCEED 75 POUNDS PER LINEAR FOOT.

GROUNDING NOTES:

1. BOND ALL LADDER RACK SECTIONS AND RACKS TOGETHER AND TO TMGB. SEE DETAILS L11/X/E105 & L14/X/E105.
2. REMOVE PAINT FROM COMPONENTS PRIOR TO ATTACHING GROUND LUGS.

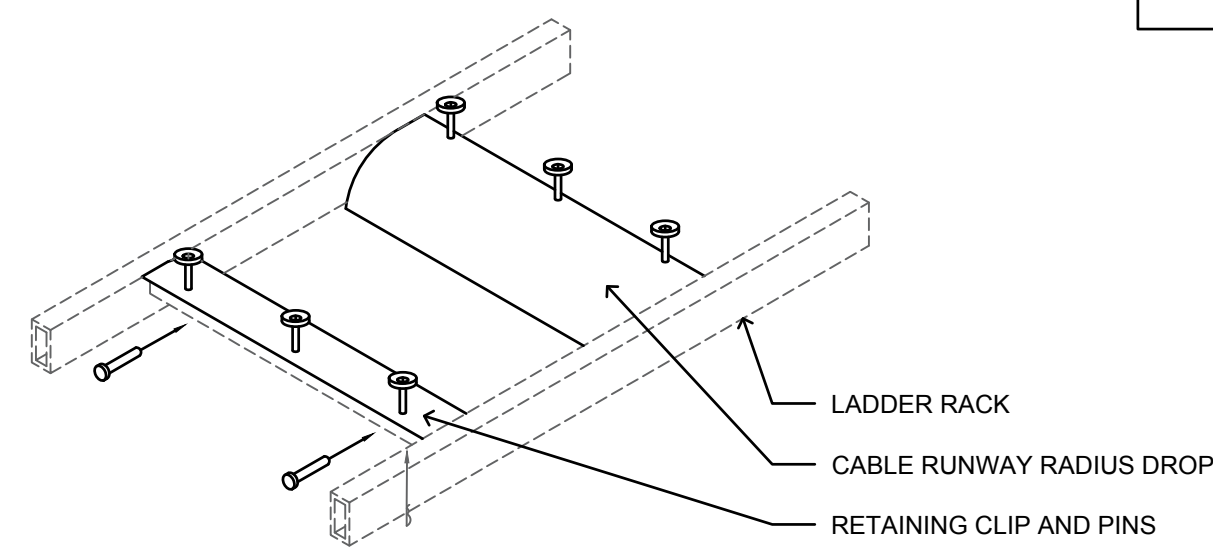


LADDER RACK CABLE TRANSITION

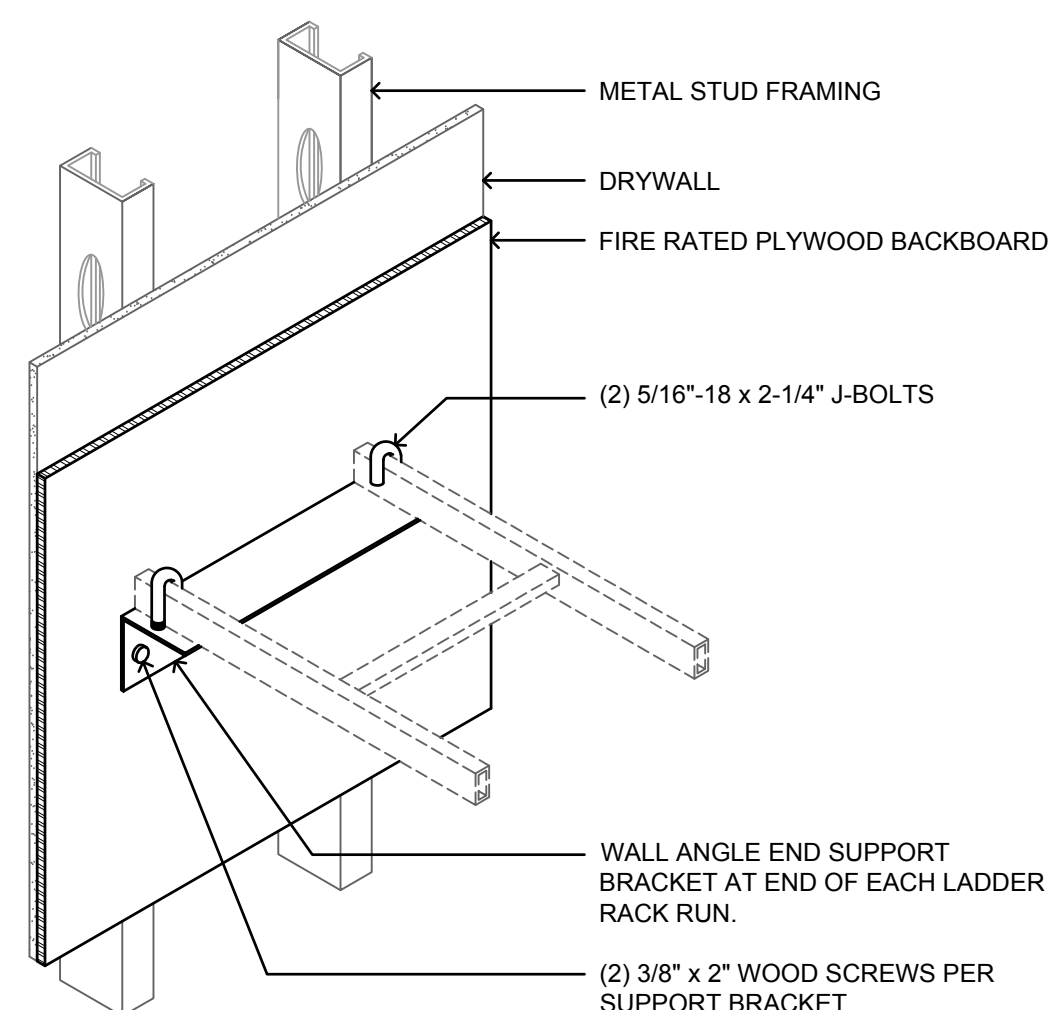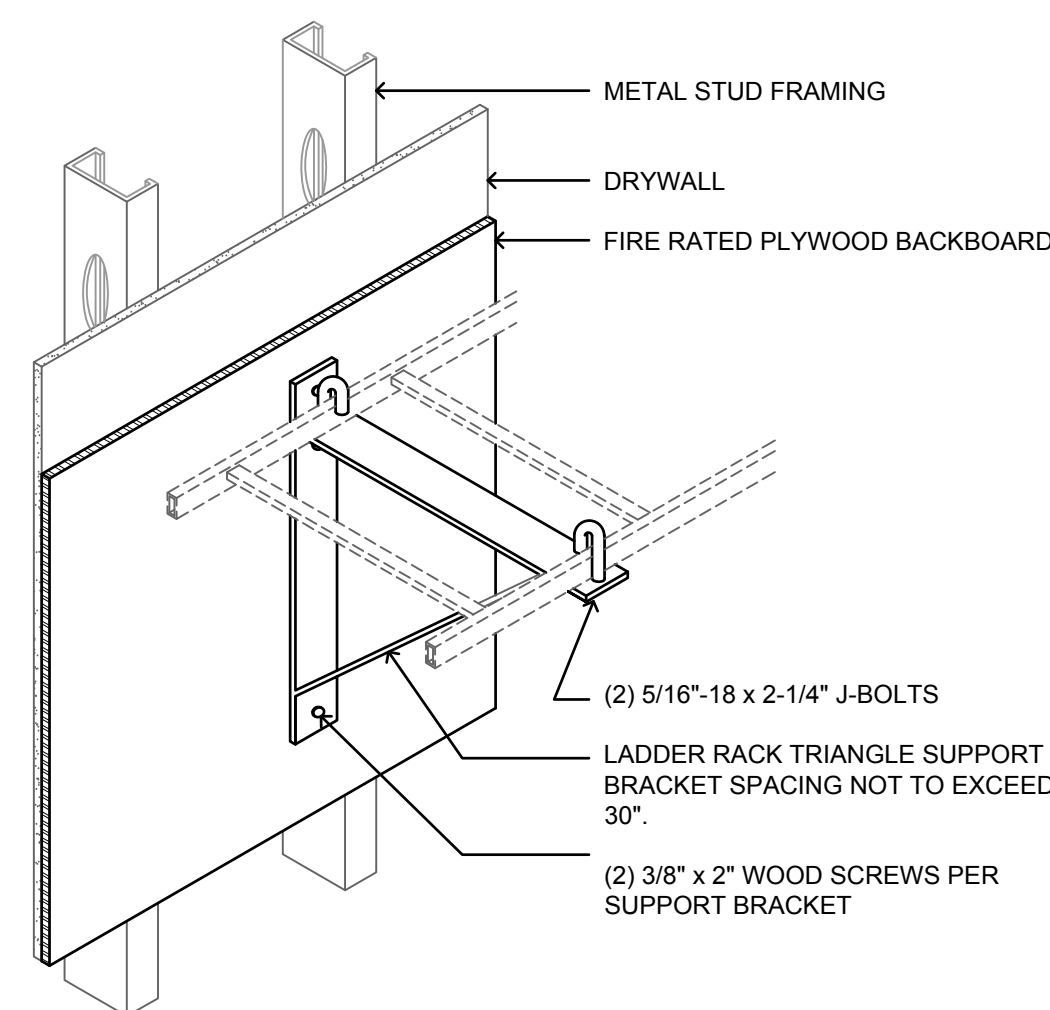

LADDER RACK WALL SUPPORT

J1 Ladder Rack Installation Detail

No Scale

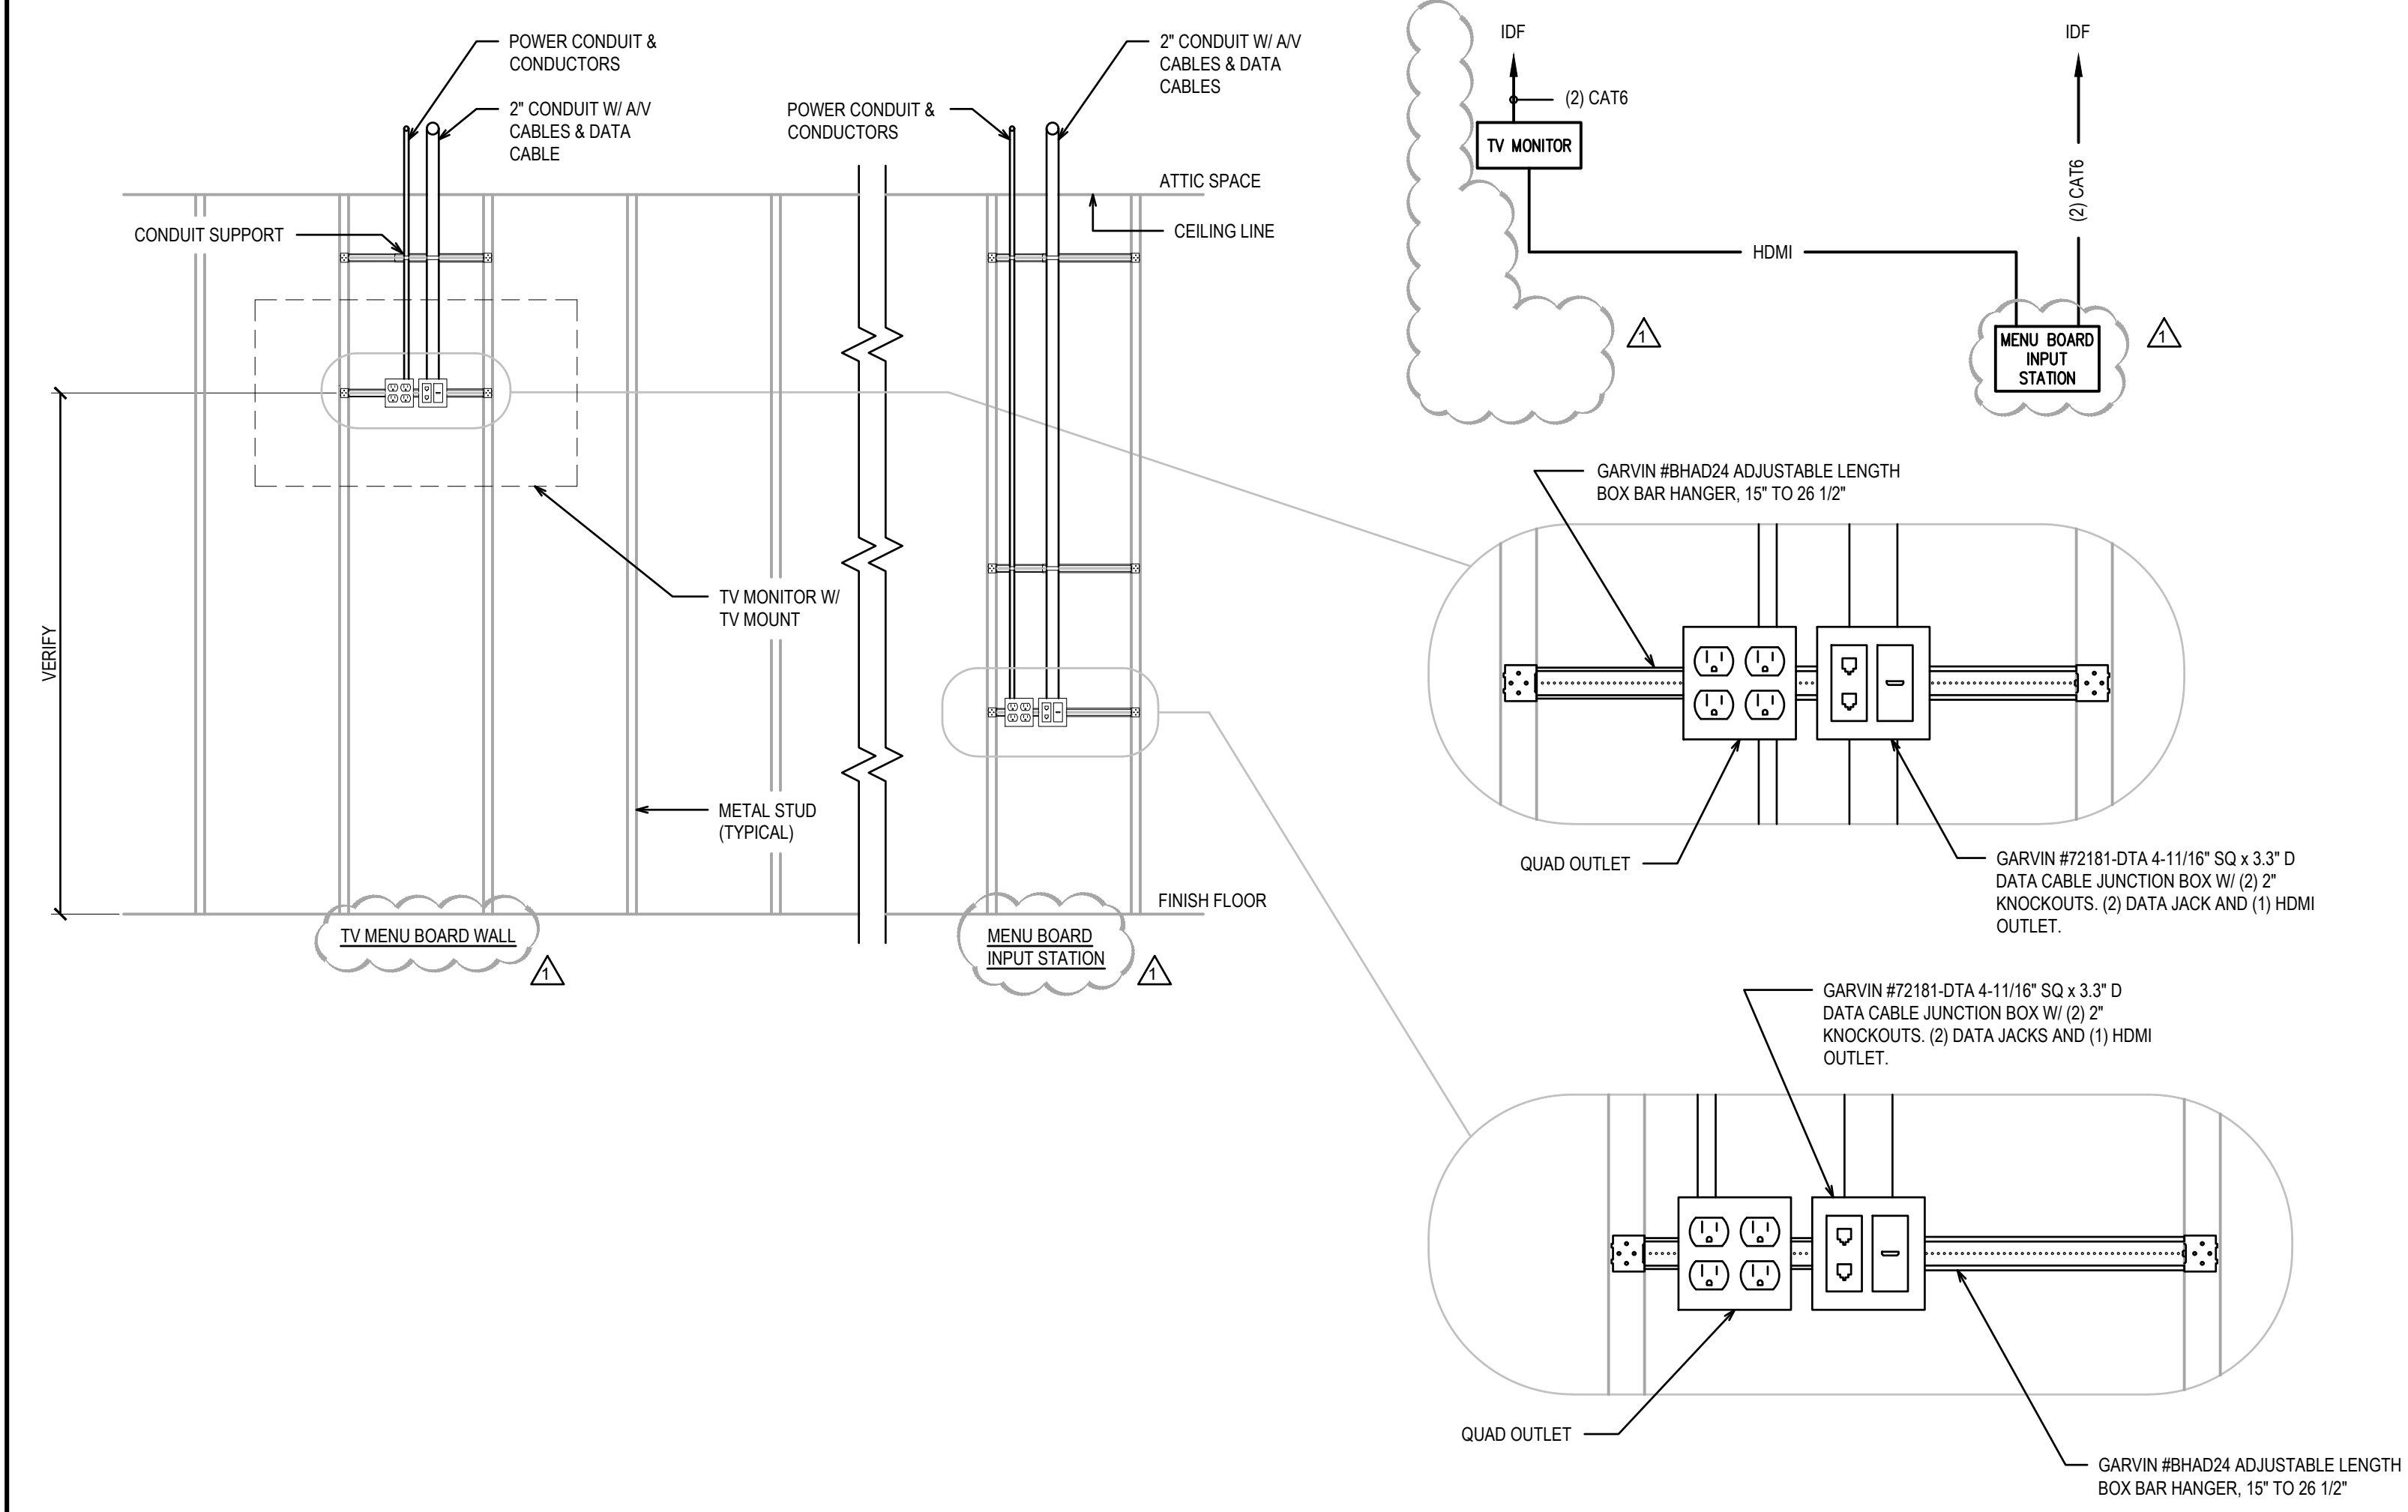

A1 TV Menu Board Detail - ALTERNATE BID

No Scale

DSA File No.: 54-H11

DSA Application No.: 02-120251

Agency Approval

Hardin-Davidson Engineering
 356 Pollasky Ave., Suite 200, Clovis, CA 93612
 559.323.4955 tel • 559.323.4928 fax
 www.hardin-davidson.com

Consultant

Mission Oak HS Aquatic Complex
 Tulare Joint Union High School District
 Tulare, CA 93274

Project

TYPICAL INFORMATION
 POWER AND LOW VOLTAGE SYSTEMS - DETAILS
 Drawing

DARDEN ARCHITECTS
 ARCHITECTURE PLANNING INTERIORS
 www.dardenarchitects.com
 8790 N. West Ave. • Fresno, CA 93711 • T. 559.448.8051

Architect

No.	Revision/Submission	Date
1	REVISION_01	05/31/2023
Revision		
Designed By:	SD	Copyright 2022 Darden Architects
Scale:	As indicated	Drawn By: HDE
Project Number:	2180	Checked By: SD
Date:	08/02/2022	Reviewed By: SD

X/E107

Sheet: _____ of: _____

8/16/2023 4:24:18 PM Z:\Clients\Darden Architects\22068 - Tulare USD Mission Oak HS Aquatic Complex\CAD Files\22068 - 4 Elec_rebid.dwg

FIRE ALARM GENERAL NOTES:

- FIRE ALARM SYSTEM: ADDRESSABLE, CLASS B, AUTOMATIC.
- ALL WORK SHALL CONFORM TO THE 2016 EDITION OF NFPA 72, AND THE 2019 EDITION OF CBC, CEC, AND CFC.
- INSTALLATION OF THE FIRE ALARM SYSTEM (FAS) SHALL NOT BE STARTED UNTIL DETAILED DESIGN DOCUMENTS AND SPECIFICATIONS, INCLUDING STATE FIRE MARSHAL LISTING NUMBERS FOR EACH COMPONENT OF THE SYSTEM HAS BEEN APPROVED BY DSA.
- UPON COMPLETION OF THE INSTALLATION OF THE FIRE ALARM SYSTEM, A SATISFACTORY TEST OF THE ENTIRE SYSTEM SHALL BE MADE IN THE PRESENCE OF A DSA PROJECT INSPECTOR. (THE LOCAL FIRE AUTHORITY MAY WITNESS THE TEST).
- A STAMPED SET OF APPROVED FIRE ALARM DESIGN DOCUMENTS SHALL BE ON THE JOB SITE AND USED FOR THE INSTALLATION.
- ANY DISCREPANCIES BETWEEN THE DRAWINGS AND THE CODE OR RECOGNIZED STANDARDS SHALL BE BROUGHT TO THE ATTENTION OF DSA AND THE ARCHITECT/ENGINEER OF THE PROJECT.
- DSA, ARCHITECT/ENGINEER AND OWNER SHALL BE NOTIFIED A MINIMUM OF 48 HOURS PRIOR TO THE FINAL INSPECTION AND/OR TESTING.
- ALL PENETRATIONS THROUGH RATED ASSEMBLIES REQUIRING OPENING PROTECTION SHALL BE PROVIDED WITH A PENETRATION FIRE STOP SYSTEM AS IDENTIFIED IN CBC CHAPTER 7, UL, OR OTHER LAB TESTING CRITERIA APPROVED TYPE OF MATERIALS SHALL BE IDENTIFIED WITHIN THE SPECIFICATION WITHIN THE FIRE ALARM SECTION.
- MICROPHONE ASSOCIATED WITH EMERGENCY VOICE ALARM COMMUNICATION SYSTEMS (EVAC) SHALL BE ACCESSIBLE FOR USE, INSTALLED IN COMPLIANCE WITH CBC SECTIONS 11B-305 AND 11B-308.
- WALL MOUNTED VISUAL NOTIFICATION DEVICES SHALL HAVE THEIR ENTIRE LENS WITHIN AT 80" MINIMUM AND 96" MAXIMUM FROM FINISHED FLOOR.
- WALL MOUNTED AUDIBLE NOTIFICATION DEVICES SHALL HAVE THEIR TOPS MOUNTED AT 90" MINIMUM AND 100" MAXIMUM FROM FINISHED FLOOR AND NO CLOSER THAN 6" TO A HORIZONTAL STRUCTURE.
- AUDIBLE DEVICES SHALL PROVIDE A SOUND PRESSURE LEVEL OF 15 DECEBELS (dBA) ABOVE THE AVERAGE AMBIENT SOUND LEVEL OR 5 dBA ABOVE THE MAXIMUM SOUND LEVEL HAVING A DURATION OF AT LEAST 60 SECONDS, WHICHEVER IS GREATER, IN EVERY SPACE WITHIN A BUILDING THAT MAY BE OCCUPIED AND BE INTELLIGIBLE.
- AUDIBLE DEVICES SHALL BE SYNCHRONIZED TEMPORAL CODE 3 PATTERN, PRIOR TO "EVAC" ANNOUNCEMENT. THE CARBON MONOXIDE SIGNAL SHALL SOUND A FOUR-PULSE TEMPORAL PATTERN PER NFPA 72, 18.4.3.2.
- THE CONTRACTOR SHALL ADJUST/INSTALL ALL DEVICES TO MAXIMIZE PERFORMANCE AND TO MINIMIZE FALSE ALARMS.
- VISUAL DEVICES SHALL NOT EXCEED 2 FLASHES PER SECOND AND SHALL NOT BE SLOWER THAN 1 FLASH PER SECOND. THE DEVICE SHALL HAVE A PULSING LIGHT SOURCE NOT LESS THAN 15 CANDELA. VISUAL DEVICES WITHIN 50' FROM EACH OTHER SHALL BE SYNCHRONIZED.
- UNDERGROUND AND EXTERIOR CONDUITS SHALL HAVE WATER-TIGHT FITTINGS AND WIRE APPROVED FOR WET LOCATIONS.
- ALL FIRE ALARM WIRING SHALL BE FLP OR FPLP (FIRE POWER LIMITED OR FIRE POWER LIMITED PLENUM) AS REQUIRED FOR APPLICATION. WIRING IN CONDUIT ABOVE GROUND SHALL BE THHN OR THWN.
- PER CEC STANDARDS, ALL WIRING SHALL BE PULLED THROUGH EACH JUNCTION BOX AND CONNECTED DIRECTLY TO EACH FIRE DEVICE. DO NOT SPICE WIRE. ANY CONNECTION SHALL BE BY LUG CONNECTION AT A DEVICE OR AT A FATC TERMINAL BLOCK ONLY. ALL BOXES TO BE SIZED PER CEC.
- SMOKE DETECTORS SHALL NOT BE CLOSER THAN 12" FROM FIRE SPRINKLERS NOR 36" FROM SUPPLY AIR DIFFUSERS. IN AREA OF CONSTRUCTION OR POSSIBLE DAMAGE/CONTAMINATION, NEWLY INSTALLED FIRE ALARM DEVICES SHALL BE COVERED UNTIL THAT AREA IS READY TO BE TURNED OVER TO THE OWNER.
- ALL FIRE ALARM CIRCUITS SHALL BE IN CONDUIT, SURFACE RACEWAY, OR OPEN RUN ABOVE CEILINGS, UNDER FLOORS, AND IN WALLS IN A NEAT AND PROTECTED MANNER AS INDICATED ON DESIGN DOCUMENTS. EXPOSED CIRCUITS ARE ONLY PERMITTED WHEN NOTED AS EXPOSED ON DESIGN DOCUMENTS. OWNER STANDARDS MAY BE MORE STRINGENT.
- FIRE ALARM PANEL, REMOTES, AND COMPONENTS SHALL BE SECURED TO MOUNTING SURFACES PER MANUFACTURERS' SPECIFICATIONS. ANY SINGLE DEVICE SHALL NOT EXCEED THE WEIGHT OF 20 LBS. WITHOUT SPECIAL MOUNTING DETAILS.
- A DEDICATED BRANCH CIRCUIT SHALL BE PROVIDED FOR FIRE ALARM EQUIPMENT. THIS CIRCUIT SHALL BE ENERGIZED FROM THE COMMON USE AREA PANEL AND SHALL HAVE NO OTHER OUTLETS. THE BREAKER SHALL HAVE A LOCKING DEVICE WITH RED MARKING PER NFPA 72, SECTION 10.6.5.4 AND 10.6.5.2 TO BLOCK THE HANDLE IN THE "ON" POSITION. THE CIRCUIT BREAKER SHALL BE LABELED "FIRE ALARM CIRCUIT CONTROL". CIRCUIT ID TO BE LABELED AT THE FIRE PANEL/EXTENDERS.
- THE INSTALLING CONTRACTOR SHALL PROVIDE A RECORD OF COMPLETION IN COMPLIANCE WITH NFPA 72, SECTION 7.5.6.
- CONTROL PANELS AND REMOTE ANNUNCIATORS SHALL BE INSTALLED WITH THEIR BOTTOMS MOUNTED AT 48".
- THE INSTALLING CONTRACTOR SHALL PROVIDE SYSTEM PROGRAMMING FOR SUPERVISORY MONITORING PER CBC 901.6.2.
- SUPERVISORY MONITORING SHALL BE TESTED AND VERIFIED AS SENDING CORRECT SIGNALS IN CONJUNCTIONS WITH FINAL TEST. FIRE ALARM SYSTEMS SHALL TRANSMIT THE ALARM, SUPERVISORY AND TROUBLE SIGNALS TO AN APPROVED SUPERVISING STATION IN ACCORDANCE WITH NFPA 72. THE SUPERVISING STATIONS SHALL BE LISTED AS EITHER ULXF (CENTRAL STATION) OR ULJIS (REMOTE AND PROPRIETARY BY UNDERWRITERS LABORATORY (UL)) OR SHALL COMPLY WITH THE REQUIREMENTS OF STANDARD FM 3011. A COPY OF ALL DEVICES REPORTED TO THE CENTRAL STATION SHALL BE PROVIDED TO THE OWNERS ELECTRONICS DEPARTMENT.

- OWNER SHALL BE RESPONSIBLE FOR ESTABLISHING A FIRE SYSTEM MONITORING CONTRACT OR PROVISIONS.
- ALL WIRING IS SHOWN DIAGRAMMATICALLY. SUBJECT TO DSA APPROVAL, CONTRACTOR MAY VARY SEQUENCE OF CIRCUITRY; HOWEVER, ALL CIRCUITS SHALL BE CONTINUOUS AND SUPERVISED.
- ALL CONNECTIONS SHALL BE PROPERLY LABELED BY CONDUCTOR AND SHALL HAVE STA-KON LUG CONNECTORS. PANDUIT TAG (TIE WRAP) SEPARATELY.
- FIRE ALARM TERMINAL CABINETS SHALL HAVE SUFFICIENT SPACE, TERMINAL BOARDS AND SCREW TERMINAL CONNECTORS TO ALLOW CONNECTION OF ALL CONDUCTORS SHOWN. PROVIDE BARRIER TO SEPARATE FIRE ALARM SYSTEM WHEN TERMINAL CABINET IS SHARED WITH NON-FIRE ALARM SYSTEMS. CONTRACTOR SHALL BE REQUIRED TO SUBMIT WITH HIS OTHER SHOP DRAWINGS DETAILED DRAWINGS OF HIS PROPOSED CONNECTIONS AT EACH FIRE ALARM TERMINAL CABINET PRIOR TO COMMENCING ANY WORK.
- ALL NAC CIRCUIT CONDUCTORS SHALL BE #12 AWG, STRANDED (19 STRANDS OR LESS) COPPER, UNLESS OTHERWISE NOTED.
- SET END-OF-LINE RESISTORS IN DISTRIBUTION TERMINAL CABINETS.
- BATTERIES SHALL BE STAMPED WITH DATE OF MANUFACTURE.
- INSTALLATION OF FAS EQUIPMENT SHALL BE BY AN AUTHORIZED ENGINEERED SYSTEM DISTRIBUTOR FOR THE EQUIPMENT SPECIFIED BY THE MANUFACTURER FOR SALES, SERVICE, INSTALLATION AND MAINTENANCE. PROVIDE CERTIFICATIONS WITH EQUIPMENT SUBMITTALS. SUBMITTALS BY FIRMS NOT FULFILLING THIS REQUIREMENT WILL BE AUTOMATICALLY REJECTED.
- THE FAS INSTALLER SHALL BE NICET LEVEL 2 CERTIFIED.
- THE FAS INSTALLER SHALL PROVIDE ALL FACTORY WARRANTIES TO THE OWNER AT THE CLOSE UP OF THE PROJECT.
- THE FAS INSTALLER SHALL PROVIDE WRITTEN CERTIFICATION USING NFPA 72 INSPECTION AND TESTING FORMS AND SHALL CERTIFY THAT THE INSTALLATION, TESTING, AND OPERATION CONFORM IN ALL RESPECTS TO THE REQUIREMENTS AS SET FORTH IN TITLE 19 OF THE CALIFORNIA CODE OF REGULATIONS AND PART 3, ARTICLE 760 OF TITLE 24 OF THE C.C.R. AND C.B.C. SECTION 907. THE CONTRACTOR SHALL SUBMIT THE COMPLETED FAS CERTIFICATION AND DESCRIPTION FORM TO DIVISION OF STATE ARCHITECT.
- INCLUDE ALL DEMOLITION OF EXISTING FIRE ALARM SYSTEM WHETHER SPECIFICALLY SHOWN OR NOT. REMOVE ALL CABLING & UNUSED EXPOSED RACEWAY & OUTLETS. BLANK OFF ALL UNUSED WALL & HARD CEILING OUTLETS. REMOVE ALL UNUSED OUTLETS IN TEE-BAR CEILING & REPLACE ACOUSTIC TILES. RETURN ALL DEVICES, APPLIANCES, & CONTROL PANELS TO OWNER IF REQUESTED BY OWNER DURING CONSTRUCTION.
- WHEN FIRE ALARM WORK WILL DISABLE PORTIONS OF THE EXISTING FAS, PROVIDE ALL REQUIRED OVERTIME AND FIRE WATCH IN SCOPE OF WORK.
- WHERE FIRE ALARM DEVICES ARE BEING INSTALLED IN OTHERWISE INACCESSIBLE AREAS, PROVIDE AN ALLOWANCE FOR THE INSTALLATION OF ACCESS PANELS AND ALL WORK ASSOCIATED WITH THE INSTALLATION. THE CONTRACTOR SHALL CUT ALL THE OPENINGS. THE SIZE OF THE ACCESS PANEL SHALL BE DETERMINED BY THE MAN ACCESS REQUIREMENTS. PROVIDE PAINT GRADE ACCESS DOORS AND PAINT TO MATCH THE COLOR & SHEEN OF THE EXISTING CEILING.
- FIRE ALARM SYSTEM INSPECTION, TESTING, AND MAINTENANCE SHALL COMPLY WITH NFPA 72, CHAPTER 14.
- PROVIDE FIRE ALARM RECORD DOCUMENTS CABINET NFPA 72, 7.7.2.
 - EVERY NEW FIRE ALARM SYSTEM SHALL PROVIDE A DOCUMENTATION CABINET, INSTALLED AT THE SYSTEM CONTROL PANEL OR OTHER APPROVED LOCATION.
 - THE DOCUMENTATION CABINET SHALL BE PROMINENTLY LABELED, "FIRE ALARM SYSTEM RECORD DOCUMENTS".
 - ALL RECORD AND TESTING DOCUMENTATION SHALL BE STORED IN THE CABINET.
 - CONTENTS SHALL BE ACCESSIBLE BY AUTHORIZED PERSONNEL ONLY.
 - WHERE CABINET IS INSTALLED IN A LOCATION OTHER THAN THE SYSTEM CONTROL UNIT, ITS LOCATION SHALL BE IDENTIFIED AT THE SYSTEM CONTROL UNIT.


- PROVIDE SYSTEM DOCUMENTS AS APPLICABLE:
- RECORD DRAWINGS/AS-BUILTS
 - EQUIPMENT OUT SHEETS & CA-SFM LISTINGS
 - ALTERNATIVE MEANS AND METHODS
 - PERFORMANCE BASED DESIGN DOCUMENTATION (NFPA 72, 7.3.7)
 - SYSTEM RECORD OF COMPLETION & ANY SUPPLEMENTAL INSPECTION AND TESTING DOCUMENTATION (NFPA 72, 7.8.2)
 - EMERGENCY RESPONSE PLAN (NFPA 72, 7.3.1)
 - EVALUATION DOCUMENTATION (NFPA 72, 7.3.9)
 - RISK ANALYSIS DOCUMENTATION (NFPA 72, 7.3.8)
 - SOFTWARE & FIRMWARE CONTROL DOCUMENTATION (NFPA 72, 23.2.2)

FIRE ALARM SYMBOLS SCHEDULE:

SYMBOL	NAME	DESCRIPTION	CSFM LISTING
[E]	(E) FIRE ALARM CONTROL PANEL W/ (N) EMERGENCY VOICE/ALARM COMMUNICATION	EDWARDSUTC #E3T3 W/ (N) 3-ASU4, 3-2A40	7165-1657-0186
[L]	(N) LOCAL OPERATING CONSOLE W/ ANNUNCIATOR & PAGING MICROPHONE	EDWARDSUTC #3-6AN W/ 3-ANNCPUS, 3-LCD, 3-REMICA, SIGA-CT1, 3-12SR	7120-1657-0193 7300-1657-0121
[E]	NAC EXPANDER PANEL	EDWARDSUTC #E3P10A	7300-1657-0229
[D]	SMOKE DETECTOR, PHOTOELECTRONIC DETECTOR BASE	EDWARDSUTC #SIGA-PD EDWARDSUTC #SIGA-SB	7272-1657-0331 7300-1657-0120
[C]	CEILING HEAT DETECTOR, 135°F DETECTOR BASE	EDWARDSUTC #SIGA-HD EDWARDSUTC #SIGA-SB	7270-1657-0333 7300-1657-0120
[M]	MONITOR MODULE	EDWARDSUTC #SIGA-MM1	7300-1657-0121
[R]	RELAY MODULE	EDWARDSUTC #SIGA-CR	7300-1657-0121
[V]	VISIBLE NAC DEVICE, WALL MTD (d) INDICATED ON PLANS	EATON/WHEELLOCK #ELSTR	7135-0785-0504
[S]	SPEAKER/VISIBLE NAC DEVICE, WALL MTD (WATTS & d) INDICATED ON PLANS	EATON/WHEELLOCK #ELSPSTR	7320-0785-0505
[W]	EXTERIOR SPEAKER, W.P., WALL MTD (WATTS INDICATED ON PLANS)	EATON/WHEELLOCK #ET-1010-R	7320-0785-0105
[I]	SPRINKLER POST INDICATOR VALVE	SPECIFIED BY FIRE PROTECTION ENG.	
[T]	SPRINKLER RISER TAMPER SWITCH	SPECIFIED BY FIRE PROTECTION ENG.	
[F]	SPRINKLER RISER FLOW SWITCH	SPECIFIED BY FIRE PROTECTION ENG.	
[B]	SPRINKLER RISER BELL	SPECIFIED BY FIRE PROTECTION ENG.	


FIRE ALARM CABLE SCHEDULE:

SYMBOL	NAME	DESCRIPTION
A	SIGNALING LINE CIRCUIT (SLC) CABLE WEST PENN #0990	16/2 TWISTED PAIR, STRANDED, LOW CAPACITANCE FA POWER LIMITED, RISER CABLE (FPLR)
AW	SIGNALING LINE CIRCUIT (SLC) CABLE, OSP WEST PENN #AQC225	16/2 TWISTED PAIR, STRANDED, AQUASEAL FA POWER LIMITED CABLE (FPL)
B	NOTIFICATION APPLIANCE CKT (NAC) CABLE WEST PENN #9985	12/2 TWISTED PAIR, STRANDED FA POWER LIMITED, RISER CABLE (FPLR)
C	EM. VOICE/ALARM COMM. (EVIAC) CABLE WEST PENN #H995	14/2 SHIELDED TWISTED PAIR, STRANDED FA POWER LIMITED CABLE (FPL)
CW	EM. VOICE/ALARM COMM. (EVIAC) CABLE, OSP WEST PENN #AQC295	14/2 SHIELDED TWISTED PAIR, STRANDED, AQUASEAL FA POWER LIMITED CABLE (FPL)
D	INITIATING DEVICE CIRCUIT (IDC) CABLE WEST PENN #9945	14/2 TWISTED PAIR, STRANDED FA POWER LIMITED, RISER CABLE (FPLR)
DW	INITIATING DEVICE CKT (IDC) CABLE, OSP WEST PENN #AQC226	14/2 TWISTED PAIR, STRANDED, AQUASEAL FA POWER LIMITED CABLE (FPL)
G	POWER CABLE WEST PENN #9985	12/2 TWISTED PAIR, STRANDED FA POWER LIMITED, RISER CABLE (FPLR)
M	MICROPHONE CABLE, POTTER FA SYSTEMS WEST PENN #3270	22/6 SHIELDED TWISTED PAIRS, STRANDED COMMUNICATIONS RISER CABLE (CMR)
MW	MICROPHONE CABLE, OSP, POTTER FA SYSTEMS WEST PENN #AQC3186	22/6 SHIELDED TWISTED PAIRS, STRANDED, AQUASEAL COMMUNICATIONS MULTI-PURPOSE CABLE (CM)

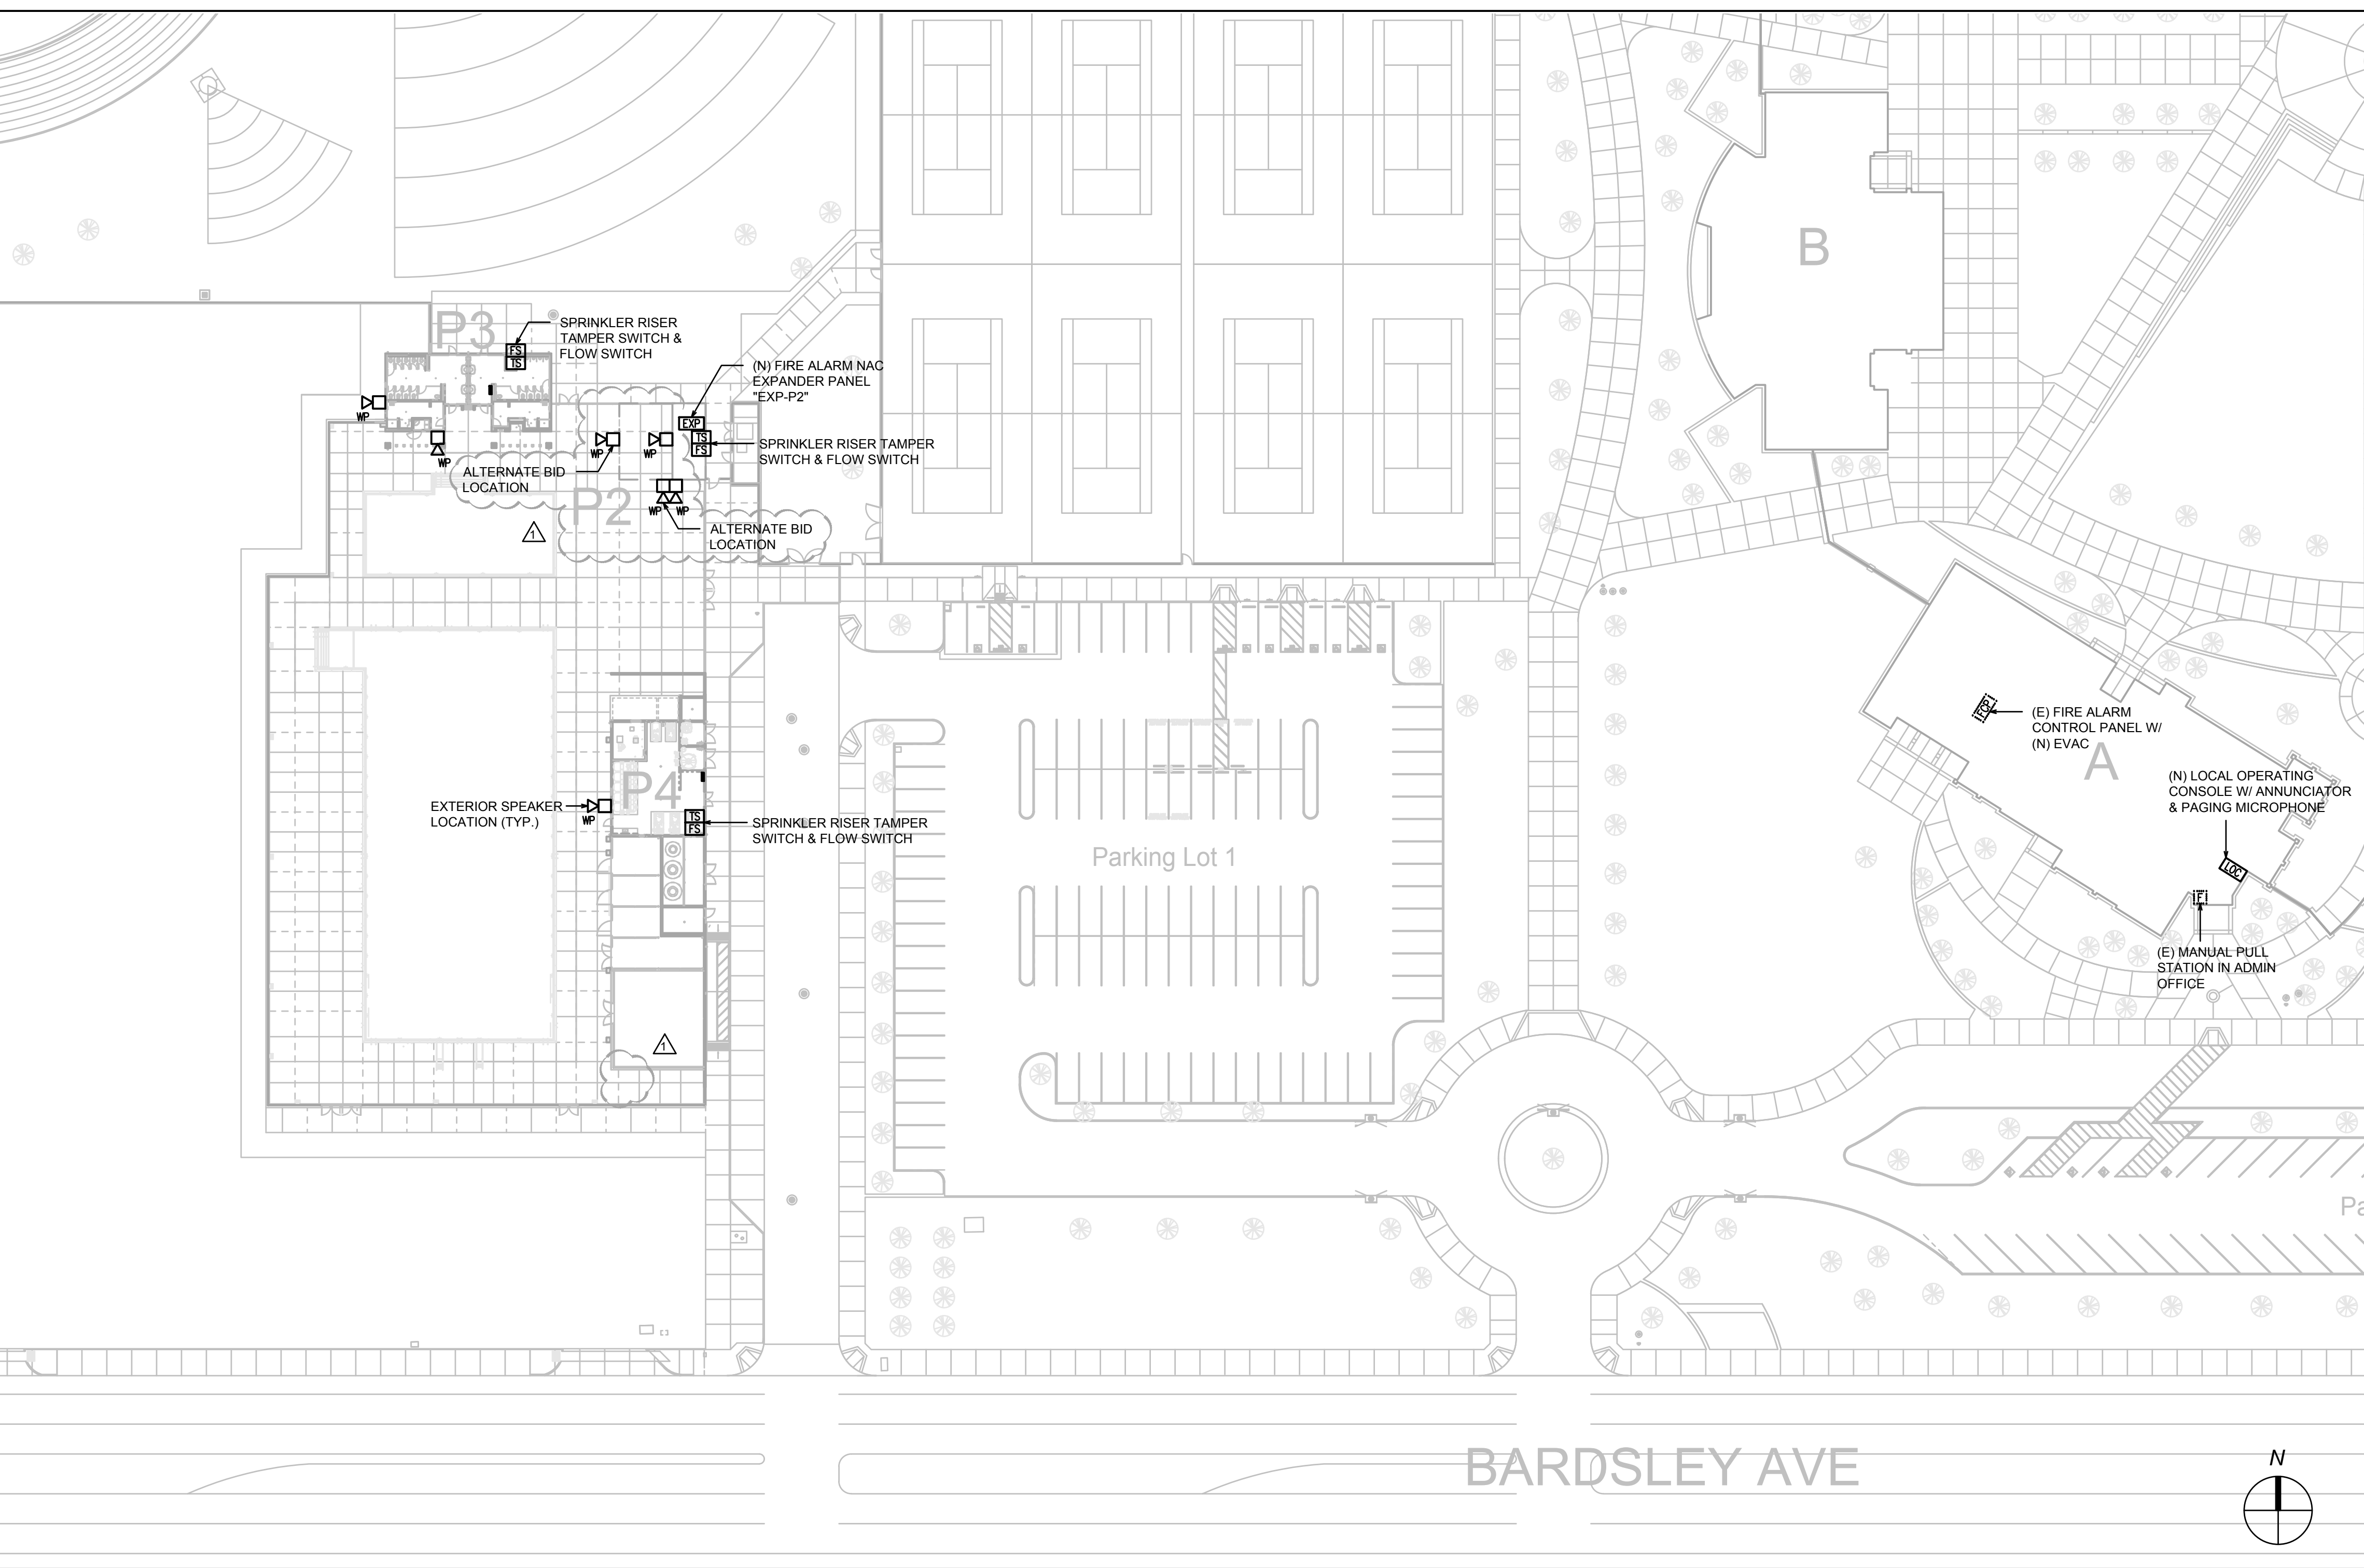

ACTION	INITIATION CONDITION	FIRE SPRINKLER TAMPER SWITCH POST INDICATOR VALVE	SMOKE, HEAT, OR DUCT DETECTOR, FIRE SPRINKLER FLOW SWITCH	POWER LOSS, SHORT CIRCUIT, GROUND FAULT
ANNUNCIATE TROUBLE				
ANNUNCIATE ALARM				
ANNUNCIATE SUPERVISORY				
INITIATE VISUAL NOTIFICATION APPLIANCES				
INITIATE EVAC SPEAKER APPLIANCES				
TRANSMIT TO CENTRAL STATION				
CLOSE FIRE/SMOKE DAMPER				
SHUTDOWN FVAC UNITS				
DOOR RELEASE				
ACCESS CONTROL OVERRIDE				

E13 Fire Alarm Sequence of Operations Matrix

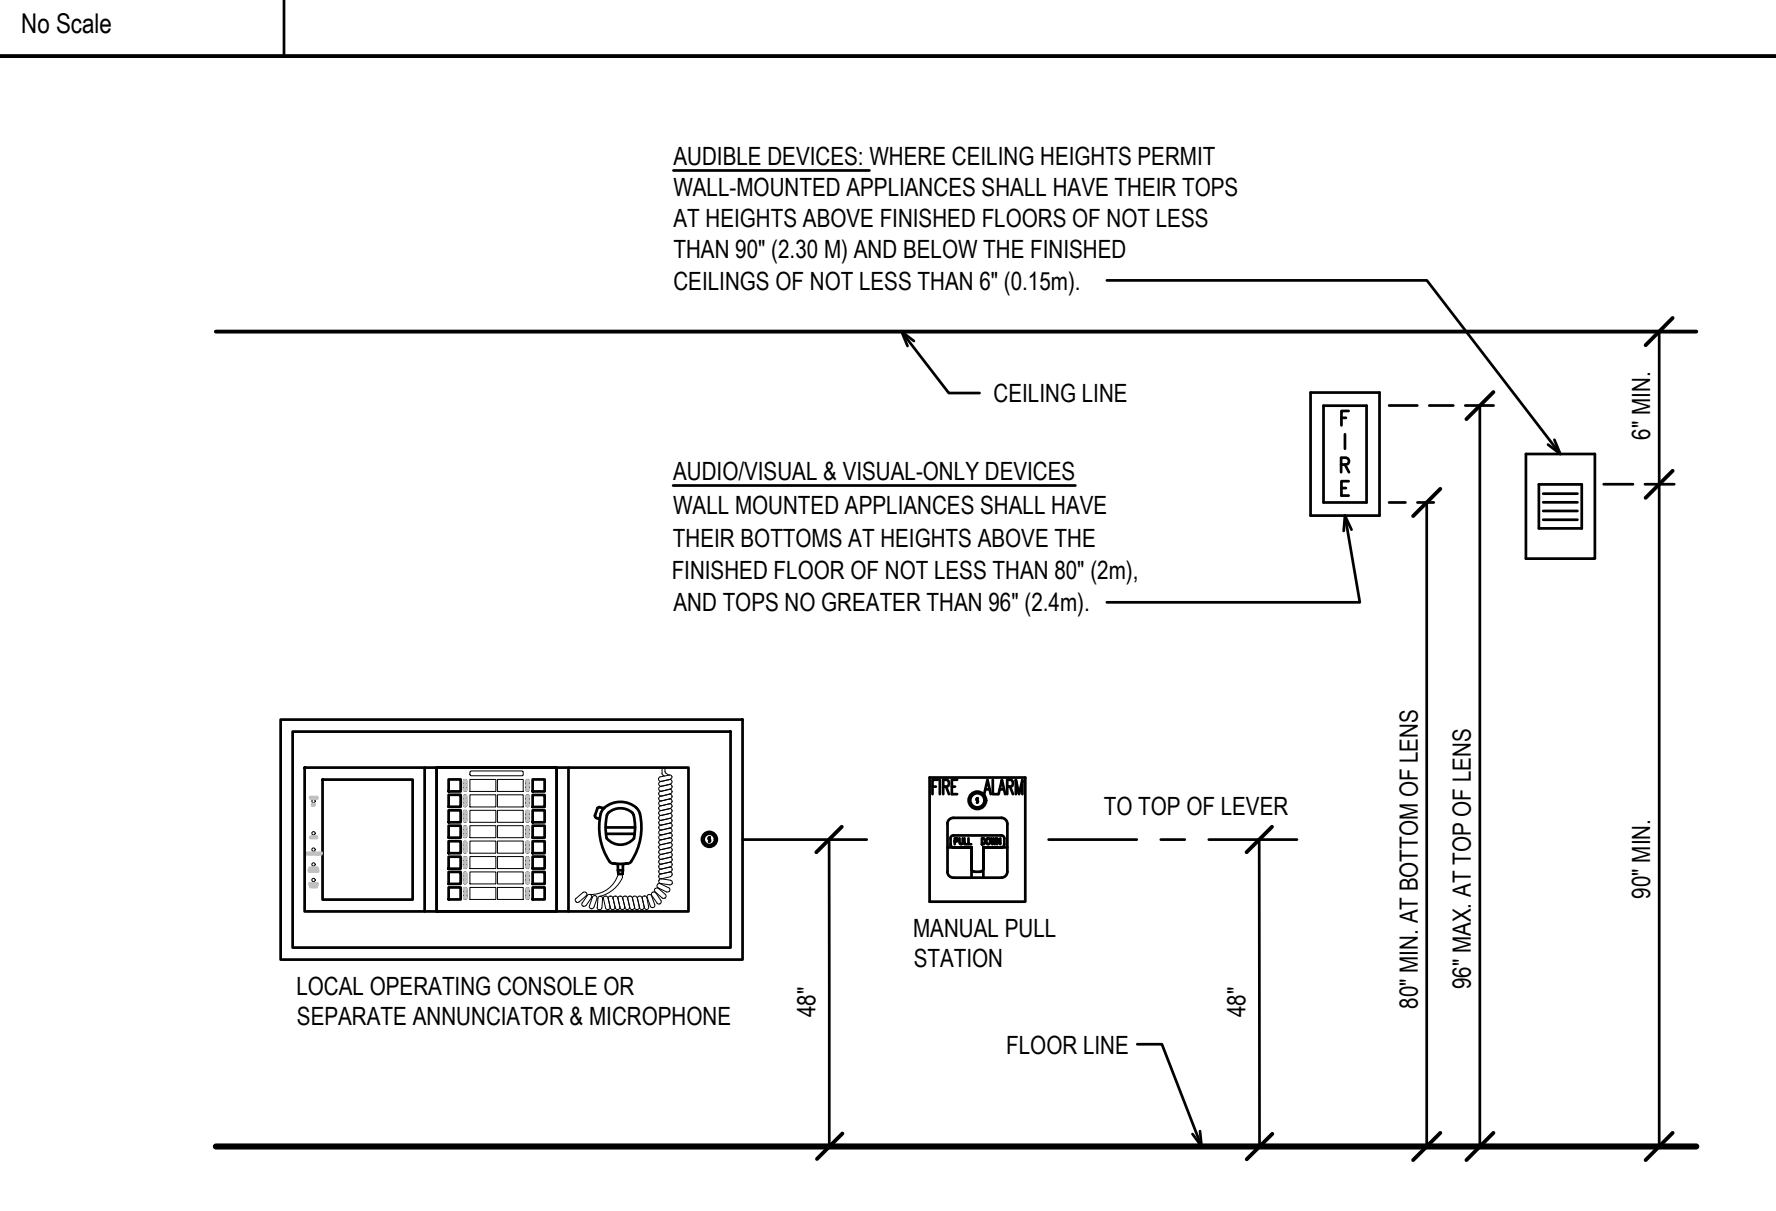

A13 Fire Alarm Wall Mounted Devices Elevation

DSA File No.: 54-H11

DSA Application No.: 02-120251

Agency Approval

Hardin-Davidson Engineering
356 Pollasky Ave., Suite 200, Clovis, CA 93612
559.323.4955 tel • 559.323.4928 fax
www.hardin-davidson.com

Mission Oak HS Aquatic Complex
Tulare Joint Union High School District
Tulare, CA 93274

TYPICAL INFORMATION
FIRE ALARM SYSTEM - SYMBOLS, NOTES, AND DETAILS

ARCHITECTURE PLANNING INTERIORS
www.dardenarchitects.com
6790 N. West Ave. • Fresno, CA 93711 • T. 559.448.8051


No.	Revision/Submission	Date
1	REVISION_01	05/31/2023

Designed By: SD
Copyright © 2022 Darden Architects

Scale: As indicated
Drawn By: HDE
Project Number: 2180
Checked By: SD
Date: 08/02/2022
Reviewed By: SD

X/E201

8/16/2023 4:24:20 PM Z:\Clients\Darden Architects\22068 - Tulare USD Mission Oak HS Aquatic Complex\CAD Files\22068 - 4 Elec_rebid.dwg

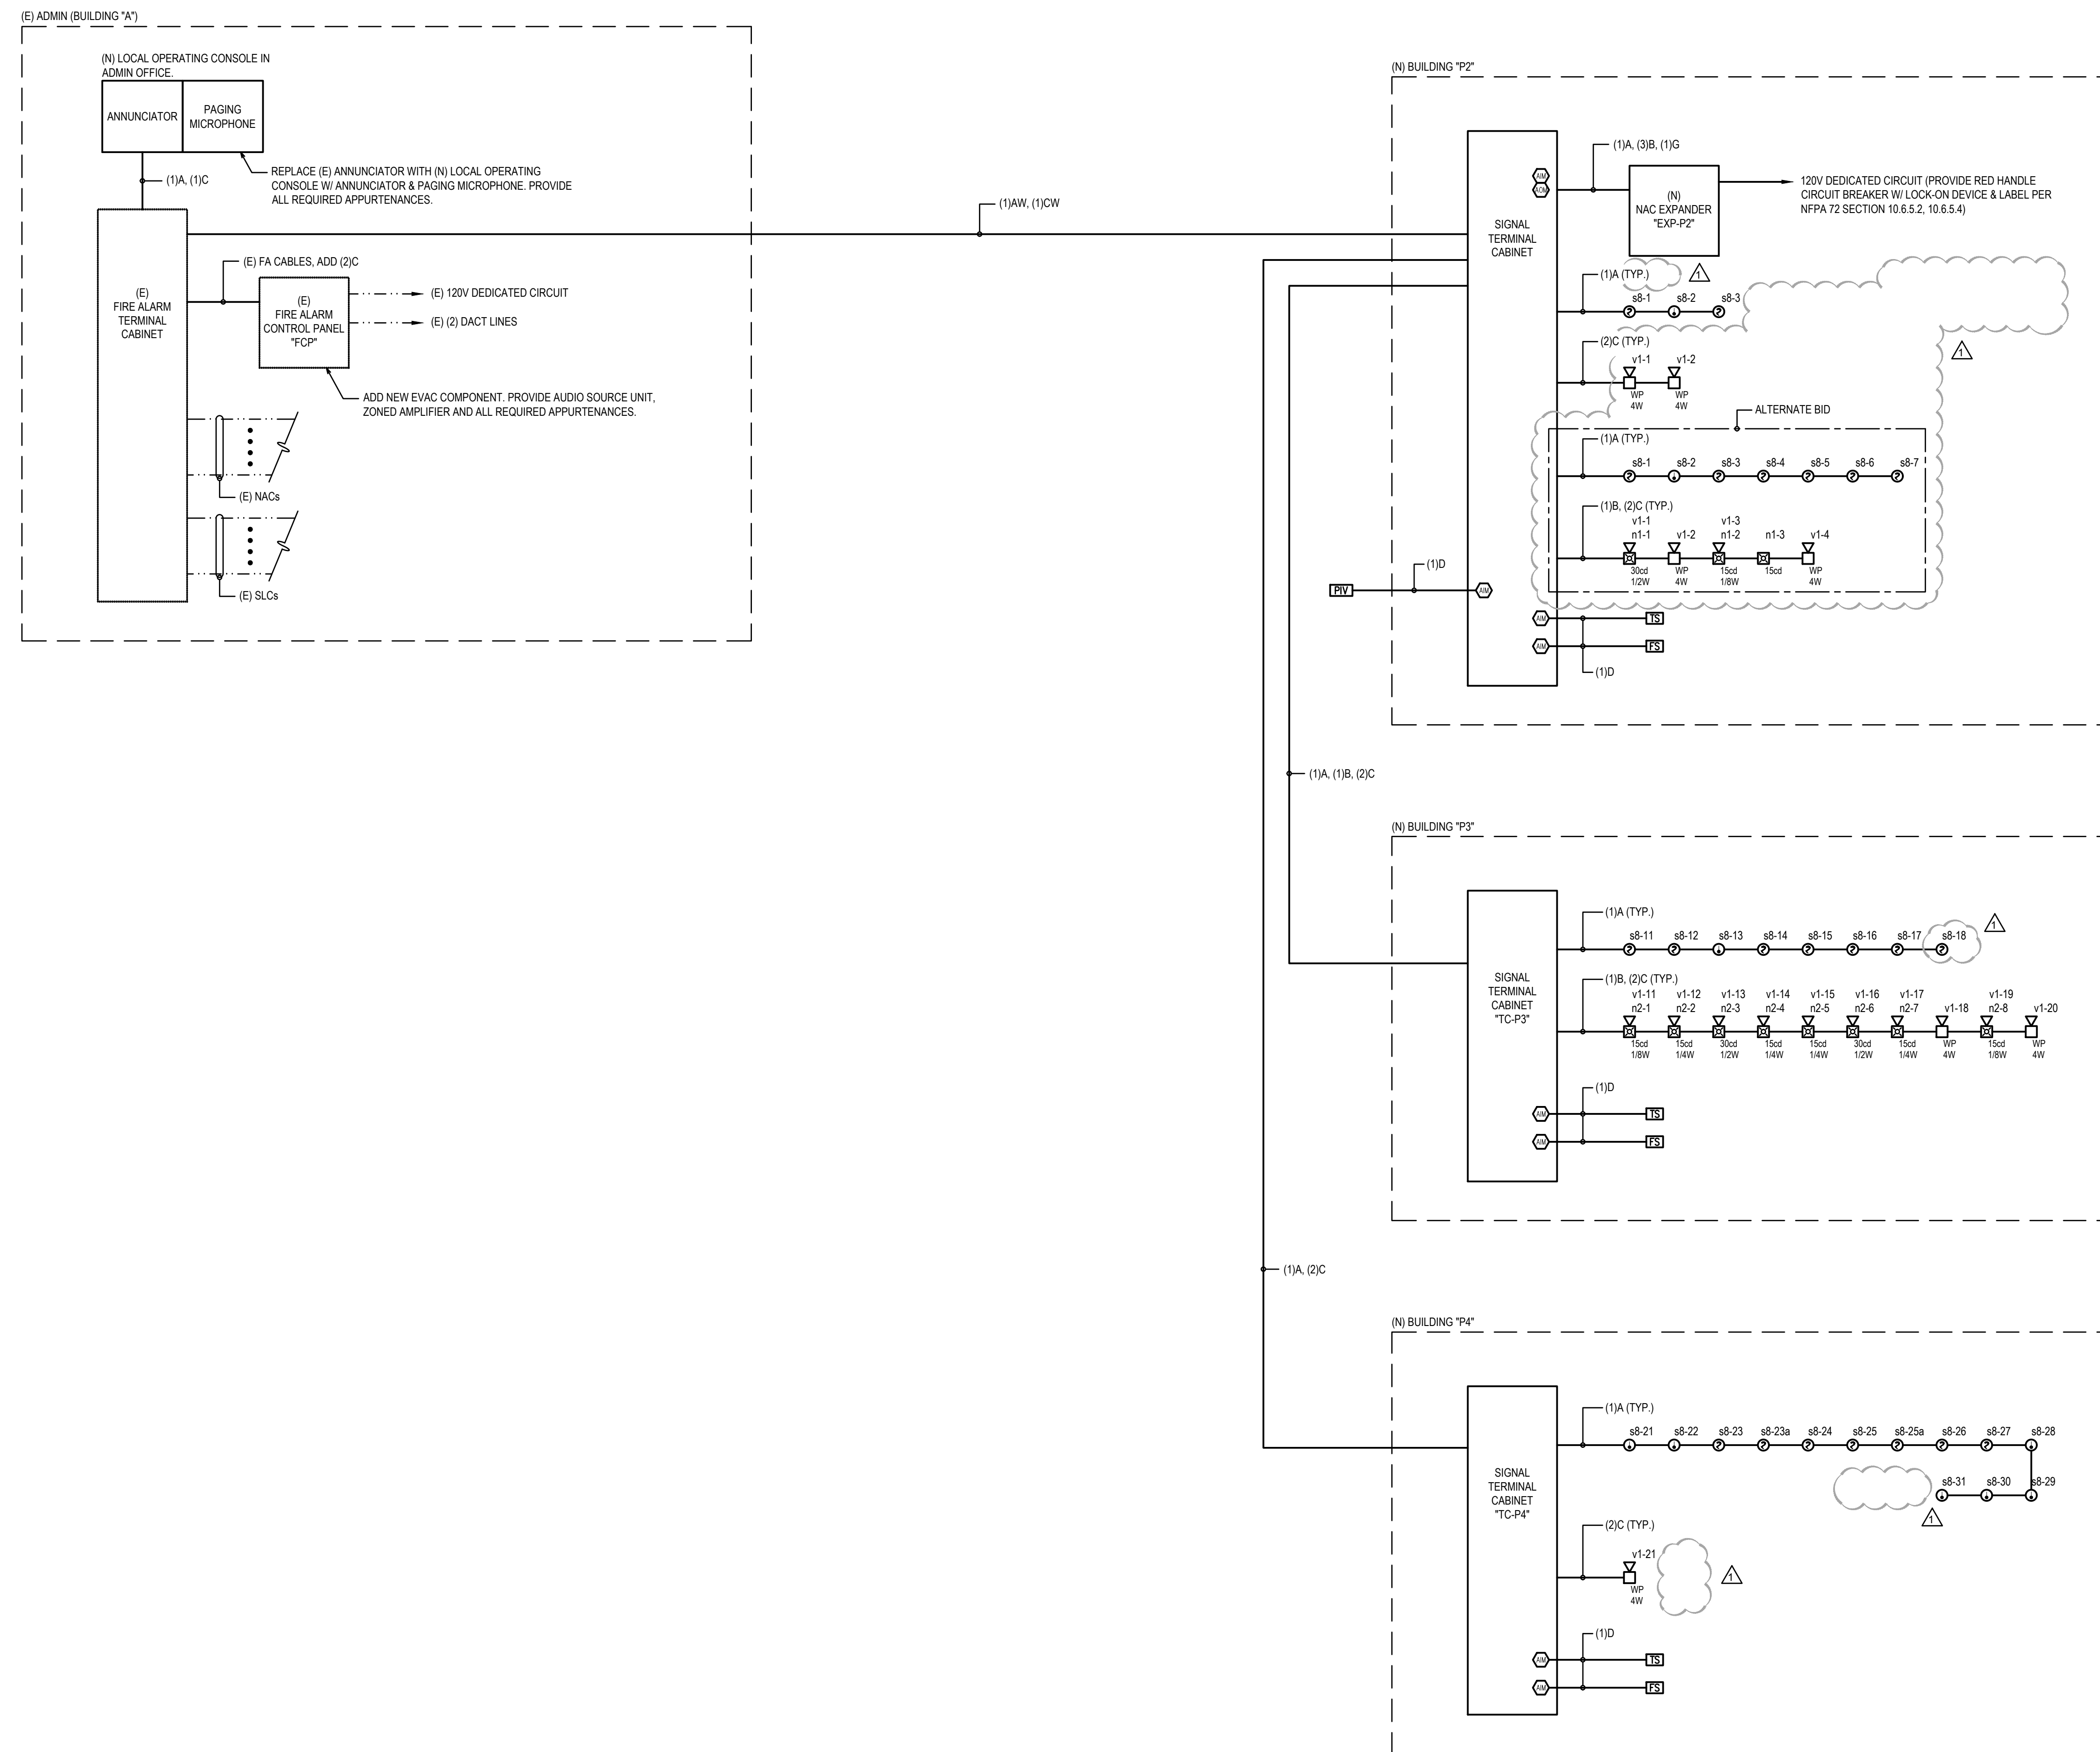

DSA File No.: 54-H11

DSA Application No.: 02-120251

Agency Approval

Hardin-Davidson Engineering
 356 Pollasky Ave., Suite 200, Clovis, CA 93612
 559.323.4955 tel • 559.323.4928 fax
 www.hardin-davidson.com

Consultant

(Professional Engineer Seal: Scott Davidson, E1785, State of California)

Mission Oak HS Aquatic Complex
 Tulare Joint Union High School District
 Tulare, CA 93274

Project

TYPICAL INFORMATION
 FIRE ALARM SYSTEM - SINGLE LINE DIAGRAM
 Drawing

darden architects ARCHITECTURE PLANNING INTERIORS
 www.dardenarchitects.com
 6790 N. West Ave. • Fresno, CA 93711 • T. 559.448.8051

Architect

(Professional Architect Seal: Darden Architects, No. C23724, State of California)

No.	Revision/Submission	Date
1	REVISION_01	05/31/2023
Revision		
Designed By:	SD	Copyright © 2022 Darden Architects
Scale:	As indicated	Drawn By: HDE
Project Number:	2180	Checked By: SD
Date:	08/02/2022	Reviewed By: SD

X/E202

Sheet: _____ of: _____

A1 Fire Alarm System Single Line Diagram

8/16/2023 4:24:20 PM Z:\Clients\Hardin Architects\22068 - Tulare USD Mission Oak HS Aquatic Complex\CAD Files\22068 - 4 Elec_rebid.dwg

BATTERY CALCULATION

(E) F.A. Control Panel 'FCP'

POWER REQUIREMENTS

	CURRENT [A]	
	SUPERVISORY	ALARM
(E) Panel overhead	0.8313	1.0398
(E) NAC Circuits	-	3.1480
3-ASU/4 (Audio Source Unit)	0.0800	0.0800
3-ZA40B (Audio Amplifier)	0.0620	1.1200
3-ANNCP/3 (Annunciator CPU)	0.1440	0.1440
3-LCD (Display Module)	0.0400	0.0420
3-REMICA (Remote Microphone)	0.0640	0.0640
SGA-CT1 (Single Input Module)	0.0003	0.0004
AUDIO Circuit 1	-	0.3147
TOTALS	1.2216	5.9529

BATTERY CAPACITY

SUPERVISORY POWER (24 HOURS)	= 24 Hr * 1.22155A	= 29.317 Ahr
ALARM POWER (15 MINUTES)	= 0.25 Hr * 5.9529100	= 1.488 Ahr
TOTAL POWER REQUIREMENT		30.805 Ahr
MINIMUM BATTERY CAPACITY (includes 25% safety factor)		39 Ahr

VOICE EVACUATION SPEAKER VOLTAGE DROP

Volt Drop Common Parameters

Volts: 70.7
Wire Size: 14 AWG
Wire Resistance: 3.26 ohm/Kft

Type	INDOOR				OUTDOOR				CIRCUIT LENGTH			
	1/8 W	1/4 W	1/2W	1W	2W	1W	2W	4W	8W	Total Watts	Max Length	Actual Length
vf	2	4	2					5		22.25	4083	2485

ALTERNATE BID

BATTERY CALCULATION

(E) F.A. Control Panel 'FCP'

POWER REQUIREMENTS

	CURRENT [A]	
	SUPERVISORY	ALARM
(E) Panel overhead	0.8313	1.0398
(E) NAC Circuits	-	3.1480
3-ASU/4 (Audio Source Unit)	0.0800	0.0800
3-ZA40B (Audio Amplifier)	0.0620	1.1200
3-ANNCP/3 (Annunciator CPU)	0.1440	0.1440
3-LCD (Display Module)	0.0400	0.0420
3-REMICA (Remote Microphone)	0.0640	0.0640
SGA-CT1 (Single Input Module)	0.0003	0.0004
AUDIO Circuit 1	-	3.7182
TOTALS	1.2216	9.3564

BATTERY CAPACITY

SUPERVISORY POWER (24 HOURS)	= 24 Hr * 1.22155A	= 29.317 Ahr
ALARM POWER (15 MINUTES)	= 0.25 Hr * 9.3564A	= 2.339 Ahr
TOTAL POWER REQUIREMENT		31.656 Ahr
MINIMUM BATTERY CAPACITY (includes 25% safety factor)		40 Ahr

VOICE EVACUATION SPEAKER VOLTAGE DROP

Volt Drop Common Parameters

Volts: 70.7
Wire Size: 14 AWG
Wire Resistance: 3.26 ohm/Kft

Type	INDOOR				OUTDOOR				CIRCUIT LENGTH			
	1/8 W	1/4 W	1/2W	1W	2W	1W	2W	4W	8W	Total Watts	Max Length	Actual Length
vf	3	4	3					5		22.875	3971	2485

BATTERY CALCULATION

NAC Expander 'EXP-P2'

POWER REQUIREMENTS

	CURRENT [A]	
	SUPERVISORY	ALARM
Panel Overhead	0.070	0.180
NAC Circuits	-	0.192
TOTALS	0.070	0.372

BATTERY CAPACITY

SUPERVISORY POWER (24 HOURS)	= 24 Hr * 0.07A	= 1.680 Ahr
ALARM POWER (15 MINUTES)	= 0.25 Hr * 0.446A	= 0.112 Ahr
TOTAL POWER REQUIREMENT		1.792 Ahr
MINIMUM BATTERY CAPACITY (includes 25% safety factor)		7 Ahr

VOLTAGE DROP CALCULATION

NAC Circuit 'n2'

VD = Voltage Drop [V]
I = Current [A] (0.192A)
K = 12.9 (Copper Constant)
L = Distance to Load [ft.] (385')
CM = Circular Mils (#12 AWG = 6530)
V = Voltage [V] (24VDC)

$VD = \frac{K * I * 2L}{CM} = \frac{12.9 * 0.192 * 2 * 385}{6530} = 0.292 V$

$VD\% = \frac{VD}{24} = 1.2\%$

BATTERY CALCULATION

NAC Expander 'EXP-P2'

POWER REQUIREMENTS

	CURRENT [A]	
	SUPERVISORY	ALARM
Panel Overhead	0.070	0.180
NAC Circuits	-	0.266
TOTALS	0.070	0.446

BATTERY CAPACITY

SUPERVISORY POWER (24 HOURS)	= 24 Hr * 0.07A	= 1.680 Ahr
ALARM POWER (15 MINUTES)	= 0.25 Hr * 0.446A	= 0.112 Ahr
TOTAL POWER REQUIREMENT		1.792 Ahr
MINIMUM BATTERY CAPACITY (includes 25% safety factor)		7 Ahr

VOLTAGE DROP CALCULATION

NAC Circuit 'n1'

VD = Voltage Drop [V]
I = Current [A] (0.074A)
K = 12.9 (Copper Constant)
L = Distance to Load [ft.] (115')
CM = Circular Mils (#12 AWG = 6530)
V = Voltage [V] (24VDC)

$VD = \frac{K * I * 2L}{CM} = \frac{12.9 * 0.074 * 2 * 115}{6530} = 0.034 V$

$VD\% = \frac{VD}{24} = 0.1\%$

VOLTAGE DROP CALCULATION

NAC Circuit 'n2'

VD = Voltage Drop [V]
I = Current [A] (0.192A)
K = 12.9 (Copper Constant)
L = Distance to Load [ft.] (385')
CM = Circular Mils (#12 AWG = 6530)
V = Voltage [V] (24VDC)

$VD = \frac{K * I * 2L}{CM} = \frac{12.9 * 0.192 * 2 * 385}{6530} = 0.292 V$

$VD\% = \frac{VD}{24} = 1.2\%$

DSA File No.: 54-H11

DSA Application No.: 02-120251

Agency Approval

Hardin-Davidson Engineering
356 Pollasky Ave., Suite 200, Clovis, CA 93612
559.323.4955 tel • 559.323.4928 fax
www.hardin-davidson.com

Consultant



Mission Oak HS Aquatic Complex
Tulare Joint Union High School District
Tulare, CA 93274

Project

TYPICAL INFORMATION
FIRE ALARM SYSTEM - CALCULATIONS

Drawing

Darden Architects
ARCHITECTURE PLANNING INTERIORS
www.dardenarchitects.com
6790 N. West Ave. • Fresno, CA 93711 • T. 559.448.8051

Architect



No.	Revision/Submission	Date
1	REVISION_01	05/31/2023

Revision


Designed By: SD Copyright 2022 Darden Architects

Scale: As indicated Drawn By: HDE
Project Number: 2180 Checked By: SD
Date: 08/02/2022 Reviewed By: SD


X/E203
Sheet: _____ of: _____

8/16/2023 4:24:20 PM Z:\Clients\Darden Architects\2068 - Tulare USD Mission Oak HS Aquatic Complex\CAD Files\22088 - 4 Elec_rebid.dwg


8/16/2023 4:24:56 PM Z:\Clients\Darden Architects\22068 - Tulare USD Mission Oak HS Aquatic Complex\CAD Files\22068 - 4 Elec_rebld.dwg

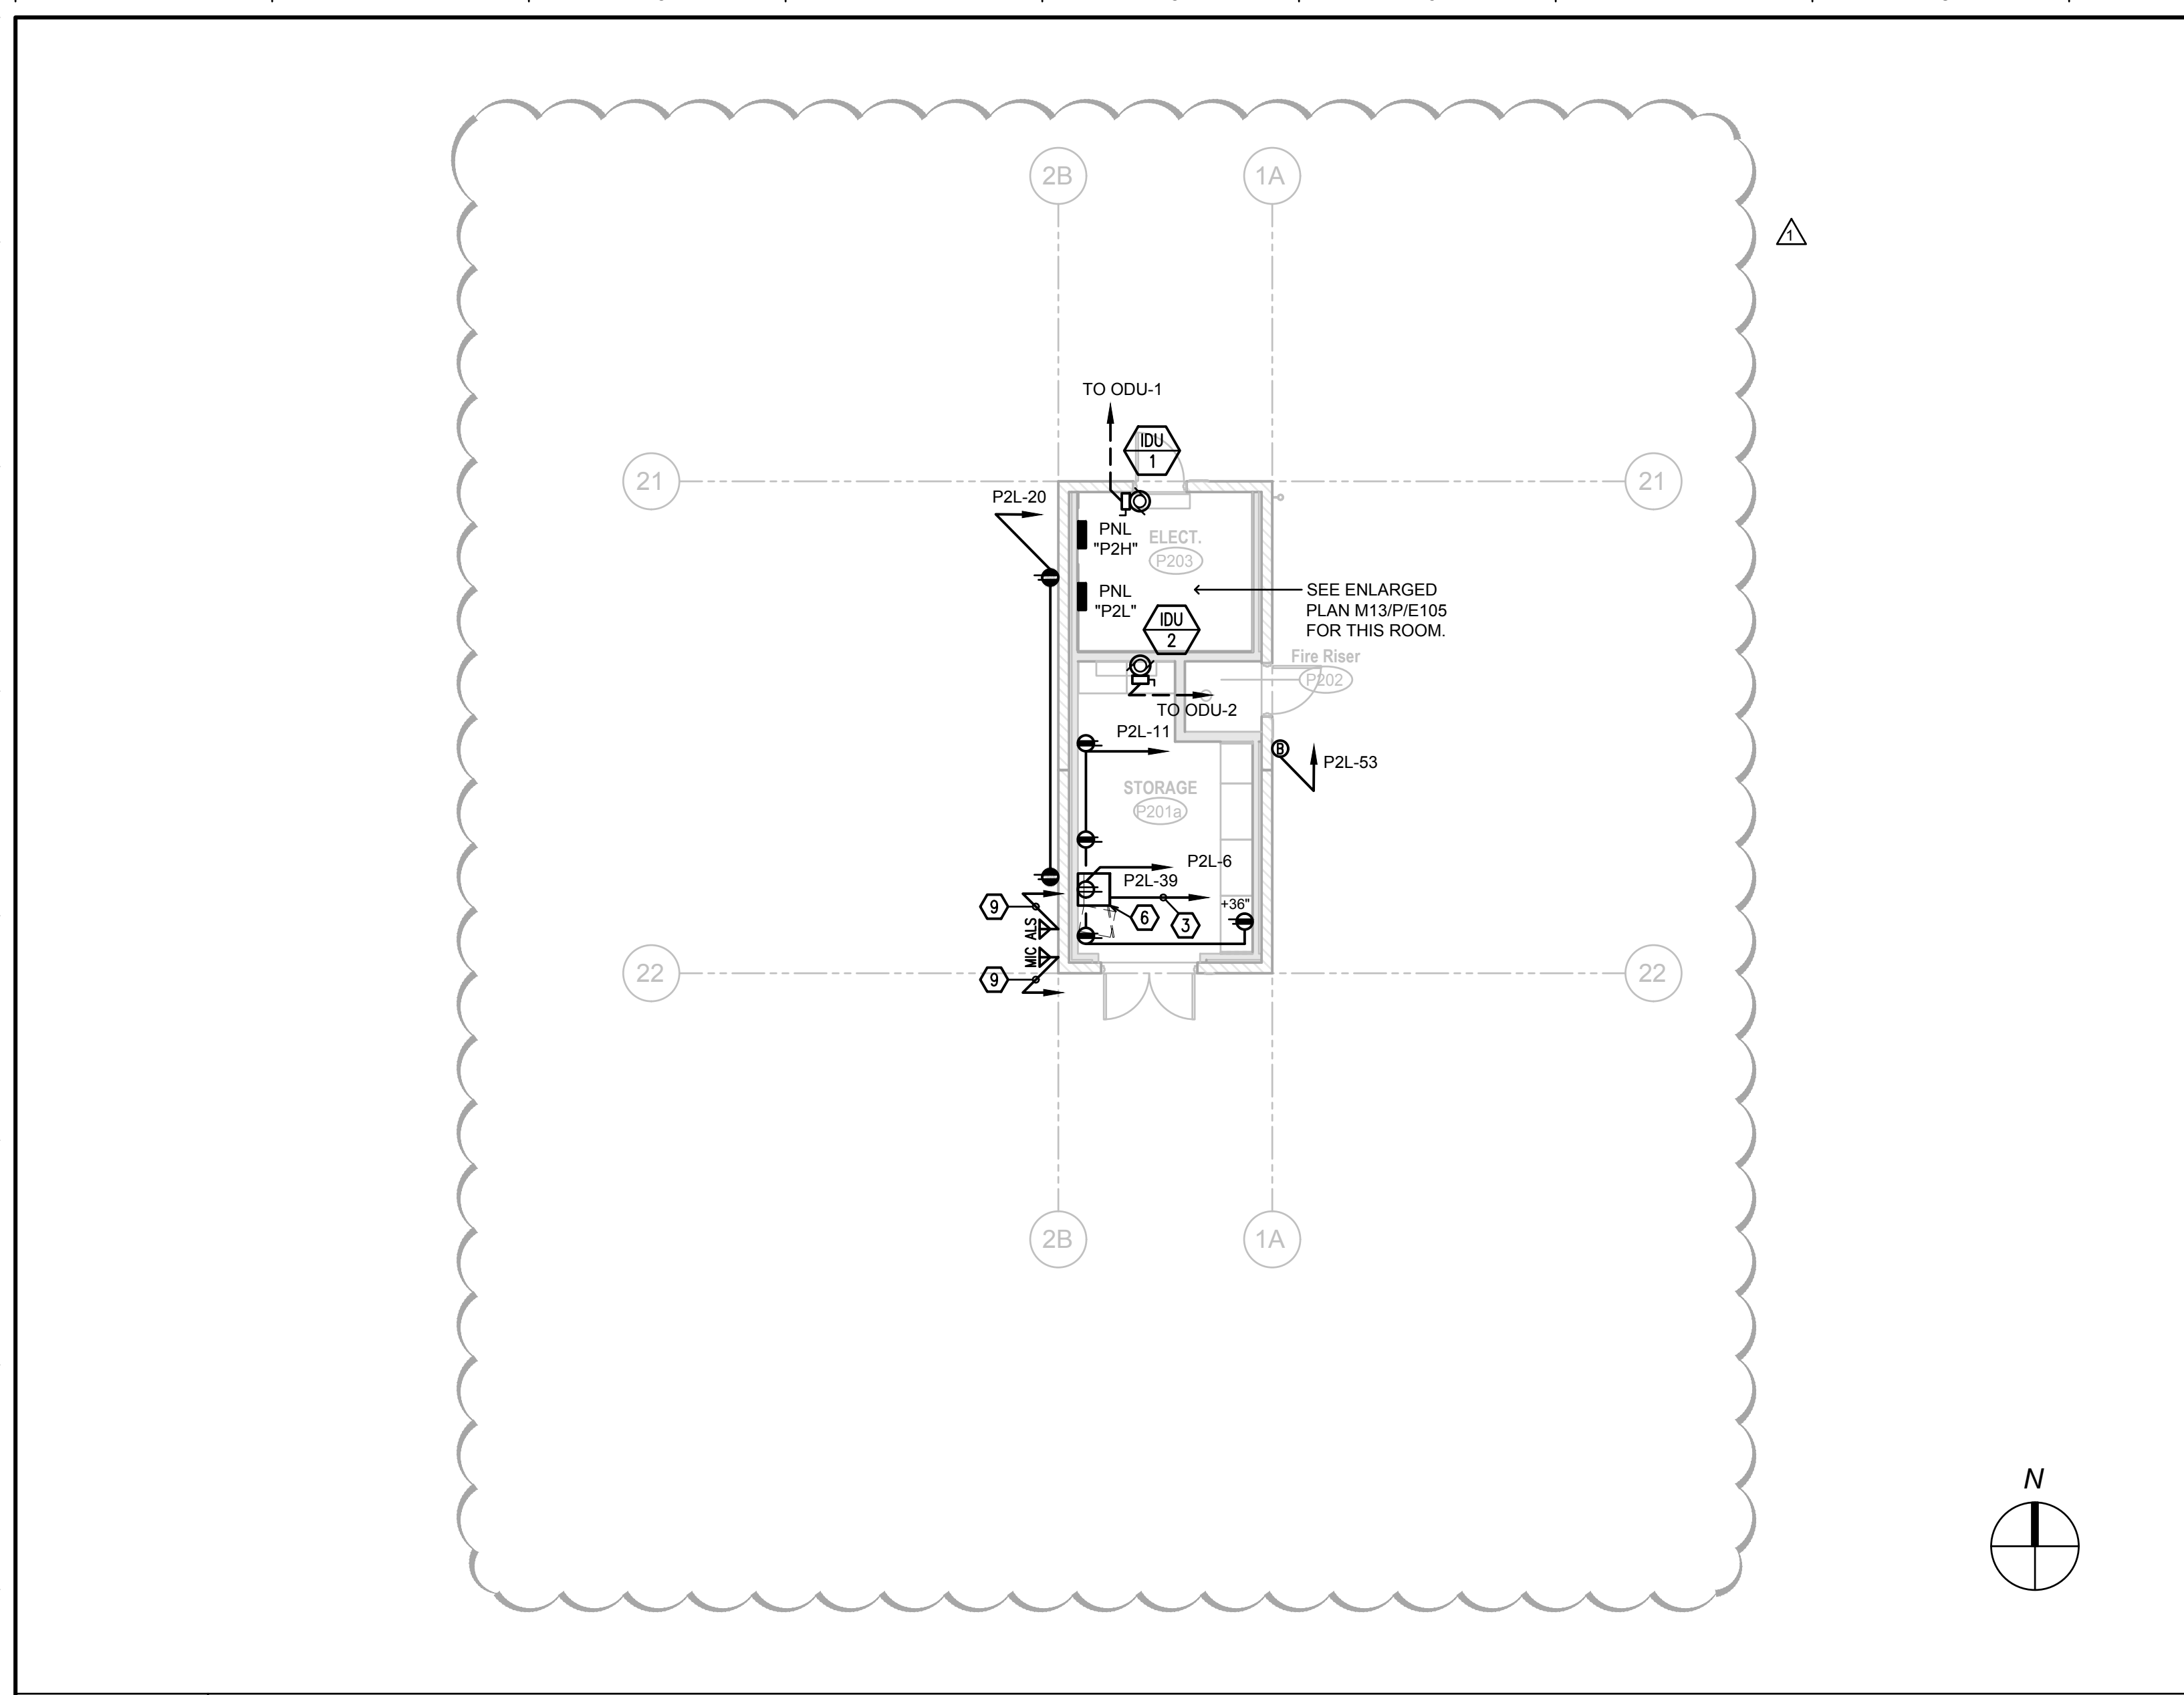

J1 Power & Datacomm Plan - Building P2
1/8" = 1'-0"

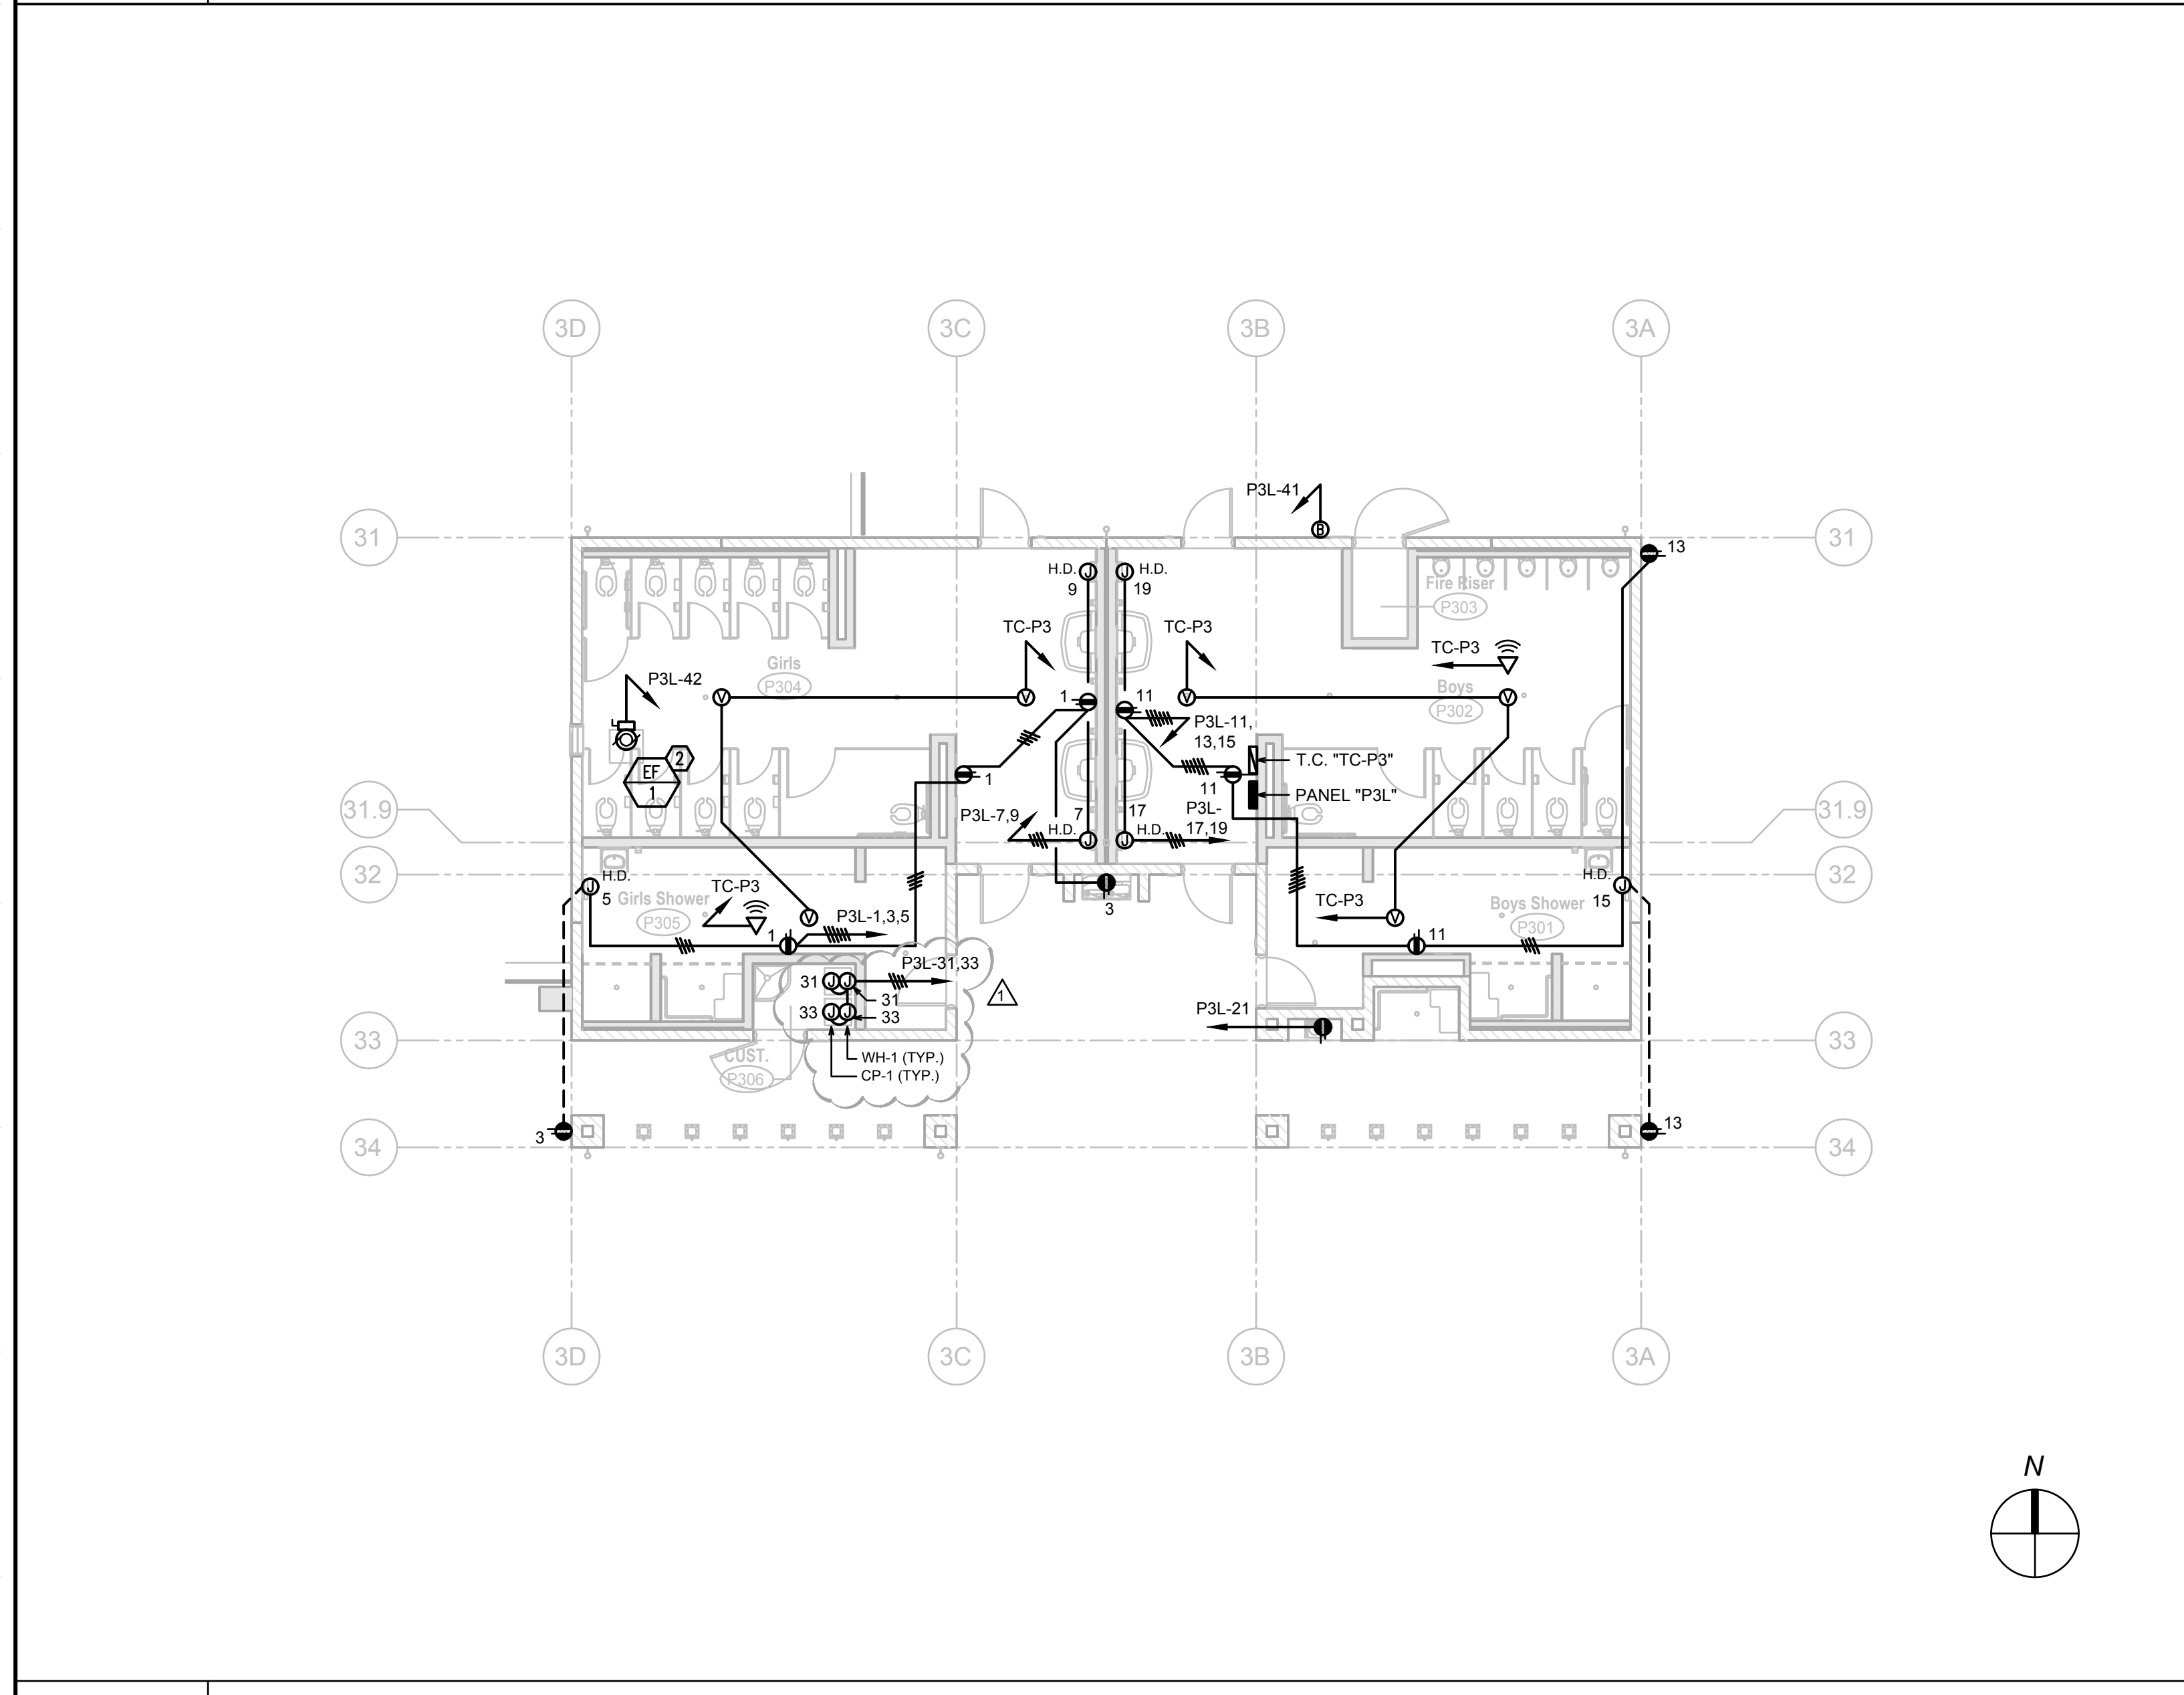

A1 Power & Datacomm Plan - Building P3
1/8" = 1'-0"

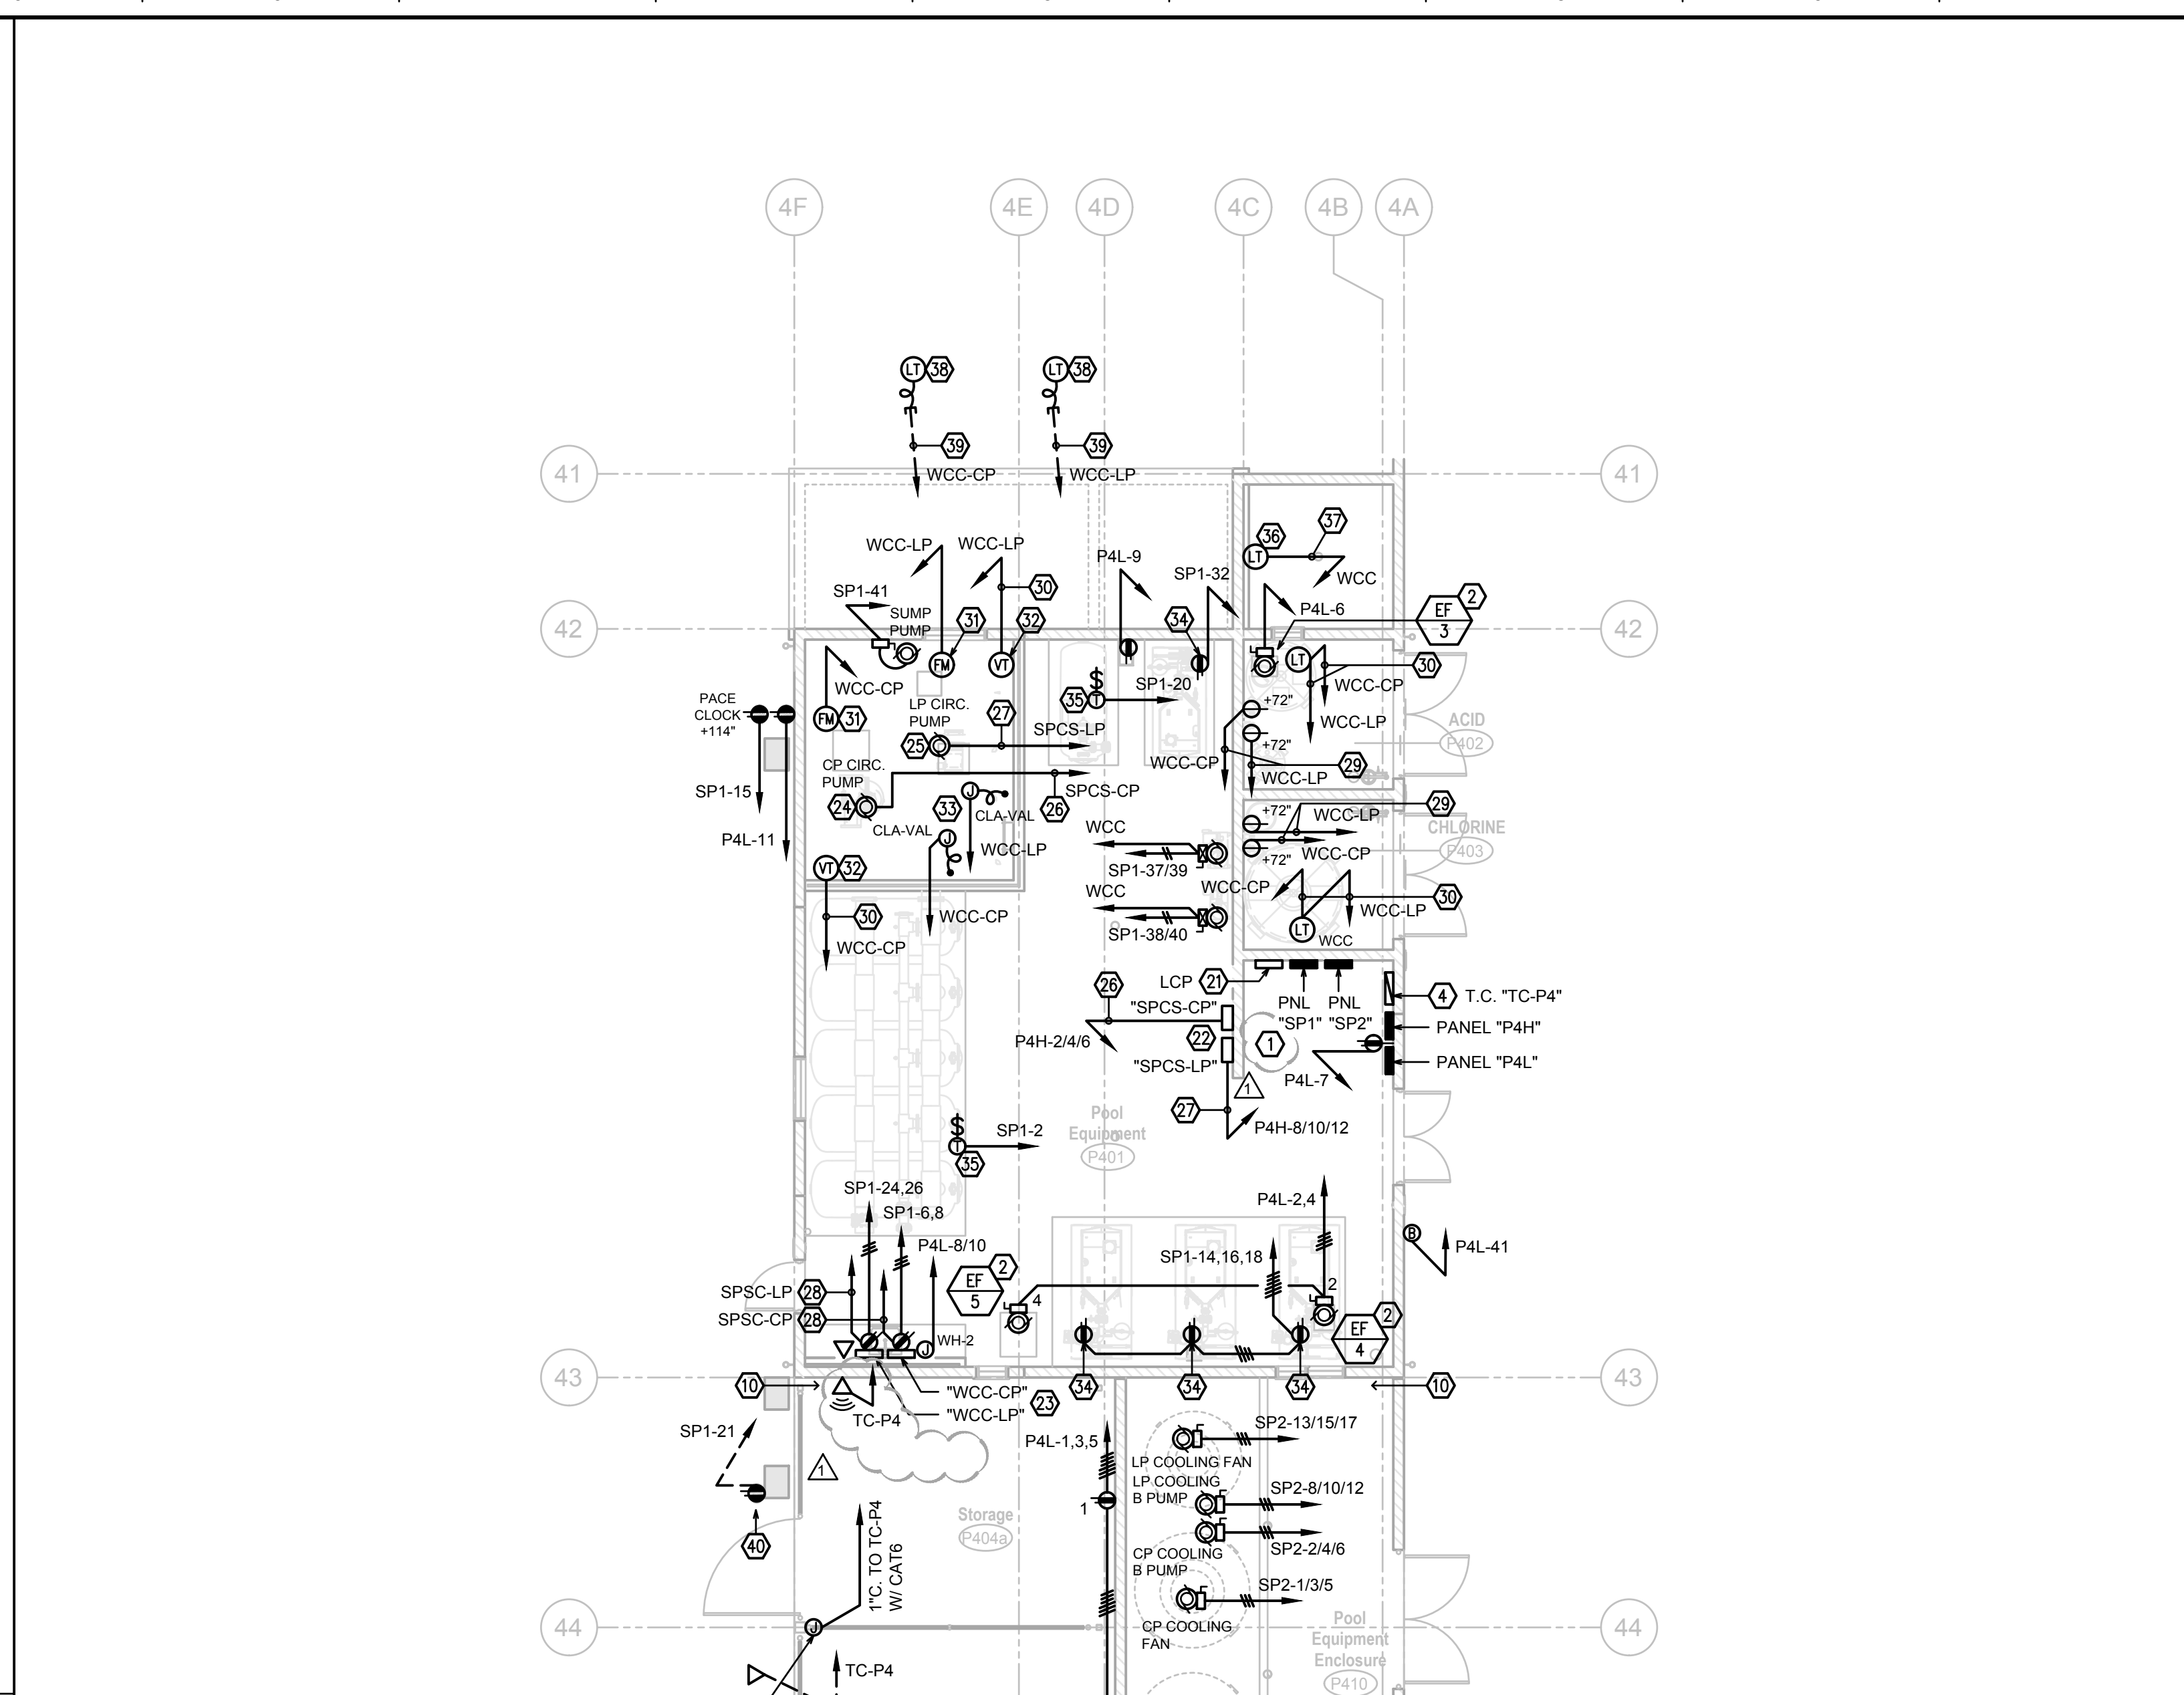

A9 Power & Datacomm Plan - Building P4
1/8" = 1'-0"

DSA File No.: 54-H11

DSA Application No.: 02-120251

Agency Approval

KEYNOTES

1. ALL PANELS, TERMINAL CABINETS, AND OTHER ENCLOSURES IN THIS ROOM SHALL BE STAINLESS STEEL, NEMA 4X.
2. CONNECT EXHAUST FAN AND INTERLOCK CONTROL AS PER MECHANICAL PLANS.
3. 2" TO ELECTRICAL ROOM.
4. 24"W x 24"H x 8"D HIGHED TERMINAL CABINET WITH LOCK HASP.
5. FURNISH AND INSTALL A COMPLETE AND OPERATIONAL AUDIO VISUAL SYSTEM, INCLUDING: SAMSUNG UN60JUB600 OR CURRENT EQUIVALENT TV MONITOR, TV MONITOR MOUNT, EPSON ELPS02 SPEAKERS, AND ALL CABLING, BALLANS, SETUP, CALIBRATION, AND REQUIRED APPURTENANCES. SEE DETAIL A5X/E107.
6. PROVIDE A COMPLETE AND OPERATIONAL POOL AREA AUDIO SYSTEM CONSISTING OF THE FOLLOWING MINIMUM COMPONENTS:
 - 188 LBS. MOUNT CABINET PER L1X/E105
 - POWER DISTRIBUTION UNIT W/ INTEGRAL SURGE SUPPRESSOR
 - SHURE RSCM10 8-CHANNEL MIXER, RACK MOUNT KIT
 - DBX #231S DUAL CHANNEL 31 BAND 1/3 OCTAVE GRAPHIC EQUALIZER, RACK MOUNT KIT
 - ATLAS SCP700 700 WATT AMPLIFIER, RACK MOUNT KIT
 - SHURE AUXS2458 W (2) WIRELESS MICS & RECEIVER, RACK MOUNT KIT, REMOTE MOUNT ANTENNA AT SOUTHWEST CORNER OF ROOF
 - (3) SHURE #5818 WIRELESS MICS W/ 20 FT. CABLES
 - WILLIAMS AV #M 558-24 PRO KIT ALS TRANSCHEVER WITH REMOTE ANTENNA AT SOUTHWEST CORNER OF ROOF, (1) PORTABLE TRANSMITTER, (2) PORTABLE RECEIVERS, (2) EAR BUDS, (6) NECK LOOPS, (2) 12-BAY CHARGERS, RACK MOUNT KIT
 - (2) ATLAS FS12T-68 SPEAKERS MOUNTED AT SCOREBOARD WITH CABLES TO AUDIO CABINET. SEE ARCHITECTURAL PLANS.
 - (2) TOMBSTONE INPUT STATIONS EACH WITH (2) XLR MIC INPUTS AND (1) 1/8" TRS INPUT. SEE SITE PLAN FOR LOCATIONS.
 - ALL REQUIRED CABLING AND INTERCONNECTS.
7. 1" W/ (2) SHIELDED MICROPHONE CABLES AND TRS AUDIO CABLE.
8. RISE CONDUITS AT BACK OF SCOREBOARD. CONNECT POWER AND DATA.
9. 1" TO AUDIO SYSTEM CABINET.
10. SEISMIC SEPARATION. PROVIDE LISTED SEISMIC DEFLECTION/ EXPANSION FITTINGS ON CONDUITS CROSSING THE SEPARATION.
21. POOL LIGHTS CONTACTOR PANEL. SEE SHEET MR-1.
22. SMART PUMP CONTROL VARIABLE SPEED DRIVE SYSTEM "SPCS-CP" AND "SPCS-LP".
23. WATER CHEMISTRY CONTROLLER "WCC-CP" AND "WCC-LP".
24. CONNECT CIRCULATION PUMP: 480V 3Ø, 50HP TO CIRCUIT P4H-2/4/6 WITH 1 1/4" 3Ø, 1#0G.
25. CONNECT CIRCULATION PUMP: 480V 3Ø, 7.5HP TO CIRCUIT P4H-8/10/12 WITH 3/4" 3Ø, 1#0G.
26. 1 1/4" 3Ø, 1#0G.
27. 3/4" 3Ø, 1#10G.
28. 3/4" 4Ø, 1#12G.
29. 1/2" 2Ø, 1#12G.
30. 1/2" 1Ø, 2TSP.
31. CONNECT FLOW METER.
32. CONNECT VACUUM TRANSMITTER.
33. CONNECT CLA-VAL SOLENOID.
34. VERIFY OUTLET LOCATION FOR HEATER PRIOR TO ROUGH-IN.
35. 120V-24VAC TRANSFORMER PER FILTRATION CONTROLLER SPECS.
36. CONNECT BACKWASH PIT LEVEL SENSOR.
37. 1/2" 1Ø, 2.
38. STUB INTO SURGE CHAMBER NEAR STILLING PIPE AND CONNECT LEVEL.
39. 1" 1Ø, 2TSP.
40. MOUNT DEVICE ON THE COLUMN.

POWER & SYSTEMS NOTES

1. ALL WORK AT THE POOLS AND RELATED POOL EQUIPMENT SHALL CONFORM WITH CEC ARTICLE 680. REFER TO AQUATIC DESIGN GROUP DRAWINGS AND SPECIFICATIONS FOR ADDITIONAL ELECTRICAL WORK (E.G., POOL LIGHTING, TIMING EQUIPMENT, GROUNDING, ETC.) AT THE POOLS AND RELATED EQUIPMENT ROOMS.
2. ALL RACEWAYS, COUPLINGS, STRAPS, ANCHORS, AND WIRING IN POOL EQUIPMENT ROOM, ACID, CHLORINE, AND POOL EQUIPMENT ENCLOSURE SHALL CONFORM TO CEC ARTICLE 680.14 AND SHALL BE UL LISTED AND ETL VERIFIED FOR SUCH USE. THE EXPOSED ELECTRICAL INSTALLATION SHALL BE FINISHED WITH PVC ANTI-CORROSIVE COATINGS. ALL UNISTRUTS SHALL HAVE A DEFENDER FINISH.
3. ALL CONDUIT PENETRATIONS THROUGH CMU WALLS SHALL BE PER DETAIL E110S/104.

HD
Hardin-Davidson Engineering
 356 Polasky Ave., Suite 200, Clovis, CA 93612
 559.323.4995 tel • 559.323.4928 fax
 www.hardin-davidson.com
 Consultant

Mission Oak HS Aquatic Complex
 Tulare Joint Union High School District
 Tulare, CA 93274
 Project



BUILDINGS P2, P3, P4
 POWER & DATACOMM PLANS
 Drawing

darden architects
 ARCHITECTURE
 PLANNING
 INTERIORS
 www.dardenarchitects.com
 6790 N. West Ave. • Fresno, CA 93711 • T. 559.448.8051
 Architect

No.	Revision/Submission	Date
1	REVISION_01	05/31/2023
Revision		
Designed By:	SD	Copyright 2022 Darden Architects
Scale:	As indicated	Drawn By: HDE
Project Number:	2180	Checked By: SD
Date:	08/02/2022	Reviewed By: SD



P/E102

Sheet: _____ of: _____

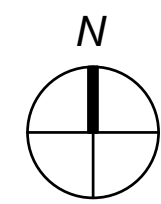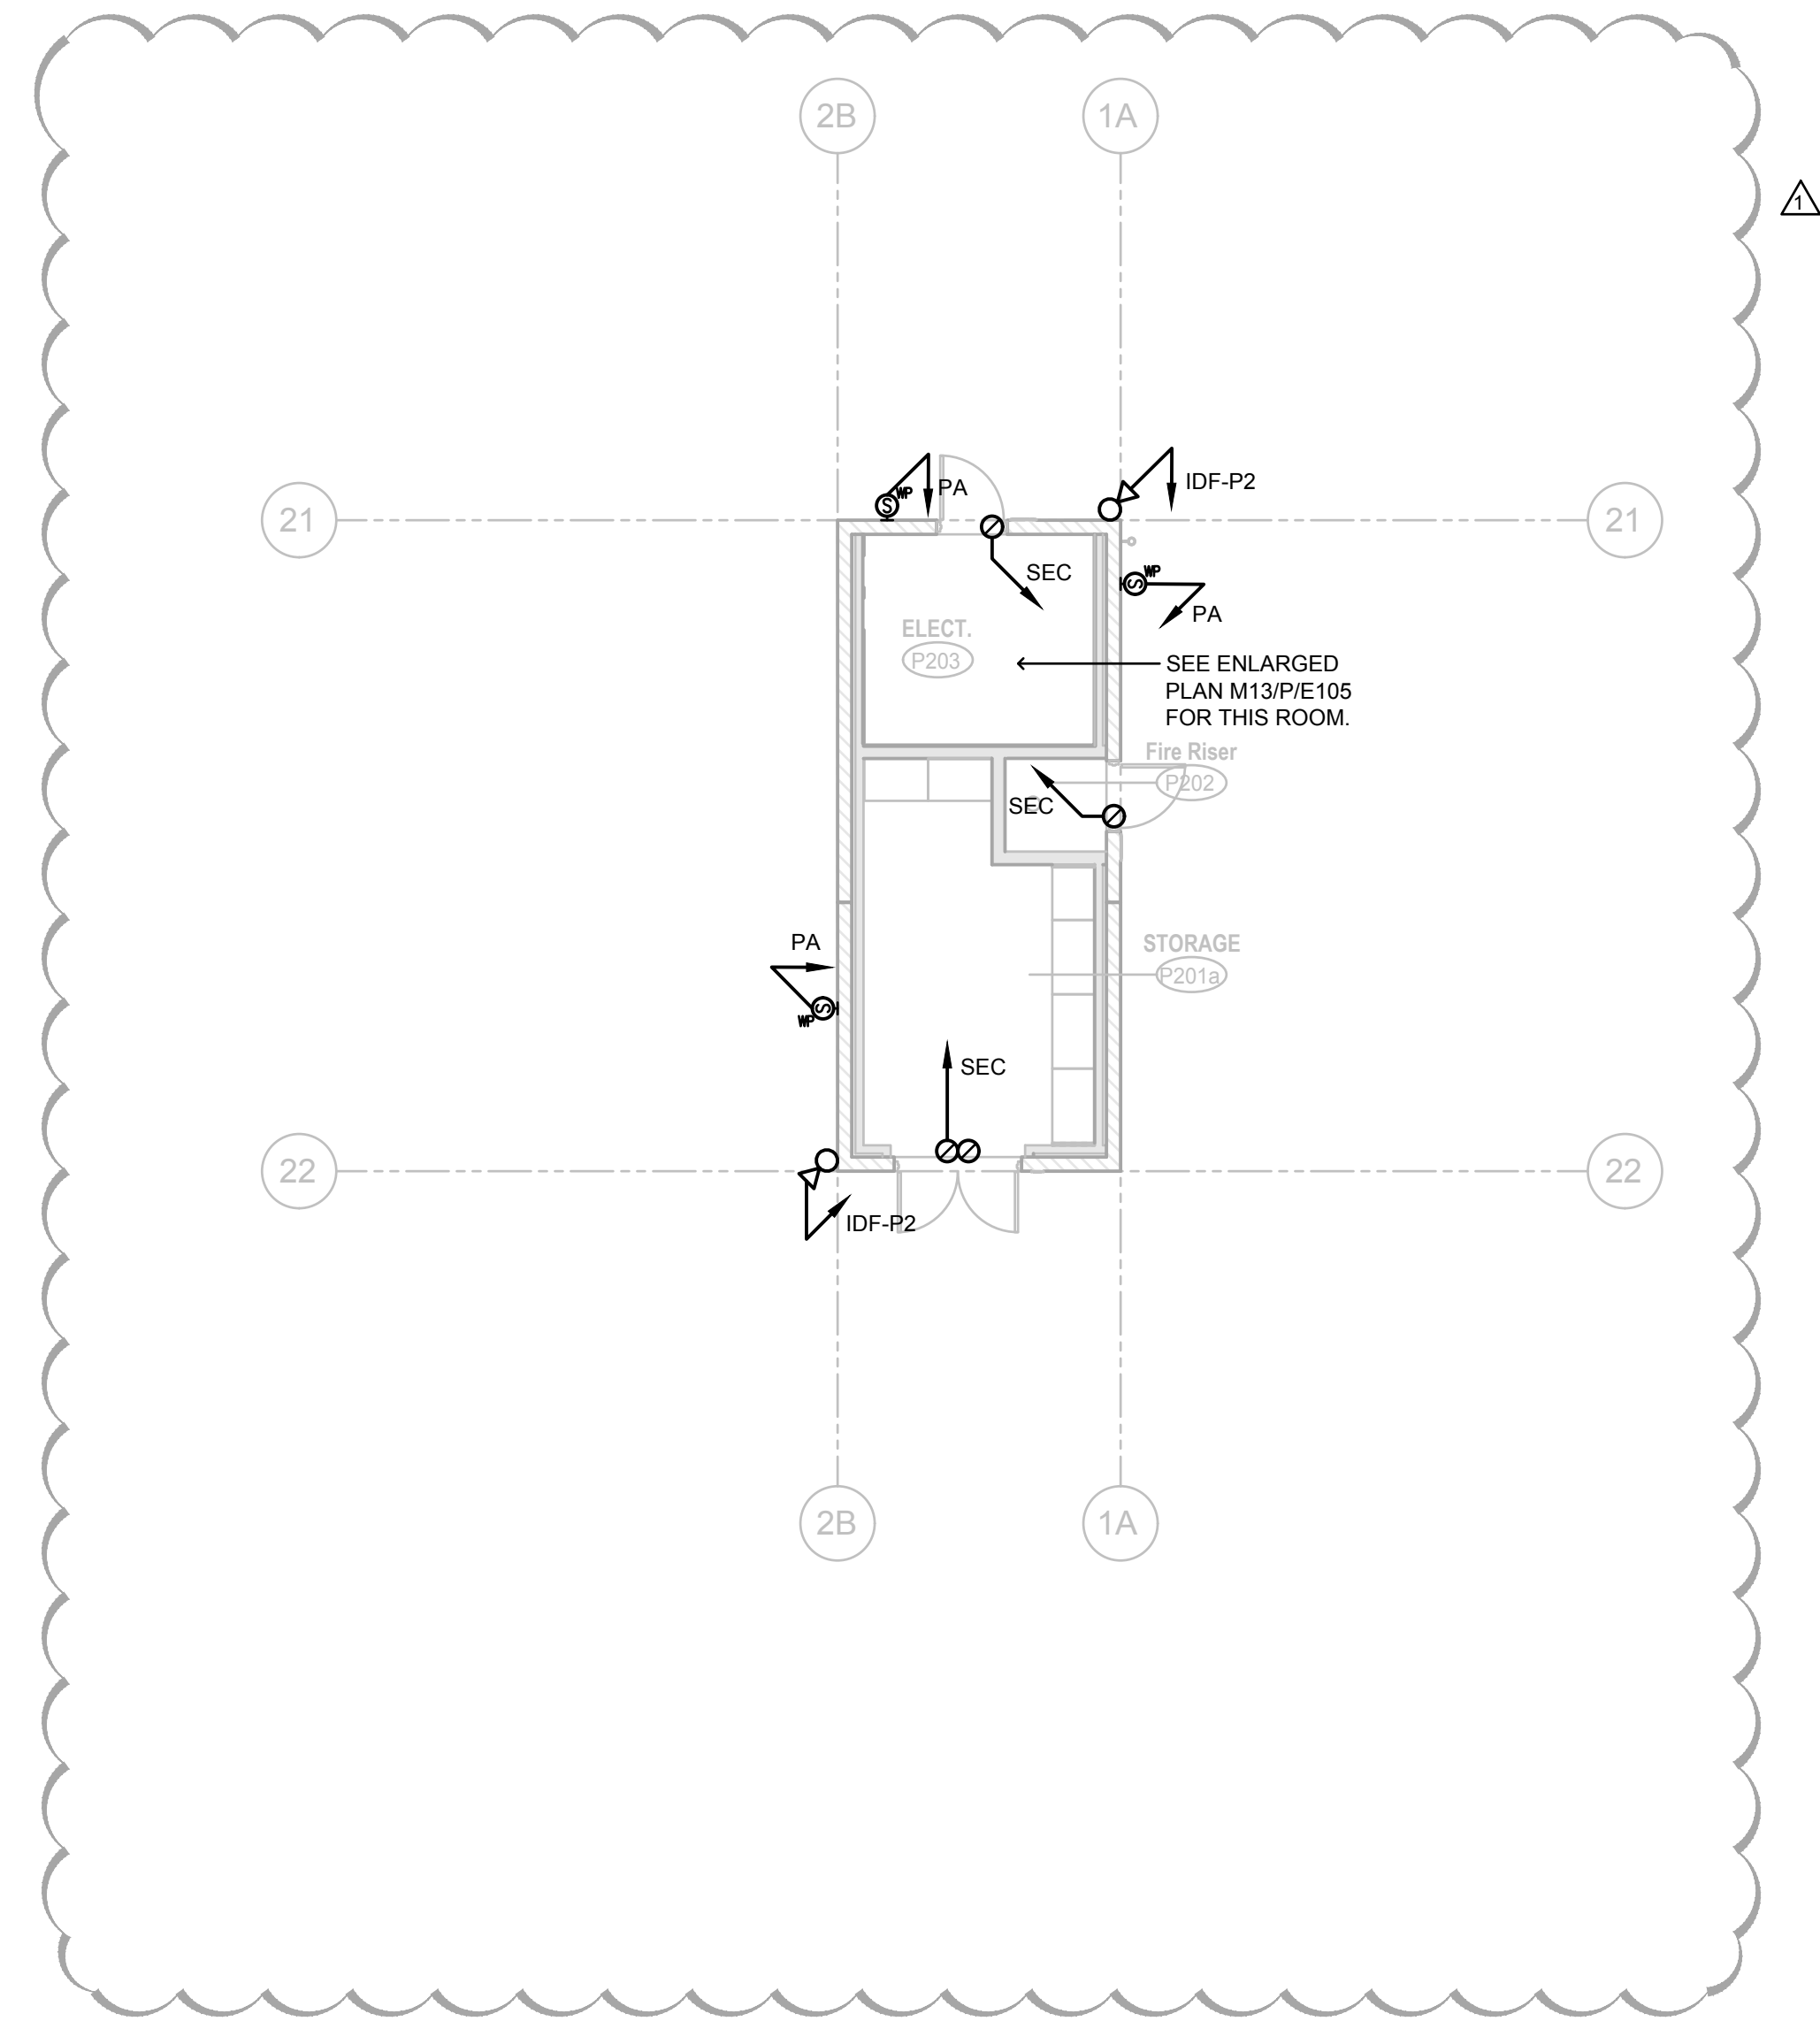



J1 PA & Intrusion Systems Plan - Building P2

1/8" = 1'-0"

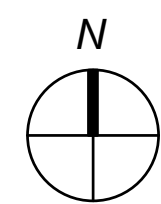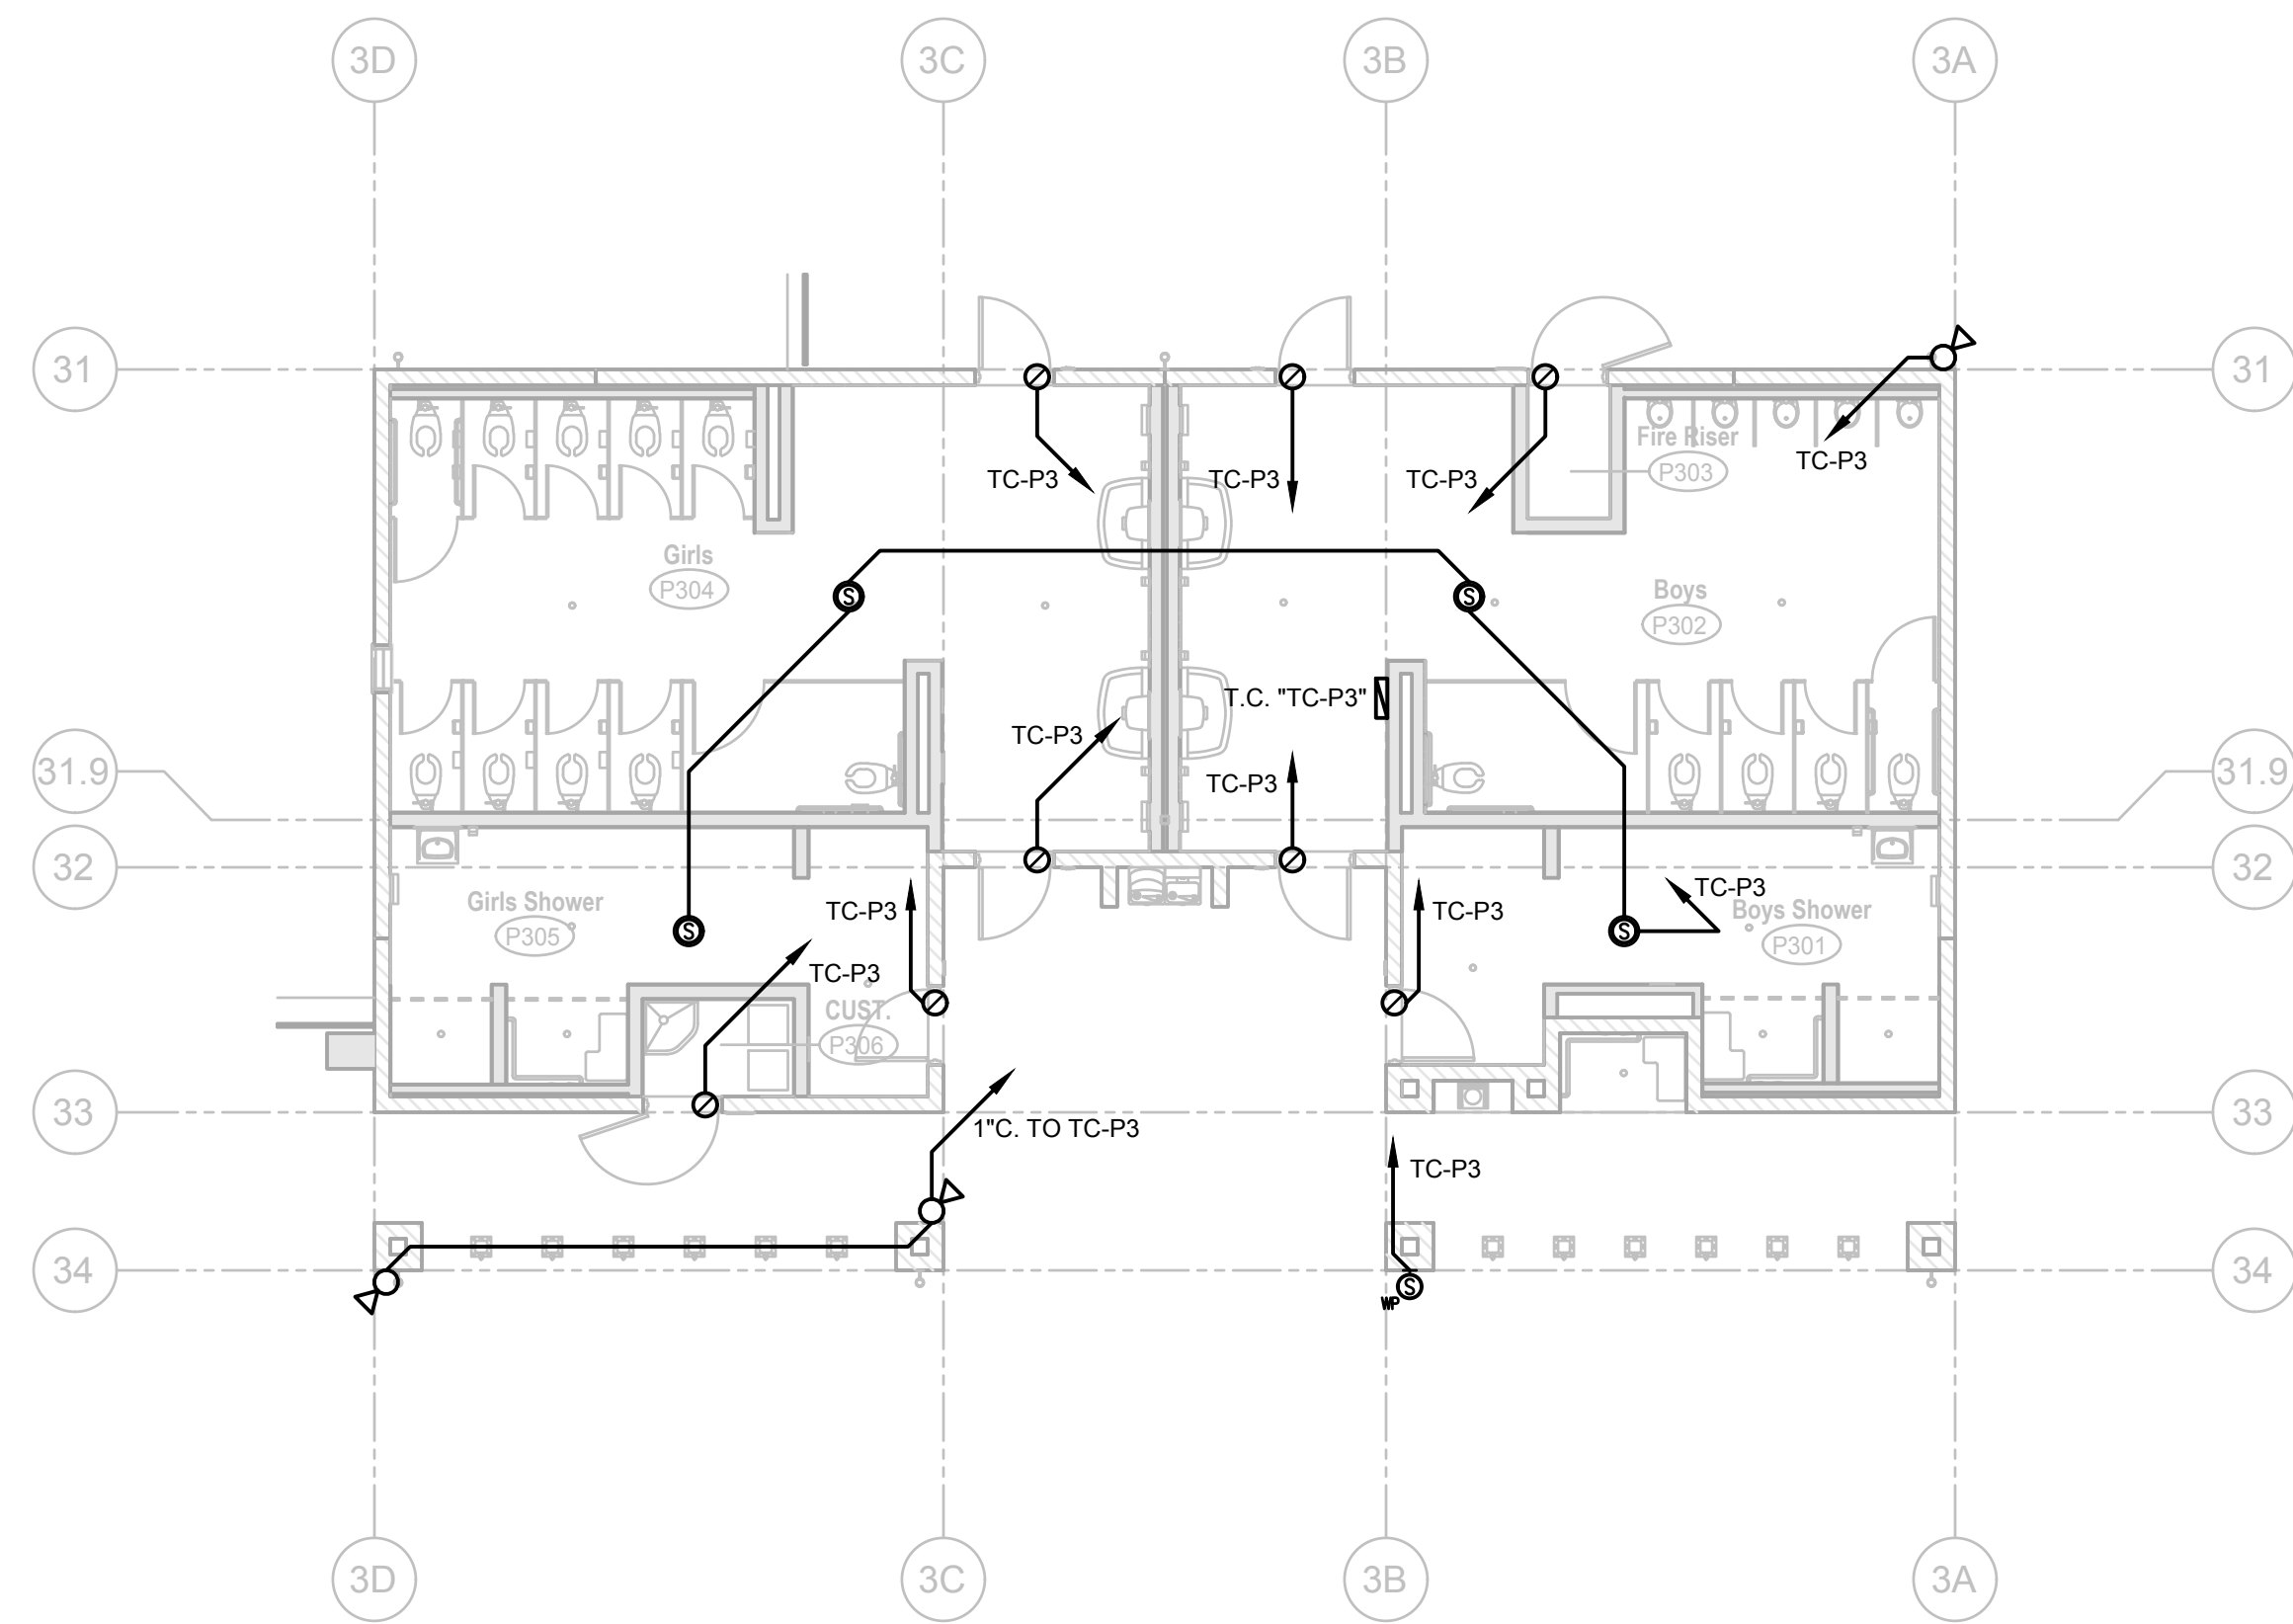

A1 PA & Intrusion Systems Plan - Building P3

1/8" = 1'-0"

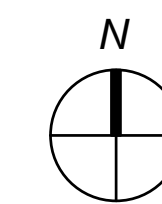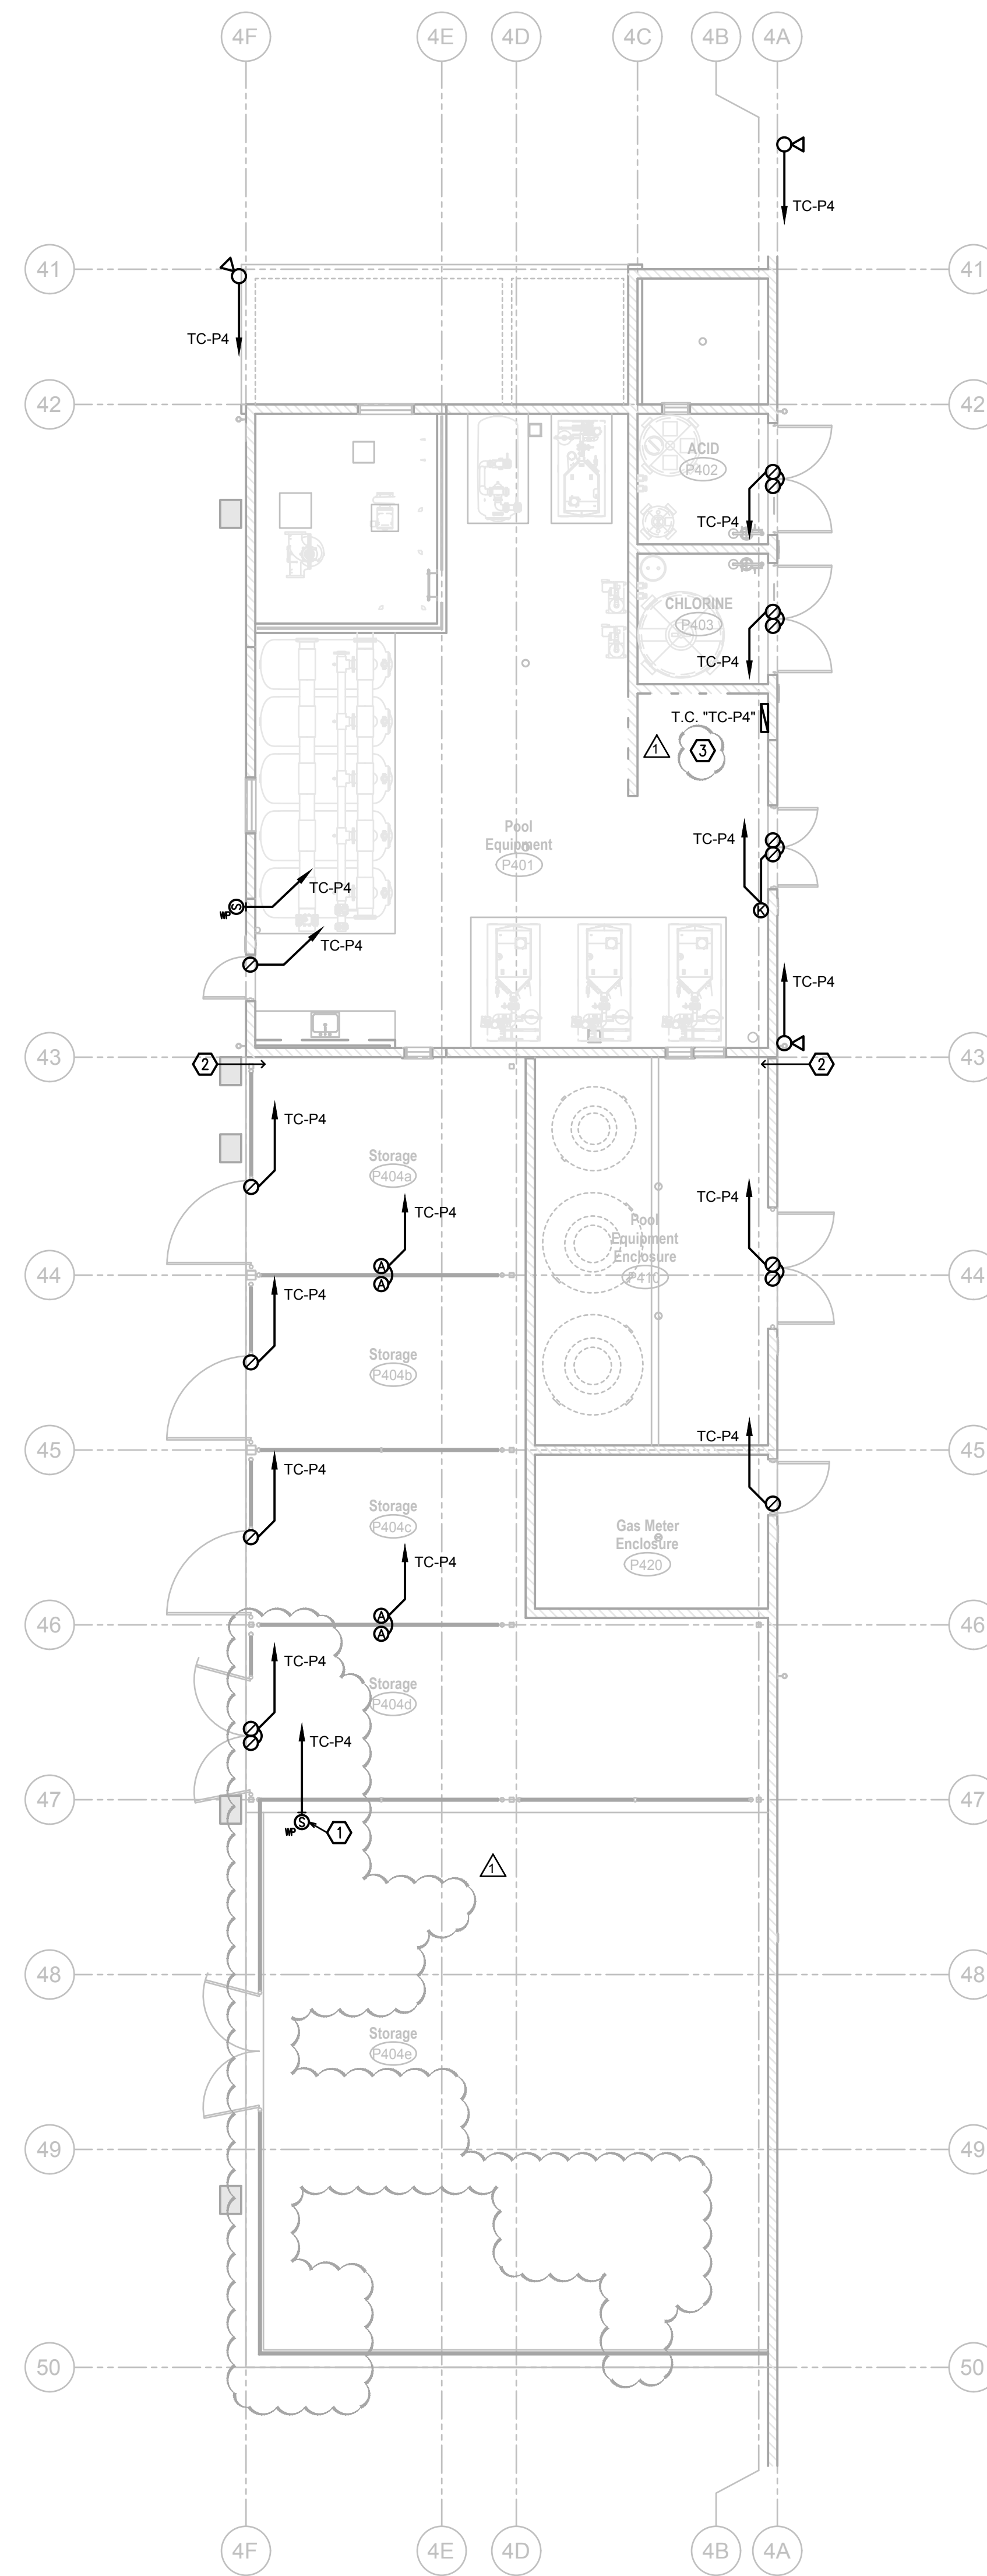

A9 PA & Intrusion Systems Plan - Building P4

1/8" = 1'-0"

DSA File No.: 54-H11

DSA Application No.: 02-120251

Agency Approval

KEYNOTES


1. MOUNT DEVICE ON THE STEEL PLATE. SEE ARCHITECTURAL DETAIL N11/PIA04
2. SEISMIC SEPARATION. PROVIDE LISTED SEISMIC DEFLECTION/EXPANSION/FITTINGS ON CONDUITS CROSSING THE SEPARATION.
3. ALL PANELS, TERMINAL CABINETS, AND OTHER ENCLOSURES IN THIS ROOM SHALL BE STAINLESS STEEL, NEMA 4X

POWER & SYSTEMS NOTES

1. ALL WORK AT THE POOLS AND RELATED POOL EQUIPMENT SHALL CONFORM WITH CEC ARTICLE 680. REFER TO AQUATIC DESIGN GROUP DRAWINGS AND SPECIFICATIONS FOR ADDITIONAL ELECTRICAL WORK (E.G. POOL LIGHTING, TIMING EQUIPMENT, GROUNDING, ETC.) AT THE POOLS AND RELATED EQUIPMENT ROOMS.
2. ALL RACEWAYS, COUPLINGS, STRAPS, ANCHORS, AND WIRING IN POOL EQUIPMENT ROOM, ACID, CHLORINE, AND POOL EQUIPMENT ENCLOSURE SHALL CONFORM TO CEC ARTICLE 680.14 AND SHALL BE UL LISTED AND ETL VERIFIED FOR SUCH USE. THE EXPOSED ELECTRICAL INSTALLATION SHALL BE FINISHED WITH PVC ANTI-CORROSIVE COATINGS. ALL UNISTRUTS SHALL HAVE A DEFENDER FINISH.
3. ALL CONDUIT PENETRATIONS THROUGH CMU WALLS SHALL BE PER DETAIL E11X/S104.




Hardin-Davidson Engineering
356 Pollasky Ave., Suite 200, Clovis, CA 93612
559.323.4995 tel • 559.323.4928 fax
www.hardin-davidson.com

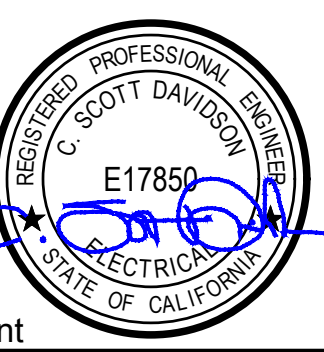

Mission Oak HS Aquatic Complex
Tulare Joint Union High School District
Tulare, CA 93274

BUILDINGS P2, P3, P4
PA & INTRUSION SYSTEMS PLANS

darden architects ARCHITECTURE PLANNING INTERIORS
www.dardenarchitects.com
6790 N. West Ave. • Fresno, CA 93711 • T. 559.448.8051

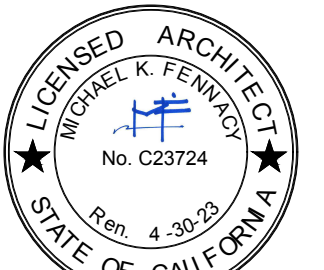

No.	Revision/Submission	Date
1	REVISION_01	05/31/2023


Revision
Designed By: SD Copyright 2022 Darden Architects

Scale: As indicated Drawn By: HDE
Project Number: 2180 Checked By: SD
Date: 08/02/2022 Reviewed By: SD

P/E103


Sheet: _____ of: _____

8/16/2023 4:24:58 PM Z:\Clients\Hardin Architects\22068 - Tulare USD Mission Oak HS Aquatic Complex\CAD Files\22068 - 4 Elec_rebld.dwg

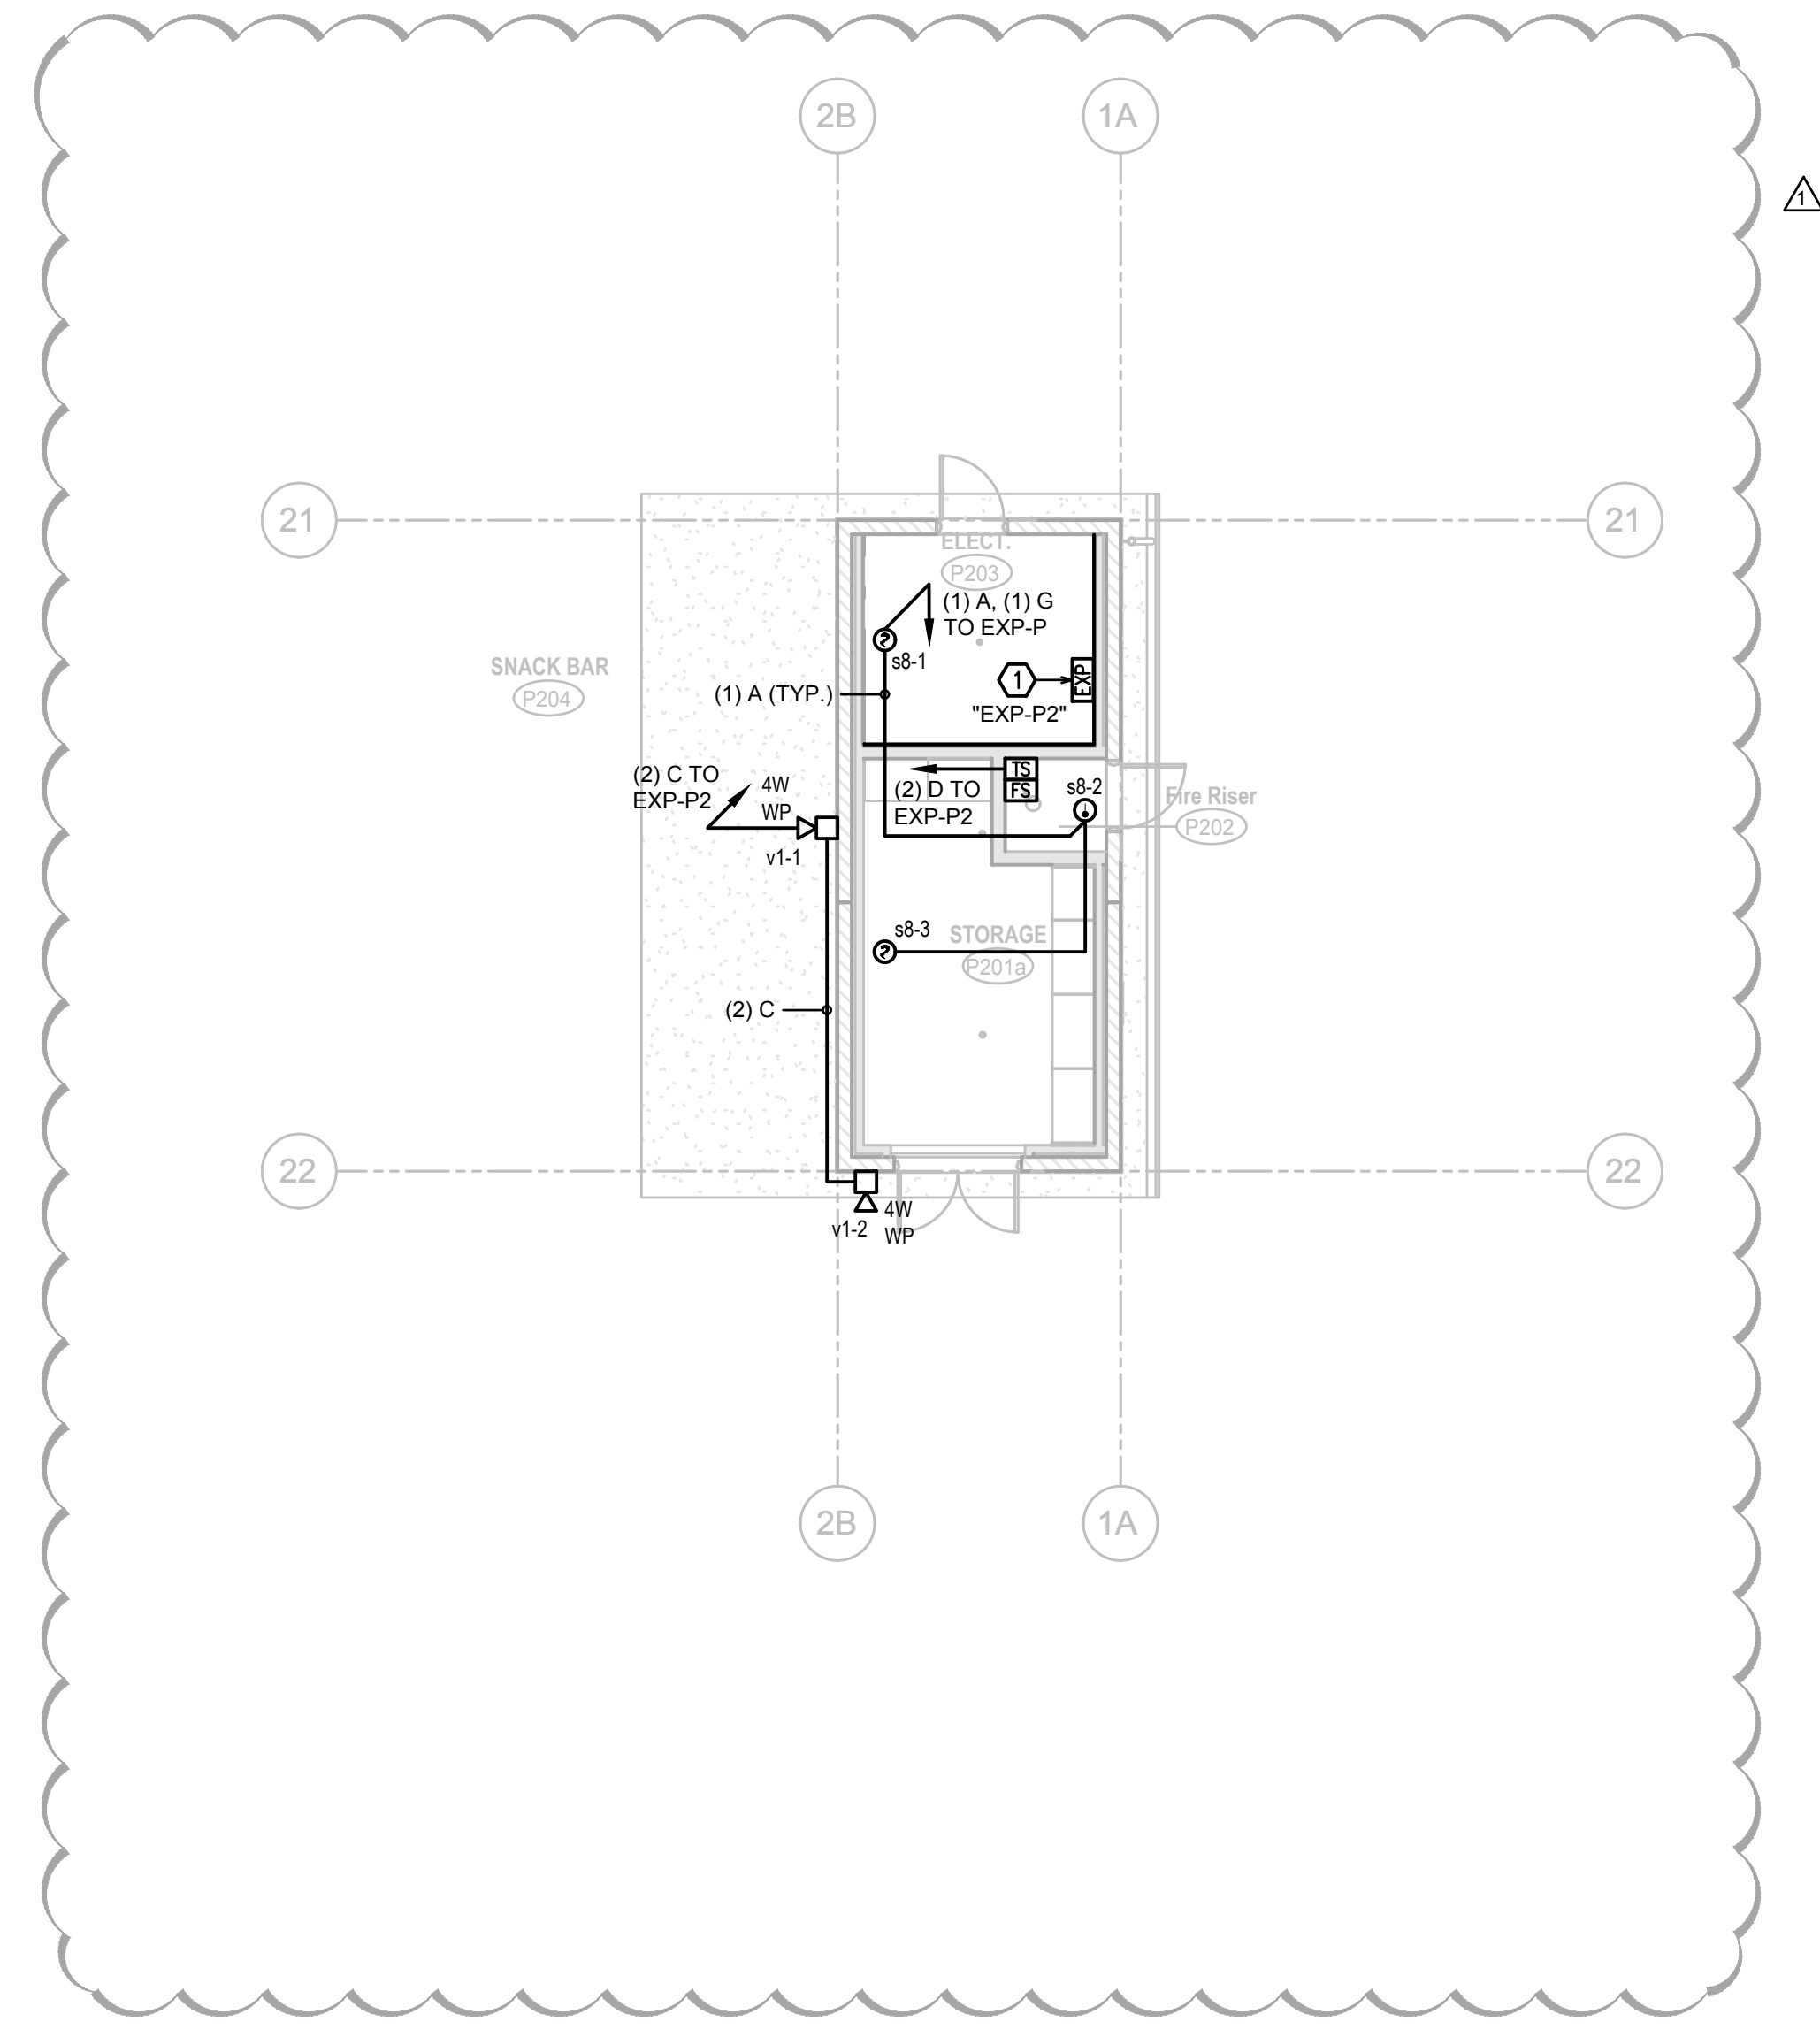


J1 Fire Alarm Plan - Building P2

1/8" = 1'-0"

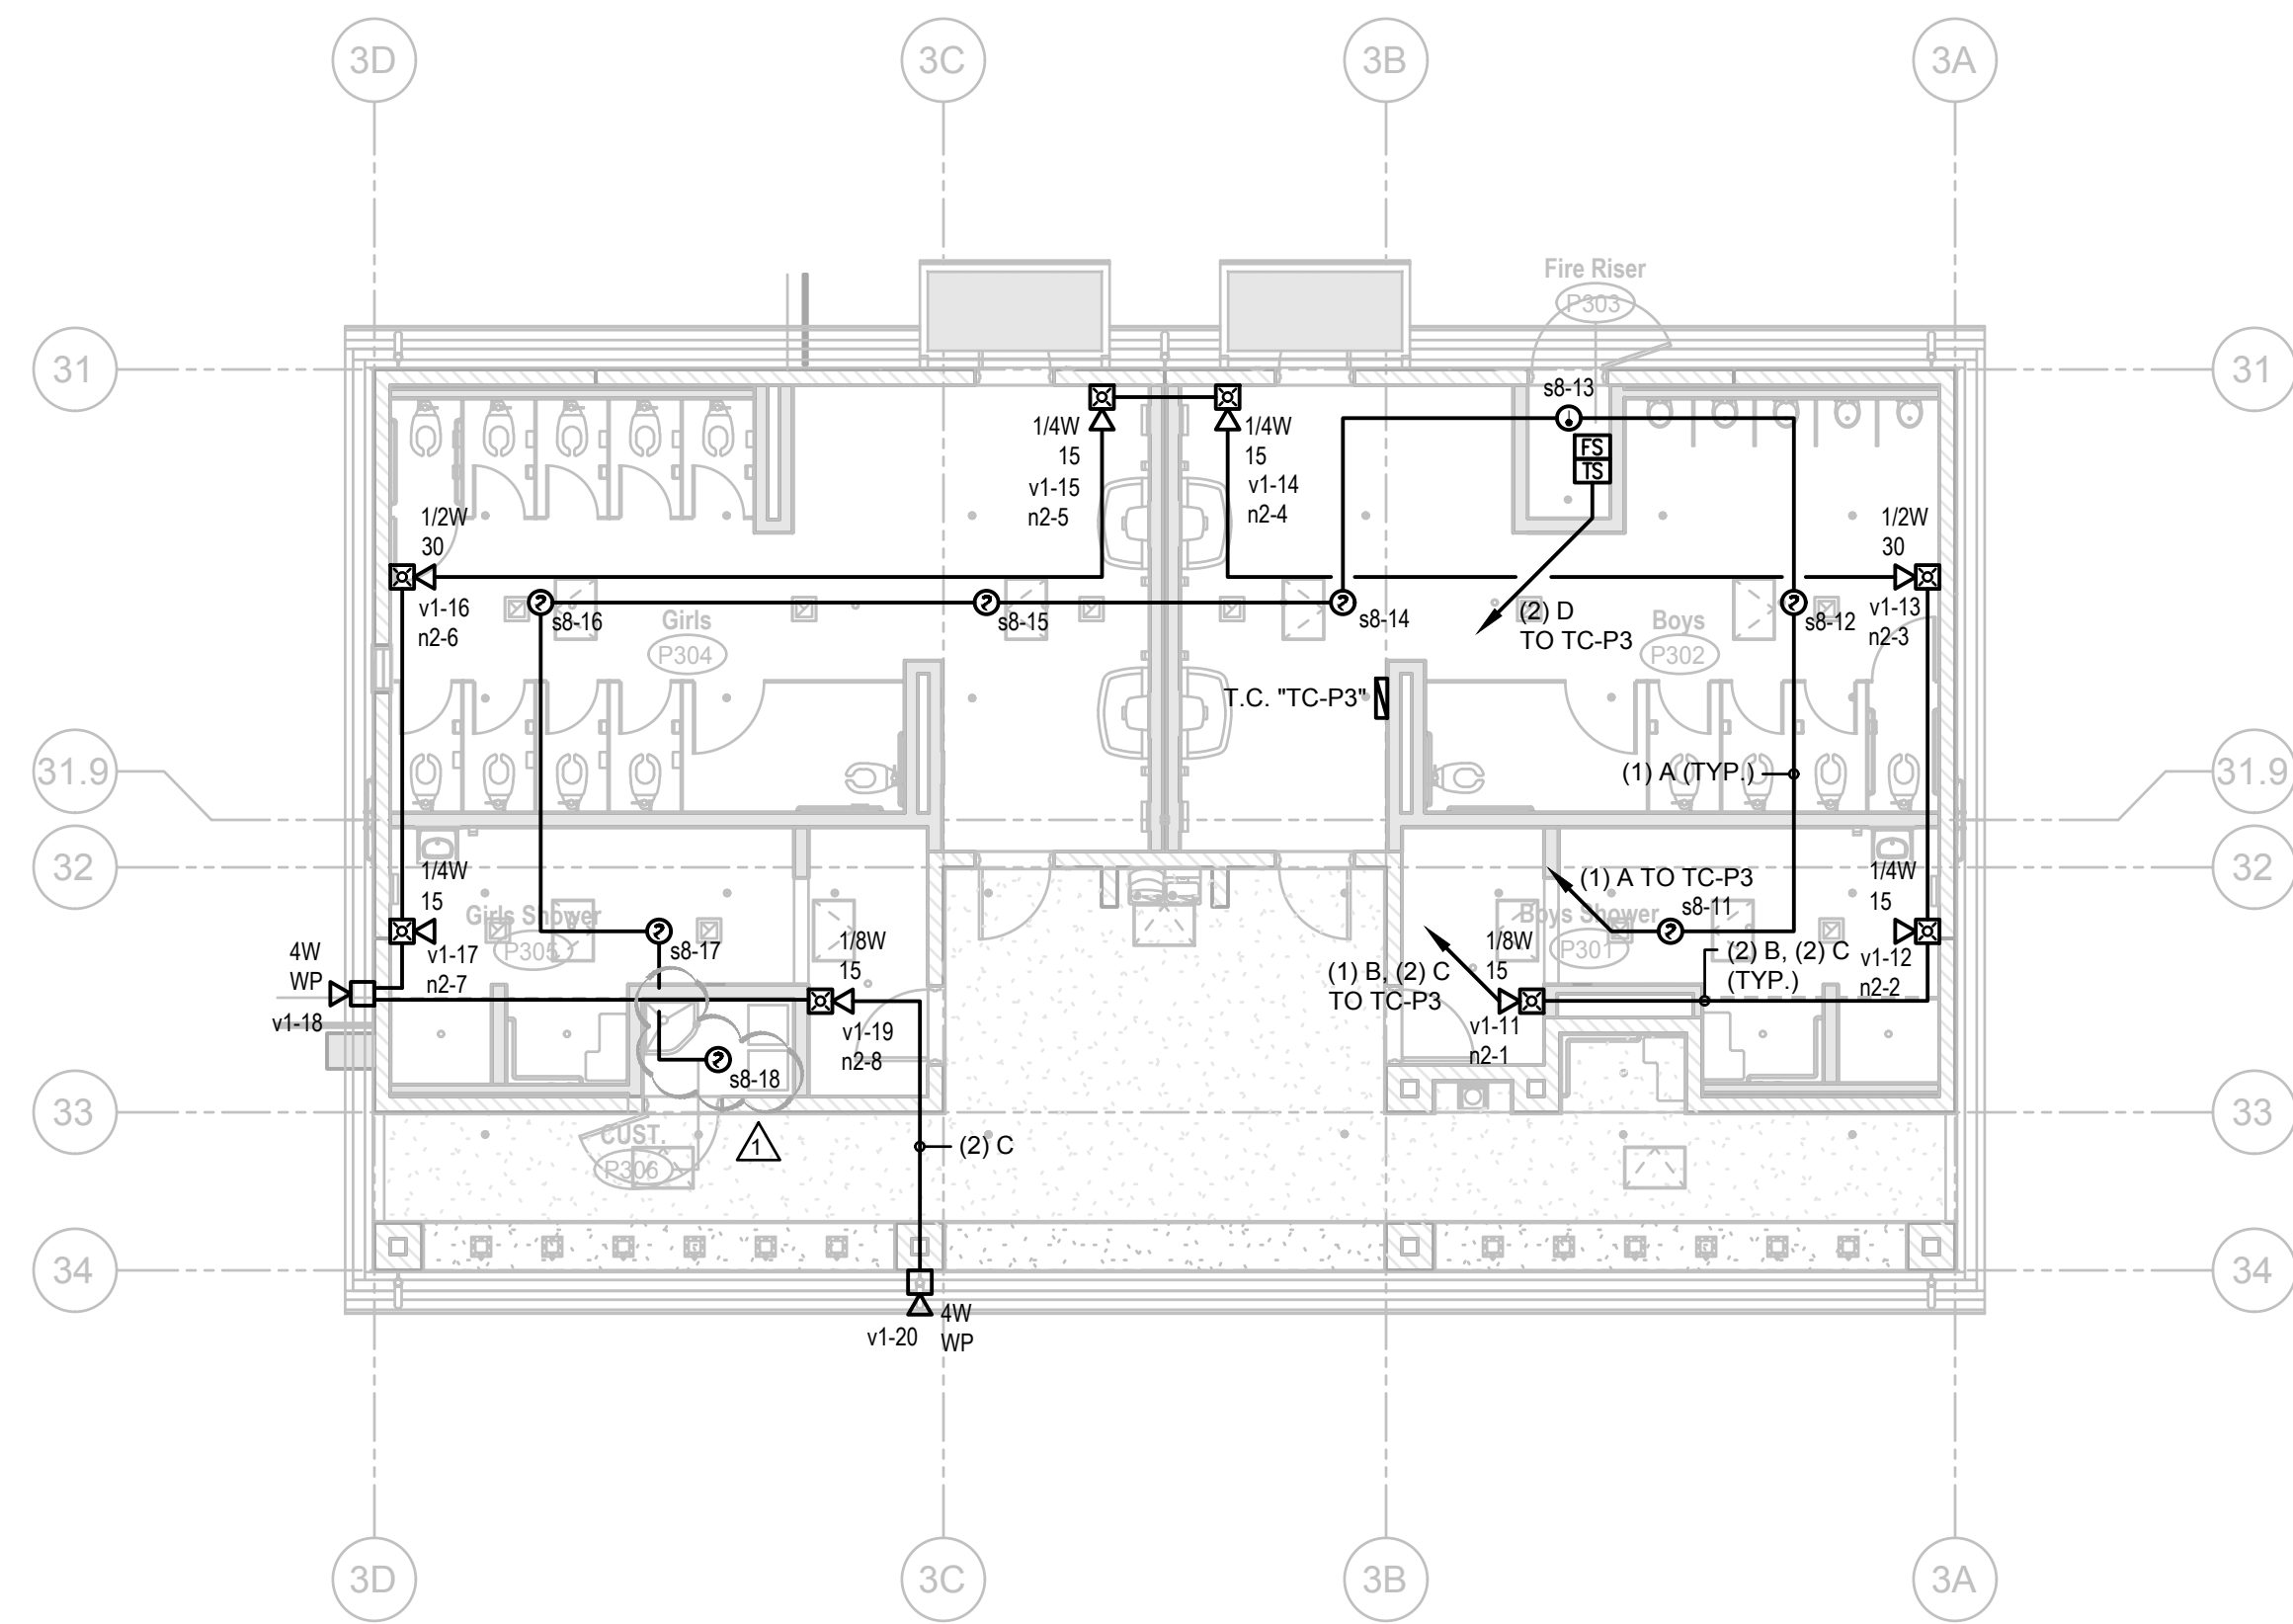

A1 Fire Alarm Plan - Building P3

1/8" = 1'-0"

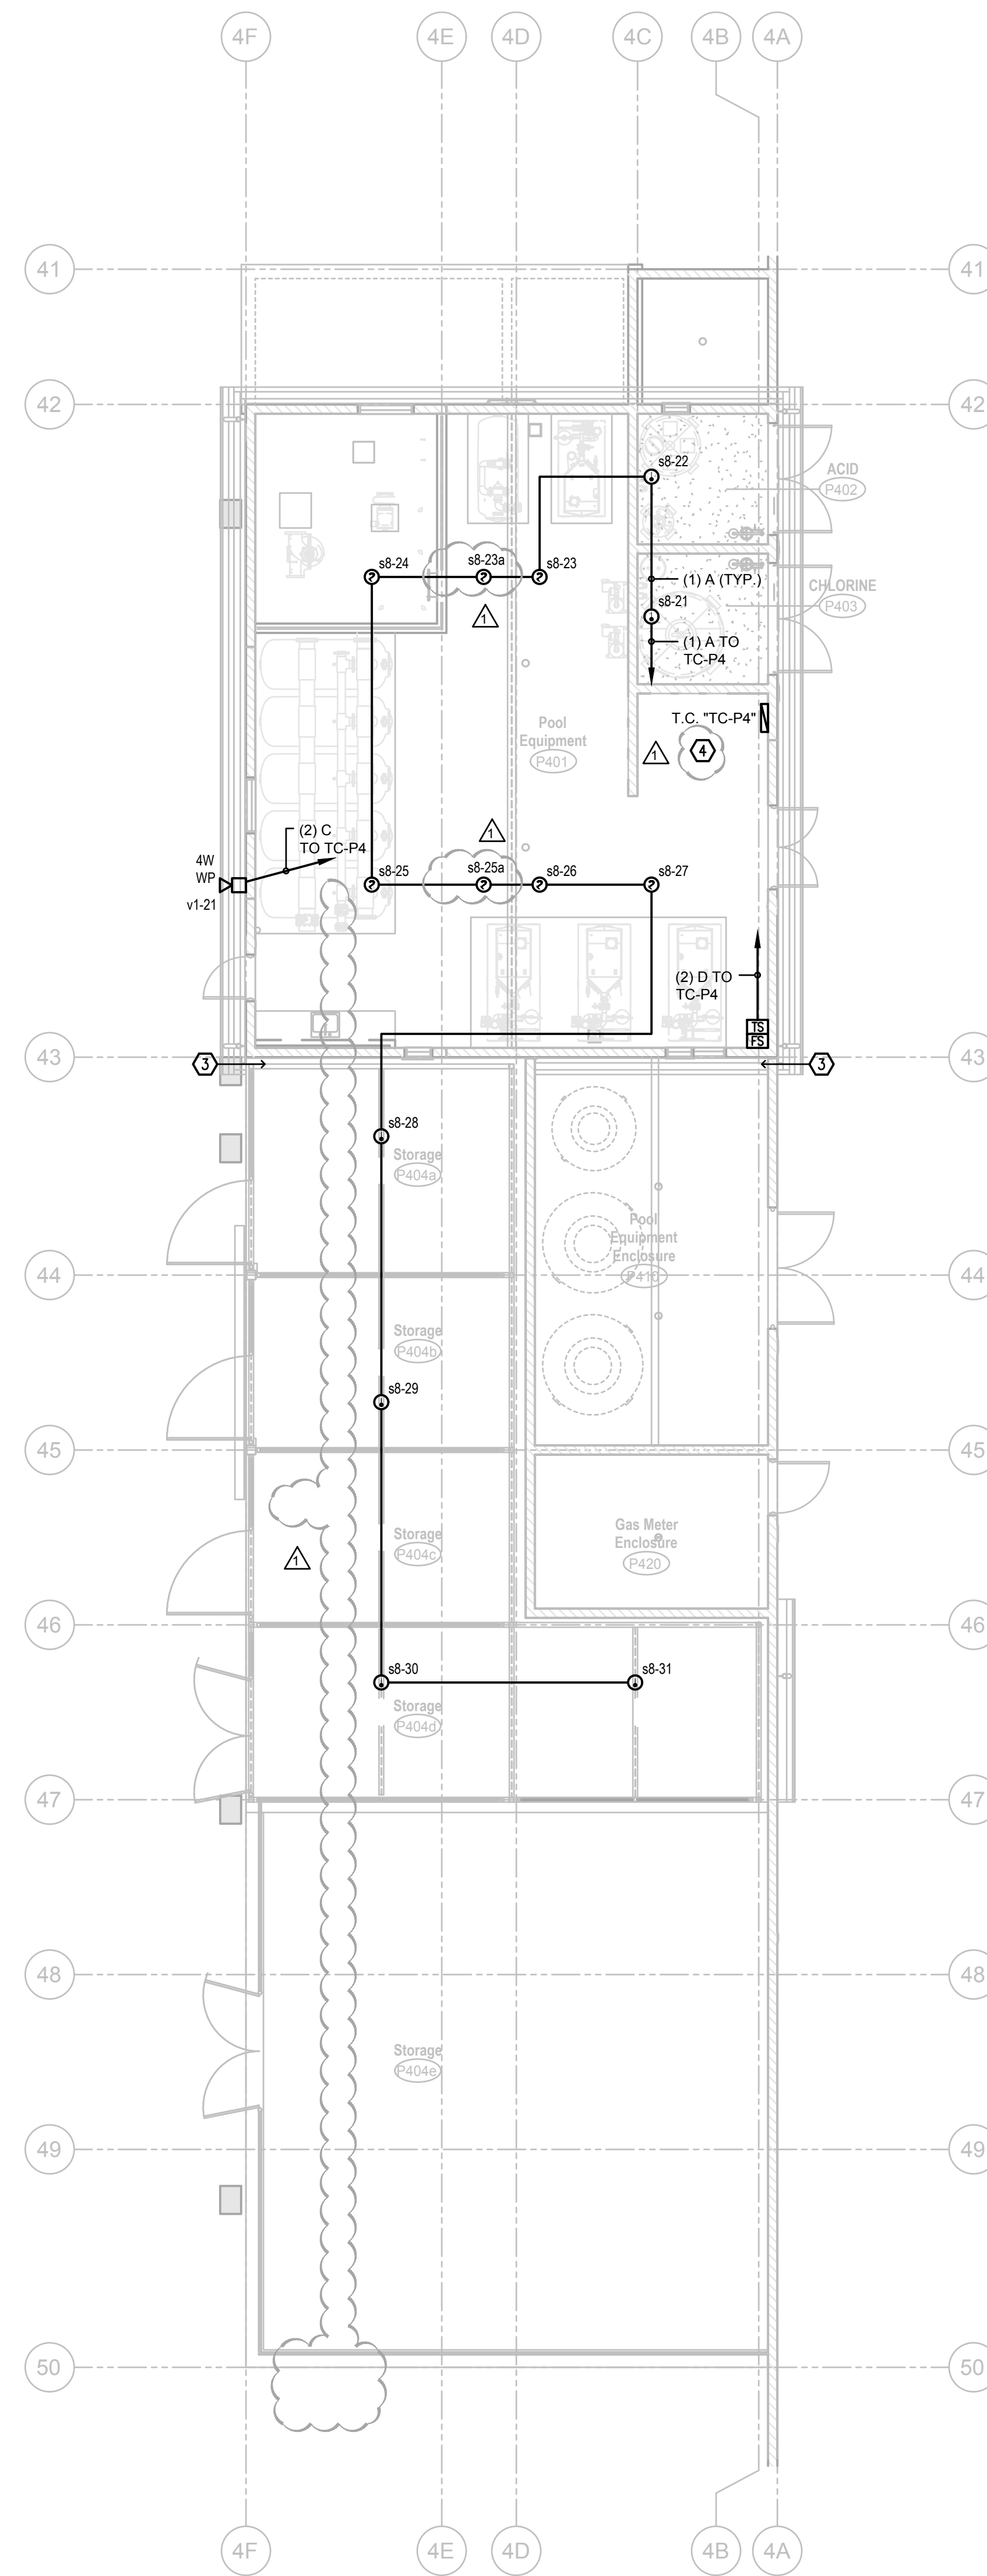

A9 Fire Alarm Plan - Building P4

1/8" = 1'-0"

DSA File No.: 54-H11

DSA Application No.: 02-120251

Agency Approval

KEYNOTES


1. INSTALL FIRE ALARM NAC EXPANDER PANEL. CONNECT TO DEDICATED 120V CIRCUIT. CONNECT FA PER FIRE ALARM SINGLE LINE DIAGRAM A10X202.
2. NOT USED.
3. SEISMIC SEPARATION. PROVIDE LISTED SEISMIC DEFLECTION/EXPANSION/FITTINGS ON CONDUITS CROSSING THE SEPARATION.
4. ALL PANELS, TERMINAL CABINETS, AND OTHER ENCLOSURES IN THIS ROOM SHALL BE STAINLESS STEEL, NEMA 4X.

POWER & SYSTEMS NOTES

1. ALL WORK AT THE POOLS AND RELATED POOL EQUIPMENT SHALL CONFORM WITH CEC ARTICLE 680. REFER TO AQUATIC DESIGN GROUP DRAWINGS AND SPECIFICATIONS FOR ADDITIONAL ELECTRICAL WORK (E.G. POOL LIGHTING, TIMING EQUIPMENT, GROUNDING, ETC.) AT THE POOLS AND RELATED EQUIPMENT ROOMS.
2. ALL RACEWAYS, COUPLINGS, STRAPS, ANCHORS, AND WIRING IN POOL EQUIPMENT ROOM, ACID, CHLORINE, AND POOL EQUIPMENT ENCLOSURE SHALL CONFORM TO CEC ARTICLE 680.14 AND SHALL BE UL LISTED AND ETL VERIFIED FOR SUCH USE. THE EXPOSED ELECTRICAL INSTALLATION SHALL BE FINISHED WITH PVC ANTI-CORROSIVE COATINGS. ALL UNISTRUTS SHALL HAVE A DEFENDER FINISH.
3. ALL CONDUIT PENETRATIONS THROUGH CMU WALLS SHALL BE PER DETAIL E10X104.



Hardin-Davidson Engineering
 356 Pollasky Ave., Suite 200, Clovis, CA 93612
 559.323.4995 tel • 559.323.4928 fax
 www.hardin-davidson.com

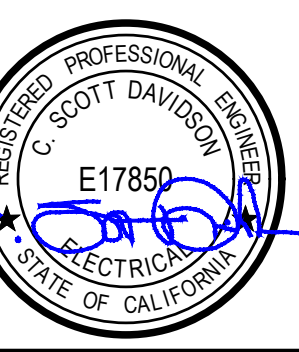

Consultant


Mission Oak HS Aquatic Complex
 Tulare Joint Union High School District
 Tulare, CA 93274

Project

BUILDINGS P2, P3, P4
 FIRE ALARM PLANS

Drawing

darden architects ARCHITECTURE PLANNING INTERIORS
 www.dardenarchitects.com
 8790 N. West Ave. • Fresno, CA 93711 • T. 559.448.8051

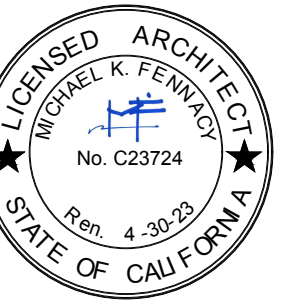

Architect

No.	Revision/Submission	Date
1	REVISION_01	05/31/2023

Revision		

Designed By:	SD	Copyright	2022 Darden Architects
--------------	----	-----------	------------------------

Scale:	As indicated	Drawn By:	HDE
--------	--------------	-----------	-----


Project Number:	2180	Checked By:	SD
-----------------	------	-------------	----

Date:	08/02/2022	Reviewed By:	SD
-------	------------	--------------	----

P/E104

Sheet: _____ of: _____

8/16/2023 4:25:01 PM Z:\Clients\Hardin Architects\2068 - Tulare USD Mission Oak HS Aquatic Complex\CAD Files\22088 - 4 Elec_rebld.dwg

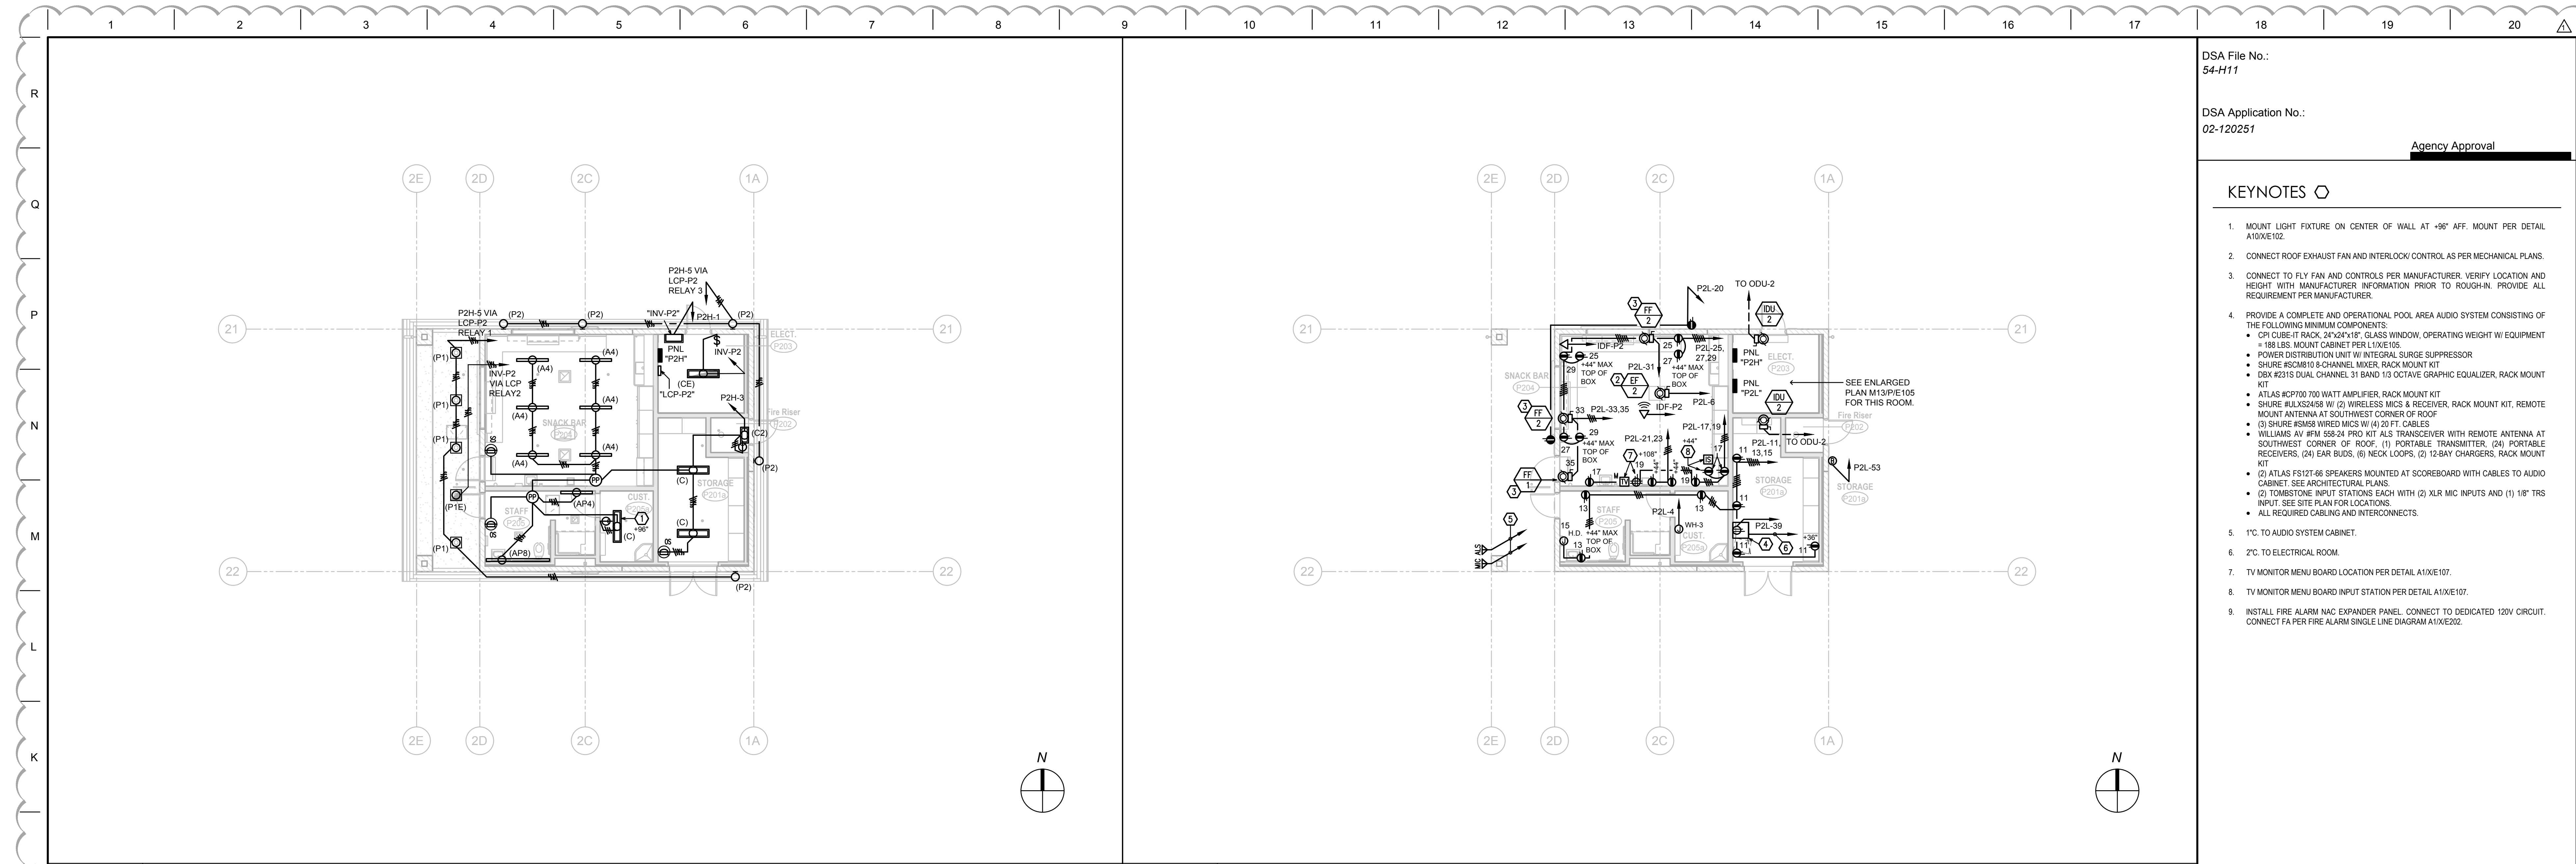


DSA File No.: 54-H11
 DSA Application No.: 02-120251
 Agency Approval

- KEYNOTES**
- MOUNT LIGHT FIXTURE ON CENTER OF WALL AT +96" AFF. MOUNT PER DETAIL A10X/E102.
 - CONNECT ROOF EXHAUST FAN AND INTERLOCK CONTROL AS PER MECHANICAL PLANS.
 - CONNECT TO FLY FAN AND CONTROLS PER MANUFACTURER. VERIFY LOCATION AND HEIGHT WITH MANUFACTURER INFORMATION PRIOR TO ROUGH-IN. PROVIDE ALL REQUIREMENT PER MANUFACTURER.
 - PROVIDE A COMPLETE AND OPERATIONAL POOL AREA AUDIO SYSTEM CONSISTING OF THE FOLLOWING MINIMUM COMPONENTS:
 - (1) CPI CUBE IT RACK, 24"x24"x18", GLASS WINDOW, OPERATING WEIGHT W/ EQUIPMENT = 180 LBS. MOUNT CABINET PER L1X/E105.
 - (2) POWER DISTRIBUTION UNIT W/ INTEGRAL SURGE SUPPRESSOR
 - (3) SHURE #SCM810 8-CHANNEL MIXER, RACK MOUNT KIT
 - (4) SBX #2315 DUAL CHANNEL 31 BAND 1/3 OCTAVE GRAPHIC EQUALIZER, RACK MOUNT KIT
 - (5) ATLAS #CP700 700 WATT AMPLIFIER, RACK MOUNT KIT
 - (6) SHURE #MX248S9 W/ (2) WIRELESS MICS & RECEIVER, RACK MOUNT KIT, REMOTE MOUNT ANTENNA AT SOUTHWEST CORNER OF ROOF
 - (7) SHURE #SM58 WIRELESS MICS W/ (4) 20 FT. CABLES
 - (8) WILLIAMS AV #PM 558-24 PRO KIT ALS TRANSDUCER WITH REMOTE ANTENNA AT SOUTHWEST CORNER OF ROOF. (1) PORTABLE TRANSMITTER, (24) PORTABLE RECEIVERS, (24) EAR BUDS, (6) NECK LOOPS, (2) 12-BAY CHARGERS, RACK MOUNT KIT
 - (9) ATLAS FS12T-66 SPEAKERS MOUNTED AT SCOREBOARD WITH CABLES TO AUDIO CABINET. SEE ARCHITECTURAL PLANS.
 - (10) TOMSTONE INPUT STATIONS EACH WITH (2) XLR MIC INPUTS AND (1) 1/8" TRS INPUT. SEE SITE PLAN FOR LOCATIONS
 - (11) ALL REQUIRED CABLING AND INTERCONNECTS.
 - 1" C. TO AUDIO SYSTEM CABINET.
 - 2" C. TO ELECTRICAL ROOM.
 - TV MONITOR MENU BOARD LOCATION PER DETAIL A10X/E107.
 - TV MONITOR MENU BOARD INPUT STATION PER DETAIL A10X/E107.
 - INSTALL FIRE ALARM NAC EXPANDER PANEL. CONNECT TO DEDICATED 120V CIRCUIT. CONNECT FA PER FIRE ALARM SINGLE LINE DIAGRAM A10X/E202.

J1 Lighting Plan - Building P2
 1/8" = 1'-0"

J1 Power & Datacomm Plan - Building P2
 1/8" = 1'-0"

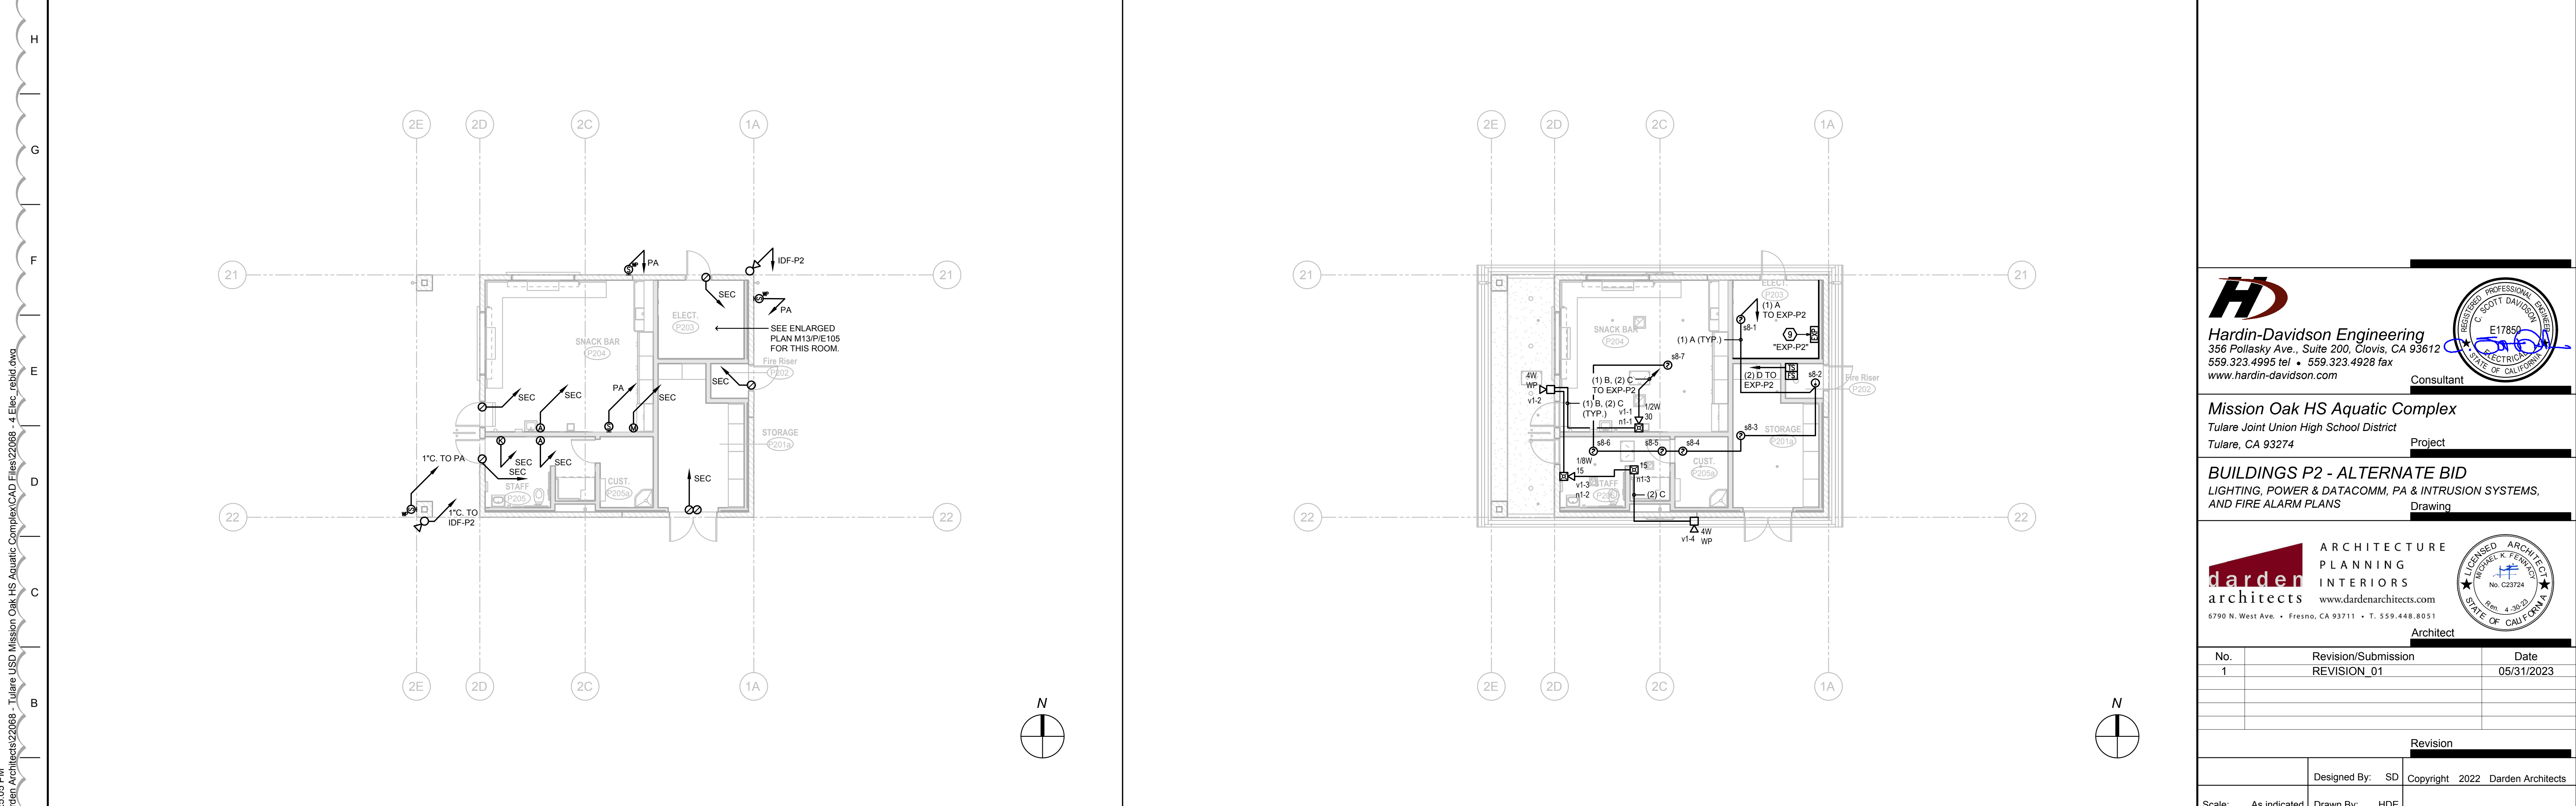

A1 PA & Intrusion Systems Plan - Building P2
 1/8" = 1'-0"

A9 Fire Alarm Plan - Building P2
 1/8" = 1'-0"

Hardin-Davidson Engineering
 356 Pollasky Ave., Suite 200, Clovis, CA 93612
 559.323.4955 tel • 559.323.4928 fax
 www.hardin-davidson.com

Consultant

Mission Oak HS Aquatic Complex
 Tulare Joint Union High School District
 Tulare, CA 93274

Project

BUILDINGS P2 - ALTERNATE BID
 LIGHTING, POWER & DATACOMM, PA & INTRUSION SYSTEMS,
 AND FIRE ALARM PLANS

Drawing


darden architects
 ARCHITECTURE
 PLANNING
 INTERIORS
 www.dardenarchitects.com
 6790 N. West Ave. • Fresno, CA 93711 • T. 559.448.8051

Architect

No.	Revision/Submission	Date
1	REVISION_01	05/31/2023

Revision		
Designed By:	Copyright	2022 Darden Architects
Scale: As indicated	Drawn By: HDE	P/E106
Project Number: 2180	Checked By: SD	
Date: 08/02/2022	Reviewed By: SD	

8/16/2023 4:25:05 PM
 Z:\Clients\Hardin Architects\22088 - Tulare USD Mission Oak HS Aquatic Complex\CAD Files\22088 - 4 Elec_rgibd.dwg

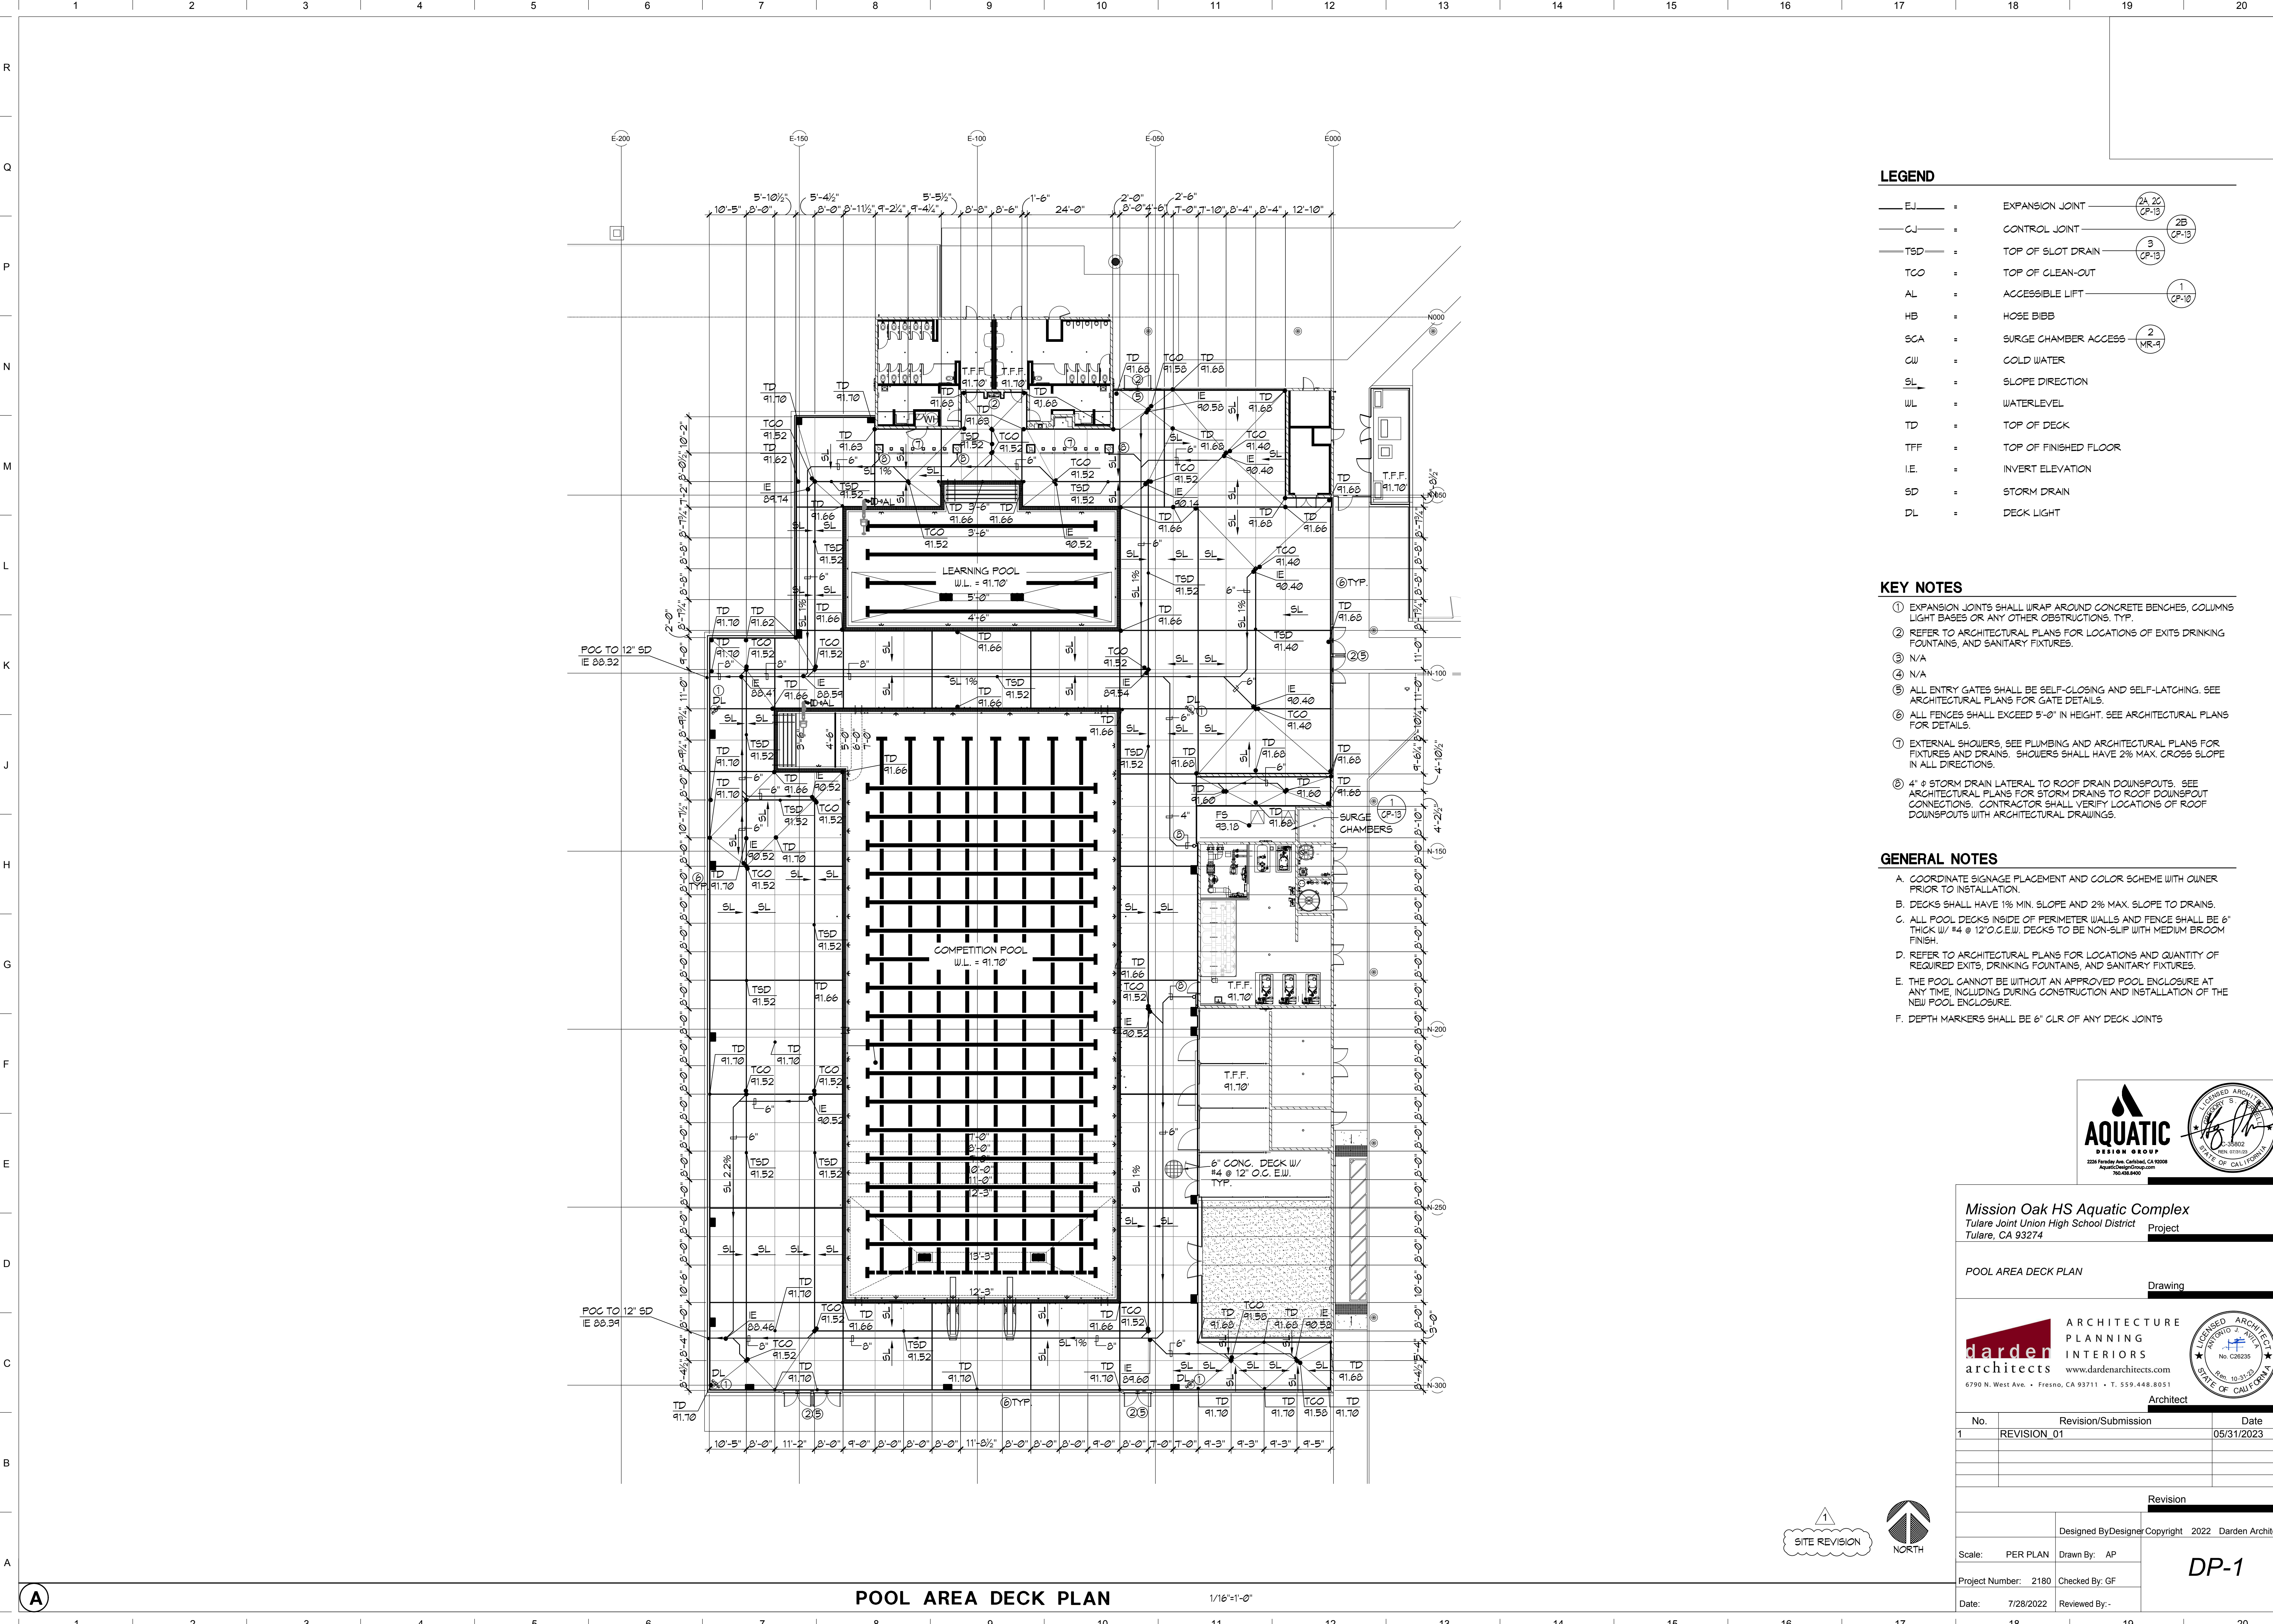

LEGEND

— EJ —	=	EXPANSION JOINT	
— CJ —	=	CONTROL JOINT	
— TSD —	=	TOP OF SLOT DRAIN	
TCO	=	TOP OF CLEAN-OUT	
AL	=	ACCESSIBLE LIFT	
HB	=	HOSE BIBB	
SCA	=	SURGE CHAMBER ACCESS	
CW	=	COLD WATER	
SL	=	SLOPE DIRECTION	
WL	=	WATERLEVEL	
TD	=	TOP OF DECK	
TFF	=	TOP OF FINISHED FLOOR	
IE	=	INVERT ELEVATION	
SD	=	STORM DRAIN	
DL	=	DECK LIGHT	

- KEY NOTES**
- EXPANSION JOINTS SHALL WRAP AROUND CONCRETE BENCHES, COLUMNS LIGHT BASES OR ANY OTHER OBSTRUCTIONS. TYP.
 - REFER TO ARCHITECTURAL PLANS FOR LOCATIONS OF EXITS DRINKING FOUNTAINS, AND SANITARY FIXTURES.
 - N/A
 - N/A
 - ALL ENTRY GATES SHALL BE SELF-CLOSING AND SELF-LATCHING. SEE ARCHITECTURAL PLANS FOR GATE DETAILS.
 - ALL FENCES SHALL EXCEED 5'-0" IN HEIGHT. SEE ARCHITECTURAL PLANS FOR DETAILS.
 - EXTERNAL SHOWERS, SEE PLUMBING AND ARCHITECTURAL PLANS FOR FIXTURES AND DRAINS. SHOWERS SHALL HAVE 2% MAX. GROSS SLOPE IN ALL DIRECTIONS.
 - 4" Ø STORM DRAIN LATERAL TO ROOF DRAIN DOWNSPOUTS. SEE ARCHITECTURAL PLANS FOR STORM DRAINS TO ROOF DOWNSPOUT CONNECTIONS. CONTRACTOR SHALL VERIFY LOCATIONS OF ROOF DOWNSPOUTS WITH ARCHITECTURAL DRAWINGS.

- GENERAL NOTES**
- COORDINATE SIGNAGE PLACEMENT AND COLOR SCHEME WITH OWNER PRIOR TO INSTALLATION.
 - DECKS SHALL HAVE 1% MIN. SLOPE AND 2% MAX. SLOPE TO DRAINS.
 - ALL POOL DECKS INSIDE OF PERIMETER WALLS AND FENCE SHALL BE 6" THICK W/ #4 @ 12" O.C. E.W. DECKS TO BE NON-SLIP WITH MEDIUM BROOM FINISH.
 - REFER TO ARCHITECTURAL PLANS FOR LOCATIONS AND QUANTITY OF REQUIRED EXITS, DRINKING FOUNTAINS, AND SANITARY FIXTURES.
 - THE POOL CANNOT BE WITHOUT AN APPROVED POOL ENCLOSURE AT ANY TIME, INCLUDING DURING CONSTRUCTION AND INSTALLATION OF THE NEW POOL ENCLOSURE.
 - DEPTH MARKERS SHALL BE 6" CLR OF ANY DECK JOINTS



Mission Oak HS Aquatic Complex
 Tulare Joint Union High School District
 Tulare, CA 93274

POOL AREA DECK PLAN
 Drawing


darden architects ARCHITECTURE PLANNING INTERIORS
 www.dardenarchitects.com
 6790 N. West Ave. • Fresno, CA 93711 • T. 559.448.8051

No.	Revision/Submission	Date
1	REVISION 01	05/31/2023


Revision
 Designed By Designer Copyright 2022 Darden Architects

Scale: PER PLAN Drawn By: AP
 Project Number: 2180 Checked By: GF
 Date: 7/28/2022 Reviewed By: -

DP-1

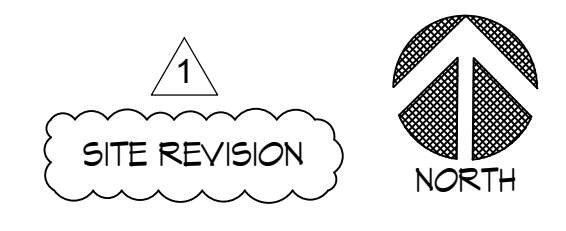

POOL AREA DECK PLAN 1/16"=1'-0"

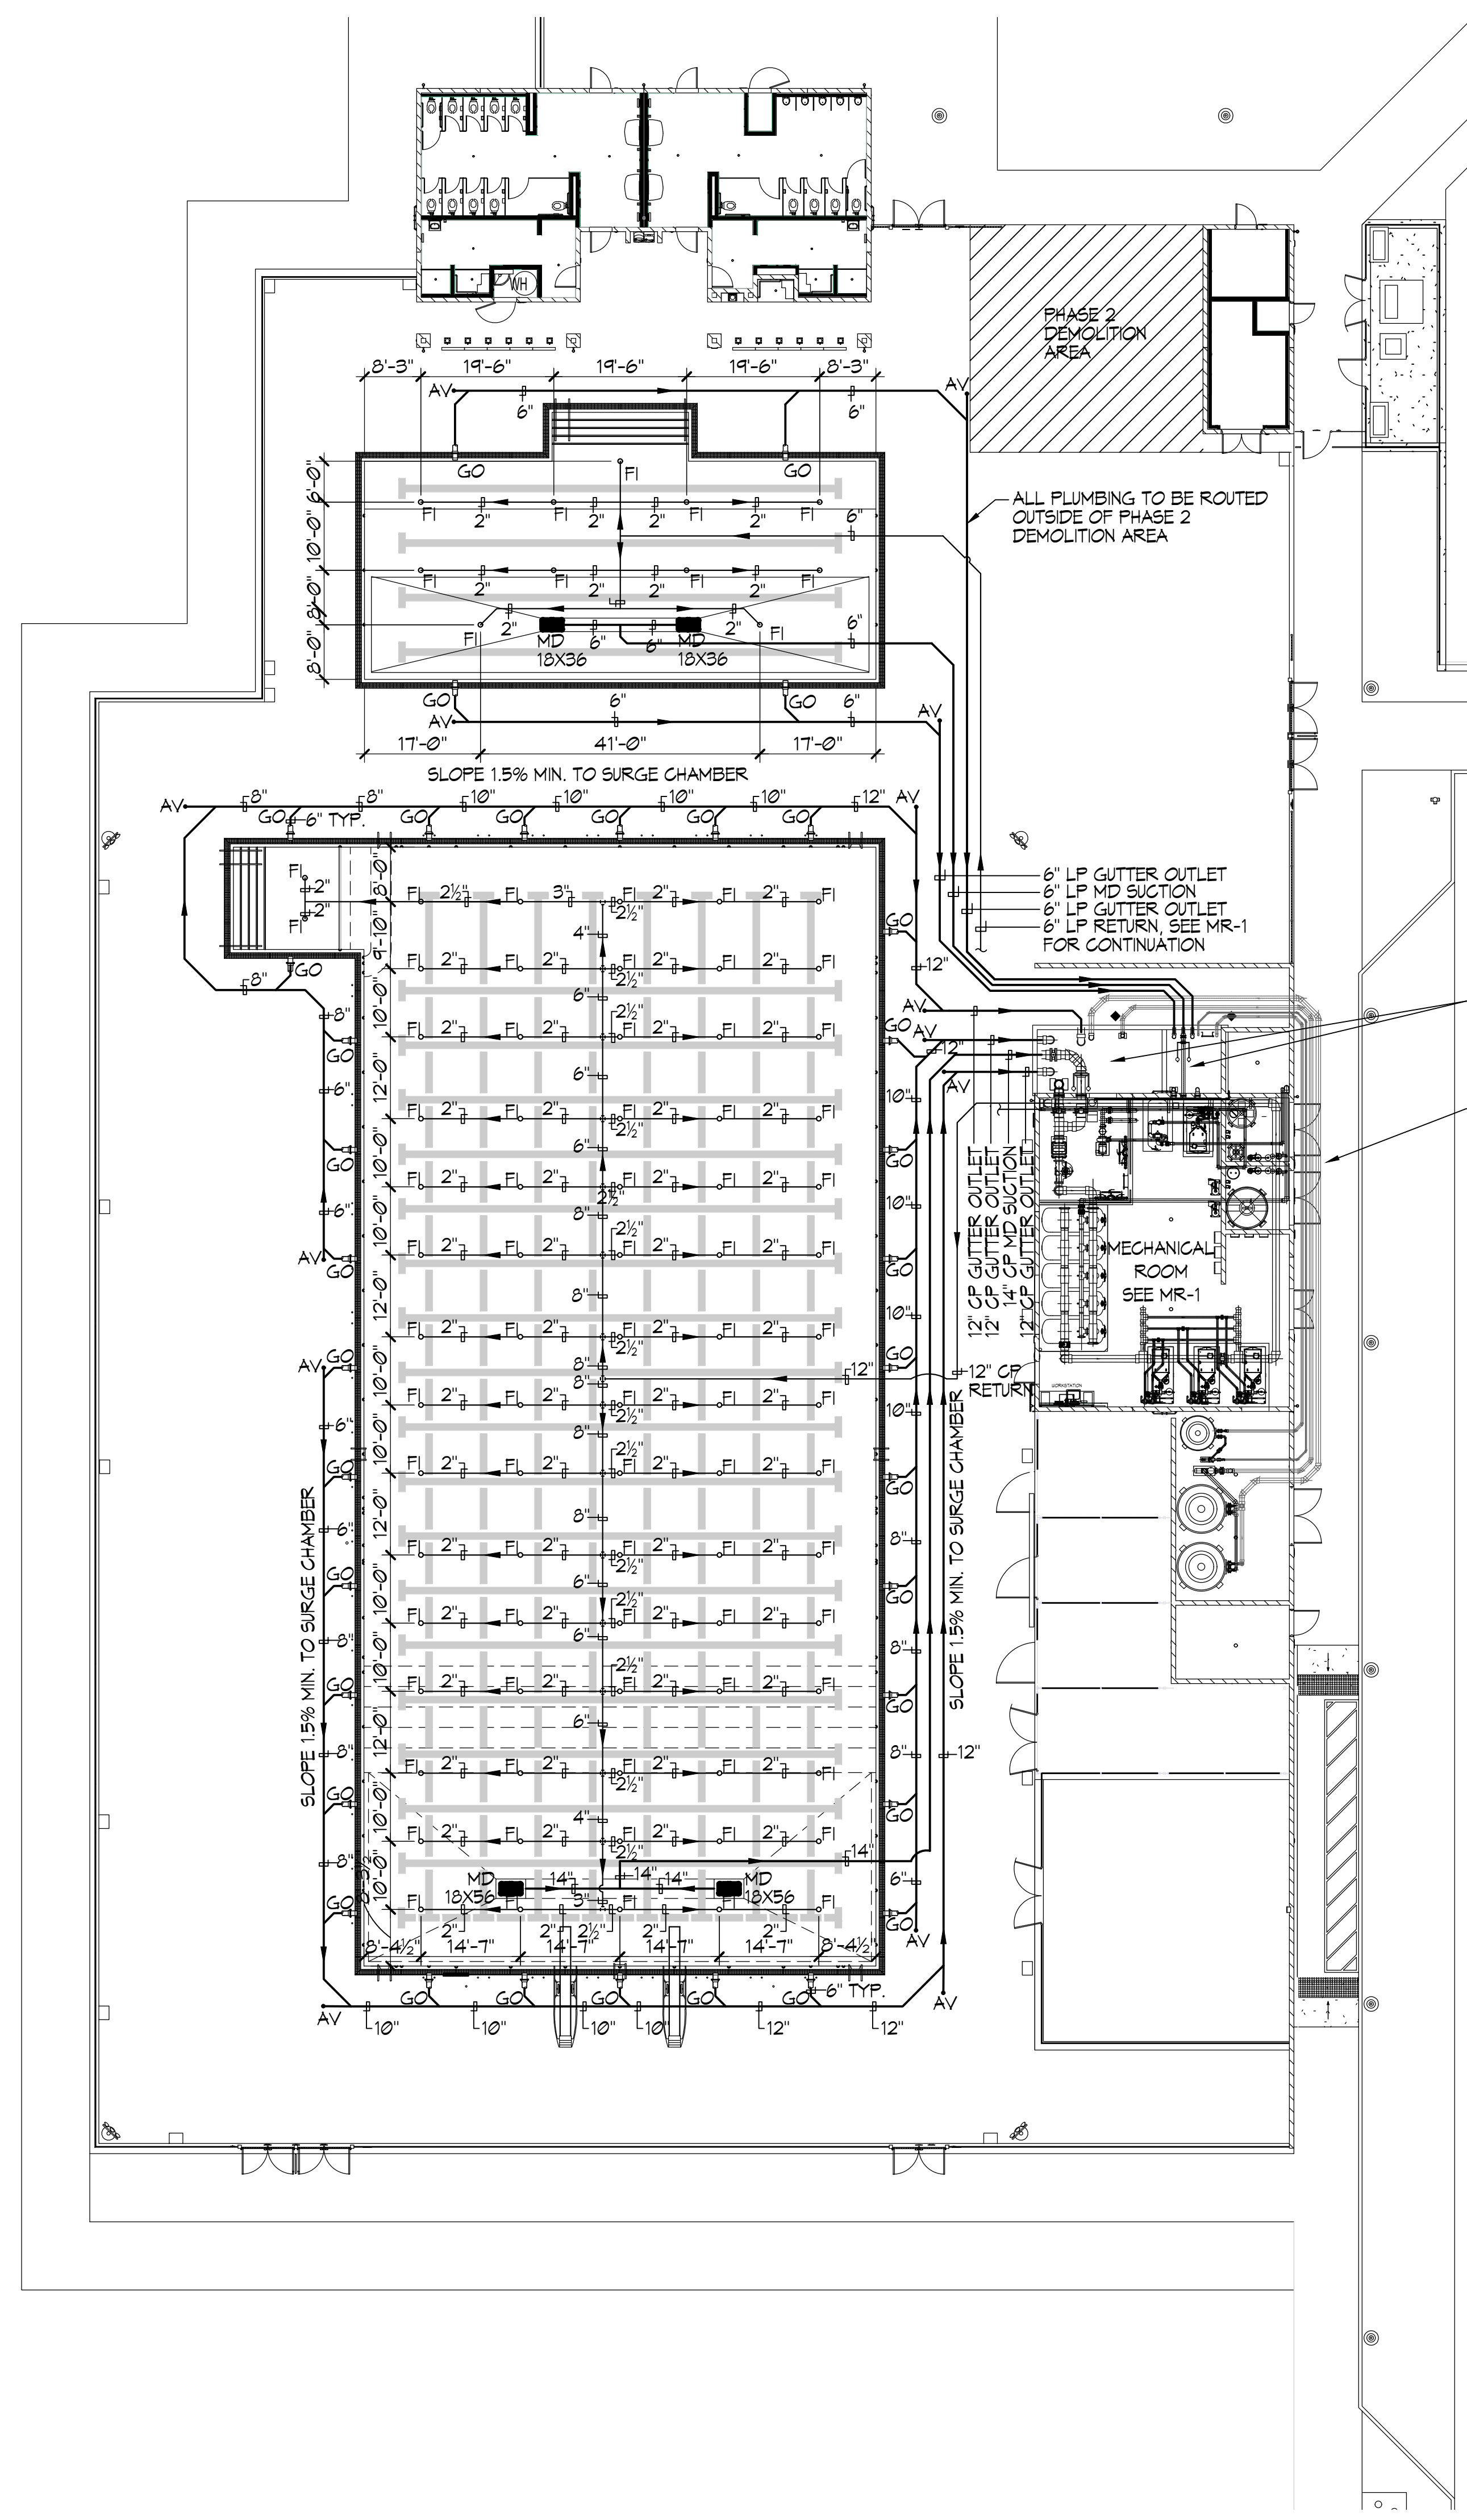

TIMING SYSTEM NOTES/EQUIPMENT

NOTE: THE CONTRACTOR SHALL SUPPLY AND INSTALL DECK PLATE BOXES, WALL PLATE BOXES, WALL PLATE JUNCTION BOXES, CONDUIT, WIRING AND ALL TIMING EQUIPMENT AS SHOWN FOR THE COLORADO TIME SYSTEM OR EQUAL. OWNER TO FURNISH SCOREBOARD, CONTRACTOR TO INSTALL PER PLANS AND MANUFACTURER INSTRUCTIONS.

QTY	MODEL	DESCRIPTION
1	GEN1-TMR	INTUITIVE SOFTWARE INTERFACE WITH MODERN WINDOWS USER INTERFACE AND TOUCHSCREEN FRIENDLY. FLEXIBLE USER INTERFACE OPTIONS WITH ETHERNET CONNECTIVITY TO THE TIMER. ADVANCED DIAGNOSTICS, INTELLIGENT BUS SYSTEM, ROBUST SAFEGUARDS. TIMER WILL CONTINUE TO RUN AND FINISH RACE WITHOUT USER INTERFACE. WET-PLUGGABLE TITANIUM CONNECTIONS. INTEGRATED 2.4 GHZ WIRELESS TO SCOREBOARDS, FACILITY NETWORK CONNECTIVITY.
1	R-600-302	GEN1 LAPTOP
2	START-FFM-2	CHAMPION SERIES START SYSTEM WITH WIRED MICROPHONE, VOLUME CONTROL ON EACH MICROPHONE INPUT, EXTERNAL CONNECTIONS FOR ADDITIONAL STROBE LIGHTS, LED BATTERY INDICATION LIGHT, AC/DC POWER CAPABILITIES AND AN EXTERNAL 360° STROBE, TRIPOD OR TABLE TOP OPTIONS.
16	SP-6/45	6 WATT INDIVIDUAL BLOCK SPEAKER
2	START-FFM-2	FLAG POLE MOUNTING KIT FOR STARTER
16	SP-6/45	6 WATT INDIVIDUAL BLOCK SPEAKER
16	4000-0040	SPECIAL SIZE TOUCHPAD BRACKETS
1	TP-GEN1-12	TWELVE-LANE TOUCHPAD SYSTEM FOR THE GEN 1 TIMING SYSTEM (SERIAL) INCLUDES AN TWELVE-LANE CABLE HARNESS, ONE PUSHBUTTON PER LANE, ONE SPARE, VACUUM PUMP AND TOUCHPAD METER.
1	CHSP-1-12	TIMING SYSTEM (SERIAL) INCLUDES AN TWELVE-LANE CABLE HARNESS, ONE PUSHBUTTON PER LANE, ONE SPARE, VACUUM PUMP AND TOUCHPAD METER.
1	R-015-101-0	SCOREBOARD CABLE, 0 METER
1	R-015-115-0	TIMER CABLE, 0 METER
2	R-015-106-0	STARTER CABLE, 0 METER
1	R-015-115-15	TIMER CABLE, 15 METER
4	TDPI-02	START DECK NODE
2	TDPI-0C5	SCOREBOARD DECK NODE
3	R-1004-0544	GEN1 WALL PLATE (15X15)
1	TDPI-K1	KIT-SCOREBOARD BUS HEAD & TAIL NODE INSTALLATION
1	TDPI-K1	KIT-TIMING BUS HEAD & TAIL NODE INSTALLATION
1	WPI-F4	WPI-YDS FIBER & LEGACY CONNECT

QTY	MODEL	DESCRIPTION
1	WITC-2	WIRELESS TABLE TOP CONTROLLER
1	CASE-WITC	CASE FOR THE WIRELESS TABLE TOP CONTROLLER
1	WHG-1	WIRELESS HANDHELD CONTROLLER
1	WA-3	WIRELESS ADAPTER, 2.4 GHZ
16	RJPL-24X32	CTS RELAY JUDGING PLATFORM 24"x32" W/ BUILT-IN LED LIGHT FOR START
2	CAD-RJPL-2	CADDY- 24" WIDTH RELAY JUDGING PLATFORMS (HOLDS 10)
1	CP-11	PROVIDE LED MATRIX DISPLAY SCOREBOARD INCLUDING ALL POWER REQUIREMENTS, BONDING AND STRUCTURAL SUPPORTS. THE SCOREBOARD SHALL HAVE FULL COLOR AND VIDEO CAPABILITIES. YES 10mm 320H x 576W SMD, FA, OD DISPLAY ACTIVE AREA: 125.98(H) x 226.77(W)
1	CP-11	PROVIDE SEVEN (7) DEDICATED 20 AMP CIRCUIT TO BE TERMINATED INTO SCOREBOARD LOAD CENTER
1	CP-11	MASTER ON/OFF SCOREBOARD SWITCH WITH PILOT LIGHT W/ LOCKABLE ENCLOSURE
1	CP-11	SCOREBOARD DATA CONNECTION BOX CONNECT TO TIMING/WALL BOX LOCATION W/ 1" PVC CONDUIT.
1200'	R-015-131	TIMING BUS CABLE- 1 CONDUCTOR
1200'	R-015-126	SCOREBOARD BUS CABLE- 4 CONDUCTOR
2	SP-1400	FACE CLOCK - WALL MOUNTED SHOT CLOCK (19 lbs.) SEE ARCHITECTURAL AND STRUCTURAL PLANS FOR ATTACHMENT TO SHADE STRUCTURE
1	DC-1500	FACE CLOCKS

- FUNCTIONS:**
- 4 DIGIT FACE CLOCK
 - 10" RED DIGITS - VIEWABLE UP TO 400 FEET
 - HIGH INTENSITY LED - INDOOR/OUTDOOR
 - "FLASH-PROOF" PROTECTIVE LENS
 - INTERNAL RECHARGEABLE BATTERY
 - INTERNAL HORN
 - FEET AND HANDLE
- FUNCTIONS:**
- SIMPLE PAGE CLOCK
 - CUMULATIVE SPLIT DISPLAY
 - LAP SPLIT DISPLAY
 - LAP COUNTER
 - LAP SPLIT DISPLAY WITH TURN SPEED
 - RELAY EXCHANGES DISPLAY
 - START REACTION DISPLAY
 - HAND TURN SPEED
 - BREAK OUT SPEED DISPLAY
 - BREAK OUT SPEED DISPLAY WITH START REACTION
 - TIME DISPLAY FOR REPETITIVE SETS
 - SINGLE LANE TIMER
 - MID-RACE TIMING DISPLAY
 - WATERPOLO SHOT CLOCK
 - WATERPOLO GAME CLOCK


NOTE: MOST FUNCTIONS REQUIRE ADDITIONAL INPUT DEVICES, I.E. TOUCHPAD, RELAY JUDGING PLATFORM, START SYSTEM, PUSHBUTTON

KEY NOTES

DESCRIPTION	QUANTITY	UNIT
ETHERNET DROP-BY OTHERS	3	COUNT
WALL PLATE FIBER CONNECTION	1	COUNT
WALL PLATE RS-485 CONNECTION	1	COUNT
FACE CLOCK	2	COUNT
WALL PLATE TIMER NODE	3	COUNT
TIMING DECK NODE (4"x4"x6" PVC BOX)	34	COUNT
START DECK NODE (4"x4"x6" PVC BOX)	4	COUNT
SCOREBOARD DECK NODE (4"x4"x6" PVC BOX)	2	COUNT

LEGEND

JB	=	JUNCTION BOX	2	CP-12
WP	=	WALL PLATE	3	CP-12
RP	=	RACING PLATFORM	5	CP-10
SB	=	SCOREBOARD	1	CP-11
UL	=	UNDERWATER LIGHT	4	CP-12

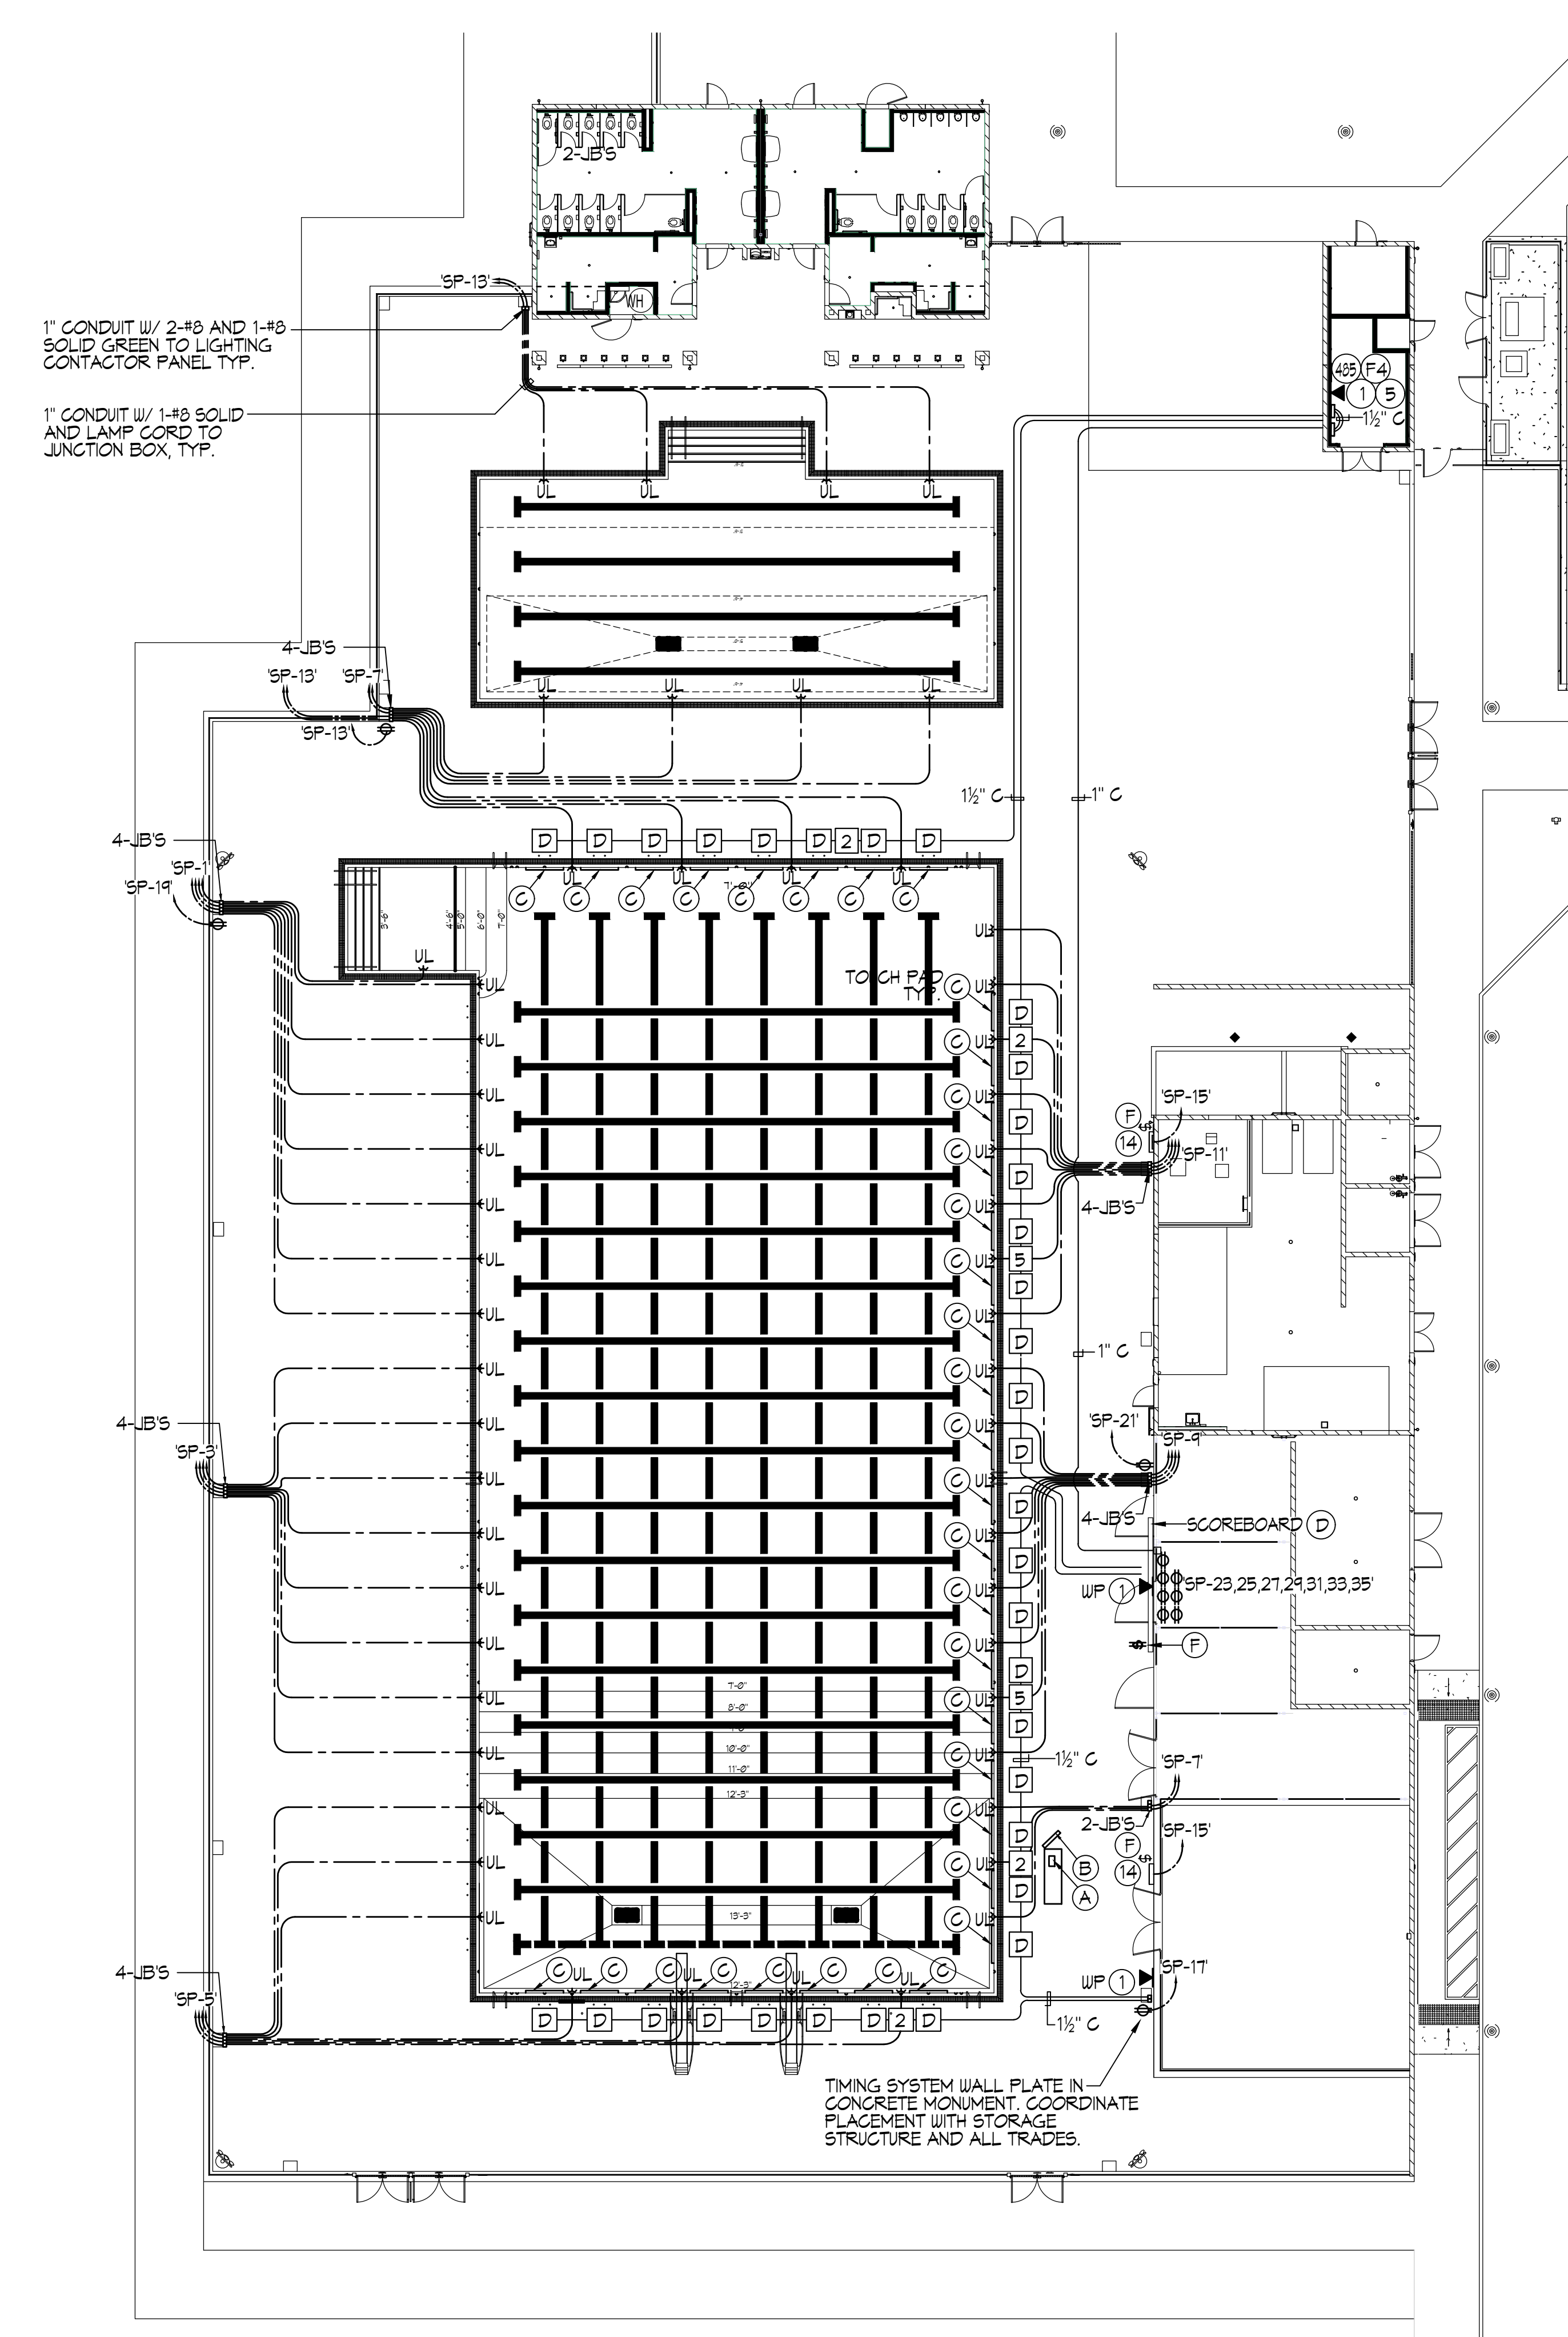

1" CONDUIT W/ 2#8 AND 1#8 SOLID GREEN TO LIGHTING CONTACTOR PANEL TYP.

1" CONDUIT W/ 1#8 SOLID AND LAMP CORD TO JUNCTION BOX, TYP.

TIMING SYSTEM WALL PLATE IN CONCRETE MONUMENT. COORDINATE PLACEMENT WITH STORAGE STRUCTURE AND ALL TRADES.

UNDERWATER LIGHTING AND TIMING PLAN

1/16"=1'-0"

Mission Oak HS Aquatic Complex
Tulare Joint Union High School District
Tulare, CA 93274



UNDERWATER LIGHTING AND TIMING PLAN
Drawing


darden architects ARCHITECTURE PLANNING INTERIORS
www.dardenarchitects.com
6790 N. West Ave. • Fresno, CA 93711 • T. 559.448.8051

No.	Revision/Submission	Date
1	REVISION 01	05/31/2023


Revision	
Designed By/Designer	Copyright 2022 Darden Architects
Scale: PER PLAN	Drawn By: AP
Project Number: 2180	Checked By: GF
Date: 7/28/2022	Reviewed By: -

CP-4

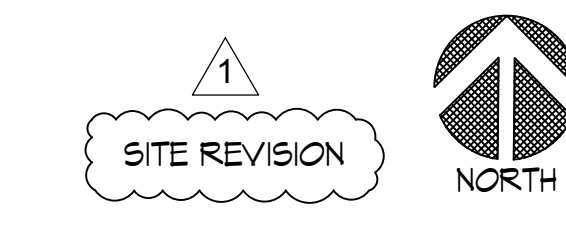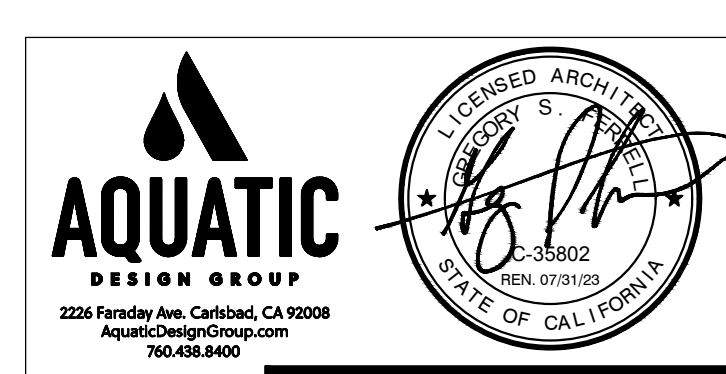


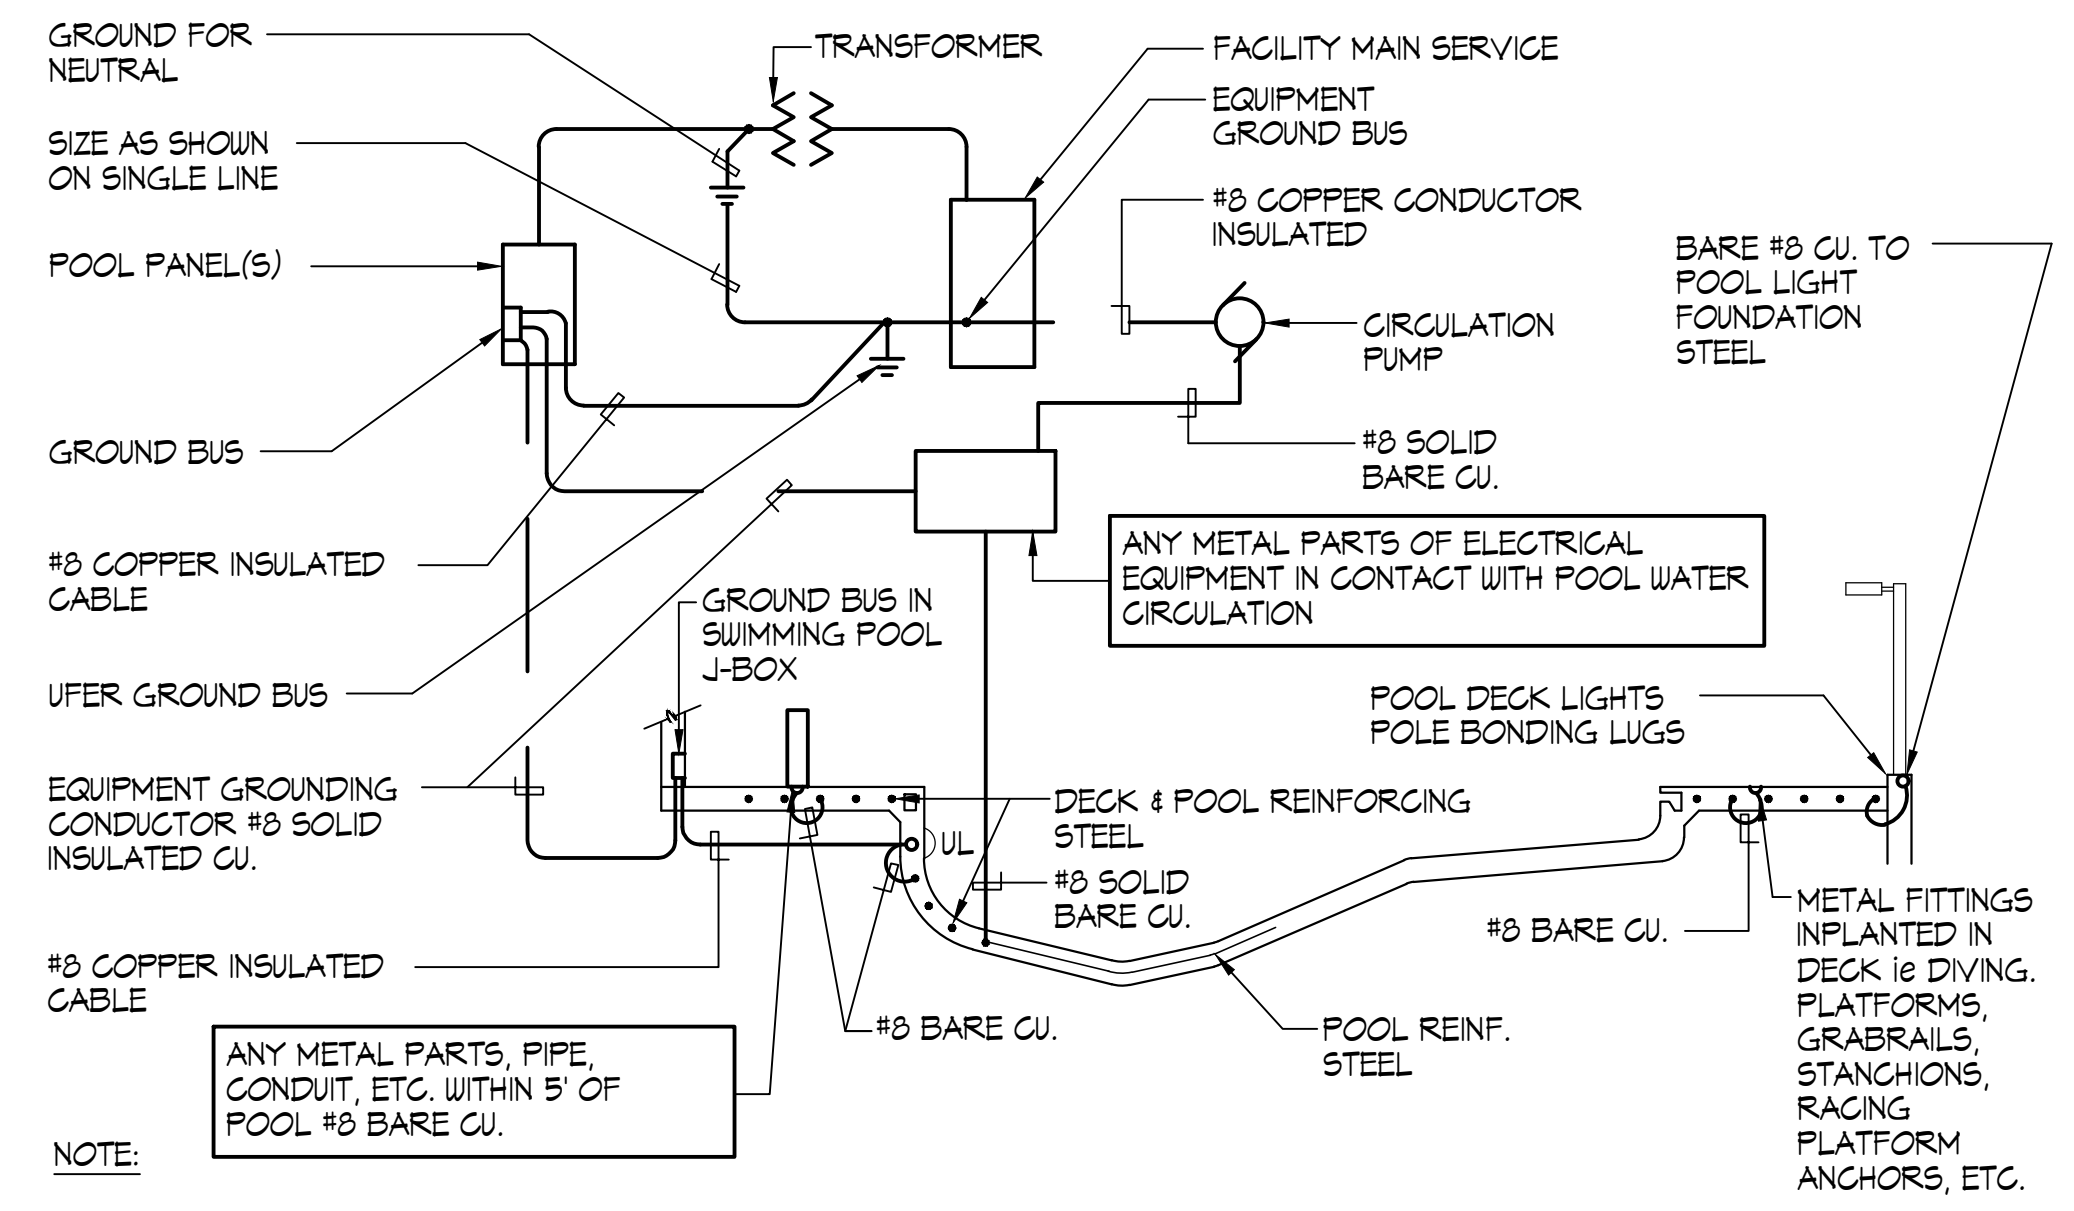

- NOTE:**
- STRUCTURAL STEEL IN POOL DECK AND POOL SHALL BE BONDED TOGETHER (TIGHTLY MADE STEEL TIE-WIRES ARE APPROVED FOR BONDING STRUCTURAL ELEMENTS).
 - BONDING CONNECTOR TO COMMON GRID, (POOL STEEL MAY BE USED FOR THAT PURPOSE) SHALL BE MADE BY PRESSURE CONNECTORS OR CLAMPS OF BRASS, COPPER, OR COPPER ALLOY.
 - ALL GROUND BUSES SHALL BE SIZED FOR CONNECTION TO AWG SIZE 8 WIRE PROVIDING ONE SPARE TERMINAL.
 - GROUND AND BOND IN ACCORDANCE WITH ARTICLE 680 OF THE CALIFORNIA ELECTRICAL CODE, i.e. LADDERS, FENCING, POLE LIGHTS, DIVING & STARTING STANCHIONS, DISABLED LIFT ETC.
 - PROVIDE BONDING OF AUTOMATIC POOL COVER MOTORS REGARDLESS OF PROXIMITY TO POOL.

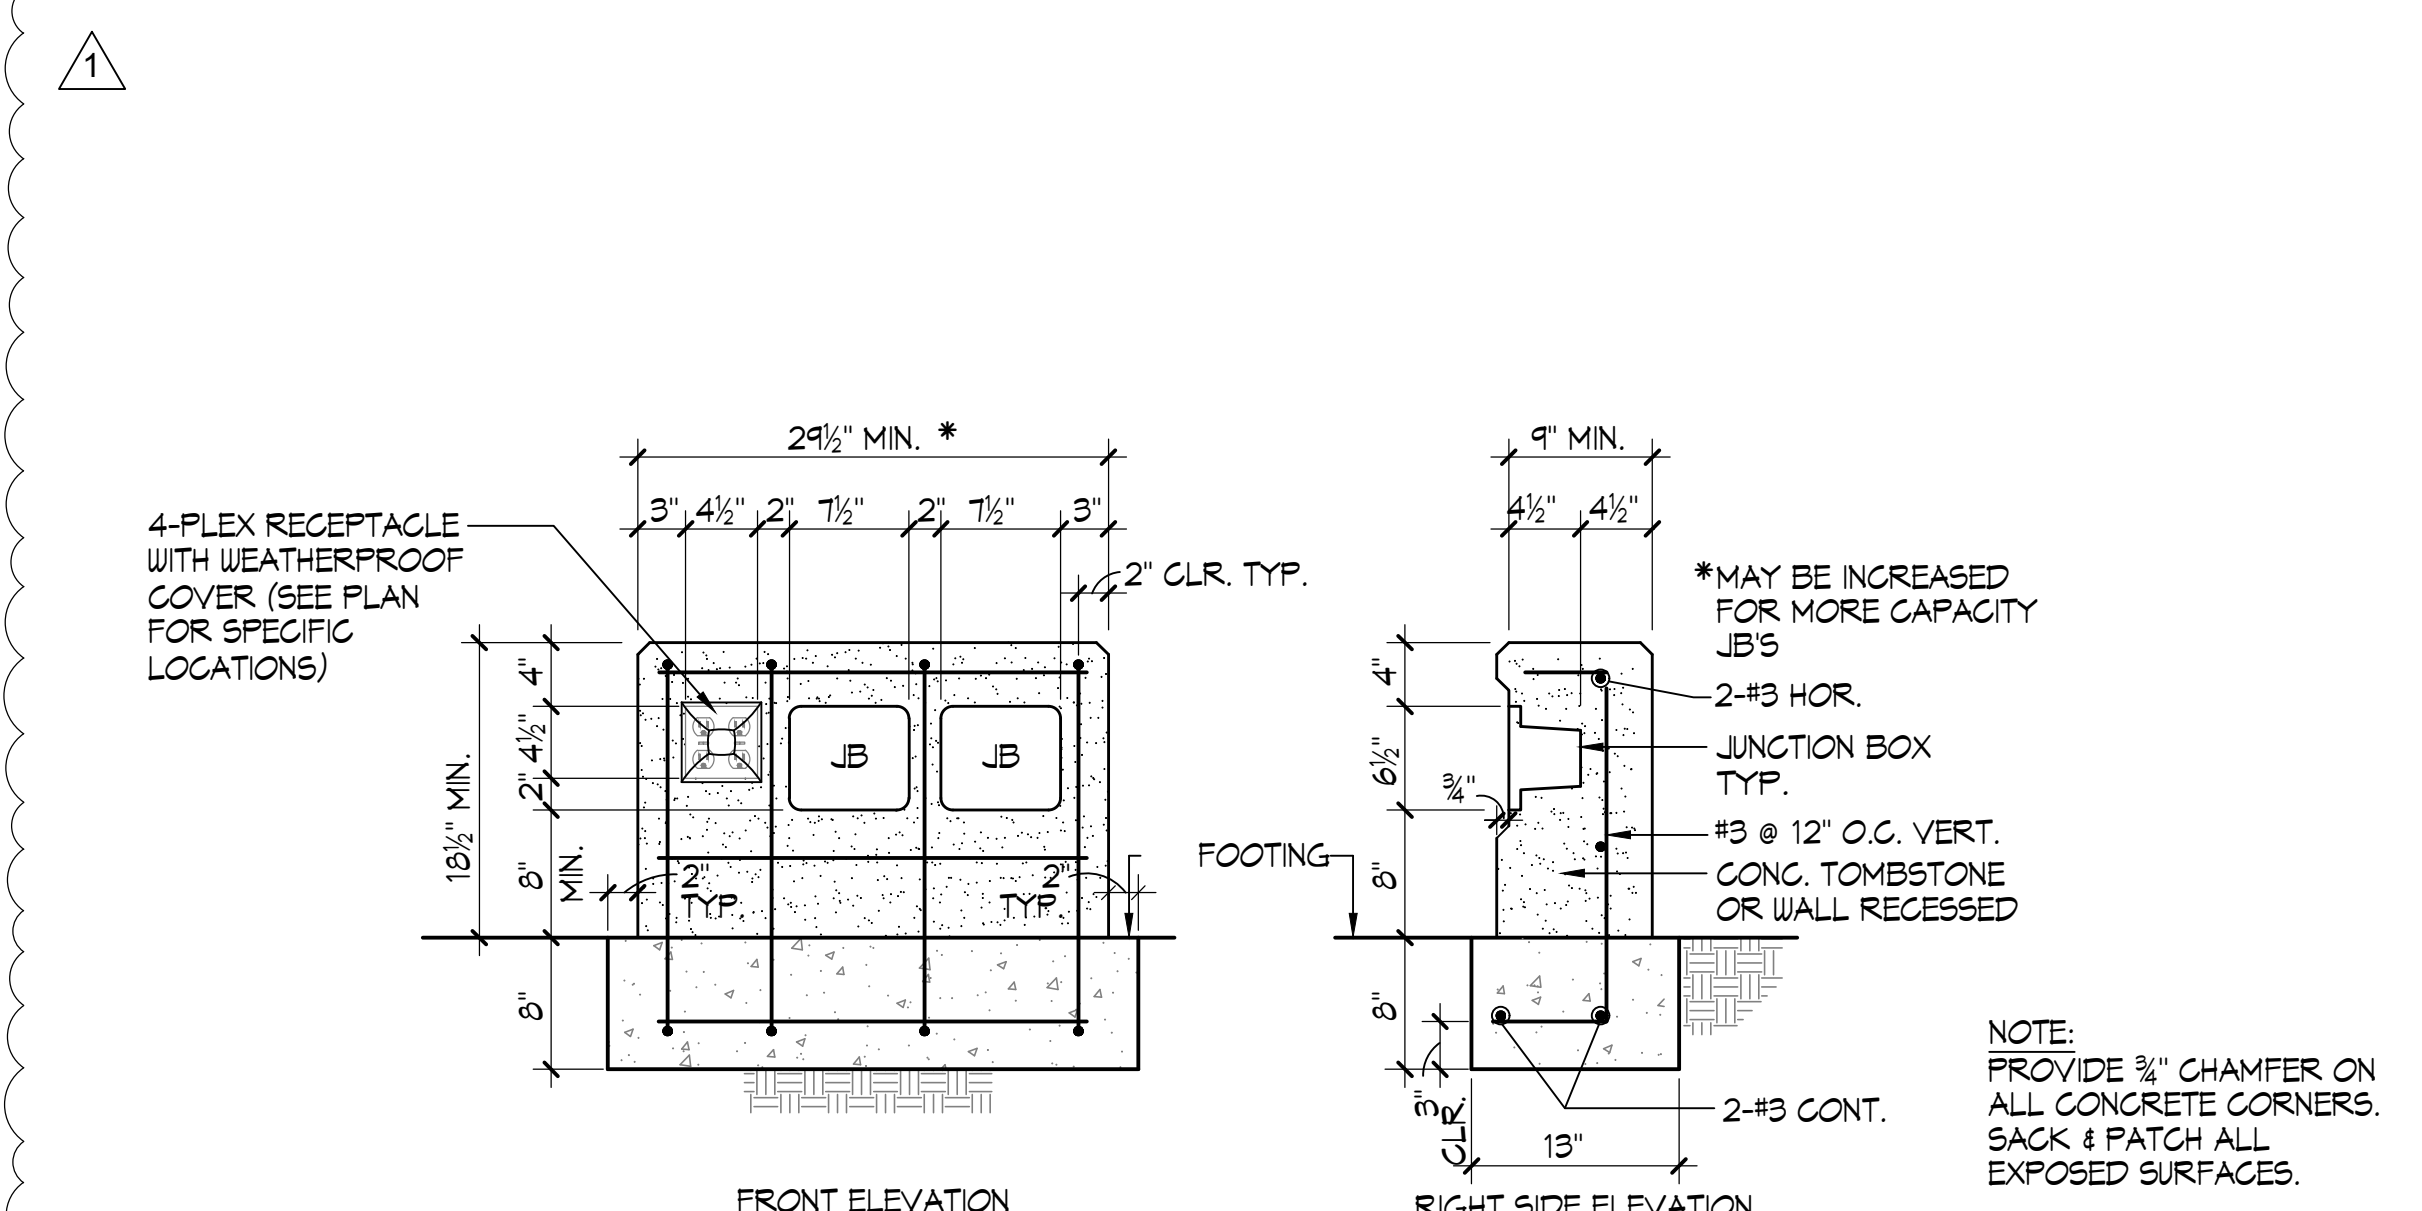

- NOTE:** PROVIDE 3/16" CHAMFER ON ALL CONCRETE CORNERS, SACK & PATCH ALL EXPOSED SURFACES.

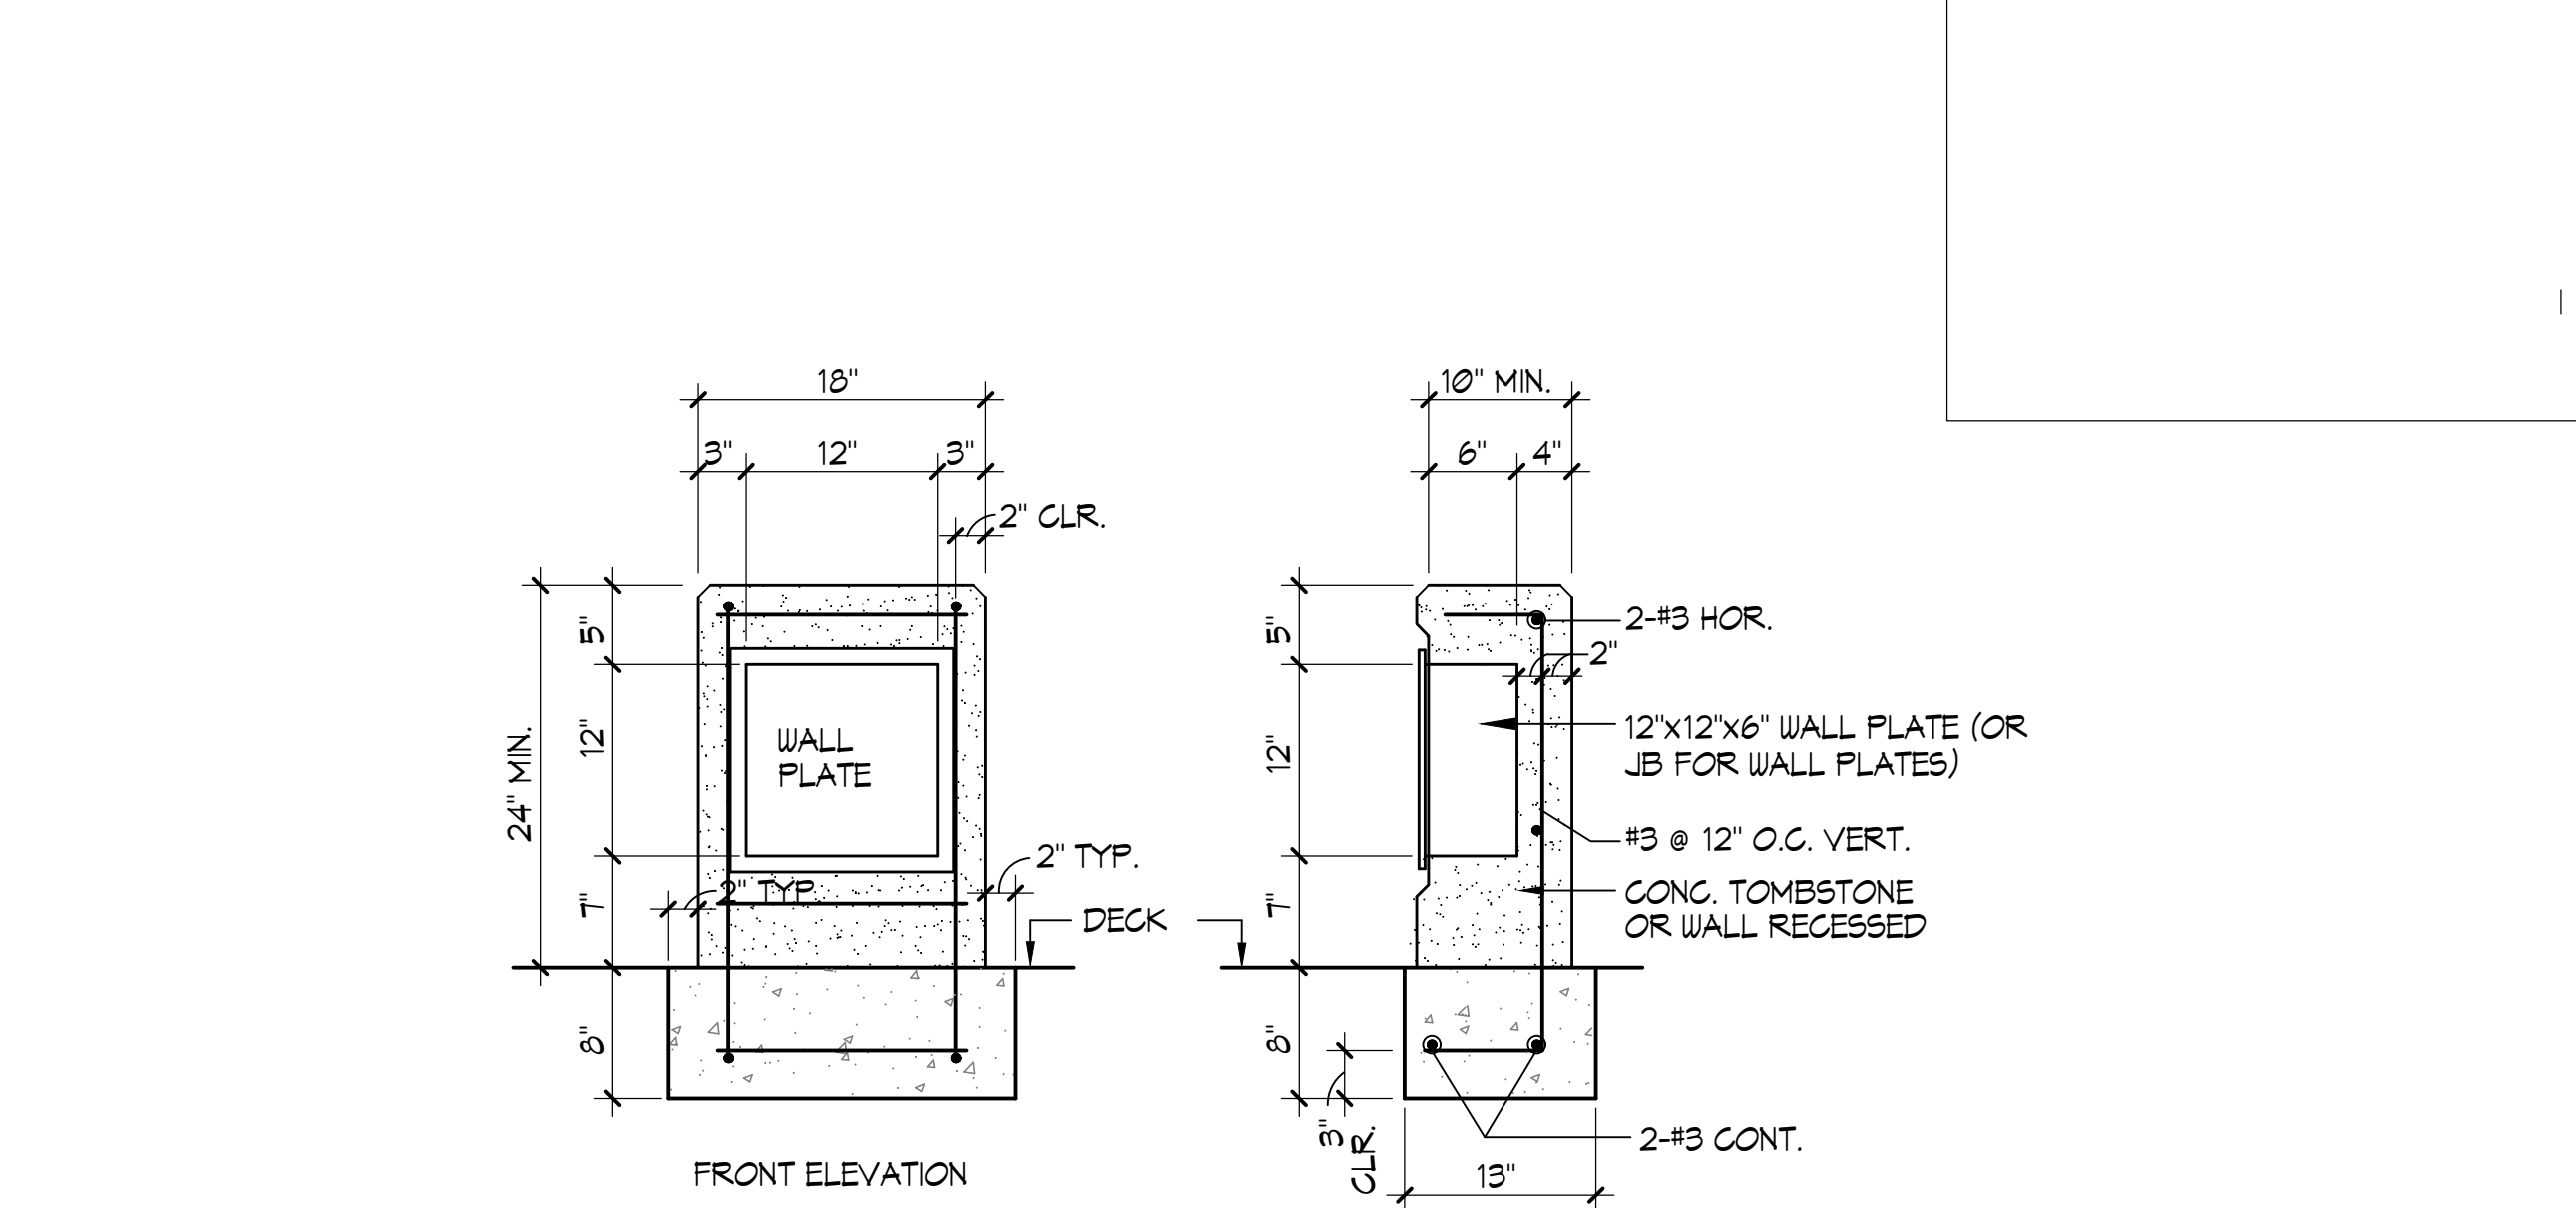


- NOTE:** PROVIDE 3/16" CHAMFER ON ALL CONCRETE CORNERS, SACK & PATCH ALL EXPOSED SURFACES.


1 TYPICAL POOL BONDING AND GROUND DETAIL NO SCALE

2 UNDERWATER LIGHT JUNCTION BOX SURROUND DETAIL 1"=1'-0"

3 TIMING SYSTEM WALL PLATE CONCRETE SURROUND DETAIL 1"=1'-0"

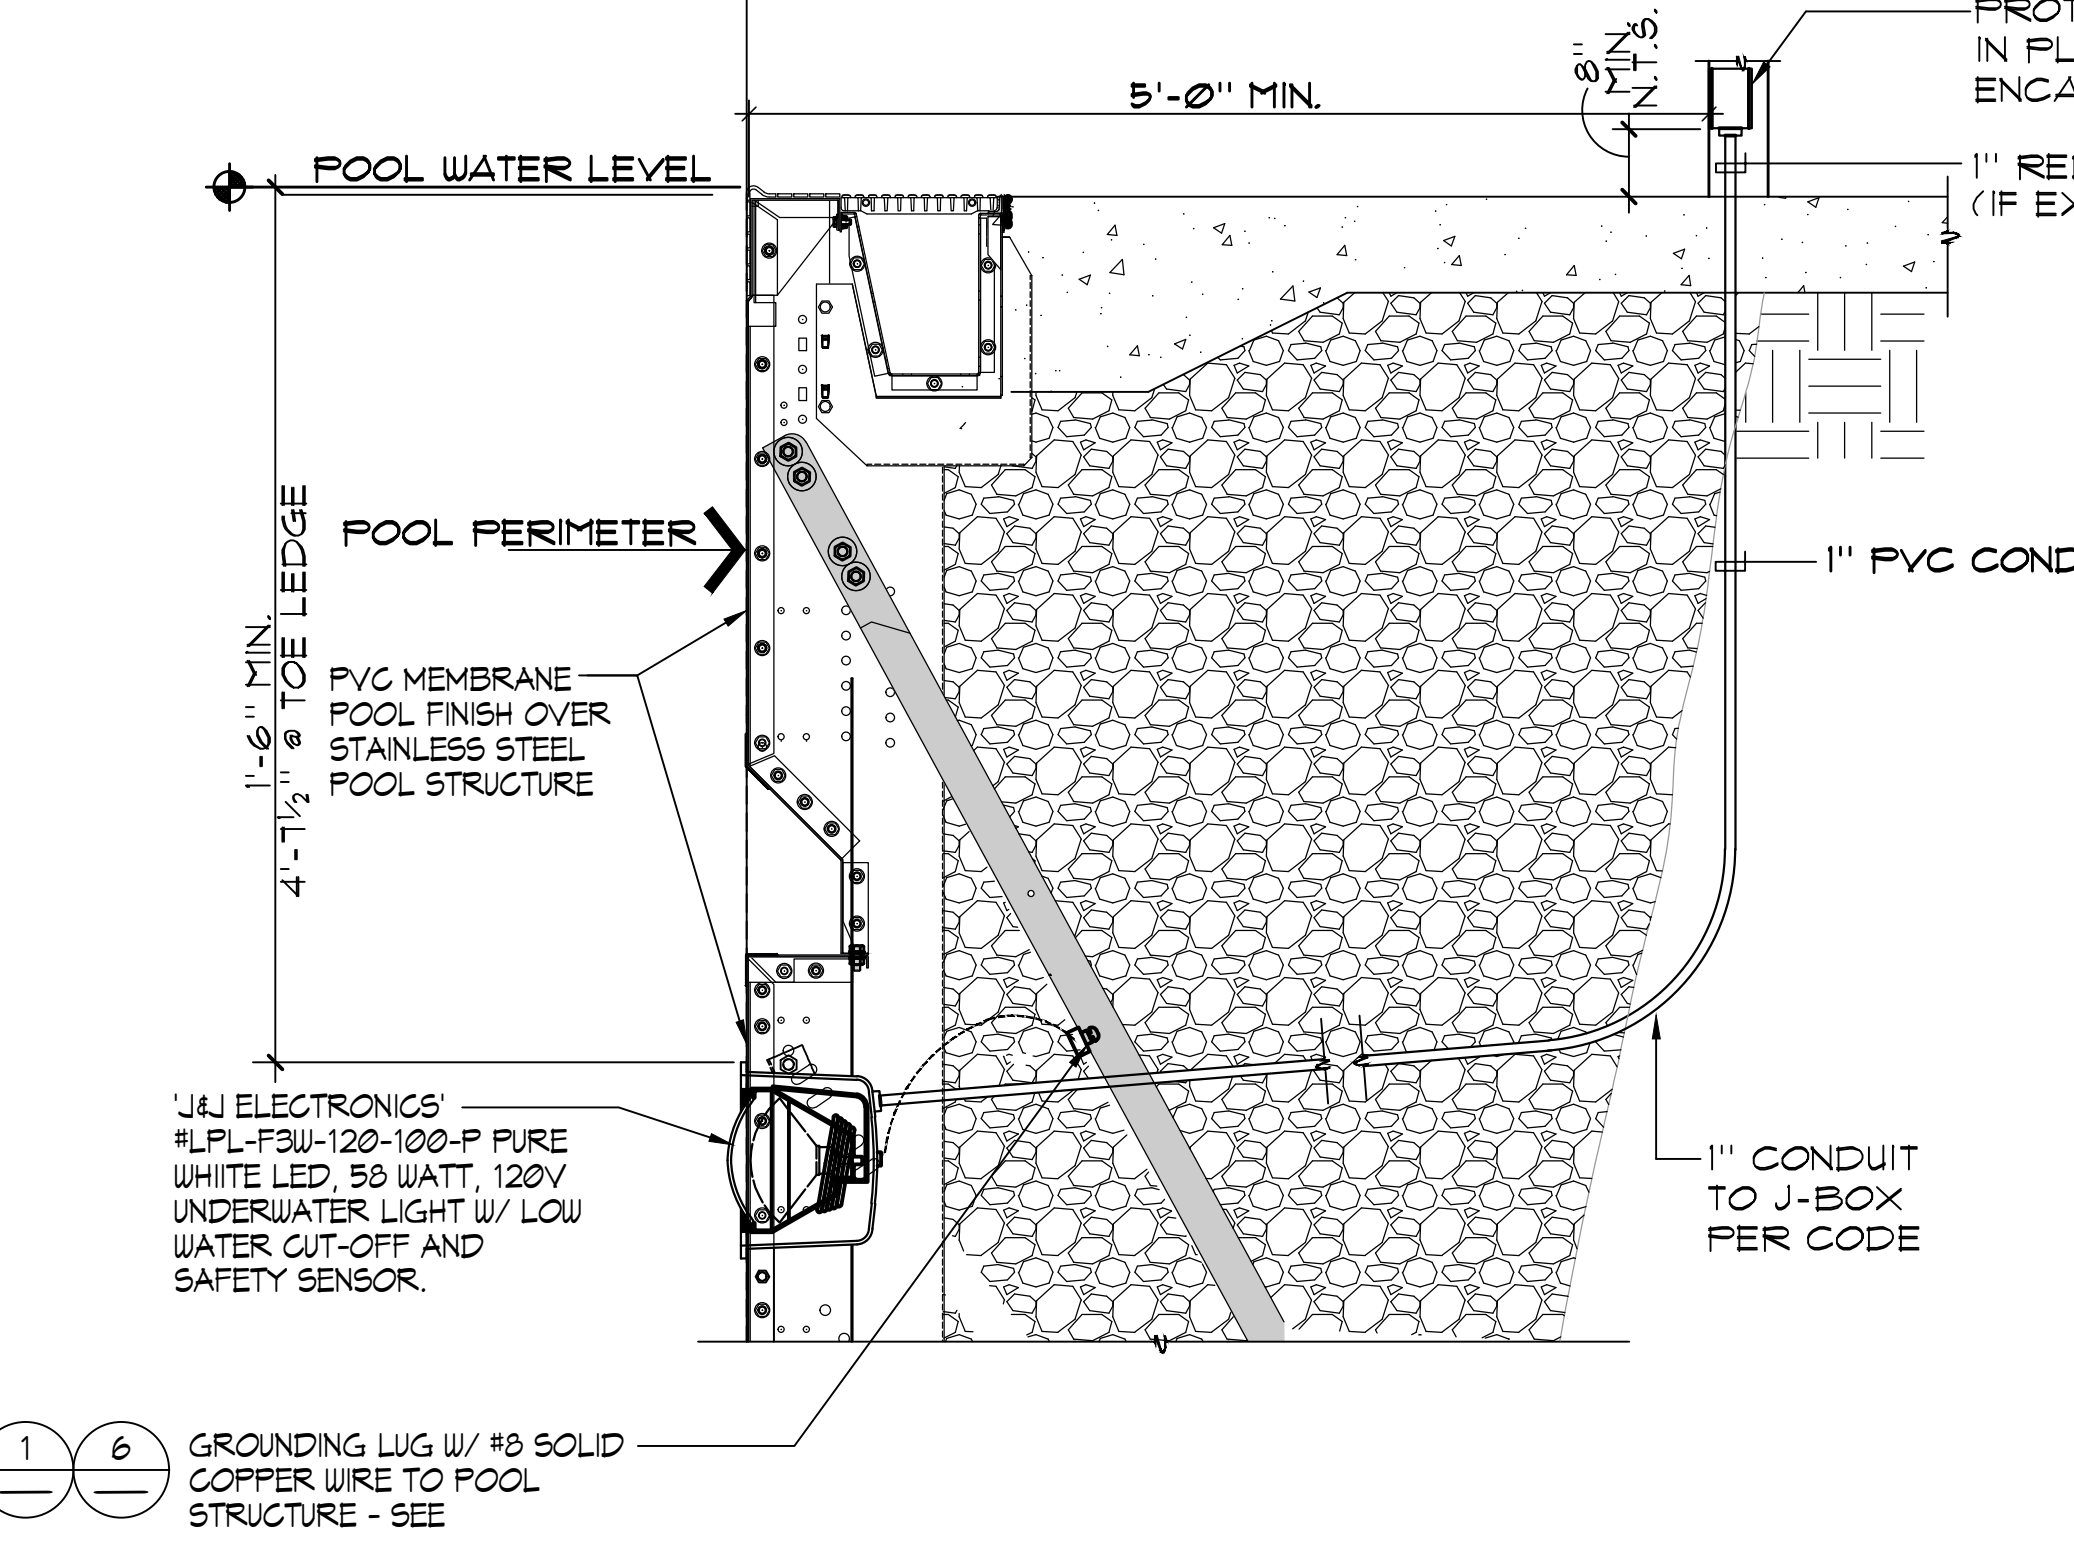


- UNDERWATER LIGHT NOTES:**
- ALL CONDUITS IN POOL LIGHTING SYSTEM TO BE A MINIMUM OF 1".
 - CONDUITS TO POOL J-BOXES SHALL BE MINIMUM 2-#8 & 1#8 (SEE UNDERWATER LIGHT PLAN) SOLID UNBROKEN TO MAIN PANEL ISOLATED GROUND BUSS. THIS BUSS IS TO BE CONNECTED WITH SOLID INSULATED #8 COPPER WIRE TO UFER & COLDWATER GROUNDING LUG ON GROUNDING BUSS. UPSIZE CONDUITS AS REQUIRED FOR HOMERUNS EXCEEDING 100'.
 - ALL BRASS POOL J-BOXES SHALL BE FLUSH MOUNTED IN WALLS. IF FLUSH MOUNTING IS NOT POSSIBLE THEN MOUNTING SHALL BE SURFACE MOUNTED AND CONCRETE ENCASED.
 - CONDUITS WHERE ALLOWED BY CODE SHALL BE P.V.C. (POLYVINYL CHLORIDE) FROM WET NICHES TO BRASS J-BOXES TO LIGHTING PANEL. ALL CONDUITS IN FREE AIR SPACE AND ALL RISERS SHALL BE RED BRASS TYPICAL. PVC CONDUITS SHALL BE SOLVENT WELDED WITH PURPLE PRIMER AND GRAY HEAVY BODIED GLUE.
 - LIGHTING CONTACTORS SHALL BE "ALLEN-BRADLEY" #500 L, OR EQUAL MOUNTED IN A NEMA 12 HINGED COVER - LOCKABLE ENCLOSURE. CONTACTORS TO BE SWITCHED BY MOMENTARY SWITCH EQUAL TO "HUBBELL" #1551 MOUNTED IN J-BOX IN MECHANICAL EQUIPMENT ROOM. REFER TO ELECTRICAL PLANS FOR LOCATION OF OWNER COORDINATED REMOTE UNDERWATER LIGHT SWITCH.
 - BRASS POOL J-BOXES SHALL BE "HYDREL" #1119, 1/2" HUBS OR EQUAL. (NO DIE CAST BOXES).
 - STRINGS SHALL BE PULLED IN ALL CONDUITS PRIOR TO PLACEMENT OF CONCRETE.
 - LOCAL COUNTY OR CITY CODES SHALL BE ADHERED TO. SPECIFICATIONS TO BE IN ACCORDANCE WITH SECTION 600 OF LATEST N.E.C. BOOK.
 - PROVIDE PULL BOXES AS MAY BE REQUIRED FOR RUNS EXCEEDING 150 FT. OR DUE TO CHANGES IN GRADE OR DIRECTION.
 - CONTRACTOR SHALL TEST UNDERWATER POOL LIGHT GFC CIRCUITS AND PROVIDE LETTER TO OWNER/DSA UPON SUCCESSFUL TEST.
 - SEAL CONTACT OPENING IN LIGHT NICHE WITH SILICON CAULKING AFTER LIGHT IS INSTALLED.
 - PRIOR TO LIGHT INSTALLATION, PROVIDE MINIMUM 10 PSI PRESSURE TEST ON ALL POOL LIGHT CONDUITS FOR FOUR (4) HOURS OBSERVED BY INSPECTOR OF RECORD. MAINTAIN PRESSURE UNTIL ALL DECKS ARE POURED.

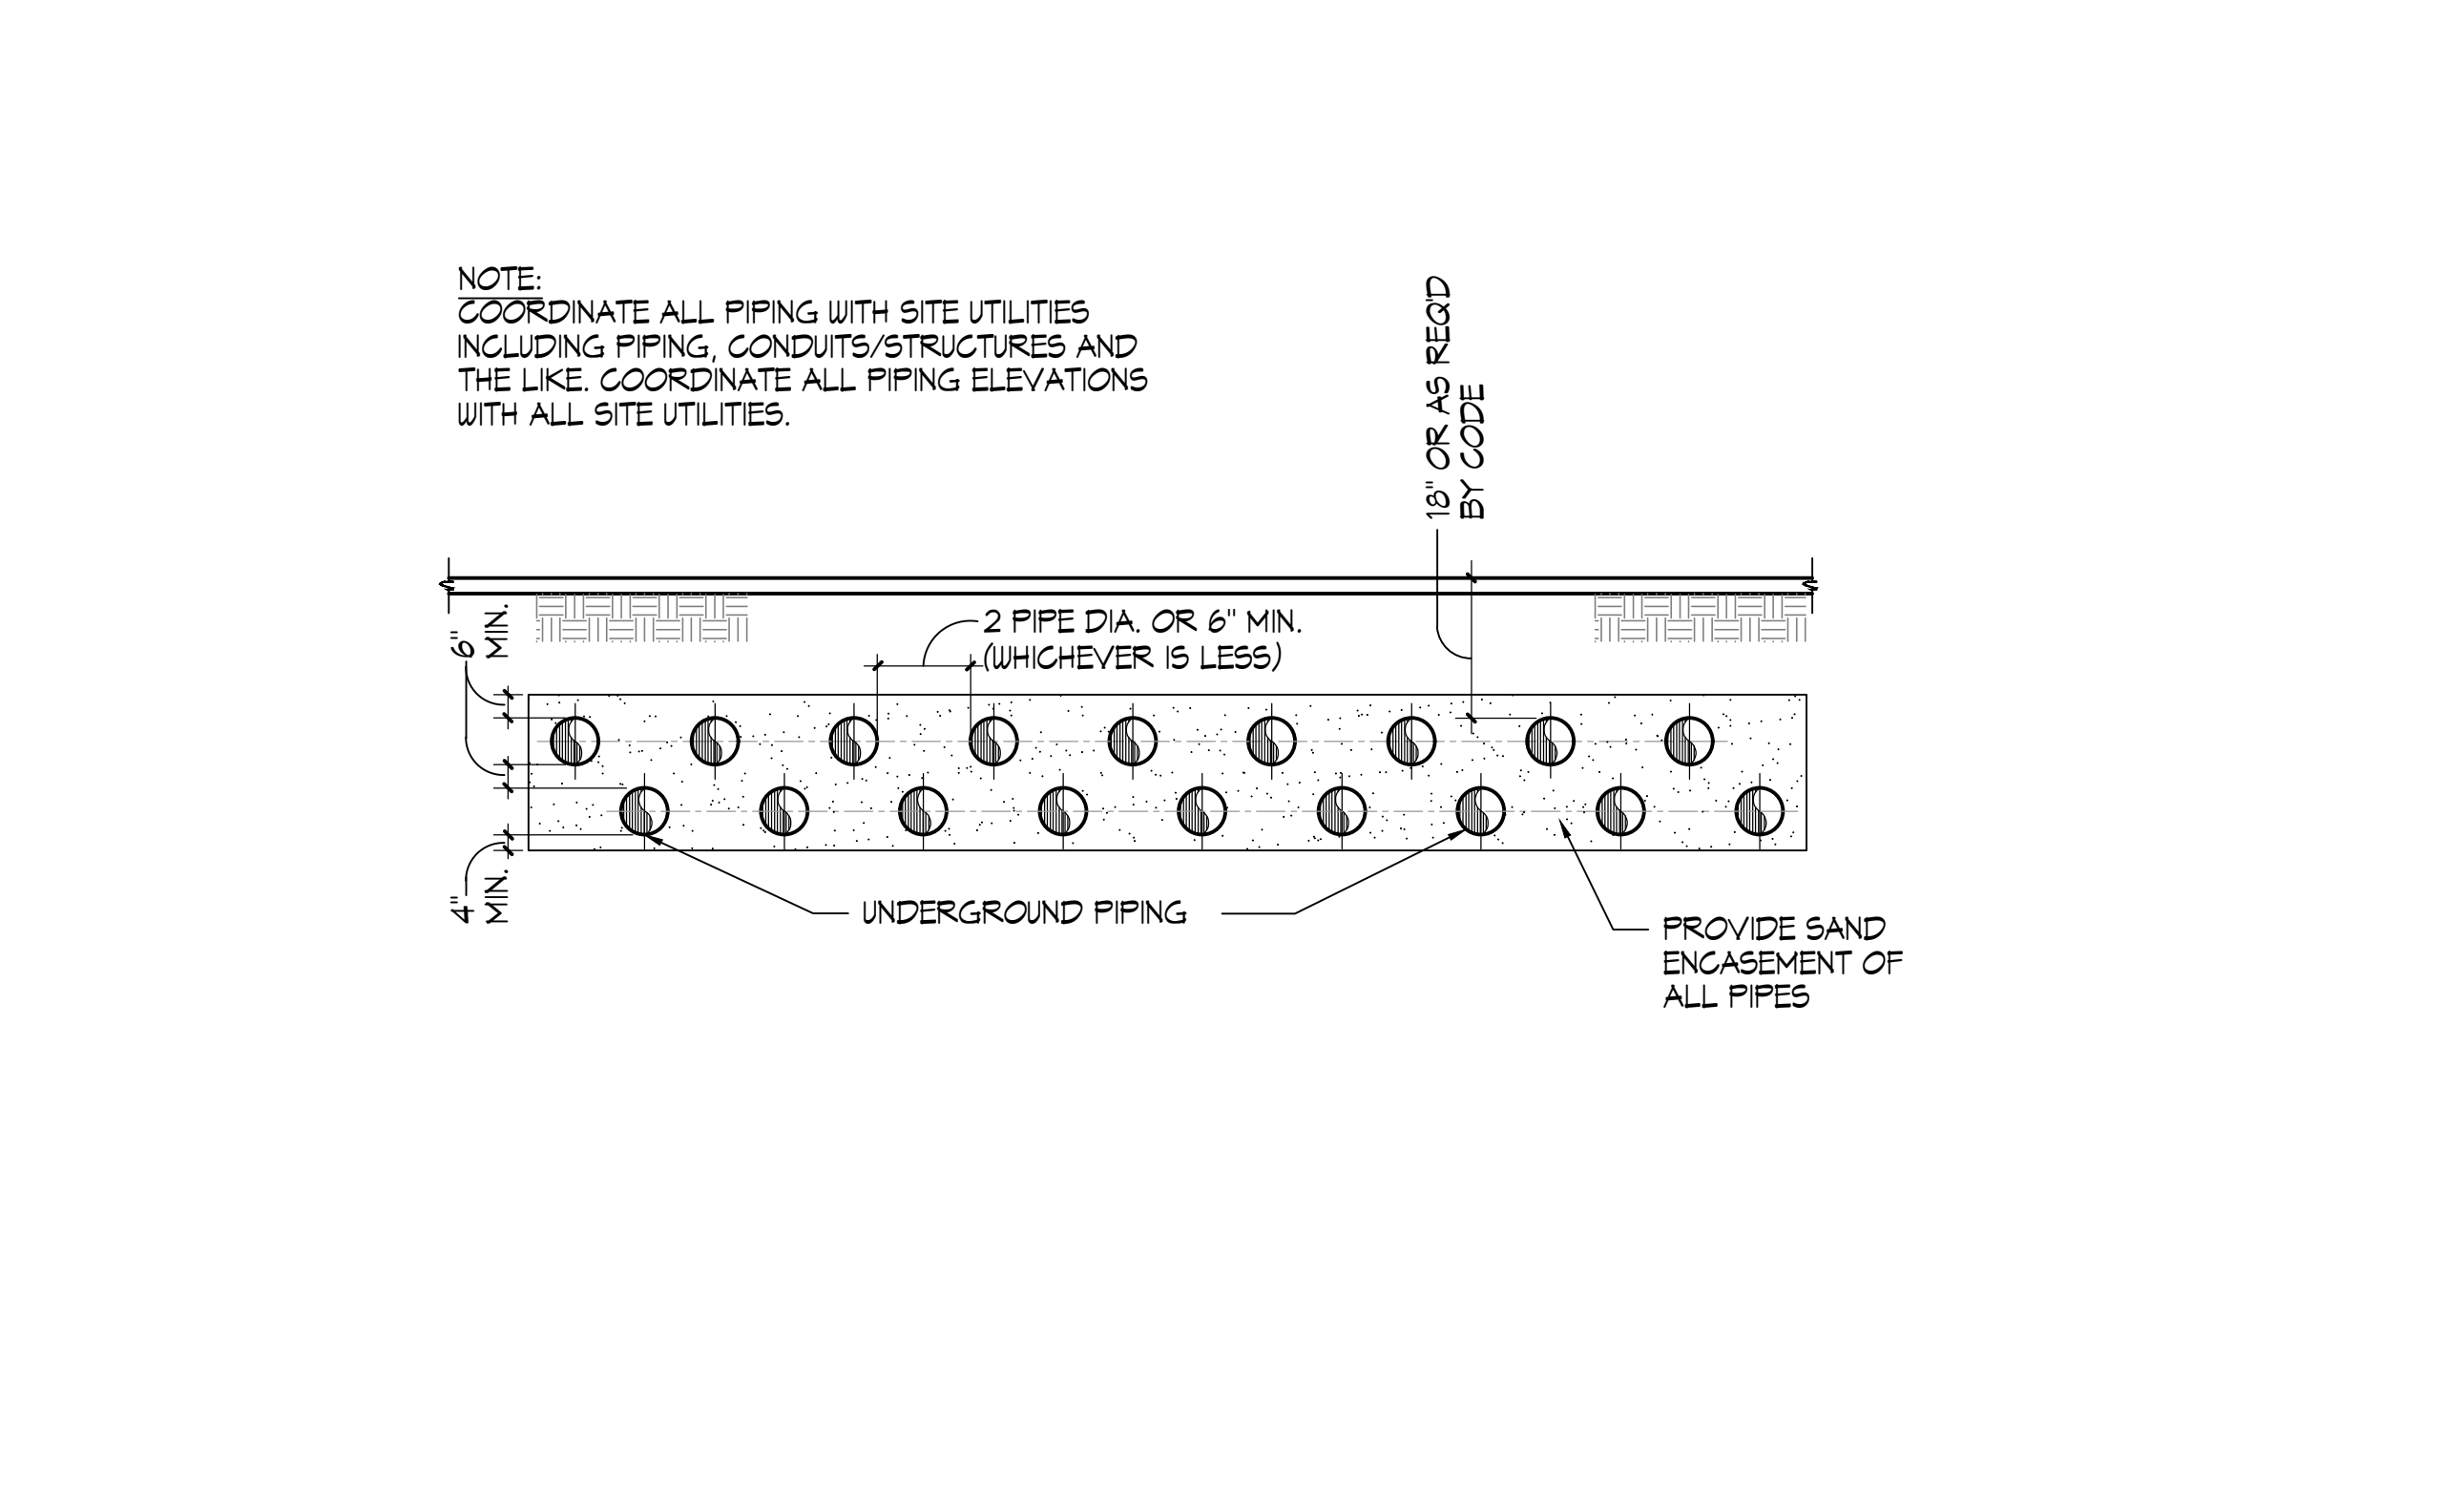


4 UNDERWATER LIGHT 1"=1'-0"


5 STACKED UNDERGROUND PIPING NO SCALE

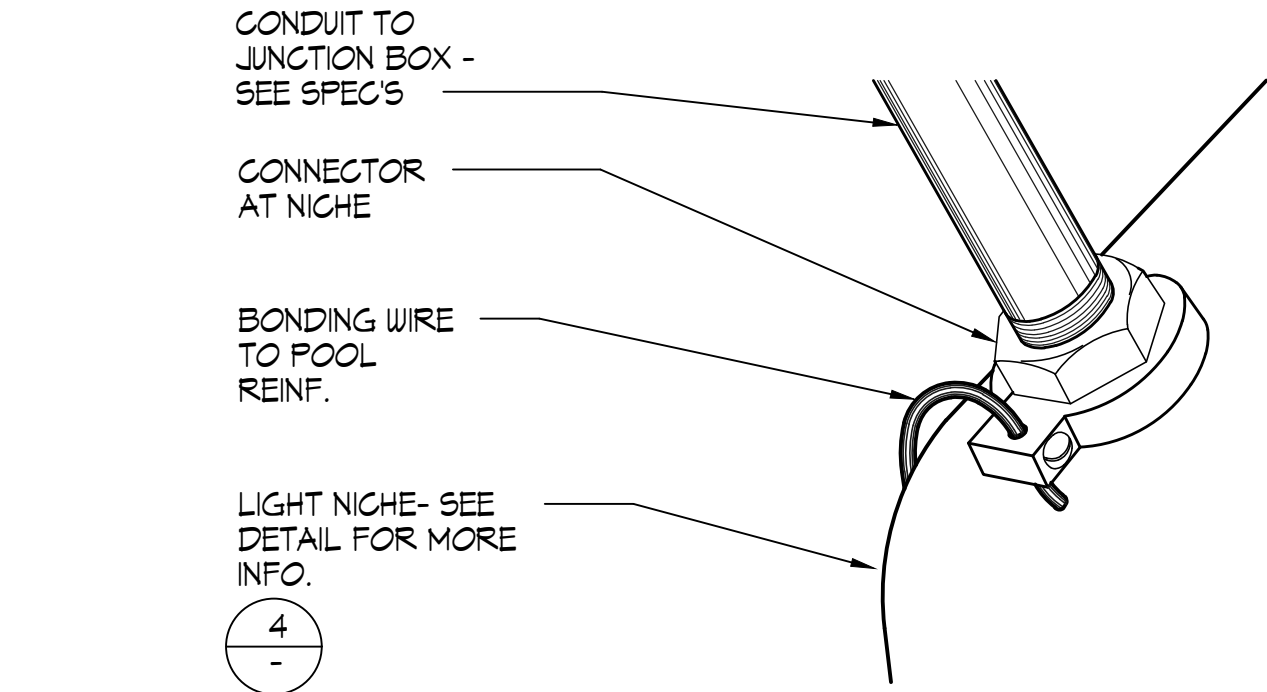


NICHE CONNECTOR
NO SCALE

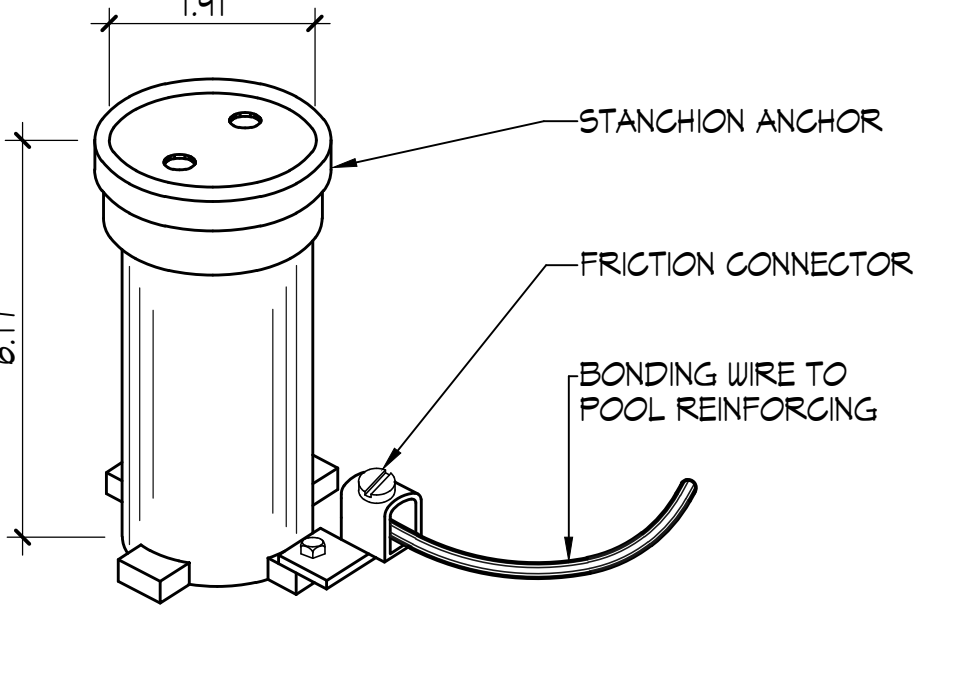


STANCHION ANCHOR
NO SCALE

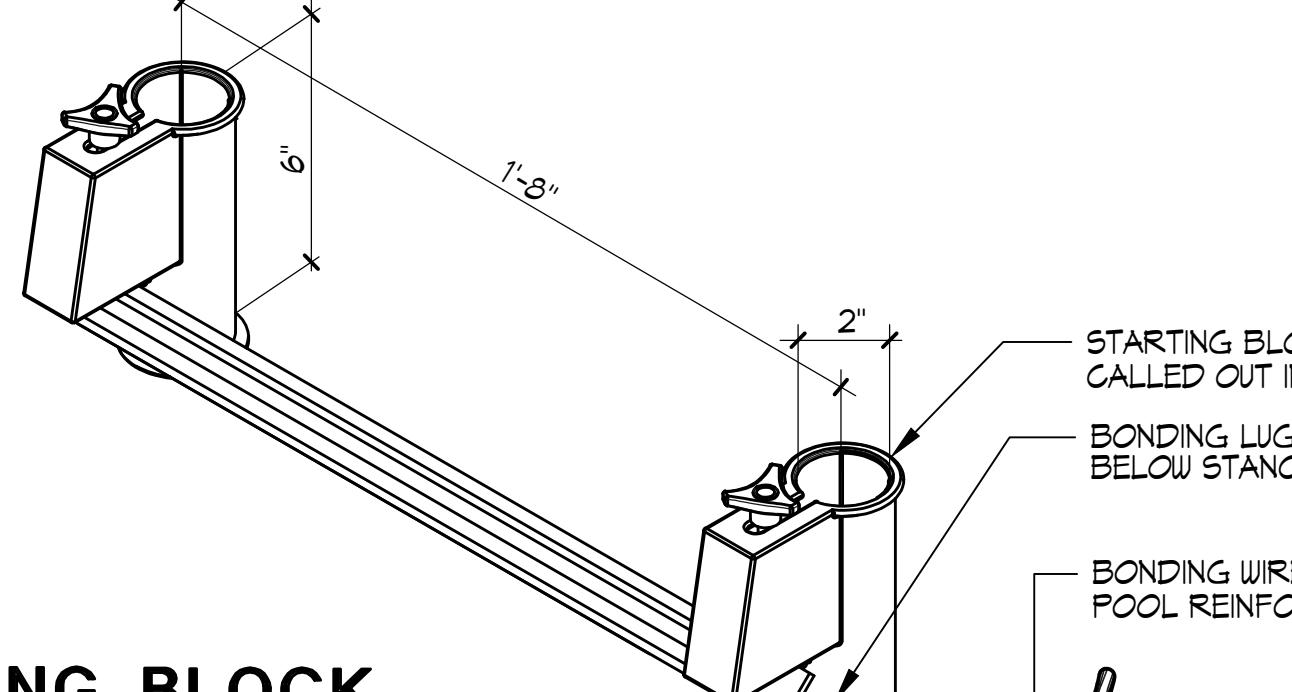


STARTING BLOCK ANCHOR
NO SCALE

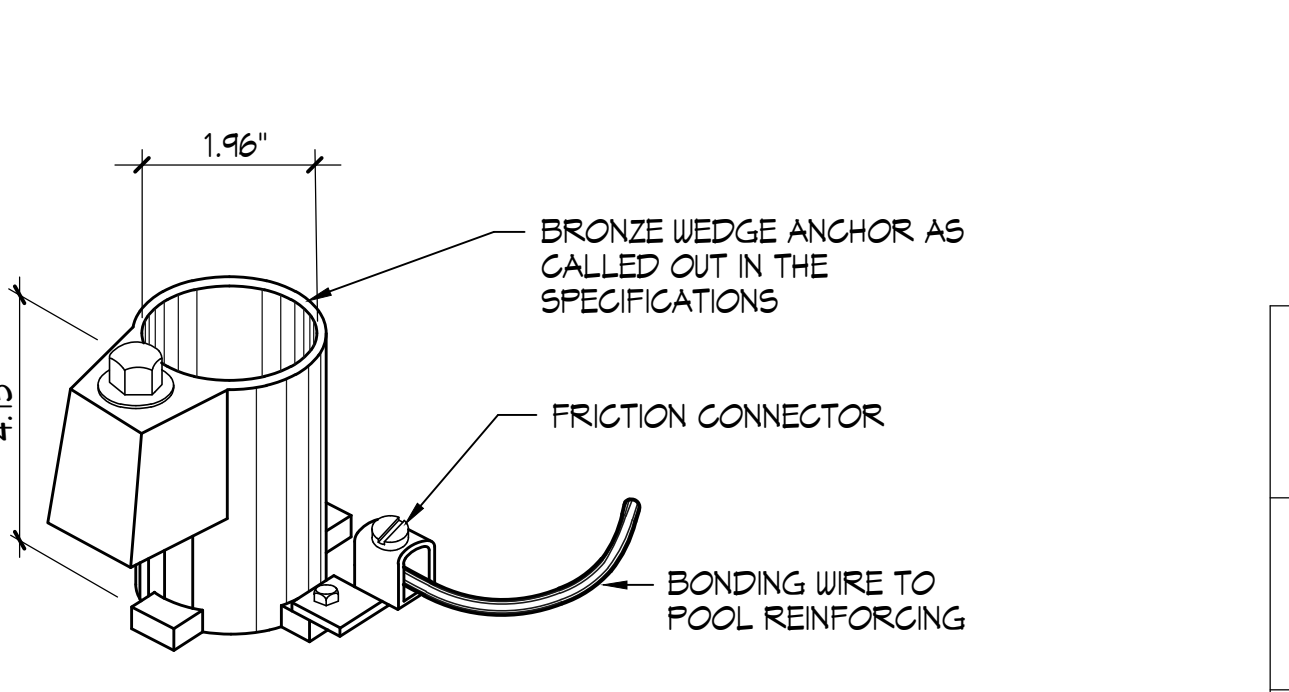


WEDGE ANCHOR
NO SCALE

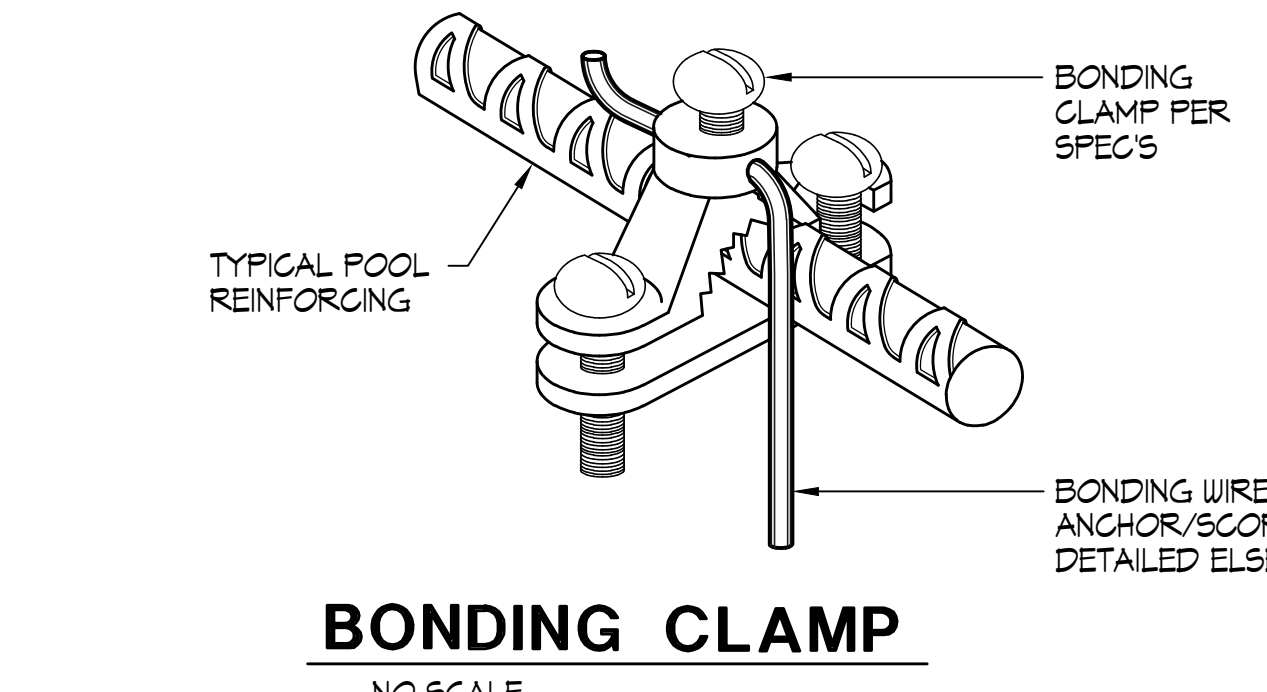


BONDING CLAMP
NO SCALE

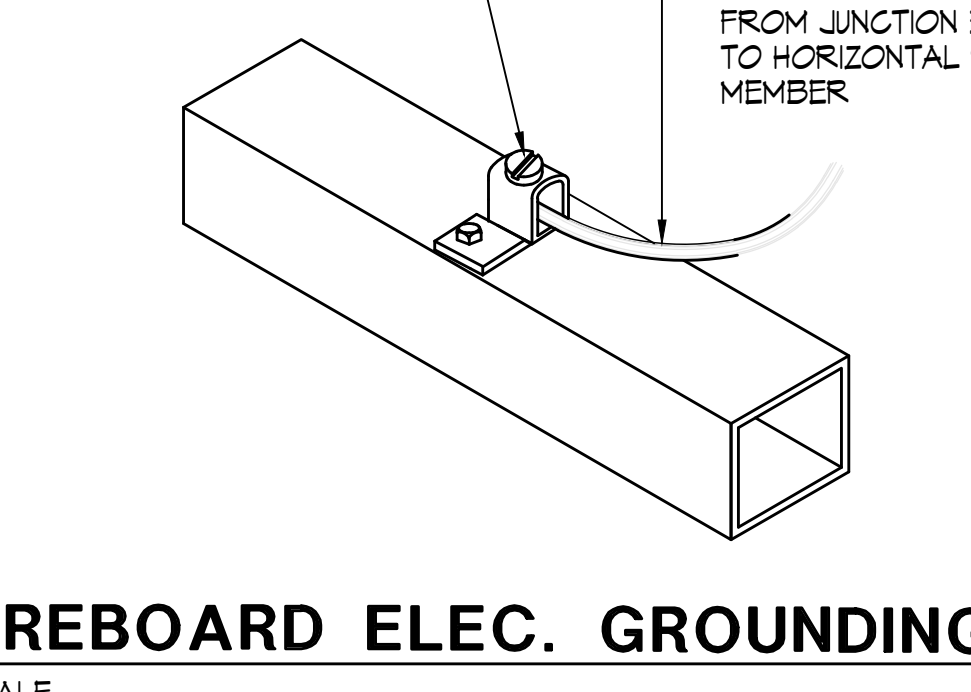

SCOREBOARD ELEC. GROUNDING
NO SCALE

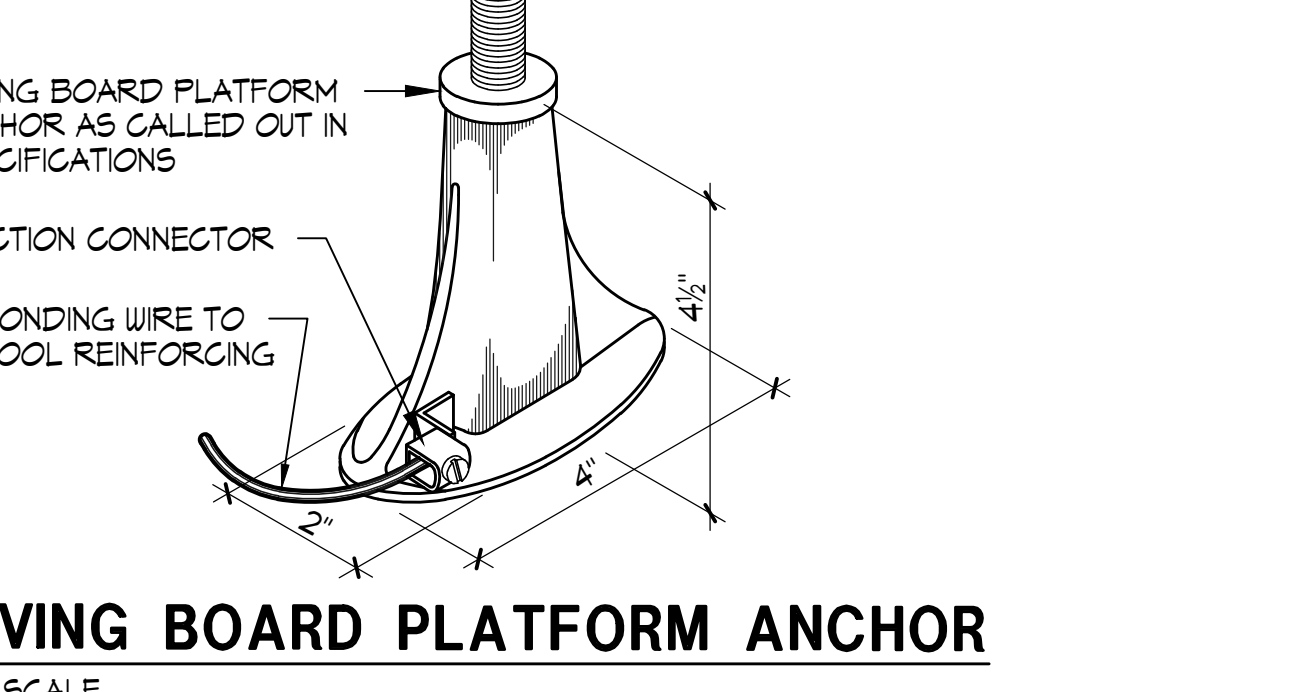

DIVING BOARD PLATFORM ANCHOR
NO SCALE

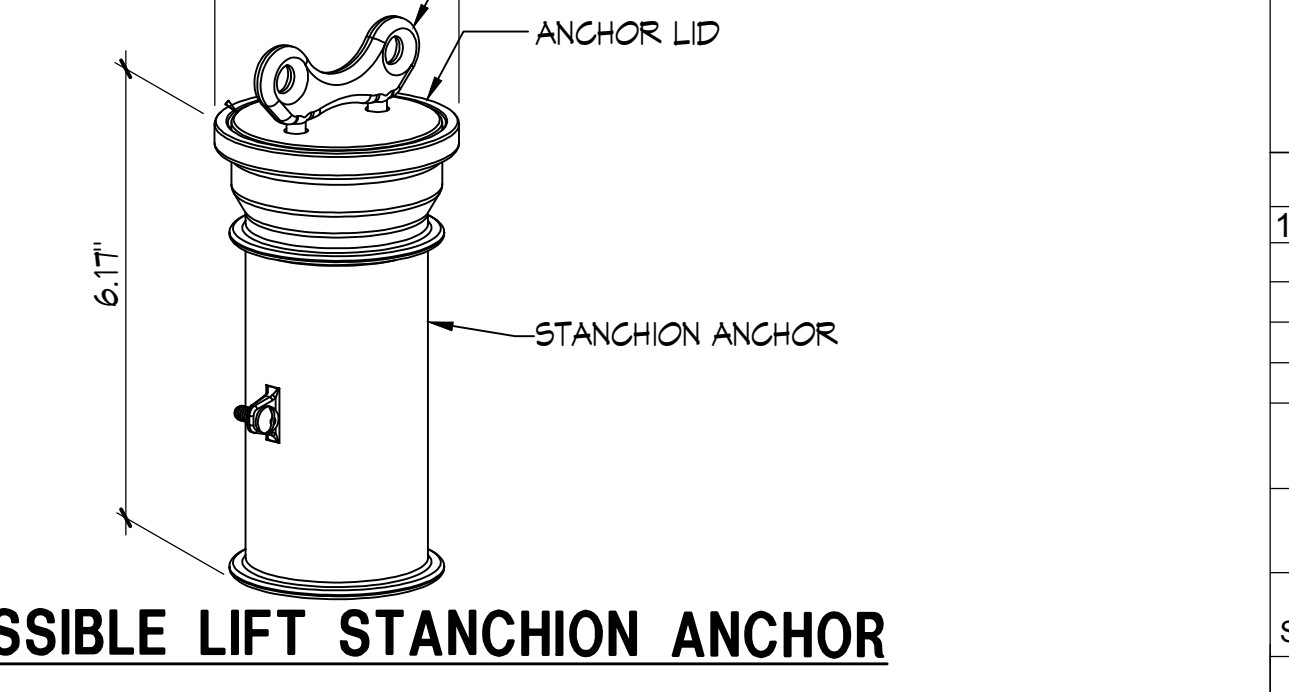

ACCESSIBLE LIFT STANCHION ANCHOR
NO SCALE

6 BONDING DETAILS NO SCALE



Mission Oak HS Aquatic Complex
Tulare Joint Union High School District
Tulare, CA 93274

Project

ARCHITECTURE
PLANNING
INTERIORS
www.dardenarchitects.com
6790 N. West Ave. • Fresno, CA 93711 • T. 559.448.8051

No.	Revision/Submission	Date
1	REVISION_01	05/31/2023

Designed By Designer Copyright 2022 Darden Architects

Scale: PER PLAN Drawn By: AP
Project Number: 2180 Checked By: GF
Date: 7/28/2022 Reviewed By: -

CP-12

GENERAL NOTES:

APPLICABLE BUILDING CODE

All construction and workmanship shall conform to the 2019 California Building Code, California Code of Regulations - Title 24, Parts 1 & 2.

This pole and foundation standard has been designed for lateral loads on the completed structure as follows:

- Wind Design Data:
 - Vult = 94 MPH (Exposure C); Vasd = 73 MPH (Exposure C)
 - Risk Category = II
 - See Pole Foundation Schedule for maximum pole wind forces.

- Seismic Design Data:
 - Ie = 1.0
 - Risk Category = II (Self Supporting Poles)
 - Ss = 0.587
 - Si = 0.229
 - Site Class = D
 - Ss = 0.521
 - Su = 0.327
 - Seismic Design Category = D
 - Basic Seismic-Force-Resisting System = Non-Building Structure, not similar to buildings
 - Cs = 0.141 (STRENGTH LEVEL)
 - R = 1.5
 - Ω = 1.5
 - Analysis Procedure = Equivalent Lateral Force Procedure
 - See Pole Foundation Schedule for maximum pole seismic forces.

GENERAL CONSTRUCTION

These notes shall be used in conjunction with the plans and any discrepancies shall be brought to the attention of the Registered Design Professional (RDP) in Responsible Charge.

Contractor must check all dimensions, clearances and job conditions before starting work. The RDP in Responsible Charge shall be notified immediately of any discrepancies or possible deficiencies.

The drawings and specifications represent the finished structure. All bracing, temporary supports, shoring, etc., is the sole responsibility of the Contractor. Observation visits to the job site by the RDP in Responsible Charge do not include inspection of construction procedures. The Contractor is solely responsible for all construction methods and for safety conditions at the worksite. These visits by RDP in Responsible Charge shall not be construed as continuous and detailed inspections.

Design, material, equipment, and products other than those described below or indicated on the drawings may be considered for use, provided prior approval is obtained from the School District, the RDP in Responsible Charge, and DSA.

All changes to the approved plans after a contract for construction has been awarded, affecting structural, access or life-safety portions of the project, shall be made by means of construction change documents (CCD) approved by DSA, as required by Section 4-338, Part 1, Title 24, CCR. All CCD shall be prepared and signed by the RDP in general Responsible Charge.

Substitutions shall be considered as a CCD and shall be approved by DSA prior to fabrication or use.

A Class 1 or Class 2 Project Inspector employed by the School District (Owner) and approved by DSA shall provide continuous inspection of the work, the duties of the inspector are defined in Section 4-342, Part 1, Title 24, CCR.

All Tests And Inspections shall be performed by an Independent lab employed by the School District and approved by DSA.

Reference pole location on the Architectural, Structural, and/or Electrical drawings for actual pole placement and site location. Pole shall be located 5'-0" min. from adjacent structures below 50'-0" A.G.L., unless noted otherwise.

LIGHT POLE FOUNDATIONS

Reference geotechnical report prepared by Technicon Engineering Services, Inc., Dated May 17, 2022; Project no. 220239.001.

Allowable Vertical soil Capacity - 70DL² (Skin Friction - D=pier diameter (FT), L=embedment length (FT)).

Allowable Lateral Bearing capacity: 175 PSF/FT to maximum 2,100 PSF (Values may be increased 1/2 for wind and seismic loading).

A representative of Technicon Engineering Services, Inc. should be available at the time of the foundation installation to verify the soil design parameters and to provide assistance if any problems arise in foundation installation.

The Contractor must familiarize himself with the complete geotechnical report, and borings and contact the above firm to understand the soil conditions and the possibility of ground water pumping and excavation stabilization or bracing during the foundation installation and placement of concrete.

Soil formations that will require special design considerations or excavation procedures may exist. Pole foundations may need to be reanalyzed according to the soil conditions that exist.

If any discrepancies or inconsistencies arise, notify the RDP in Responsible Charge of such discrepancies.

All piers and concrete must bear on and against firm undisturbed soil as determined by the Geotechnical Engineer.

Place plywood collar around perimeter at the top of foundation excavation to prevent soil from entering pier.

All excavations must be free of loose soil, and debris prior to foundation installation and placement of concrete. Casing or drilling slurry may be required if caving occurs. Review and approval of the Geotechnical Engineer and DSA is required.

All excavations must be free of water or concrete shall be placed by the Tremie Method in accordance with ACI standard 336. Concrete placed by the Tremie Method shall have a minimum ultimate strength of 1,000 PSI greater than required under "Concrete Cast-in-Place" and a maximum slump of 8".

CONCRETE (CAST-IN-PLACE)

Concrete pier foundations with steel reinforcement shall attain a minimum ultimate compressive strength at 28 day test of 3,000 psi. Batch plant inspection not required.

All concrete shall attain a minimum strength of 2,500 psi prior to steel pole erection.

Use Type II/V Portland cement or as directed by the Geotechnical Engineer.

Portland Cement ASTM C-150.

Aggregate ASTM C-33. 1" maximum aggregate size. 3/8" max agg. size acceptable where pump mixes are used at unreinforced concrete backfill. 3/8" max agg. size not permitted at reinforced piers.

Mix in conformance with ASTM C-94, ACI 318 SECTIONS 19.2 and 26.4.

Place concrete immediately after completion of excavation and inspection by the Geotechnical Engineer and the DSA Inspector. Under no circumstances shall piers be allowed to remain open for more than 12 hours without the approval of the Geotechnical Engineer. Excavations shall be covered and protected until filled with concrete.

Concrete shall be placed in one continuous operation (no construction joint) with special equipment to assure a maximum freefall of 5 ft and to prevent concrete from striking the sides of the excavation. Freefall of concrete is unacceptable through water or drilling slurry.

Vibrate concrete full depth, except for concrete with slump greater than 6", then vibrate only upper 10"-0". Concrete placed under water shall have a slump of 6"-8".

STEEL POLE

Steel pole sections conform to the California Code of Regulations T.24, Part 2, Chapter 22A.

All steel conforms to referenced ASTM specifications. (See Pole Data Table for each pole type).

All weldment conforms with AWS D1.1-15 specification for GMAW fillet utilizing E70S-X filler metal or SAW fillet utilizing F7XX-EXXX or FBXX-EXXX filler metal. GMAW procedure conforms to AWS A5.18. SAW procedure conforms to AWS A5.23.

Longitudinal seam welds for pole sections shall have 60% minimum penetration; Except longitudinal seam welds on the female section of telescopic field splices shall be full penetration groove welds for a length equal to the minimum splice length plus 6 inches. See drawing number MD1 for seam weld details.

Pole sections hot dipped galvanized to ASTM A123 latest standards.

All miscellaneous structural steel items conform to AISC 360-16.

Steel pole sections shall be assembled in the field by attaching two 1.5 ton "come alongs" to jacking ears, using full effort on each simultaneously, to ensure minimum overlaps as indicated on the "MS" sheet(s) and detail G/MD1.

PRECAST BASE

The precast concrete base conforms to California Code of Regulations, T.24, part 2, Chapter 19A and to Building Code Requirements for Reinforced Concrete, ACI 318-14.

See detail "A" on "MS" sheet(s) for material strengths and specifications.

TESTING AND INSPECTION

Testing and inspection in accordance with Title 24, Part 1 & Part 2 & project DSA 103 form.

EXCAVATIONS & FOUNDATIONS: Inspection of cast-in-place deep foundations - 1705A.8 & Table 1705A.8

CONCRETE MATERIALS: 1903A.1 Portland cement - 1910A.1 Concrete aggregates - 1903A.5 Reinforcing bars - 1910A.2 & DSA IR 17-10 Prestressing steel and anchorages - 1910A.3

CONCRETE QUALITY: Proportions of concrete - Reference ACI 318 Section 26.4.3.1 Through 26.4.4.1. Strength tests of concrete - 1905A.1.15 and ACI 318 Section 26.12 & 26.5.3.2.

CONCRETE INSPECTION: 1705A.3 & Table 1705A.3 Job site - Reference ACI 318 Section 26.5.1, 26.5.2.1(a) & (b), 26.6.1.2(d), 26.11.1(a). Batch Plant Inspection Not Required - 1705A.3.3.2 Prestressed concrete - 1704A.2.5, 1705A.3.4

STEEL MATERIALS: Structural steel - 2202A.1 & 2205A.1 Cold formed steel - 2210A.1 Identification - 2202A.1 High strength bolt identification - table 1705A.2.1 & DSA IR 17-9

STEEL QUALITY: Tests of structural steel & cold formed steel - 2202A.1 Tests of high strength bolts, nuts, & washers - 2213A.1 & DSA IR 17-8

STRUCTURAL STEEL INSPECTIONS: Table 1705A.2.1 Shop fabrication inspection - 1704A2.5 Welding - 1705A.2.5, DSA IR 17-3 and AWS D1.1. High strength bolt installation - Table 1705A.2.1 & DSA IR 17-9 (including Skidmore-Wilhelm bolt tension pre-installation verification testing) (NOTE: ALL WELDING SHALL BE CONTINUOUSLY INSPECTED BY AN AWS CWI CERTIFIED INSPECTOR APPROVED BY DSA)

These plans are for construction approval. An application number and approval of these drawings by the Division of The State Architect of California must be secured to build from these plans.

INDEX OF SHEETS

MT1 NOTES, FOUNDATION DETAIL

MS1 70A POLE DETAILS

MD1 ATTACHMENT DETAILS


MD2 ATTACHMENT DETAILS

MD3 ATTACHMENT DETAILS

Mission Oak H.S. Pool
FIELD LIGHTING
Tulare, CA




MUSCO Lighting
CORPORATE OFFICE:
P.O. Box 808
100 1st Avenue West
Oskaloosa, Iowa 52577
800/825-6020

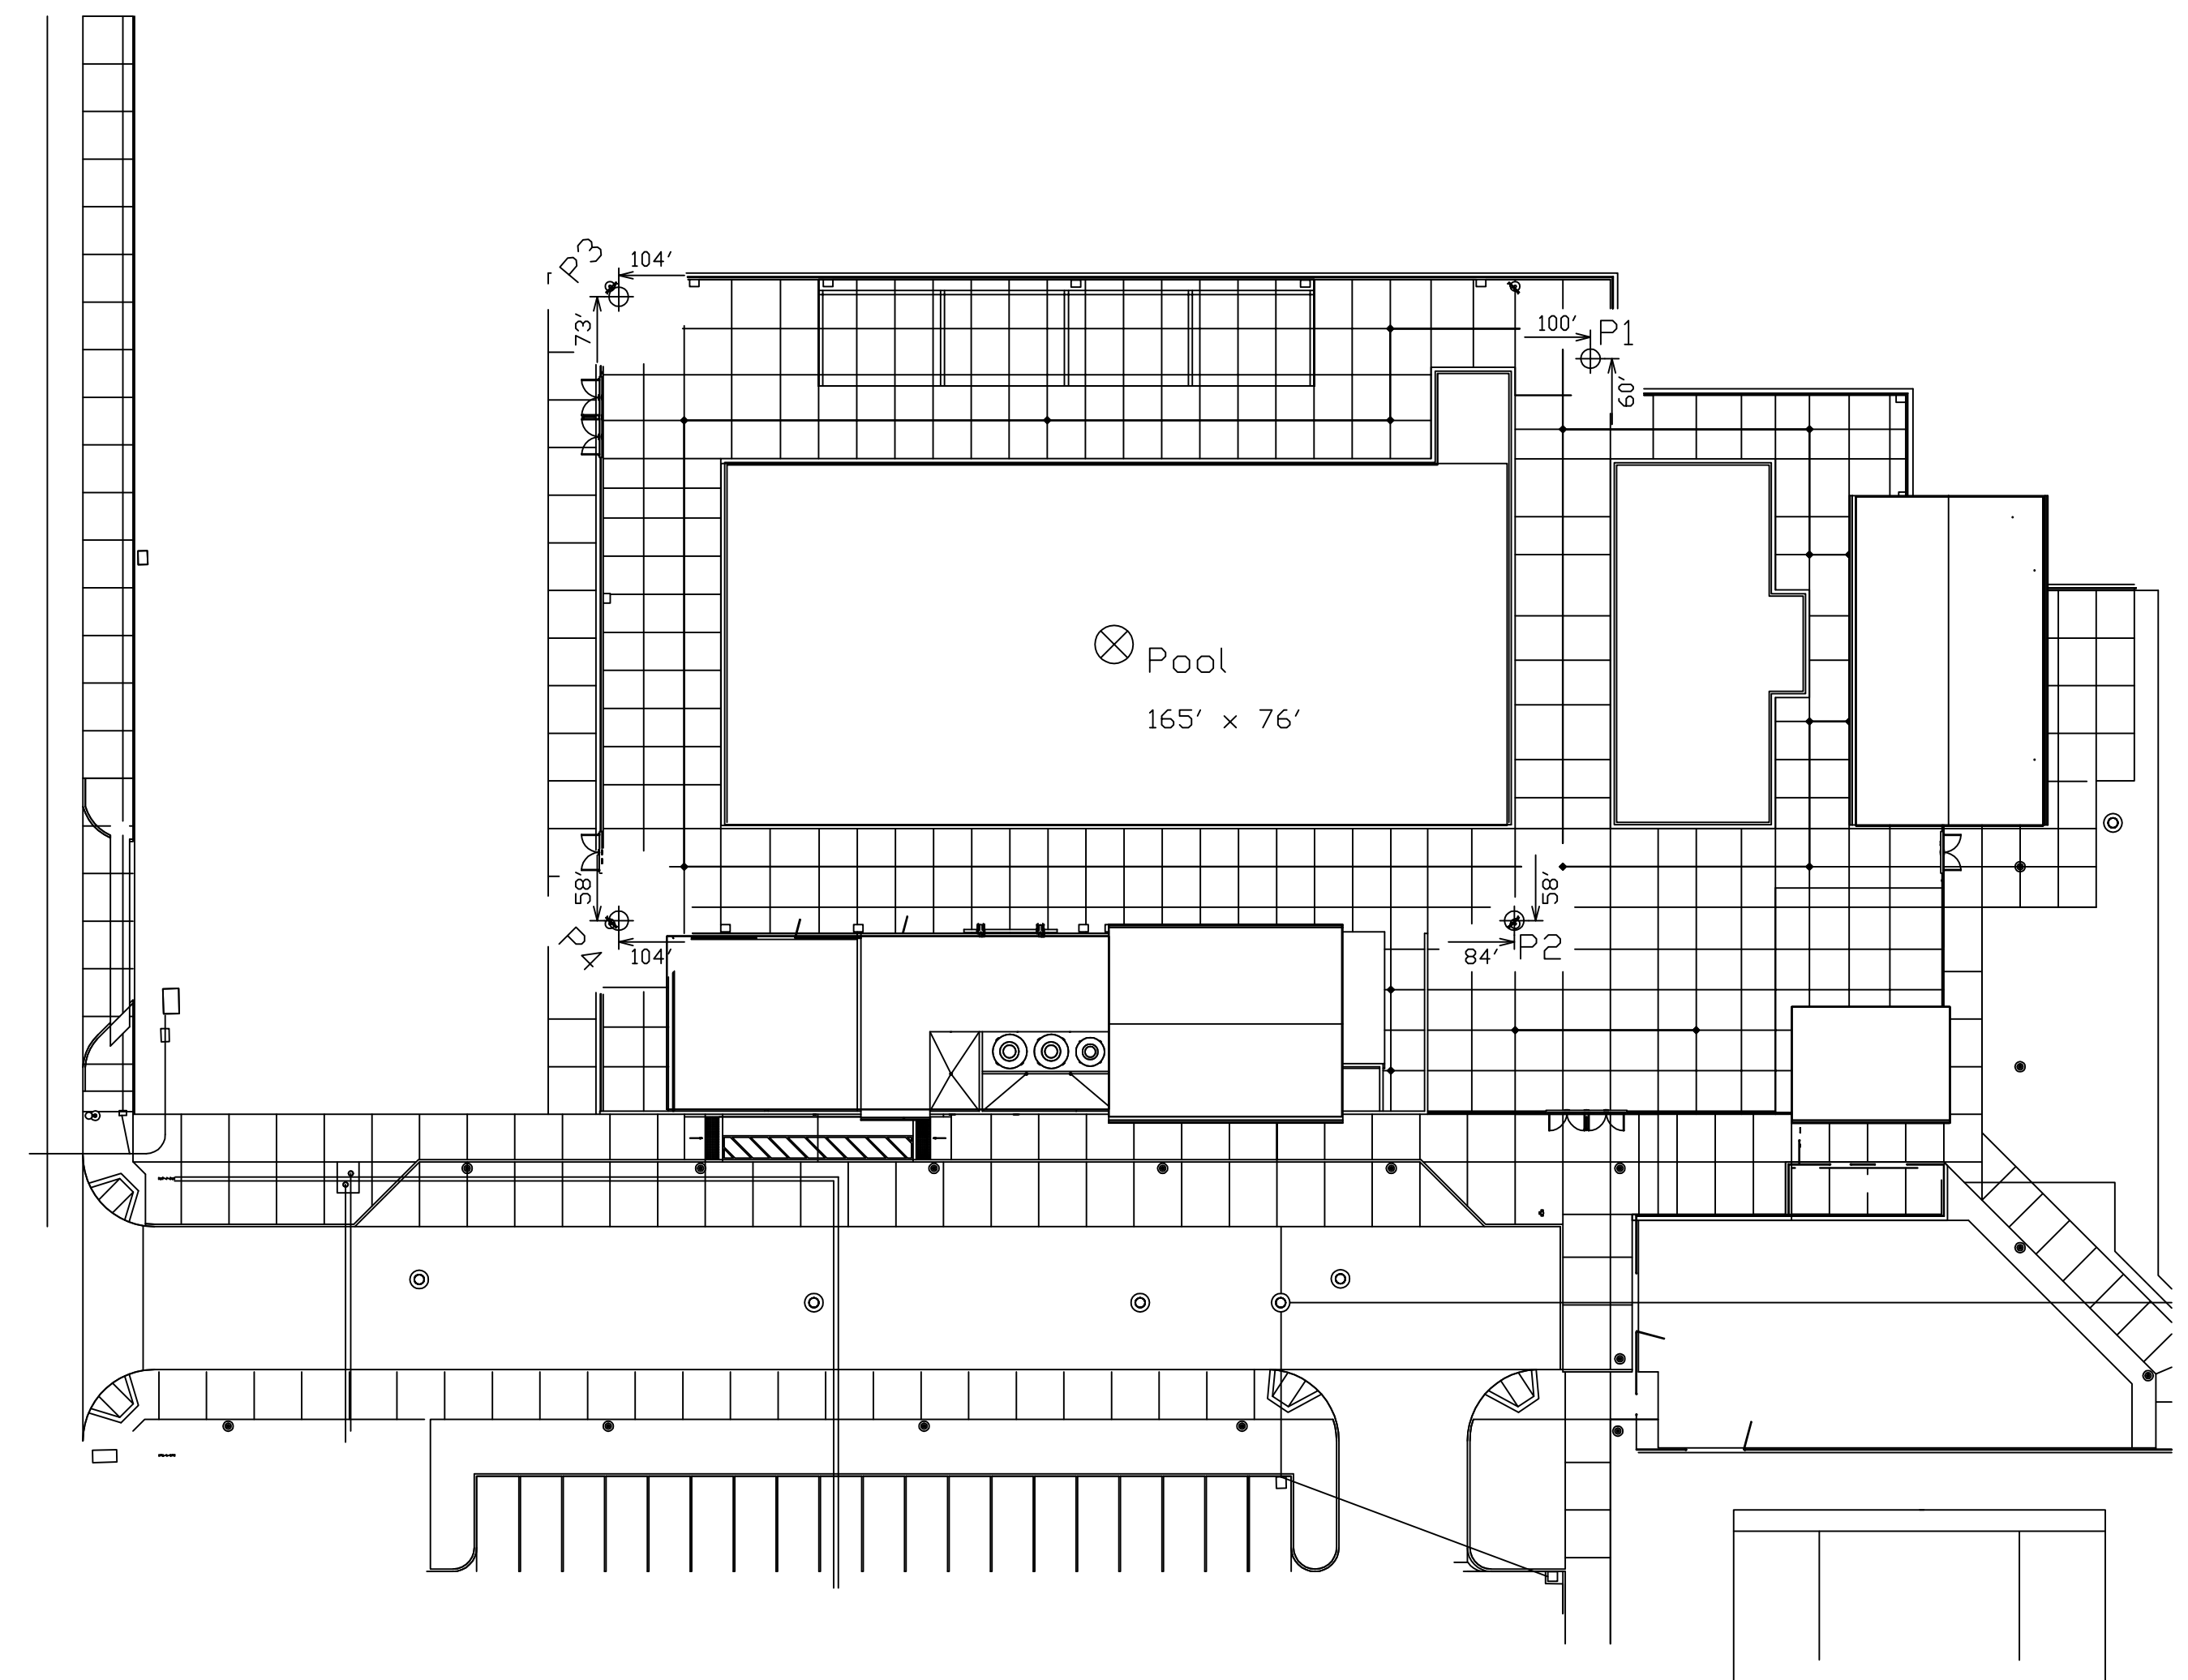

POLE ORIENTATION PLAN
N.T.S.

NOTE: THIS PLAN IS A PICTORIAL REPRESENTATION OF THE SITE LAYOUT. REFERENCE APPROPRIATE ARCHITECTURAL SITE PLAN FOR ALL NECESSARY INFORMATION.

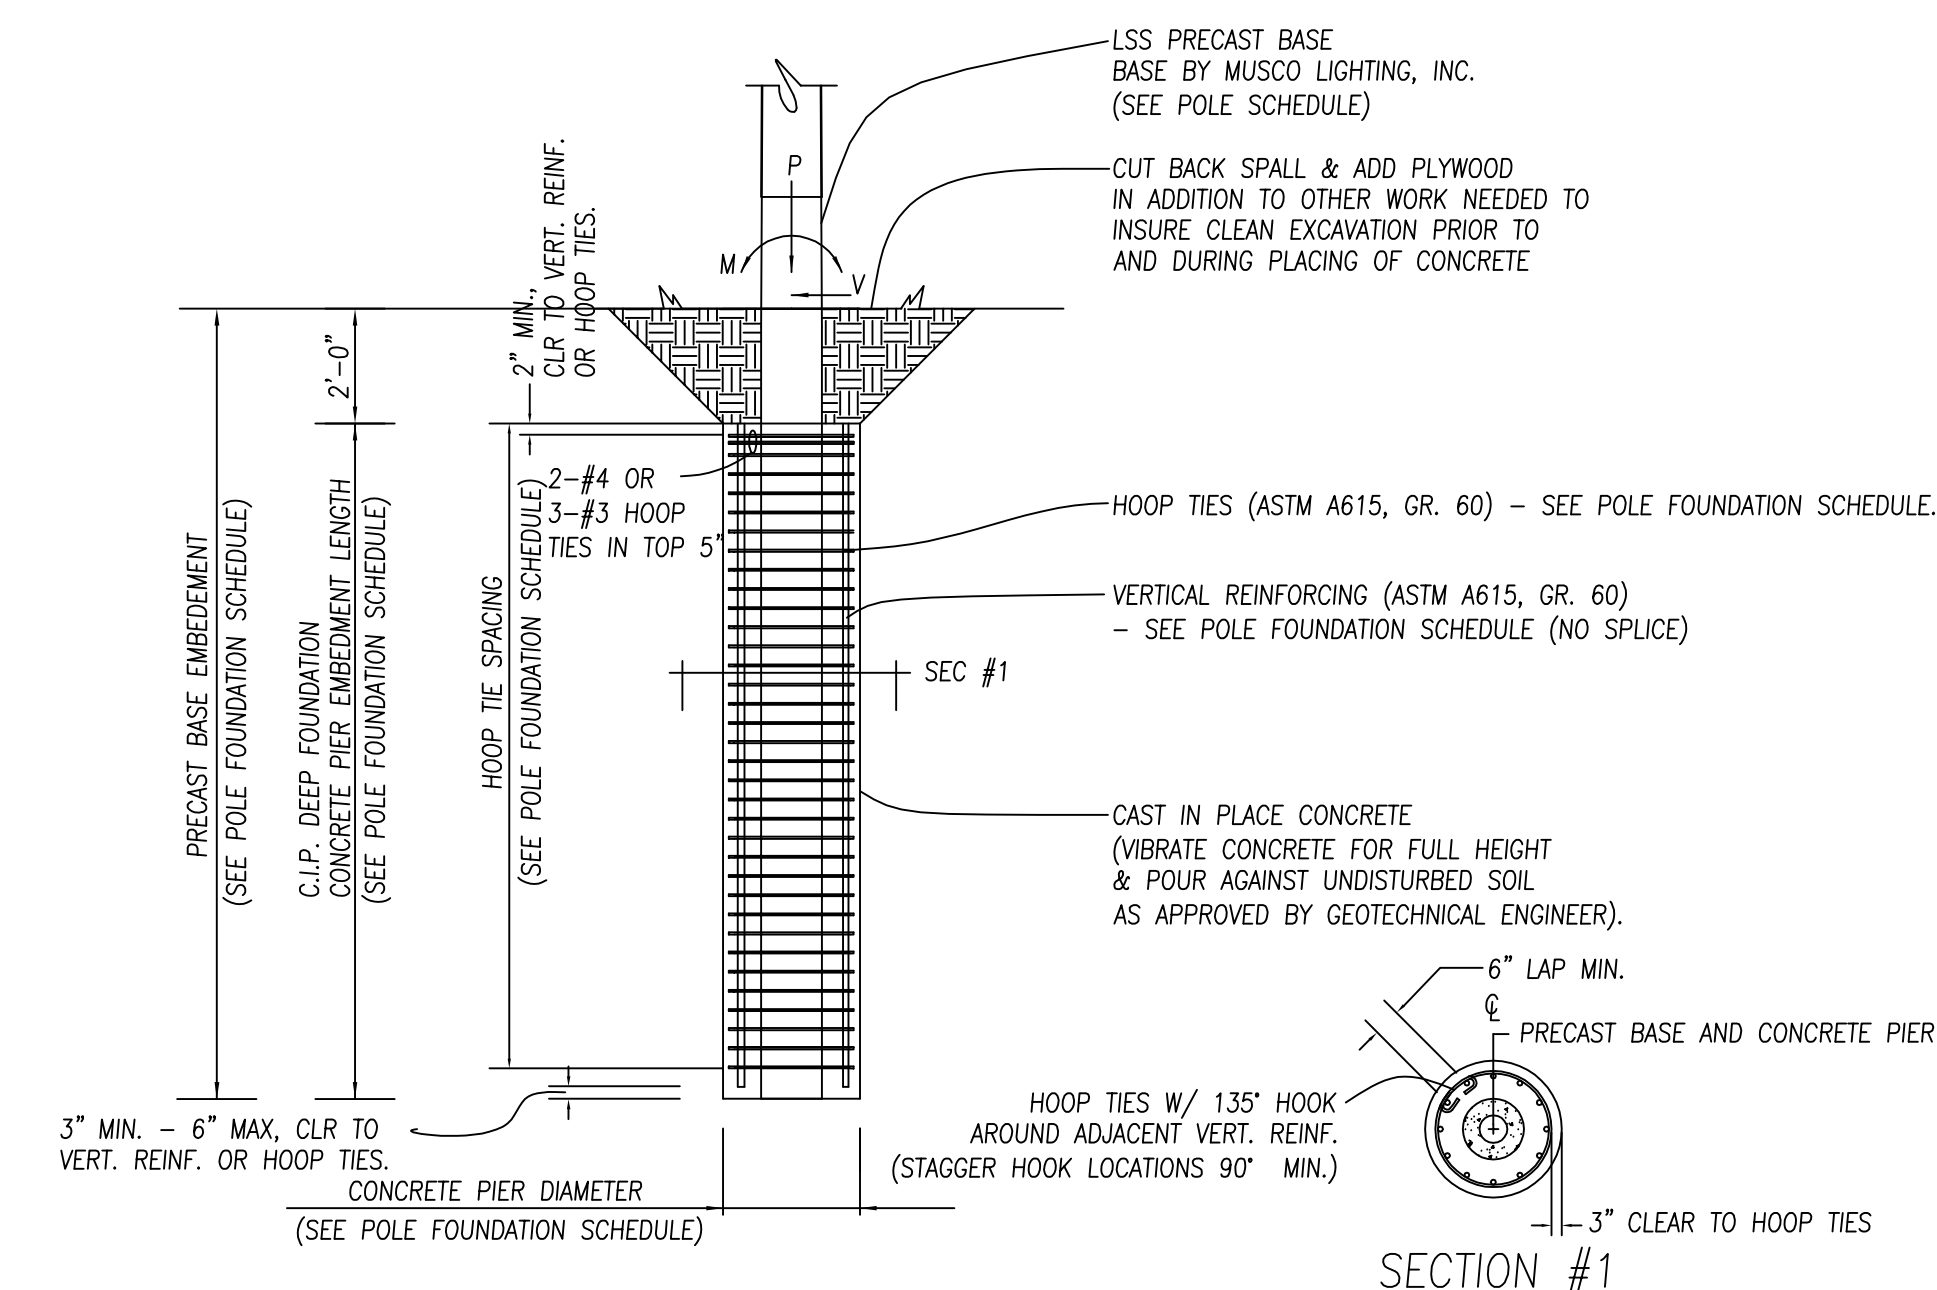

A REINFORCED FOUNDATION DETAIL
N.T.S. DSA-A2-CASFDND_A

POLE TYPE-# OF FIXTURES (MAX) (LSS=LIGHT STRUCTURE)	MARK (SEE POLE ORIENTATION PLAN)	WIND OR SEISMIC (SEISMIC FORCE INCLUDES OVERSTRENGTH FACTOR=1.5)	ASD LEVEL FORCES (MAX)			C.I.P. DEEP FOUNDATION			PRECAST BASE EMBEDMENT FEET
			MOMENT (M) FT-LBS*	SHEAR (V) LBS	VERTICAL (P) LBS**	DIAMETER INCHES	EMBEDMENT FEET (SEE NOTE BELOW)	VERTICAL REINFORCING (ASTM A615, GR 60)	
LSS70A-5	P1-P4	SEISMIC	19,200	398	2,685	36"	10'-0"	8-#8	#4 @ 6" O.C.
		WIND	52,800	1,148	1,610				

*Moment (M) computed below grade at Shear (V) = 0.
**Vertical (P) load includes steel pole, light fixtures, and attachments. Vertical (P) load for wind is the dressed pole weight for erection purposes. Vertical (P) load for seismic also includes weight of precast base above groundline. Reference Detail "A" on MS Sheet(s) for precast base weight.
Note: Final Embedment to be determined in the field by the Geotechnical Engineer of Record

DRAWING TITLE: NOTES, FOUNDATION DETAIL
SCALE: SEE PLAN
REVISIONS:
REFERENCE:

PROJECT NO. 219340

DATE: 06/27/2022

DRAWN BY: Bryce Miles

DRAWING NO. MT1