

# PRE-BID CLARIFICATION FORM

PROJECT NAME:	FILLMORE HIGH SCHOOL NEW ATHLETIC COMPLEX		
PROJECT NUMBER:	Project No. 2024-017 / DSA #03-123950		
TO:	RJ Stump Fillmore Unified School Dist.  Roy Frey WestGroup Designs		
	EMAIL: <a href="mailto:ri.stump@fillmoreusd.org">ri.stump@fillmoreusd.org</a> ,  EMAIL: <a href="mailto:royfawest2roupdesigns.com">royfawest2roupdesigns.com</a>		
DATE:	5-Feb		
FROM:	SC Anderson - Raymond Ramos	EMAIL:	<a href="mailto:estimating@scanderson.com">estimating@scanderson.com</a> ; <a href="mailto:jramosr@scanderson.com">jramosr@scanderson.com</a> ; <a href="mailto:joejannino@scanderson.com">joejannino@scanderson.com</a>
DOCUMENT/DIVISION NUMBER:	Spec Section 2.1.4.4 Other Utilities	DRAWING NUMBER:	N/A

## REQUESTED CLARIFICATION:

**Please circle all applicable bid packages below, that this RFI pertains to:**

Base **bid** Included

**Alt #1** Included

**Mt #2** Included

General condition states should it be necessary to remove, relocate, or temporarily maintain a utility because of interference with the work, the general contractor is to include this cost if not covered by utility owner.

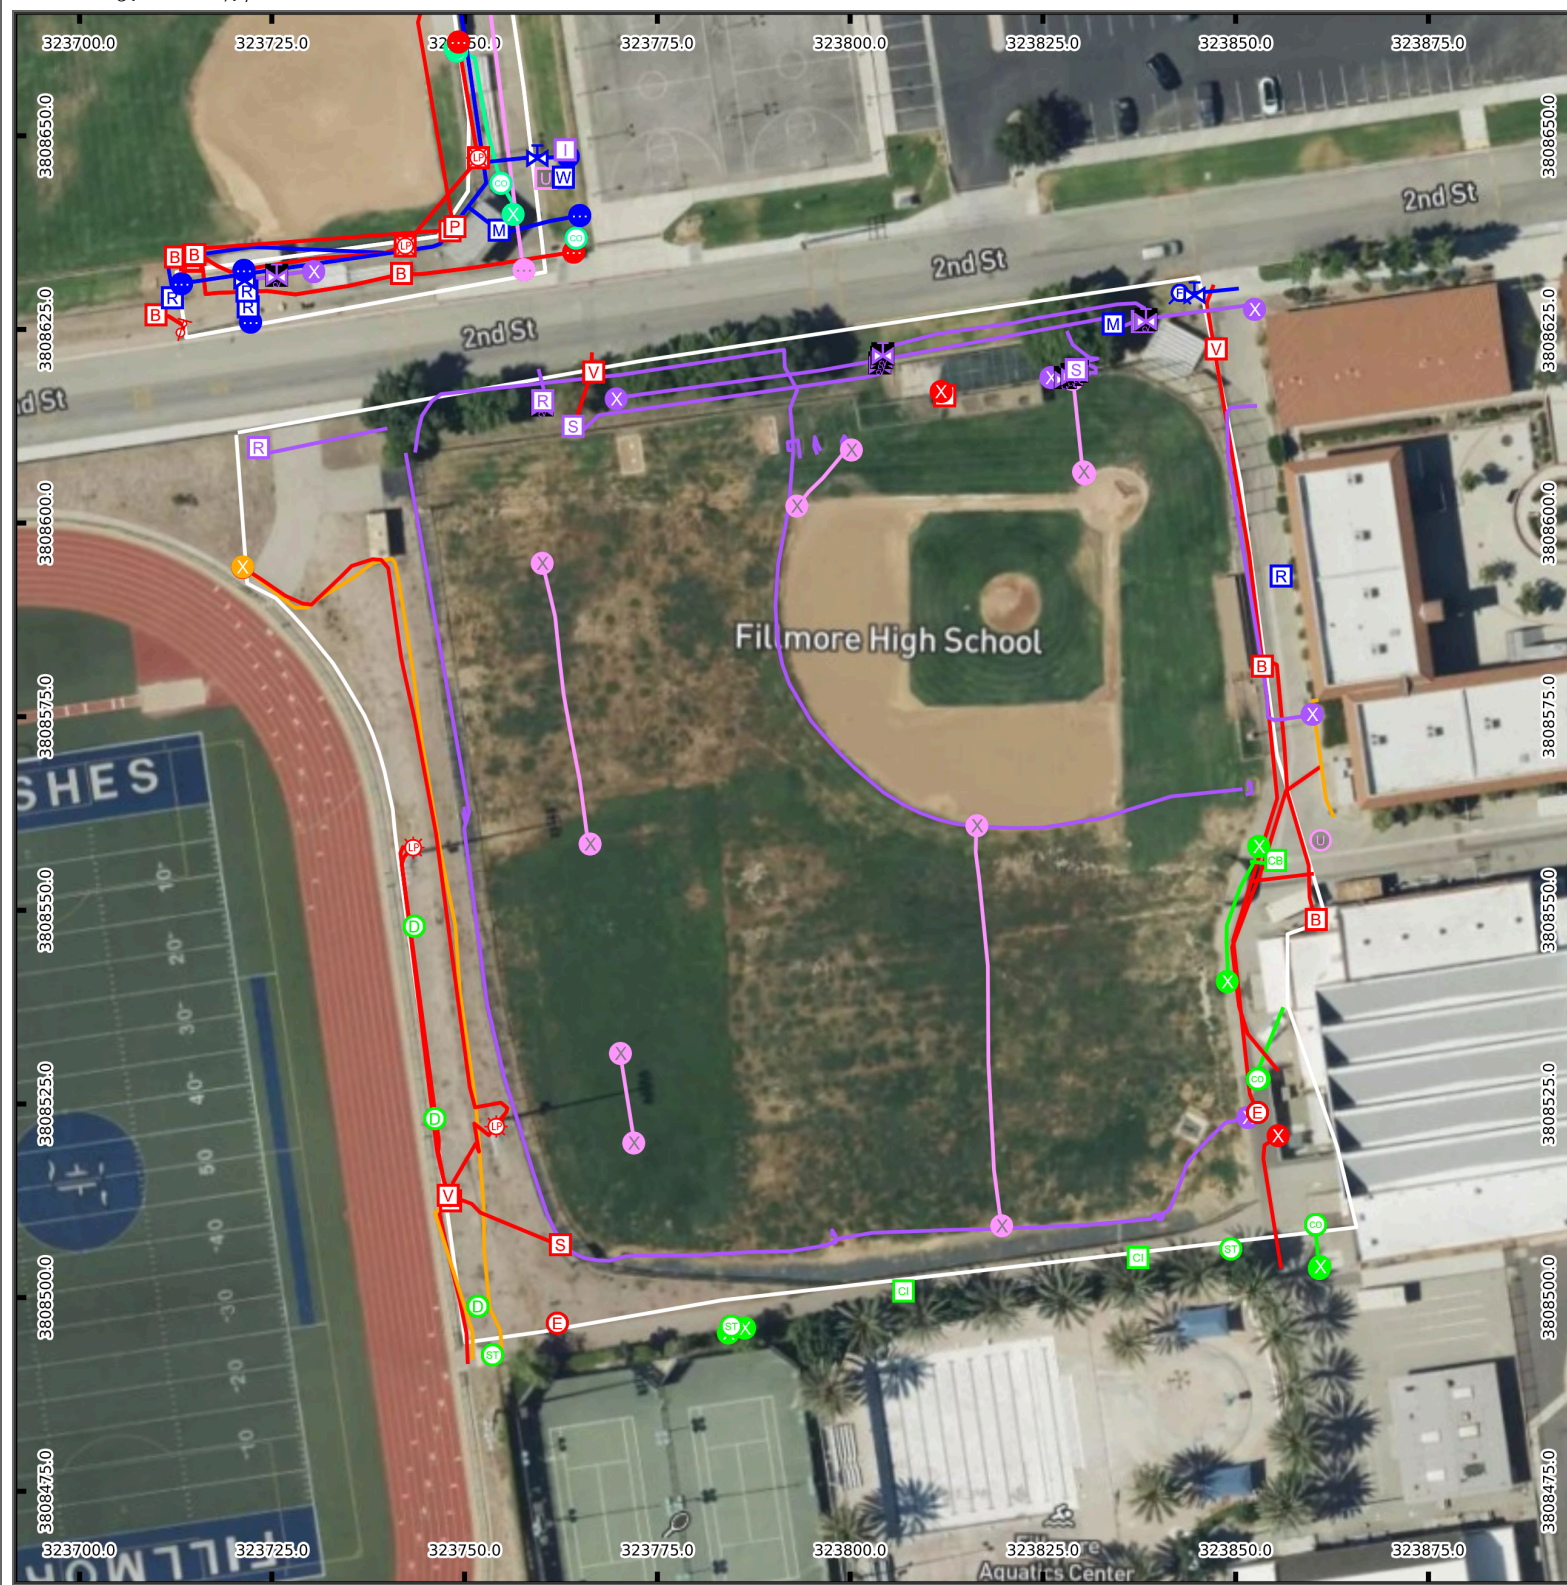
Please confirm this excludes any unforeseen utilities, not referenced on drawings.

If bidders are to include any unforeseen utilities, please provide an allowance to be included in all bids.

Prime contractor is not responsible for undocumented utilities. In addition to the utilities shown on the plans, the District will provide a Utility scan prior to construction. Contractor will be responsible for verifying and potholing all known or identified utilities.

Attached is a preliminary utility scan for existing utilities.

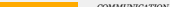
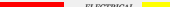

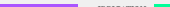
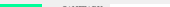

 
 







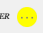








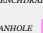
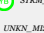

 

 
 
 
 
 
 
 
 
 
 
 
 
 
 
 















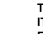

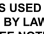














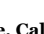
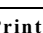
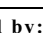
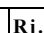
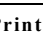
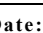
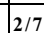



RJ Stump - FUSD 2-5-25

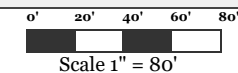


## DISCLAIMER

1. THIS EXHIBIT IS INTENDED TO ILLUSTRATE RECORDS OF FEATURES, AND UTILITY MARKINGS COLLECTED ON SITE. THE HISTORIC RECORDS SHOWN ARE A COMBINATION OF GPRS COLLECTED DATA AS WELL AS ANY ADJUSTMENTS BY OTHER SITEMAP USERS WITH ACCESS TO MAKE CHANGES TO THIS DATA. GPRS CANNOT GUARANTEE IT WILL BE ABLE TO LOCATE ALL UTILITIES OR OTHER SUBSURFACE FEATURES ON SITE NOR CAN IT CERTIFY THAT THE ITEMS SHOWN ON THIS EXHIBIT ARE CURRENT BEYOND THE OFFICIAL SUBMITTAL DATE OF A GPRS CONTRACT LOCATE DELIVERABLE. ALL FINDINGS ARE SUBJECT TO THE TERMS AND CONDITIONS THAT CAN BE VIEWED WITH THE LINK: [HTTPS://M.GP-RADAR.COM/TERMS-CONDITIONS](https://m.gp-radar.com/terms-conditions)
2. GPRS DOES NOT PROVIDE GEOPHYSICAL, GEOLOGICAL, LAND SURVEYING, OR ENGINEERING SERVICES.
3. FOR ADDITIONAL INFORMATION REGARDING FINDINGS AND EQUIPMENT USED, SEE THE "JOB SUMMARY REPORT" THAT WAS SUBMITTED VIA EMAIL FOLLOWING COMPLETION OF FIELD WORK.
4. PRIVATE UTILITY LOCATING IS NEVER A REPLACEMENT FOR ONE CALL/811 SERVICES. STATE LAW REQUIRES 811 TO BE CALLED PRIOR TO ANY AND ALL EXCAVATION ACTIVITIES.

## LEGEND

	COMMUNICATION		ELECTRICAL		GAS
	IRRIGATION		SANITARY		SCAN INFO
	UNKNOWN		WATER		
	COMM_BOX		COMM_EOI		COMM_VAULT
	ELEC_CABINET		ELEC_EOI		ELEC_EQUIPMENT
	ELEC_PANEL		ELEC_SIGN		ELEC_MANHOLE
	FIRE_RISER		ELEC_SITELIGHT		ELEC_VAULT
	GAS_CONTINUOUS		GAS_RISER		IRR_CONTINUOUS
	IRR_EOI		IRR_MISC		IRR_RISER
	IRR_EOI		IRR_MISC		IRR_RISER
Know what's below.  
Call before you dig.



GPRS IS NOT AFFILIATED WITH 811 BUT DOES RECOMMEND THAT THIS SERVICE IS USED ON EVERY PROJECT IN ADDITION TO OUR OWN. IT IS REQUIRED BY LAW TO CALL 811 TO MARK UTILITIES PRIOR TO EXCAVATION. SEE NOTE #4 ABOVE.

FOR INFORMATION ONLY

## SITEMAP RECORD EXHIBIT

LOCATION

511 2nd Street

Fillmore, California 93015, United States

Printed by: Rj.stump@fillmoreusd.org

Print Date: 2/7/2025