

ADDENDUM NO. 4

Bid No. 5384 BATTLES ELEMENTARY SCHOOL NEW TK-K BUILDING AND SITE UPGRADES

Date of Addendum:April 21, 2025Bid Opening Date Remains:April 30, 2025 @ 2:00 p.m.

Plans, Specifications, and Drawings- Changes as follows (in RED):

The attached DLR Group Architect Addendum No. 2 is hereby incorporated into the Bid Documents.

ALL OTHER REQUIREMENTS, TERMS, AND CONDITIONS REMAIN THE SAME



DLR Group inc. a California corporation

700 South Flower Street, 22nd Floor Los Angeles, CA 90017

ADDENDUM 02

Pre-Bid Revision for Contractors' Incorporation into:

Battles ES – TK/K Building and Site Upgrades				
Santa Maria-Bonita School District				
DSA Application No:	03-124614			
File No.	42-48			
DLR Group Project No.:	75-24119-00			
Prepared By:	DLR Group 700 South Flower Street, 22 nd Floor Los Angeles, CA 90017 (213) 800-9400			

NOTICE TO BIDDERS:

The following changes, deletions, additions and/or alterations in, on and to the drawings shall apply to proposals made for and to the execution of the various parts of the work affected thereby.

Careful note of this addendum shall be taken by all parties of interest so that the proper allowance may be made in all computations, estimates, and contracts, and all trades affected shall be fully advised in the performance of the work which will be required of them.

The following revisions are being made to the Bidding Documents to the above referenced project:

A. PROJECT MANUAL - Narrative of Changes

1. SECTION 00 01 10 - TABLE OF CONTENTS

- A. Noted section 00 01 10 was revised.
- B. ADDED new specification section 07 26 00 under Division 07 Thermal and Moisture Protection.
- C. Noted section 09 05 61 was revised.

2. SECTION 07 26 00 - UNDER-SLAB VAPOR RETARDER

A. ADDED new specification section in its entirety.

3. SECTION 09 05 61 - COMMON WORK RESULTS FOR FLOORING PREPARATION

B. Revised specification to indicate Mohawk requirements in lieu of Tandus Power Bond Carpet.

B. DRAWINGS – Narrative of Changes

1. SHEET CO.1 - GENERAL NOTES

- A. Revised erosion control note 17.
- 2. SHEET C1.0 DEMOLITION PLAN

- A. Revised demolition notes 20 and 33.
- B. Revised protection note 15.
- C. Added demolition note 33 to plans.

3. SHEET C4.0 – GRADING AND DRAINAGE PLAN

- A. Added general note regarding construction of storm drain line.
- B. Revised drainage note 2.

4. SHEET C4.1 – GRADING AND DRAINAGE PLAN

- A. Added general note regarding construction of storm drain line.
- B. Revised drainage note 2.

5. SHEET C5.0 - UTILITY PLAN

A. Revised domestic water notes W3 and W6.

6. SHEET C6.0 - DETAILS

A. Revised detail 10.

7. SHEET C6.1 - DETAILS

A. Revised detail 9.

8. SHEET AS1.1 - ENLARGED SITE PLANS

A. Revised 4/AS1.1: Added wall type and dimensions to Trash Area. Added note indicated wall to be 8'-0" high around trash area.

9. SHEET A1.1 - FLOOR PLAN - LEVEL 1

- A. Colored Track updated with spec section, color, and dimensions.
- B. Revised GENERAL ARCHITECTURAL NOTES, note 8 to omit fire-treated verbiage.

10. SHEET A3.1 - REFLECTED CEILING PLAN - LEVEL 1

A. Updated illuminated exit sign layout. Revised CBC reference in Ceiling Plan Legend.

11. SHEET A12.10 - FINISH SCHEDULES

- A. CGD-1 Notes updated.
- B. HW-06 Notes updated.
- C. 'Room Finish Schedule Specific Notes' revised to 'Room Finish Schedule Typical Notes'. Notes revised.

C. GENERAL CLARIFICATIONS

- ASK-001 SUMMER 2025 WORK EXHIBIT IS HEREBY ADDED TO THE CONSTRUCTION DOCUMENTS; Parking lot
 and utility scope work indicated in ASK-001A through ASK-001G to be completed during Summer 2025 for fully
 functional and operational school by August 2025. Contractor to schedule and coordinate accordingly.
 - A. SHEET REVISED ASK-001F to indicate Storm Drain scope.
 - B. NEW SHEET ADDED ASK-001G to indicate updated overlay of Summer 2025 scope to include Storm Drain scope.

INCLUDED ATTACHMENTS:

Drawings: C0.1, C1.0, C4.0, C4.1, C5.0, C6.0, C6.1, AS1.1, A1.1, A3.1, A12.0 Specification Sections: 00 01 10, 07 26 00, 09 05 61 Sketches: ASK-001 (A through G)

**** END OF ADDENDUM 02 ****

SECTION 00 01 10 TABLE OF CONTENTS

PROCUREMENT AND CONTRACTING REQUIREMENTS

DIVISION 00 -- PROCUREMENT AND CONTRACTING REQUIREMENTS

- 00 01 01 Project Title Page
- 00 01 02 Project Information
- 00 01 07 Seals Page
- 00 01 10 Table of Contents (Revised)
- 00 31 00 Available Project Information
- 00 40 25 Request for Information
- 00 43 25 Substitution Request Form During Procurement
- 00 63 25 Substitution Request Form During Construction
- 00 72 00 General Conditions

SPECIFICATIONS

DIVISION 01 -- GENERAL REQUIREMENTS

- 01 10 00 Summary
- 01 20 00 Price and Payment Procedures
- 01 25 00 Substitution Procedures
- 01 30 00 Administrative Requirements
 - 01 30 00.01 Request for Interpretation
- 01 31 14 Facility Services Coordination
- 01 32 16 Construction Progress Schedule
- 01 35 50 Requests for Electronic Files
- 01 35 53 Security Procedures
- 01 40 00 Quality Requirements
- 01 41 00 Regulatory Requirements
- 01 42 19 Reference Standards
- 01 45 33 Code-Required Special Inspections
- 01 50 00 Temporary Facilities and Controls
- 01 51 00 Temporary Utilities
- 01 52 13 Field Offices and Sheds
- 01 55 00 Vehicular Access and Parking
- 01 57 23 Storm Water Pollution Prevention Plan
- 01 57 19 Temporary Environmental Controls

Addendum 2

- 01 58 13 Temporary Project Signage
- 01 60 00 Product Requirements
- 01 61 16 Volatile Organic Compound (VOC) Content Restrictions
 - 01 61 16.01 Accessory Material VOC Content Certification Form
- 01 70 00 Execution and Closeout Requirements
- 01 71 23 Field Engineering
- 01 74 19 Construction Waste Management and Disposal
- 01 76 10 Temporary Protective Coverings
- 01 78 00 Closeout Submittals
 - 01 78 00.01 Warranty Form Letter
- 01 78 39 Project Record Documents
- 01 79 00 Demonstration and Training
- 01 84 13 Interior Acoustical Performance
- 01 91 13 General Commissioning Requirements
- 01 91 14 Commissioning Authority Responsibilities

DIVISION 02 -- EXISTING CONDITIONS

02 41 00 - Demolition

DIVISION 03 -- CONCRETE

- 03 10 00 Concrete Forming and Accessories
- 03 20 00 Concrete Reinforcing
- 03 30 00 Cast-in-Place Concrete
- 03 35 11 Concrete Floor Finishes

DIVISION 04 -- MASONRY

04 22 00 - Concrete Unit Masonry

DIVISION 05 -- METALS

- 05 12 00 Structural Steel Framing
- 05 50 00 Metal Fabrications
- 05 51 33 Metal Ladders
- 05 52 13 Pipe and Tube Railings

DIVISION 06 -- WOOD, PLASTICS, AND COMPOSITES

- 06 05 73 Wood Treatment
- 06 10 00 Rough Carpentry
- 06 16 00 Sheathing
- 06 17 33 Wood I-Joists
- 06 18 00 Glued-Laminated Construction
- 06 20 00 Finish Carpentry

06 41 00 - Architectural Wood Casework	
06 42 00 - Wood Paneling	
06 83 16 - Fiberglass Reinforced Paneling	
DIVISION 07 THERMAL AND MOISTURE PROTECTION	
07 19 00 - Water Repellents	
07 21 00 - Thermal Insulation	
07 25 00 - Weather Barriers	
07 26 00 – Under-Slab Vapor Retarder (New Section)	Addendum 2
07 27 00 - Air Barriers	
07 52 00 - Modified Bituminous Membrane Roofing	
07 62 00 - Sheet Metal Flashing and Trim	
07 72 00 - Roof Accessories	
07 92 00 - Joint Sealants	
DIVISION 08 OPENINGS	
08 06 71 - Door Hardware Schedule	
08 11 13 - Hollow Metal Doors and Frames	
08 14 16 - Flush Wood Doors	
08 31 00 - Access Doors and Panels	
08 43 13 - Aluminum-Framed Storefronts	
08 71 00 - Door Hardware	
08 80 00 - Glazing	
DIVISION 09 FINISHES	
09 05 61 - Common Work Results for Flooring Preparation (Revised)	Addendum 2
09 21 16 - Gypsum Board Assemblies	
09 22 36 - Lath	
09 24 00 - Cement Plastering	
09 30 00 - Tiling	
09 51 00 - Acoustical Ceilings	
09 65 00 - Resilient Flooring	
09 68 13 - Tile Carpeting	Addendum 1
09 91 13 - Exterior Painting	
09 91 23 - Interior Painting	
09 93 00 - Staining and Transparent Finishing	
09 96 00 - High-Performance Coatings	
09 96 23 - Graffiti-Resistant Coatings	

DIVISION 10 -- SPECIALTIES

- 10 11 00 Visual Display Units
- 10 11 46 Presentation Dry Erase Wallcovering
- 10 14 16 Plaques
- 10 14 19 Dimensional Letter Signage
- 10 14 23 Panel Signage
- 10 14 43 Photoluminescent Signage
- 10 21 13.19 FRP/Aluminum Toilet Compartments
- 10 26 00 Wall and Door Protection
- 10 28 00 Toilet Accessories
- 10 44 00 Fire Protection Specialties
- 10 75 00 Flagpoles
- 10 82 33 Treillage

DIVISION 11 -- EQUIPMENT

11 12 00 - Parking Control Equipment

DIVISION 12 -- FURNISHINGS

- 12 11 03 Mural Painting and Faux Finishes
- 12 24 00 Window Roller Shades
- 12 36 00 Countertops
- 12 93 13 Bicycle Racks

DIVISION 21 -- FIRE SUPPRESSION

21 13 13 - Wet-Pipe Fire Sprinkler Systems

DIVISION 22 -- PLUMBING

- 22 05 13 Common Motor Requirements for Plumbing Equipment
- 22 05 16 Expansion Fittings and Loops for Plumbing Piping
- 22 05 17 Sleeves and Sleeve Seals for Plumbing Piping
- 22 05 18 Escutcheons for Plumbing Piping
- 22 05 19 Meters and Gauges for Plumbing Piping
- 22 05 23 General-Duty Valves for Plumbing Piping
- 22 05 29 Hangers and Supports for Plumbing Piping and Equipment
- 22 05 53 Identification for Plumbing Piping and Equipment
- 22 05 93 Testing, Adjusting, and Balancing for Plumbing
- 22 07 19 Plumbing Piping Insulation
- 22 11 16 Domestic Water Piping
- 22 11 19 Domestic Water Piping Specialties
- 22 11 23 Domestic Water Pumps

Addendum 1

ADDENDUM 2

- 22 13 16 Sanitary Waste and Vent Piping
- 22 14 13 Facility Storm Drainage Piping
- 22 14 23 Storm Drainage Piping Specialties
- 22 33 00 Electric, Domestic Water Heaters
- 22 42 13.13 Commercial Water Closets
- 22 42 13.16 Commercial Urinals
- 22 42 16.13 Commercial Lavatories
- 22 42 16.16 Commercial Sinks
- 22 47 13 Drinking Fountains
- DIVISION 23 -- HEATING, VENTILATING, AND AIR-CONDITIONING (HVAC)
 - 23 00 00 Basic Mechanical Requirements
 - 23 05 13 Common Motor Requirements for HVAC
 - 23 05 16 Expansion Fittings and Loops for HVAC Piping
 - 23 05 17 Sleeves and Sleeve Seals for HVAC Piping
 - 23 05 18 Escutcheons for HVAC Piping
 - 23 05 29 Hangers and Supports for HVAC
 - 23 05 48 Noise, Vibration, and Seismic Control for HVAC
 - 23 05 53 Identification for HVAC
 - 23 05 93 Testing, Adjusting, and Balancing
 - 23 07 00 HVAC Insulation
 - 23 09 00 Building Automation System
 - 23 23 00 Refrigerant Piping
 - 23 31 13 Metal Ducts
 - 23 33 00 Air Duct Accessories
 - 23 37 13 Diffusers, Registers and Grilles
 - 23 81 26 Split-System Air-Conditioners

DIVISION 26 -- ELECTRICAL

- 26 05 00 Common Work Results for Electrical
- 26 05 19 Low-Voltage Electrical Power Conductors and Cables
- 26 05 23 Control-Voltage Electrical Power Cables
- 26 05 26 Grounding and Bonding for Electrical Systems
- 26 05 29 Hangers and Supports for Electrical Systems
- 26 05 33 Raceways and Boxes for Electrical Systems
- 26 05 43 Underground Ducts and Raceways for Electrical Systems
- 26 05 44 Sleeves and Sleeve Seals for Electrical Raceways and Cabling
- 26 05 48.16 Seismic Controls for Electrical Systems
- 26 05 53 Identification for Electrical Systems

ADDENDUM 2

 26 05 73.13 - Short-Circuit Studies 26 05 73.16 - Coordination Studies 26 05 73.19 - Arc-Flash Hazard Analysis 26 09 23 - Lighting Control Systems and Devices 26 09 36 - Modular Dimming Controls 26 22 13 - Low-Voltage Distribution Transformers 26 24 13 - Switchboards 26 24 16 - Panelboards 	Addendum 1
 26 27 26 - Wiring Devices 26 28 13 - Fuses 26 28 16 - Enclosed Switches and Circuit Breakers 26 29 23 - Variable-Frequency Motor Controllers 26 33 23.11 - Central Battery Equipment for Emergency Lighting 26 33 73 - Battery Energy Storage System (BESS) 26 51 19 - LED Interior Lighting 26 52 13 - Emergency and Exit Lighting 26 56 19 - LED Exterior Lighting 	Addendum 1
DIVISION 27 COMMUNICATIONS 27 00 05 - Special Conditions for Communications Systems 27 05 26 - Grounding Bonding for Communications Systems 27 05 27 - Exterior Pathways for Communications Systems 27 05 28 - Interior Pathways for Communications Systems 27 13 05 - Communication Single-Mode Fiber Optic Cabling 27 15 05 – Communication Cabling CAT6A 27 51 26 - Assistive Listening System	Addendum 1 Addendum 1 Addendum 1 Addendum 1 Addendum 1 Addendum 1
DIVISION 28 ELECTRONIC SAFETY AND SECURITY 28 46 21.11 - Addressable Fire-Alarm Systems DIVISION 31 EARTHWORK 31 10 00 - Site Clearing 31 22 00 - Grading 31 23 16 - Excavation 31 23 16.13 - Trenching 31 23 23 - Fill 31 63 29 - Drilled Concrete Piers and Shafts	
DIVISION 32 EXTERIOR IMPROVEMENTS 32 01 90 - Operation and Maintenance of Planting	

- 32 01 90.23 Tree and Plant Protection
- 32 11 23 Aggregate Base Course
- 32 12 16 Asphalt Paving
- 32 13 13 Site Concrete
- 32 14 13 Precast Concrete Unit Paving
- 32 17 13 Concrete Wheel Stops
- 32 17 23 Pavement Markings
- 32 17 26 Tactile Warning Surfacing
- 32 31 19 Decorative Metal Fences and Gates
- 32 33 13 Site Bicycle Racks
- 32 80 00 Landscape Irrigation
- 32 90 00 Landscape Planting
- 32 91 19 Landscape Grading
- 32 92 00 Turf Sodding

DIVISION 33 -- UTILITIES

- 33 01 10.58 Disinfection of Water Utility Piping Systems
- 33 05 43 Corrosion Protection
- 33 14 16 Site Water Distribution Piping
- 33 31 13 Site Sanitary Sewerage Piping
- 33 41 00 Subdrainage
- 33 42 11 Stormwater Gravity Piping
- 33 42 30 Stormwater Drains

APPENDIX 01

ADDENDUM 1

SOILS ENGINEERING REPORT – NEW TK/K BUILDING AND SITE IMPROVEMENTS BATTLES ELEMENTARY SCHOOL, dated June 11, 2024. Project GS00433-1.

RFI NO. 1 – RECOMMENDATIONS FOR CONCRETE DRIVE AISLES – NEW TK/K BUILDING AND SITE IMPROVEMENTS BATTLES ELEMENTARY SCHOOL, dated July 23, 2024. Project GS00433-1.

RFI NO. 2 – RECOMMENDATIONS FOR CAST-IN-PLACE DRILLED PIER FOOTINGS – NEW TK/K BUILDING AND SITE IMPROVEMENTS BATTLES ELEMENTARY SCHOOL, dated July 23, 2024. Project GS00433-1.

APPENDIX 02

ADDENDUM 1

GEOLOGIC HAZARD ASSESSMENT – NEW TK/K BUILDING AND SITE IMPROVEMENTS BATTLES ELEMENTARY SCHOOL, dated August 29, 2024. Project GS00433-2.

END OF SECTION

ADDENDUM 2

SECTION 07 26 00 UNDER-SLAB VAPOR RETARDER

PART 1 - GENERAL

1.01 SECTION INCLUDES

A. Sheet vapor retarder under concrete slabs on grade.

1.02 RELATED REQUIREMENTS

- A. Section 03 10 00 Concrete Forming and Accessories: Forms and accessories for formwork.
- B. Section 03 20 00 Concrete Reinforcing: Coordination of placement of reinforcement with vapor retarder/barrier.
- C. Section 03 30 00 Cast-in-Place Concrete: Preparation of subgrade, granular fill, placement of concrete.
- D. Section 31 22 00 Grading: Preparation of building pad and base placed beneath vapor barrier.

1.03 REFERENCE STANDARDS

- A. ACI 302.1R Guide to Concrete Floor and Slab Construction.
- B. ACI 302.2R Guide for Concrete Slabs that Receive Moisture-Sensitive Flooring Materials.
- C. ASTM D1709 Standard Test Methods for Impact Resistance of Plastic Film by the Free-Falling Dart Method.
- D. ASTM E1643 Standard Practice for Selection, Design, Installation, and Inspection of Water Vapor Retarders Used in Contact with Earth or Granular Fill Under Concrete Slabs.
- E. ASTM E1745 Standard Specification for Plastic Water Vapor Retarders Used in Contact with Soil or Granular Fill under Concrete Slabs.
- F. ASTM E96/E96M Standard Test Methods for Gravimetric Determination of Water Vapor Transmission Rate of Materials.

1.04 SUBMITTALS

- A. See Section 01 30 00 Administrative Requirements, for submittal procedures.
- B. Product Data: Provide manufacturers product data identifying specific product to be utilized.
- C. Shop Drawings: Indicate the following:
 - 1. Seaming Layout
 - 2. Penetration and termination details.
- D. Samples: Submit six material samples, 6 x 6 inch in size, illustrating actual materials to be installed.
- E. Specimen Warranty.
- F. Certificate: Certify that products of this section meet or exceed specified requirements.
- G. Test Reports: Indicate compliance with requirements listed in this section.
 - 1. Independent laboratory test results showing compliance with ASTM and ACI Standards.

- H. Manufacturer's Installation Instructions: Indicate installation procedures and interface required with adjacent construction.
- I. Manufacturer's Field Reports: Indicate Manufacturers review of field conditions at 50% installation and after installation of reinforcing, prior to placement of concrete..
- J. Warranty: Submit manufacturer warranty and ensure that forms have been completed in District's name and registered with manufacturer.

1.05 QUALITY ASSURANCE

- A. Preinstallation Meeting: Convene a preinstallation meeting 2 weeks before start of installation of reinforced vapor retarders. Require attendance of parties directly affecting work of this section, including Manufacturer's Representative, Contractor, Architect, and installer. Review installation, protection, and coordination with other work.
- B. Coordination: Coordinate installation timing and sequence to maintain required moisture content in prepared subgrade.
- C. Copies of Documents at Project Site: Maintain at the project site a copy of each referenced document that prescribes execution requirements.

PART 2 - PRODUCTS

2.01 MANUFACTURERS

- A. Manufacturers and Products:
 - 1. Fortifiber Building Products Systems; Moistop Ultra 15, 15 mils thick (0.010 max. permeance), Class A, unreinforced polyolefin: www.fortifiber.com.
 - 2. ISI Building Products; Viper VaporCheck II 15-mil (Class A): www.isibp.com/#sle.
 - 3. Raven Industries; VaporBlock VB15, 15 mils thick (0.01 perms), Class A, unreinforced polyolefin: ravenefd.com,
 - 4. Reef Industries, Inc.; Vaporguard, 15 mil (E-96 0.000 perms), Class B: www.reefindustries.com
 - 5. Stego Industries LLC; Stego Wrap Vapor Barrier, 15 mils: www.stegoindustries.com.
 - 6. W.R. Meadows; Perminator, 15 mils thick (0.0063 perms, puncture resistant) Class A: www.wrmeadows.com..
 - 7. Substitutions: See Section 01 60 00 Product Requirements.

2.02 **PERFORMANCE REQUIREMENTS**

- A. Comply with ACI 302.1R and ACI 302.2R.
- B. Water Vapor Permeance: Not more than 0.010 perms, maximum.
 - 1. Permeance as tested after conditioning (ASTM E1745).
- C. Comply with ASTM E1745 Class A.
- D. Puncture Resistance, ASTM D1709: 2,300 gms.

2.03 MATERIALS

- A. Reinforced Vapor Barrier:
 - 1. Minimum Thickness ACI 302.1R: 15 mil.

- 2. Material: Multi-ply laminate/extrusion of Polyolefin.
- B. Sheet polyethylene membrane not acceptable.

2.04 ACCESSORIES

- A. General: Ensure accessories are from same manufacturer as reinforced vapor retarders.
 - 1. Vapor barrier manufacturer's recommended tape, adhesive, mastic, etc., for sealing seams and penetrations in vapor barrier.
- B. Adhesive Mastic: Adhesive compatible with sheet retarder/barrier and substrate materials, water vapor transmission rate of 0.3 perms or lower per ASTM E96/E96M. Membrane manufacturer's recommended elastomeric sealant.
- C. Adhesive Tape for Sheet Joint Sealing and Repair and Sealing of Miscellaneous Penetrations: Membrane manufacturer's recommended double sided tape with water vapor transmission rate of 0.03 perms or lower per ASTM E96/E96M.
 - 1. Mastic Tape: Manufacturer's system tape.
 - 2. Self-Adhesive Repair Tape: Manufacturer's system tape.
- D. Pipe and Conduit Boot:
 - 1. Manufacturers factory fabricated pipe boots.

PART 3 - EXECUTION

3.01 EXAMINATION

- A. Examine areas to receive reinforced vapor retarders. Notify Architect if areas are not acceptable. Do not begin installation until unacceptable conditions have been corrected.
- B. Subbase: Per ACI 302.1R.
 - 1. As indicated on Drawings and approved by the Geotechnical Engineer.
 - a. Minimum 4 inch thick (or larger) base of 1/2 inch or larger clean aggregate, per CA Green Code 4.505.2.1 and CBC 1907.1A.
- C. Preparation: Ensure that crushed rock or sand base is tamped or rolled and level.
- D. Ensure subgrade beneath vapor retarder is smooth, level, and compacted with no sharp projections.
- E. Beginning installation shall indicate acceptance of condtions.

3.02 UNDERSLAB VAPOR RETARDER / BARRIER INSTALLATION

- A. Install vapor barrier in accordance with manufacturer's instructions and ASTM E1643.
- B. Location: Provide vapor retarder/barrier under building slabs on grade to limits indicated on Drawings.
- C. Installation: Place sheet over crushed rock, as detailed on Drawings, without damaging sheeting.
 - 1. Unroll vapor barrier with the longest dimension parallel with the direction of the concrete placement.
 - a. Install vapor retarders in largest practical widths.
 - 2. Place sheets continuous between footings or foundation walls, without voids.

- 3. Lap vapor barrier over footings and/or seal to foundation walls.
- 4. Lap all joints 6 inches minimum. Seal seams as noted below.
- 5. Turn down sheeting 12 inches minimum along inside face of perimeter grade beams and/or continuous perimeter footings.
- 6. Fit sheeting tightly around column, pipe and conduit penetrations. Install standard pipe boot where possible, following manufacturer's instructions.
 - a. No penetration of the vapor barrier is allowed except for reinforcing steel and permanent utilities.
- D. Seam and Lap Sealing: With adhesive mastic and adhesive sealing tape, seal all seams, edges and penetrations of vapor retarder/barrier.
 - 1. For adhesive mastic seal, apply adhesive to both surfaces, allow approximately 10 minutes to set up and then press together smoothly and evenly, without gaps or fishmouths, for full contact bond.
 - 2. For adhesive tape seal, comply with manufacturer's instructions and recommendations.
 - 3. Seal all penetrations with both adhesive sealing tape and adhesive mastic.
 - 4. Seal sheets to concrete footing faces and penetrating components with adhesive mastic or double sided tape as recommended by membrane manufacturer.
- E. Ensure there is no moisture entrapment by vapor retarder due to rainfall or ground water intrusion.
- F. Immediately repair holes in vapor retarder with self-adhesive repair tape.
- G. Remedial Work: Inspect sheeting installation prior to placing fill materials. Repair all apparent and suspected damaged areas.
 - 1. Clean surface of sheeting.
 - 2. Cut patch from new sheeting material, overlapping damaged area 6 inches minimum, and apply over damaged area sealing in place with adhesive and tape.

3.03 PROTECTION

- A. Protect reinforced vapor retarders from damage during installation of reinforcing steel and utilities and during placement of concrete slab or granular materials.
- B. Immediately repair damaged vapor retarder in accordance with manufacturer's instructions

END OF SECTION

SECTION 09 05 61 COMMON WORK RESULTS FOR FLOORING PREPARATION

PART 1 GENERAL

1.01 SECTION INCLUDES

- A. This section applies to floors identified in Contract Documents that are receiving the following types of floor coverings:
 - 1. Resilient tile and sheet.
 - a. Moisture vapor seal is required at all locations to receive resilient flooring regardless of moisture test.
 - 2. Broadloom carpet.
 - a. Sealer is not needed under Tandus Power Bond Carpet.
 - 3. Carpet tile.
 - a. Sealer is not needed under <u>Tandus Power Bond Carpet</u>Mohawk Group when installed per manufacturer instructions according to moisture content.
 - b. Moisture vapor seal is required at all locations to receive fluid-applied flooring regardless of moisture test.
 - 4. Thin-set ceramic tile and stone tile.
 - 5. Fluid-Applied flooring
 - a. Moisture vapor seal is required at all locations to receive fluid-applied flooring regardless of moisture test.
- B. Removal of existing floor coverings.
- C. Preparation of new and existing concrete floor slabs for installation of floor coverings.
- D. Testing of concrete floor slabs for moisture and alkalinity (pH).
- E. Remediation of concrete floor slabs due to unsatisfactory moisture or alkalinity (pH) conditions.
 - 1. Contractor shall perform all specified remediation of concrete floor slabs. If such remediation is indicated by testing agency's report and is due to a condition not under Contractor's control or could not have been predicted by examination prior to entering into the contract, a contract modification will be issued.
- F. Patching compound.
- G. Remedial floor coatings.
- H. Remedial floor sheet membrane.
- I. Preparation of new and existing wood-based floors and subfloors for installation of new floor coverings.

1.02 RELATED REQUIREMENTS

- A. Section 01 40 00 Quality Requirements: Additional requirements relating to testing agencies and testing.
- B. Section 01 74 19 Construction Waste Management and Disposal: Handling of existing floor coverings removed.

- C. Section 03 30 00 Cast-in-Place Concrete: Moisture emission reducing curing and sealing compound for slabs to receive adhered flooring, to prevent moisture content-related flooring failures; to remain in place, not to be removed.
- D. Section 03 30 00 Cast-in-Place Concrete: Limitations on curing requirements for new concrete floor slabs.

1.03 REFERENCE STANDARDS

- A. ASTM C109/C109M Standard Test Method for Compressive Strength of Hydraulic Cement Mortars (Using 50 mm [2 in.] Cube Specimens); 2023.
- B. ASTM C472 Standard Test Methods for Physical Testing of Gypsum, Gypsum Plasters, and Gypsum Concrete; 2020.
- C. ASTM D4259 Standard Practice for Preparation of Concrete by Abrasion Prior to Coating Application; 2018.
- D. ASTM F710 Standard Practice for Preparing Concrete Floors to Receive Resilient Flooring; 2022.
- E. ASTM F1869 Standard Test Method for Measuring Moisture Vapor Emission Rate of Concrete Subfloor Using Anhydrous Calcium Chloride; 2023.
- F. ASTM F2170 Standard Test Method for Determining Relative Humidity in Concrete Floor Slabs Using in situ Probes; 2019a.
- G. RFCI (RWP) Recommended Work Practices for Removal of Resilient Floor Coverings; 2018.

1.04 ADMINISTRATIVE REQUIREMENTS

A. Coordinate scheduling of cleaning and testing, so that preliminary cleaning has been completed for at least 24 hours prior to testing.

1.05 SUBMITTALS

- A. See Section 01 30 00 Administrative Requirements for submittal procedures.
- B. Visual Observation Report: For existing floor coverings to be removed.
- C. Floor Covering and Adhesive Manufacturers' Product Literature: For each specific combination of substrate, floor covering, and adhesive to be used; showing:
 - 1. Moisture and alkalinity (pH) limits and test methods.
 - 2. Manufacturer's required bond/compatibility test procedure.
- D. Remedial Materials Product Data: Manufacturer's published data on each product to be used for remediation.
 - 1. Manufacturer's qualification statement.
 - 2. Test reports indicating compliance with specified performance requirements, performed by nationally recognized independent testing agency.
 - 3. Manufacturer's installation instructions.
 - 4. Specimen Warranty: Copy of warranty to be issued by coating manufacturer and certificate of underwriter's coverage of warranty.
- E. Testing Agency's Report:
 - 1. Description of areas tested; include floor plans and photographs if helpful.
 - 2. Summary of conditions encountered.
 - 3. Moisture and alkalinity (pH) test reports.

BATTLES ES - TK-K BUILDING AND SITE UPGRADES SANTA MARIA-BONITA SCHOOL DISTRICT SANTA MARIA, CALIFORNIA

- 4. Copies of specified test methods.
- 5. Recommendations for remediation of unsatisfactory surfaces.
- 6. Submit report directly to District.
- 7. Submit report not more than two business days after conclusion of testing.
- F. Adhesive Bond and Compatibility Test Report.
- G. Floor Moisture Testing Technician Certificate: International Concrete Repair Institute (ICRI) Concrete Slab Moisture Testing Technician- Grade I certificate.
- H. Copy of RFCI (RWP).

1.06 QUALITY ASSURANCE

- A. Moisture and alkalinity (pH) testing will be performed by an independent testing agency employed and paid by District.
- B. Contractor may perform additional adhesive and bond test with Contractor's own personnel or hire a testing agency.
- C. Testing Agency Qualifications: Independent testing agency experienced in the types of testing specified.
 - 1. Submit evidence of experience consisting of at least 3 test reports of the type required, with project District's project contact information.
- D. Contractor's Responsibility Relating to Independent Agency Testing:
 - 1. Provide access for and cooperate with testing agency.
 - 2. Confirm date of start of testing at least 10 days prior to actual start.
 - 3. Allow at least 4 business days on site for testing agency activities.
 - 4. Achieve and maintain specified ambient conditions.
 - 5. Notify District when specified ambient conditions have been achieved and when testing will start.
- E. Floor Moisture Testing Technician Qualifications: International Concrete Repair Institute (ICRI) Concrete Slab Moisture Testing Technician Certification- Grade I.
- F. Remedial Coating Installer Qualifications: Company specializing in performing work of the type specified in this section, trained by or employed by coating manufacturer, and able to provide at least 3 project references showing at least 3 years' experience installing moisture emission coatings.

1.07 DELIVERY, STORAGE, AND HANDLING

- A. Deliver, store, handle, and protect products in accordance with manufacturer's instructions and recommendations.
- B. Deliver materials in manufacturer's packaging; include installation instructions.
- C. Keep materials from freezing.

1.08 FIELD CONDITIONS

- A. Maintain ambient temperature in spaces where concrete testing is being performed, and for at least 48 hours prior to testing, at not less than 65 degrees F or more than 85 degrees F.
- B. Maintain relative humidity in spaces where concrete testing is being performed, and for at least 48 hours prior to testing, at not less than 40 percent and not more than 60 percent.

2.01 MATERIALS

- A. Patching Compound: Floor covering manufacturer's recommended product, suitable for conditions, and compatible with adhesive and floor covering. In the absence of any recommendation from flooring manufacturer, provide a product with the following characteristics:
 - 1. Cementitious moisture-, mildew-, and alkali-resistant compound, compatible with floor, floor covering, and floor covering adhesive, and capable of being feathered to nothing at edges.
 - 2. Latex or polyvinyl acetate additions are permitted; gypsum content is prohibited.
 - 3. Compressive Strength: 3000 psi, minimum, after 28 days, when tested in accordance with ASTM C109/C109M or ASTM C472, whichever is appropriate.
 - 4. Products:
 - a. ARDEX Engineered Cements; ARDEX Feather Finish: www.ardexamericas.com/#sle.
 - b. Floor Seal Technology, Inc; Color Match Patch: www.floorseal.com/#sle.
 - c. H.B. Fuller Construction Products, Inc; TEC Feather Edge Skim Coat: www.tecspecialty.com/#sle.
 - d. Mapei International; Mapei Ultraplan 1 Plus: www.mapei.com.
 - e. Sika Corporation; Sika Level-315: www.sikafloorusa.com.
 - f. USG Corporation; Durock Brand Advanced Skim Coat Floor Patch: www.usg.com/#sle.
 - g. Substitutions: See Section 01 60 00 Product Requirements.
- B. Alternate Flooring Adhesive: Floor covering manufacturer's recommended product, suitable for the moisture and pH conditions present; low-VOC. In the absence of any recommendation from flooring manufacturer, provide a product recommended by adhesive manufacturer as suitable for substrate and floor covering and for conditions present.
- C. Remedial Floor Coating: Single- or multi-layer coating or coating/overlay combination intended by its manufacturer to resist water vapor transmission to degree sufficient to meet flooring manufacturer's emission limits, resistant to the level of alkalinity (pH) found, and suitable for adhesion of flooring without further treatment.
 - 1. Thickness: As required for application and in accordance with manufacturer's installation instructions.
 - 2. Products:
 - a. ARDEX Engineered Cements; ARDEX VB 100: www.ardexamericas.com/#sle.
 - b. Custom Building Products; TechMVC Moisture Vapor and Alkalinity Barrier: www.custombuildingproducts.com/#sle.
 - c. Floor Seal Technology, Inc; MES 100 with Floor Seal FloorCem SLU: www.floorseal.com/#sle.
 - d. Koster American Corporation; Koster VAP I 2000 with Koster SL Premium overlay: www.kosterusa.com/#sle.
 - e. LATICRETE International, Inc; LATICRETE VAPOR BAN E with LATICRETE NXT LEVEL PLUS: www.laticrete.com/#sle.

- f. Maxxon Corporation; Aquafin SG4: www.maxxon.com/#sle.
- g. Sika Corporation; Sikafloor Moisture Tolerance Epoxy Primer and Sikafloor Self-Leveling Moisture Tolerant Resurfacer: www.sikafloorusa.com/#sle.
- h. USG Corporation; Durock CoverPrep: www.usg.com/#sle.
- i. Substitutions: See Section 01 60 00 Product Requirements.
- D. Remedial Floor Sheet Membrane: Pre-formed multi-ply sheet membrane installed over concrete subfloor and intended by its manufacturer to resist water vapor transmission to degree sufficient to meet flooring manufacturer's emission limits, resistant to the level of alkalinity (pH) found, and suitable for adhesion of flooring without further treatment.
 - 1. Thickness: 28 mil (0.028 inch).
 - 2. Tape: Types recommended by underlayment manufacturer to install membrane and cover seams.
 - 3. Products:
 - a. GCP Applied Technologies: www.gcpat.com/#sle.
 - b. Substitutions: See Section 01 60 00 Product Requirements.

PART 3 EXECUTION

- 3.01 CONCRETE SLAB PREPARATION
 - A. Follow recommendations of testing agency.
 - B. Perform following operations in the order indicated:
 - 1. Existing concrete slabs (on-grade and elevated) with existing floor coverings:
 - a. Visual observation of existing floor covering, for adhesion, water damage, alkaline deposits, and other defects.
 - b. Removal of existing floor covering.
 - 2. Existing concrete slabs with coatings or penetrating sealers/hardeners/dustproofers:
 - a. Do not attempt to remove coating or penetrating material.
 - b. Do not abrade surface.
 - c. Remove existing coatings and curing agents from surface according to recommendations of remedial coating manufacturer.
 - d. Prepare surface according to recommendations of remedial coating manufacturer and according to ASTM D4259.
 - 3. Preliminary cleaning.
 - 4. Moisture vapor emission tests; 3 tests in the first 1000 square feet and one test in each additional 1000 square feet, unless otherwise indicated or required by flooring manufacturer.
 - 5. Internal relative humidity tests; in same locations as moisture vapor emission tests, unless otherwise indicated.
 - 6. Alkalinity (pH) tests; in same locations as moisture vapor emission tests, unless otherwise indicated.
 - 7. Specified remediation, if required.
 - 8. Patching, smoothing, and leveling, as required.

BATTLES ES - TK-K BUILDING AND SITE UPGRADES SANTA MARIA-BONITA SCHOOL DISTRICT SANTA MARIA, CALIFORNIA

- 9. Other preparation specified.
- 10. Adhesive bond and compatibility test.
- 11. Protection.
- C. Remediations:
 - 1. Active Water Leaks or Continuing Moisture Migration to Surface of Slab: Correct this condition before doing any other remediation; re-test after correction.
 - 2. Excessive Moisture Emission or Relative Humidity: If an adhesive that is resistant to the level of moisture present is available and acceptable to flooring manufacturer, use that adhesive for installation of the flooring; if not, apply remedial floor coating or remedial sheet membrane over entire suspect floor area.
 - 3. Excessive Alkalinity (pH): If remedial floor coating is necessary to address excessive moisture, no additional remediation is required; if not, if an adhesive that is resistant to the level present is available and acceptable to the flooring manufacturer, use that adhesive for installation of the flooring; otherwise, apply a skim coat of specified patching compound over entire suspect floor area.

3.02 REMOVAL OF EXISTING FLOOR COVERINGS

- A. Comply with local, State, and federal regulations and recommendations of RFCI (RWP), as applicable to floor covering being removed.
- B. Dispose of removed materials in accordance with local, State, and federal regulations and as specified.

3.03 PRELIMINARY CLEANING

- A. Clean floors of dust, solvents, paint, wax, oil, grease, asphalt, residual adhesive, adhesive removers, film-forming curing compounds, sealing compounds, alkaline salts, excessive laitance, mold, mildew, and other materials that might prevent adhesive bond.
- B. Do not use solvents or other chemicals for cleaning.

3.04 MOISTURE VAPOR EMISSION TESTING

- A. Where the floor covering manufacturer's requirements conflict with either the referenced test method or this specification, comply with the manufacturer's requirements.
- B. Where this specification conflicts with the referenced test method, comply with the requirements of this section.
- C. Test in accordance with ASTM F1869 and as follows.
- D. Plastic sheet test and mat bond test may not be substituted for the specified ASTM test method, as those methods do not quantify the moisture content sufficiently.
- E. In the event that test values exceed floor covering manufacturer's limits, perform remediation as indicated. In the absence of manufacturer limits, perform remediation if test values exceed 3 pounds per 1000 square feet per 24 hours.
- F. Report: Report the information required by the test method.

3.05 INTERNAL RELATIVE HUMIDITY TESTING

A. Where the floor covering manufacturer's requirements conflict with either the referenced test method or this specification, comply with the manufacturer's requirements.

- B. Where this specification conflicts with the referenced test method, comply with the requirements of this section.
- C. Test in accordance with ASTM F2170 Procedure A and as follows.
- D. Testing with electrical impedance or resistance apparatus may not be substituted for the specified ASTM test method, as the values determined are not comparable to the ASTM test values and do not quantify the moisture content sufficiently.
- E. In the event that test values exceed floor covering manufacturer's limits, perform remediation as indicated. In the absence of manufacturer limits, perform remediation if any test value exceeds 75 percent relative humidity.
- F. Report: Report the information required by the test method.

3.06 ALKALINITY TESTING

- A. Where the floor covering manufacturer's requirements conflict with either the referenced test method or this specification, comply with the manufacturer's requirements.
- B. The following procedure is the equivalent of that described in ASTM F710, repeated here for the Contractor's convenience.
 - 1. Use a wide range alkalinity (pH) test paper, its associated chart, and distilled or deionized water.
 - 2. Place several drops of water on a clean surface of concrete, forming a puddle approximately 1 inch in diameter. Allow the puddle to set for approximately 60 seconds, then dip the alkalinity (pH) test paper into the water, remove it, and compare immediately to chart to determine alkalinity (pH) reading.
 - 3. Use of a digital pH meter with probe is acceptable; follow meter manufacturer's instructions.
- C. In the event that test values exceed floor covering manufacturer's limits, perform remediation as indicated. In the absence of manufacturer limits, perform remediation if alkalinity (pH) test value is over 10.

3.07 PREPARATION

- A. Protection of In-Place Conditions: Where indicated as contaminated to remain.
- B. See individual floor covering section(s) for additional requirements.
- C. Comply with recommendations of testing agency.
- D. Comply with requirements and recommendations of floor covering manufacturer.
- E. Fill and smooth surface cracks, grooves, depressions, control joints and other non-moving joints, and other irregularities with patching compound.
- F. Do not fill expansion joints, isolation joints, or other moving joints.

3.08 ADHESIVE BOND AND COMPATIBILITY TESTING

A. Comply with requirements and recommendations of floor covering manufacturer.

3.09 APPLICATION OF REMEDIAL FLOOR COATING

- A. Comply with requirements and recommendations of coating manufacturer.
- B. Install remedial coating over all concrete floor areas where moisture emission and/or alkalinity exceeds the floor covering manufacturer's published limits.
- C. Prepare floor areas to be coated in accordance with coating manufacturer's requirements.

BATTLES ES - TK-K BUILDING AND SITE UPGRADES SANTA MARIA-BONITA SCHOOL DISTRICT SANTA MARIA, CALIFORNIA

- 1. Mask and protect adjacent wall and floor surfaces from damage due to this work.
- D. Apply coating using manufacturer's recommended procedures.
- E. Apply 1/8 inch thick cementitious surfacing over coating in areas to receive adhesively applied floor coverings.
- F. Verify that prepared floor slab has moisture emission rate and alkalinity meeting requirements.

3.10 APPLICATION OF REMEDIAL FLOOR TREATMENT

A. Comply with requirements and recommendations of treatment manufacturer.

3.11 INSTALLATION OF REMEDIAL FLOOR SHEET MEMBRANE

A. Install in accordance with sheet membrane manufacturer's instructions.

3.12 PROTECTION

A. Cover prepared floors with building paper or other durable covering.

END OF SECTION

CAUTION

EXCAVATION OR IMPROVEMENT.

GENERAL NOTES:

SUBMITTING OF A BID.

ARE EVEN SUSPECTED OF BEING CONTAMINATED.

GENERAL UTILITY SYSTEM NOTES:

- FEET.

SITE MAINTENANCE (BY CONTRACTOR)

2. ALL WORK ON-SITE AND IN THE PUBLIC RIGHT-OF-WAY SHALL CONFORM TO ALL APPLICABLE GOVERNING AGENCIES STANDARD DETAILS & SPECIFICATIONS. 3. PRIOR TO BEGINNING WORK AND AFTER INITIAL HORIZONTAL CONTROL STAKING, CONTRACTOR SHALL FIELD CHECK ALL JOIN ELEVATIONS AND REPORT ANY DISCREPANCIES GREATER THAN 0.05' FOR FINISHED GRADE OR 0.02' FOR FINISHED SURFACE IN ADA AREAS TO CIVIL ENGINEER. 4. DAMAGE TO ANY EXISTING SITE IMPROVEMENTS, UTILITIES AND/OR SERVICES TO REMAIN SHALL BE RESPONSIBILITY OF THE CONTRACTOR. CONTRACTOR SHALL REPAIR AND/OR REPLACE IN KIND AT NO COST TO THE OWNER. 5. CONTRACTOR SHALL REPLACE ALL STRUCTURES AND GRATE LIDS FOR VAULTS, CATCH BASINS, ETC., WITHIN TRAFFIC ACCESSIBLE AREAS WITH STRUCTURES AND LIDS RATED FOR HS20-44 LOADING AND MARKED AS SUCH. 6. THE CONTRACTOR SHALL ADJUST TO FINAL GRADE ALL EXISTING AND/OR NEW MANHOLES, CURB INLETS, CATCH BASINS, VALVES, MONUMENT COVERS, AND OTHER CASTINGS WITHIN THE WORK AREA TO FINAL GRADE IN PAVEMENT AND LANDSCAPE AREAS UNLESS NOTED OTHERWISE. 7. CONTRACTOR AGREES THAT HE SHALL ASSUME SOLE AND COMPLETE RESPONSIBILITY FOR JOB SITE CONDITIONS DURING THE COURSE OF CONSTRUCTION OF THIS PROJECT INCLUDING SAFETY OF ALL PERSONS AND PROPERTY THAT THIS REQUIREMENT SHALL APPLY CONTINUOUSLY AND NOT BE LIMITED TO NORMAL WORKING HOURS AND THAT THE CONTRACTOR SHALL DEFEND INDEMNIFY AND HOLD THE DISTRICT AND THE CONSULTING ENGINEER HARMLESS FROM ANY AND ALL LIABILITY, REAL OR ALLEGED, IN CONNECTION WITH THE PERFORMANCE OF WORK ON THIS PROJECT, EXCEPTING FOR LIABILITY ARISING FROM THE SOLE NEGLIGENCE OF THE DISTRICT OR THE CONSULTING ENGINEER. 8. THE DISTRICT AND CONTRACTOR SHALL BE RESPONSIBLE AND SHALL TAKE NECESSARY PRECAUTIONS TO PREVENT PUBLIC TRESPASS ONTO AREAS WHERE IMPOUNDED WATER CREATES A HAZARDOUS CONDITION. 9. EXISTING PEDESTRIAN WALKWAYS, BIKE PATHS AND ACCESSIBLE PATHWAYS SHALL BE MAINTAINED, WHERE FEASIBLE, DURING CONSTRUCTION. 10. IF A CONFLICT ARISES BETWEEN THE SPECIFICATIONS AND THE PLAN NOTES, THE MORE STRINGENT REQUIREMENT SHALL GOVERN. **TREE/PLAN PROTECTION NOTES** 1. PRIOR TO BEGINNING CONSTRUCTION ON SITE, CONTRACTOR SHALL IDENTIFY AND PROTECT EXISTING TREES AND PLANTS DESIGNATED AS TO REMAIN. 2. PROVIDE 6 FOOT TALL TREE PROTECTION FENCE WITH DISTINCTIVE MARKING VISIBLE TO CONSTRUCTION EQUIPMENT, ENCLOSING DRIP LINES OF TREES DESIGNATED TO REMAIN. 3. WORK REQUIRED WITHIN FENCE LINE SHALL BE HELD TO A MINIMUM, AVOID UNNECESSARY MOVEMENT OF HEAVY EQUIPMENT WITHIN FENCED AREA AND DO NOT PARK VEHICLES WITH IDLE RUNNING ENGINES UNDER DRIP LINE OF TREES. 4. CONSULT WITH THE PROJECT MANAGER PRIOR TO REMOVING ROOTS AND BRANCHES LARGER THAN 2" IN DIAMETER OF TREES OR PLANTS THAT ARE TO REMAIN. 5. ANY GRADE CHANGES GREATER THAN 6" WITHIN THE DRIPLINE OF EXISTING TREES SHALL NOT BE MADE WITHOUT FIRST CONSULTING THE LANDSCAPE ARCHITECT/CIVIL ENGINEER. 6. PROTECT EXISTING TREES TO REMAIN FROM SPILLED CHEMICALS, FUEL OIL, MOTOR OIL, GASOLINE AND ALL OTHER CHEMICALLY INJURIOUS MATERIAL; AS WELL AS FROM PUDDLING OR CONTINUOUSLY RUNNING WATER. SHOULD A SPILL OCCUR, STOP WORK IN THAT AREA AND CONTACT THE CITY'S ENGINEER/INSPECTOR IMMEDIATELY. CONTRACTOR SHALL BE RESPONSIBLE TO MITIGATE DAMAGE FROM SPILLED MATERIAL AS WELL AS MATERIAL CLEAN UP, AT NOT COST TO THE OWNER. 7. PROVIDE TEMPORARY IRRIGATION TO ALL TREES AND PLANTS THAT ARE IN OR ADJACENT TO CONSTRUCTION AREAS WHERE EXISTING IRRIGATION SYSTEMS MAY BE AFFECTED BY THE CONSTRUCTION. ALSO PROVIDE TEMPORARY IRRIGATION TO RELOCATED TREES. 8. CONTRACTOR SHALL BE RESPONSIBLE FOR ONGOING MAINTENANCE OF ALL TREES DESIGNATED TO REMAIN AND FOR MAINTENANCE OF RELOCATED TREES STOCKPILED DURING CONSTRUCTION. CONTRACTOR WILL BE REQUIRED TO REPLACE TREES THAT DIE DUE TO LACK OF MAINTENANCE. **PAVEMENT SECTION** 1. SEE SHEET C6.0 FOR ALL PAVEMENT SECTIONS. 2. SEE SHEET C6.0 FOR ALL VEHICULAR PAVEMENT SECTIONS AND FOR LOCATION OF PAVEMENT SECTIONS. 3. SEE SHEET C6.0 FOR FLATWORK SECTIONS AND BASE REQUIREMENTS 4. EXISTING PAVEMENT SHALL BE TACK COATED PRIOR TO CONSTRUCTING NEW PAVEMENT. 5. THE FINAL OR SURFACE LAYER OF ASPHALT CONCRETE SHALL NOT BE PLACED UNTIL ALL ON-SITE IMPROVEMENTS HAVE BEEN COMPLETED, INCLUDING ALL GRADING, AND ALL UNACCEPTABLE CONCRETE WORK HAS BEEN REMOVED AND REPLACED, UNLESS OTHERWISE APPROVED BY THE IOR. 6. EXISTING ASPHALT CONCRETE IN PARKING LOT TO BE REMOVED IN ACCORDANCE WITH THE DEMOLITION PLAN. SCRAPE OFF BASE ROCK AND STOCKPILE FOR RE-USE AS GENERAL FILL IN NEW PAVEMENT SECTION IF APPROVED BY GEOTECHNICAL ENGINEER. 7. ALL PAVING SHALL BE IN CONFORMANCE WITH SECTION 26 "AGGREGATE BASE" AND SECTION 39 "ASPHALT CONCRETE" PER LATEST EDITION OF CALTRANS STANDARD SPECIFICATIONS. HORIZONTAL CONTROL NOTES:

1. THE LOCATIONS, SIZES AND/OR DEPTHS OF EXISTING UNDERGROUND UTILITIES AS SHOWN ON THIS PLAN

WERE OBTAINED FROM SOURCES OF VARYING RELIABILITY. THE CONTRACTOR IS CAUTIONED THAT ONLY

ACTUAL EXCAVATION WILL REVEAL THE TYPES, EXTENT, SIZES, LOCATIONS AND DEPTHS OF SUCH

UNDERGROUND UTILITIES. (A REASONABLE EFFORT HAS BEEN MADE TO LOCATE AND DELINEATE ALL

KNOWN UNDERGROUND UTILITIES). CONTRACTOR SHALL VERIFY LOCATION AND DEPTH PRIOR TO ANY

2. CONTRACTOR SHALL CONTACT UNDERGROUND SERVICE ALERT FOR LOCATION OF UNDERGROUND UTILITIES

CONTRACTOR SHALL VERIFY ALL EXISTING UTILITIES PRIOR TO BEGINNING ANY WORK ON THIS SITE.

3. THESE DRAWINGS DO NOT ADDRESS CONTRACTOR MEANS, METHODS OR PROCESSES THAT MAY BE

1. CONTRACTOR SHALL VISIT THE SITE PRIOR TO BIDDING ON THIS WORK AND CONSIDER THE EXISTING

CONDITIONS AND SITE CONSTRAINTS IN THE BID. CONTRACTOR SHALL BE IN THE POSSESSION OF AND

FAMILIAR WITH ALL APPLICABLE GOVERNING AGENCIES STANDARD DETAILS AND SPECIFICATIONS PRIOR TO

AT LEAST 48 HOURS PRIOR TO COMMENCEMENT OF CONSTRUCTION- PHONE (800) 642-2444.

ASSOCIATED WITH ANY TOXIC SOILS IF FOUND ON SITE. THE CONTRACTOR IS RESPONSIBLE FOR

COMPLYING WITH ALL CITY, COUNTY AND STATE STANDARDS AND APPROPRIATE REGULATIONS IF TOXIC

SOILS ARE ENCOUNTERED. CONTRACTOR MUST NOTIFY THE PROJECT MANAGER IMMEDIATELY IF ANY SOILS

- 1. CONTRACTOR SHALL LAYOUT THE CONTROL FOR THE SITE AS SPECIFIED ON SHEETS C3.0 AND C3.1. CONTRACTOR SHALL CLEARLY SET AND MARK EACH OF THE CONTROL POINTS, PROTECTING THE POINTS THROUGHOUT CONSTRUCTION.
- 2. ALL DIMENSIONS ON THE PLANS ARE IN FEET OR DECIMALS THEREOF UNLESS SPECIFICALLY CALLED OUT AS FEET AND INCHES.
- 3. ALL RETURN RADII AND CURB DATA ARE TO FACE OF CURB, UNLESS OTHERWISE SHOWN OR INDICATED.
- 4. ALL DIMENSION SHOWN ARE TO FACE OF CURB UNLESS OTHERWISE NOTED.

RECORD DRAWINGS

1. THE CONTRACTOR SHALL KEEP A COMPLETE UP-TO-DATE AND ACCURATE RECORD SET OF PRINTS OF THE CONTRACT DRAWINGS SHOWING EVERY CHANGE FROM THE ORIGINAL DRAWINGS MADE DURING THE COURSE OF CONSTRUCTION INCLUDING EXACT FINAL LOCATION, ELEVATION, SIZES, MATERIALS, AND DESCRIPTION OF ALL WORK. RECORDS SHALL BE "REDLINED" ON A SET OF CONSTRUCTION PLAN DRAWINGS. A COMPLETE SET OF CORRECTED AND COMPLETED RECORD DRAWING PRINTS SHALL BE SUBMITTED TO THE DISTRICT AND DISTRICT'S CIVIL ENGINEER PRIOR TO FINAL ACCEPTANCE FOR REVIEW AND APPROVAL BY THE DISTRICT.

- SOME AREAS WHERE CONSTRUCTION WORK IS NOT BEING DONE AND THE AREA IS NOT OBJECTIONABLE

- OR DRAINS.
- MANUALLY.

1. ALL TRENCHES SHALL BE BACK FILLED PER THE SPECIFICATIONS WITH APPROPRIATE TESTS BY THE GEOTECHNICAL ENGINEER TO VERIFY COMPACTION VALUES.

2. CLEAN OUTS, CATCH BASINS AND AREA DRAINS ARE TO BE ACCURATELY LOCATED BY THEIR RELATIONSHIP TO THE BUILDING, FLATWORK, ROOF DRAINS, AND/OR CURB LAYOUT, NOT BY THE LENGTH OF PIPE SPECIFIED IN THE DRAWINGS (WHICH IS APPROXIMATE).

3. CONTRACTOR SHALL STAKE LOCATION OF ABOVE GROUND UTILITY EQUIPMENT (BACKFLOW PREVENTOR SATELLITE DISH, TRANSFORMER, GAS METER, ETC.) AND MEET WITH DISTRICT TO REVIEW LOCATION PRIOR TO INSTALLATION. PLANNING DEPARTMENT MUST SPECIFICALLY AGREE WITH LOCATION PRIOR TO PROCEEDING WITH THE INSTALLATION.

4. CONTRACTOR SHALL PREPARE AN ACCURATE COMPOSITE UTILITY PLAN THAT TAKES INTO ACCOUNT THE ACTUAL LOCATION OF EXISTING UTILITIES AS DETERMINED DURING THE DEMOLITION WORK, THE UTILITIES SHOWN ON THE CIVIL DRAWINGS, AND THE SITE POWER, CONDUITS AND LIGHTING SHOWN ON THE ELECTRICAL PLANS. THE FIRE SPRINKLER SYSTEM SHALL BE INCLUDED.

5. CATHODIC PROTECTION MAY BE REQUIRED ON ALL METALLIC FITTINGS AND ASSEMBLIES THAT ARE IN CONTACT WITH THE SOIL, IF RECOMMENDED BY THE GEOTECHNICAL REPORT. CONTRACTOR IS RESPONSIBLE TO FULLY ENGINEER AND INSTALL THIS SYSTEM AND COORDINATE ANODE AND TEST STATION LOCATIONS WITH OWNER'S PROJECT MANAGER.

6. COMPLETE SYSTEMS: ALL UTILITY SYSTEMS ARE DELINEATED ON THESE PLANS. CONTRACTOR IS TO PROVIDE ALL FITTINGS, ACCESSORIES AND WORK NECESSARY TO COMPLETE THE UTILITY SYSTEM SO THAT IT IS FULLY FUNCTIONING FOR THE PURPOSE INTENDED.

7. UNDERGROUND UTILITIES OR STRUCTURES ARE SHOWN IN THEIR APPROXIMATE LOCATIONS AND EXTENT BASED UPON RECORD INFORMATION. LOCATIONS MAY NOT HAVE BEEN VERIFIED IN THE FIELD AND NO GUARANTEE IS MADE TO THE ACCURACY OR COMPLETENESS OF THE INFORMATION SHOWN. THE DISTRICT, BY ACCEPTING THESE PLANS OR PROCEEDING WITH IMPROVEMENTS PURSUANT THERETO AGREES TO ASSUME LIABILITY AND TO HOLD UNDERSIGNED HARMLESS FOR ANY DAMAGES RESULTING FROM THE EXISTENCE OF UNDERGROUND UTILITIES OR STRUCTURES NOT REPORTED TO THE UNDERSIGNED; NOT INDICATED ON THE PUBLIC RECORDS EXAMINED, LOCATED AT VARIANCE WITH THOSE REPORTED OR SHOWN ON RECORDS EXAMINED.

8. THE CONTRACTOR SHALL BE RESPONSIBLE FOR PROTECTING ALL UTILITIES FROM DAMAGE DURING COMPACTION OF ROADWAY SUBGRADE AND PRIOR TO PLACEMENT OF FINAL PAVEMENT SECTIONS.

9. EXISTING UTILITY CROSSINGS OF NEW PIPELINE ARE SHOWN ACCORDING TO THE BEST AVAILABLE INFORMATION. GAS, WATER AND SEWER SERVICE LATERALS ARE SHOWN ACCORDING TO THE BEST AVAILABLE INFORMATION. THE CONTRACTOR SHALL VERIFY THE TYPE, SIZE, LOCATION AND DEPTH OF ALL THE UTILITY CROSSING (BOTH MAINS AND LATERALS) ARE CORRECT AS SHOWN. NO GUARANTEE IS MADE THAT ALL EXISTING UTILITIES (BOTH MAINS AND LATERALS) ARE SHOWN. THE CONTRACTOR SHALL EXERCISE CAUTION WHEN EXCAVATING AND SHALL PROTECT ALL EXISTING UTILITIES (BOTH MAINS AND LATERALS) FROM DAMAGE DUE TO HIS OPERATION.

10. CONTRACTOR SHALL UNCOVER AND EXPOSE ALL EXISTING UTILITY AND SEWER LINES WHERE THEY ARE TO BE CROSSED ABOVE OR BELOW BY THE NEW FACILITY BEING CONSTRUCTED IN ORDER TO VERIFY THE GRADE AND TO ASSURE THAT THERE IS SUFFICIENT CLEARANCE.

11. VERTICAL SEPARATION REQUIREMENTS:

A MINIMUM OF SIX (6) INCHES VERTICAL CLEARANCE SHALL BE PROVIDED BETWEEN CROSSING UTILITY PIPES, EXCEPT THAT THE MINIMUM VERTICAL CLEARANCE BETWEEN WATER AND SANITARY SEWER PIPELINES SHALL BE 12 INCHES AND ALL NEW WATER PIPES SHALL BE TYPICALLY INSTALLED TO CROSS ABOVE/OVER EXISTING SANITARY SEWER PIPELINES.

WHERE NEW WATER PIPELINES ARE REQUIRED TO CROSS UNDER EXISTING AND/OR NEW SANITARY SEWER PIPELINES, THE MINIMUM VERTICAL SEPARATION SHALL BE 12 INCHES (EDGE OF PIPE TO EDGE OF PIPE). WATER LINE JOINTS SHALL BE INSTALLED NO CLOSER THAN 10' MINIMUM HORIZONTAL DISTANCE FROM CENTERLINE OF UTILITY CROSSINGS, WHERE FEASIBLE 12. HORIZONTAL SEPARATION REQUIREMENTS:

A MINIMUM HORIZONTAL SEPARATION BETWEEN NEW PIPELINES AND ANY EXISTING UTILITIES SHALL BE 5' FEET, EXCEPT THAT THE MINIMUM HORIZONTAL SEPARATION FOR WATER AND SANITARY SEWER PIPELINES SHALL BE 10' MINIMUM, UNLESS OTHERWISE NOTED.

A MINIMUM HORIZONTAL SEPARATION BETWEEN NEW PIPELINES AND JOINT TRENCH SHALL BE 5

13. THE CONTRACTOR SHALL BE RESPONSIBLE FOR CONTACTING APPROPRIATE UTILITIES AND REQUESTING VERIFICATION OF SERVICE POINTS, FIELD VERIFICATION OF LOCATION, SIZE, DEPTH, ETC. FOR ALL THEIR FACILITIES AND TO COORDINATE WORK SCHEDULES.

GATHER ALL CONSTRUCTION DEBRIS ON A REGULAR BASIS AND PLACE IT IN A DUMPSTER OR OTHER CONTAINER WHICH IS EMPTIED OR REMOVED ON A REGULAR BASIS. WHEN APPROPRIATE, USE TARPS ON THE GROUND TO COLLECT FALLEN DEBRIS OR SPLATTERS THAT COULD CONTRIBUTE TO STORM WATER RUNOFF POLLUTION.

2. REMOVE ALL DIRT, GRAVEL, RUBBISH, REFUSE, AND GREEN WASTE FROM STREET PAVEMENT AND STORM DRAINS ADJOINING THE SITE. LIMIT CONSTRUCTION ACCESS ROUTES ONTO THE SITE AND PLACE GRAVEL PADS AT THESE LOCATIONS. DO NOT DRIVE VEHICLES AND EQUIPMENT OFF THE PAVED OR GRAVELED AREAS DURING WET WEATHER.

SWEEP OR VACUUM THE STREET PAVEMENT AND SIDEWALKS ADJOINING THE PROJECT SITE AND THE ON-SITE PAVED AREAS ON A DAILY BASIS. SCRAPE CAKED-ON MUD AND DIRT FROM THESE AREAS BEFORE SWEEPING. CORNERS AND HARD TO REACH AREAS SHALL BE SWEPT

IF THE STREETS. SIDEWALKS AND/OR PARKING LOT ARE PRESSURE WASHED. DEBRIS MUST BE TRAPPED AND COLLECTED TO PREVENT ENTRY INTO THE STORM DRAIN SYSTEM. NO CLEANING AGENT MAY BE DISCHARGED INTO THE STORM DRAIN. IF ANY CLEANING AGENT OR DEGREASER IS USED, WASH WATER MUST BE COLLECTED AND DISCHARGED TO THE SANITARY SEWER, SUBJECT TO THE APPROVAL OF THE PROJECT MANAGER, OR OTHERWISE DISPOSED OF THROUGH APPROVED DISPOSAL METHODS.

. CREATE A CONTAINED AND COVERED AREA ON THE SITE FOR THE STORAGE OF BAGS, CEMENT PAINTS, OILS, FERTILIZERS, PESTICIDES, OR OTHER MATERIALS USED ON THE SITE THAT HAVE THE POTENTIAL OF BEING DISCHARGED INTO THE STORM DRAIN SYSTEM THROUGH EITHER BEING WIND-BLOWN OR IN THE EVENT OF A MATERIAL SPILL.

6. NEVER CLEAN MACHINERY, EQUIPMENT OR TOOLS INTO A STREET, GUTTER OR STORM DRAIN.

. ENSURE THAT CEMENT TRUCKS. PAINTERS. OR STUCCO/PLASTER FINISHING CONTRACTORS DO NOT DISCHARGE WASH WATER FROM EQUIPMENT, TOOLS OR RINSE CONTAINERS INTO GUTTERS

UPON PROJECT COMPLETION THE DISTRICT SHALL BE SOLELY RESPONSIBLE TO ROUTINELY INSPECT AND MAINTAIN ALL ON-SITE STORM DRAIN FACILITIES. STORM DRAIN SYSTEM SHALL BE CLEANED AND/OR FLUSHED ON A BIANNUAL BASIS OR AS FOUND NECESSARY.

9. PREVENT DUST FROM LEAVING THE SITE AND ACCUMULATING ON ADJACENT AREAS AS REQUIRED IN THE DUST CONTROL NOTES ON THIS SHEET. 10. PREVENT SEDIMENT LADEN STORM RUN-OFF FROM LEAVING THE SITE OR ENTERING STORM

DRAIN OR SANITARY SEWER SYSTEMS AS REQUIRED IN THE EROSION AND SEDIMENTATION CONTROL NOTES ON THIS SHEET.

11. MAINTAIN EXISTING TREES AND PLANTS THAT ARE TO REMAIN AS REQUIRED BY THE TREE AND PLANT PROTECTION NOTES ON THIS SHEET. **CONSTRUCTION FENCE NOTES**

1. CONTRACTOR SHALL PROVIDE A CONSTRUCTION FENCE AROUND THE ENTIRE AREA OF DEMOLITION AND CONSTRUCTION, INCLUDING ALL STAGING, STORAGE, CONSTRUCTION OFFICE AND LAYDOWN AREAS. . FENCE LOCATION MAY BE ADJUSTED FROM TIME TO TIME AS CONSTRUCTION PROCEEDS TO EXCLUDE

IN VISUAL APPEARANCE. 3. CONSTRUCTION FENCE SHALL BE A MINIMUM OF A 6' HIGH GALVANIZED CHAIN LINK WITH GREEN WINDSCREEN FABRIC ON THE OUTSIDE OF THE FENCE. 4. CONTRACTOR SHALL REPLACE THE GREEN FABRIC AT SUCH A TIME AS IT BECOMES TATTERED AND UNSIGHTLY DUF TO WIND OR CONSTRUCTION ACTIVITY.

5. CONSTRUCTION FENCE ADDRESSED IN THESE NOTES IS ONLY FOR VISUAL CONFORMANCE OF THIS CONSTRUCTION SITE TO THE CITY STANDARDS. CONTRACTOR MAY BE REQUIRED TO PROVIDE ADDITIONAL FENCING. BARRICADES OR OTHER SAFETY DEVICES TO KEEP THE SITE SECURE AND SAFE.

EROSION CONTROL NOTES:

- CITY STORM DRAIN SYSTEM, SANITARY SEWER SYSTEM OR FROM LEAVING THE SITE. THE CONTRACTOR SHALL MAKE ADJUSTMENTS IN THE FIELD TO MAKE SURE THAT THIS CONCEPT IS CARRIED OUT.
- EROSION CONTROL FACILITIES AND MEASURES ARE TO BE INSTALLED AND OPERABLE YEAR-ROUND PERMANENT SITE IMPROVEMENTS.
- 3. CONTRACTOR SHALL ASSUME THE CONCEPTS ON THE EROSION CONTROL PLAN, IF PROVIDED, ARE SCHEMATIC MINIMUM REQUIREMENTS. CONTRACTOR IS RESPONSIBLE FOR THE EXACT DESIGN AND EXTENT OF THE EROSION CONTROL SYSTEM SO THAT IT WORKS WITH THE CONTRACTOR'S INTENDED USE AND MANAGEMENT OF THE CONSTRUCTION SITE.
- 4. ALL EROSION CONTROL FACILITIES SHALL BE INSPECTED BY THE CONTRACTOR AND REPAIRED, AS REQUIRED, AT THE CONCLUSION OF EACH WORKING DAY. THE CONTRACTOR SHALL INSPECT THE EROSION CONTROL FACILITIES AND MAKE NECESSARY REPAIRS PRIOR TO ANTICIPATED STORMS AND AT REASONABLE INTERVALS DURING STORMS OF EXTENDED DURATION. REPAIRS TO DAMAGED FACILITIES SHALL BE MADE IMMEDIATELY UPON DISCOVERY.
- 5. AS SOON AS PRACTICAL FOLLOWING EACH STORM, THE CONTRACTOR SHALL REMOVE ANY ACCUMULATION OF SILT OR DEBRIS FROM THE EROSION CONTROL SEDIMENT BASINS AND SHALL CLEAR THE OUTLET PIPES OF ANY BLOCKAGE.
- 6. STOCKPILED MATERIAL SHALL BE COVERED WITH VISQUEEN OR A TARPAULIN UNTIL THE MATERIAL IS REMOVED FROM THE SITE. ANY REMAINING BARE SOIL THAT EXISTS AFTER THE STOCKPILE HAS BEEN REMOVED SHALL BE COVERED UNTIL A NATURAL GROUND COVER IS ESTABLISHED OR IT MAY BE SEEDED OR PLANTED TO PROVIDE GROUND COVER.
- 7. PRIOR TO THE COMMENCEMENT OF ANY CLEARING. GRADING. OR EXCAVATION. THE CONTRACTOR SHALL VERIFY THAT THE DISTRICT HAS SUBMITTED TO THE STATE WATER RESOURCES CONTROL BOARD A NOTICE OF INTENT (NOI) FOR COVERAGE UNDER THE STATE CONSTRUCTION STORM WATER GENERAL PERMIT, IF REQUIRED BY THE STATE. THE CONTRACTOR SHALL MAINTAIN A COPY OF THE NOI ON THE CONSTRUCTION SITE.
- FACILITATE RAPID CONSTRUCTION OF TEMPORARY DEVICES WHEN RAIN IS IMMINENT.
- 9. EROSION CONTROL DEVICES SHALL NOT BE MOVED OR MODIFIED WITHOUT THE APPROVAL OF THE DISTRICT.
- DAY WHEN THE 5-DAY RAIN PROBABILITY FORECAST EXCEEDS 40%.
- BASINS. 12. GRADED AREAS ON THE PERMITTED AREA PERIMETER MUST DRAIN AWAY FROM THE FACE OF SLOPES AT THE CONCLUSION OF EACH WORKING DAY. DRAINAGE IS TO BE DIRECTED TOWARD DESILTING
- FACILITIES. 13. THE CONTRACTOR SHALL INSPECT THE EROSION CONTROL WORK AND INSURE THAT THE WORK IS IN ACCORDANCE WITH APPROVED PLANS.
- 14. PROTECT ADJACENT PROPERTIES AND UNDISTURBED AREAS FROM CONSTRUCTION IMPACTS USING VEGETATIVE BUFFER STRIPS, SEDIMENT BARRIERS OR FILTERS, DIKES, MULCHING OR OTHER MEASURES AS APPROPRIATE.
- 15. CONTRACTOR SHALL MAINTAIN ADJACENT STREETS IN A NEAT, CLEAN, DUST FREE AND SANITARY CONDITION AT ALL TIMES AND TO THE SATISFACTION OF THE INSPECTOR. THE ADJACENT STREET SHALL CONTRACTOR SHALL BE RESPONSIBLE FOR ANY CLEAN UP ON ADJACENT STREETS AFFECTED BY THEIR STOCKPILING OF BUILDING MATERIALS WITHIN THE CITY'S RIGHT-OF-WAY IS PERMITTED.
- 16. ALL EROSION CONTROL MATERIALS SHALL BE FURNISHED AND INSTALLED BY CONTRACTOR UNLESS OTHERWISE NOTED.
- 17. CONTRACTOR SHALL BE RESPONSIBLE FOR IMPLEMENTING AND MAINTAINING EROSION CONTROLS. SEDIMENT CONTROLS AND ALL OTHER BEST MANAGEMENT PRACTICES (BMP'S) THROUGH OUT THE DURATION OF CONSTRUCTION, AS OUTLINED IN THE PROJECT SWPPR AND AS DIRECTED BY THE PROJECT QUALIFIED SWPPP PRACTITIONER (QSP), WHO SHALL BE HIRED BY THE CONTRACTOR.

DUST CONTROL (BY CONTRACTORS)

- 1. WATER TRUCKS SHALL BE PRESENT AND IN USE AT THE CONSTRUCTION SITE. ALL PORTIONS OF THE SITE SUBJECT TO BLOWING DUST SHALL BE WATERED AS OFTEN AS DEEMED NECESSARY BY THE DISTRICT/INSPECTOR IN ORDER TO INSURE PROPER CONTROL OF BLOWING DUST FOR THE DURATION OF THE PROJECT.
- 2. WATERING ASSOCIATED WITH ON-SITE CONSTRUCTION ACTIVITY SHALL TAKE PLACE BETWEEN THE HOURS OF 8:00 AM AND 7:00 PM AND SHALL INCLUDE AT LEAST ONE LATE-AFTERNOON WATERING TO MINIMIZE THE EFFECTS OF BLOWING DUST.
- BE CLEANED AND SWEPT ON A DAILY BASIS DURING THE WORK WEEK, OR AS OFTEN AS DEEMED NECESSARY BY THE DISTRICT/INSPECTOR, OR TO THE SATISFACTION OF THE CITY'S DEPARTMENT OF PUBLIC WORKS.
- 4. WATERING ON PUBLIC STREETS OR POWER WASHING SEDIMENTATION ON STREETS SHALL NOT OCCUR, UNLESS CONTRACTOR COLLECTS AND FILTERS THE WASH WATER PRIOR TO ITS ENTERING THE CITY'S STORM DRAIN SYSTEM.
- 5. ON-SITE PAVED ACCESS ROADS, PARKING AREAS, AND STAGING AREAS SHALL BE SWEPT DAILY WITH A WATER SWEEPER.
- TARPAULINS OR OTHER EFFECTIVE COVERS.
- 7. THE SPEED OF ALL VEHICLES DRIVING ON UNPAVED ROADS OR PORTIONS OF THE SITE SHALL BE LIMITED TO 15 MPH.
- 8. WHEEL WASHERS SHALL BE INSTALLED AND USED TO CLEAN ALL TRUCKS AND EQUIPMENT LEAVING THE CONSTRUCTION SITE. IF WHEEL WASHERS CANNOT BE INSTALLED, TIRES OR TRACKS OF ALL TRUCKS AND EQUIPMENT SHALL BE WASHED OFF BEFORE LEAVING THE CONSTRUCTION SITE.
- 9. THE CONTRACTOR SHALL DEMONSTRATE DUST SUPPRESSION MEASURES, SUCH AS REGULAR WATERING, WHICH SHALL BE IMPLEMENTED TO REDUCE EMISSIONS DURING CONSTRUCTION AND GRADING IN A MANNER MEETING THE APPROVAL OF THE CONSTRUCTION MANAGER. THIS SHALL ASSIST IN REDUCING SHORT-TERM IMPACTS FROM PARTICLES WHICH COULD RESULT IN NUISANCES THAT ARE PROHIBITED BY AIR QUALITY MANAGEMENT DISTRICT RULE 403 (FUGITIVE DUST).
- 10. GRADING OR ANY OTHER OPERATIONS THAT CREATES DUST SHALL BE STOPPED IMMEDIATELY IF DUST AFFECTS ADJACENT PROPERTIES. THE CONTRACTOR SHALL PROVIDE SUFFICIENT DUST CONTROL FOR THE ENTIRE PROJECT SITE IN ACCORDANCE WITH THE PROJECT SWPPP AT ALL TIMES. THE SITE SHALL BE SPRINKLERED AS NECESSARY TO PREVENT DUST NUISANCE. IN THE EVENT THAT THE CONTRACTOR NEGLECTS TO USE ADEQUATE MEASURES TO CONTROL DUST, THE DISTRICT RESERVES THE RIGHT TO TAKE WHATEVER MEASURES ARE NECESSARY TO CONTROL DUST AND CHARGE THE COST TO THE CONTRACTOR.
- 11. THE CONTRACTOR IS RESPONSIBLE FOR DUST CONTROL MEASURES AND FOR OBTAINING ALL REQUIRED PERMITS AND APPROVALS. ALL GRADING OPERATIONS SHALL BE SUSPENDED DURING SECOND (OR WORSE) STAGE SMOG ALERTS.

1. EROSION CONTROL MEASURES ARE INTENDED TO PREVENT SEDIMENT AND DEBRIS FROM ENTERING THE THROUGHOUT CONSTRUCTION, AND SHALL CONTINUE IN EFFECT UNTIL INSTALLATION OF THE

8. NECESSARY MATERIALS SHALL BE AVAILABLE ON SITE AND STOCKPILED AT CONVENIENT LOCATIONS TO

10. ALL REMOVABLE EROSION PROTECTIVE DEVICES SHALL BE IN PLACE AT THE END OF EACH WORKING

11. AFTER A RAINSTORM, ALL SILT AND DEBRIS SHALL BE REMOVED FROM STREETS, CHECK BERMS AND

BE KEPT CLEAN OF DEBRIS, WITH DUST AND OTHER NUISANCE BEING CONTROLLED AT ALL TIMES. CONSTRUCTION, METHOD OF STREET CLEANING SHALL BE BY DRY SWEEPING OF ALL PAVED AREAS. NO

ADD2

3. ALL PUBLIC STREETS AND MEDIANS SOILED OR LITTERED DUE TO THIS CONSTRUCTION ACTIVITY SHALL

6. ALL TRUCKS HAULING SOIL, SAND, AND OTHER LOOSE MATERIALS SHALL BE COVERED WITH

NPDES REQUIREMENTS (BY CONTRACTOR)

- . ALL CONSTRUCTION OF OFF-SITE OR ON-SITE IMPROVEMENTS SHALL ADHERE TO NPDES (NATIONAL POLLUTION DISCHARGE ELIMINATION SYSTEM) BEST MANAGEMENT PRACTICES TO PREVENT DELETERIOUS MATERIALS OR POLLUTANTS FROM ENTERING THE CITY OR COUNTY STORM DRAIN SYSTEMS.
- ERODED SEDIMENTS AND OTHER POLLUTANTS MUST BE RETAINED ON SITE AND MAY NOT BE TRANSPORTED FROM THE SITE VIA SHEET FLOW, SWALES, AREA DRAINS, NATURAL DRAINAGE COURSES, OR WIND.
- STOCKPILES OF EARTH AND OTHER CONSTRUCTION RELATED MATERIALS MUST BE PROTECTED FROM BEING TRANSPORTED FROM THE SITE BY THE FORCES OF WIND OR WATER.
- 4. FUELS, OILS, SOLVENTS, AND OTHER TOXIC MATERIALS MUST BE STORED IN ACCORDANCE WITH THEIR LISTING AND ARE NOT TO CONTAMINATE THE SOIL AND SURFACE WATERS. ALL APPROVED STORAGE CONTAINERS ARE TO BE PROTECTED FROM THE WEATHER. SPILLS MUST BE CLEANED UP IMMEDIATELY AND DISPOSED OF IN A PROPER MANNER. SPILLS MAY NOT BE WASHED INTO THE DRAINAGE SYSTEM.
- . EXCESS OR WASTE CONCRETE MAY NOT BE WASHED INTO THE PUBLIC RIGHT-OF-WAY OR ANY OTHER DRAINAGE SYSTEM. PROVISIONS SHALL BE MADE TO RETAIN CONCRETE WASTES ON SITE UNTIL THEY CAN BE DISPOSED OF AS SOLID WASTE.
- 6. TRASH AND CONSTRUCTION RELATED SOLID WASTES MUST BE DEPOSITED INTO A COVERED RECEPTACLE TO PREVENT CONTAMINATION AND DISPERSAL BY WIND.
- SEDIMENTS AND OTHER MATERIALS MAY NOT BE TRACKED FROM THE SITE BY VEHICLE TRAFFIC. THE CONSTRUCTION ENTRANCE ROADWAYS MUST BE STABILIZED SO AS TO INHIBIT SEDIMENTS FROM BEING DEPOSITED INTO THE PUBLIC RIGHT-OF-WAY. ACCIDENTAL DEPOSITIONS MUST BE SWEPT UP IMMEDIATELY AND MAY NOT BE WASHED DOWN BY RAIN OR OTHER MEANS.
- 8. ANY SLOPES WITH DISTURBED SOILS OR DENUDED OF VEGETATION MUST BE STABILIZED SO AS TO INHIBIT EROSION BY WIND AND WATER.
- 9. CLEAN UP ALL SPILLS USING DRY METHODS.
- 10. SWEEP ALL GUTTERS AT THE END OF EACH WORKING DAY. GUTTERS SHALL BE KEPT CLEAN AFTER LEAVING CONSTRUCTION SITE.
- 11. CALL 911 IN CASE OF A HAZARDOUS SPILL.
- 12. BMP'S AS OUTLINED IN, BUT NOT LIMITED TO, CALIFORNIA STORM WATER QUALITY TASK FORCE, SACRAMENTO, CALIFORNIA, JANUARY 2009, OR THE LATEST REVISED EDITION, MAY APPLY DURING THE CONSTRUCTION OF THIS PROJECT (ADDITIONAL MEASURES MAY BE REQUIRED IF DEEMED APPROPRIATE BY THE INSPECTORS).
- 13. UPON SATISFACTORY COMPLETION OF THE WORK, THE ENTIRE WORK SITE SHALL BE CLEANED BY THE CONTRACTOR AND LEFT WITH A SMOOTH AND NEATLY GRADED SURFACE FREE OF CONSTRUCTION WASTE, RUBBISH, AND DEBRIS OF ANY NATURE.

RECORD DRAWINGS

WHERE LOCAL JURISDICTIONS REQUIRE RECORD DRAWINGS, THE CONTRACTOR SHALL PROVIDE TO THE ENGINEER AND OWNER COPIES OF A PAVING, GRADING AND DRAINAGE RECORD DRAWING AND A SEPARATE UTILITY RECORD DRAWING, BOTH PREPARED BY A CALIFORNIA REGISTERED SURVEYOR. THE RECORD DRAWINGS SHALL VERIFY ALL DESIGN INFORMATION INCLUDED ON THE DESIGN PLANS OF THE SAME NAME.

PROJECT CLOSEOUT

CONTRACTOR SHALL PROVIDE THE NECESSARY ITEMS INCLUDING ANY TESTING, REPORTS, OR CERTIFICATION DOCUMENTS REQUIRED BY THE GOVERNING JURISDICTIONS TO PROPERLY CLOSEOUT THE PROJECT BEFORE IT CAN BE DEEMED COMPLETE.


BENCHMARK NOTE


THE BENCHMARK IS THE TOP OF A MAGNETIC NAIL AND TIN SHINER SET IN THE ASPHALT OF A BASKETBALL COURT AND HAVING AN ELEVATION OF 230.66' PER OPUS SOLUTION (NAVD 88)

BASIS OF BEARINGS NOTE

THE BASIS OF BEARINGS IS A LINE BETWEEN TWO FOUND CENTER LINE MONUMENTS IN STANDARD MONUMENT WELLS ON LARK STREET BEING 2" BRASS CAPS STAMPED "LS 3485" AND HAVING A BEARING OF N 0°45'33" E AS SHOWN ON 151 MAPS 3

SHE	EET LIST TABLE
Sheet Number	Sheet Title
C0.1	GENERAL NOTES
C1.0	DEMOLITION PLAN
C2.0	EROSION CONTROL PLAN
C2.1	EROSION CONTROL DETAILS
C3.0	HORIZONTAL CONTROL PLAN
C3.1	HORIZONTAL CONTROL PLAN
C4.0	GRADING AND DRAINAGE
C4.1	GRADING AND DRAINAGE
C5.0	UTILITY PLAN
C6.0	DETAILS
C6.1	DETAILS

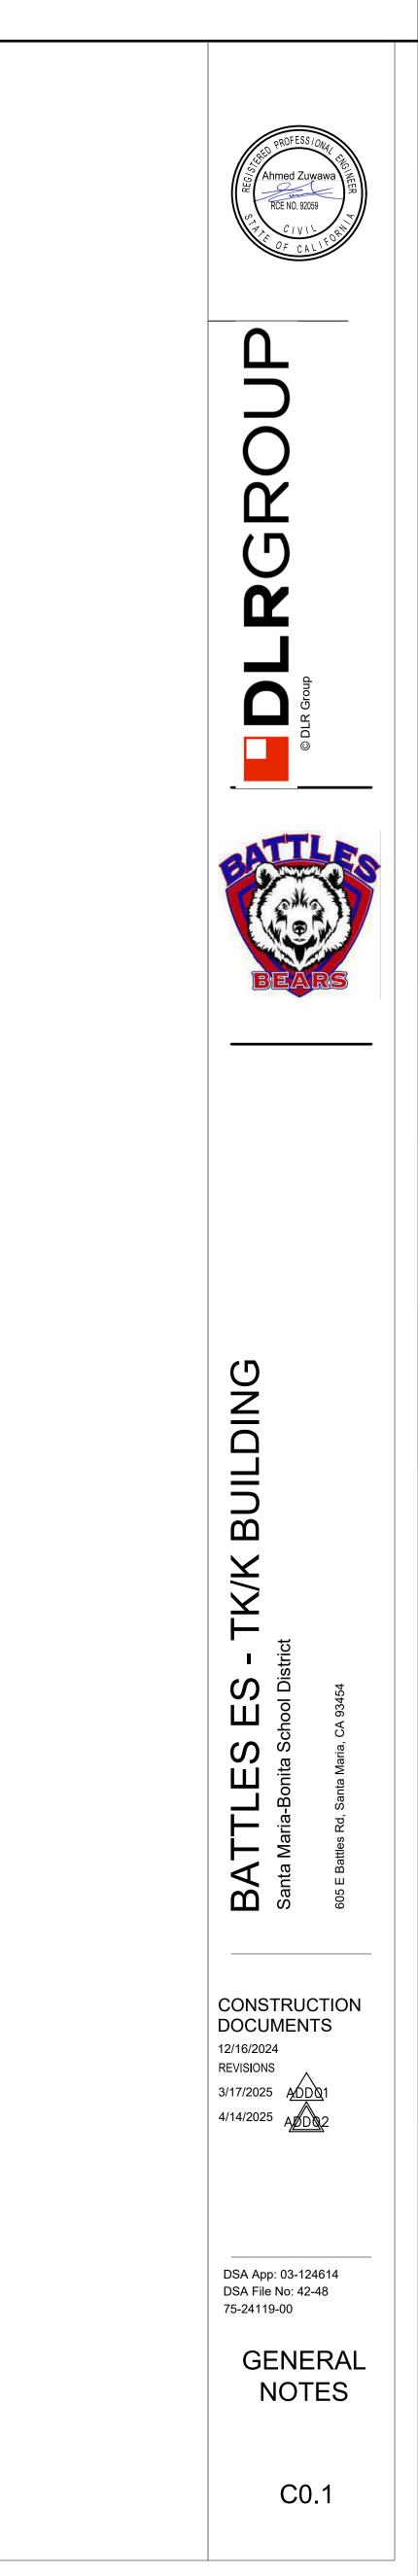

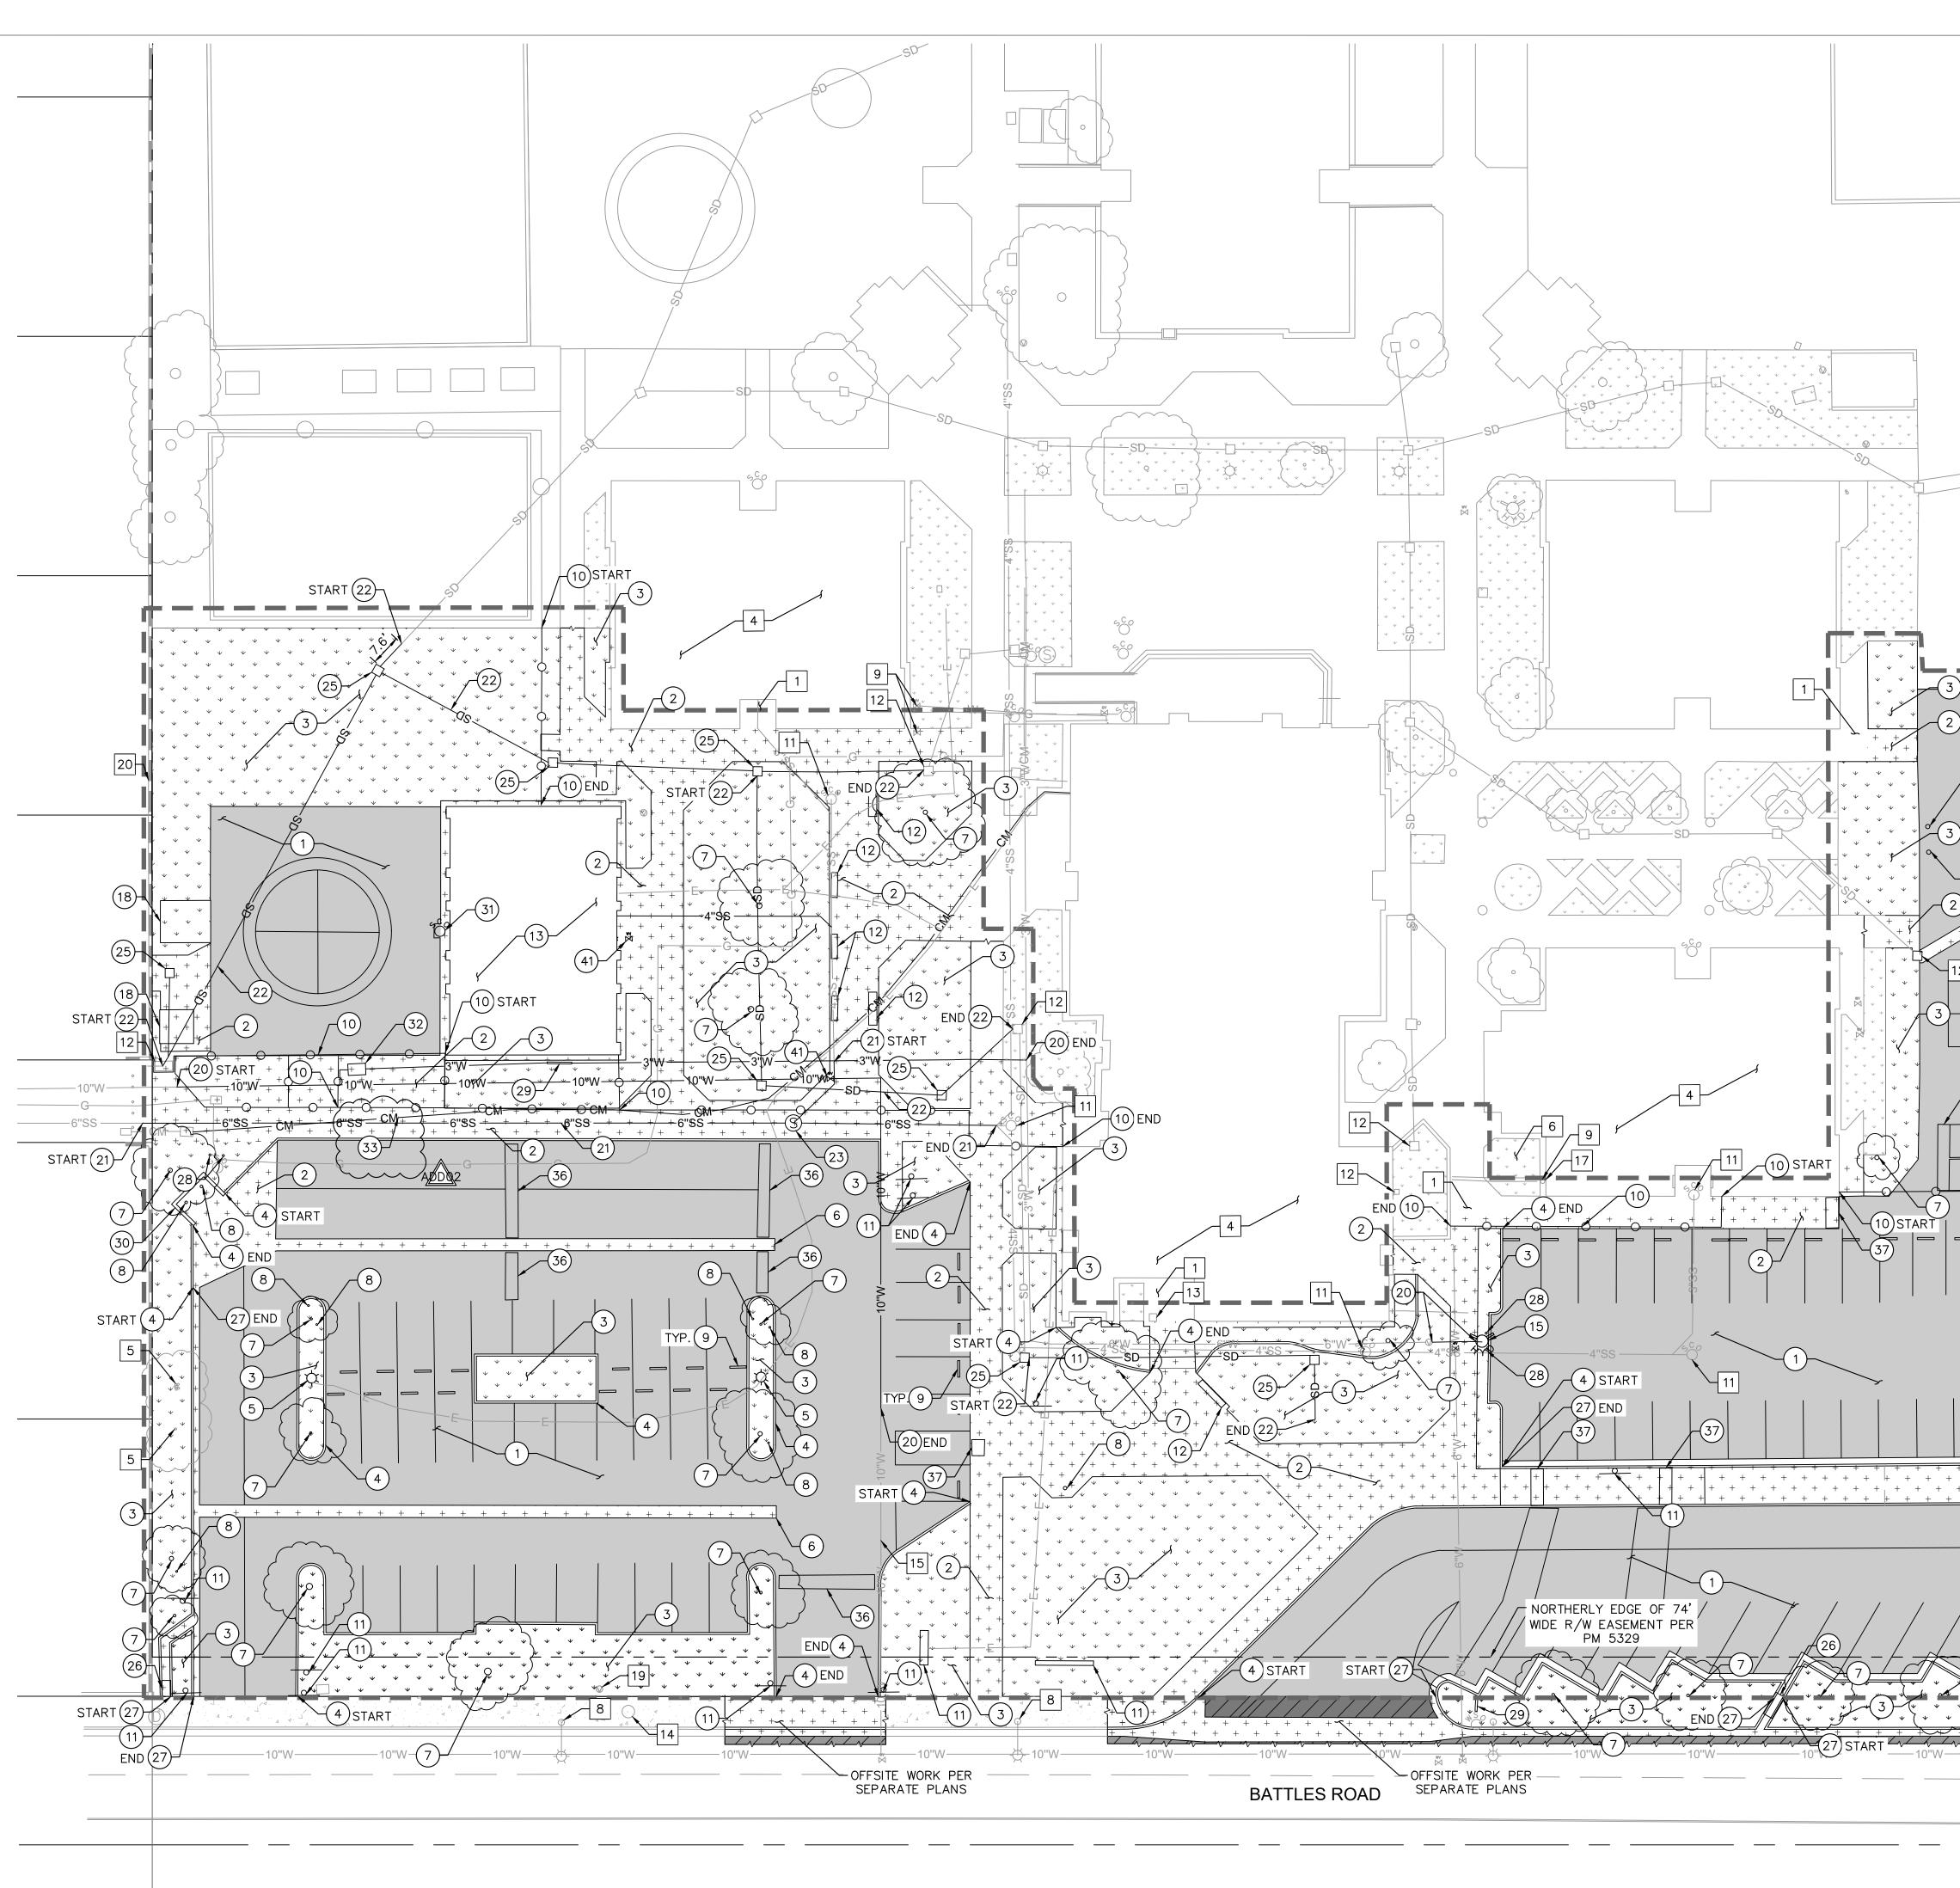

GENERAL DEMOLITION NOTES

THE CONTRACTOR SHALL CLEAR THE PROJECT SITE AREA WITHIN THE CONFINES OF THE DEMOLITION LIMIT LINE. THE CONTRACTOR SHALL CAP IN PLACE ALL EXISTING UTILITIES AT THE DEMOLITION LIMIT LINE, UNLESS NOTED ON THE PLAN. THE CONTRACTOR SHALL DEMOLISH AND REMOVE FROM THE SITE ALL EXISTING UTILITY STRUCTURES, PLANTERS, TREES, AND ALL OTHER SITE FEATURES, UNLESS OTHERWISE NOTED ON THE PLAN. 2. DEMOLITION AND REMOVAL OF PAVEMENT INCLUDES PAVEMENT THICKNESS AS WELL AS BASE COURSE THICKNESS.

3. REMOVAL OF LANDSCAPING SHALL INCLUDE ROOTS AND ORGANIC MATERIAL.

4. THE CONTRACTOR SHALL BE RESPONSIBLE FOR OBTAINING ANY AND ALL PERMITS AND SHALL PAY ALL FEES NECESSARY FOR ENCROACHMENT, GRADING, DEMOLITION, AND DISPOSAL OF SAID MATERIALS AS REQUIRED BY PRIVATE, LOCAL AND STATE JURISDICTIONS.

5. THE CONTRACTOR SHALL BE RESPONSIBLE FOR A SITE INSPECTION TO FULLY ACKNOWLEDGE THE EXTENT OF DEMOLITION WORK.

6. THE CONTRACTOR SHALL VERIFY AND LOCATE ALL EXISTING ABOVE AND UNDERGROUND UTILITIES. LOCATIONS SHOWN ON THE PLANS ARE APPROXIMATE AND 17. CONTINUOUS ACCESS SHALL BE MAINTAINED FOR SURROUNDING PROPERTIES AT ALL TIMES DURING DEMOLITION OF EXISTING FACI ARE SHOWN FOR GENERAL INFORMATION ONLY.

- 7. DAMAGE TO ANY EXISTING UTILITIES AND SERVICES TO REMAIN SHALL BE THE RESPONSIBILITY OF THE CONTRACTOR. CONTRACTOR SHALL REPAIR AND/OR REPLACE IN KIND.
- 8. EROSION CONTROL MEASURES SHALL BE IMPLEMENTED TO PREVENT DEBRIS AND UNSUITABLE MATERIALS FROM ENTERING STORM DRAINS, SANITARY SEWERS AND STREETS.
- 9. DUST CONTROL MEASURES SHALL BE IMPLEMENTED DURING DEMOLITION.
- 10. DEMOLITION IS LIMITED TO WITHIN THE DEMOLITION LIMIT LINE UNLESS OTHERWISE NOTED.

12. THE DRAWINGS MAY NOT INDICATE IN DETAIL ALL DEMOLITION WORK TO BE PERFORMED. THE CONTRACTOR SHALL EXAMII DETERMINE THE FULL EXTENT OF DEMOLITION. 13. ALL DEMOLITION SHALL COMPLY WITH CHAPTER 33 OF THE CALIFORNIA BUILDING CODE AND CHAPTER 33 OF THE CALIFORNIA FIR

14. CONTRACTOR TO USE CARE IN HANDLING DEBRIS FROM SITE TO ENSURE THE SAFETY OF THE PUBLIC. HAUL ROUTE TO BE CLC OR MATERIALS TRACKED ONTO ADJOINING ROADWAYS, SIDEWALKS, ETC. ROADWAYS AND WALKWAYS TO BE CLEARED DAILY OR PUBLIC SAFETY. 15. SEE EROSION CONTROL PLAN FOR REMAINING INLET PROTECTION AND EROSION PREVENTION.

16. CONTRACTOR TO INSTALL CHAIN LINK FENCE WITH MESH SCREEN TO PROTECT PUBLIC FROM ENTERING CONSTRUCTION AREA.

18. THIS PLAN IS NOT INTENDED TO BE A COMPLETE CATALOGUE OF ALL EXISTING STRUCTURES AND UTILITIES. THIS PLAN INTE INFORMATION KNOWN BY THE ENGINEER AND TO SHOW THE LIMITS OF THE AREA WHERE WORK WILL BE PERFORMED. THIS FEATURES TAKEN FROM A FIELD SURVEY, FIELD INVESTIGATIONS AND OTHER AVAILABLE INFORMATION. THIS PLAN MAY OR MAY NO TYPE OR EXTENT OF THE ITEMS TO BE ENCOUNTERED AS THEY ACTUALLY EXIST. WHERE EXISTING FEATURES TARE NOT SHOWN, IN ARE NOT TO BE DEMOLISHED OR REMOVED. THE CONTRACTOR SHALL PERFORM A THOROUGH FIELD INVESTIGATION AND REVIEW OF WORK SHOWN IN THIS PLAN SET TO DETERMINE THE TYPE, QUANTITY AND EXTENT OF ANY AND ALL ITEMS. THE CON RESPONSIBLE FOR DETERMINING THE EXTENT OF EXISTING STRUCTURES AND UTILITIES AND QUANTITY OF WORK INVOLVED IN REMO SITE.


19. CONTRACTOR TO SAWCUT, DEMOLISH, AND REPLACE CONCRETE SIDEWALK TO NEAREST JOINT.


20. REFER TO MEP PLAN FOR REMOVAL AND RELOCATION EXTENTS OF DRY UTILITY INFRASTRUCTURE.


 In the construction of the constructi		НО	LEC 	<u>SEND</u>	PROPERTY LINE LOT LINE CENTERLINE CIVIL LIMIT OF WORK LINE SAWCUT LINE	
		Но			REMOVE EXISTING CONCRETE AN	D BASE COURSE INCLU
1 1		20 10 10 10 10 10 10 10 10 10 1	$\begin{array}{ c c c c c c c c c c c c c c c c c c c$	REMOVE AND PROF COURSE INCLUDING CLEAR AND GRUB REMOVE AND PROF INCLUDING REBAR REMOVE AND PROF FOUNDATION REMOVE AND PROF REMOVE AND PROF	PERLY DISPOSE OF EXISTING ASPH PERLY DISPOSE OF EXISTING CONC REBAR EXISTING LANDSCAPE AREA PERLY DISPOSE OF EXISTING CONC PERLY DISPOSE OF EXISTING LIGHT PERLY DISPOSE OF EXISTING GUTT PERLY DISPOSE OF EXISTING GUTT PERLY DISPOSE OF EXISTING TREE PERLY DISPOSE OF EXISTING POST PERLY DISPOSE OF EXISTING WHEE PERLY DISPOSE OF EXISTING BENC PERLY DISPOSE OF EXISTING SEVE PERLY DISPOSE OF EXISTING TABLI PERLY DISPOSE OF EXISTING TABLI PERLY DISPOSE OF EXISTING WATE CAP AND PROTECT EXISTING WATE CAP AND PROTECT EXISTING WATE PERLY DISPOSE OF EXISTING SEVE PERLY DISPOSE OF EXISTING SEVE PERLY DISPOSE OF EXISTING SEVE PERLY DISPOSE OF EXISTING CURB PERLY DISPOSE OF EXISTING WATE PERLY DISPOSE OF EXISTING CURB PERLY DISPOSE OF EXISTING BOLL PERLY DISPOSE OF EXISTING SEVE PERLY DISPOSE OF EXISTING BOLL	CRETE AND BASE CRETE CURB POST INCLUDING ER INCLUDING ROOT AND FOUNDATION AND FOUNDATION AND FOUNDATION AND FOUNDATION H DING ITE WATER LINE PER UTILITY PLAN FOR E NATE RELOCATION RDINATE DISPOSAL R LINE PER TER LINE TO REMAIN. R LINE PER TER LINE TO REMAIN. R LINE M DRAIN LINE H BASIN OND PLATE AND GUTTER AND FOUNDATION R CLEANOUT R SEPARATE PERMIT COORDINATE WITH FOR MORE
AINE EXISTING CONDITIONS TO RE CODE. SEELY MONITORED FOR DEBRIS 3 AS NECESSARY TO MAINTAIN ALUTES. TENDS TO DISCLOSE GENERAL S HALL SE SUBJECT HERE TO SUBJECT THE PLACE EXISTING CATCH BASIN. CONTRACTOR TO ADJUST TO FINAL GRADE. 10 PROTECT -IN-PLACE EXISTING CATCH BASIN. CONTRACTOR TO ADJUST 10 PROTECT -IN-PLACE EXISTING CATCH BASIN. CONTRACTOR TO ADJUST 10 PROTECT -IN-PLACE EXISTING CATCH BASIN. CONTRACTOR TO ADJUST 10 PROTECT -IN-PLACE EXISTING CATCH BASIN. CONTRACTOR TO ADJUST 11 PROTECT -IN-PLACE EXISTING CATCH BASIN. CONTRACTOR TO ADJUST TO FINAL GRADE. 12 PROTECT -IN-PLACE EXISTING CATCH BASIN. CONTRACTOR TO ADJUST TO FINAL GRADE. 13 PROTECT -IN-PLACE EXISTING CATCH BASIN. CONTRACTOR TO ADJUST TO FINAL GRADE. 14 PROTECT -IN-PLACE EXISTING CATCH BASIN. CONTRACTOR TO ADJUST TO FINAL GRADE. 15 PROTECT -IN-PLACE EXISTING CATCH BASIN. CONTRACTOR TO ADJUST TO FINAL GRADE. 16 NOT USED 17 PROTECT -IN-PLACE EXISTING CATCH BASIN. CONTRACTOR TO 18 PROTECT -IN-PLACE EXISTING CATCH BASIN. CONTRACTOR TO 19 PROTECT -IN-PLACE EXISTING CATCH BASIN. CONTRACTOR TO 40 JUST TO FINAL GRADE. 10 PROTECT -IN-PLACE EXISTING CATCH BASIN. CONTRACTOR TO 40 JUST TO FINAL GRADE. 11 PROTECT -IN-PLACE EXISTING CATCH BASIN. CONTRACTOR TO 40 JUST TO FINAL GRADE. 13 PROTECT -IN-PLACE EXISTING BOLLARD. CONTRACTOR TO ADJUST 14 PROTECT -IN-PLACE EXISTING BOLLARD. CONTRACTOR TO ADJUST 15 NOT USED 16 NOT USED 17 PROTECT -IN-PLACE EXISTING BOLLARD. CONTRACTOR TO ADJUST 10 FINAL GRADE. 19 PROTECT -IN-PLACE EXISTING UNDERGROUND STORM DRAIN LINE 19 PROTECT -IN-PLACE EXISTING UNDERGROUND STORM DRAIN LINE 19 PROTECT -IN-PLACE EXISTING WALL 19 PROTECT -IN-PLACE EXISTING WALL 19 PROTECT -IN-PLACE EXISTING WALL			(41) PR(REMOVE AND PROF	NOTES	R VALVE
III PROTECT-IN-PLACE EXISTING SEWER CLEANOUT. CONTRACTOR TO ADJUST TO FINAL GRADE. III PROTECT-IN-PLACE EXISTING CATCH BASIN. CONTRACTOR TO ADJUST TO FINAL GRADE. OSELY MONITORED FOR DEBRIS R AS NECESSARY TO MAINTAIN PROTECT-IN-PLACE EXISTING COLUMN PROTECT-IN-PLACE EXISTING COLUMN PROTECT-IN-PLACE EXISTING MANHOLE. CONTRACTOR TO ADJUST III PROTECT-IN-PLACE EXISTING BOLLARD. CONTRACTOR TO ADJUST III PROTECT-IN-PLACE EXISTING BOLLARD. CONTRACTOR TO ADJUST III S NOT USED III S NOT USED III S NOT IMPLIED THAT THEY III S NOT IMPLIED THAT THEY III IS NOT IMPLED THAT THEY III IS NOT IMPLIED THAT THEY III IS NOT HAE STREWTHIN THE LIMIT IVING THESE ITEMS FROM THE IVING THESE ITEMS FROM THE IVING THESE ITEMS FROM THE	* * * 8 * * * 8 * * * * * * * * * * * * * * * * * * *	+ + + + + + + + + + + + + + + + + + +	3 4 5 6 7 8 9	PROTECT-IN-PLAC PROTECT-IN-PLAC PROTECT-IN-PLAC PROTECT-IN-PLAC PROTECT-IN-PLAC ADJUST TO FINAL PROTECT-IN-PLAC TO FINAL GRADE. PROTECT-IN-PLAC ADJUST TO FINAL	E EXISTING ASPHALT E EXISTING BUILDING E EXISTING TREE E EXISTING LANDSCAPE E EXISTING POWER POLE. CONTRA GRADE. E EXISTING LIGHT POLE. CONTRAC E EXISTING WATER STRUCTURE. C GRADE.	TOR TO ADJUST
TENDS TO DISCLOSE GENERAL S PLAN SHOWS THE EXISTING NOT ACCURATELY REFLECT THE IT IS NOT IMPLIED THAT THEY OF THE SITE WITHIN THE LIMIT DNTRACTOR SHALL BE SOLELY NOVING THESE ITEMS FROM THE IT IS NOT IMPLIED THAT THEY OF THE SITE WITHIN THE LIMIT DNTRACTOR SHALL BE SOLELY IT IS NOT IMPLIED THESE ITEMS FROM THE	RE CODE. OSELY MONITORED FOR DEBRIS & AS NECESSARY TO MAINTAIN	Ą	11 12 13 2002 14 (15) 16	PROTECT-IN-PLAC ADJUST TO FINAL PROTECT-IN-PLAC ADJUST TO FINAL PROTECT-IN-PLAC TO FINAL GRADE. PROTECT-IN-PLAC VERIFY IN FIELD. NOT USED	E EXISTING SEWER CLEANOUT. CO GRADE. E EXISTING CATCH BASIN. CONTRA GRADE. E EXISTING COLUMN E EXISTING MANHOLE. CONTRACTO E EXISTING 10" WATER LINE. CONT	ACTOR TO OR TO ADJUST TRACTOR TO
	S PLAN SHOWS THE EXISTING NOT ACCURATELY REFLECT THE IT IS NOT IMPLIED THAT THEY OF THE SITE WITHIN THE LIMIT ONTRACTOR SHALL BE SOLELY		17 18 19	TO FINAL GRADE. PROTECT—IN—PLAC PROTECT—IN—PLAC CONTRACTOR TO A	E EXISTING UNDERGROUND STORM E EXISTING IRRIGATION CONTROL ' DJUST TO FINAL GRADE.	DRAIN LINE

c c	C A I
3	CAL
WHEN	PRI


LUDING REBAR

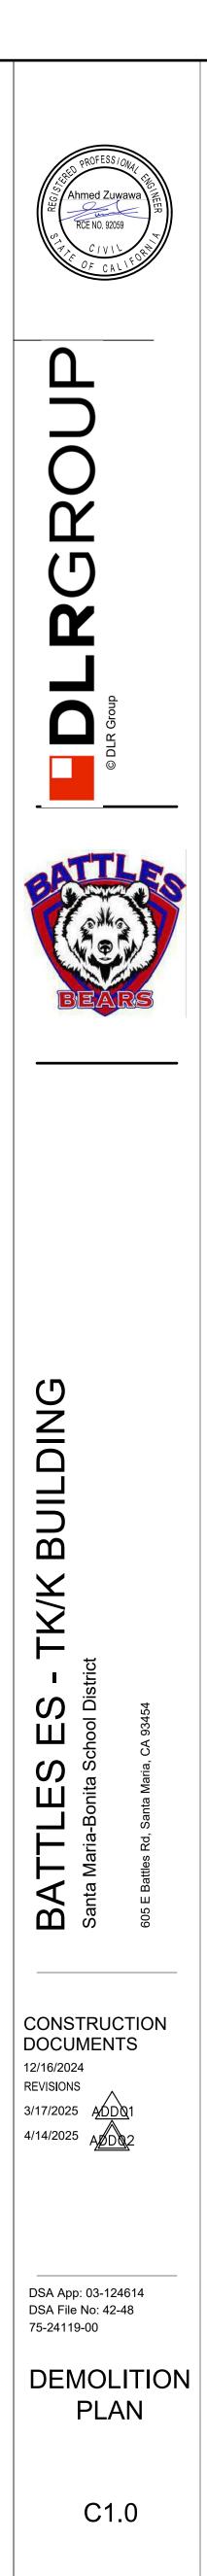


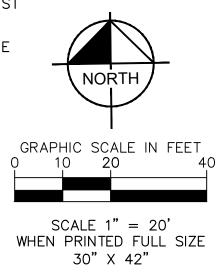


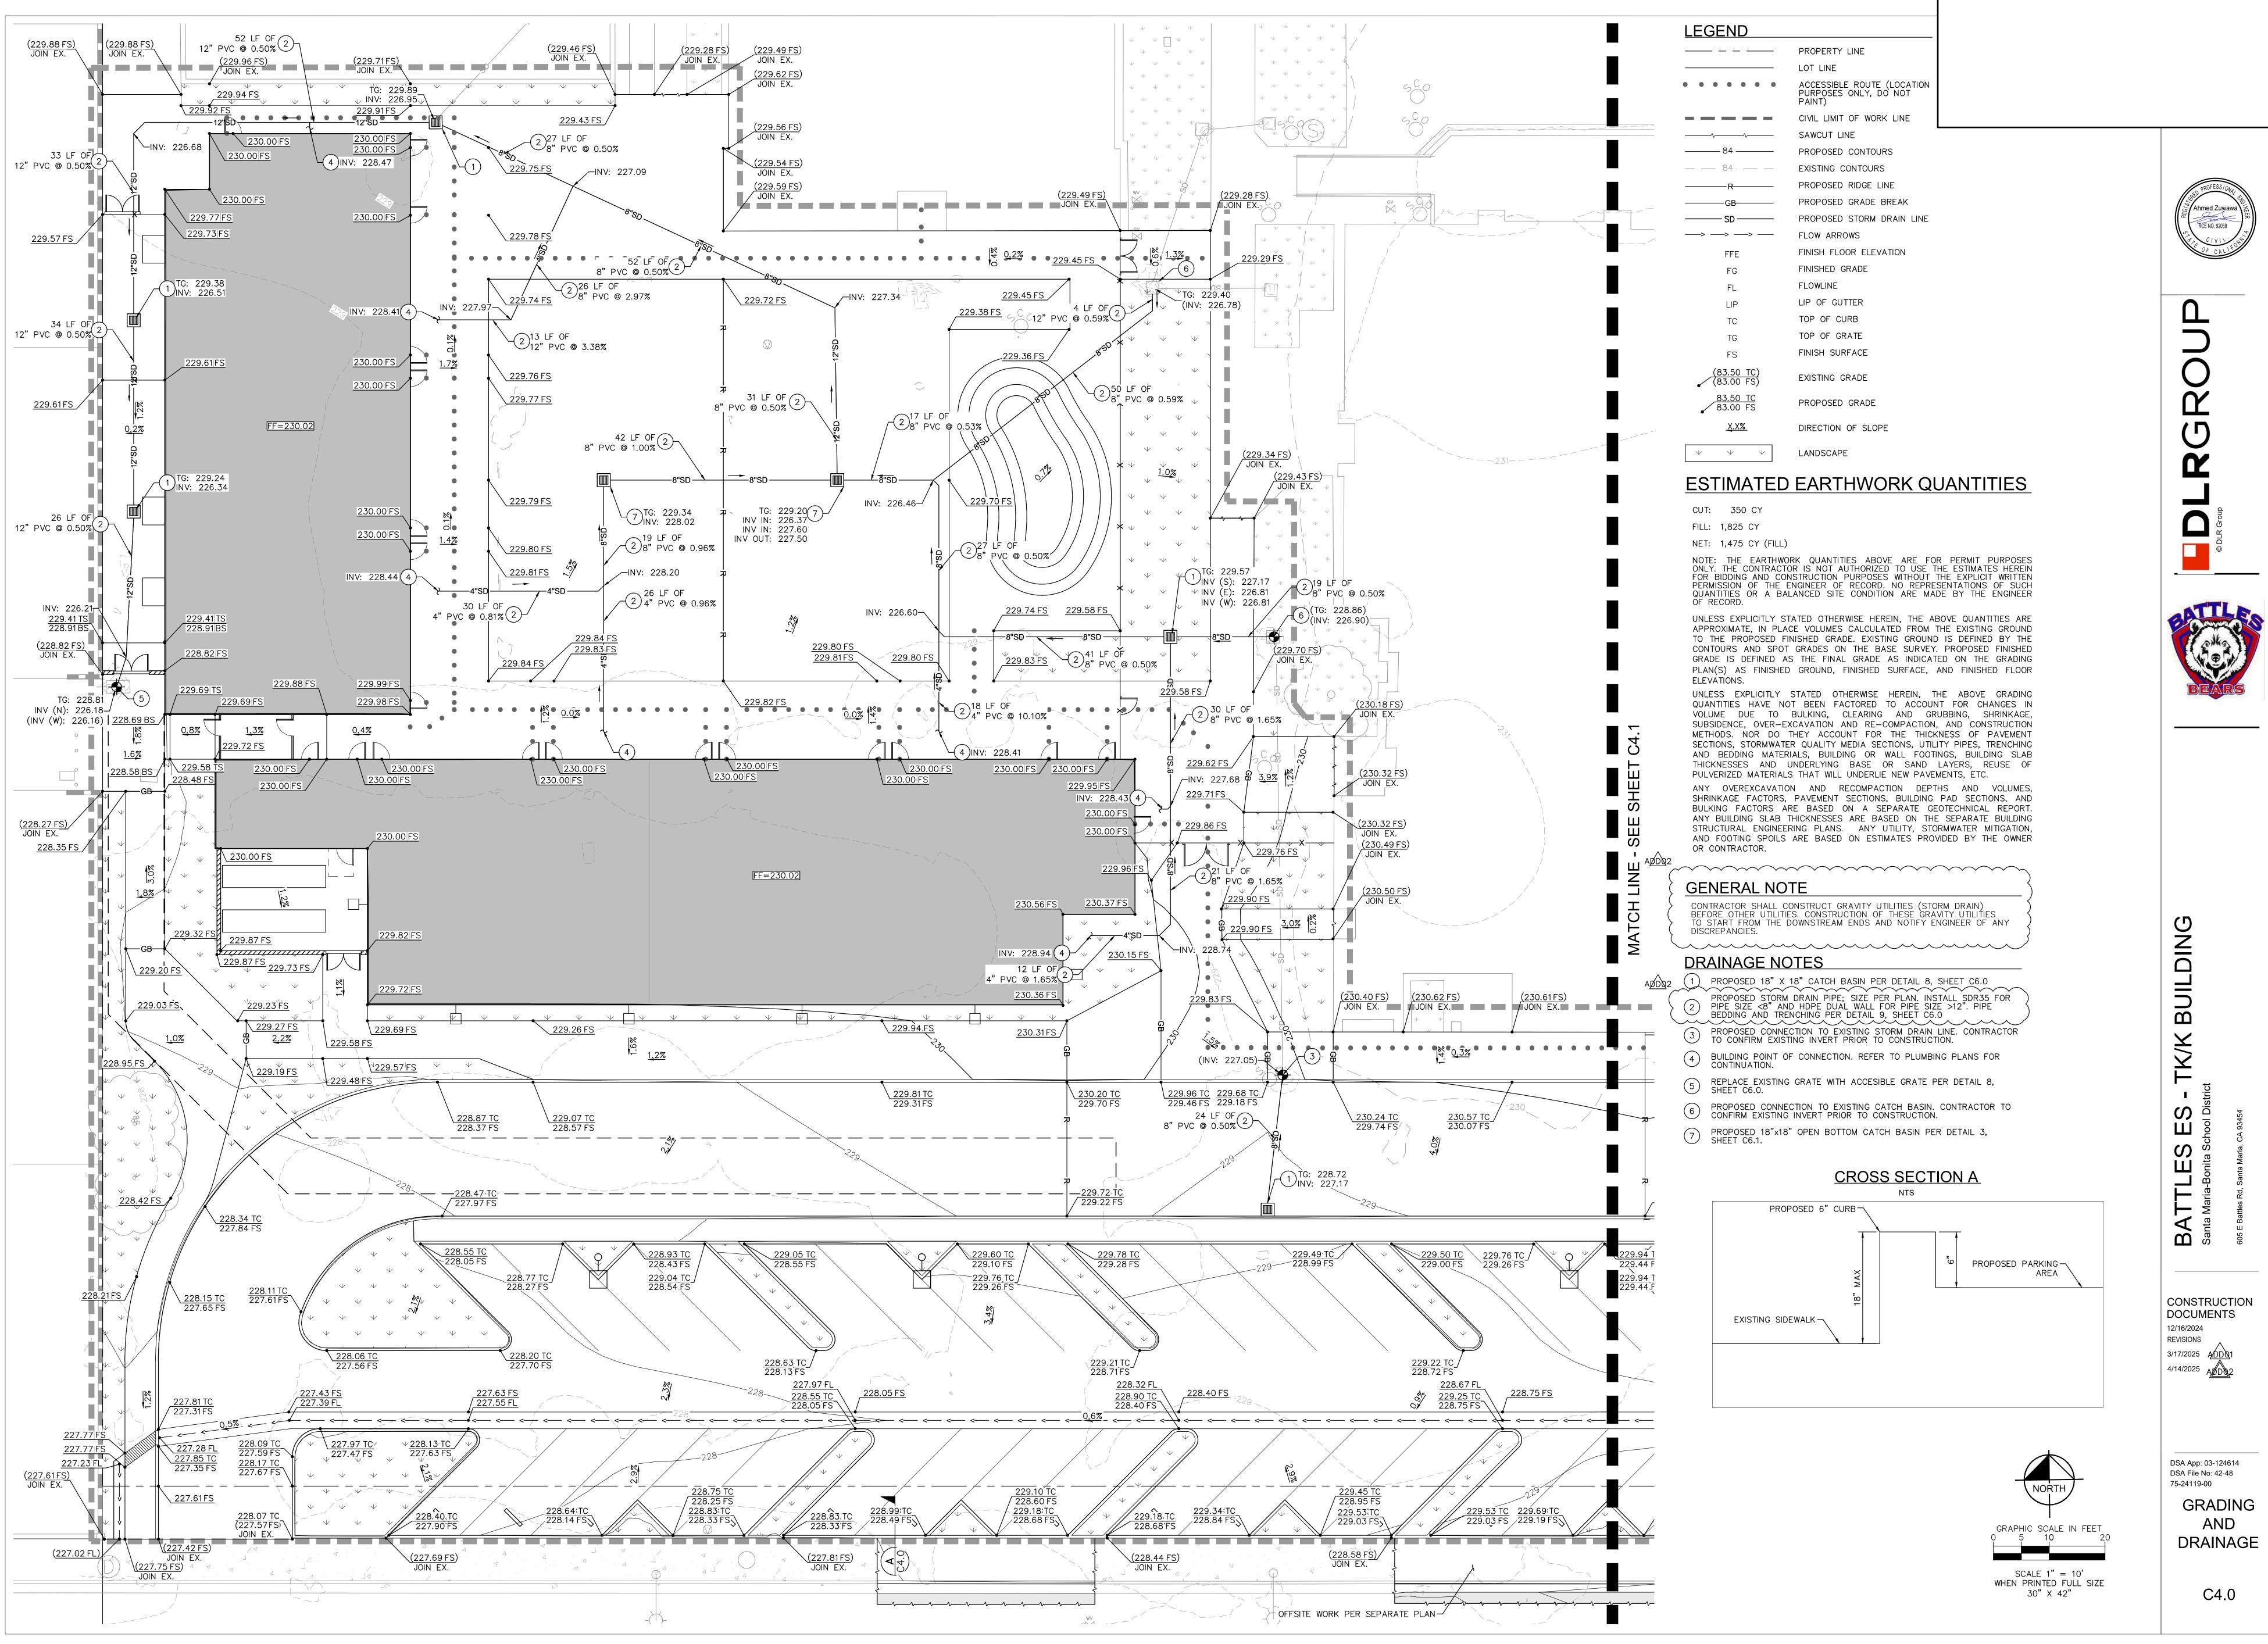



Ш	Sa	605
CONS DOCU	-	
12/16/202	24	
REVISION	s	\
3/17/2025	5 AN	1001

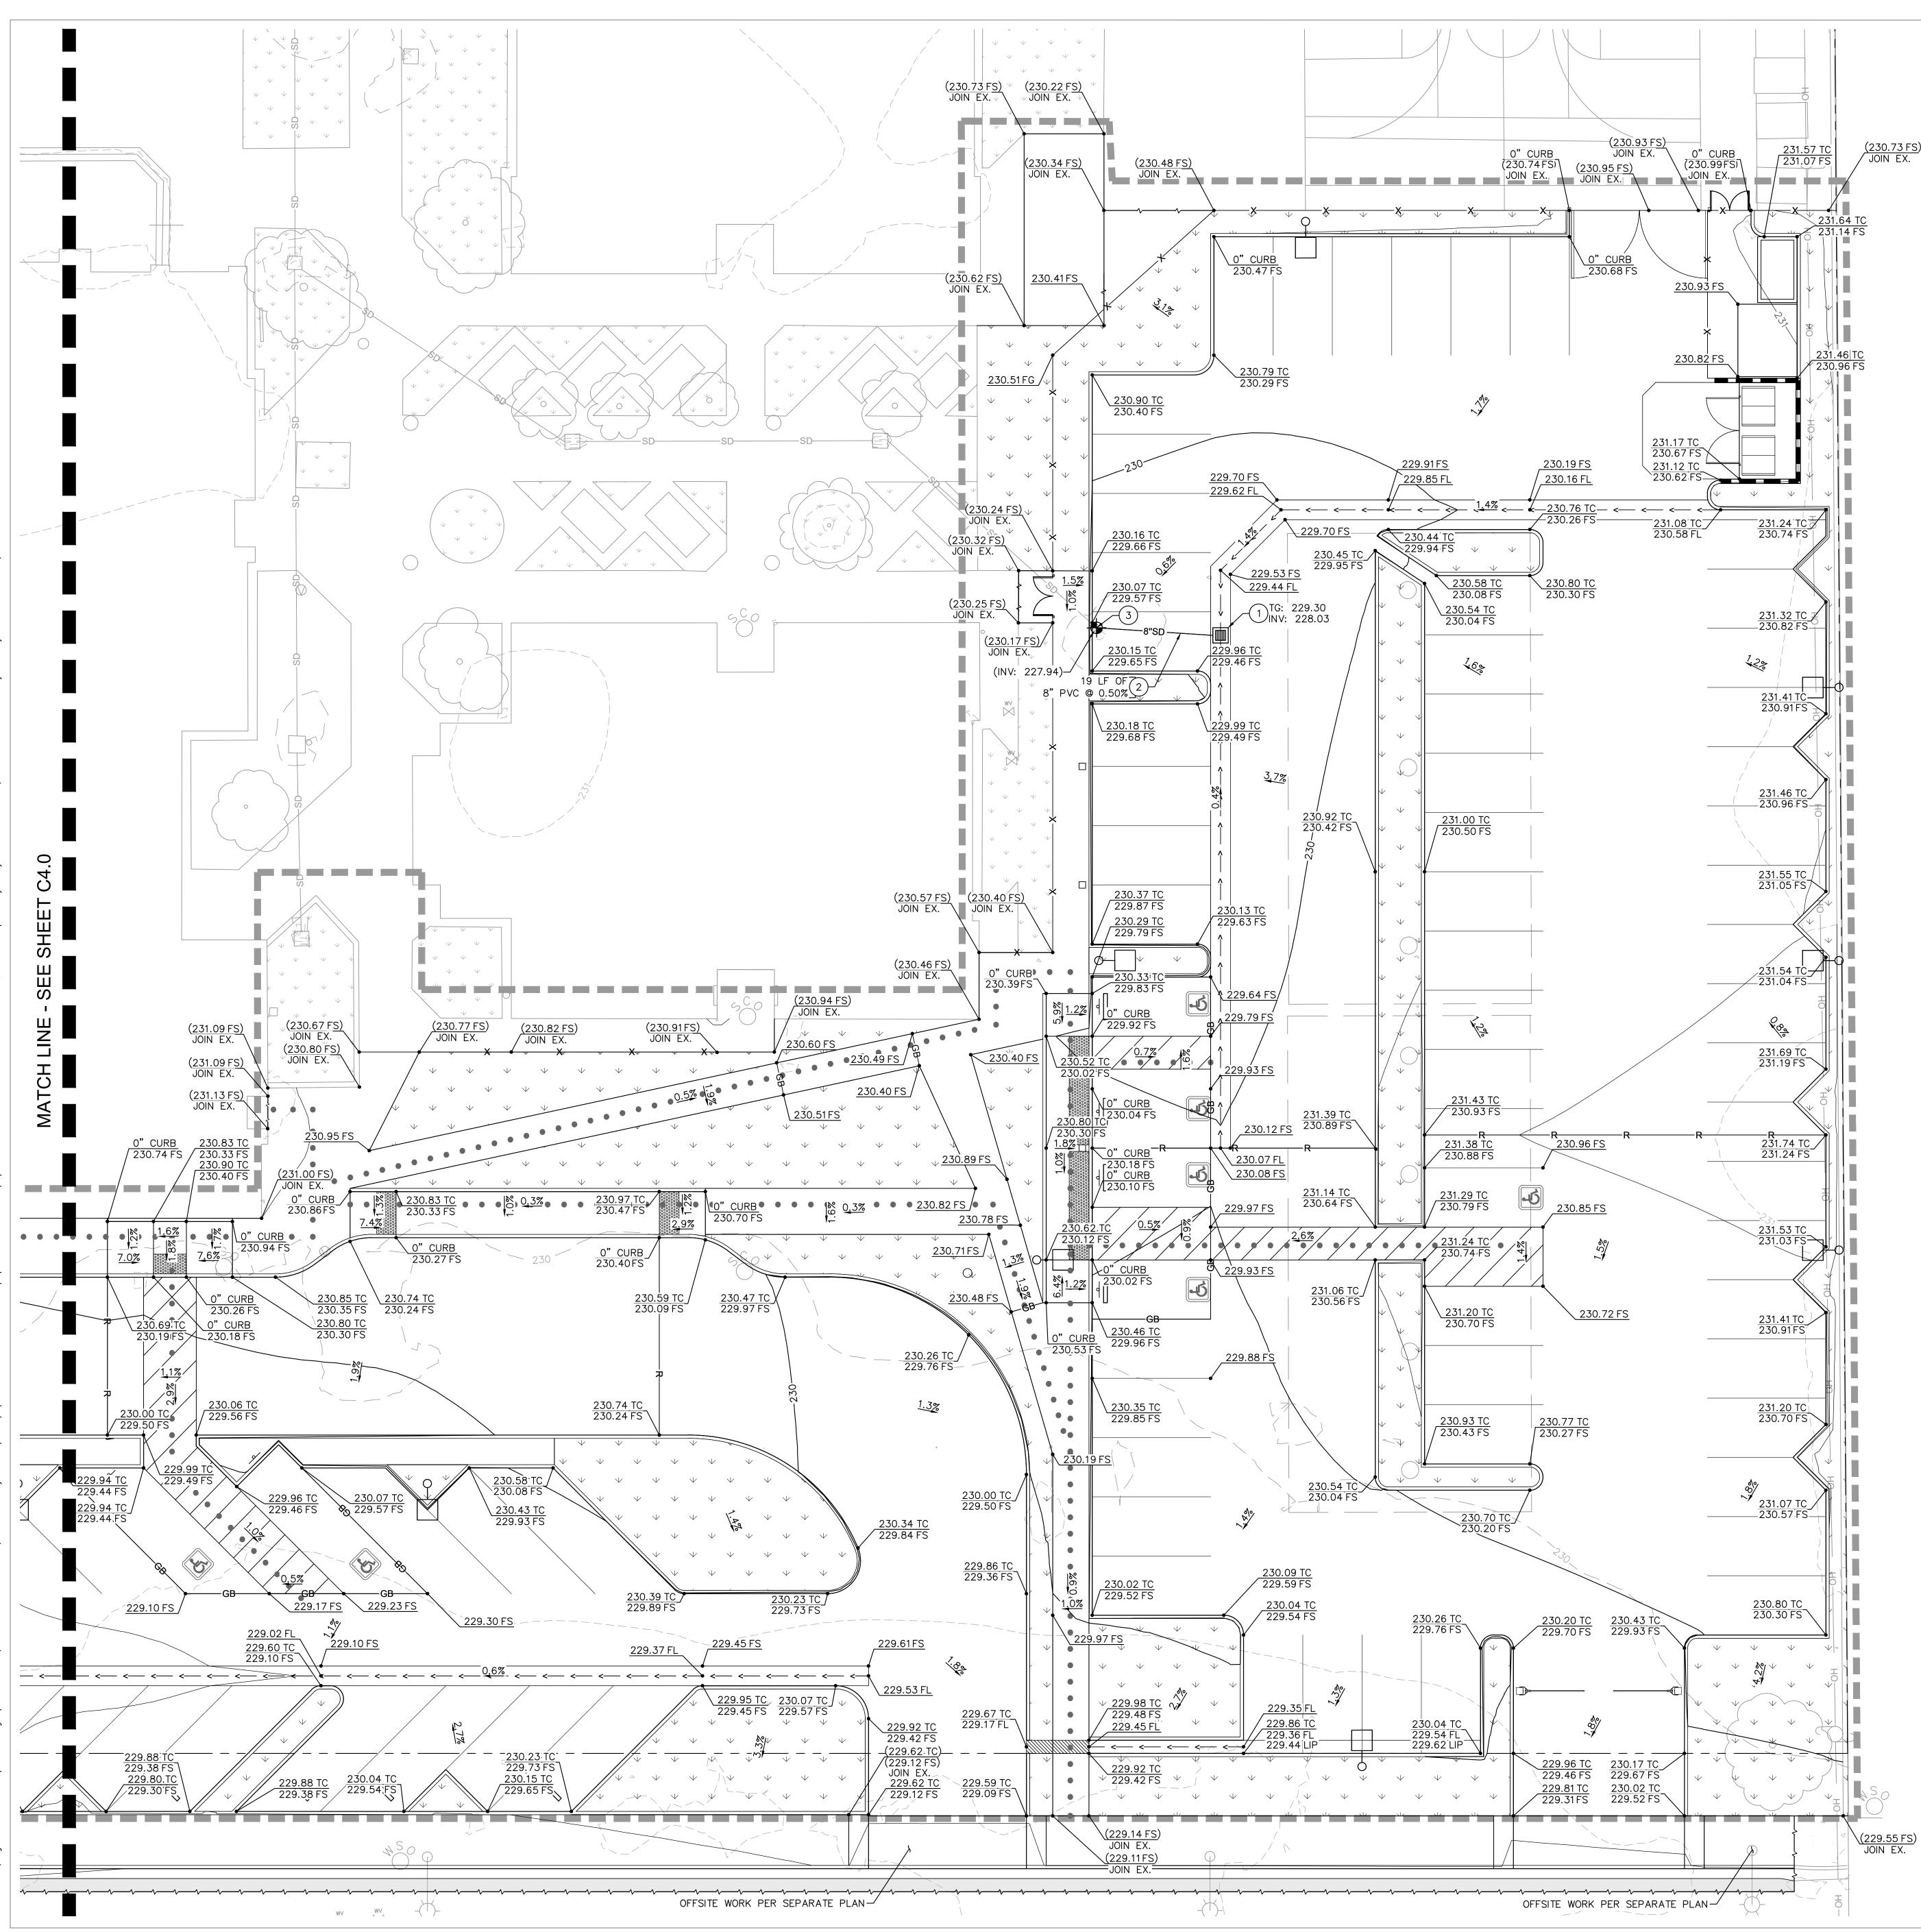


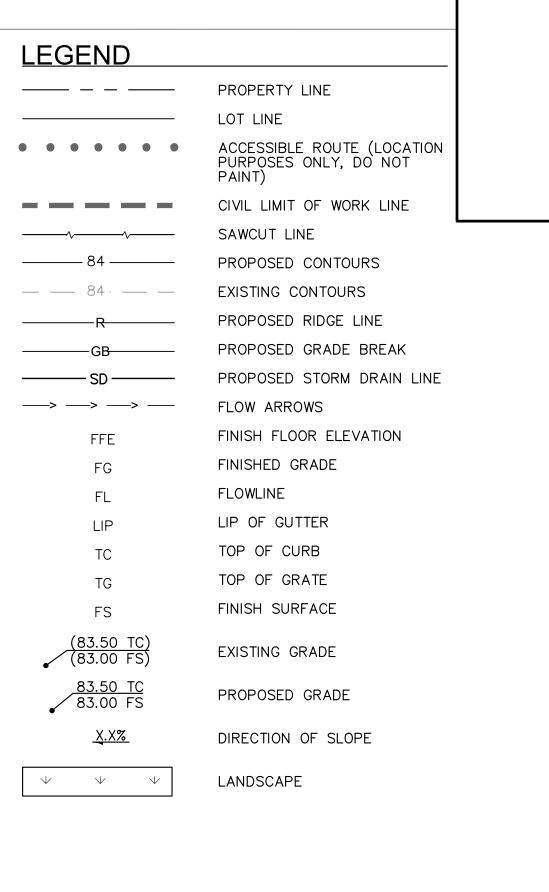

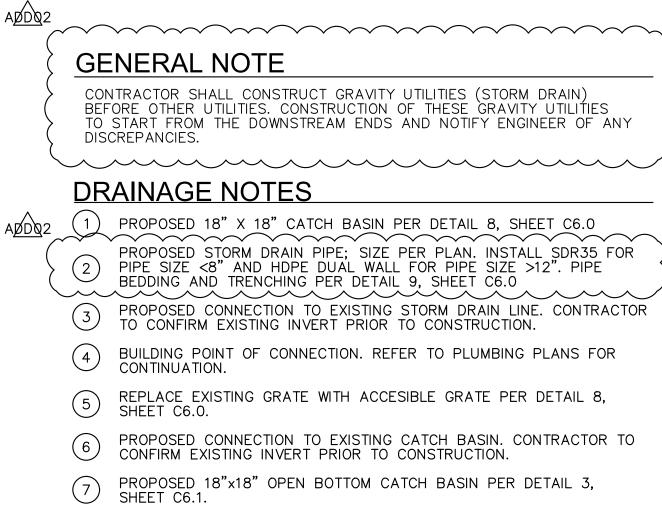

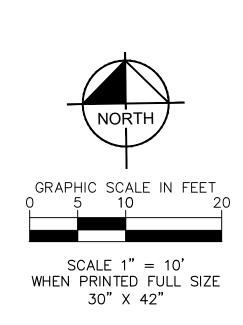

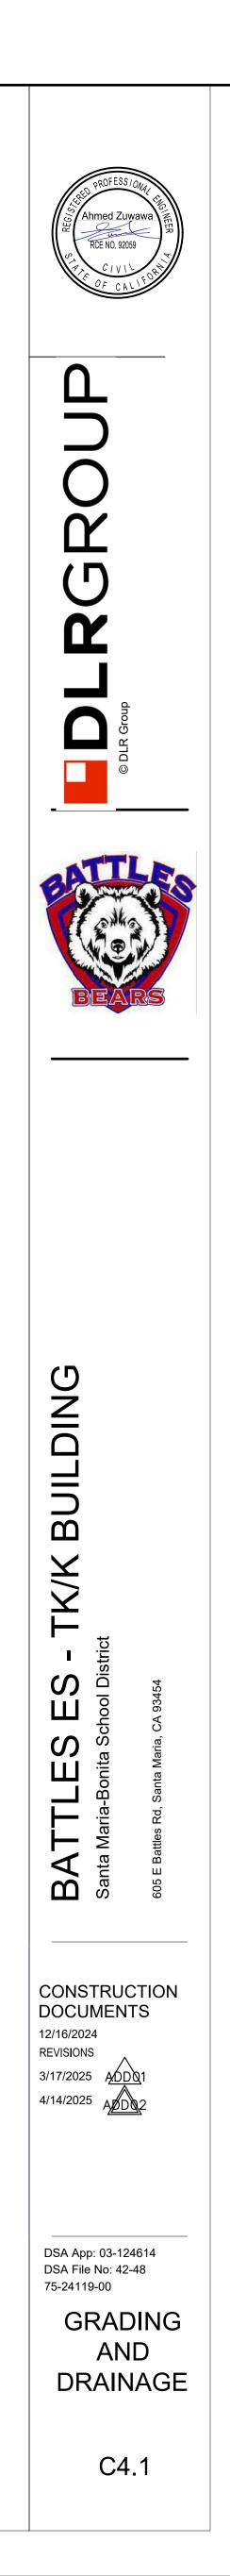

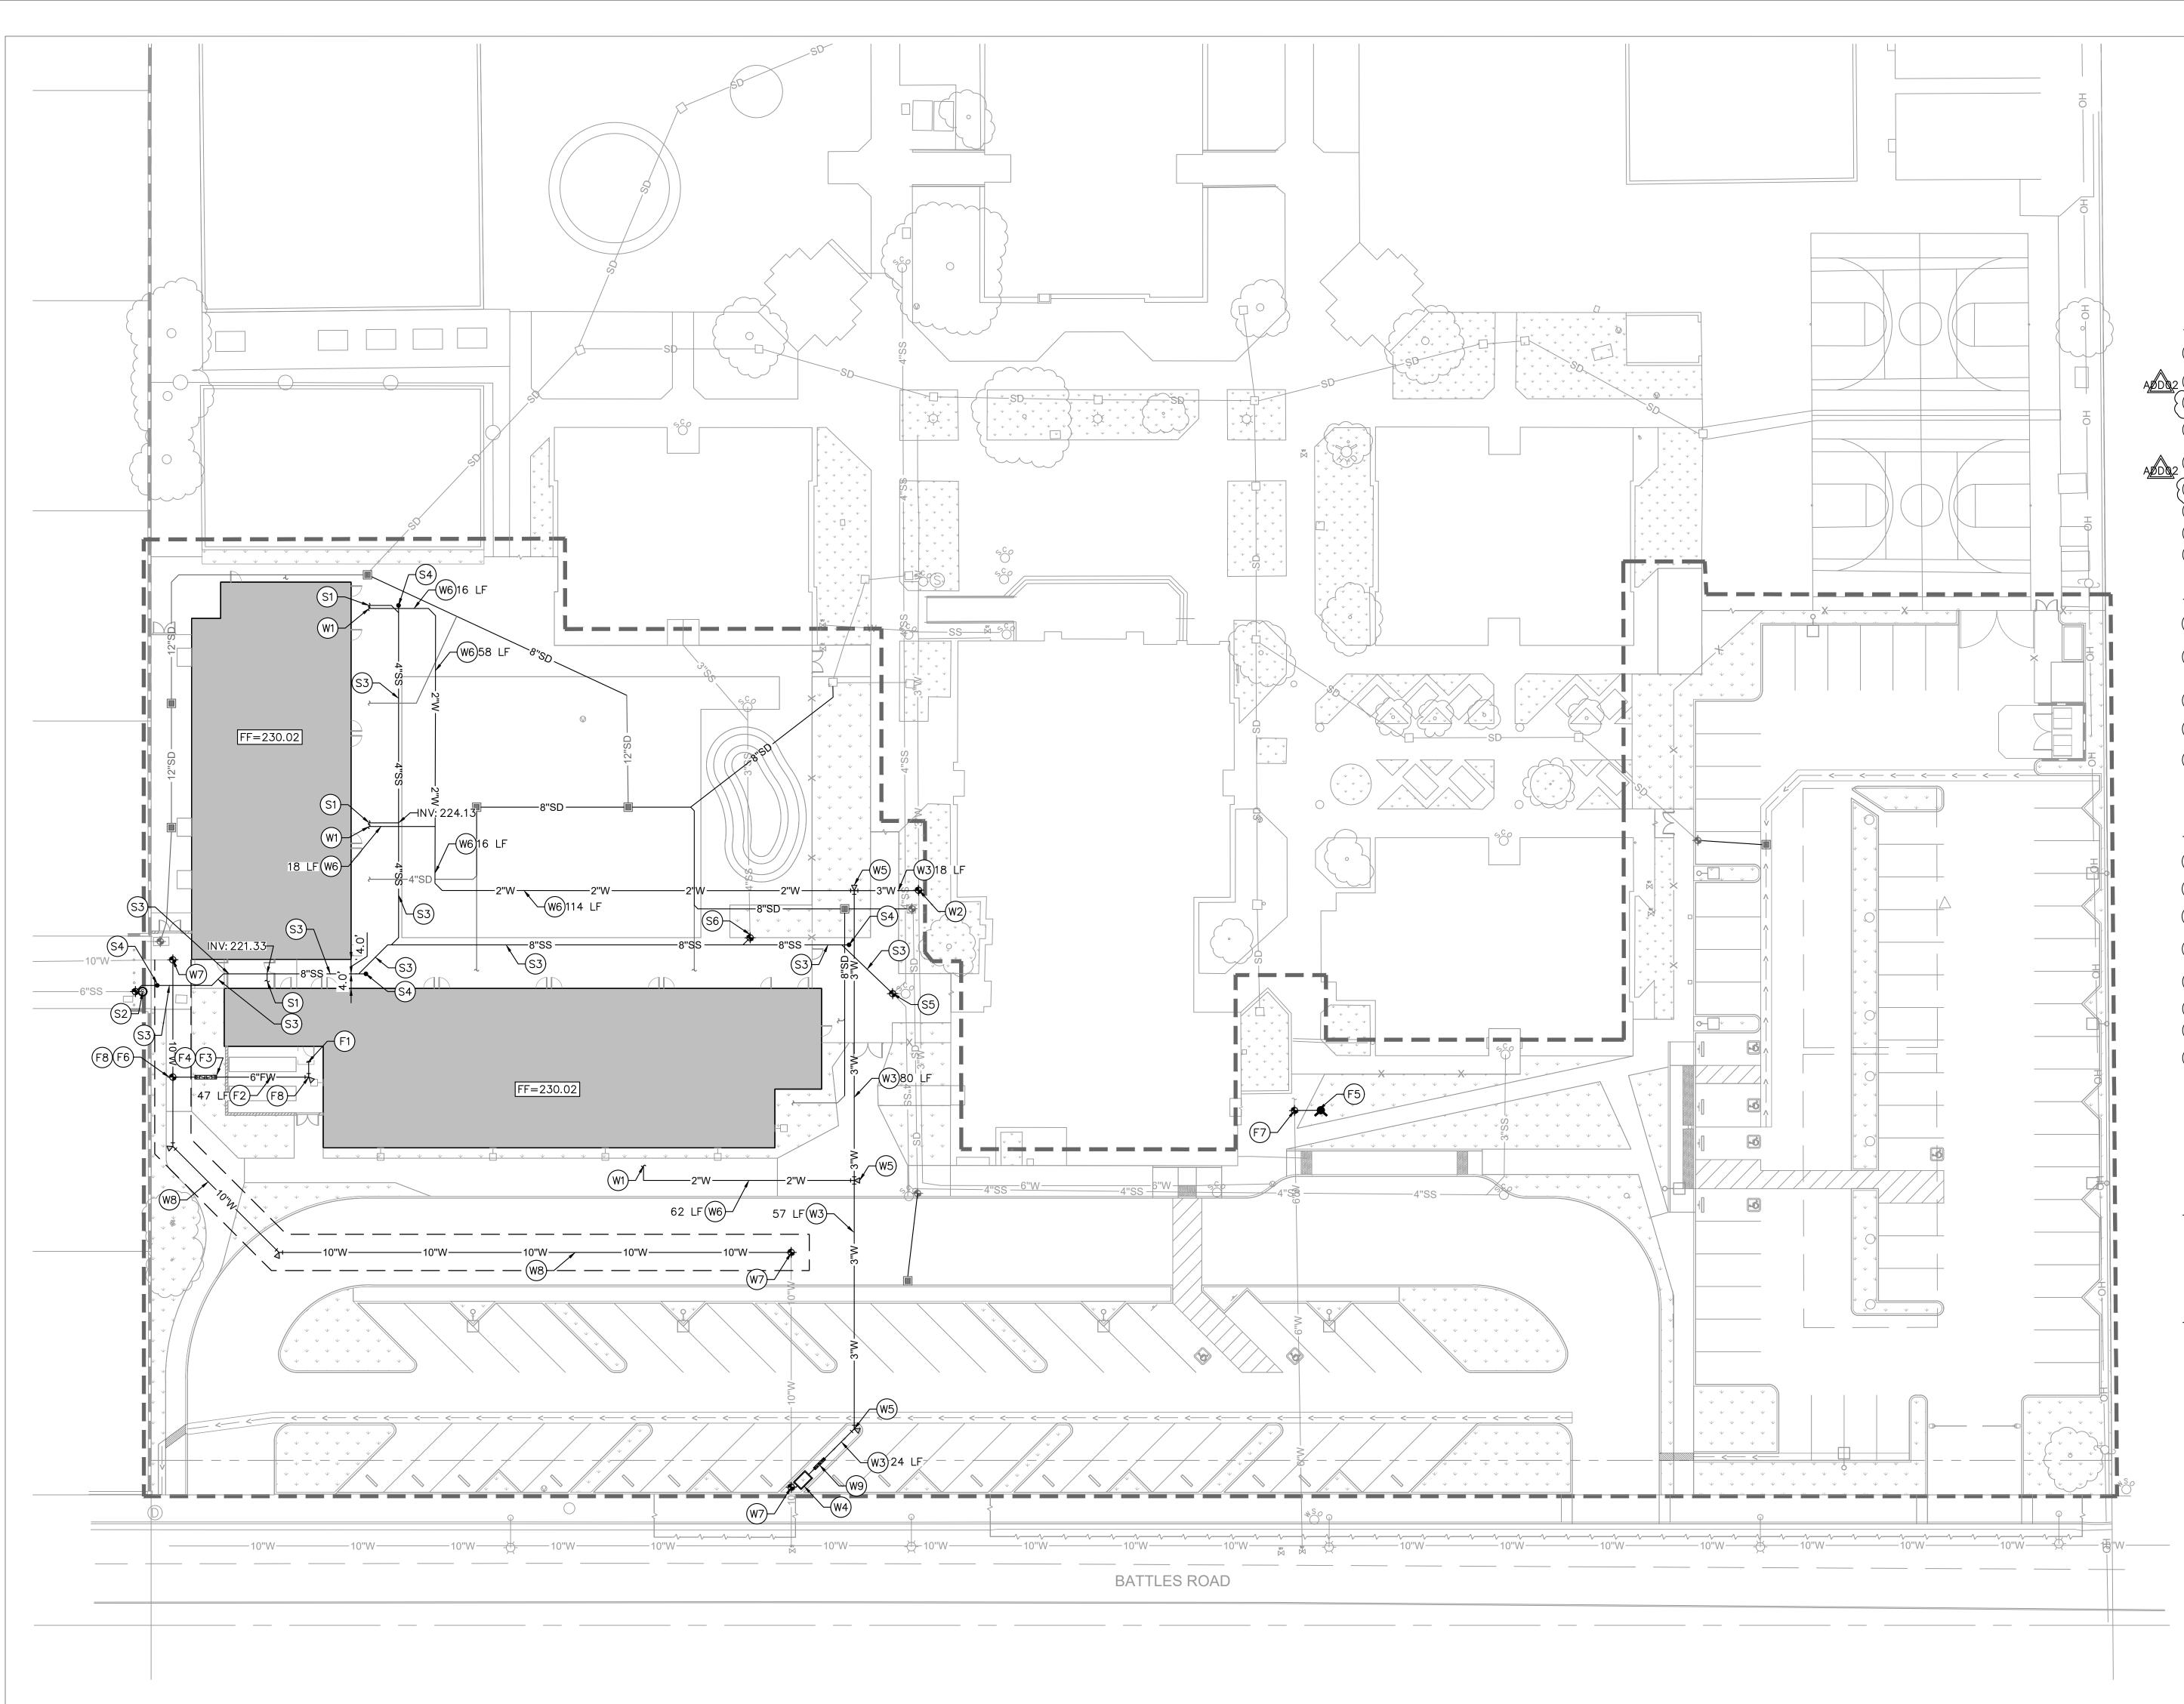

LEGEND	
	PROPERTY LINE
	LOT LINE
	CIVIL LIMIT OF WORK LINE
W	PROPOSED WATER LINE
SS	PROPOSED SEWER LINE
SD	PROPOSED STORM DRAIN LINE
FW	PROPOSED FIRE WATER LINE

DOMESTIC WATER

 ψ ψ ψ ψ ψ

* * * * * *

W1 BUILDING POINT OF CONNECTION (5-FT FROM BUILDING FACE). REFER TO PLUMBING PLAN FOR CONTINUATION

PROPOSED LANDSCAPE AREA

ADD 2 (W2) POINT OF CONNECTION TO EXISTING 3" WATER MAIN (W3) INSTALL 3" SCHEDULE 80 PVC C900 WATER LINE. TRENCHING PER DETAIL 9, SHEET C6.0. W4 COORDINATE RELOCATION OF EXISTING WATER METER WITH LOCAL WATER PURVEYOR PER SEPARATE PERMIT.

W5 INSTALL PVC C900, CLASS 200, BEND WITH THRUST BLOCK. SIZE PER PLAN. ANGLE PER PLAN. SEE DETAIL 1, SHEET C6.1. (W6 INSTALL 2" SCHEDULE 80 PVC WATER LINE. TRENCHING DETAIL 9, SHEET C6.0. (W7) CONNECT TO EXISTING 10" WATER LINE PER SEPARATE PERMIT.

- (W8) INSTALL 10" SCHEDULE 40 PVC WATER LINE PER SEPARATE PERMIT.
- (W9) INSTALL BACKFLOW PREVENTER PER SEPARATE PERMIT.

SANITARY SEWER

- S1 BUILDING POINT OF CONNECTION (5-FT FROM BUILDING FACE). REFER TO PLUMBING PLAN FOR CONTINUATION
- S2 PROPOSED WYE CONNECTION TO EXISTING SEWER MAIN PER SEPARATE PERMIT. INSTALL 8"X6" FITTING ON PRIVATE LATERAL UPSTREAM OF CLEANOUT AND WYE CONNECTION.
- S3 INSTALL SDR-35 PVC SANITARY SEWER LATERAL. SIZE PER PLAN. TRENCHING PER DETAIL 9, SHEET C6.0.
- (S4) INSTALL SANITARY SEWER CLEANOUT PER DETAIL 2, SHEET C6.1.
- S5 POINT OF CONNECTION TO EXISTING 4" SANITARY SEWER LATERAL. CONTRACTOR TO POTHOLE AND VERIFY DEPTH OF LINE PRIOR TO THE START OF CONSTRUCTION. NOTIFY CIVIL ENGINEER OF ANY DISCREPANCIES.

FIRE WATER

- $\stackrel{(F1)}{=}$ building point of connection (5-ft from building face). Refer to fire protection plans plans for continuation
- (F2) INSTALL 6" PVC C900 FIRE WATER LINE. TRENCH PER DETAIL 9, SHEET C6.0.
- F3 INSTALL 6" FEBCO MASTERSERIES LF876V BACKFLOW PREVENTER PER DETAIL 10, SHEET C6.0, OR APPROVED EQUAL.
- F4 INSTALL FIRE DEPARTMENT CONNECTION PER DETAIL 7, SHEET C6.1. MOUNT TO BACKFLOW PREVENTER
- F5 INSTALL FIRE HYDRANT PER CITY OF SANTA MARIA STANDARD DRAWING WA-31, SHOWN IN DETAIL 4, SHEET C6.1, PER SEPARATE PERMIT.
- (F6) CONNECT TO 10" WATER LINE PER SEPARATE PERMIT.


(F7) POINT OF CONNECTION TO EXISTING 6" WATER LINE LATERAL PER SEPARATE PERMIT. F8 INSTALL PVC C900, CLASS 200, BEND WITH THRUST BLOCK. SIZE PER PLAN. ANGLE PER PLAN. SEE DETAIL 1, SHEET C6.1.

EXISTING UTILITY NOTE

THE EXISTING UTILITIES SHOWN ON THE PLAN ARE BASED ON AVAILABLE RECORDS. THE CONTRACTOR MUST POTHOLE AND FIELD VERIFY THE LOCATION AND DEPTH OF ALL EXISTING UTILITIES PRIOR TO ANY CONSTRUCTION. REPORT DISCREPANCIES AND POTENTIAL CONFLICTS WITH PROPOSED UTILITIES TO CIVIL ENGINEER PRIOR TO INSTALLATION OF ANY PIPING.

GENERAL NOTE

CONTRACTOR SHALL CONSTRUCT GRAVITY UTILITIES (SEWER) BEFORE OTHER UTILITIES. CONSTRUCTION OF THESE GRAVITY UTILITIES TO START FROM THE DOWNSTREAM ENDS AND NOTIFY ENGINEER OF ANY DISCREPANCIES.

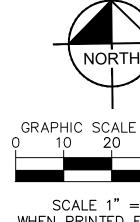










CONSTRUCTION DOCUMENTS 12/16/2024 REVISIONS 3/17/2025 ADD 1 4/14/2025 App 2


> DSA App: 03-124614 DSA File No: 42-48 75-24119-00

NORTH GRAPHIC SCALE IN FEET SCALE 1" = 20' WHEN PRINTED FULL SIZE 30"X 42"

C5.0

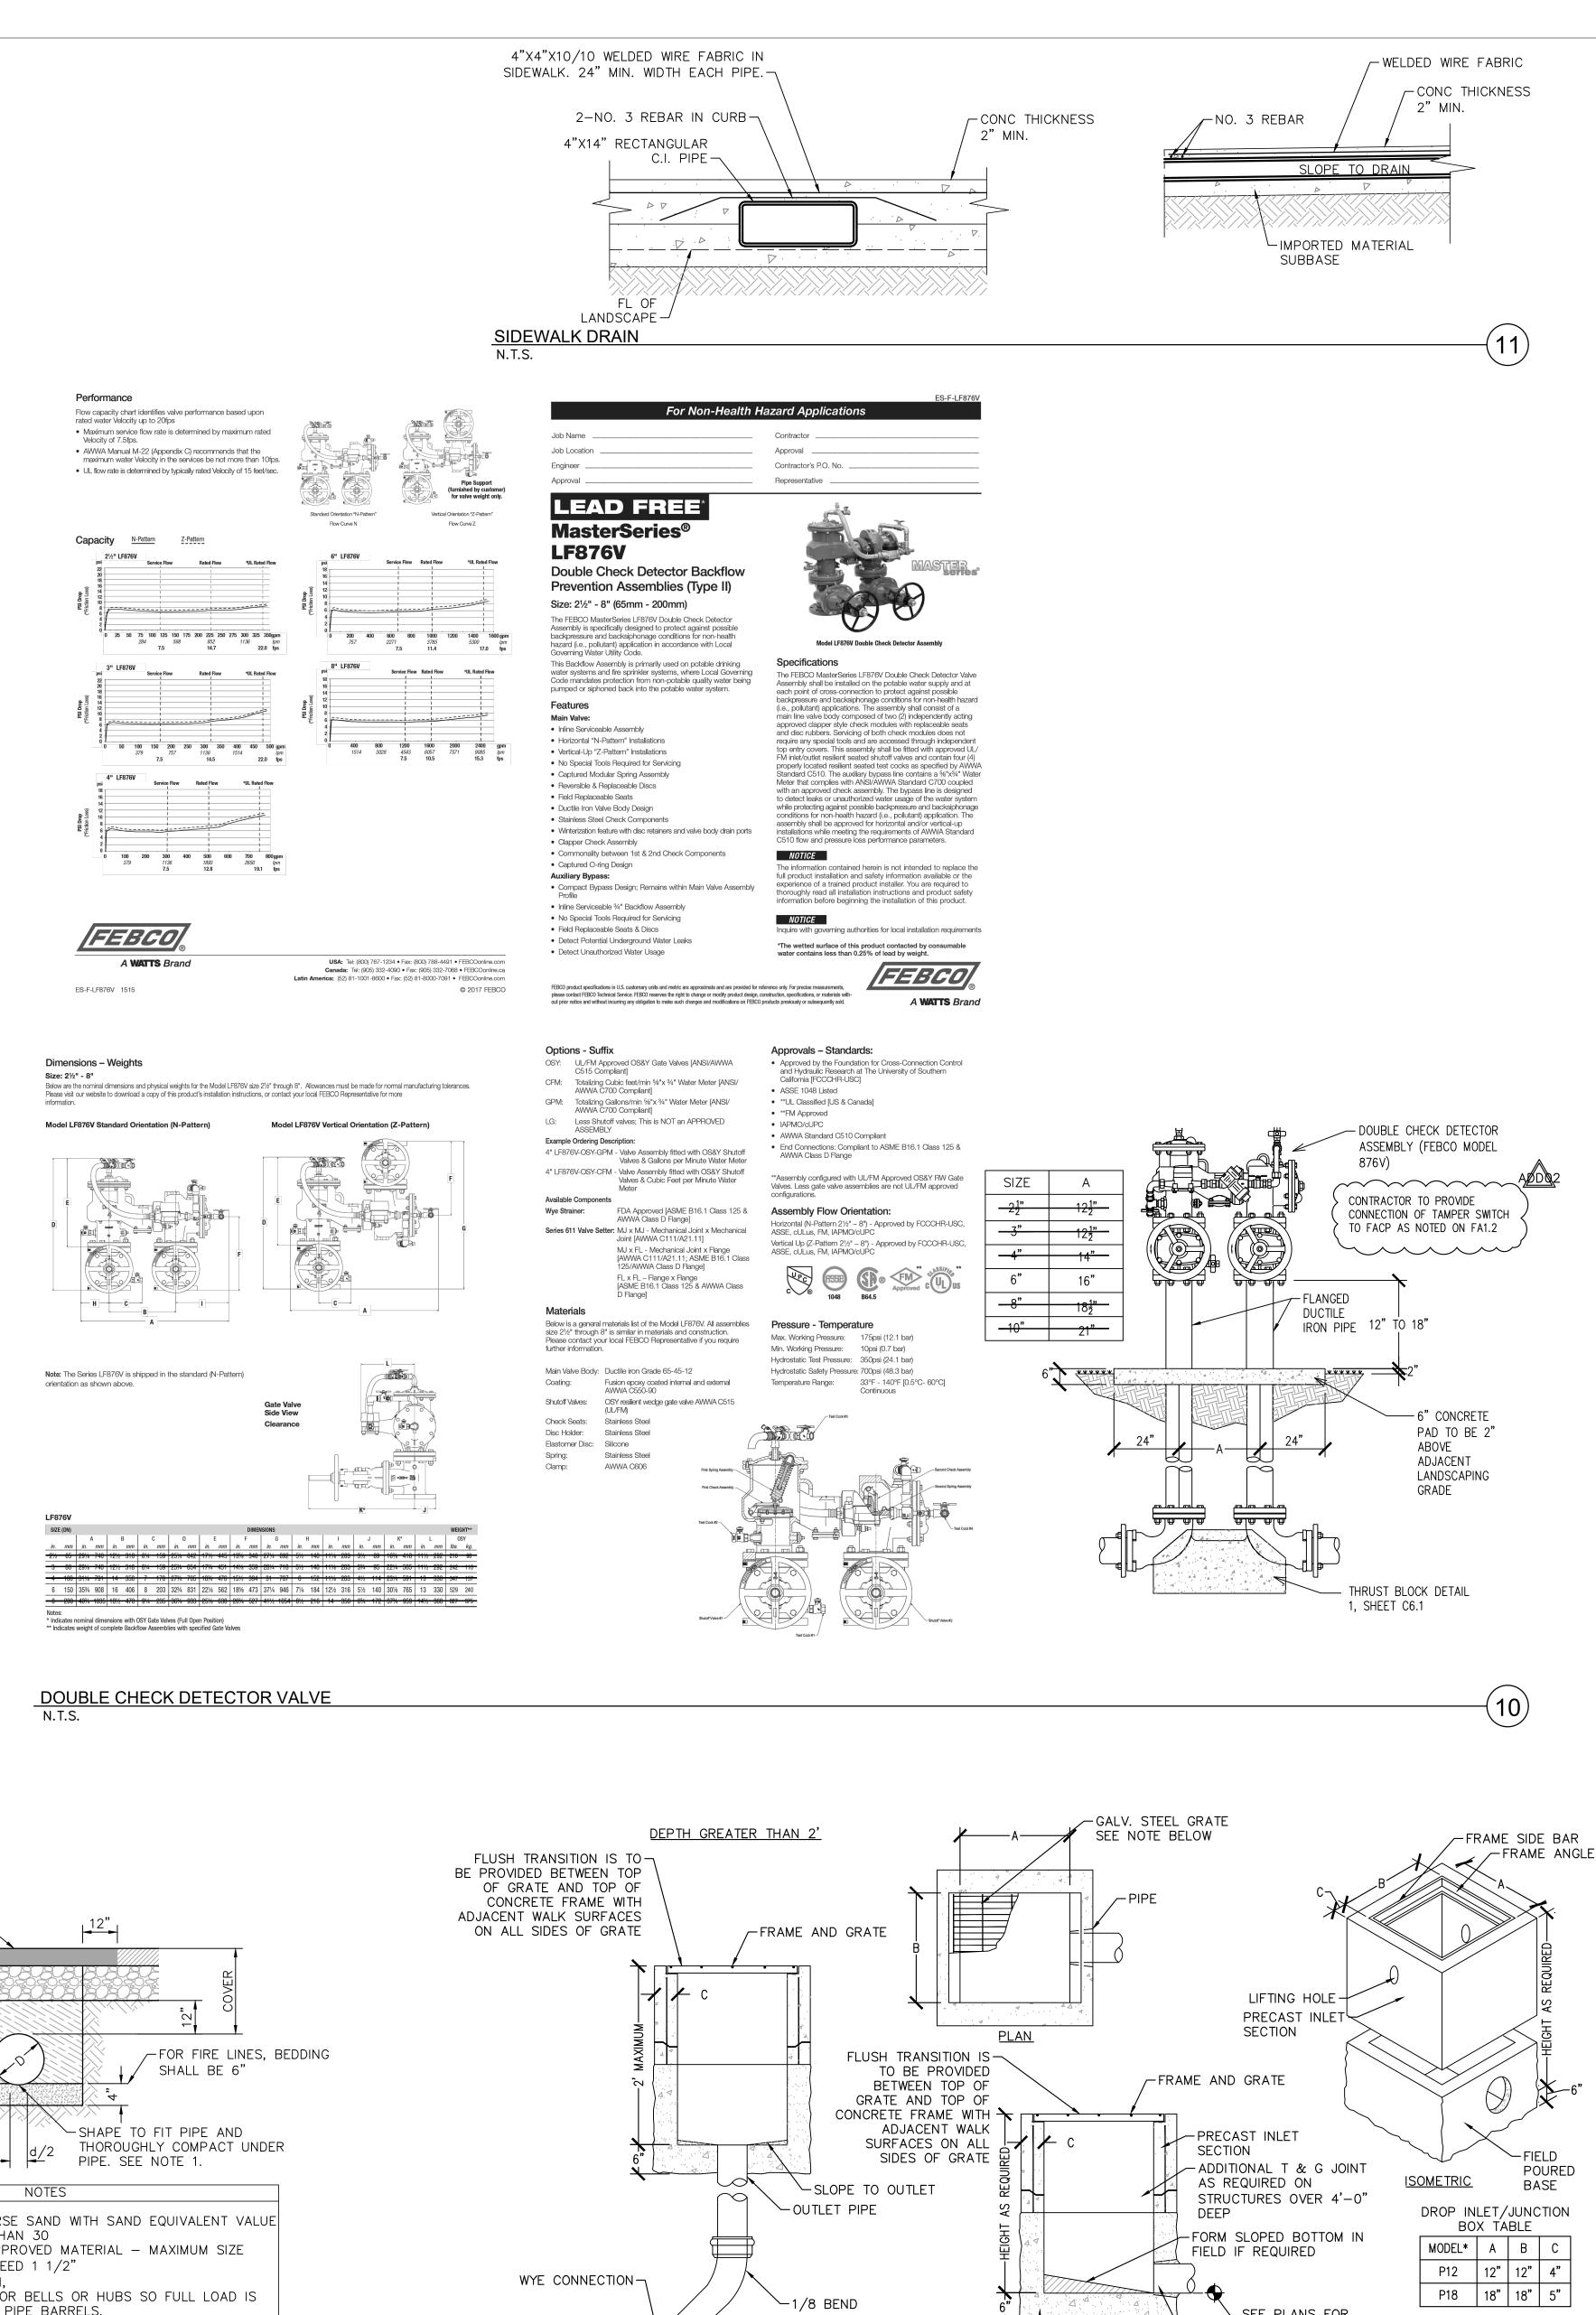


(9)

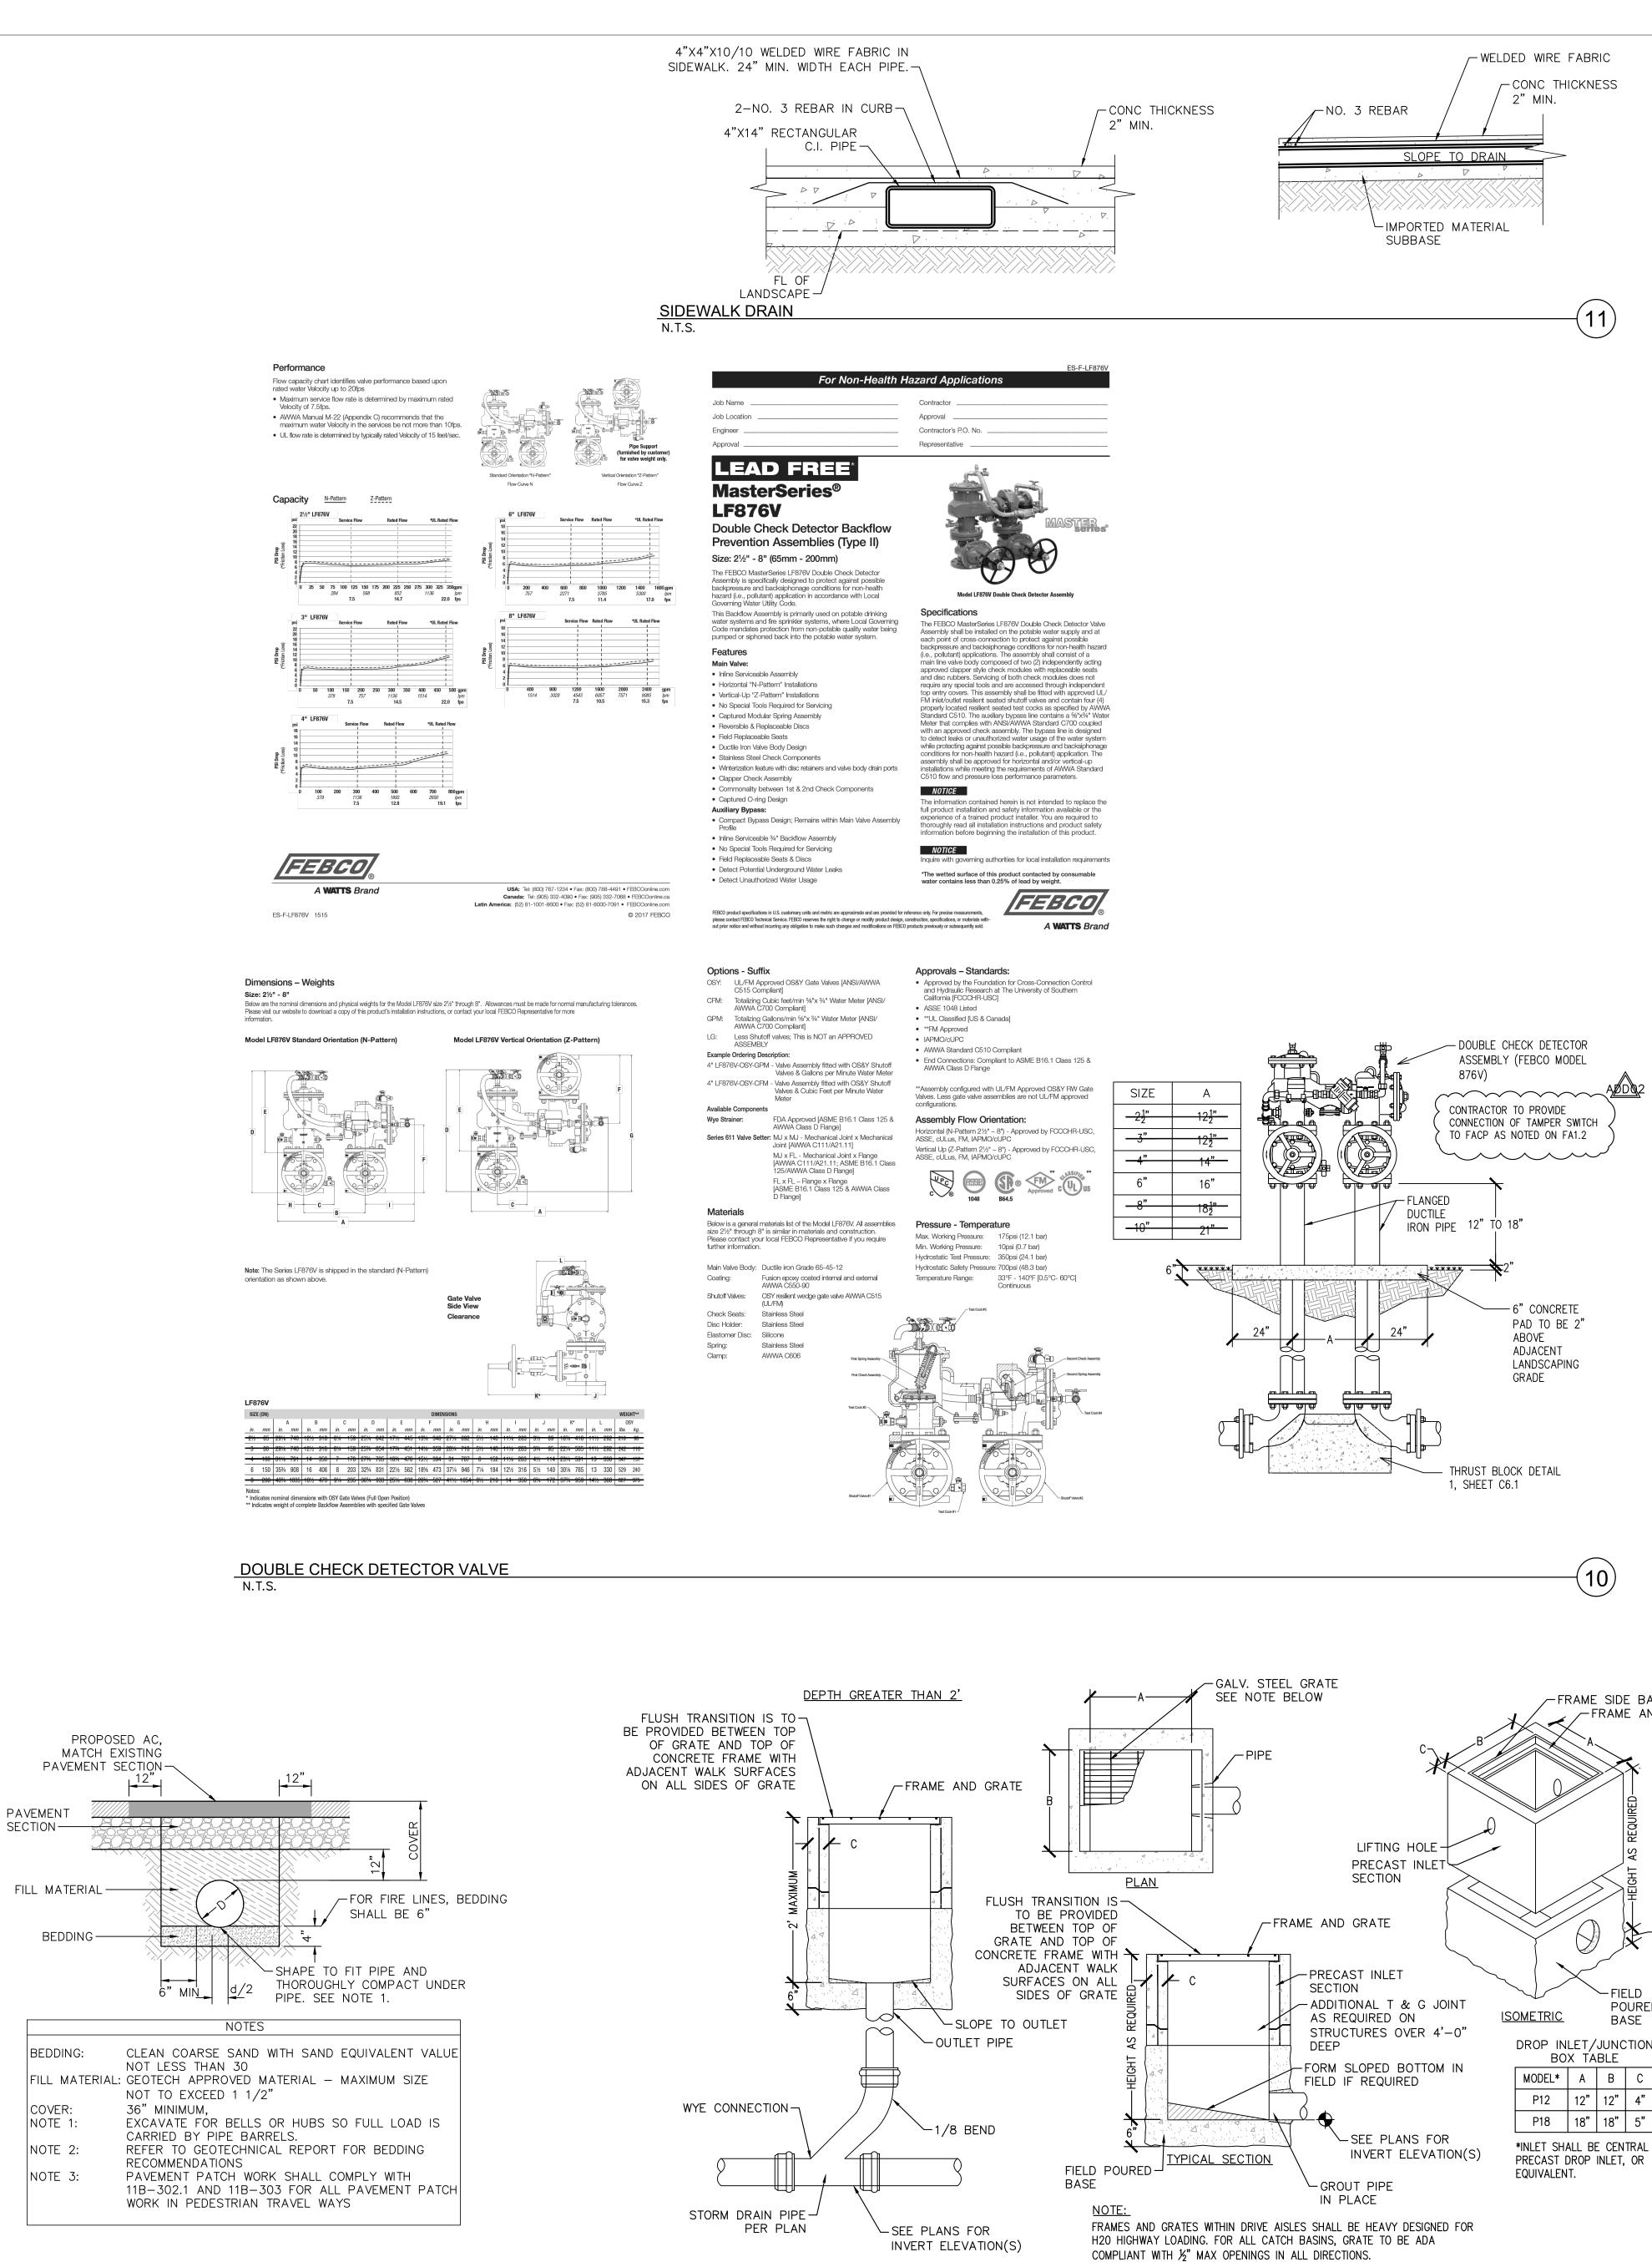

PIPE TRENCHING AND BEDDING DETAIL

CATCH BASIN N.T.S.

8

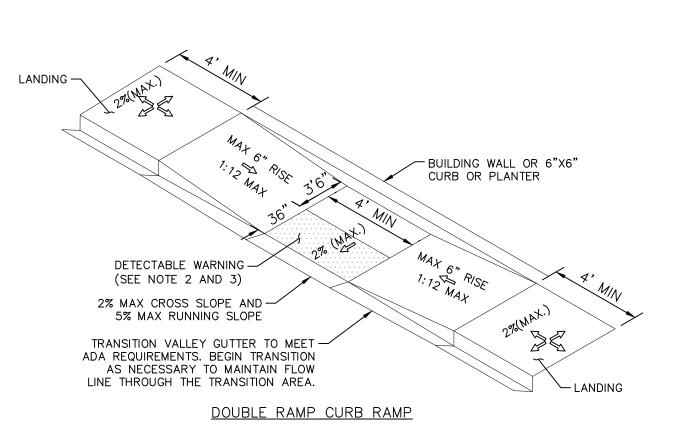

<u>NOTES:</u>


- 1. ALL ACCESSIBLE COMPONENTS CONSTRUCTED AS PART OF THESE PLANS SHALL COMPLY WITH THE LOCAL, STATE, AND FEDERAL REGULATIONS WHICHEVER ARE MORE STRINGENT. 2. CURB RAMPS SHALL HAVE A DETECTABLE WARNING EXTENDING THE FULL WIDTH OF THE CURB RAMP AND 3' DEEP. GROOVED
- SURFACES ON OUTDOOR CURB RAMPS ARE NOT PERMITTED. VERIFY LOCAL REQUIREMENTS WITH THE BUILDING DEPARTMENT. REFER TO TRUNCATED DOMES DETAIL AND REQUIREMENTS IN THE CALIFORNIA BUILDING CODE.
- 3. PARALLEL CURB RAMPS SHALL HAVE A DETECTABLE WARNING EXTENDING 36" DEEP ALONG THE FLUSH TRANSITION BETWEEN STREET AND SIDEWALK. REFER TO TRUNCATED DOMES DETAIL. 4. PUBLIC SIDEWALK CURB RAMPS CONSTRUCTED WITHIN A PUBLIC
- RIGHT- OF -WAY, IN ABSENCE OF LOCAL ROADWAY GUIDELINES, SHALL MEET OR EXCEED LOCAL REGULATIONS.
- 5. CURB RAMP SURFACES (FLARES AND RAMP) SHALL HAVE A DIFFERENT TEXTURE FROM THE SURROUNDING PAVEMENT. 6. CURB RAMPS SHALL BE CONCRETE WITH STRENGTH OF 2500
- PSI. 7. INSTALL 1/4" EXPANSION JOINT FILLER MATERIAL BETWEEN A NEW CURB RAMP AND THE EXISTING SIDEWALKS. 8. WATER PONDING WITHIN THE CURB RAMP LIMITS IS NOT
- ALLOWED. 9. NO GRADE BREAK IS ALLOWED ALONG THE RAMP SURFACE. 10. CROSS SLOPE OF THE CURB RAMP SURFACE SHALL BE LESS
- THAN 2%. 11. TRANSITION CHANGE IN ELEVATION IS NOT TO EXCEED 1/2"

ACCESSIBLE RAMP DETAILS

N.T.S.

NOTES:

WITHIN AN ACCESSIBLE ROUTE. 12. DIAGONAL CURB RAMP SIDE SLOPE VARIES UNIFORMLY FROM A MAXIMUM OF UP TO 10% AT CURB TO CONFORM WITH LONGITUDINAL SIDEWALK SLOPE ADJACENT TO TOP OF THE RAMP

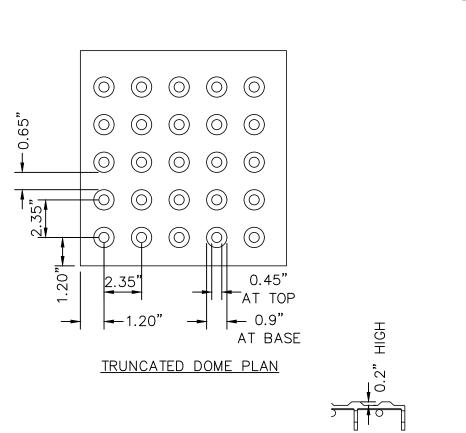

TRUNCATED DOME SECTION

N.T.S.


NOTES:

N.T.S.

N.T.S.

1. CONTRACTOR TO REFERENCE MANUFACTURERS GUIDELINES FOR INSTALLATION OF TRUNCATED DOMES. 2. COLOR TO BE YELLOW UNLESS NOTED OTHERWISE


DETECTABLE WARNING N.T.S.

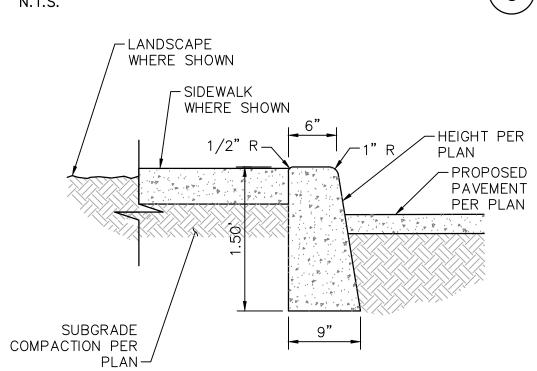



<u>NOTES:</u>


- . CONCRETE SHALL BE 3500 PSI.
- 2. ISOLATION JOINTS SHALL BE PLACED ONLY AS SPECIFIED 3. CONTRACTION JOINTS CONSISTING OF 1" DEEP SCORES SHALL BE
- PLACED AT 15' INTERVALS O.C. 4. WHERE A WALK IS ADJACENT TO THE CURB THE JOINTS SHALL ALIGN
- WITH JOINTS IN THE WALK.


CONCRETE CURE N.T.S.

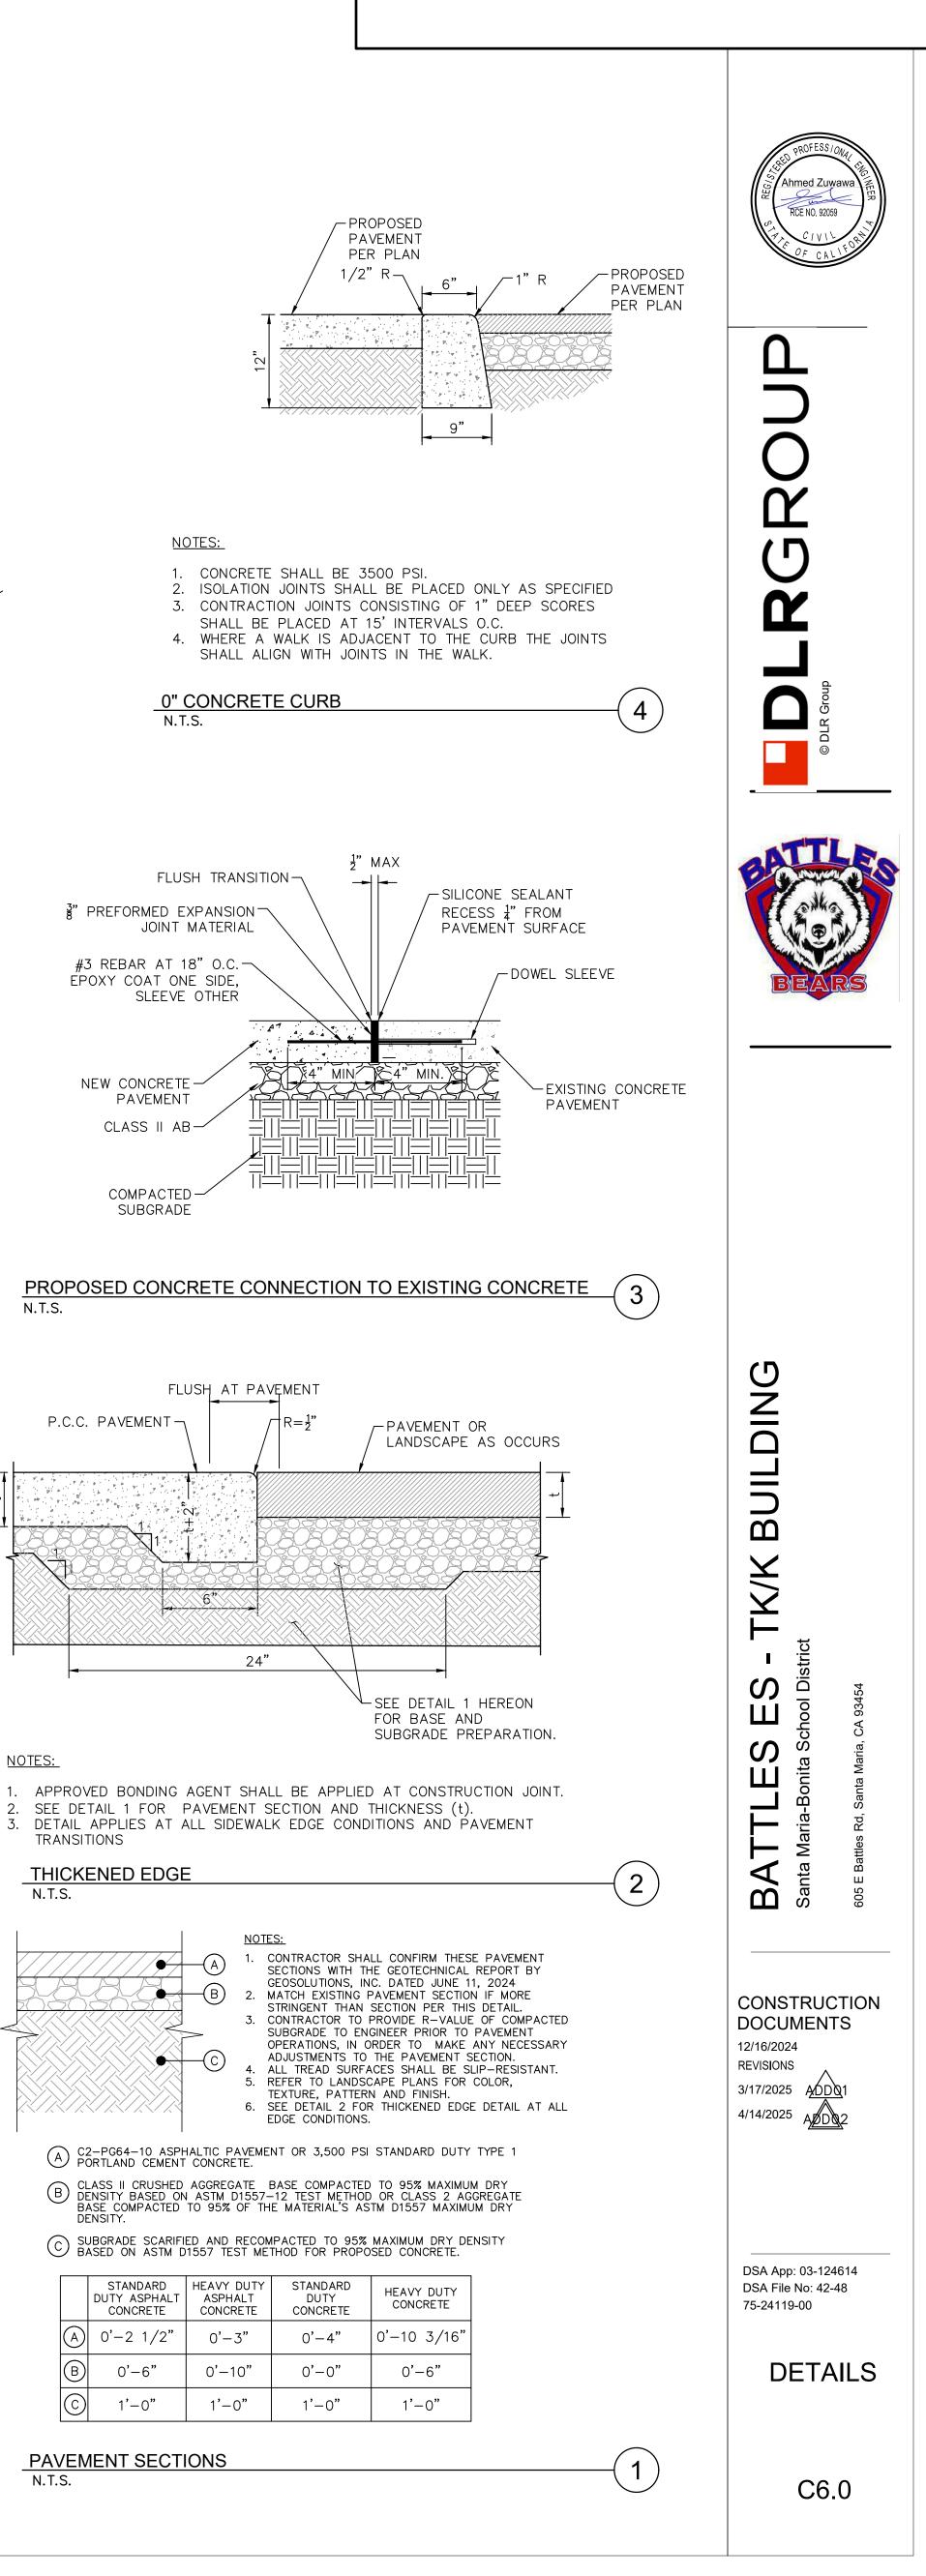


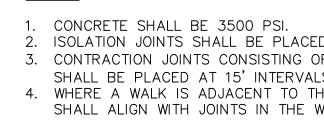


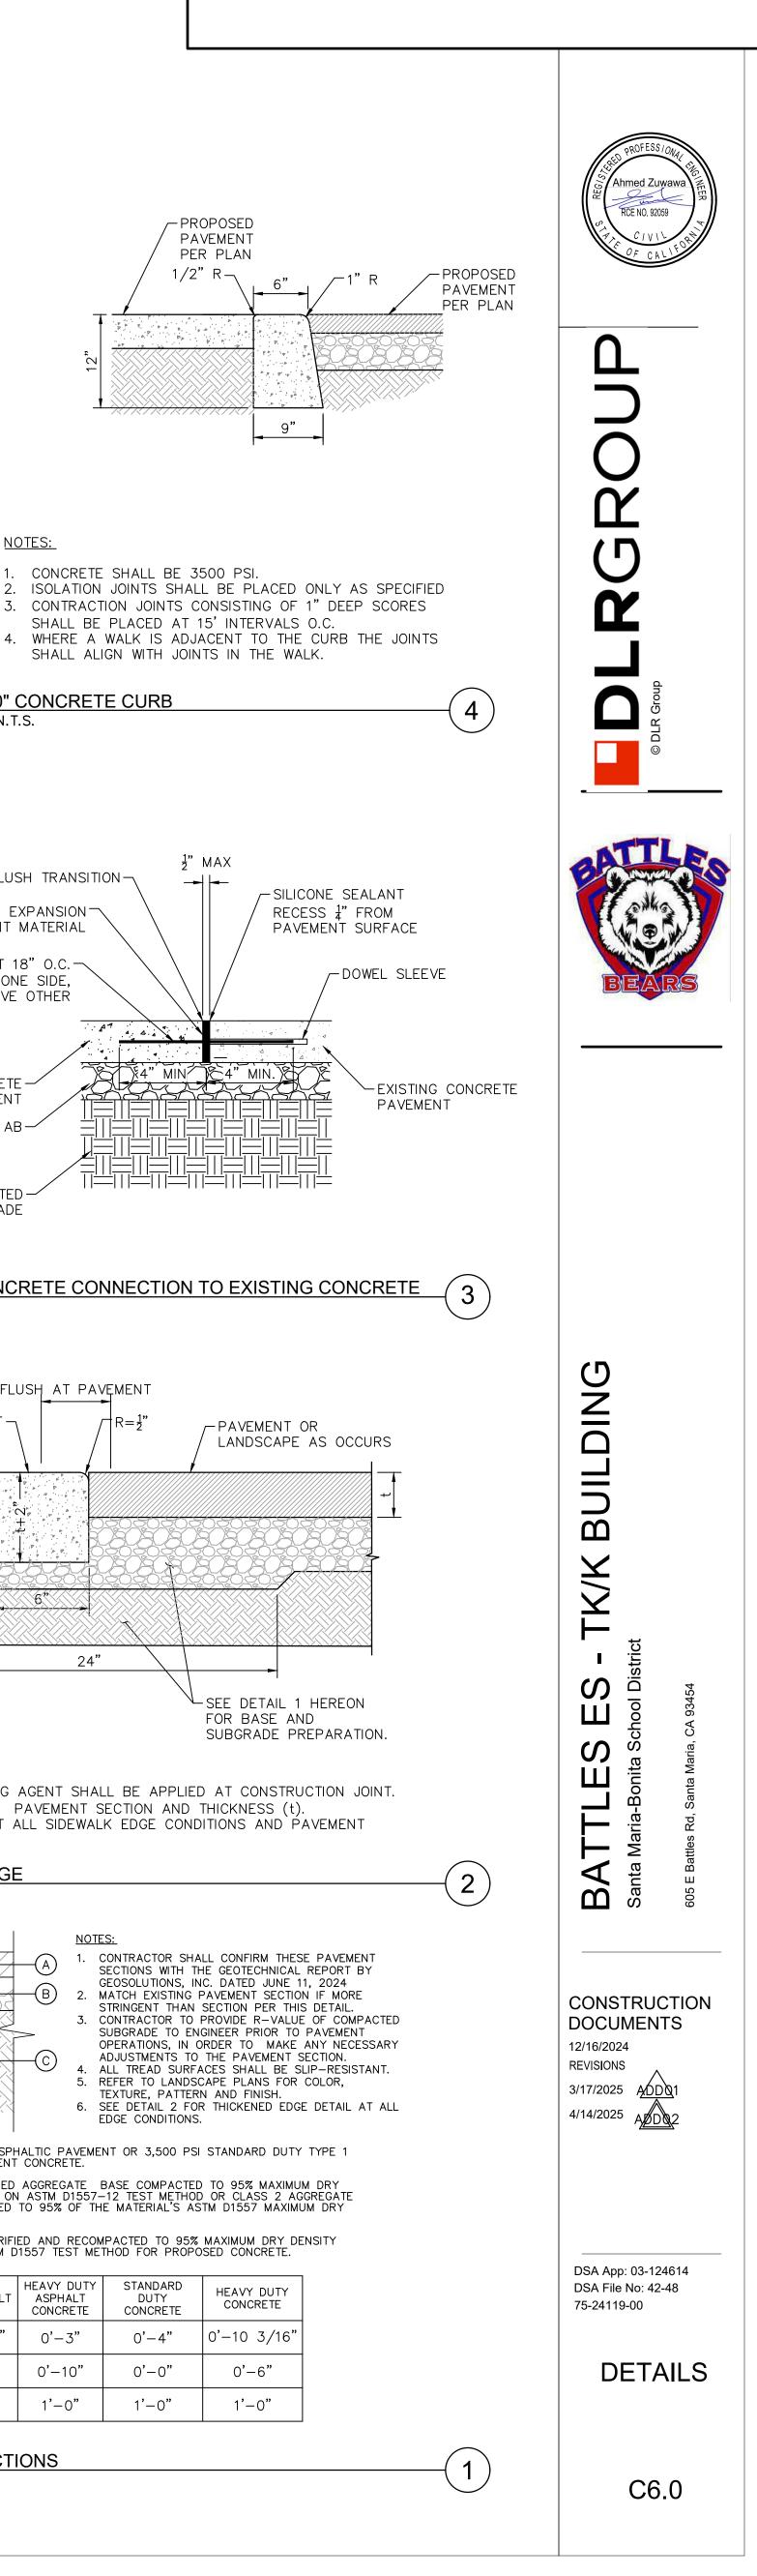


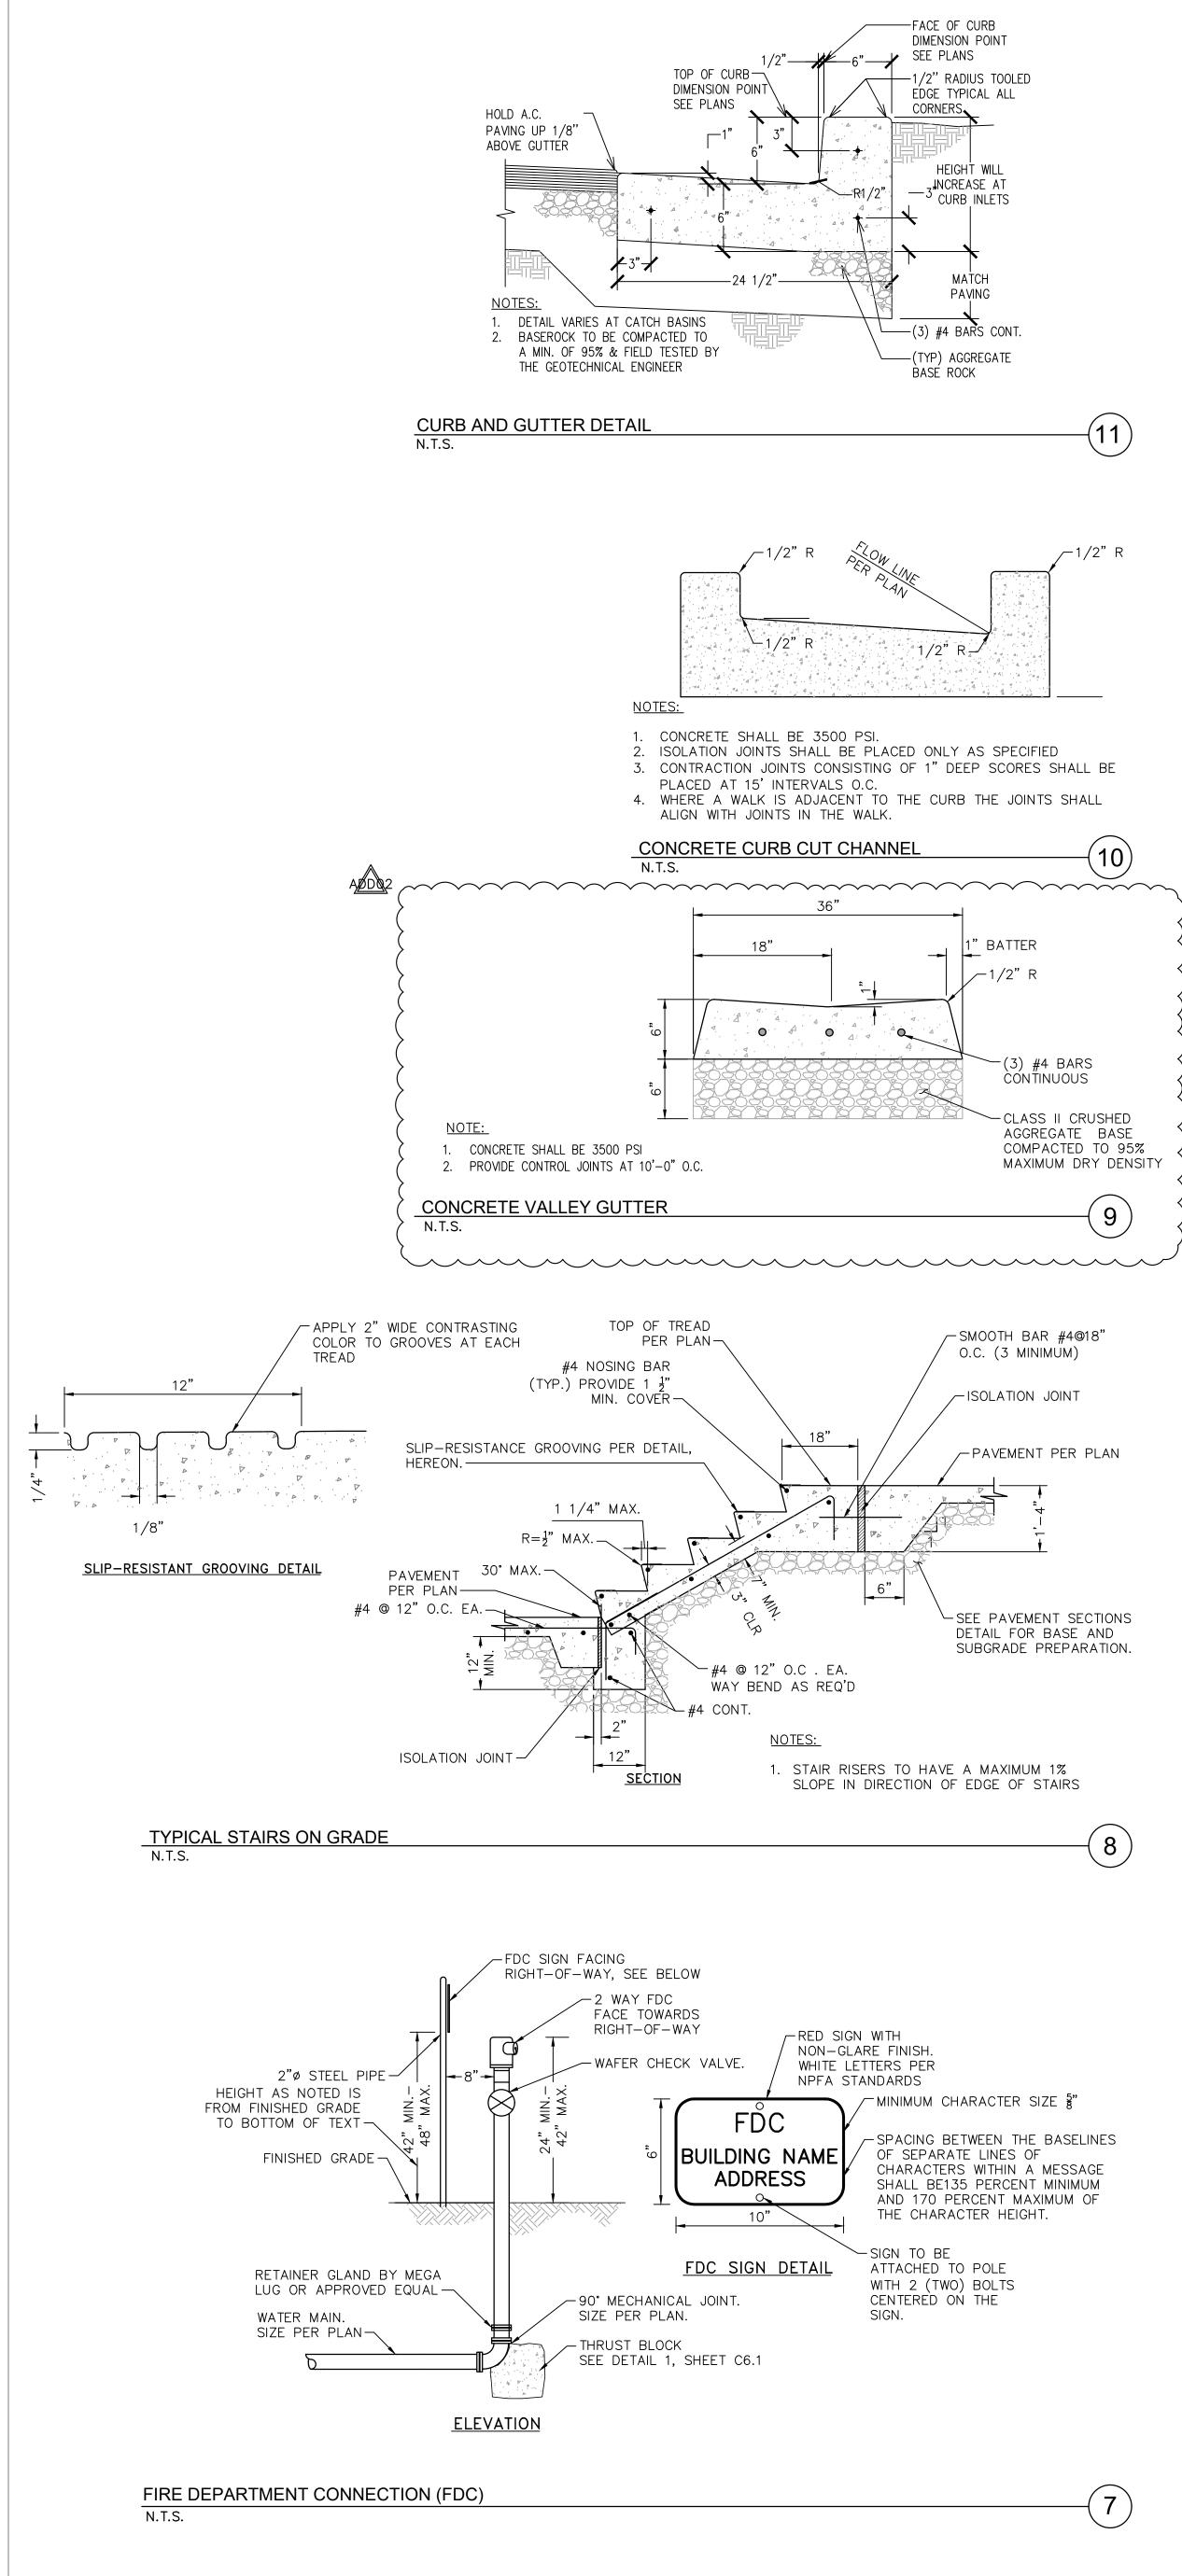


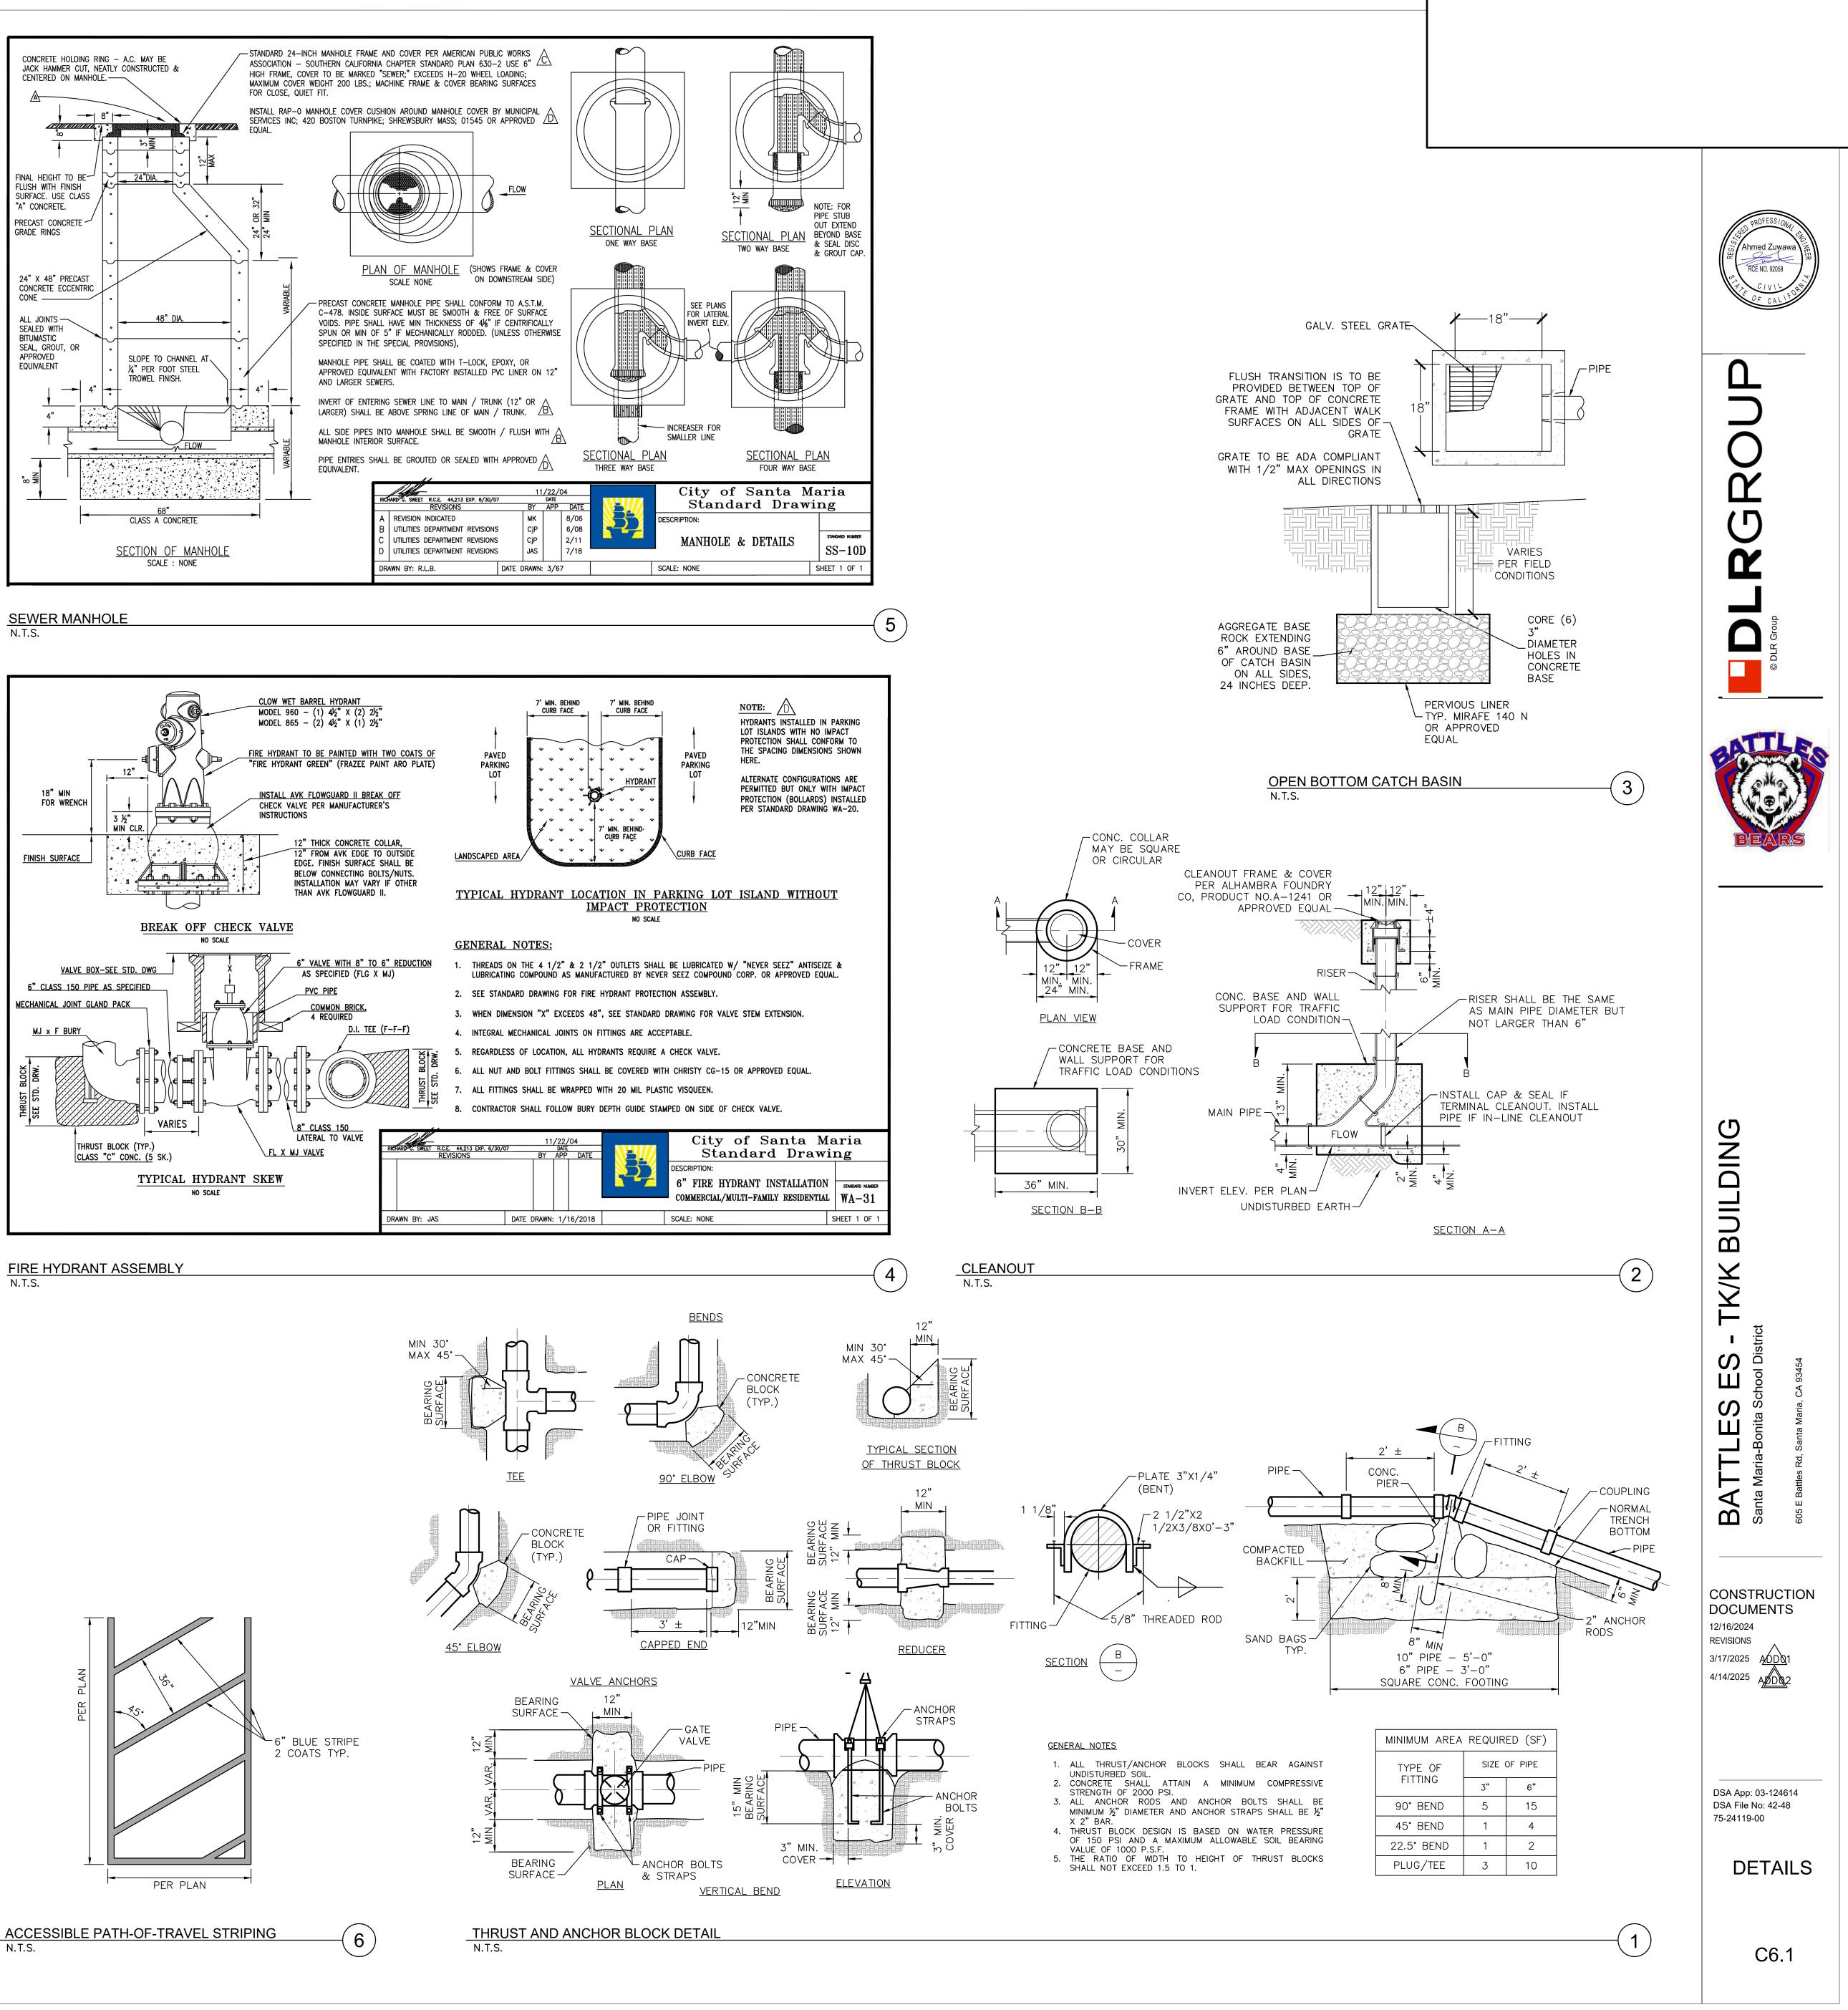


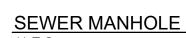


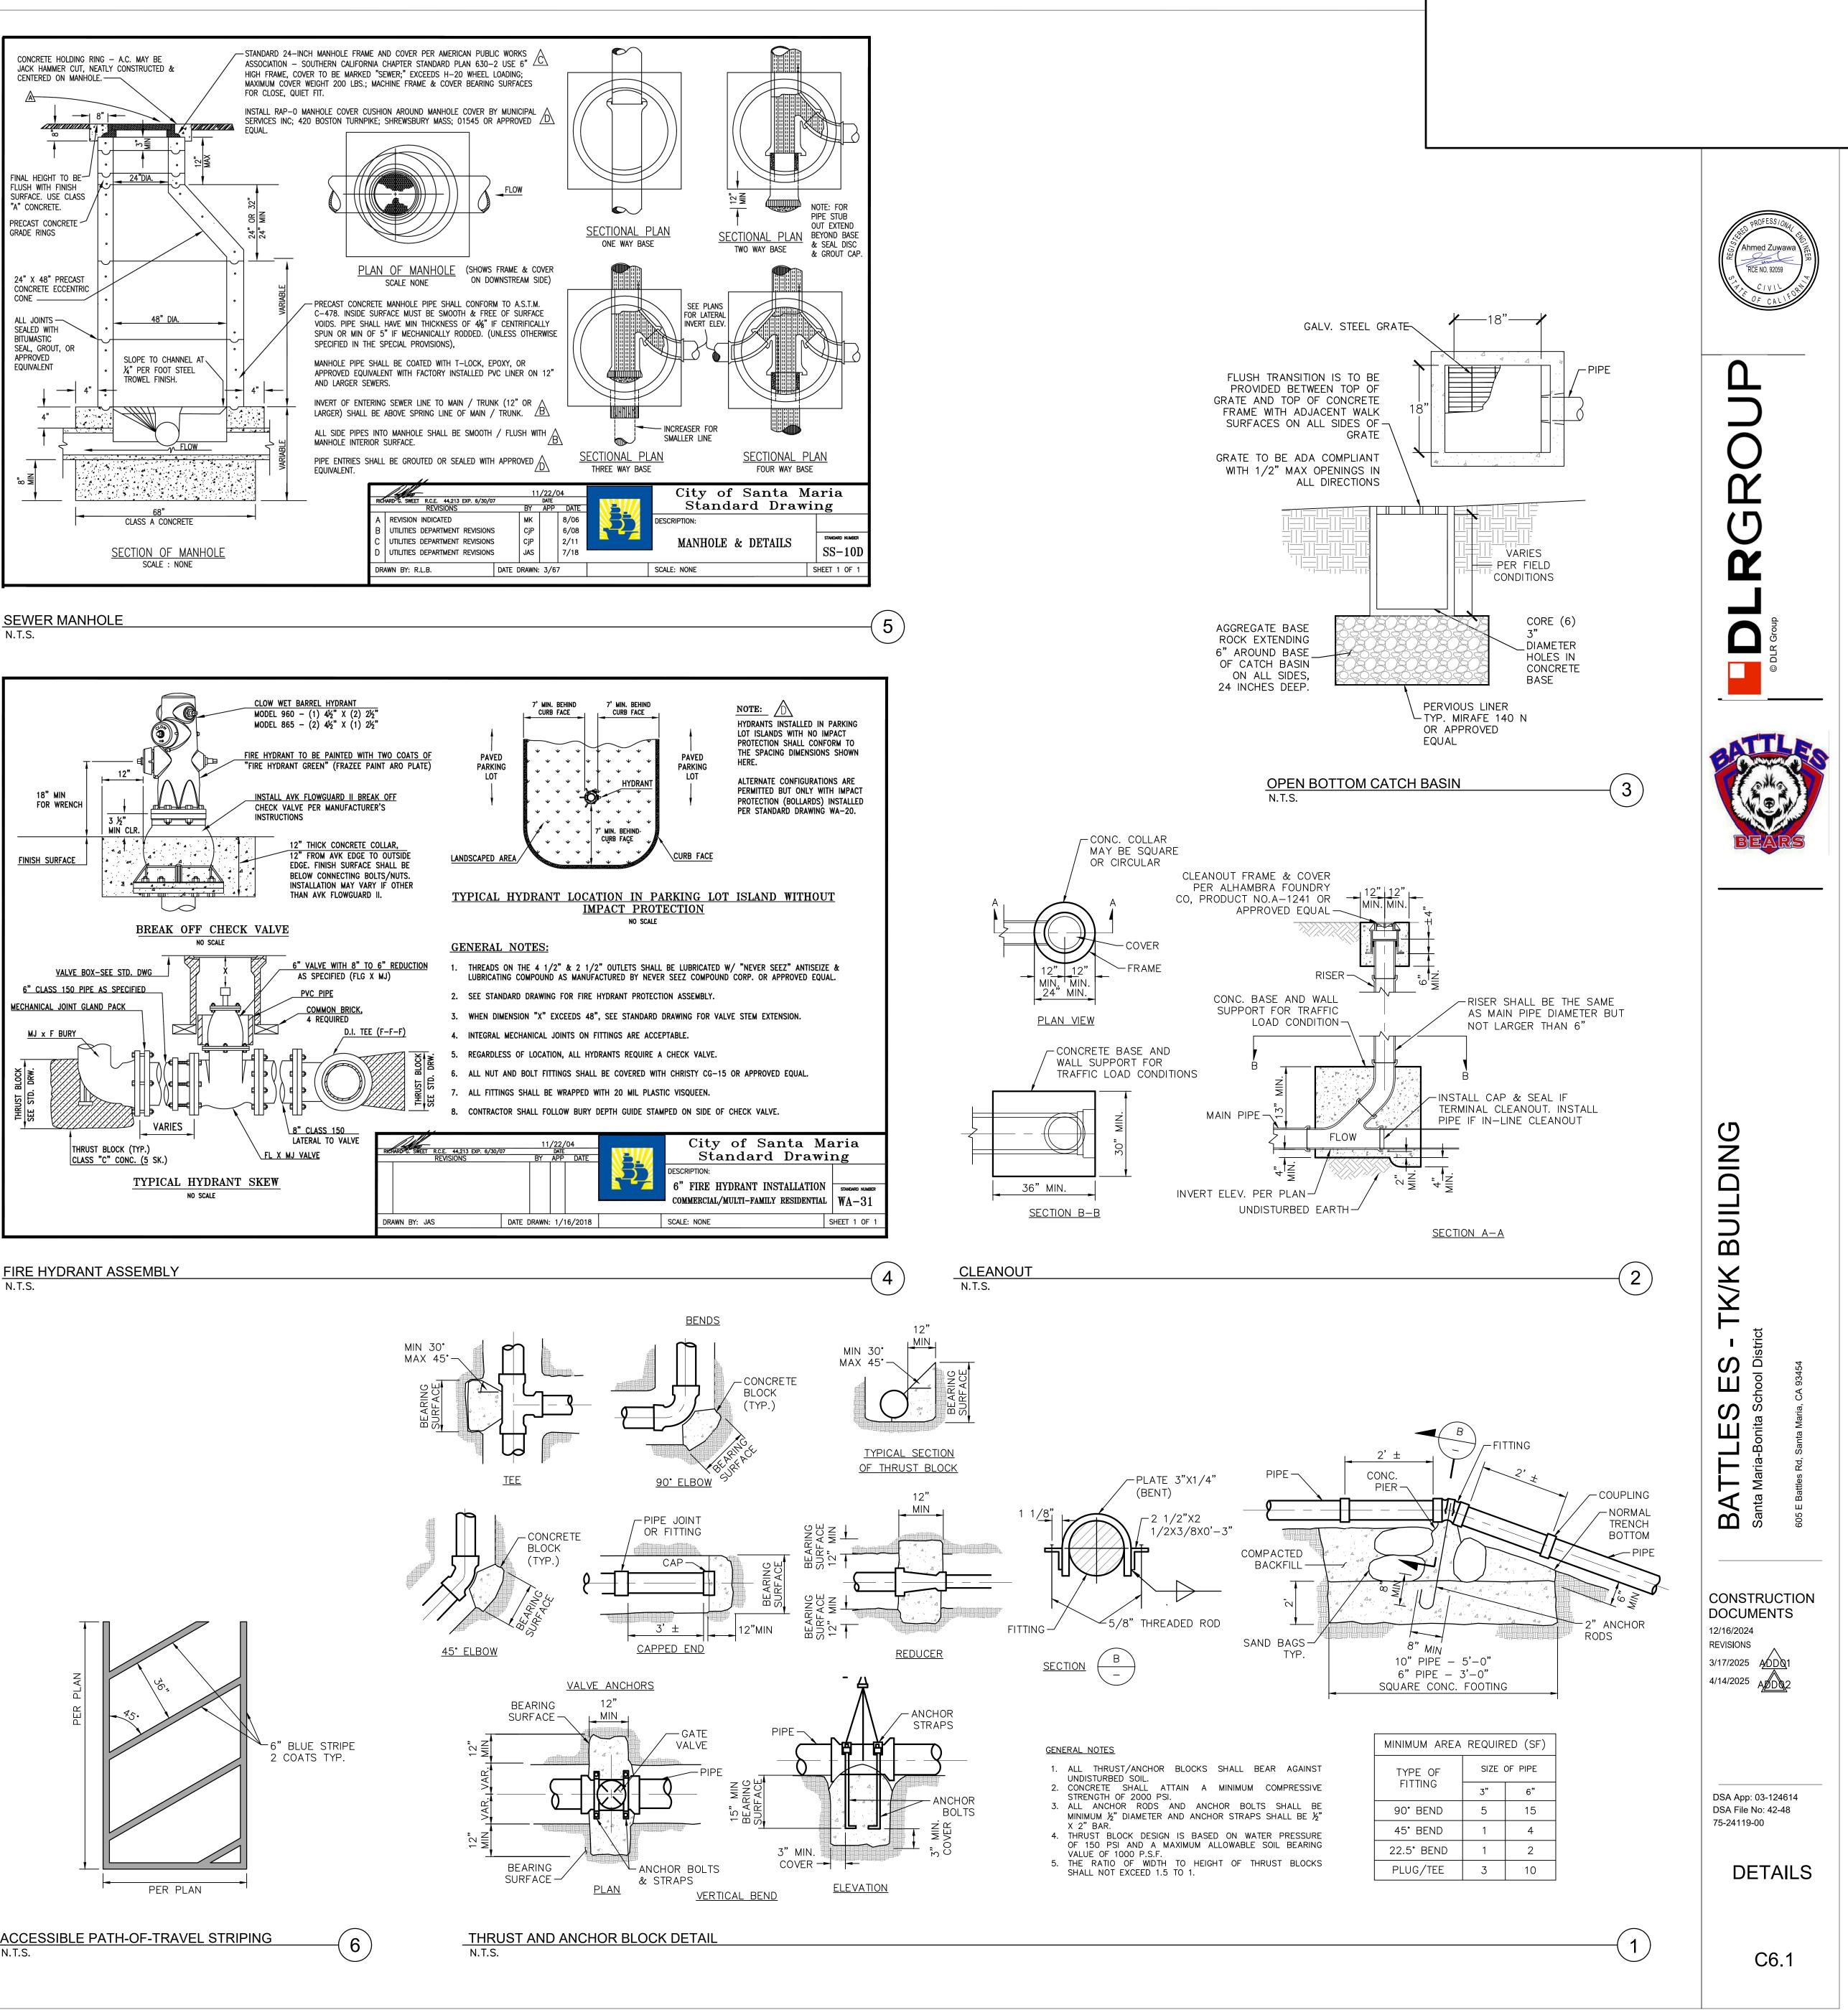


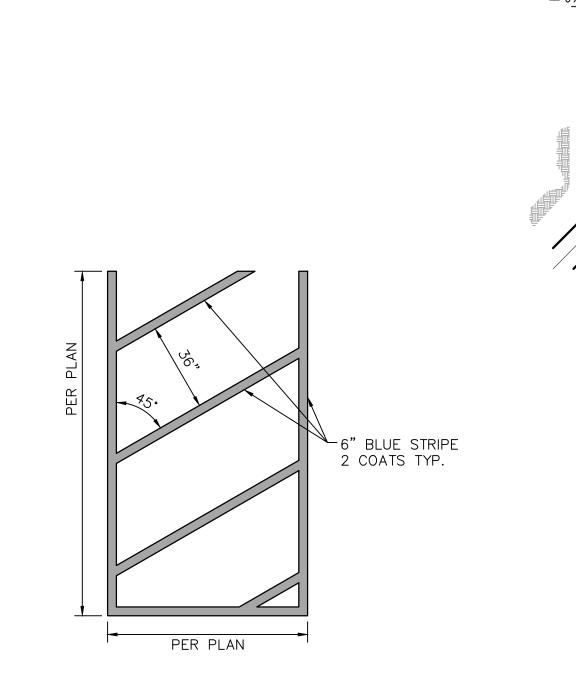

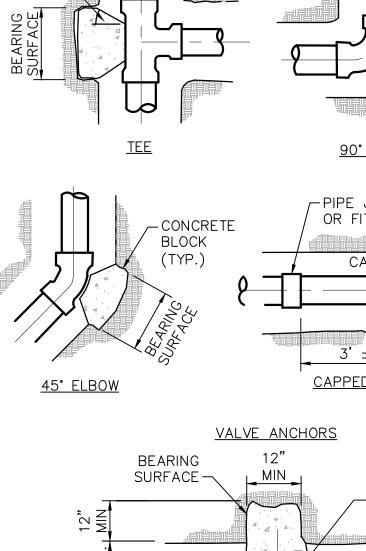

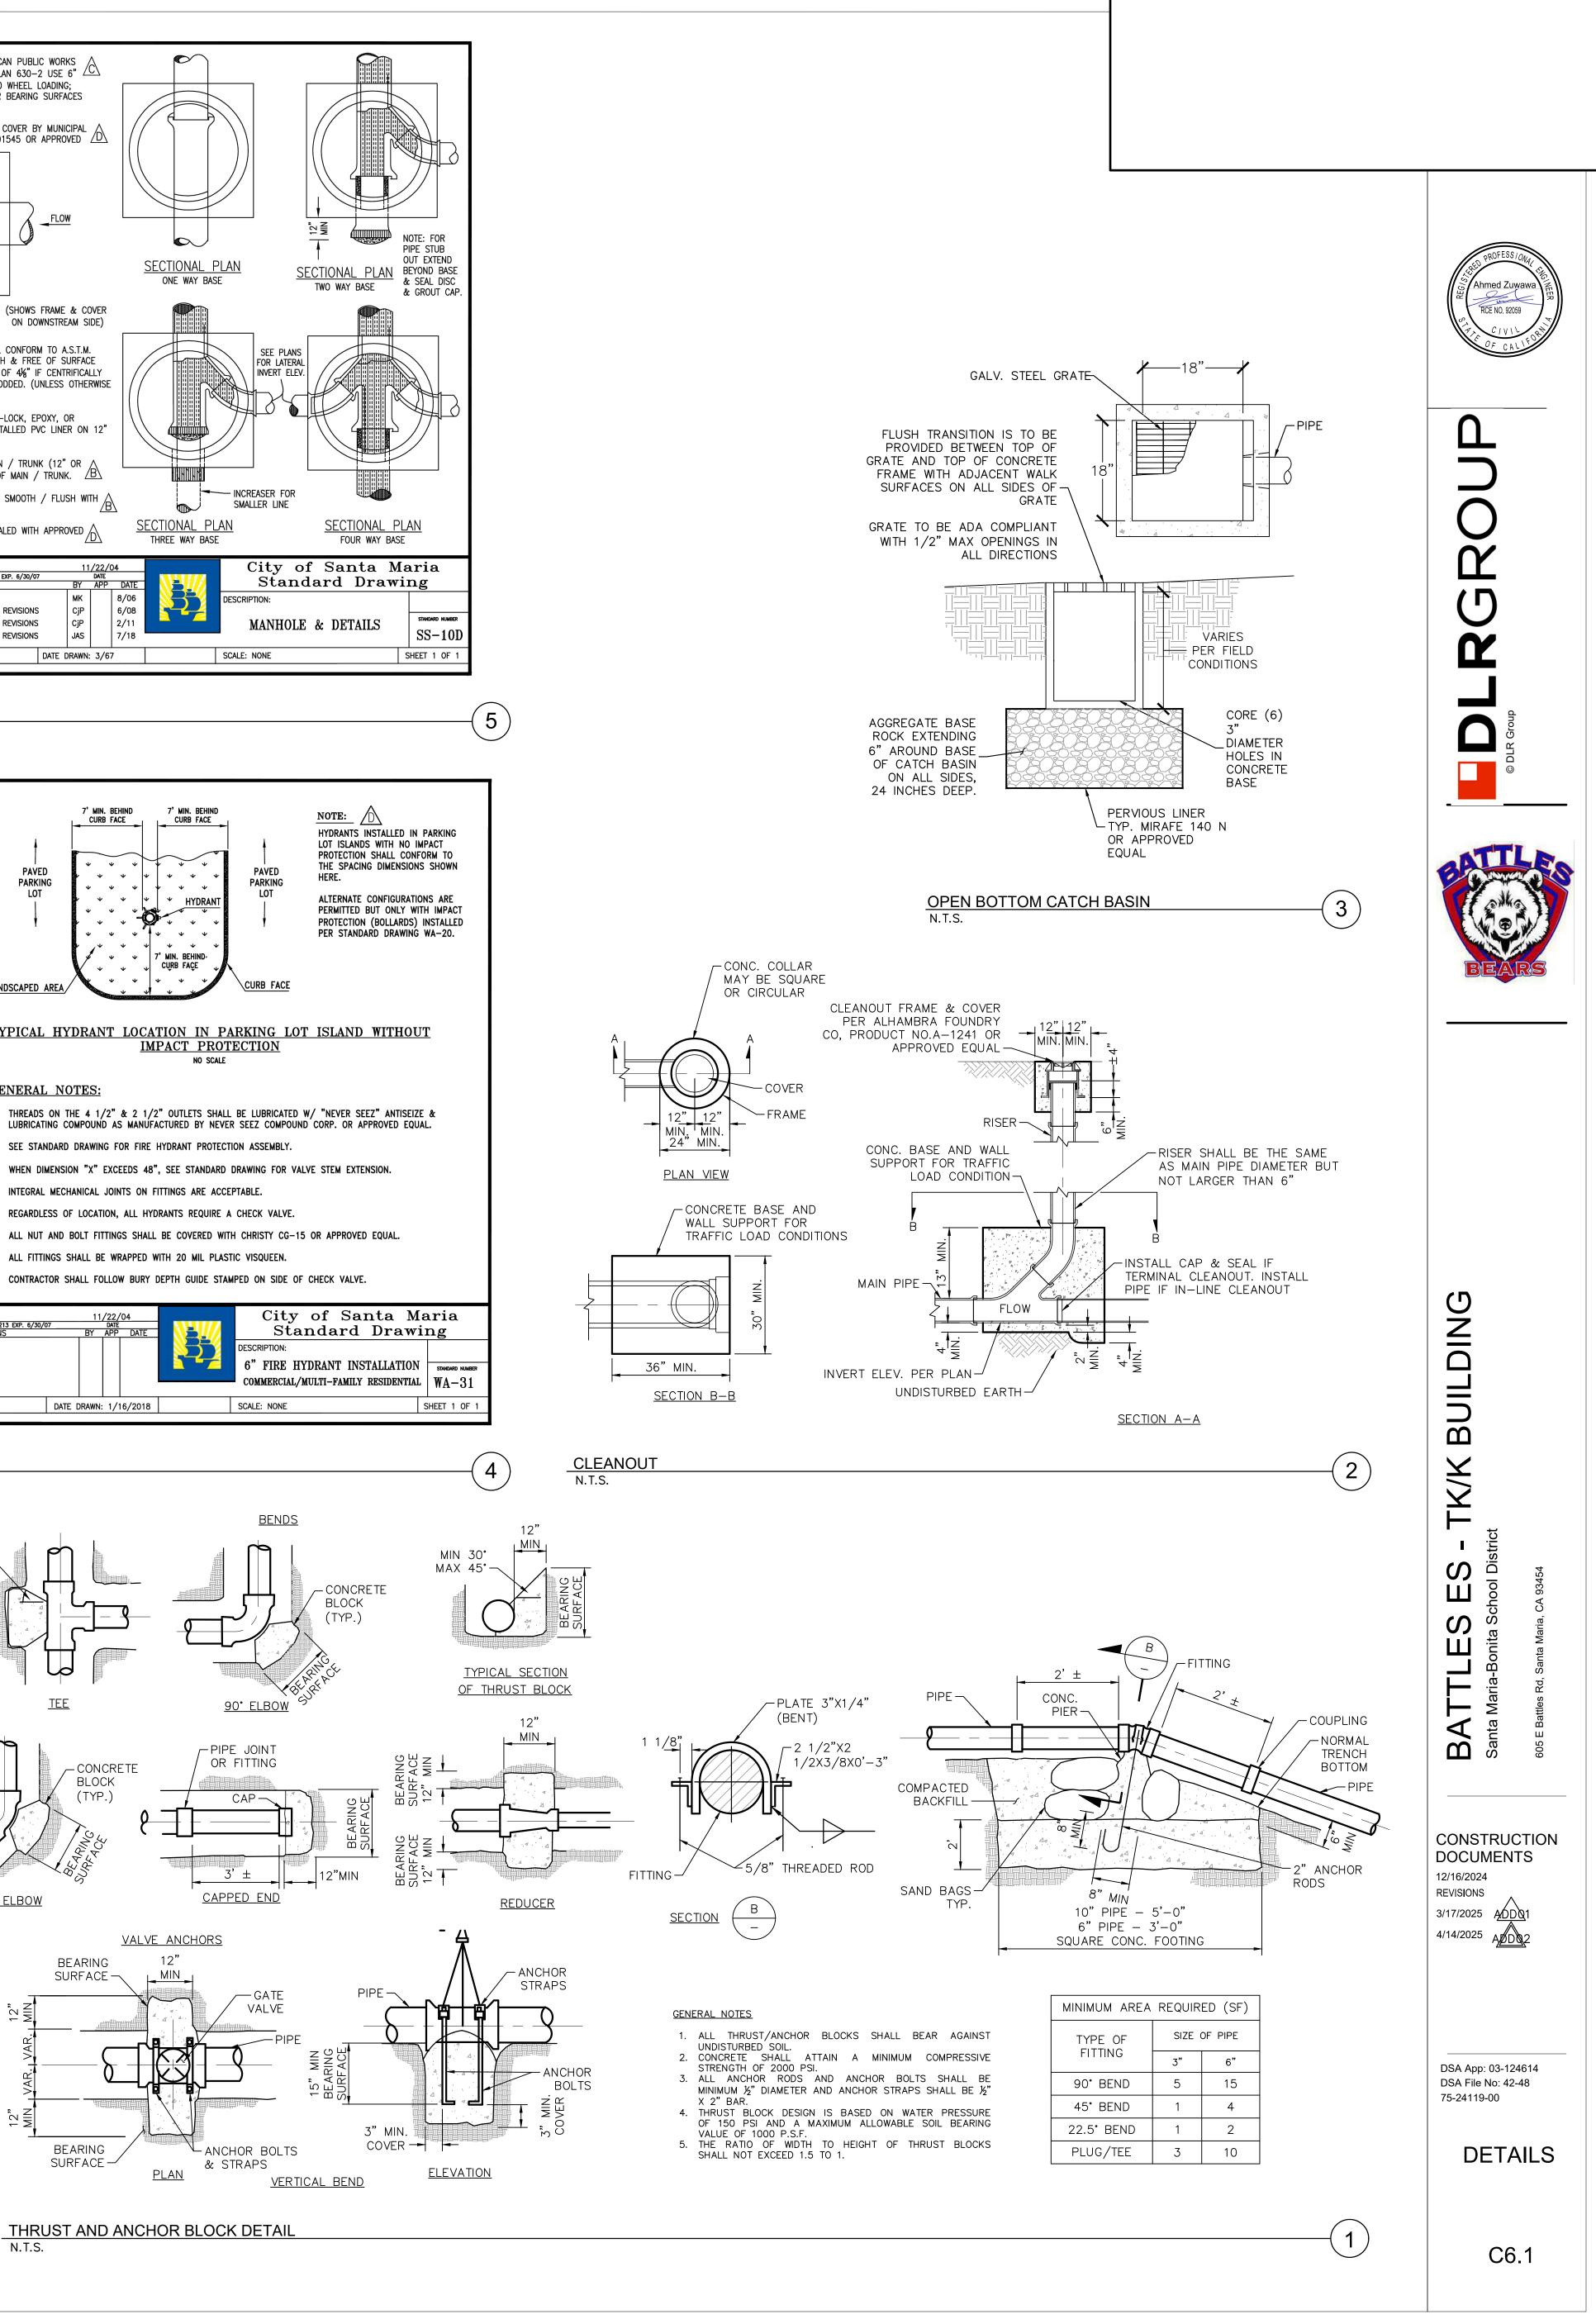

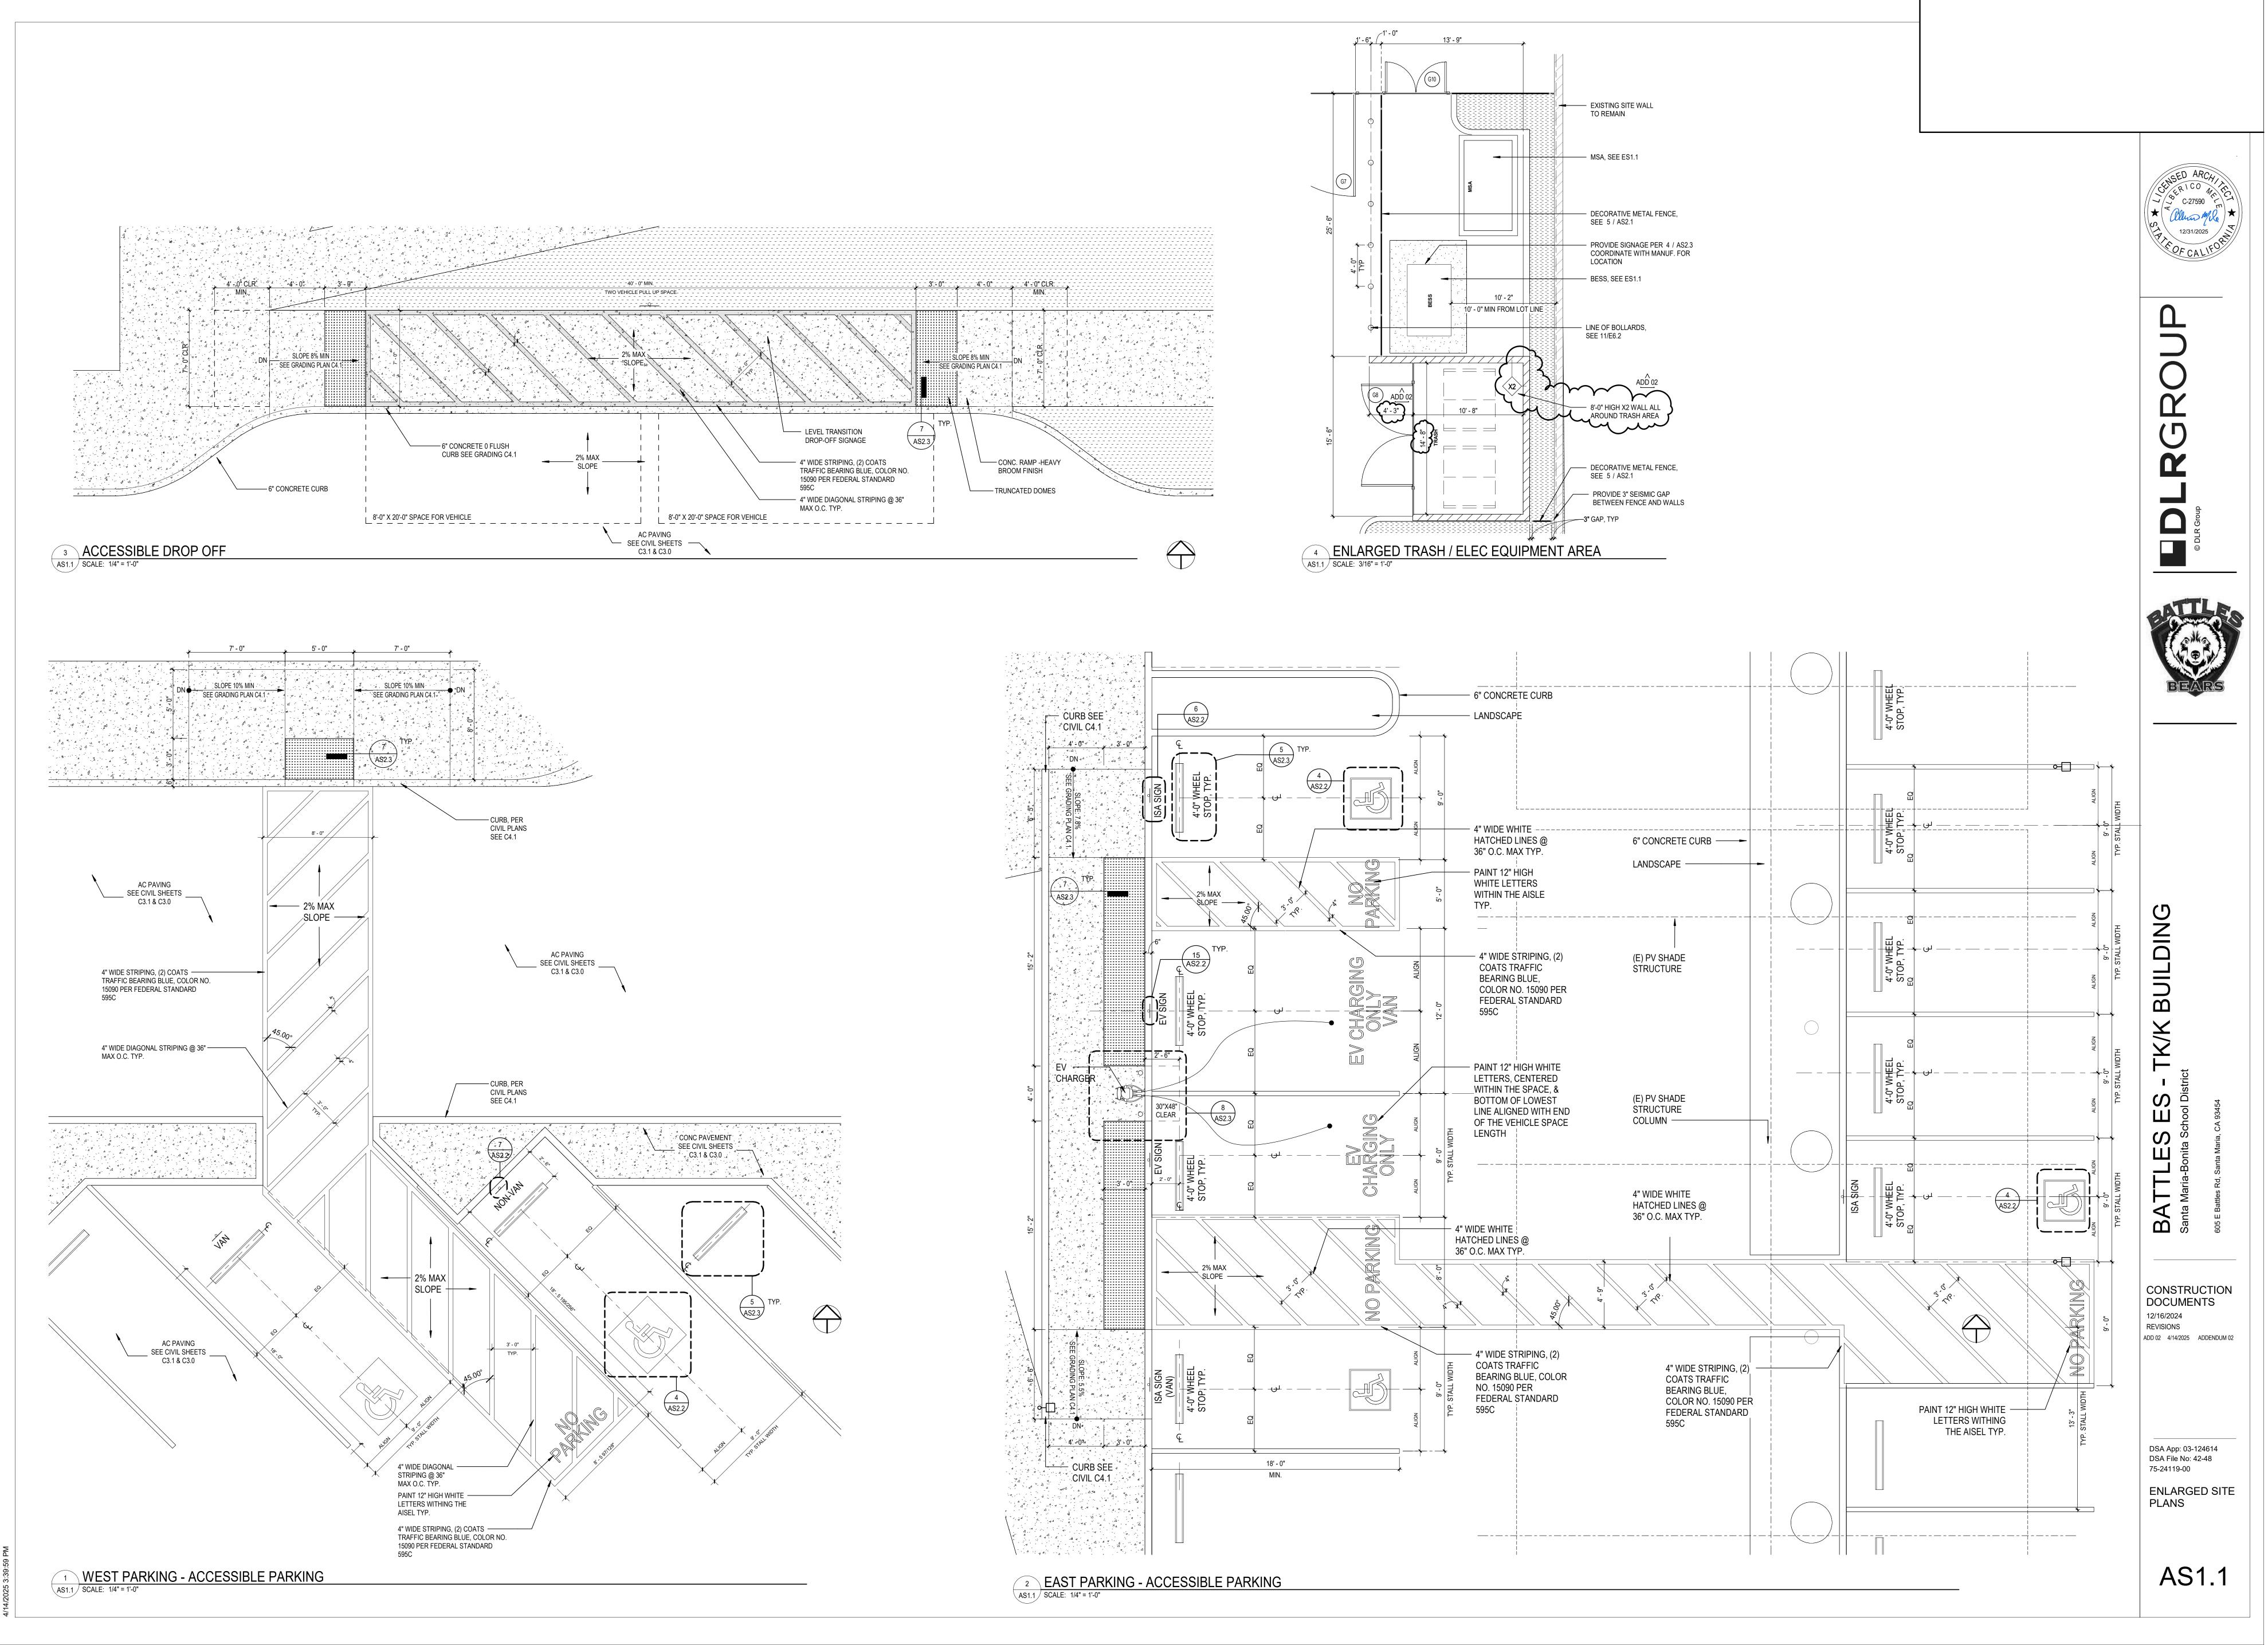

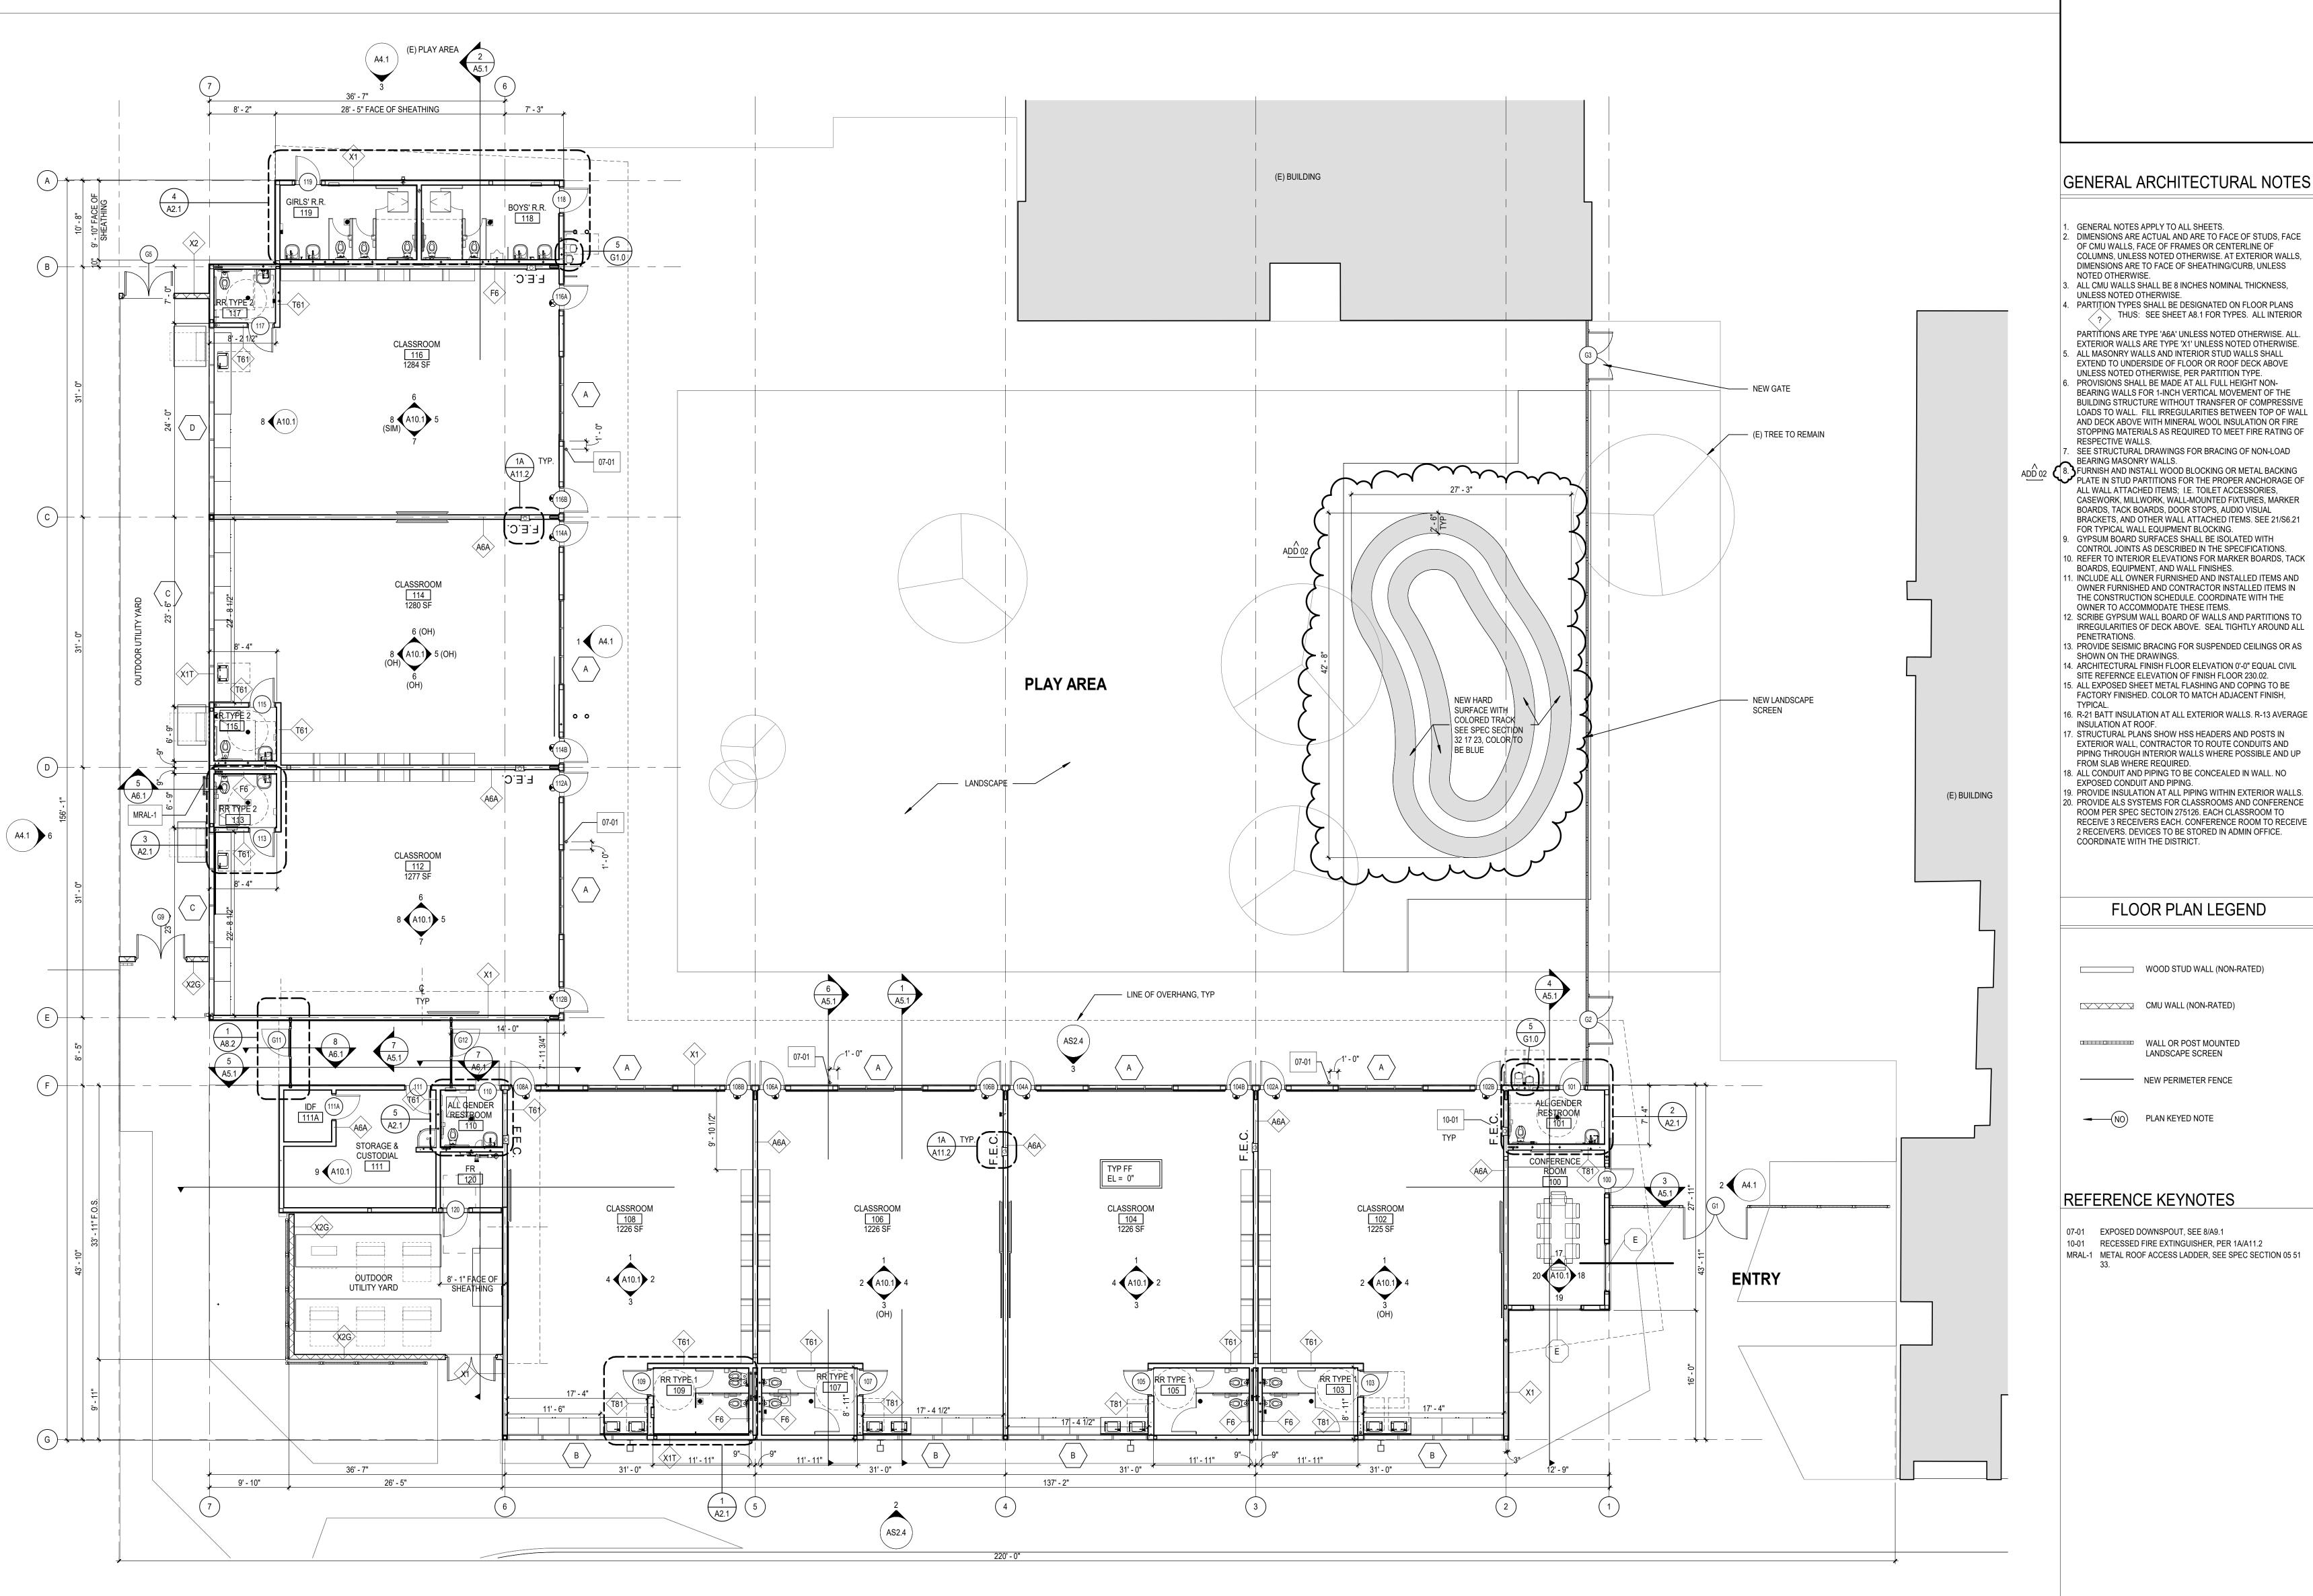

LEVEL 1 FLOOR PLAN SCALE: 1/8" = 1'-0"

GENERAL ARCHITECTURAL NOTES

DIMENSIONS ARE ACTUAL AND ARE TO FACE OF STUDS, FACE COLUMNS, UNLESS NOTED OTHERWISE. AT EXTERIOR WALLS, DIMENSIONS ARE TO FACE OF SHEATHING/CURB, UNLESS

4. PARTITION TYPES SHALL BE DESIGNATED ON FLOOR PLANS THUS: SEE SHEET A8.1 FOR TYPES. ALL INTERIOR

EXTERIOR WALLS ARE TYPE 'X1' UNLESS NOTED OTHERWISE. EXTEND TO UNDERSIDE OF FLOOR OR ROOF DECK ABOVE BEARING WALLS FOR 1-INCH VERTICAL MOVEMENT OF THE BUILDING STRUCTURE WITHOUT TRANSFER OF COMPRESSIVE LOADS TO WALL. FILL IRREGULARITIES BETWEEN TOP OF WALL

STOPPING MATERIALS AS REQUIRED TO MEET FIRE RATING OF 7. SEE STRUCTURAL DRAWINGS FOR BRACING OF NON-LOAD

CASEWORK, MILLWORK, WALL-MOUNTED FIXTURES, MARKER BRACKETS, AND OTHER WALL ATTACHED ITEMS. SEE 21/S6.21

10. REFER TO INTERIOR ELEVATIONS FOR MARKER BOARDS, TACK 11. INCLUDE ALL OWNER FURNISHED AND INSTALLED ITEMS AND OWNER FURNISHED AND CONTRACTOR INSTALLED ITEMS IN THE CONSTRUCTION SCHEDULE. COORDINATE WITH THE

12. SCRIBE GYPSUM WALL BOARD OF WALLS AND PARTITIONS TO IRREGULARITIES OF DECK ABOVE. SEAL TIGHTLY AROUND ALL

16. R-21 BATT INSULATION AT ALL EXTERIOR WALLS. R-13 AVERAGE EXTERIOR WALL, CONTRACTOR TO ROUTE CONDUITS AND PIPING THROUGH INTERIOR WALLS WHERE POSSIBLE AND UP


19. PROVIDE INSULATION AT ALL PIPING WITHIN EXTERIOR WALLS. 20. PROVIDE ALS SYSTEMS FOR CLASSROOMS AND CONFERENCE ROOM PER SPEC SECTOIN 275126. EACH CLASSROOM TO

FLOOR PLAN LEGEND







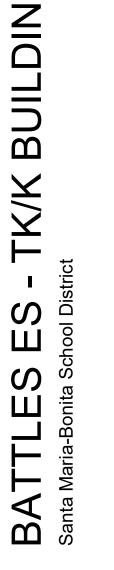



C

CONSTRUCTION DOCUMENTS 12/16/2024 REVISIONS ADD 02 4/14/2025 ADDENDUM 02

DSA App: 03-124614 DSA File No: 42-48 75-24119-00

FLOOR PLAN -LEVEL 1

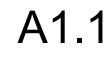

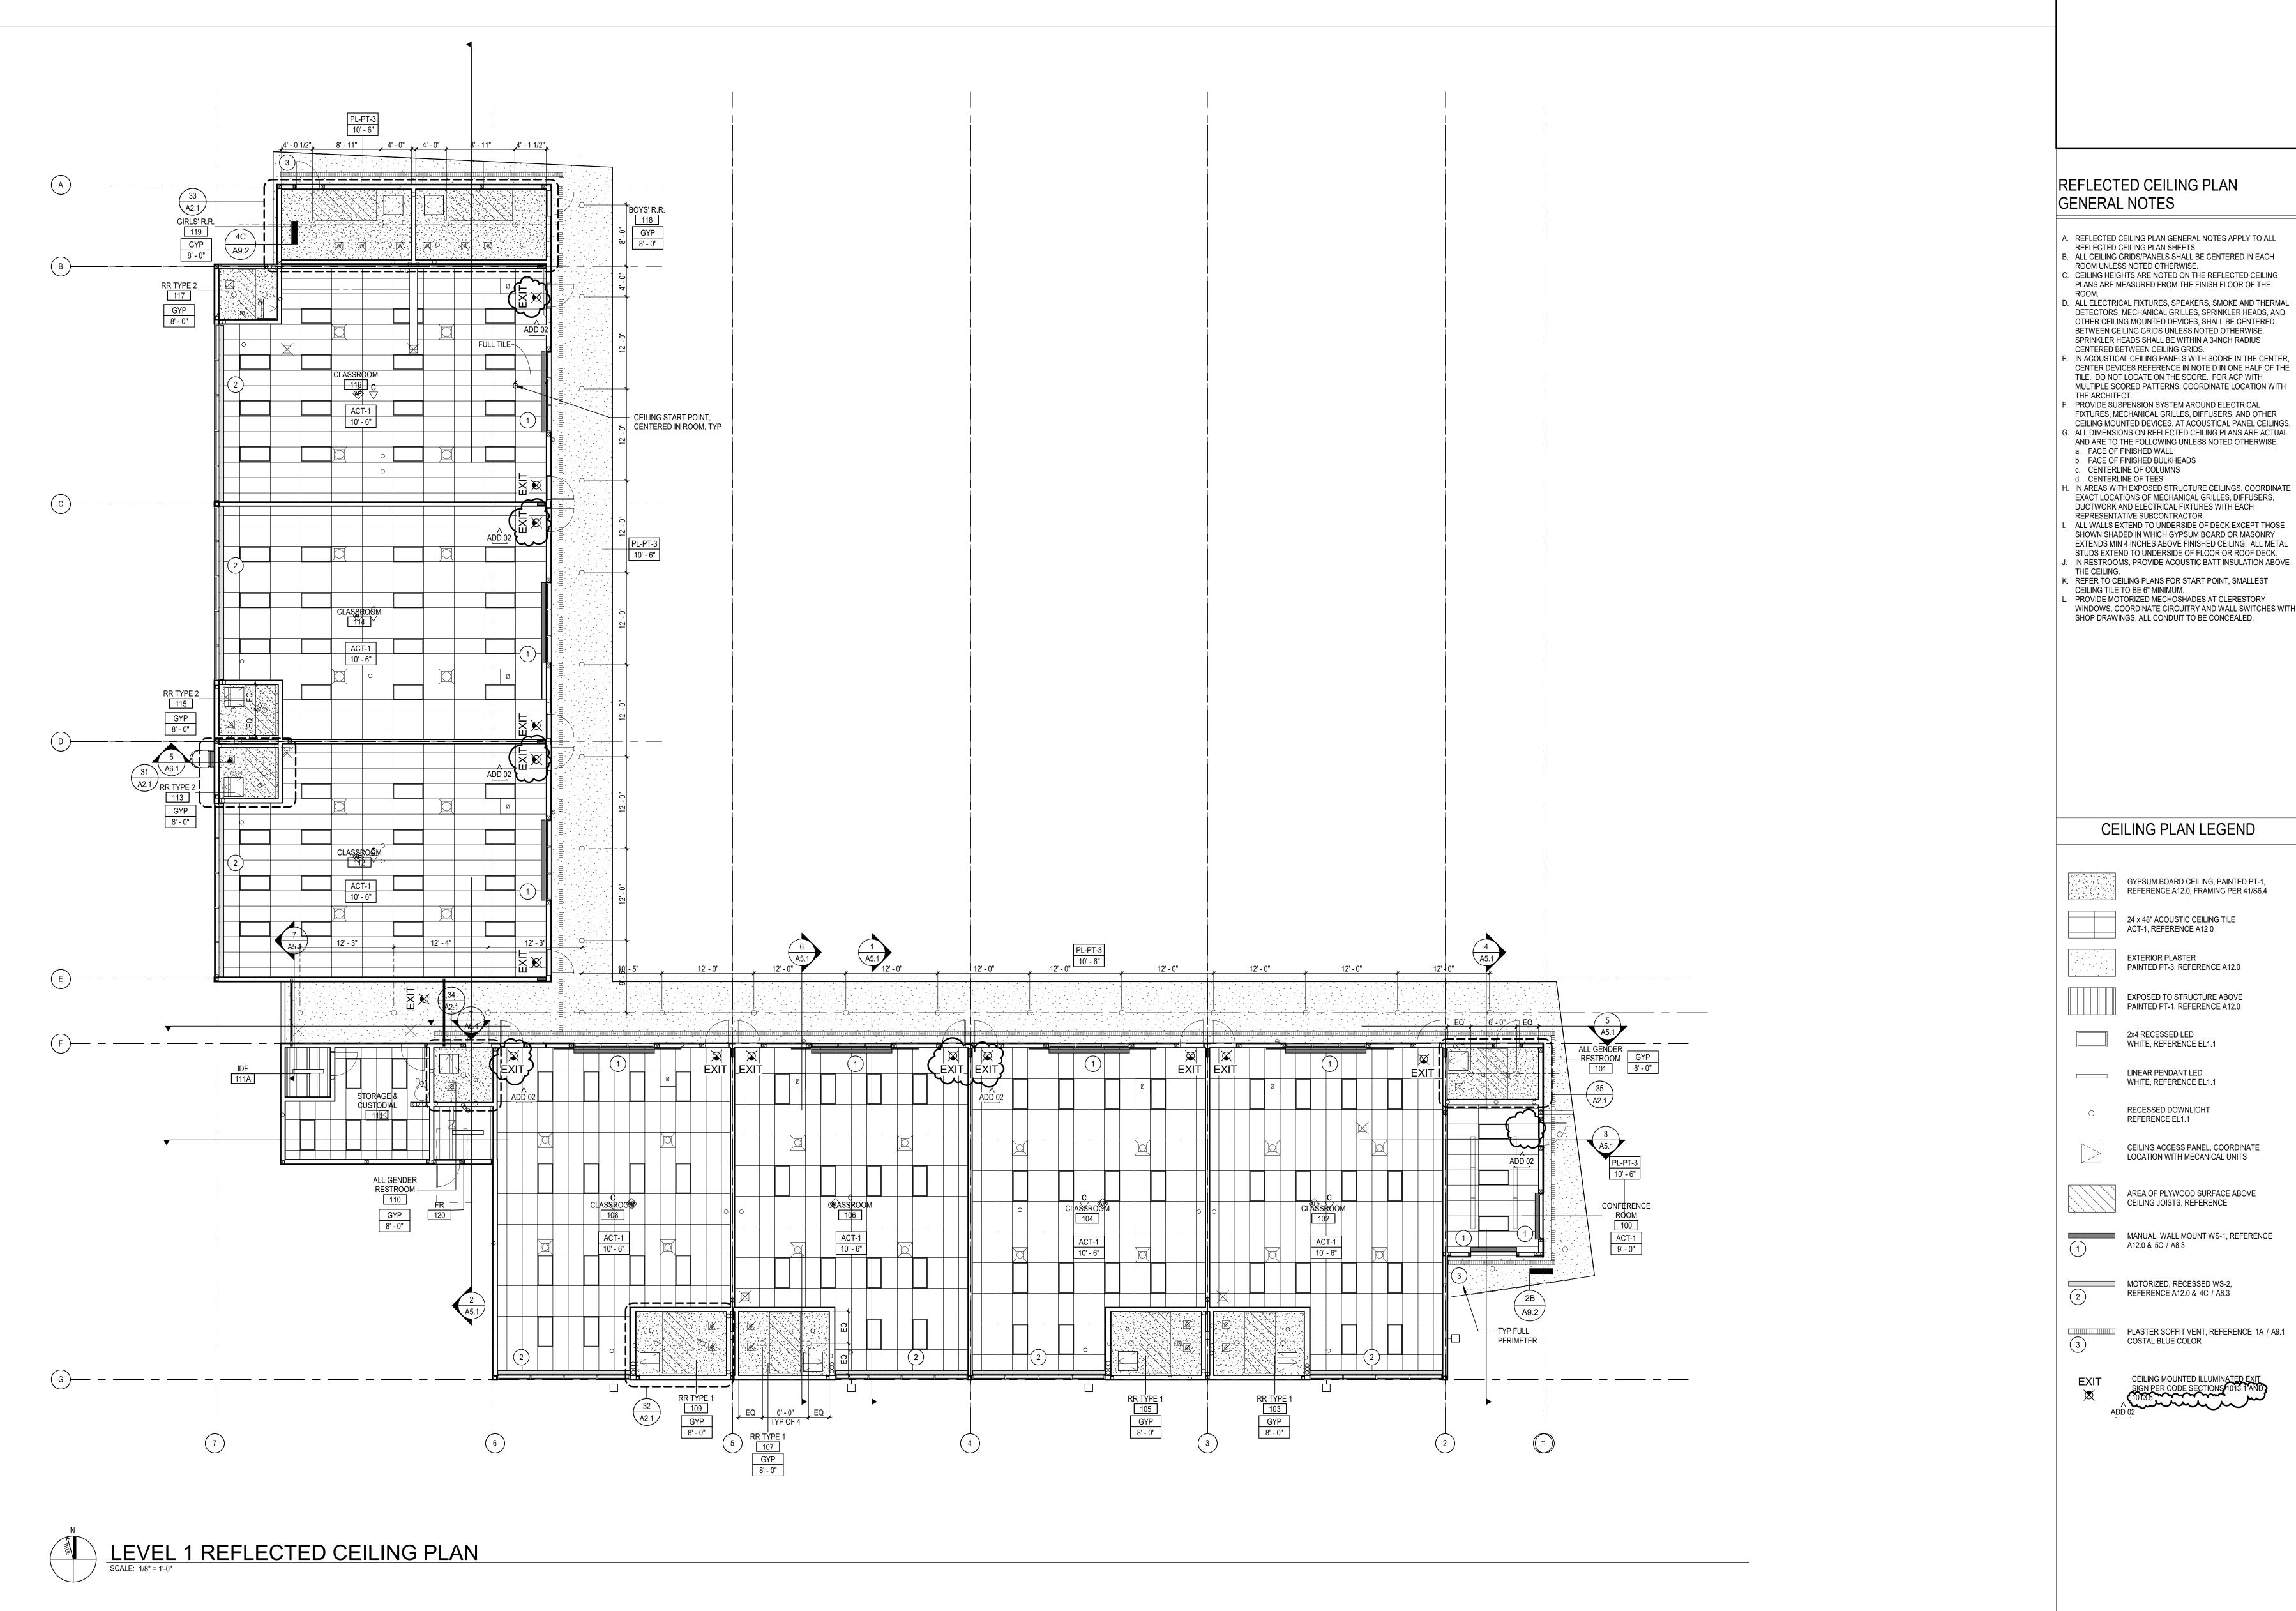

B. ALL CEILING GRIDS/PANELS SHALL BE CENTERED IN EACH C. CEILING HEIGHTS ARE NOTED ON THE REFLECTED CEILING

D. ALL ELECTRICAL FIXTURES, SPEAKERS, SMOKE AND THERMAL DETECTORS, MECHANICAL GRILLES, SPRINKLER HEADS, AND OTHER CEILING MOUNTED DEVICES, SHALL BE CENTERED

E. IN ACOUSTICAL CEILING PANELS WITH SCORE IN THE CENTER, CENTER DEVICES REFERENCE IN NOTE D IN ONE HALF OF THE TILE. DO NOT LOCATE ON THE SCORE. FOR ACP WITH MULTIPLE SCORED PATTERNS, COORDINATE LOCATION WITH

FIXTURES, MECHANICAL GRILLES, DIFFUSERS, AND OTHER CEILING MOUNTED DEVICES. AT ACOUSTICAL PANEL CEILINGS. G. ALL DIMENSIONS ON REFLECTED CEILING PLANS ARE ACTUAL AND ARE TO THE FOLLOWING UNLESS NOTED OTHERWISE:

EXACT LOCATIONS OF MECHANICAL GRILLES, DIFFUSERS,

SHOWN SHADED IN WHICH GYPSUM BOARD OR MASONRY EXTENDS MIN 4 INCHES ABOVE FINISHED CEILING. ALL METAL STUDS EXTEND TO UNDERSIDE OF FLOOR OR ROOF DECK. J. IN RESTROOMS, PROVIDE ACOUSTIC BATT INSULATION ABOVE

WINDOWS, COORDINATE CIRCUITRY AND WALL SWITCHES WITH







CEILING PLAN LEGEND

GYPSUM BOARD CEILING, PAINTED PT-1, REFERENCE A12.0, FRAMING PER 41/S6.4

- PAINTED PT-3, REFERENCE A12.0
- EXPOSED TO STRUCTURE ABOVE PAINTED PT-1, REFERENCE A12.0
- AREA OF PLYWOOD SURFACE ABOVE
- MANUAL, WALL MOUNT WS-1, REFERENCE



CONSTRUCTION DOCUMENTS 12/16/2024 REVISIONS ADD 02 4/14/2025 ADDENDUM 02

DSA App: 03-124614 DSA File No: 42-48 75-24119-00

REFLECTED CEILING PLAN -LEVEL 1

A3.1

	SUAL DISPLAY UNITS MATERIAL	MANUFACTURER	MODEL	FINISH OR COLO
WP-1	TACKABLE FABRIC WRAPPED ACOUSTIC PANEL (GREY)		CUSTOM FABRIC WRAPPED ACOUSTECH HIGH IMPACT TACKABLE ACOUSTIC PANEL 7/8" THICK.	
WP-2		AVL SYSTEMS	CUSTOM FABRIC WRAPPED ACOUSTECH HIGH IMPACT TACKABLE ACOUSTIC PANEL 7/8"	FABRIC: MAHARAM, MERIT, 466444-014 RIPPLE
NP-3	BLUE) TACKABLE FABRIC WRAPPED ACOUSTIC PANEL (BLUE)	AVL SYSTEMS	THICK. CUSTOM FABRIC WRAPPED ACOUSTECH HIGH IMPACT TACKABLE ACOUSTIC PANEL 7/8"	FABRIC: MAHARAM, MERIT, 466444-011 POOLSIDE
NP-4	TACKABLE FABRIC WRAPPED ACOUSTIC PANEL	AVL SYSTEMS	THICK. CUSTOM FABRIC WRAPPED ACOUSTECH HIGH IMPACT TACKABLE ACOUSTIC PANEL 7/8"	FABRIC: MAHARAM, MODE, 466337-015 GOLDENROI
5 20 00 - FII	(YELLOW)		THICK.	
TAG	MATERIAL	MANUFACTURER	MODEL	FINISH OR COLO
PH-1	UPHOSTERLY FABRIC (BLUE)	MAHARAM FABRICS	MERIT	466444-011 POOLSIDE
68 13 - TI	LE CARPETING			
TAG	MATERIAL	MANUFACTURER	MODEL	FINISH OR COLO
/M-1	WALK-OFF MAT	MOHAWK GROUP	FIRST STEP II	955 COBALT
PT-1	CARPET FLOORING	MOHAWK GROUP	SIDE STRIPE GT419	965 WESTPOINT
35 11 - CO	DNCRETE FLOOR FINISHES			
TAG	MATERIAL	MANUFACTURER	MODEL	FINISH OR COLC
C-1	SEALED CONCRETE	ASHFORD FORMULA		
) 26 00 - W	ALL AND DOOR PROTECTION			
TAG	MATERIAL	MANUFACTURER		MODEL
GD-1	CORNER GUARD	FRY RECGLET	DRYWALL CORNER TRIM DMCT-375	1001 GLOBAL WHITE
5 41 00 - AF	ACHITECTURAL WOOD CASEWORK	MANUFACTURER	MODEL	FINISH OR COLC
L-1	PLASTIC LAMINATE (WOOD)	ABET LAMINATI	ABET COLLECTION LAMINATES	639 GRAINWOOD
L-2	PLASTIC LAMINATE (ACCENT)	ABET LAMINATI	ABET COLLECTION LAMINATES	853 BLEU SPAZIO
	CABINET PULL	MOCKETT	#DP130A, 6 25/32" - SATIN STAINLESS STEEL	
IW-02	DRAWER GLIDES-	HAFELE	FULL EXTENSION HEAVY DUTY SIDE MOUNT DRAWER SLIDES HAFELE-3832-22, ZINC	
W-04	CONCEALED HINGES-	HAFELE	165 DEGREE CONCEALED HINGE	
W-05	SHELF SUPPORTS	HAFELE	1/4" DIA., ANGLE 282.11.761, NICKEL PLATED. PROVIDE (4) MIN. PER SHELF	
W-06	CABINET LOCK SUAL DISPLAY UNITS	HAFELE	CAM LOCKS, NATIONAL LOCK C8053-14A	
TAG	MATERIAL	MANUFACTURER	MODEL	FINISH OR COLC
B-1	MARKERBOARD	EGAN	ALUMINUM FRAME WHITEBOARD	PORCELAIN WHITE
0 11 46 - PF	ESENTATION DRY ERASE WALLCOVERING			
TAG	MATERIAL	MANUFACTURER	MODEL	FINISH OR COLC
IB-2	MAGNETIC MARKERBOARD WALLCOVERING	KOROSEAL	WALLTALKERS W/ MAGNETIC TRAY	MAG-RITE 48 WHITE M248-00
9 30 00 - TII	ING			
TAG	MATERIAL	MANUFACTURER	MODEL	FINISH OR COLC
ITB-1	METAL BASE, COVE	SCHLUTER	DILEX- AHK 1S125 AT	SATIN ANODIZED
ITB-2 R-1	METAL BASE, CORNER COVE	SCHLUTER	DILEX- AHK 1S125 AT, IN CORNER 90-DEGREE QUADEC ALUMINUM EDGE STRIP	SATIN ANODIZED SATIN ANODIZED
R-2	EDGE TRIM	SCHLUTER	AE250 STRAIGHT ANCHORING LEG SCHIENE STRAIGHT	SATIN ANODIZED
B-1	TILE - BASE	TILE BAR	PEZZI SPECIALI - I COLORI	MARINA & GALASSIA
W-1	TILE - WALL (ACCENT)	TILE BAR - CE SI	I COLORI	MARINA & GALASSIA
W-2 F-1	TILE - WALL (WHITE) TILE - FLOOR	TILE BAR - CE SI TILE BAR	I COLORI FORDHAM	TALCO GRIGIO MATTE PORCELAIN
	ENGINEERED STONE THRESHOLD	TILE BAR	ENGINEERED STONE SADDLE	WHITE POLISHED
9 51 00 - AC	COUSTICAL CEILINGS			
TAG	MATERIAL	MANUFACTURER	MODEL	FINISH OR COLC
CT-1	ACOUSTIC CEILING TILE & GRID	ARMSTRONG	GRID: SUPRAFINE XL 9/16" EXPOSED TEE, TILE: PUEBLO TEGULAR LAY-IN 9/16"	WHITE
9 91 23 - IN	TERIOR PAINTING	I		
TAG	MATERIAL		MODEL	
TAG T-1		MANUFACTURER SHERWIN-WILLIAMS SHERWIN-WILLIAMS	MODEL	FINISH OR COLC SW7004 SNOWBOUND SW6793 BLUEBELL
TAG T-1 T-2	MATERIAL FIELD PAINT	SHERWIN-WILLIAMS	MODEL	SW7004 SNOWBOUND
TAG T-1 T-2 T-3 T-4	MATERIAL FIELD PAINT ACCENT PAINT (ACCENT BLUE) ACCENT PAINT (LIGHT BLUE) ACCENT PAINT (MEDIUM BLUE)	SHERWIN-WILLIAMS SHERWIN-WILLIAMS SHERWIN-WILLIAMS SHERWIN-WILLIAMS	MODEL	SW7004 SNOWBOUND SW6793 BLUEBELL SW6778 AVIARY BLUE SW6500 OPEN SEAS
TAG T-1 T-2 T-3 T-4 T-5	MATERIAL FIELD PAINT ACCENT PAINT (ACCENT BLUE) ACCENT PAINT (LIGHT BLUE) ACCENT PAINT (MEDIUM BLUE) ACCENT PAINT (DARK BLUE)	SHERWIN-WILLIAMS SHERWIN-WILLIAMS SHERWIN-WILLIAMS SHERWIN-WILLIAMS SHERWIN-WILLIAMS	MODEL	SW7004 SNOWBOUND SW6793 BLUEBELL SW6778 AVIARY BLUE SW6500 OPEN SEAS SW7602 INDIGO BATIK
TAG T-1 T-2 T-3 T-4 T-5 T-6	MATERIAL FIELD PAINT ACCENT PAINT (ACCENT BLUE) ACCENT PAINT (LIGHT BLUE) ACCENT PAINT (MEDIUM BLUE) ACCENT PAINT (DARK BLUE) ACCENT PAINT (GREY)	SHERWIN-WILLIAMS SHERWIN-WILLIAMS SHERWIN-WILLIAMS SHERWIN-WILLIAMS	MODEL	SW7004 SNOWBOUND SW6793 BLUEBELL SW6778 AVIARY BLUE SW6500 OPEN SEAS
TAG T-1 T-2 T-3 T-4 T-5 T-6	MATERIAL FIELD PAINT ACCENT PAINT (ACCENT BLUE) ACCENT PAINT (LIGHT BLUE) ACCENT PAINT (MEDIUM BLUE) ACCENT PAINT (DARK BLUE)	SHERWIN-WILLIAMS SHERWIN-WILLIAMS SHERWIN-WILLIAMS SHERWIN-WILLIAMS SHERWIN-WILLIAMS	MODEL	SW7004 SNOWBOUND SW6793 BLUEBELL SW6778 AVIARY BLUE SW6500 OPEN SEAS SW7602 INDIGO BATIK SW7057 SILVER STRAND
TAG T-1 T-2 T-3 T-4 T-5 T-6 2 36 00 - C(TAG	MATERIAL FIELD PAINT ACCENT PAINT (ACCENT BLUE) ACCENT PAINT (LIGHT BLUE) ACCENT PAINT (MEDIUM BLUE) ACCENT PAINT (DARK BLUE) ACCENT PAINT (GREY) DUNTERTOPS	SHERWIN-WILLIAMS SHERWIN-WILLIAMS SHERWIN-WILLIAMS SHERWIN-WILLIAMS SHERWIN-WILLIAMS		SW7004 SNOWBOUND SW6793 BLUEBELL SW6778 AVIARY BLUE SW6500 OPEN SEAS SW7602 INDIGO BATIK SW7057 SILVER STRAND
TAG T-1 T-2 T-3 T-4 T-5 T-6 2 36 00 - C(TAG SM-1	MATERIAL FIELD PAINT ACCENT PAINT (ACCENT BLUE) ACCENT PAINT (LIGHT BLUE) ACCENT PAINT (MEDIUM BLUE) ACCENT PAINT (MEDIUM BLUE) ACCENT PAINT (DARK BLUE) ACCENT PAINT (GREY) OUNTERTOPS MATERIAL QUARTZ SOLID SURFACE	SHERWIN-WILLIAMS SHERWIN-WILLIAMS SHERWIN-WILLIAMS SHERWIN-WILLIAMS SHERWIN-WILLIAMS SHERWIN-WILLIAMS MANUFACTURER	MODEL	SW7004 SNOWBOUND SW6793 BLUEBELL SW6778 AVIARY BLUE SW6500 OPEN SEAS SW7602 INDIGO BATIK SW7057 SILVER STRAND FINISH OR COLC
TAG T-1 T-2 T-3 T-4 T-5 T-6 2 36 00 - C(TAG SM-1	MATERIAL FIELD PAINT ACCENT PAINT (ACCENT BLUE) ACCENT PAINT (LIGHT BLUE) ACCENT PAINT (MEDIUM BLUE) ACCENT PAINT (DARK BLUE) ACCENT PAINT (GREY) DUNTERTOPS MATERIAL	SHERWIN-WILLIAMS SHERWIN-WILLIAMS SHERWIN-WILLIAMS SHERWIN-WILLIAMS SHERWIN-WILLIAMS SHERWIN-WILLIAMS MANUFACTURER	MODEL	SW7004 SNOWBOUND SW6793 BLUEBELL SW6778 AVIARY BLUE SW6500 OPEN SEAS SW7602 INDIGO BATIK SW7057 SILVER STRAND FINISH OR COLO LUNA SAND
TAG T-1 T-2 T-3 T-4 T-5 T-6 2 36 00 - C(TAG SM-1 9 65 00 - RE TAG	MATERIAL FIELD PAINT ACCENT PAINT (ACCENT BLUE) ACCENT PAINT (LIGHT BLUE) ACCENT PAINT (MEDIUM BLUE) ACCENT PAINT (MEDIUM BLUE) ACCENT PAINT (DARK BLUE) ACCENT PAINT (GREY) OUNTERTOPS MATERIAL QUARTZ SOLID SURFACE SILIENT FLOORING	SHERWIN-WILLIAMS SHERWIN-WILLIAMS SHERWIN-WILLIAMS SHERWIN-WILLIAMS SHERWIN-WILLIAMS MANUFACTURER FORMICA	MODEL EVERFORM SOLID SURFACE	SW7004 SNOWBOUND SW6793 BLUEBELL SW6778 AVIARY BLUE SW6500 OPEN SEAS SW7602 INDIGO BATIK SW7057 SILVER STRAND FINISH OR COLO LUNA SAND
TAG T-1 T-2 T-3 T-4 T-5 T-6 2 36 00 - CC TAG SM-1 9 65 00 - RE TAG B-1 5 83 16 - FII	MATERIAL FIELD PAINT ACCENT PAINT (ACCENT BLUE) ACCENT PAINT (ACCENT BLUE) ACCENT PAINT (LIGHT BLUE) ACCENT PAINT (MEDIUM BLUE) ACCENT PAINT (DARK BLUE) ACCENT PAINT (GREY) DUNTERTOPS MATERIAL QUARTZ SOLID SURFACE SILIENT FLOORING MATERIAL RESILIENT BASE BERGLASS REINFORCED PANELING	SHERWIN-WILLIAMS SHERWIN-WILLIAMS SHERWIN-WILLIAMS SHERWIN-WILLIAMS SHERWIN-WILLIAMS MANUFACTURER FORMICA MANUFACTURER ROPPE	MODEL VINYL WALL BASE 1/8"	SW7004 SNOWBOUND SW6793 BLUEBELL SW6778 AVIARY BLUE SW6500 OPEN SEAS SW7602 INDIGO BATIK SW7057 SILVER STRAND FINISH OR COLO LUNA SAND FINISH OR COLO 174 SMOKE
TAG T-1 T-2 T-3 T-4 T-5 T-6 2 36 00 - CC TAG SM-1 9 65 00 - RE TAG B-1 3 83 16 - FII TAG	MATERIAL FIELD PAINT ACCENT PAINT (ACCENT BLUE) ACCENT PAINT (LIGHT BLUE) ACCENT PAINT (LIGHT BLUE) ACCENT PAINT (MEDIUM BLUE) ACCENT PAINT (DARK BLUE) ACCENT PAINT (GREY) DUNTERTOPS MATERIAL QUARTZ SOLID SURFACE SILIENT FLOORING MATERIAL RESILIENT BASE	SHERWIN-WILLIAMS SHERWIN-WILLIAMS SHERWIN-WILLIAMS SHERWIN-WILLIAMS SHERWIN-WILLIAMS MANUFACTURER FORMICA MANUFACTURER	MODEL	SW7004 SNOWBOUND SW6793 BLUEBELL SW6778 AVIARY BLUE SW6500 OPEN SEAS SW7602 INDIGO BATIK SW7057 SILVER STRAND FINISH OR COLO LUNA SAND FINISH OR COLO 174 SMOKE
TAG T-1 T-2 T-3 T-4 T-5 T-6 2 36 00 - CC TAG SM-1 9 65 00 - RE TAG B-1 3 83 16 - FII TAG	MATERIAL FIELD PAINT ACCENT PAINT (ACCENT BLUE) ACCENT PAINT (LIGHT BLUE) ACCENT PAINT (LIGHT BLUE) ACCENT PAINT (MEDIUM BLUE) ACCENT PAINT (DARK BLUE) ACCENT PAINT (GREY) DUNTERTOPS MATERIAL QUARTZ SOLID SURFACE SILIENT FLOORING MATERIAL RESILIENT BASE SERGLASS REINFORCED PANELING MATERIAL	SHERWIN-WILLIAMS SHERWIN-WILLIAMS SHERWIN-WILLIAMS SHERWIN-WILLIAMS SHERWIN-WILLIAMS SHERWIN-WILLIAMS MANUFACTURER FORMICA MANUFACTURER ROPPE MANUFACTURER	MODEL EVERFORM SOLID SURFACE MODEL VINYL WALL BASE 1/8" COLLECTION	SW7004 SNOWBOUND SW6793 BLUEBELL SW6778 AVIARY BLUE SW6500 OPEN SEAS SW7602 INDIGO BATIK SW7057 SILVER STRAND FINISH OR COLO LUNA SAND FINISH OR COLO 174 SMOKE FINISH OR COLO
TAG F-1 F-2 F-3 F-4 F-5 F-6 2 36 00 - CC TAG SM-1 9 65 00 - RE TAG B-1 5 83 16 - FII TAG RP-1 9 21 13.19 -	MATERIAL FIELD PAINT ACCENT PAINT (ACCENT BLUE) ACCENT PAINT (LIGHT BLUE) ACCENT PAINT (MEDIUM BLUE) ACCENT PAINT (MEDIUM BLUE) ACCENT PAINT (DARK BLUE) ACCENT PAINT (GREY) DUNTERTOPS MATERIAL QUARTZ SOLID SURFACE SILIENT FLOORING MATERIAL RESILIENT BASE BERGLASS REINFORCED PANELING MATERIAL FIBER REINFORCED PLASTIC FRP/ALUMINUM TOILET COMPARTMENTS	SHERWIN-WILLIAMS SHERWIN-WILLIAMS SHERWIN-WILLIAMS SHERWIN-WILLIAMS SHERWIN-WILLIAMS SHERWIN-WILLIAMS MANUFACTURER FORMICA MANUFACTURER MANUFACTURER MANUFACTURER MARLITE	MODEL VINYL WALL BASE 1/8" COLLECTION SMOOTH	SW7004 SNOWBOUND SW6793 BLUEBELL SW6778 AVIARY BLUE SW6500 OPEN SEAS SW7602 INDIGO BATIK SW7057 SILVER STRAND FINISH OR COLC LUNA SAND FINISH OR COLC 174 SMOKE FINISH OR COLC S 100G WHITE
TAG T-1 T-2 T-3 T-4 T-5 T-6 2 36 00 - C(TAG SM-1 3 65 00 - RE TAG B-1 3 83 16 - FII TAG RP-1 3 21 13.19 - TAG	MATERIAL FIELD PAINT ACCENT PAINT (ACCENT BLUE) ACCENT PAINT (LIGHT BLUE) ACCENT PAINT (LIGHT BLUE) ACCENT PAINT (MEDIUM BLUE) ACCENT PAINT (DARK BLUE) ACCENT PAINT (GREY) OUNTERTOPS MATERIAL QUARTZ SOLID SURFACE SILIENT FLOORING MATERIAL RESILIENT BASE BERGLASS REINFORCED PANELING MATERIAL FIBER REINFORCED PLASTIC FRP/ALUMINUM TOILET COMPARTMENTS MATERIAL	SHERWIN-WILLIAMS SHERWIN-WILLIAMS SHERWIN-WILLIAMS SHERWIN-WILLIAMS SHERWIN-WILLIAMS SHERWIN-WILLIAMS MANUFACTURER FORMICA MANUFACTURER MANUFACTURER MARLITE MANUFACTURER MANUFACTURER	Image: Collection Collection	SW7004 SNOWBOUND SW6793 BLUEBELL SW6778 AVIARY BLUE SW6500 OPEN SEAS SW7602 INDIGO BATIK SW7057 SILVER STRAND FINISH OR COLC LUNA SAND FINISH OR COLC S 100G WHITE FINISH OR COLC
TAG T-1 T-2 T-3 T-4 T-5 T-6 2 36 00 - CC TAG SM-1 3 65 00 - RE TAG B-1 3 83 16 - FII TAG RP-1 3 21 13.19 - TAG	MATERIAL FIELD PAINT ACCENT PAINT (ACCENT BLUE) ACCENT PAINT (LIGHT BLUE) ACCENT PAINT (MEDIUM BLUE) ACCENT PAINT (MEDIUM BLUE) ACCENT PAINT (DARK BLUE) ACCENT PAINT (GREY) DUNTERTOPS MATERIAL QUARTZ SOLID SURFACE SILIENT FLOORING MATERIAL RESILIENT BASE BERGLASS REINFORCED PANELING MATERIAL FIBER REINFORCED PLASTIC FRP/ALUMINUM TOILET COMPARTMENTS	SHERWIN-WILLIAMS SHERWIN-WILLIAMS SHERWIN-WILLIAMS SHERWIN-WILLIAMS SHERWIN-WILLIAMS SHERWIN-WILLIAMS MANUFACTURER FORMICA MANUFACTURER MANUFACTURER MANUFACTURER MARLITE	MODEL VINYL WALL BASE 1/8" COLLECTION SMOOTH	SW7004 SNOWBOUND SW6793 BLUEBELL SW6778 AVIARY BLUE SW6500 OPEN SEAS SW7602 INDIGO BATIK SW7057 SILVER STRAND FINISH OR COLC LUNA SAND FINISH OR COLC 174 SMOKE FINISH OR COLC S 100G WHITE
TAG F-1 F-2 F-3 F-4 F-5 F-6 2 36 00 - CC TAG 5M-1 0 65 00 - RE TAG 3-1 3 83 16 - FII TAG RP-1 2 1 13.19 - TAG C-1	MATERIAL FIELD PAINT ACCENT PAINT (ACCENT BLUE) ACCENT PAINT (LIGHT BLUE) ACCENT PAINT (LIGHT BLUE) ACCENT PAINT (MEDIUM BLUE) ACCENT PAINT (DARK BLUE) ACCENT PAINT (GREY) OUNTERTOPS MATERIAL QUARTZ SOLID SURFACE SILIENT FLOORING MATERIAL RESILIENT BASE BERGLASS REINFORCED PANELING MATERIAL FIBER REINFORCED PLASTIC FRP/ALUMINUM TOILET COMPARTMENTS MATERIAL	SHERWIN-WILLIAMS SHERWIN-WILLIAMS SHERWIN-WILLIAMS SHERWIN-WILLIAMS SHERWIN-WILLIAMS SHERWIN-WILLIAMS MANUFACTURER FORMICA MANUFACTURER MANUFACTURER MARLITE MANUFACTURER MANUFACTURER	Image: Collection Collection	SW7004 SNOWBOUND SW6793 BLUEBELL SW6778 AVIARY BLUE SW6500 OPEN SEAS SW7602 INDIGO BATIK SW7057 SILVER STRAND FINISH OR COLO LUNA SAND FINISH OR COLO 174 SMOKE FINISH OR COLO S 100G WHITE FINISH OR COLO
TAG F-1 F-2 F-3 F-4 F-5 F-6 2 36 00 - CC TAG 36 00 - CC TAG 5 M-1 65 00 - RE TAG 33 16 - FII TAG 7 AG 7 AG 7 AG 7 AG 7 AG 7 AG 7 AG 7 AG	MATERIAL FIELD PAINT ACCENT PAINT (ACCENT BLUE) ACCENT PAINT (LIGHT BLUE) ACCENT PAINT (MEDIUM BLUE) ACCENT PAINT (DARK BLUE) ACCENT PAINT (DARK BLUE) ACCENT PAINT (GREY) OUNTERTOPS MATERIAL QUARTZ SOLID SURFACE SILIENT FLOORING MATERIAL RESILIENT BASE BERGLASS REINFORCED PANELING MATERIAL FIBER REINFORCED PLASTIC FRP/ALUMINUM TOILET COMPARTMENTS MATERIAL TOILET COMPARTMENT NDOW SHADES MATERIAL	SHERWIN-WILLIAMS SHERWIN-WILLIAMS SHERWIN-WILLIAMS SHERWIN-WILLIAMS SHERWIN-WILLIAMS SHERWIN-WILLIAMS SHERWIN-WILLIAMS MANUFACTURER FORMICA MANUFACTURER MANUFACTURER MARLITE MANUFACTURER SPECIAL-LITE MANUFACTURER	MODEL EVERFORM SOLID SURFACE MODEL VINYL WALL BASE 1/8" COLLECTION SMOOTH COLLECTION SPECLITE 3 FRP COLLECTION	SW7004 SNOWBOUND SW6793 BLUEBELL SW6778 AVIARY BLUE SW6500 OPEN SEAS SW7602 INDIGO BATIK SW7057 SILVER STRAND FINISH OR COLO LUNA SAND FINISH OR COLO 174 SMOKE FINISH OR COLO S 100G WHITE FINISH OR COLO LIGHT GREY FINISH OR COLO
TAG T-1 T-2 T-3 T-4 T-5 T-6 2 36 00 - CC TAG SM-1 9 65 00 - RE TAG B-1 5 83 16 - FII TAG RP-1 0 21 13.19 - TAG C-1 2 24 00 - W	MATERIAL FIELD PAINT ACCENT PAINT (ACCENT BLUE) ACCENT PAINT (LIGHT BLUE) ACCENT PAINT (MEDIUM BLUE) ACCENT PAINT (MEDIUM BLUE) ACCENT PAINT (DARK BLUE) ACCENT PAINT (GREY) OUNTERTOPS MATERIAL QUARTZ SOLID SURFACE SILIENT FLOORING MATERIAL RESILIENT BASE SERGLASS REINFORCED PANELING MATERIAL FIBER REINFORCED PLASTIC FRP/ALUMINUM TOILET COMPARTMENTS MATERIAL TOILET COMPARTMENT NDOW SHADES	SHERWIN-WILLIAMS SHERWIN-WILLIAMS SHERWIN-WILLIAMS SHERWIN-WILLIAMS SHERWIN-WILLIAMS SHERWIN-WILLIAMS SHERWIN-WILLIAMS MANUFACTURER FORMICA MANUFACTURER MANUFACTURER MARLITE MANUFACTURER SPECIAL-LITE	MODEL EVERFORM SOLID SURFACE VINYL WALL BASE 1/8" COLLECTION SMOOTH COLLECTION SPECLITE 3 FRP	SW7004 SNOWBOUND SW6793 BLUEBELL SW6778 AVIARY BLUE SW6500 OPEN SEAS SW7602 INDIGO BATIK SW7057 SILVER STRAND IUNA SAND LUNA SAND FINISH OR COLO 174 SMOKE S 100G WHITE FINISH OR COLO S 100G WHITE FINISH OR COLO S 100G WHITE
TAG T-1 T-2 T-3 T-4 T-5 T-6 2 36 00 - CO TAG SM-1 9 65 00 - RE TAG B-1 6 83 16 - FII TAG RP-1 0 21 13.19 - TAG C-1 TAG /S-1	MATERIAL FIELD PAINT ACCENT PAINT (ACCENT BLUE) ACCENT PAINT (LIGHT BLUE) ACCENT PAINT (MEDIUM BLUE) ACCENT PAINT (DARK BLUE) ACCENT PAINT (DARK BLUE) ACCENT PAINT (GREY) OUNTERTOPS MATERIAL QUARTZ SOLID SURFACE SILIENT FLOORING MATERIAL RESILIENT BASE BERGLASS REINFORCED PANELING MATERIAL FIBER REINFORCED PLASTIC FRP/ALUMINUM TOILET COMPARTMENTS MATERIAL TOILET COMPARTMENT NDOW SHADES MATERIAL	SHERWIN-WILLIAMS SHERWIN-WILLIAMS SHERWIN-WILLIAMS SHERWIN-WILLIAMS SHERWIN-WILLIAMS SHERWIN-WILLIAMS SHERWIN-WILLIAMS MANUFACTURER FORMICA MANUFACTURER MANUFACTURER MARLITE MANUFACTURER SPECIAL-LITE MANUFACTURER	MODEL EVERFORM SOLID SURFACE MODEL VINYL WALL BASE 1/8" COLLECTION SMOOTH COLLECTION SPECLITE 3 FRP COLLECTION	SW7004 SNOWBOUND SW6793 BLUEBELL SW6778 AVIARY BLUE SW6500 OPEN SEAS SW7602 INDIGO BATIK SW7057 SILVER STRAND FINISH OR COLO LUNA SAND FINISH OR COLO 174 SMOKE FINISH OR COLO S 100G WHITE FINISH OR COLO S 100G WHITE FINISH OR COLO S 100G WHITE FINISH OR COLO S 100G WHITE SOLAR: THERMOVEIL DENSE BASKET WEAVE1500 S SILVER BIRCH
TAG T-1 T-2 T-3 T-4 T-5 T-6 2 36 00 - C(TAG SM-1 9 65 00 - RE TAG B-1 6 83 16 - FII TAG RP-1 0 21 13.19 - TAG C-1 2 24 00 - Wi	MATERIAL FIELD PAINT ACCENT PAINT (ACCENT BLUE) ACCENT PAINT (LIGHT BLUE) ACCENT PAINT (MEDIUM BLUE) ACCENT PAINT (DARK BLUE) ACCENT PAINT (DARK BLUE) ACCENT PAINT (GREY) DUNTERTOPS MATERIAL QUARTZ SOLID SURFACE SILIENT FLOORING MATERIAL RESILIENT BASE BERGLASS REINFORCED PANELING MATERIAL FIBER REINFORCED PLASTIC FRP/ALUMINUM TOILET COMPARTMENTS MATERIAL TOILET COMPARTMENT NDOW SHADES MATERIAL WINDOW TREATMENT/ SOLAR	SHERWIN-WILLIAMS SHERWIN-WILLIAMS SHERWIN-WILLIAMS SHERWIN-WILLIAMS SHERWIN-WILLIAMS SHERWIN-WILLIAMS SHERWIN-WILLIAMS SHERWIN-WILLIAMS MANUFACTURER MANUFACTURER MANUFACTURER MARLITE MANUFACTURER SPECIAL-LITE MANUFACTURER MECHOSHADE	MODEL EVERFORM SOLID SURFACE VINYL WALL BASE 1/8" COLLECTION SMOOTH COLLECTION SPECLITE 3 FRP COLLECTION MANUALLY OPPERATED ROLLER SHADES	SW7004 SNOWBOUND SW6793 BLUEBELL SW6778 AVIARY BLUE SW6500 OPEN SEAS SW7602 INDIGO BATIK SW7057 SILVER STRAND FINISH OR COLO LUNA SAND FINISH OR COLO 174 SMOKE FINISH OR COLO S 100G WHITE FINISH OR COLO S 100G WHITE FINISH OR COLO S 100G WHITE FINISH OR COLO S 100G WHITE FINISH OR COLO S 100G WHITE
TAG T-1 T-2 T-3 T-4 T-5 T-6 2 36 00 - CC TAG SM-1 9 65 00 - RE TAG B-1 5 83 16 - FII TAG RP-1 7 AG 7 AG 7	MATERIAL FIELD PAINT ACCENT PAINT (ACCENT BLUE) ACCENT PAINT (LIGHT BLUE) ACCENT PAINT (MEDIUM BLUE) ACCENT PAINT (DARK BLUE) ACCENT PAINT (DARK BLUE) ACCENT PAINT (GREY) DUNTERTOPS MATERIAL QUARTZ SOLID SURFACE SILIENT FLOORING MATERIAL RESILIENT BASE BERGLASS REINFORCED PANELING MATERIAL FIBER REINFORCED PLASTIC FRP/ALUMINUM TOILET COMPARTMENTS MATERIAL TOILET COMPARTMENT NDOW SHADES MATERIAL WINDOW TREATMENT/ SOLAR	SHERWIN-WILLIAMS SHERWIN-WILLIAMS SHERWIN-WILLIAMS SHERWIN-WILLIAMS SHERWIN-WILLIAMS SHERWIN-WILLIAMS SHERWIN-WILLIAMS SHERWIN-WILLIAMS MANUFACTURER MANUFACTURER MANUFACTURER MARLITE MANUFACTURER SPECIAL-LITE MANUFACTURER MECHOSHADE	MODEL EVERFORM SOLID SURFACE VINYL WALL BASE 1/8" COLLECTION SMOOTH COLLECTION SPECLITE 3 FRP COLLECTION MANUALLY OPPERATED ROLLER SHADES	SW6793 BLUEBELL SW6778 AVIARY BLUE SW6500 OPEN SEAS SW7602 INDIGO BATIK SW7057 SILVER STRAND FINISH OR COLO LUNA SAND FINISH OR COLO 174 SMOKE FINISH OR COLO S 100G WHITE FINISH OR COLO S 100G WHITE FINISH OR COLO S 100G WHITE FINISH OR COLO S 100G WHITE FINISH OR COLO S 100G WHITE SOLAR: THERMOVEIL DENSE BASKET WEAVE 1500 S SILVER BIRCH


RESTROOM ACCESSORIES SCHEDULE


TAG	EQUIPMENT	MANUFACTURER	ITEM/ MODEL NO.	COLOR
GB-1	36" GRAB BAR	BOBRICK	1 1/4" DIA STAINLESS STEEL GRAB BAR WITH SNAP FLANGE - B-5806-1	STAINLESS STEE
GB-2	42" GRAB BAR	BOBRICK	1 1/4" DIA STAINLESS STEEL GRAB BAR WITH SNAP FLANGE - B-5806-1	STAINLESS STEE
MR-1	MIRROR	BOBRICK	MIRROR WITH STAINLESS STEEL CHANNEL FRAME B-165	
HD-1	HAND DRYER	DYSON	LOW VOLTAGE AIRBLADE V HU02 307174-01	WHITE
SD-1	SOAP DISPENSER - WALL	BOBRICK	AUTOMATIC WALL-MOUNTED SOAP DISPENSER B-2012	STAINLESS STEE
TTD-1/2	TOILET PAPER/SEAT COVER/ SANITARY NAPKIN DISPOSAL	BOBRICK	RECESSED TOILET SEAT COVER DISPENSER, SANITARY NAPKIN DISPOSAL, AND TOILET TISSUE DISPENSER B-3574	STAINLESS STEE
TSD-1	TOILET PAPER/SEAT COVER	BOBRICK	SURFACE MOUNTED TOILET SEAT COVER AND TOILET TISSUE DISPENSER B221	STAINLESS STEE
WRC-1	PAPER TOWEL DISPENSER AND WASTE RECEPTACLE	BOBRICK	RECESSED CONVERTIBLE PAPER TOWEL DISPENSER AND WASTE RECEPTACLE B-3944	STAINLESS STEE
	•			


			INISH SCHEDULE			
	SEE ELEVATIONS SEE ELEVATIONS SEE ELEVATIONS	SIZE	COMMENTS C-7 PCF FIBERGLASS SUBSTRATE WITH 1/8" 16-20 PCF HIGH DENSITY FIBERGLASS TACKABLE LAYER. EXPOSED EDGE TO RECEIVE TRIM TR-2, OR HARDENED EDGES PER MANUFACTURER.	REP CONTACT PANEL: COBY BOTHA E: COBYBOTHA@MYPACIFICSOLUTION.COM P: 949.280.4137 FABRIC:	LOCA CLASSROOMS, CONFERENCE	
	SEE ELEVATIONS			LINDSAY AVERY E: LAVERY@MAHARAM.COM		
	SEE ELEVATIONS	SIZE	COMMENTS FOR BENCH CUSHIONED SEATING, SEE DETAIL 1D/A11.1	REP CONTACT	LOCA	TION
				E: LAVERY@MAHARAM.COM P: 213.392.2913		
	24" X 24"		COMMENTS MONOLITHIC INSTALLATION, W/ ECO-BACKING. WM-1 TO BE OFCI.	REP CONTACT	LOCA TYP. WALK-OFF MAT FOR ALL ROOMS WIT CLASSROOM SINKS	
	24" X 24"	ADD 01 ADD 01	BRICK INSTALLATION, W/ ECO-BACKING. CPT-1 TO BE OFCI.	ANDREW_JOHNSON1@MOHAWKIND.COM P: 310.936.0369	CLASSROOMS, CONFERENCE	
		SIZE	COMMENTS	REP CONTACT	LOCA	ION
			CLEAR SEALER, PREMIUM QUALITY, LOW VOC	BRUCE SILVERS E: BRUCE@BMSAINC.COM P: 949.233.2127	TYPICAL THROUGHOUT	
	3/8"		COMMENTS SEE DETAIL 2A/A11.1	REP CONTACT ADD 02 MARVIN ROSSATTY E: MARVINROSSATTY@FRYREGLET.COM P: 626.394.8641	TYPICAL THROUGHOUT AT ALL EXTERNAL	CORNERS OCCURING INSIDE THE OF CLASSROOM RESTROOMS,
	51" X 120"		COMMENTS VERTICLE GRAIN DIRECTION, MATTE. PROVIDE 1/4" COLOR MATCHING SILICONE EDGEBANDING FOR ALL EXPOSED EDGES ON MILLWORK.	REP CONTACT JOE DANNA E: JOE.DANNA@ABETLAMINATI.COM P: 714.504.1328	LOCA"	TION
	51" X 120"		PROVIDE 1/4" COLOR MATCHING SILICONE EDGEBANDING FOR ALL EXPOSED EDGES ON MILLWORK. SEE A-SERIES SHEETS FOR MILLWORK HARDWARE LOCATION			
			PROVIDE 90 DEGREE CONCEALED HINGE WHERE ADJACENT TO WALL	ADD 02	ALL CASEWORK, TYPICAL	
	4' X 8' SEE ELEVATIONS	SIZE	COMMENTS Z-CLIP MOUNTING, WHITE TRIM, MAGNETIC	REP CONTACT TERRI BURKHART E: terri@epictrends.net P: 760.717.7167	LOCA [*] CLASSROOMS, CONFERENCE	TON
		SIZE	COMMENTS	REP CONTACT	LOCA	-10N
	48"W x 75'ROLL, SEE ELEVATIONS	FOR INSTALL DIMENSION	INSTALLED HORIZONTALLY TO AVOID SEAMS IN THE MAIN WRITING AND PROJECTION AREA, PREP WALL TO BE LEVEL 4 PRIOR TO INSTALL WALLCOVERING.	LAURA POITRAS E: LPOITRAS@KOROSEAL.COM P: 213.505.6544	CLASSROOMS, CONFERENCE	
		SIZE	COMMENTS			TION
	REQUIRED TO COORDINATE WITH	I TILE SELECTION AND SETTING SYSTE	REFER TO DETAIL 4E/A11.1	MARY E. YOCUM E: MYOCUM@SCHLUTER.COM P: 714.329.0355	TYP THROUGHOUT RESTROOMS	
	MATCH DEPTH OF TILE 1" OR AS REQUIRED TO COORDIN 8"X4"X5/16" 4"X4"X5/16" 12"X24"X5/16" 6" x 36" x 3/4"	JATE WITH SPECIFIED FINISH	REFER TO DETAIL 4E/A11.1, WHERE APPLICABLE REFER TO ELEVATIONS AND DETAILS FOR LOCATION MONOLITHIC INSTALLATION, 1/16" GROUT LINE, GROUT COLOR: GREY, FULL MORTAR SET FLOOR TILE, 50% EACH (2-TONE) AT INDICATED WALLS 1/16" GROUT LINE, GROUT COLOR: GREY, THINSET WALL TILE FULL HEIGHT, SUBSTRATE SHALL BE DENSHIELD OR OTHER DURABLE PRODUCT, NO PLYWOOD BACKING REQUIRED, 50% EACH (2-TONE) AT INDICATED WALLS, VERTICAL BRICK 1/16" GROUT LINE, GROUT COLOR: GREY, THINSET WALL TILE FULL HEIGHT, SUBSTRATE SHALL BE DENSHIELD OR OTHER DURABLE PRODUCT, NO PLYWOOD BACKING REQUIRED, 50% EACH (2-TONE) AT INDICATED WALLS, VERTICAL BRICK 1/16" GROUT LINE, GROUT COLOR: GREY, THINSET WALL TILE FULL HEIGHT, SUBSTRATE SHALL BE DENSHIELD OR OTHER DURABLE PRODUCT, NO PLYWOOD BACKING REQUIRED, 100% AT ALL WALLS, MONOLITHIC INSTALLATION MONOLITHIC INSTALLATION, 1/16" GROUT LINE, GROUT COLOR: GREY, FULL MORTAR SET FLOOR TILE SEE DETAIL 51/A1.1104	AMY KNECHT E: AKNECHT@TILEBAR.COM P: 570.927.5474	AT ACOUSTIC WALL PANEL & WALLCOVER AT ACOUSTIC WALL PANEL & WALLCOVER CLASSROOMS STAFF RESTROOMS, KINDER RESTROOMS	INGS W/ SUBSTRATE
		SIZE	COMMENTS	REP CONTACT	LOCA	TION
	24" X 48"			MATTHEW P. NEWMAN E: MPNEWMAN@ARMSTRONGCEILINGS.COI P: 213.408.9957	CLASSROOMS, CONFERENCE	
		SIZE	COMMENTS SEMI-GLOSS FOR WALL, SEMI-GLOSS FOR DOOR AND DOOR FRAME, FLAT FOR CEILING, U.O.N.	REP CONTACT	LOCA GENERAL PAINT	ION
				E: THOMAS.W.BRUMMETT@SHERWIN.CO P: 310.999.9396		VATIONS
		SIZE	COMMENTS	REP CONTACT BILL YOUNT E: BILL.YOUNT@FORMICA.COM P: 310.266.2861	LOCA	TION
	4" H	SIZE	COMMENTS	REP CONTACT	LOCA	-10N
	4'W x 7'-2"H	SIZE	COMMENTS	REP CONTACT ASHLEY BARKHEIMER E: ABARKHEIMER@MARLITE.COM P: N/A	LOCA	TON
	SEE ELEVATION	SIZE	COMMENTS	REP CONTACT DENNIS ZANROSSO E: DENNISZ@THEZGROUP.COM P: 848.340.1011	LOCA	TON
LOR: 1519 LOR: 1519	VARIES		COMMENTS MOUNTING METHOD: WALL - MOUNTED FASCIA: WHITE BRACKET: MECHO/7, SINGLE ROLLER SHADES, PROVIDE MULTIBAND SHADES AT ALL LOCATIONS FOR OPERATION OF ALL BANDS SIMULTANEOUSLY USING A SINGLE CLUTCH OPERATOR MOUNTING METHOD: WALL - MOUNTED FASCIA: WHITE BRACKET: ELECTRO/2 BRACKET MOTOR: WHISPER IQ2 + AC SINGLE ROLLER SHADES AT ALL LOCATIONS FOR OPERATION OF ALL BANDS SIMULTANEOUSLY USING A SINGLE ELECTRONIC DRIVE OPERATOR	REP CONTACT JESSE RUSS E: JESSE@ARCHITYPE.NET P: 213.631.5001	LOCA THROUGHOUT AT PERIMETER WINDOWS THROUGHOUT AT PERIMETER WINDOWS	TON


	FINISH	SIZE	COMMENTS
TEEL	SATIN	36"	HORIZONTAL
TEEL	SATIN	42"	HORIZONTAL
		24"W X 48"H	
		15 1/2"X9 1/4"X4"D	
TEEL	SATIN	9 9/16"X4 3/16"X4 7/32"	
TEEL	SATIN	17 3/16"W X 30 5/8"H X 3 15/16"D	ROUGH WALL OPENING: 16"W X 29 1/4"H X 4"D
TEEL	SATIN	17 3/16"W X 30 5/8"H X 3 15/16"D	ROUGH WALL OPENING: 16"W X 29 1/4"HX4"D
TEEL	SATIN		ROUGH WALL OPENING: 16"W X 54 3/4"H X 4"D

ALL FINISHES SHALL COMPLY WITH CBC CHAPTER 8, WITH TITLE 19 CCR, & 2019 CFC CHAPTER 8. ALL FLOORING SHALL HAVE A COEFFICIENT OF FRICTION GREATER THAN 0.6, PER ASTM C1028. ALL FINISHES SHALL BE CLASS C AND TESTED IN ACCORDANCE W/ ASTM E84 OR UL 723.

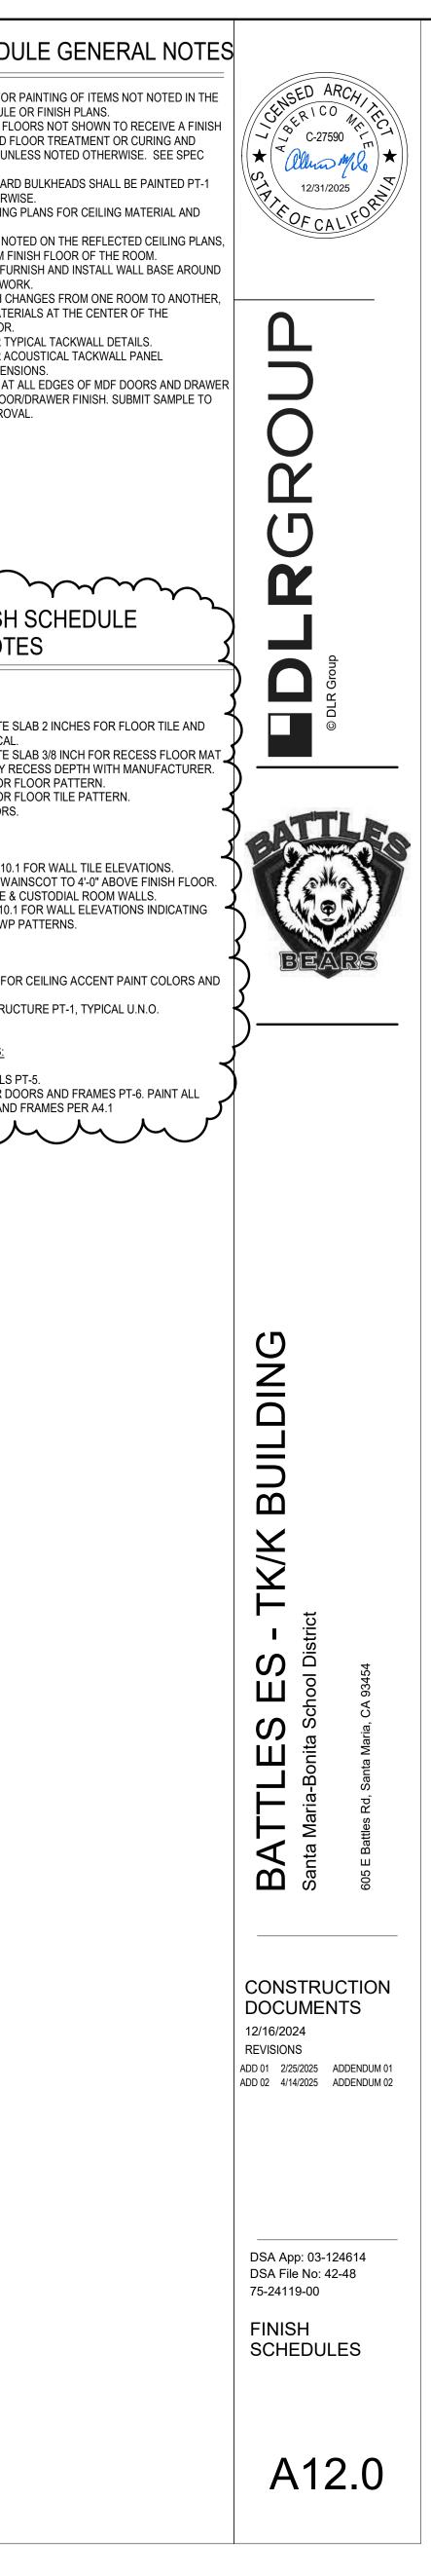

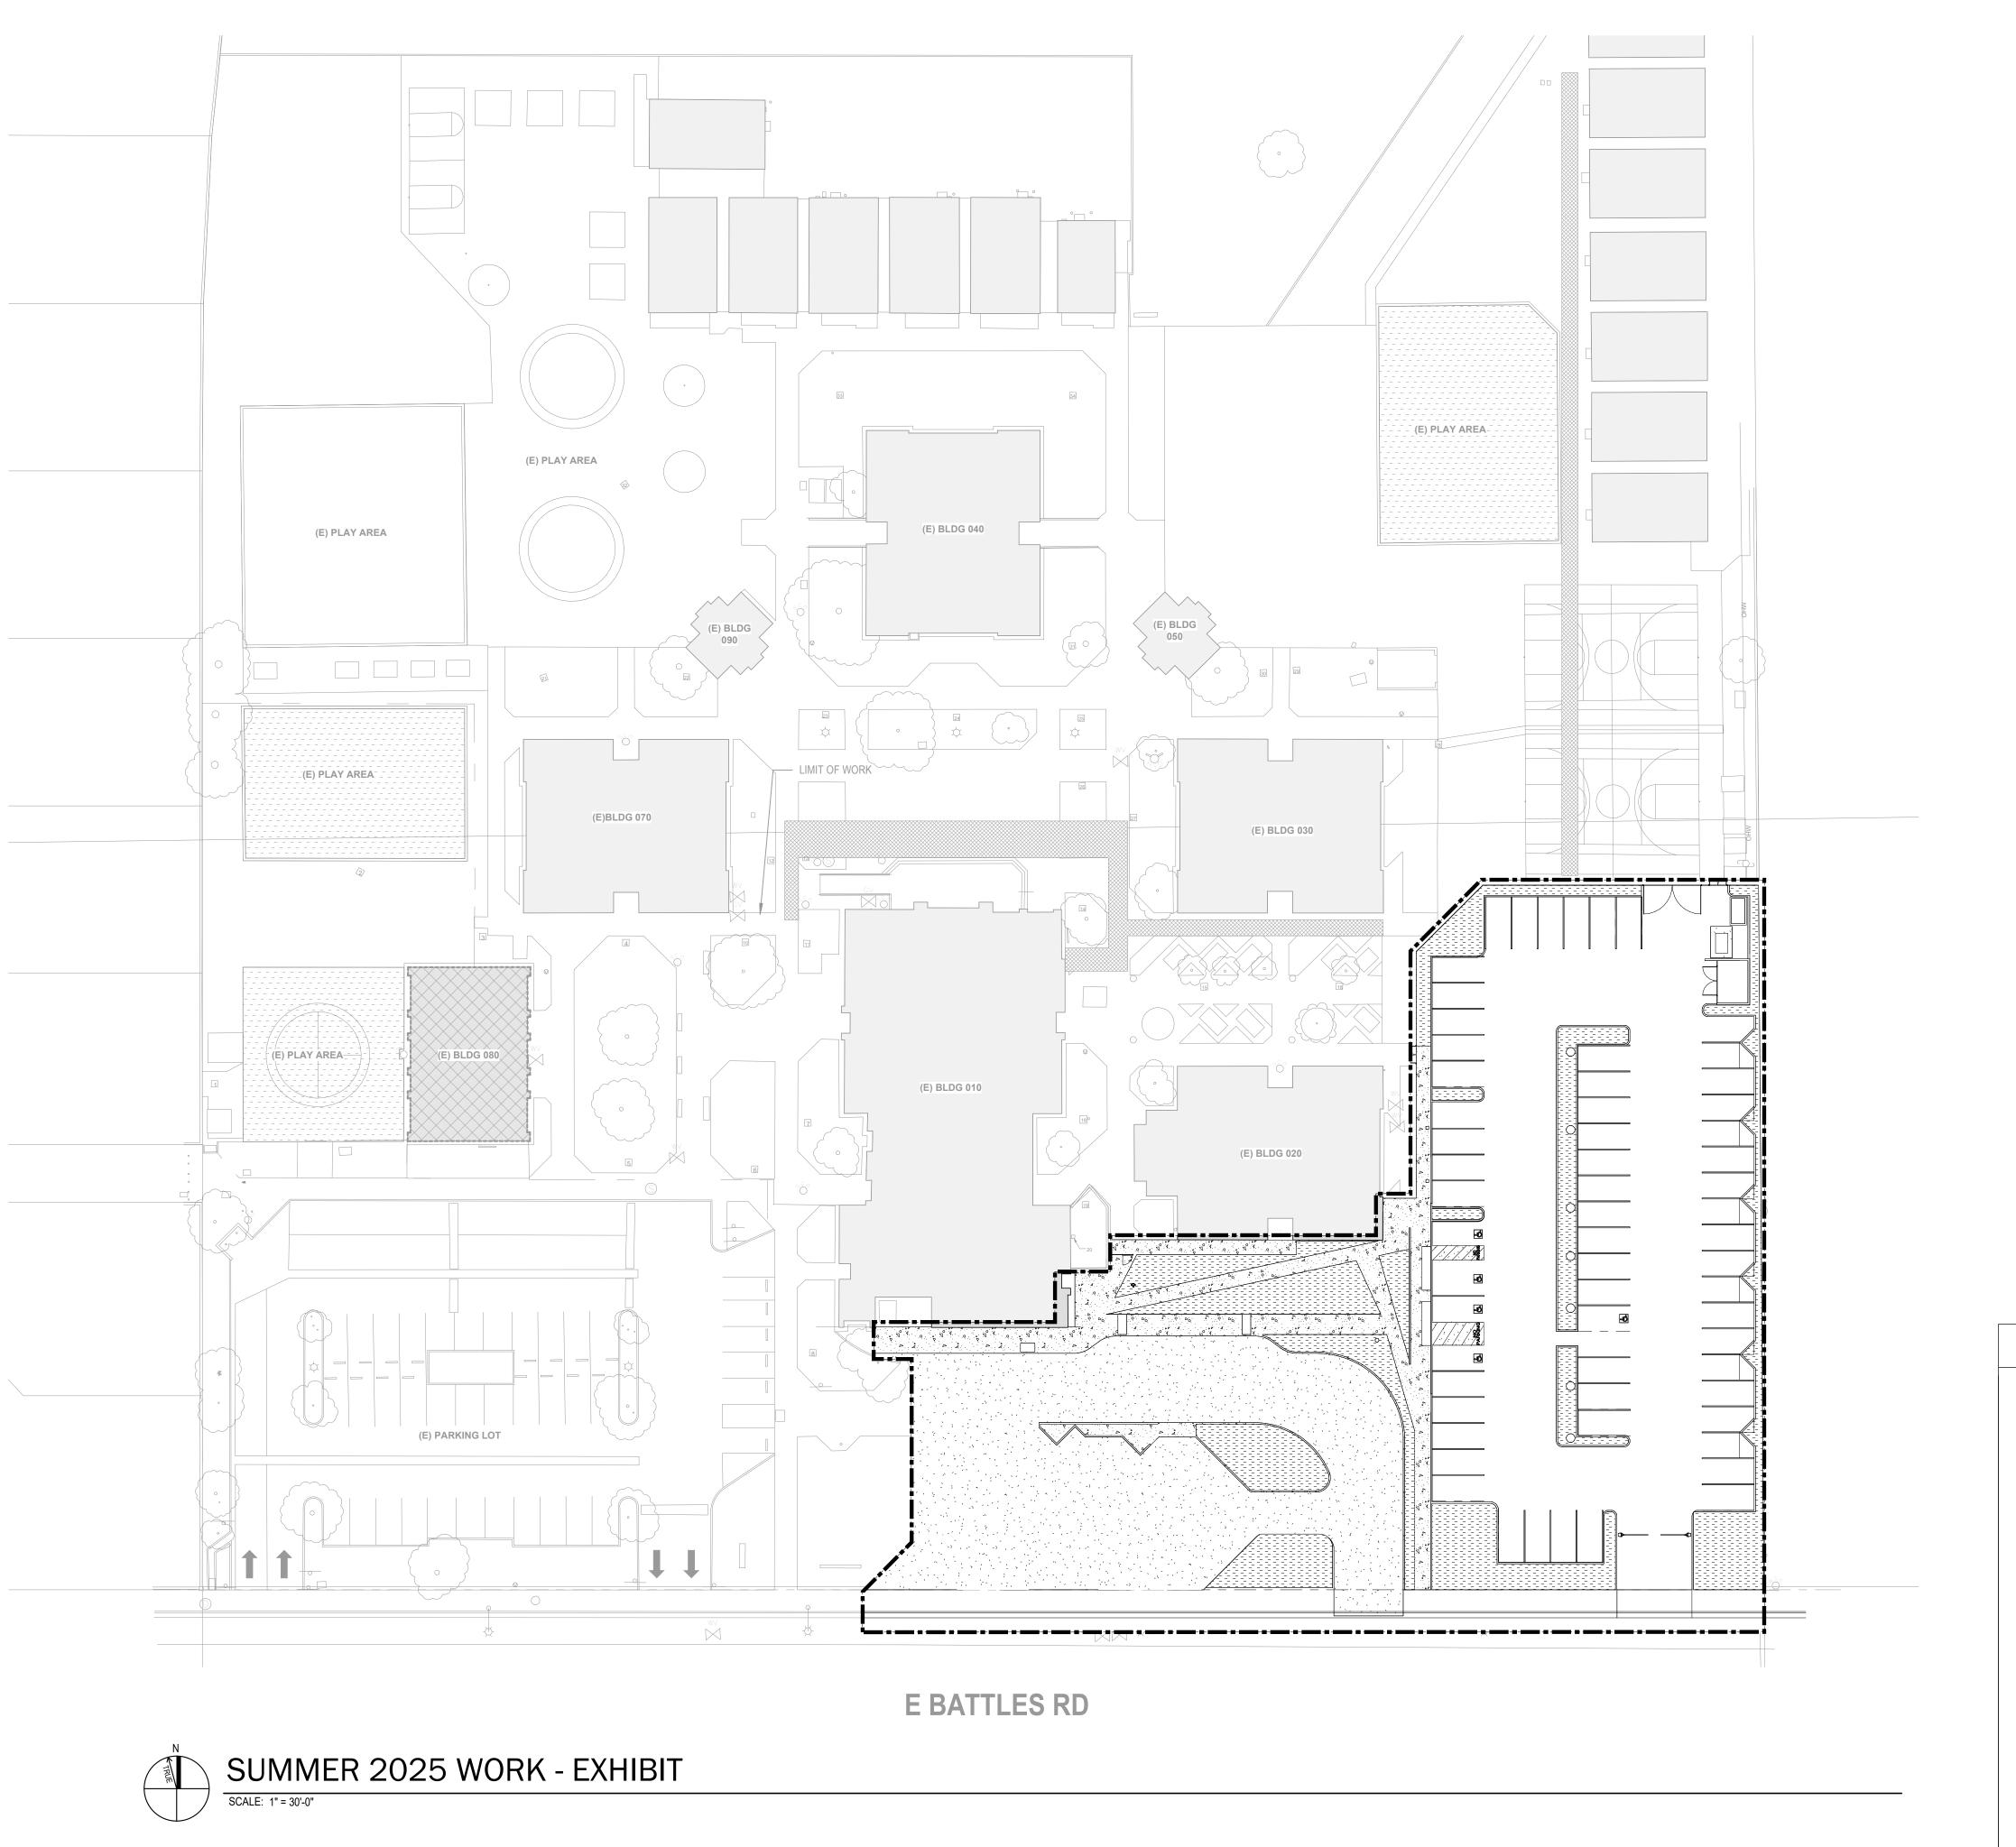

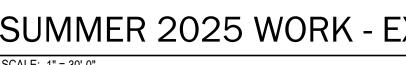

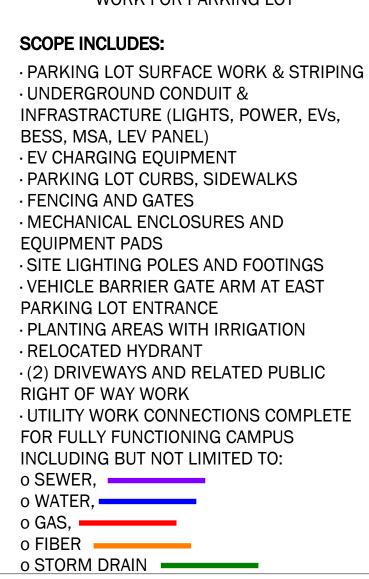

DSA App: 03-124614 DSA File No: 42-48 75-24119-00 SUMMER 2025 WORK - EXHIBIT


ASK-001A

3/17/2025

AREA OF SCOPE OF SUMMER WORK FOR PARKING LOT


PHASE 1 - SUMMER 2025 WORK

UILDING Ш XX. $\overline{}$ S Ш S S Ш Ĕ **BA** Santa

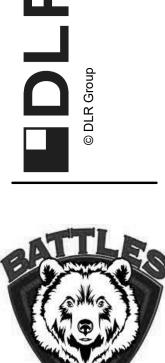



bears



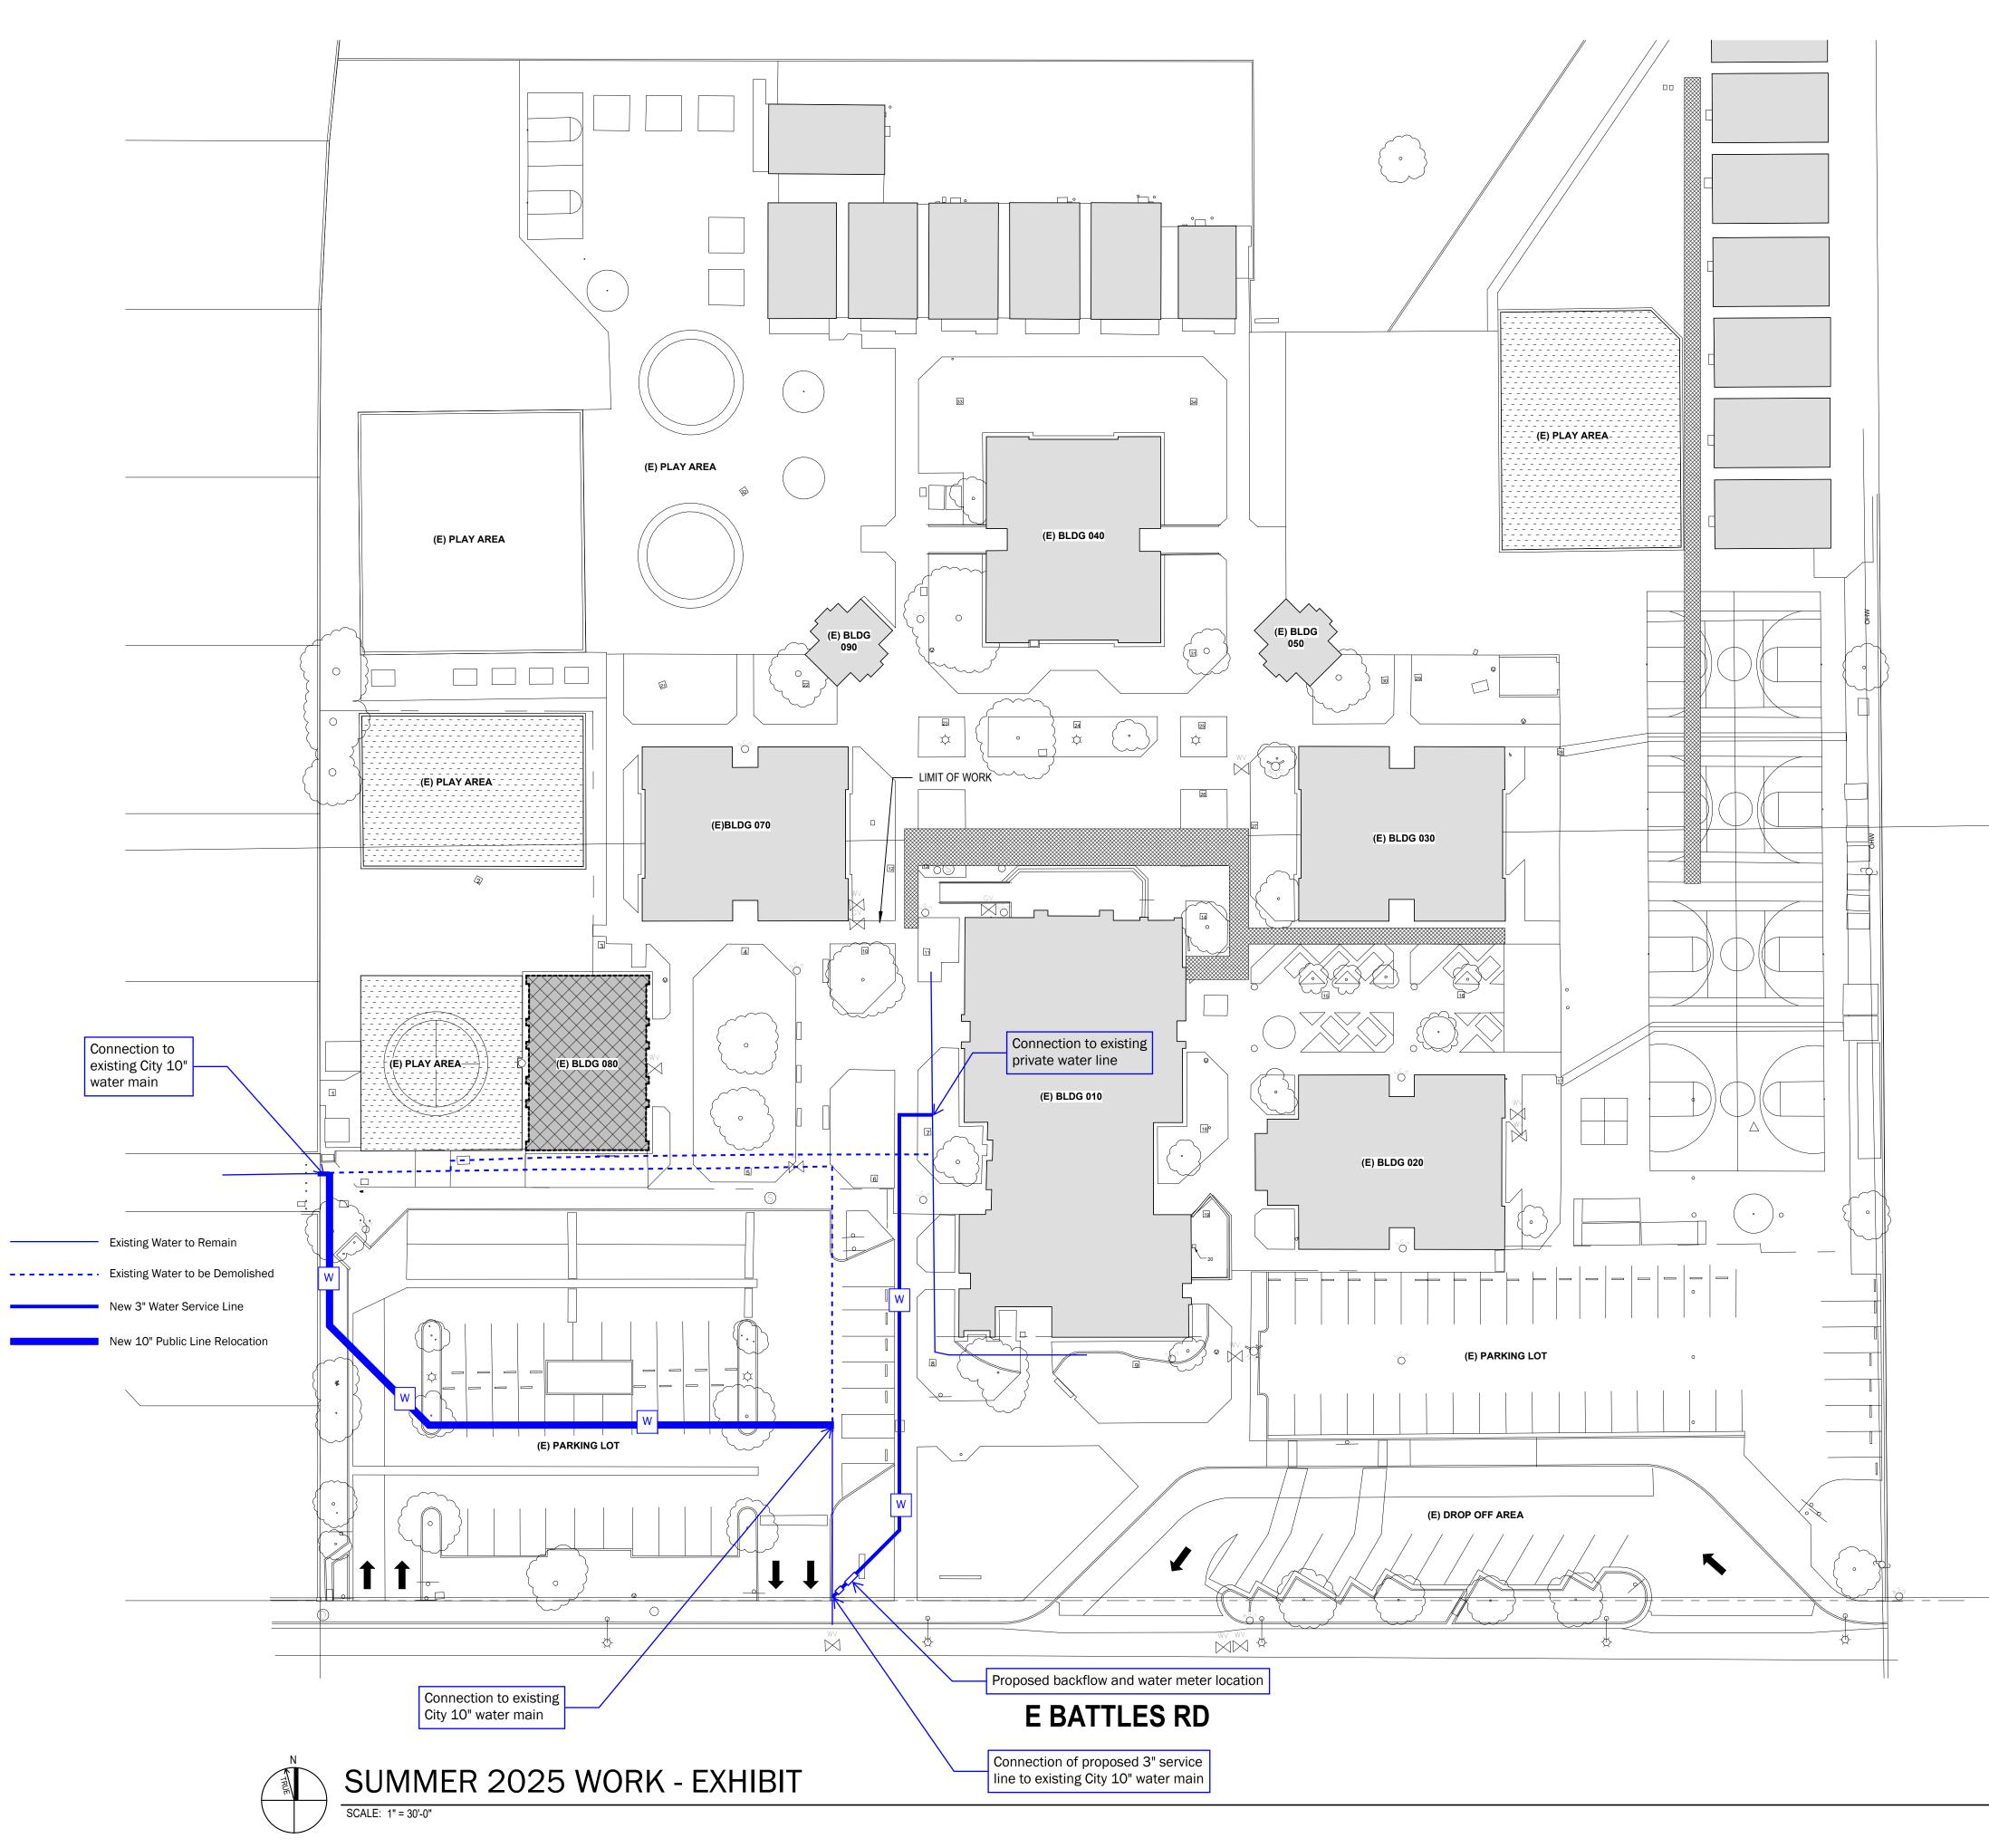


PHASE 1 - SUMMER
• EXACT WATER LINE LOC KNOWN, GC TO POTHOL LOCATION PRIOR TO WO SHARE LOCATION AND F DISTRICT AND DESIGN T
UTILITY WORK CONNEC FOR FULLY FUNCTIONING INCLUDING BUT NOT LIM o SEWER, o WATER, o GAS, o FIBER o STORM DRAIN

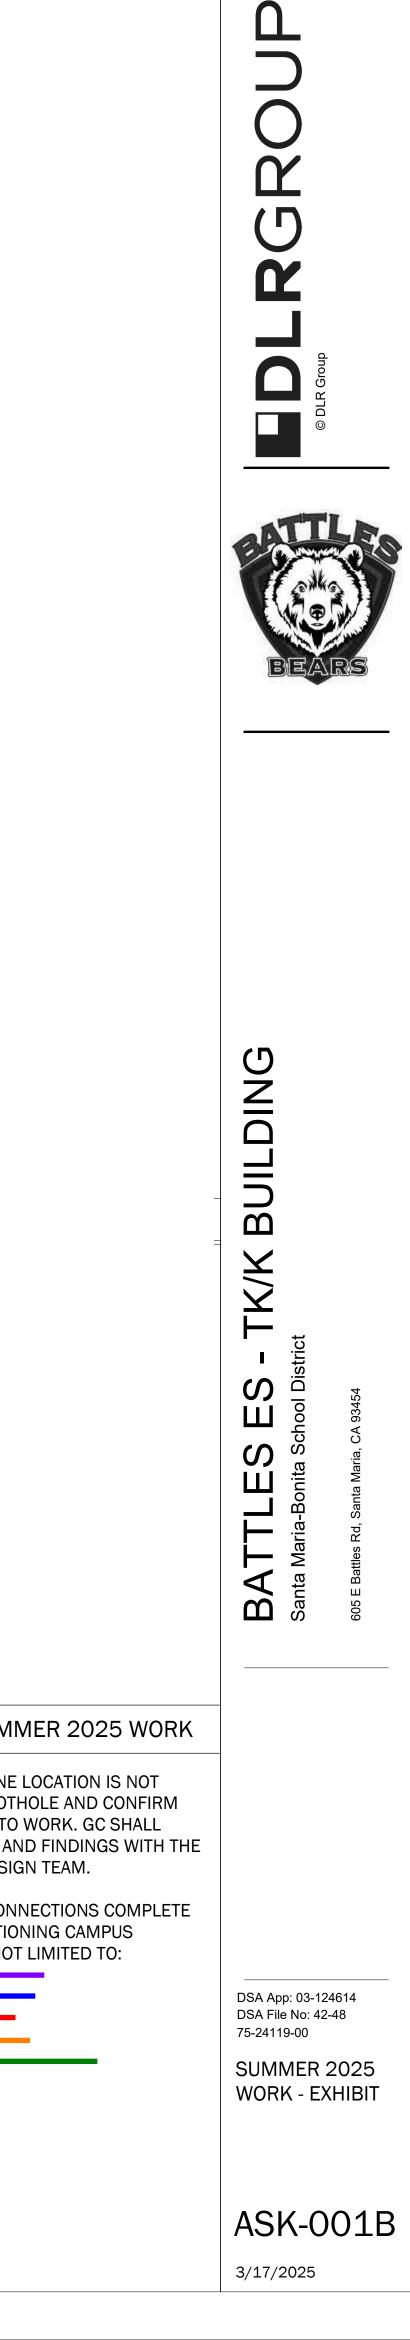


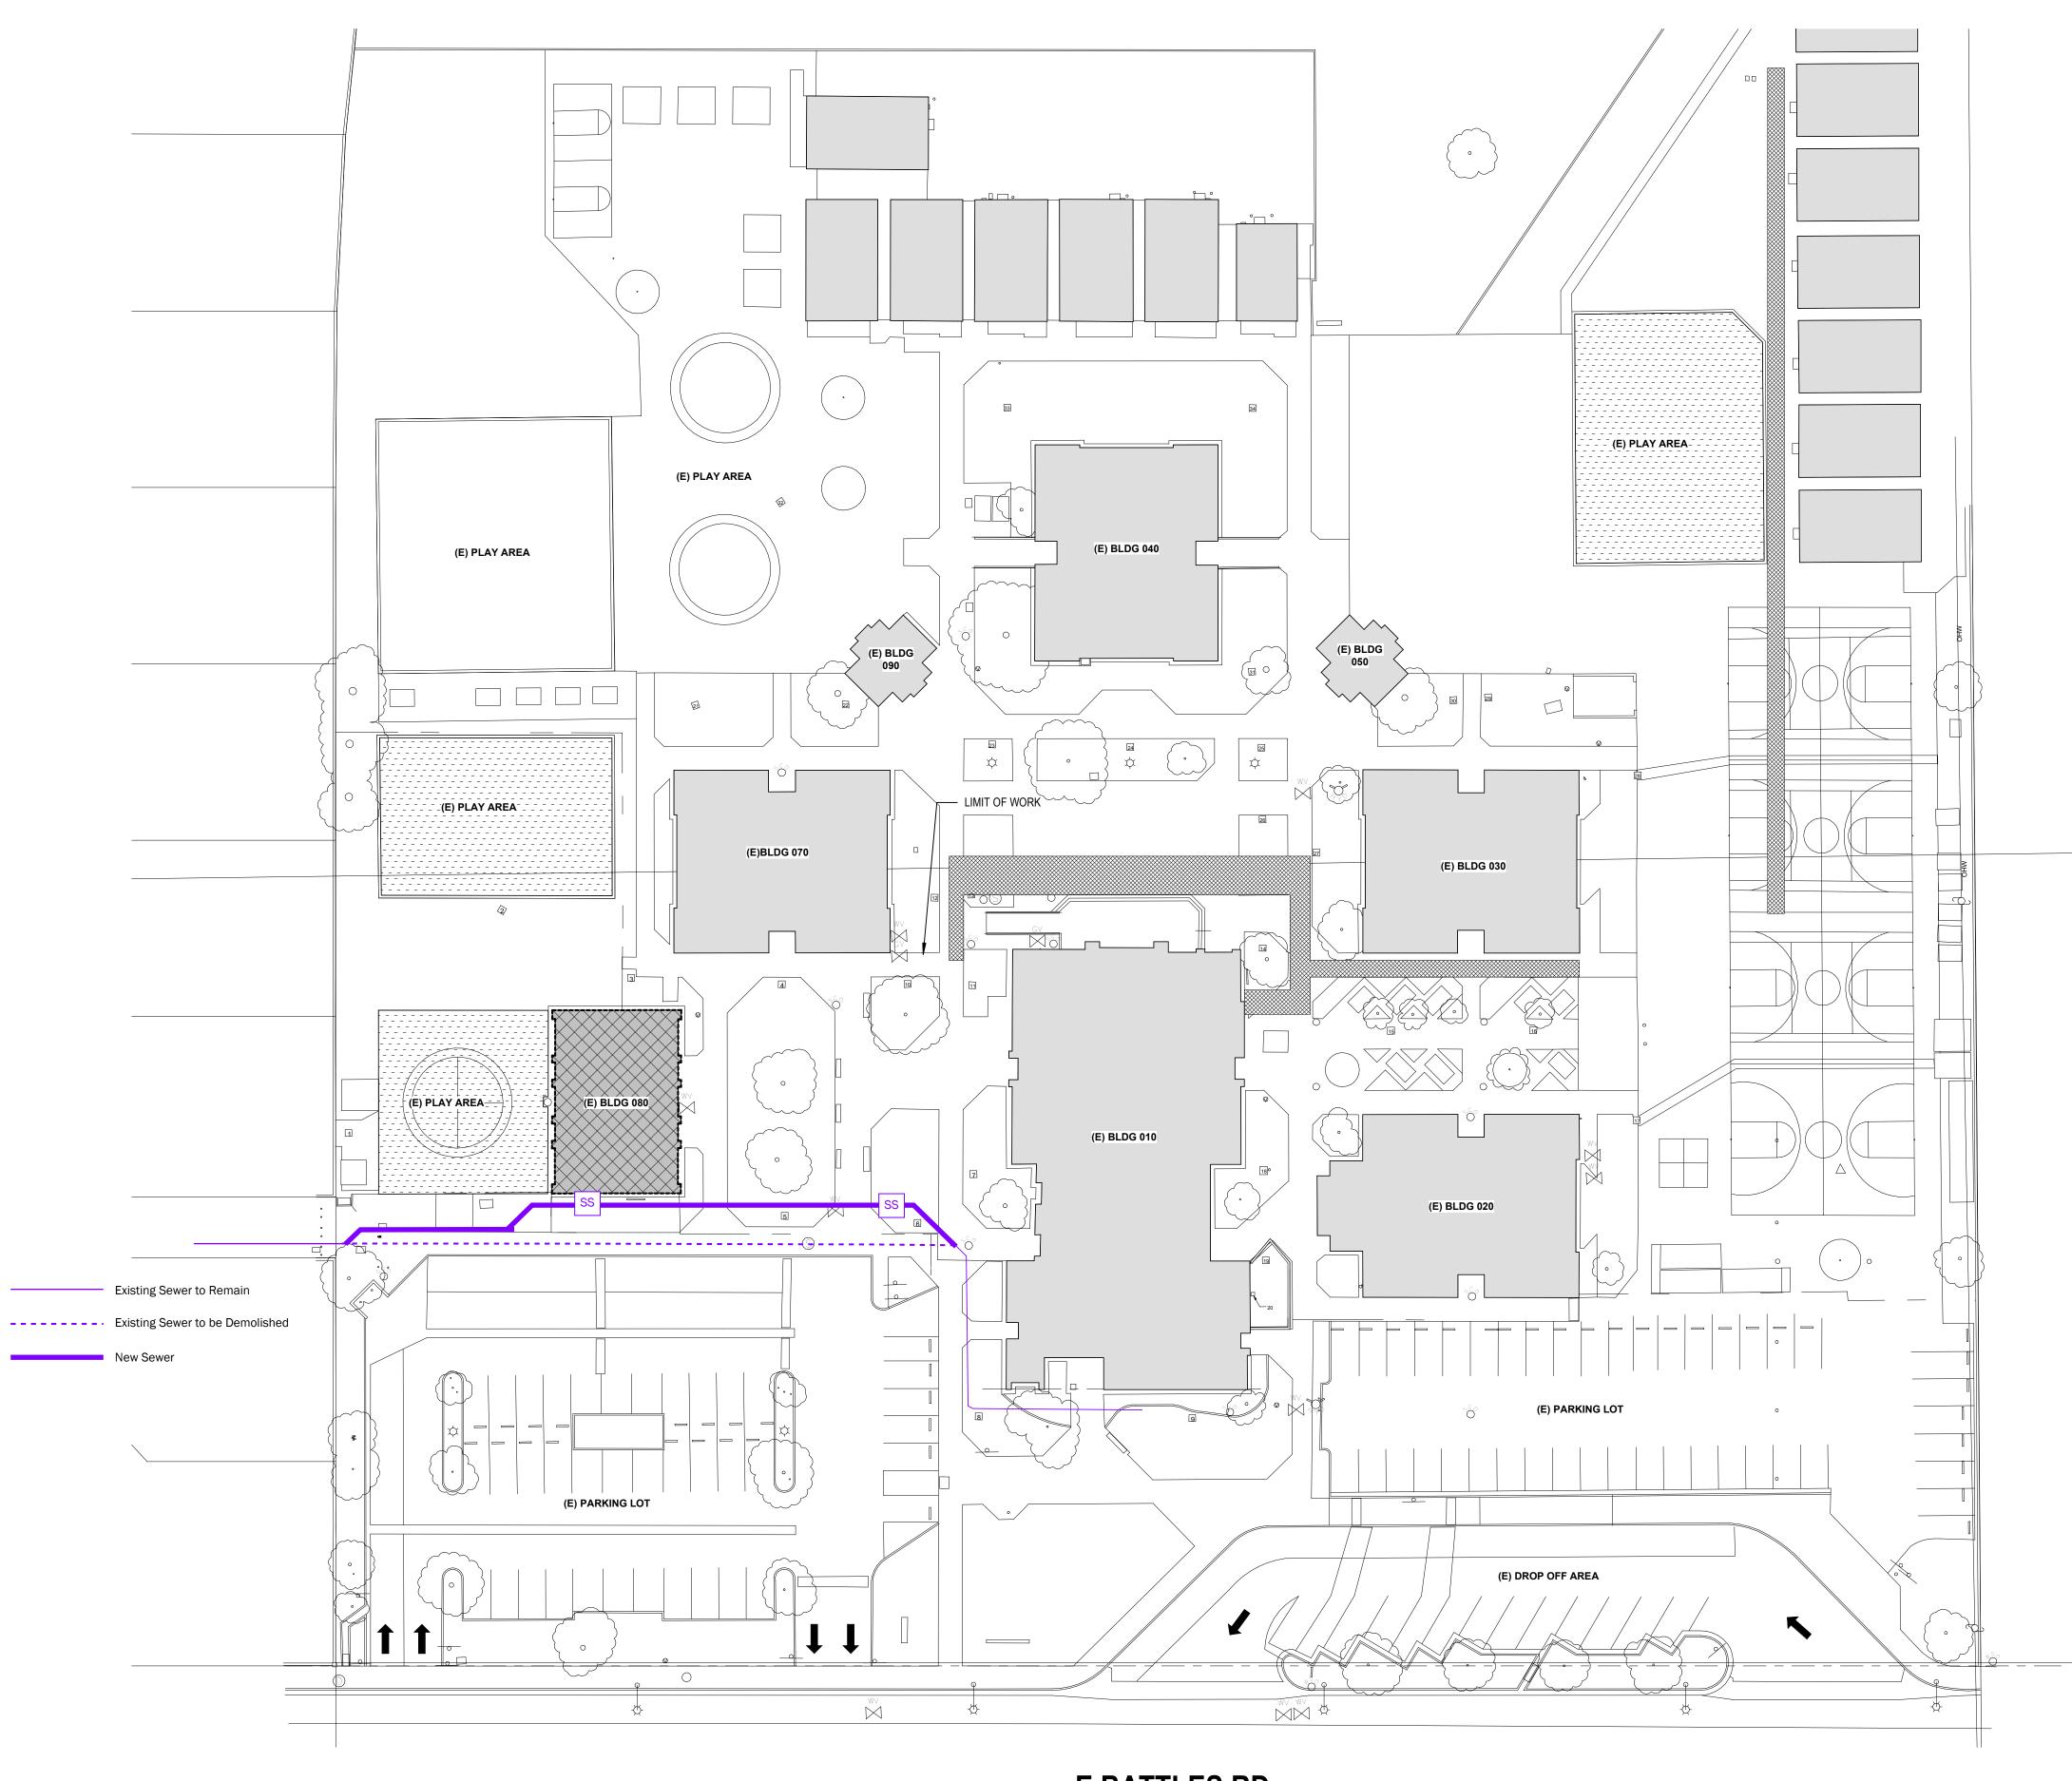

SUMMER 2025 WORK - EXHIBIT SCALE: 1" = 30'-0"

E BATTLES RD

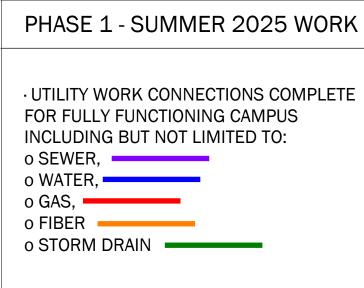


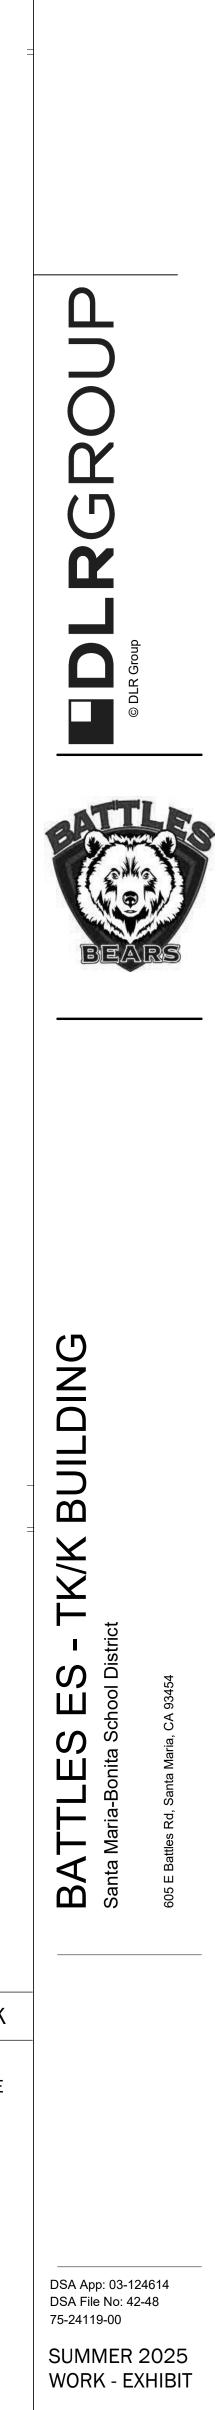



ASK-001C


3/17/2025

· UTILITY WORK CONNECTIONS COMPLETE

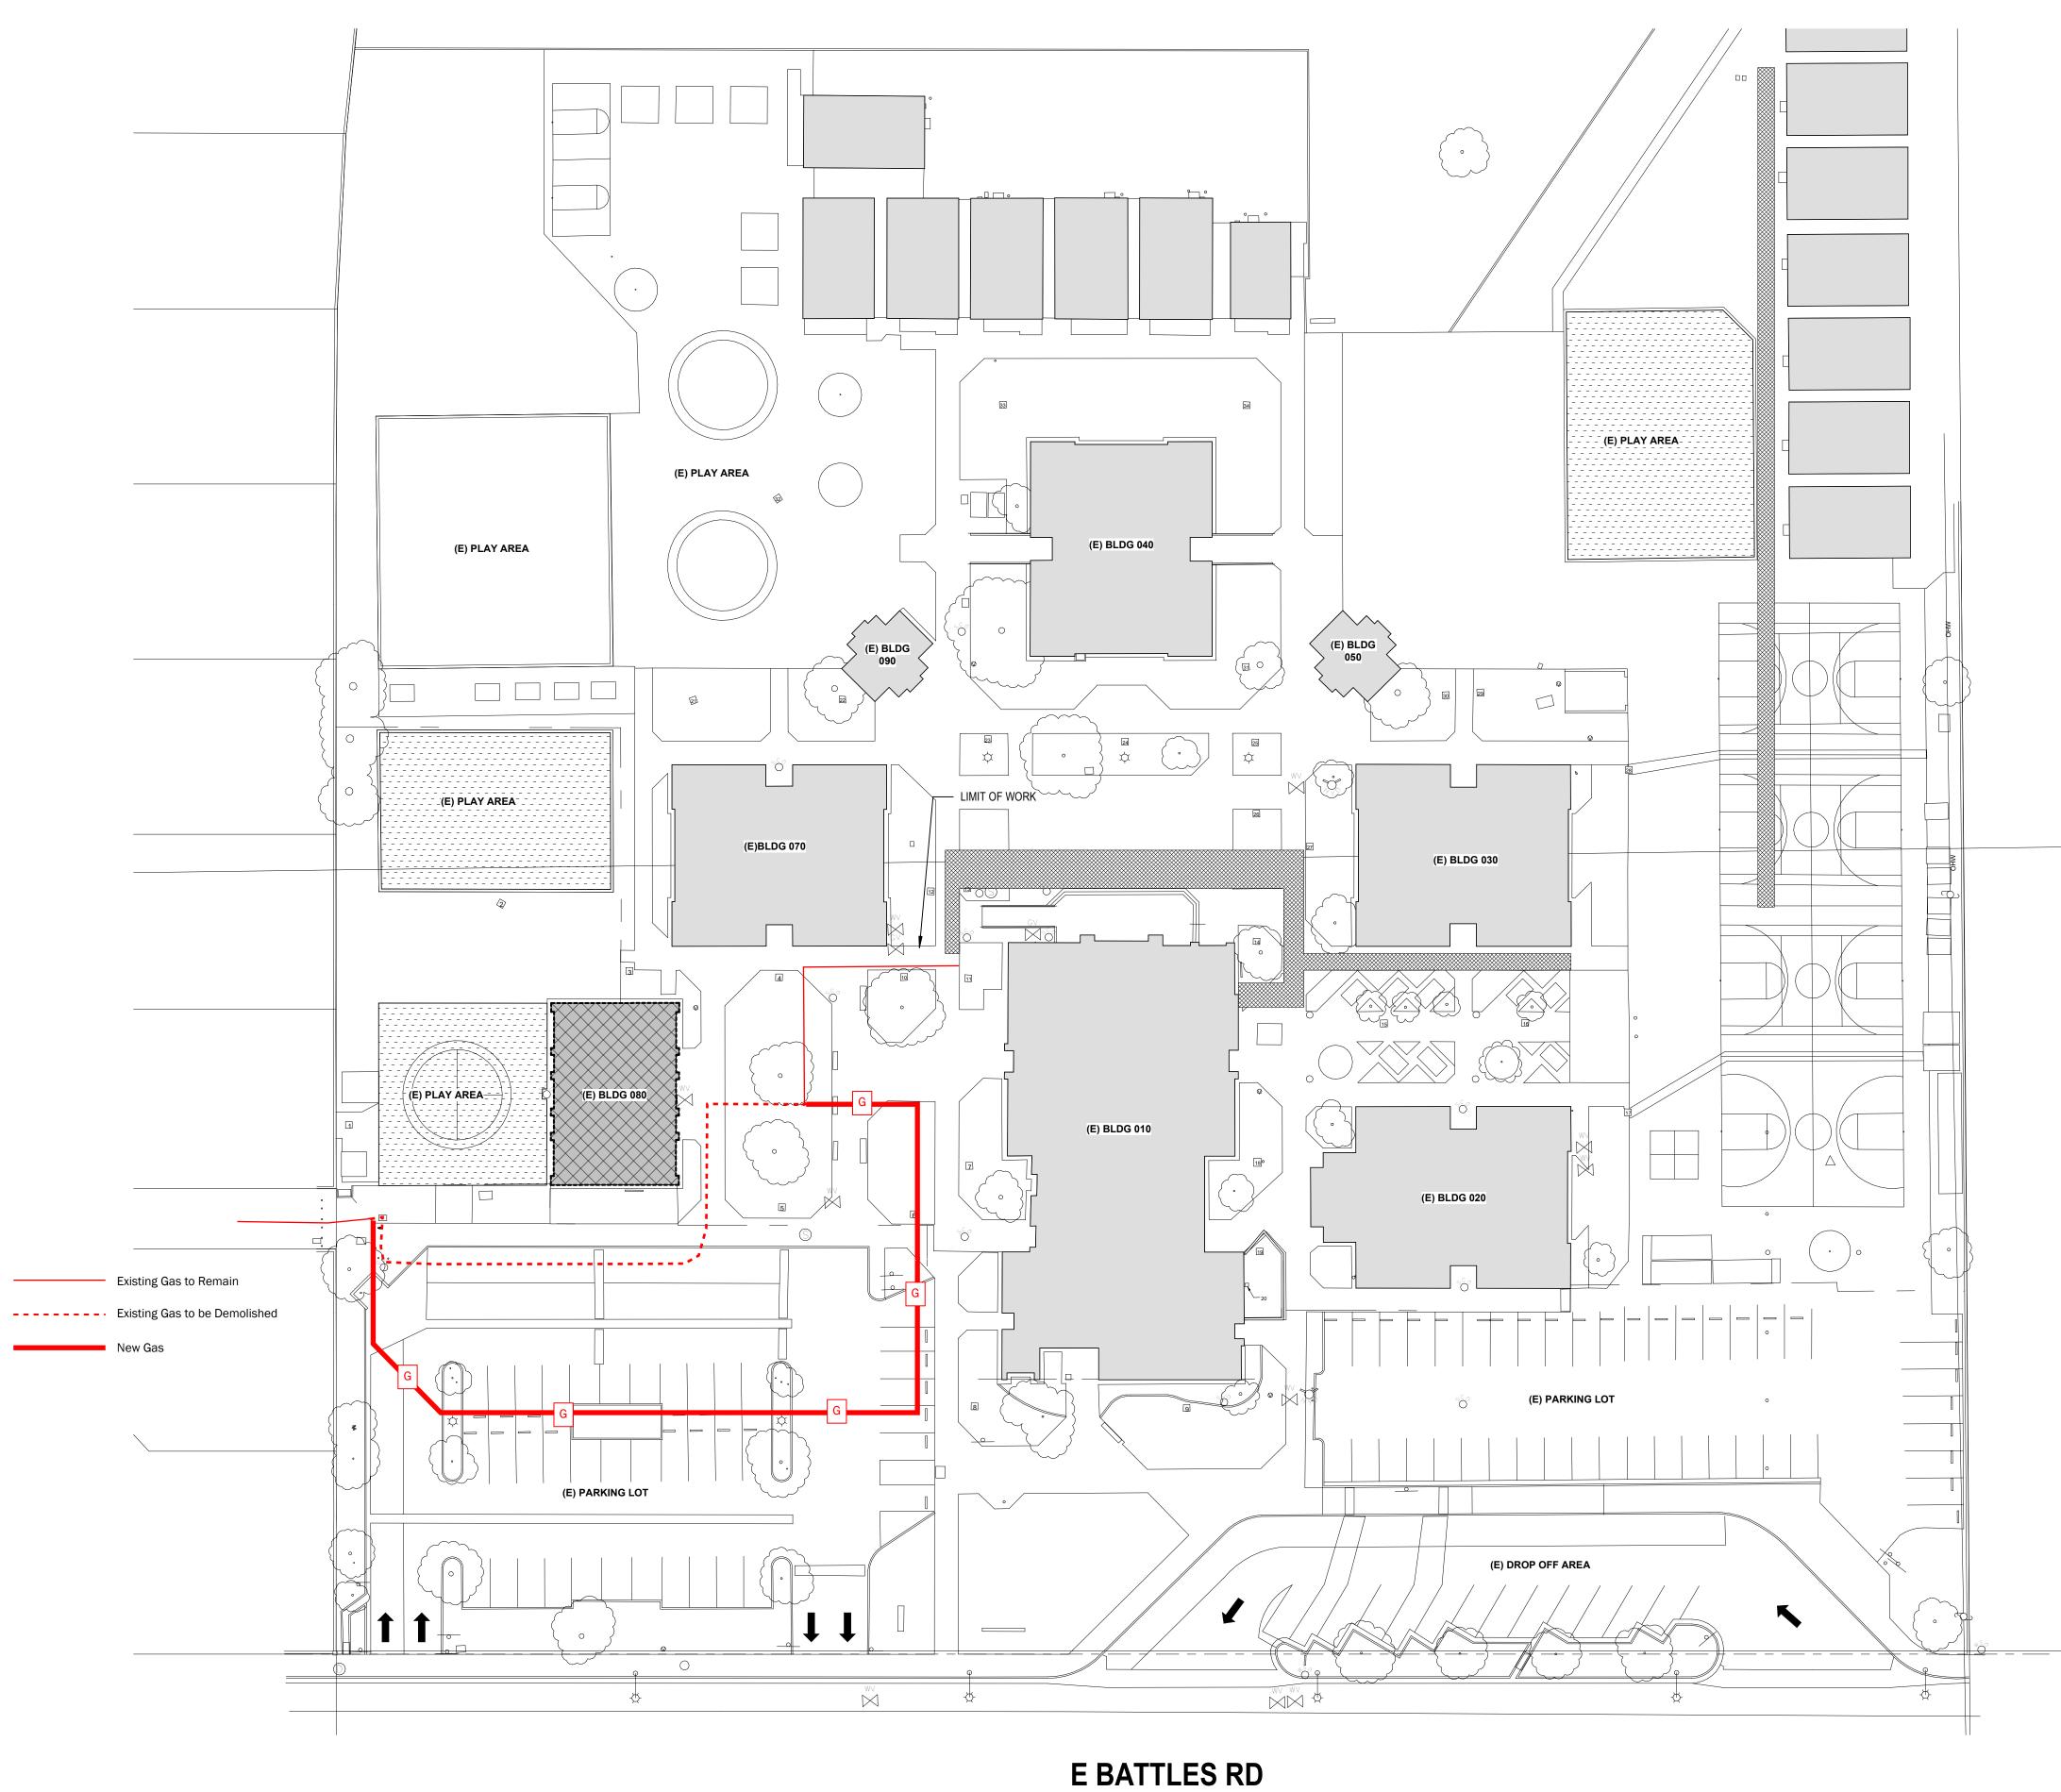

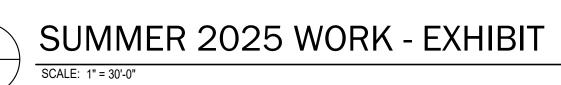


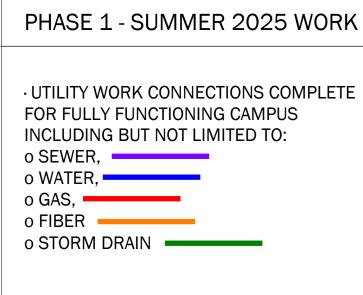

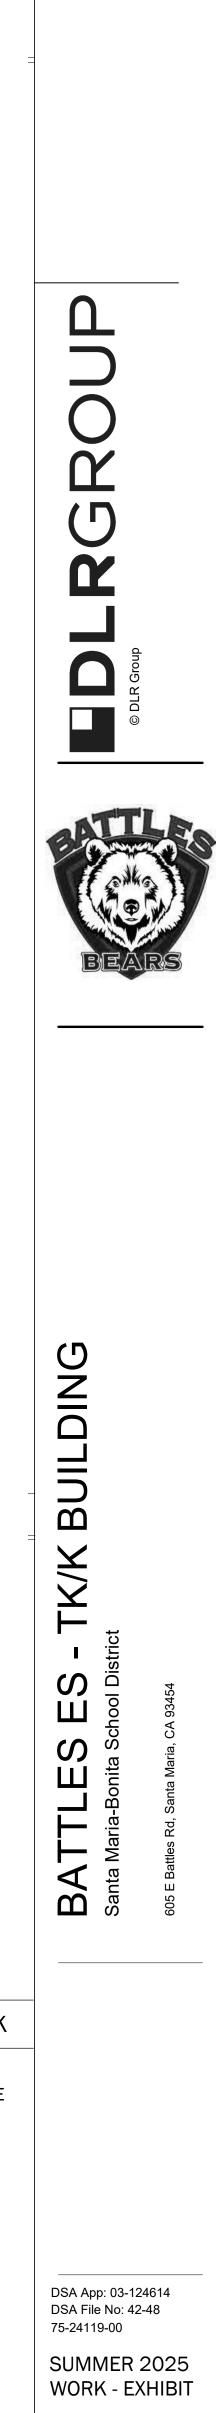


ASK-001D 3/17/2025


Box

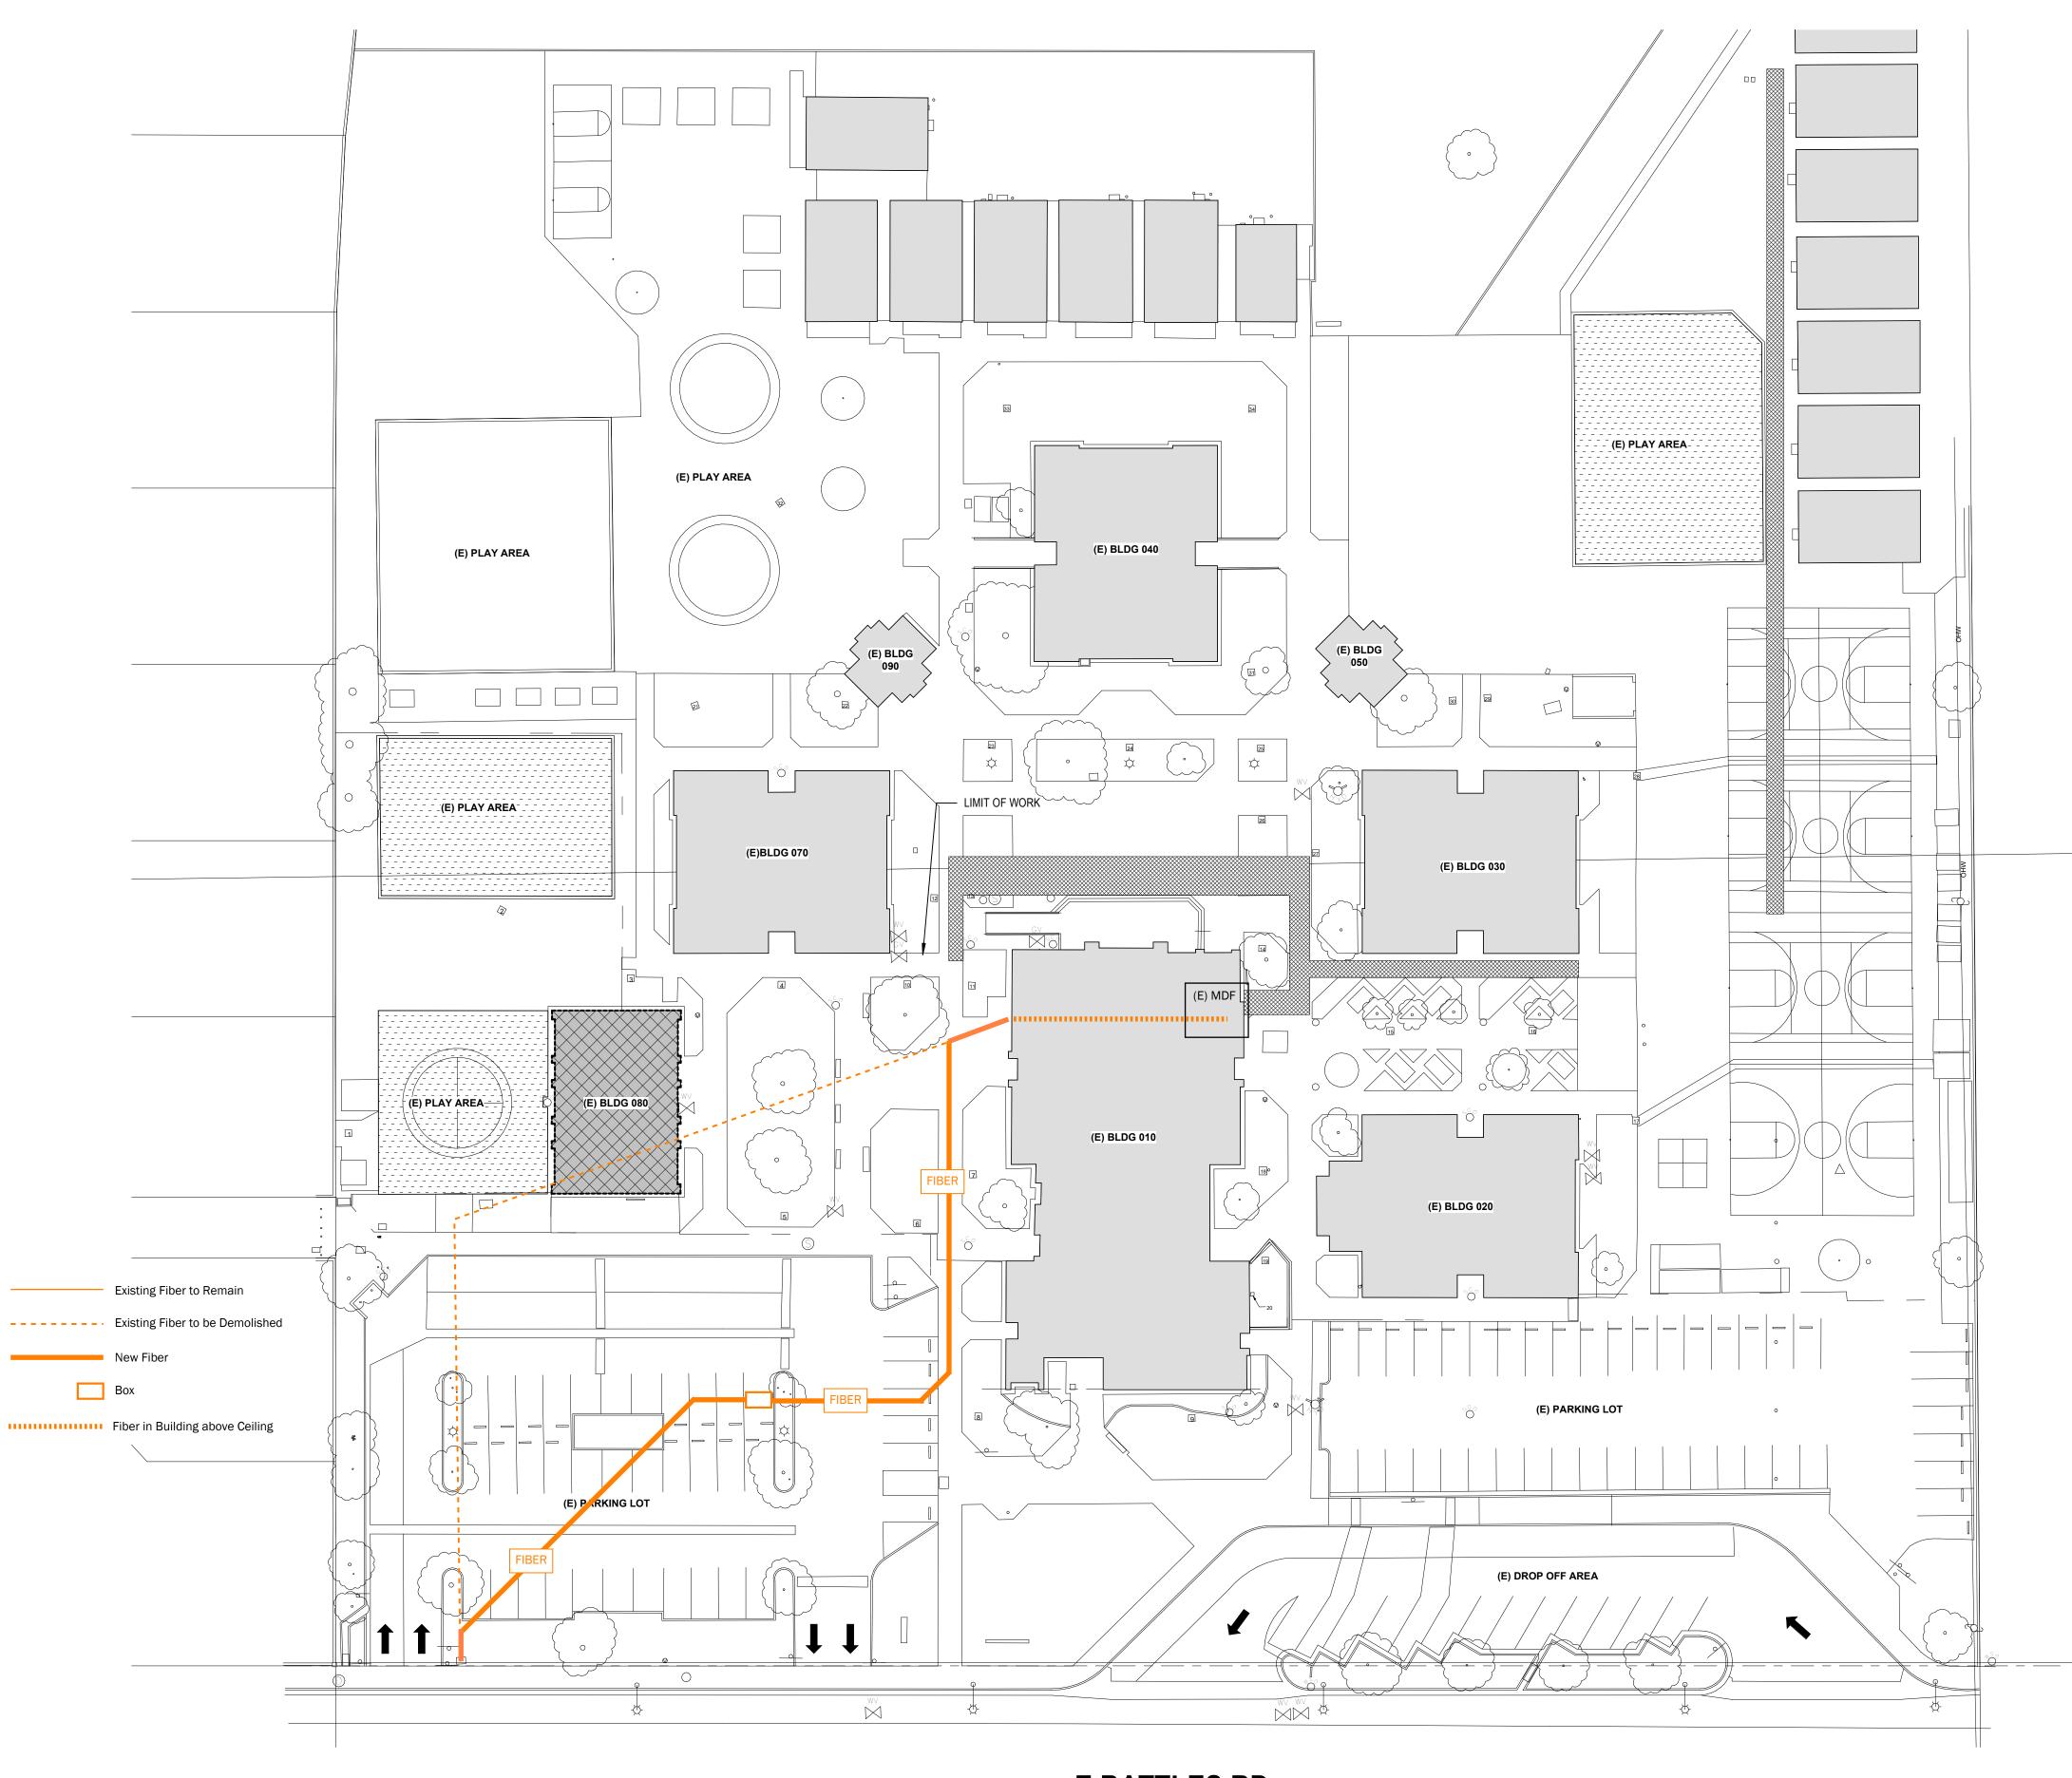

SUMMER 2025 WORK - EXHIBIT SCALE: 1" = 30'-0"


E BATTLES RD

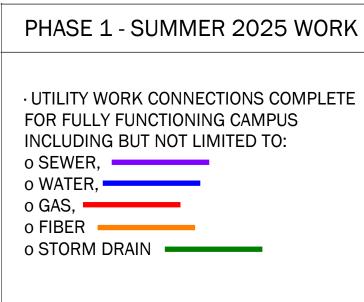

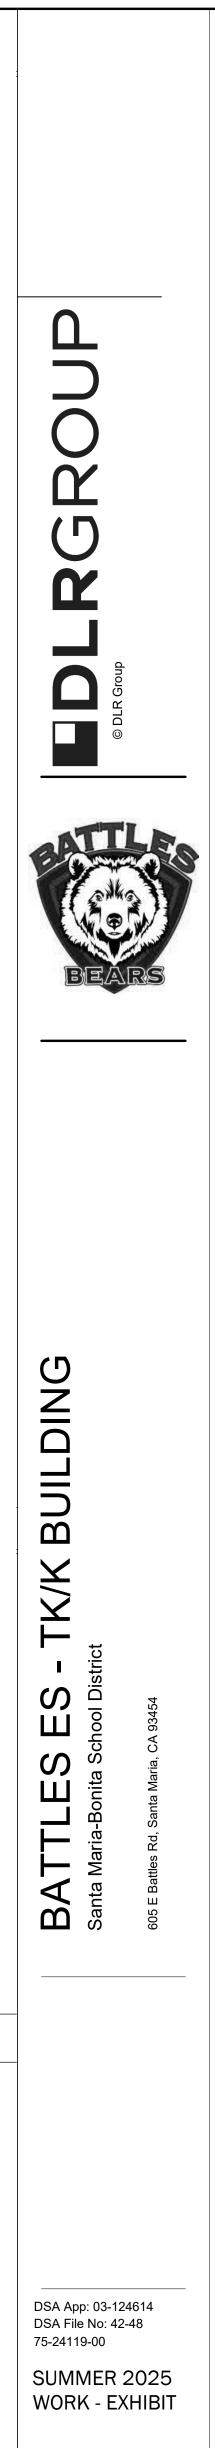



ASK-001E

3/17/2025

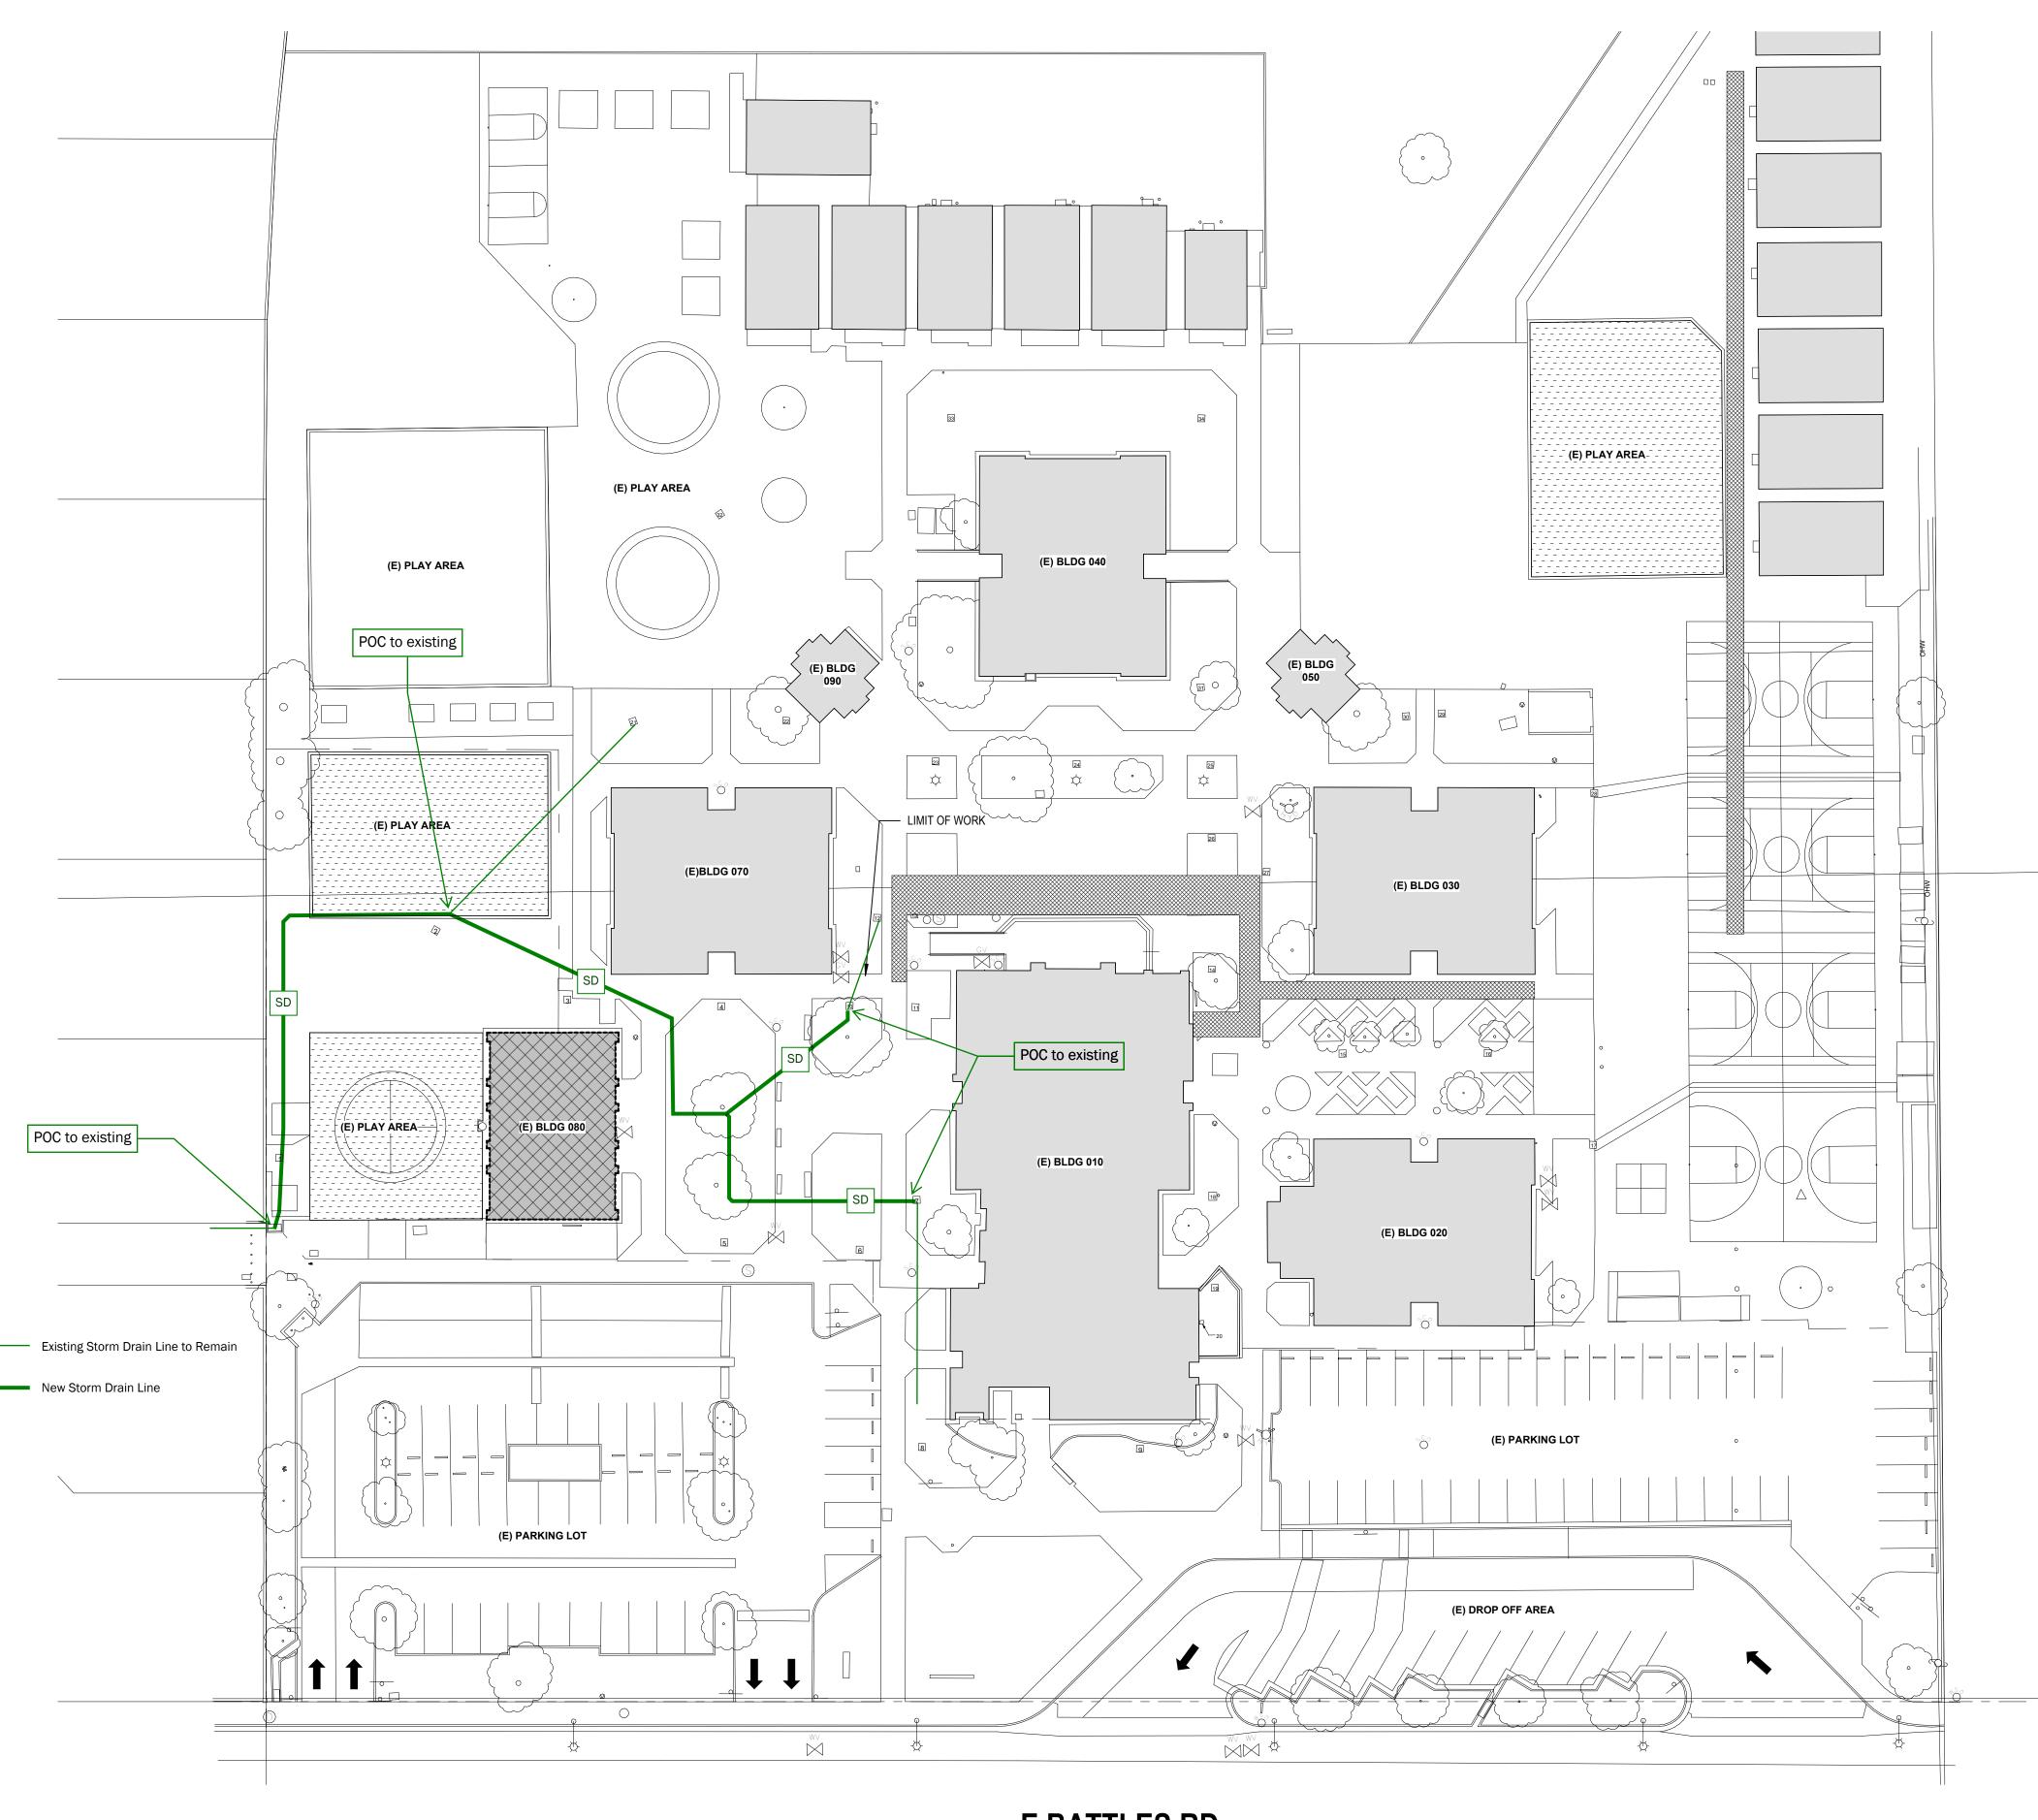


E BATTLES RD

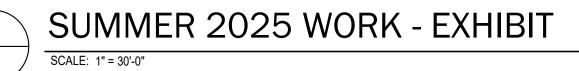

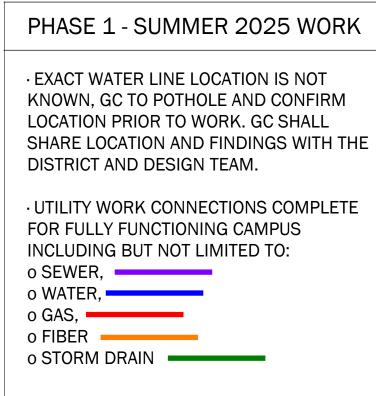





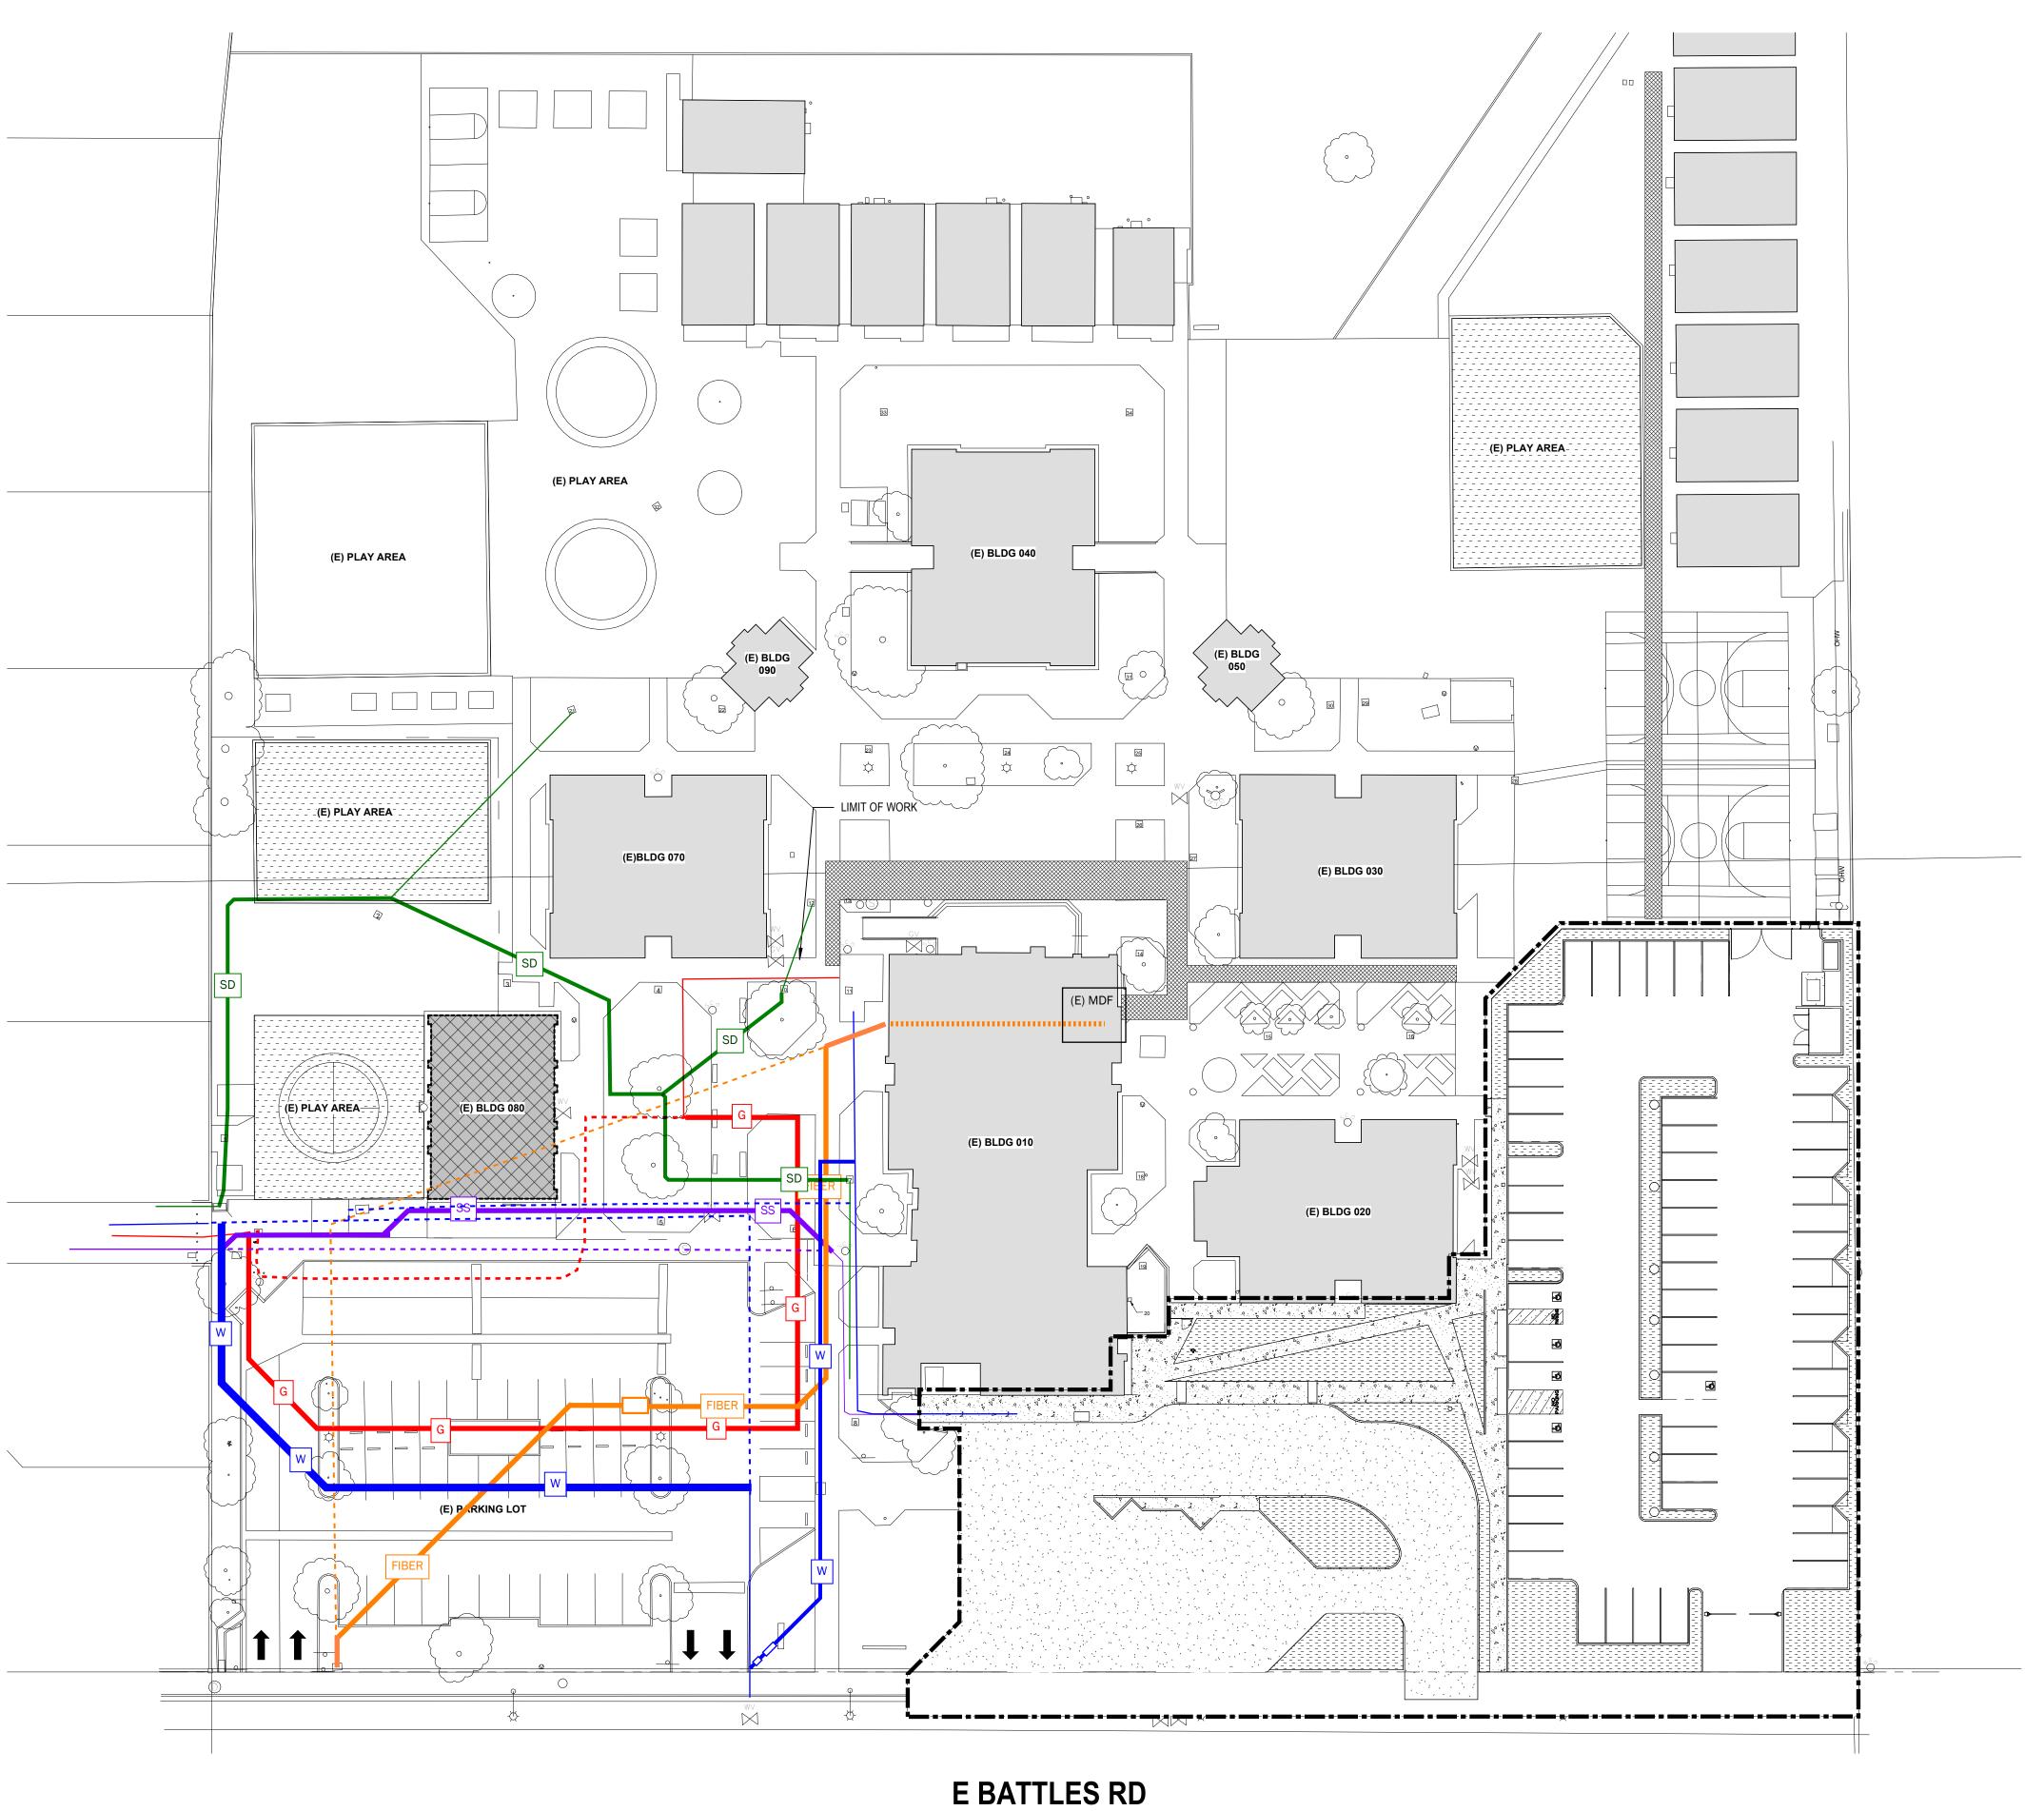

SUMMER 2025 WORK - EXHIBIT SCALE: 1" = 30'-0"

TRUE

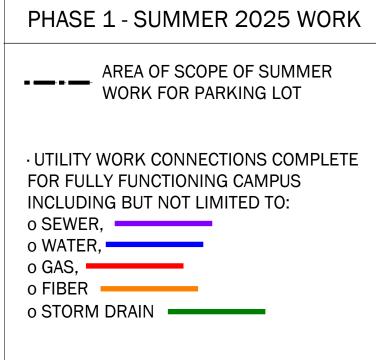

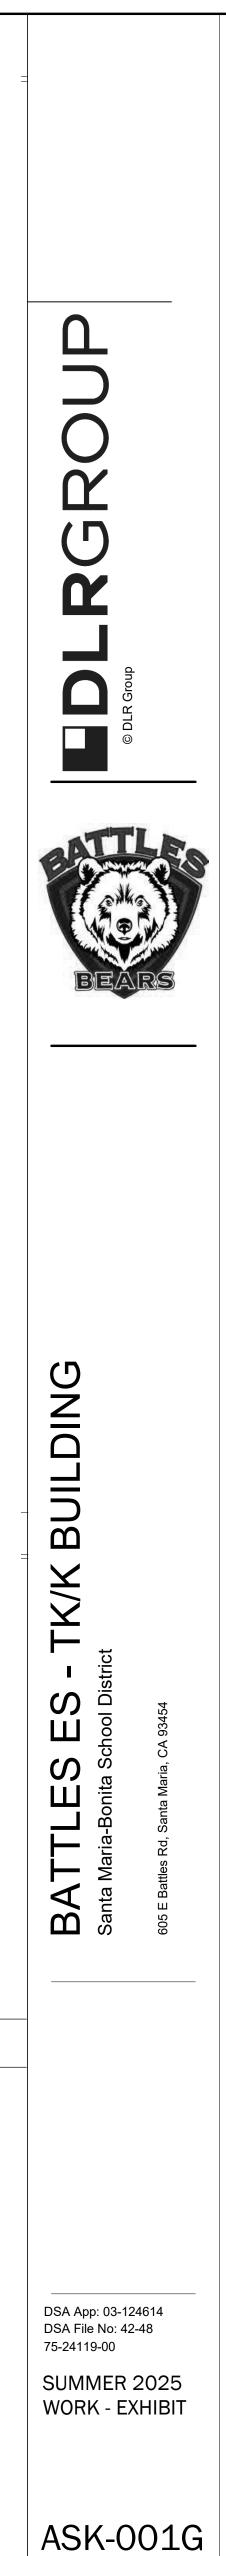

PHASE 1 - SUMMER 2025 WORK

4/14/2025