

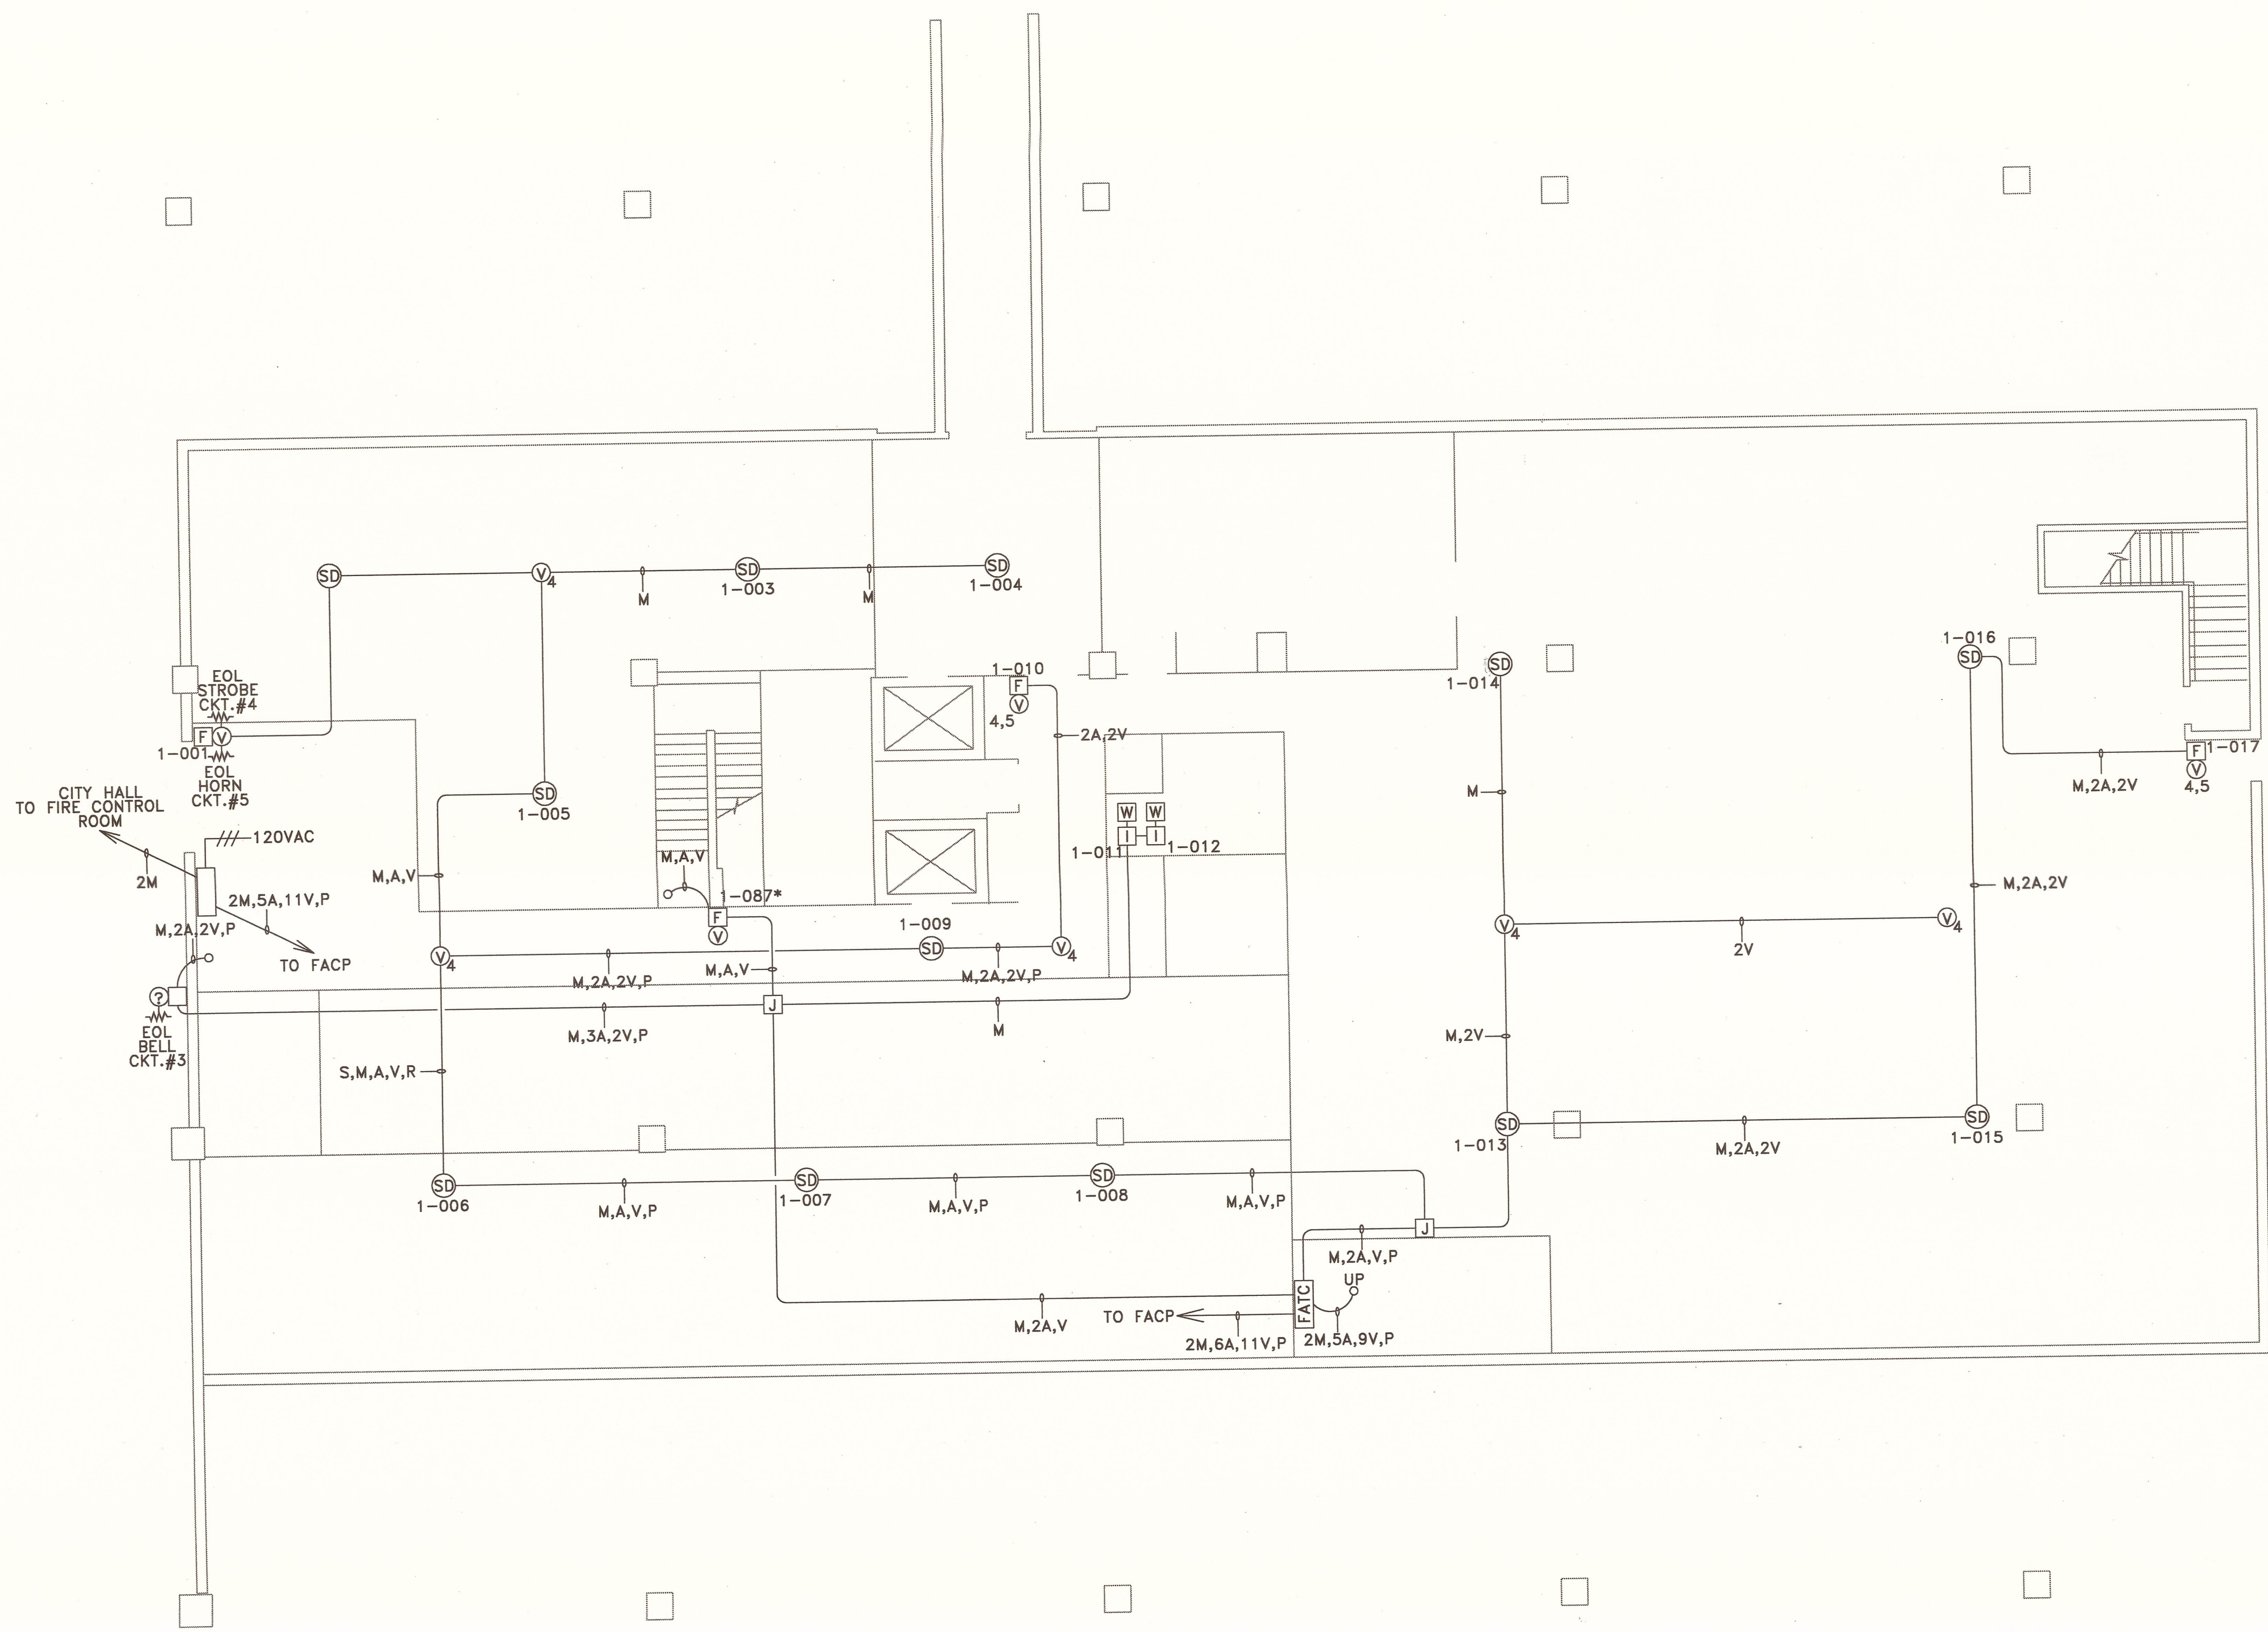
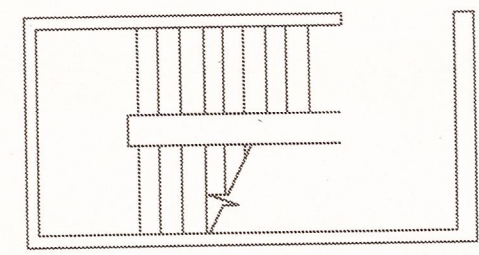


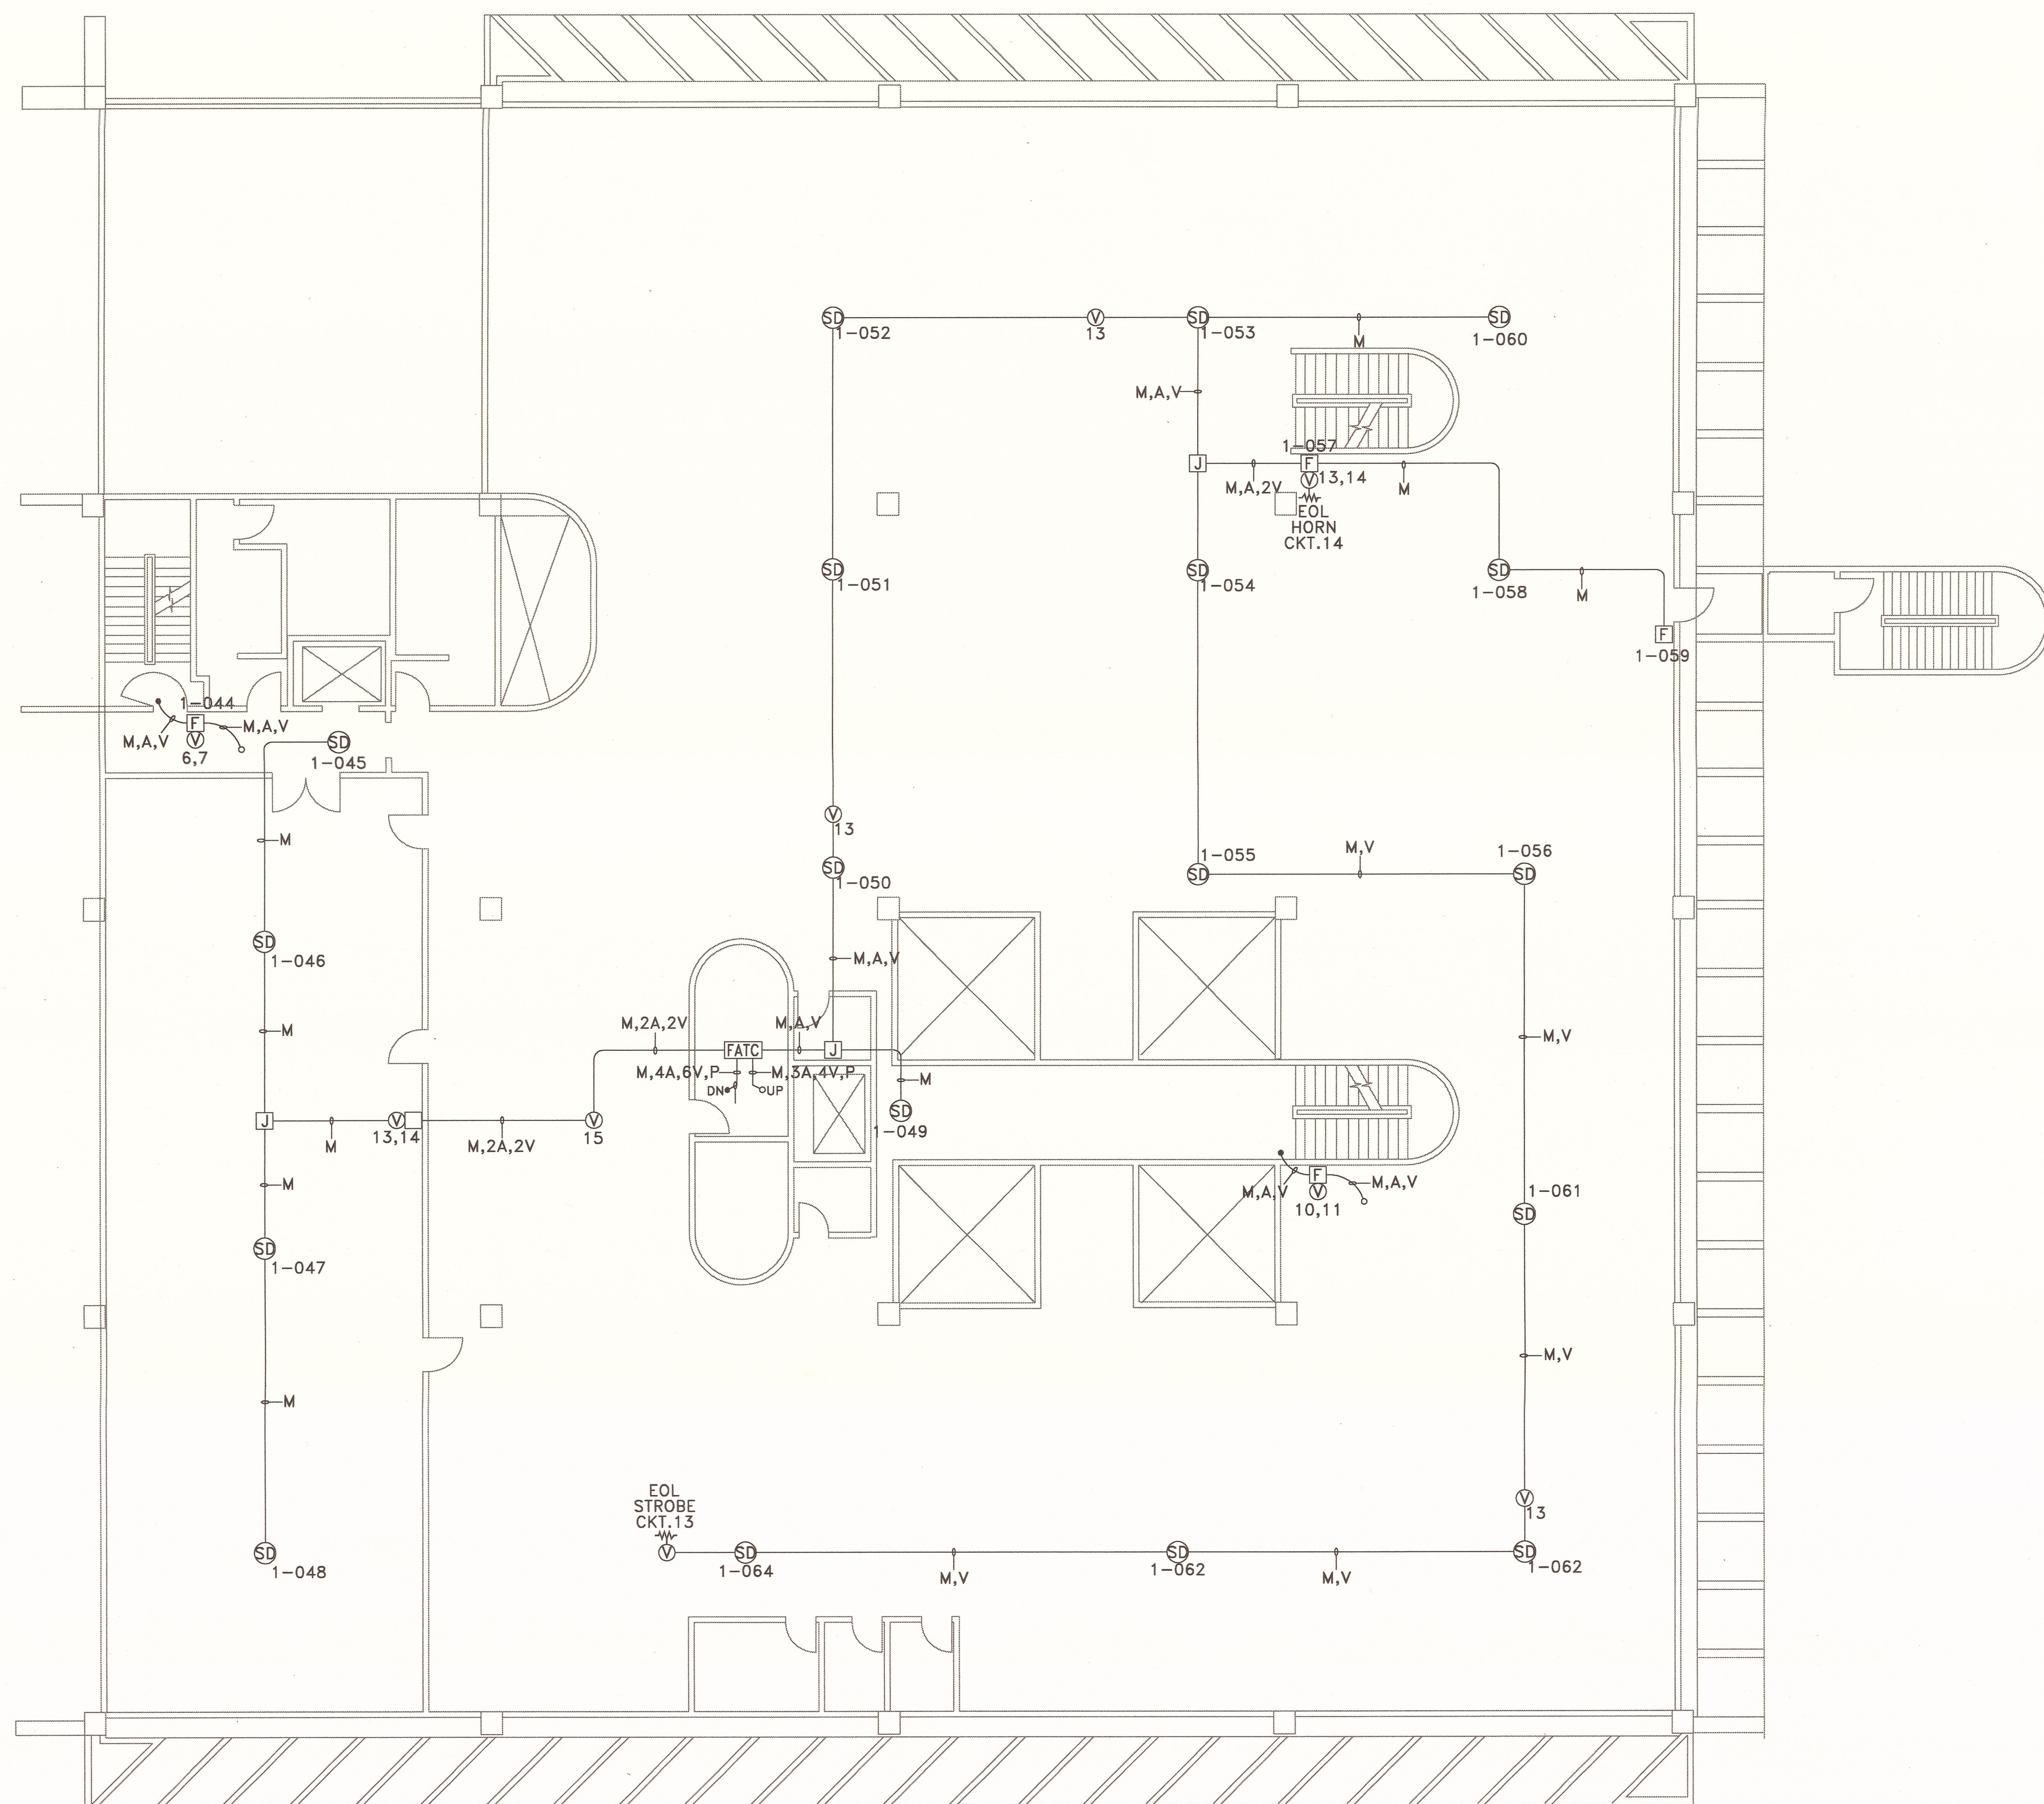


LIBRARY - PARKING LEVEL
SCALE: 1/8" = 1'-0"

Simplex SIMPLEX TIME RECORDER CO. SIMPLEX TIME RECORDER CO. GLENDALE, CA 91201 SALES: (818) 247-1188 SERVICE: (818) 247-2888 FAX: (818) 247-0888			
INITIALS	REVISION DESCRIPTION	DATE	NO.
INGLEWOOD CIVIC CENTER LIBRARY BUILDING ONE MANCHESTER BOULEVARD INGLEWOOD, CALIFORNIA			
PROJECT # 101-008		SITE # 434-920085-24	
CUSTOMER:			
INSTALLER:			
SALESPERSON: LEON GRUZLIN			
ENGINEER: XXX	DATE: 01-12-01		
DRAWN BY: L.C.	DATE: 01-12-01		
APPROVED BY:	DATE:		
SIMPLEX SITE NUMBER: 434-920085-24			
SIMPLEX PROJECT NUMBER: 101-008			
SHEET NUMBER:			

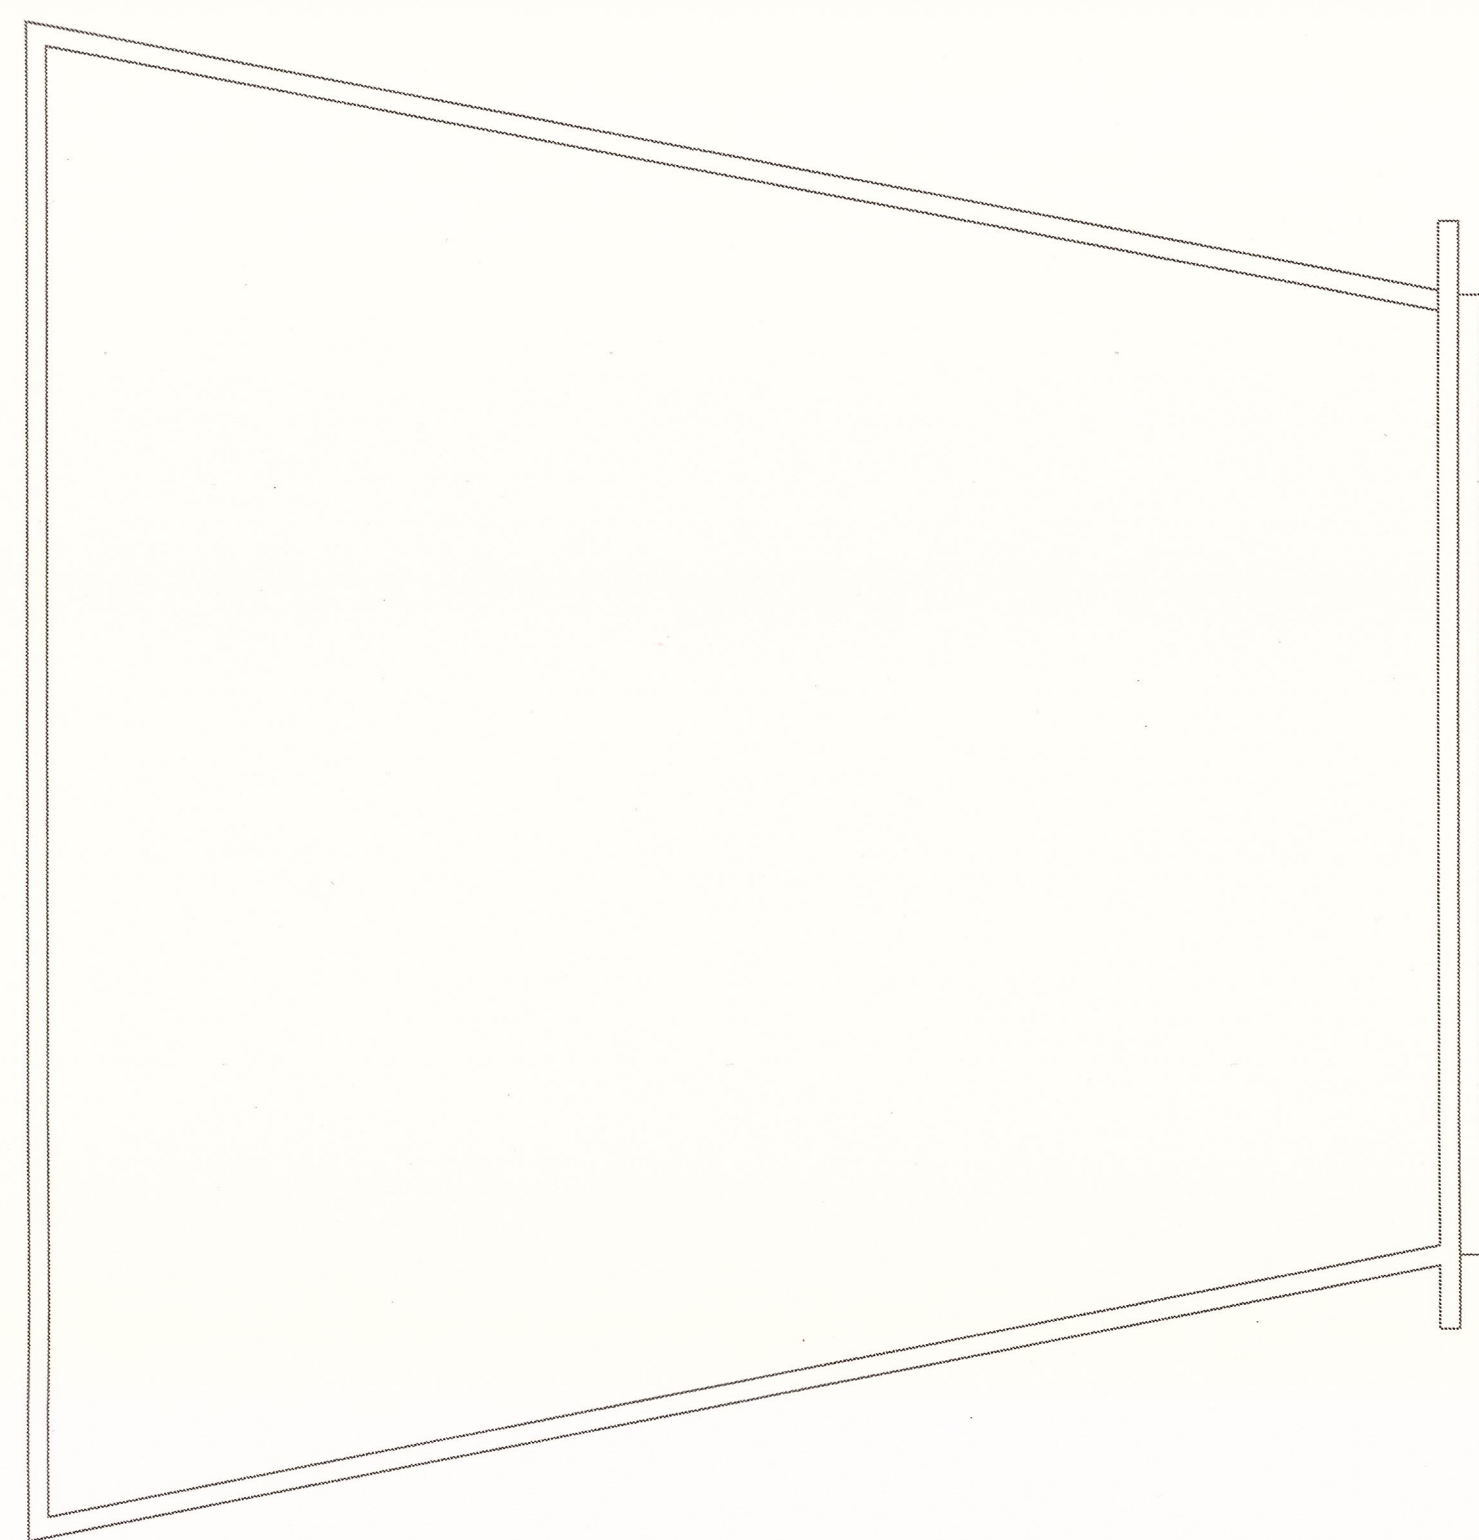

LIBRARY — SECOND FLOOR & LECTURE ROOM ROOF PLANS
SCALE: 1/8" = 1'-0"

Simplex SIMPLEX TIME RECORDER CO. GLENDALE, CA. 91201 SALES: (818) 247-1199 SERVICE: (818) 247-3889 FAX: (818) 247-0888	
INITIALS	
REVISION DESCRIPTION	
DATE	
NO.	
INGLEWOOD CIVIC CENTER LIBRARY BUILDING ONE MANCHESTER BOULEVARD INGLEWOOD, CALIFORNIA	
PROJECT # 101-008 SITE # 434-920085-24	
CUSTOMER:	
INSTALLER:	
SALESPERSON: LEON GRUZLIN	
ENGINEER: XXX	DATE: 01-12-01
DRAWN BY: L.C.	DATE: 01-12-01
APPROVED BY:	DATE:
SIMPLEX SITE NUMBER: 434-920085-24	
SIMPLEX PROJECT NUMBER: 101-008	
SHEET NUMBER:	

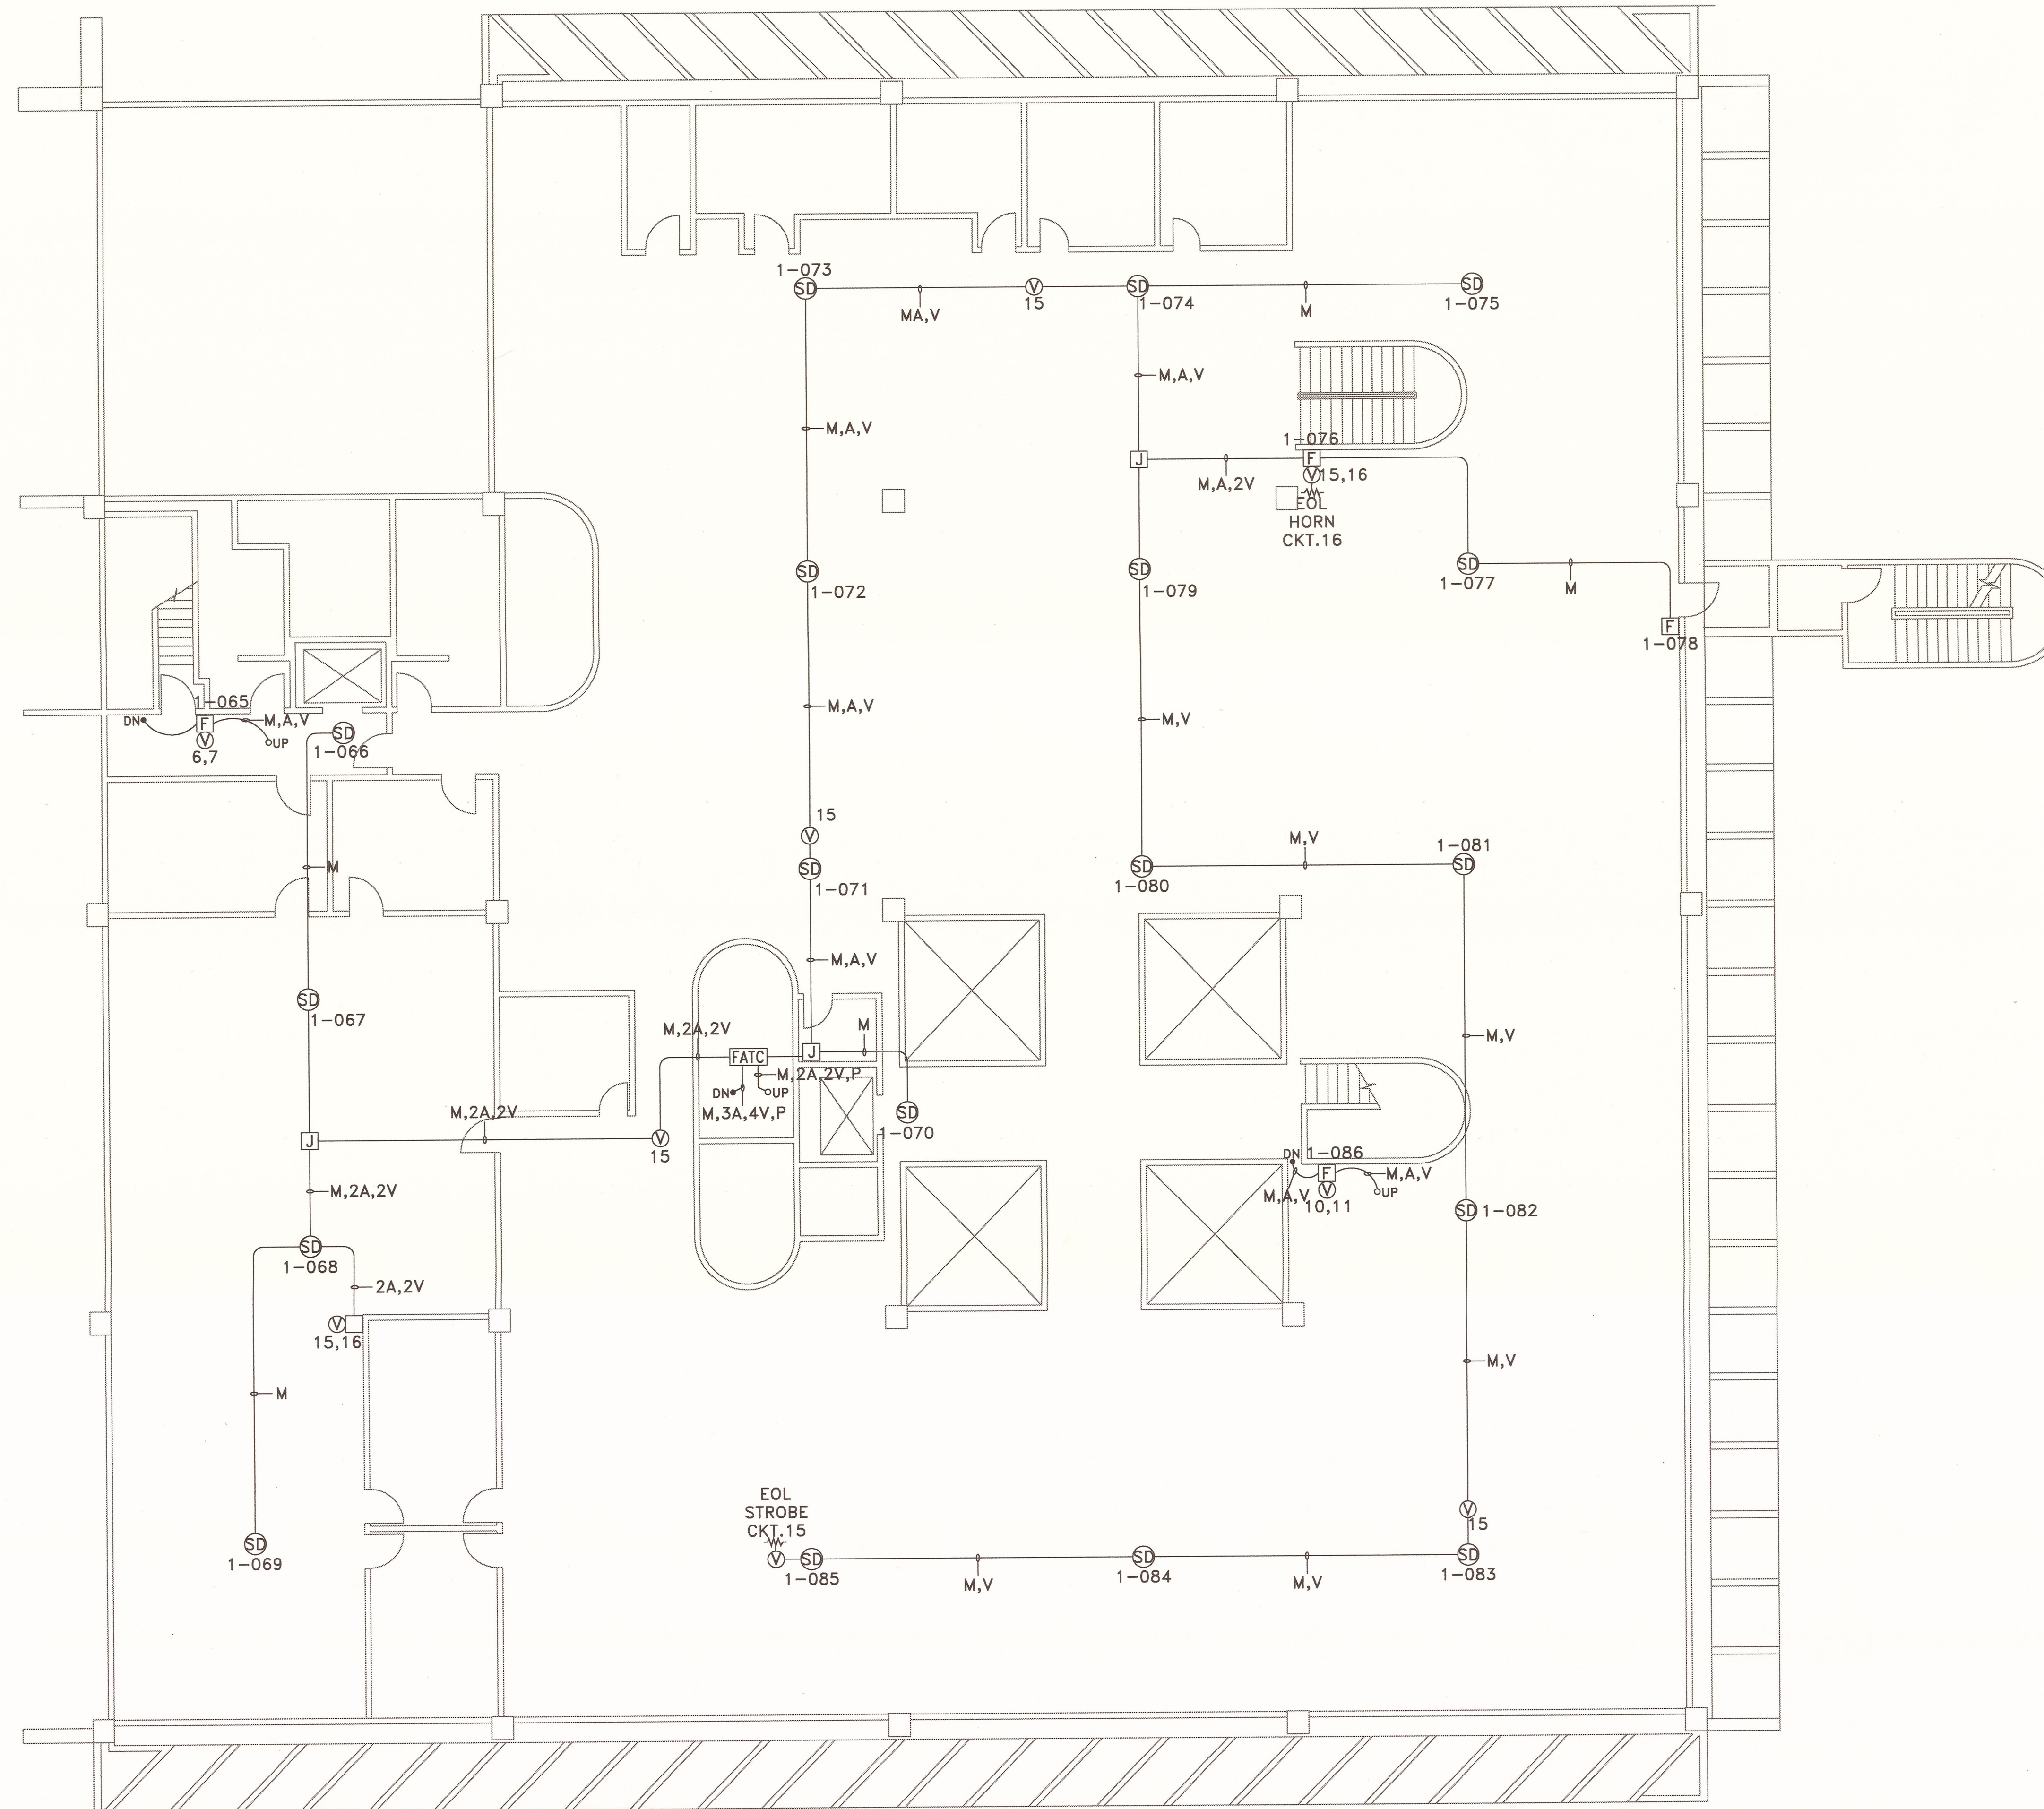

LIBRARY - THIRD FLOOR PLAN
SCALE: 1/8"=1'-0"

Simplex
SIMPLEX TIME RECORDER CO.
SIMPLEX TIME RECORDER CO.
GLENDALE, CA. 91201
SALES: (818) 247-1199
SERVICE: (818) 247-2899
FAX: (818) 247-0999

INITIALS	REVISION DESCRIPTION	DATE	NO.

INGLEWOOD CIVIC CENTER
LIBRARY BUILDING
ONE MANCHESTER BOULEVARD
INGLEWOOD, CALIFORNIA

PROJECT # 101-008 SITE # 434-920085-24

CUSTOMER:

INSTALLER:

SALESPERSON:
LEON GRUZLIN

ENGINEER:
XXX

DATE:
01-12-01

DRAWN BY:
L.C.

DATE:
01-12-01

APPROVED BY: DATE:

SIMPLEX SITE NUMBER:
434-920085-24

SIMPLEX PROJECT NUMBER:
101-008

SHEET NUMBER: