

**COUNTY OF VENTURA
PUBLIC WORKS AGENCY**

Date: December 19, 2025

To: All Prospective Bidders

From: Gregg Strakaluse **Addendum No.1**
Director of Public Works

Subject: **Project Name: E.P. Foster Library Modernization**
Specification No. CP24-01
Bids to be Opened: Thursday, January 8, 2026 is changed to
Wednesday, January 14, 2026

Make the following modifications to the bidding documents for subject project:

SPECIFICATIONS

1. Replace the Project Information Sheet of the Specifications with the attached Addendum No. 1 Project Information Sheet.
 - a. Change the bid opening date from Thursday, January 8, 2026, at 2:00 PM to Wednesday, January 14, 2026, at 2:00 PM.
2. Add the following items to Specification Section 01 00 01 General Requirements - 1.21 Removal & Replacing Existing Items:
 7. The Contractor shall coordinate & work with Library staff to remove books from shelves, pack and organize the books in boxes, and clearly label all boxes.
 8. The Contractor shall coordinate & work with Library staff to pack computers and other equipment for temporary storage.
 9. Upon completion of construction, the Contractor shall coordinate & work with Library staff to unpack the books, computers and other equipment and return them to their original location.
3. Add the following to Specification Section 01 00 01 General Requirements:
 - 1.23 ASBESTOS REMOVAL AND ABATEMENT
 - a. The Contractor shall remove, abate, and properly dispose of all hazardous materials identified in the Asbestos and Lead Survey Report included in Appendix H, in accordance with all applicable federal, state, and local regulations.
4. Add the attached Addendum No. 1 Specification Section 10 21 13.13 Metal Toilet Compartments, to the Technical Specifications.
5. Add the attached Addendum No. 1 Specification Section 10 28 00 Toilet, Bath, and Laundry Accessories, to the Technical Specifications.
6. Add the attached Addendum No. 1 Specification Section 14 24 10 Hydraulic Elevator, to the Technical Specifications.

PLANS

1. Replace Sheet AD-201 – Demo First Floor Plan with the attached Addendum No. 1 plan Sheet AD-201 – Demo First Floor Plan.
Explanation: See cloud revisions. Keynote 217 has been revised to remove the existing carpet & linoleum down to concrete substrate. A new keynote 225 has been added to indicate the removal and replacement of the existing roof hatch and access ladder with new ones in the Topping Room closet.
2. Replace Sheet AD-202 – Demo Second Floor Plan with the attached Addendum No. 1 plan Sheet AD-202 – Demo Second Floor Plan.
Explanation: See cloud revisions. Keynote 217 has been revised to remove the existing carpet & linoleum down to concrete substrate.
3. Replace Sheet AD-206 – Demo RCP- First Floor Plan with the attached Addendum No. 1 plan Sheet AD-206 – Demo RCP- First Floor Plan.
Explanation: See cloud revisions. Demo Ceiling Legend has been updated to show existing ceiling access panel to be removed in the Topping Room closet.
4. Replace Sheet A-101 – Site Plan with the attached Addendum No. 1 plan Sheet A-101 – Site Plan.
Explanation: See cloud revisions. The existing ramp near the Topping Room has been revised to show a new ramp, and keynote number 111 has been added to indicate the new ramp. The enlarged plan indication is noted as 2/A-103 for the new ramp
5. Add Addendum No. 1 plan Sheet A-103 – Ramp Plan Elevation and Details.
Explanation: Added new sheet for the replacement of the existing ramp near the Topping Room.
6. Replace Sheet S-201 – Foundation Plan with the attached Addendum No. 1 plan Sheet S-201 – Foundation Plan.
Explanation: See revision clouds. Two new concrete curbs along gridline C have been added at the Men (106) and Women (105) restrooms.
7. Replace Sheet E-100 – General Notes with the attached Addendum No. 1 plan Sheet E-100 – General Notes.
Explanation: See revision clouds. Electrical Drawing Sheet Index updated with new added sheets; E-406 First Floor Lighting Controls Plan, E-407 Second Floor Lighting Controls Plan, E-408 Lighting Control Wiring Diagrams, SCE Drawing 1 of 2, SCE Drawing 2 of 2.
8. Replace Sheet E-300 – First Floor Demolition Power Plan with the attached Addendum No. 1 plan Sheet E-300 – First Floor Demolition Power Plan.
Explanation: See revision clouds. Added project area line work to the drawing for Friends of Library (FOL) space and Hallway area.
9. Replace Sheet E-402 – First Floor Lighting Plan with the attached Addendum No. 1 plan Sheet E-402 – First Floor Lighting Plan.
Explanation: See revision clouds. Added Wall Wash Light fixtures to replace existing. Added Light Fixture Type “WW”
10. Replace Sheet E-403 – Second Floor Lighting Plan with the attached Addendum No. 1 plan Sheet E-403 – Second Floor Lighting Plan.
Explanation: See revision clouds. Added Wall Wash Light fixtures to replace existing. Added Light Fixture Type “WW”
11. Replace Sheet E-404 –Lighting Fixture Schedule with the attached Addendum No. 1 plan Sheet E-404 –Lighting Fixture Schedule.
Explanation: See revision clouds. Added Light Fixture Type “WW” to Lighting Fixture Schedule

12. Replace Sheet E-405 –Light Fixture Data Sheets with the attached Addendum No. 1 plan Sheet E-405 –Light Fixture Data Sheets
Explanation: See revision clouds. Added Light Fixture Type “WW” Data Sheet detail 5.
13. Add Addendum No. 1 plan Sheet E-406 – First Floor Lighting Controls Plan.
Explanation: Added new sheet showing Lighting Controls.
14. Add Addendum No. 1 plan Sheet E-407 – Second Floor Lighting Controls Plan.
Explanation: Added new sheet showing Lighting Controls.
15. Add Addendum No. 1 plan Sheet E-408 –Lighting Controls Wiring Diagrams.
Explanation: Added new sheet showing Lighting Controls Wiring Diagrams.
16. Add Addendum No. 1 SCE plan Sheet 1 of 2 Design/Drwg. No. 1889010_0.01
Explanation: SCE sheet showing connection details to E Main St vault.
17. Add Addendum No. 1 SCE plan Sheet 2 of 2 Design/Drwg. No. 1889010_0.01

RESPONSES TO RFI'S

1. *Question: What is the scope of work for the fire alarm?*

Reply: Existing fire alarm system is to be fully removed. New fire alarm is a deferred approval and shall be a Bay Alarm system.

2. *Question: What is the scope of Public Address Systems?*


Reply: Refer to Section 27 51 16 Public Address Systems, which is a performance specification. New PA system shall be a deferred approval and shall be added to the list on plan sheet G-001

3. *Question: How many paging zones are there to be? Example... 1 per floor, 1 per room, 1 per speaker etc.? Please advise*

Reply: For bidding purposes, include (4) zones per floor.

Acknowledgment of this addendum is required on the Bonfire website when submitting your bid. Failure to do so may result in the disqualification of your bid.

Approved: _____


Gregg Strakaluse, Director

12/18/25
Date Approved

PROJECT INFORMATION

FOR

VENTURA COUNTY E.P. FOSTER LIBRARY MODERNIZATION

**LOCATED IN
VENTURA COUNTY, CALIFORNIA**

**MAKE BID GUARANTEE TO COUNTY OF VENTURA
USE FORM PROVIDED (SEE PARAGRAPH 9, INSTRUCTION TO BIDDERS).**

SPECIFICATION NO. CP26-12 INCLUDING 113 SHEETS OF PLANS

BIDS WILL BE RECEIVED ELECTRONICALLY UNTIL January 14, 2026 AT 2:00 P.M.

AGENCY IS ALLOWED 60 DAYS TO AWARD A CONTRACT (SEE SECTION 1-7.3).

**THE STARTING DATE OF CONTRACT WILL BE 28 CALENDAR DAYS AFTER AWARD OF
CONTRACT (SEE SECTION 6-3.2.1).**

COMPLETION TIME IS 215 WORKING DAYS (SEE SECTION 6-3).

LIQUIDATED DAMAGES ARE \$ 2,650 PER CALENDAR DAY (SEE SECTION 6-9).

CONTRACTOR'S LICENSE CLASSIFICATION REQUIRED IS CLASS B.

LIABILITY INSURANCE CLASS REQUIRED PER SECTION 5-4.2.2 IS L-C.

**NON-MANDATORY PREBID MEETING: 2:00 P.M on Wednesday, December 10, 2025 at
the project site: 651 E Main Street, Ventura, CA 93001 (Section 01 00 01)**

SECTION 10 21 13.13
METAL TOILET COMPARTMENTS

PART 1 - GENERAL**1.01 SECTION INCLUDES**

- A. Metal toilet compartments.
- B. Urinal screens.

1.02 RELATED REQUIREMENTS

- A. Section 061000 - Rough Carpentry: Blocking and supports.
- B. Section 102800 - Toilet, Bath, and Laundry Accessories.

1.03 REFERENCE STANDARDS

- A. ASTM A653/A653M - Standard Specification for Steel Sheet, Zinc-Coated (Galvanized) or Zinc-Iron Alloy-Coated (Galvannealed) by the Hot-Dip Process; 2023.
- B. ASTM A666/A666M - Standard Specification for Annealed or Cold-Worked Austenitic Stainless Steel Sheet, Strip, Plate, and Flat Bar; 2024.

1.04 ADMINISTRATIVE REQUIREMENTS

- A. Coordination: Coordinate the work with placement of support framing and anchors in walls and ceilings.

1.05 SUBMITTALS

- A. See Section 013000 - Administrative Requirements, for submittal procedures.
- B. Shop Drawings: Indicate partition plan, elevation views, dimensions, details of wall and floor supports, door swings.
- C. Product Data: Provide data on panel construction, hardware, and accessories.
- D. Manufacturer's Installation Instructions: Indicate special procedures

PART 2 - PRODUCTS**2.01 MANUFACTURERS**

- A. Metal Toilet Compartments:
 - 1. ASI Accurate Partitions; Stainless Steel: www.asi-accuratepartitions.com/sle.
 - 2. ASI Global Partitions; Stainless Steel: www.asi-globalpartitions.com/sle.
 - 3. General Partitions Mfg. Corp: www.generalpartitions.com/sle.
 - 4. Substitutions: Section 016000 - Product Requirements.

2.02 MATERIALS

- A. Steel Sheet: Hot-dipped galvanized steel sheet, ASTM A653/A653M, with G90/Z275 coating.
- B. Stainless Steel Sheet: ASTM A666/A666M, Type 304.

2.03 COMPONENTS

- A. Toilet Compartments: Stainless steel, floor-mounted headrail-braced.
- B. Doors, Panels, and Pilasters: Sheet steel faces, pressure bonded to sound-deadening core, corners made with corner clips or mitered, welded, and ground smooth.
- C. Door and Panel Dimensions:
 - 1. Thickness: 1 inch (25 mm).
 - 2. Door Width: 24 inches (610 mm).
 - 3. Door Width for Handicapped Use: 36 inch (915 mm) , out-swinging.
 - 4. Height: 63-1/2 inches (1613 mm).
- D. Pilasters: 1-1/4 inch (32 mm) thick, of sizes required to suit compartment width and spacing.

- E. Urinal Screens: Wall mounted with continuous panel brackets.

2.04 ACCESSORIES

- A. Pilaster Shoes: Formed ASTM A666 Type 304 stainless steel with No.4 finish, 3 inches (175 mm) high, concealing floor fastenings.
 - 1. Provide adjustment for floor variations with screw jack through steel saddles integral with pilaster.
- B. Head Rails: Hollow stainless steel tube, 1 by 1-5/8 inches (25 by 41 mm) in size, with anti-grip strips and cast socket wall brackets.
- C. Brackets: Satin stainless steel.
- D. Attachments, Screws, and Bolts: Stainless steel, tamper-proof type.
- E. Hardware: Satin stainless steel:
 - 1. Pivot hinges, gravity type, adjustable for door close positioning; two per door.
 - 2. Thumb turn or sliding door latch with exterior emergency access feature.
 - 3. Door strike and keeper with rubber bumper; mounted on pilaster in alignment with door latch.
 - 4. Coat hook with rubber bumper; one per compartment, mounted on door.
 - 5. Provide door pull for outswinging doors.

2.05 FINISHING

- A. Stainless Steel Compartments: No. 4 finish

PART 3 - EXECUTION

3.01 EXAMINATION

- A. Verify existing conditions before starting work.
- B. Verify that field measurements are as indicated.
- C. Verify correct spacing of and between plumbing fixtures.
- D. Verify correct location of built-in framing, anchorage, and bracing.

3.02 INSTALLATION

- A. Install partitions secure, rigid, plumb, and level in accordance with manufacturer's instructions.
- B. Maintain 3/8 to 1/2 inch (9 to 13 mm) space between wall and panels and between wall and end pilasters.
- C. Attach panel brackets securely to walls using anchor devices.
- D. Attach panels and pilasters to brackets. Locate head rail joints at pilaster center lines.

3.03 TOLERANCES

- A. Maximum Variation From True Position: 1/4 inch (6 mm).
- B. Maximum Variation From Plumb: 1/8 inch (3 mm).

3.04 ADJUSTING

- A. Adjust and align hardware to uniform clearance at vertical edge of doors, not exceeding 3/16 inch (5 mm).
- B. Adjust hinges to position doors in partial opening position when unlatched. Return out swinging doors to closed position.
- C. Adjust adjacent components for consistency of line or plan

END OF SECTION

This Page Left Blank Intentionally

SECTION 10 28 00
TOILET, BATH AND LAUNDRY ACCESSORIES

PART 1 - GENERAL**1.01 SECTION INCLUDES**

- A. Commercial toilet accessories.
- B. Under-lavatory pipe supply covers.
- C. Electric hand/hair dryers.
- D. Diaper changing stations.
- E. Utility room accessories.

1.02 RELATED REQUIREMENTS

- A. Section 06 1000 Rough Carpentry: Concealed supports for accessories, including in wall framing and plates and above ceiling framing.
- B. Section 10 2113.13 - Metal Toilet Compartments.
- C. Section 22 4000 - Plumbing Fixtures: Under-lavatory pipe and supply covers.

1.03 REFERENCE STANDARDS

- A. ASTM A269/A269M - Standard Specification for Seamless and Welded Austenitic Stainless Steel Tubing for General Service; 2025.
- B. ASTM A666/A666M - Standard Specification for Annealed or Cold-Worked Austenitic Stainless Steel Sheet, Strip, Plate, and Flat Bar; 2024.
- C. ASTM C1036 - Standard Specification for Flat Glass; 2025.
- D. ASTM C1048 - Standard Specification for Heat-Strengthened and Fully Tempered Flat Glass; 2025.
- E. ASTM C1503 - Standard Specification for Silvered Flat Glass Mirror; 2024.
- F. ASTM F2285 - Standard Consumer Safety Performance Specification for Diaper Changing Tables for Commercial Use; 2022.

1.04 ADMINISTRATIVE REQUIREMENTS

- A. Coordinate the work with the placement of internal wall reinforcement, concealed ceiling supports, and reinforcement of toilet partitions to receive anchor attachments.

1.05 SUBMITTALS

- A. See Section 01 3000 - Administrative Requirements, for submittal procedures.
- B. Manufacturer's Installation Instructions: Indicate special procedures and conditions requiring special attention

PART 2 - PRODUCTS**2.01 MANUFACTURERS**

- A. Commercial Toilet, Shower, and Bath Accessories:
 - 1. American Specialties, Inc: www.americanspecialties.com/#sle.
 - 2. Bradley Corporation: www.bradleycorp.com/#sle.
 - 3. Bobrick Washroom Equipment, Inc.: www.bobrick.com.
- B. Under-Lavatory Pipe Supply Covers:
 - 1. Plumberex Specialty Products, Inc: www.plumberex.com/sle.
 - 2. IPS Corporation; Truebro: <https://ipsplumbingproducts.com/brands/truebro/>.
 - 3. Substitutions: Section 01 6000 - Product Requirements.
- C. Electric Hand/Hair Dryers:

1. American Specialties, Inc; TRI-Umph High Speed Handryer: www.americanspecialties.com/#sle.
 2. Dyson Inc; Dyson Airblade V: www.dyson.com/sle.
 3. Saniflow Hand Dryer Corporation: www.saniflowcorp.com/sle.
 4. Bobrick TrimLineSeries™ Recessed Automatic Hand Dryer: www.bobrick.com.
 5. Substitutions: Section 01 6000 - Product Requirements.
- D. Diaper Changing Stations:
1. American Specialties, Inc; Model 9022: www.americanspecialties.com/#sle.
 2. Bradley Corporation; Model 962-11: www.bradleycorp.com/sale.
 3. Koala Kare Products; KB310-SSWM: www.koalabear.com/sle.
 4. Substitutions: 01 6000 - Product Requirements.
- E. Provide products of each category type by single manufacturer.
- 2.02 MATERIALS
- A. Accessories - General: Shop assembled, free of dents and scratches and packaged complete with anchors and fittings, steel anchor plates, adapters, and anchor components for installation.
 - B. Keys: Provide two keys for each accessory to Owner; master key lockable accessories.
 - C. Stainless Steel Sheet: ASTM A666/A666M, Type 304.
 - D. Stainless Steel Tubing: ASTM A269/A269M, Grade TP304 or TP316.
 - E. Mirror Glass: Annealed float glass, ASTM C1036 Type I, Class 1, Quality Q2, with silvering, protective and physical characteristics complying with ASTM C1503.
 - F. Mirror Glass: Tempered safety glass, ASTM C1048; and ASTM C1036 Type I, Class 1, Quality Q2, with silvering as required.
 - G. Adhesive: Two components epoxy type, waterproof.
 - H. Fasteners, Screws, and Bolts: Hot dip galvanized; tamper-proof; security type.
 - I. Expansion Shields: Fiber, lead, or rubber as recommended by accessory manufacturer for component and substrate.
- 2.03 FINISHES
- A. Stainless Steel: Satin finish, unless otherwise noted.
- 2.04 COMMERCIAL TOILET ACCESSORIES
- A. TA-01 Seat Cover Dispenser: Stainless steel, surface-mounted, reloading by hinged front panel.
 1. Minimum capacity: 500 seat covers.
 2. Products:
 - a. American Specialties, Inc; Model 6477-9 "Simplicity": www.americanspecialties.com/#sle.
 - b. Substitutions: Section 01 6000 - Product Requirements.
 - B. TA-02 Toilet Paper Dispenser: Double roll, recessed type, stainless steel, spindleless type for tension spring delivery designed to prevent theft of tissue roll.
 1. Products:
 - a. American Specialties, Inc; Model 0031: www.americanspecialties.com/#sle.
 - b. Substitutions: Section 01 6000 - Product Requirements.
 - C. TA-03 Sanitary Napkin Disposal Unit: Stainless steel, recessed, self-closing door, locking bottom panel with full-length stainless steel piano-type hinge, removable receptacle.
 1. Products:
 - a. American Specialties, Inc; Model 0473: www.americanspecialties.com/#sle.
 - b. Substitutions: Section 01 6000 - Product Requirements.

- D. TA-04 and TA-05 Grab Bars: Stainless steel, smooth surface.
 - 1. Heavy Duty Grab Bars: Floor supports are not acceptable.
 - a. Push/Pull Point Load: Minimum 250 pound-force (1112 N), minimum.
 - b. Dimensions: 1-1/2 inch (38 mm) outside diameter, minimum 18-gauge wall thickness, concealed flange mounting, 1-1/2 inch (38 mm) clearance between wall and inside of grab bar.
 - c. Length and Configuration: As indicated on drawings.
 - d. Products:
 - 1) American Specialties, Inc; Model Series 3800: www.americanspecialties.com/#sle.
 - 2) Substitutions: Section 01 6000 - Product Requirements.
 - E. TA-06 Paper Towel Dispenser: Folded paper type, stainless steel, surface-mounted, with viewing slots on sides as refill indicator and tumbler lock.
 - 1. Capacity: 500 multifold minimum.
 - 2. Products:
 - a. American Specialties, Inc; Model 20210 "Roval": www.americanspecialties.com/#sle.
 - b. Substitutions: Section 01 6000 - Product Requirements.
 - F. TA-07 Mirrors: Stainless steel framed, 1/4 inch (6 mm) thick annealed float glass; ASTM C1036.
 - 1. Annealed Float Glass: Silvering, protective and physical characteristics in compliance with ASTM C1503.
 - 2. Size: 24 inch x 36 inch.
 - 3. Frame: 0.05-inch (1.3 mm) angle shapes, with mitered and welded and ground corners, and tamperproof hanging system; satin finish.
 - 4. Products:
 - a. American Specialties, Inc; Model 0620 Series: www.americanspecialties.com/#sle.
 - b. Substitutions: Section 01 6000 - Product Requirements.
 - G. TA-08 Soap Dispenser: Liquid soap dispenser, wall-mounted, surface, with stainless steel cover and horizontal stainless steel tank and working parts; push type soap valve, check valve, and tamper-resistant window gauge refill indicator.
 - 1. Minimum Capacity: 40 ounces (1.18 liters).
 - 2. Products:
 - a. American Specialties, Inc; Model 0347: www.americanspecialties.com/#sle.
 - b. Substitutions: Section 01 6000 - Product Requirements.
 - H. TA-11 Sanitary Napkin Disposal Unit: Stainless steel, surface-mounted, self-closing door, locking bottom panel with full-length stainless steel piano-type hinge, removable receptacle.
 - 1. Products:
 - a. American Specialties, Inc; Model 0473-A: www.americanspecialties.com/#sle.
 - b. Substitutions: Section 01 6000 - Product Requirements.
 - I. TA-12 Toilet Paper Dispenser: Twin Jumbo roll, surface mounted, for cored or coreless type rolls.
 - 1. Products:
 - a. American Specialties, Inc; Model 0040: www.americanspecialties.com/#sle.
 - b. Substitutions: Section 01 6000 - Product Requirements.
- 2.05 UNDER-LAVATORY PIPE AND SUPPLY COVERS
- A. Specified in 22 4000 - Plumbing Fixtures.
- 2.06 DIAPER CHANGING STATIONS
- A. TA-09 Diaper Changing Station: Wall-mounted folding diaper changing station for use in commercial toilet facilities, meeting or exceeding ASTM F2285.
- 1. Material: Stainless steel.
 - 2. Mounting: Surface.

3. Minimum Rated Load (tested): 300 pounds (136.1 kg).
4. Products:
 - a. Saniflow Hand Dryer Corporation; Babymedi Horizontal Model CP0016HCS: www.saniflowcorp.com/#sle.
 - b. American Specialties, Inc; Model 9013-9: www.americanspecialties.com/#sle.
 - c. Substitutions: 01 6000 - Product Requirements.

2.07 ELECTRIC HAND/HAIR DRYERS

- A. TA-10 Electric Hand Dryers: Traditional fan-in-case type, with downward fixed nozzle.
 1. Operation: Automatic, sensor-operated on and off.
 2. Mounting: Wall-mounted - surface.
 3. Cover: Stainless steel with brushed finish.
 - a. Tamper-resistant screw attachment of cover to mounting plate.
 4. Fan/Heater Control: Field adjustable down to approximately half-speed with corresponding reduction in heat output.
 5. Electric Hand Dryer Products:
 - a. Saniflow Hand Dryer Corporation; Speedflow M17ACS-UL : www.saniflowcorp.com/#sle.
 - b. American Specialties, Inc; Model 0192-1-93: www.americanspecialties.com/#sle.
 - c. Dyson; Airblade V: www.dyson.com/commercial/products.
 - d. Substitutions: Section 01 6000 - Product Requirements.

2.08 UTILITY ROOM ACCESSORIES

- A. Combination Utility Shelf/Mop and Broom Holder: 0.05 inch (1.3 mm) thick stainless steel, Type 304, with 1/2 inch (12 mm) returned edges, 0.06 inch (1.6 mm) steel wall brackets.
 1. Hooks: Four, 0.06 inch (1.6 mm) stainless steel rag hooks under shelf.
 2. Mop/broom holders: Three spring-loaded rubber cam holders at shelf front.
 3. Length: Manufacturer's standard length for number of holders/hooks.
 4. Products:
 - a. American Specialties, Inc; Model 1308-3: www.americanspecialties.com/#sle.
 - b. Substitutions: 01 6000 - Product Requirements.

PART 3 - EXECUTION

3.01 EXAMINATION

- A. Verify existing conditions before starting work.
- B. Verify exact location of accessories for installation.
- C. For electrically-operated accessories, verify that electrical power connections are ready and in the correct locations.
- D. See Section 06 1000 Rough Carpentry for installation of blocking, reinforcing plates, and concealed anchors in walls and ceilings.

3.02 PREPARATION

- A. Deliver inserts and rough-in frames to site for timely installation.
- B. Provide templates and rough-in measurements as required.

3.03 INSTALLATION

- A. Install accessories in accordance with manufacturers' instructions in locations indicated on drawings.
- B. Install plumb and level, securely and rigidly anchored to substrate.
- C. Mounting Heights: As required by accessibility regulations, unless otherwise indicated.

3.04 PROTECTION

- A. Protect installed accessories from damage due to subsequent construction operations.

END OF SECTION

This Page Left Blank Intentionally

SECTION 14 24 10
MODERNIZATION OF EXISTING HYDRAULIC ELEVATOR

PART 1 - GENERAL**1.01 DESCRIPTION**

- A. Scope: Provide materials, labor, and services necessary for the complete modernization of existing electric hydraulic elevators.
 - 1. Modernize one hydraulic elevator.
 - a. The Contractor shall work normal hours and normal days with the exception of noisy work, which shall be performed from 5 a.m. to 8 a.m. Noisy work is considered work which will create disruption to normal court or building operation and is performed in the hoistways/lobbies/elevator cabs. The work in the machine room is not considered to be part of this "noisy" work.
- B. Any cranes used to bring equipment into the building shall be the responsibility of the Elevator Contractor and shall be scheduled for use on weekends. Permits for cranes are the Elevator Contractor's responsibility
- C. Upon bidding the work, the Contractor shall indicate any additional code compliance items which may be affected as a result of this work. This shall be reported to Owner's Representative and Architect, regardless of whether it is included in any contract document including the specifications and drawings.
- D. If additional work is required for compatibility with the Contractor's equipment, that shall be identified and itemized with the bid submittal.
- E. The new cab and car components shall be designed to stay within 5% of the original car weight, as stamped on the crosshead. Should the original weight be exceeded by more than 5%, comply with all ASME A17.1 requirement and report the specific conditions to Owner and Consultant prior to manufacture of any equipment.
- F. The Contractor is required to design all changes to not exceed a 5% increase in the original deadweight of the car enclosure, plus rated capacity. Should the total car weight be exceeded, Contractor shall be responsible for the following:
 - 1. All code-required changes.
 - 2. Provide structural calculations as required by code to determine integrity and capability of existing elevator components including machine support beams, with ASME A17.1, to withstand the new weights.
 - 3. Review of existing structural electrical and mechanical provisions for compatibility with Contractor's products.
 - 4. Documentation shall be furnished to the enforcing code authorities verifying the results.
 - 5. Owner shall not be responsible for changes to structural, mechanical, electrical or
 - a. other systems required to accommodate Contractor's equipment.

1.02 NON-PROPRIETARY EQUIPMENT

- A. It is recognized that each manufacturer's system contains components that are proprietary to the development of their systems. The Owner may wish to have the elevator system maintained by another technically qualified service provider and by submitting a bid for this project, the manufacturer shall guarantee that for a minimum of 20 years they will provide the following:
 - 1. Diagnostic, adjusting and monitoring tools for all components including documents, manuals, wiring diagrams and spare parts as listed in part 3 of this specification shall be provided in each machine room, controller room or machine space as a permanent part of the installation and become the property of the Owner. Devices shall be permanent at no additional cost to Owner, shall not self-destruct, and require charging or exchange. Remote monitoring devices are excluded from this requirement, however if such devices are removed all wiring shall be neatly terminated, tied within a junction box and properly marked as to its content.

2. Manufacturer shall guarantee to support the equipment for this project with regard to notification to Owner of system corrective updates, provide and be responsible for the cost to install such updates at no cost to Owner.
3. Provide contact information for their separate parts warehouse so that the Owner or designated service provider can order parts on a 24-hour basis and delivered with 48 hours.
4. Provide a list of parts of each component manufactured and stored at the warehouse and the retail cost of each at closeout of the project and estimated escalation cost. The cost of these parts is what would be charged to Owner or other service provider
5. Provide contact information for technical support so that the Owner or designated service provider can obtain technical support on a 24-hour basis to provide assistance in troubleshooting problems. Indicate hourly rate charged to Owner or designated service provider for such service.

1.03 CONTRACTOR RESPONSIBILITY

A. GENERAL REQUIREMENTS

1. Should additional work be required either due to code or the elevator contractor's specific requirements, these shall be noted and included with the bid. In the absence of such a list it is assumed the Contractor's equipment is compatible with the existing building system and any resulting work or revisions to the building or to the elevators shall be the responsibility of the Elevator Contractor.
2. Verify existing building systems including but not limited to mechanical, electrical system and fire life safety is compatible with the new equipment being proposed, identify any necessary modifications and include modifications in bid.
3. Provide all floor protection to disburse the weight of materials being removed and/or brought into the facility. Floor protection shall be adequate to prevent damage to existing flooring. Contractor accepts responsibility for cost of replacing
 - a. any building surfaces, features or finishes damaged by their actions.
4. Provide, identify and protect clear pathway, subject to Owner's prior approval, for any and all movement and storage of equipment, material and tools, around the property and within the building.
5. Provide guards and barricades to shield people from worksite hazards, including open hoistway, machinery, materials, equipment, and tools.
6. Protect premises from damage throughout course of construction, including floors, walks, walls, thresholds, entrance frames, doors, equipment, etc. Repair or replace items damaged or marred during construction.
7. Clean and apply one finish coat of low VOC low odor, industrial enamel paint on areas and equipment as specified.
8. Apply one finish coat of low VOC low odor, industrial enamel paint on the machine room walls, ceilings and floors.
9. Perform code and performance related tests as specified.
10. Remove and properly dispose of discarded equipment and materials, including debris, rubbish, oil and lubricants.
11. Adjust all safety and emergency control related devices and perform code mandated safety tests.
12. Remove and legally dispose of all elevator equipment replaced by this modification. Removed equipment shall be disposed of as fast as it accumulates and shall not be staged in public spaces.
13. Contractor shall include all code required items, permits, testing, records and inspection costs.
14. Coordinate with the Contractor to restore all damaged building finishes, including carpet, door frames, walls, ceilings, etc. to pre-modernization condition.
15. All modifications to the entry/exit areas shall be the Owner's responsibility but are the Contractor's responsibility to coordinate.

16. Provide LED pit lighting of not less than 100 lx (10 fc), measured at the pit floor. Furnish properly located light switch and GFCI duplex outlet near pit entry.
17. Provide GFCI convenience outlets in pit for sump pump.
18. Removal all non-elevator equipment from machine room, as required by the Cal/OSHA Elevator Unit.
19. Provide a class "ABC" fire extinguisher mounted inside each machine room.
20. Secure the storage space for tools and materials.
21. Include all costs associated with the safe hoisting of new equipment to the machine room.

1.04 RELATED BUILDING WORK.

- A. The following work shall be the responsibility of the other trades.
 1. Patching and finishing around entrances and adjacent flooring after installation.
 - a. Provide code-required machine room door signage.
 2. All modifications to the entry/exit areas shall be the Owner's responsibility but are the Contractor's responsibility to coordinate.
 3. Bevel all shaft ledges with an angle of not less than 75 degrees with the horizontal, where required.
 4. Provide all required hoistway wall patching.
 5. Modifications to the existing hoistway walls.
 6. Wall block outs and fire rated closure for control and signal fixture boxes which penetrate walls.
 7. Patching and finishing around entrances and adjacent flooring after installation.
 8. All modifications to the entry/exit areas shall be the Owner's responsibility but are the Contractor's responsibility to coordinate.
 9. Coordinate with the Contractor to restore all damaged building finishes, including carpet, door frames, walls, ceilings, etc. to pre-modernization condition. Build back surfaces and or building areas to match pre-existing finishes.
 10. Removal of all non-elevator equipment from machine room.
 11. Provide storage space for tools and materials. Contractor shall be responsible for securing the area.
- B. Mechanical: Provide adequate machine room heating and cooling necessary to maintain an ambient temperature between 55 and 85 degrees Fahrenheit, with relative humidity not exceeding 85% non-condensing. The existing ventilation for the machine room will remain in place.
- C. Electrical:
 1. Verify existing electrical system is compatible with the new equipment being proposed, identify any necessary modifications and include modifications in bid.
 2. Provide LED pit lighting of not less than 100 lx (10 fc), measured at the pit floor. Furnish properly located light switch and GFCI duplex outlet near pit entry. All to be NEMA 4 for wet application.
 3. Provide one GFCI type duplex utility receptacle near each elevator hoist machine. Replace existing outlets with GFCI type. Receptacles shall be manually reset type.
 4. Provide single non-GFCI outlet in pit when there is an existing sump pump.
 5. Provide required conduit between hoistway and remote elevator control panel.
 6. Provide proper machine room lighting arranged for optimal viewing of control equipment. The light level must be a minimum of 200 lx (19 fc), measured at the machine room floor. Provide sufficient quantity of T8 fluorescent fixtures with wire cage bulb guards. Locate light switch near the lockable side of the entry door.
 7. Provide properly sized, 3-phase power with lockable, fused disconnect switch at code required location for each elevator. Run feeder wires in separate code compliant conduit, terminated at each individual car controller or transformer. If alternate for auxiliary power supply is accepted, disconnect switch must be equipped with auxiliary contacts. Verify requirements with Contractor.

8. Provide 120 VAC single phase with fused disconnect switch mounted adjacent to group controller, where required. Verify requirements with Contractor.
 9. Provide insulated copper grounding conductor from the main building ground to each power disconnect switch.
- D. Fire Alarm—Refer to contract documents; Minimally the following is required?
1. Provide code compliant elevator recall fire alarm panel.
 2. Provide addressable smoke detectors installed in accordance with NFPA 72 and City of Pasadena building code, capable of initiating Phase 1 Emergency Recall Operation and notifying the Fire Department via the Central Monitoring station or City Tie Fire Alarm Box where required.
 3. Provide required main and alternate floor signals with wiring and contacts terminated in junction box, located in appropriate machine room. Machine room and elevator hoist way must be equipped with at least one smoke detector and one heat detector within 18" of each sprinkler head. Include required signals to flash the in-car fire hat in the event smoke or heat detector is activated in the machine room or hoistway.
 4. OWNER RESPONSIBILITY:
 - a. ACCESS TO SITE/GENERAL:
 - b. On-site Parking shall be provided for the Contractor.
 - c. Provide and designate adequate storage space for tools and materials.
 - d. No objects adjacent to, and below, the hall push button station shall project more than 4-inches from the wall.
- E. MACHINE ROOM:
1. Service all air conditioning systems and clean all vents.

1.05 REFERENCES

- A. Applicable Codes (Latest Edition):
1. All work shall be completed in accordance with national, state and local codes in effect at time of award. All requirements of local building department and fire jurisdictions shall be fulfilled by the Contractor.
 2. The American Society of Mechanical Engineers, Safety Code for Elevators and Escalators (ASME A17.1)
 3. The American Society of Mechanical Engineers, Safety Code for Existing Elevators and Escalators (ASME A17.3 - Latest Edition)
 4. American National Standard Accessible and Usable Buildings and Facilities (ICC/ANSI A117.1-Latest Edition)
 5. National Fire Protection Association (NFPA 13)
 6. National Fire Protection Association (NFPA 72)
 7. National Electrical Code (NFPA 72)
 8. American with Disabilities Act (ADA)
 9. California State Building, Fire, Elevator and Accessibility Codes – 2022 Edition
 10. American Welding Society (AWS) D1.1 - Structural Welding Code - Steel
 11. Authorities having jurisdiction

1.06 CONTRACT

- A. Contractor shall advise Consultant and Owner of any discrepancies or ambiguities found in the project specifications prior to submitting bid.
- B. Contract includes all engineering, labor, tools, materials, permits, equipment, required to complete the specified work, except those items defined as to be performed by the Contractor.
- C. Contractor shall familiarize itself with the site conditions and include all incidental work that might occur or be required as part of this project.

1.07 DEFINITIONS

- A. The following definitions apply to work of this Section:
1. "Owner": as used herein, refers to the County of Ventura (beneficial occupant).

2. "Contractor": refers to the Contractor having the contract with Owner to furnish labor and materials for the execution of work as specified herein.
3. "Architect": refers to the Kruger Bensen Ziemer Architects, Inc.
4. "Provide": to furnish and install, complete for safe operation, unless specifically indicated otherwise.
5. "Install": to erect, mount and connect complete with related accessories.
6. "Refurbish": to modify as required for like new operation and characteristics, meeting all current code requirements.
7. "Supply": to purchase, procure, acquire and deliver complete with related accessories.
8. "As required", "where required", "as needed", "if required", and "if necessary": repair or replace components to provide like new operation or meet code requirements.
9. "Work": labor and materials required for proper and complete installation.
10. "Wiring": raceway, fittings, wire, boxes, and related items.
11. "Concealed": embedded in masonry or other construction, installed in furred spaces, within double partitions or hung ceilings, in trenches, in crawl spaces or in enclosures.
12. "Exposed": not installed underground or "concealed" as defined above.
13. "Indicated", "shown", or "noted": as indicated, shown or noted on Drawings or as specified.
14. "Similar" or "equal": of base bid manufacturer, equal in materials, weight, size, design and efficiency of specified product, conforming to "Acceptable manufacturers."
15. "Reviewed", "satisfactory", "accepted", or "directed": as reviewed, satisfactory, accepted or directed, by or to Owner.
16. Where a device or a part of equipment is referred to in the singular number, it is intended that such reference shall apply to as many such devices as are required to complete the installation.

1.08 INSTRUCTIONS TO CONTRACTORS:

- A. Bids shall be subject to all the requirements of the contract documents and any other documents issued in connection with this project.
- B. Contractor shall identify any operations and features that are unique to their product or practices.
- C. If Contractor desires to furnish items differently than specified, Contractor shall submit substitution as an alternate quotation along with bid. Contractor shall supply information in regard to the proposed substitution of components or materials.
- D. Contractor shall identify any conflicts or problems/issues with the implementation of this work. In the absence of such identification, Contractor is responsible for existing conditions and modifications to the existing hoistway, machine rooms, elevator cars, etc. pertaining to this work, shall be the responsibility of the Contractor. Modifications to building systems,
 1. i.e. mechanical, structural, and electrical, etc., shall not be made to accommodate Contractor's equipment.

1.09 HAZARDOUS MATERIALS NOTIFICATION, TRAINING & REQUIREMENTS:

- A. If asbestos containing building materials or other hazardous materials are found to be present within the elevator machine rooms and hoistways, moving, drilling, cutting or otherwise disturbing such materials can pose a health risk and should not be attempted by untrained personnel. Contractor shall immediately notify Owner if there is need to disturb such materials as part of the project or if they observe any materials that they suspect contain asbestos or other hazardous materials that are not properly maintained.
- B. All technicians working on the project are to have undergone hazardous materials awareness training to learn about adverse health effects, necessary precautions, emergencies, inspections, and maintenance.
- C. Should removal or abatement be required, it shall be performed by others and the responsibility of the Owner.

1.10 MATERIALS:

- A. All exposed retained metal in the hoistway and on the car tops shall have all rust removed, shall be mechanically and chemically cleaned, followed immediately by the application of common, low-VOC, low-odor, rust-inhibiting coating. Stainless Steel: Type 302 or 304 or 316 complying with ASTM A240, with standard tempers and hardness required for fabrication, strength and durability.
- B. Paint: Clean all new exposed metal parts and assemblies of oil, grease, scale, and other foreign matter and factory paint one shop coat of standard rust-resistant primer. After erection, provide one finish coat of low VOC, low odor, and industrial enamel paint. Galvanized metal need not be painted.

1.11 OPERATION PERFORMANCE

- A. The control system shall provide smooth acceleration and deceleration with 1/8-inch leveling accuracy at all landings, from no load to full rated load in the elevator, under normal or unloading conditions. The self-leveling shall, within its zone, be entirely automatic and independent of the operating device and shall correct for over travel and under travel. The car shall remain at the landing irrespective of load.
- B. The floor-to-floor performance time shall be 15.0 seconds as measured from the start of door close at one floor to $\frac{3}{4}$ open at the next floor.
- C. The door open time shall be 2.5 seconds as measured from start of door open to fully open.
- D. The door close time shall be 3.6 seconds as measured from start of door close to fully closed.
- E. The door close time shall be based on the Code requirements with a door delay feature.
- F. The hall call door dwell time shall be based on the code requirements with a door delay feature. The door delay is the minimum acceptable time from notification that a car is answering a call (lantern and audible signal) until the doors of the car start to close. The minimum acceptable time for doors to remain fully open after answering a hall call shall not be less than 5-seconds. Time shall be calculated by the following equation:
 - 1. $T = D/(1.5 \text{ ft/s})$
 - 2. T = Total time in seconds.
 - 3. D = Distance from a point in the lobby 60-inches directly in front of the hall station to center line of the door opening.
- G. Car call door dwell time: The minimum acceptable time for doors to remain fully open after answering a car call shall not be less than 3-seconds, per code. Initial setting shall be 3.5-seconds.
- H. The speed of the elevator shall not vary by more than +/- 5% under loading conditions.
- I. Differential Door Timing Feature: Provide adjustable timers to vary the time that the doors remain open in response to a car or hall call. The doors shall remain open for 4.0-seconds in response to a car call and 5 to 8-seconds for a hall call. The doors shall remain open as long as passengers are crossing the threshold.
- J. Nudging: When doors are prevented from closing for 20-seconds due to failure of the proximity device or obstruction, the doors shall remain open and a buzzer shall sound.
- K. Prior to final acceptance and prior to the termination of the maintenance period, the elevators shall be adjusted as required to meet these performance requirements.

1.12 SOUND CONTROL/NOISE AND VIBRATION/RIDE QUALITY

- A. Limit overall elevator noise emissions to the building to the following maximum A-weighted sound pressure levels in any mode of operation:
 - 1. 55-decibels measured 5-feet above the cab floor near center while running at rated speed.
 - 2. 55-decibels measured 5-feet above the cab floor near center while the doors are opening or closing.
 - 3. 55-decibels measured in the elevator lobby 10-feet from the elevator doors.

4. All elevator equipment including their supports and fastenings to building, shall be mechanically and electrically isolated from the building structure and main line power feeders to minimize objectionable noise and vibration transmission to car, building structure, or adjacent occupied areas of building.
5. Ride Quality requirements shall include a horizontal acceleration measured inside of the cab during all conditions to not exceed 15 mg peak to peak within the 1-10 MHz range.
6. Vertical acceleration and deceleration shall free of bumps, jerk, and sway, and shall be not less than 3.3 feet (100.58 cm)/sec² with initial ramp of between 0.5 and 0.75-seconds.
7. Make all necessary modifications or replacement of equipment as necessary prior to final acceptance or warranty expiration to meet the performance requirement. This shall be performed at no additional charge.

1.13 SUBMITTALS

- A. Submit the following before beginning fabrication of equipment:
 1. The source of all finishes shall be provided by Ownership. The Contractor shall coordinate procurement of those materials with the Ownership and shall direct any of its subcontractors accordingly. Sourcing of all materials and the intended manufacturer/Contractor shall be submitted for approval.
 2. Shop Drawings: Provide an electronic set of complete, fully dimensioned shop drawings, to scale, in PDF format. Include layouts of pits, overhead, plan view of hoistway, cab, machine room, equipment loads, power and heat data for all equipment and required clearances. Provide detailed signal fixture drawings and cut sheets for all major components (controller, door operator, roller guides, etc.)
 3. Details of hold-to interior dimensions shall be provided. Drawings shall include details of cab interior including plans, and elevations. Fixture details shall be submitted for review. Generic brochures shall be rejected as not job specific. All details are to reflect modification to existing conditions and exact locations on the new materials. Provide hoistway, overhead and pit sections, and plan view of pit and machine room. Include all applicable structural, electrical and mechanical loads for new equipment. Provide manufacturer cut sheets for control system, power unit and door operator.
 4. Design Information: Provide calculations verifying the following:
 - a. Adequacy of existing electrical provisions.
 - b. Adequacy of retained equipment relative to Code requirements if car weight increased by more than 5%.
 - c. Machine room heat emissions in B.T.U.
 - d. Adequacy of existing retained elevator machine beams.
 - e. Adequacy of existing car platform structure for intended loading.
 5. Samples: Provide three sets of materials and finishes exposed to public view, 6-inch by 6-inch panels or 12-inch lengths as applicable.
 6. Color Charts: Provide three sets of color charts for all paint and car interior, entrance finish selections.
 7. Product Brochures: Provide an electronic submittal in PDF format including of literature on controller, landing system, motor starter, door operator and related door operating equipment, and door detector.
- B. Before acceptance of work, submit the following:
 1. Provide an electronic submittal in PDF format of job specific manufacturer's equipment brochures and service manuals. Assemble manuals in chronological order according to the specification alphanumeric system. Provide in manufacturers standard binders consisting of:
 - a. Equipment and components, descriptive literature.
 - b. Performance data, model number.
 - c. Installation instructions.
 - d. Operating instructions.

- e. Maintenance and repair instructions.
- f. Spare parts lists.
- g. Lubrication instructions.
- h. Detailed, record and as-built layout drawings.
2. Detailed, simplified, one line, wiring diagrams. Provide one complete set per manual.
3. Diagnostics: Controller and system shall include all necessary on-board diagnostics for performance of routine maintenance and troubleshooting. Contractor shall provide all diagnostic documentation required for troubleshooting and maintaining the elevator system upon completion including a composite listing of the individual settings chosen for variable software parameters stored in the software programs.
4. Layout Drawings: Provide a minimum of two sets of record as-built layout drawings. Drawings shall be prepared in AutoCAD. Provide one (1) complete set of drawings on labeled USB drive.
5. Wiring Diagrams: Provide a minimum of three (3) sets of "as-built" wiring diagrams that include all electrical circuits in the cars, hoistways and machine rooms. Diagrams shall include definition of all nomenclature and symbols. Provide two (2) sets of wiring diagrams in protective binders or in laminated format and one (1) set on labeled USB drive.
6. Keys: Provide six sets of keys for all keyed switches installed as part of this project, including: controller cabinet, fire service, stop switch, service cabinet, inspection and others if provided.
7. Certificate of Warranty in accordance with Specifications.
- C. Consultant shall review and return to Contractor all submittals including shop drawings, samples and color charts, where applicable. Consultant shall review all close-out documents, including service manuals, wiring diagrams, letter from structural engineer, keys, etc. and deliver to Owner upon approval.

1.14 QUALITY ASSURANCE:

- A. Contractor and Maintenance Qualifications:
 1. Be able to show evidence of local installations of similar scope and size with the proposed control system.
 2. Directly employ sufficient competent personnel within 100-miles of project to handle modernization and maintenance duties.
 3. Modernization work and maintenance duties shall be separately performed by specialized crews and individuals.
- B. Quality and Gauges of Materials:
 1. New, best of their respective kinds free from defects. Gauges as noted.
 - a. Materials, equipment of similar application; same manufacturer, except as noted.
 - b. Entire elevator equipment shall operate without irregularities and quietly by use of high-grade materials, first class workmanship and adjustments.

1.15 PRODUCT DELIVERY, STORAGE AND HANDLING

- A. Ship in factory crated sections of a size to permit passage through available space.
- B. Obtain approval and schedule delivery of material to meet Owner's requirements.
- C. Storage of equipment and materials shall be coordinated with Owner.
- D. Hoisting and Storage: All hoisting operations and storage of equipment and materials shall be coordinated in advance of delivery with Owner.
 1. Supply a plan detailing the proposed methods for hoisting of equipment including anticipated roof preparation, hoisting times and durations, traffic control and other special requirements.
 2. Supply a proposed location and size of area needed for tools, materials and equipment to be stored.
 3. Schedule of anticipated delivery, hoisting and storage dates.

1.16 SEQUENCING AND SCHEDULING

A. Schedule of Operations:

1. Within thirty (30) days after contract award, the Contractor shall submit a complete plan and schedule of its proposed operations for approval. In preparation of its plan and schedule, the Contractor shall make due allowance for and include the following:
 - a. Preparation of equipment and material submittal.
 - b. Review of each submittal (four weeks)
 - c. Manufacturing lead times for the equipment.
 - d. Shipping durations and anticipated delivery dates.
 - e. Related work by other trades, whether under the Contractor's or Owner's responsibility.
 - f. The schedule shall be updated and resubmitted on a monthly basis.
 - g. The schedule may be in the form of a bar chart, graph or other approved system by which are shown predicted sequence, dependencies, durations, starting and completion dates for the various work units or trades involved, together with such other information relative to job progress and completion. If required, the schedule shall be submitted in PDF Format.

B. Interruptions of Building Elevator Service:

1. All work shall be done with a minimum amount of interference to the operation of the building. The Contractor shall not interrupt the services without the prior written permission of the Owner.
2. Contractor shall perform as much pre-work as possible, prior to removing the first elevator from service. As a minimum, all new equipment shall be hoisted to the machine room.
3. The elevator shall be tested and accepted by the Owner. Contractor shall run each elevator on auto-call operation for a minimum of 72 hours without cycling doors and at least 8 hours with cycling doors, before turning the elevator over to the building. During door cycling period, Contractor shall provide personnel in the elevator at all times, preventing the public from entering the elevator.
4. Work may begin after detailed work schedule has been approved.

1.17 WARRANTY

- A. The elevator and associated equipment shall be free of defective material, imperfect work and faulty operation not due to ordinary wear and tear or improper use or care, for a period of three years concurrent with the warranty maintenance from final acceptance after completion of the final elevator. Defective work shall be repaired or replaced at no additional cost to the Owner. Provide Certificate of Warranty with start date effective on the date the Consultant accepts all work, including completion of all punch list items.

1.18 MAINTENANCE SERVICE

- A. Interim Maintenance: Submit with base bid a separate monthly price to provide Full Service on the elevators, from the first day of the month following contract award until the first elevator is removed from service for modernization. Coverage shall be in accordance with Vertical Transportation Interim Maintenance Agreement.
- B. Construction Maintenance: Submit with base bid a separate monthly price per elevator to provide Full Service from the date the first elevator is removed from service until both elevators are complete and warranty date is established. Coverage shall be in accordance with Vertical Transportation Construction Maintenance Agreement.
- C. Warranty Maintenance: Submit with base bid a separate monthly price for three-year maintenance service during warranty period. Maintenance shall commence upon completion and acceptance of all elevator work on the final elevator. Coverage shall be in accordance with Vertical Transportation Warranty Maintenance Agreement.
- D. On-Going Maintenance: Submit with base bid a separate monthly price should the maintenance be extended past the three-year period. Coverage shall be in accordance with Vertical Transportation Maintenance Agreement.

- E. The Owner reserves the right to accept or reject any or all maintenance terms noted above at any time prior to their commencement date.

1.19 PROTECTION OF PERSONS AND PROPERTY

- A. The Contractor shall be responsible for initiating, maintaining and supervising all safety precautions and programs in connection with the work.
- B. The Contractor shall take reasonable precautions for the safety of, and shall provide reasonable protection to prevent damage, injury or loss to:
 - 1. Employees working on the project and other persons who may be affected thereby.
 - 2. The work, materials, and equipment to be incorporated therein, whether in storage on or off the site, under the care, custody or control of the Contractor or any of his Subcontractors or Sub-Subcontractors.
 - 3. The property, including but not limited to roofing, walls, ceilings, flooring, furnishings, etc. Contractor shall repair or replace all damaged items. Under no circumstances shall any employees of Contractor or subcontractor employees smoke while on-site. Contractor shall advise all employees and Subcontractors that smoking on roof may void Owner's roofing warranty and Contractor shall be responsible for all costs associated with violation of this requirement.
- C. The Contractor shall designate a responsible member of his organization at the site whose duty shall be the prevention of accidents. This person shall be the Contractor's superintendent unless otherwise designated in writing by the Contractor to the Owner.
- D. The Contractor shall comply with all applicable laws, ordinances, rules, regulations and lawful orders of public authority having jurisdiction for the safety of persons, property or to protect them from damage, injury or loss. He shall erect and maintain, as required by existing conditions and progress of the work, all partitions for safety and protection, including posting danger signs, and other warnings against hazards, promulgating safety regulations and notifying Owners and users of adjacent utilities. The Contractor shall restore all damaged building
- E. In any emergency affecting the safety of persons or property, the Contractor shall act, at his discretion, to prevent threatened damages, injury or loss.

1.20 PERMITS AND INSPECTION FEES

- A. The Contractor shall obtain without cost to the Owner, all permits and certificates as required.

PART 2 - PRODUCTS

2.01 MANUFACTURERS

- A. Product of individuals, firms or corporations regularly engaged in modernizing elevators comparable with this contract and in satisfactory operation for a period of not less than five years.
- B. Qualified Contractors—or Approved Equal:
 - 1. Kone Elevator Company
 - 2. Otis Elevator Company
 - 3. Schindler Elevator Company
 - 4. ThyssenKrupp Elevator Company
 - 5. Mitsubishi Elevator Company
- C. Approved Base Bid Control System:
 - 1. Non-Proprietary Equipment. Alternate for Motion Control Engineering: iControls or approved equal.

2.02 OUTLINE OF EQUIPMENT

- A. Library Elevator (All information shall be field verified by Contractor):
1. Elevators Type: Hydraulic Direct Plunger
 2. Contract Load, in Pounds: Retain Existing
 3. Contract Speed, in FPM: Retain Existing
 4. Machine Location: As presently located
 5. Power Unit: Provide new
 6. Type of Control: Soft Start AC
 7. Operation Selective Collective
 8. Guide Rails Retain existing; remove all dirt, debris rust; Apply one finish coat of low VOC, low odor, and industrial enamel apply one finish coat of low VOC low odor, industrial enamel paint on non-running surfaces
 9. Buffers and Pit Channels Retain existing; remove all debris, rust and dirt;
 - a. Apply one finish coat of low VOC, low odor, and industrial enamel apply one finish coat of low VOC low odor, industrial enamel paint on non-running surfaces. Test and make any modifications necessary to pass state tests.
 10. Plunger and Cylinder Provide new PVC Casing; new plunger and new cylinder.
 11. Roller Guide Assembly Provide new car assemblies and rollers.
 12. Traveling Cable Provide new
 13. Door Operation Provide new VVVF-AC Closed Loop type; GAL MOVFR or approved equal.
 14. Door Detector: Provide new infrared full screen full height of door device with differential timing, nudging and interrupted beam time.
 15. Car Platform Check all fastenings, tighten and secure.
 - a. Platform: remove rust, dirt and debris and clean. . Apply one finish coat of low VOC, low odor, and industrial enamel paint
 16. Cab Enclosure New car doors with textured stainless steel finish; refer to drawings.
 - a. Interior Finishes: Refer to drawings.
 17. Cab Door Equipment: Provide all new GAL or approved equal door equipment including headers, tracks, rollers, hangers, etc.
 18. Cab Sills Retain existing; remove rust, debris and dirt, wire brush, clean and polish. Apply one finish coat of low VOC, low odor, and industrial enamel paint Check and tighten all fastenings.
 19. Top of Car Inspection Station: Provide new with light fixture and convenience outlet
 20. Hoistway Entrances: Retain existing configuration.
 21. Hoistway Entrance
 - a. Equipment: All new equipment shall be GAL or approved equal.
 - b. New interlocks, door tracks, headers, hanger's rollers and closers.
 - c. Any retained equipment: Remove all rust, dirt, debris, wire brush and clean all equipment which is being retained. Apply one finish coat of low VOC, low odor, and industrial enamel paint on all non-running surfaces.
 22. Lobby Hoistway Sills & Sill Angles
 - a. Retain existing; remove rust, dirt, debris, wire brush and clean. Apply one finish coat of low VOC, low odor, and industrial enamel paint Check and tighten all fastenings
 23. Lobby Hoistway Doors & Frames:
 - 1) Doors: Provide new doors with satin stainless steel finish at all floors.
 - 2) Frames: Retain existing frames; Apply one finish coat of low VOC, low odor, and industrial enamel paint Check all fastenings and refinish.
 24. Car Operating Panel: Provide new main applied car operating panel.
 - a. Incorporate a 12" to 15" CEC Elite P.I. into the new applied car operating panel.
 25. Hall Fixtures Provide all with new; reuse of existing boxes is acceptable. All fixtures shall be mounted to meet disabled height requirements.
 26. Combination Hall Position Indicator and Hall Lanterns:

- a. Provide new surface mounted type vandal resistant type with adjustable chimes at all floors for all elevators.
- 27. Hall Call Stations: Provide new surface mount type with oversized
 - 1) faceplate and engraved fire exit signs. Provide fully illuminated white vandal resistant buttons and button assemblies to meet CBC requirements.
 - 2) Provide key switch operation to match existing.
- 28. Phase 1 Fire Recall Switch: Provide new at main return landing; integrate with hall pushbutton station.
- 29. Access Switches: Provide new in existing location.
- 30. Car Blower: Provide new three speed blower.
- 31. Communication System: Provide new self-dialing vandal resistant push to call two way communication system with recall, tracking and voiceless communication.
- 32. Under Car Light: Provide new car light under car platform with switch in service cabinet.
- 33. Special Features: Fire recall operation, emergency power operation, verbal floor and direction annunciation and communication system

2.03 MACHINE ROOM EQUIPMENT

- A. Provide equipment to fit in existing machine room space. Any and all costs for re-design of, and revisions to, building spaces and structure due to selection of Contractor, Manufacturer, change to equipment availability, production or selection shall be borne by Contractor.
- B. Hydraulic Pump Unit: Retain Existing; check and tighten all fastenings. Adjust motor and shut off valves as required. Test muffler and make necessary adjustment.
- C. A pressure switch shall be mounted in line to prevent loss of oil.
- D. Controller: Microprocessor-based AC type with unit valve suitable for operation specified and capable of providing smooth, comfortable car acceleration and retardation. Limit the difference in car speed between full load and no load to not more than $\pm 10\%$ of the contract speed in either direction.
- E. Controller: Disconnect and completely remove the existing controller and selector for each elevator and replace with a new microprocessor system.
 - 1. Non-proprietary diagnostic control system from approved manufacturer. Provide NEMA – 1 enclosures and doors arranged with locks or mechanical latches.
 - 2. All controller components shall be designed to provide the required operation as herein specified.
 - 3. All assemblies, power supplies, switches, relays and other items shall be securely mounted on a substantial, self-supporting steel frame of angles or channels and shall be totally enclosed with hinged or removable covers in a floor mounted cabinet. Equipment shall not be mounted on any of the covers.
 - 4. All controller switches and relays shall be magnet operated with contacts of design and material to ensure maximum conductivity, long life and reliable operation without overheating or excessive wear and shall provide a wiping action to prevent sticking due to fusion.
 - 5. Where time delay relays are used in the circuits, they shall be of an acceptable design that is reliable and consistent, such as condenser timing or electronic timing circuits. No dashpot time relays shall be used.
 - 6. Each device on all panels shall be properly identified by name, letter, or standard symbol that shall be neatly stencil painted (or otherwise marked), in an indelible and legible manner, on device or panel. Identification markings shall be coordinated with identical markings used on wiring diagrams. The ampere rating shall be marked adjacent to all fuse holders. All spare conductors shall be neatly formed, laced and identified.
 - 7. Safety switch shall cut off current, automatically apply brake and stop car upon current failure or upon operation of any electrical safety device.
 - 8. All line voltage (110-volt or above) contact points inside the controller cabinet shall be protected from accidental contact when the doors are open.

9. Controllers shall be designed, tested and certified for Electromagnetic Interference (EMI) immunity in compliance with EN12015.
 10. Provide adequate ventilation fans.
 11. Provide isolated input with opto-isolation modules.
 12. Power Supplies: All power supplies utilized shall be UL recognized. They shall all have short-circuit protection.
 13. Frame: All assemblies, power supplies, chassis, switches, relays, and other items shall be securely mounted on a substantial, self-supporting steel frame. The equipment shall be completely enclosed with covers. No equipment is to be mounted on the covers.
 14. Wiring: All factory wiring shall utilize UL labeled copper wires. All wiring interconnections shall be neatly routed. All wiring connections to studs of terminals shall be made by means of solder or solderless lugs.
 15. Marking: All components shall be clearly and permanently identified adjacent to each device and shall be identical to the wiring diagram.
 16. Terminals shall be provided for a future connection to a computerized test system. An adequate number of terminals shall be provided so as to monitor all of the various functions of the elevators. These shall include but not be limited to car positions, running functions up and down, door open and close, hall and car calls, door protective devices, safety circuits, elevator recapture, etc.
 17. Printed Circuits and Related Hardware:
 18. All solid-state hardware and devices shall have built-in noise suppression devices that provide a level of noise immunity compliant with EN12015.
 19. Power supplies shall have noise suppression devices provided.
 20. All inputs from external devices (such as pushbuttons) and all outputs to external devices (such as indicators, relays) shall be isolated.
 21. The use of relays as input/output devices is not acceptable.
 22. A separate regulated power supply shall be used for each computer chassis.
 23. The control circuits shall be so designed so that one side of the power supply is grounded to provide for testing.
 24. Under no circumstances shall the safety circuits be affected by accidental grounding of any part of the system.
 25. In the event of a power failure or interruption, the system shall be designed so that it will start properly when power is returned.
 26. System memory shall be provided so that data shall not be lost in the event of a power failure or disturbance.
- F. Auxiliary Disconnects shall be provided where the equipment is not in the line of sight of the Main Line Disconnects. These are the responsibility of the Contractor.
- G. Diagnostic Tools: Subcontractor shall provide all diagnostic tools and documentation required for the adjustment, troubleshooting, and reprogramming of the elevator system upon completion, including:
1. Passwords or identification codes required to gain access to each software program in order to perform diagnostics or program changes.
 2. A composite listing of the individual settings chosen for variable software parameters stored in the software programs.
 3. A complete dictionary of fault codes with recommended steps for resolution, in sequence from highest to lowest probable cause.
 4. Provide one project laptop capable of and configured for displaying elevator status, hoistway position and direction, door position and direction, approximate percentage loading, existing issue and direction of hall and car calls and any current or recent faults for troubleshooting the equipment. It is the intent that the laptop be left on-site for diagnostic use in each control room.
- H. Provide vibration sound isolation to eliminate structure-borne sound being transmitted to the building. Vibration isolators shall be equivalent to Mason Industries Model RBA or SWM waffle

pad with neoprene grommet and washer isolated bolt attachment. Select isolators to compress a minimum of 0.1-inches under load. Seismic Protective Features: Provide per the Code requirements.

2.04 SYSTEM OPERATION AND FEATURES

- A. Selective Collective Operation – Library Elevator:
 - 1. Controls shall be a microprocessor-based system.
 - 2. Registration of car call button shall cause the car to start. The car shall respond to its own car calls and corridor calls, in the direction of travel, and in order in which the landings are reached.
 - 3. The car shall remain at the arrival floor for an adjustable interval to permit passenger transfer. Doors shall close after a predetermined interval, unless the car is parked at the main floor, after opening unless closing is interrupted by car door reversal device or door open button in car.
 - 4. Delayed Car Protection: The system shall automatically disassociate a car from the Duplex system in the event the car is delayed for a predetermined time. The car shall be automatically restored to the Duplex System when the cause of the delay has been eliminated.
 - 5. Programmed Door Control: Separate adjustable times shall be provided for each car to establish minimum passenger transfer time for car stops, intermediate floor hall call stops and lobby floor stops. All timing shall be computerized to coincide with traffic demands.
 - 6. Designated Parking: The system shall provide for cars to park as designated by the Duplex system or park at its last call.
 - 7. Provisions shall be made in the dispatch computer so that the elevator system dispatching can be modified at a future time. The system shall be so designed that the modifications to the software shall be all that is required to revise the dispatching. It shall be further designed so that there will be minimum shut down time should changes be required.
- B. Independent Service: Provide controls to remove elevator from normal operation and provide control of the elevator from car buttons only. Car shall travel at contract speed and shall not respond to corridor calls.
- C. Car Top Inspection Operation: Provide new per Code requirements.
- D. Hydraulic Elevator Low Oil Control: Should the elevator determine a low oil condition, the elevator shall be automatically retuned to the bottom floor and park until the condition is remedied.
- E. Emergency Recall Operation (Fire Service): Provide operation and equipment per Code requirements. Contractor shall provide relays, wiring, and terminal strips to receive signals from the fire alarm system.
- F. Hydraulic Elevator Battery Lowering: In the event of a power loss, the elevator shall return to the lowest landing and the doors shall automatically open. The elevator shall then automatically deactivate. The standby power source shall be a 12 volt DC battery unit with solid state charger and testing. Battery to be rechargeable with a ten year life. Upon restoration of normal power, the elevator shall automatically resume its operation.
- G. Differential Door Timing Feature: Provide adjustable timers to vary the time that the doors remain open in response to a car or hall call. The doors shall remain open for 3.5-seconds in response to a car call and 5 to 8-seconds for a hall call.
- H. Nudging: When doors are prevented from closing for 20-seconds due to failure of the proximity device or obstruction, the doors shall close at reduced speed and a buzzer shall sound.
- I. Fan and Light Output Timer: Provide an adjustable timer (Range 5 to 10-minutes) that when activated will turn off the fan and light within the car. The time will start when the car becomes inactive.

- J. Ascending Car Over-speed and Unintended Car Movement Protection: Provide future operation to prevent the elevator from striking the hoistway overhead and prevent unintended car movement per code.
- K. Seismic Operation: Provide operation and equipment per Code.

2.05 SECURITY SYSTEM:

- A. Interface with building security systems shall be required.
- B. Cameras: Provisions Only; All Elevators:
 - 1. Provisions for future camera provisions shall be installed for all elevators. These provisions shall include wiring and mounting brackets.
 - 2. One (1) pair wires shall be provided and installed per elevator cab in traveler cable. Shielding shall not be required. Must be separated from 480 v power sources.
 - 3. Wire shall be terminated in machine room with connection point for MCM outside of machine room. MTM to distribute from machine room as needed

2.06 SEISMIC

- A. Provide a minimum of one seismic switch for each single or group of elevators. A dual axis seismic switch shall activate per code requirements in both vertical and horizontal directions.

2.07 HOISTWAY EQUIPMENT

- A. Guide Rails and Brackets:
 - 1. Retain existing car guide rail brackets.
 - 2. Thoroughly clean all guide rails free of grease, oil and other foreign substances, file and remove all rough edges and surfaces. Realign, and tighten bracket bolts and guide rail clips as required for smooth and quiet operation of car. Provide additional rail brackets or backing as required by code or as necessary to meet ride quality standards.
- B. Buffers:
 - 1. Existing car spring buffers shall be refurbished. Clean thoroughly, flush and refill units with new oil.
 - 2. Provide inspection ladder and under car platform, where required by code.
 - 3. Apply one finish coat of low VOC, low odor, and industrial enamel paint on the exterior of buffer and stencil number the car number on each buffer.
 - 4. Buffers shall be load tested and tagged prior to turnover.
- C. Hydraulic Jack Assembly:
 - 1. Cylinder: Provide a seamless steel pipe and design head to receive unit type packing.
 - 2. Provide water tight PVC casing.
 - 3. Plunger: Provide a polished seamless steel pipe. The lengths shall not exceed 24'- 0"
 - 4. Provide over speed valves and shut off valve adjacent to the jack unit.
- D. Well Hole and Casing:
 - 1. Reuse the existing jack hole. Provide all necessary drilling and expand hole diameter as required for the new jack unit. Remove existing jack and oil. Removal of all spoils shall be the elevator contractor's responsibility.
 - 2. Drilling rig and attachments, access to the building, and any associated drilling costs shall be included. A rock clause shall not be acceptable.
 - 3. Install a PVC watertight casing which shall be capable of accommodating the new jack unit and additional fluid capacity.
 - 4. Seal well opening at the pit floor with hydraulic quick setting cement.
 - 5. Provide vision and access ports in the PVC.
- E. Pit Stop Switch: Provide new red colored stop switches to meet code requirements.
- F. Alarm Bell: Provide car top alarm bell and second alarm bell inside hoistway at lobby level.
- G. Final Terminal Stopping Devices:

1. Final Device Operation: New final limit switches located at top and bottom of the hoistway shall be arranged to automatically stop the car within the predetermined over travel limits, independently of all other devices.
 2. Rollers: Switches shall be equipped with engaging arms provided with polyurethane-tired rollers for engagement with cams.
- H. Electrical Wiring: Terminal connections for all conductors at equipment panels, center of hoistway and on elevator car shall be made with terminal blocks or studs having identifying numbers. All conductor connections shall be made with terminal eyelets of the solderless type.
1. Conductors: Provide copper insulated wiring with flame retarding and moisture resisting outer cover. Install in galvanized metal wireways and raceways. Conductors from shaft riser to door interlocks shall be SF-2 type or equal, maximum operating temperature 392-degrees F. All terminations shall be insulated to maintain integrity of wiring. Flexible conduit may be used for short connections.
 2. Traveling Cables: UL- labeled fire and moisture resistant outer braid and steel supporting strand. Provide a minimum of eight (8) pairs of shielded communication wires and car lighting circuits.
 3. Provide wiring as required for fire alarm initiating devices, emergency two-way communication, and firefighter's phone jacks, paging speaker's intercom, announcement speakers and card reader interface.
 4. Remote Wiring: Provide wiring between machine room, hoistway and remote locations of guard, security, life safety and fire control panels.
 5. Work Light and Plug Receptacles: Provide on top and bottom of car with lamp guards.
 6. Stop Switches: Provide Code required stop switches in the pit, near the governor access door, in the machinery spaces of machine room less elevators and where split level machine rooms occur.
 7. Provide NEMA4 weatherproof electrical equipment and wiring identified for use in wet locations when any electrical devices are located less than four (4) feet above the pit floor.
 8. Note: Conduits or other wiring shall not be exposed in the lobby or other occupied parts of the building.
- I. Raceway: Remove all rust, wire brush, clean and apply one finish coat of low VOC, low odor, and industrial enamel paint. Retain existing raceway where suitable and replace sections as necessary for new equipment. Modify lower section, where required, to accommodate proper pit ladder access.

2.08 DOORS AND ENTRANCE EQUIPMENT

- A. Retained Equipment: Remove all rust, dirt, debris; clean all surfaces on the hoistway and lobby side. Apply one finish coat of low VOC, low odor, and industrial enamel paint on all non-running surfaces.
- B. Frames: Retain existing entrance frames. Remove all rust, debris and dirt from face and back side of frames. Clean both hoistway and lobby side of frames. Clad existing frames with satin stainless steel as detailed on the drawings.
- C. Provide new rubber door strike astragals.
- D. Remove existing and provide new Braille plates centered at a height of 60-inches above the floor, mounted at each entrance side jamb. Match design of car Braille plates. Provide epoxy adhesively mounted plates; no rivets or visible fasteners. Braille and Designation plates shall have white characters with black background at typical floors. Plates shall be manufactured by SCS, Vison Mark or Entrada; cast design.
- E. Sills and Sill Angles: Reuse existing; check and tighten all fastenings.
- F. Struts: Reuse existing and clean thoroughly. Check and tighten all fastenings.
- G. Header: Provide new.
- H. Dust Covers: Reuse existing. Align, adequately reinforce and secure as required. Replace any missing covers or fasteners. Check and tighten all fastenings.

- I. Fascia: Reuse existing and clean thoroughly. Align, adequately reinforce and secure as necessary to prevent contact with the car. Replace any missing fascia and fasteners. Check and tighten all fastenings. Paint floor number on fascia.
- J. Door Panels:
 - 1. Stencil paint 4 inch (101.6 mm) high floor numbers on the back of each landing door panel.
 - 2. Library Elevator at all floors:
 - a. Provide new 14 gauge panels with a satin stainless steel finish. Provide rubber astragals on leading edge. Each door panel shall have two gibs which shall remain in the sill the entire length of door travel. Any cladding shall wrap around the trailing edge of the door a minimum of ½"
 - b. Provide 14 gauge sight guards with finish to match doors.
- K. Door Hangers: Provide new removable two-point suspension type with provisions for vertical and lateral adjustments. Sheaves shall be 2 ½-inch diameter with sealed or roller bearings.
- L. Door Tracks: Provide new removable steel tracks with smooth roller contact surface.
- M. Door Closers: Spring, spirator, or jamb/strut mounted counterweight type. Design and adjust to ensure smooth, quiet mechanical close of doors.
- N. Interlocks: Provide new interlocks and door release roller assembly at each entrance. Where door release assembly is replaced with new design, roller assembly shall be mounted to an 8-inch by 6-inch (10-gauge) reinforcement plate, properly screwed to the back of each landing door. Reinforcement plate shall be equipped with two (2) ¼-20 by 1- inch long self-clinching zinc studs designed specifically for door release roller assembly attachment. Where new interlock design is provided, the interlock shall be the same make as the door operator.

2.09 CAR EQUIPMENT

- A. All existing equipment shall have all rust, dirt and debris removed, wire brushed, cleaned and apply one finish coat of low VOC, low odor, and industrial enamel paint.
- B. Platform: Reuse existing platform. Balance in order to distribute, as evenly as possible, the pressure of the individual guides on the guide rails surfaces. Tighten fasteners and clean. Modify underside as required for code compliance.
- C. Car Frame:
 - 1. Retain and refurbish existing car frame. Remove rust, wire brushed, cleaned and apply one finish coat of low VOC, low odor, and industrial enamel paint.
 - 2. Square and adjust frame within guide rails in order to center, as evenly as possible, between the guide rail surfaces. Tighten fasteners and clean.
 - 3. Stencil paint 4" high car number on crosshead.
- D. Under Car Lighting: Provide new incandescent light fixture with bulb guard in NEMA 4 watertight and weather resistant box. Provide switch in service cabinet to turn light on/off.
- E. Platform:
 - 1. Retain and refurbish existing platform.
 - 2. Balance in order to distribute, as evenly as possible, the pressure of the individual guides on the guide rail surfaces. Tighten fasteners and clean.
 - 3. Provide new rubber platform isolation pads.
 - 4. Repair or replace any missing or damaged brace or support angles.
- F. Test at full load and full speed at the end of the equipment modernization. Replace all defective components or devices that do not function properly, including new safety actuating ropes as required.
- G. Toe Guard: Provide new, paint with one coat of black enamel.
- H. Roller Guides: Provide new roller type guides to provide smooth and quiet ride free of rumbles, bumps, vibrations, and excessive sway. Guides shall consist of three or more adjustable spring mounted rollers per guide assembly (3 1/2-inch minimum diameter) to maintain rail contact and

include adjustable stops. Rollers shall be constructed of neoprene or other similar sound deadening material. Rollers shall have high memory characteristics, enabling the rollers to quickly regain their round shape after an elevator sits still overnight or for a moderate period of time. Provide adapter plates and mounting hardware as necessary.

- I. Door Hangers: Provide new removable two-point suspension type with provisions for vertical and lateral adjustments. Sheaves shall be 2 ½-inch diameter with sealed or roller bearings. Hangers shall be galvanized metal or treated with 3 coats of Rustoleum.
- J. Door Tracks: Removable steel tracks with smooth roller contact surface.
- K. Door Protection: Infrared detector: Provide a door proximity edge that projects an infrared curtain of light guarding the door opening. Unit shall extend the height of the door panel. Arrange to reopen doors if one beam of the curtain is penetrated. Unit shall have Transmitters and Receivers spaced at a minimum distance to provide the maximum amount of protection within the height of the doorway. Systems which have the availability to turn off or on individual zones within the curtain will not be allowed. Door Detector shall extend the entire height of the door panel.
- L. Door Operator: Provide new VVVF-AC, high speed, closed-loop door operator to automatically open and close the car and hoistway doors. The doors shall be capable of smooth and quiet operation without slam or shock.
 - 1. Opening speed shall not be less than 3.0-f.p.s. with reversal in no more than 2-1/2-inches.
 - 2. An auxiliary-closing device shall automatically close hoistway doors if car leaves the landing zone.
 - 3. In case of a power interruption, it shall be possible to manually operate car and hoistway doors from inside the cab.
- M. Door Restrictor: Provide new mechanical zone lock. Electronic door restrictor shall not be allowed.
- N. Car Door Contact: Electrical contact shall prevent the operation of the elevator by normal operating devices unless car doors are closed or within tolerances allowed by Code.
- O. Emergency Exit Contact: Provide electrical contact to shut-off power to the elevator if emergency exit is open.
- P. Car Top Service Guardrail: Provide a 42-inch high railing on the car top with intermediate rail, toe board and stationary posts, where required by Code.

2.10 CAR ENCLOSURE

- A. All retained metal shall have the rust, dirt, and debris removed, wire brushed and cleaned; Apply one finish coat of low VOC, low odor, and industrial enamel paint. If removal of rust compromises the integrity of the equipment, the Contractor shall indicate as such with their bid.
- B. Library Elevator:
 - 1. An approved company shall manufacture car enclosure. Interior finishes as manufactured by Forms + Surfaces, City Lift, Sterling Corporation or approved equal. Provide the following features:
 - 2. General: The enclosure shall be adequately reinforced and ventilated to meet Code requirements. Weigh all interiors and verify weight of new interiors is per code and manufacturers weight requirements. Provide verification of weights prior to ordering any material. Check and tighten all fastenings. Confirm the structural integrity of the cab shell and platform.
 - 3. Confirm the structural integrity of the cab shell and platform. Repair platform and remove all rust. Check for termites and any deterioration. Replace platform if necessary. If platform is to be retained check and tighten all fastening. Broken welds on the floor support braces shall be re-welded or replaced. Reinforce the existing platform as required. The Contractor shall survey the sub floor to ensure it is free of deterioration and rust. The

- broken welds on the floor support braces underneath the floor shall be either replaced or repaired.
4. Shell: Arrange shell to accept interior panels as specified. Check and tighten all fastenings. Provide one coat of paint on the interior.
 5. Refer to attached drawings for all new finishes.
 6. Canopy: Check and tighten all fastenings. Modify canopy for light fixtures. Lighting fixtures that uniformly distribute not less than foot-candles of light at handrail height as required by Code. Provide clear and easily accessible access to the emergency exit per Code requirements.
 7. Drop Ceiling and Lighting: Provide new EPCO Flexi light emergency cab lighting system, capable of re-lighting two normal down-light fixtures. Emergency light transformer and fixture to be mounted in a water tight/weather proof enclosure.
 8. Floor Covering Provide new as shown on the drawings.
 9. Transom, Front Return Panels and Entrance Columns: Provide as detailed on the drawings.
 10. Car Door Panels: Door panels shall be 14-gauge hollow metal flush door construction, furniture steel. Provide reinforcement by formed vertical sections running full height of door. Doors shall be provided with two removable gibs with fire tabs, located at the leading and trailing edge of the door panel. Finish shall be textured stainless steel. There shall be no visible exposed or protruding fasteners.
 11. Ventilation: Three-speed type AA exhaust blower mounted to car canopy on isolated rubber grommets.

2.11 SIGNALS AND FIXTURES

- A. All new fixtures shall be provided.
- B. Car Operating Panel
 1. Provide new applied type main car operating panel in compliance with applicable Code.
 - a. Car Operating Panel: Provide new illuminating stainless steel vandal resistant pushbuttons or approved equal product. Faceplate shall have Satin stainless steel finish. Faceplate shall have continuous hinge with three point latching.
 - b. Provide a keyed stop switch and alarm bell button, door open and door close buttons. All floor pushbuttons shall be located no higher than 48- inches above the car floor, the keyed in car stop switch and alarm button shall be located no lower than 35- inches above finished floor height. Provide fire service cabinet, phase 2 switch, fire jewel, call cancel button, emergency light fixture, and voice annunciation grill and flush mounted speaker grill for the Hands-Free telephone.
 - c. Braille/Arabic designations shall be identified by a minimum of 5/8-inch Arabic numeral, standard alphabet character, or standard symbol immediately to the left of the control button. Braille shall be located immediately below the numeral, character or symbol. Controls and emergency equipment shall be identified by raised symbols, including but not limited to, door open, door close, alarm bell, emergency stop and telephone. The call button for the main entry floor shall be designated by a raised star at the left of the floor designation. Braille and Arabic designations shall be flush with inconspicuous mechanical mounting. The plaques shall have raised white characters on a black background. Provide cast Oval Surround style Braille plates as provided by Entrada, Vison Mark or SCS.
 - d. Provide a lockable service cabinet with concealed hinges. Cabinet door shall be flush with the faceplate with hairline joints.
 - 1) Cabinet shall contain the following toggle type controls:
 - (a) Light toggle switch.
 - (b) Three speed fan switch.
 - (c) Inspection keyed switch.
 - (d) Independent service toggle switch.
 - (e) Emergency Light test button

- (f) Duplex 120 volt, A.C. GFCI convenience outlet.
 - (g) Light switch for under car platform light.
 - e. Engrave the following; the font shall be as directed by architect and code:
 - 1) Elevator Number. Minimum 1/2-inch high lettering.
 - 2) Elevator Capacity below Elevator Number.
 - 3) Building Name and Address.
 - 4) Fire Instruction signage.
 - 5) All Code Required Signage/Verbiage Shall be engraved on the new car operating panel.
 - f. Floor Annunciator: Provide new digitized voice annunciator providing both male and female voices in a system capable of up to 5-minutes of speech. Provide concealed speaker. Messages shall include the following announcements:
 - 1) Floor number and direction of travel.
 - 2) Notice of doors closing prior to nudging operation.
 - 3) Notice of car on independent service.
 - 4) Emergency operation announcements:
 - 5) Firefighter's Service, "Elevator returning to lobby."
- C. Car Position Indicator: Provide new segmented digital readout type with 2-inch high (minimum) indications at upper section of car operating panel. Indicator shall provide car position and direction of travel.
- D. Fixture Requirements: Provide new faceplates constructed of Satin brushed stainless steel at all floors, minimum thickness 1/8-inch. All edges shall be relieved. All hall fixtures to have concealed fasteners. Wherever feasible, reuse existing electrical boxes; otherwise, perform all required cutting and patching. Extend faceplates as required to cover holes left by removal of existing fixture.
- E. Hall Pushbutton Station: Provide a single riser for each elevator. Station shall include flush mounted satin stainless steel faceplate. Extend faceplates as required to cover holes left by removal of existing fixture. Centerline of riser to be at 3-feet-6-inches above the finished floor. Buttons shall have a minimum dimension of 3/4-inch, be raised 1/8-inch plus or minus 1/32-inch above the surrounding surface, and have a detectable mechanical motion. A minimum clear space of 3/8-inch separation shall be provided. Button design shall be vandal resistant fully illuminated white Provide spanner type security fasteners.
- F. Fire Key Switch, Fire Sign and In Case of Fire Sign:
 - 1. Locate the fire key switch with the hall pushbutton at the main return landing.
 - 2. Provide Code required pictograph Fire signs incorporated with the hall buttons, at all floors. Provide 3-position Code required Phase I key switch and operational instructions engraved minimum 1/8-inch high on the faceplate at the main return floor. In Case of Fire signs minimum 1/2-inch high shall be integral within the faceplate, at all floors. Faceplate edges shall be relieved. Finish shall be stainless steel No. 4 brushed finish. Backfill for engraving shall be epoxy filled. Integral signs shall be as follows:
 - a. Fire Signs. Minimum 1/2-inch high lettering.
 - b. Fire Operational Instructions. Minimum 1/8-inch high lettering.
 - 3. Provide spanner type security fasteners. Finish matching faceplate.
- G. Hoistway Access Switch: Mount in existing location and reuse existing electrical boxes; otherwise, coordinate all required cutting and patching. Extend faceplates as required to cover holes left by removal of existing fixture.
- H. Combination Hall Position/Hall Lanterns Provide new digital position indicators with vandal resistant arrows in an integral fixture. Provide with stainless steel faceplate in locations where presently existing. Extend faceplates as required to cover holes left by removal of existing fixture. Provide arrow shaped up and down lanterns with audible signals at each entrance per architectural drawings. The visual signal for each direction, minimum 2 1/2- inches by 2 1/2- inches, shall be visible from the proximity of the hall station. Indicators shall have audible

signals consisting of voice annunciation and volume adjustable chimes that sound once for the up direction and twice for the down direction of travel. Extend faceplates as required to cover holes left by removal of existing fixture.

2.12 COMMUNICATION AND SECURITY SYSTEMS

- A. Telephone System: Provide automatic dial Hands Free telephone station located in the car station. A button shall suitably identify activation of auto dialer for the visually impaired. Speaker shall be mounted without faceplate or visible fasteners and located either behind the control station or within the telephone box. Communication shall be capable of being heard from any location within the car enclosure. Provide a means to communicate to each car individually from telephone unit at the elevator control panel, in compliance with ASME A17.1, rule 2.27.1.1.4.
 - 1. Provide a telephone symbol minimum 2-inch high, and raised 1/32-inch with Braille indications adjacent to a separate activation button mounted on the control panel.
 - 2. Provide engraved emergency instructions above the activation button. Instructions shall read: TO USE EMERGENCY TELEPHONE, PRESS BUTTON BELOW. DIALING WILL OCCUR AUTOMATICALLY. Identical instructions in Braille shall be provide below the engraved instructions.
 - 3. Provide a visual indication, approximately 3/4-inch in diameter, or a jewel that illuminates once a call has been received. Instructions under the visual indicator or within the lighted jewel shall read: ASSISTANCE IS ON THE WAY.
- B. Provide wiring from car to telephone terminal box in elevator machine room.
- C. Mount fire alarm speaker on each car top and run required wiring from speaker to life safety terminal box in machine room. Speakers to be provided by fire alarm contractor.
- D. Mount security camera in each elevator cab and run required wiring from car top junction box to security camera terminal box in machine room. Security cameras to be provided by Owner.

PART 3 - EXECUTION

3.01 EXAMINATION OF EXISTING BUILDING AND CONTRACT DOCUMENTS

- A. Contractor shall carefully examine all existing building conditions and be informed as to facilities for delivery of materials and equipment, floor loading limitations, and be familiar with difficulties that may be encountered in completing execution of all work, prior to bid.
- B. Contractor will be held to have examined all specifications and all other data pertaining to work.
- C. The Owner shall bear no responsibility for any incomplete or missing wiring diagrams or other data that may be needed to adapt the new equipment to the existing equipment. Obtaining such information from other sources is the Contractor's responsibility.
- D. No consideration or allowance will be granted for failure to visit site, or for alleged misunderstanding of materials to be furnished, or work to be done, it being understood that tender of proposal carries with it agreement to all items and conditions referred to herein.

3.02 MAJOR ALTERATION - INCREASE IN DEAD WEIGHT

- A. The Contractor is required to design all changes to not exceed a 5% increase in the original deadweight of the car enclosure, plus rated capacity. Should the total car weight be exceeded, Contractor shall be responsible for all code required changes. Documentation shall be furnished to the enforcing code authorities verifying the results.

3.03 FIELD QUALITY CONTROL

- A. Tests:
 - 1. Perform as required by code, and authorities having jurisdiction.
 - 2. Provide labor, material, equipment and connections.
 - 3. Repair or replace defective work as required.
 - 4. Pay for restoring or replacing damaged work due to tests.

- B. Final Inspection: When all work is completed, and tested, notify the Owner in writing that the elevator is ready for final inspection and acceptance test. A testing and inspection date shall then be arranged. The proper operation of every part of the elevator system and compliance with contract requirements of the code shall be demonstrated to the Owner. Furnish all test instruments, weights, and materials, required at the time of final inspection. The following tests shall be made on each elevator at the time of final inspection:
1. Test Period: The elevator shall be subjected to a test for a period of one hour continuous run, with full specified load in the car. During the test run, the car shall be stopped at all floors in both directions of travel for a standing period of 10- seconds per floor.
 2. Speed Load Tests: The actual speed of the elevator car shall be determined in both directions of travel with full contract load and with no load in the elevator car. Speed shall be determined by a tachometer. The actual measured speed of elevator car with full load shall be within 5% of rated speed. The maximum difference in actual measured speeds obtained under the various conditions outlined between the UP and the DOWN directions shall be checked.
 3. Floor-to-floor times with no load in the car, balanced load in the car and full load in the car shall be checked.
 4. Car Leveling Tests: Elevator car leveling devices shall be tested for accuracy of landing at all floors with no load in the car, balanced load, and full load, in both directions of travel. Accuracy of floor landing (plus or minus 1/8-inch) shall be determined both before and after the full-load run test.
 5. Final System Tests for Smoke Detection/Fire Elevator Recall: After work is completed, conduct a final test of entire system. Perform testing "after hours" unless normal business hours testing is authorized by Owner. Submit results on approved test report forms.
 6. Re-inspection: If any equipment is found to be damaged or defective, or if the performance of the elevator does not conform to the requirements of the contract specifications or the Safety Code, no approval or acceptance of the elevators shall be issued until all defects have been corrected. When the repairs and adjustments have been completed and the discrepancies corrected the Owner shall be notified and the elevator shall be re-inspected. Rejected elevators shall not be used until they have been re-inspected and approved.

3.04 ADJUSTING, CLEANING, LUBRICATION AND PAINTING


- A. In order to maintain cleanliness throughout the project, Contractor shall thoroughly clean all hoistways, car tops, pits and landing sills free of dirt, grease, oil and debris, prior to disabling the first elevator from service for modernization.
- B. Perform the following work prior to final testing and acceptance:
1. Adjust all equipment for optimum performance, including controllers, motors, motor drive, landing systems, hoistway switches, door operating equipment and safety equipment to achieve the required performance levels.
 2. Thoroughly clean all equipment and equipment areas free of all dust, dirt, debris and excessive oil and grease.
 3. Lubricate all equipment in accordance with manufacturer's guidelines.
 4. Patch and paint exposed work soiled or damaged during installation. Repair to match adjoining work prior final acceptance.
 5. Clean and paint the following equipment and areas: Hoist machine, machine room floor, car top, buffers and pit floor.

3.05 INSTRUCTIONS

- A. Upon completion of all work, the Contractor shall provide an instruction period. Instructions shall be given by competent supervisory personnel and shall apply to actual field conditions. The instructions shall cover, but shall not be limited to the following:
1. Operation of elevators under emergency conditions, maintenance, adjustment, troubleshooting and diagnostic procedures.
 2. Operation and maintenance of smoke detectors and elevator fire recall system.
 3. Operation of elevator communication, door reversal device, etc.

END OF SECTION

This Page Left Blank Intentionally

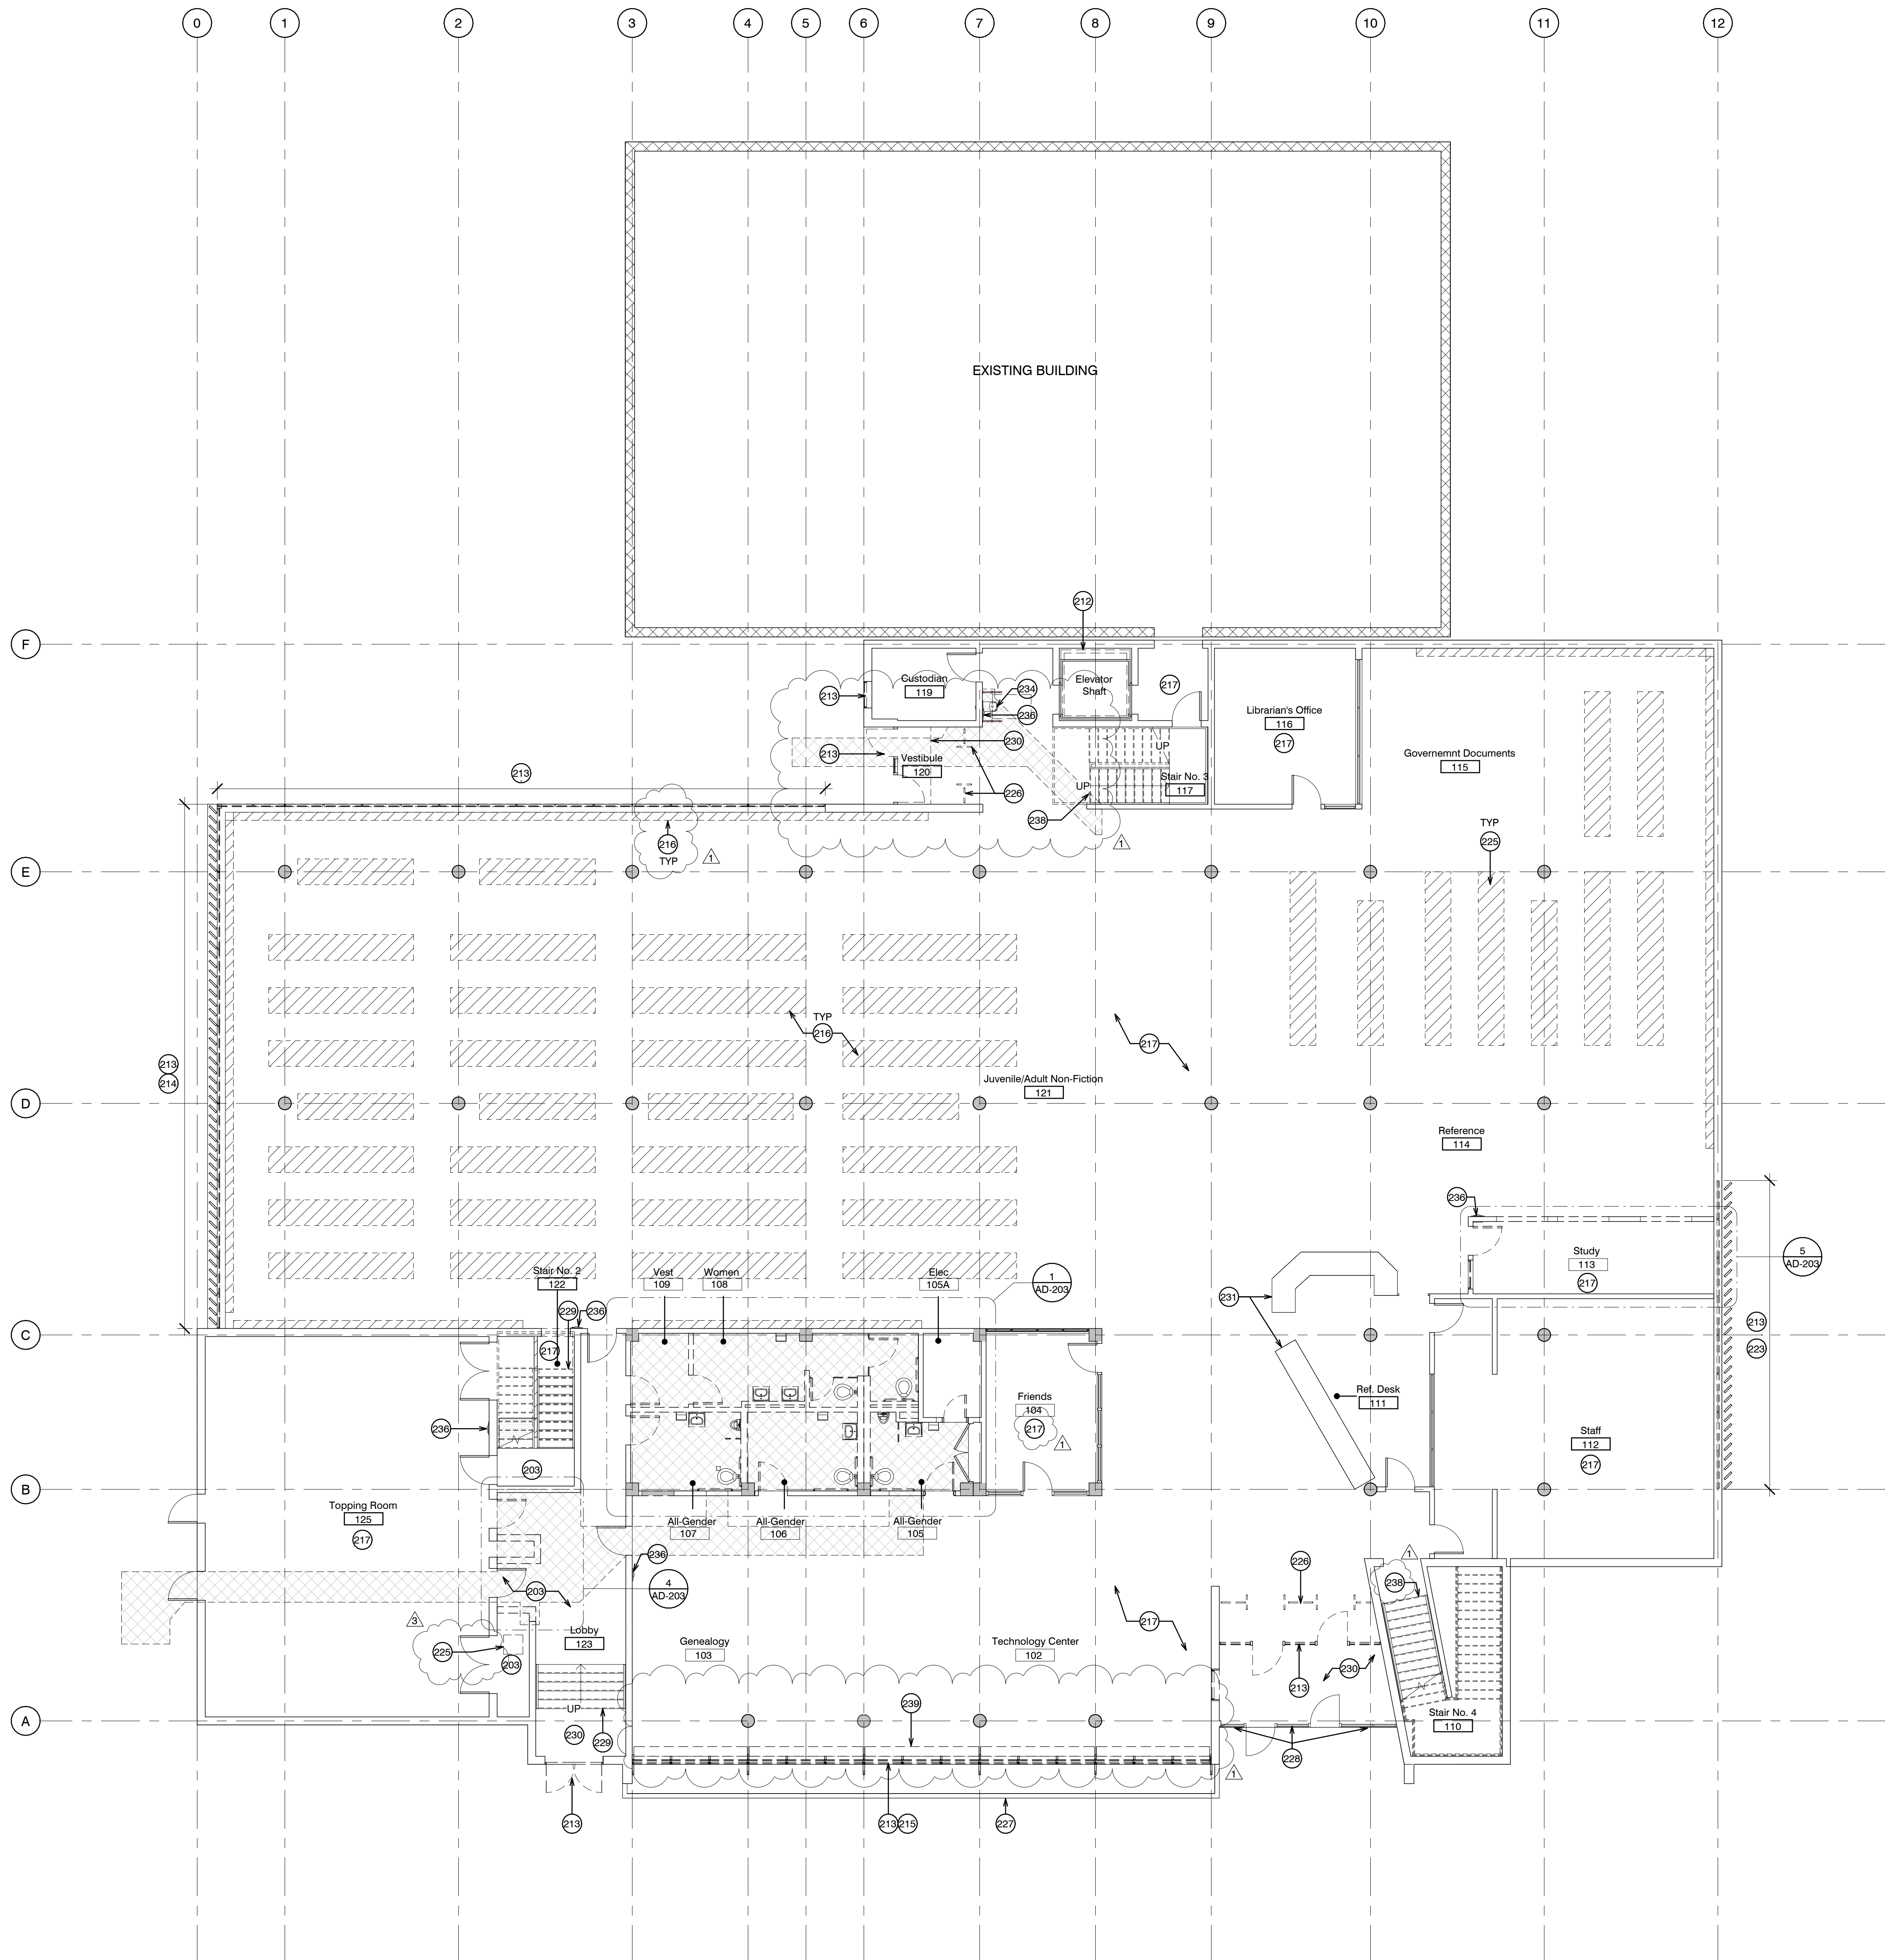

1 First Floor Plan - Demolition
SCALE: 1/8" = 1'-0"

DEMO KEYNOTES

- 203 DEMO (E) FLOOR FINISH/CARPET
- 212 REMOVE (E) ELEVATOR CAB, INTERIOR FINISHES, LIGHTING, AND INT. EXT. CONTROLS
- 213 REMOVE (E) WINDOWS AND STOREFRONT ENTRANCES
- 214 CAREFULLY REMOVE (E) SHADING DEVICES, REFURBISH, REFINISH, AND REINSTALL
- 215 REMOVE, REFINISH AND RE-INSTALL (E) VERTICAL AND HORIZONTAL LOUVER SYSTEM
- 216 REMOVE (E) STACKS, STORE FOR REINSTALLATION AFTER FLOORING REPLACEMENT
- 217 REMOVE (E) CARPET & LINOLEUM DOWN TO CONCRETE SUBSTRATE
- 223 REMOVE, CLEAN, REFURBISH, AND RE-INSTALL (E) VERTICAL LOUVERS
- 225 REMOVE AND REPLACE (E) ROOF HATCH AND ACCESS LADDER WITH (N)
- 226 DEMO (E) SECURITY DEVICES AND RAILINGS
- 227 (E) PLANTER TO REMAIN
- 228 PROTECT (E) CUSTOM ARTWORK ON GLAZING
- 229 REMOVE HANDRAIL, STAIR RISER, TREAD AND NOSING FINISH MATERIAL
- 230 (E) TERRAZZO FLOORING TO REMAIN
- 231 (E) BUILT-IN REFERENCE DESK TO REMAIN
- 234 (E) DRINKING FOUNTAIN WITH RAILS TO REMAIN
- 236 (E) FIRE EXTINGUISHER TO REMAIN
- 238 PROTECT (E) HANDRAIL, REMOVE (E) STAIR RISER, TREAD AND NOSING FINISH MATERIAL
- 239 REMOVE (E) LITE SHELF WITH VERTICAL SUPPORT

DEMO PLAN LEGEND

- DEMO (E) CONC. FLOOR SLAB PER STRUC. & PLUMB. PROTECT (E) COLUMN FOOTINGS

DEMO PLAN NOTES

1. REMOVE ALL DOOR LOCKSETS; REPLACE PER DOOR SCHEDULE.
2. REPLACE ALL (E) SIGNAGES INCLUDING ROOM SIGNAGE, EXIT SIGNAGE, ELEVATOR SIGNAGE, ACCESSIBILITY SIGNAGE, DIRECTIONAL SIGNAGE AND OCCUPANT LOAD SIGNAGE WITH (N).

CONTRACTOR NOTES

1. THE CONTRACTOR SHALL CAREFULLY REMOVE THE LIBRARY COLLECTION PHYSICAL MATERIALS (BOOKS, JOURNALS, NEWSPAPERS, MAPS, ETC.), PLACE IN BOXES SORTED BY NUMBER AS DIRECTED BY THE AGENCY, CLEARLY LABEL EACH BOX, AND TEMPORARILY RELOCATE AS REQUIRED TO COMPLETE THE WORK. LIBRARY COLLECTION PHYSICAL MATERIALS SHALL BE STORED IN A SECURE, DRY, CLIMATE-CONTROLLED ENVIRONMENT.
2. ALL LIBRARY TECH EQUIPMENT (COMPUTERS, SERVERS, AND PERIPHERALS LIKE KEYBOARDS, MONITORS, PRINTERS, ETC.), AND OTHER ELECTRONIC DEVICES ON THE FIRST AND SECOND FLOORS SHALL BE CAREFULLY REMOVED, PROTECTED, AND TEMPORARILY RELOCATED AS REQUIRED TO COMPLETE THE WORK.
3. THE CONTRACTOR SHALL CAREFULLY REMOVE ALL LIBRARY FURNITURE AND TEMPORARILY RELOCATE AS REQUIRED TO COMPLETE THE WORK.
4. ALL LIBRARY STACKS ON THE FIRST AND SECOND FLOORS SHALL BE CAREFULLY REMOVED, PROTECTED, AND TEMPORARILY RELOCATED AS REQUIRED TO COMPLETE THE WORK.
5. BEFORE FINAL COMPLETION OF PROJECT, THE CONTRACTOR SHALL RETURN ALL FURNITURE, STACKS, TECH EQUIPMENT, AND LIBRARY COLLECTION PHYSICAL MATERIALS TO THEIR ORIGINAL LOCATIONS IN AN ORDERLY MANNER.
6. ANY ITEMS DAMAGED DURING REMOVAL OR RETURN SHALL BE REPLACED IN KIND BY CONTRACTOR.

COUNTY of VENTURA Library

PUBLIC VENTURA COUNTY WORKS

ENGINEERING SERVICES

KBZ

KRUGER BENSEN ZIEMER ARCHITECTS, INC.
199 FIGUEROA STREET, SUITE 100A
VENTURA, CA 93001
TELEPHONE (805) 963-1726

TODD A JESPERSEN AIA
PRINCIPAL-IN-CHARGE

JONATHAN D LEE AIA
PROJECT MANAGER

All design, design arrangements and plans indicated or represented by this drawing are owned by and are the property of Kruger-Bensen-Ziemer, AIA architects, and were created, evolved and developed for use on, and in connection with, the specified project. None of such design, drawings, arrangements or plans shall be used by or disclosed to any person, firm or corporation for any purpose whatsoever without the written permission of Kruger-Bensen-Ziemer.

PROFESSIONAL SEALS

PERMIT APPROVAL STAMP

PERMIT NO BP25-02229		
NO	REVISION	DATE
1	Owner Changes	08/11/25
2	Plan Review Corrections	09/08/25
3	Owner Changes	12/09/25

PUBLIC WORKS PROJECT MANAGER
DEVI NALLAMALA

PRINCIPAL-IN-CHARGE
TODD A. JESPERSEN AIA

DRAWN BY
JONATHAN D. LEE AIA

CHECKED BY
TODD A. JESPERSEN AIA

ARCHITECTS JOB NO
24004

DATE
07/11/2025

PROJECT TITLE AND ADDRESS

E. P. FOSTER LIBRARY MODERNIZATION

651 E MAIN ST,
VENTURA, CA 93001


COUNTY SPEC NUMBER
CP26-12

COUNTY PROJECT NUMBER
P6T24008

COUNTY DWG NO
SHEET OF

SHEET TITLE
DEMO FIRST FLOOR PLAN

SHEET NO
AD-201

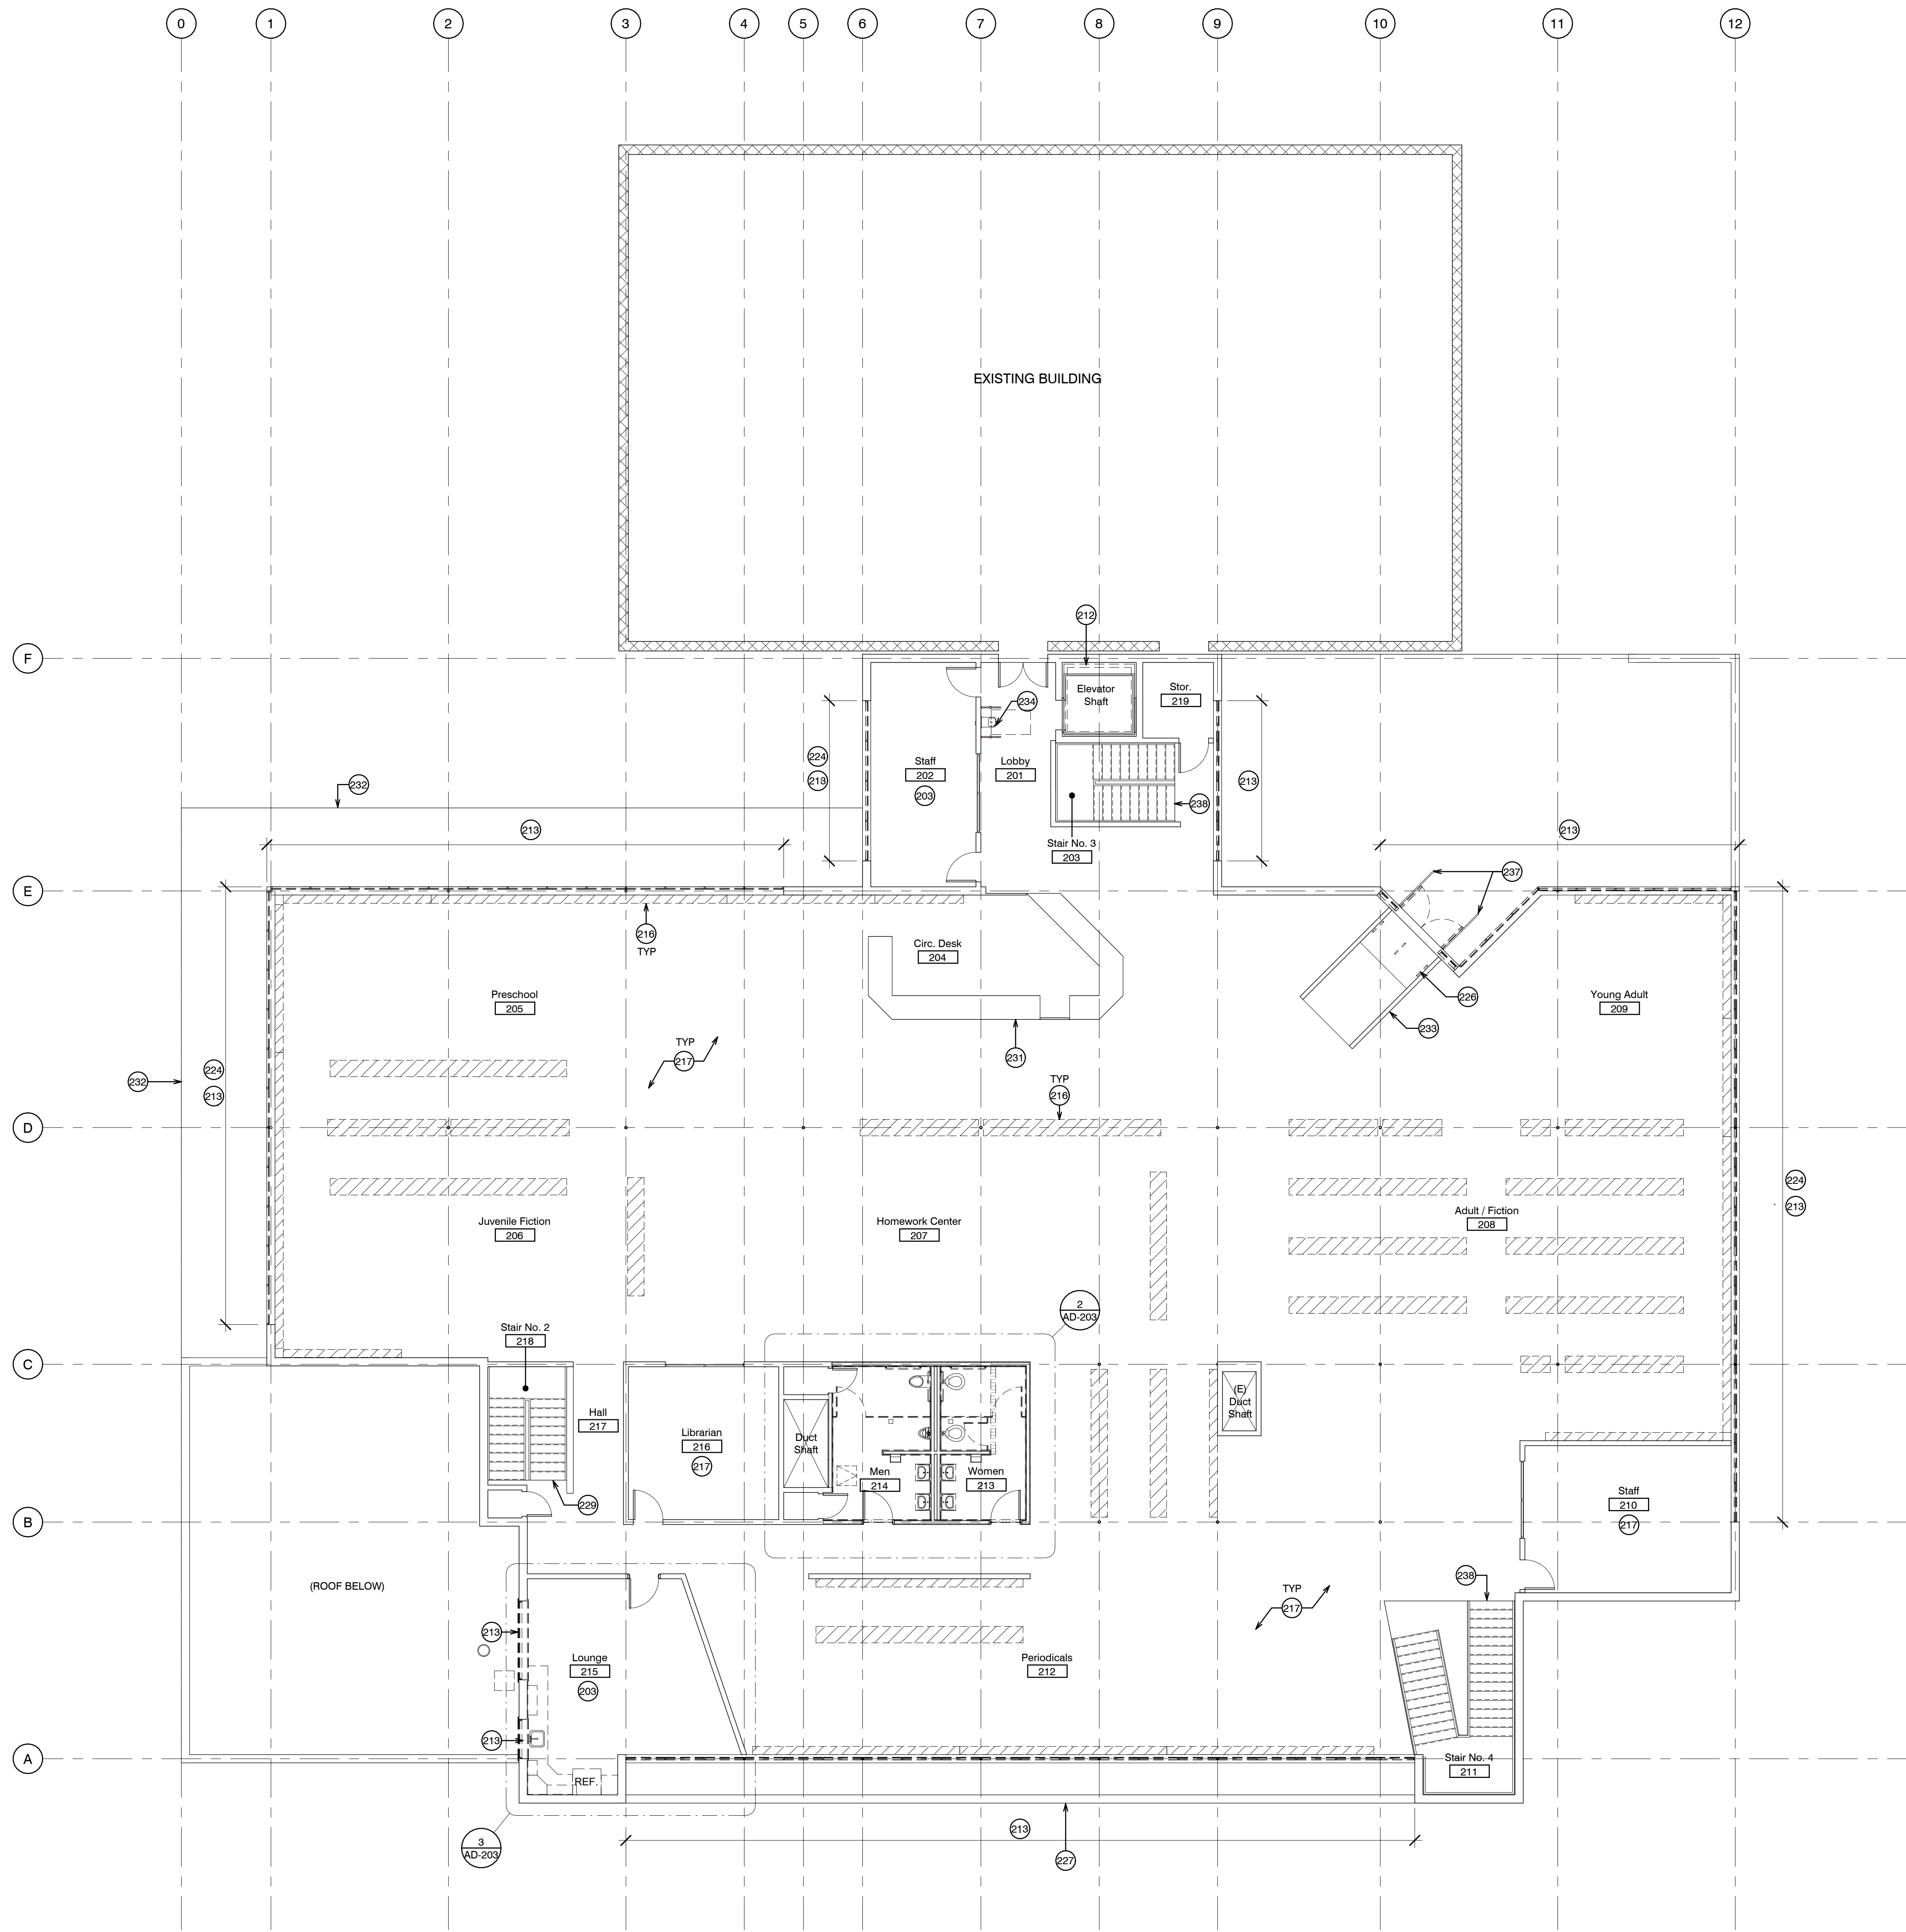

1 Second Floor Plan - Demolition
SCALE: 1/8" = 1'-0"

DEMO KEYNOTES

- 203 DEMO (E) FLOOR FINISH/CARPET
212 REMOVE (E) ELEVATOR CAB, INTERIOR FINISHES,
LIGHTING, AND INT. EXT. CONTROLS
213 REMOVE (E) WINDOWS AND
STOREFRONT ENTRANCES
216 REMOVE (E) STACKS, STORE FOR
REINSTALLATION AFTER FLOORING
REPLACEMENT
217 REMOVE (E) CARPET & LINOLEUM DOWN TO CONCRETE SUBSTRATE
224 REMOVE AND RE-INSTALL (E) MOTORIZED
SUNSCREENS
226 DEMO (E) SECURITY DEVICES AND RAILINGS
227 (E) PLANTER TO REMAIN
229 REMOVE HANDRAIL, STAIR RISER, TREAD AND
NOSING FINISH MATERIAL
231 (E) BUILT-IN REFERENCE DESK TO REMAIN
232 (E) ROOF OVERHANG BELOW
233 (E) RAMP AND CURB TO REMAIN
234 (E) DRINKING FOUNTAIN WITH RAILS TO REMAIN
237 (E) RAILS TO REMAIN
238 PROTECT (E) HANDRAIL, REMOVE (E) STAIR RISER,
TREAD AND NOSING FINISH MATERIAL

DEMO PLAN NOTES

1. REMOVE ALL DOOR LOCKSETS; REPLACE PER DOOR
SCHEDULE.
2. REPLACE ALL (E) SIGNAGES INCLUDING ROOM
SIGNAGE, EXIT SIGNAGE, ELEVATOR SIGNAGE,
ACCESSIBILITY SIGNAGE, DIRECTIONAL SIGNAGE AND
OCCUPANT LOAD SIGNAGE WITH (N).


CONTRACTOR NOTES

1. THE CONTRACTOR SHALL CAREFULLY REMOVE THE LIBRARY
COLLECTION PHYSICAL MATERIALS (BOOKS, JOURNALS,
NEWSPAPERS, MAPS, ETC.), PLACE IN BOXES SORTED BY NUMBER
AS DIRECTED BY THE AGENCY, CLEARLY LABEL EACH BOX, AND
TEMPORARILY RELOCATE AS REQUIRED TO COMPLETE THE WORK.
LIBRARY COLLECTION PHYSICAL MATERIALS SHALL BE STORED IN
A SECURE, DRY, CLIMATE-CONTROLLED ENVIRONMENT.
2. ALL LIBRARY TECH EQUIPMENT (COMPUTERS, SERVERS, ETC.), AND
PERIPHERALS LIKE KEYBOARDS, MONITORS, PRINTERS, ETC.), AND
OTHER ELECTRONIC DEVICES ON THE FIRST AND SECOND
FLOORS SHALL BE CAREFULLY REMOVED, PROTECTED, AND
TEMPORARILY RELOCATED AS REQUIRED TO COMPLETE THE
WORK.
3. THE CONTRACTOR SHALL CAREFULLY REMOVE ALL LIBRARY
FURNITURE AND TEMPORARILY RELOCATE AS REQUIRED TO
COMPLETE THE WORK.
4. ALL LIBRARY STACKS ON THE FIRST AND SECOND FLOORS
SHALL BE CAREFULLY REMOVED, PROTECTED, AND TEMPORARILY
RELOCATED AS REQUIRED TO COMPLETE THE WORK.
5. BEFORE FINAL COMPLETION OF PROJECT, THE CONTRACTOR
SHALL RETURN ALL FURNITURE, STACKS, TECH EQUIPMENT, AND
LIBRARY COLLECTION PHYSICAL MATERIALS TO THEIR ORIGINAL
LOCATIONS IN AN ORDERLY MANNER.
6. ANY ITEMS DAMAGED DURING REMOVAL OR RETURN SHALL BE
REPLACED IN KIND BY CONTRACTOR.



**PUBLIC
VENTURA COUNTY
WORKS**


ENGINEERING SERVICES

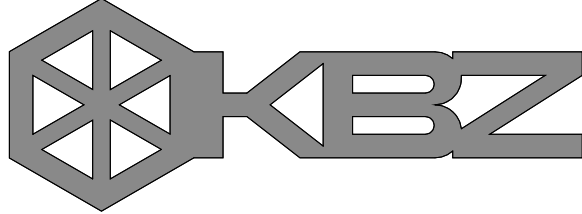

**KRUGER BENSEN ZIEMER
ARCHITECTS, INC.**
199 FIGUEROA STREET, SUITE 100A
VENTURA, CA 93001
TELEPHONE (805) 963-1726

TODD A JESPERSEN AIA
PRINCIPAL-IN-CHARGE
JONATHAN D LEE AIA
PROJECT MANAGER

All plans, design, arrangements and plans indicated or represented by this
drawing are owned by and are the property of Kruger-Bensen-Ziemer, AIA
architects, and were created, evolved and developed for use on, and in
connection with, the specified project. None of such plans, designs,
arrangements or plans shall be used by or disclosed to any person, firm or
corporation for any purpose whatsoever without the written permission of
Kruger-Bensen-Ziemer.

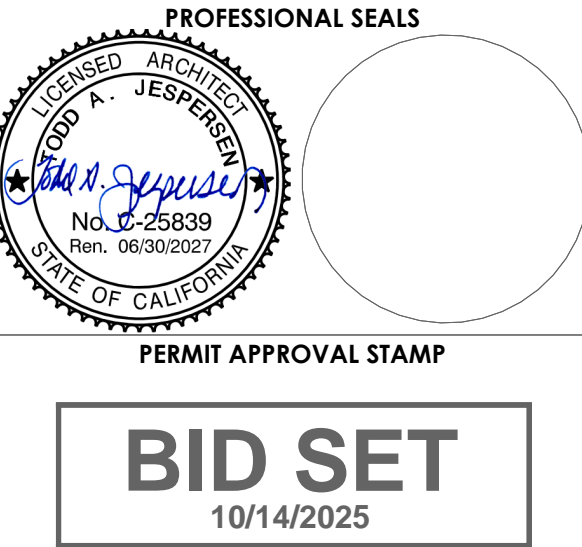

PERMIT NO BP25-02229		
NO	REVISION	DATE
1	Owner Changes	08/11/25
2	Plan Review Corrections	09/08/25
3	Owner Changes	12/09/25


PUBLIC WORKS PROJECT MANAGER
DEVI NALLAMALA
PRINCIPAL-IN-CHARGE
TODD A. JESPERSEN AIA
DRAWN BY JONATHAN D. LEE AIA **CHECKED BY** TODD A. JESPERSEN AIA
ARCHITECT'S JOB NO 24004 **DATE** 07/11/2025
PROJECT TITLE AND ADDRESS

**E. P. FOSTER
LIBRARY
MODERNIZATION**

651 E MAIN ST,
VENTURA, CA 93001
COUNTY SPEC NUMBER CP26-12
COUNTY PROJECT NUMBER P6T24008
COUNTY DWG NO SHEET OF

SHEET TITLE
DEMO SECOND
FLOOR PLAN
SHEET NO AD-202


Addendum No. 1

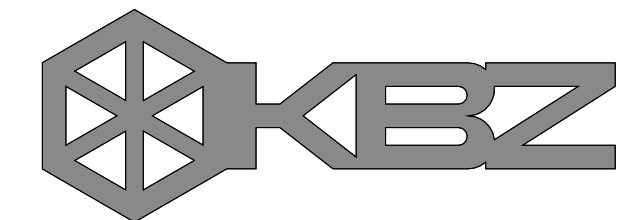

KRUGER BENSEN ZIEMER
ARCHITECTS, INC.
199 FIGUEROA STREET, SUITE 100A
VENTURA, CA 93001
TELEPHONE (805) 963-1726

TODD A JESPERSEN AIA
PRINCIPAL-IN-CHARGE
JONATHAN D LEE AIA
PROJECT MANAGER

All plans, design, arrangements and plans indicated or represented by this drawing are owned by and are the property of Kruger-Bensen-Ziemer, AIA architects, and were created, evolved and developed for use on, and in connection with the specified project. None of such plans, designs, arrangements or plans shall be used by or disclosed to any person, firm or corporation for any purpose whatsoever without the written permission of Kruger-Bensen-Ziemer.

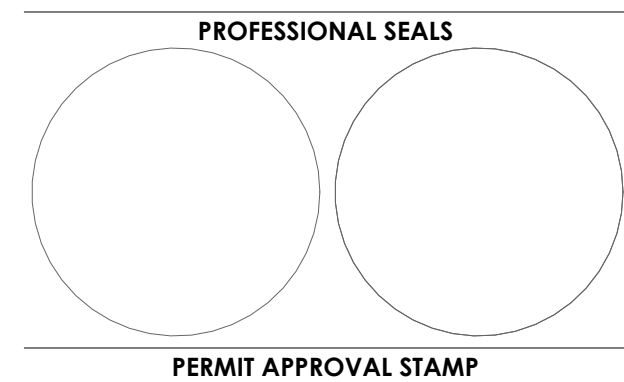

PERMIT NO BP25-02229		
NO	REVISION	DATE
1	Owner Changes	08/11/25
2	Plan Review Corrections	09/08/25
3	Owner Changes	12/09/25

PUBLIC WORKS PROJECT MANAGER
DEVIN HALLAMALA
PRINCIPAL-IN-CHARGE
TODD A. JESPERSEN AIA
DRAWN BY
JONATHAN D. LEE AIA
CHECKED BY
TODD A. JESPERSEN AIA
ARCHITECT'S JOB NO
24004
DATE
07/11/2025
PROJECT TITLE AND ADDRESS

E. P. FOSTER
LIBRARY
MODERNIZATION

651 E MAIN ST,
VENTURA, CA 93001

COUNTY SPEC NUMBER
CP26-12

COUNTY PROJECT NUMBER
P6T24008

COUNTY DWG NO SHEET OF

SHEET TITLE

DEMO RCP - FIRST FLOOR

SHEET NO
AD-206



1 Demo RCP - First Floor
SCALE: 1/8" = 1'-0"



SITE PLAN KEYNOTES

- 100 (E) FIRE HYDRANT
- 101 (E) ACCESSIBLE PARKING SPACE
- 102 (E) VAN ACCESSIBLE PARKING SPACE
- 103 (E) FIRE LANE
- 104 (N) PAD MOUNTED METER/MAIN SWITCHGEAR
- 105 (N) PAD MOUNTED SCE TRANSFORMER
- 106 (E) NON-ACCESSIBLE PAINTED PATH
- 107 (E) BOOK RETURN BOX
- 108 (E) PARKING LOT SIGNAGE
- 109 (N) ACCESSIBILITY SIGNAGE PER S101A-701
- 110 REMOVE (E) STAIRING
- 111 (N) ACCESSIBLE RAMP TO TOPPING ROOM

SITE PLAN LEGEND

AREA OF WORK

GENERAL NOTES

1. PROTECT ALL EXISTING STRUCTURES, UTILITIES & LANDSCAPING DURING CONSTRUCTION.
2. PLANS WERE PREPARED USING AS-BUILT DRAWINGS RECEIVED FROM THE OWNER. THE CONTRACTOR SHALL FIELD VERIFY EXISTING ACTUAL CONDITIONS PRIOR TO START OF WORK AND NOTIFY THE ARCHITECT OF ANY DISCREPANCIES.

PATH OF TRAVEL

PATH OF TRAVEL (P.O.T.) AS INDICATED IS A BARRIER FREE ACCESS IS AT LEAST 48" WIDE WITHOUT ANY ABRUPT VERTICAL CHANGES EXCEEDING 1/2" BEVELED AT 1:2 MAX. SLOPE, EXCEPT THAT LEVEL CHANGES DO NOT EXCEED 1/4" VERTICAL AND IS AT LEAST 48" INCHES WIDE. SURFACE IS SLIP RESISTANT, STABLE, FIRM AND SMOOTH. CROSS SLOPE DOES NOT EXCEED 2% AND SLOPE IN THE DIRECTION OF TRAVEL IS LESS THAN 5%, UNLESS OTHERWISE NOTED. P.O.T. SHALL BE MAINTAINED FREE OF OVERHANGING OBSTRUCTIONS TO 80" MINIMUM AND PROTRUDING OBJECTS GREATER THAN 4" PROJECTION FROM WALL AND ABOVE 27" AND LESS THAN 80". ARCHITECT HAS VERIFIED THAT ALL BARRIERS IN THE PATH OF TRAVEL HAVE BEEN REMOVED OR WILL BE REMOVED UNDER THIS PROJECT.

PATH OF TRAVEL (POT) AS VERIFIED BY ARCHITECT IS:
· A COMMON BARRIER FREE ACCESSIBLE ROUTE AT LEAST 48" WIDE WITHOUT ANY ABRUPT VERTICAL CHANGES EXCEEDING 1/2" BEVELED AT 1:2 MAXIMUM SLOPE, EXCEPT THAT LEVEL CHANGES DO NOT EXCEED 1/4" VERTICAL.
· THE PATH SURFACE IS SLIP RESISTANT, STABLE, FIRM, AND SMOOTH.
· PASSING SPACES AT LEAST 60" X 60" ARE LOCATED NOT MORE THAN 200' APART.
· CONTINUOUS GRADIENTS HAVE 60" LEVEL AREAS NOT MORE THAN 400' APART.
· CROSS-SLOPE DOES NOT EXCEED 2%.
· SLOPE IN THE DIRECTION OF TRAVEL IS LESS THAN 5% UNLESS OTHERWISE INDICATED AS A RAMP.
· MAINTAIN POT FREE OF OVERHANGING OBSTRUCTIONS TO 80" MINIMUM, PROTRUDING OBJECTS GREATER THAN 4" PROJECTION FROM WALL OR EDGE AND 27" ABOVE FINISH GRADE.

FOR GRATINGS LOCATED IN THE SURFACE OF ANY PEDESTRIAN WAYS AT PATH OF TRAVEL, GRID/OPENINGS IN GRATINGS SHALL BE LIMITED TO 1/2" MAX. IN THE DIRECTION OF TRAFFIC FLOW. IF SUCH CONDITION OCCURS, PROVIDE MANUFACTURER CUTSHEETS OF GRATE PROVIDED.

GATES AND DOORS SERVING THE MEANS OF EGRESS SYSTEM SHALL COMPLY WITH THE REQUIREMENTS OF SECTION 1010. GATES USED AS A COMPONENT IN A MEANS OF EGRESS SHALL CONFORM TO THE APPLICABLE REQUIREMENTS FOR DOORS. PROVIDE LEVER HARDWARE AND KICKPLATE. FIRE AND LIFE SAFETY MAY REQUIRE PANIC HARDWARE FOR EMERGENCY EXITING EVEN WITH THE SIGN. COORDINATE WITH FIRE AND LIFE SAFETY REQUIREMENTS. VERIFY AND ADJUST THE FORCE FOR PUSHING OR PULLING OPEN A DOOR OR GATE OTHER THAN FIRE DOORS TO BE 5 LBS MAXIMUM.

DESIGN PROFESSIONAL IN GENERAL RESPONSIBLE CHARGE STATEMENT
THE POT IDENTIFIED IN THESE CONSTRUCTION DOCUMENTS IS COMPLIANT WITH THE CURRENT APPLICABLE CALIFORNIA BUILDING CODE ACCESSIBILITY PROVISIONS FOR PATH OF TRAVEL REQUIREMENTS FOR ALTERATIONS, ADDITIONS AND STRUCTURAL REPAIRS. AS PART OF THE DESIGN OF THIS PROJECT, THE POT WAS EXAMINED AND ANY ELEMENTS, COMPONENTS OR PORTIONS OF THE POT THAT WERE DETERMINED TO BE NON COMPLIANT:
1. HAVE BEEN IDENTIFIED
2. THE CORRECTIVE WORK NECESSARY TO BRING THEM INTO COMPLIANCE HAS BEEN INCLUDED WITHIN THE SCOPE OF THIS PROJECTS WORK THROUGH DETAILS, DRAWINGS AND SPECIFICATIONS INCORPORATED INTO THESE CONSTRUCTION DOCUMENTS.
DURING CONSTRUCTION, IF POT ITEMS WITHIN THE SCOPE OF THE PROJECT REPRESENTED AS CODE COMPLIANT ARE FOUND TO BE NON CONFORMING BEYOND REASONABLE CONSTRUCTION TOLERANCES, THEY SHALL BE BROUGHT INTO COMPLIANCE WITH THE CBC AS PART OF THIS PROJECT BY MEANS OF A CONSTRUCTION CHANGE DOCUMENT.

PROFESSIONAL SEALS
PERMIT APPROVAL STAMP

PERMIT NO BP25-02229		
NO	REVISION	DATE
1	Owner Changes	08/11/25
2	Plan Review Corrections	09/08/25
3	Owner Changes	12/09/25

PUBLIC WORKS PROJECT MANAGER	
DEV NALLAMALA	
PRINCIPAL-IN-CHARGE	
TODD A. JESPersen AIA	
DRAWN BY	CHECKED BY
JONATHAN D. LEE AIA	TODD A. JESPersen AIA
ARCHITECTS JOB NO	DATE
24024	07/11/2025
PROJECT TITLE AND ADDRESS	

E. P. FOSTER LIBRARY MODERNIZATION


651 E MAIN ST,
VENTURA, CA 93001
COUNTY SPEC NUMBER CP26-12
COUNTY PROJECT NUMBER P6T24008
COUNTY DWG NO SHEET OF
SHEET TITLE

SITE PLAN

SHEET NO A-101

1 Site Plan
SCALE: 1" = 20'-0"

Addendum No. 1

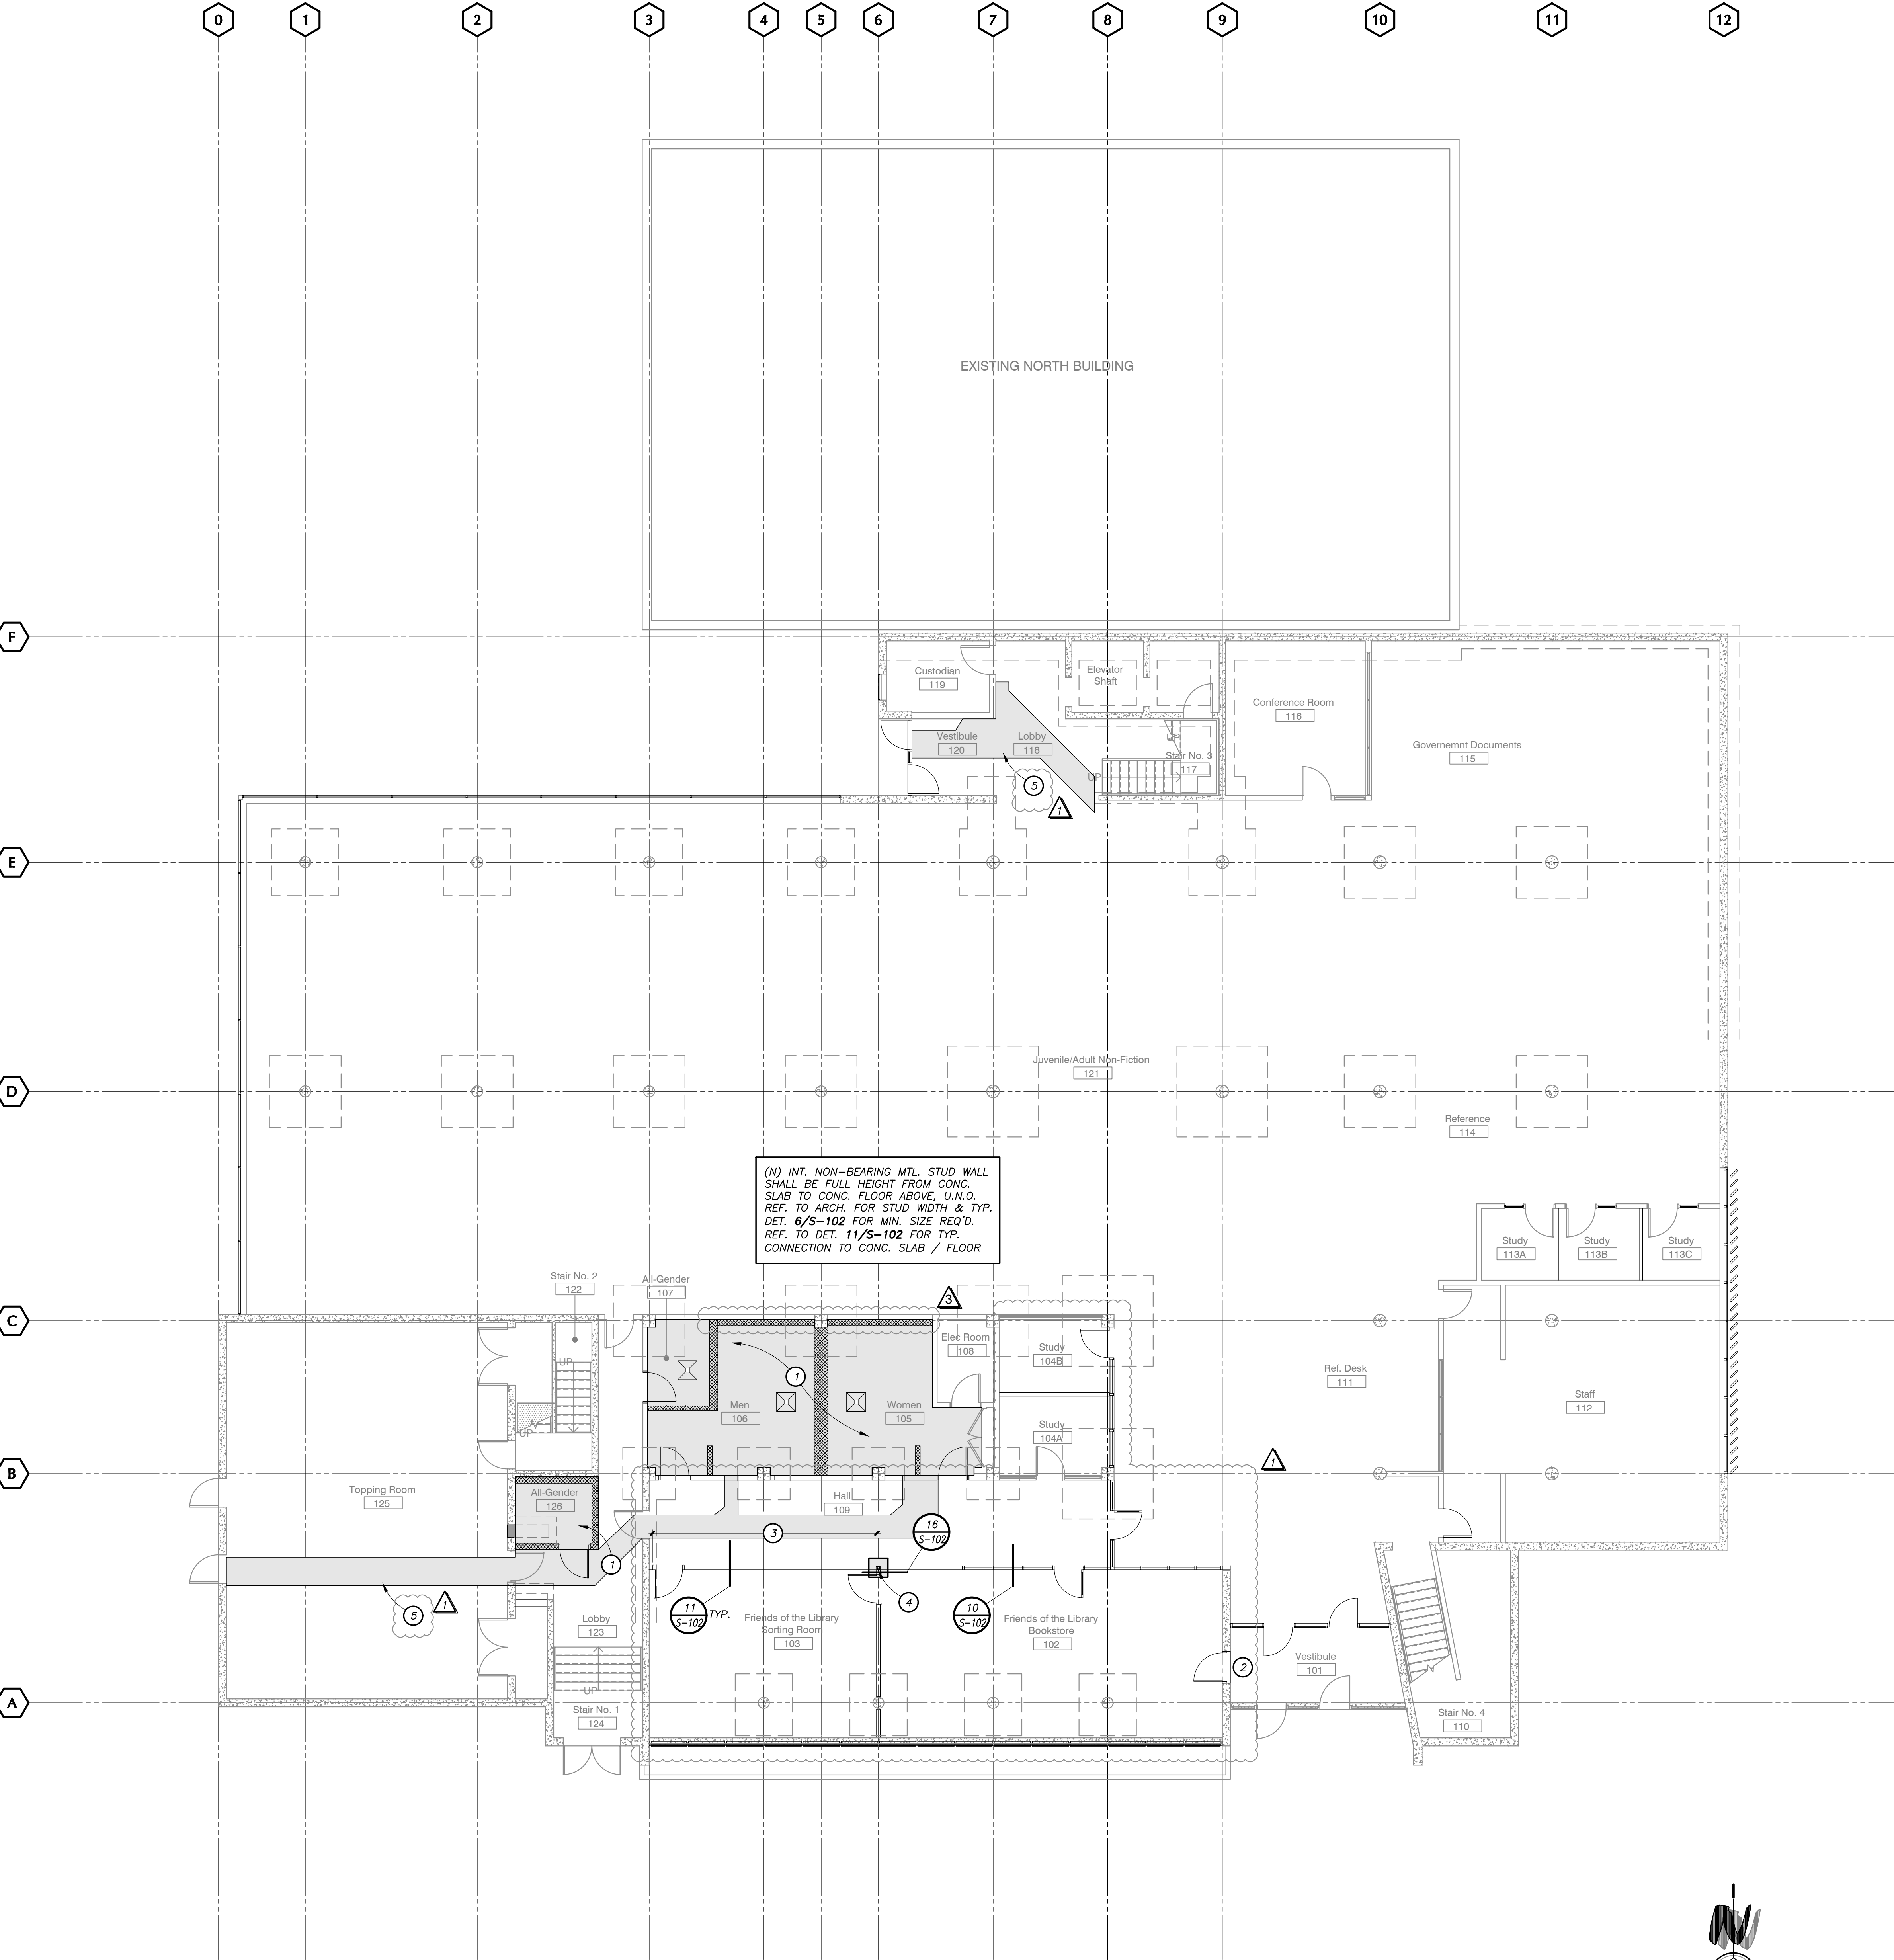

FOUNDATION PLAN NOTES :

A. REFER TO GENERAL NOTES SHEET S-001.
B. SEE ARCHITECTURAL PLANS FOR LOCATIONS OF ALL WALL OPENINGS, SLOPED AND DERESSED SLABS, CONCRETE CURBS, ADDITIONAL EMBEDDED ITEMS NOT SHOWN ON THESE DRAWINGS. VERIFY ALL BUILDING DIMENSIONS, SLOPES AND DERESSED SLAB DIMENSIONS WITH ARCHITECTURAL PLANS. BEFORE BEGINNING WORK, REPORT ANY DISCREPANCIES TO THE ARCHITECT FOR RESOLUTION.
C. SEE GENERAL NOTES AND SPECIFICATIONS FOR SPECIAL GRADING REQUIREMENTS UNDER FOOTINGS.
D. (E) INDICATES EXISTING
(N) INDICATES NEW

FOUNDATION KEYED NOTES :


1 (N) 4" CONC. SLAB-ON-GRADE PER TYP. DETS. 8 & 12/S-101
2 (E) WINDOW TO BE REPLACED w/ (N) DOOR OF SAME WIDTH PER ARCH DRAWINGS. SAWCUT & REMOVE (E) CONC. WALL PORTION BELOW THE WINDOW AS REQ'D. REF. TO DET. 13/S-101 FOR MORE INFO.
3 (N) PARTIAL HT. MTL. STUD WALL PER ARCH. REF. TO DET. 6/S-102 FOR MIN. STUD SIZE REQ'D. & DET. 14/S-102 FOR CONNECTION TO STEEL BEAM ABOVE
4 (N) HSS3 1/2x3 1/2x1/4 FULL HT. COL. & (N) 2'-0" SQ. MIN. CONC. PAD CENTERED COL. REF. TO 15/S-102 FOR CONN. TO CONC. FLOOR ABOVE & DET. 16/S-102 FOR CONN. TO CONC. SLAB
5 DEMO. (E) CONC. SLAB AS REQ'D. AT (N) PLUMBING, & PATCH UP PER DET. 12/S-102. REF. TO PLUMBING PLAN P3.0 FOR LOCATIONS

LEGEND :

(E) CONC. WALL
(E) CONC. FTG.
(N) CONC. S.O.G. PER DETS. 8 & 12/S-101
(N) MTL. STUD WALL PER PER ARCH. REF. TO DET. 6/S-102 FOR MIN. SIZE REQ'D.
(N) STOREFRONT PER ARCH. REF. TO DET. 9/S-102 FOR CONNECTION TO HANGING STUD ABOVE, 10/S-102 FOR CONNECTION TO PARTIAL HT. WALL BELOW, & 11/S-102 FOR CONN. TO CONC. SLAB/FLOOR, TYP.
(N) CONC. CURB PER DET. 12/S-101
(N) DRAIN PER DET. 12/S-101




PUBLIC
VENTURA COUNTY
WORKS

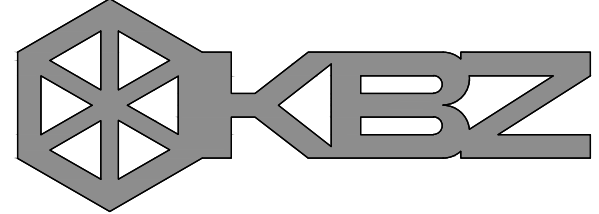

KRUGER BENSEN ZIEMER
ARCHITECTS, INC.
199 FIGUEROA STREET, SUITE 100A
VENTURA, CA 93001
TELEPHONE (805) 963-1726
TODD A JESPersen AIA
PRINCIPAL-IN-CHARGE
JONATHAN D LEE AIA
PROJECT MANAGER
All ideas, design arrangements and plans indicated or represented by drawings are owned by and are the property of Kruger-Bensen-Ziemer, Architects, and were created, evolved and developed for use on, and in connection with, the specified projects. None of such ideas, designs, arrangements or plans shall be used by or disclosed to any person, organization for any purpose whatsoever without the written permission of Kruger-Bensen-Ziemer.

Stork, Wolfe, & Associates
S w A
Structural Engineers
333 Chorro St., Ste. A1 San Luis Obispo, CA 93405
Tel. (805) 548-8600 Fax (805) 548-8601

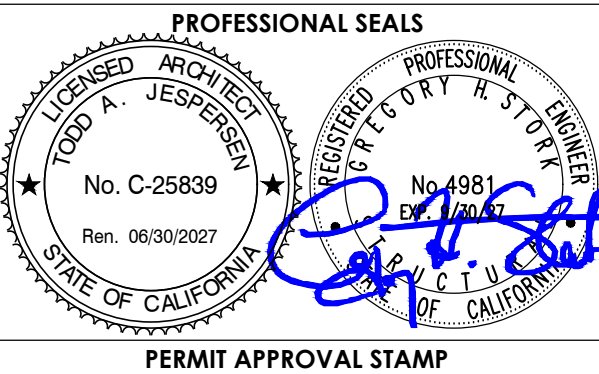

PERMIT NO		
NO	REVISION	DATE
1	OWNER CHANGES	08.11.25
2	PLAN REVIEW CORRECTIONS	09.08.25
3	OWNER CHANGES	12.09.25

PUBLIC WORKS PROJECT MANAGER
DEVI NALLAMALA
PRINCIPAL-IN-CHARGE
GREGORY H. STORK, SE
DRAWN BY
GHS
CHECKED BY
GHS
SWA JOB NO.
24018
DATE
07/11/2025
PROJECT TITLE AND ADDRESS

E. P. FOSTER
LIBRARY
MODERNIZATION

651 E MAIN ST.
VENTURA, CA 93001
COUNTY SPEC NUMBER
COUNTY PROJECT NUMBER
COUNTY DWG NO
SHEET
OF
SHEET TITLE

FOUNDATION PLAN

SHEET NO
S-201

ABBREVIATIONS	
AC AMPERES	IF INTERMEDIATE DISTRIBUTION FRAME
AG ALTERNATING CURRENT	IS ISOLATED GROUND
AF AMP FRAME/AMP FUSE	JB JUNCTION BOX
AFC AVAILABLE FAULT CURRENT	KV KILO VOLT
AFF ABOVE FINISHED FLOOR	KVA KILOVOLT AMPS=1000VA
AFG ABOVE FINISHED GRADE	KW KILOWATT
AIC AMPERES INTERRUPTING CAPACITY	CMIL THOUSANDS CIRCULAR MILS
AL ALUMINUM	LC LIGHTING
ARCH ARCHITECT	LC LIGHTING CONTACTOR
AS AMP SWITCH RATING	LV LOW VOLTAGE
AT AMP TRIP	MD MAIN DISTRIBUTION FRAME
ATS AUTOMATIC TRANSFER SWITCH	MT MAIN TELEPHONE BACKBOARD
AV AUDIO VISTA	MTB MOUNTED
AWG AMERICAN WIRE GAGE	MV MERCURY VAPOR
BLD BOARD	MTB METAL HALIDE
BLD BUILDING	MTB MANUFACTURER
BL BASIC IMPULSE LEVEL	MPOE MAIN POINT OF ENTRY
BLD BUILDING	NC NORMALLY CLOSED
BLD BUILDING	NEC NATIONAL ELECTRICAL CODE
BLD BUILDING	NOT IN CONTRACT
BLD BUILDING	NO NOT
BLD BUILDING	NTS NOT TO SCALE
BLD BUILDING	PO POWER OR POLE
BLD BUILDING	PROV PROVIDED BY OTHERS
BLD BUILDING	PNL PANEL
BLD BUILDING	RM REMOVED
BLD BUILDING	RGS RIGID GALVANIZED STEEL CONDUIT
BLD BUILDING	RM REMOVED
BLD BUILDING	SN SYSTEM NEUTRAL
BLD BUILDING	TC TIME CLOCK
BLD BUILDING	TTC TELEPHONE TERMINAL BOARD
BLD BUILDING	TR TRANSFORMER
BLD BUILDING	TR TYPICAL
BLD BUILDING	UON UNLESS OTHERWISE NOTED
BLD BUILDING	UNSW UNSWITCHED
BLD BUILDING	VA VOLT AMPERES
BLD BUILDING	V VOLTS/VOLTAGE
BLD BUILDING	WATTS/WATTAGE
BLD BUILDING	WP WEATHERPROOF
BLD BUILDING	W/ WITH
BLD BUILDING	(X) EXISTING

U.L. STANDARD 486B TORQUING RECOMMENDATIONS									
TIGHTENING TORQUE FOR SCREWS (a)									
TORQUE, POUND – INCHES									
WIRE SIZE	SLOT WIDTH (IN.)	SLOTTED HEAD		HEXAGONAL HEAD/EXTERNAL DRIVE SOCKET WRENCH		SPLIT-BOLT CONNECTORS		OTHER CONNECTORS	
		NO. 10 AND LARGER (b)	NO. 8 AND SMALLER (b)	NO. 10 AND LARGER (b)	NO. 8 AND SMALLER (b)	NO. 10 AND LARGER (b)	NO. 8 AND SMALLER (b)	NO. 10 AND LARGER (b)	NO. 8 AND SMALLER (b)
18-10 AWG	20	35	20	35	80	75			
8	25	40	25	40	80	75			
6	35	45	35	45	165	110			
4	—	45	—	45	165	110			
3	—	50	—	50	275	150			
2	—	50	—	50	275	150			
1	—	50	—	50	275	150			
1/0	—	50	—	50	385	180			
2/0	—	50	—	50	385	180			
3/0	—	50	—	50	500	250			
4/0	—	50	—	50	500	250			
250 kcmil	—	50	—	50	650	325			
300	—	50	—	50	650	325			
350	—	50	—	50	650	325			
400	—	50	—	50	825	325			
500	—	50	—	50	825	375			
600	—	50	—	50	1000	375			
700	—	50	—	50	1000	375			
750	—	50	—	50	1000	375			
800	—	50	—	50	1100	500			
900	—	50	—	50	1100	500			
1000	—	50	—	50	1100	500			
1250	—	—	—	—	1100	600			
1500	—	—	—	—	1100	600			
1750	—	—	—	—	1100	600			
2000	—	—	—	—	1100	600			

THIS TABLE GIVES RECOMMENDED CONNECTOR INSTALLING TORQUES FOR COPPER AND ALUMINUM CONDUCTORS. THEY ARE FOR GUIDANCE ONLY WHERE NO TIGHTENING INFORMATION IS AVAILABLE AND SHOULD NOT BE USED TO REPLACE MANUFACTURERS' INSTRUCTIONS WHICH SHOULD ALWAYS BE FOLLOWED.

- (a) CLAMPING SCREWS WITH MULTIPLE TIGHTENING MEANS, FOR EXAMPLE, FOR A SLOTTED HEXAGONAL HEAD SCREW, USE THE HIGHEST TORQUE VALUE ASSOCIATED WITH THE DIFFERENT TIGHTENING MEANS.
- (b) FOR VALUES OF SLOT WIDTH OR WIRE SIZE OTHER THAN THOSE SPECIFIED, SELECT THE LARGEST TORQUE VALUE ASSOCIATED WITH CONDUCTOR SIZE.

CEC ART. 310 CONDUCTOR DERATING	
NEC #310.15 (B)(3)(a) ADJUSTMENT FACTORS	
(a) MORE THAN THREE CURRENT-CARRYING CONDUCTORS IN A RACEWAY OR CABLE WHERE THE NUMBER OF CURRENT-CARRYING CONDUCTORS EXCEEDS THREE, THE ALLOWABLE AMPLIFY SHALL BE REDUCED AS SHOWN IN THE FOLLOWING TABLE:	
NUMBER OF CURRENT-CARRYING CONDUCTORS	PERCENT OF VALUES IN TABLES AS ADJUSTED FOR AMBIENT TEMPERATURE NECESSARY
4 THROUGH 6	80
7 THROUGH 9	70
10 THROUGH 12	60
13 THROUGH 20	50
21 THROUGH 30	45
31 THROUGH 40	40
41 AND ABOVE	35

WHERE SINGLE CONDUCTORS OR MULTICONDUCTOR CABLES ARE STACKED OR BUNDLED LONGER THAN 24 INCHES (610 mm) WITHOUT MAINTAINING SPACING AND ARE NOT INSTALLED IN RACEWAYS, THE ALLOWABLE AMPLIFY OF EACH CONDUCTOR SHALL BE REDUCED AS SHOWN IN THE ABOVE TABLE.

EXCEPTION NO. 1: WHERE CONDUCTORS OF DIFFERENT SYSTEMS, AS PROVIDED IN SECTION 300-3, ARE INSTALLED IN A COMMON RACEWAY OR CABLE, THE DERATING FACTORS SHOWN ABOVE SHALL APPLY TO THE NUMBER OF POWER AND LIGHTING (ARTICLES 210, 215, 220, AND 230) CONDUCTORS ONLY.

EXCEPTION NO. 2: FOR CONDUCTORS INSTALLED IN CABLE TRAYS, THE PROVISIONS OF SECTION 392.11 SHALL APPLY.

EXCEPTION NO. 3: DERATING FACTORS SHALL NOT APPLY TO CONDUCTORS IN NIPPLES HAVING A LENGTH NOT EXCEEDING 24 INCHES (600mm).

EXCEPTION NO. 4: DERATING FACTORS SHALL NOT APPLY TO UNDERGROUND CONDUCTORS ENTERING OR LEAVING AN OUTDOOR TRENCH IF THOSE CONDUCTORS HAVE PHYSICAL PROTECTION IN THE FORM OF RIGID METAL CONDUIT, INTERMEDIATE METAL CONDUIT, OR RIGID NONMETALLIC CONDUIT HAVING A LENGTH NOT EXCEEDING 10 FEET (3.05m) ABOVE GRADE AND THE NUMBER OF CONDUCTORS DOES NOT EXCEED FOUR.

CEC WIRE FILL TABLE 314.16(a)						
JUNCTION BOX DIMENSION, INCHES TRADE SIZE OR TYPE	MIN. CU. IN. CAP.	MAXIMUM NUMBER OF CONDUCTORS				
		NO.14	NO.12	NO.10	NO.8	NO.6
4 x1-1/4 ROUND OR OCTAGONAL	12.5	6	5	5	5	2
4 x1-1/2 ROUND OR OCTAGONAL	15.5	7	6	6	5	3
4 x2-1/8 ROUND OR OCTAGONAL	21.5	10	9	8	7	4
4 x1-1/4 SQUARE	18.0	9	8	7	6	3
4 x1-1/2 SQUARE	21.0	10	9	8	7	4
4 x2-1/8 SQUARE	30.3	15	13	12	10	6
4-11/16 x1-1/4 SQUARE	25.5	12	11	10	8	5
4-11/16 x1-1/2 SQUARE	29.5	14	13	11	9	5
4-11/16 x2-1/8 SQUARE	40.2	21	18	16	14	8
3 x2 x1-1/2 DEVICE	7.5	3	3	3	2	1
2 x2 DEVICE	10.0	5	4	4	3	2
3 x2 x2-1/4 DEVICE	10.5	5	4	4	3	2
3 x2 x2-1/2 DEVICE	12.5	6	5	5	4	2
3 x2 x2-3/4 DEVICE	14.0	7	6	5	4	2
3 x2 x3-1/2 DEVICE	18.0	9	8	7	6	3
4 x2-1/8 x1-1/2 DEVICE	10.3	5	4	4	3	2
4 x2-1/8 x1-7/8 DEVICE	13.0	6	5	5	4	2
4 x2-1/8 x2-1/8 DEVICE	14.5	7	6	5	4	2
3-3/4 x2 x2-1/2 MASONRY BOX / GANG	14.0	7	6	5	4	2
3-3/4 x2 x3-1/2 MASONRY BOX / GANG	21.0	10	9	8	7	4
FS – MINIMUM INTERNAL DEPTH 1-3/4 SINGLE COVER / GANG	13.5	6	6	5	4	2
FD – MINIMUM INTERNAL DEPTH 2-3/8 SINGLE COVER / GANG	18.0	9	8	7	6	3
FS – MINIMUM INTERNAL DEPTH 1-3/4 MULTIPLE COVER / GANG	18.0	9	8	7	6	3
FD – MINIMUM INTERNAL DEPTH 2-3/8 MULTIPLE COVER / GANG	24.0	12	10	9	8	4

GENERAL ELECTRICAL NOTES	
A. GENERAL	
1. SCOPE	THE DRAWINGS AND THESE GENERAL NOTES DESCRIBE THE SCOPE OF WORK AND SYSTEMS. THE MATERIAL REQUIRED FOR THE WORK SHALL BE THE CONTRACTOR'S RESPONSIBILITY. THE CONTRACTOR SHALL BE RESPONSIBLE FOR OBTAINING ALL NECESSARY PERMITS, INSPECTION FEES, AND OTHER CHARGES BY AGENCIES HAVING JURISDICTION.
2. PERMITS AND CHARGES	OBTAIN AND PAY FOR ALL NECESSARY CONSTRUCTION PERMITS, INSPECTION FEES, AND OTHER CHARGES BY AGENCIES HAVING JURISDICTION.
3. REGULATIONS AND CODES	PROVIDE AND INSTALL ALL MATERIALS IN CONFORMANCE WITH THE NATIONAL ELECTRICAL CODE, CALIFORNIA ADMINISTRATIVE CODE TITLE 8, AND OTHER CODES AND REGULATIONS HAVING JURISDICTION. INSTALL ALL EQUIPMENT IN ACCORDANCE WITH THE REQUIREMENTS OF THE INSPECTING AUTHORITY AND THE MANUFACTURERS' RECOMMENDATIONS.
4. EXECUTION	CAREFULLY PROTECT ALL WALLS, TRIM, FLOORS, EQUIPMENT UTILITY LINES AND MATERIALS. WHEN WORKING ON FINISHED SURFACES, LIMIT DAMAGE TO THE CONFINES AS MUCH AS POSSIBLE AND RESTORE TO THE ORIGINAL CONDITION ALL SURFACES WHICH ARE DAMAGED BECAUSE OF THE INSTALLATION OF THIS WORK.
5. EQUIPMENT, MATERIALS AND SUPPLIES	EQUIPMENT, MATERIALS AND SUPPLIES REMOVED FOR PROTECTION SHALL BE REPLACED IN ORIGINAL LOCATIONS. ANY MATERIALS DAMAGED SHALL BE REPLACED WITH NEW MATERIALS OF LIKE KIND AND QUALITY.
6. DRILLING, CUTTING, CHANNELING AND PATCHING	REQUIRED TO INSTALL ELECTRICAL WORK AS INDICATED OR HEREIN SPECIFIED. ALL HOLES, CURRS, ETC., IN FLOORS, CEILINGS AND WALLS SHALL BE PATCHED, UNLESS INDICATED OTHERWISE. PAINT ALL NEW ELECTRICAL RACEWAYS, CABINETS, ENCLOSURES AND FITTINGS PENETRATING INTO FIRE RATED ENVELOPES, SPACES, ETC.
7. CONDUIT RUNS	ALL CONDUIT RUNS SHALL BE CONCEALED, UNLESS SHOWN OTHERWISE. PROVIDE A PULL WIRE IN ALL EMPTY CONDUITS.
8. EXISTING CONDITION	SHOWN IS FROM AVAILABLE RECORD DRAWINGS AND VISUAL FIELD SURVEY AND SHOWN FOR REFERENCE ONLY. CONTRACTOR SHALL VERIFY ACTUAL EXISTING CONDITION AT SITE.
9. ALL WORK SHOWN IS NEW UNLESS SPECIALLY INDICATED AS EXISTING (X). ALL ELECTRICAL EQUIPMENT MOUNTING AND ANCHORAGE MUST CONFORM WITH LOCAL AND STATE SEISMIC CODES.	
10. PROVIDE RACEWAYS, CAT 6 CABLE, PATCH PANELS, JACKS, TERMINATIONS, BOXES, SUPPORTS, AND ALL MATERIAL INCLUDING PULLING NEW CABLE FROM IDF TO OUTLET AT DESK OR WORKSTATION.	
11. GROUNDING & BONDING	FURNISH AND INSTALL COMPLETE BONDING AND GROUNDING SYSTEM AS REQUIRED BY CODES. CONTINUITY OF GROUNDING SHALL BE MAINTAINED MECHANICALLY AND ELECTRICALLY THROUGHOUT THE SYSTEM. A GREEN GROUNDING CODE SIZED CONDUCTOR SHALL BE CARRIED IN ALL CONDUITS.
12. INSTALLATION	IT IS THE INTENT OF THESE PLANS AND SPECIFICATIONS THAT A COMPLETE AND WORKABLE ELECTRICAL INSTALLATION BE PROVIDED FOR ALL THE EQUIPMENT DESCRIBED OR SHOWN AS REQUIRED BY THE PLANS. THE CONTRACTOR SHALL BE RESPONSIBLE FOR OBTAINING ALL NECESSARY PERMITS, INSPECTION FEES, AND OTHER CHARGES BY AGENCIES HAVING JURISDICTION.
13. PROCUREMENT	ALL PERMITS FROM LEGALLY CONSTITUTED AUTHORITIES, ARRANGE FOR ALL INSPECTIONS AND PAY ALL COSTS FOR FEES AND TESTS IN CONNECTION THEREWITH. COMPLY WITH CODES: NOTHING IN THESE PLANS AUTHORIZES DEVIATION FROM APPLICABLE CODES.
14. DETERMINE EXISTING	ROUTING OF CONCEALED FEEDERS AND BRANCH HOMERUNS IN COOPERATION WITH OTHER TRADES TO SIMPLIFY INSTALLATION WHEREVER POSSIBLE BUT SUBJECT TO APPROVAL OF ARCHITECT FOR VISUAL AND STRUCTURAL REASONS.
15. PROVIDE A CODE APPROVED DISCONNECT SWITCH OR BREAKER WITHIN SIGHT OF EVERY MOTOR AND FEED MOTORS NOT EQUIPPED WITH "BUILT IN" PROTECTION THROUGH A MAGNETIC OR MANUAL STARTER WITH OVERLOAD HEATERS SIZED TO COMPLY WITH MOTOR MANUFACTURER'S RECOMMENDATIONS AND APPLICABLE CODES.	
16. FOR CONNECTIONS TO EXHAUST FANS, PUMPS, COMPRESSORS, SPACE HEATERS, WATER HEATERS, AQUASTATS, SOLENOID VALVES AND OTHER MECHANICAL EQUIPMENT AND FOR CONDUITS AND WIRE REQUIRED BUT NOT NECESSARILY SHOWN ON THESE DRAWINGS REFER TO MECHANICAL PLANS AND DETERMINE EXACT LOCATIONS UNDER DIRECTION OF HEATING AND VENTILATING CONTRACTOR.	
17. DO NOT RUN ANY CONDUIT IN SLAB IF ITS OUTSIDE DIAMETER EXCEEDS 1/3 THE THICKNESS OF THE SLAB. LOCATE CONDUITS WITHIN THE MIDDLE OF THE SLAB WHERE CONDUITS ARE GROUPED IN PARALLEL RUNS. SPACE THEM 3" OR MORE APART. WHERE CONDUITS CROSS EACH OTHER, THICKEN SLAB PROPORTIONATELY OVER A HORIZONTAL AREA EQUAL TO TEN TIMES THE DIAMETER OF THE LARGEST CONDUIT. REFER ALSO TO DETAILS SHOWN.	
18. SIZE OUTLET BOXES IN CONFORMITY WITH CODE FOR NUMBER AND GAUGE OF CONDUCTORS THEREIN, EXCEPT WHERE NOTED TO BE LARGER. MINIMUM BOX SIZE SHALL BE 4" SQUARE BY 1-1/2" DEEP.	
19. EXAMINE PLANS TO DISCERN CEILINGS WITH A FIRE RATING OF ONE HOUR OR MORE, PROVIDE A ONE HOUR FIRE-RATED ENCLOSURE OVER EACH LIGHT FIXTURE RECESSED THEREIN.	
20. ALL ELECTRICAL WORK SHALL BE INSTALLED SO AS TO BE READILY ACCESSIBLE FOR OPERATING, SERVICING, MAINTAINING AND REPAIRING. ALL CONDUIT SHALL BE CONCEALED WHERE POSSIBLE. EXPOSED CONDUIT SHALL BE IN STRAIGHT LINES PARALLEL WITH, OR AT RIGHT ANGLES TO, WALLS, CEILINGS, FLOORS, AND PARTITIONS. BY AT LEAST THREE (3) INCHES FROM WATER LINES WHENEVER THEY RUN LONG SIDE OR ACROSS SUCH LINES. CONDUIT SHALL NOT BE RUN BELOW CABLE TRAYS OR LIGHT FIXTURES WITHOUT SPECIFIC APPROVAL OF THE OWNERS REPRESENTATIVE. HANGERS SHALL BE FASTENED TO STEEL CONCRETE MASONRY, BUT NOT TO PIPING, HANGERS AND SUPPORT SYSTEMS ARE AN INTEGRAL PART OF THE VISUAL ENVIRONMENT. ALL HANGERS AND SUPPORTS EXPOSED TO PUBLIC VIEW MUST BE SHOWN IN DETAIL ON PLANS SUBMITTED TO OBTAIN APPROVAL OF ARCHITECT. ALL HANGERS MUST BE UNIFORM IN APPEARANCE AND NEATLY INSTALLED WITH NO EXCESS MATERIAL BEYOND WHAT IS REQUIRED FOR THE SUPPORT FUNCTION. CONTRACTOR SHALL SELECT ACCESSORIES AND HARDWARE WITH A SMOOTH, NEAT FINISHED APPEARANCE AND PAINT ALL EXPOSED CONDUIT HANGERS TO MATCH THE ADJACENT FINISHES.	
21. ALL WALL SWITCHES AND RECEPTACLES SHALL BE MOUNTED BETWEEN 18" AND 48" TO TOP OF OUTLET BOX PER ADA REQUIREMENTS UNLESS NOTED OTHERWISE.	
22. ELECTRICAL SWITCHES, CONTROLS AND SWITCHES INTENDED TO BE USED BY THE OCCUPANT OF THE ROOM OR AREA TO CONTROL LIGHTING AND RECEPTACLE OUTLETS, APPLIANCES OR COOLING, HEATING AND VENTILATING EQUIPMENT SHALL BE INSTALLED AT A HEIGHT OF 48 INCHES MEASURED FROM THE TOP OF OUTLET BOX OR LESS THAN 15 INCHES MEASURED FROM THE BOTTOM OF THE OUTLET BOX TO THE LEVEL OF THE FINISH FLOOR OR WORKING PLATFORM.	
23. ALL DISTRIBUTION BOARDS, SWITCHBOARDS AND TRANSFORMERS THAT ARE FLOOR MOUNTED SHALL BE MOUNTED ON 4" THICK HOUSEKEEPING PAD. TRANSFORMER SHALL BE ON VIBRATION ISOLATION PADS AND CONNECTED WITH FLEXIBLE CONDUIT.	
24. CONTRACTOR SHALL EXAMINE PLANS AND VERIFY IN FIELD LOCATIONS OF ALL FIRE RATED WALLS, CEILINGS AND FLOORS. CONTRACTOR SHALL SEAL ALL ELECTRICAL SYSTEM PENETRATIONS THROUGH FIRE RATED WALLS, CEILINGS AND FLOORS WITH U.L. LISTED MATERIAL APPROVED BY THE AUTHORITY HAVING JURISDICTION.	
25. SURFACE MOUNTED RACEWAY COMPLETENESS: CONTRACTOR SHALL PROVIDE ALL RACEWAY, FITTINGS, SUPPORTS, BOXES, DEVICES PLATES, ETC. NECESSARY FOR A COMPLETE RACEWAY SYSTEM. CONTRACTOR SHALL PROVIDE ALL RACEWAY, FITTINGS, SUPPORTS, BOXES, DEVICES PLATES, ETC. NECESSARY FOR A COMPLETE RACEWAY SYSTEM. CONTRACTOR SHALL PROVIDE ALL RACEWAY, FITTINGS, SUPPORTS, BOXES, DEVICES PLATES, ETC. NECESSARY FOR A COMPLETE RACEWAY SYSTEM. CONTRACTOR SHALL PROVIDE ALL RACEWAY, FITTINGS, SUPPORTS, BOXES, DEVICES PLATES, ETC. NECESSARY FOR A COMPLETE RACEWAY SYSTEM.	
26. FIRE ALARM SYSTEM (DESIGN BUILD) BY CONTRACTOR CONTRACTOR SHALL PROVIDE AND INSTALL A FIRE ALARM SYSTEM FOR THE PROJECT AREA TO INCLUDE:	
27. SMOKE DETECTORS IN ALL REQUIRED AREAS	
28. DETECTOR DETECTORS IN ALL REQUIRED AREAS	
29. STROBES/ALARMS IN ALL REQUIRED AREAS	
30. CARBON MONOXIDE DETECTORS IN ALL REQUIRED AREAS	
31. PULL STATIONS AT ALL LEGAL FIRE EXITS – WHERE REQUIRED	
32. TAMPER AND FLOW SWITCHES AT FIRE SPRINKLER RISERS & BACKFLOW PREVENTERS	
33. BRANCH CIRCUIT & CONTROL WIRING TO FIRE SPRINKLER ALARM BELLS	
34. ELEVATOR SMOKE DETECTORS, RECALL PANEL, SHUNT TRIP, ETC. AS REQUIRED.	
35. SMOKE / FIRE DAMPER / INAD UNIT SHUT DOWN BRANCH CIRCUIT WIRING	
36. CONTROL WIRING, CONTROL DEVICES, RELAYS, ETC. SEE MECHANICAL PLANS FOR ADDITIONAL INFORMATION.	
37. PROVIDE REMOTE INDICATORS BELOW CEILINGS FOR ALL DETECTORS, SMOKE FIRE DAMPERS, ETC. WHERE INSTALLED IN RECESSED LOCATIONS PER NFPA 72 & LOCAL AUTHORITY HAVING JURISDICTION.	
38. ALL VALVES CONTROLLING THE WATER SUPPLY FOR AUTOMATIC SPRINKLER SYSTEMS, PUMP, WATER FLOW SWITCHES ON ALL SPRINKLER SYSTEMS SHALL BE ELECTRICALLY SUPERVISED.	
39. CONTRACTOR SHALL SUBMIT FOR THE OWNERS SIGNED APPROVAL, APPROVED FIRE DEPARTMENT FIRE ALARM DRAWINGS FOR THE PROJECT AREA TO INCLUDE:	
40. CONTRACTOR SHALL BE BAY ALARM OR OWNER APPROVED EQUAL.	
41. ALL DEVICES AND EQUIPMENT SHALL BE CALIFORNIA STATE FIRE MARSHAL APPROVED.	
42. CONTRACTOR SHALL WARRANTY ALL DEVICES AND SYSTEMS FOR A PERIOD OF TWO YEARS.	
43. CONTRACTOR SHALL PROVIDE 6 (SIX) SETS OF FIRE ALARM MANUALS FOR ALL SYSTEMS AND DEVICES IN ADDITION TO 6 (SIX) SETS OF A SYSTEM OPERATIONAL MANUAL TAILORED FOR THE PROJECT SPACE.	
44. CONTRACTOR SHALL PROVIDE A FIRE ALARM CONTROL PANEL INDIVIDUALLY ADDRESSABLE TOTALLY SUPERVISED BACK-UP FOR 24 HOURS OF MONITORING INITIATING CIRCUITS PLUS 30 MINUTES OF ALARM WITH DUAL RATE BATTERY CHARGER.	
45. CONTRACTOR SHALL PROVIDE A SATISFACTORY SYSTEM TEST IN THE PRESENCE OF THE OWNER, FIRE PREVENTION BUREAU AND CONSULTING ENGINEER.	
46. CONTRACTOR SHALL PROVIDE A CENTRAL MASTER ANNUNCIATOR PANEL IN THE ELECTRICAL ROOM PER LOCAL FIRE MARSHAL.	
47. CONTRACTOR SHALL PROVIDE ALL CONNECTION TO POWER PLANS, CONDUIT AND WIRE AND CONNECTIONS REQUIRED TO PROVIDE AN OPERATIONAL FIRE ALARM EVACUATION SYSTEM.	
48. SUBMITTAL DOCUMENTS FOR DEFERRED ITEMS SHALL BE SUBMITTED TO THE REGISTERED DESIGN PROFESSIONAL IN RESPONSIBLE CHARGE, WHO SHALL REVIEW THEM AND FORWARD THEM TO THE BUILDING OFFICIAL WITH A NOTATION INDICATING THAT THE DEFERRED DOCUMENTS HAVE BEEN REVIEWED AND THAT THEY HAVE BEEN FOUND TO BE IN GENERAL CONFORMANCE WITH DESIGN OF THE BUILDING. THE DEFERRED ITEMS SHALL NOT BE INSTALLED UNTIL THEIR DESIGN AND SUBMITTAL DOCUMENTS HAVE BEEN APPROVED BY THE BUILDING OFFICIAL.	
49. CONTRACTOR SHALL PROVIDE PERMANENT SIGNAGE AT ALL HIGH VOLTAGE ENCLOSURES, FENCING, ROOMS, VAULTS, ETC. PER CEC 110.13(4)(C). SIGNAGE SHALL READ "DANGER-HIGH VOLTAGE-KEEP OUT"	
50. ALL SWITCHBOARDS & PANELBOARDS SHALL BE FIELD MARKED TO WARN QUALIFIED PERSONS OF POTENTIAL ELECTRICAL ARC FLASH HAZARDS. PER CEC 110.16 THE MARKING SHALL BE LOCATED SO AS TO BE CLEARLY VISIBLE TO QUALIFIED PERSONS BEFORE EXAMINATION, ADJUSTMENT, SERVICING, OR MAINTENANCE OF THE EQUIPMENT.	
51. CONTRACTOR SHALL PROVIDE PERMANENT SIGNAGE AT ALL HIGH VOLTAGE ENCLOSURES, FENCING, ROOMS, VAULTS, ETC. PER CEC 110.13(4)(C). SIGNAGE SHALL READ "DANGER-HIGH VOLTAGE-KEEP OUT"	
52. ALL SWITCHBOARDS & PANELBOARDS SHALL BE FIELD MARKED TO WARN QUALIFIED PERSONS OF POTENTIAL ELECTRICAL ARC FLASH HAZARDS. PER CEC 110.16 THE MARKING SHALL BE LOCATED SO AS TO BE CLEARLY VISIBLE TO QUALIFIED PERSONS BEFORE EXAMINATION, ADJUSTMENT, SERVICING, OR MAINTENANCE OF THE EQUIPMENT.	

CEC 110.34(C)	
CONTRACTOR SHALL PROVIDE PERMANENT SIGNAGE AT ALL HIGH VOLTAGE ENCLOSURES, FENCING, ROOMS, VAULTS, ETC. PER CEC 110.13(4)(C). SIGNAGE SHALL READ "DANGER-HIGH VOLTAGE-KEEP OUT"	
CEC 110.16	
ALL SWITCHBOARDS & PANELBOARDS SHALL BE FIELD MARKED TO WARN QUALIFIED PERSONS OF POTENTIAL ELECTRICAL ARC FLASH HAZARDS. PER CEC 110.16 THE MARKING SHALL BE LOCATED SO AS TO BE CLEARLY VISIBLE TO QUALIFIED PERSONS BEFORE EXAMINATION, ADJUSTMENT, SERVICING, OR MAINTENANCE OF THE EQUIPMENT.	

GENERAL ELECTRICAL NOTES

C. DEMOLITION

NOTIFY THE OWNER IMMEDIATELY WHEREVER EXISTING EQUIPMENT IS ENCOUNTERED WHICH MUST BE RELOCATED DUE TO THE NEW CONSTRUCTION, AND WHICH IS NOT INDICATED ON THE PLANS.

1. ALL REMOVED MATERIALS AND EQUIPMENT WHICH ARE SALVAGEABLE SHALL REMAIN THE PROPERTY OF THE OWNER. DELIVER SUCH SALVAGED MATERIALS AND EQUIPMENT ON THE PREMISES AS DIRECTED BY OWNER, AND NEATLY PILE OR STORE THEM AND PROTECT FROM DAMAGE. REMOVE FROM PREMISES AND DISPOSE OF ALL MATERIALS CONSIDERED BY THE OWNER TO BE SCRAP.

2. ALL DEVICES, CIRCUITS CONDUCTORS, FEEDERS ETC., WHEN NOTED TO BE REMOVED, SHALL BE REMOVED TO THE LAST ACTIVE DEVICE. ALL OVER-CURRENT PROTECTION AND DISCONNECT DEVICES NO LONGER UTILIZED BUT REMAINING AS LAST ACTIVE DEVICE SHALL BE LABELED AS "SPARE", COORDINATE ALL OUTAGES WITH OWNERS REPRESENTATIVE.

D. EXECUTION

CAREFULLY PROTECT ALL WALLS, TRIM, FLOORS, EQUIPMENT UTILITY LINES AND MATERIALS. WHEN WORKING ON FINISHED SURFACES, LIMIT DAMAGE TO THE CONFINES AS MUCH AS POSSIBLE AND RESTORE TO THE ORIGINAL CONDITION ALL SURFACES WHICH ARE DAMAGED BECAUSE OF THE INSTALLATION OF THIS WORK.

1. EQUIPMENT, MATERIALS AND SUPPLIES REMOVED FOR PROTECTION SHALL BE REPLACED IN ORIGINAL LOCATIONS. ANY MATERIALS DAMAGED SHALL BE REPLACED WITH NEW MATERIALS OF LIKE KIND AND QUALITY.

2. DO ALL DRILLING, CUTTING, CHANNELING AND PATCHING REQUIRED TO INSTALL ELECTRICAL WORK AS INDICATED OR HEREIN SPECIFIED. ALL HOLES, CURBS, ETC., IN FLOORS, CEILINGS AND WALLS SHALL BE PATCHED, UNLESS INDICATED OTHERWISE. PAINT ALL NEW ELECTRICAL RACEWAYS, CABINETS, ENCLOSURES AND FITTINGS PENETRATING INTO FIRE RATED ENVELOPES, SPACES, ETC.

3. ALL CONDUIT RUNS SHALL BE CONCEALED, UNLESS SHOWN OTHERWISE. PROVIDE A PULL WIRE IN ALL EMPTY CONDUITS.

4. EXISTING CONDITION SHOWN IS FROM AVAILABLE RECORD DRAWINGS AND VISUAL FIELD SURVEY AND SHOWN FOR REFERENCE ONLY. CONTRACTOR SHALL VERIFY ACTUAL EXISTING CONDITION AT SITE.

5. ALL WORK SHOWN IS NEW UNLESS SPECIALLY INDICATED AS EXISTING (X). ALL ELECTRICAL EQUIPMENT MOUNTING AND ANCHORAGE MUST CONFORM WITH LOCAL AND STATE SEISMIC CODES.

E. VOICE/DATA SYSTEMS

PROVIDE RACEWAYS, CAT 6 CABLE, PATCH PANELS, JACKS, TERMINATIONS, BOXES, SUPPORTS, AND ALL MATERIAL INCLUDING PULLING NEW CABLE FROM IDF TO OUTLET AT DESK OR WORKSTATION.

F. GROUNDING & BONDING

FURNISH AND INSTALL COMPLETE BONDING AND GROUNDING SYSTEM AS REQUIRED BY CODES. CONTINUITY OF GROUNDING SHALL BE MAINTAINED MECHANICALLY AND ELECTRICALLY THROUGHOUT THE SYSTEM. A GREEN GROUNDING CODE SIZED CONDUCTOR SHALL BE CARRIED IN ALL CONDUITS.

G. INSTALLATION

IT IS THE INTENT OF THESE PLANS AND SPECIFICATIONS THAT A COMPLETE AND WORKABLE ELECTRICAL INSTALLATION BE PROVIDED FOR ALL THE EQUIPMENT DESCRIBED OR SHOWN AS REQUIRED BY THE PLANS. THE CONTRACTOR SHALL BE RESPONSIBLE FOR OBTAINING ALL NECESSARY PERMITS, INSPECTION FEES, AND OTHER CHARGES BY AGENCIES HAVING JURISDICTION.

1. PROCURE ALL PERMITS FROM LEGALLY CONSTITUTED AUTHORITIES, ARRANGE FOR ALL INSPECTIONS AND PAY ALL COSTS FOR FEES AND TESTS IN CONNECTION THEREWITH. COMPLY WITH CODES: NOTHING IN THESE PLANS AUTHORIZES DEVIATION FROM APPLICABLE CODES.

2. DETERMINE EXIST ROUTING OF CONCEALED FEEDERS AND BRANCH HOMERUNS IN COOPERATION WITH OTHER TRADES TO SIMPLIFY INSTALLATION WHEREVER POSSIBLE BUT SUBJECT TO APPROVAL OF ARCHITECT FOR VISUAL AND STRUCTURAL REASONS.

3. PROVIDE A CODE APPROVED DISCONNECT SWITCH OR BREAKER WITHIN SIGHT OF EVERY MOTOR AND FEED MOTORS NOT EQUIPPED WITH "BUILT IN" PROTECTION THROUGH A MAGNETIC OR MANUAL STARTER WITH OVERLOAD HEATERS SIZED TO COMPLY WITH MOTOR MANUFACTURER'S RECOMMENDATIONS AND APPLICABLE CODES.

4. FOR CONNECTIONS TO EXHAUST FANS, PUMPS, COMPRESSORS, SPACE HEATERS, WATER HEATERS, AQUASTATS, SOLENOID VALVES AND OTHER MECHANICAL EQUIPMENT AND FOR CONDUITS AND WIRE REQUIRED BUT NOT NECESSARILY SHOWN ON THESE DRAWINGS REFER TO MECHANICAL PLANS AND DETERMINE EXACT LOCATIONS UNDER DIRECTION OF HEATING AND VENTILATING CONTRACTOR.

5. DO NOT RUN ANY CONDUIT IN SLAB IF ITS OUTSIDE DIAMETER EXCEEDS 1/3 THE THICKNESS OF THE SLAB. LOCATE CONDUITS WITHIN THE MIDDLE OF THE SLAB WHERE CONDUITS ARE GROUPED IN PARALLEL RUNS. SPACE THEM 3" OR MORE APART. WHERE CONDUITS CROSS EACH OTHER, THICKEN SLAB PROPORTIONATELY OVER A HORIZONTAL AREA EQUAL TO TEN TIMES THE DIAMETER OF THE LARGEST CONDUIT. REFER ALSO TO DETAILS SHOWN.

6. SIZE OUTLET BOXES IN CONFORMITY WITH CODE FOR NUMBER AND GAUGE OF CONDUCTORS THEREIN, EXCEPT WHERE NOTED TO BE LARGER. MINIMUM BOX SIZE SHALL BE 4" SQUARE BY 1-1/2" DEEP.

7. EXAMINE PLANS TO DISCERN CEILINGS WITH A FIRE RATING OF ONE HOUR OR MORE, PROVIDE A ONE HOUR FIRE-RATED ENCLOSURE OVER EACH LIGHT FIXTURE RECESSED THEREIN.

8. ALL ELECTRICAL WORK SHALL BE INSTALLED SO AS TO BE READILY ACCESSIBLE FOR OPERATING, SERVICING, MAINTAINING AND REPAIRING. ALL CONDUIT SHALL BE CONCEALED WHERE POSSIBLE. EXPOSED CONDUIT SHALL BE IN STRAIGHT LINES PARALLEL WITH, OR AT RIGHT ANGLES TO, COLUMN LINES OR BEAMS AND SEPARATED BY AT LEAST THREE (3) INCHES. WHERE CONDUITS CROSS EACH OTHER, THICKEN SLAB PROPORTIONATELY OVER A HORIZONTAL AREA EQUAL TO TEN TIMES THE DIAMETER OF THE LARGEST CONDUIT. REFER ALSO TO DETAILS SHOWN.

9. ALL WALL SWITCHES AND RECEPTACLES SHALL BE MOUNTED BETWEEN 18" AND 48" TO TOP OF OUTLET BOX, PER ADA REQUIREMENTS, UNLESS NOTED OTHERWISE.

10. ELECTRICAL SWITCHES, CONTROLS AND SWITCHES INTENDED TO BE USED BY THE OCCUPANT OF THE ROOM OR AREA SHALL BE LOCATED TO PROVIDE ACCESS TO ALL RECEPTACLES, AIR COOLING, HEATING AND VENTILATING EQUIPMENT, SHALL BE LOCATED NO MORE THAN 48 INCHES MEASURED FROM THE TOP OF OUTLET BOX NOR MORE THAN 15 INCHES MEASURED FROM THE BOTTOM OF THE RECEPTACLE OUTLET BOX OR RECEPTACLE MOUNTING TO THE LEVEL OF THE FINISH FLOOR OR WORKING PLATFORM.

11. ELECTRICAL RECEPTACLE OUTLETS. ELECTRICAL RECEPTACLE OUTLETS ON BRANCH CIRCUITS OF 30 AMPERES OR LESS AND COMMUNICATION SYSTEM RECEPTACLES SHALL BE LOCATED NO MORE THAN 48 INCHES MEASURED FROM THE TOP OF THE RECEPTACLE OUTLET BOX OR RECEPTACLE HOUSING NOR LESS THAN 15 INCHES MEASURED FROM THE BOTTOM OF THE RECEPTACLE OUTLET BOX OR RECEPTACLE MOUNTING TO THE LEVEL OF THE FINISH FLOOR OR WORKING PLATFORM.

12. ALL DISTRIBUTION BOARDS, SWITCHBOARDS AND TRANSFORMERS THAT ARE FLOOR MOUNTED SHALL BE MOUNTED ON 4" THICK HOUSEKEEPING PAD. TRANSFORMER SHALL BE ON VIBRATION ISOLATION PADS AND CONNECTED WITH FLEXIBLE CONDUIT.

13. CONTRACTOR SHALL EXAMINE PLANS AND VERIFY IN FIELD LOCATIONS OF ALL FIRE RATED WALLS, CEILINGS AND FLOORS. CONTRACTOR SHALL SEAL ALL ELECTRICAL SYSTEM PENETRATIONS THROUGH FIRE RATED WALLS, CEILINGS AND FLOORS WITH UL LISTED MATERIAL APPROVED BY THE AUTHORITY HAVING JURISDICTION.

14. SURFACE MOUNTED RACEWAY COMPLETENESS; CONTRACTOR SHALL PROVIDE ALL RACEWAY, FITTINGS, SUPPORTS, BOXES, DEVICES PLATES, ETC. NECESSARY FOR A COMPLETE AND WORKABLE SURFACE MOUNTED ELECTRICAL RACEWAY SYSTEM. PREWIRE SYSTEM. CONTRACTOR SHALL PERFORM A PRE-INSTALLATION SURFACE MOUNTED RACEWAY JOB WALK WITH OWNER & ARCHITECT FOR CONTRACTOR TO FIELD VERIFY EXACT ROUTING OF ANY & ALL SURFACE MOUNTED RACEWAYS.

H. FIRE ALARM SYSTEM (DESIGN BUILD) BY CONTRACTOR

CONTRACTOR SHALL PROVIDE AND INSTALL A FIRE ALARM SYSTEM FOR THE PROJECT AREA TO INCLUDE:

A) SMOKE DETECTORS IN ALL REQUIRED AREAS

B) HEAT DETECTORS IN ALL REQUIRED AREAS

C) DUCT DETECTORS IN ALL REQUIRED SPACES

D) STROBES/ALARMS IN ALL REQUIRED AREAS

E) CARBON MONOXIDE DETECTORS IN ALL REQUIRED AREAS

F) PULL STATIONS AT ALL LEGAL FIRE EXITS – WHERE REQUIRED

G) TAMPER AND FLOW SWITCHES AT FLOW SPRINKLER RISERS & BACKFLOW PREVENTERS

H) BRANCH CIRCUIT & CONTROL WIRING TO FLOW SPRINKLER ALARM BELLS

I) ELEVATOR SMOKE DETECTORS, RECALL PANEL, SHUNT TRIP, ETC. AS REQUIRED.

J) SMOKE / FLOW DAMPER / HVAC UNIT SHUT DOWN BRANCH CIRCUIT WIRING.

K) CONTROL WIRING, CONTROL DEVICES, RELAYS, ETC. SEE MECHANICAL PLANS FOR ADDITIONAL INFORMATION

L) PROVIDE REMOTE INDICATORS BELOW CEILINGS FOR ALL DUCT DETECTORS, SMOKE FLOW DAMPERS, ETC. WHERE INSTALLED IN RECESSED LOCATIONS PER NFPA 72 & LOCAL AUTHORITY HAVING JURISDICTION.

M) ALL VALVES CONTROLLING THE WATER SUPPLY FOR AUTOMATIC SPRINKLER SYSTEMS, PUMP, WATER FLOW SWITCHES ON ALL SPRINKLERS SYSTEMS SHALL BE ELECTRICALLY SUPERVISED.

1. CONTRACTOR SHALL SUBMIT FOR THE OWNERS SIGNED APPROVAL, APPROVED FIRE DEPARTMENT FIRE ALARM DRAWINGS FOR THE PROJECT SPACE.

2. CONTRACTOR SHALL BE BAY ALARM OR OWNER APPROVED EQUAL.

3. ALL DEVICES AND EQUIPMENT SHALL BE CALIFORNIA STATE FIRE MARSHAL APPROVED.

4. CONTRACTOR SHALL WARRANTY ALL DEVICES AND SYSTEMS FOR A PERIOD OF TWO YEARS.

5. CONTRACTOR SHALL PROVIDE 6 (SIX) SETS OF FIRE ALARM MANUALS FOR ALL SYSTEMS AND DEVICES IN ADDITION TO 6 (SIX) SETS OF A SYSTEM OPERATIONAL MANUAL TAUNDED FOR THE PROJECT SPACE.

6. CONTRACTOR SHALL PROVIDE A FIRE ALARM CONTROL PANEL INDIVIDUALLY ADDRESSABLE TOTALLY SUPERVISED SYSTEM WITH BATTERY BACK-UP TEST FOR 24 HOURS OF MONITORING INITIATING CIRCUITS PLUS 30 MINUTES OF ALARM WITH DUAL RATE OF DISCHARGE.

7. CONTRACTOR SHALL PROVIDE A SATISFACTORY SYSTEM TEST IN THE PRESENCE OF THE OWNER, FIRE PREVENTION BUREAU AND CONSULTING ENGINEER.


8. CONTRACTOR SHALL PROVIDE A CENTRAL MASTER ANNUNCIATOR PANEL IN THE ELECTRICAL ROOM PER LOCAL FIRE MARSHAL REQUIREMENTS.

9. CONTRACTOR SHALL PROVIDE ALL CONNECTION TO POWER PANELS, CONDUIT AND WIRE AND CONNECTIONS REQUIRED TO PROVIDE AN OPERATIONAL FIRE ALARM EVACUATION SYSTEM.

SUBMITTAL DOCUMENTS FOR DEFERRED ITEMS SHALL BE SUBMITTED TO THE REGISTERED DESIGN PROFESSIONAL IN RESPONSIBLE CHARGE, AND SHALL BE FORWARDED BY THEM TO THE BUILDING OFFICIAL WITH A NOTATION INDICATING THAT THE DEFERRED DOCUMENTS HAVE BEEN REVIEWED AND THAT THEY HAVE BEEN FOUND TO BE IN GENERAL CONFORMANCE WITH DESIGN OF THE BUILDING. THE DEFERRED ITEMS SHALL NOT BE INSTALLED UNTIL THEIR DESIGN AND SUBMITTAL DOCUMENTS HAVE BEEN APPROVED BY THE BUILDING OFFICIAL.

MINOR ELECTRICAL DEMOLITION FOR REMODELING

- 1.0 EXAMINATION
- A. OBTAIN RECORD DRAWINGS / AS-BUILTS FROM OWNER. VERIFY FIELD MEASUREMENTS AND CIRCUITING ARRANGEMENTS ARE AS SHOWN ON RECORD DRAWINGS.
- B. VERIFY THAT ABANDONED WIRING AND EQUIPMENT SERVE ONLY ABANDONED FACILITY.
- C. DEMOLITION DRAWINGS ARE BASED ON CASUAL FIELD OBSERVATION AND EXISTING RECORD DOCUMENTS. REPORT DISCREPANCIES TO OWNER AND ARCHITECT/ENGINEER BEFORE DISTURBING EXISTING INSTALLATION.
- D. BEGINNING OF DEMOLITION MEANS INSTALLER ACCEPTS EXISTING CONDITIONS.
- 2.0 PREPARATION
- A. DISCONNECT AND MAKE SAFE ALL ELECTRICAL SYSTEMS IN WALLS, FLOORS, AND CEILINGS SCHEDULED FOR REMOVAL.
- B. COORDINATE UTILITY SERVICE OUTAGES WITH UTILITY COMPANY AND OWNER'S REPRESENTATIVE.
- C. PROVIDE WIRING AND CONNECTIONS TO MAINTAIN REQUIRED EXISTING SYSTEMS IN SERVICE DURING CONSTRUCTION. WHEN WORK MUST BE PERFORMED ON ENERGIZED EQUIPMENT OR CIRCUITS, USE PERSONNEL EXPERIENCED IN SUCH OPERATIONS.
- D. EXISTING ELECTRICAL SERVICE: MAINTAIN EXISTING SYSTEM IN SERVICE UNTIL NEW SYSTEM IS COMPLETE AND READY FOR SERVICE. DISABLE SYSTEM ONLY TO MAKE SWITCHOVERS AND CONNECTIONS. OBTAIN PERMISSION FROM OWNER AT LEAST 72 HOURS BEFORE PARTIALLY OR COMPLETELY DISABLING SYSTEM. MINIMIZE OUTAGE DURATION. MAKE TEMPORARY CONNECTIONS TO MAINTAIN SERVICE IN AREAS ADJACENT TO WORK AREA WHEN OUTAGE AFFECTS BUSINESS OPERATION.
- E. EXISTING FIRE ALARM SYSTEM: MAINTAIN EXISTING SYSTEM IN SERVICE UNTIL NEW SYSTEM IS ACCEPTED. DISABLE SYSTEM ONLY TO MAKE SWITCHOVERS AND CONNECTIONS. NOTIFY OWNER AND LOCAL FIRE SERVICE AT LEAST 72 HOURS BEFORE PARTIALLY OR COMPLETELY DISABLING SYSTEM. MINIMIZE OUTAGE DURATION. MAKE TEMPORARY CONNECTIONS TO MAINTAIN SERVICE IN AREAS ADJACENT TO WORK AREA.
- F. EXISTING TELEPHONE SYSTEM: MAINTAIN EXISTING SYSTEM IN SERVICE.
- G. EXISTING SECURITY SYSTEM: MAINTAIN EXISTING SYSTEM IN SERVICE.
- 3.0 DEMOLITION AND EXTENSION OF EXISTING WORK
- A. DEMOLISH AND EXTEND EXISTING ELECTRICAL WORK UNDER PROVISIONS OF THIS SECTION.
- B. REMOVE, RELOCATE, AND EXTEND EXISTING INSTALLATIONS TO ACCOMMODATE NEW CONSTRUCTION.
- C. REMOVE ABANDONED WIRING TO SOURCE OF SUPPLY AND RE-LABEL DEVICES AS SPARES.
- D. REMOVE EXPOSED ABANDONED CONDUIT, INCLUDING ABANDONED OUTLETS IF CONDUIT SERVICING THEM IS ABANDONED AND REMOVED. PROVIDE BLANK COVER FOR ABANDONED OUTLETS WHICH ARE NOT REMOVED.
- E. DISCONNECT ABANDONED OUTLETS AND REMOVE DEVICES. REMOVE ABANDONED OUTLETS IF CONDUIT SERVICING THEM IS ABANDONED AND REMOVED. PROVIDE BLANK COVER FOR ABANDONED OUTLETS WHICH ARE NOT REMOVED.
- F. DISCONNECT AND REMOVE ABANDONED PANELBOARDS AND DISTRIBUTION EQUIPMENT.
- G. DISCONNECT AND REMOVE ELECTRICAL DEVICES AND EQUIPMENT SERVING UTILIZATION EQUIPMENT THAT HAS BEEN REMOVED.
- H. DISCONNECT AND REMOVE ABANDONED LUMINAIRES. REMOVE BRACKETS, STEMS, HANGERS, AND OTHER ACCESSORIES.
- I. DISCONNECT AND REMOVE ABANDONED CONDUIT.
- J. REPAIR ADJACENT CONSTRUCTION AND FINISHES DAMAGED DURING DEMOLITION AND EXTENSION WORK.
- K. MAINTAIN ACCESS TO EXISTING ELECTRICAL INSTALLATIONS WHICH REMAIN ACTIVE. MODIFY INSTALLATION OR PROVIDE ACCESS PANEL AS APPROPRIATE.
- L. EXTEND EXISTING INSTALLATIONS USING MATERIALS AND METHODS COMPATIBLE WITH EXISTING ELECTRICAL INSTALLATIONS, AND IN COMPLIANCE WITH NEW PROJECT SPECIFICATIONS.
- M. MODIFY EXISTING AS-BUILT DRAWINGS TO NOTE CHANGES.
- 4.0 CLEANING AND REPAIR
- A. CLEAN AND REPAIR EXISTING MATERIALS AND EQUIPMENT WHICH REMAIN OR ARE TO BE REUSED.
- B. SWITCHBOARDS & PANELBOARDS: CLEAN EXPOSED SURFACES AND CHECK TIGHTNESS OF ELECTRICAL CONNECTIONS. REPLACE DAMAGED CIRCUIT BREAKERS AND PROVIDE CLOSURE PLATES FOR VACANT POSITIONS. REPLACE ALL MISSING DEAD FRONT FITTINGS & COVERS. PROVIDE TYPED CIRCUIT DIRECTORY SHOWING REVISED CIRCUITING ARRANGEMENT.
- 5.0 INSTALLATION
- A. INSTALL RELOCATED MATERIALS AND AS REQUIRED BY THIS SECTION AND OWNER'S REPRESENTATIVE.

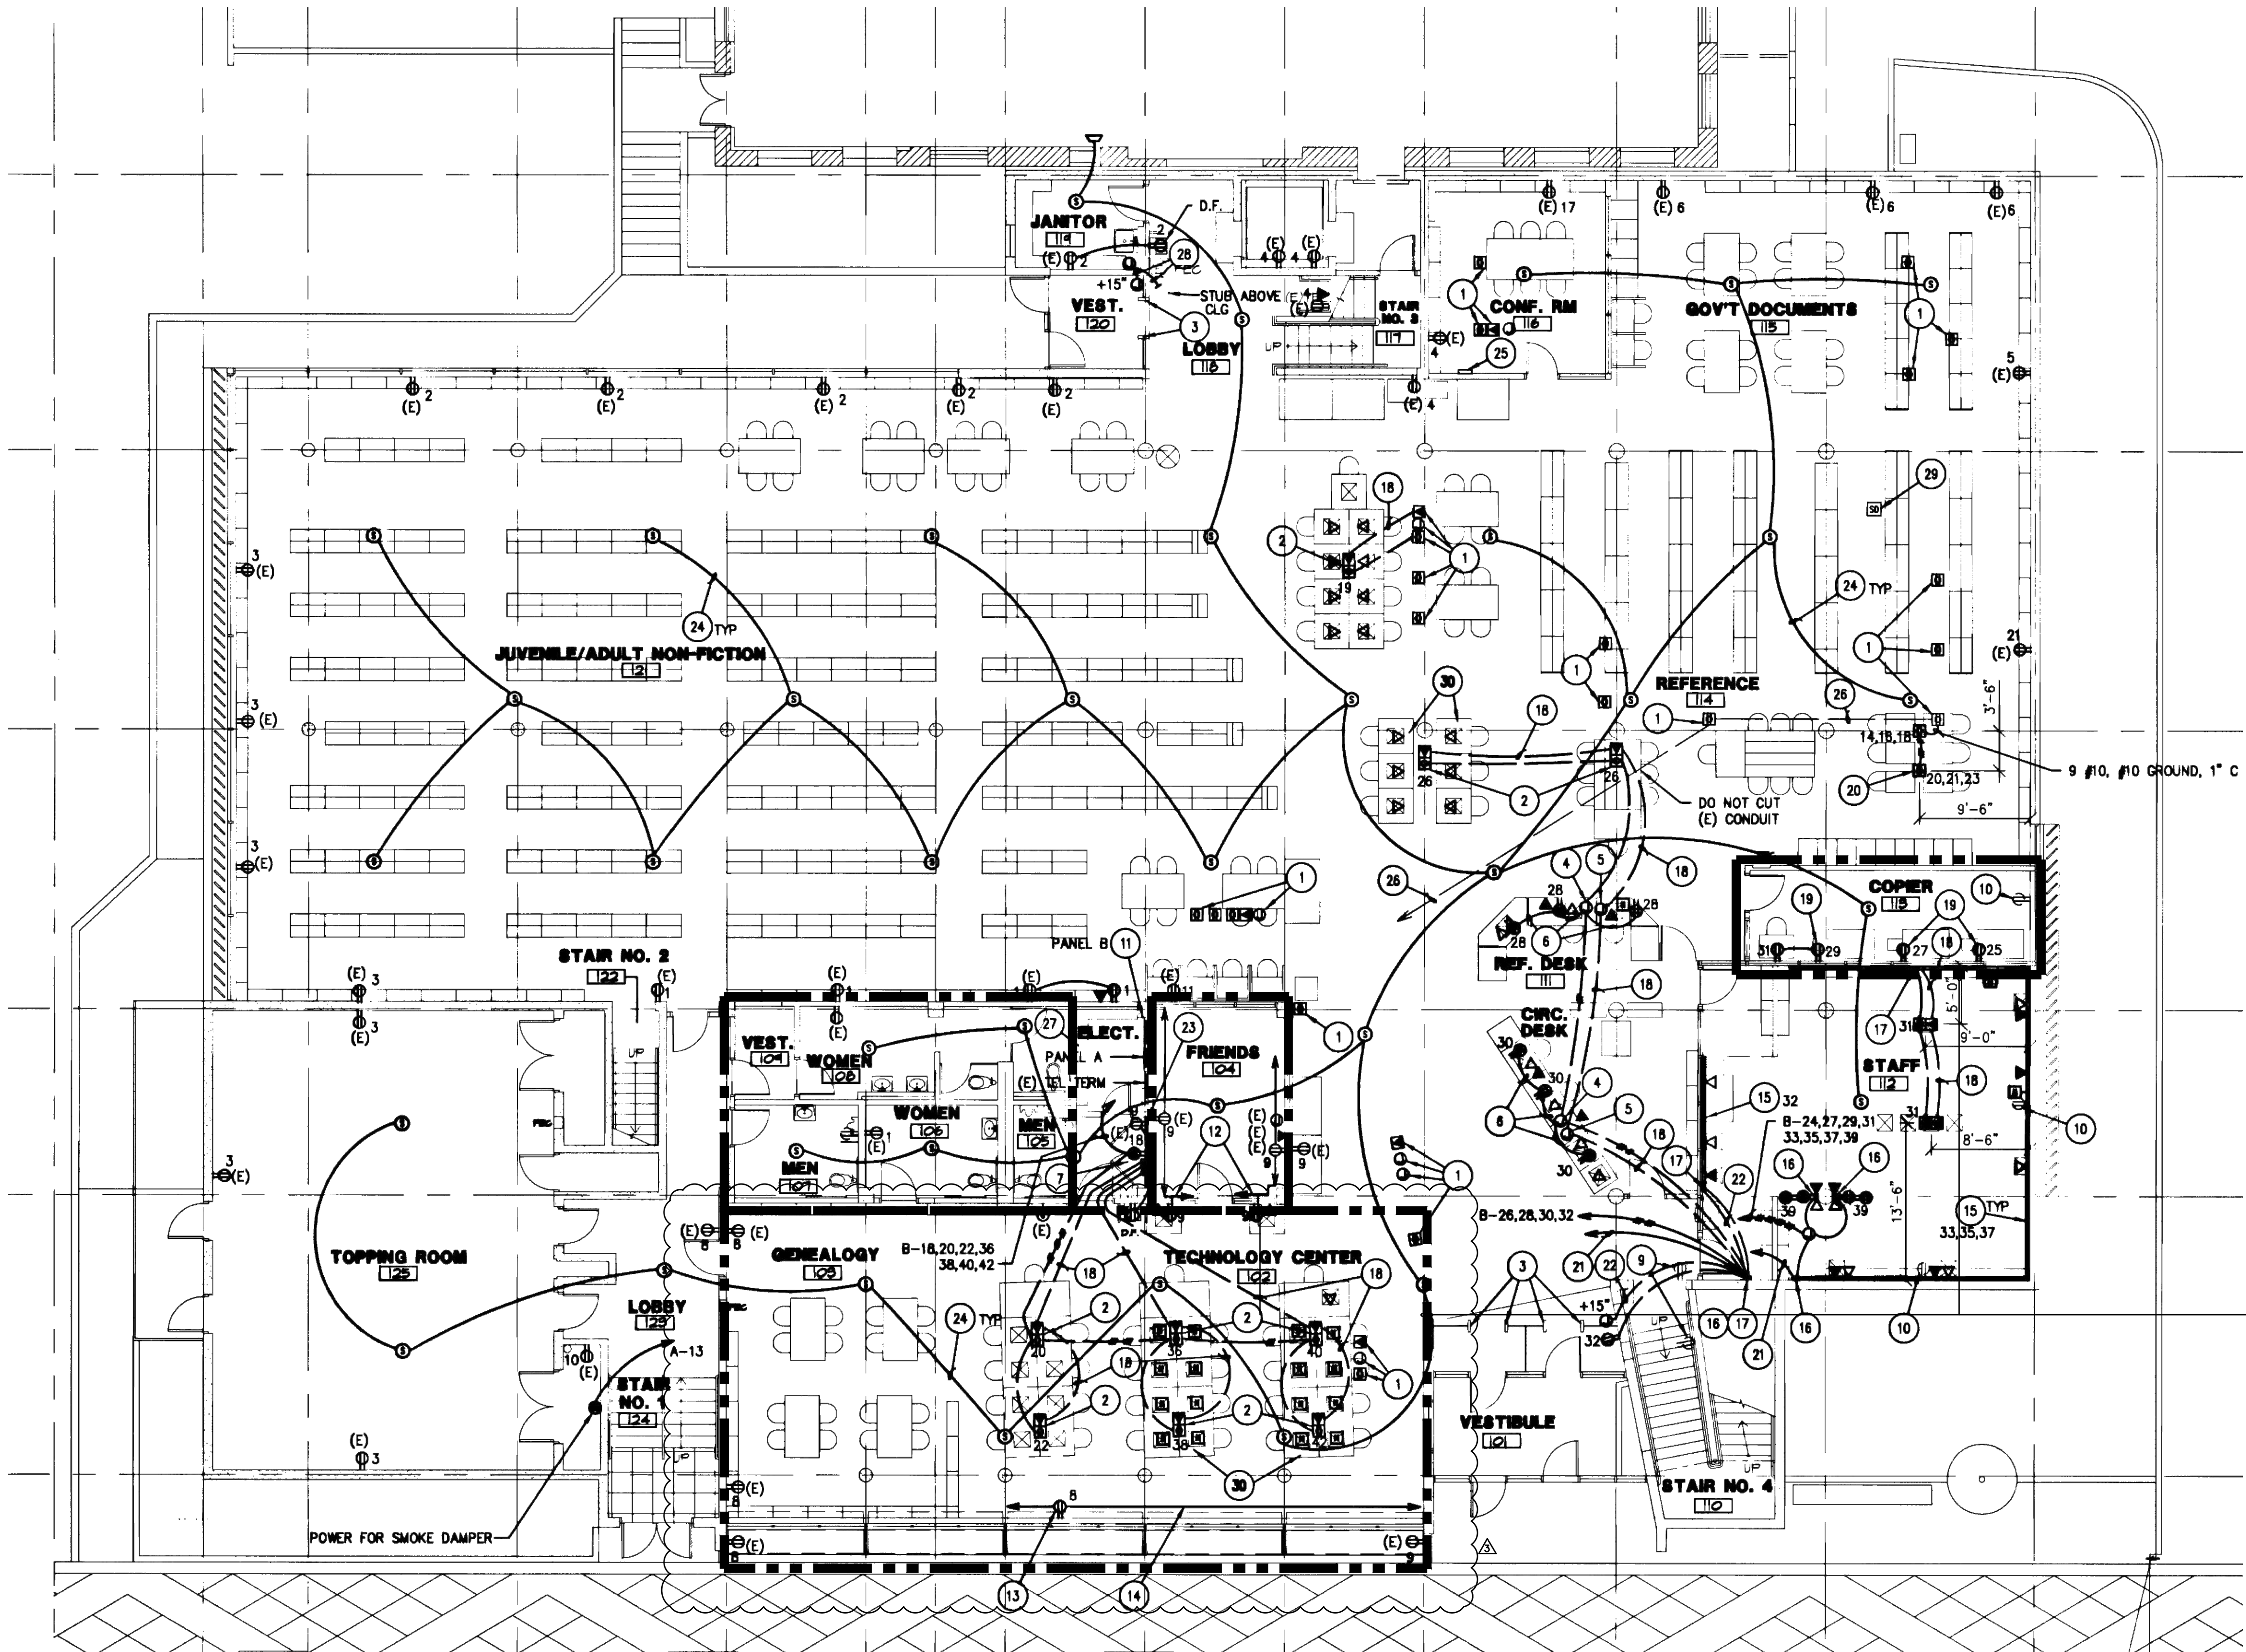

DEMOLITION NOTES

- SCOPE: PROVIDE AND PERFORM DEMOLITION, PREPARATORY AND MISCELLANEOUS WORK IN AREAS AS INDICATED AND SPECIFIED, COMPLETE.
- DEMOLITION AND REMOVAL OF EXISTING ELECTRICAL CONDUIT, WIRING AND EQUIPMENT REQUIRED TO COMPLETE THE PROJECT.
- PREPARATION OF THE EXISTING BUILDING TO RECEIVE OR CONNECT THE NEW WORK.
- MISCELLANEOUS DEMOLITION, CUTTING, ALTERATION, AND REPAIR WORK ON EXISTING SITE AND IN THE EXISTING BUILDING NECESSARY FOR THE COMPLETION OF THE ENTIRE PROJECT.
- DISCONNECTING AND RECONNECTION OF ELECTRICAL EQUIPMENT AS REQUIRED BY THE CONSTRUCTION MODIFICATIONS.
- EXISTING CONDITIONS: PRIOR TO BID MAKE A DETAILED SURVEY OF THE EXISTING CONDITIONS PERTAINING TO THE WORK. CHECK THE LOCATIONS OF ALL EXISTING STRUCTURES, EQUIPMENT AND WIRING (BRANCH CIRCUITING AND CONTROLS). CHECK FOR ANY HAZARDOUS MATERIALS WHICH MAY REQUIRE SPECIAL HANDLING.
- SALVAGE AND DISPOSAL: ALL REMOVED MATERIAL OTHER THAN ITEMS TO BE REUSED SHALL BE RETURNED TO THE OWNER OR DISPOSED OF IN ACCORDANCE WITH INSTRUCTIONS FROM THE OWNER'S REPRESENTATIVE. DISPOSAL SHALL BE DONE IN ACCORDANCE WITH EPA AND GOVERNING BODY REQUIREMENTS AND REGULATIONS. CONTRACTOR SHALL PAY FEES AND CHARGES FOR DISPOSAL.
- TWO WEEKS PRIOR TO START OF ANY WORK CONTRACTOR SHALL SCHEDULE ALL WORK AND ELECTRICAL SYSTEM OUTAGES WITH OWNERS WRITTEN APPROVAL.
- PROTECT ALL EXISTING POWER, MOTORS AND RELATED EQUIPMENT, ALARM SYSTEM, LIGHTING AND CONTROL SYSTEMS, AND TELEPHONE EQUIPMENT IN PLACE, UNLESS OTHERWISE NOTED.
- CONTRACTOR SHALL LEAVE ALL POWER AND SIGNAL CIRCUITS ENERGIZED, VIA JUNCTION BOX, TO DEVICES IN AREAS OUTSIDE OF DEMOLITION AREA EVEN IF SYSTEMS ARE ROUTED THROUGH DEMOLITION AREA.
- CONTRACTOR SHALL FIELD VERIFY LOCATION OF ALL UNDERGROUND UTILITIES PRIOR TO ANY TRENCHING. CONTRACTOR SHALL PROTECT ALL EXISTING / REMAINING UNDERGROUND UTILITY SYSTEMS IN PLACE. CONTRACTOR SHALL REPAIR ANY UTILITY SYSTEM DAMAGE DURING CONSTRUCTION.


DEMOLITION SCOPE OF WORK:

- REMOVE & REPLACE EXISTING LIGHTING SYSTEMS WITH NEW
- REMOVE & REPLACE EXISTING INTERCOM/PAGING SYSTEM WITH NEW
- REMOVE & REPLACE EXISTING FIRE ALARM SYSTEM WITH NEW
- REMOVE & REPLACE POWER, LIGHTING, FIRE ALARM, AND COMMUNICATION SYSTEMS IN RESTROOMS, LOUNGE, ETC. ROOMS AS NOTED.
- REMOVE & REPLACE EXISTING HVAC POWER SYSTEMS
- REPAIR/RENOVATE/REFINISH EXISTING POWER PANELS & SWITCHGEAR

RECORD DRAWING SHOWN FOR PROJECT AREA REFERENCE AREAS ONLY

NOTE:
DEMOLITION PROJECT AREAS, CONTRACTOR SHALL FIELD VERIFY & REMOVE ELECTRICAL OUTLETS & ELECTRICAL DEVICES, ETC. FROM DEMOLITION AREAS UNLESS OTHERWISE NOTED TO BE PROTECTED IN PLACE. PREPARE AREA TO RECEIVE NEW WORK AS INDICATED ON PLANS.

1 FIRST FLOOR DEMOLITION POWER PLAN
SCALE: NONE

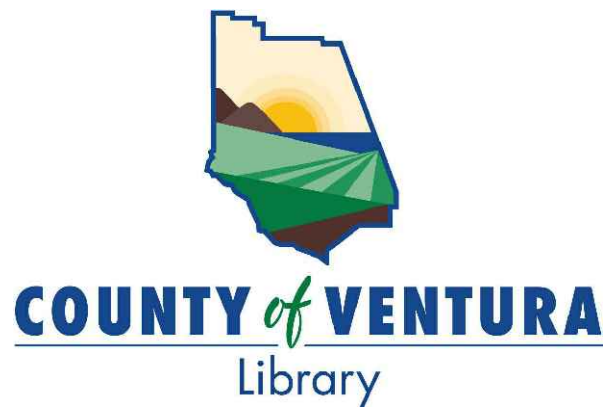

PUBLIC
VENTURA COUNTY
WORKS

ENGINEERING SERVICES



KRUGER BENSEN ZIEMER
ARCHITECTS, INC.

199 FIGUEROA STREET, SUITE 100A
VENTURA, CA 93001
TELEPHONE (805) 963-1726

TODD A JESPERSEN AIA
PRINCIPAL-IN-CHARGE

JONATHAN D LEE AIA
PROJECT MANAGER

All ideas, design arrangements and plans indicated or represented by this drawing are owned by and are the property of Kruger-Bensen-Ziemer, AIA, architects, and were created, evolved and developed for use on, and in connection with, the specified project. None of such ideas, designs, arrangements or plans shall be used by or disclosed to any person, firm or corporation for any purpose whatsoever without the written permission of Kruger-Bensen-Ziemer.

C. HOOD & ASSOCIATES, INC.
CONSULTING ELECTRICAL ENGINEERS

858 East Front Street Phone (805) 641-4012
Ventura, California 93001 Fax (805) 641-0450
www.choodassociates.com
Copyright © 2025



PERMIT APPROVAL STAMP

PERMIT NO BP25-02229		
NO	REVISION	DATE
1	OWNER CHANGES	08/11/25
2	PLAN REVIEW CORRECTIONS	09/08/25
3	OWNER CHANGES	12/09/25

PUBLIC WORKS PROJECT MANAGER

PRINCIPAL-IN-CHARGE
CRAIG HOOD, P.E.

DRAWN BY
ANGIE MONZON

CHECKED BY
CRAIG HOOD, P.E.

ENGINEER'S JOB NO
23-438

DATE
12/09/2025

PROJECT TITLE AND ADDRESS

E. P. FOSTER
LIBRARY
MODERNIZATION

651 E MAIN ST.
VENTURA, CA 93001

COUNTY SPEC NUMBER

COUNTY PROJECT NUMBER

P6T24008

COUNTY DWG NO SHEET OF

SHEET TITLE

FIRST FLOOR
DEMOLITION
POWER PLAN

SHEET NO

E-300

PERMIT SUBMITTAL

CONNECT AND PROGRAM nLIGHT AIR LED DIMMER SWITCHES, OCCUPANCY SENSOR, POWER PACK/RELAYS, nLIGHT AIR PHOTO CELLS, nLIGHT AIR AUTOMATIC DAYLIGHT DIMMING DEVICES, MISCELLANEOUS nLIGHT AIR DEVICES, ETC. FOR A FULLY OPERATIONAL nLIGHT LIGHTING CONTROL SYSTEM. VERIFY AND PROVIDE nLIGHT AIR LIGHTING CONTROL CABLING REQUIREMENTS PER LIGHTING CONTROL VENDOR'S SHOP DRAWINGS AND SUBMITTALS.

IN ALL PROJECT AREAS NOT REQUIRED BY SECTION 130.1(b) THE OCCUPANT SENSING CONTROLS SHALL FUNCTION AS A OCCUPANCY SENSOR. IN ADDITION, CONTROLS SHALL BE PROVIDED THAT ALLOW THE LIGHTS TO BE MANUALLY SHUT-OFF IN ACCORDANCE WITH SECTION 130.1(q) REGARDLESS OF THE SENSOR STATUS.

ALL nLIGHT SYSTEM PROGRAMMING SHALL BE BY LOCAL ACUTY BRANDS REPRESENTATIVE STEVE DOMINGUEZ 805-701-8156.

LIGHTING CONTROL LEGEND

	nLIGHT AIR WIRELESS LINE POWERED WALL SWITCH - MODEL #RPODLA
	nLIGHT AIR POWER/RELAY PACK
	LINE VOLTAGE OCCUPANCY SENSOR WALL SWITCH - HP RATED -MODEL #WSAX-SSA
	LINE VOLTAGE CEILING OCCUPANCY SENSOR

SWITCH LIGHTING CONTROL ZONE

nLIGHT AIR ON/OFF WALL DIMMER SWITCH - RPODLA-4S-DX-MVOLT-WH-G2-WS XP0DA-1GNG-WH


DESIGNATED SWITCH "a" CONTROLS LIGHT FIXTURES IN ZONE "a". CONTRACTOR SHALL PROGRAM nLIGHT LED DIMMER SWITCH AND CORRESPONDING LIGHT FIXTURES LABELED "a" ON LIGHTING PLAN AS LIGHTING CONTROL ZONE "a". CONTRACTOR SHALL JOB WALK AND VERIFY LIGHTING CONTROL ZONES WITH OWNER PRIOR TO BID.

SHEET NOTES

- CONTRACTOR SHALL VERIFY LOCATION, CEILING TYPE, TRIM, AND REQUIREMENTS OF ALL LIGHT FIXTURES AND CONTROL PRIOR TO BID PROPOSAL, ROUGH-IN, AND FINISH INSTALLATION.
- CONTRACTOR SHALL, IN ROUTING ALL CIRCUITS, INCREASE CONDUCTOR & CONDUIT SIZE TO ALLOW FOR VOLTAGE DROP SHOULD THE CONTRACTOR EXCEED ROUTING INDICATED ON DRAWING. ENGINEER OF RECORD MUST BE NOTIFIED PRIOR TO ANY DEVIATIONS FROM APPROVED PLAN CHECK (PERMIT SET) DRAWINGS.
- CONTRACTOR SHALL FURNISH AND INSTALL PULL BOXES AS REQUIRED TO INSTALL CONDUCTORS PER CONDUCTOR MANUFACTURERS RECOMMENDATIONS, PER THE NATIONAL ELECTRICAL CODE AND PER LOCAL AUTHORITIES HAVING JURISDICTION.
- 3/4" CONDUIT MINIMUM UNLESS OTHERWISE NOTED.
- ALL LIGHTING FIXTURES SHALL BE SECONDARILY SUPPORTED WITH SAFETY CABLES, PROVIDED BY CONTRACTOR.
- VERIFY LOCATION OF ALL DEVICES ON ARCHITECTURAL PLANS AND IN FEED PRIOR TO ROUGH IN.
- MAINTAIN A MAXIMUM 2% VOLTAGE DROP ON ALL LIGHTING HOMERUNS.
- ALL EXIT SIGNS ARE +12" TO CENTER LINE OF FIXTURE ABOVE DOOR FRAME UNLESS OTHERWISE NOTED.
- CONTRACTOR SHALL PROVIDE ALL BACKING, BRACKETS, SUPPORTS, AND MOUNTING HARDWARE NECESSARY TO PROPERLY INSTALL LIGHTING FIXTURES.
- VERIFY THE EXACT ROUTING OF ALL EXPOSED CONDUIT WITH OWNER PRIOR TO INSTALLATION.
- COORDINATE WORK WITH OTHER TRADES. OBTAIN ALL DRAWINGS THAT WILL REQUIRE COORDINATION AND PROVIDE ALL ELECTRICAL CONNECTIONS, DEVICES, AND WIRING REQUIRED WHETHER SHOWN ON ELECTRICAL DRAWINGS OR NOT.
- PROVIDE CODE SIZED EQUIPMENT GROUNDING CONDUCTOR IN ALL LIGHTING SYSTEM CONDUITS.
- ALL LIGHTING FIXTURES, EXCEPT EMERGENCY, SHALL BE CONTROLLED BY CONTRACTOR PROVIDED AUTOMATIC LIGHTING CONTROL SYSTEM AS REQUIRED BY STATE OF CALIFORNIA TITLE 24 REGULATIONS.

KEY NOTES

- REPLACE EXISTING LIGHT SWITCH WITH nLIGHT AIR WIRELESS LINE POWERED WALL BOX SWITCH, UNLESS OTHERWISE NOTED. VERIFY AND PROVIDE NEUTRAL AND GROUND WIRES AT SWITCH LOCATIONS PER LIGHT MANUFACTURER'S APPROVED SHOP DRAWINGS AND SUBMITTALS.
 - CONTRACTOR SHALL REPLACE EXISTING LIGHT FIXTURES WITH NEW. INTERCEPT AND EXTEND EXISTING LIGHTING BRANCH CIRCUIT WIRING TO FEED NEW/REPLACED LIGHT FIXTURES.
 - REPLACE OUTDOOR FIXTURE WITH NEW. CONTRACTOR SHALL PATCH, RESURFACE, AND PAINT SURROUNDING CEILING AREA.
 - PROVIDE KIRLUN LIGHTING: LRC-08KLD-2500L-UNV-SKL-WFL-35K-EM-94-17
 - CONTRACTOR SHALL REPLACE EXISTING LIGHT SWITCHES WITH nLIGHT AIR WIRELESS LINE POWERED SWITCHES UNLESS NOTED OTHERWISE.
- AT EXISTING LIGHTING CEILING JUNCTION BOX LOCATIONS, INTERCEPT AND EXTEND NEUTRAL AND GROUND WIRES AND PULL WIRES THROUGH EXISTING RACEWAYS TO nLIGHT AIR WIRELESS LINE POWERED SWITCH LOCATIONS.
- CONTRACTOR SHALL VERIFY AND PROVIDE NEUTRAL AND GROUND WIRES AT REPLACED SWITCH LOCATIONS PER nLIGHT MANUFACTURER'S APPROVED SHOP DRAWINGS AND SUBMITTALS.

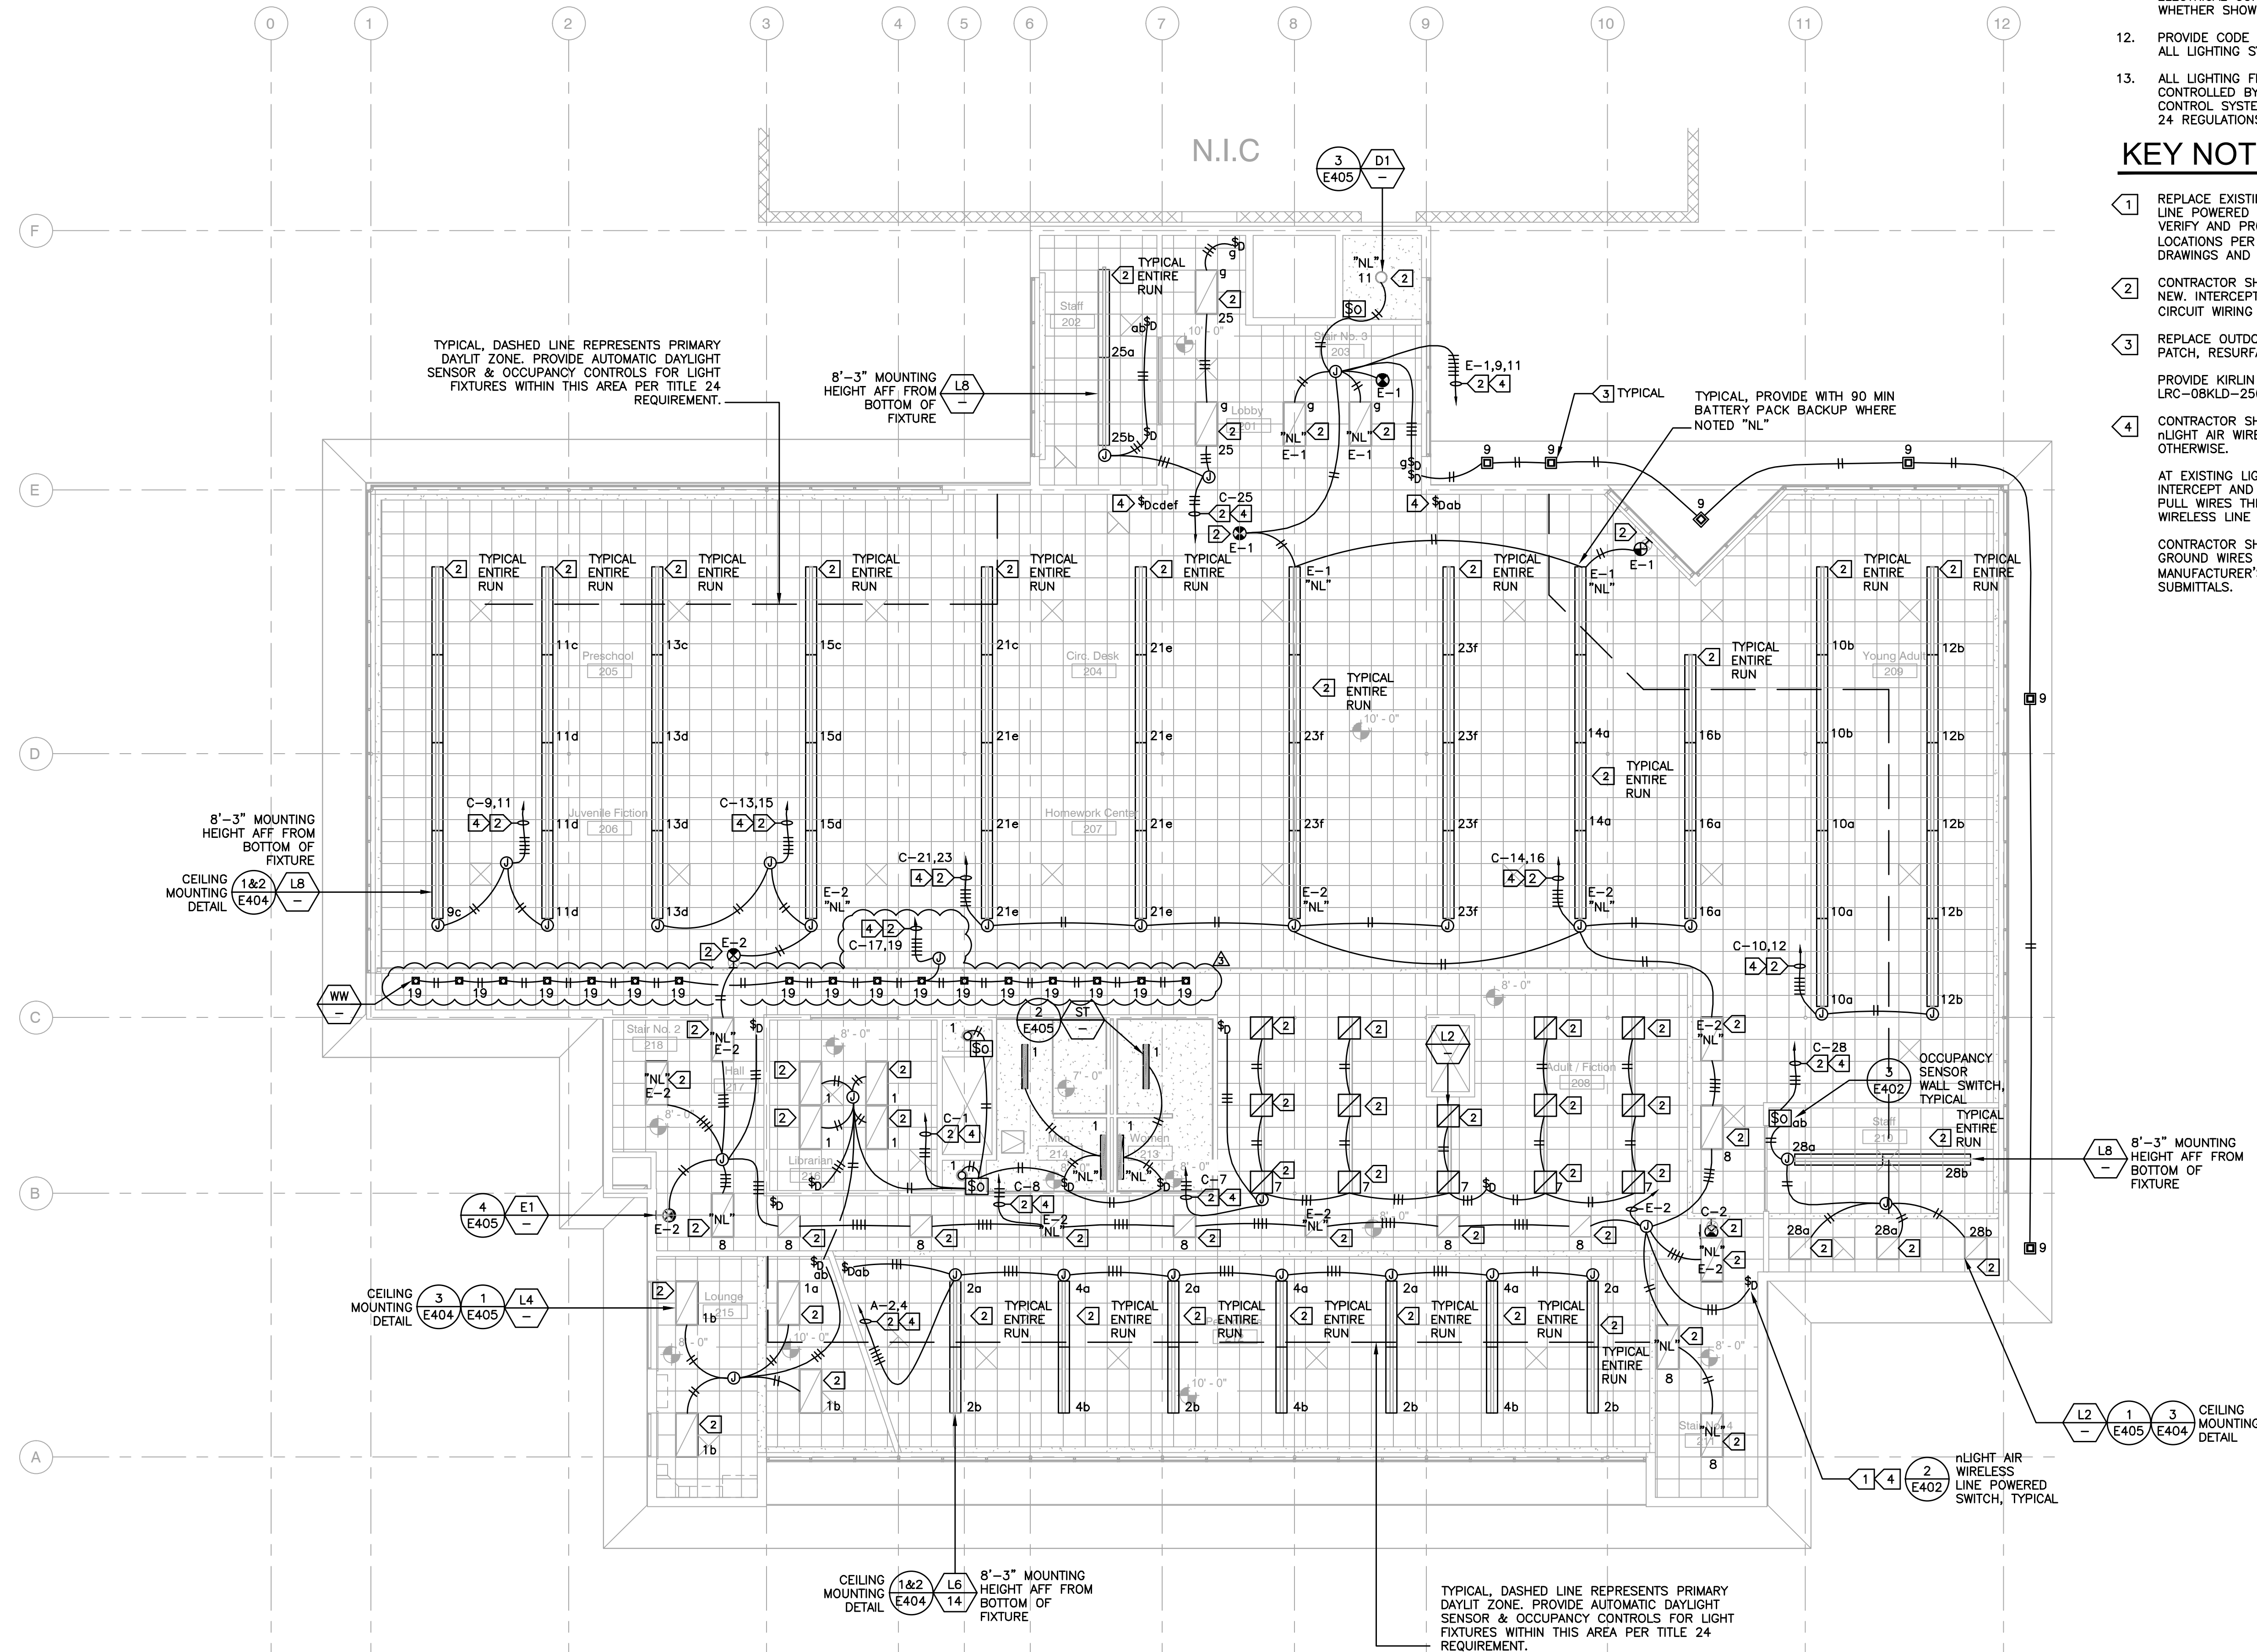

1 SECOND FLOOR LIGHTING PLAN

SCALE: 1/8"=1'-0"

Addendum No. 1



PUBLIC
VENTURA COUNTY
WORKS

ENGINEERING SERVICES



KRUGER BENSEN ZIEMER
ARCHITECTS, INC.
199 FIGUEROA STREET, SUITE 100A
VENTURA, CA 93001
TELEPHONE (805) 963-1726

TODD A JESPERSEN AIA
PRINCIPAL-IN-CHARGE

JONATHAN D LEE AIA
PROJECT MANAGER

All ideas, design arrangements and plans indicated or represented by this drawing are owned by and are the property of Kruger-Bensen-Ziemer, AIA, architects, and were created, modeled and developed for use on, and in connection with, the specified project. None of such ideas, designs, arrangements or plans shall be used by or disclosed to any person, firm or corporation for any purpose whatsoever without the written permission of Kruger-Bensen-Ziemer.



858 East Front Street Phone (805) 641-4012
Ventura, California 93001 Fax (805) 641-0450
www.choodassociates.com
Copyright © 2025



PERMIT APPROVAL STAMP

NO	REVISION	DATE
1	OWNER CHANGES	08/11/25
2	PLAN REVIEW CORRECTIONS	09/08/25
3	OWNER CHANGES	12/09/25

PUBLIC WORKS PROJECT MANAGER	
PRINCIPAL-IN-CHARGE CRAIG HOOD, P.E.	
DRAWN BY ANGELO MONZON	CHECKED BY CRAIG HOOD, P.E.
ENGINEER'S JOB NO 23-438	DATE 12/09/2025
PROJECT TITLE AND ADDRESS	

E. P. FOSTER LIBRARY MODERNIZATION

651 E MAIN ST.
VENTURA, CA 93001

COUNTY SPEC NUMBER	-
COUNTY PROJECT NUMBER	P6T24008
COUNTY DWG NO 23-438	SHEET OF
SHEET TITLE	

SECOND FLOOR
LIGHTING PLAN

SHEET NO
E-403

PERMIT SUBMITTAL

4 LIGHT FIXTURE TYPE E1

SCALE: NONE

Luminaire Type _____
Catalog Number _____

IVO™ 6" Square Shallow Recessed Wall Wash

New Construction & Remodel

9 1/2" x 13 1/8" x 13 1/2"

See installation location. Please refer to the full set of dimensional drawings.

Flange Styles

Flanged

Flushless

Flushless in Millwork

Reflector Colors

Clear Anodize

Gold

Powder

White

Black

White Anodizing

Soft White

Brass

Feature Set

- Ultra Shallow recessed downlight fits in plenums as small as 5.5 inches above ceiling
- Perfect Color® consistency within in-step MacAdam Ellipse

- Exceptional color rendering with 80 CRI, 90 CRI, or 95 CRI minimum
- Proprietary optical design delivers exceptional uniformity ceiling-to-floor
- Up to 90% lumen maintenance at 55,000 hours
- Wet Location standard, covered calling
- ICAT is Spray Foam Compatible
- ENERGY STAR® Certified product

Distribution / Beam Angles

Superior Performance*

Recessed Lumens	60LM	67LM	105LM	151LM	205LM	295LM	395LM	395LM	405LM	495LM	595LM
Delivered Lumens	352	324	665	944	1380	1607	1942	2179	2480	2762	3106
Wattage	5.1	7.5	9.2	10.9	17.5	22.1	26.6	31.8	37.2	43.1	49.9
Lumens per Watt	69	79	72	72	79	73	73	68	67	65	62

*Based on IEEE XECC RECR LW ARI L80
**ETM90 options add 2.8 watts

IVO 6" Square Product Family

Overlight

Lensed LED

Surface Collector

Pendant Collector

Wall Collect

Wall Adjustable Collector

INX00000-WB page 1 of 8

© 2014-2025 Acuity Brands Lighting Inc. All Rights Reserved. Rev. 11/04/25 Specifications subject to change without notice.

GOATHAM ARCHITECTURAL DOWNLIGHT | 1 Inch Wx, Dmax: DA 08050 | P-RD 550-550 (707) | gothamlighting.com

BAA **BABA** **ICAT** **IESA**

NOM **Rohs** **ENERGY STAR** **UL** **ALCO**

gothamlighting.com

[illegible][illegible]

1 LIGHT FIXTURE TYPE L2 & L4
SCALE: NONE

Addendum No. 1



KEYNOTES	
1	NO DEFINED PRIMARY OR SECONDARY DAYLIT ZONES. CONTROLS SUBJECT TO CHANGE IF DAYLITE ZONES PROVIDED.

PERMIT SUBMITTAL





Addendum No. 1



PERMIT SUBMITTAL

