

CITY OF IRVINE - GREAT PARK  
MAINTENANCE & OPERATIONS FACILITY

901 SKYHAWK  
IRVINE, CA 92618

BID SET - 11/21/2025

REVISIONS:


REV	DESCRIPTION	DATE
3	REV (BIDDING)	01/20/2026

PROJECT NO: 2023-40108  
DATE ISSUED: JAN 20, 2026  
SCALE: As Indicated


SHEET NUMBER: **S6.1A3**  
SHEET TITLE:

WALL  
ELEVATIONS

MCA ENGINEERS, INC.  
CIVIL • STRUCTURAL  
2401 E KATELLA Ave. #430  
Anaheim, CA 92806  
Tel. 949.679.0870  
Fax. 949.679.9370  
Project No.: H601

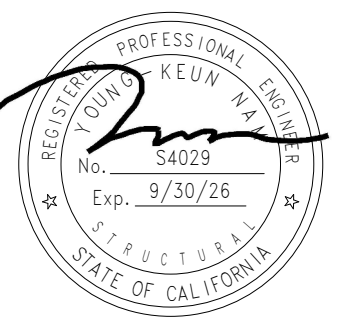

PLAN CHECK 00954071-PARK

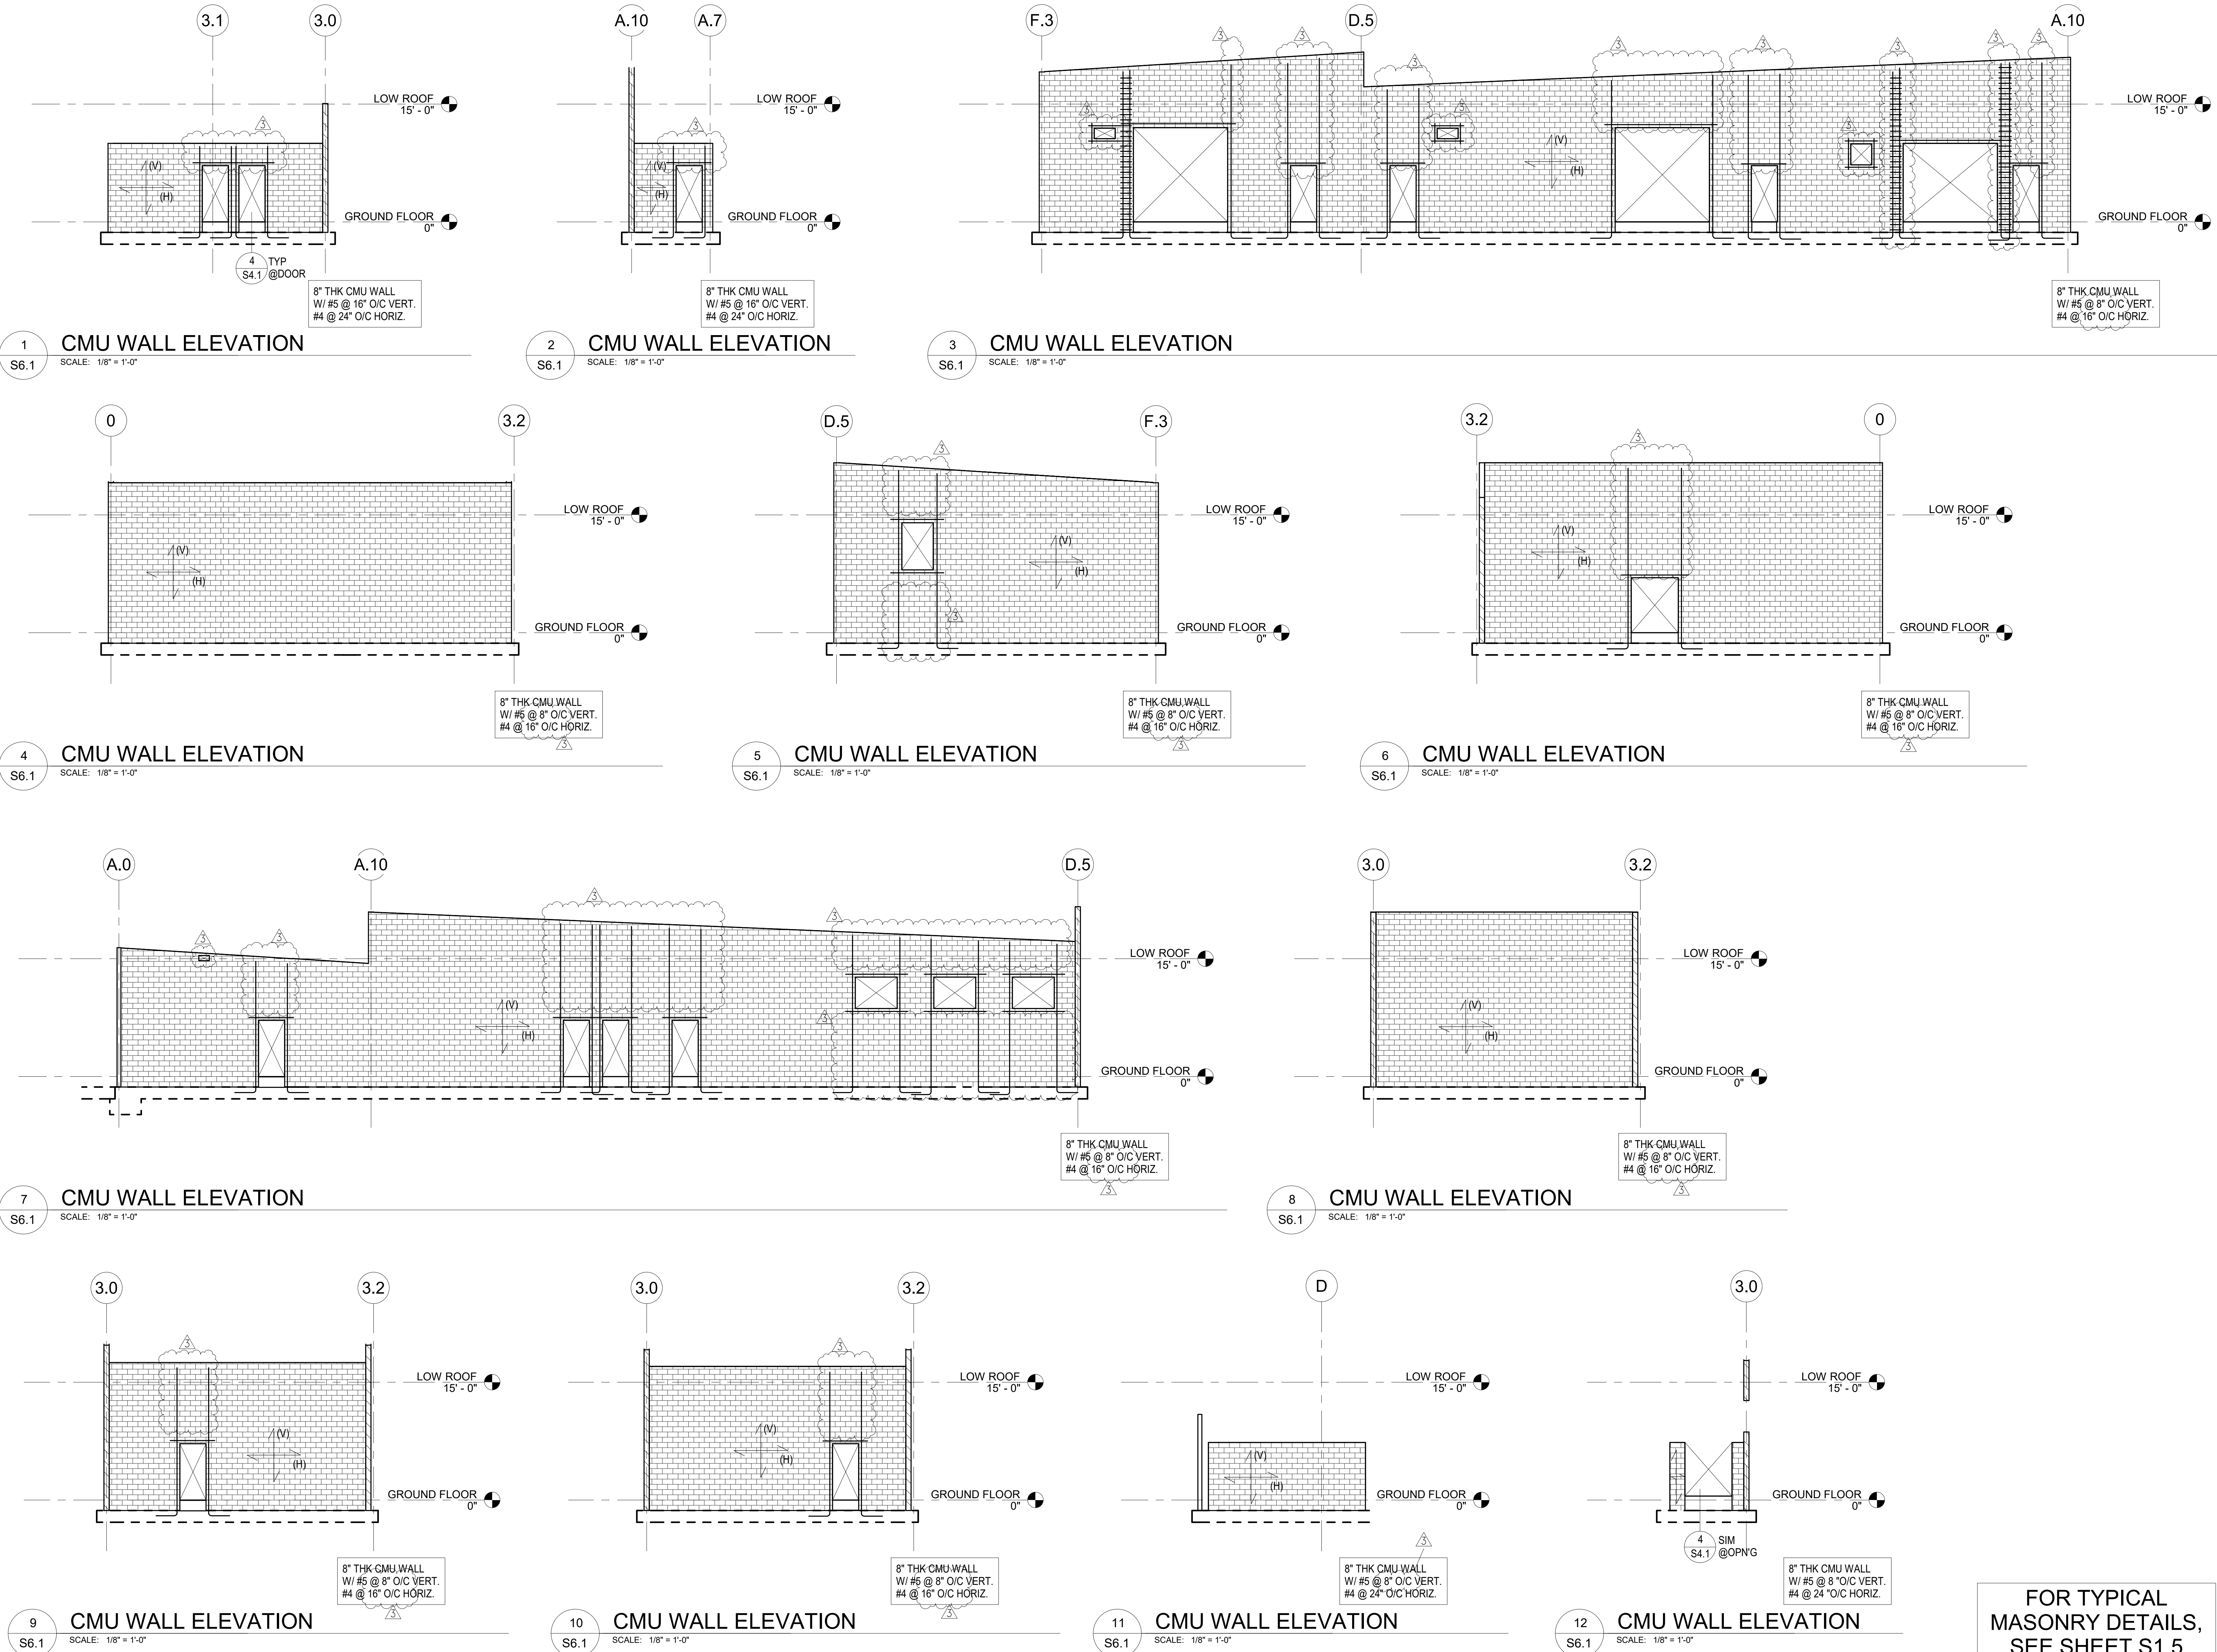

FOR TYPICAL  
MASONRY DETAILS,  
SEE SHEET S1.5

VERIFY OPENING DIMENSIONS  
WITH ARCHITECTURAL DRAWINGS