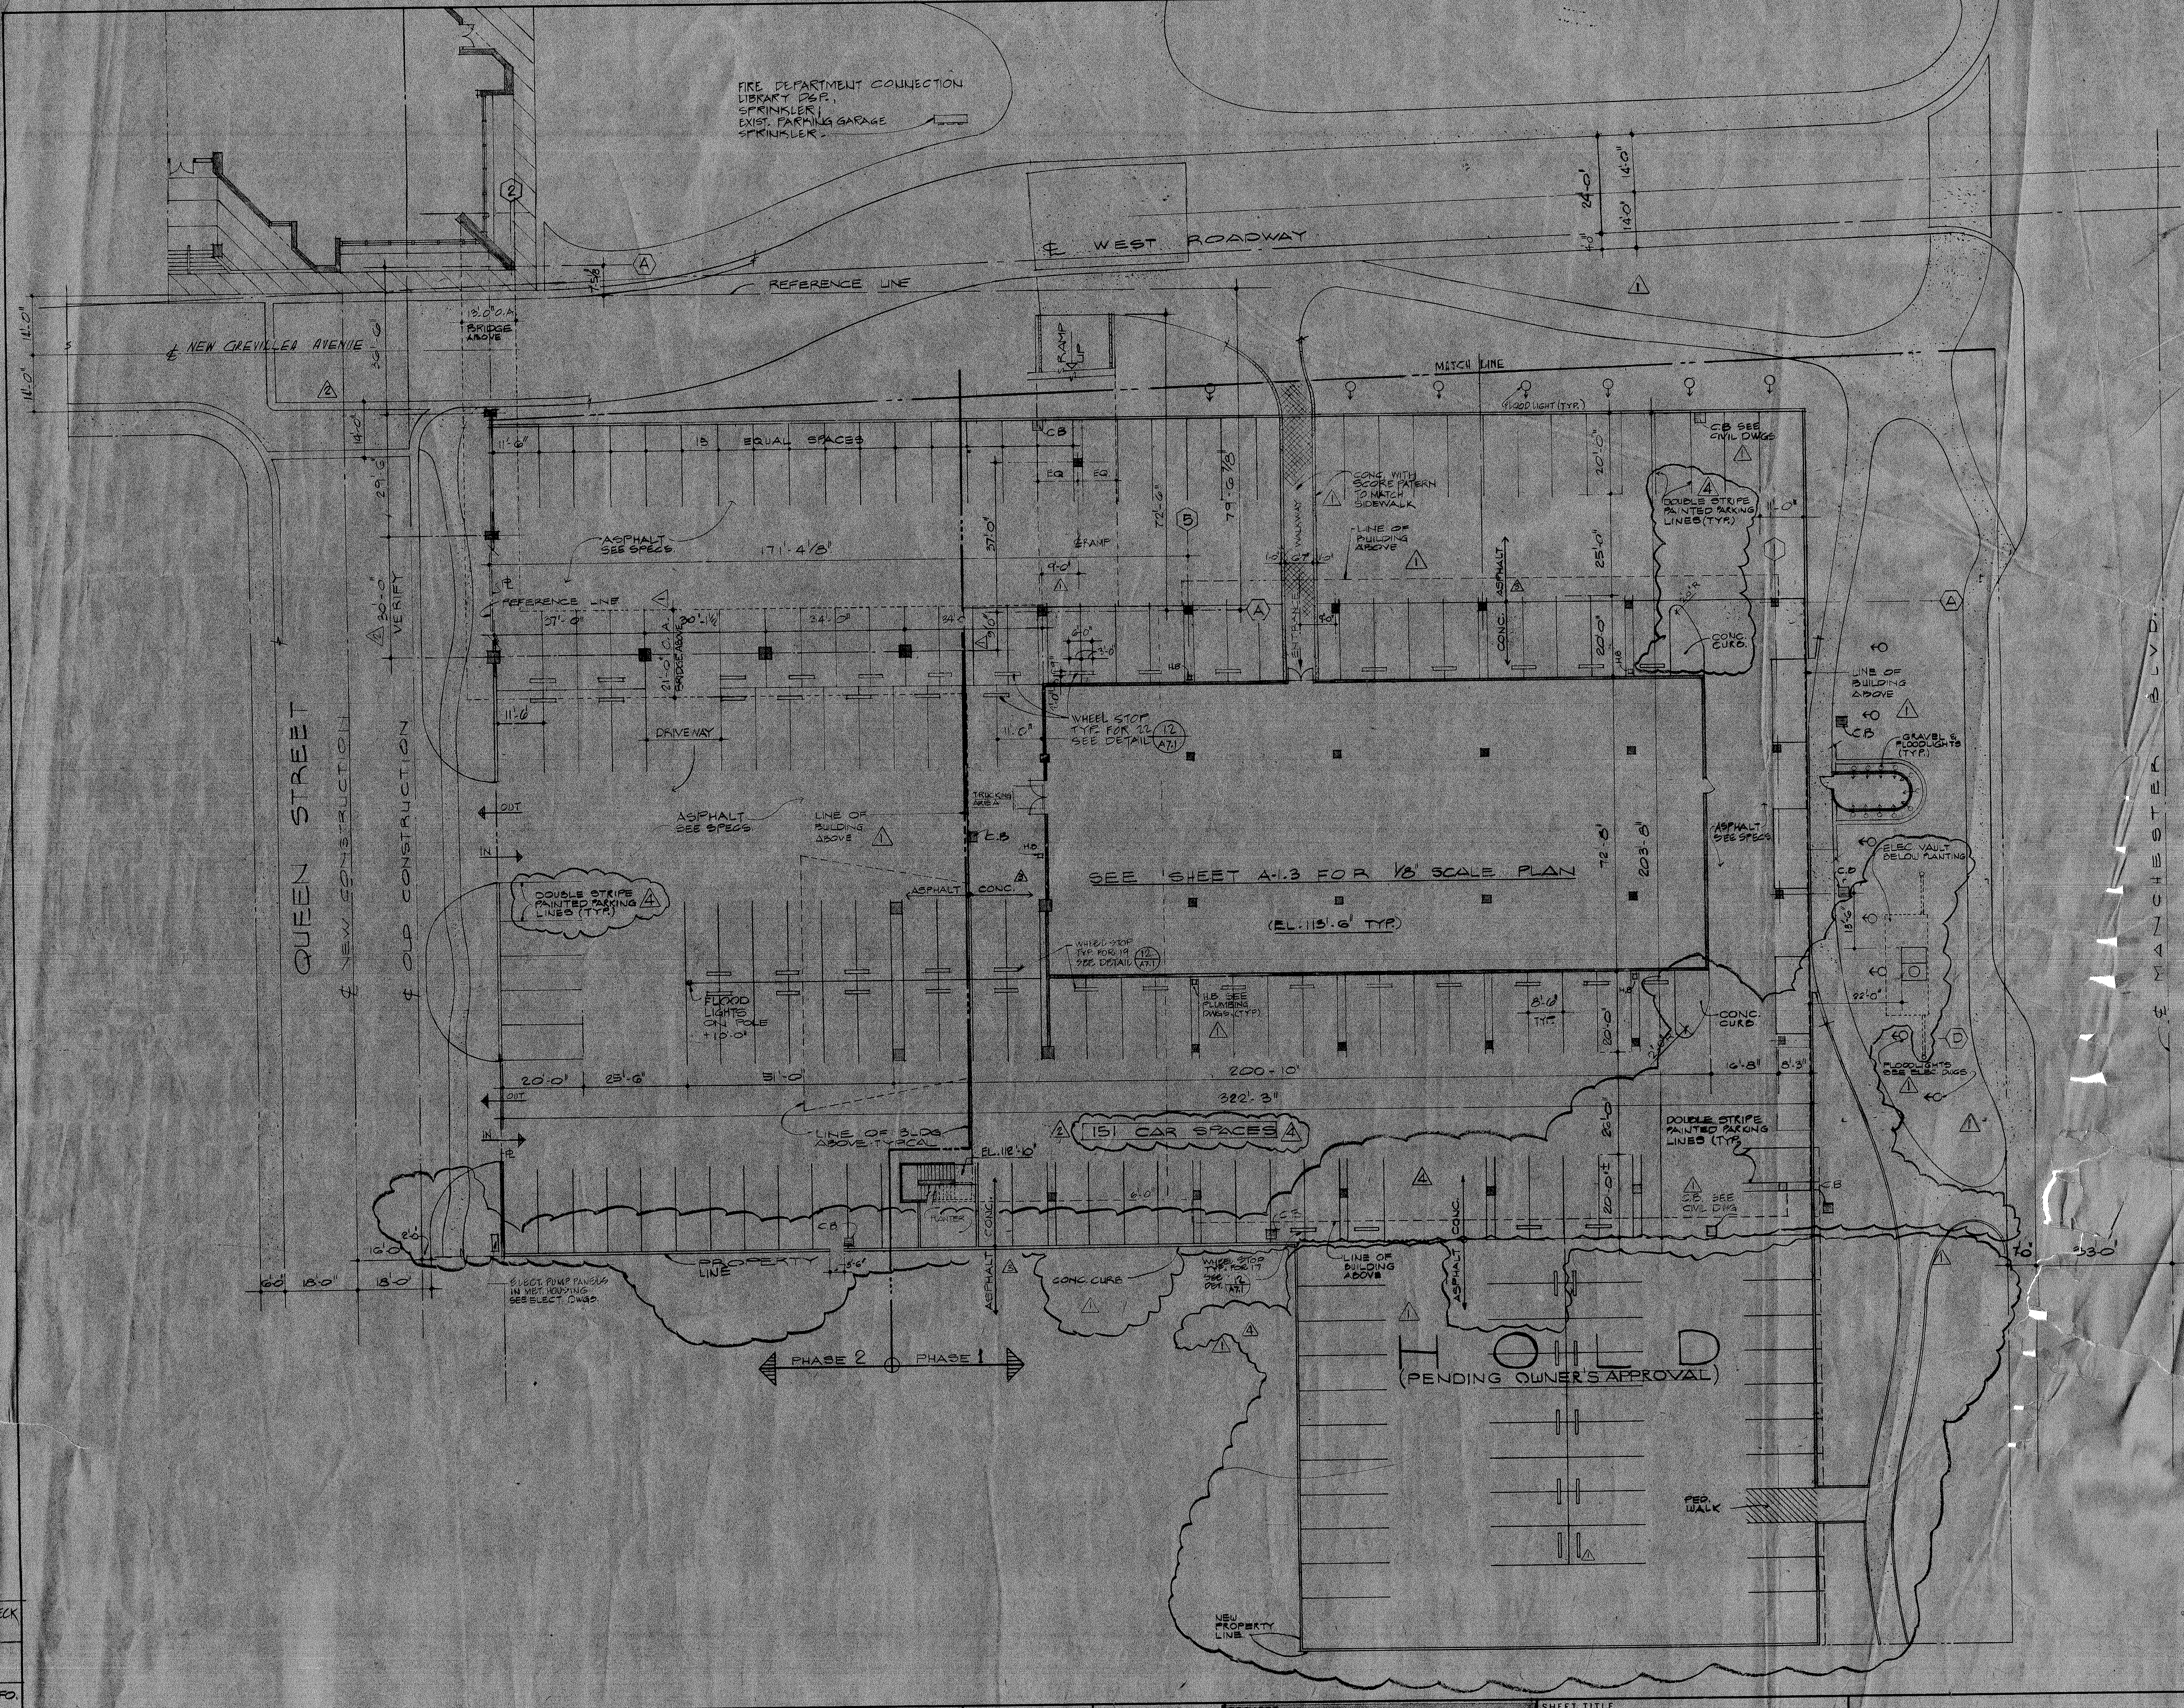

NOTE:
1- FOR DRAINAGE & ELEVATIONS OF PARKING AREA SEE CIVIL DRAWINGS.

2- FOR THE FOLLOWING ITEMS SEE LANDSCAPE DRAWINGS
A- EXTERIOR PHONES.
B- TRASH URNS.
C- DRINKING FOUNTAINS.
D- LANDSCAPE & IRRIGATION.
E- SIDEWALKS. △1

△4

1/A1.2

1/16" = 1'-0"

INTERNAL CHECK
11-18-71

11-16-70

PRELIM. BID INFO.
11-9-70

10-5-70

OWNERS REVIEW
9-23-70

NO.	DATE	REVISION	BY	CHK	NO.	DATE	REVISION	BY	CHK
△					△4	1-24-72	RELOC. ELECT. VAULT - DELETE RET. WALL - REV. PARKING AREA - PROPOSED PARKING & PARKING EXTENSION	MF	WW
△					△3	12-9-71	BLDG. DEPT. CHANGES	MF	ap
△					△2	2-19-71	ADDENDUM No 2		
△					△1		ADDENDUM NO. 1		

NOTE: CONTRACTOR IS ADVISED THAT ISSUANCE OF THIS DRAWING DOES NOT NECESSARILY INCLUDE REVISIONS MADE BY PREVIOUS ADDENDA, BULLETINS, REVISIONS TO DRAWINGS, OR APPROVED SHOP DRAWINGS.

PROJECT GROUP	APPROVED BY
DESIGNER R. VELAND	PRODUCTION
PROJECT CAPTAIN G. WAN	PROJECT ARCHITECT
DRAFTSMAN SB/EP/VC.	ENGINEER
CHECKER	

THIS DRAWING IS NOT TO BE CONSIDERED FINAL UNTIL ALL THE REQUIRED SIGNATURES OF APPROVAL HAVE BEEN AFFIXED.

PROJECT
CITY OF INGLEWOOD
CIVIC CENTER
LIBRARY
INGLEWOOD CALIFORNIA

SHEET TITLE
BUILDING SITE PLAN

Charles Luckman Associates
Planning Architecture Engineering
9220 Sunset Boulevard Los Angeles, California 90069

SHEET NO.
A-1.2

JOB NO.
6002.03.00

DATE 1-29-71

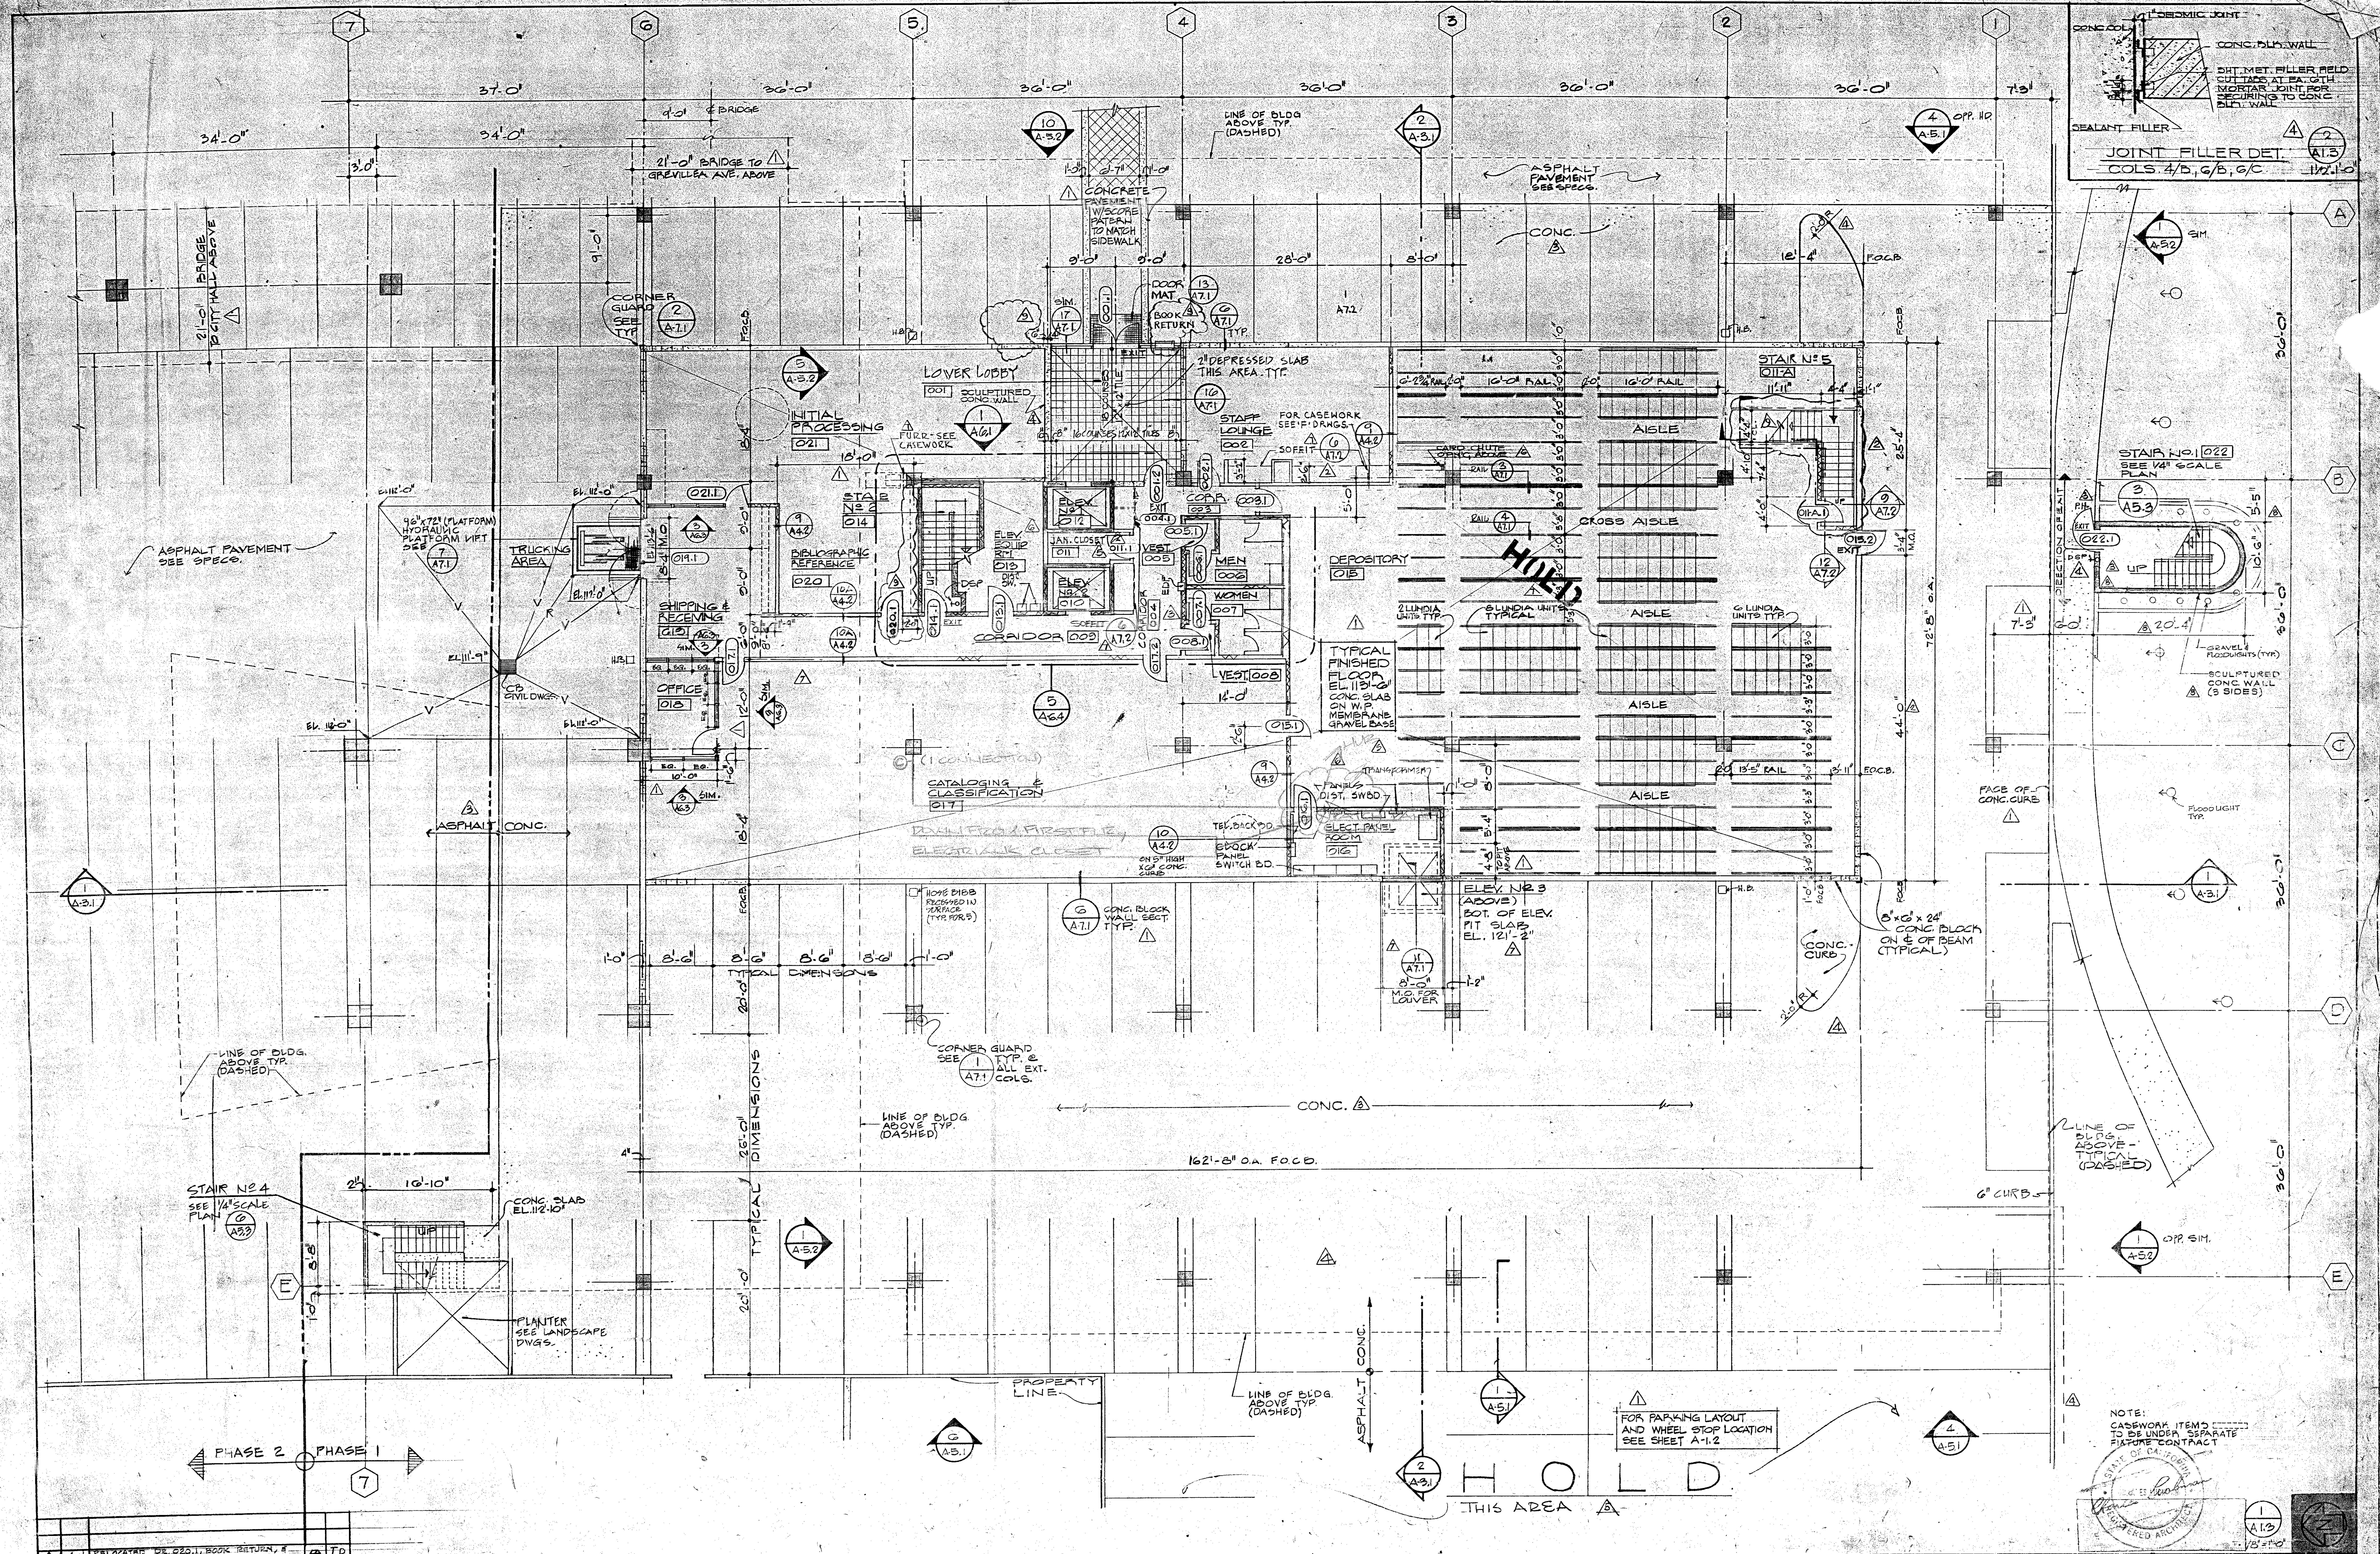
JOINT FILLER DET.
COLS. 4/B, 6/B, 6/C
SEISMIC JOINT
CONC. COL.
CONC. BLK. WALL
SHT. MET. FILLER FIELD CUT TO FIT AT FACE OF MORTAR JOINT FOR SECURING TO CONC. BLK. WALL
SEALANT FILLER
37'-0"
36'-0"
34'-0"
21'-0" BRIDGE TO GREVILLEA AVE. ABOVE
21'-0" BRIDGE TO CITY HALL ABOVE
LINE OF BLDG. ABOVE TYP. (DASHED)
ASPHALT PAVEMENT SEE SPECS.
CONCRETE PAVEMENT W/ SCORE PATERN TO MATCH SIDEWALK
CONC.
DOOR MAT
BOOK RETURN
CORNER GUARD SEE TYP.
LOWER LOBBY 001
SCULPTURED CONC. WALL
2" DEPRESSED SLAB THIS AREA TYP.
INITIAL PROCESSING 021
STAFF LOUNGE 002
FOR CASEWORK SEE "F" DWGS.
SOFFIT
CARD CHUTE
STAIR Nº 5 011A
AISLE
CROSS AISLE
16'-0" RAIL
HOLD
96" x 72" (PLATFORM) HYDRAULIC PLATFORM LIFT
TRUCKING AREA
SHIPPING & RECEIVING 019
BIBLIOGRAPHIC REFERENCE 020
STAIR Nº 2 014
ELEV. Nº 1 012
ELEV. Nº 2 013
JAN. CLOSET 011
VEST 005
CORR. 003
MEN 006
WOMEN 007
VEST 008
CORRIDOR 009
DEPOSITORY 015
TYPICAL FINISHED FLOOR EL. 113'-6" CONC. SLAB ON W.P. MEMBRANE GRAVEL BASE
2 LUNDIA UNITS TYP.
3 LUNDIA UNITS TYPICAL
6 LUNDIA UNITS TYP.
STAIR Nº 1 022
SEE 1/4" SCALE PLAN
GRAVEL & FLOODLIGHTS (TYP.)
SCULPTURED CONC. WALL (3 SIDES)
OFFICE 018
CB CIVIL DWGS.
CATALOGING & CLASSIFICATION 017
TRANSFORMER
DIST. SWBD.
TEL. BACK BD.
CLOCK PANEL SWITCH BD.
ELECT. PANEL ROOM 016
ELEV. Nº 3 (ABOVE) BOT. OF ELEV. PIT SLAB EL. 121'-2"
M.O. FOR LOUVER
FACE OF CONC. CURB
FLOODLIGHT TYP.
HOSE BIBB RECESSED IN SURFACE (TYP. FOR 5)
CONC. BLOCK WALL SECT. TYP.
8" x 8" x 24" CONC. BLOCK ON ℄ OF BEAM (TYPICAL)
CONC. CURB
TYPICAL DIMENSIONS
CORNER GUARD SEE TYP. @ ALL EXT. COLS.
CONC.
162'-8" O.A. F.O.C.B.
LINE OF BLDG. ABOVE TYPICAL (DASHED)
6" CURB
STAIR Nº 4 SEE 1/4" SCALE PLAN
CONC. SLAB EL. 112'-10"
PLANTER SEE LANDSCAPE DWGS.
PROPERTY LINE
ASPHALT CONC.
FOR PARKING LAYOUT AND WHEEL STOP LOCATION SEE SHEET A-1.2
NOTE: CASEWORK ITEMS TO BE UNDER SEPARATE FIXTURE CONTRACT
PHASE 2
PHASE 1
HOLD THIS AREA
1/8" = 1'-0"
7 6 5 4 3 2 1
A B C D E

NO.	DATE	REVISION	BY	CHK	NO.	DATE	REVISION	BY	CHK
9	6/30/72	RELOCATED DR. 020.1, BOOK RETURN, & STAIR #5 REV.	FA	TP	4	1-24-72	SCULPTURED CONC. WALL ADD. RM. 001 - DELETION OF RET. WALL - CURBS ADDED - PROPOSED PARK'G. EXTEND. - DE. 2/A1.3 ADD.	MF	WW
8	5-24-72	SCULPTURED WALLS ADDED	BS	TP	3	12-9-71	BLDG. DEPT. CHANGES	MF	A.P.
7	5/17/72	CLG. RM. 019 HEIGHT CHANGE RELOCATED REV. ELEV. PIT HEIGHT; FURR NOTE ADDED	FA	TP	2	12-9-71	OWNERS CHANGES (2002.06.02)	MF	A.P.
6	3/25/72	~~FURR. DELETED IN JAN. CLOSET~~ ~~RELOCATED CARD OPN'G.~~	MM						
5	2.1.72	FURRING ADDED - CARD CHUTE ADDED	M.M.	MMR	1		ADDENDUM Nº. 1		

NOTE: CONTRACTOR IS ADVISED THAT ISSUANCE OF THIS DRAWING DOES NOT NECESSARILY INCLUDE REVISIONS MADE BY PREVIOUS ADDENDA, BULLETINS, REVISIONS TO DRAWINGS, OR APPROVED SHOP DRAWINGS.

PROJECT GROUP	APPROVED BY
DESIGNER R. VELAND	PRODUCTION
PROJECT CAPTAIN G WAN	PROJECT ARCHITECT
DRAFTSMAN S.B. / E.P.	ENGINEER
CHECKER	

THIS DRAWING IS NOT TO BE CONSIDERED FINAL UNTIL ALL THE REQUIRED SIGNATURES OF APPROVAL HAVE BEEN AFFIXED.

PROJECT
CITY OF INGLEWOOD
CIVIC CENTER
LIBRARY
INGLEWOOD CALIFORNIA

SHEET TITLE
PARKING LEVEL PLAN

Charles Luckman Associates
Planning Architecture Engineering
9220 Sunset Boulevard Los Angeles, California 90069

SHEET NO.
A-1.3
JOB NO. 2002.03.00
DATE 1-29-71

REGISTERED ARCHITECT

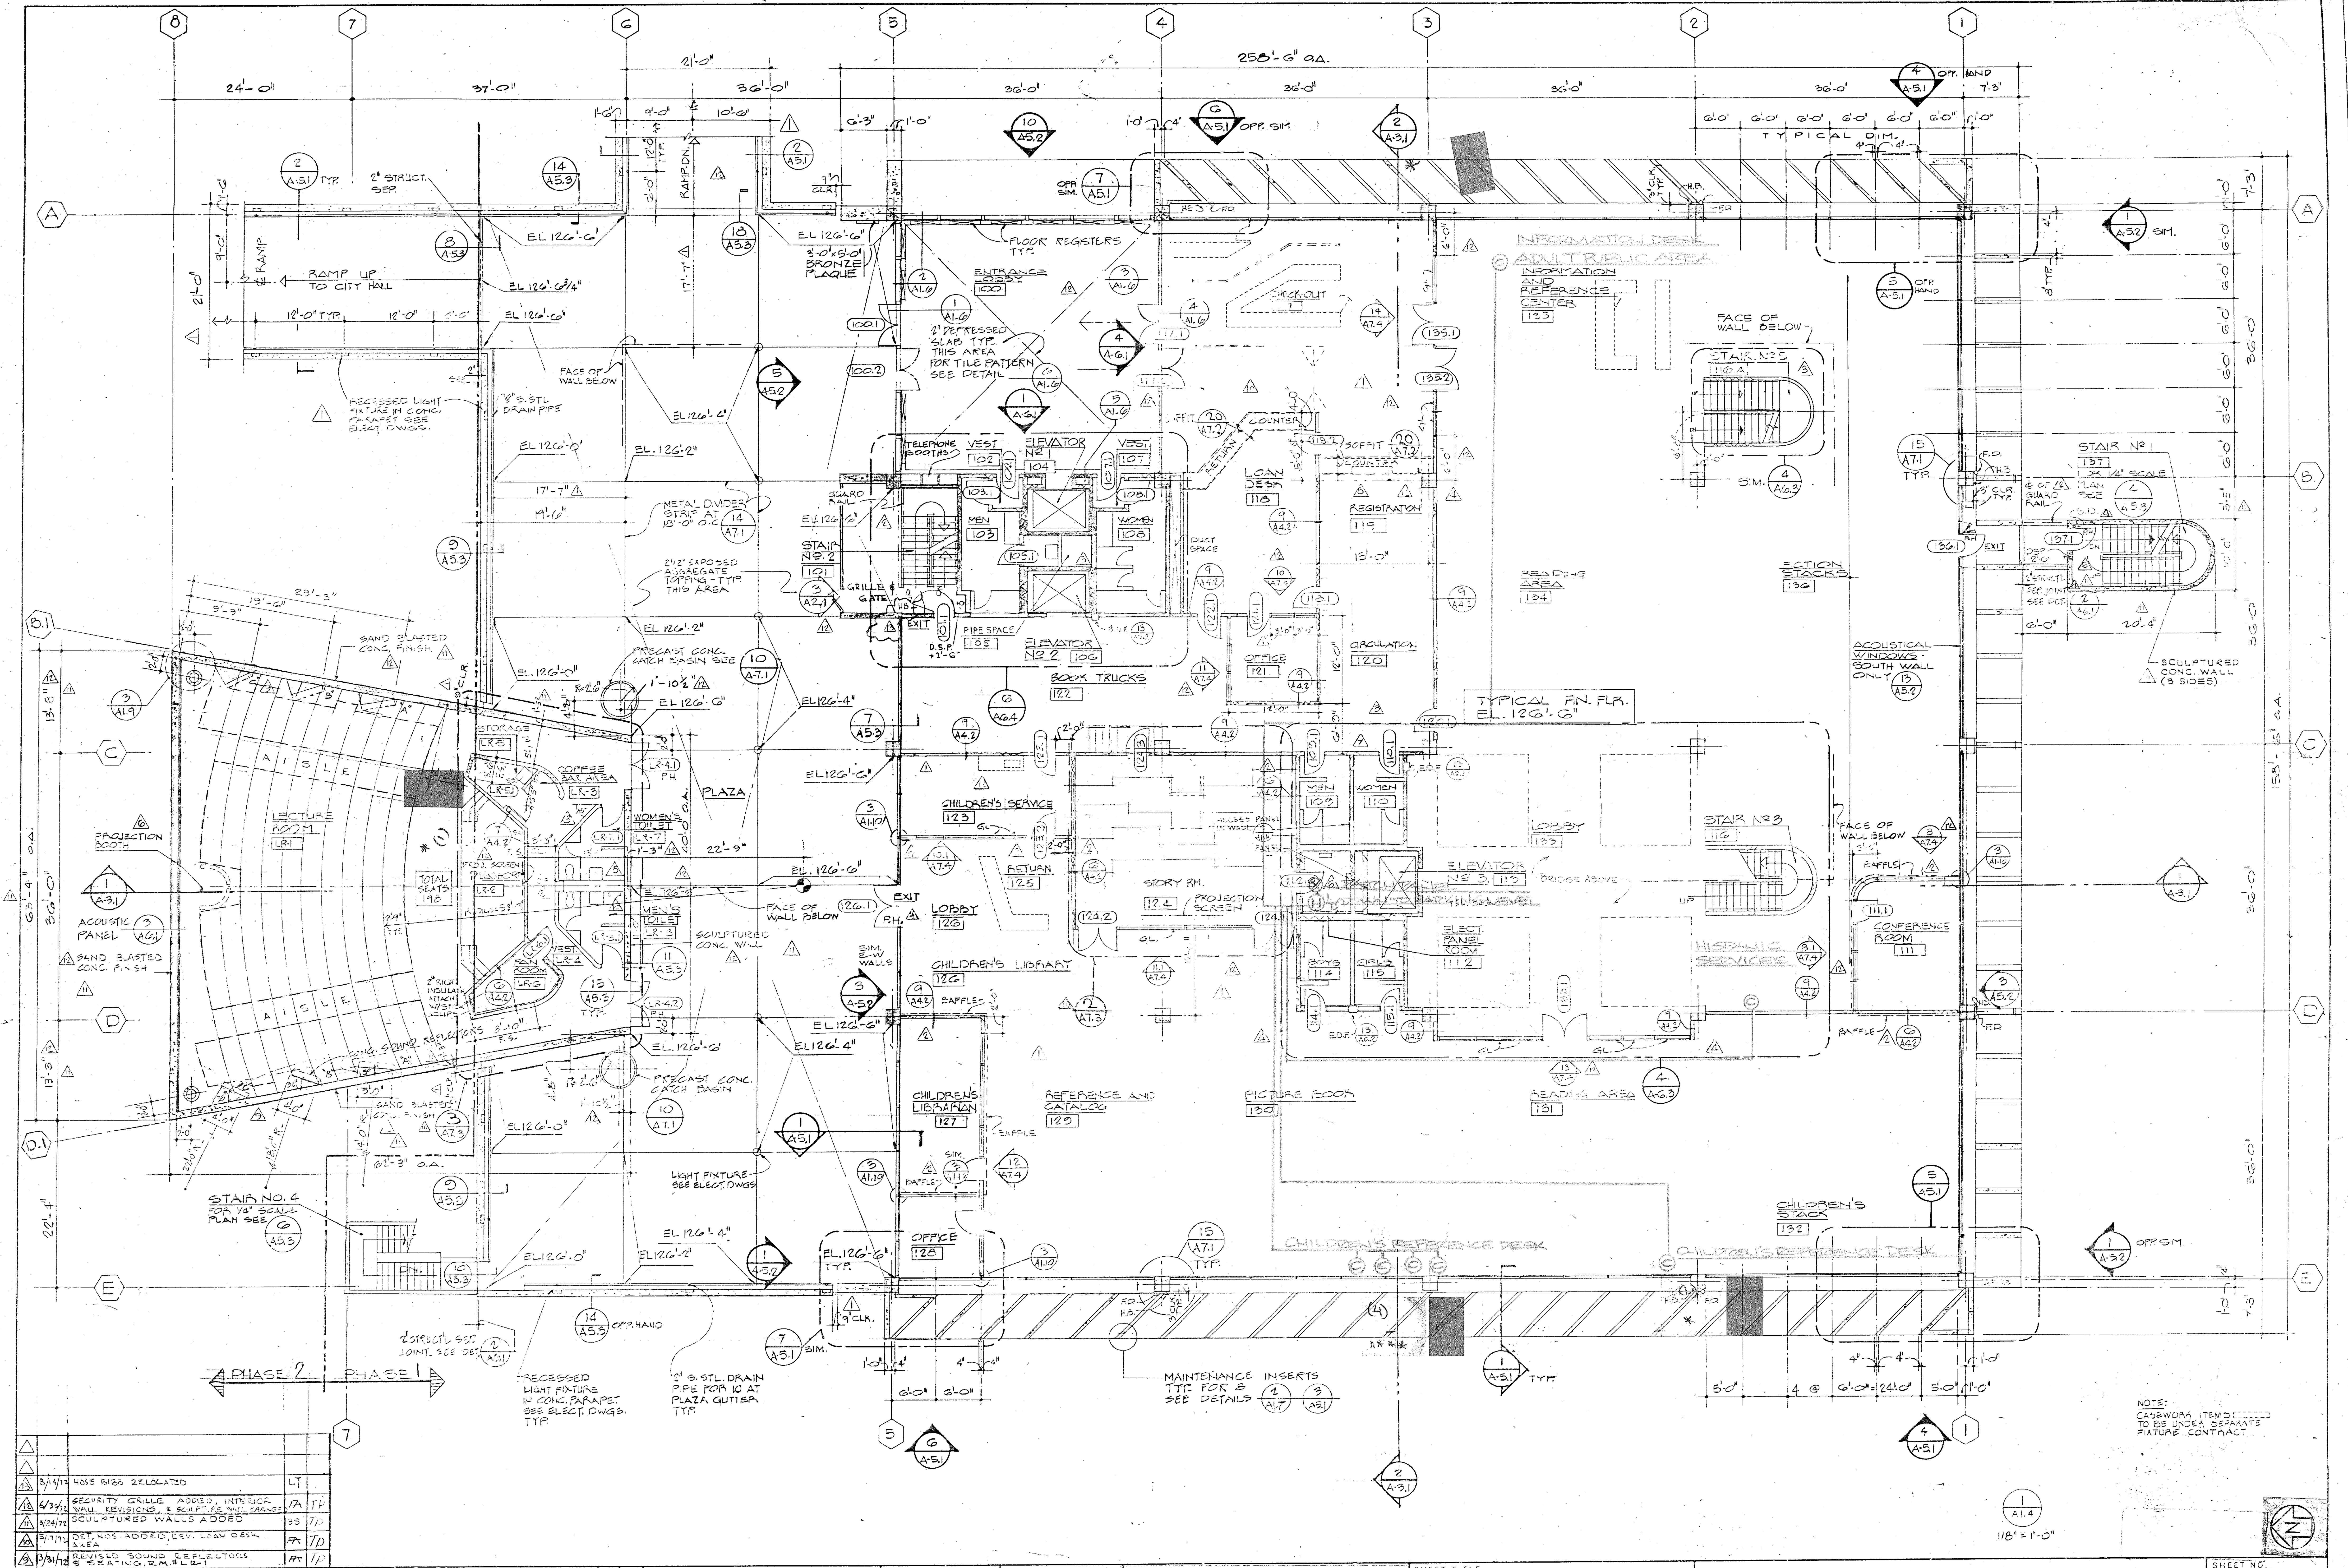

NO.	DATE	REVISION	BY	CHK
△				
△				
13	8/14/72	HOSE BIBB RELOCATED	LT	
12	6/30/72	SECURITY GRILLE ADDED, INTERIOR WALL REVISIONS, & SCULPTURE WALL CHANGED	FA	TP
11	5/24/72	SCULPTURED WALLS ADDED	BS	TP
10	5/17/72	DET. NOS. ADDED, REV. LOAN DESK AREA	FA	TP
9	3/31/72	REVISED SOUND REFLECTORS & SEATING, RM.#LR-1	FA	TP
8	2/28/72	PIPE SPACE REV. IN L.R.7 AND L.R.8 TOILETS - RELOCATED CARD FLR. OPNG.	M.M.	
7	2-1-72	ADDED CARD CHUTE [illegible], RM 119	MF	MVR
6	2-24-72	OWNER'S CHANGES (2002.06.02)	MF	D.R.
5		MECH. COORD. @ TOILETS LR-7 & LR-8	[illegible]	

NO.	DATE	REVISION	BY	CHK
4	12-9-71	BLDG. DEPT. CHANGES	M.F	A.P
3	12-9-71	OWNERS CHANGES (2002.06.02)	M.F	A.P
2	2-19-71	ADDENDUM Nº 2		
1		ADDENDUM Nº 1		

NOTE: CONTRACTOR IS ADVISED THAT ISSUANCE OF THIS DRAWING DOES NOT NECESSARILY INCLUDE REVISIONS MADE BY PREVIOUS ADDENDA, BULLETINS, REVISIONS TO DRAWINGS, OR APPROVED SHOP DRAWINGS.

PROJECT GROUP	APPROVED BY
DESIGNER R. VELAND	PRODUCTION
PROJECT CAPTAIN G. WAN	PROJECT ARCHITECT
DRAFTSMAN S. B./ E.P./ V.C.	ENGINEER
CHECKER W.A.Post	

THIS DRAWING IS NOT TO BE CONSIDERED FINAL UNTIL ALL THE REQUIRED SIGNATURES OF APPROVAL HAVE BEEN AFFIXED.

PROJECT

CITY OF INGLEWOOD
CIVIC CENTER
LIBRARY
INGLEWOOD CALIFORNIA

SHEET TITLE

FIRST FLOOR &
LECTURE ROOM
FLOOR PLANS

Charles Luckman Associates

Planning Architecture Engineering
9220 Sunset Boulevard Los Angeles, California 90069

SHEET NO.
A-1.4

JOB NO.
2002

DATE

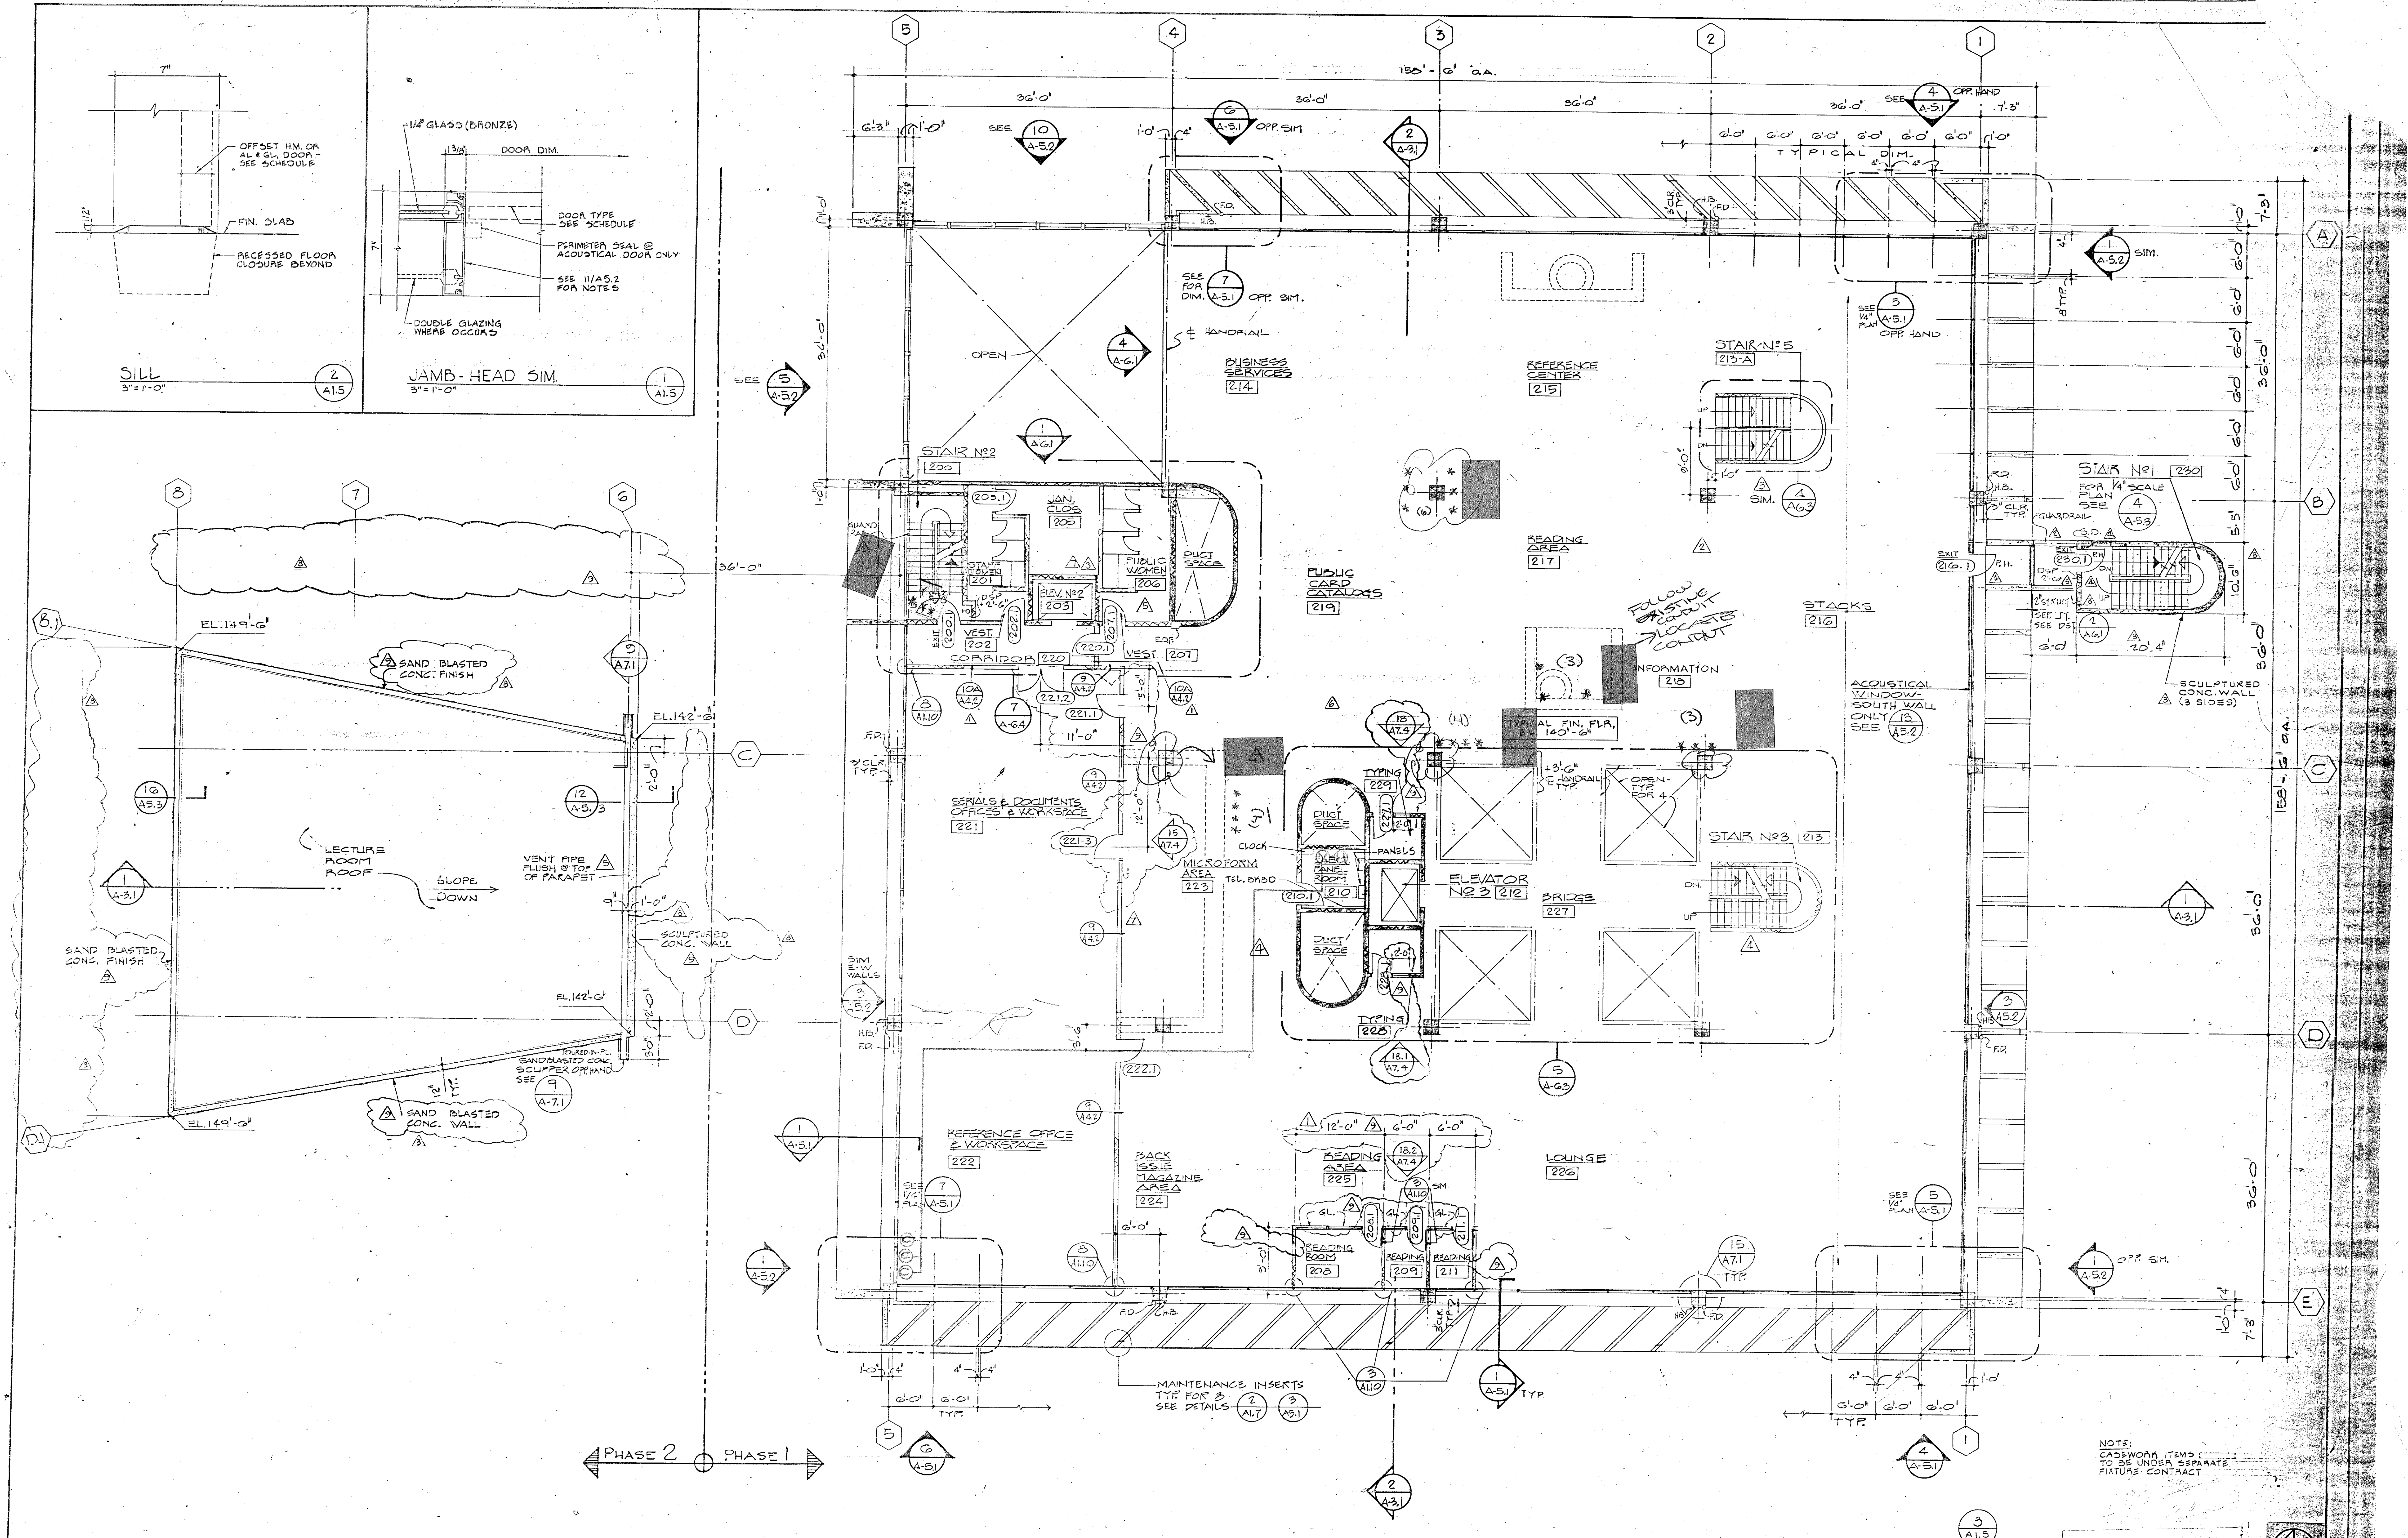

NO.	DATE	REVISION	BY	CHK
9	6/30/72	SCULPTURE ON SOUTH WALL, MISC. INT. WALL REVISIONS	FA	TP
8	5/24/72	SCULPTURED WALLS ADDED	SS	TP
7	5/17/72	DELETED DR.; RELOCATED WINDOW, DELETED "CARD CHUTE & WORDS" "PIPE SPACE"	FA	TP
6	2-4-72	ADDED CARD CHUTE OPNG..	MF	MW
5	1-24-72	OWNER'S CHANGES (2002.06.02)	MF	D.P.
4	12-9-71	BLDG. DEPT. CHANGES	MF	A.P.
3	12-9-71	OWNER'S CHANGES (2002.06.02)	MF	A.P.
2	2-19-71	ADDENDUM Nº 2		
1		ADDENDUM Nº 1		

NOTE: CONTRACTOR IS ADVISED THAT ISSUANCE OF THIS DRAWING DOES NOT NECESSARILY INCLUDE REVISIONS MADE BY PREVIOUS ADDENDA, BULLETINS, REVISIONS TO DRAWINGS, OR APPROVED SHOP DRAWINGS.

PROJECT GROUP	APPROVED BY
DESIGNER R VELAND	PRODUCTION
PROJECT CAPTAIN G WAN	PROJECT ARCHITECT
DRAFTSMAN SB / E.P.	ENGINEER
CHECKER	

THIS DRAWING IS NOT TO BE CONSIDERED FINAL UNTIL ALL THE REQUIRED SIGNATURES OF APPROVAL HAVE BEEN AFFIXED.

PROJECT
CITY OF INGLEWOOD
CIVIC CENTER
LIBRARY
INGLEWOOD CALIFORNIA

SHEET TITLE
SECOND FLOOR PLAN
& LECTURE ROOM
ROOF PLAN

Charles Luckman Associates
Planning Architecture Engineering
9220 Sunset Boulevard Los Angeles, California 90069

SHEET NO. A-1.5
JOB NO. 2002.03.00
DATE 1-29-71

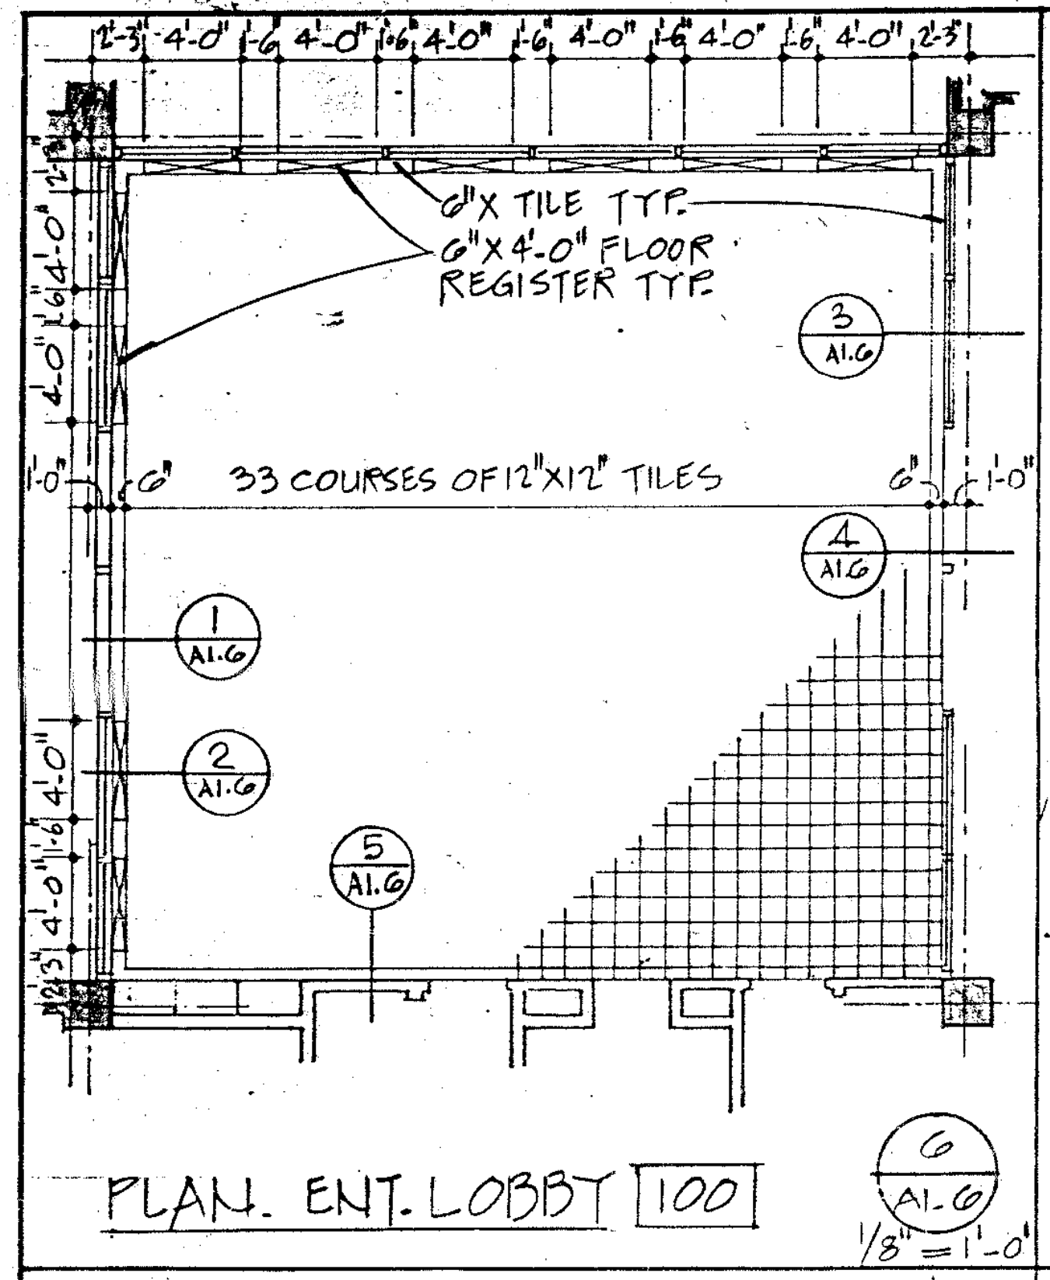

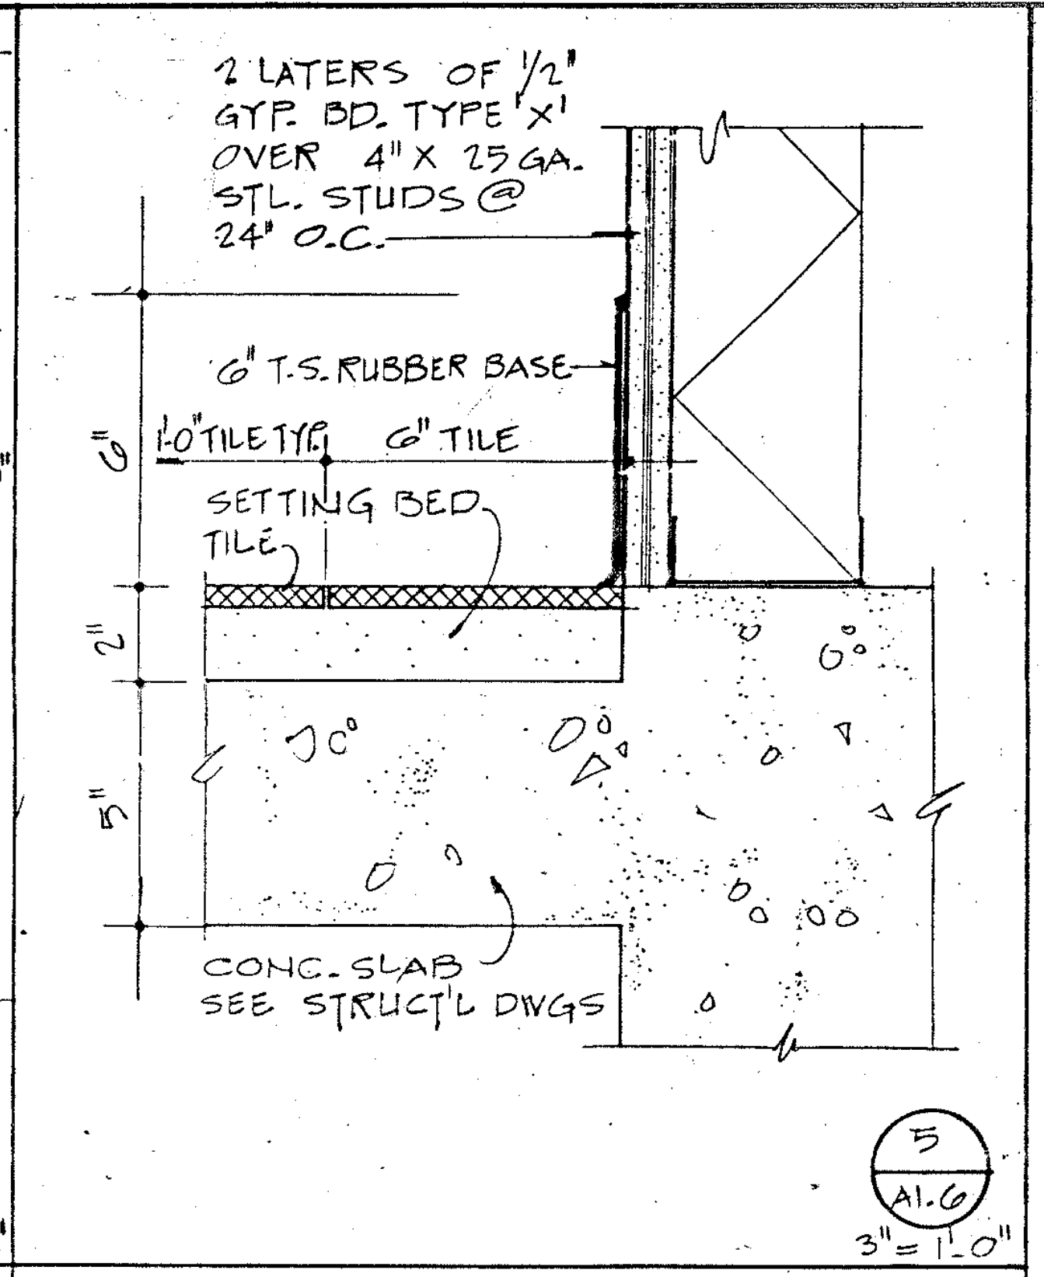
2 LAYERS OF 1/2" GYP. BD. TYPE 'X' OVER 4" X 25 GA. STL. STUDS @ 24" O.C.
6" T.S. RUBBER BASE
1'-0" TILE TYP. 6" TILE
SETTING BED
TILE
CONC. SLAB SEE STRUCT'L DWGS
5 A1.6
3" = 1'-0"

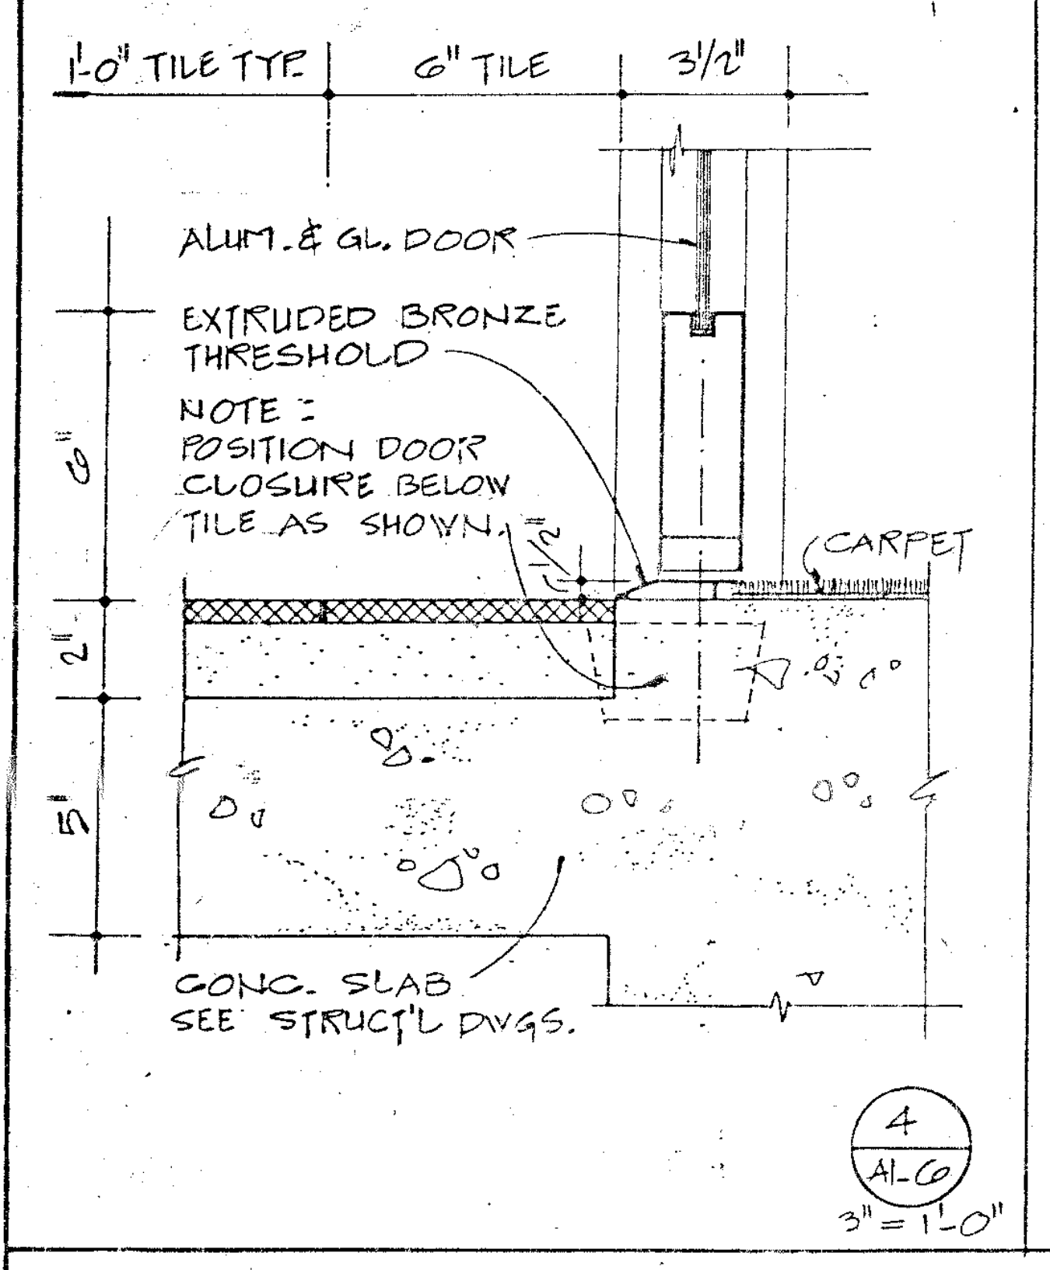
1'-0" TILE TYP. 6" TILE 3/12"
ALUM. & GL. DOOR
EXTRUDED BRONZE THRESHOLD
NOTE: POSITION DOOR CLOSURE BELOW TILE AS SHOWN.
CARPET
CONC. SLAB SEE STRUCT'L DWGS.
4 A1.6
3" = 1'-0"

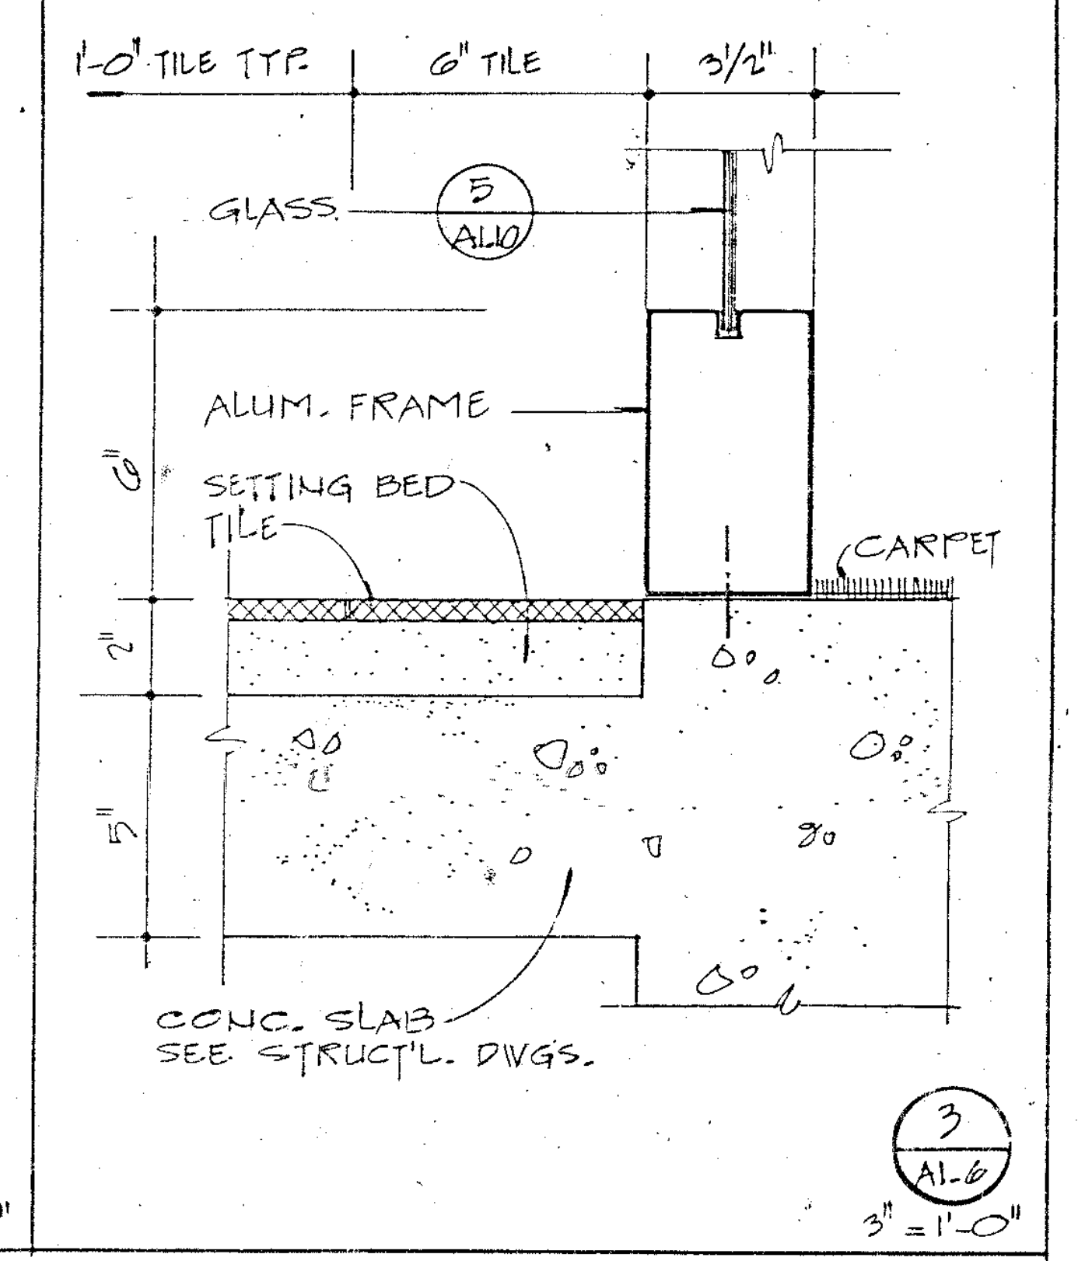

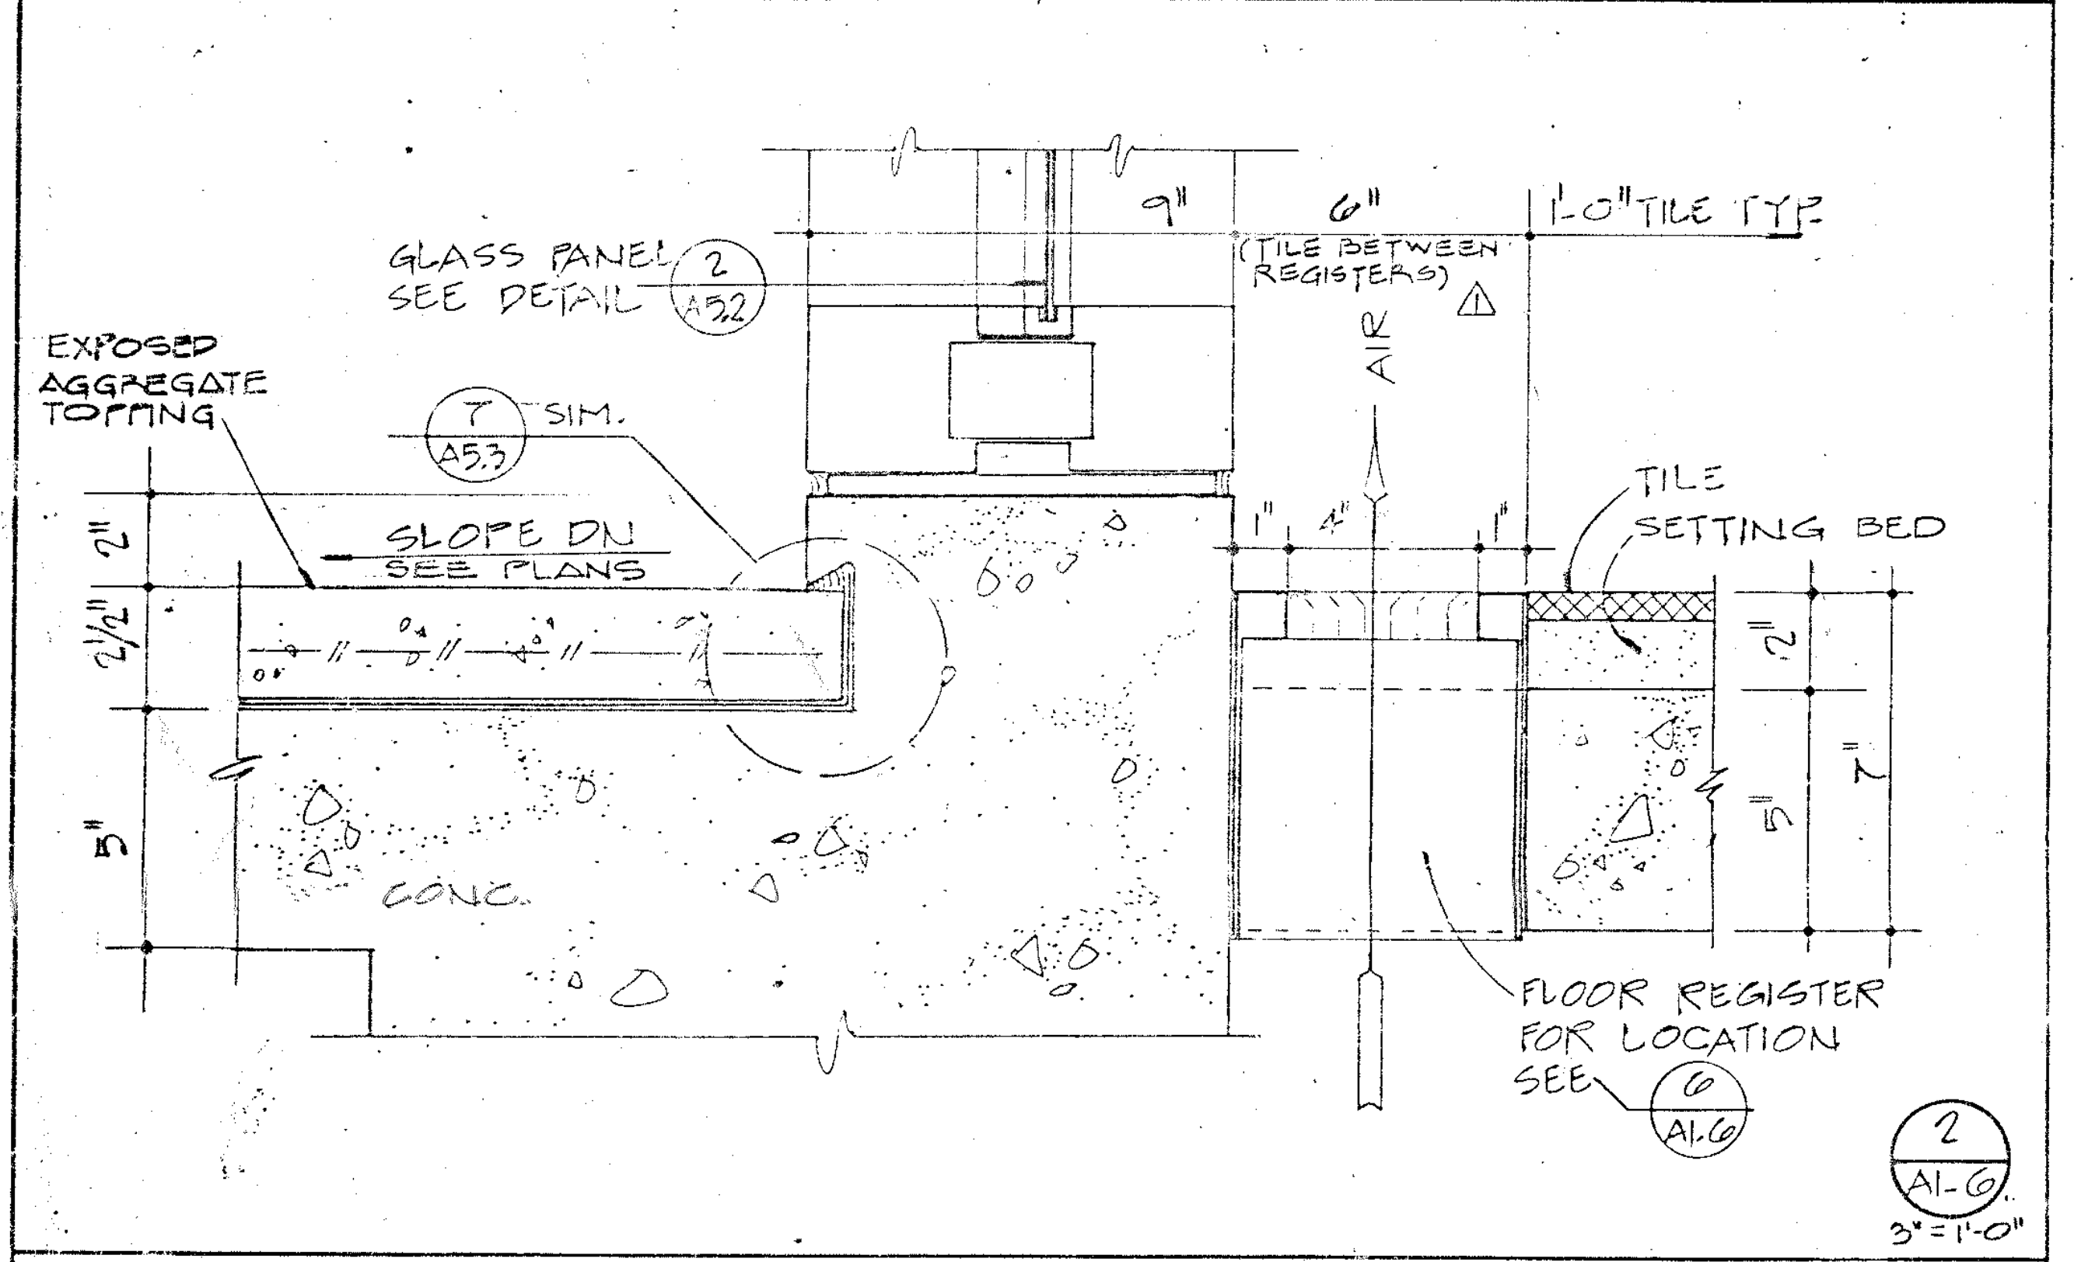

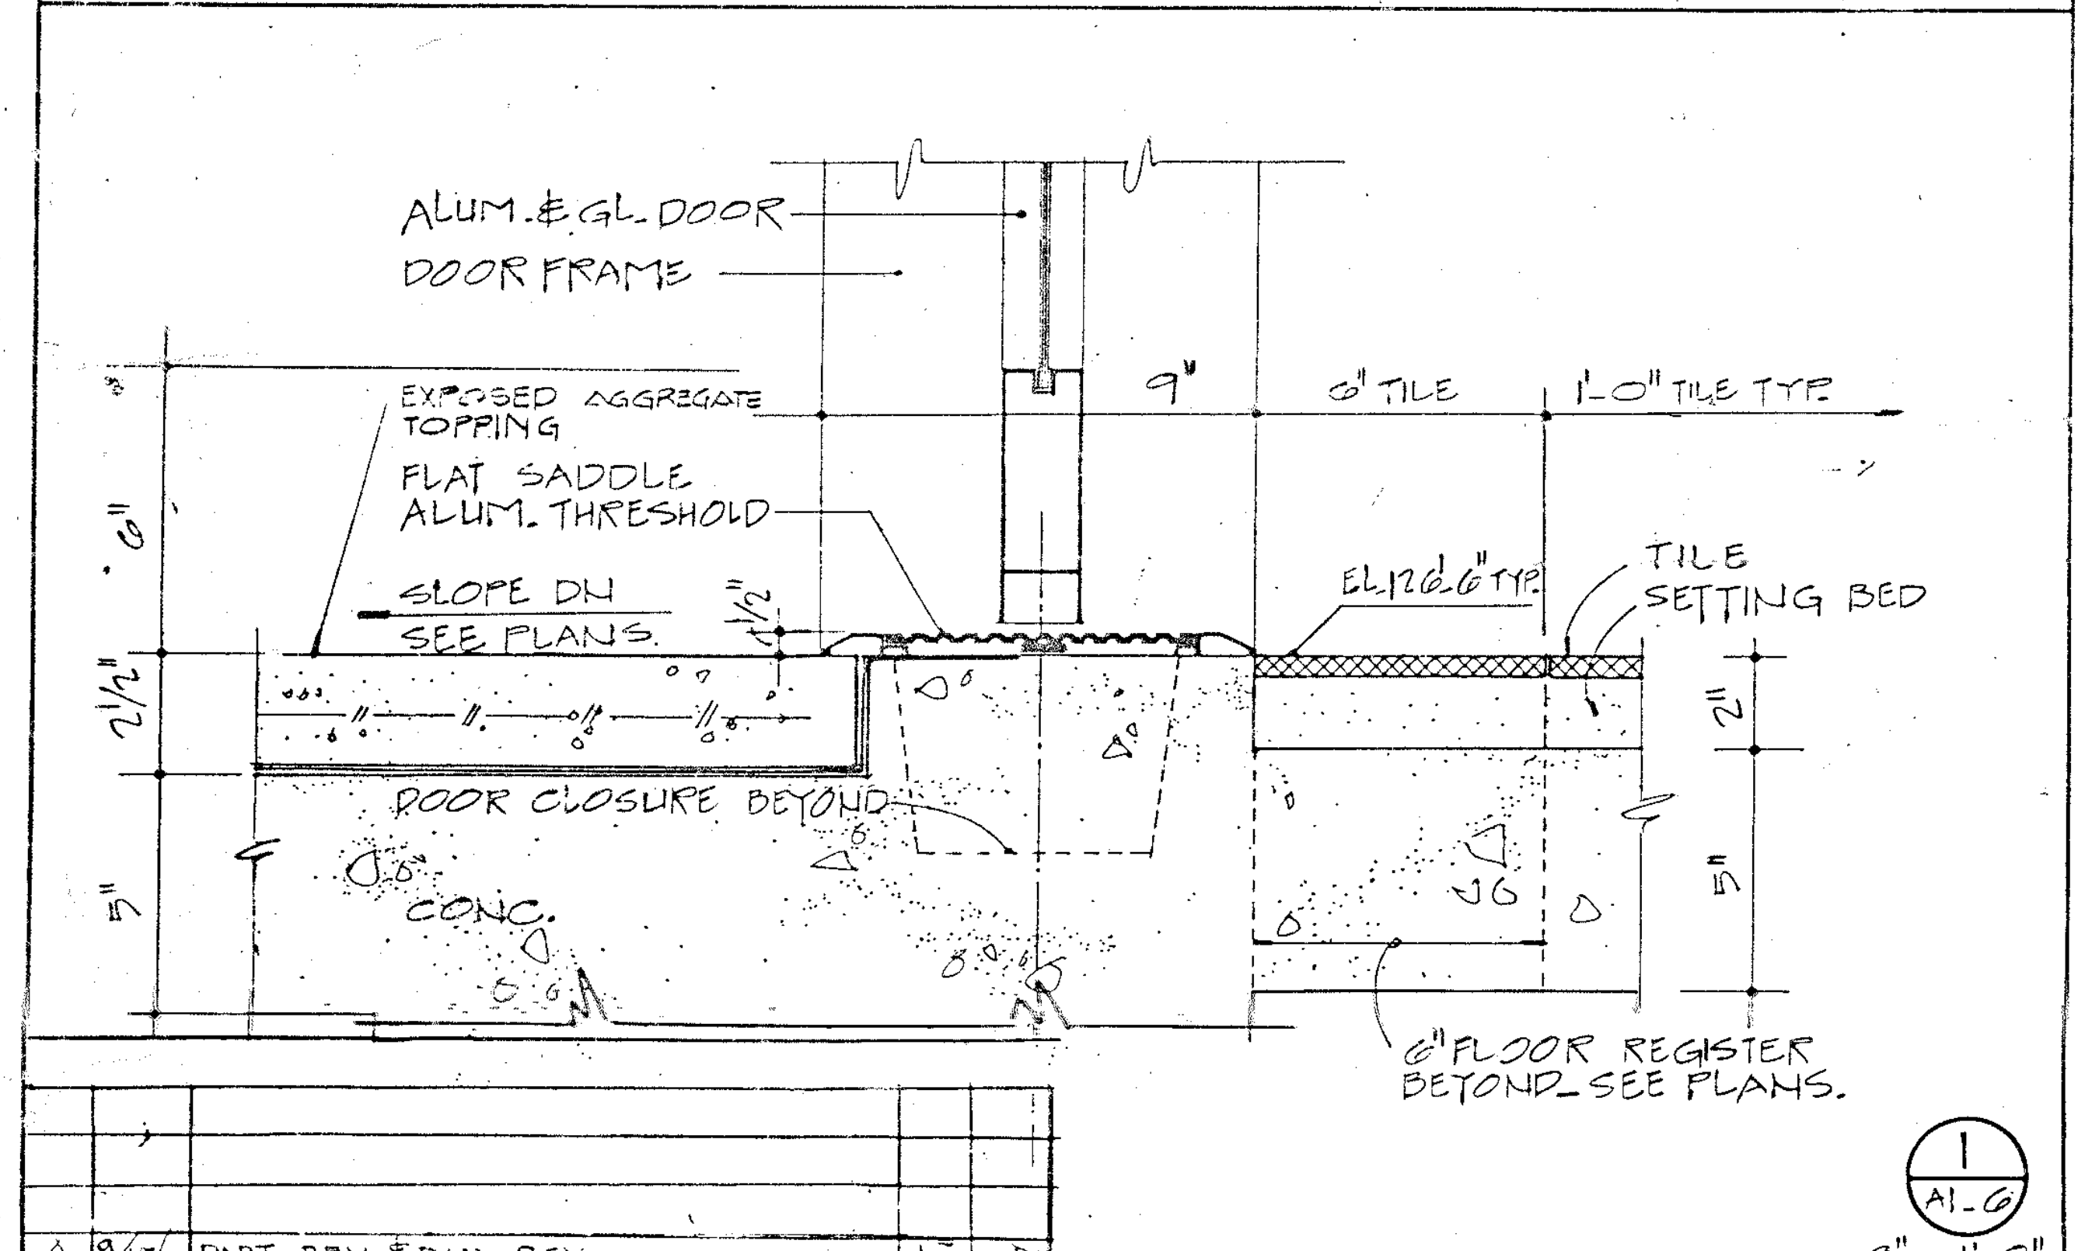

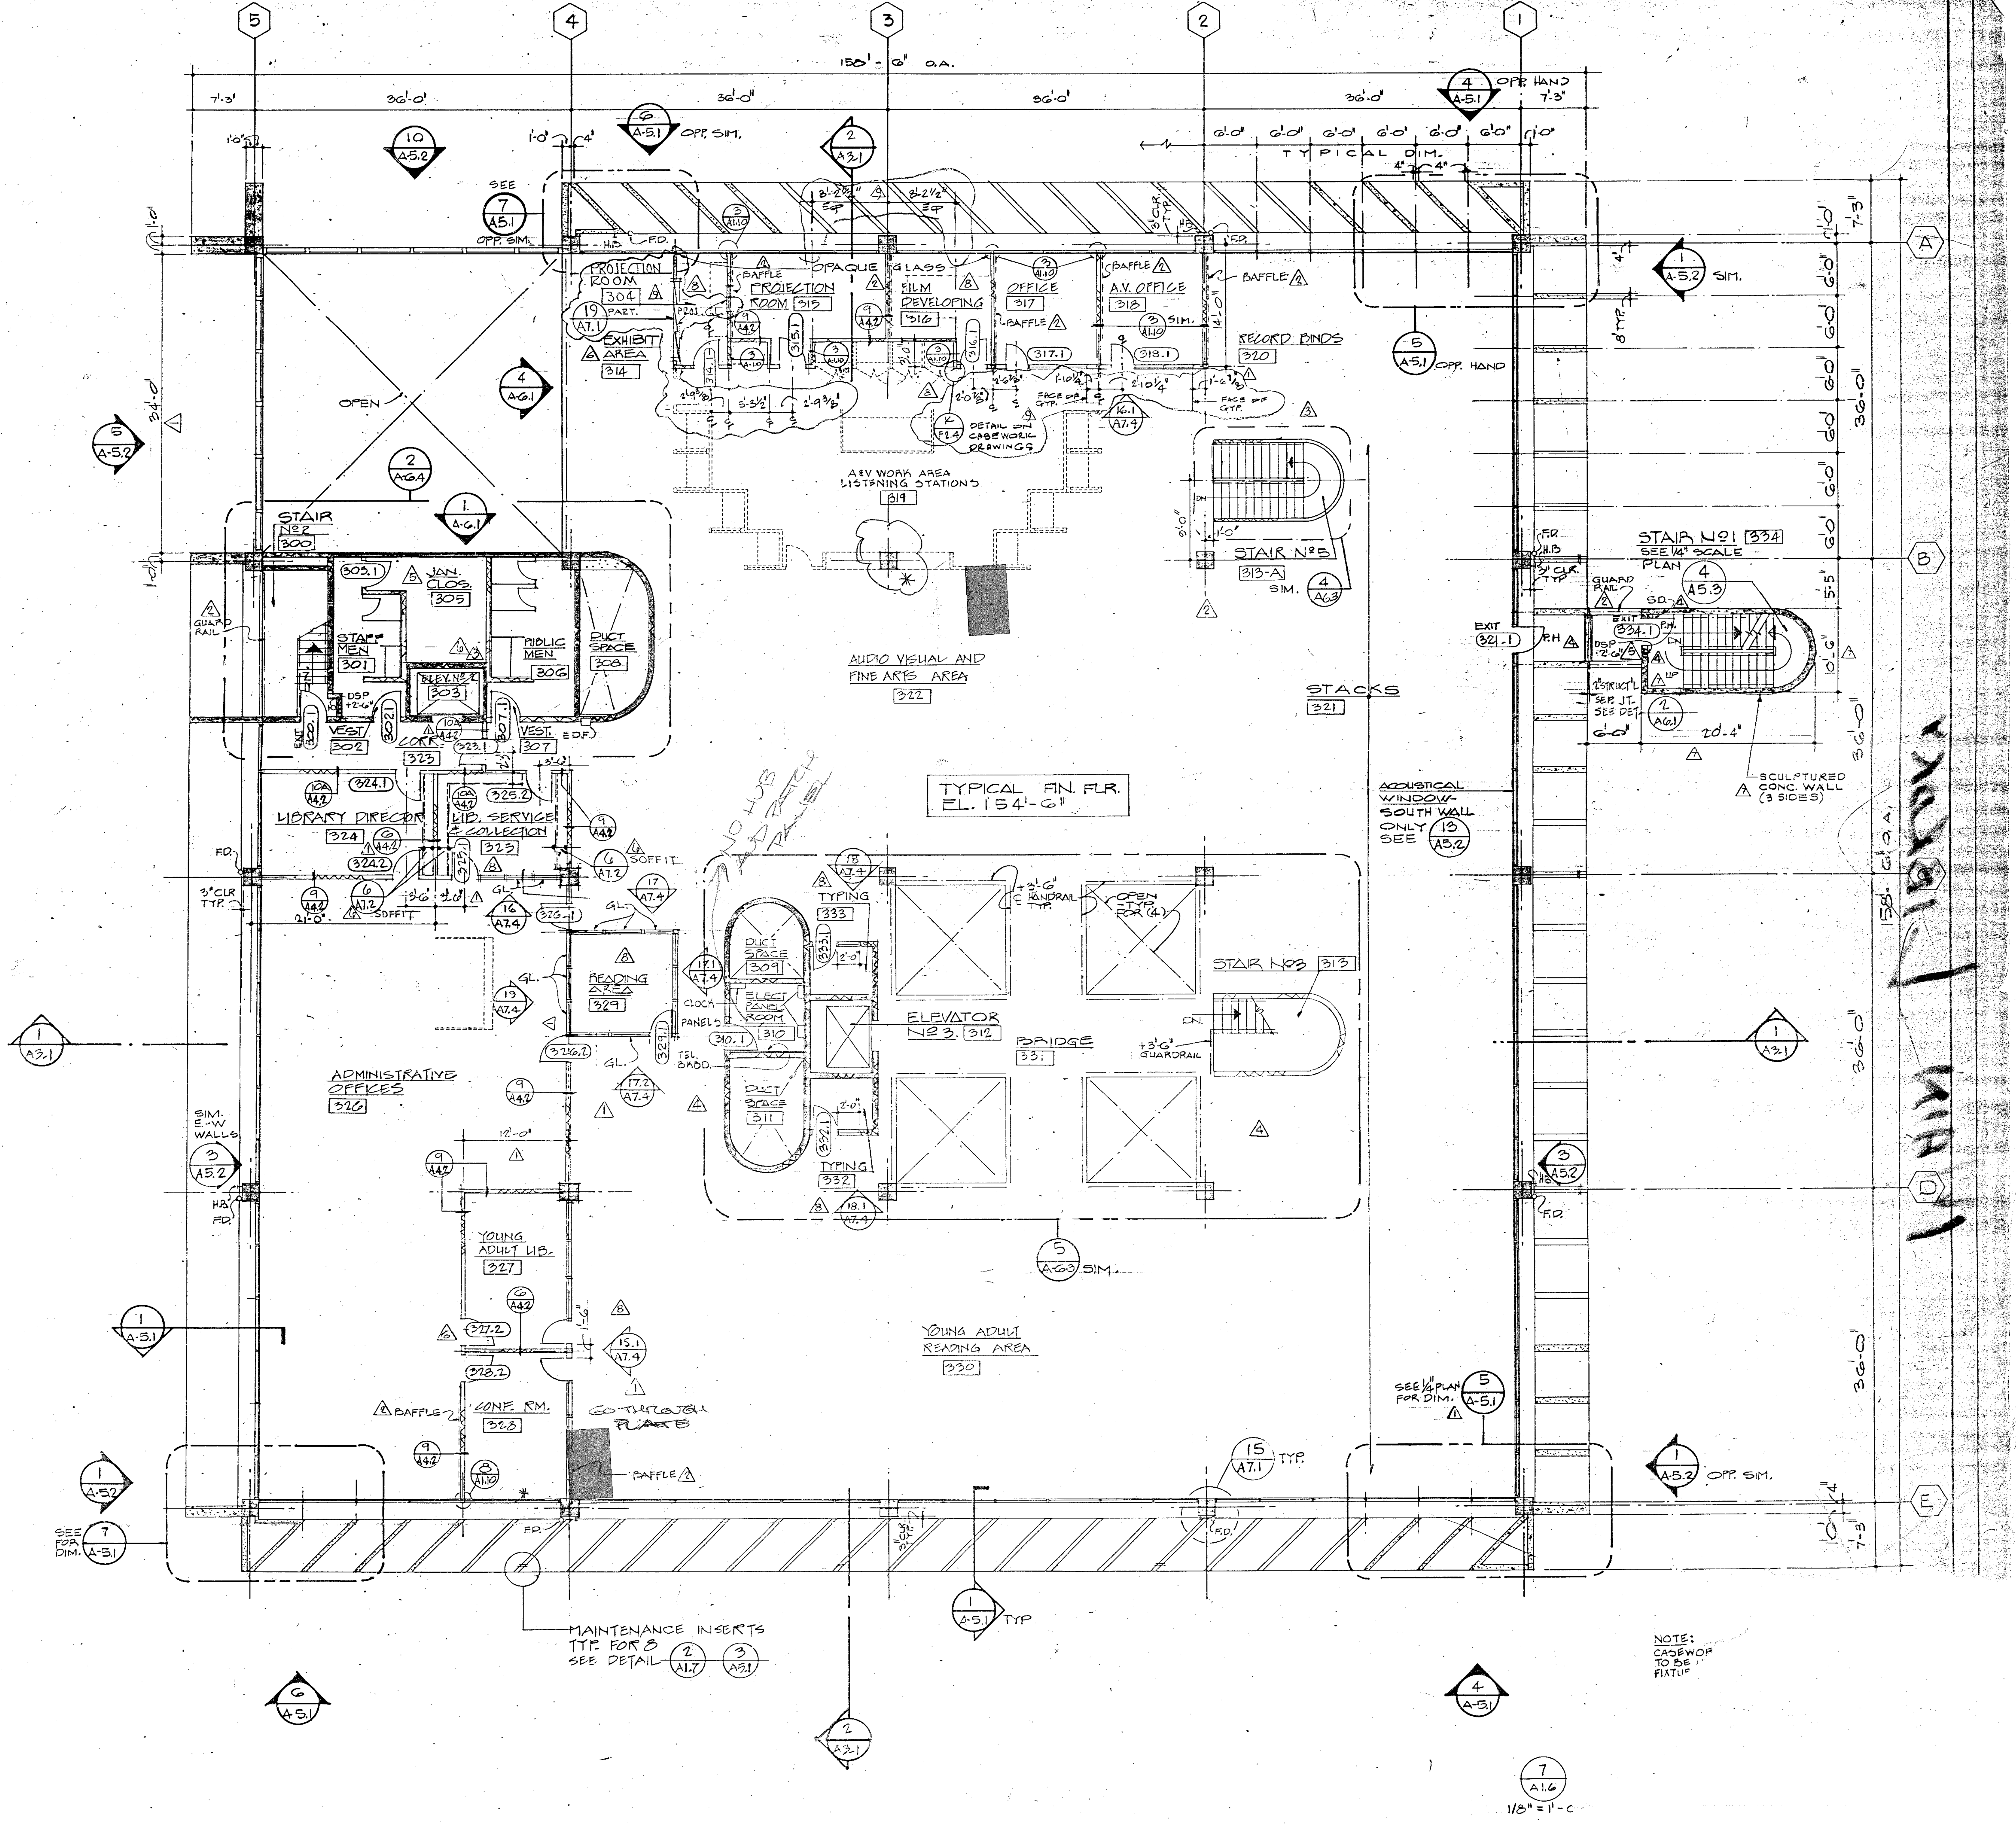

NOTE: CASEWOR TO BE FIXTUR

9	9/13/72	PART. REV. & DIM. REV.	LT	TP					
8	6/30/72	INTERIOR WALL REVISIONS	FA	TP	4	12-9-71	BLDG. DEPT. CHANGES	MF	A.P.
7	5/24/72	SCULPTURED WALLS ADDED	BS	TP	3	12-9-71	OWNER'S CHANGES (2002.06.02)	MF	A.P.
6	5/17/72	SOFFITS ADDED; DRS. 327.2 & 328.2 MOVED; HOLD ON RM. 314, DELETED WORDS "PIPE SPACE"	FA	TP	2	12-19-71	ADDENDUM No 2		
5	1-24-72	OWNERS CHANGES (2002.06.02)	MF	D.P.	1		ADDENDUM No 2.1		
NO.	DATE	REVISION	BY	CHK	NO.	DATE	REVISION	BY	CHK

NOTE: CONTRACTOR IS ADVISED THAT ISSUANCE OF THIS DRAWING DOES NOT NECESSARILY INCLUDE REVISIONS MADE BY PREVIOUS ADDENDA, BULLETINS, REVISIONS TO DRAWINGS, OR APPROVED SHOP DRAWINGS.

PROJECT GROUP	APPROVED BY
DESIGNER R VELAND	PRODUCTION
PROJECT CAPTAIN G WAN	PROJECT ARCHITECT
DRAFTSMAN S B / EP / V.C.	ENGINEER
CHECKER AA Post	

~~THIS DRAWING IS NOT TO BE CONSIDERED FINAL UNTIL ALL~~ THE REQUIRED SIGNATURES OF APPROVAL HAVE BEEN AFFIXED.

PROJECT

CITY OF INGLEWOOD
CIVIC CENTER
LIBRARY
INGLEWOOD CALIFORNIA

SHEET TITLE

THIRD FLOOR PLAN

Charles Luckman Asso

Planning Architecture Engineering
9220 Sunset Boulevard Los Angeles, California 90069

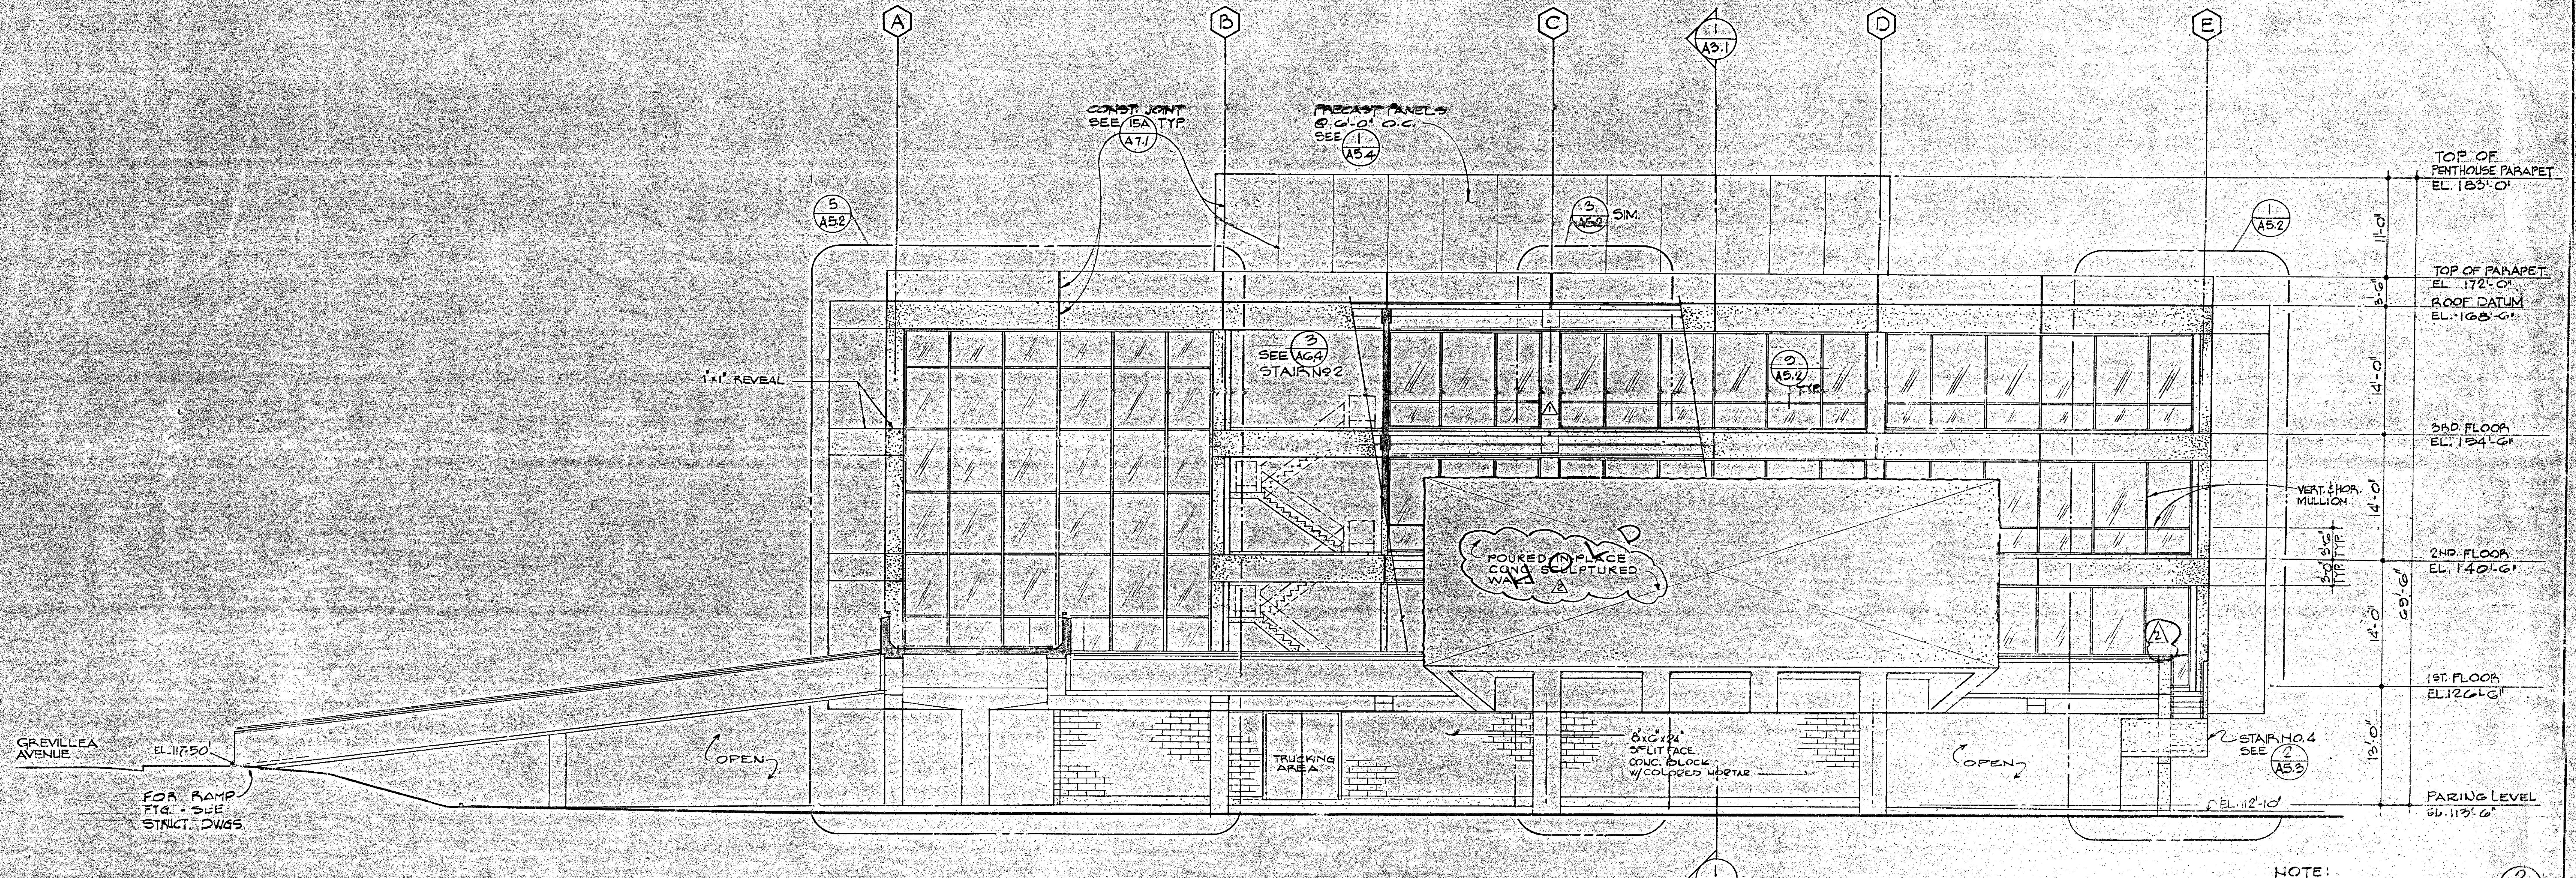

NORTH ELEVATION

NOTE: FOR TYPICAL NOTATIONS, SEE 1/A2.1

2/A2.1 1/8" = 1'-0"

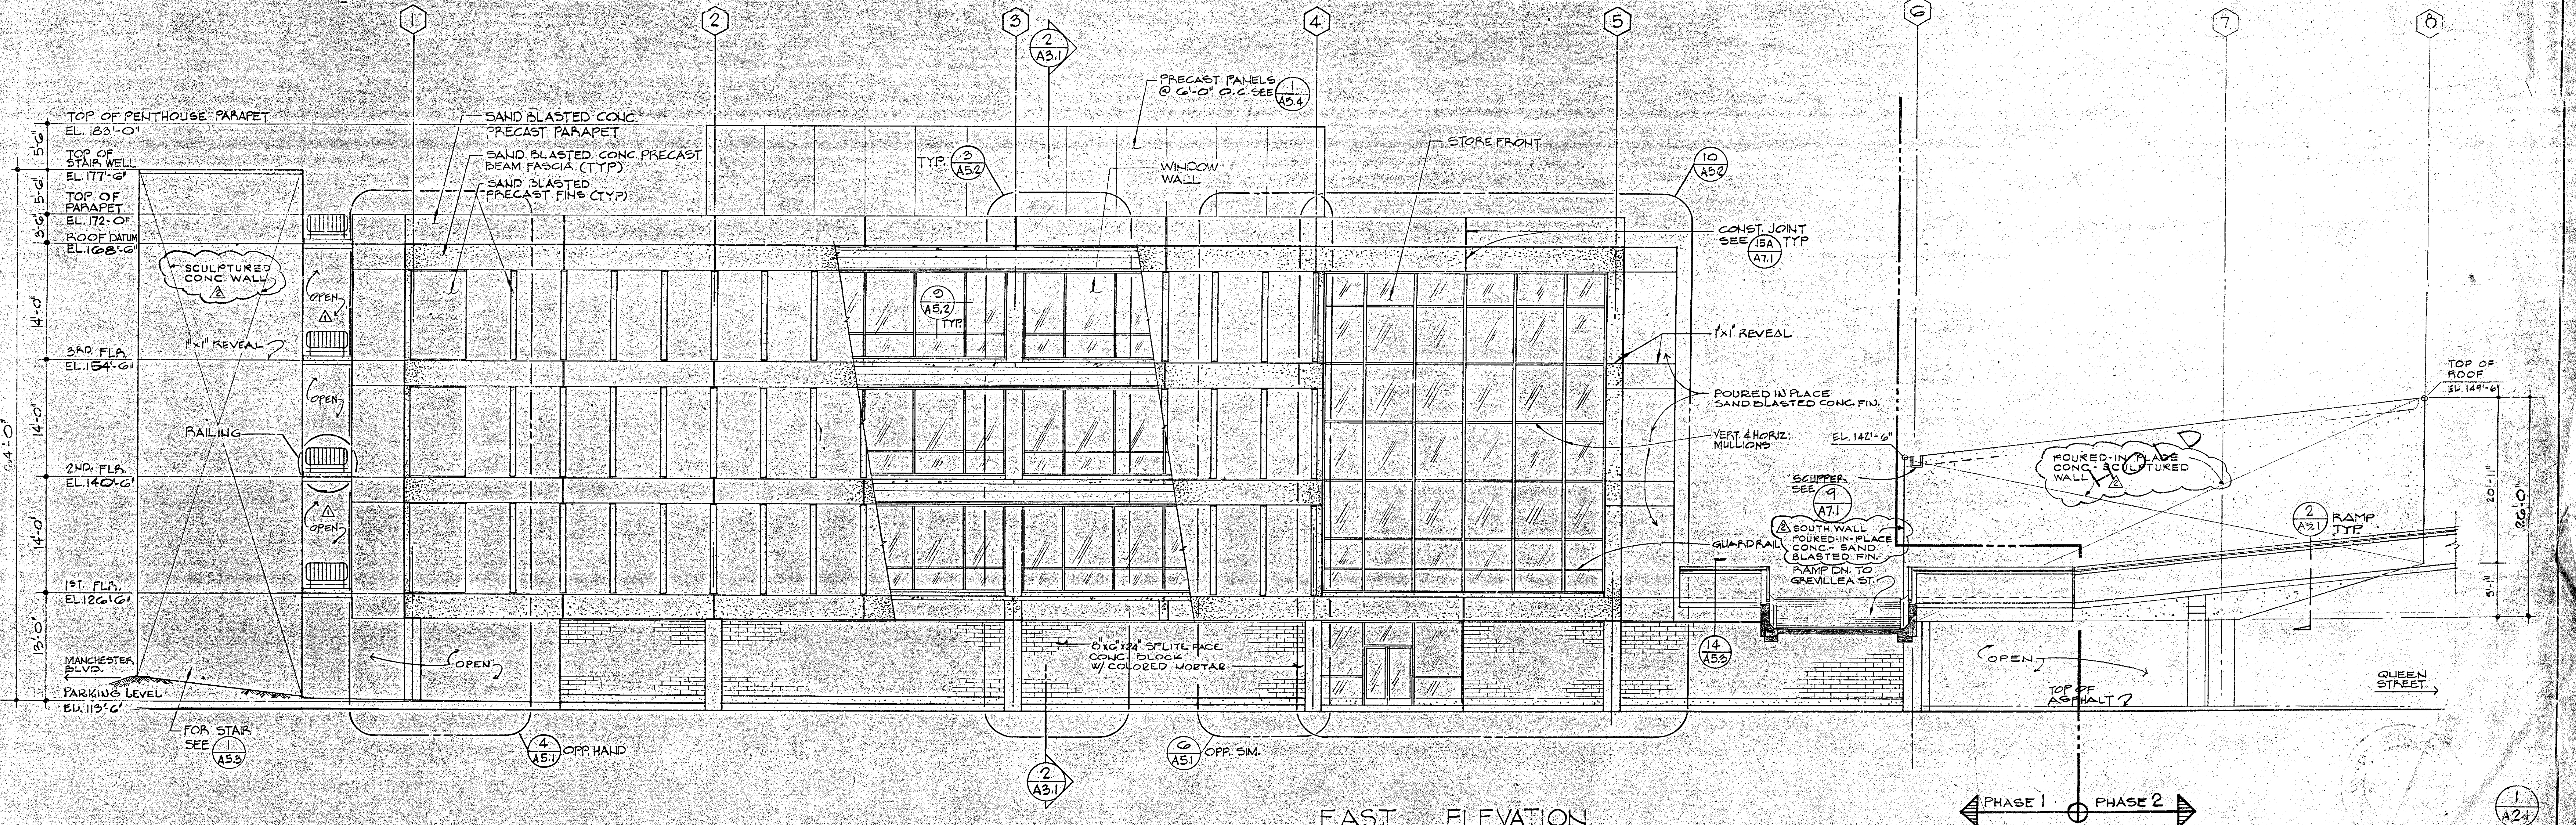

EAST ELEVATION

1/A2.1 1/8" = 1'-0"

NO.	DATE	REVISION	BY	CHK	NO.	DATE	REVISION	BY	CHK
△					△				
△					△				
△					②	5/24/72	SCULPTURED WALLS ADDED	BS	TP
△					①		ADDENDUM No 1		

NOTE: CONTRACTOR IS ADVISED THAT ISSUANCE OF THIS DRAWING DOES NOT NECESSARILY INCLUDE REVISIONS MADE BY PREVIOUS ADDENDA, BULLETINS, REVISIONS TO DRAWINGS, OR APPROVED SHOP DRAWINGS.

PROJECT GROUP	APPROVED BY
DESIGNER R. YELAND	PRODUCTION H. Maynard
PROJECT CAPTAIN G. WAN	PROJECT ARCHITECT Berry
DRAFTSMAN S. B / E. P.	ENGINEER
CHECKER A. A. Post	

THIS DRAWING IS NOT TO BE CONSIDERED FINAL UNTIL ALL THE REQUIRED SIGNATURES OF APPROVAL HAVE BEEN AFFIXED.

PROJECT
CITY OF INGLEWOOD
CIVIC CENTER
LIBRARY
INGLEWOOD CALIFORNIA

SHEET TITLE
BUILDING ELEVATIONS

Charles Luckman Associates
Planning Architecture Engineering
9220 Sunset Boulevard Los Angeles, California 90069

SHEET NO.
A-2.1
JOB NO. 2002.03.00
DATE 1-29-71

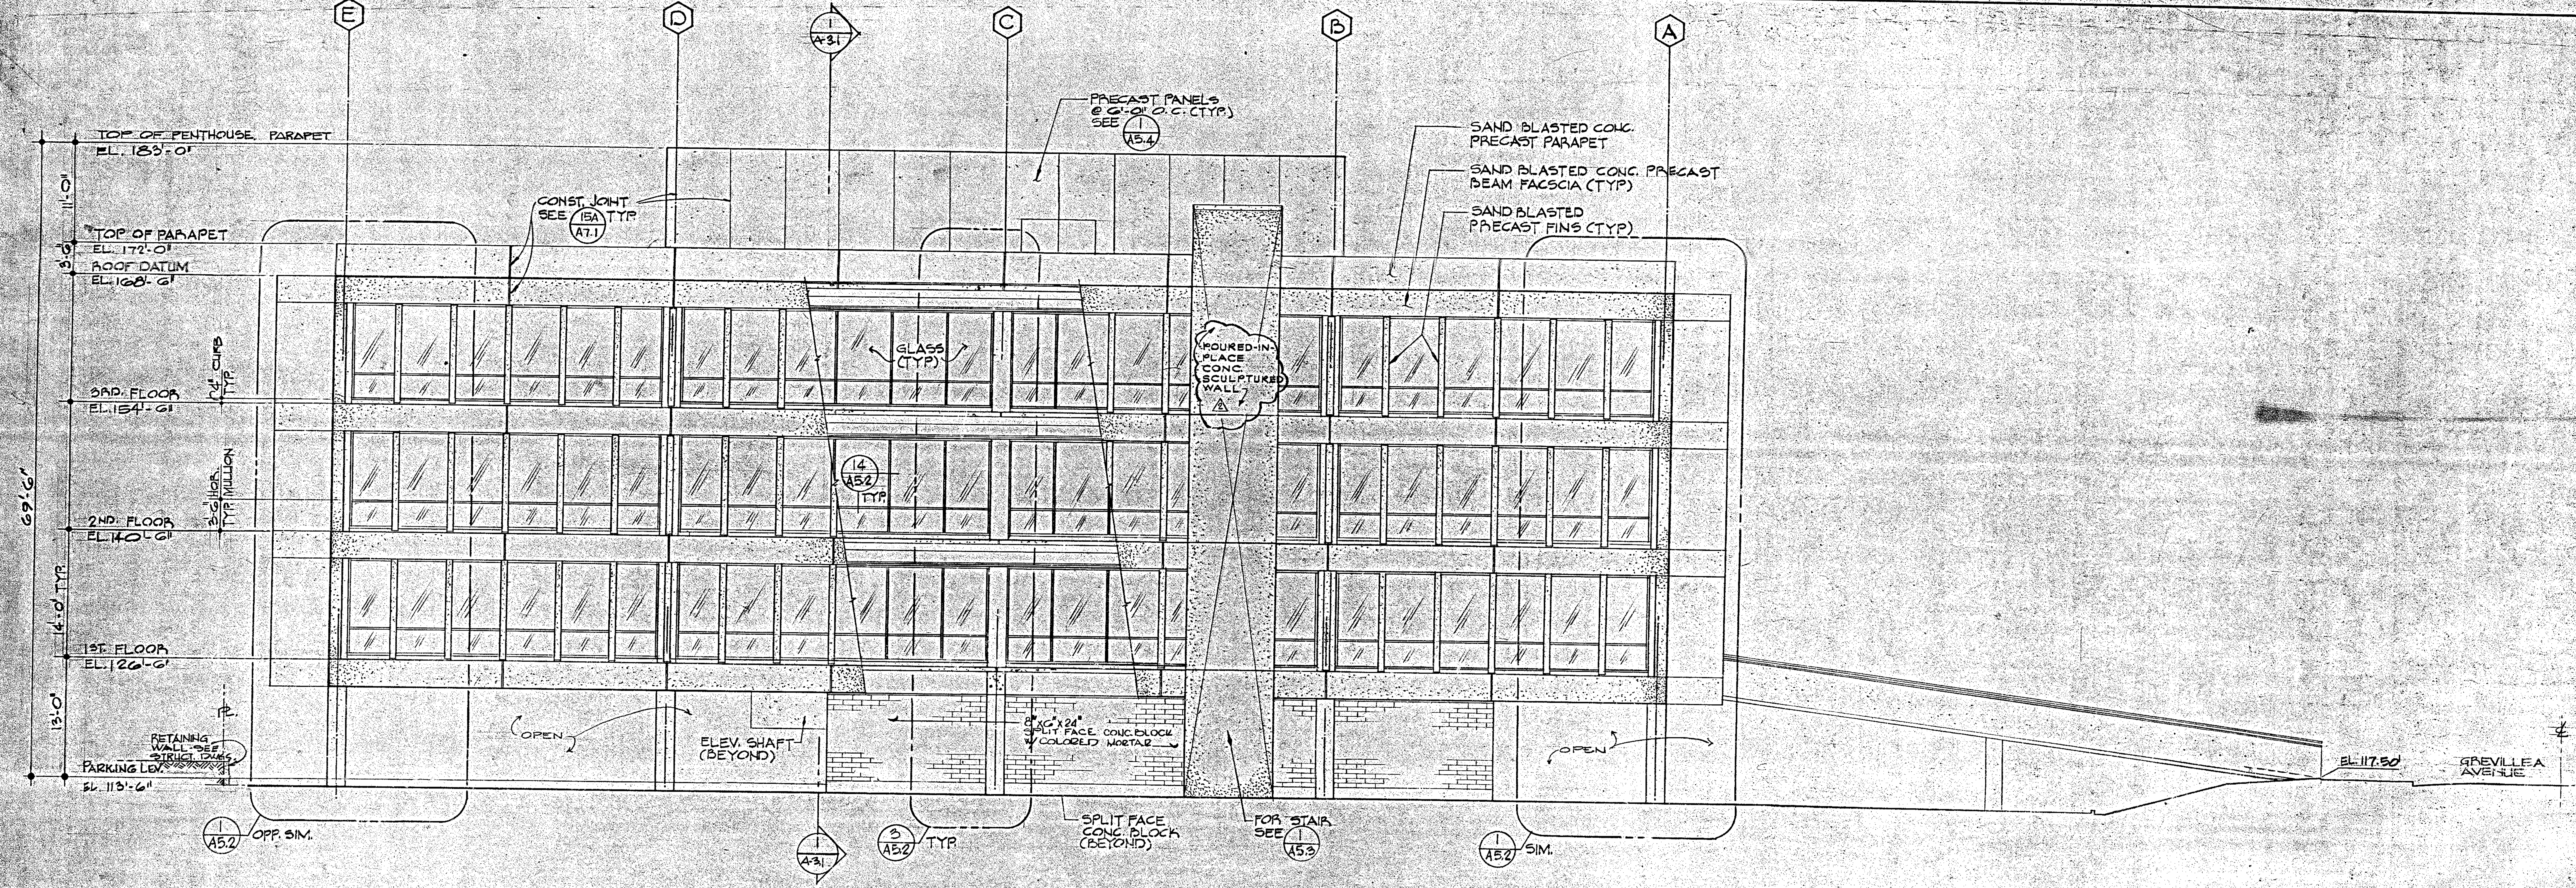

SOUTH ELEVATION

2 A2.2

1/8" = 1'-0"

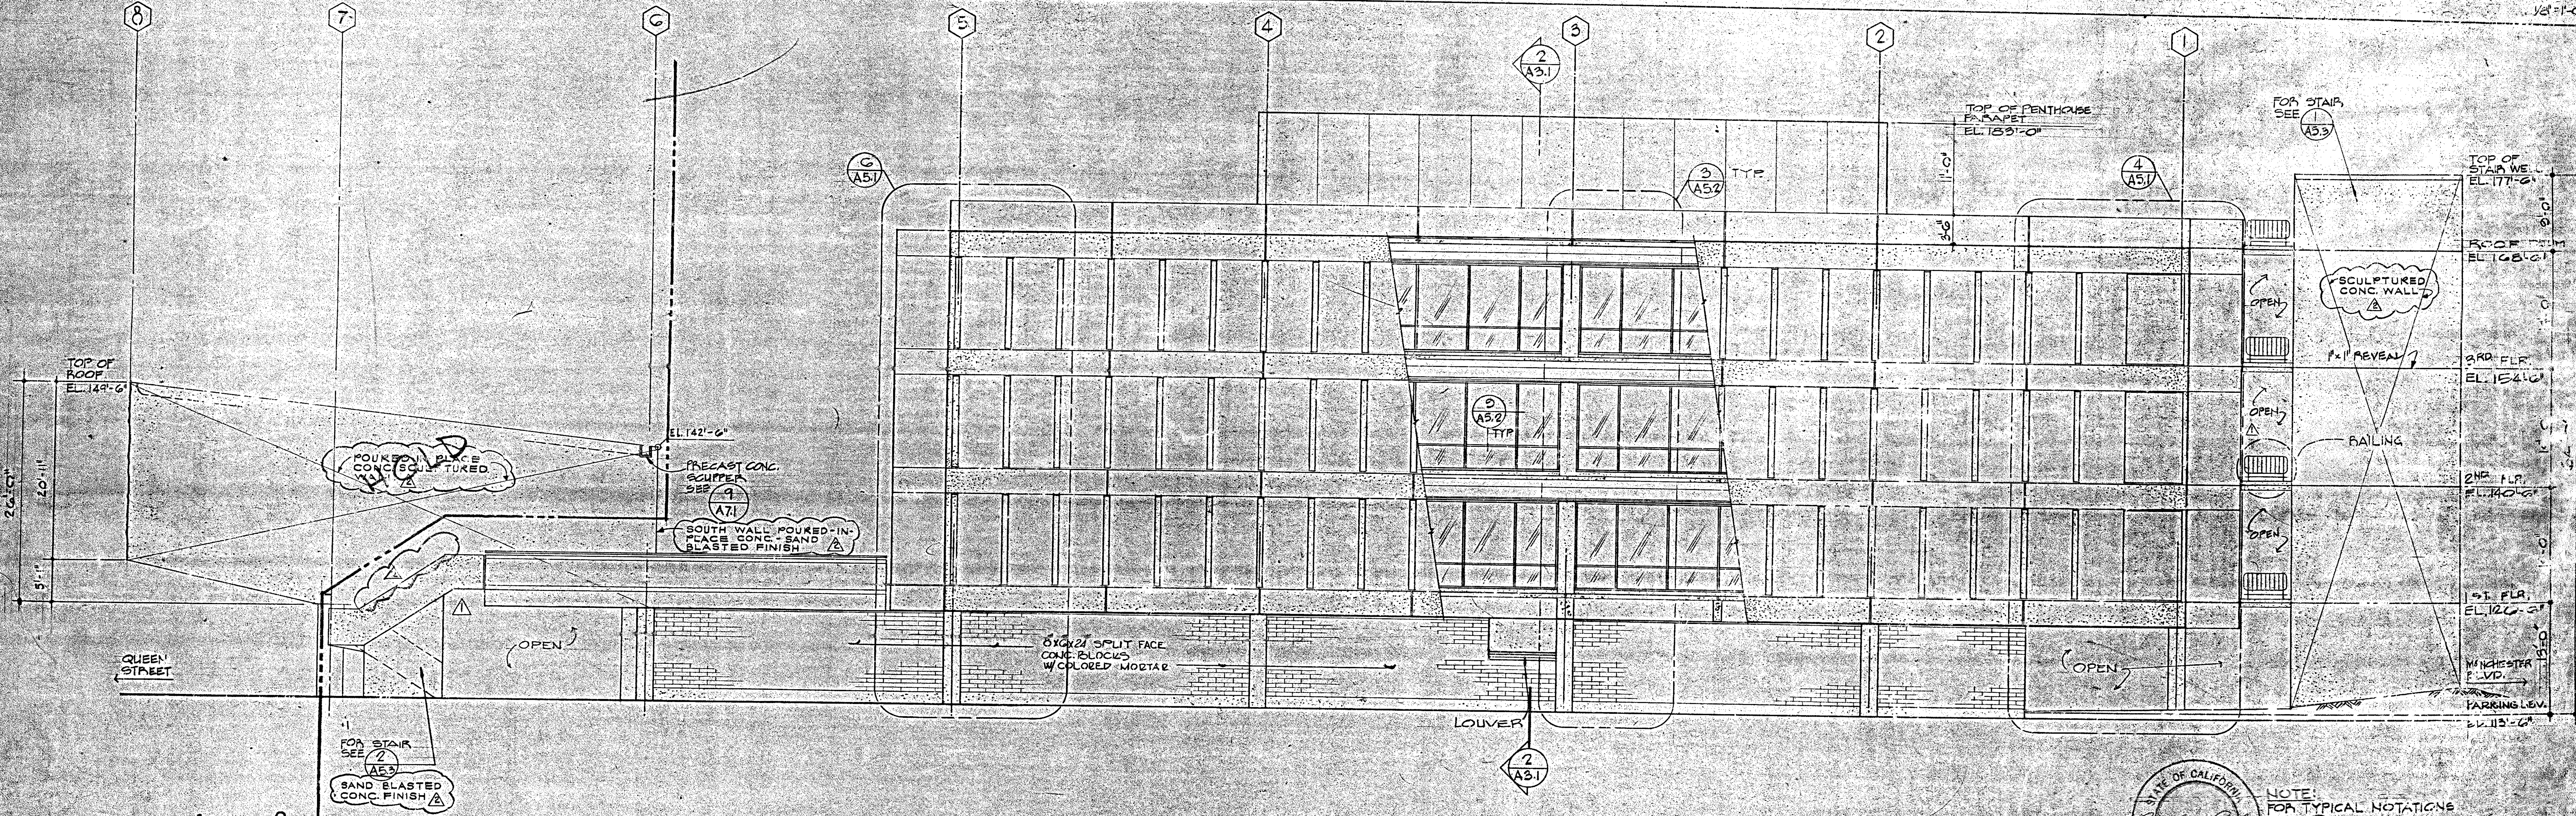

WEST ELEVATION

NOTE:
FOR TYPICAL NOTATIONS SEE 2 A2.2

1 A2.2

1/8" = 1'-0"

NO.	DATE	REVISION	BY	CHK	NO.	DATE	REVISION	BY	CHK
△					△				
△					△				
△					2	5-24-72	SCULPTURED WALLS ADDED	BS	Tp.
△					1		ADDENDUM No 1		

NOTE: CONTRACTOR IS ADVISED THAT ISSUANCE OF THIS DRAWING DOES NOT NECESSARILY INCLUDE REVISIONS MADE BY PREVIOUS ADDENDA, BULLETINS, REVISIONS TO DRAWINGS, OR APPROVED SHOP DRAWINGS.

PROJECT GROUP	APPROVED BY
DESIGNER R. VELAND	PRODUCTION
PROJECT CAPTAIN G. WAN	PROJECT ARCHITECT
DRAFTSMAN SB/EP	ENGINEER
CHECKER aaPost	

THIS DRAWING IS NOT TO BE CONSIDERED FINAL UNTIL ALL THE REQUIRED SIGNATURES OF APPROVAL HAVE BEEN AFFIXED.

PROJECT
CITY OF INGLEWOOD
CIVIC CENTER
LIBRARY
INGLEWOOD CALIFORNIA

SHEET TITLE
BUILDING ELEVATIONS

Charles Luckman Associates
Planning Architecture Engineering
9220 Sunset Boulevard Los Angeles, California 90069

SHEET NO.
A-2.2
JOB NO. 2002.03.00
DATE 1-29-71

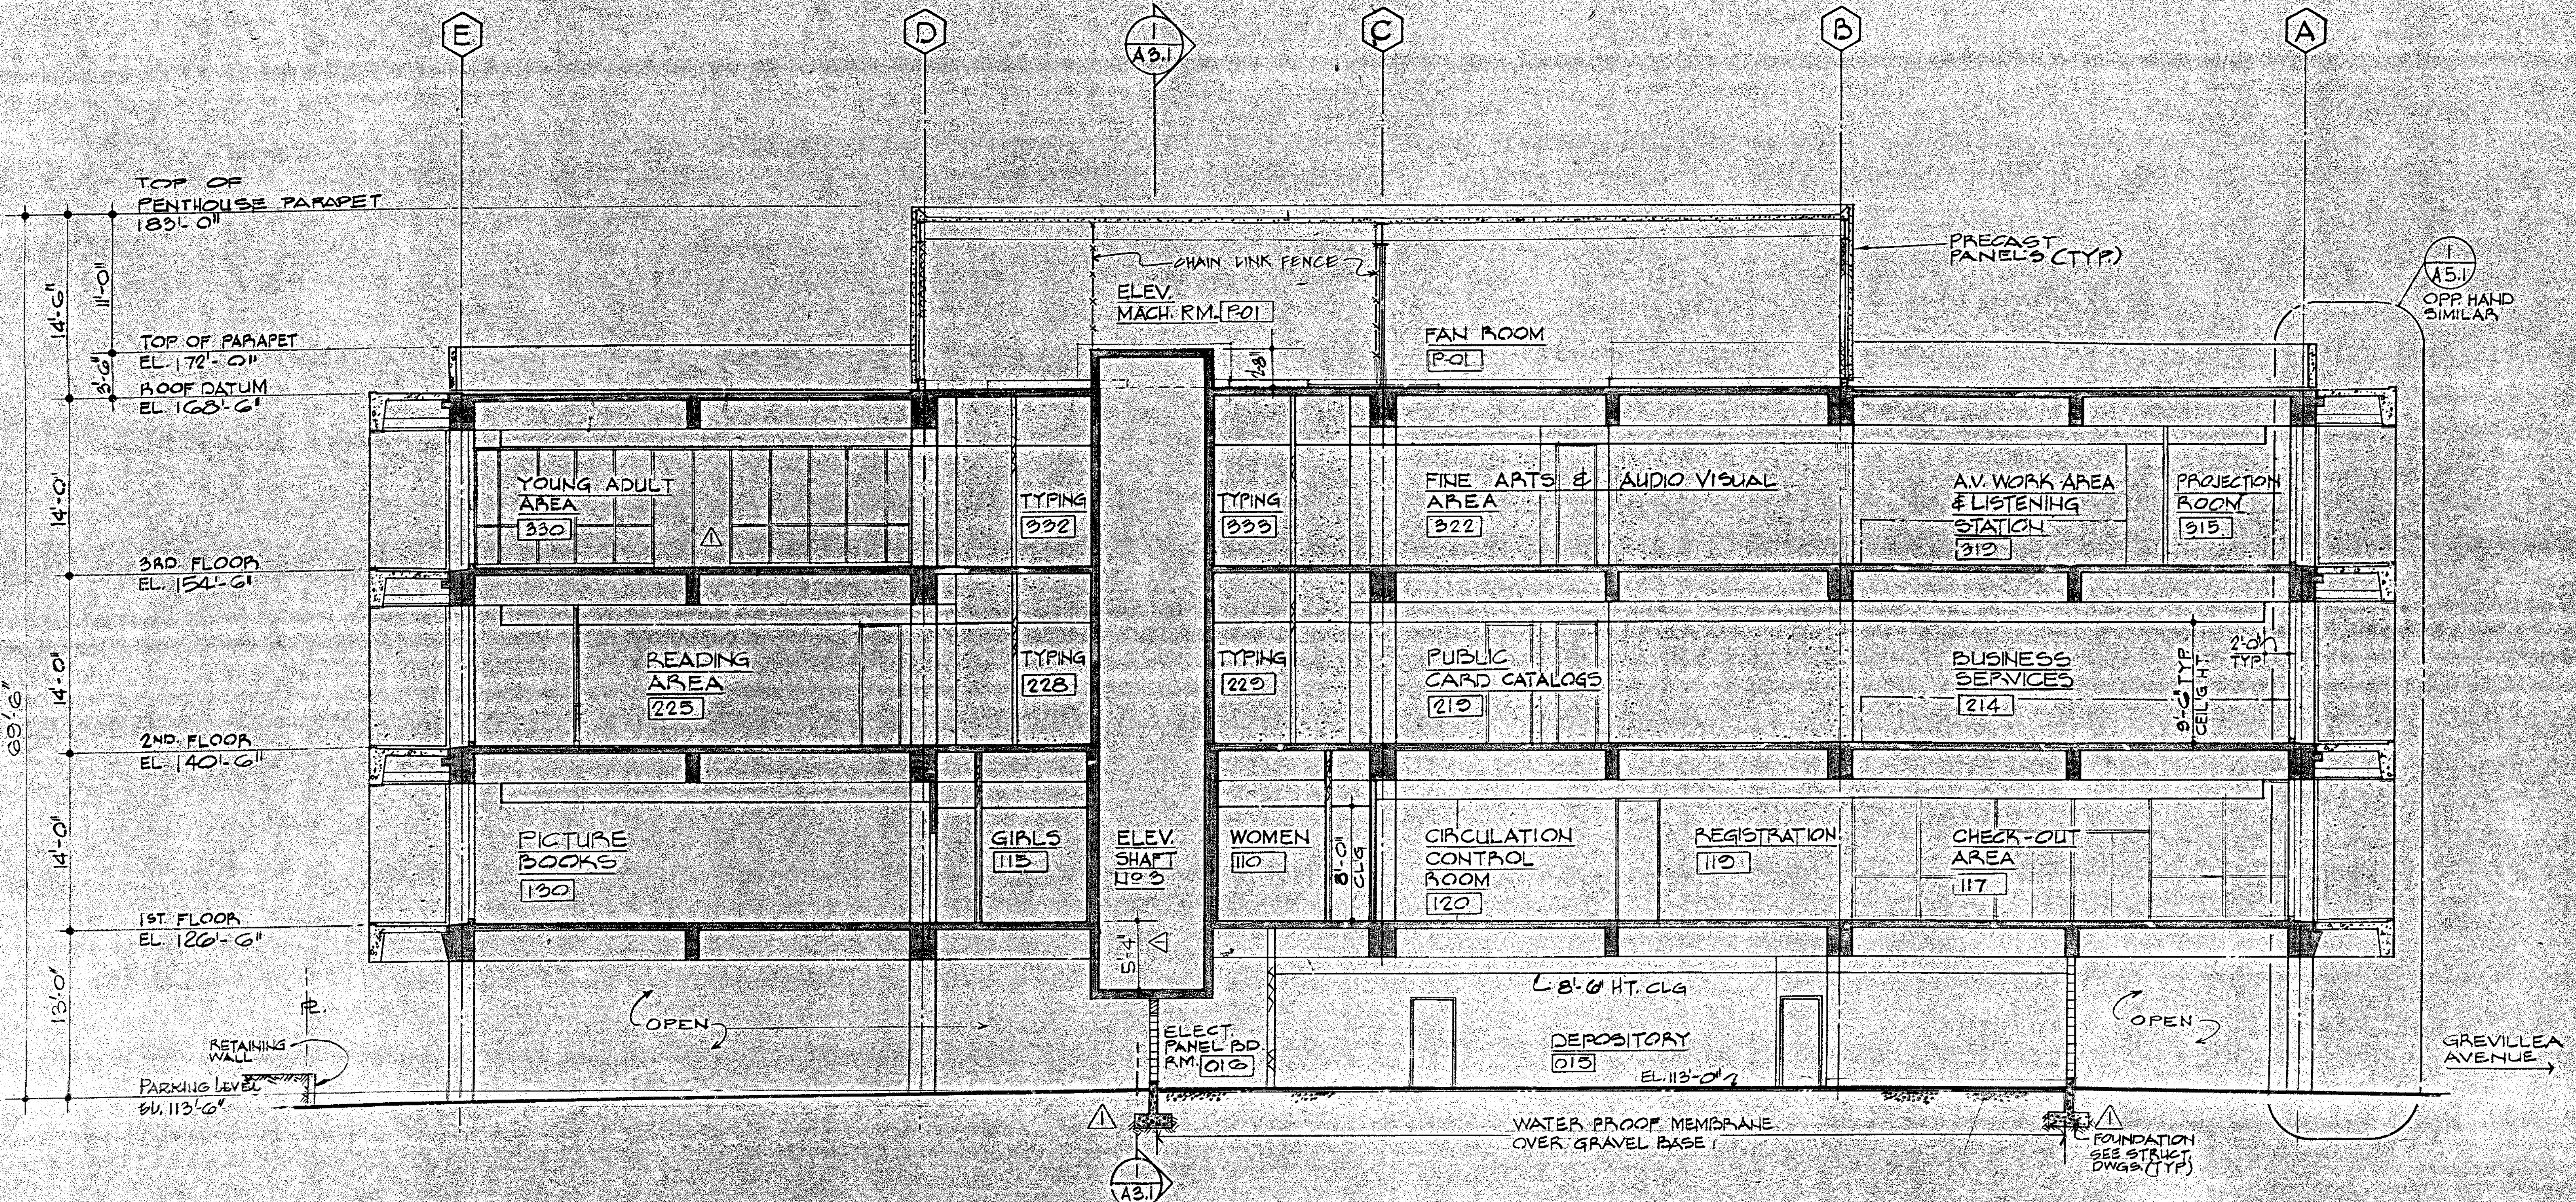

SECTION-'2'

2 / A3.1

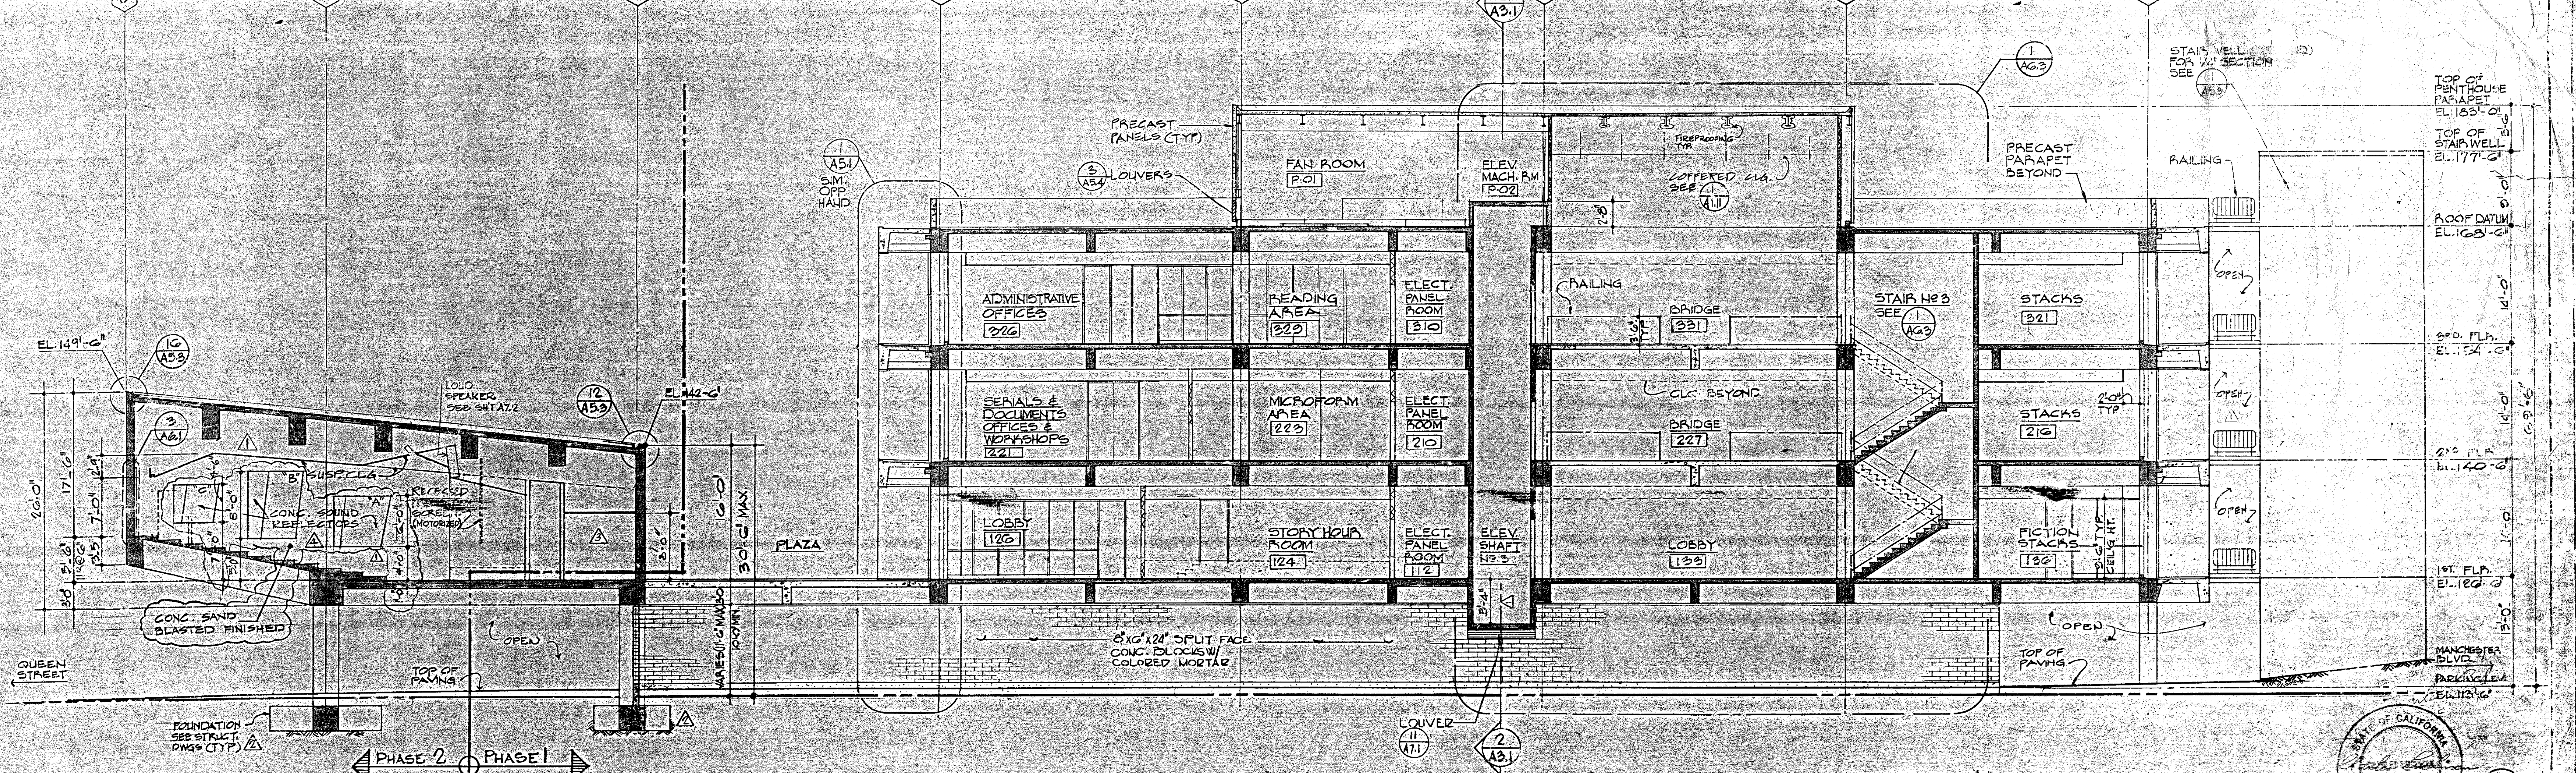

SECTION-'1'

1 / A3.1
1/8"=1'-0"

STATE OF CALIFORNIA
REGISTERED ARCHITECT

INTERNAL CHECK 1-18-71
PRELIM. E.D. INFO 1-9-70
10-5-70

NO.	DATE	REVISION	BY	CHK	NO.	DATE	REVISION	BY	CHK
△					4	3/31/72	REVISION OF SOUND REFLECTORS	FA	TP
△					3	12-29-71	OWNER'S CHANGES	MF	A.P.
△					2	2-1-71	ADDENDUM NO. 2		
△					1		ADDENDUM NO. 1		

NOTE: CONTRACTOR IS ADVISED THAT ISSUANCE OF THIS DRAWING DOES NOT NECESSARILY INCLUDE REVISIONS MADE BY PREVIOUS ADDENDA, BULLETINS, REVISIONS TO DRAWINGS, OR APPROVED SHOP DRAWINGS.

PROJECT GROUP	APPROVED BY
DESIGNER R. VELAND	PRODUCTION
PROJECT CAPTAIN G. WON	PROJECT ARCHITECT
DRAFTSMAN SB/EP	ENGINEER
CHECKER AAPost	

THIS DRAWING IS NOT TO BE CONSIDERED FINAL UNTIL ALL THE REQUIRED SIGNATURES OF APPROVAL HAVE BEEN AFFIXED.

PROJECT
CITY OF INGLEWOOD
CIVIC CENTER
LIBRARY
INGLEWOOD CALIFORNIA

SHEET TITLE
BUILDING SECTIONS

Charles Luckman Associates
Planning Architecture Engineering
9220 Sunset Boulevard Los Angeles, California 90069

SHEET NO.
A-3.1
JOB NO.
DATE