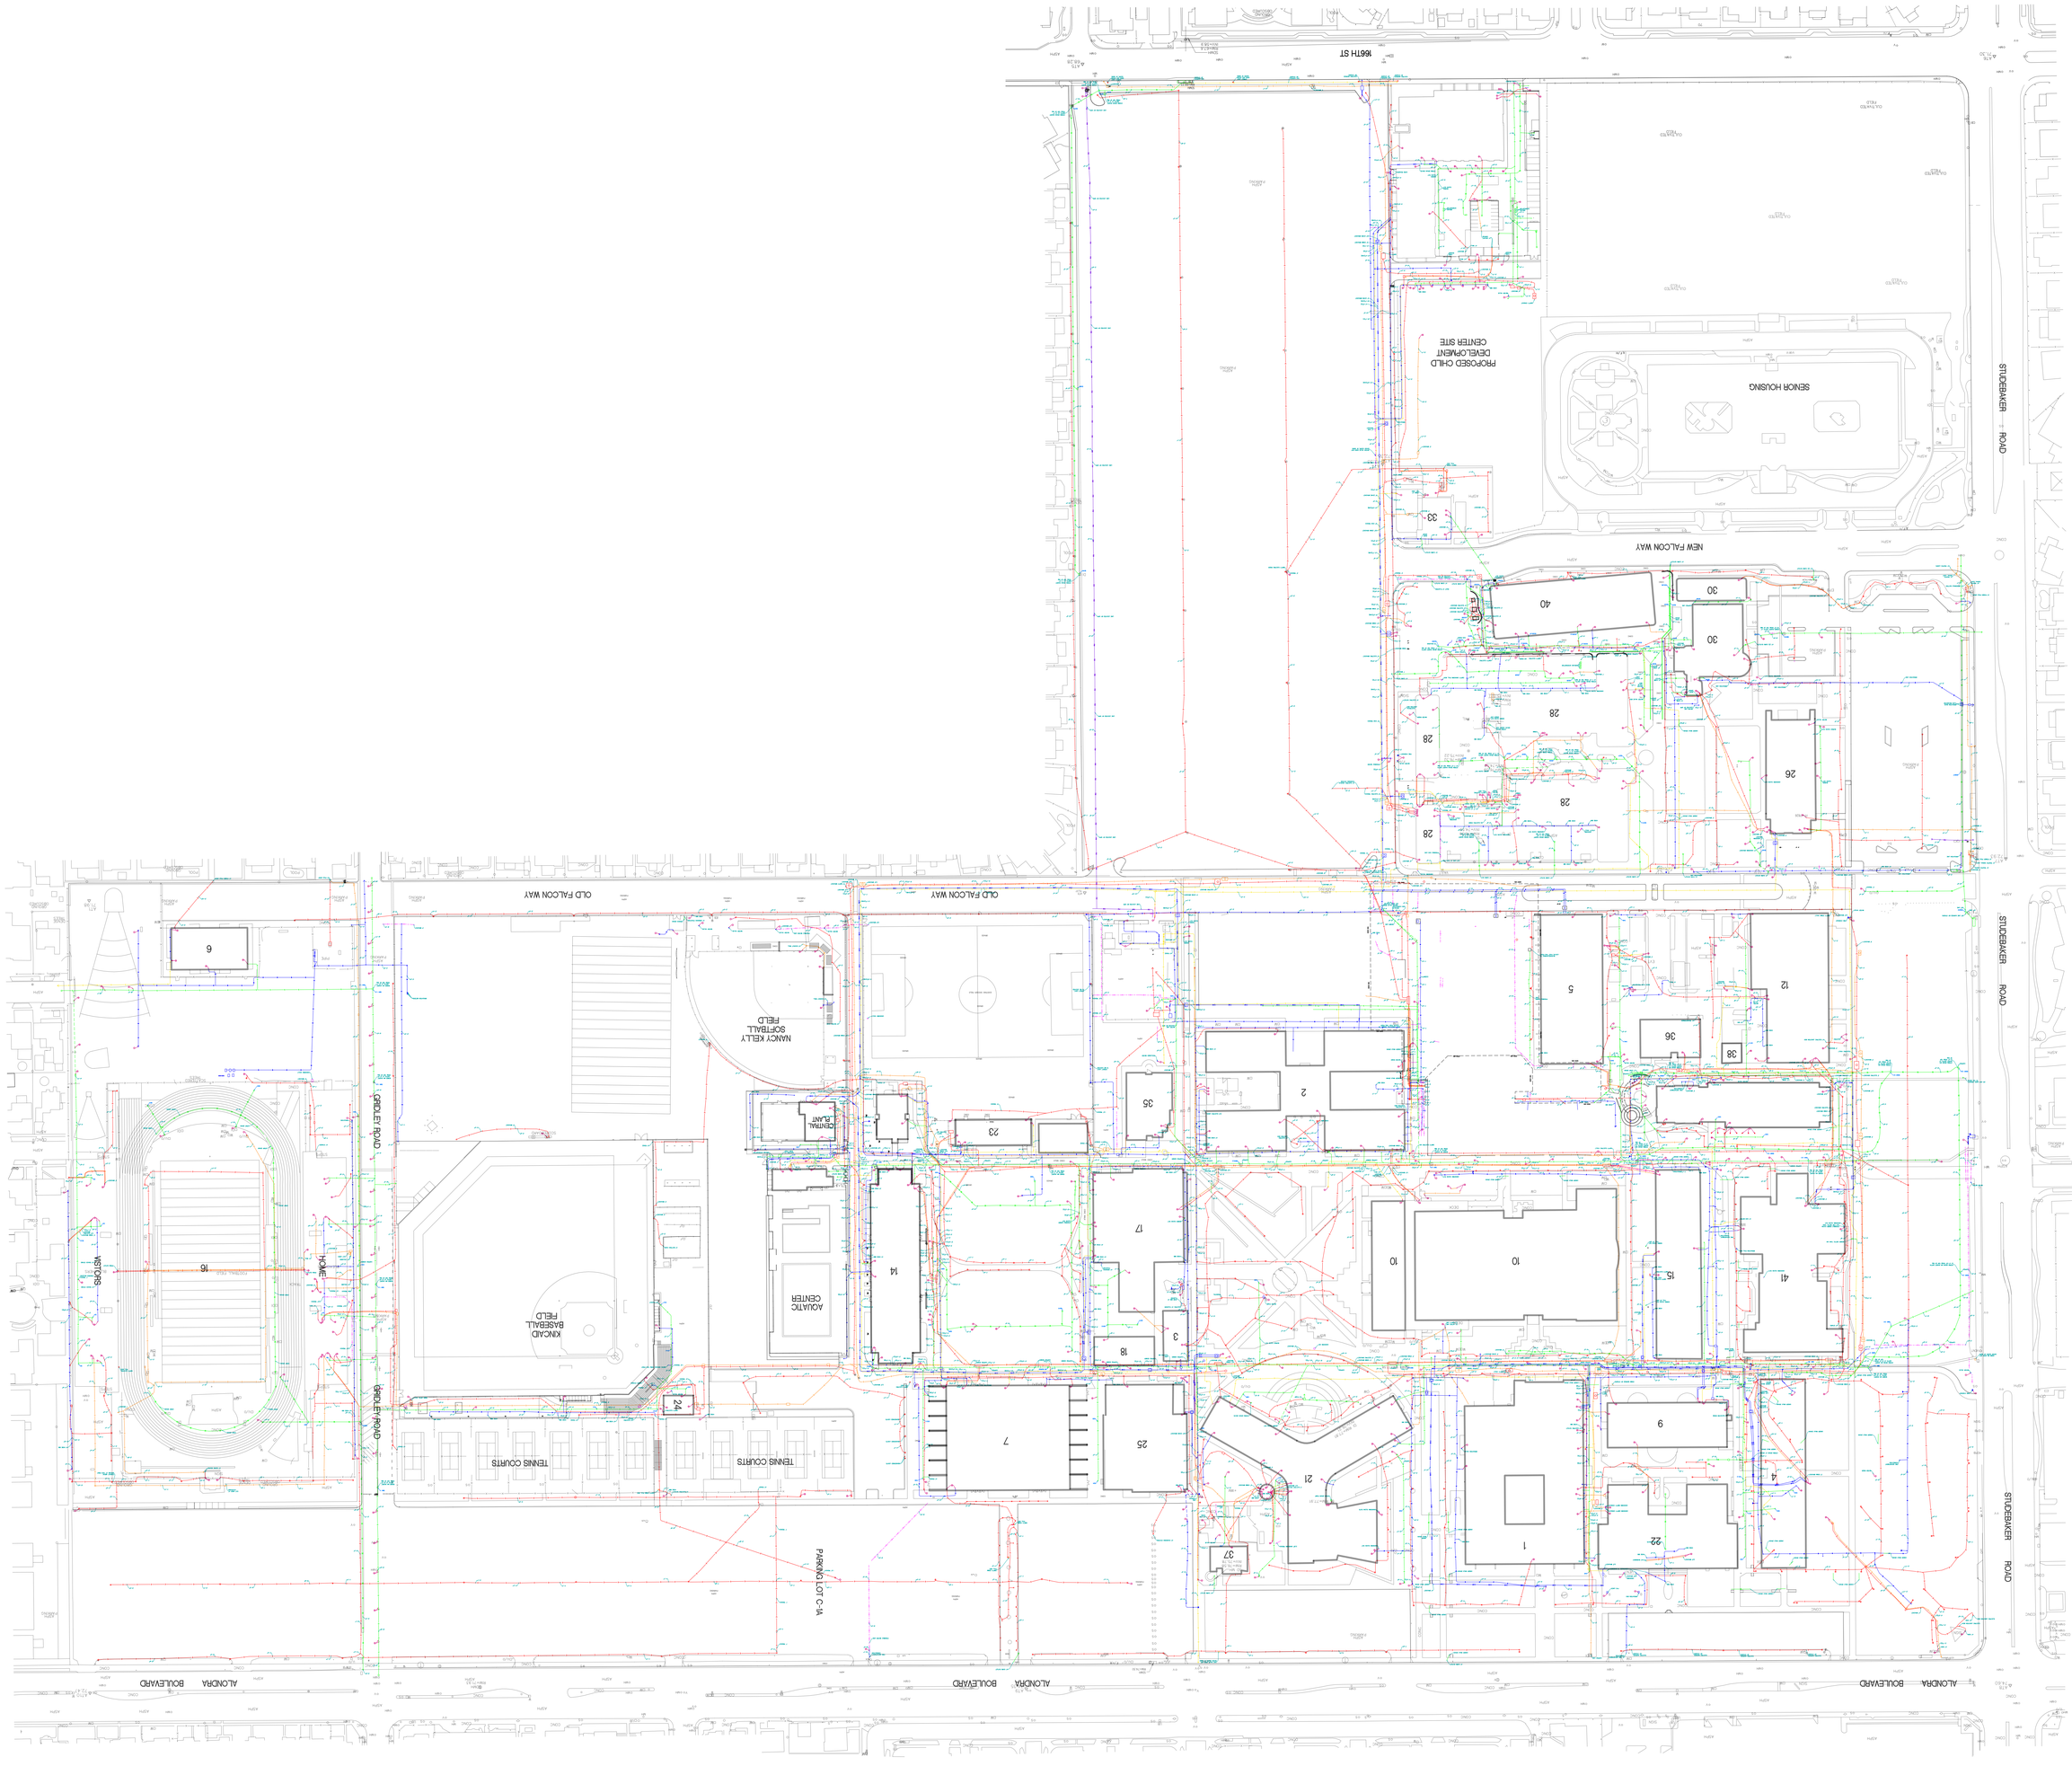

166TH ST
NEW FALCON WAY
OLD FALCON WAY
OLD FALCON WAY
OLD FALCON WAY
PROPOSED CHILD DEVELOPMENT CENTER SITE
SENIOR HOUSING
STUDEBAKER ROAD
STUDEBAKER ROAD
STUDEBAKER ROAD
NANCY KELLY SOFTBALL FIELD
CENTRAL PLANT
AQUATIC CENTER
KINCAID BASEBALL FIELD
TENNIS COURTS
TENNIS COURTS
PARKING LOT C-1A
GRIDLEY ROAD
GRIDLEY ROAD
VISITORS
HOME
ALONDRA BOULEVARD
ALONDRA BOULEVARD
ALONDRA BOULEVARD
33
40
30
30
28
28
28
26
6
16
24
23
35
2
5
12
36
38
14
17
3
18
10
10
15
41
7
25
21
9
4
1
22
37